

**ADDENDUM NO. 3**

March 4, 2016

**Re: Sanford High School and Technical Center  
12-067-00**

To: Bidders and All Others to Whom Bidding Documents have been issued.

All items in this Addendum shall supersede or clarify the Bidding Documents as originally issued. The cost of the Work of all trades affected by the changes in this Addendum shall be included in the Base Bid or Alternates, on the Proposal Form, as applicable. Failure to do so may subject the Bidder to disqualification. This Addendum forms a part of the Contract Documents. It supplements and/or modifies them as follows:

**Item No. 3.1 Reference Specification 10 44 00:** Question: In the fire protection specialties spec section 10 44 00 under Schedule it says to include one cabinet mounted fire extinguisher FE36 type 5BC in all computer labs and classrooms. What exactly do you define as a classroom? Is it just the rooms labeled Classroom? There are many different types of rooms in the building that could be considered classrooms – Please clarify.

Answer: 10 44 00, 3.03 A, Delete item 4. And replace with “Twelve Cabinet Mounted Fire Extinguishers FE-36 Type 5BC to be located by the Architect during construction (in computer intense classrooms/labs)”

**Item No. 3.2 Reference Specification 32 12 93:** Question: The specification for Greenfields turf requires a fiber length of 2” while Field Turf requires a 2.5” fiber. Please clarify is this is correct.

Answer: This is correct. To further clarify, the average Gmax (per ASTM F355 and F1936) rating for any system should not exceed 125 at completion and will not exceed 165 for a period of 8 years. The manufacturer shall submit verification including testing data of this at the time of submittals. Should additional infill or fiber length be needed to obtain this rating, the manufacturer shall provide this at no additional cost.

**Item No. 3.3 Reference Drawing A8.52.** Question: Drawing A8.52/B1 (SPARTANS) calls for 34” cast aluminum letters. Will fabricated aluminum letters at 34” x 2” be acceptable?

Answer: Fabricated Aluminum will be accepted with a minimum thickness of 12 gage.

**Item No. 3.4 Reference Specification 10 50 00** Question: Please confirm if all sub trades are responsible for their own rigging, hoists, cranes, lifts, staging, etc. required for their work. Section 01 50 00 part 3.03 D 4 seems to imply that.

Answer: 01 50 00 3.03 D 3 states the Contractor (GC in this case) is responsible for all hoisting equipment unless its “peculiar” to the needs of a subcontractor in which case per 3.03 D 4 the subcontractor needs to provide. The Contractor (GC) needs to make sure ultimately all hoisting is covered and know what his/her selected subcontractor has or has not carried.

Addendum #3

**Item No. 3.5 Reference Specification 06 10 00** Question: Please provide additional details and/or sketches of the proposed wood framed building per specification section 06 10 00. Also please provide the final location where this building will be installed.

Answer: See drawing A5.41. This is within the residential wiring lab. Also, the notes for wood framing at the gables and roof of the storage building on A8.01 should also refer to 06 10 00 rather than 06 10 54.

**Item No. 3.6 Reference Specification 31 23 15** Question: Please confirm that section 31 23 15 Building Pad Earthwork is expected to be completed by Sub-Bid Package F contractor. The individual section is not designated as such.

Answer: Yes, Section 31 23 15 should be part of Filed Sub Bid Package F per Section 1-B.

**Item No. 3.7 Reference Specification 09 21 16** Question: Please clarify if the term “install” in Sub-Bid Package B’s section 09 21 16 3.03G.

Answer: The blocking should be furnished and installed as part of the 06 10 54 which is NOT in Filed Sub Bid Package B. There is coordination necessary between the subcontractor of 09 21 16 and 06 10 54. In addition, to properly engineer the metal studs, Filed Sub Bidders will need coordinate with the General Contractor to verify where loads are being applied to the walls and the placement of blocking necessary to accommodate those loads. Submittals for Filed Sub Bid Package B (shop drawings) should show locations for blocking with anticipated loads noted.

**Item No. 3.8 Reference Electrical Specifications.** Question: The Spec calls for a MTS but I cannot find it on the one line. Can you advise as to what is required? Answer: There is no MTS on this project.

**Item No. 3.9 Reference Specification 12 36 00.** Question: Please clarify what edge is to be provided on the epoxy resin counter tops. Spec section 123600-2.02-A7 calls for the edge to be 3/16 inch radius bullnose corner. We do not find bullnose edges available from any of the listed manufacturer’s. Edges shown on drawing for lab casework are shown as square edge. The standard detail from Durcon show what is be provided with Machined radius front edge with radius corners at ¼” radius. Answer: Manufacturers standard ¼” radius, machine edge, is acceptable.

**Item No. 3.10 Reference Addendum 2.** Question: ITEM No. 2.80. What rooms are to receive phone list per A0.60 and what size should these be?

Answer: At all rooms with an information center (IC), as noted on drawings. Size to be 8.5 x 11 acrylic window sign as manufactured by Graphic Components, or equal.

**Item No. 3.11 Reference Specification 32 84 00** Question: Irrigation specs for synthetic field system are very vague – please provide specs on HDPE piping system, fittings, pump if needed, heads, swing joints, valves, etc...

Answer: Irrigation Head specifications for the synthetic field system were provided in Addendum #2, HDPE piping, fittings, valves and other relevant materials are provided in Section 32 84 00 – Irrigation Components and/or systems.

**Item No. 3.12 Reference Specification 32 84 00** Question: Related to irrigation, would be possible to install heads on outer playing surface of synthetic field? I fully understand trying to water all areas but 10 boxes with mechanical fitting inside the playing surface

Answer: Yes, heads at the outer playing surface would be acceptable, if modified contractor will be responsible for submitting alternate design for approval and to ensure equal coverage and application rate.

Addendum #3

**Item No. 3.13 Reference Specification 32 84 00** Question: Are the three irrigation meter/backflow set ups to be above ground? If so need specs on pads and enclosures (I could not find detail)

Answer: Yes, the Sanford Water District requested that the meter and backflow be aboveground. A detail is included on Sheet 65.

**Item No. 3.14 Reference Specification 32 84 00** Question: Is there any irrigation on field #2 softball?

Answer: No, there is a stub provided for future irrigation.

**Item No. 3.15 Reference Specification 32 84 00** Question: I see one controller for fields #1 but two water set ups – would it be possible to have one service for these fields to cut down on overall costs and future maintenance?

Answer: This would be acceptable.

**Item No. 3.16 Reference Specification 08 80 00** Question: Section 88000, page 2 calls for types IG-1 & IG 1A, IG-2, IG-3 to have clear glass. Page 7 calls for same to use Guardian Sunguard Light Blue 63 and Sunguard 15. Per the manufacturer those products do not exist. The Light Blue 63 was discontinued and is not available, and the Sunguard 15 doesn't exist at all. Please provide what glass is to be used for IG1/1A, IG2 & IG3.

Answer: Provide clear glass with coatings equal to the basis of design to be selected from Manufacturer's full range. Revise specification 08 80 00 for revised glass selections at IG-1, IG-1a, IG-2 and IG-3 as follows:

**2.05 SEALED INSULATING GLASS UNITS**

A. Sealed Glass Assemblies Basis of Design:

1. IG-1: Sunguard ~~Light Blue 63~~ **Super Neutral 68** on Clear Low-E (#2) and Sunguard ~~15~~ **IS-20** (#4); panels fabricated by Guardian Sunguard Advanced Architectural Glass.
1. IG-1A: Sunguard Super ~~Neutral 68~~ **Neutral 50** on Clear Low-E (#2) and Sunguard ~~15~~ **IS-20** (#4); panels fabricated by Guardian Sunguard Advanced Architectural Glass.
2. IG-2: Sunguard ~~Light Blue 63~~ **Neutral 50** on Clear Low-E (#2) and opacifier panel by Guardian (#4); panels fabricated by Guardian Sunguard Advanced Architectural Glass.
3. IG-3: Sunguard ~~Light Blue 63~~ **Neutral 50** on Clear Low-E (#2) and satin-deco etched panel by Guardian (#3); panels fabricated by Guardian Sunguard Advanced Architectural Glass.

**Item No. 3.17 Reference Specification 08 80 00, 08 51 13, 08 43 13 08 44 13 and Related Drawings.** Question: Please clarify what type of windows are used in what locations.

Answer: The following is a clarification on the correct specification section for the windows and aluminum framing.

- Revise specification section 08 80 00 2.08 C. to "Insulated Sliding Glass Window"
- 08 51 13 Aluminum Windows: Types: W1 through W8
- 08 80 00 Insulated Sliding Glass Window: W9
- 08 43 13 Aluminum Storefront (with entrance doors and windows as indicated in 08 43 13 where shown): S1-5, S7-12, S15, S17, S18, S21 –S33, IC2, IC3, IS1-12-35, IS37-38
- 08 44 13 Curtain Wall (with entrance doors and windows as indicated in 08 43 13 where shown): C1-C19, IC1, IC4, IC5, IC6, IC7, IC8
- 08 80 00 Sliding Glass Window: IS36

Addendum #3

**Item No. 3.18 Reference Specification 08 44 13** Question: Section 84413, the system specified at 2" wide is not available for 4 side SSG. We would need a system that is 2 ½" wide.

Answer: 2.5" wide is acceptable where the manufacturer cannot accommodate the system in a 2" format.

**Item No. 3.19 Reference Specification 08 44 13** Question: Section 84413 page 3, calls for a 13" deep cover, the drawings are detailed using a 9" deep cover. Which is correct?

Answer: 9" is correct. Revise Specification 08 44 13 2.02 Curtain Wall A. 1. a. 2) to the following: Type 2: EFCO 12L8 9" deep pin on sunshade cover. Provide pressure plate as required by manufacturer

**Item No. 3.20 Reference Specification 08 44 13** Question: Section 84413, page 4 line 4 calls out a custom 6" x 6" post "as indicated on drawings" We went through the details and do not find this condition drawn. If this exists, please provide the location & detail for such.

Answer: Detail J4/A3.61 shows the condition. The location is at Curtain Wall C6. Revise the detail call out for the lower portion of the left jamb (at the IG-2 glazing) to be J4/A3.61.

**Item No. 3.21 Reference Specification A0.38, A0.39, A0.45** Question: Many of these curtain wall frames do not appear to have any mid-span anchor points available. Those points need to be available and/or the mullion depth will need to increase substantially

Answer: The following Curtain Walls exceed unbraced height limitation of curtainwall and mid-span anchors are required: C1, C2, C6, C7, C8, C16. Anchor points to structural steel are available – anchor similar to details J4/A3.17 and E5/A3.35. C7 should be designed to be jamb anchored and span horizontally.

**Item No. 3.22 Reference Electrical Site Drawings** Question: The ES dwgs do not utilize "match lines". Without the "match lines", we are unable to accurately measure the ductbanks as the drawing areas do appear to overlap slightly. Please consider reissuing these dwgs with "match lines".

Answer: Match lines were added to all site drawings, see ES attached drawings.

**Item No. 3.23 Reference Drawings ES2.02** Question: The site electrical dwgs show what appear to be hand-holes tagged EHH, LHH1 and THH1. I see details for EHH and CHH on ES2.06 and LHH1 on ES2.03. Please advise what THH1 is and if and where CHH is to be utilized?

Answer: THH1 and CHH1 are the same. Telecom Hand Hole/Communications Hand Hole shall be all labeled THH1.

**Item No. 3.24 Reference Drawings ES1.01, 1.04, 1.08** Question: ES1.01, ES1.04, and ES1.08 have note 3 indicating Alternate 7 and that the fixture head and wiring is an "add alternate". Section 012300 indicates that Alternate 7 is fencing. However Alternate 15 is a deduct to eliminate signage lighting. Please advise the correct way to price the Base bid and these alternates?

Answer: Drawing note 3 on sheets ES1.01, ES1.04, and ES1.08 shall reference Alternate 15 as described in specification section 012300. Drawing note 3 shall be revised to say "TYPE G1 SIGNAGE FIXTURES AND WIRING ARE TO BE REMOVED UNDER ALTERNATE #15. UNDER BASE BID, PROVIDE DIRECT BURY POLE AND BASE (SEE F1/G1 FIXTURE DIRECT BURIAL POLE MOUNTING DETAIL ON DRAWING ES2.04), FIXTURES, CONDUIT, AND CIRCUITING AS INDICATED. UNDER

Addendum #3

ALTERNATE #15, PROVIDE DIRECT BURY POLE AND BASE, AND CAPPED CONDUITS WITH PULL STRINGS FOR FUTURE USE.”

**Item No. 3.25 Reference Specification 26 01 00** Question: 260100-1.01-D-1 and E-1 calls for us to include CMP’s fees. I had a conversation with the CMP contact listed on dwg C35. He has indicated that CMP has not been provided with enough information as of yet and that CMP will NOT have fixed pricing available. We advise that the specification be amended for Utility fees be excluded from our filed-sub-bid or specify an Allowance amount for us to include.

Answer: See Addendum 2.53

**Item No. 3.26 Reference Specification Divisions 26 and 27** Question: Division 26 spec section are all titled with (Electrical Trade Bid Required). Division 27 spec sections are all titled with (Telecommunication Trade Bid Required). Section 1-B indicates that Sub-Bid Package E includes Div 26 Electrical and Div 27 Communications. Please confirm that we shall provide a single bid inclusive of Div 26 and Div 27?

Answer: Yes, Division 26 and 27 is a single filed sub-bid by the electrical contractor under Field Sub Bid Package E

**Item No. 3.27 Reference Specification 26 71 00** Question: 267100-2.18: Line A calls for us to provide, but line B says furnished by Div 8. Please confirm who is to furnish and install the door holder-closers?

Answer: To be provided by Division 8 and wired by the Electrical Contractor.

**Item No. 3.28 Reference Specification 26 71 00, 2.01** Substitution Request Simplex Grinnell 4100ES shall not be an acceptable substitution for the specified Silent Knight Fire Alarm System.

**Item No. 3.29 Reference Specification 08 80 00** Question: Type IG-4 is described as a custom profile panel, to match details as drawn. When you look at the said detail, there is no custom profile shown. If a custom profile is required please confirm and detail as such.

Answer: Specification description is correct. In details J8/A3.36 and J11 /A3.36 revise the IG-4 insulated metal panel profile to be flush with the Mullion Cover Type 1. In detail J5/A3.64, revise the IG-4 insulated metal panel profile to be flush with the Mullion Cover Type 1 and replace the 08 44 13 SSG frame at the jamb to 08 44 13 Mullion Cover Type 1

**Item No. 3.30 Reference Drawing A0.39** Question: Drawing A0.39 shows designation for type IG-4, but also has reference to those areas as being panels under division 7 spec?

Answer: In the Glazing Schedule for IG-4: replace “07 40 00 – INSUL MTL PANEL” with “08 80 00 – INSUL GLASS – OPAQUE PANELS”

**Item No. 3.31 Reference Drawing A0.39** Question: Drawing A0.39, there is a frame with type IG-1 called out, but is also drawn with a different infill shading than the other areas marked IG-1?

Answer: C2/A0.39 – change IG-1 tags at stippled area to indicate IG-2 08 80 00 INSUL GLASS – SPANDREL C16/0.39 – IG- 1A and 4 only (no IG-1 or 2)

**Item No. 3.32 Reference Specification 13 12 55 and Drawing A8.06** Clarification: See attached Specification 13 12 55 for the away side (smaller) bleacher. Bleacher shall be 500 seat and as shown on the drawings, A8.06. All references on A8.06 should point towards section 13 12 55 instead of 13 12 50 as currently noted.

Addendum #3

**Item No. 3.33 Reference Addendum #2** Question: Subcontractor bid form issued w/ Add #2, Section 2-B-3 Item 2.1 Mass Rock Excavation and Off Site Disposal has Add/Deduct Pricing. Is this pricing in reference to the 5,000 c.y. listed in 01 21 00 Allowances, 2.01A? Answer: This is related to 01 21 00 as well as 01 22 00 1.07 B 1.

**Item No. 3.34 Reference Specifications** Question: How are trench and mass rock removal to be paid for? Answer: See sections 01 21 00 as well as 01 22 00 1.07 B 1.

**Item No. 3.35 Reference Specification 31 23 15** Section 31 23 15 Building Pad Earthwork, 1.04B states testing by owner and paid from testing allowance, but we cannot find the testing allowance or who carries it. Answer: The owner will carry the testing allowance / pay for this testing.

**Item No. 3.36 Reference Specification 32 12 16** Section 32 12 16, Asphalt Paving, 1.06A.1 & 2.01B refers to "prime coat. We have not seen a "prime coat" requirement for many years and may require a special DEP permit. Is the prime coat required? Answer: Both of these references are for tack coat between binder and surface layers

**Item No. 3.37 Reference Specification 01 50 00** Question: Section 01 50 00, Temporary Facilities, 1.09A reads that no temporary fencing is required, while Note 25, Plan C3 states that temporary fencing is required and to be carried by the Site Contractor. Please clarify. Answer: Temporary fencing is not required.

**Item No. 3.38 Reference Specification Section 01 00 00** Question: Does the term 'CONTRACTOR' refer to the General Contractor? Answer: The Term contractor shall refer to either the General Contractor or the Sub Contractor. Generally the filed sub bid specification sections use the term as the Sub-Bidder.

**Item No. 3.39 Reference Civil Specifications** Question: Please confirm that any fill material (granular borrow) required for muck/peat replacement is incidental. Answer: Yes.

**Item No. 3.40 Reference Specification 22 13 00** Question: Section 22 13 00, Sewers, Drains & Site Piping, 1.02A1.d, states that the Site Contractor is responsible for electrical/telecom conduit. Please confirm that this is to be supplied and installed under Subbid E Answer: Please refer to Addendum 2 for clarification. The electrical contractor will be responsible for the electrical/ telecom conduit.

**Item No. 3.41 Reference Civil Drawings** Question: Regarding the existing 36" sewer that sanitary manholes 5, 13 & 14 tie into: What material is the existing sewer? We would like to see a detail on the proposed 48" diameter manhole and how is to be installed on the existing 36" sewer Answer: The existing 36" sewer is reinforced concrete pipe. Please refer to the sewer manhole doghouse structure detail on Sheet 63 for the connection. A standard 48" diameter manhole will not be acceptable.

**Item No. 3.42 Reference Addendum 2.** Question: ITEM No. 2.80. What rooms are to receive these map signs? Answer: All rooms with an IAO, E, A2, A3, or A1 occupancy classification. (refer to Code Plans)

Addendum #3

**Item No. 3.43 Reference Drawings ES2.01, 2.02** Question: The 1-line indicates 8 sets of 4-#500 in 4”C + 1 spare. ES2.01 indicates P2 as 4”C w 4-#600. ES2.02 indicates trench B as 15x P2 + 2 spares. Please confirm that 8 sets + 1 spare is desired for each service? Please advise if #500 or #600 is required for the service?

Answer: The one-line is correct; 8 sets of 4-#500 in 4”C + 1 spare. Drawings ES2.01 and ES2.02 have been updated and are attached.

**Item No. 3.44 Reference Drawing ES2.02** Question: There is clearly intent to have site and stadium cameras as well as press box communications run to the stadium electrical building. Trench detail F on ES2.02 does not contain a communication conduit. Please advise as to how, or modify ES dwgs, to provide for a backbone pathway from the school to the stadium electric room. Answer: Trench detail was updated – drawing attached.

**Item No. 3.45** Question: Please confirm that we should provide a communications pathway from the pressbox, down the bleacher structure, and underground to the stadium electrical building? Note 3 on ES1.10 indicates power only to the pressbox. Answer: Pathway from pressbox to electric room required.

**Item No. 3.46 Reference Drawing T1.31** Question: T1.31 indicates communications in the prefabricated pressbox. Please advise how we are to cable this area? Should we plan on using Wiremold or surface EMT?

Answer: Provide Wiremold Raceway System.

**Item No. 3.47 Reference Electrical Site Drawings** Question: ES1.01, 2, 3, 4 has note calling for a spare 1.5” C. Is that the conduit between THH1 handholes? If not, what is the conduit size between THH1’s? This conduit line appears to be used for the pole cameras on ES1.04, 7, 8, and 10 but empty again on ES1.12, 13, and 14 where there is no note for spare conduit.

Answer: Drawing notes refer to lighting system. THH1 requires 2-2”C between handholes. 1 for fiber and 1 spare for the future.

**Item No. 3.48 Reference Electrical Drawings and Specifications** Question: Please confirm quantity and location of the site security cameras:

- a. According to the Site Lighting Schedule, the “C” in R2C and S4C indicates to provide for camera mounting. According to the Security Phone spec, the Blue Phones are to be provided with an integral camera. Answer: **Mount**
- b. I see 1x 180 camera on R2C light poles on each ES1.04 and 1.07. Answer: **Correct.**
- c. There is an R2C shown on ES1.10, but no camera is shown at this location. Please advise if we should provide a camera and fiber optic cabling? Answer: **Camera and cabling not required. Pole only for future location.**
- d. There is a 360deg camera shown on the Blue Phone on E1.10 with copper cabling to the stadium electrical building. Answer: **Yes**
- e. ES1.08 has a Blue Phone and S4C pole light in the same vicinity with a 360deg camera. Is this camera to be mounted on the Blue Phone, the light pole, or should we provide a camera on each? Answer: **Camera is on blue phone location on mount provided with pedestal.**

## Addendum #3

**Item No. 3.49 Reference Electrical Drawings** Question: Blue Phone spec indicates that 120V is required. ES2.04 shows a 120 duplex receptacle in the pole mounted box for the media converter. None of the ES dwgs indicate providing 120V power to either the site phones or camera locations. Please modify the ES dwgs to include conduit and wiring (size and source) as required. There appears to be a conduit from CHH1 running to E127B in ES1.08; Is this for 120V to this Blue Phone and S4C?

Answer: See attached Drawings. Should read THH1 in lieu of CHH1. This is for fiber optic cabling. Power for blue light phones added to attached updated drawings (ES1.08, 1.10).

**Item No. 3.50 Reference Electrical Drawing E2.41.** Main electric room closet (2-hour rated) and equipment layout was revised. See updated Drawing. See attached sketch SKA-AD3.50 for revised Emerg Elec room B054B. Revise door B054B to a single 42x84 HM door. Revise Hardware to set 019.

**Item No. 3.51 Reference Drawing C9.** Question: What does the concrete curb sit on in the permeable paver parking area? Answer: See attached updated drawing C66 with added detail for this condition.

**Item No. 3.52 Reference Specification 03 30 00, 2.05, C:** Change the concrete specification for elevated slabs item 3. Elevated slabs (section 2.05 C), page 8 of 20 within specification 03 30 00) to read:

3. Elevated slabs:

- a. Strength: 4,000 psi at 28 days
- b. Aggregate: 3/4" **Maximum**, Light Weight, **Presoaked**
- c. Design Air Dry Density: 115 pcf Light Weight
- d. W/C Ratio: 0.52 maximum **based on active water, or as determined per ACI 211.2.2.3, Method 1 (Weight Method, Specific Gravity Pycnometer) or Method 2 (Trial Mixtures)**
- e. **Entrained Air 5 1/2% +/- 1 1/2%**
- f. Slump: 4" maximum **at point of discharge from conveying equipment**

**Item No. 3.53 Reference Drawing C66.** Question: Plan C66 shows 4" depth of loam in landscape areas & C70 shows 4" depth amended loam & 8" depth of Type 'B' sand. We cannot find the demarcation borders between the two finishes.

Answer: Sheets 15 and 16 include a call out that points to the edge of field and reads "limits of typical field section." The same would apply to the softball field shown on Sheet 17. The outer edge of field areas is the demarcation between the two finishes.

**Item No. 3.54 Reference Civil Drawings.** Question: There are numerous test pits shown on the plans marked 'STI-TP xxx' but we cannot find in the Geotechnical Report. Is this information available?

Answer: Test pits with the STI designation were performed by Sebago Technics and are not included in the geotechnical report. They are enclosed as part of Addendum 3, along with the Soils Map. See attached.

**Item No. 3.55 Reference Civil Drawing C64.** Question: Plan C64 shows a headwall detail w/ notes to see reinforcing plan. Where is this shown?

Answer: The reinforcing headwall section is part of the overall detail for the headwall.

Addendum #3

**Item No. 3.56** Reference Civil Drawing C64. Question: Plan C64-Typical Foundation Section shows a vapor retarder. What subbid section should include this?

Answer: The General Contractor should include the vapor retarder per architectural drawings.

**Item No. 3.57** Reference Civil Drawing C65. Question: Plan 65, regarding the above ground water meters, which section(s) should include the enclosure, heating system and meter?

Answer: The meter, valves, pipe and fitting shall conform to Section 221113. A detail for the enclosure system shall be provided by the contractor for approval, as it is not covered in the specifications. A heating unit is not required as part of this project.

**Item No. 3.58** Reference Specification 22 13 00, 2.02 A-H. Substitution Request SC 740 by ADS Stormtech shall not be an acceptable substitution for the specified S-29 by Triton by NDS. .

**Item No. 3.59** Reference Drawing S1.6, S1.3, S1.5, S1.9. Question: Line CE-1 from line C-1 to match line shows both sections 4/S2.2 & 4A/S2.2. Please verify.

Answer: Attached drawings S1.3, S1.5, S1.6 & S1.9 clarify this section and other foundation sections in certain locations. Rammed Aggregate Pier loads are clarified on S1.9. Note 4A/S2.2 specifies a 4 foot wide footing. Note 7 "Sim"/S2.2 specifies a 4 foot wide footing.

**Item No. 3.60** Reference Sub-bid Package F and Specification 03 30 00. Question: Are the following items included with the building package or the site package? a. Concrete door stoops b. CTE and Field Storage buildings foundations and slabs c. Bleachers seating foundations and slab d. Visitors seating foundation and slab.

Answer: Concrete door stoops with a frost wall foundation underneath (detailed on the structural drawings) shall be by the General Contractor. CTE and Field Storage Buildings foundations and slabs (detailed on the structural drawings) shall be by the General Contractor. Bleachers seating foundations and slab (detailed on the structural drawings) shall be by the General Contractor. Visitors seating foundation and slab (detailed on the structural drawings) shall be by the General Contractor. These items shall be excluded from Filed Sub Bid Package F.

**Item No. 3.61** Reference Specification 12 34 00. Question: Please clarify what test reports are to be submitted for the Fume Hoods as called for in spec section 123400-1.03-A-1. We have not found any test requirements.

Answer: Delete requirement for test reports under section 12 34 00 1.03 A-1.

**Item No. 3.62** Reference Specification 12 34 00 and 12 36 00 and Drawings A6.20 and P1.14. Question: Please clarify what size sinks are to be provided in the Fume Hoods as shown on elevation F1 on drawing A6.20. Plumbing drawing P1.14 notes call for these sinks to be provided by others and no sizes are noted.

Answer: The 12 36 00 Lab Sink sizes for fumes hoods are listed under 12 36 00 2.02 C 2.d.

**Item No. 3.63** Reference Civil Drawings. Question: On the detail for the tennis courts it calls for a 9ga 2" mesh fabric. Typical for tennis courts is a 1 3/4" mesh. Which one would you like? Answer: Please use 1 3/4" mesh.

Addendum #3

**Item No. 3.64 Reference Civil Drawings.** Question: The detail for the tennis courts also shows the footings belled out at the bottom. Can we go with a standard 12" x 48" deep hole? -otherwise we would have to get the posts precast in concrete

Answer: Footings need to be belled as currently shown. Posts need to be a minimum 54 inches deep with concrete to a depth of 60 inches. Diameters at the top and bottom shall be coordinated with the manufacturer, but the footing diameters shown in the details on Sheet 68 shall be the minimum

**Item No. 3.65 Reference Civil Drawings and Specifications 32 31 13** Question: On the Pedestrian Guardrail (ornamental fence) it shows the spacing or panel sections at 5'. They come 8' from the manufacturer. Can we go with 8' sections or do you want us to cut them all down to 5' sections? Answer: 8 foot sections is acceptable.

**Item No. 3.66 Reference Civil Drawings and Specifications 32 31 13** Question: On the 4',6' and tennis court fencing, I would like a clarification if you want bottom tension wire or bottom rail. There is contradiction between the details and specs? Answer: Bottom rail.

**Item No. 3.67 Reference Specifications 32 31 13.** Question: Related to fencing, the spec for the pipe is 2oz compared to typical 1.8oz. This is extremely rare to go with 2oz, not to mention the extreme increase in costs, but just wanted to confirm. Also you are asking for an alt for vinyl coated. Would you want 2oz vinyl coated pipe as well?

Answer: 1.8 oz. is acceptable.

**Item No. 3.68 Reference Drawing ES2.01 and Civil drawing C7.** Question: Which Sub-bid carries the transformer and generator pad?

Answer: The Generator Pad and the Transformer Pad should be carried by the General Contractor and excluded from Sub Bid Package F. Site Preparation for the pads including fill materials shall be by the Site Contractor under Package F. Change/clarification of discrepancy: there are three pads required at this location. Final sizes will need to be verified with the equipment. At this time, the General Contractor should assume two 10'x10' pads for transformers, and one 10'x15' for the generator. For all three pads, see detail on ES2.01.

**Item No. 3.69 Reference Drawing 26 56 68.** Question: Are the bases for the stadium lights in Subbid F?

Answer: Stadium light foundations are by electrical contractor – see section 26 56 68.

**Item No. 3.70 Reference Sub Bid Package F.** Question: Are the exterior concrete slabs that are doweled into the building foundation in Sub Bid F? If so, who is responsible for installing the dowels?

Answer: For exterior slabs without a foundation underneath, which are provided by the Site Work Contractor under Sb Bid Package F, the dowels are site work contractor, package F.

**Item No. 3.71 Reference Electrical Drawings.** Question: Regarding Filed Sub Bid Package F, concrete duct encasement, is reinforcing required and if so, is there a detail?

Answer: Reinforcing is not required.

Addendum #3

**Item No. 3.72 Reference Drawing C28 and C70.** Question: Regarding the Artificial Turf & Track: C-43 shows a 12" & 8" collector drains around the perimeter at the edge of track and the field. C-28 shows a 4" UD in the same location. C-70 shows a trench drain. Is the trench drain continuous around the track and if so, should the 4"

Answer: Disregard the notes referring to a '4" perimeter track UD' on Sheet 28. The track trench drain is continuous around the track. The 'TRACK DRAIN CATCH BASIN & COLLECTOR SYSTEM' detail shown on Sheet 70 is correct.

**Item No. 3.73 Reference Specification 01 23 00.** Question: Regarding Alternate 16: If the J drains are deleted are they replaced with something else?

Answer: J-drains will not be replaced. If the question's intent is how to handle the void left by the j-drain then assume it is replaced by surrounding material.

**Item No. 3.74 Reference Drawing C-65.** Question: Plan C-65 has a detail of 'INLET CONTROL STRUCTURE' with a label stating to see Note 4. Where is Note 4?

Answer: The special structure notes were incorrectly included as part of the infiltration basin on Sheet 64. The call out on the 'INLET CONTROL STRUCTURE' should read "see special structure note 3 for wall thickness requirements."

**Item No. 3.75 Reference Drawing C-63.** Question: Detail 'GROUNDWATER RELIEF DRAIN', Plan C-63 states the pipe to be PVC. Is HDPE acceptable? Answer: Perforated HDPE with the perforations faced up is acceptable.

**Item No. 3.76 Reference Civil Drawings.** Question: Numerous notes on the details (porous pavement C-66, subsurface sand filter C-65, etc.) refer to inspections by a P. E. Is this cost to be included in Sub bid F?

Answer: No, this is a cost to the owner. These notes are required on the plans for State permitting. The contractor is responsible for coordinating with the inspecting engineer.

**Item No. 3.77 Reference Drawing C68.** Question: Is there a specification section for the ornamental fence detailed on C-68? Answer: Refer to Section 129300.

**Item No. 3.78 Reference Specification 31 20 00.** Question: Should the Site Work Contractor follow the Earthwork Specification (Section 312000) or the Geotechnical Report for earthwork considerations? The specification section indicates the Geotechnical Report takes precedence, but then indicates the "report is not a part of the contract documents and is furnished only for the information and convenience to the contractor." The specification section and the Geotechnical Report differ on acceptable use of material for fill applications

Answer: The geotechnical report takes precedence. Refer to Section 312000 1.01.D.

**Item No. 3.79 Reference Specification 27 74 00** Question: Spec section 27 74 00; 2.03, A. 1 specifies a "cleave and polish" style connector for fiber optic terminations, would a "cleave and crimp" style be acceptable? Please note this is a standard type of termination which complies with TIA requirements for terminations and testing.

Answer: Fiber terminations per specification are bonded by epoxy to fiber and more reliable. While accepted by standards there is higher possibility/probability of fiber pulling from crimp type connections.

**Item No. 3.80 Reference Specification 26 23 00** Question: 262300, 2.03.C – Are circuit breakers with solid state adjustable trip units acceptable in lieu of the thermal magnetic trip unit that is specified?

Addendum #3

Answer: Solid state adjustable trip breakers are acceptable.

**Item No. 3.81 Reference Specification 26 23 00** Question: 262300, 2.04.B & D – Which ATS mode of operation is intended for this project – ‘Adjustable dwell period’ or ‘in-phase monitor’? Answer: In-phase monitor.

**Item No. 3.82 Reference Specification 26 23 00** Question: 262300, 2.07 – There is no maximum sound level specified for the sound attenuated enclosure. The typical industry offering would be 75 dB(A) @ 23’ under full load conditions. Is this acceptable? Answer: Standard enclosure is acceptable.

**Item No. 3.83 Reference Specification 26 32 00** Question: 263200, 2.09.G – It appears that the specified 48 hour capacity fuel tank is the only fuel tank for the system. Does paragraph ‘G’ (electrically operated fuel transfer pump) apply here? If so, what are the distance and elevation change to the underground fuel tank?  
Answer: Skid-mounted fuel tank, only – no transfer pump needed.

**Item No. 3.84 Reference Electrical Drawings** Question: Confirm HP for Item Number: CP-1, CP-3, B-1, B-2, B-3, B-4 & B-5 Answer: Various information on mechanical equipment schedule is correct.

**Item No. 3.85 Reference Electrical Drawings** Question: PP-2 is designated to be a combination starter. Unit is single phase 1/8HP. Please confirm if this is correct?  
Answer: **Equipment PP-2 is 120V, single-phase – change “2” in the column to a “1” (manual starter). Drawing to be re-issued.**

**Item No. 3.86 Reference Electrical Drawings** Question: Feeder to Transformer ST1 shown as 500A, panel schedule shown as 600AET.  
Answer: Panel P4SBB1 – panel schedule should show 500ET, to match the one-line. See attached Revised Drawing.

**Item No. 3.87 Reference Electrical Drawings** Question: Panel has a 150AF feeder, maximum available is 100AF/3P. Maximum allowable circuits is 42, schedule has 54.  
Answer: Panel P4LSB1 – Eliminate 150A feeder from panel, and make panel 42 poles – modified one-line diagram. See attached Revised Drawing.

**Item No. 3.88 Reference Electrical Drawings** Question: Panel P2LSB1 has a 125AF feeder, maximum available is 100AF/3P. Answer: Change 125 amp feeder breaker to 100 amp. See attached Revised Drawing.

**Item No. 3.89 Reference Electrical Drawings** Question: Panel P2N1C6 - One-line shows ET MCB, panel schedule does not. Answer: Panel P2N1C6 – panel schedule should show ET on MCB. See attached Revised Drawing.

**Item No. 3.90 Reference Electrical Drawings** Question: Panel D2N1D1 – panel schedule should show 1000A ET MCB. Answer: Panel schedule changed. See attached Revised Drawing.

**END OF ADDENDA #3**

**SECTION 13 12 55**  
**HEAVY DUTY ALL-ALUMINUM FRAME BLEACHER**

**PART 1 GENERAL**

**1.01 SECTION INCLUDES**

- A. Bleacher Seating System

**1.02 RELATED REQUIREMENTS**

- A. Section 03 30 00 – Cast in Place Concrete
- B. Division 31 – Earthwork
- C. Division 32 – Site Construction
- D. Division 26 - Electrical: Equipment wiring.

**1.03 ADMINISTRATIVE REQUIREMENTS**

- A. Coordinate all foundation systems between manufacturer and Structural Engineer. Current drawings shown have been coordinated with the Basis of Design manufacturer. Concrete Slab shown is on bid document drawings, in order to establish an equal bidding opportunity for all participants. Slab changes may be required with some manufacturers. Additional Costs (if any) for foundation changes required by the manufacturer must be included within the bid.
- B. Coordinate with all Structural Design Loads for the project. See Structural Drawings. Guardrail loads shall comply with current building codes and requirements (State of Maine).

**1.05 SUBMITTALS**

- A. See Section 01 30 00 - Administrative Requirements, for submittal procedures.
- B. Product Data: Provide manufacturer's data showing configuration, sizes, materials, finishes, hardware, accessories, electrical characteristics and connection locations.
- C. Shop Drawings: Include: For custom fabricated systems indicate, in large scale detail, construction methods; method of attachment or installation; type and gage of metal, hardware, and fittings; plan front elevation; sections, section details, seat details, seat materials, elevations and dimensions; utility requirements as to types, sizes, and locations. Seating plan indicating aisles, walkways, seating sections and exits and showing exit calculations using appropriate tables and requirements of the Maine State Building Code. Footings and foundation sizes and types and relationships to finish grade in compliance with construction documents. Exposed portions of foundations, pier height and top elevations shall be subject to customer approval.
- F. Samples: Submit samples representative of materials and finished products as may be requested by the Architect.
- G. Product Certificate: Prepare written statement on manufacturer's letterhead certifying that product complies with requirements in the Construction Documents.
- H. Warranty: Submit manufacturer warranty and ensure that forms have been completed in Owner's name and registered with manufacturer.

### 1.06 QUALITY ASSURANCE

- A. Manufacturer Qualifications: Company specializing in manufacturing products specified in this section, with not less than ten years of documented experience.
- B. Installer Qualifications: Company specializing in performing work of the type specified with minimum five years of experience.
- C. Installation: Installation shall be performed by factory trained and certified representatives of the grandstand manufacturer. Installer shall have completed at least three installations of similar size.

### 1.07 DELIVERY, STORAGE, AND HANDLING

- A. Deliver products to project site in manufacturer's original packaging with factory original labels attached.
- B. Store products indoors and elevated above floor; prevent warping, twisting, or sagging.

### 1.08 WARRANTY

- A. See Section 01 78 00 - Warranties, for additional warranty requirements.
- B. Product shall be guaranteed for (5) years on the structure and (3) years on the finishes together with labor.

## PART 2 PRODUCTS

### 2.01 MANUFACTURERS

- A. Basis of Design: Dant Clayton Corporation – Alum-A-Stand system
- B. Acceptable Manufacturers, subject for product review:
  - 1. Substitutions: See Section 01 60 00 - Product Requirements.

### 2.02 PRODUCT COMPONENTS

- A. See Drawings for design intent.
- B. All material and workmanship shall be in accordance with the following:
  - AISC Manual, 8<sup>th</sup> Edition
  - ACI Building Code for Reinforced Concrete
  - Aluminum Association of America
  - Maine State Building Code
- A. Design Loads:

Dead Load	6 psf	seat and footboards risers, etc.
Live Load	120 psf	to structural member
	120 plf	seatboards
	120 plf	footboards (individually)
Design Wind Speed	75 mph	on projected vertical surface
Sway	24 plf	parallel per ft. of seat parallel to seat run
	10 plf	perpendicular per foot of seat
Guardrail Loads	50 plf distributed or 200 lb concentrated load applied in any direction	
- B. Understructure Criteria:

The following criteria is used to establish a minimum requirement for strength, stiffness, and rigidity of the understructure components.

Moment of inertia of	.822
Section modulus of	.576
Radius of gyration of	.975
Axial loading of	.889

- C. Code Compliance: Submittals shall be based on specifications contained in the bid documents or the latest code edition adopted at the time of bidding.

## 2.03 MATERIALS

- A. Understructure:
1. Understructure shall be fabricated from 6061-T6 alloy aluminum extrusions.
  2. Vertical members shall be 2 7/8" o.d. tubing or minimum L3.5"x3.5"x1/4" angles.
  3. Horizontal members and footboard supports shall be 3" x 2 7/8" channel or minimum L2.5"xL2.5"x3/16" angles.
  4. Cross braces and diagonals shall be 2 1/4" x 7/8" channel or 2"x2" angle.
  5. Handrail support shall be 2 5/8" o.d. tubing.
  6. The understructure shall be assembled from the above items in an interlocking design and 7/16" x 3 1/2" hot-dipped galvanized bolts.
  7. The structure shall be designed so that in the event of accidental damage, the sub-component parts may be replaced using common hand tools. Field welding for repair purposes shall not be considered.
  8. Primary structural members shall be bolted together, or calculations must be submitted verifying that the structure has taken into account the weakening of aluminum associated with welding per 2005 AA ADMI sections 7.2.1 and 7.2.3
- B. Guardrail Systems:
1. Guardrails shall be of anodized aluminum extruded channel, 3 x 2 7/8", 6061-T6 alloy, anodized to clear 204R1.
  2. The guardrail system shall be of interlocking design with positive through bolt fastening. The top rail shall be designed to fully cover the rail support posts for a totally snag-free area and eliminate the potential of sharp edge contact with the spectators.
  3. Grabrails shall be extruded aluminum pipe of 6063-T6 alloy, 1 – 15/16" o.d.
  4. Chain link fence shall be 2" mesh, 6 gauge vinyl coated fabric
- C. Hand & Grab Rails
1. Hand and Grab Rails shall be located in all areas required by building code.
  2. Hand and Grab Rails shall be 1 15/16" O.D. extruded aluminum pipe.
  3. Two-Line mid-aisle handrails shall be located in all interior aisles. All mid-aisle rails shall feature internal fittings for both lines of rail. External fittings are not permitted.
- D. Extrusions

1. Seats shall be 6063-T6 extruded aluminum with a fluted surface and a wall thickness of .078". Seatboards shall be a minimum of 9½" wide actual, with outside legs of 1 ¾" actual vertical height, and shall have two internal legs with a vertical height of 2 5/8". Seatboards shall attach with one 3/8" diameter bolt and shall be designed for positive physical fastening. Bolt clips, bolt runners or other friction type fastening devices are not acceptable. Seats shall be pre-treated and clear anodized.
  2. Footboards shall be 6063-T6 extruded aluminum with a fluted surface and a wall thickness of .078". Each footboard member (individually) shall have two internal legs with 2 1/8" actual vertical height. All footboards shall attach without the use of hardware. Attachment shall be positive snap and interlock with the support structure. Use of bolt clips, bolt runners, or other friction type fastening devices are not acceptable.
  3. Riserboards shall be 6063-T6 extruded aluminum and shall be pre-treated and powder coated in color selected by architect from manufacturers standard color options.
- E. Walking Surface Requirement  
All aluminum footboards shall have an enhanced stain resistant and slip resistant finish at all locations intended for use as a walking surface.
- a. This finish shall be produced by the bleacher manufacturer in addition to the mill extrusion process and shall be uniform in appearance. The slip and stain resistant surface treatment shall be achieved either with a blasted and anodized process or an applied slip and stain coating. The metallic media blasting option must be performed in a controlled factory environment to ensure consistency. Hand processes or sand blasting is prohibited as they produce an inconsistent finish that is not uniform in appearance or performance.
  - b. This surface finish shall prevent oxidation staining and be resistant to staining from beverage spills and organic matter. Oxidation staining prior to warranty expiration shall be grounds for product replacement at the manufacturer's expense.
  - c. This surface finish shall exhibit enhanced slip resistance beyond the mill extrusion process, resulting in an improved coefficient of friction under wet conditions in all directions of travel.
  - d. Untreated mill finish aluminum with raised extruded "flutes" or "ribs" does not meet this requirement.
- F. Stairs:
- i. Shall conform to all above pertinent criteria consistent with the component design of the grandstand.
  - ii. Shall be self-supporting and shall not attach to or be suspended from any footboard of decking member.
- G. Aisles: Aisles shall be designed so that all vertical and horizontal areas within the 6' bay of the aisles area shall be fully closed.
- H. Ramps and Ramp Platforms:
- i. Frames shall be 9" x 1.40 extruded aluminum mill finish channel with 3" x 1.4" extruded aluminum mill finish vertical channel columns.

- ii. Treads shall be 6063-T6 extruded aluminum with a fluted surface and a minimum wall thickness of .078". Minimum vertical height of treads shall be 1.75" actual. Treads shall be mill finish.
- I. Hardware:
  - i. Bolts used for field installation shall be hot dipped galvanized.
  - ii. Primary connections, i.e. seat, crossbrace, handrail (rail and posts) shall be made with minimum of 3/8" diameter hardware.
  - iii. End Caps – All end caps (seatboard, footboard and handrail) shall be cast aluminum.

### **PART 3 EXECUTION**

#### **3.01 EXAMINATION**

- A. Take field measurements to ensure proper fitting of work. If taking field measurements before fabrication will delay work, allow for adjustments within recommended tolerances.
- B. Inspect areas and conditions before installation. Notify Architect in writing of unsatisfactory or detrimental conditions. Do not proceed until conditions have been corrected. Commencing installation constitutes acceptance of work site conditions.
- C. Verify that electrical services are correctly located and of the proper characteristics.
- D. Examine all existing conditions with installer present for compliance with requirements for installation tolerances and other conditions affecting performance of the work.
- E. Prepare written report, endorsed by installer, listing conditions detrimental to performance of the work.
- F. Proceed with installation only after unsatisfactory conditions have been corrected.


#### **3.02 INSTALLATION**

- A. Install grandstand and all components according to manufacturer's written instruction and the approved shop drawings.
- B. Install equipment rigid, straight, plumb, and level.
- C. Secure all equipment with manufacturer's recommended anchoring devices.
- D. Install all components securely, with fasteners tight
- E. Separate dissimilar metals to prevent electrolytic corrosion

#### **3.03 ADJUSTING, CLEANING AND PROTECTIONI**

- A. Verify proper placement of equipment.
- B. Use cleaning solutions and methods that do not damage the finishes or the adjacent surfaces
- C. Remove all metal burrs, sharp edges or other cutting, unsafe conditions.
- D. Touch up finishes as recommended by manufacturer to the satisfaction of the architect

**END OF SECTION**

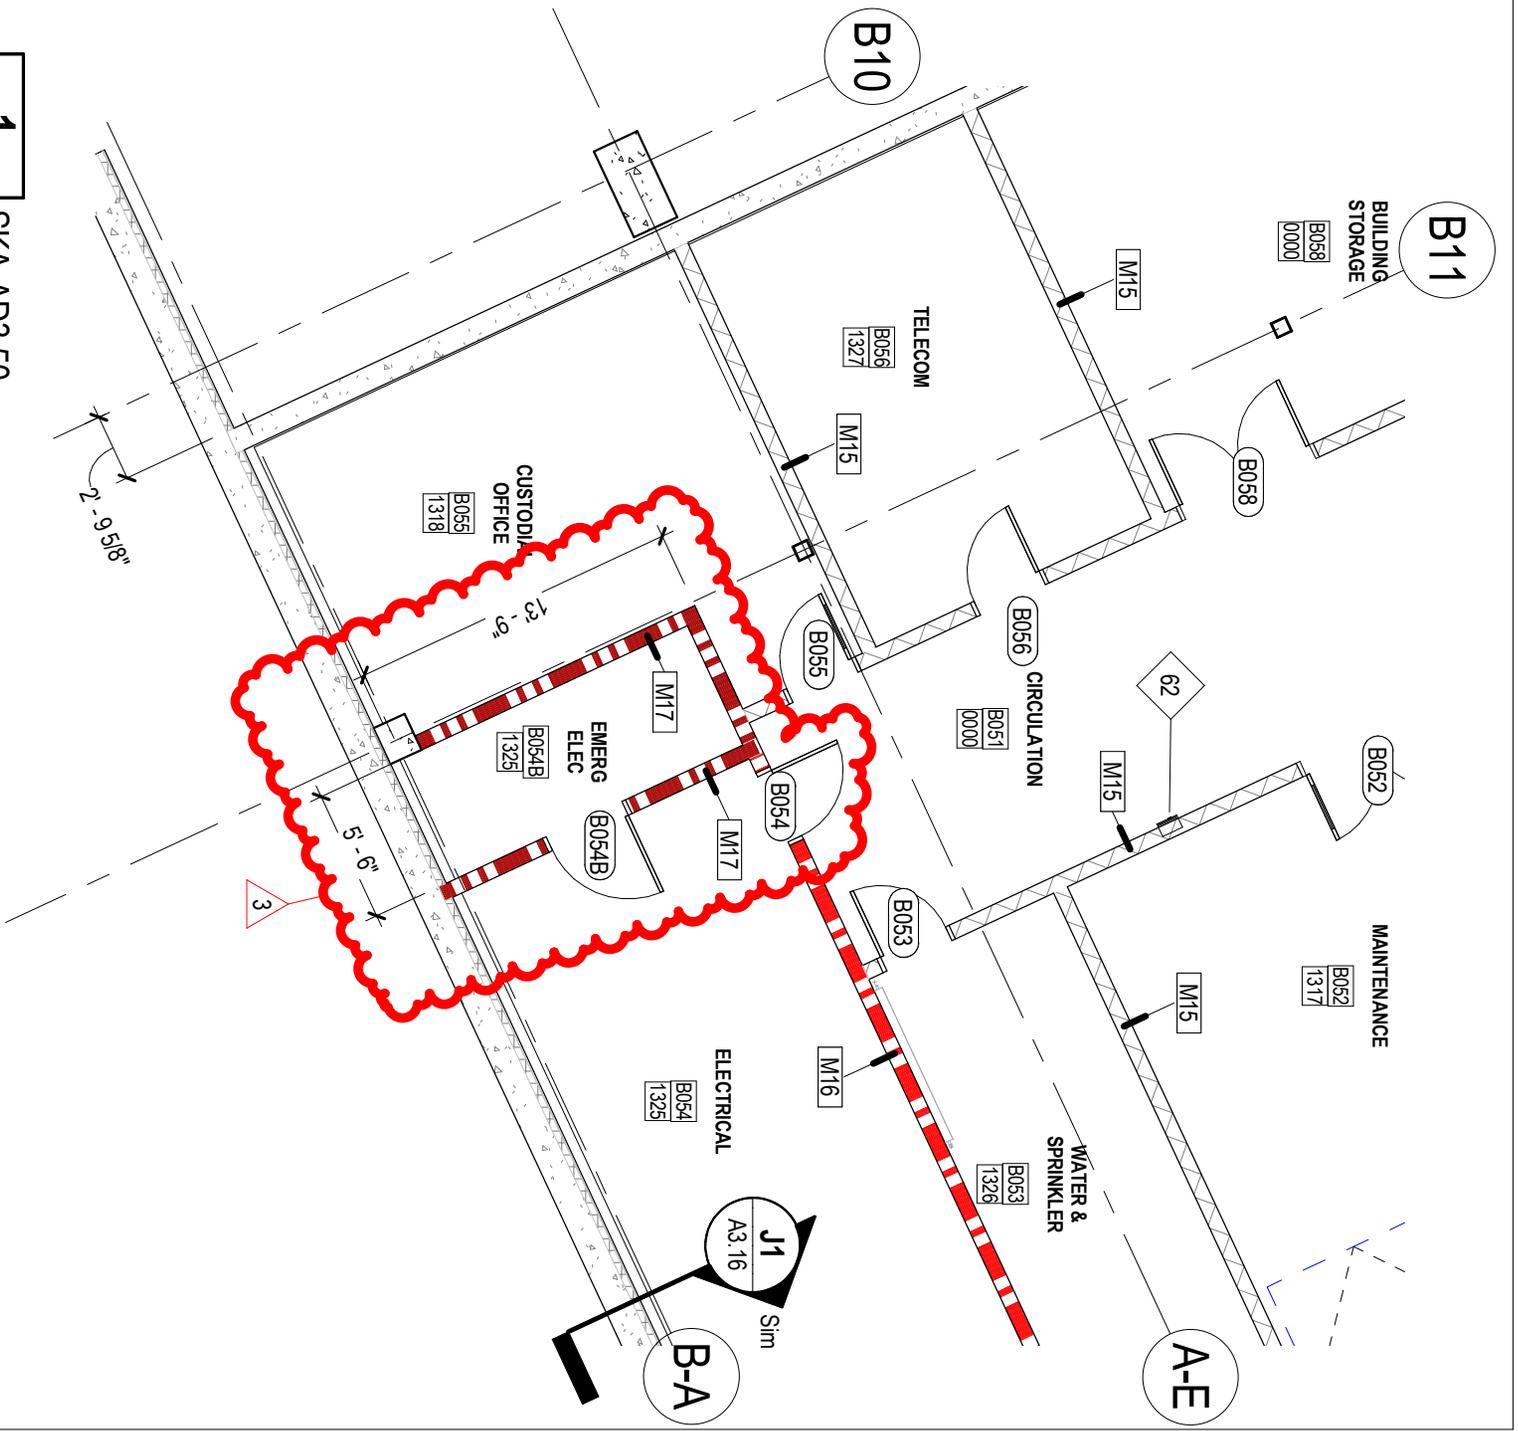

**1** SKA-AD3.50  
 1/8" = 1'-0"

**LAVALLEE BRENSINGER ARCHITECTS**

Boston | Manchester | Portland  
 www.LBPA.com


**REVISED EMERG ELEC ROOM B043B**

PROJECT: Sanford School Department and State of Maine Department of Education  
 SANFORD HIGH SCHOOL and TECHNICAL CENTER

PR NO: 12-067-00 DATE: 03/04/16

SCALE: 1/8" = 1'-0"

**SKA-AD3.50**

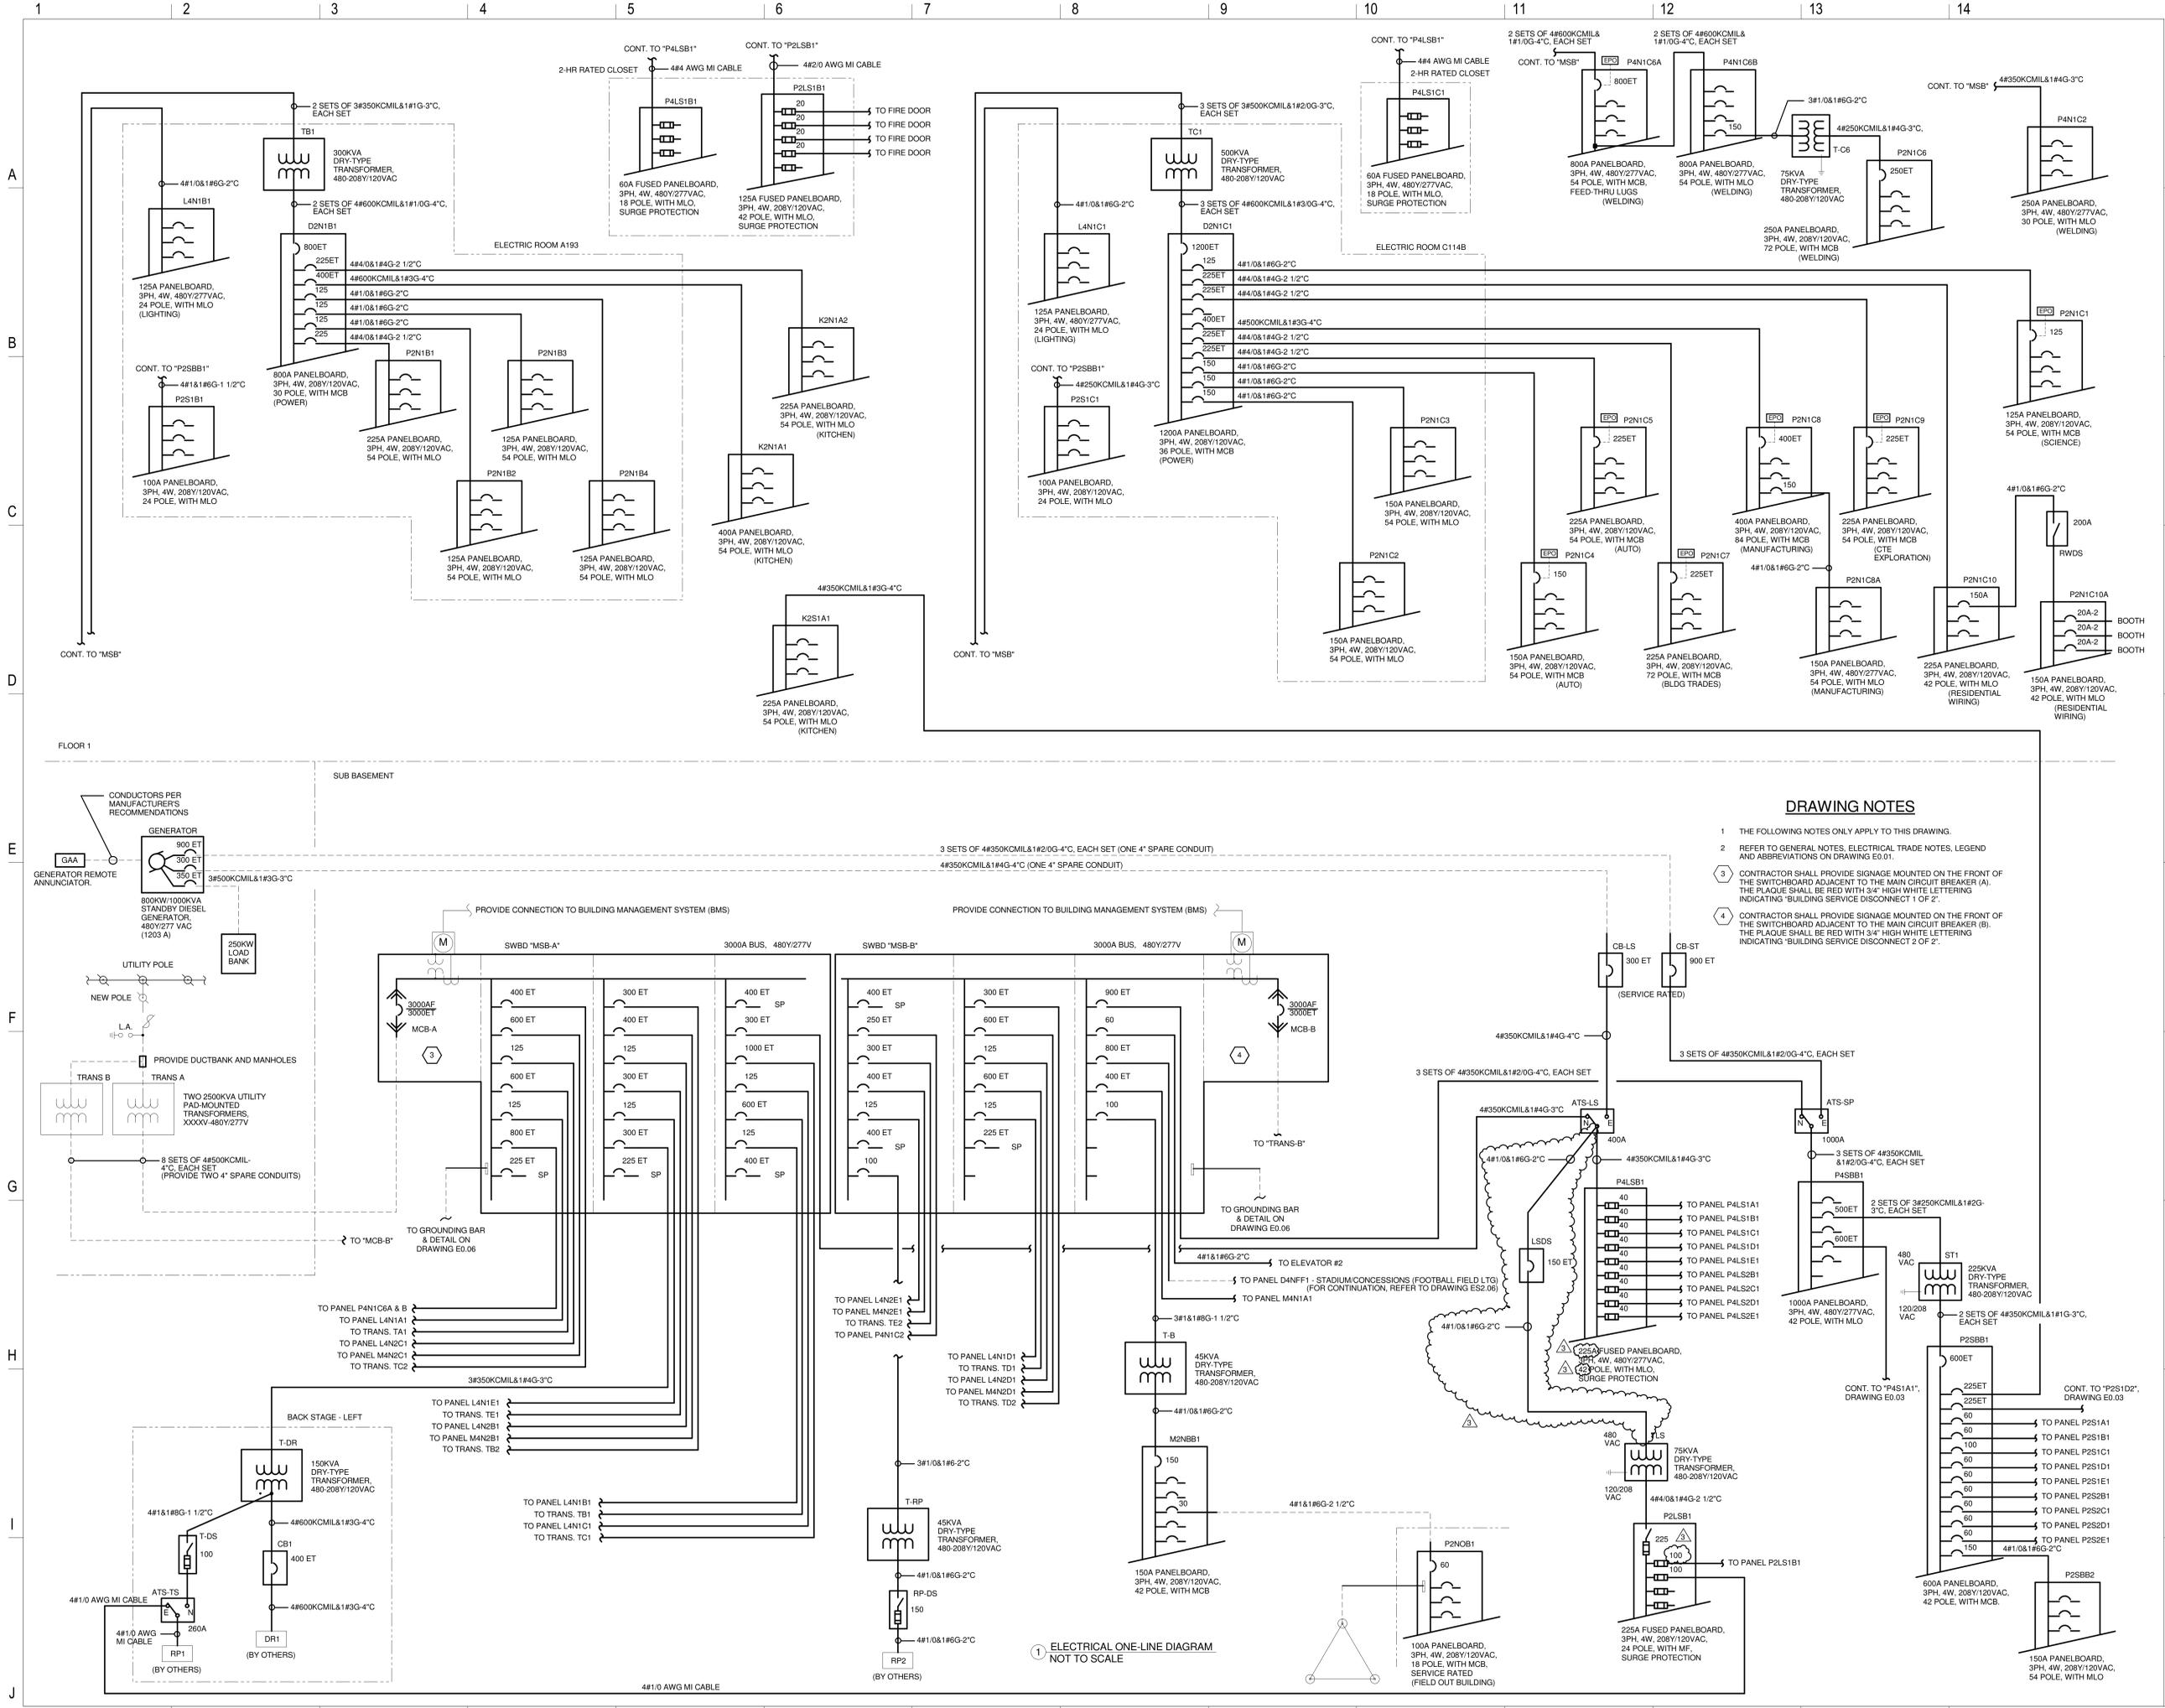


**DRAWING NOTES**

- THE FOLLOWING NOTES ONLY APPLY TO THIS DRAWING.
- REFER TO GENERAL NOTES, ELECTRICAL TRADE NOTES, LEGEND AND ABBREVIATIONS ON DRAWING E0.01.
- CONTRACTOR SHALL PROVIDE SIGNAGE MOUNTED ON THE FRONT OF THE SWITCHBOARD ADJACENT TO THE MAIN CIRCUIT BREAKER (A). THE PLAQUE SHALL BE RED WITH 3/4" HIGH WHITE LETTERING INDICATING BUILDING SERVICE DISCONNECT 1 OF 2.
- CONTRACTOR SHALL PROVIDE SIGNAGE MOUNTED ON THE FRONT OF THE SWITCHBOARD ADJACENT TO THE MAIN CIRCUIT BREAKER (B). THE PLAQUE SHALL BE RED WITH 3/4" HIGH WHITE LETTERING INDICATING BUILDING SERVICE DISCONNECT 2 OF 2.

1 ELECTRICAL ONE-LINE DIAGRAM NOT TO SCALE

**LAVALLEE BRENSINGER ARCHITECTS**  
 Boston | Manchester | Portland  
 155 Dow Street, Suite 400, Manchester, NH 03101  
 603.622.5450  
 305 Commercial Street, Portland, ME 04101  
 207.558.7200  
 www.LBPA.com

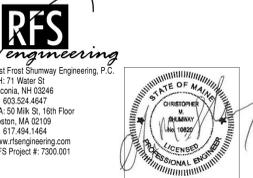

Sanford School Department and State of Maine Department of Education

**SANFORD HIGH SCHOOL and TECHNICAL CENTER**

SANFORD, ME 04073

NO.	DESCRIPTION	DATE
3	ADDENDUM #3	2016-03-04

CONTENT:  
ELECTRICAL ONE-LINE DIAGRAM

DRAWN BY: C. NEWELL

PROJECT NO: 12-067-00

DATE: 02/11/2016

REVISED:

SCALE: AS NOTED

**E0.02**

Project Phase  
BID DOCUMENTS

FOR ADDITIONAL INFORMATION, REFER TO PROJECT MANUAL.

Copyright © 2016 by Lavallee/Brensinger Professional Association. All rights reserved. No reproduction without permission.

DRAWING NOTES

- THE FOLLOWING NOTES ONLY APPLY TO THIS DRAWING.
- REFER TO GENERAL NOTES, ELECTRICAL TRADE NOTES, LEGEND AND ABBREVIATIONS ON DRAWING E0.01.

ELECTRIC EQUIPMENT AND CONTROL SCHEDULE

EQUIPMENT										SUPPLY				POWER WIRING FROM PANEL TO CONTROL UNIT AND FROM CONTROL UNIT TO EQUIPMENT			ACCESSORIES	
ITEM NO.	NAME	ROOM LOC.	AMPS	HP	KW	PHASE	SYSTEM VOLTS	PANEL OR CONTROL CENTER	CIRCUIT BREAKER	PHASE	COND	CONDUIT	REF. NOTES	FUSED DISCONNECT SWITCH	CONTROL DEVICES NOTES			
ACC-3	A/C CONDENSER #3	ROOFTOP - B	16			1	208	D2N2B1	20/2	3#10 AWG	1#10 AWG E.G.	3/4"	A	PROVIDE WP	4			
ACC-4	A/C CONDENSER #4	ROOFTOP - B	16			1	208	D2N2B1	20/2	3#10 AWG	1#10 AWG E.G.	3/4"	A	PROVIDE WP	4			
ACC-5	A/C CONDENSER #5	ROOFTOP - B	16			1	208	D2N2B1	20/2	3#10 AWG	1#10 AWG E.G.	3/4"	A	PROVIDE WP	4			
ACC-6	A/C CONDENSER #6	ROOFTOP - B	23			1	208	D2N2B1	35/2	3#10 AWG	1#10 AWG E.G.	3/4"	A	PROVIDE WP	4			
ACC-7	A/C CONDENSER #7	ROOFTOP - A1	23			1	208	D2N2B1	35/2	3#10 AWG	1#10 AWG E.G.	3/4"	A	PROVIDE WP	4			
ACC-8	A/C CONDENSER #8	ROOFTOP - A1	16			1	208	D2N2B1	20/2	3#10 AWG	1#10 AWG E.G.	3/4"	A	PROVIDE WP	4			
ACC-9	A/C CONDENSER #9	ROOFTOP - E	16			1	208	D2N2E1	20/2	3#10 AWG	1#10 AWG E.G.	3/4"	A	PROVIDE WP	4			
ACC-10	A/C CONDENSER #10	ROOFTOP - A1	16			1	208	D2N2B1	20/2	3#10 AWG	1#10 AWG E.G.	3/4"	A	PROVIDE WP	4			
ACC-11	A/C CONDENSER #11	ROOFTOP - D	16			1	208	D2N2D1	20/2	3#10 AWG	1#10 AWG E.G.	3/4"	A	PROVIDE WP	4			
ACC-12	A/C CONDENSER #12	ROOFTOP - D	16			1	208	D2N2D1	20/2	3#10 AWG	1#10 AWG E.G.	3/4"	A	PROVIDE WP	4			
ACC-13	A/C CONDENSER #13	ROOFTOP - A2	16			1	208	D2N2A1	20/2	3#10 AWG	1#10 AWG E.G.	3/4"	A	PROVIDE WP	4			
ACC-14	A/C CONDENSER #14	ROOFTOP - E	16			1	208	D2N2E1	20/2	3#10 AWG	1#10 AWG E.G.	3/4"	A	PROVIDE WP	4			
ACC-15	A/C CONDENSER #15	ROOFTOP - C1	16			1	208	D2N2C1	20/2	3#10 AWG	1#10 AWG E.G.	3/4"	A	PROVIDE WP	4			
ACC-16	A/C CONDENSER #16	ROOFTOP - A3	16			1	208	D2N2A1	20/2	3#10 AWG	1#10 AWG E.G.	3/4"	A	PROVIDE WP	4			
ACC-17	A/C CONDENSER #17	ROOFTOP - C1	16			1	208	D2N2C1	20/2	3#10 AWG	1#10 AWG E.G.	3/4"	A	PROVIDE WP	4			
ACC-18a	A/C CONDENSER #18a	ROOFTOP - D	16			1	208	D2N2D1	20/2	3#10 AWG	1#10 AWG E.G.	3/4"	A	PROVIDE WP	4			
ACC-18b	A/C CONDENSER #18b	ROOFTOP - D	16			1	208	D2N2D1	20/2	3#10 AWG	1#10 AWG E.G.	3/4"	A	PROVIDE WP	4			
ACC-19	OUTDOOR ACC UNIT #1-1	ROOFTOP - D	21.7			3	480	M4N2D1	30/3	4#10 AWG	1#10 AWG E.G.	3/4"	A	PROVIDE	-			
ACC-20	OUTDOOR ACC UNIT #2-1	ROOFTOP - D	21.7			3	480	M4N2D1	30/3	4#10 AWG	1#10 AWG E.G.	3/4"	A	PROVIDE	-			
ACC-21	OUTDOOR ACC UNIT #3-1	ROOFTOP - A2	16.4			3	480	M4N2B1	20/3	4#10 AWG	1#10 AWG E.G.	3/4"	A	PROVIDE	-			
PUH-1	PROP. UNIT HEATER #1	MECH ROOM B057	120			1	120	P2S1B2	20/1	2#12 AWG	1#12 AWG E.G.	3/4"	-	-	1			
PUH-2	PROP. UNIT HEATER #2	MECH ROOM B057	120			1	120	FED WITH PUH-1	-	2#12 AWG	1#12 AWG E.G.	3/4"	-	-	1			
PUH-3	PROP. UNIT HEATER #3	MAINTENANCE B052	120			1	120	P2S1B2	20/1	2#12 AWG	1#12 AWG E.G.	3/4"	-	-	1			
PUH-4	PROP. UNIT HEATER #4	ELECTRICAL B054	120			1	120	FED WITH PUH-3	-	2#12 AWG	1#12 AWG E.G.	3/4"	-	-	1			
PUH-5	PROP. UNIT HEATER #5	AUTOMOTIVE COLLISION C139	1/3			1	120	P2S1C1	20/1	2#12 AWG	1#12 AWG E.G.	3/4"	-	-	1			
PUH-6	PROP. UNIT HEATER #6	AUTOMOTIVE COLLISION C139	1/3			1	120	P2S1C1	20/1	2#12 AWG	1#12 AWG E.G.	3/4"	-	-	1			
PUH-7	PROP. UNIT HEATER #7	AUTOMOTIVE COLLISION C139	1/3			1	120	P2S1C1	20/1	2#12 AWG	1#12 AWG E.G.	3/4"	-	-	1			
PUH-8	PROP. UNIT HEATER #8	WELDING FABRICATION C138	1/3			1	120	P2S1C1	20/1	2#12 AWG	1#12 AWG E.G.	3/4"	-	-	1			
PUH-9	PROP. UNIT HEATER #9	WELDING FABRICATION C138	1/3			1	120	P2S1C1	20/1	2#12 AWG	1#12 AWG E.G.	3/4"	-	-	1			
PUH-10	PROP. UNIT HEATER #10	WELDING FABRICATION C138	1/3			1	120	P2S1C1	20/1	2#12 AWG	1#12 AWG E.G.	3/4"	-	-	1			
PUH-11	PROP. UNIT HEATER #11	PRECISION MANUFACTURING C134	1/3			1	120	P2S1C1	20/1	2#12 AWG	1#12 AWG E.G.	3/4"	-	-	1			
PUH-12	PROP. UNIT HEATER #12	PRECISION MANUFACTURING C134	1/3			1	120	P2S1C1	20/1	2#12 AWG	1#12 AWG E.G.	3/4"	-	-	1			
PUH-13	PROP. UNIT HEATER #13	PRECISION MANUFACTURING C134	1/3			1	120	P2S1C1	20/1	2#12 AWG	1#12 AWG E.G.	3/4"	-	-	1			
PUH-14	PROP. UNIT HEATER #14	AUTO TECHNOLOGY C133	1/3			1	120	P2S1C1	20/1	2#12 AWG	1#12 AWG E.G.	3/4"	-	-	1			
PUH-15	PROP. UNIT HEATER #15	AUTO TECHNOLOGY C133	1/3			1	120	P2S1C1	20/1	2#12 AWG	1#12 AWG E.G.	3/4"	-	-	1			
PUH-16	PROP. UNIT HEATER #16	AUTO TECHNOLOGY C133	1/3			1	120	P2S1C1	20/1	2#12 AWG	1#12 AWG E.G.	3/4"	-	-	1			
PUH-17	PROP. UNIT HEATER #17	AUTO TECHNOLOGY C133	1/3			1	120	P2S1C1	20/1	2#12 AWG	1#12 AWG E.G.	3/4"	-	-	1			
PUH-18	PROP. UNIT HEATER #18	BUILDING TRADES C127	1/3			1	120	P2S1C1	20/1	2#12 AWG	1#12 AWG E.G.	3/4"	-	-	1			
PUH-19	PROP. UNIT HEATER #19	BUILDING TRADES C127	1/3			1	120	P2S1C1	20/1	2#12 AWG	1#12 AWG E.G.	3/4"	-	-	1			
PUH-20	PROP. UNIT HEATER #20	BUILDING TRADES C127	1/3			1	120	P2S1C1	20/1	2#12 AWG	1#12 AWG E.G.	3/4"	-	-	1			
PUH-21	PROP. UNIT HEATER #21	CTE EXPLORATION STUDIO C117	1/3			1	120	P2S1C1	20/1	2#12 AWG	1#12 AWG E.G.	3/4"	-	-	1			
PUH-22	PROP. UNIT HEATER #22	CTE EXPLORATION STUDIO C117	1/3			1	120	P2S1C1	20/1	2#12 AWG	1#12 AWG E.G.	3/4"	-	-	1			
PUH-23	PROP. UNIT HEATER #23	RESIDENTIAL WIRING C113	120			1	120	P2S1C1	20/1	2#12 AWG	1#12 AWG E.G.	3/4"	-	-	1			
PUH-24	PROP. UNIT HEATER #24	RESIDENTIAL WIRING C113	120			1	120	FED WITH PUH-23	-	2#12 AWG	1#12 AWG E.G.	3/4"	-	-	1			
PUH-25	PROP. UNIT HEATER #25	INCUBATOR C101	1/3			1	120	P2S1C1	20/1	2#12 AWG	1#12 AWG E.G.	3/4"	-	-	1			
PUH-26	PROP. UNIT HEATER #26	INCUBATOR C101	1/3			1	120	P2S1C1	20/1	2#12 AWG	1#12 AWG E.G.	3/4"	-	-	1			
PUH-27	PROP. UNIT HEATER #27	HORTICULTURE D150	1/3			1	120	P2S1D1	20/1	2#12 AWG	1#12 AWG E.G.	3/4"	-	-	1			
PUH-28	PROP. UNIT HEATER #28	HORTICULTURE D150	1/3			1	120	P2S1D1	20/1	2#12 AWG	1#12 AWG E.G.	3/4"	-	-	1			
PUH-29	PROP. UNIT HEATER #29	EMS TRAINING E140A	1/3			1	120	P2S1D1	20/1	2#12 AWG	1#12 AWG E.G.	3/4"	-	-	1			
PUH-30	PROP. UNIT HEATER #30	EMS TRAINING E140A	1/3			1	120	P2S1E1	20/1	2#12 AWG	1#12 AWG E.G.	3/4"	-	-	1			
PUH-31	PROP. UNIT HEATER #31	EMS TRAINING E140A	1/3			1	120	P2S1E1	20/1	2#12 AWG	1#12 AWG E.G.	3/4"	-	-	1			
PUH-32	PROP. UNIT HEATER #32	FIRE DRILL AREA E28	120			1	120	P2S1E1	20/1	2#12 AWG	1#12 AWG E.G.	3/4"	-	-	1			
PUH-33	PROP. UNIT HEATER #33	PROP & GEAR STORAGE E243	120			1	120	FED WITH PUH-32	-	2#12 AWG	1#12 AWG E.G.	3/4"	-	-	1			
PUH-34	PROP. UNIT HEATER #34	TRACTOR INSTRUCTION D156B	120			1	120	P2S1D1	20/1	2#12 AWG	1#12 AWG E.G.	3/4"	-	-	1			
PUH-35	PROP. UNIT HEATER #35	PRE-ENG ROBOTICS C105	120			1	120	P2S1C1	20/1	2#12 AWG	1#12 AWG E.G.	3/4"	-	-	1			
PUH-36	PROP. UNIT HEATER #36	PRE-ENG ROBOTICS C105	120			1	120	FED WITH PUH-35	-	2#12 AWG	1#12 AWG E.G.	3/4"	-	-	1			
PUH-37	PROP. UNIT HEATER #37	STORAGE F102A	120			1	120	P2N1A7	20/1	2#12 AWG	1#12 AWG E.G.	3/4"	-	-	1			
VE-1	VEHICLE EXHAUST UNIT #1	AUTO TECHNOLOGY C133	1/2			1	120	P2N1C4	20/1	2#12 AWG	1#12 AWG E.G.	3/4"	A	PROVIDE	1			
VE-2	VEHICLE EXHAUST UNIT #2	AUTO TECHNOLOGY C133	1/2			1	120	P2N1C4	20/1	2#12 AWG	1#12 AWG E.G.	3/4"	A	PROVIDE	1			
VE-3	VEHICLE EXHAUST UNIT #3	AUTO TECHNOLOGY C133	1/2			1	120	P2N1C4	20/1	2#12 AWG	1#12 AWG E.G.	3/4"	A	PROVIDE	1			
VE-4	VEHICLE EXHAUST UNIT #4	AUTO TECHNOLOGY C133	1/2			1	120	P2N1C4	20/1	2#12 AWG	1#12 AWG E.G.	3/4"	A	PROVIDE	1			
VE-5	VEHICLE EXHAUST UNIT #5	EMS TRAINING E140A	1			1	120	P2N1E3	20/1	2#12 AWG	1#12 AWG E.G.	3/4"	A	PROVIDE	1			
VE-6	VEHICLE EXHAUST UNIT #6	EMS TRAINING E140A	1			1	120	P2N1E3	20/1	2#12 AWG	1#12 AWG E.G.	3/4"	A	PROVIDE	1			
AFF-C127c	AIR FILTER FAN C127c	BUILDING TRADES C127	3/4			1	120	P2N1C7	25/1	2#10 AWG	1#10 AWG E.G.	3/4"	-	-	1			
AFF-C127d	AIR FILTER FAN C127d	BUILDING TRADES C127	3/4			1	120	P2N1C7	25/1	2#10 AWG	1#10 AWG E.G.	3/4"	-	-	1			
AFF-C127e	AIR FILTER FAN C127e	BUILDING TRADES C127	3/4			1	120	P2N1C7	25/1	2#10 AWG	1#10 AWG E.G.	3/4"	-	-	1			
AFF-C127f	AIR FILTER FAN C127f	BUILDING TRADES C127	3/4			1	120	P2N1C7	25/1	2#10 AWG	1#10 AWG E.G.	3/4"	-	-	1			
AFF-C117a	AIR FILTER FAN C117a	CTE EXPLORATION STUDIO C117	3/4			1	120	P2N1C9	25/1	2#10 AWG	1#10 AWG E.G.	3/4"	-	-	1			
AFF-C117b	AIR FILTER FAN C117b	CTE EXPLORATION STUDIO C117	3/4			1	120	P2N1C9	25/1	2#10 AWG	1#10 AWG E.G.	3/4"	-	-	1			
AC1-1	INDOOR FAN COIL UNIT #1-1	COSMETOLOGY INSTRUCTION D132A	30			1	208	P2N1D2	20/2	3#12 AWG	1#12 AWG E.G.	3/4"	A	PROVIDE	-			
AC1-2	INDOOR FAN COIL UNIT #1-2	COSMETOLOGY CLINICAL LAB D132	27			1	208	FED WITH AC1-1	-	3#12 AWG	1#12 AWG E.G.	3/4"	A	PROVIDE	-			
AC1-3	INDOOR FAN COIL UNIT #1-3	COSMETOLOGY CLINICAL LAB D132	27			1	208	FED WITH AC1-1	-	3#12 AWG	1#12 AWG E.G.	3/4"	A	PROVIDE	-			
AC1-4	INDOOR FAN COIL UNIT #1-4	BUSINESS/BANK D130	19			1	208	FED WITH AC1-1	-	3#12 AWG	1#12 AWG E.G.	3/4"	A	PROVIDE	-			
AC1-5	INDOOR FAN COIL UNIT #1-5	BUSINESS/BANK D130	19			1	208	FED WITH AC1-1	-	3#12 AWG	1#12 AWG E.G.	3/4"	A	PROVIDE	-			
AC1-6	INDOOR FAN COIL UNIT #1-6	BUSINESS D128	27			1	208	FED WITH AC1-1	-	3#12 AWG	1#12 AWG E.G.	3/4"	A	PROVIDE	-			
AC1-7	INDOOR FAN COIL UNIT #1-7	BUSINESS D128	27			1	208	FED WITH AC1-1	-	3#12 AWG	1#12 AWG E.G.	3/4"	A	PROVIDE	-			
AC2-1	INDOOR FAN COIL UNIT #2-1	CONFERENCE/INSTRUCTION D249	30			1	208	P2N2										

DRAWING NOTES

- THE FOLLOWING NOTES ONLY APPLY TO THIS DRAWING.
- REFER TO GENERAL NOTES, ELECTRICAL TRADE NOTES, LEGEND AND ABBREVIATIONS ON DRAWING E0.01.

**LAVALLEE BRENSINGER ARCHITECTS**  
 Boston | Manchester | Portland  
 155 Dow Street, Suite 400, Manchester, NH 03101  
 603.622.5450  
 305 Commercial Street, Portland, ME 04101  
 207.558.7200  
 www.LBPA.com

**RFS Engineering**  
 Riel Frost Shumway Engineering, P.C.  
 71 Water St.  
 Lacrosse, WI 54601  
 P. 603.224.4547  
 M. 509.331.1888  
 F. 608.785.1888  
 www.rfsengineering.com  
 RFS Project #: 7300.001

Sanford School Department and State of Maine Department of Education

**SANFORD HIGH SCHOOL and TECHNICAL CENTER**

SANFORD, ME 04073

NO.	DESCRIPTION	DATE
3	ADDENDUM #3	2016-03-04

CONTENT: PANELBOARD SCHEDULES

DRAWN BY: C. NEWELL

PROJECT NO: 12-067-00

DATE: 02/11/2016

REVISION:

SCALE: NO SCALE

**E0.07**

Project Phase  
**BID DOCUMENTS**  
 COPYRIGHT © 2016 BY LAVALLEE/BRENSINGER PROFESSIONAL ASSOCIATION. ALL RIGHTS RESERVED. NO REPRODUCTION WITHOUT PERMISSION.

PANELBOARD: P4S1A1											
BUS SIZE: 600 AMPS			MAIN: MLO			NEUTRAL: 100%			ELECTRONIC TRIP		
VOLTAGE: 480 Y/277V 3PH,4W			LOCATION: ELEC B054			MOUNTING: SURFACE			TVSS: NO		
SERVICE RATED: NO			ISOLATED GND BUS: NO			SHORT CIR. CURRENT RATING: 18000 AMPS			ELEC F111D		
DIRECTORY	WATTS OF LOAD			CKT BKR AMPS	POLES	CKT BKR AMPS	WATTS OF LOAD			DIRECTORY	
	L1	L2	L3				L1	L2	L3		
UNIT DHU-12	30817	30817	30817	125	1 2	150	35605	35605	35605	UNIT AHU-1	
UNIT AHU-3	35605	35605	35605	150	3 4	90	20785	20785	20785	UNIT AHU-4	
UNIT AHU-6	26305	26305	26305	110	13 14	20	443	443	443	CIRC PUMP CP-1	
CIRC PUMP CP-3	443	443	443	20	15 16	50				SPARE	
SPARE				20	17 18					SPARE	
LTG - GYM F122	2002			20	19 20	2990				LTG - GYM F102	
LTG - GYM F122		2772		20	21 22	3680				LTG - GYM F102	
SPARE				20	23 24	4036				LTG - CIRCULATION F119	
SPARE				20	25 26					SPARE	
SPARE				20	27 28					SPARE	
SPARE				20	29 30					SPARE	
SPARE				20	31 32					SPARE	
SPARE				20	33 34					SPARE	
SPARE				20	35 36					SPARE	
SPARE				20	37 38					SPARE	
SPARE				20	39 40					SPARE	
SPARE				20	41 42					SPARE	
NOTES:	SUBTOTAL			95172	95942	93170					
							TOTAL WATTS L1:	32663	60513	60869	SUBTOTAL
							TOTAL WATTS L2:	15495			
							TOTAL WATTS L3:	15409			
							TOTAL WATTS:	46581			
							TOTAL AMPS @ 100%:	161	306	306	
							TOTAL AMPS @ 125%:	127	230	230	
							TOTAL PANEL RECPT LOAD =	0	0	0	WATTS
C.B. TYPE			G-GFCI			H-HACR C.B.			AF-AFRC FAULT		
S-SHUNT TRIP			L-LOCK ON C.B.			AF-AFRC FAULT					

SWITCHBOARD: MSB-B											
BUS SIZE: 3000 AMPS			MAIN: 3000 AMP MCB			NEUTRAL: 100%			ELECTRONIC TRIP		
VOLTAGE: 480 Y/277V 3PH,4W			LOCATION: ELEC B054			MOUNTING: FLOOR			TVSS: YES		
SERVICE RATED: YES			ISOLATED GND BUS: NO			SHORT CIR. CURRENT RATING: 65000 AMPS					
DIRECTORY	WATTS OF LOAD			CKT BKR AMPS	POLES	CKT BKR AMPS	WATTS OF LOAD			DIRECTORY	
	L1	L2	L3				L1	L2	L3		
PANEL M4N2E1	70225	70225	70225	400ET	1 2	148996	148996	148996		PANEL M4N2D1	
PANEL D4NFF1 FOOTBALL FIELD LIGHTING & STADIUM, ETC.	50563	48888	50278	800ET	3 4	300ET	41228	39344			
PANEL D2N1D1 VIA TRANS TD1	110236	103507	104830	600ET	13 14	250ET	59028	59028		PANEL P4N1C2	
PANEL M4N1A1	95756	95756	95756	400ET	15 16	125	23870			PANEL L4N1D1	
PANEL P4SBB1 VIA ATS-SP	292651	241312	235128	900ET	17 18	125	7702	14309		PANEL L4N2D1	
PANEL D2N2E1 VIA TRANS TC2	27081	26123	26708	300ET	19 20	125	3961	5226		PANEL L4N2E1	
PANEL M2NBB1 VIA TRANS T-B	2444	2328	2520	300ET	21 22	100	14410	14410		PANEL L4N2E1	
ELEVATOR #2	9422	9422	9422	60	23 24	400ET				SPARE	
SPARE				400ET	25 26	225ET				SPARE	
NOTES:	SUBTOTAL			618378	597561	594867					
							TOTAL WATTS L1:	302306	289588	284779	SUBTOTAL
							TOTAL WATTS L2:	92084			
							TOTAL WATTS L3:	87346			
							TOTAL WATTS:	482736			
							TOTAL AMPS @ 100%:	1612	1526	1526	
							TOTAL AMPS @ 125%:	1289	1181	1181	
							TOTAL PANEL RECPT LOAD =	0	0	0	WATTS
C.B. TYPE			G-GFCI			H-HACR C.B.			AF-AFRC FAULT		
S-SHUNT TRIP			L-LOCK ON C.B.			AF-AFRC FAULT					

SWITCHBOARD: MSB-A											
BUS SIZE: 3000 AMPS			MAIN: 3000 AMP MCB			NEUTRAL: 100%			ELECTRONIC TRIP		
VOLTAGE: 480 Y/277V 3PH,4W			LOCATION: ELEC B054			MOUNTING: FLOOR			TVSS: YES		
SERVICE RATED: YES			ISOLATED GND BUS: NO			SHORT CIR. CURRENT RATING: 65000 AMPS					
DIRECTORY	WATTS OF LOAD			CKT BKR AMPS	POLES	CKT BKR AMPS	WATTS OF LOAD			DIRECTORY	
	L1	L2	L3				L1	L2	L3		
PANEL L4N1E1	11587	4679	2714	125	1 2	88672	80744	82148		PANEL D2N1B1 VIA TRANS TB1	
PANEL M4N2C1	121882	121882	121882	600ET	3 4	1000ET	145879	140857	133255	PANEL D2N1C1 VIA TRANS TC1	
PANEL M4N2B1	87606	87606	87606	400ET	5 6	125	9857	12825	1544	PANEL L4N2B1	
PANEL P4N1C6A & B	160290	159034	157802	800ET	7 8	96959	95573	85468		PANEL D2N1A1 VIA TRANS TA1	
PANEL D2N1E1 VIA TRANS TE1	38414	30757	26269	300ET	9 10	300ET	25000	25000		DIMMER RACK DR1 VIA TRANS T-DR	
PANEL D2N2C1 VIA TRANS TC2	38700	24770	26828	400ET	11 12	300ET	51914	58090	35108	PANEL D2N2B1 VIA TRANS TB2	
PANEL L4N1C1	14414	12850	5103	125	13 14	2911	4077	3003		PANEL L4N2C1	
PANEL P4SBB1 AND PANEL P2LSB1 VIA ATS-LS	89258	59647	50843	300ET	15 16	125	3410	6166	3262	PANEL L4N1B1	
SPARE				400ET	17 18	125	15690	15523	9090	PANEL L4N1A1	
SPARE				225ET	19 20	400ET				SPARE	
SPARE				225ET	21 22	250				SPACE	
NOTES:	SUBTOTAL			541091	501225	478847					
							TOTAL WATTS L1:	961383			
							TOTAL WATTS L2:	640000			
							TOTAL WATTS L3:	656746			
							TOTAL WATTS:	2778229			
							TOTAL AMPS @ 100%:	3346	3146	3146	
							TOTAL AMPS @ 125%:	2677	2517	2517	
							TOTAL PANEL RECPT LOAD =	0	0	0	WATTS
C.B. TYPE			G-GFCI			H-HACR C.B.			AF-AFRC FAULT		
S-SHUNT TRIP			L-LOCK ON C.B.			AF-AFRC FAULT					

PANELBOARD: K2S1A1											
BUS SIZE: 225 AMPS			MAIN: MLO			NEUTRAL: 100%			ELECTRONIC TRIP		
VOLTAGE: 208 Y/120V 3PH,4W			LOCATION: CORRIDOR C104			MOUNTING: SURFACE			TVSS: NO		
SERVICE RATED: NO			ISOLATED GND BUS: NO			SHORT CIR. CURRENT RATING: 22000 AMPS					
DIRECTORY	WATTS OF LOAD			CKT BKR AMPS	POLES	CKT BKR AMPS	WATTS OF LOAD			DIRECTORY	
	L1	L2	L3				L1	L2	L3		
COOLER CONDENSING UNIT #14A	709	709	709	20	1 2	1729	1729	1729		FREEZER COND. UNIT #14C	
COOLER CONDENSING UNIT #14A	709	709	709	20	3 4	1729	1729	1729		FREEZER COND. UNIT #14C	
SPARE				20	5 6	1238	1238	1238		FREEZER EVAP COIL #14D	
SPARE				20	7 8	1238	1238	1238		FREEZER EVAP COIL #14D	
REFRIGERATED GRAB-N-GO #82	1225	1225	1225	20	9 10	1238	1238	1238		FREEZER EVAP COIL #14D	
REFRIGERATED GRAB-N-GO #82	1225	1225	1225	20	11 12	1300	1500	1500		WALK-IN COOLER LIGHTS #12	
COOLER EVAP COIL #14B	240	240	240	20G	13 14	1500	1500	1500		WALK-IN FREEZER LIGHTS #13A	
COOLER EVAP COIL #14B	240	240	240	20G	15 16	1500	1500	1500		WALK-IN FREEZER TRACE #13B	
VENT CONTROL SYSTEM #42	1500	1500	1500	20G	17 18	1032	984	984		PASS THRU REFRIGERATOR #56	
FIRE SUPPRESSION SYSTEM #43	1500	1500	1500	20G	19 20	984	1200	1200		CASHIER TERMINAL #85	
REFRIGERATED GRAB-N-GO #65	840	840	840	20G	21 22	1200	1200	1200		CASHIER TERMINAL #85	
REFRIGERATED GRAB-N-GO #65	840	840	840	20G	23 24	1200	1200	1200		CASHIER TERMINAL #85	
SPARE				20G	25 26	1200	1200	1200		CASHIER TERMINAL #85	
SPARE				20G	27 28	1200	1200	1200		CASHIER TERMINAL #85	
SPARE				20G	29 30	1200	1200	1200		CASHIER TERMINAL #85	
SPARE				20G	31 32	1200	1200	1200		CASHIER TERMINAL #85	
SPARE				20G	33 34	1200	1200	1200		CASHIER TERMINAL #85	
SPARE				20G	35 36	1200	1200	1200		CASHIER TERMINAL #85	
SPARE				20G	37 38	1200	1200	1200		CASHIER TERMINAL #85	
SPARE				20G	39 40	1200	1200	1200		CASHIER TERMINAL #85	
SPARE				20G	41 42	1200	1200	1200		CASHIER TERMINAL #85	
NOTES:	SUBTOTAL			6208	4383	3723					
							TOTAL WATTS L1:	15674	8380	8596	SUBTOTAL
							TOTAL WATTS L2:	12763			
							TOTAL WATTS L3:	12319			
							TOTAL WATTS:	40756			
							TOTAL AMPS @ 100%:	113	113	113	
							TOTAL AMPS @ 125%:	90	90	90	
							TOTAL PANEL RECPT LOAD =	0	0	0	WATTS
C.B. TYPE			G-GFCI			H-HACR C.B.			AF-AFRC FAULT		
S-SHUNT TRIP			L-LOCK ON C.B.			AF-AFRC FAULT					

PANELBOARD: P2SBB1											
BUS SIZE: 225 AMPS			MAIN: 225 AMP MCB			NEUTRAL: 100%			ELECTRONIC TRIP		
VOLTAGE: 208 Y/120V 3PH,4W			LOCATION: ELEC B054			MOUNTING: SURFACE			TVSS: NO		
SERVICE RATED: NO			ISOLATED GND BUS: NO			SHORT CIR. CURRENT RATING: 22000 AMPS					
DIRECTORY	WATTS OF LOAD			CKT BKR AMPS	POLES	CKT BKR AMPS	WATTS OF LOAD			DIRECTORY	
	L1	L2	L3				L1	L2	L3		
PANEL K2S1A1 (KITCHEN)	15674	12763	12319	225ET	1 2	13926	11870	12346		PANEL P2S1D2 (CULINARY)	
PANEL P2S1A1	8108	5456	6972	60	3 4	60	3180	1720		PANEL P2S1B1	
PANEL P2S1C1	8928	7368	6804	100	5 6	60	3140	3840		PANEL P2S1B1	
PANEL P2S1E1											

**DRAWING NOTES**

- THE FOLLOWING NOTES ONLY APPLY TO THIS DRAWING.
- REFER TO GENERAL NOTES, ELECTRICAL TRADE NOTES, LEGEND AND ABBREVIATIONS ON DRAWING E0.01.

**LAVALLEE BRENSINGER ARCHITECTS**  
 Boston | Manchester | Portland  
 155 Dow Street, Suite 400, Manchester, NH 03101  
 603.622.5450  
 305 Commercial Street, Portland, ME 04101  
 207.558.7200  
 www.LBPA.com

**RFS Engineering**  
 Riel Frost Shumway Engineering, P.C.  
 NH: 71 Water St.  
 Laconia, NH 03246  
 P: 603.224.4547  
 MA: 50 Main St. 16th Floor  
 Boston, MA 02109  
 P: 617.494.1464  
 www.rfsengineering.com  
 RFS Project #: 7300.001

Sanford School Department and State of Maine Department of Education

**SANFORD HIGH SCHOOL and TECHNICAL CENTER**

SANFORD, ME 04073

NO.	DESCRIPTION	DATE
3	ADDENDUM #3	2016-03-04

CONTENT: PANELBOARD SCHEDULES

DRAWN BY: C. NEWELL

PROJECT NO: 12-067-00

DATE: 02/11/2016

REVISED:

SCALE: NO SCALE

**E0.08**

Project Documents  
 COPYRIGHT © 2016 BY LAVALLEE/BRENSINGER PROFESSIONAL ASSOCIATION. ALL RIGHTS RESERVED. NO REPRODUCTION WITHOUT PERMISSION.

**PANELBOARD: M2NB1**  
 BUS SIZE: 150 AMPS MAIN: 150 AMP MCB  
 VOLTAGE: 208 Y120V 3PH 4W NEUTRAL: 100%  
 SERVICE RATED: NO LOCATION: WELDING STORAGE C138  
 ISOLATED GND BUS: NO MOUNTING: SURFACE  
 SHORT CIR. CURRENT RATING: 22000 AMPS TVSS: NO

DIRECTORY	WATTS OF LOAD			CKT BKR AMPS	POLES	CKT BKR AMPS	WATTS OF LOAD			DIRECTORY
	L1	L2	L3				L1	L2	L3	
METAL SPINNING LATHE - C138	1400	1400	1400	20	1 2	20	1400	1400	1400	METAL SAW - C138
SPARE				20	3 4	20				HYDRAUL METAL WORKER - C138
SPARE				20	5 6	20				
SPARE				20	7 8	20				
SPARE				20	9 10	20				
SPARE				20	11 12	20				
DROP CORD - WELDING FAB C138	360			20G	13 14	20	1248		1248	
DROP CORD - WELDING FAB C138	360			20G	15 16	20				
DROP CORD - WELDING FAB C138	360			20G	17 18	20				
DROP CORD - WELDING FAB C138	360			20G	19 20	20				
DROP CORD - WELDING FAB C138	360			20G	21 22	20				
DROP CORD - WELDING FAB C138	360			20G	23 24	20				
PED. GRINDER BUS DROP C138	1000			20	25 26	20	540		540	RECEP - LOCKERS C138B
PED. GRINDER BUS DROP C138	1000			20	27 28	20	900		900	RECEP - WELDING FAB C138
IBW RECEP - CLASSROOM C138A	300			20	29 30	20	1000		1000	BAND SAW BUS DROP C138
RECEP - CLASSROOM C138A	720			20	31 32	20	600		600	WELDING BOOTH RECEP - C138
RECEP - CLASSROOM C138A	720			20	33 34	20	600		600	WELDING BOOTH RECEP - C138
RECEP - WELD. STORAGE C138D	900			20	35 36	20	600		600	WELDING BOOTH RECEP - C138
WELDING BOOTH RECEP - C138	600			20	37 38	20	600		600	WELDING BOOTH RECEP - C138
WELDING BOOTH RECEP - C138	600			20	39 40	20	600		600	WELDING BOOTH RECEP - C138
WELDING BOOTH RECEP - C138	600			20	41 42	20	600		600	WELDING BOOTH RECEP - C138
WELDING BOOTH RECEP - C138	600			20	43 44	20	600		600	WELDING BOOTH RECEP - C138
WELDING BOOTH RECEP - C138	600			20	45 46	20	600		600	WELDING BOOTH RECEP - C138
WELDING BOOTH RECEP - C138	600			20	47 48	20	600		600	WELDING BOOTH RECEP - C138
WELDING BOOTH RECEP - C138	600			20	49 50	20	600		600	WELDING BOOTH RECEP - C138
WELDING BOOTH RECEP - C138	600			20	51 52	20	600		600	WELDING BOOTH RECEP - C138
WELDING BOOTH RECEP - C138	600			20	53 54	20	600		600	WELDING BOOTH RECEP - C138
RECEP - OFFICE C138	720			20	55 56	20	1000		1000	DISC SANDER BUS DROP C138
DUST COLLECTION FIRE PANEL	300			20	57 58	20	864		864	OVERHEAD DOOR C138
HEAT TRACE - OFFICE C138	400			20	59 60	20	1000		1000	DRILL PRESS BUS DROP C138
SPARE				20	61 62	20				DRILL PRESS BUS DROP C138
SPARE				20	63 64	20				
SPARE				20	65 66	20				
SPARE				20	67 68	20				
SPARE				20	257 258	20				
SPARE				20	259 2					

DRAWING NOTES

- THE FOLLOWING NOTES ONLY APPLY TO THIS DRAWING.
- REFER TO GENERAL NOTES, ELECTRICAL TRADE NOTES, LEGEND AND ABBREVIATIONS ON DRAWING E0.01.

**LAVALLEE BRENSINGER ARCHITECTS**  
 Boston | Manchester | Portland  
 155 Dow Street, Suite 400, Manchester, NH 03101  
 603.622.5450  
 305 Commercial Street, Portland, ME 04101  
 207.558.7200  
 www.LBPA.com

**RFS Engineering**  
 Riel Frost Shumway Engineering, P.C.  
 NH: 71 Water St.  
 Laconia, NH 03246  
 P: 603.524.4547  
 MA: 50 Main St. 16th Floor  
 Boston, MA 02109  
 P: 617.494.1464  
 www.rfsengineering.com  
 RFS Project #: 73001.01

Sanford School Department and State of Maine Department of Education

**SANFORD HIGH SCHOOL and TECHNICAL CENTER**

SANFORD, ME 04073

NO.	DESCRIPTION	DATE
3	ADDENDUM #3	2016-03-04

**PANELBOARD SCHEDULES**

DRAWN BY: C. NEWELL  
 PROJECT NO: 12-067-00  
 DATE: 02/11/2016

REVISIONS:  
 SCALE: NO SCALE

**E0.13**

Project Phase: **BID DOCUMENTS**  
 COPYRIGHT © 2016 BY LAVALLEE/BRENSINGER PROFESSIONAL ASSOCIATION. ALL RIGHTS RESERVED. NO REPRODUCTION WITHOUT PERMISSION.

**PANELBOARD: D2N2B1**  
 BUS SIZE: 400 AMPS  
 VOLTAGE: 208 Y/120V 3PH-4W  
 SERVICE RATED: NO  
 ISOLATED GND BUS: NO  
 SHORT CIR. CURRENT RATING: 22000 AMPS

MAIN: 400 AMP MCB  
 NEUTRAL: 100%  
 LOCATION: ELEC B228A  
 MOUNTING: SURFACE  
 TVSS: NO

DIRECTORY	WATTS OF LOAD			CKT BKR AMPS	POLES	CKT BKR AMPS	WATTS OF LOAD			DIRECTORY
	L1	L2	L3				L1	L2	L3	
PANEL P2N2B1	8400	9540	6000	125	1 2 20	150ET	16990	18770	8460	PANEL P2N2B2
PANEL P2N2B3	8940	12960	9660	125	9 10 22SET		3960	2620	2160	PANEL P2N2B4
SPARE				50	15 16 20					SPARE
UNIT ACC-6	2392	2392		35	19 20 20		2392	2392		UNIT ACC-7
UNIT ACC-3		1664	1664	20	23 24 20			1664	1664	UNIT ACC-4
UNIT ACC-5	1664	1664	1664	20	25 26 20		1664	1664	1664	UNIT ACC-8
UNIT ACC-10	1664	1664		20	29 30 20			1664	1664	UNIT ACC-16
SPARE				20	35 36 20					SPARE
FAN EF-A193		528		20	37 38 20		528			FAN EF-A174
FAN REF-7		1176		20	41 42 20		696			FAN REF-8
FAN EF-B149		1656		25	43 44 20		528			FAN EF-C104C
FAN DEF-1		1176		20	45 46 20		528			FAN EF-B228A
SPARE				20	47 48 20					SPARE
SPARE				20	49 50 20					SPARE
SPARE				20	51 52 20					SPARE
SPARE				20	53 54 20					SPARE
SUBTOTAL	24716	29924	20164				27198	28168	14944	SUBTOTAL

NOTES:  
 TOTAL WATTS L1: 51914  
 TOTAL WATTS L2: 56600  
 TOTAL WATTS L3: 34908  
 TOTAL WATTS: 144812  
 TOTAL AMPS @ 100%: 402 AMPS  
 TOTAL AMPS @ 125%: 503 AMPS

C.B. TYPE: G-GFCI  
 L-LOCK ON C.B. H-HACR C.B.  
 AF-ARC FAULT  
 TOTAL PANEL RECEPT LOAD = 0 WATTS

**PANELBOARD: P2N2B1**  
 BUS SIZE: 125 AMPS  
 VOLTAGE: 208 Y/120V 3PH-4W  
 SERVICE RATED: NO  
 ISOLATED GND BUS: NO  
 SHORT CIR. CURRENT RATING: 22000 AMPS

MAIN: MLO  
 NEUTRAL: 100%  
 LOCATION: ELEC B228A  
 MOUNTING: SURFACE  
 TVSS: NO

DIRECTORY	WATTS OF LOAD			CKT BKR AMPS	POLES	CKT BKR AMPS	WATTS OF LOAD			DIRECTORY
	L1	L2	L3				L1	L2	L3	
IWB RECEPT - LEARNING CTR A224	300			20	1 2 20		540			RECEPT - LEARNING CTR A224
RECEPT - LEARNING CTR A224		720		20	3 4 20		360	360		RECEPT - LEARNING CTR A224
RECEPT DESK - LEARNING A224		360		20	5 6 20			360	360	RECEPT DESK - LEARNING A224
RECEPT DESK - LEARNING A224	360			20	7 8 20		540			RECEPT DESK - LEARNING A224
RECEPT DESK - LEARNING A224		540		20	9 10 20			540		RECEPT DESK - LEARNING A224
RECEPT DESK - LEARNING A224		11 12 20		20	11 12 20			540	540	RECEPT DESK - LEARNING A224
IWB RECEPT - FACULTY TRAIN A228	300			20	13 14 20		720			RECEPT - FACULTY TRAIN A228
RECEPT - FACULTY TRAIN A228		540		20	15 16 20		360			RECEPT - FACULTY TRAIN A228
RECEPT DESK - FACULTY A228		360		20	17 18 20			360	360	RECEPT DESK - FACULTY A228
RECEPT DESK - FACULTY A228	540			20	19 20 20		540			RECEPT DESK - FACULTY A228
RECEPT DESK - FACULTY A228		540		20	21 22 20		1440			RECEPT - LIGHT LOCK A260
RECEPT - ACAD SUPPORT A244		540		20	23 24 20			540	540	RECEPT - ACAD SUPPORT A244
RECEPT - ACAD SUPPORT A244	360			20	25 26 20		720			RECEPT - SPECIAL ED A260A
COPPER - SPECIAL ED A260A		1500		20	27 28 20		300			LL CONF B204
IWB RECEPT - RESOURCE RM A242	300			20	29 30 20		540			RECEPT - RESOURCE RM A242
RECEPT - RESOURCE RM A242	540			20	31 32 20		720			RECEPT - RESOURCE RM A242
RECEPT - SPECIAL ED A260		720		20	33 34 20		360			QUAD RECEPT - SPECIAL ED A260
QUAD RECEPT - SPECIAL ED A260		360		20	35 36 20		360	360		QUAD RECEPT - SPECIAL ED A260
IWB RECEPT - RESOURCE RM A243	300			20	37 38 20		540			RECEPT - RESOURCE RM A243
RECEPT - RESOURCE RM A243	540			20	39 40 20		540			RECEPT - RESOURCE RM A243
IWB RECEPT - RESOURCE RM A241	300			20	41 42 20		540			RECEPT - RESOURCE RM A241
RECEPT - RESOURCE RM A241	540			20	43 44 20		840			FAN EF-B215C & EF-A252
RECEPT - RESOURCE RM A241		540		20	45 46 20					SPARE
SPARE				20	47 48 20					SPARE
SPARE				20	49 50 20					SPARE
SPARE				20	51 52 20					SPARE
SPARE				20	53 54 20					SPARE
SUBTOTAL	3240	5640	2760				5160	3900	3240	SUBTOTAL

NOTES:  
 TOTAL WATTS L1: 8400  
 TOTAL WATTS L2: 9600  
 TOTAL WATTS L3: 6000  
 TOTAL WATTS: 23940  
 TOTAL AMPS @ 100%: 67 AMPS  
 TOTAL AMPS @ 125%: 83 AMPS

C.B. TYPE: G-GFCI  
 L-LOCK ON C.B. H-HACR C.B.  
 AF-ARC FAULT  
 TOTAL PANEL RECEPT LOAD = 18600 WATTS

**PANELBOARD: P2N2B2**  
 BUS SIZE: 150 AMPS  
 VOLTAGE: 208 Y/120V 3PH-4W  
 SERVICE RATED: NO  
 ISOLATED GND BUS: NO  
 SHORT CIR. CURRENT RATING: 22000 AMPS

MAIN: MLO  
 NEUTRAL: 100%  
 LOCATION: ELEC B228A  
 MOUNTING: SURFACE  
 TVSS: NO

DIRECTORY	WATTS OF LOAD			CKT BKR AMPS	POLES	CKT BKR AMPS	WATTS OF LOAD			DIRECTORY
	L1	L2	L3				L1	L2	L3	
RANGE RECEPT - KITCHENETTE B215B	4000			50	1 2 30		3250			DRYER RECEPT - LAUNDRY B215A
IWB RECEPT - JOB GRADS A260		4000		20	3 4 20			3250	720	RECEPT - JOB GRADS A260
RECEPT - JOB GRADS A260	720			20	5 6 20		540			RECEPT - JOB GRADS A260
RECEPT - TOILET A262		540		20	7 8 20			540		RECEPT - ED TECH OFFICE A268
RECEPT - ED TECH OFFICE A268		540		20	9 10 20			540	540	RECEPT - ED TECH OFFICE A268
RECEPT - ED TECH OFFICE A268	720			20	11 12 20		720			RECEPT - ED TECH OFFICE A268
RECEPT - ED TECH OFFICE A268		720		20	13 14 20			720	720	RECEPT - ED TECH OFFICE A268
CNTR RECEPT - ED TECH A268		360		20	15 16 20			360	1500	COPPER - ED TECH OFFICE A268
RECEPT - ELECT ROOM B228A		540		20	17 18 20		660			COPPER - ED TECH OFFICE A268
RECEPT - CORRIDOR B220		900		20	21 22 20		1080			COOR RECEPT - LL ENGLISH B201
BOX B1ALCD - LL CONF B204		660		20	23 24 20			800	800	PROJECTOR SCREEN - DINING
RECEPT - LL CONF B204	540			20	25 26 20		200			LOPR - ELEC B228A
RECEPT - OFFICE B269		540		20	27 28 20		1500			WASHER RECEPT - LAUNDRY B215A
RECEPT - BATH B215C		180		20	29 30 20			360	360	QUAD RECEPT - LL ENGLISH B201
RECEPT - KITCHENETTE B215B	1500			20	31 32 20		360			QUAD RECEPT - LL ENGLISH B201
QUAD RECEPT - SPECIAL ED A260		720		20	33 34 20		300			QUAD RECEPT - LL ENGLISH B201
BOX B1ALCD - LL STUDENT B202		660		20	35 36 20			540	540	RECEPT - CAREER EXPLOR B211
RECEPT - LL STUDENT ASSIST B202	720			20	37 38 20		720			RECEPT - CAREER EXPLOR B211
PROJECTOR - DINING		1200		20	39 40 20			360	360	QUAD RECEPT - CAREER EXPLOR B211
RECEPT - CORRIDOR		540		20	41 42 20		360			QUAD RECEPT - CAREER EXPLOR B211
REFRIGERATOR - KITCHEN B215B	1500			20G	43 44 20		360			QUAD RECEPT - CAREER EXPLOR B211
RECEPT - LIFE SKILLS B215		900		20	45 46 20		1500			RECEPT - KITCHENETTE B215B
JUNCTION - DAMPERS - B220		400		20	47 48 20					SPARE
SPARE				15	49 50 20					SPARE
SPARE				15	51 52 20					SPARE
SPARE				15	53 54 20					SPARE
SUBTOTAL	10240	9520	3640				6750	9250	4820	SUBTOTAL

NOTES:  
 TOTAL WATTS L1: 16990  
 TOTAL WATTS L2: 18770  
 TOTAL WATTS L3: 9460  
 TOTAL WATTS: 44220  
 TOTAL AMPS @ 100%: 123 AMPS  
 TOTAL AMPS @ 125%: 154 AMPS

C.B. TYPE: G-GFCI  
 L-LOCK ON C.B. H-HACR C.B.  
 AF-ARC FAULT  
 TOTAL PANEL RECEPT LOAD = 20100 WATTS

**PANELBOARD: L4N1D1**  
 BUS SIZE: 125 AMPS  
 VOLTAGE: 480 Y/277V 3PH-4W  
 SERVICE RATED: NO  
 ISOLATED GND BUS: NO  
 SHORT CIR. CURRENT RATING: 18000 AMPS

MAIN: MLO  
 NEUTRAL: 100%  
 LOCATION: ELEC D146  
 MOUNTING: SURFACE  
 TVSS: NO

DIRECTORY	WATTS OF LOAD			CKT BKR AMPS	POLES	CKT BKR AMPS	WATTS OF LOAD			DIRECTORY
	L1	L2	L3				L1	L2	L3	
GREENHOUSE CONTROL POWER	12000	12000	12000	100	1 2 20		363			LTG - EXTERIOR BUILDING D
LTG - DATA D144	2043			20	3 4 20		185		274	LTG - STAIR D
LTG - BUSINESS D128		3563		20	5 6 20					LTG - COSMETOLOGY D132
LTG - PATHWAY LIBRARY D120		740		20	7 8 20		2121			LTG - LOBBY D140
LTG - STORAGE D133	3330			20	9 10 20		1361			LTG - DINING D151
SPARE				20	11 12 20					LTG - TECH HUB A135
SPARE				20	13 14 20		4013			SPARE
SPARE				20	15 16 20					SPARE
SPARE				20	17 18 20					SPARE
SPARE				20	19 20 20					SPARE
SPARE				20	21 22 20					SPARE
SPARE				20	23 24 20					SPARE
SUBTOTAL	17373	15583	12740				6487	1546	1569	SUBTOTAL

NOTES:  
 TOTAL WATTS L1: 23870  
 TOTAL WATTS L2: 17109  
 TOTAL WATTS L3: 14358  
 TOTAL WATTS: 55298  
 TOTAL AMPS @ 100%: 67 AMPS  
 TOTAL AMPS @ 125%: 83 AMPS

C.B. TYPE: G-GFCI  
 L-LOCK ON C.B. H-HACR C.B.  
 AF-ARC FAULT  
 TOTAL PANEL RECEPT LOAD = 0 WATTS

**PANELBOARD: D2N1D1**  
 BUS SIZE: 1000 AMPS  
 VOLTAGE: 208 Y/120V 3PH-4W  
 SERVICE RATED: NO  
 ISOLATED GND BUS: NO  
 SHORT CIR. CURRENT RATING: 22000 AMPS


MAIN: 1000 AMP MCB  
 NEUTRAL: 100%  
 LOCATION: ELEC D146  
 MOUNTING: SURFACE  
 TVSS: NO

DIRECTORY	WATTS OF LOAD			CKT BKR AMPS	POLES	CKT BKR AMPS	WATTS OF LOAD			DIRECTORY
	L1	L2	L3				L1	L2	L3	
PANEL P2N1D1	8602	7498	7944	125	1 2 20		5526	5888	6403	PANEL P2N1D2
PANEL P2N1D3	5480	6201	5220	125	9 10 20SET		31544	27354	26894	PANEL P2N1D4
PANEL P2N1D5	20902	19110	21337	400ET	15 16 400ET		38482	37476	37032	PANEL P2N1D6
SPARE				125	17 18 20					

**DRAWING NOTES**

- THE FOLLOWING NOTES ONLY APPLY TO THIS DRAWING.
- REFER TO GENERAL NOTES, ELECTRICAL TRADE NOTES, LEGEND AND ABBREVIATIONS ON DRAWING E0.01.

**LAVALLEE BRENSINGER ARCHITECTS**  
 Boston | Manchester | Portland  
 155 Dow Street, Suite 400, Manchester, NH 03101  
 603.622.5450  
 305 Commercial Street, Portland, ME 04101  
 207.558.7200  
 www.LBPA.com

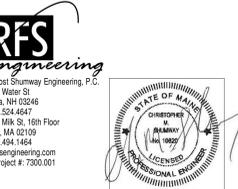

Sanford School Department and State of Maine Department of Education

**SANFORD HIGH SCHOOL and TECHNICAL CENTER**

SANFORD, ME 04073

NO.	DESCRIPTION	DATE
3	ADDENDUM #3	2016-03-04

**PANELBOARD SCHEDULES**

CONTENT:  
 DRAWN BY: C. NEWELL  
 PROJECT NO: 12-067-00  
 DATE: 02/11/2016  
 REVISION:  
 SCALE: NO SCALE

**E0.15**

Project Phase  
**BID DOCUMENTS**  
 COPYRIGHT © 2016 BY LAVALLEE/BRENSINGER PROFESSIONAL ASSOCIATION. ALL RIGHTS RESERVED. NO REPRODUCTION WITHOUT PERMISSION.

**PANELBOARD: P2N2D1**  
 BUS SIZE: 125 AMPS MAIN: MLO  
 VOLTAGE: 480 Y127V 3PH,4W NEUTRAL: 100%  
 SERVICE RATED: NO LOCATION: ELEC D247  
 ISOLATED GND BUS: NO MOUNTING: SURFACE  
 SHORT CIR. CURRENT RATING: 22000 AMPS TVSS: NO

DIRECTORY	WATTS OF LOAD			CKT BKR AMPS	POLES	CKT BKR AMPS	WATTS OF LOAD			DIRECTORY		
	L1	L2	L3				L1	L2	L3			
UNITS AC2-1, 2, 3, 4 & 5				20	1	2				SPARE		
LTG - GUID RECEPTION A210A IP5				20	5	6			720	RECEP - OFFICE D241		
FLOOR BOX B11LCD - INSTR D249	660			20	7	8			360	QUAD RECEP - OFFICE D241		
RECEP - CONF INSTRUCT D249				20	9	10			300	IWB RECEP - EARTH CLASS E237		
RECEP - CONF INSTRUCT D249				20	11	12			540	RECEP - EARTH CLASSROOM E237		
IWB RECEP - MARKETING D245	300			20	13	14			720	RECEP - EARTH CLASSROOM E237		
FLOOR BOX B2 - MARKETING D245				20	15	16			360	RECEP - EARTH CLASSROOM E237		
LCD (3) - MARKETING D245				20	17	18			360	CNTR RECEP - EARTH CLASS E237		
LCD (3) - MARKETING D245	900			20	19	20			360	IWB RECEP - BUSINESS D243		
RECEP - MARKETING D245				20	21	22			900	LCD (3) - BUSINESS D243		
RECEP - MARKETING D245	720			20	23	24			600	LCD (2) - BUSINESS D243		
RECEP - MARKETING D245				20	25	26			720	RECEP - BUSINESS D243		
RECEP DESK - MARKETING D245	540			20	27	28			720	RECEP - BUSINESS D243		
RECEP DESK - MARKETING D245				20	29	30			540	RECEP DESK - BUSINESS D243		
RECEP DESK - MARKETING D245	540			20	31	32			540	RECEP DESK - BUSINESS D243		
RECEP DESK - MARKETING D245				20	33	34			540	RECEP DESK - BUSINESS D243		
FAN EF-A237	528			20	37	38			540	RECEP DESK - BUSINESS D243		
FAN KEF-4				20	39	40			540	RECEP DESK - BUSINESS D243		
FANS EF-A131 & EF-D220	1920			20	41	42			540	RECEP DESK - BUSINESS D243		
LCD (2) - BUSINESS D243	600			20	43	44			540	RECEP DESK - BUSINESS D243		
SPARE				20	45	46				SPARE		
SPARE				20	47	48				SPARE		
SPARE				20	49	50				SPARE		
SPARE				20	51	52				SPARE		
SPARE				20	53	54				SPARE		
NOTES:												
SUBTOTAL				4068	4620	4155			3720	3360	3840	
				TOTAL WATTS L1:			7788					
				TOTAL WATTS L2:			7860					
				TOTAL WATTS L3:			7956					
				TOTAL WATTS:			23763					
				TOTAL AMPS @ 100%:			66 AMPS					
				TOTAL AMPS @ 125%:			83 AMPS					
C.B. TYPE				G-GFCI			H-HACR C.B.					
S-SHUNT TRIP				G-GFCI			H-HACR C.B.					
L-LOCK ON C.B.				G-GFCI			H-HACR C.B.					
AF-ARC FAULT				G-GFCI			H-HACR C.B.					
				TOTAL PANEL RECEPT LOAD =			14880 WATTS					

**PANELBOARD: D2N2D1**  
 BUS SIZE: 400 AMPS MAIN: 400 AMP MCB ELECTRONIC TRIP  
 VOLTAGE: 208 Y120V 3PH,4W NEUTRAL: 100%  
 SERVICE RATED: NO LOCATION: ELEC D247  
 ISOLATED GND BUS: NO MOUNTING: SURFACE  
 SHORT CIR. CURRENT RATING: 22000 AMPS TVSS: NO

DIRECTORY	WATTS OF LOAD			CKT BKR AMPS	POLES	CKT BKR AMPS	WATTS OF LOAD			DIRECTORY		
	L1	L2	L3				L1	L2	L3			
PANEL P2N2D1	10440	7860	7860	125	1	2	3784	5584	4140	PANEL P2N2D2		
PANEL P2N2D3		9420	9720	125	9	10	11960	11580	9420	PANEL P2N2D4		
UNIT ACC-1		1664		20	17	18	1664	1664		UNIT ACC-11		
UNIT ACC-12		1664	1664	20	21	22	1664	1664	1664	UNIT ACC-13		
FAN KEF-4	1664	1373		25	25	26	1664	1664		UNIT ACC-18		
SPARE				20	27	28				FAN EF-D132		
FAN EF-247		528		20	31	32	528	528		FAN EF-D129		
FAN DEF-2	1176			20	37	38	1176	1176		FAN EF-D146		
SPARE				20	39	40				SPARE		
SPARE				20	41	42				SPARE		
NOTES:												
SUBTOTAL				21832	20137	21280	19096	21188	19064			
				TOTAL WATTS L1:			41228					
				TOTAL WATTS L2:			41325					
				TOTAL WATTS L3:			39344					
				TOTAL WATTS:			121897					
				TOTAL AMPS @ 100%:			329 AMPS					
				TOTAL AMPS @ 125%:			423 AMPS					
C.B. TYPE				G-GFCI			H-HACR C.B.					
S-SHUNT TRIP				G-GFCI			H-HACR C.B.					
L-LOCK ON C.B.				G-GFCI			H-HACR C.B.					
AF-ARC FAULT				G-GFCI			H-HACR C.B.					
				TOTAL PANEL RECEPT LOAD =			0 WATTS					

**PANELBOARD: L4N2D1**  
 BUS SIZE: 125 AMPS MAIN: MLO  
 VOLTAGE: 480 Y127V 3PH,4W NEUTRAL: 100%  
 SERVICE RATED: NO LOCATION: ELEC D247  
 ISOLATED GND BUS: NO MOUNTING: SURFACE  
 SHORT CIR. CURRENT RATING: 18000 AMPS TVSS: NO

DIRECTORY	WATTS OF LOAD			CKT BKR AMPS	POLES	CKT BKR AMPS	WATTS OF LOAD			DIRECTORY		
	L1	L2	L3				L1	L2	L3			
LTG - MARKETING & MNG D245	2587			20	1	2	3265			LTG - CONFERENCE/INST D249		
LTG - BIU & MNG 2ND LEVEL D220		814		20	3	4	1875			LTG - BIO-SCIENCE LAB D233		
LTG - CLASSROOM D217		2472		20	5	6	2754			LTG - CLASSROOM D230		
LTG - BIU & MNG 2ND LEVEL D220	410			20	7	8	1440			LTG - OFFICE D211		
SPARE				20	9	10	1272			LTG - OFFICE A211E		
SPARE				20	11	12				SPARE		
SPARE				20	13	14				SPARE		
SPARE				20	15	16				SPARE		
SPARE				20	17	18				SPARE		
NOTES:												
SUBTOTAL				2997	814	2472	4705	3147	2754			
				TOTAL WATTS L1:			7702					
				TOTAL WATTS L2:			3961					
				TOTAL WATTS L3:			6226					
				TOTAL WATTS:			16889					
				TOTAL AMPS @ 100%:			20 AMPS					
				TOTAL AMPS @ 125%:			25 AMPS					
C.B. TYPE				G-GFCI			H-HACR C.B.					
S-SHUNT TRIP				G-GFCI			H-HACR C.B.					
L-LOCK ON C.B.				G-GFCI			H-HACR C.B.					
AF-ARC FAULT				G-GFCI			H-HACR C.B.					
				TOTAL PANEL RECEPT LOAD =			0 WATTS					

**PANELBOARD: P2N2D2**  
 BUS SIZE: 125 AMPS MAIN: 125 AMP MCB (SHUNT-TRIP)  
 VOLTAGE: 208 Y120V 3PH,4W NEUTRAL: 100%  
 SERVICE RATED: NO LOCATION: BIO-SCIENCE LAB D219  
 ISOLATED GND BUS: NO MOUNTING: RECESSED  
 SHORT CIR. CURRENT RATING: 22000 AMPS TVSS: NO


DIRECTORY	WATTS OF LOAD			CKT BKR AMPS	POLES	CKT BKR AMPS	WATTS OF LOAD			DIRECTORY		
	L1	L2	L3				L1	L2	L3			
UNITS AC2-1, 2, 3, 4 & 5	144			20	1	2	300			IWB RECEP - LAB D233		
CNTR QUAD RECEP - LAB D219		144		20	3	4	720			RECEP - DESK LAB D233		
GOOGLE SAN. RECEP - LAB D219	360		360	20	5	6	360		360	GOOGLE SAN. RECEP - LAB D233		
COUNTER RECEP - LAB D219		360		20	7	8	360			RECEP - LAB D233		
COUNTER RECEP - LAB D219		360		20	9	10	360		360	COUNTER RECEP - LAB D233		
COUNTER RECEP - LAB D219		360		20	11	12	360		360	COUNTER RECEP - LAB D233		
COUNTER RECEP - LAB D219	360			20	13	14	360		360	COUNTER RECEP - LAB D233		
COUNTER RECEP - LAB D219		360		20	15	16	360		360	CNTR QUAD RECEP - LAB D233		
CNTR QUAD RECEP - LAB D219		360		20	17	18	360		360	CNTR QUAD RECEP - LAB D233		
CNTR QUAD RECEP - LAB D219	360			20	19	20	360		360	CNTR QUAD RECEP - LAB D233		
CNTR QUAD RECEP - LAB D219		360		20	21	22	360		360	CNTR QUAD RECEP - LAB D233		
CNTR QUAD RECEP - LAB D219		360		20	23	24	360		360	CNTR QUAD RECEP - LAB D233		
CNTR QUAD RECEP - LAB D219	360			20	25	26	360		360	CNTR QUAD RECEP - LAB D233		
IWB RECEP - LAB D219		300		20	27	28	1500			REFRIGERATOR - PREP RM D227		
RECEP - DESK LAB D219		540		20	29	30	360		360	COUNTER RECEP - PREP D227		
SHUNT-TRIP POWER	100			20	31	32	360		360	COUNTER RECEP - PREP D227		
LUNCTION - DAMPERS - D220		400		20	33	34	360		360	COUNTER RECEP - PREP D227		
SPARE				20	35	36				SPARE		
SPARE				20	37	38				SPARE		
SPARE				20	39	40				SPARE		
SPARE				20	41	42				SPARE		
NOTES:												
SUBTOTAL				1684	1924	1980	2100	3660	2160			
				TOTAL WATTS L1:			3784					
				TOTAL WATTS L2:			5984					
				TOTAL WATTS L3:			4140					
				TOTAL WATTS:			13908					
				TOTAL AMPS @ 100%:			38 AMPS					
				TOTAL AMPS @ 125%:			47 AMPS					
C.B. TYPE				G-GFCI			H-HACR C.B.					
S-SHUNT TRIP				G-GFCI			H-HACR C.B.					
L-LOCK ON C.B.				G-GFCI			H-HACR C.B.					
AF-ARC FAULT				G-GFCI			H-HACR C.B.					
				TOTAL PANEL RECEPT LOAD =			10620 WATTS					

**PANELBOARD: P4NFF1**  
 BUS SIZE: 400 AMPS MAIN: MLO  
 VOLTAGE: 480 Y127V 3PH,4W NEUTRAL: 100%  
 SERVICE RATED: YES LOCATION: STADIUM ELECTRIC ROOM  
 ISOLATED GND BUS: NO MOUNTING: SURFACE  
 SHORT CIR. CURRENT RATING: 35000 AMPS TVSS: NO

DIRECTORY	WATTS OF LOAD			CKT BKR AMPS	POLES	CKT BKR AMPS	WATTS OF LOAD			DIRECTORY
	L1	L2	L3				L1	L2	L3	
POLE F1 - CONTACTOR C1 GAME LIGHTS	9228			40	1	2	9228			POLE F2 - CONTACTOR C2 GAME LIGHTS
POLE F3 - CONTACTOR C3 GAME LIGHTS	9228		9228	40	3	4	9228		9228	POLE F4 - CONTACTOR C4 GAME LIGHTS
POLE F1 - CONTACTOR C5 WALKING TRACK	2051		2051	20	7	8	2051		2051	POLE F2 - CONTACTOR C6 WALKING TRACK
POLE F3 - CONTACTOR C7 WALKING TRACK		2051		20	9	10	2051		2051	POLE F4 - CONTACTOR C8 WALKING TRACK
SPARE				30	13	14	3500		3500	PANEL P2NFF1
SPARE				30</						

**DRAWING NOTES**

- 1 THE FOLLOWING NOTES ONLY APPLY TO THIS DRAWING.
- 2 REFER TO GENERAL NOTES, ELECTRICAL TRADE NOTES, LEGEND AND ABBREVIATIONS ON DRAWING E0.01.
- 3 WIRE EXIT SIGNS AND EMERGENCY WALL PACKS AHEAD OF ALL SWITCHING.
- 4 REFER TO LIGHTING CONTROL DETAILS AND DIAGRAMS ON SHEETS E4.02, E4.03, E4.04, AND E4.05.
- 5 COORDINATE MOUNTING OF FIXTURE TYPE "C1" 4" AND "C2" 4" IN MECHANICAL ROOMS, ELECTRIC ROOM AND STORAGE ROOMS WITH MECHANICAL DUCTWORK AND PIPING PRIOR TO INSTALLATION. FIXTURES SHALL BE SURFACE OF CHAIN HUNG AS HIGH AS POSSIBLE WHILE MAINTAINING AN UNOBSTRUCTED PATH OF ILLUMINATION TO THE FLOOR.
- 6 COORDINATE MOUNTING OF FIXTURE TYPE "C2" IN TELECOMMUNICATIONS ROOM WITH TELECOMMUNICATIONS EQUIPMENT AND CABLETRAY LAYOUT PRIOR TO INSTALLATION OF ANY CABLE OR CONDUIT. FIXTURES ARE TO BE MOUNTED AT 8'-2" AFF (U.O.N.). REFER TO TELECOM DRAWING T1.31.
- 7 COORDINATE MOUNTING OF FIXTURE TYPE "C2" IN MAIN ELECTRICAL ROOM WITH ELECTRICAL DISTRIBUTION GEAR AND EQUIPMENT PRIOR TO INSTALLATION OF ANY CABLE OR CONDUIT. FIXTURES ARE TO BE MOUNTED AT 8'-2" AFF (U.O.N.). REFER TO ELECTRICAL POWER DRAWING E2.41.
- 8 WALL MOUNT FIXTURE JUST ABOVE DOOR OPENING.
- 9 REFER TO TYPICAL STAIRWELL LIGHTING WIRING DIAGRAM ON DRAWING E4.03.
- 10 COORDINATE MOUNTING OF TYPE "C1" FIXTURES IN WATER SERVICE ROOM WITH PLUMBING AND FIRE PROTECTION EQUIPMENT AND PIPING PRIOR TO INSTALLATION OF ANY CABLE OR CONDUIT. FIXTURES ARE TO BE SURFACE MOUNTED TO THE BOTTOM OF THE WIDE FLANGE BEAM AT APPROXIMATELY 7'-10" AFF. REFER TO PLUMBING DRAWING P1.09 AND FIRE PROTECTION DRAWING FP1.09.
- 11 FIXTURES ARE TO BE MOUNTED AT 8'-8" AFF (U.O.N.).

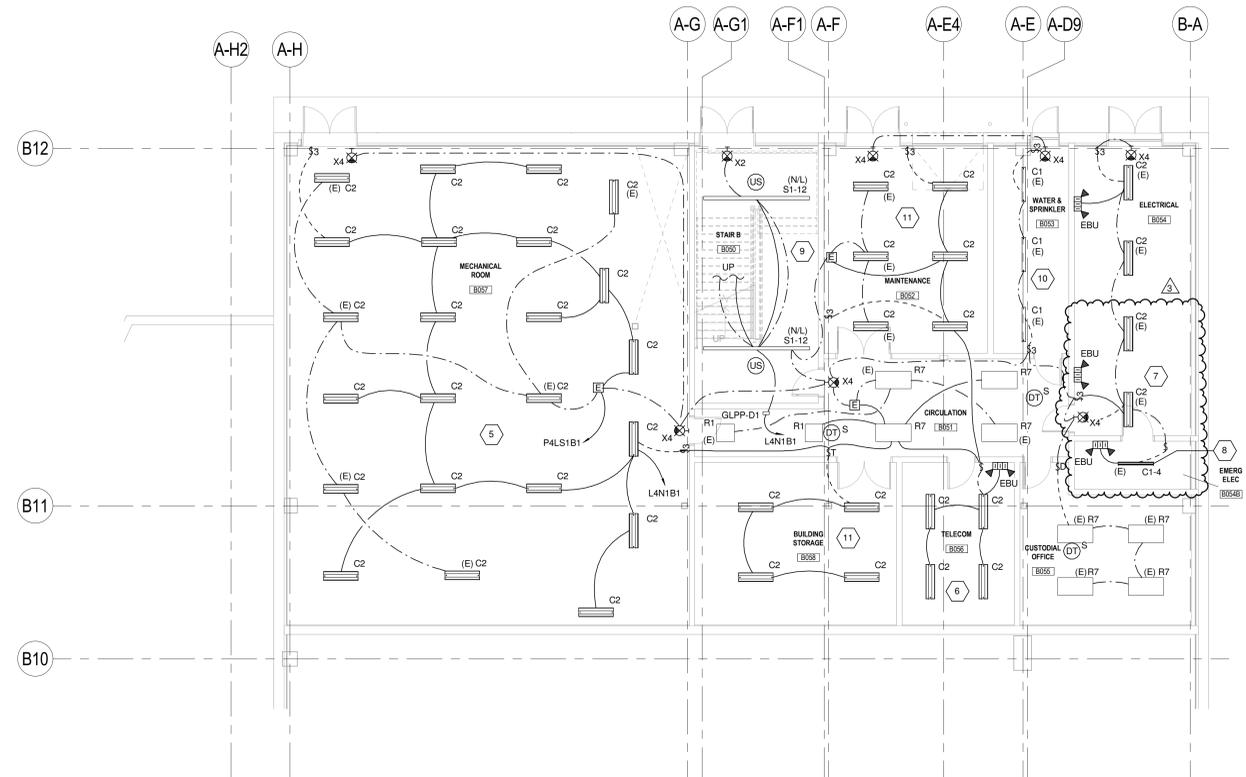


1 BASEMENT - LIGHTING PLAN  
1/8" = 1'-0"

155 Dow Street, Suite 400, Manchester, NH 03101  
603.622.5450  
305 Commercial Street, Portland, ME 04101  
207.558.7200  
www.LBPA.com



Risht Frost Shumway Engineering, P.C.  
NH: 71 Water St.  
Laconia, NH 03246  
P: 603.324.4541  
MA: 50 Main St., 16th Floor  
Boston, MA 02109  
P: 617.494.1464  
www.rfsengineering.com  
RFS Project #: 7300.001

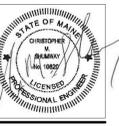


Sanford School Department and  
State of Maine Department of  
Education


**SANFORD HIGH  
SCHOOL and  
TECHNICAL CENTER**

SANFORD, ME 04073

NO.	DESCRIPTION	DATE
3	ADDENDUM #3	2016-03-04

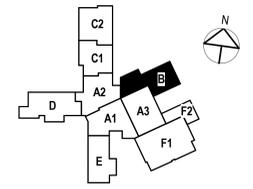

CONTENT: BASEMENT LIGHTING PLAN	
DRAWN BY:	C. NEWELL
PROJECT NO:	12-067-00
DATE:	02112016
REVISED:	
SCALE:	1/8" = 1'-0"
<b>E1.09</b>	
Project Phase <b>BID DOCUMENTS</b>	
COPYRIGHT © 2016 BY LAVALLEE/BRENSINGER PROFESSIONAL ASSOCIATION. ALL RIGHTS RESERVED. NO REPRODUCTION WITHOUT PERMISSION.	

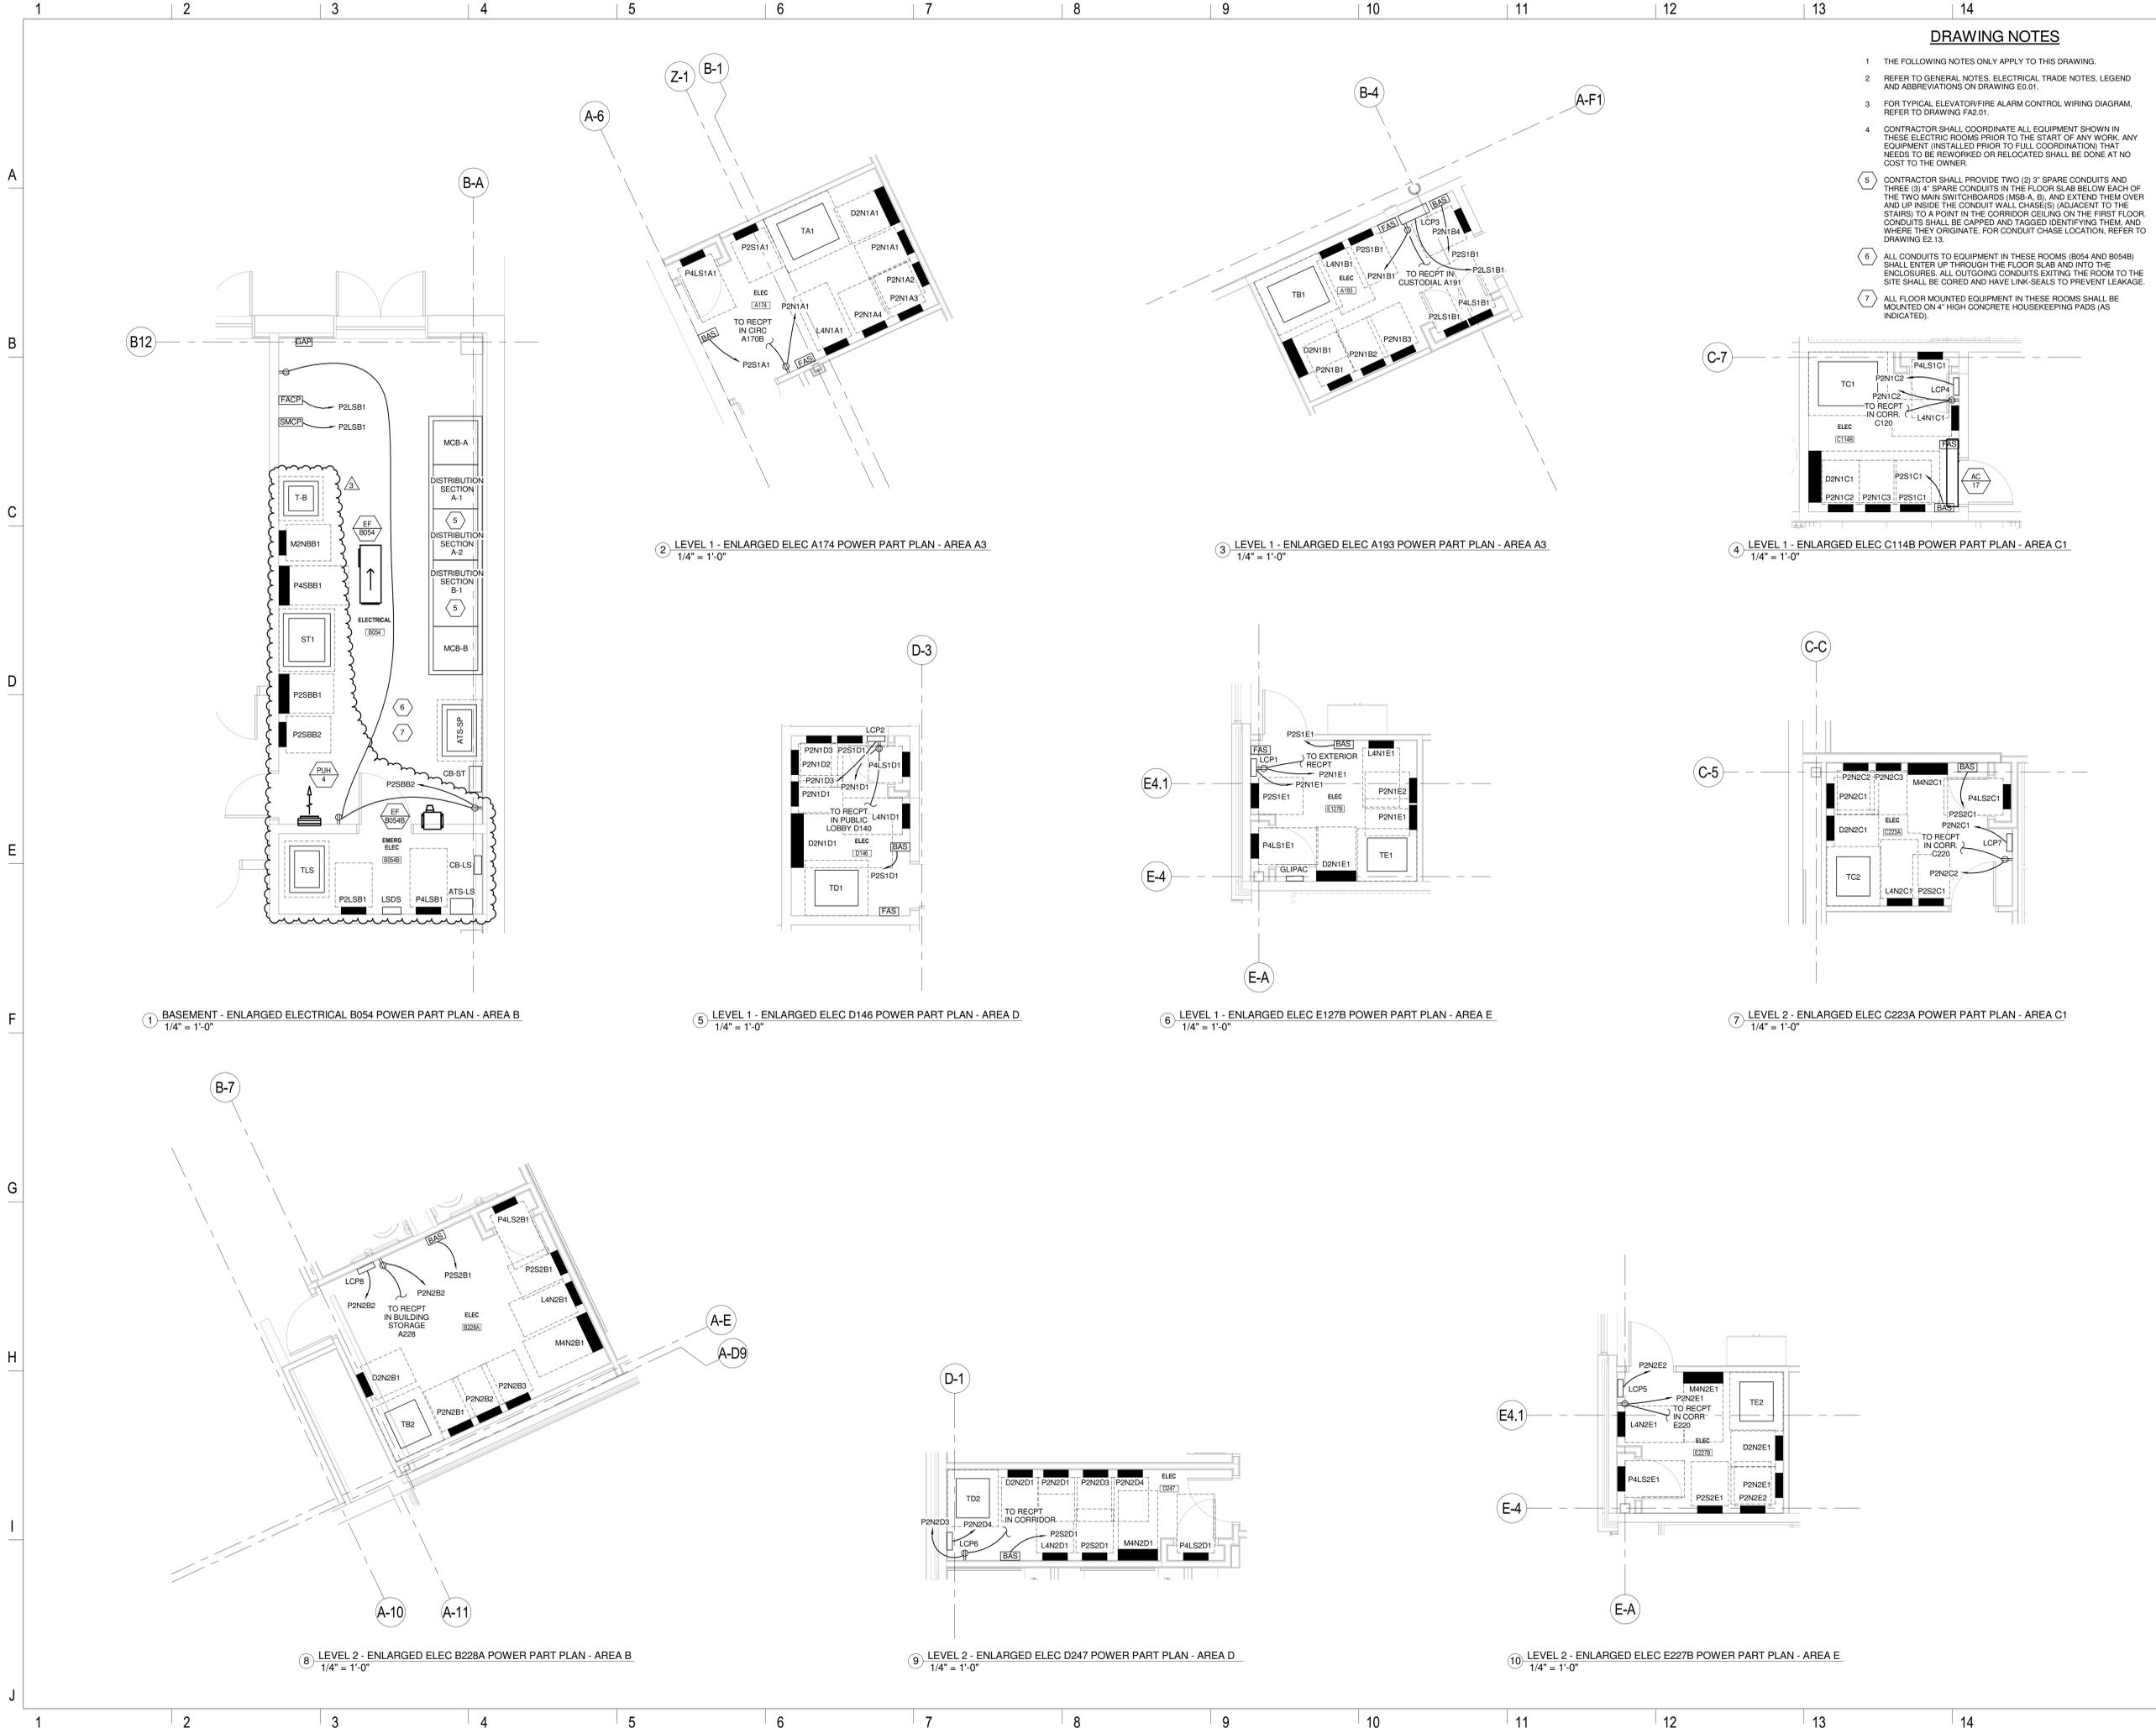

**DRAWING NOTES**


- 1 THE FOLLOWING NOTES ONLY APPLY TO THIS DRAWING.
- 2 REFER TO GENERAL NOTES, ELECTRICAL TRADE NOTES, LEGEND AND ABBREVIATIONS ON DRAWING E0.01.
- 3 FOR TYPICAL ELEVATOR/FIRE ALARM CONTROL WIRING DIAGRAM, REFER TO DRAWING FA2.01.
- 4 CONTRACTOR SHALL COORDINATE ALL EQUIPMENT SHOWN IN THESE ELECTRIC ROOMS PRIOR TO THE START OF ANY WORK. ANY EQUIPMENT (INSTALLED PRIOR TO FULL COORDINATION) THAT NEEDS TO BE REWORKED OR RELOCATED SHALL BE DONE AT NO COST TO THE OWNER.
- 5 CONTRACTOR SHALL PROVIDE TWO (2) 3" SPARE CONDUITS AND THREE (3) 4" SPARE CONDUITS IN THE FLOOR SLAB BELOW EACH OF THE TWO MAIN SWITCHBOARDS (MSB-A, B), AND EXTEND THEM OVER AND UP INSIDE THE CONDUIT WALL CHASE(S) (ADJACENT TO THE STAIRS) TO A POINT IN THE CORRIDOR CEILING ON THE FIRST FLOOR. CONDUITS SHALL BE CAPPED AND TAGGED IDENTIFYING THEM AND WHERE THEY ORIGINATE. FOR CONDUIT CHASE LOCATION, REFER TO DRAWING E2.13.
- 6 ALL CONDUITS TO EQUIPMENT IN THESE ROOMS (B054 AND B054B) SHALL ENTER UP THROUGH THE FLOOR SLAB AND INTO THE ENCLOSURES. ALL OUTGOING CONDUITS EXITING THE ROOM TO THE SITE SHALL BE CORED AND HAVE LINK SEALS TO PREVENT LEAKAGE.
- 7 ALL FLOOR MOUNTED EQUIPMENT IN THESE ROOMS SHALL BE MOUNTED ON 4" HIGH CONCRETE HOUSEKEEPING PADS (AS INDICATED).

**LAVALLEE BRENSINGER ARCHITECTS**  
 Boston | Manchester | Portland  
 155 Dow Street, Suite 400, Manchester, NH 03101  
 603.622.5450  
 305 Commercial Street, Portland, ME 04101  
 207.558.7200  
 www.LBPA.com

**RFS engineering**  
 Risk Frost Shumway Engineering, P.C.  
 NH: 71 Water St.  
 Laconia, NH 03246  
 P: 603.524.4541  
 MA: 50 Main St. 16th Floor  
 Boston, MA 02109  
 P: 617.494.1464  
 www.rfsengineering.com  
 RFS Project #: 7300.001

Sanford School Department and  
 State of Maine Department of  
 Education  
  
**SANFORD HIGH SCHOOL and  
 TECHNICAL CENTER**  
  
 SANFORD, ME 04073

NO.	DESCRIPTION	DATE
3	ADDENDUM #3	2016-03-04

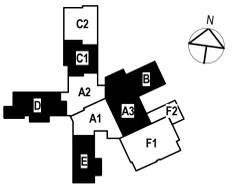

CONTENT:  
 ENLARGED POWER PART PLANS


DRAWN BY: C. NEWELL  
 PROJECT NO: 12-067-00  
 DATE: 02/11/2016  
 REVISED:  
 SCALE: 1/4" = 1'-0"

**E2.41**

Project Phase  
**BID DOCUMENTS**

COPYRIGHT © 2016 BY LAVALLEE/BRENSINGER PROFESSIONAL ASSOCIATION. ALL RIGHTS RESERVED. NO REPRODUCTION WITHOUT PERMISSION.

C:\Users\m6870\Desktop\DRAWINGS\SET11 MEP\7300\2016 FOR\MAT\7300-Civil-Excl-2016.rvt

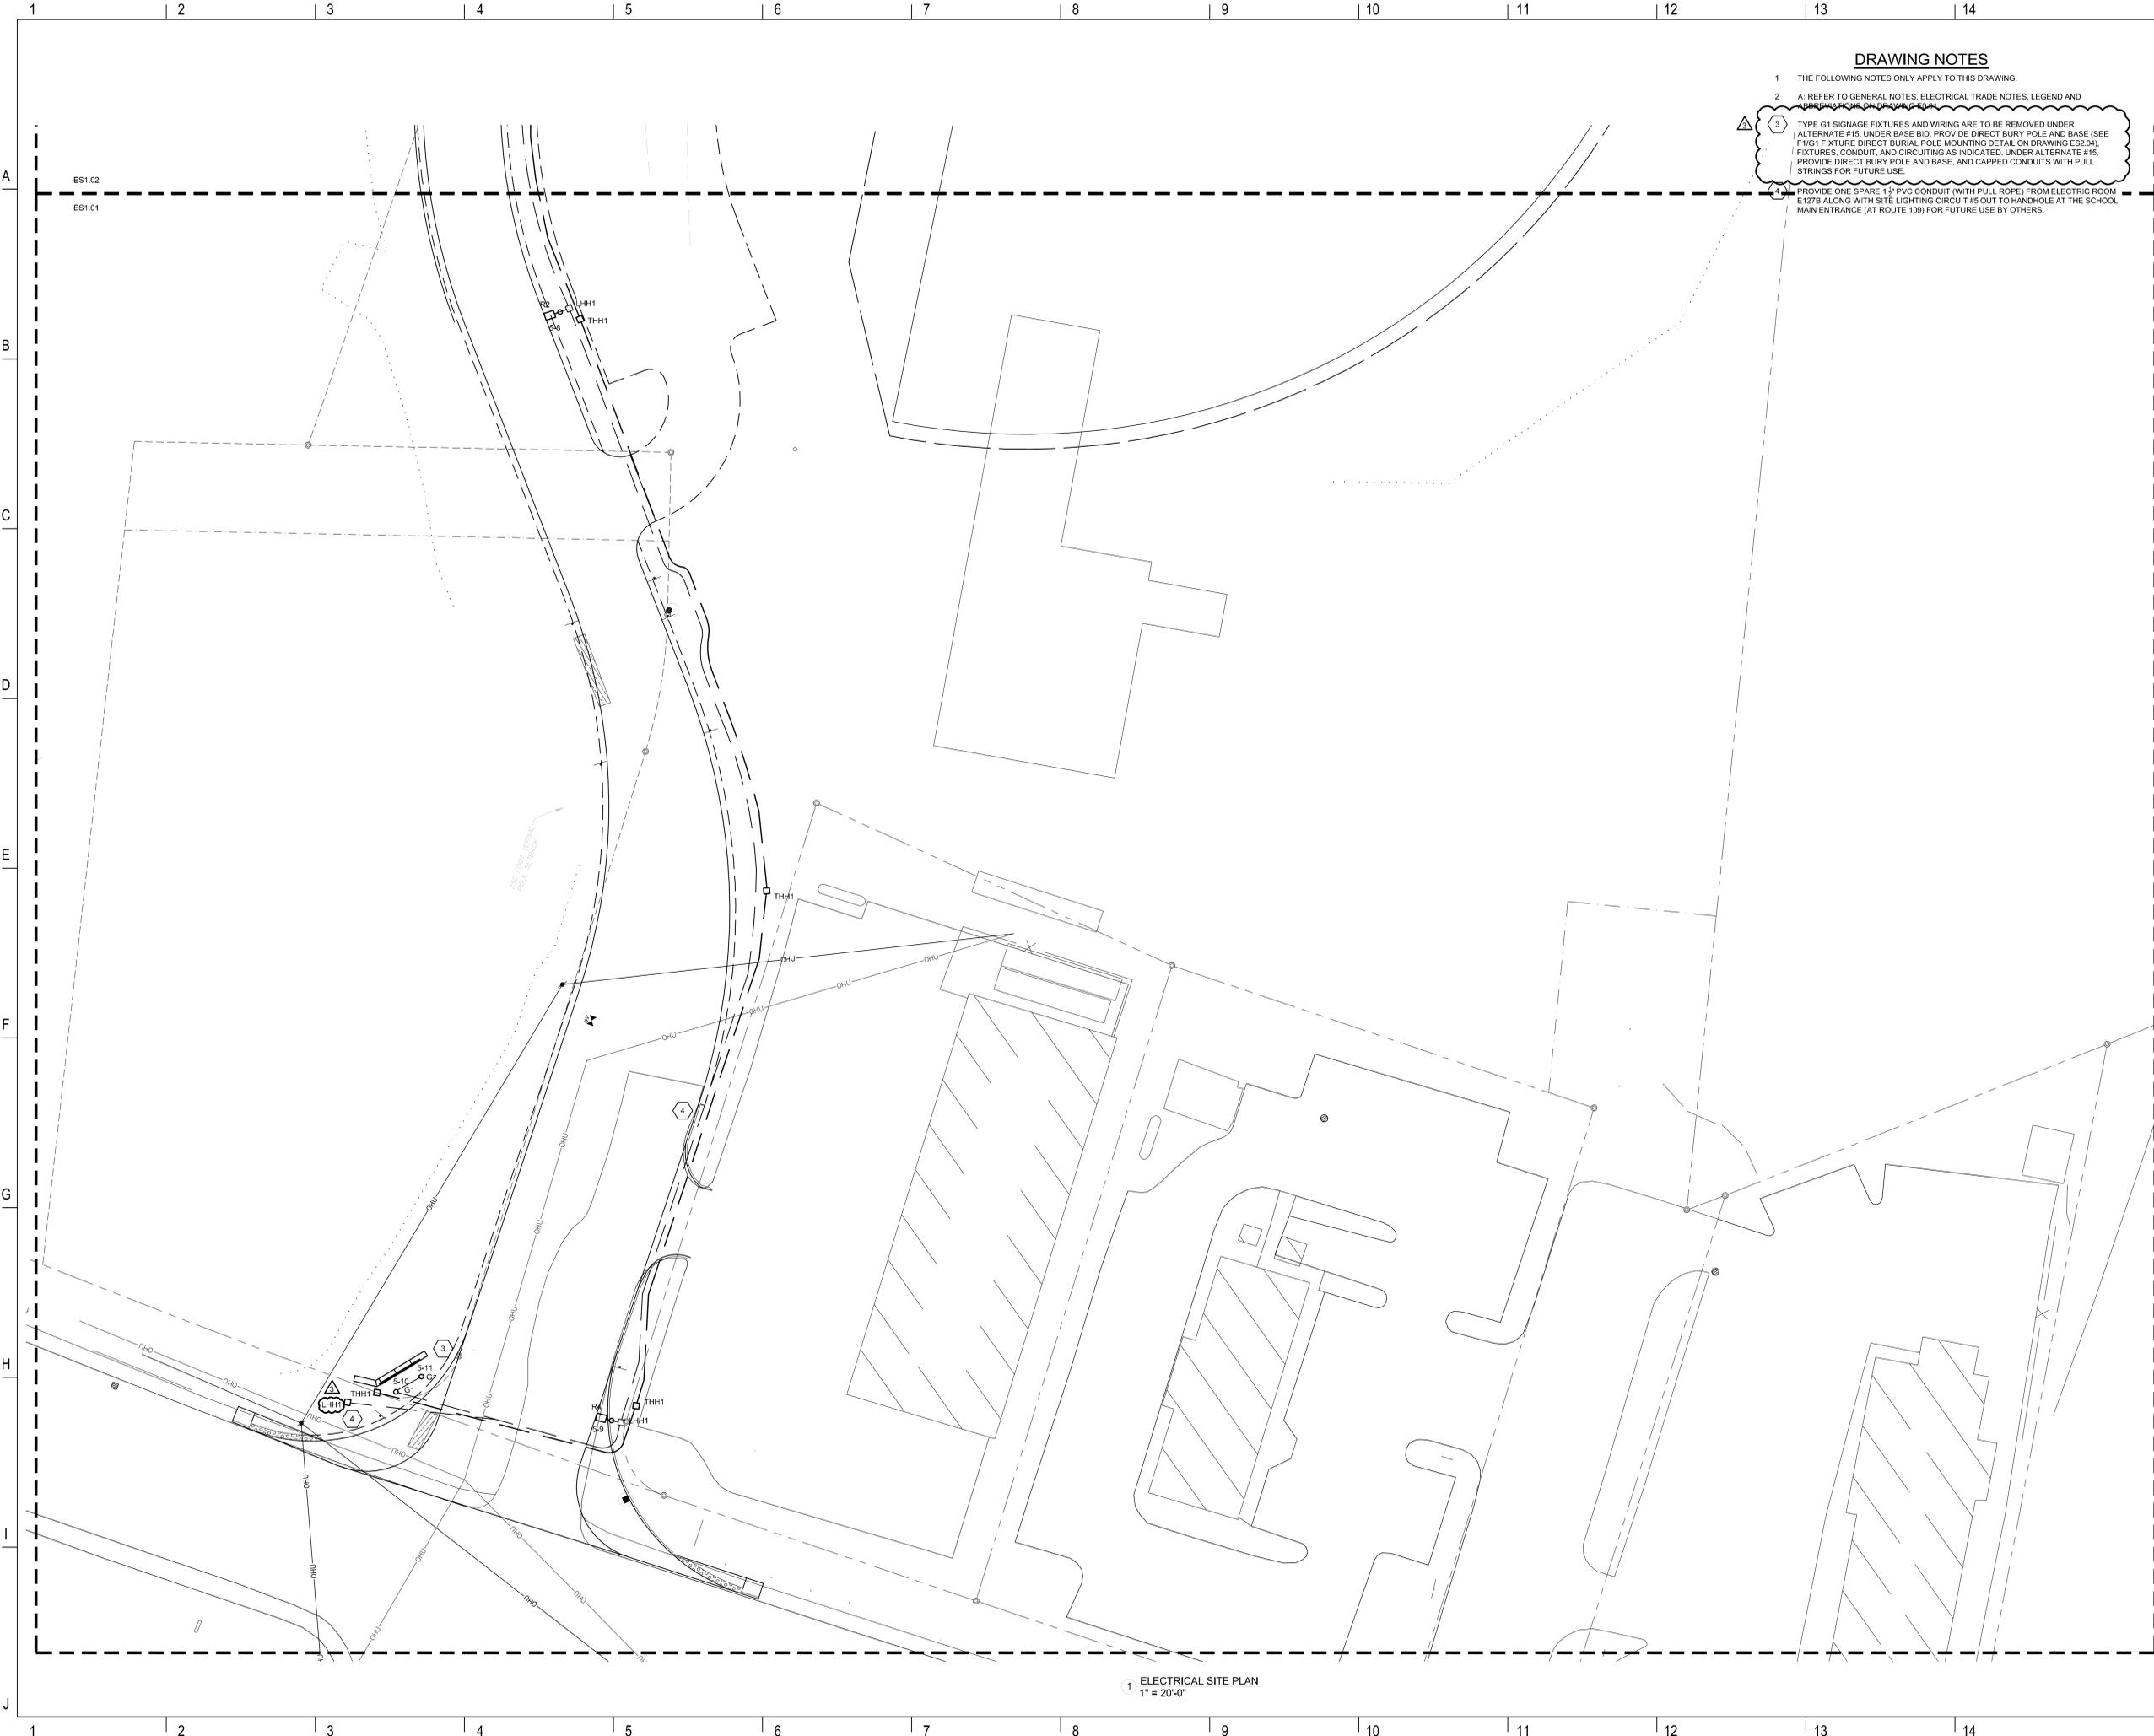


**DRAWING NOTES**

- 1 THE FOLLOWING NOTES ONLY APPLY TO THIS DRAWING.
- 2 A: REFER TO GENERAL NOTES, ELECTRICAL TRADE NOTES, LEGEND AND SPECIFICATIONS ON DRAWING E127B.
- 3 TYPE G1 SIGNAGE FIXTURES AND WIRING ARE TO BE REMOVED UNDER ALTERNATE #15. UNDER BASE BID, PROVIDE DIRECT BURY POLE AND BASE (SEE F101 FIXTURE DIRECT BURIAL POLE MOUNTING DETAIL ON DRAWING ES2.04), FIXTURES, CONDUIT, AND CIRCUITING AS INDICATED, UNDER ALTERNATE #15. PROVIDE DIRECT BURY POLE AND BASE, AND CAPPED CONDUITS WITH PULL STRINGS FOR FUTURE USE.
- 4 PROVIDE ONE SPARE 1" PVC CONDUIT (WITH PULL ROPE) FROM ELECTRIC ROOM E127B ALONG WITH SITE LIGHTING CIRCUIT #5 OUT TO HANDHOLE AT THE SCHOOL MAIN ENTRANCE (AT ROUTE 109) FOR FUTURE USE BY OTHERS.

**LAVALLEE BRENSINGER ARCHITECTS**  
 Boston | Manchester | Portland  
 155 Dow Street, Suite 400, Manchester, NH 03101 603.622.5450  
 305 Commercial Street, Portland, ME 04101 207.558.7200  
 www.LBPA.com

**RFS engineering**  
 Rist Frost Shumway Engineering, P.C.  
 NH: 71 Water St. Lanes, NH 03245 P: 603.524.4647  
 MA: 53 Milk St., 18th Floor Boston, MA 02109 P: 617.494.1464  
 www.rfsengineering.com RFS Project #: 7300.001

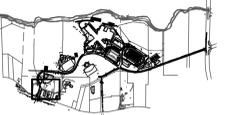

Sanford School Department and State of Maine Department of Education

**SANFORD HIGH SCHOOL and TECHNICAL CENTER**


SANFORD, ME 04073

NO.	DESCRIPTION	DATE
3	ADDENDUM #3	2016-03-04

FOR ADDITIONAL INFORMATION, REFER TO PROJECT MANUAL.

CONTENT:	ELECTRICAL SITE PLAN
DRAWN BY:	C. NEWELL
PROJECT NO.:	12-067-00
DATE:	02/11/2016
REVISED:	
SCALE:	AS NOTED
<b>ES1.01</b>	
Project Phase:	
BID DOCUMENTS	
<small>COPYRIGHT © 2016 BY LAVALLEEBRENSINGER PROFESSIONAL ASSOCIATION. ALL RIGHTS RESERVED. NO REPRODUCTION WITHOUT PERMISSION.</small>	

1 ELECTRICAL SITE PLAN  
 1" = 20'-0"

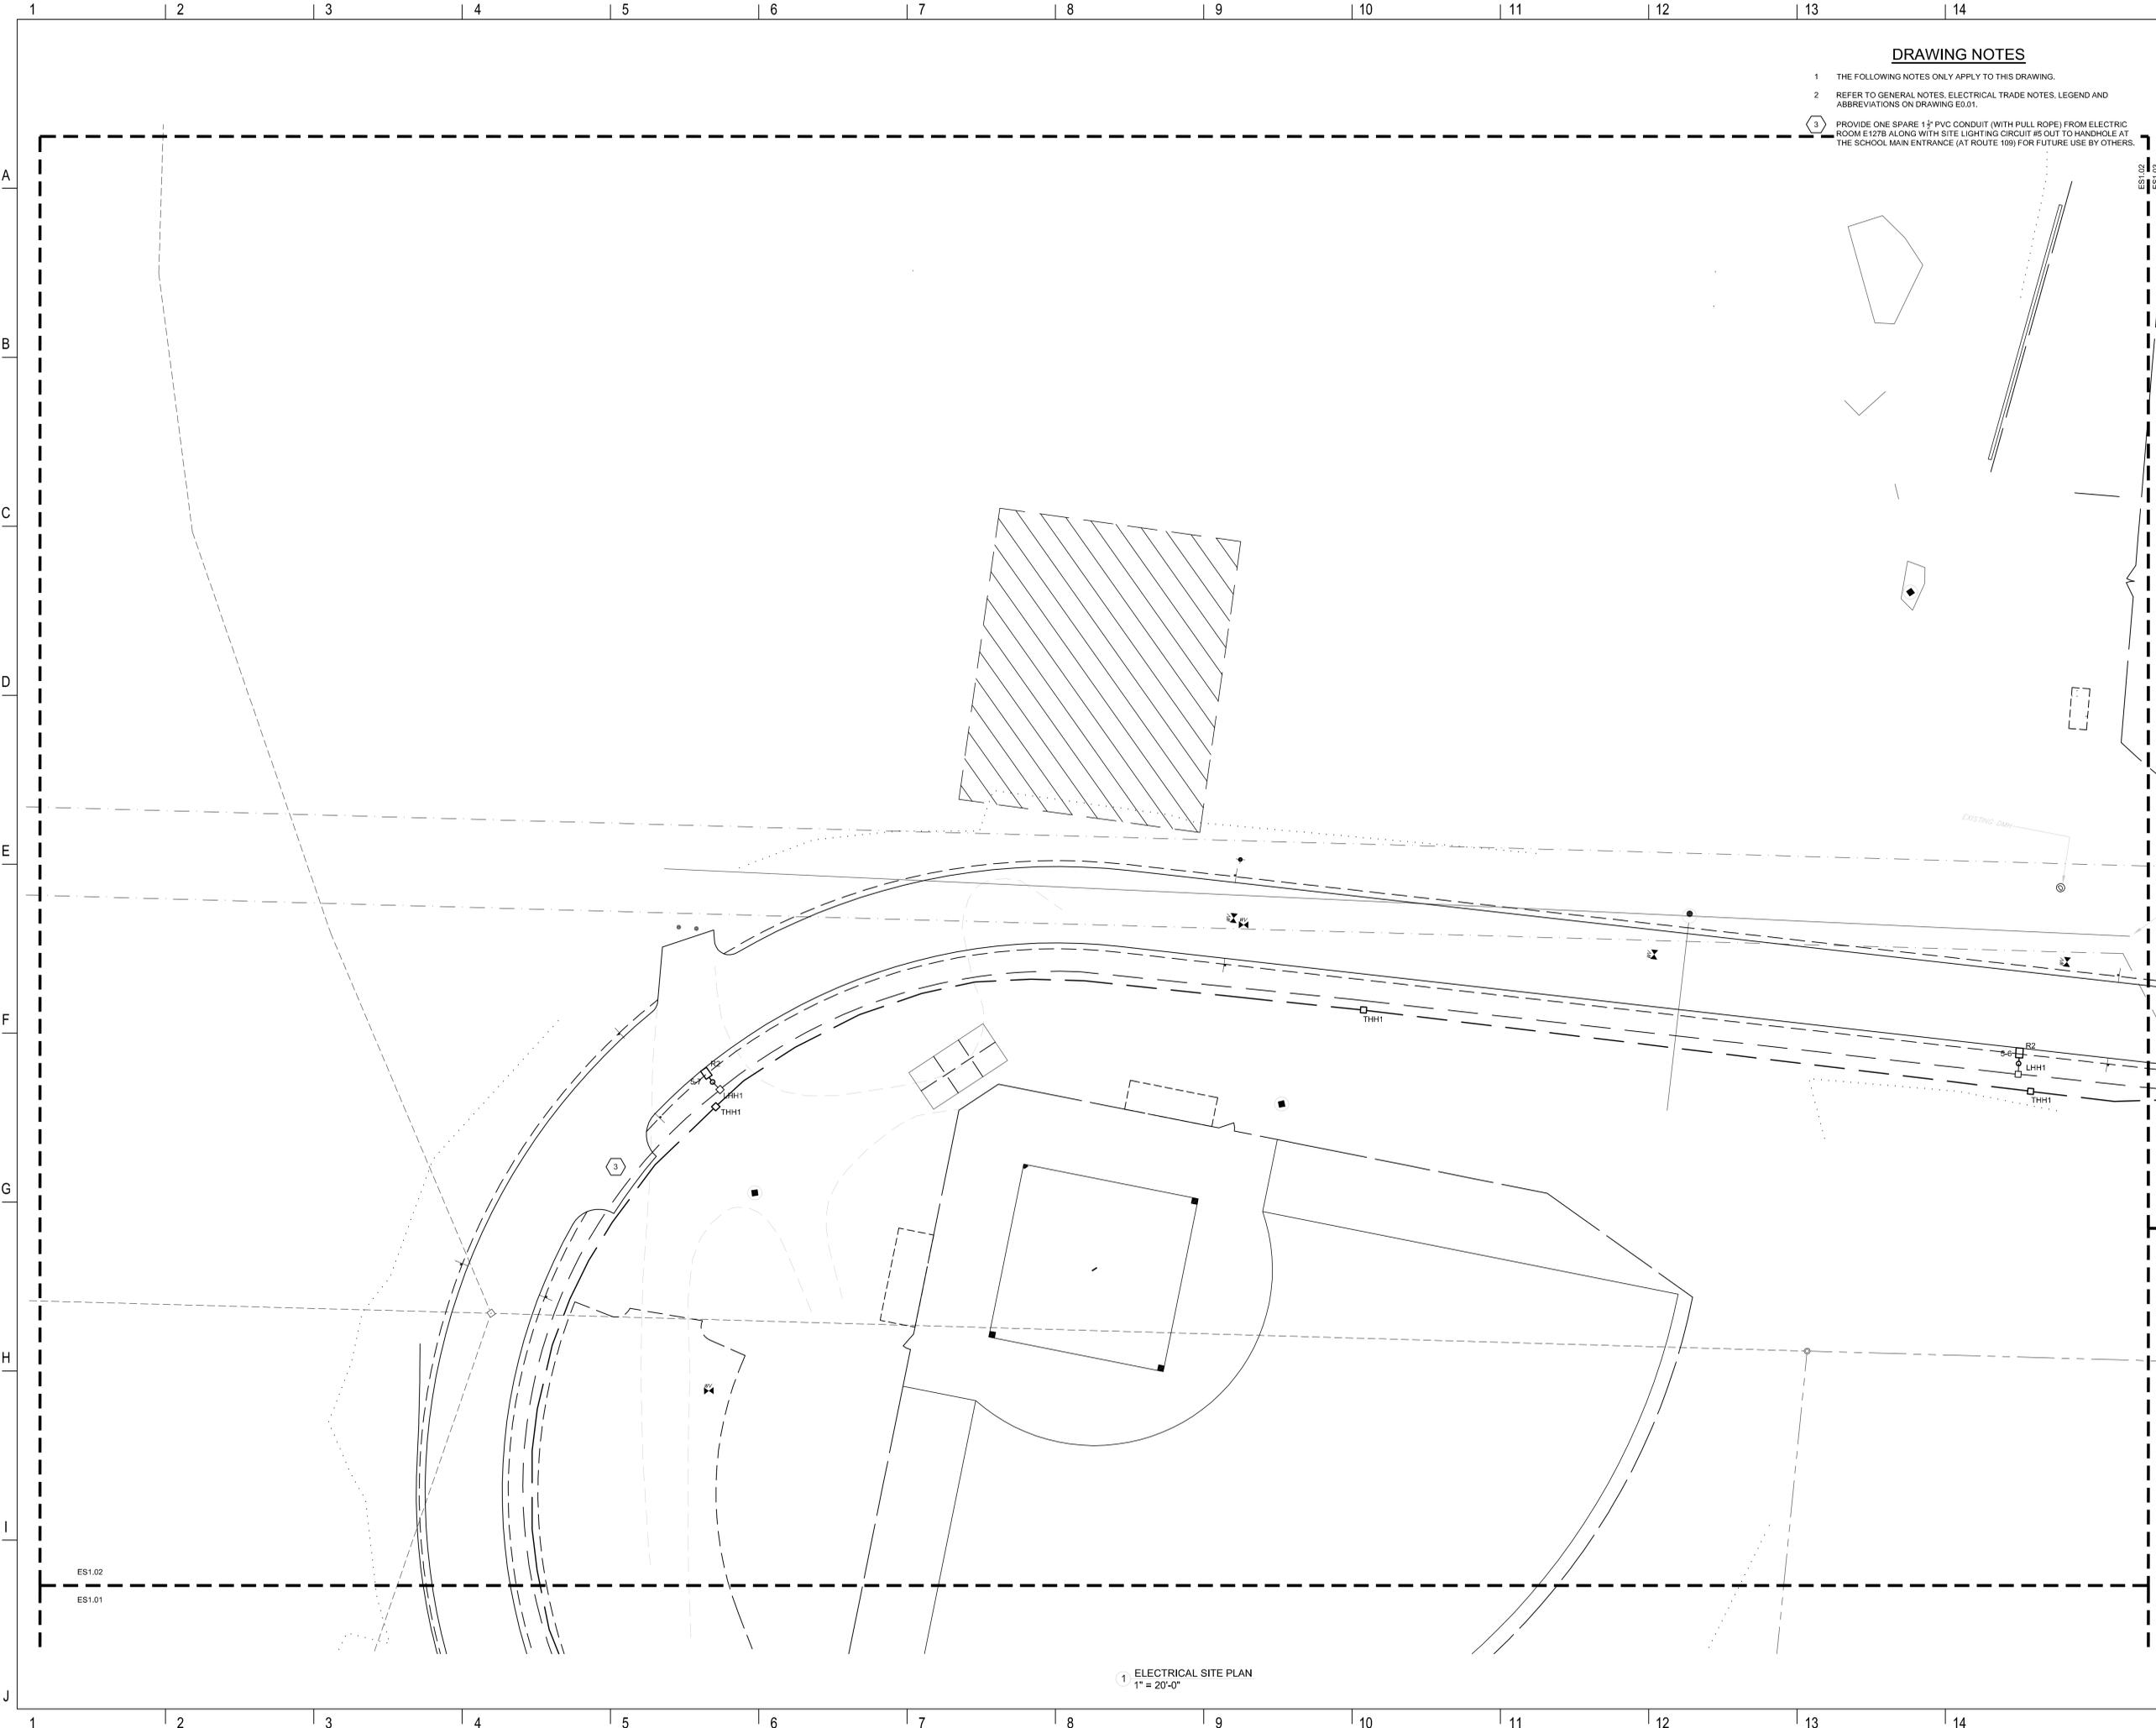

**DRAWING NOTES**

- 1 THE FOLLOWING NOTES ONLY APPLY TO THIS DRAWING.
- 2 REFER TO GENERAL NOTES, ELECTRICAL TRADE NOTES, LEGEND AND ABBREVIATIONS ON DRAWING E0.01.
- 3 PROVIDE ONE SPARE 1 1/2" PVC CONDUIT (WITH PULL ROPE) FROM ELECTRIC ROOM E127B ALONG WITH SITE LIGHTING CIRCUIT #5 OUT TO HANDHOLE AT THE SCHOOL MAIN ENTRANCE (AT ROUTE 109) FOR FUTURE USE BY OTHERS.

**LAVALLEE BRENSINGER ARCHITECTS**  
 Boston | Manchester | Portland  
 155 Dow Street, Suite 400, Manchester, NH 03101  
 603.622.5450  
 305 Commercial Street, Portland, ME 04101  
 207.558.7200  
 www.LBPA.com

**RFS engineering**  
 Rist Frost Shumway Engineering, P.C.  
 NH: 71 Water St.  
 Lacrosse, NH 03245  
 P: 603.524.4647  
 MA: 53 Milk St., 18th Floor  
 Boston, MA 02109  
 P: 617.494.1464  
 www.rfsengineering.com  
 RFS Project #: 7300.001

Sanford School Department and  
 State of Maine Department of  
 Education

**SANFORD HIGH SCHOOL and TECHNICAL CENTER**

SANFORD, ME 04073


NO.	DESCRIPTION	DATE
3	ADDENDUM #3	2016-03-04

FOR ADDITIONAL INFORMATION, REFER TO PROJECT MANUAL.

CONTENT: ELECTRICAL SITE PLAN	
DRAWN BY:	C. NEWELL
PROJECT NO.:	12-067-00
DATE:	02/11/2016
REVISED:	
SCALE:	AS NOTED
<b>ES1.02</b>	
Project Phase <b>BID DOCUMENTS</b>	
COPYRIGHT © 2016 BY LAVALLEEBRENSINGER PROFESSIONAL ASSOCIATION. ALL RIGHTS RESERVED. NO REPRODUCTION WITHOUT PERMISSION.	

1 ELECTRICAL SITE PLAN  
 1" = 20'-0"

ES1.02  
 ES1.01

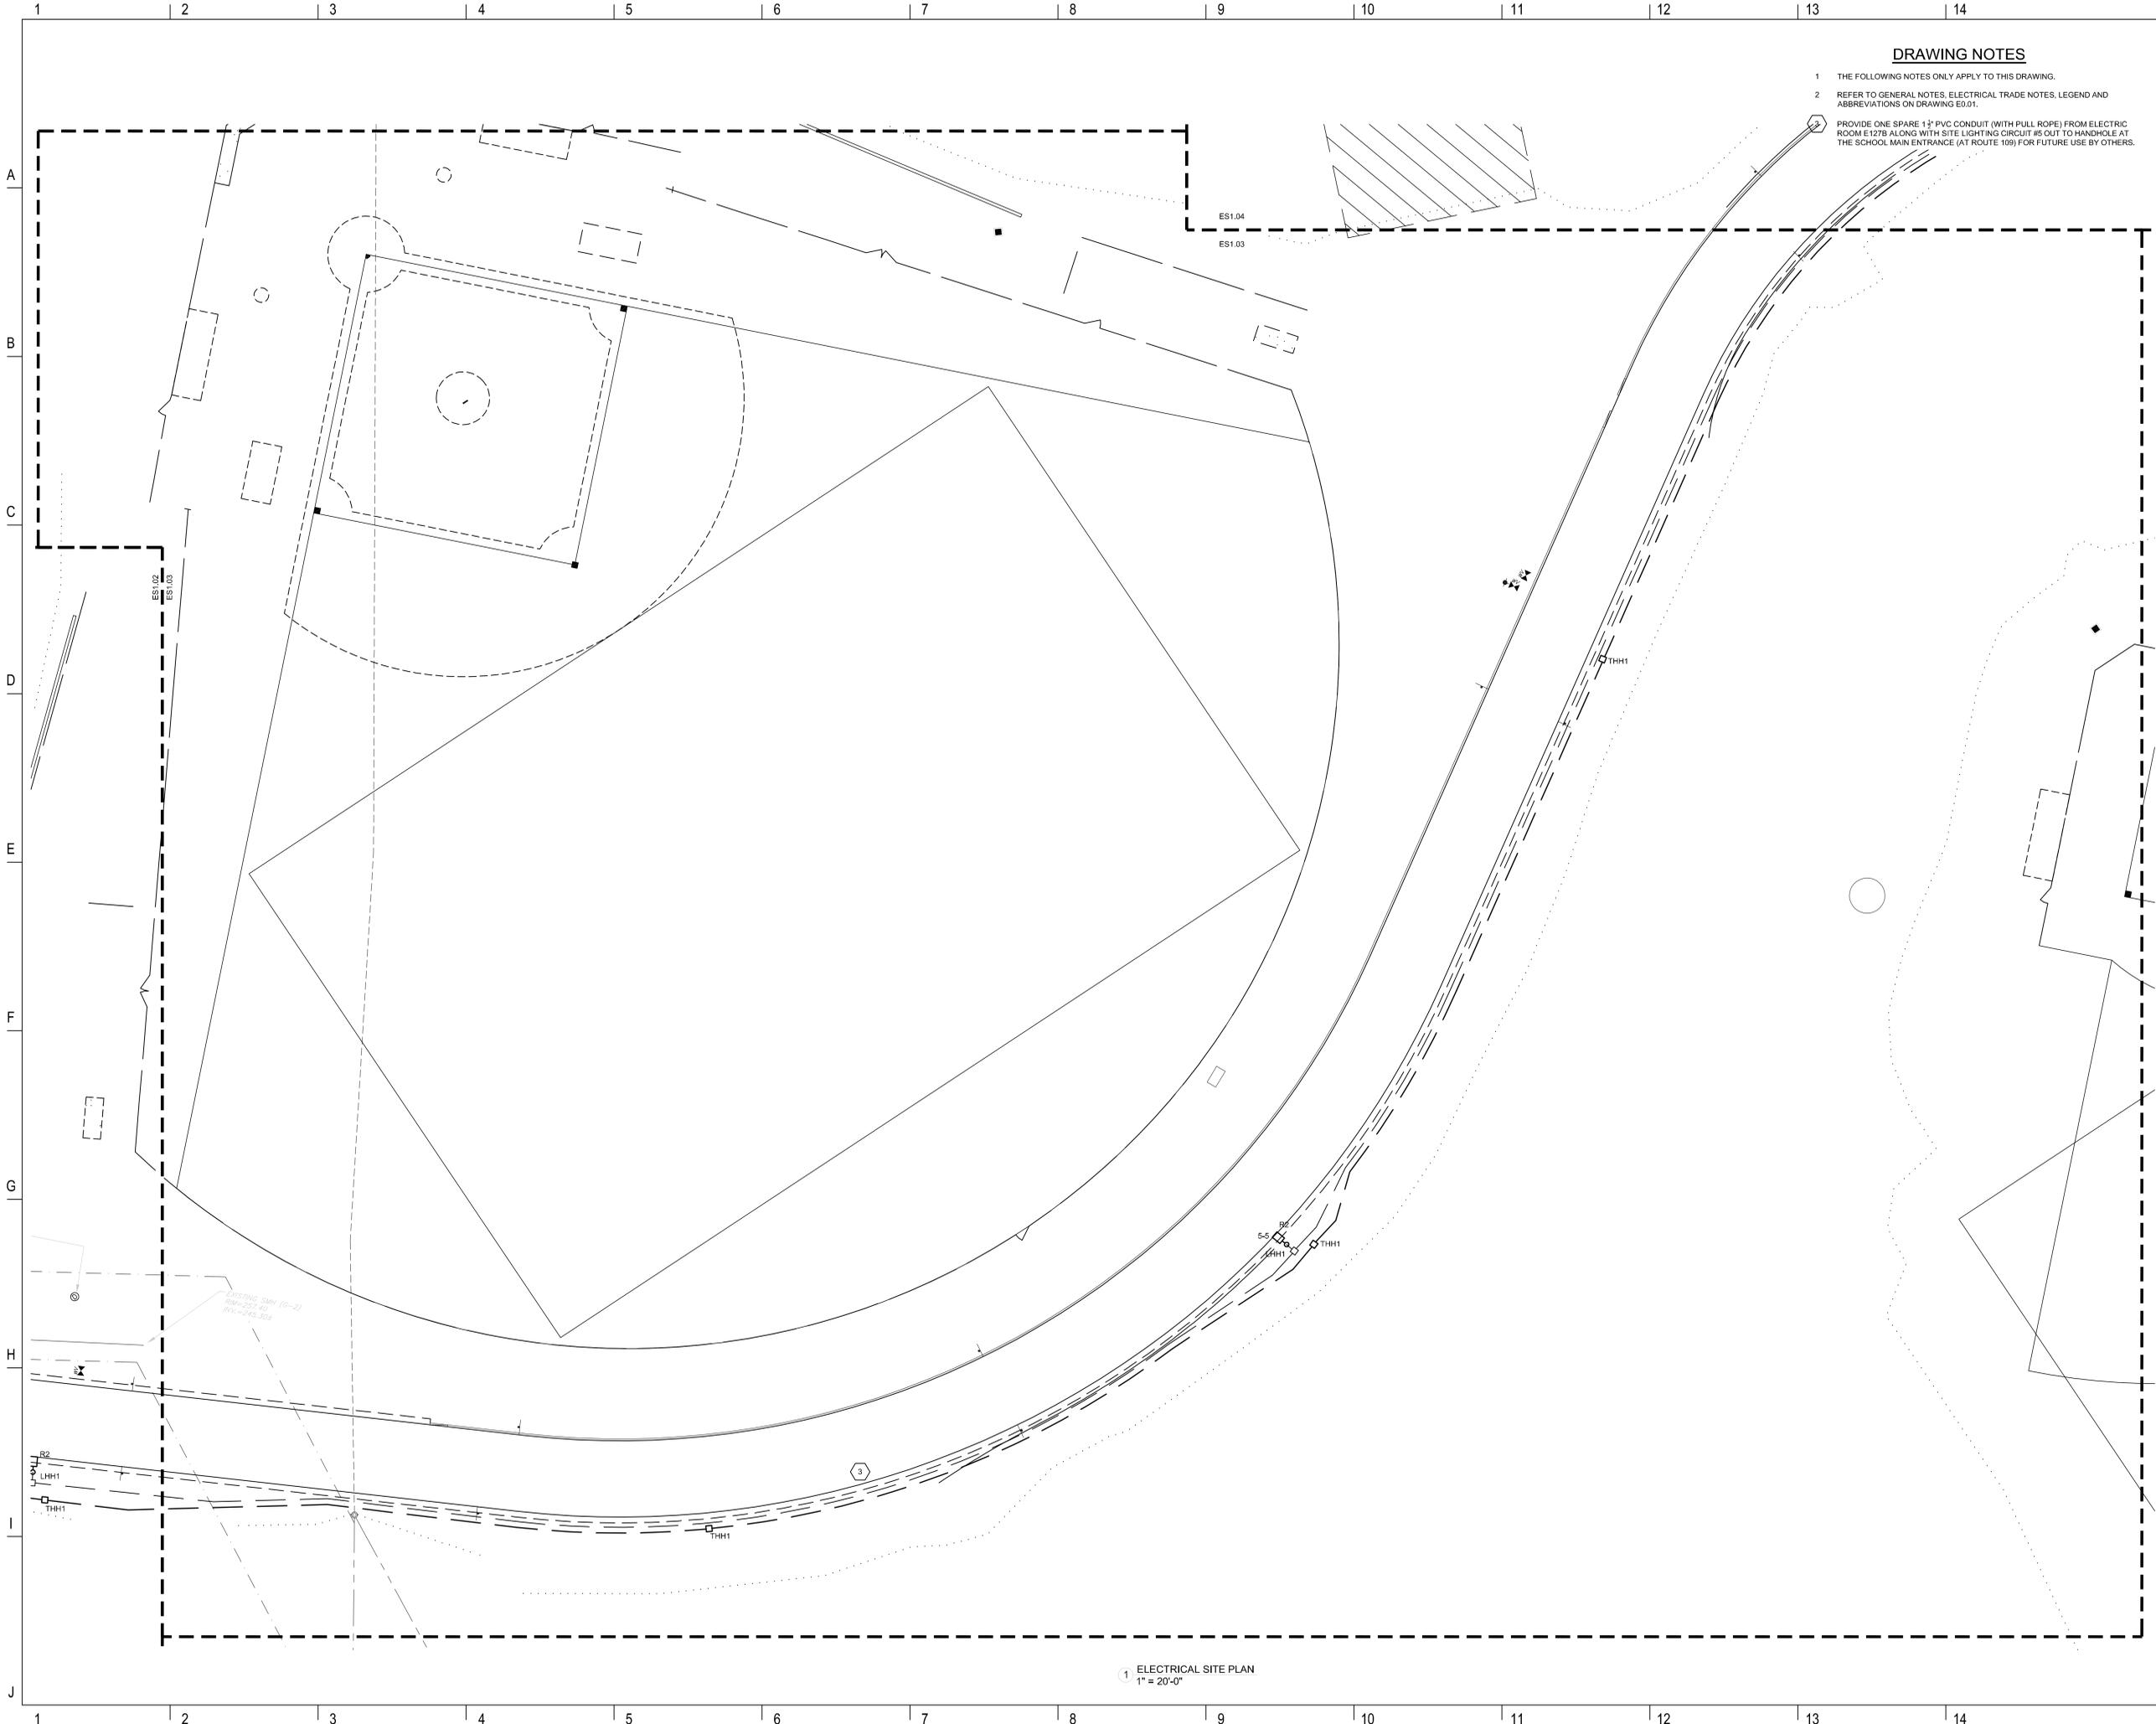


**DRAWING NOTES**

- 1 THE FOLLOWING NOTES ONLY APPLY TO THIS DRAWING.
  - 2 REFER TO GENERAL NOTES, ELECTRICAL TRADE NOTES, LEGEND AND ABBREVIATIONS ON DRAWING E0.01.
- PROVIDE ONE SPARE 1 1/2" PVC CONDUIT (WITH PULL ROPE) FROM ELECTRIC ROOM E127B ALONG WITH SITE LIGHTING CIRCUIT #5 OUT TO HANDHOLE AT THE SCHOOL MAIN ENTRANCE (AT ROUTE 109) FOR FUTURE USE BY OTHERS.

**LAVALLEE BRENSINGER ARCHITECTS**  
 Boston | Manchester | Portland  
 155 Dow Street, Suite 400, Manchester, NH 03101  
 603.622.5450  
 305 Commercial Street, Portland, ME 04101  
 207.558.7200  
 www.LBPA.com

**RFS engineering**  
 Risk Frost Shumway Engineering, P.C.  
 NH: 71 Water St  
 Lacrosse, NH 03245  
 P: 603.524.4647  
 MA: 53 Milk St, 18th Floor  
 Boston, MA 02109  
 P: 617.494.1464  
 www.rfsengineering.com  
 RFS Project #: 7300.001

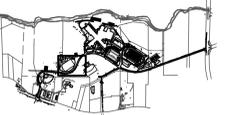

Sanford School Department and  
 State of Maine Department of  
 Education

**SANFORD HIGH SCHOOL and TECHNICAL CENTER**


SANFORD, ME 04073

NO.	DESCRIPTION	DATE
3	ADDENDUM #3	2016-03-04

CONTENT: ELECTRICAL SITE PLAN	
DRAWN BY:	C. NEWELL
PROJECT NO.:	12-067-00
DATE:	02/11/2016
REVISED:	
SCALE:	AS NOTED
<b>ES1.03</b>	
Project Phase	
BID DOCUMENTS	
<small>COPYRIGHT © 2016 BY LAVALLEEBRENSINGER PROFESSIONAL ASSOCIATION. ALL RIGHTS RESERVED. NO REPRODUCTION WITHOUT PERMISSION.</small>	

1 ELECTRICAL SITE PLAN  
 1" = 20'-0"



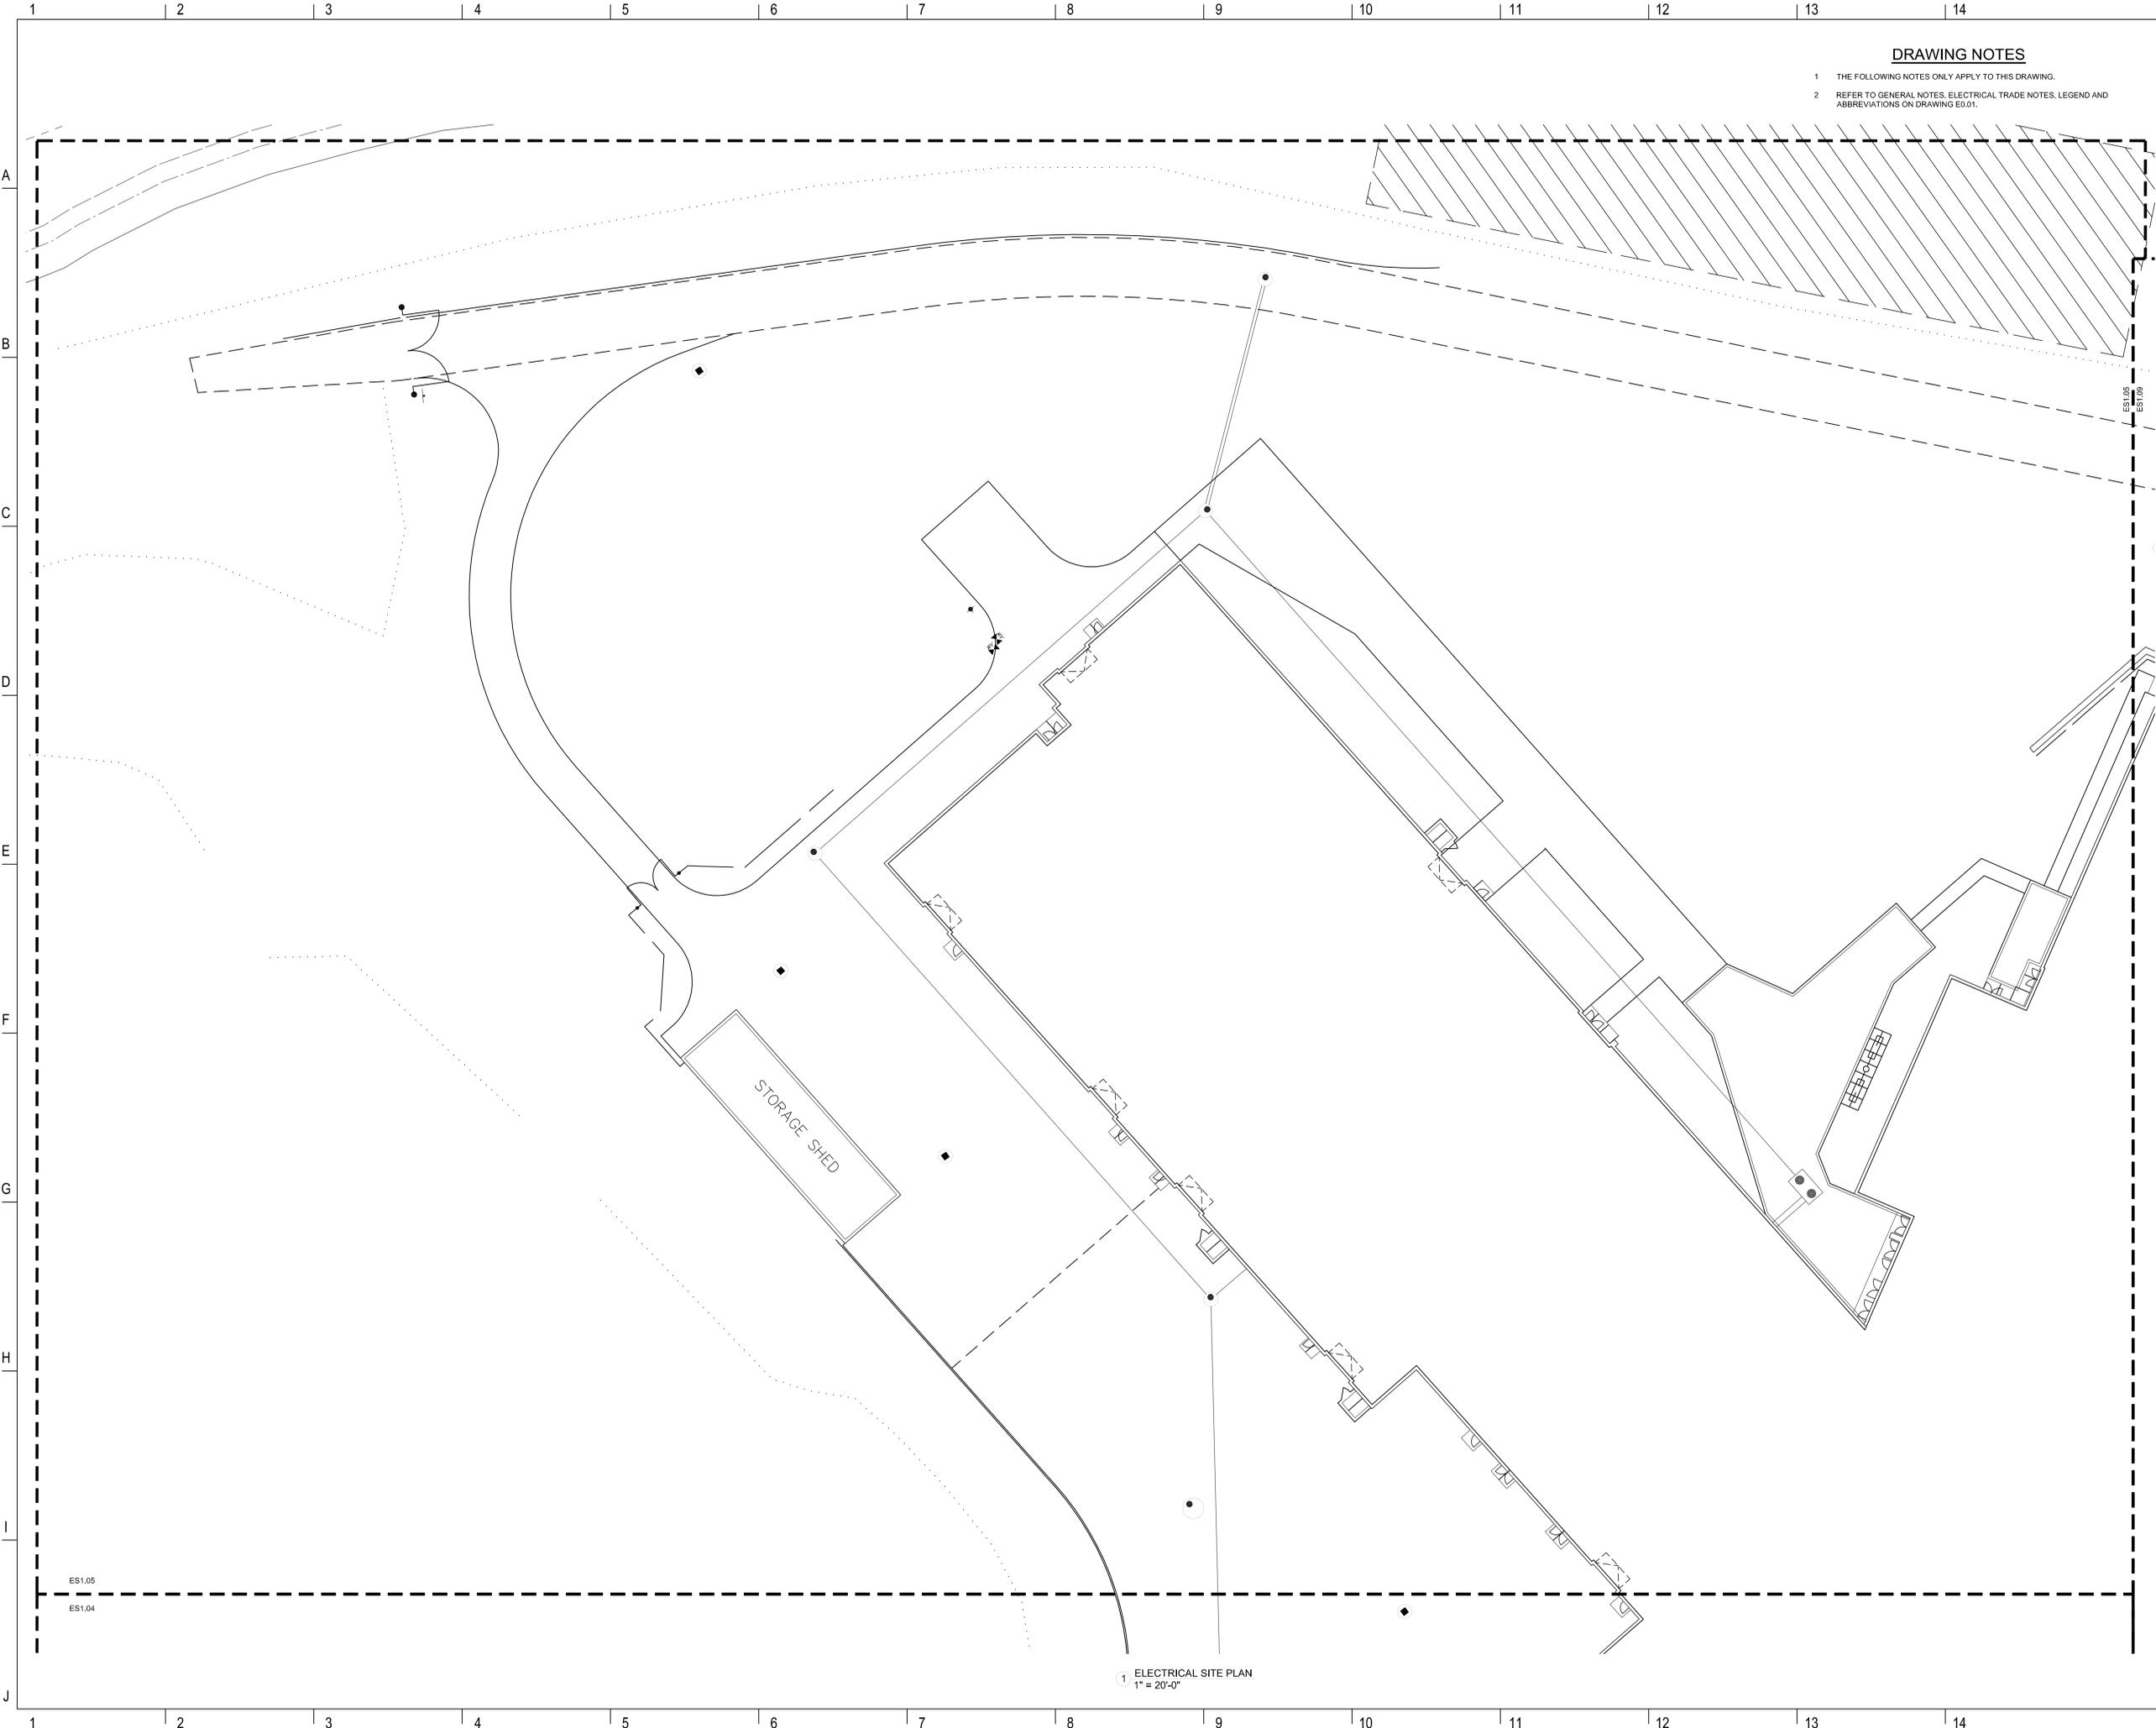


**DRAWING NOTES**

- 1 THE FOLLOWING NOTES ONLY APPLY TO THIS DRAWING.
- 2 REFER TO GENERAL NOTES, ELECTRICAL TRADE NOTES, LEGEND AND ABBREVIATIONS ON DRAWING E0.01.

**LAVALLEE BRENSINGER ARCHITECTS**  
 Boston | Manchester | Portland  
 155 Dow Street, Suite 400, Manchester, NH 03101  
 603.622.5450  
 305 Commercial Street, Portland, ME 04101  
 207.558.7200  
 www.LBPA.com

**RFS engineering**  
 Rist Frost Shumway Engineering, P.C.  
 NH: 71 Water St.  
 Laconia, NH 03245  
 P: 603.524.4647  
 MA: 53 Milk St., 18th Floor  
 Boston, MA 02109  
 P: 617.494.1464  
 www.rfsengineering.com  
 RFS Project #: 7300.001

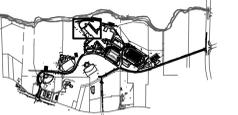

Sanford School Department and  
 State of Maine Department of  
 Education

**SANFORD HIGH SCHOOL and  
 TECHNICAL CENTER**

SANFORD, ME 04073


NO.	DESCRIPTION	DATE
3	ADDENDUM #3	2016-03-04

FOR ADDITIONAL INFORMATION, REFER TO PROJECT MANUAL.

CONTENT: ELECTRICAL SITE PLAN	
DRAWN BY:	C. NEWELL
PROJECT NO.:	12-067-00
DATE:	02/11/2016
REVISED:	
SCALE:	AS NOTED
<b>ES1.05</b>	
Project Phase	
<b>BID DOCUMENTS</b>	
<small>COPYRIGHT © 2016 BY LAVALLEEBRENSINGER PROFESSIONAL ASSOCIATION. ALL RIGHTS RESERVED. NO REPRODUCTION WITHOUT PERMISSION.</small>	

1 ELECTRICAL SITE PLAN  
 1" = 20'-0"

ES1.05  
 ES1.04

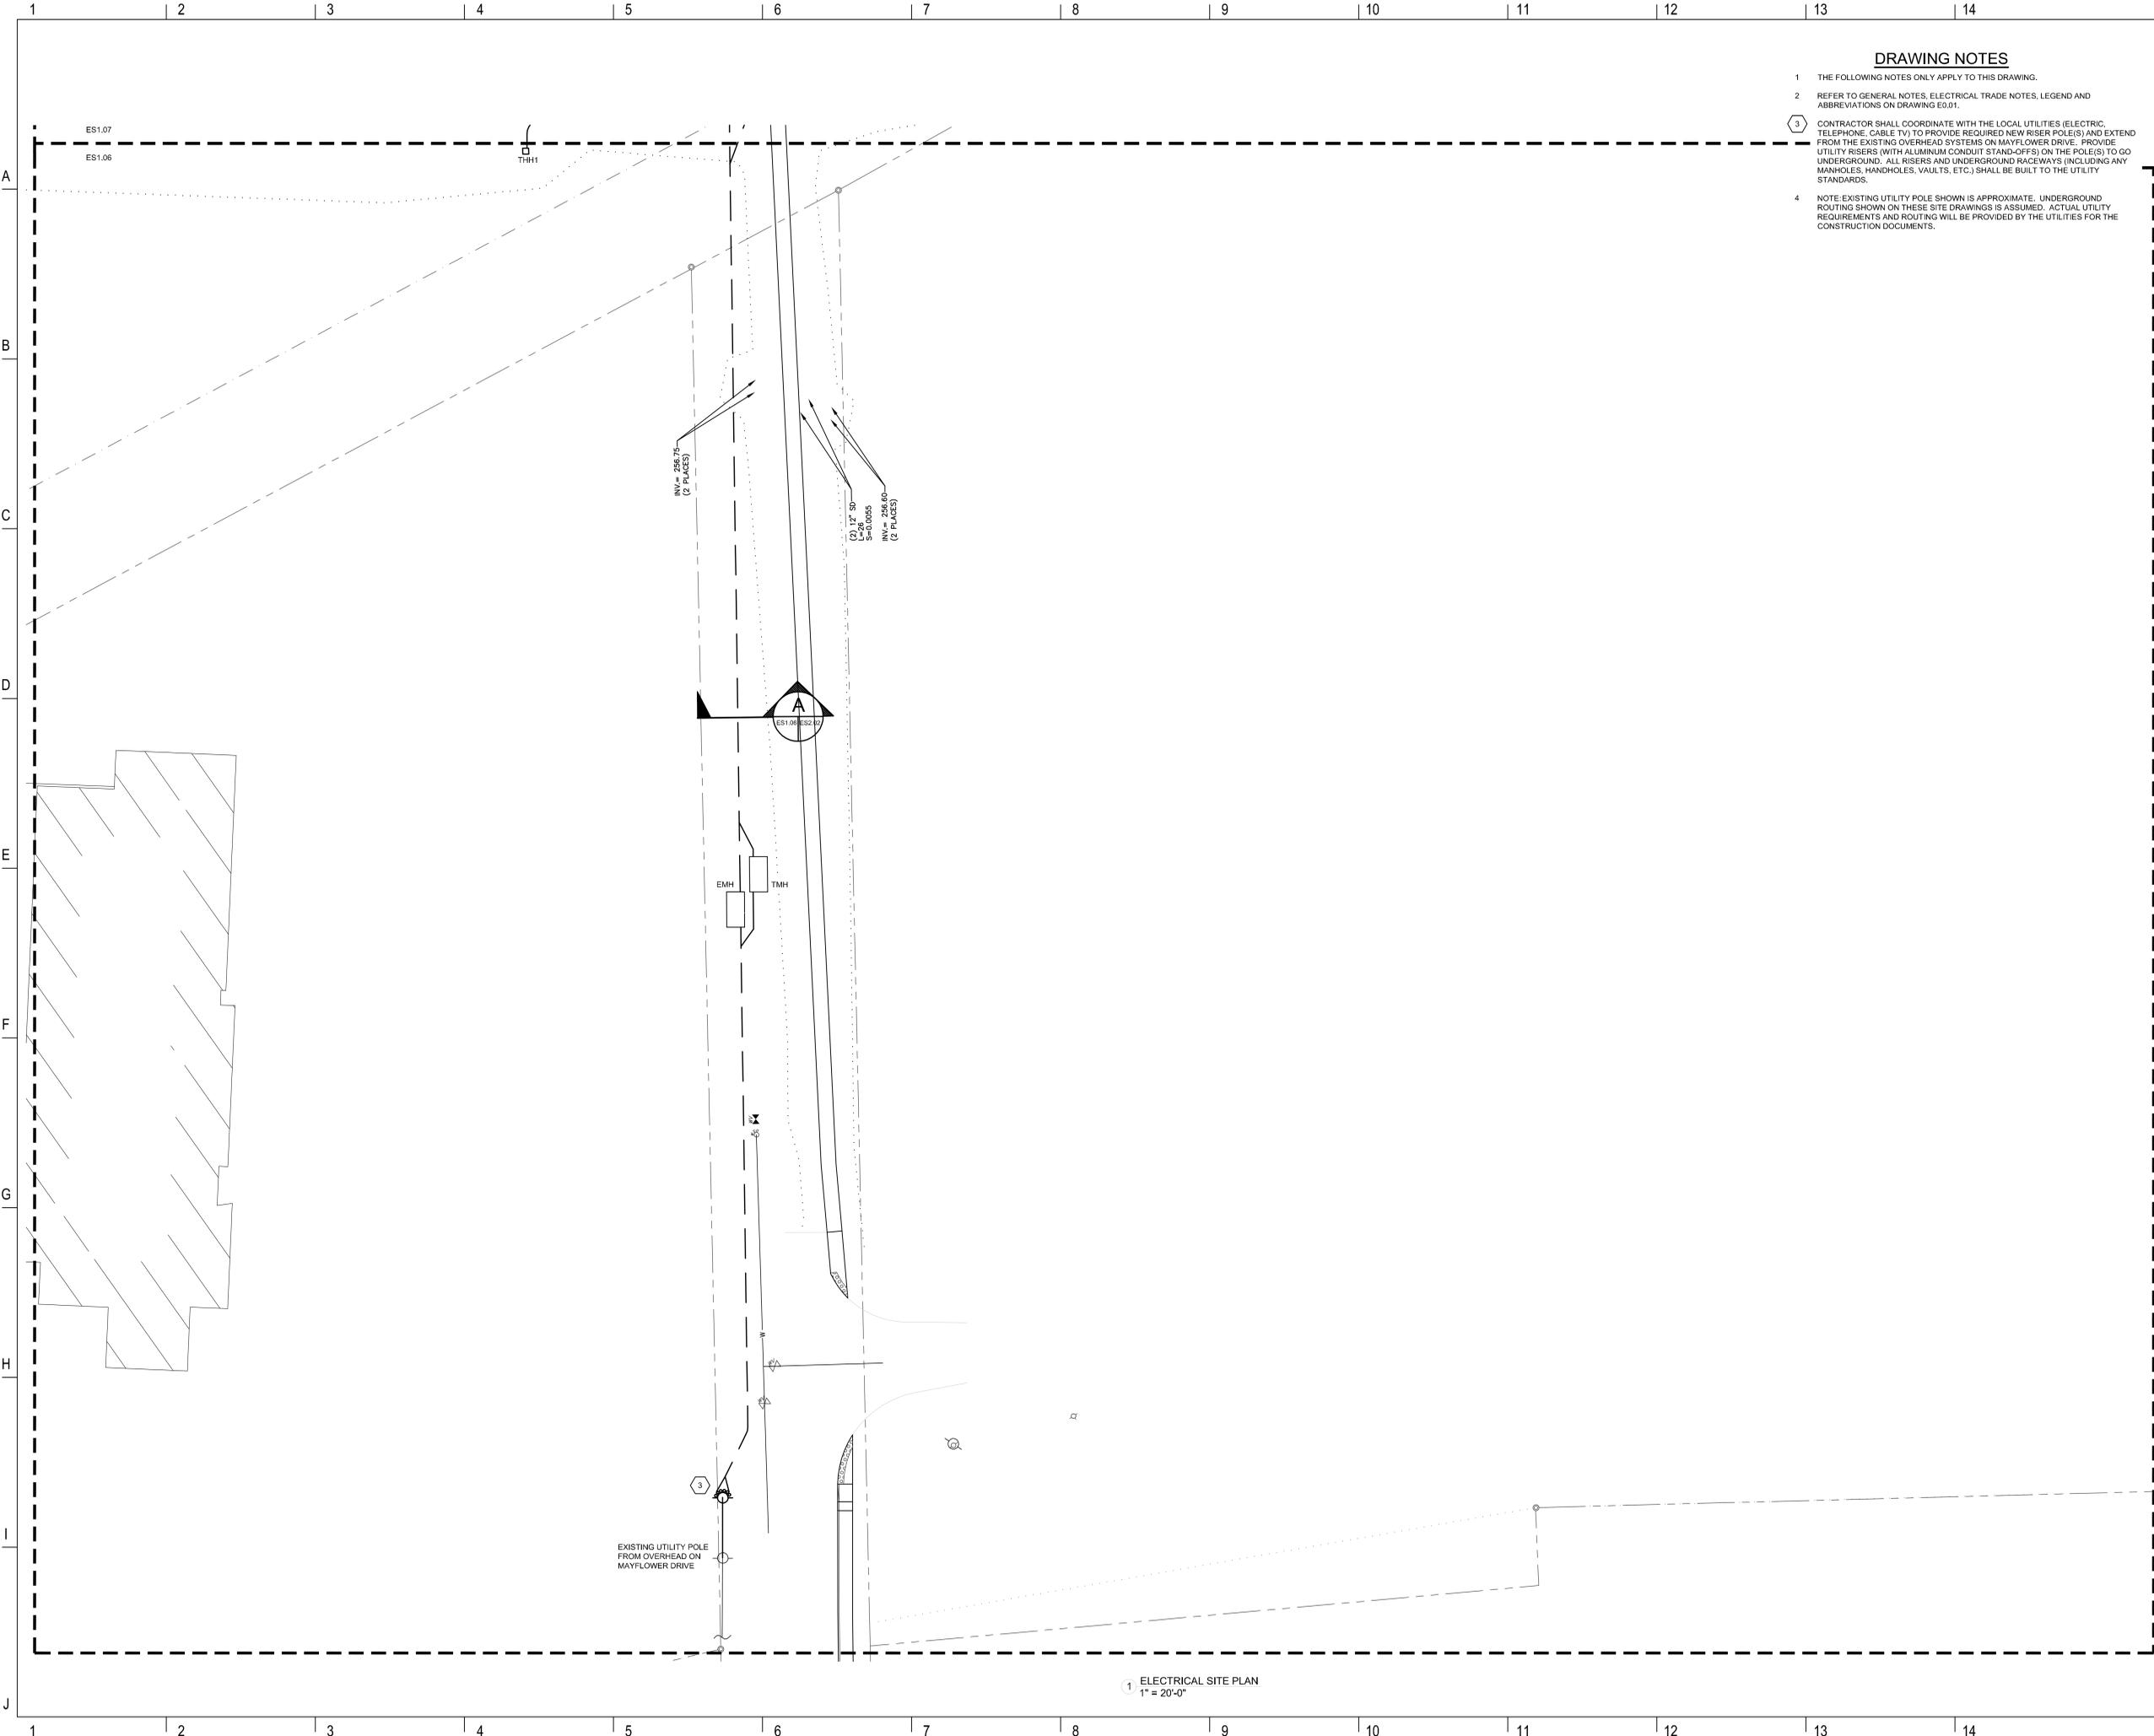


**DRAWING NOTES**


- 1 THE FOLLOWING NOTES ONLY APPLY TO THIS DRAWING.
- 2 REFER TO GENERAL NOTES, ELECTRICAL TRADE NOTES, LEGEND AND ABBREVIATIONS ON DRAWING E0.01.
- 3 CONTRACTOR SHALL COORDINATE WITH THE LOCAL UTILITIES (ELECTRIC, TELEPHONE, CABLE TV) TO PROVIDE REQUIRED NEW RISER POLE(S) AND EXTEND FROM THE EXISTING OVERHEAD SYSTEMS ON MAYFLOWER DRIVE. PROVIDE UTILITY RISERS (WITH ALUMINUM CONDUIT STAND-OFFS) ON THE POLE(S) TO GO UNDERGROUND. ALL RISERS AND UNDERGROUND RACEWAYS (INCLUDING ANY MANHOLES, HANDHOLES, VAULTS, ETC.) SHALL BE BUILT TO THE UTILITY STANDARDS.
- 4 NOTE: EXISTING UTILITY POLE SHOWN IS APPROXIMATE. UNDERGROUND ROUTING SHOWN ON THESE SITE DRAWINGS IS ASSUMED. ACTUAL UTILITY REQUIREMENTS AND ROUTING WILL BE PROVIDED BY THE UTILITIES FOR THE CONSTRUCTION DOCUMENTS.

**LAVALLEE  
BRENSINGER**  
ARCHITECTS  
Boston | Manchester | Portland

155 Dow Street, Suite 400, Manchester, NH 03101  
603.622.5450  
305 Commercial Street, Portland, ME 04101  
207.558.7200  
www.LBPA.com

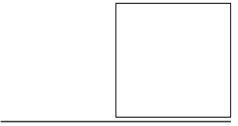

**RFS**  
engineering  
Rist Frost Shumway Engineering, P.C.  
NH: 71 Water St.  
Laconia, NH 03245  
P: 603.524.4647  
MA: 50 Milk St., 18th Floor  
Boston, MA 02109  
P: 617.494.1464  
www.rfsengineering.com  
RFS Project #: 7300.001

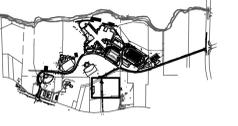

Sanford School Department and  
State of Maine Department of  
Education


**SANFORD HIGH  
SCHOOL and  
TECHNICAL CENTER**

SANFORD, ME 04073

NO.	DESCRIPTION	DATE
3	ADDENDUM #3	2016-03-04

CONTENT: ELECTRICAL SITE PLAN	
DRAWN BY:	C. NEWELL
PROJECT NO.:	12-067-00
DATE:	02/11/2016
REVISED:	
SCALE:	AS NOTED
<b>ES1.06</b>	
Project Phase <b>BID DOCUMENTS</b>	
COPYRIGHT © 2016 BY LAVALLEEBRENSINGER PROFESSIONAL ASSOCIATION. ALL RIGHTS RESERVED. NO REPRODUCTION WITHOUT PERMISSION.	

1 ELECTRICAL SITE PLAN  
1" = 20'-0"

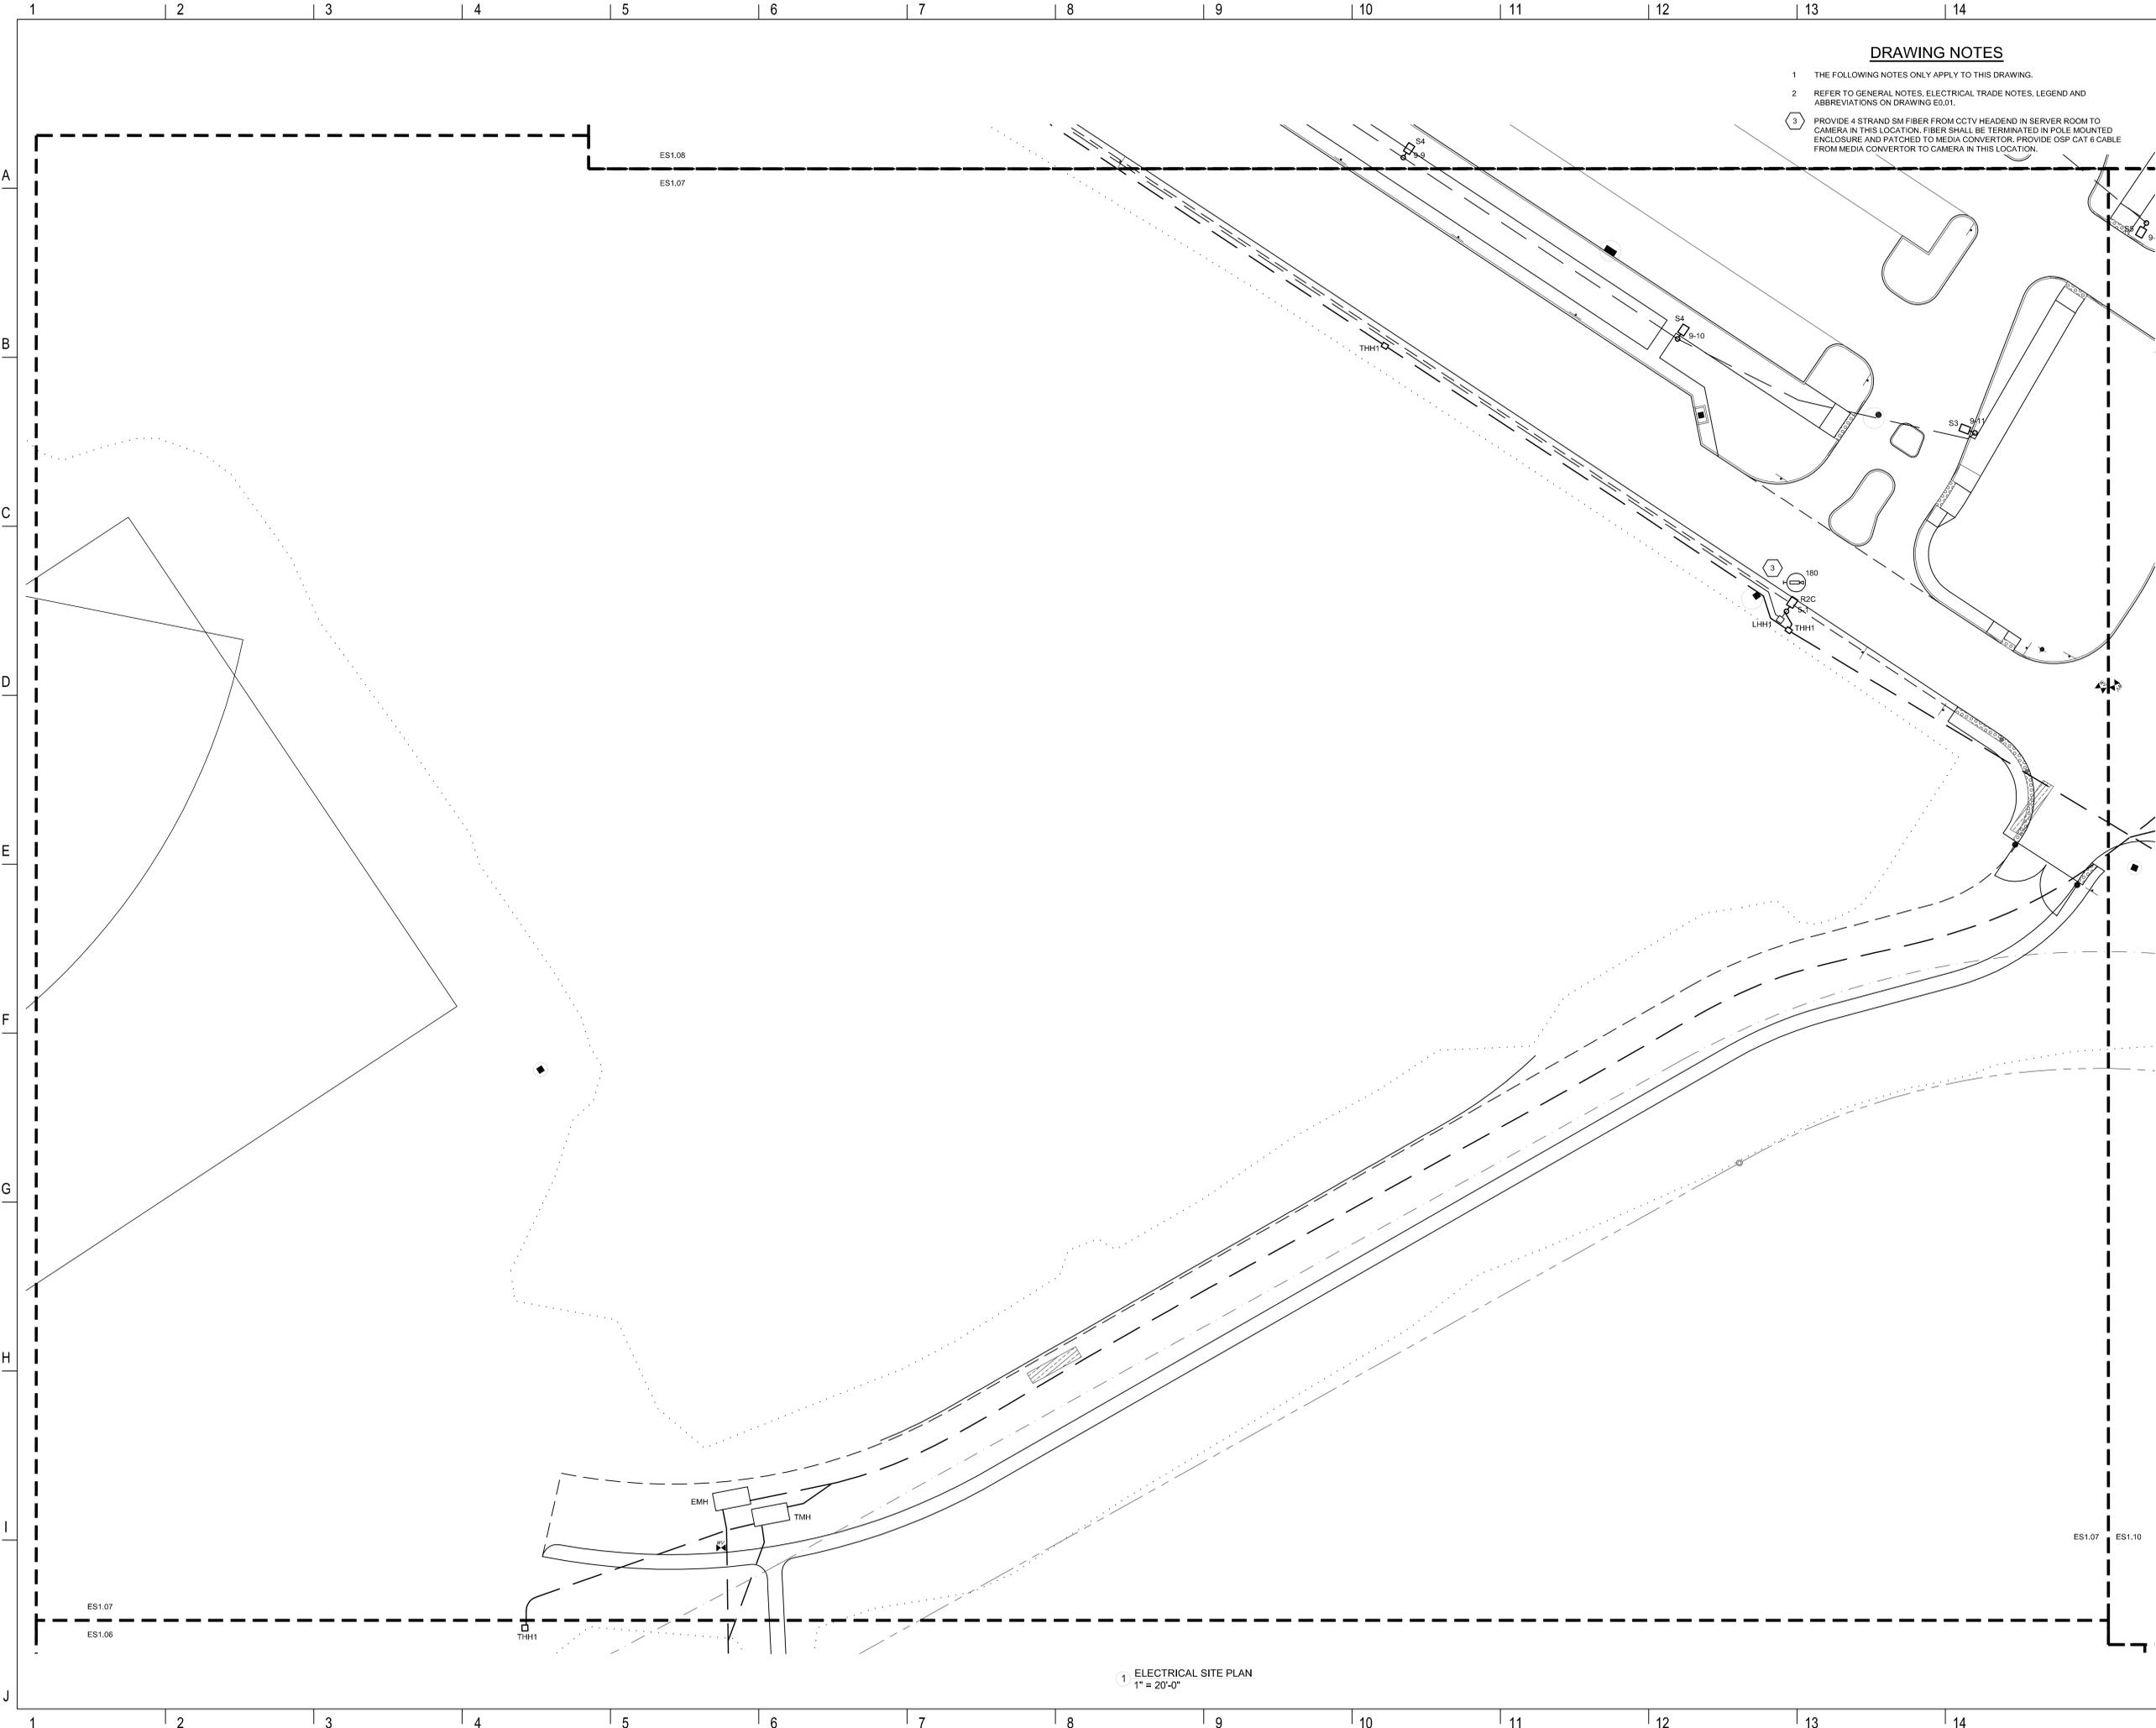


**DRAWING NOTES**

- 1 THE FOLLOWING NOTES ONLY APPLY TO THIS DRAWING.
- 2 REFER TO GENERAL NOTES, ELECTRICAL TRADE NOTES, LEGEND AND ABBREVIATIONS ON DRAWING E0.01.
- 3 PROVIDE 4 STRAND SM FIBER FROM CCTV HEADEND IN SERVER ROOM TO CAMERA IN THIS LOCATION. FIBER SHALL BE TERMINATED IN POLE MOUNTED ENCLOSURE AND PATCHED TO MEDIA CONVERTOR. PROVIDE OSP CAT 6 CABLE FROM MEDIA CONVERTOR TO CAMERA IN THIS LOCATION.

**LAVALLEE  
BRENSINGER**  
ARCHITECTS  
Boston | Manchester | Portland  
155 Dow Street, Suite 400, Manchester, NH 03101  
603.622.5450  
305 Commercial Street, Portland, ME 04101  
207.558.7200  
www.LBPA.com

**RFS**  
*engineering*  
Ris Frost Shumway Engineering, P.C.  
NH: 71 Water St.  
Lacrosse, NH 03245  
P: 603.524.4647  
MA: 53 Milk St., 18th Floor  
Boston, MA 02109  
P: 617.494.1464  
www.rfsengineering.com  
RFS Project #: 7300.001

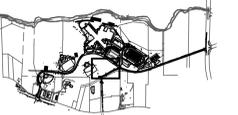

Sanford School Department and  
State of Maine Department of  
Education

**SANFORD HIGH  
SCHOOL and  
TECHNICAL CENTER**

SANFORD, ME 04073


NO.	DESCRIPTION	DATE
3	ADDENDUM #3	2016-03-04

FOR ADDITIONAL INFORMATION, REFER TO PROJECT MANUAL.

CONTENT: ELECTRICAL SITE PLAN	
DRAWN BY:	C. NEWELL
PROJECT NO.:	12-067-00
DATE:	02/11/2016
REVISED:	
SCALE:	AS NOTED
<b>ES1.07</b>	
Project Phase	
<b>BID DOCUMENTS</b>	
COPYRIGHT © 2016 BY LAVALLEEBRENSINGER PROFESSIONAL ASSOCIATION. ALL RIGHTS RESERVED. NO REPRODUCTION WITHOUT PERMISSION.	

1 ELECTRICAL SITE PLAN  
1" = 20'-0"



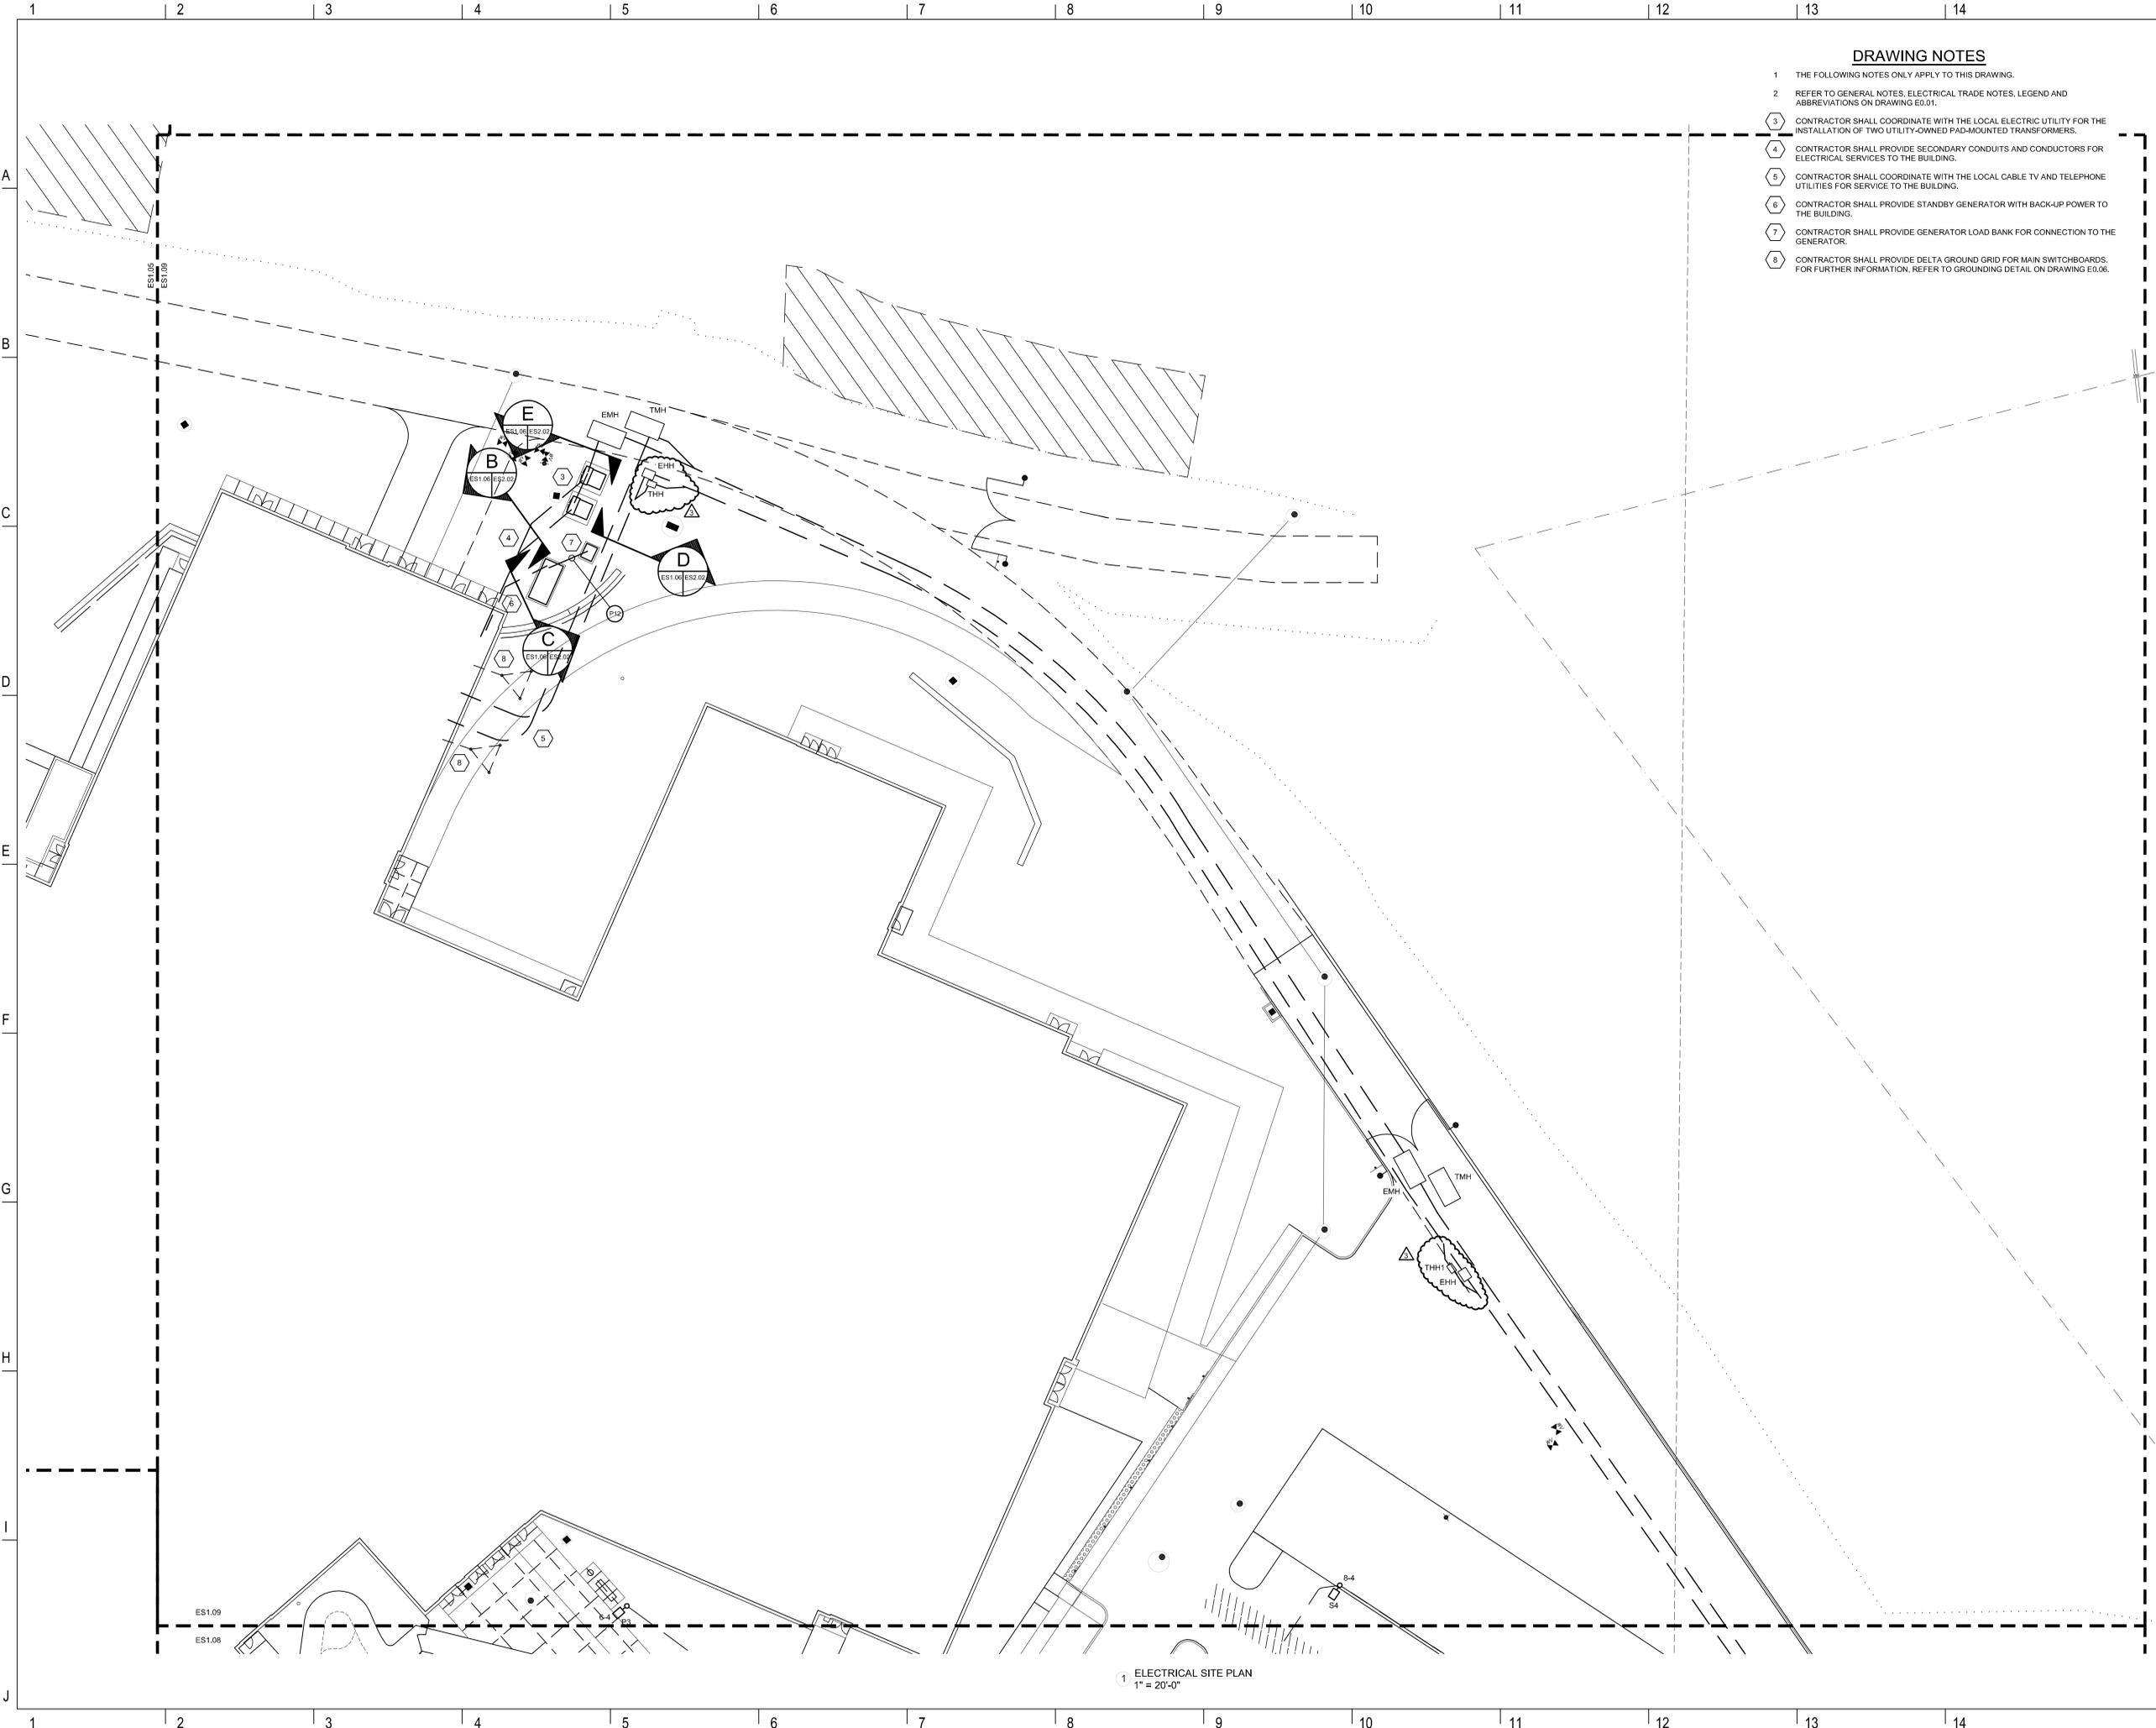

**DRAWING NOTES**


- 1 THE FOLLOWING NOTES ONLY APPLY TO THIS DRAWING.
- 2 REFER TO GENERAL NOTES, ELECTRICAL TRADE NOTES, LEGEND AND ABBREVIATIONS ON DRAWING E0.01.
- 3 CONTRACTOR SHALL COORDINATE WITH THE LOCAL ELECTRIC UTILITY FOR THE INSTALLATION OF TWO UTILITY-OWNED PAD-MOUNTED TRANSFORMERS.
- 4 CONTRACTOR SHALL PROVIDE SECONDARY CONDUITS AND CONDUCTORS FOR ELECTRICAL SERVICES TO THE BUILDING.
- 5 CONTRACTOR SHALL COORDINATE WITH THE LOCAL CABLE TV AND TELEPHONE UTILITIES FOR SERVICE TO THE BUILDING.
- 6 CONTRACTOR SHALL PROVIDE STANDBY GENERATOR WITH BACK-UP POWER TO THE BUILDING.
- 7 CONTRACTOR SHALL PROVIDE GENERATOR LOAD BANK FOR CONNECTION TO THE GENERATOR.
- 8 CONTRACTOR SHALL PROVIDE DELTA GROUND GRID FOR MAIN SWITCHBOARDS. FOR FURTHER INFORMATION, REFER TO GROUNDING DETAIL ON DRAWING E0.06.

**LAVALLEE  
BRENSINGER**

**ARCHITECTS**

Boston | Manchester | Portland  
 155 Dow Street, Suite 400, Manchester, NH 03101  
 603.622.5450  
 305 Commercial Street, Portland, ME 04101  
 207.558.7200  
 www.LBPA.com

**RFS**  
*engineering*  
 Rist Frost Shumway Engineering, P.C.  
 NH: 71 Water St.  
 Lacrosse, NH 03245  
 P: 603.524.4647  
 MA: 50 Milk St., 18th Floor  
 Boston, MA 02109  
 P: 617.494.1464  
 www.rfsengineering.com  
 RFS Project #: 7300.001

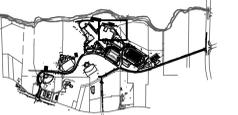

Sanford School Department and  
 State of Maine Department of  
 Education

**SANFORD HIGH  
 SCHOOL and  
 TECHNICAL CENTER**


SANFORD, ME 04073

NO.	DESCRIPTION	DATE
3	ADDENDUM #3	2016-03-04

FOR ADDITIONAL INFORMATION, REFER TO PROJECT MANUAL.

CONTENT:	ELECTRICAL SITE PLAN
DRAWN BY:	C. NEWELL
PROJECT NO.:	12-067-00
DATE:	02/11/2016
REVISED:	
SCALE:	AS NOTED
<b>ES1.09</b>	
Project Phase:	
BID DOCUMENTS	
COPYRIGHT © 2016 BY LAVALLEEBRENSINGER PROFESSIONAL ASSOCIATION. ALL RIGHTS RESERVED. NO REPRODUCTION WITHOUT PERMISSION.	

1 ELECTRICAL SITE PLAN  
 1" = 20'-0"

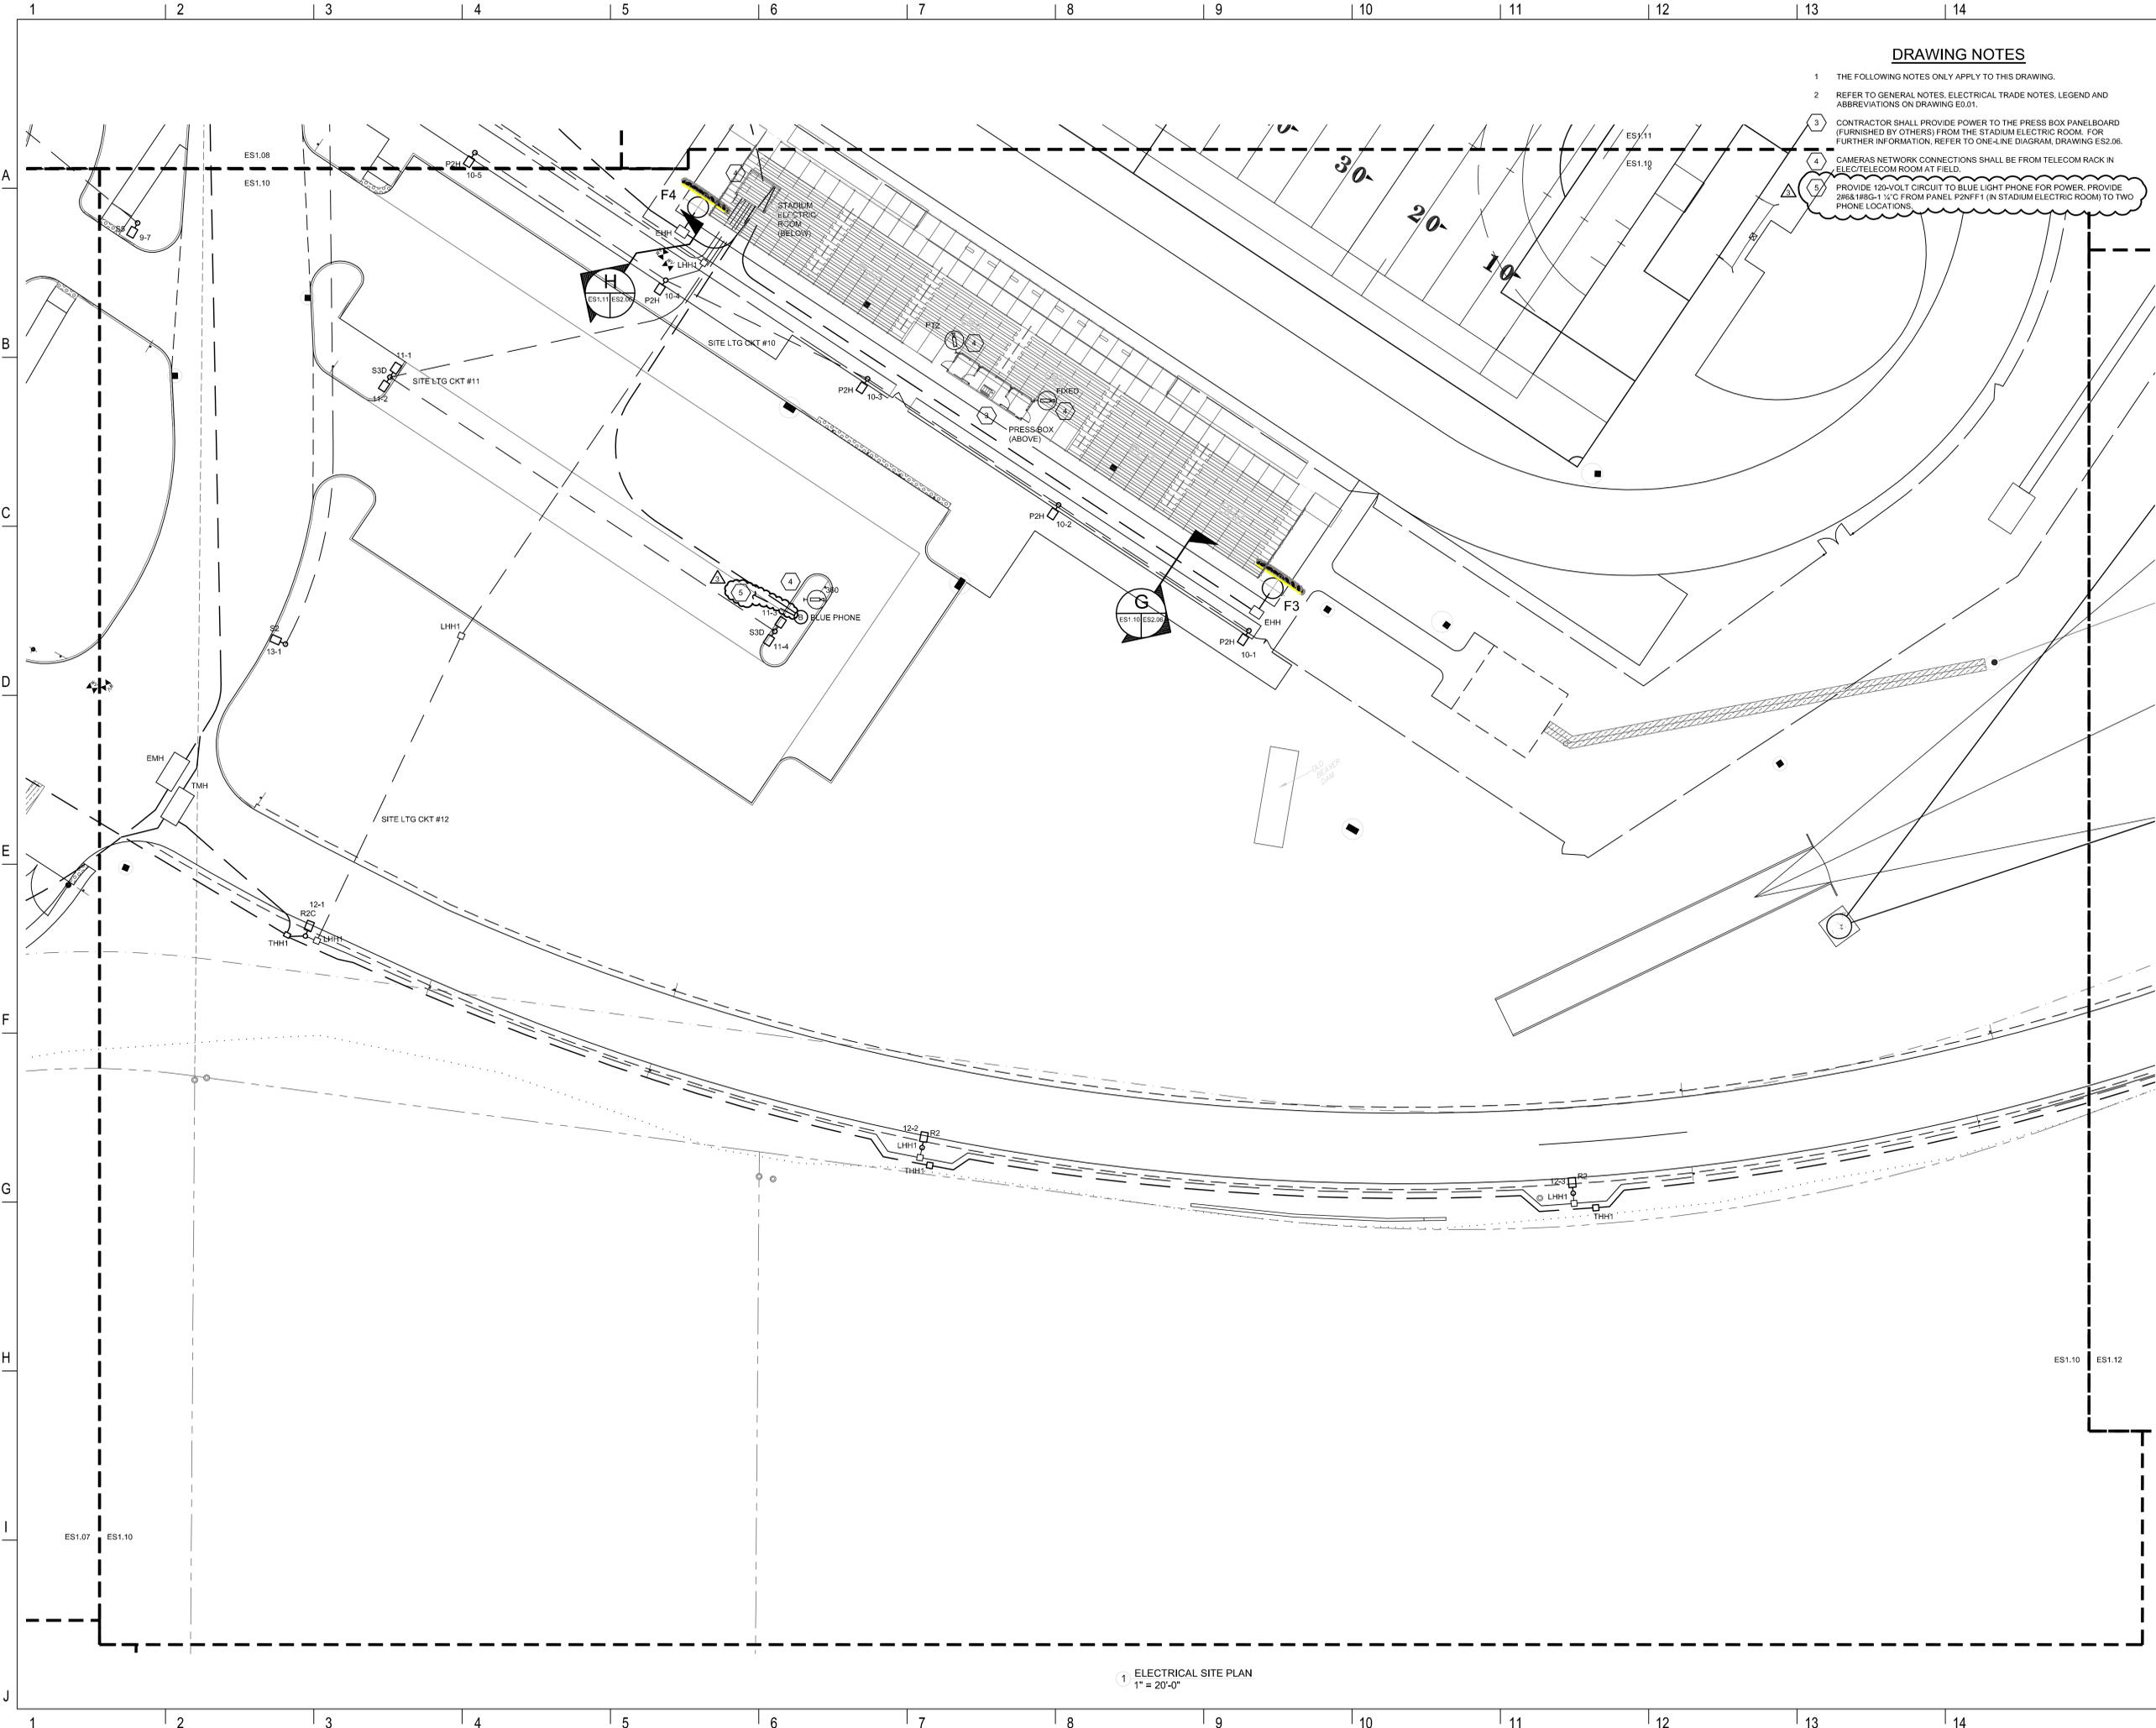

**DRAWING NOTES**

- 1 THE FOLLOWING NOTES ONLY APPLY TO THIS DRAWING.
- 2 REFER TO GENERAL NOTES, ELECTRICAL TRADE NOTES, LEGEND AND ABBREVIATIONS ON DRAWING E0.01.
- 3 CONTRACTOR SHALL PROVIDE POWER TO THE PRESS BOX PANELBOARD (FURNISHED BY OTHERS) FROM THE STADIUM ELECTRIC ROOM. FOR FURTHER INFORMATION, REFER TO ONE-LINE DIAGRAM, DRAWING ES2.06.
- 4 CAMERAS NETWORK CONNECTIONS SHALL BE FROM TELECOM RACK IN ELECTROTELECOM ROOM AT FIELD.
- 5 PROVIDE 120-VOLT CIRCUIT TO BLUE LIGHT PHONE FOR POWER. PROVIDE 200K-1000-1 1/2" C FROM PANEL P2NFF1 (IN STADIUM ELECTRIC ROOM) TO TWO PHONE LOCATIONS.

**LAVALLEE BRENSINGER ARCHITECTS**  
 Boston | Manchester | Portland  
 155 Dow Street, Suite 400, Manchester, NH 03101  
 603.622.5450  
 305 Commercial Street, Portland, ME 04101  
 207.558.7200  
 www.LBPA.com

**RFS engineering**  
 Rist Frost Shumway Engineering, P.C.  
 NH: 71 Water St.  
 Lebanon, NH 03245  
 P: 603.524.4647  
 MA: 53 Milk St., 18th Floor  
 Boston, MA 02109  
 P: 617.494.1464  
 www.rfsengineering.com  
 RFS Project #: 7300.001

Sanford School Department and  
 State of Maine Department of  
 Education


**SANFORD HIGH SCHOOL and TECHNICAL CENTER**

SANFORD, ME 04073

NO.	DESCRIPTION	DATE
3	ADDENDUM #3	2016-03-04

CONTENT: ELECTRICAL SITE PLAN	
DRAWN BY:	C. NEWELL
PROJECT NO.:	12-067-00
DATE:	02/11/2016
REVISED:	
SCALE:	AS NOTED
<b>ES1.10</b>	
Project Phase <b>BID DOCUMENTS</b>	
<small>COPYRIGHT © 2016 BY LAVALLEEBRENSINGER PROFESSIONAL ASSOCIATION. ALL RIGHTS RESERVED. NO REPRODUCTION WITHOUT PERMISSION.</small>	

1 ELECTRICAL SITE PLAN  
 1" = 20'-0"

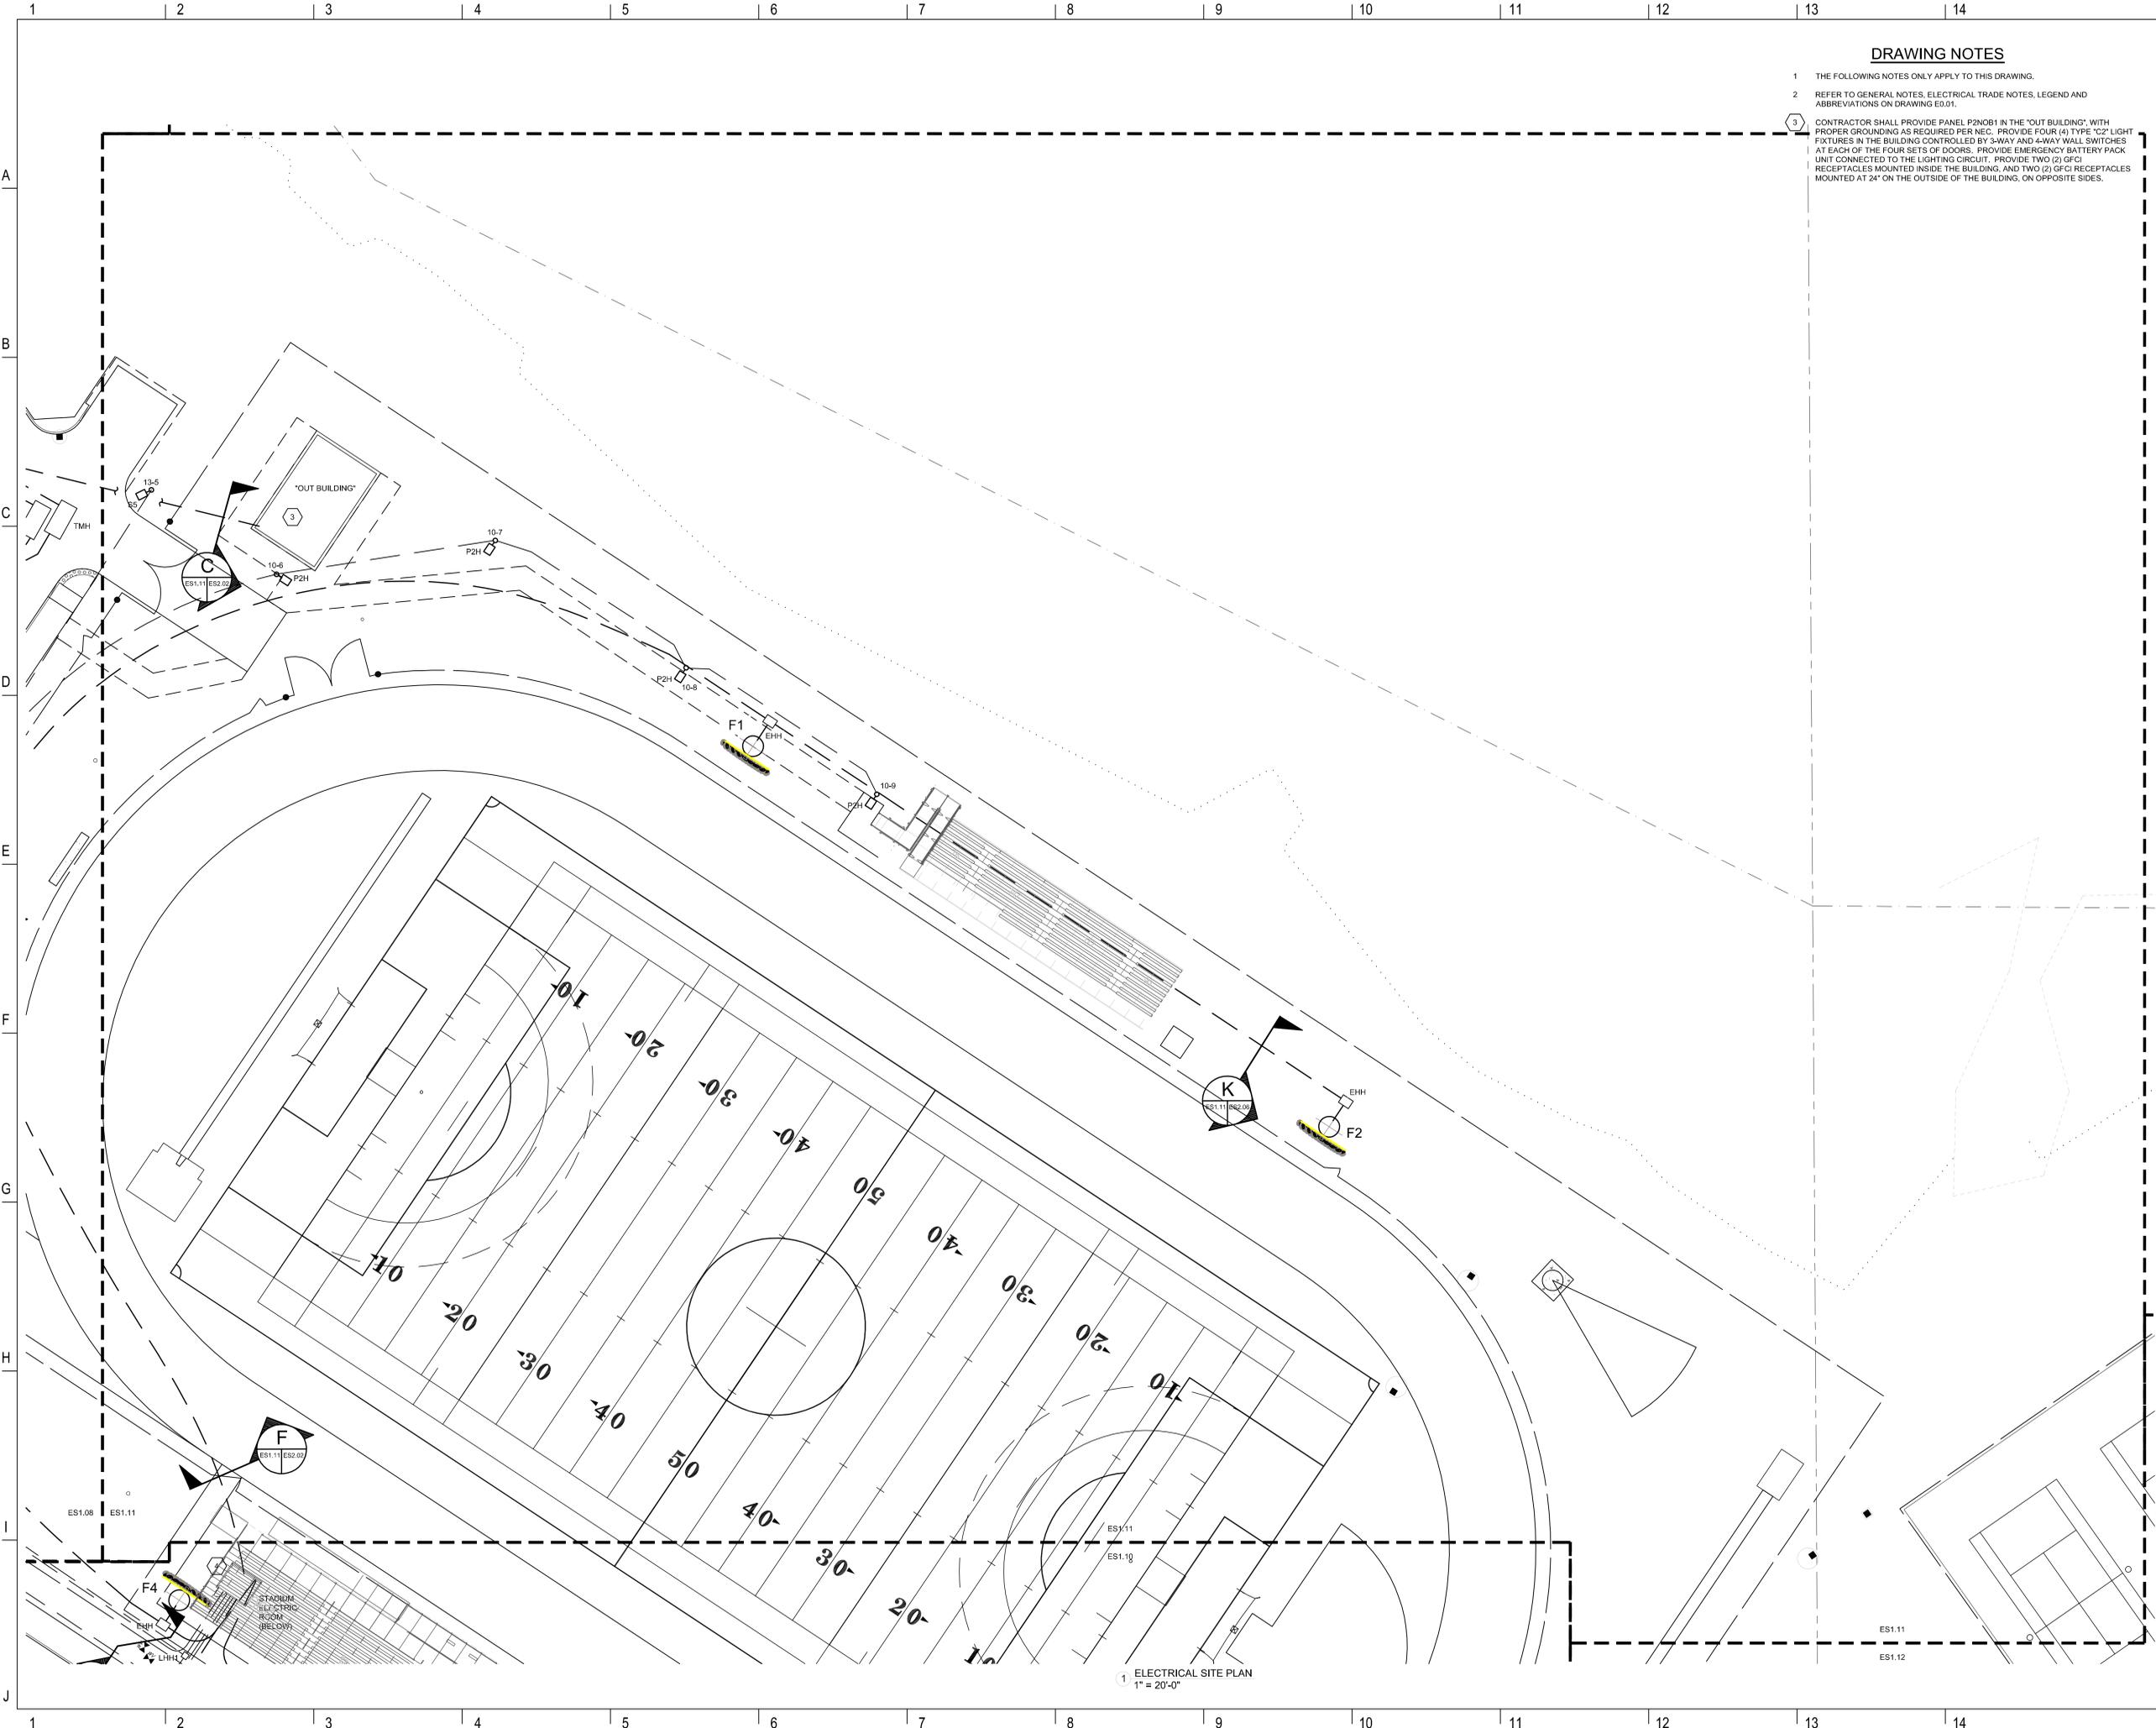


**DRAWING NOTES**

- 1 THE FOLLOWING NOTES ONLY APPLY TO THIS DRAWING.
- 2 REFER TO GENERAL NOTES, ELECTRICAL TRADE NOTES, LEGEND AND ABBREVIATIONS ON DRAWING E0.01.
- 3 CONTRACTOR SHALL PROVIDE PANEL P2N081 IN THE "OUT BUILDING", WITH PROPER GROUNDING AS REQUIRED PER NEC. PROVIDE FOUR (4) TYPE "C2" LIGHT FIXTURES IN THE BUILDING CONTROLLED BY 3-WAY AND 4-WAY WALL SWITCHES AT EACH OF THE FOUR SETS OF DOORS. PROVIDE EMERGENCY BATTERY PACK UNIT CONNECTED TO THE LIGHTING CIRCUIT. PROVIDE TWO (2) GFCI RECEPTACLES MOUNTED INSIDE THE BUILDING, AND TWO (2) GFCI RECEPTACLES MOUNTED AT 24" ON THE OUTSIDE OF THE BUILDING, ON OPPOSITE SIDES.

**LAVALLEE BRENSINGER ARCHITECTS**  
 Boston | Manchester | Portland  
 155 Dow Street, Suite 400, Manchester, NH 03101  
 603.622.5450  
 305 Commercial Street, Portland, ME 04101  
 207.558.7200  
 www.LBPA.com

**RFS engineering**  
 Rist Frost Shumway Engineering, P.C.  
 NH: 71 Water St.  
 Lacrosse, NH 03245  
 P: 603.524.4647  
 MA: 53 Milk St., 18th Floor  
 Boston, MA 02109  
 P: 617.494.1464  
 www.rfsengineering.com  
 RFS Project #: 7300.001

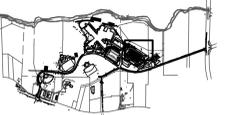

Sanford School Department and  
 State of Maine Department of  
 Education


**SANFORD HIGH SCHOOL and  
 TECHNICAL CENTER**

SANFORD, ME 04073

NO.	DESCRIPTION	DATE
3	ADDENDUM #3	2016-03-04

CONTENT: ELECTRICAL SITE PLAN	
DRAWN BY:	C. NEWELL
PROJECT NO.:	12-067-00
DATE:	02/11/2016
REVISED:	
SCALE:	AS NOTED
<b>ES1.11</b>	
Project Phase <b>BID DOCUMENTS</b>	
<small>COPYRIGHT © 2016 BY LAVALLEEBRENSINGER PROFESSIONAL ASSOCIATION. ALL RIGHTS RESERVED. NO REPRODUCTION WITHOUT PERMISSION.</small>	

1 ELECTRICAL SITE PLAN  
 1" = 20'-0"

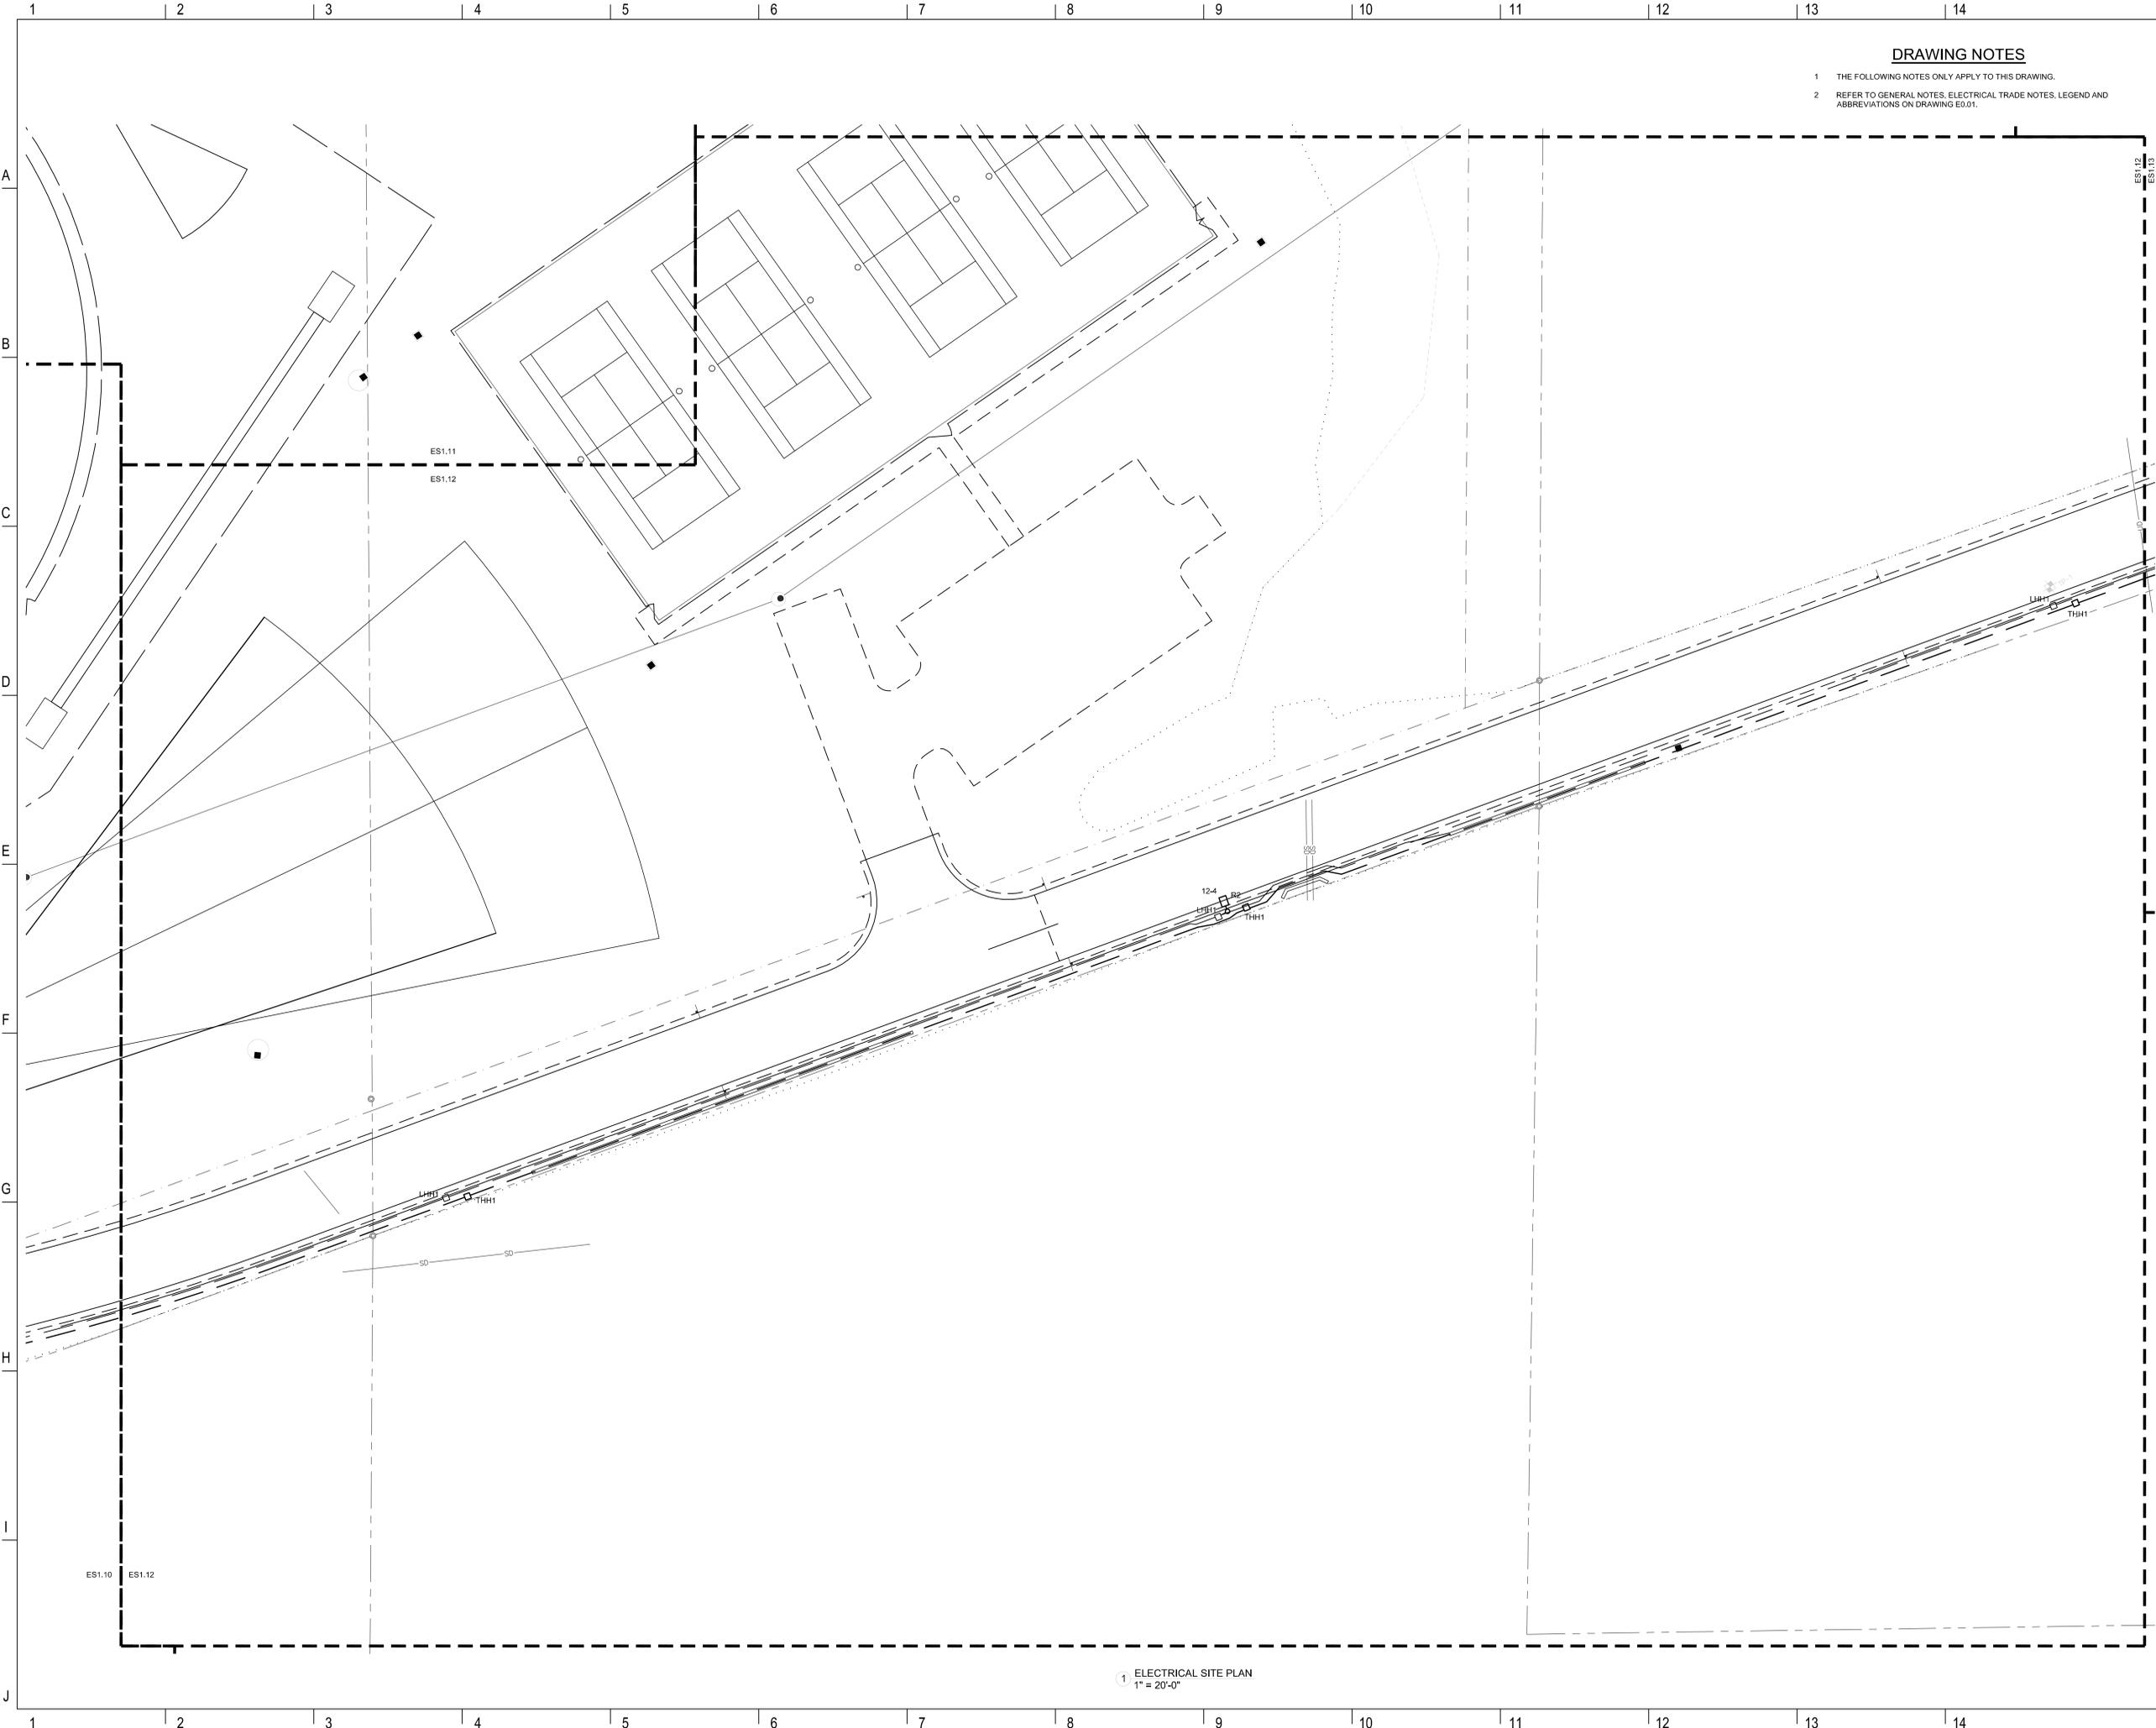

**DRAWING NOTES**

- 1 THE FOLLOWING NOTES ONLY APPLY TO THIS DRAWING.
- 2 REFER TO GENERAL NOTES, ELECTRICAL TRADE NOTES, LEGEND AND ABBREVIATIONS ON DRAWING E0.01.

**LAVALLEE  
BRENSINGER**

**ARCHITECTS**

Boston | Manchester | Portland


155 Dow Street, Suite 400, Manchester, NH 03101  
603.622.5450

305 Commercial Street, Portland, ME 04101  
207.558.7200

www.LBPA.com

**RFS**  
*engineering*

Ris Frost Shumway Engineering, P.C.  
NH: 71 Water St.  
Laconia, NH 03245  
P: 603.524.4647  
MA: 53 Milk St., 18th Floor  
Boston, MA 02109  
P: 617.494.1464  
www.rfsengineering.com  
RFS Project #: 7300.001

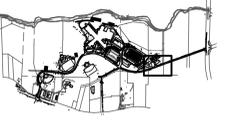

Sanford School Department and  
State of Maine Department of  
Education

**SANFORD HIGH  
SCHOOL and  
TECHNICAL CENTER**


SANFORD, ME 04073

NO.	DESCRIPTION	DATE
3	ADDENDUM #3	2016-03-04

FOR ADDITIONAL INFORMATION, REFER TO PROJECT MANUAL.

CONTENT:	ELECTRICAL SITE PLAN
DRAWN BY:	C. NEWELL
PROJECT NO.:	12-067-00
DATE:	02/11/2016
REVISED:	
SCALE:	AS NOTED
<b>ES1.12</b>	
Project Phase:	BID DOCUMENTS
<small>COPYRIGHT © 2016 BY LAVALLEEBRENSINGER PROFESSIONAL ASSOCIATION. ALL RIGHTS RESERVED. NO REPRODUCTION WITHOUT PERMISSION.</small>	

1 ELECTRICAL SITE PLAN  
1" = 20'-0"

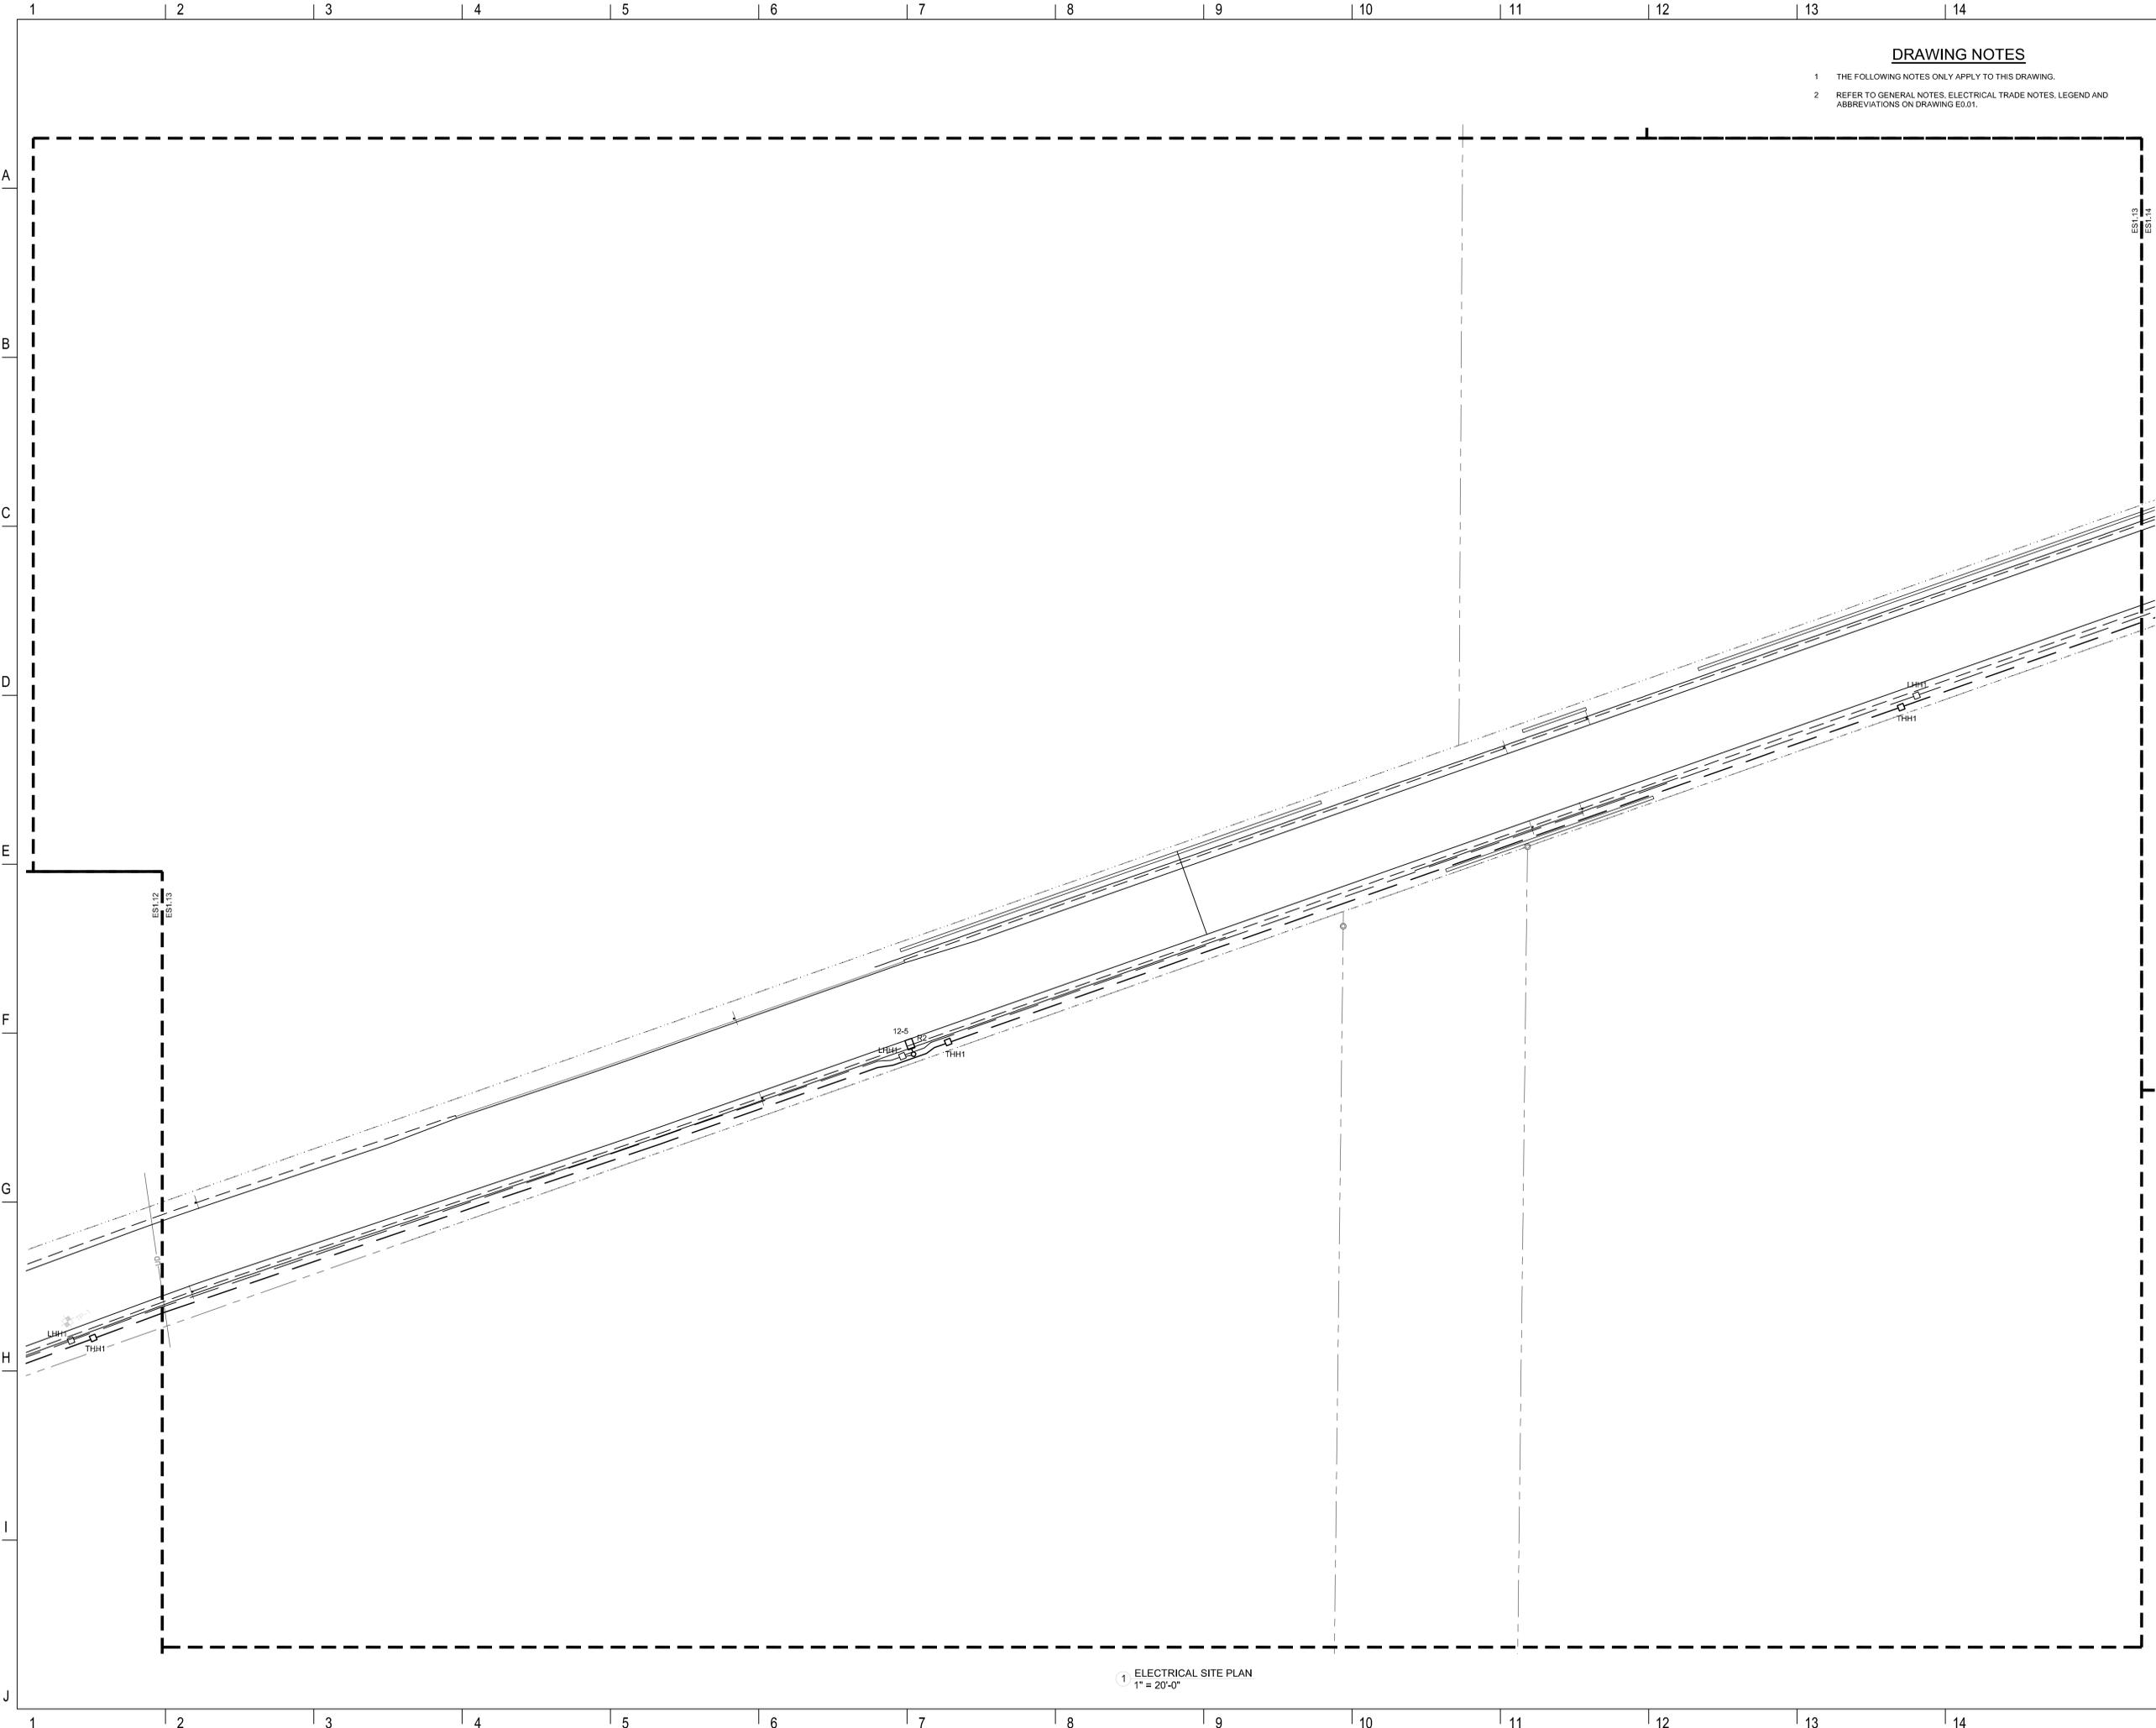

**DRAWING NOTES**

- 1 THE FOLLOWING NOTES ONLY APPLY TO THIS DRAWING.
- 2 REFER TO GENERAL NOTES, ELECTRICAL TRADE NOTES, LEGEND AND ABBREVIATIONS ON DRAWING E0.01.

**LAVALLEE  
BRENSINGER**

**ARCHITECTS**

Boston | Manchester | Portland



155 Dow Street, Suite 400, Manchester, NH 03101  
603.622.5450

305 Commercial Street, Portland, ME 04101  
207.558.7200

www.LBPA.com



Ris Frost Shumway Engineering, P.C.  
NH: 71 Water St.  
Laconia, NH 03245  
P: 603.524.4647  
MA: 50 Milk St., 18th Floor  
Boston, MA 02109  
P: 617.494.1464  
www.rfsengineering.com  
RFS Project #: 7300.001

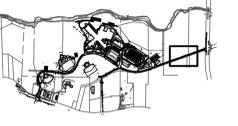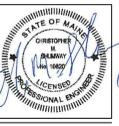

Sanford School Department and  
State of Maine Department of  
Education


**SANFORD HIGH  
SCHOOL and  
TECHNICAL CENTER**

SANFORD, ME 04073

NO.	DESCRIPTION	DATE
3	ADDENDUM #3	2016-03-04

CONTENT: ELECTRICAL SITE PLAN	
DRAWN BY:	C. NEWELL
PROJECT NO.:	12-067-00
DATE:	02/11/2016
REVISED:	
SCALE:	AS NOTED
<b>ES1.13</b>	
Project Phase <b>BID DOCUMENTS</b>	
<small>COPYRIGHT © 2016 BY LAVALLEEBRENSINGER PROFESSIONAL ASSOCIATION. ALL RIGHTS RESERVED. NO REPRODUCTION WITHOUT PERMISSION.</small>	

1 ELECTRICAL SITE PLAN  
1" = 20'-0"

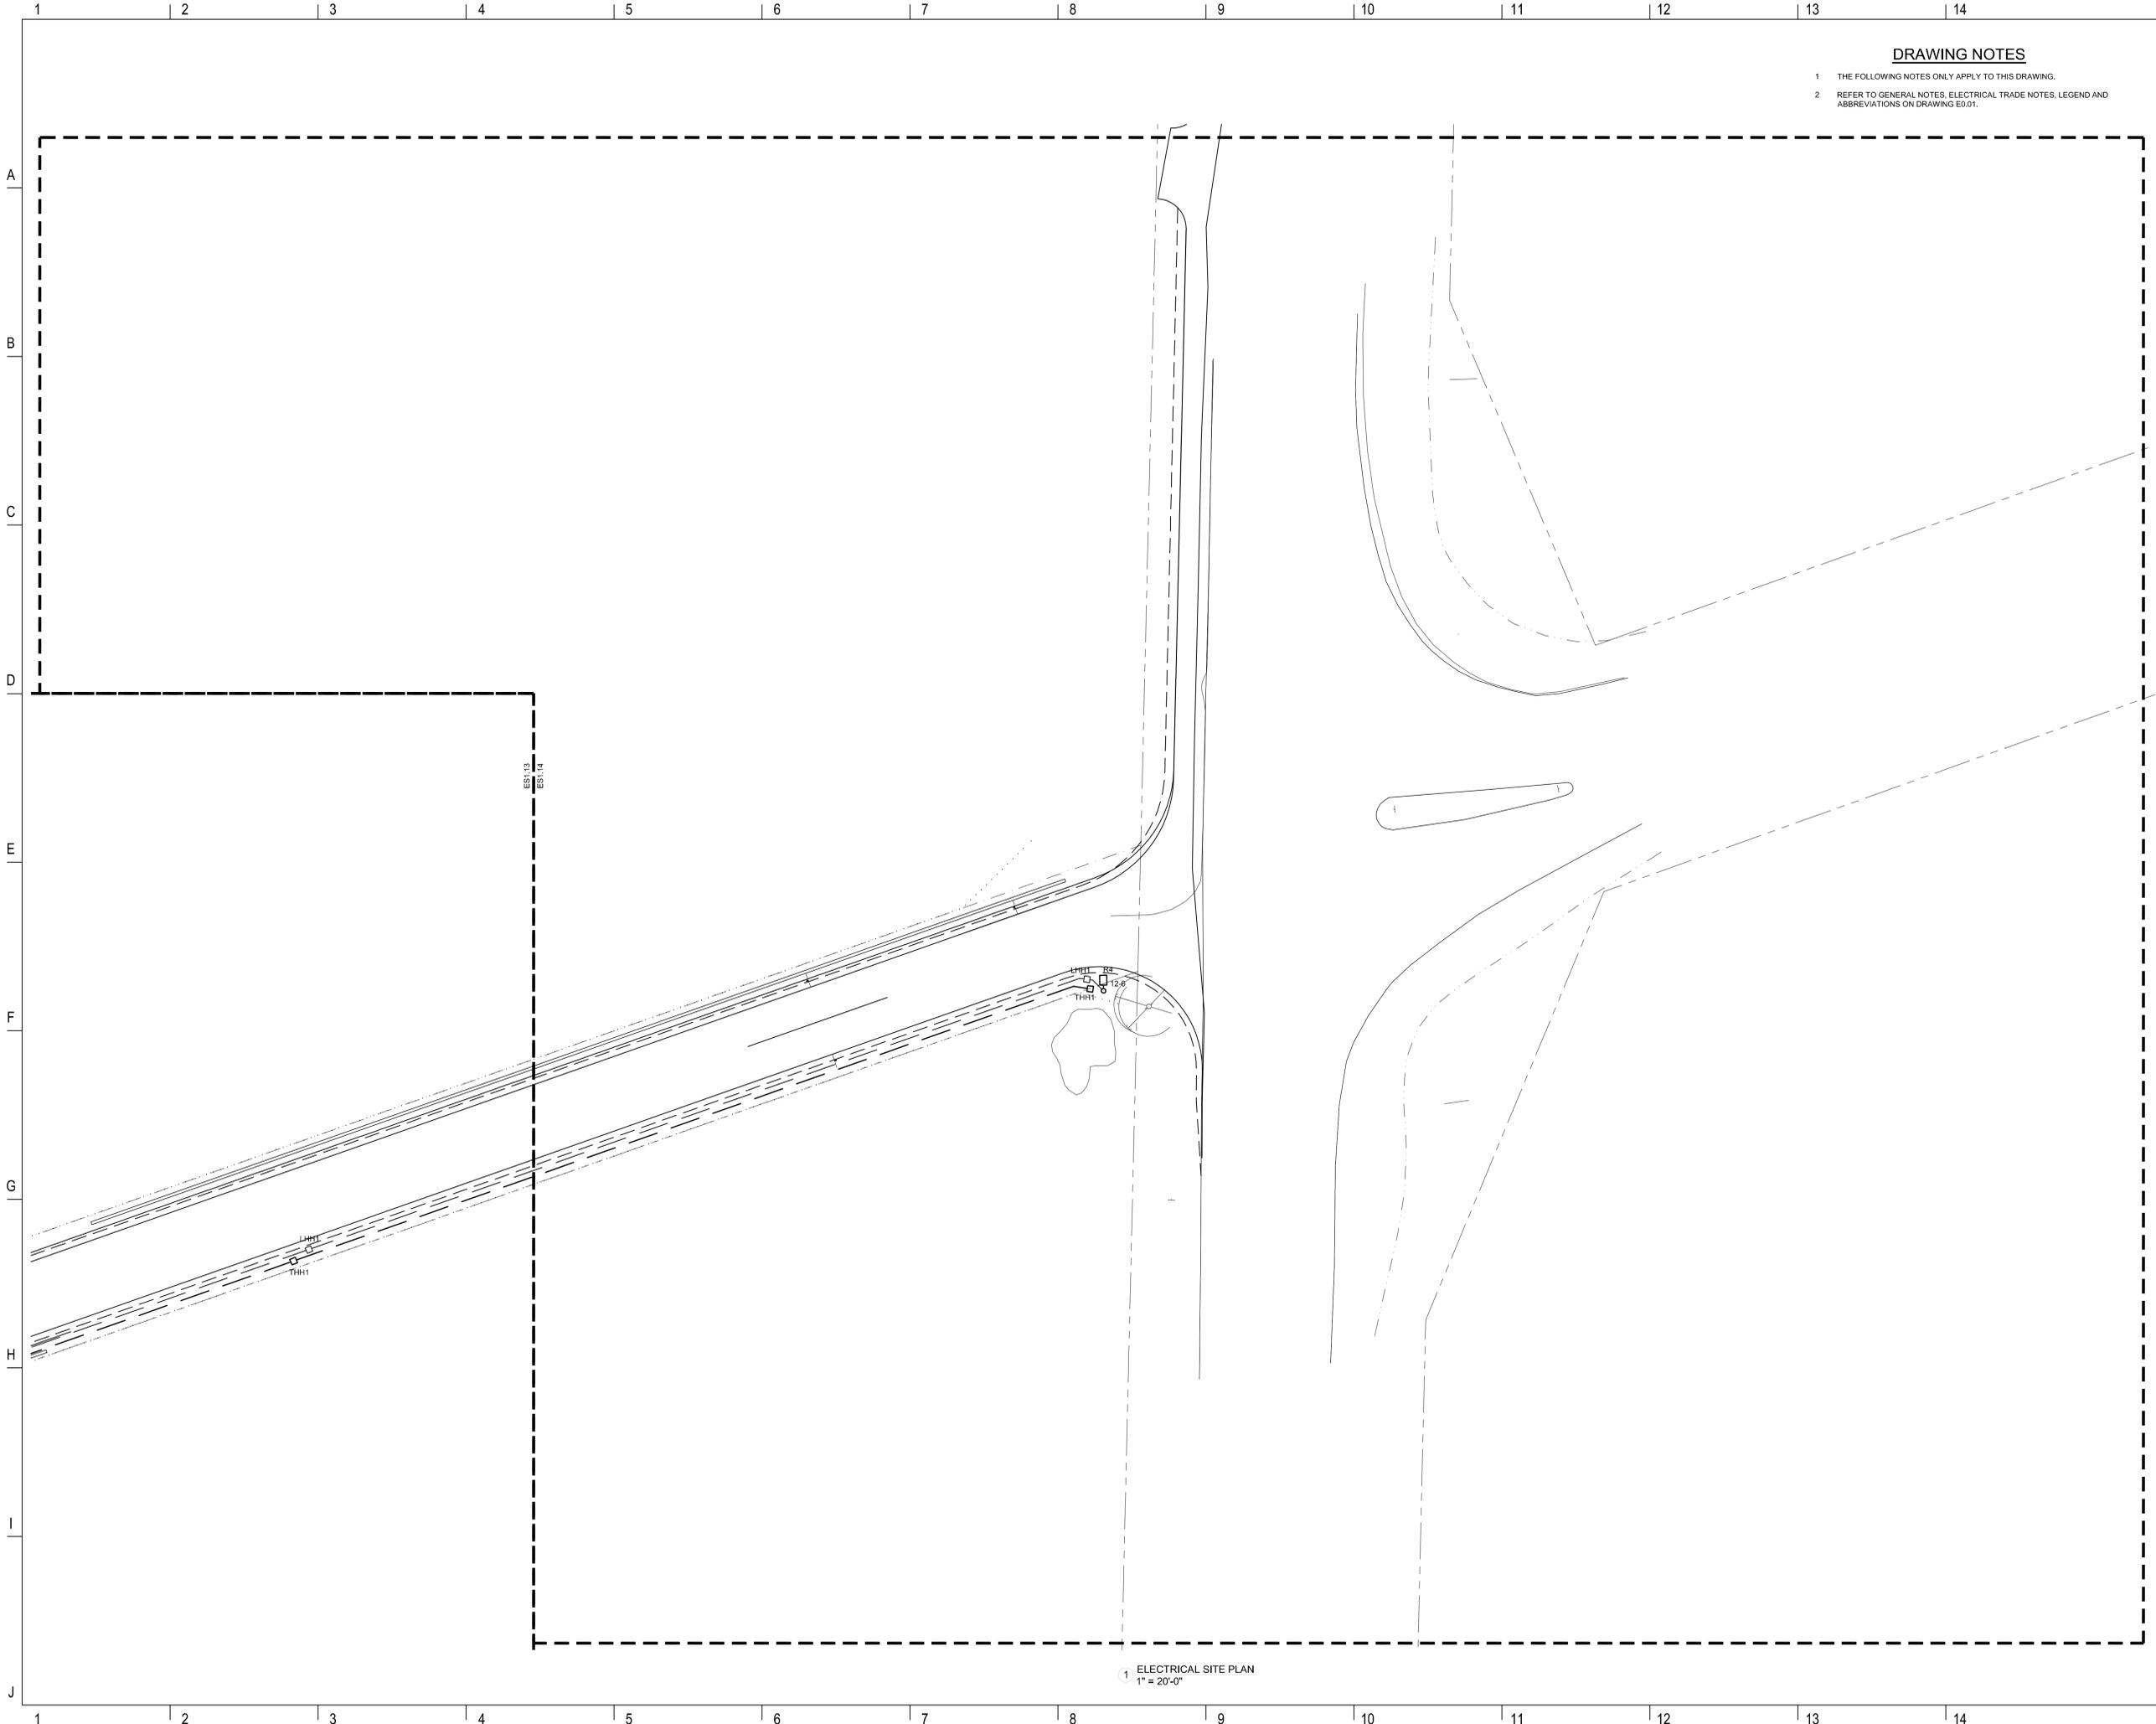

**DRAWING NOTES**

- 1 THE FOLLOWING NOTES ONLY APPLY TO THIS DRAWING.
- 2 REFER TO GENERAL NOTES, ELECTRICAL TRADE NOTES, LEGEND AND ABBREVIATIONS ON DRAWING E0.01.

**LAVALLEE  
BRENSINGER**

**ARCHITECTS**

Boston | Manchester | Portland


155 Dow Street, Suite 400, Manchester, NH 03101  
603.622.5450

305 Commercial Street, Portland, ME 04101  
207.558.7200

www.LBPA.com



Ris Frost Shumway Engineering, P.C.  
NH: 71 Water St.  
Laconia, NH 03245  
P: 603.524.4647  
MA: 50 Milk St., 18th Floor  
Boston, MA 02109  
P: 617.494.1464  
www.rfsengineering.com  
RFS Project #: 7300.001

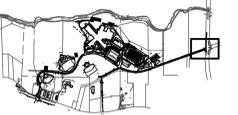Sanford School Department and  
State of Maine Department of  
Education

**SANFORD HIGH  
SCHOOL and  
TECHNICAL CENTER**

SANFORD, ME 04073

NO.	DESCRIPTION	DATE
3	ADDENDUM #3	2016-03-04

FOR ADDITIONAL INFORMATION, REFER TO PROJECT MANUAL.

CONTENT:	ELECTRICAL SITE PLAN
DRAWN BY:	C. NEWELL
PROJECT NO.:	12-067-00
DATE:	02/11/2016
REVISED:	
SCALE:	AS NOTED
<b>ES1.14</b>	
Project Phase	
<b>BID DOCUMENTS</b>	
COPYRIGHT © 2016 BY LAVALLEEBRENSINGER PROFESSIONAL ASSOCIATION. ALL RIGHTS RESERVED. NO REPRODUCTION WITHOUT PERMISSION.	

1 ELECTRICAL SITE PLAN  
1" = 20'-0"



**DRAWING NOTES**

- THE FOLLOWING NOTES ONLY APPLY TO THIS DRAWING.
- REFER TO GENERAL NOTES, ELECTRICAL TRADE NOTES, LEGEND AND ABBREVIATIONS ON DRAWING E0.01.
- CONTRACTOR SHALL COORDINATE EXACT CONDUIT STUB-UP QUANTITIES AND LOCATIONS WITH THE GENERATOR MANUFACTURER AND THE EQUIPMENT BEING PROVIDED.
- CONDUIT SHALL ENTER THROUGH THE FOUNDATION LEVEL, AND SQUARE TO THE PENETRATION.
- COVER FOR THE ELECTRIC SHALL BE CAST INDICATING "GMP CO." CONTRACTOR SHALL PROVIDE GROUNDING AROUND THE TRANSFORMER PAD(S) CONSISTING OF A #4-0 AWG BARE COPPER RING WITH SECTIONAL GROUND RODS (MINIMUM) TO ACHIEVE REQUIRED READINGS. ALL GROUNDING REQUIREMENTS SHALL BE TO CENTRAL MAINE POWER STANDARDS.

**TRENCHING NOTES**

- CONTRACTOR SHALL USE EXTREME CAUTION WHEN TRENCHING. DIGGING TEST PITS ARE REQUIRED AT EVERY UTILITY CROSSING. THE MOST CRITICAL AREAS ARE INDICATED ON THE DRAWINGS. FAILURE TO PERFORM TEST PITS MAY RESULT IN UNNECESSARY DELAYS AND CONFLICTS FOR WHICH THE CONTRACTOR MAY BE HELD RESPONSIBLE.
- TEST PITS SHALL BE COORDINATED WITH THE ENGINEER, AND ALL SHALL INCLUDE INFORMATION AS TO SIZE AND CONFIGURATION OF PIPES FOUND AS WELL AS INVERT ELEVATIONS.
- TRENCH BOTTOM SHALL BE UNDISTURBED, FIRM, AND UNIFORM FOR ITS ENTIRE LENGTH.
- KEEP THE TRENCH WIDTH AS NARROW AS POSSIBLE. THE SIDES OF THE CONCRETE DUCTBANKS SHALL BE FORMED VERTICAL OR SLIGHTLY INWARD TO MINIMIZE POTENTIAL FOR FROST HEAVING.
- PLACE 2" LAYER OF SAND IN BOTTOM OF TRENCH AS BASE FOR CONCRETE PLACEMENT.
- WHEN FINAL BACKFILLING IS PERFORMED, UTILIZE EXCAVATED MATERIAL. REMOVE ALL LARGE ROCKS, FOREIGN MATERIALS, ETC. TO AVOID DAMAGE TO CONDUITS.
- ALL UNDERGROUND CONDUITS SHALL BE RIGID PVC SCHEDULE 40, BURIED IN SAND, UNLESS OTHERWISE INDICATED ON DRAWINGS. PROVIDE CONDUITS SIZE IN ACCORDANCE WITH THE CONDUIT SCHEDULE. ALL VERTICAL CONDUIT SWEEPS SHALL BE ASPHALTUM-COATED RIGID GALVANIZED STEEL (FRS). AT POLES, RGS SHALL EXTEND A MINIMUM OF 10' UP POLE BEFORE CHANGING TO SCHEDULE 40 PVC.
- SEAL ALL CONDUIT JOINTS AND AROUND EACH CONDUIT AT WALL PENETRATIONS.
- ALL DUCTS SHALL BE CAPPED DURING CONCRETE POURING AND LEFT CAPPED UNTIL CABLE PULLING BEGINS.
- ALL CONDUIT SHALL BE SLOPED @ 3/100' MINIMUM TO DRAIN.
- INDICATED DIMENSIONS FOR THE SPACING OF CONDUIT IN THE DUCT BANKS ARE MINIMUMS. INSTALL RIGID PLASTIC SPACERS AT INTERVALS OF 10'-0" OR LESS FOR DUCTBANKS ENCASED IN CONCRETE.
- PROVIDE A MINIMUM OF 12" SEPARATION BETWEEN MEDIUM VOLTAGE CONDUITS AND TELECOMMUNICATIONS CONDUITS.

**LAVALLEE BRENSINGER ARCHITECTS**  
 Boston | Manchester | Portland  
 155 Dow Street, Suite 400, Manchester, NH 03101  
 603.622.5450  
 305 Commercial Street, Portland, ME 04101  
 207.558.7200  
 www.LBPA.com

**RFS engineering**  
 Riel Frost Shumway Engineering, P.C.  
 NH: 71 Water St.  
 Laconia, NH 03246  
 P: 603.524.4547  
 MA: 50 Main St. 18th Floor  
 Boston, MA 02109  
 P: 617.494.1464  
 www.rfsengineering.com  
 RFS Project #: 7300.001

Sanford School Department and  
 State of Maine Department of  
 Education

**SANFORD HIGH SCHOOL and TECHNICAL CENTER**

SANFORD, ME 04073

NO.	DESCRIPTION	DATE
3	ADDENDUM #3	2016-03-04

FOR ADDITIONAL INFORMATION, REFER TO PROJECT MANUAL.

CONTENT:  
 ELECTRICAL SITE DETAILS

DRAWN BY: C. NEWELL

PROJECT NO: 12-067-00

DATE: 02/11/2016


REVISED:

SCALE: AS NOTED


**ES2.02**

Project Phase  
**BID DOCUMENTS**


COPYRIGHT © 2016 BY LAVALLEE/BRENSINGER PROFESSIONAL ASSOCIATION. ALL RIGHTS RESERVED. NO REPRODUCTION WITHOUT PERMISSION.

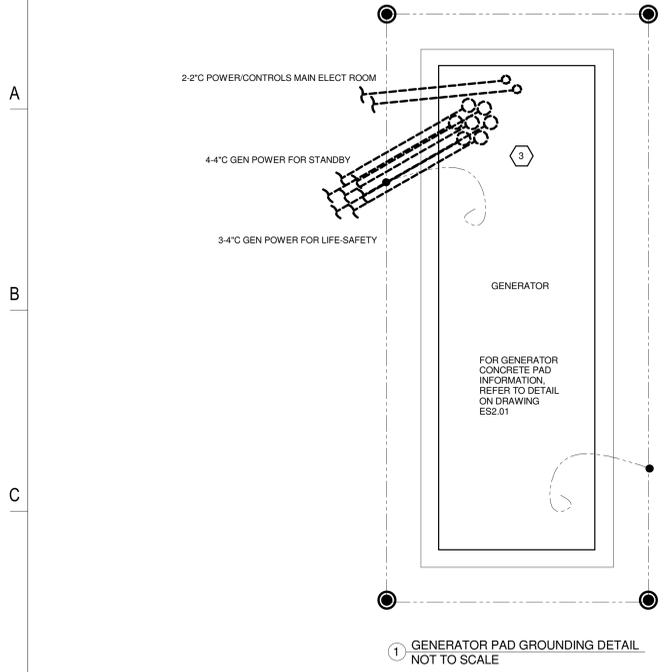


1 GENERATOR PAD GROUNDING DETAIL  
 NOT TO SCALE

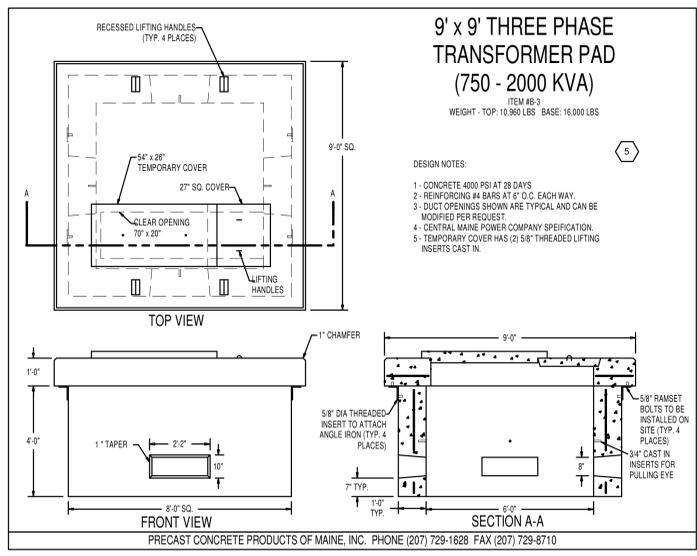

5 9' x 9' THREE PHASE TRANSFORMER PAD (750 - 2000 KVA)  
 ITEM #B-3  
 WEIGHT - TOP: 10,900 LBS BASE: 16,000 LBS

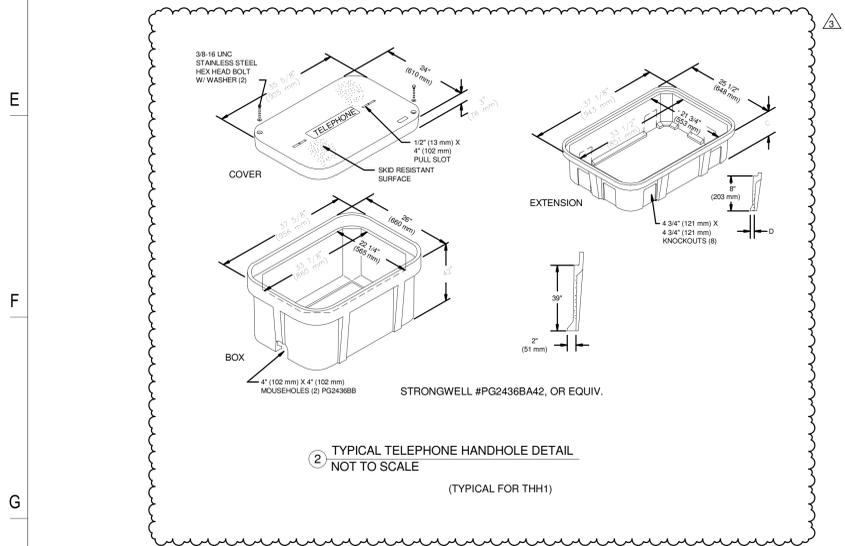

2 TYPICAL TELEPHONE HANDHOLE DETAIL  
 NOT TO SCALE  
 (TYPICAL FOR THH1)

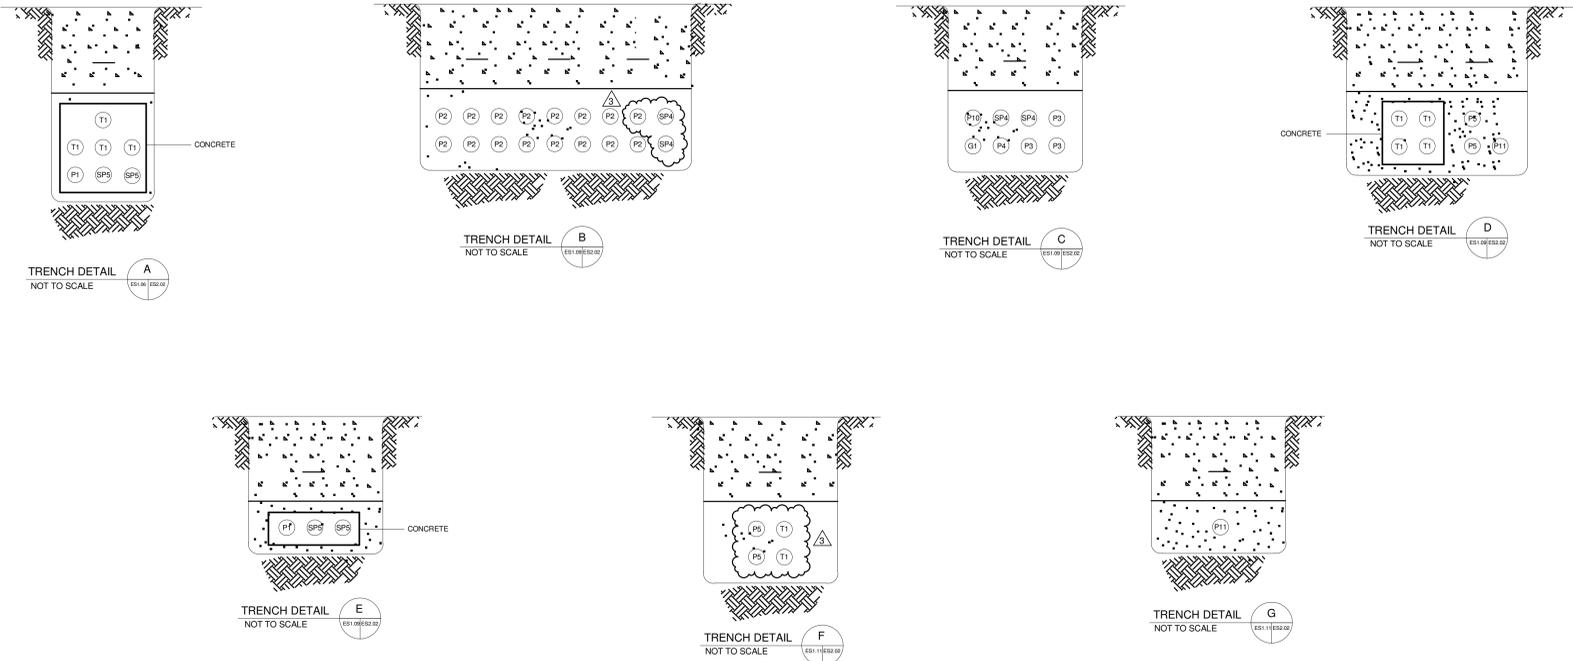

TRENCH DETAIL A  
 NOT TO SCALE

TRENCH DETAIL B  
 NOT TO SCALE


TRENCH DETAIL C  
 NOT TO SCALE

TRENCH DETAIL D  
 NOT TO SCALE

TRENCH DETAIL E  
 NOT TO SCALE

TRENCH DETAIL F  
 NOT TO SCALE

TRENCH DETAIL G  
 NOT TO SCALE

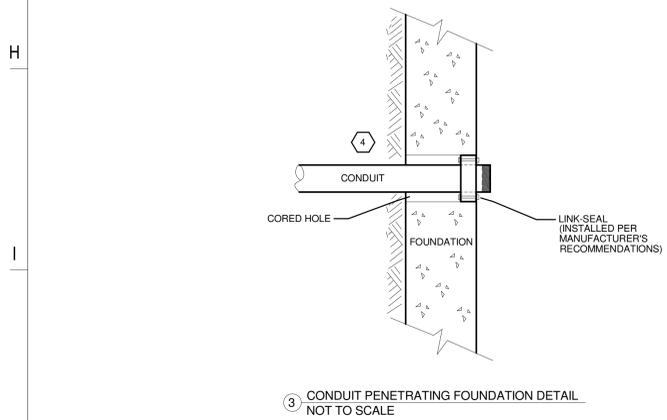


3 CONDUIT PENETRATING FOUNDATION DETAIL  
 NOT TO SCALE

C:\Users\m687\Desktop\DRAWINGS\SET IT UP\7300\2016 FOR MAT\7300-C.dwg - Escalator.dwg





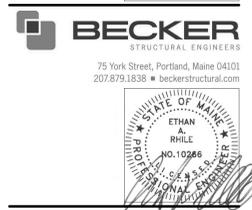


FOOTING SCHEDULE		
FOOTING MARK	FOOTING SIZE	REINFORCING
F3	3'-0"x3'-0"x1'-0"	4#4 E.W.B.
F4	4'-0"x4'-0"x1'-0"	4#4 E.W.B.
F5	5'-0"x5'-0"x1'-0"	5#5 E.W.B.
F6	6'-0"x6'-0"x1'-2"	6#6 E.W.B.
F7	7'-0"x7'-0"x1'-6"	6#6 E.W.B.
F8	8'-0"x8'-0"x1'-8"	6#7 E.W.B.
F9	9'-0"x9'-0"x1'-10"	6#7 E.W.B.
F10	10'-0"x10'-0"x2'-0"	9#7 E.W.B.
F11	11'-0"x11'-0"x2'-2"	8#8 E.W.B.
F12	12'-0"x12'-0"x2'-4"	10#8 E.W.B.
F57	5'-0"x7'-0"x1'-6"	4#6 L.W.B. 10#8 S.W.B.
F810	8'-0"x10'-0"x1'-8"	8#6 L.W.B. 10#8 S.W.B.
F812	9'-0"x12'-0"x2'-4"	6#8 L.W.B. 10#8 S.W.B.
F1011	10'-0"x11'-0"x2'-2"	7#8 L.W.B. 8#8 S.W.B.

\* INDICATES FOOTING W/ REINF TOP & BOTTOM.

**LEVEL 1 PART FOUNDATION PLAN**  
 1/8"=1'-0"

- NOTES:**
1. TOP OF WALL EL 0'-0" U.N.O. BY (0'-8"), ETC.
  2. Fx INDICATES CONCRETE FOOTING. SEE SCHEDULE THIS DWG FOR SIZE & REINF.
  3. TOP OF INTERIOR FOOTING EL (-1'-0") U.N.O.
  4. TOP OF EXTERIOR FOOTING EL (-3'-10") U.N.O.
  5. Fx INDICATES REINF CONCRETE PIER. SEE PIER DETAILS DWG S2.3. NOTE: BOND OUT WALL STEM AS REQD FOR BASE PLATE. DO NOT BOND OUT BRICKSHELF.
  6. TOP OF PIER EL (-0'-8") U.N.O.
  7. F.D. INDICATES FLOOR DRAIN. COORD ALL FLOOR DRAINS (W/ASSOCIATED SLOPES) & SLAB PENETRATIONS, W/ARCH & MEP DWGS.
  8. BP-A INDICATES COLUMN BASE PLATE. SEE DWG S3.1 FOR BASE PLATE DETAILS.
  9. C.J. INDICATES SLAB CONTRACTION/CONSTRUCTION JOINT. SEE TYP DETAILS DWG S2.1 FOR ADDL INFO.
  10. S.K. INDICATES SHEAR KEY. SEE DETAIL A/S4.16 BASE PLATE DETAILS, DWG S3.1 FOR ADDITIONAL INFORMATION.
  11. BF-1, BF-2, ETC INDICATES BRACED FRAME. SEE BRACED FRAME ELEVATIONS DWG S4.X.
  12. GB-1 INDICATES GRADE BEAM. SEE TYP DETAIL DWG S2.1.
  13. WL-1, WL-2, ETC. INDICATES WALL LOCATIONS THAT REQUIRE THE RAMMED AGGREGATE PIER SYSTEM. SEE PLANS FOR LOCATIONS & DWG S01 FOR ADDL INFO.
  14. PROVIDE THICKENED SLAB AT CMU PARTITIONS. SEE ARCH DWGS FOR LOCATIONS. SEE TYP DETAIL DWG S2.1.
  15. G. C. TO COORDINATE ALL PLUMBING WITH FOOTING ELEVATIONS. DO NOT SLEEVE THROUGH FOOTINGS.

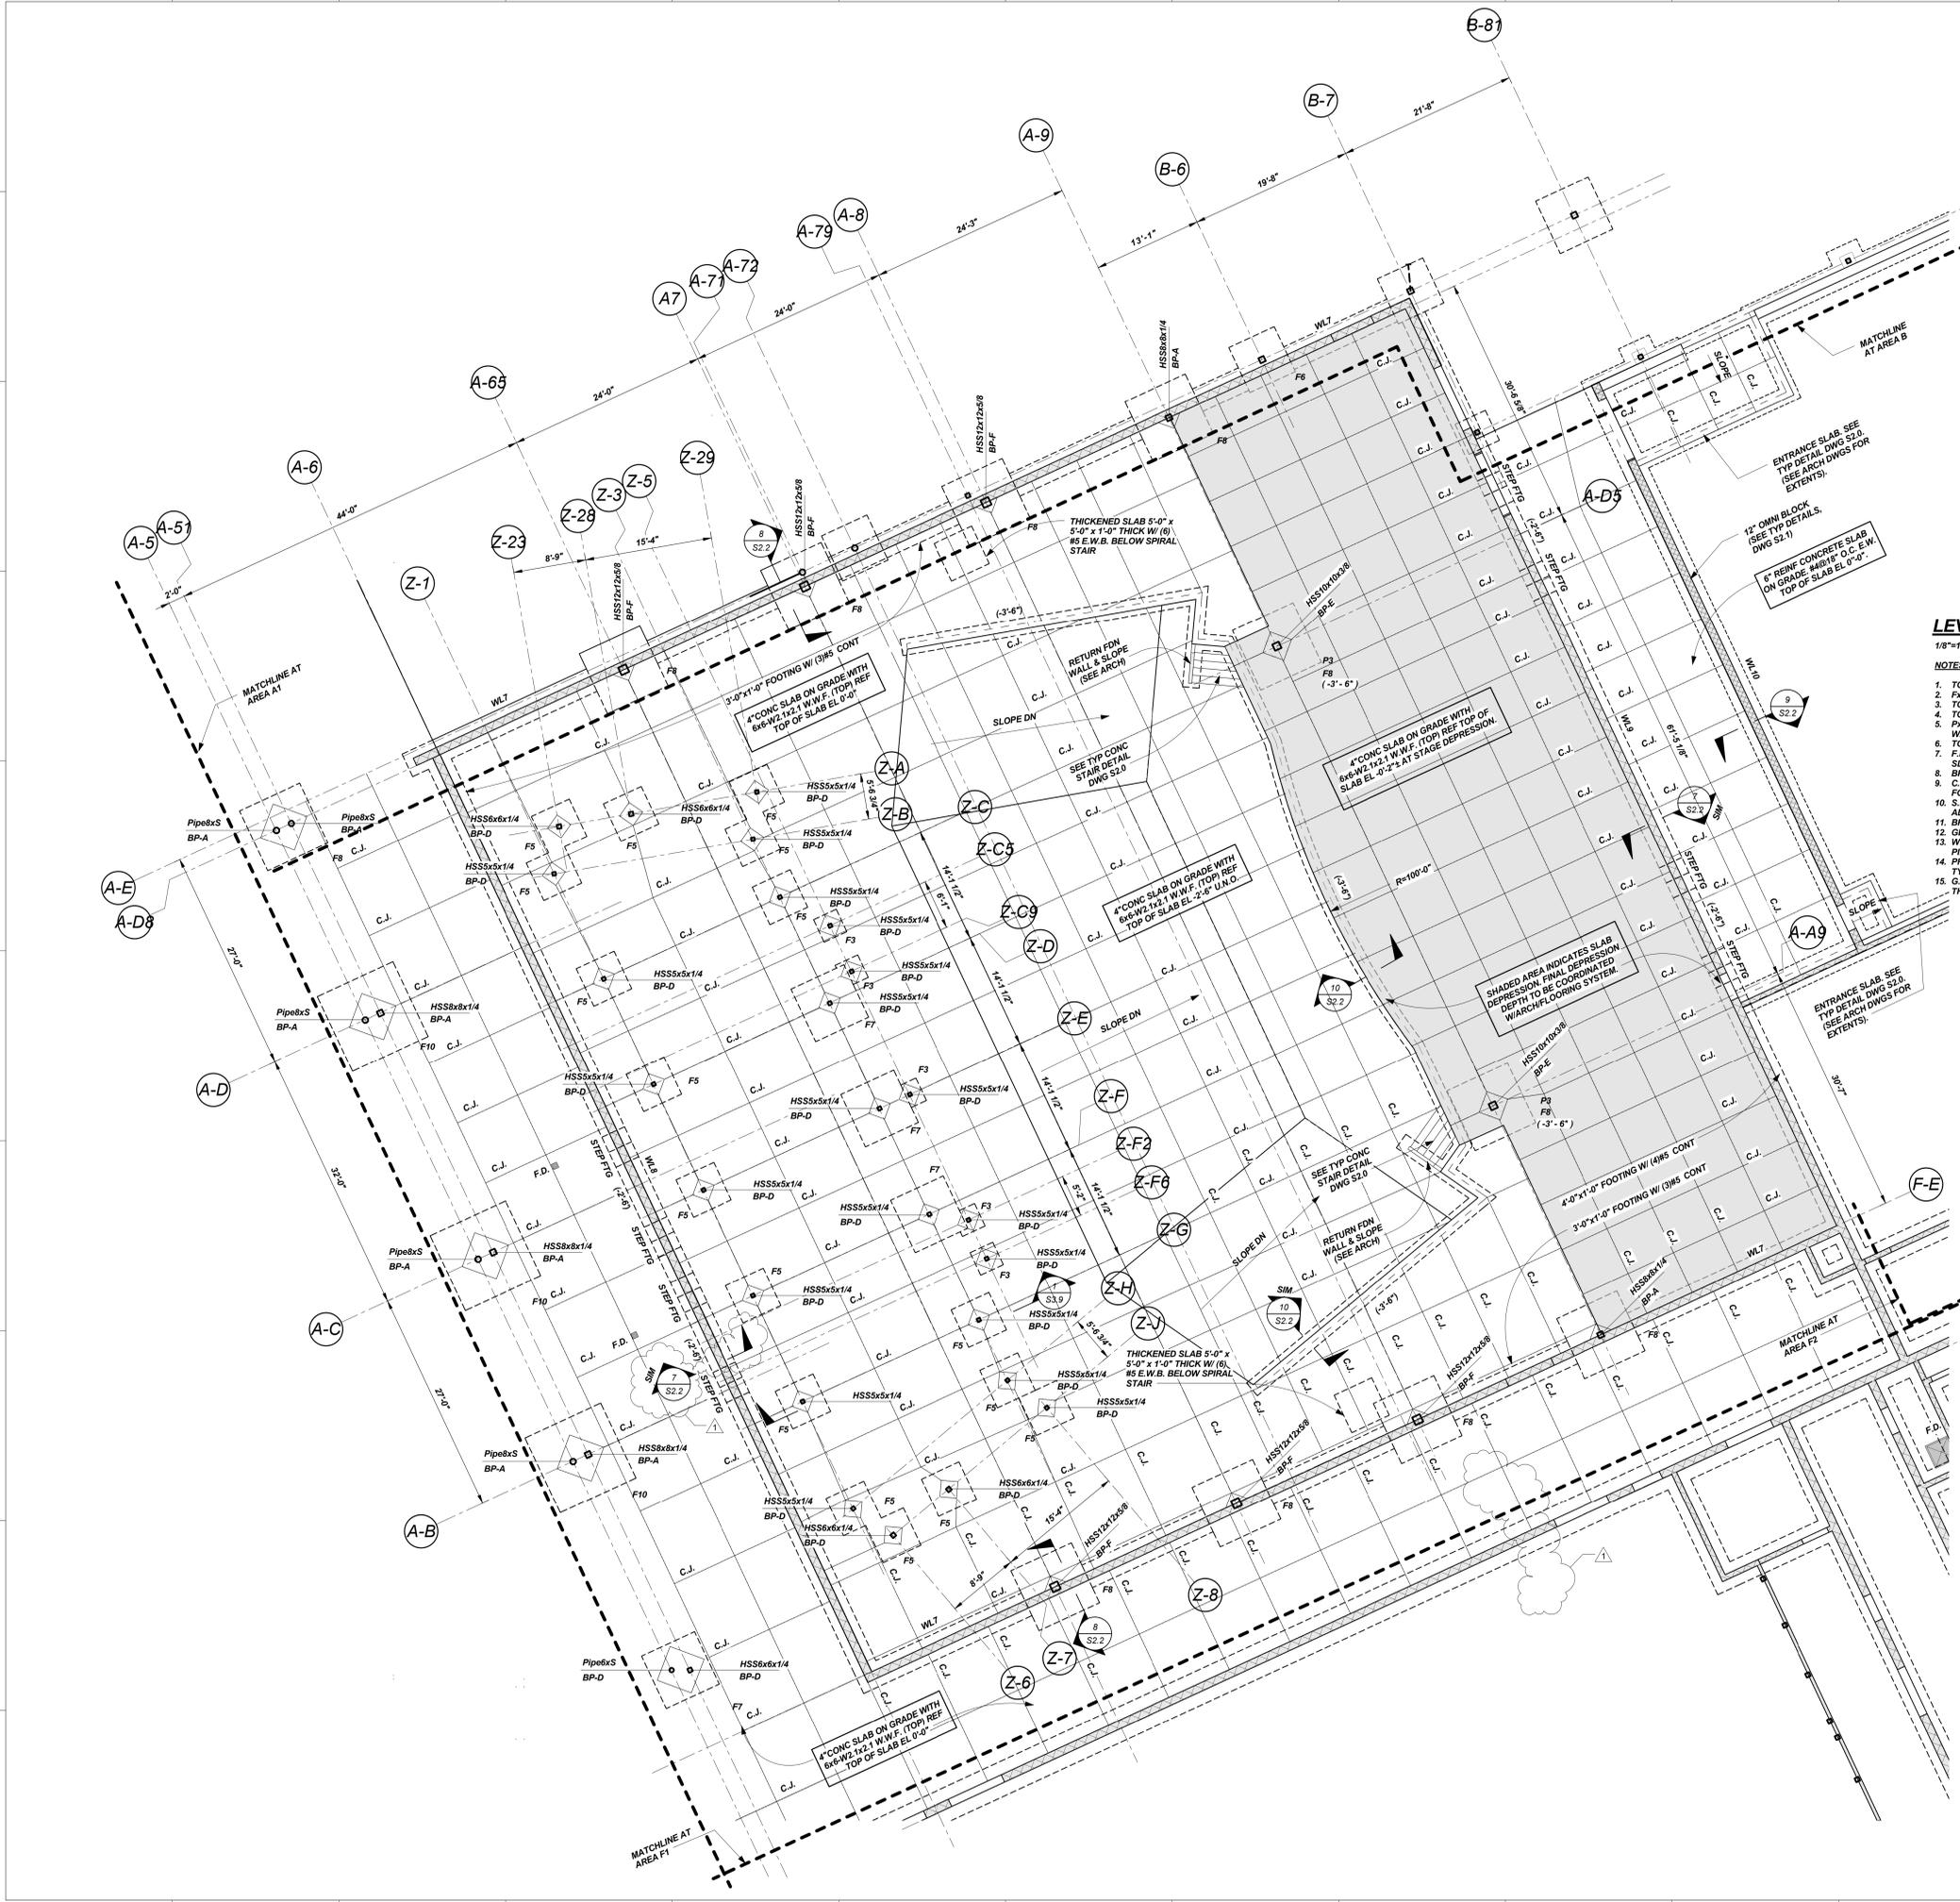


SANFORD SCHOOL  
 DEPARTMENT AND STATE OF  
 MAINE DEPARTMENT OF  
 EDUCATION

**SANFORD HIGH SCHOOL AND TECHNICAL CENTER**

SANFORD, ME 04073

NO.	DESCRIPTION	DATE
3	Addendum 3	03/04/16

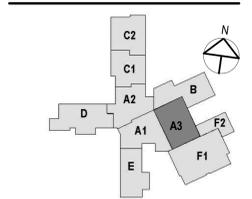

CONTENT:  
 LEVEL 1 PART FOUNDATION PLAN - AREA A3

DRAWN BY: BSE  
 PROJECT NO: 12-067-00  
 DATE: 02/11/2016  
 REVISED:  
 SCALE: As indicated


**S1.3**

Project Phase  
 POST CD ADDENDUMS & REVISIONS

COPYRIGHT © BY LAVALLEE BRENSINGER PROFESSIONAL ASSOCIATION. ALL RIGHTS RESERVED. NO REPRODUCTION WITHOUT PERMISSION.



NO.	DESCRIPTION	DATE
1	Addendum 3	03/04/16

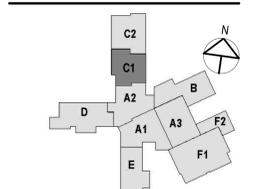

CONTENT:  
LEVEL 1 PART FOUNDATION PLAN - AREA C1

DRAWN BY: BSE

PROJECT NO: 12-067-00

DATE: 02/11/2016


REVISED:

SCALE: As indicated

**S1.5**

Project Phase  
POST CD ADDENDUMS & REVISIONS

COPYRIGHT © BY LAVALLEEBRENSINGER PROFESSIONAL ASSOCIATION. ALL RIGHTS RESERVED. NO REPRODUCTION WITHOUT PERMISSION.

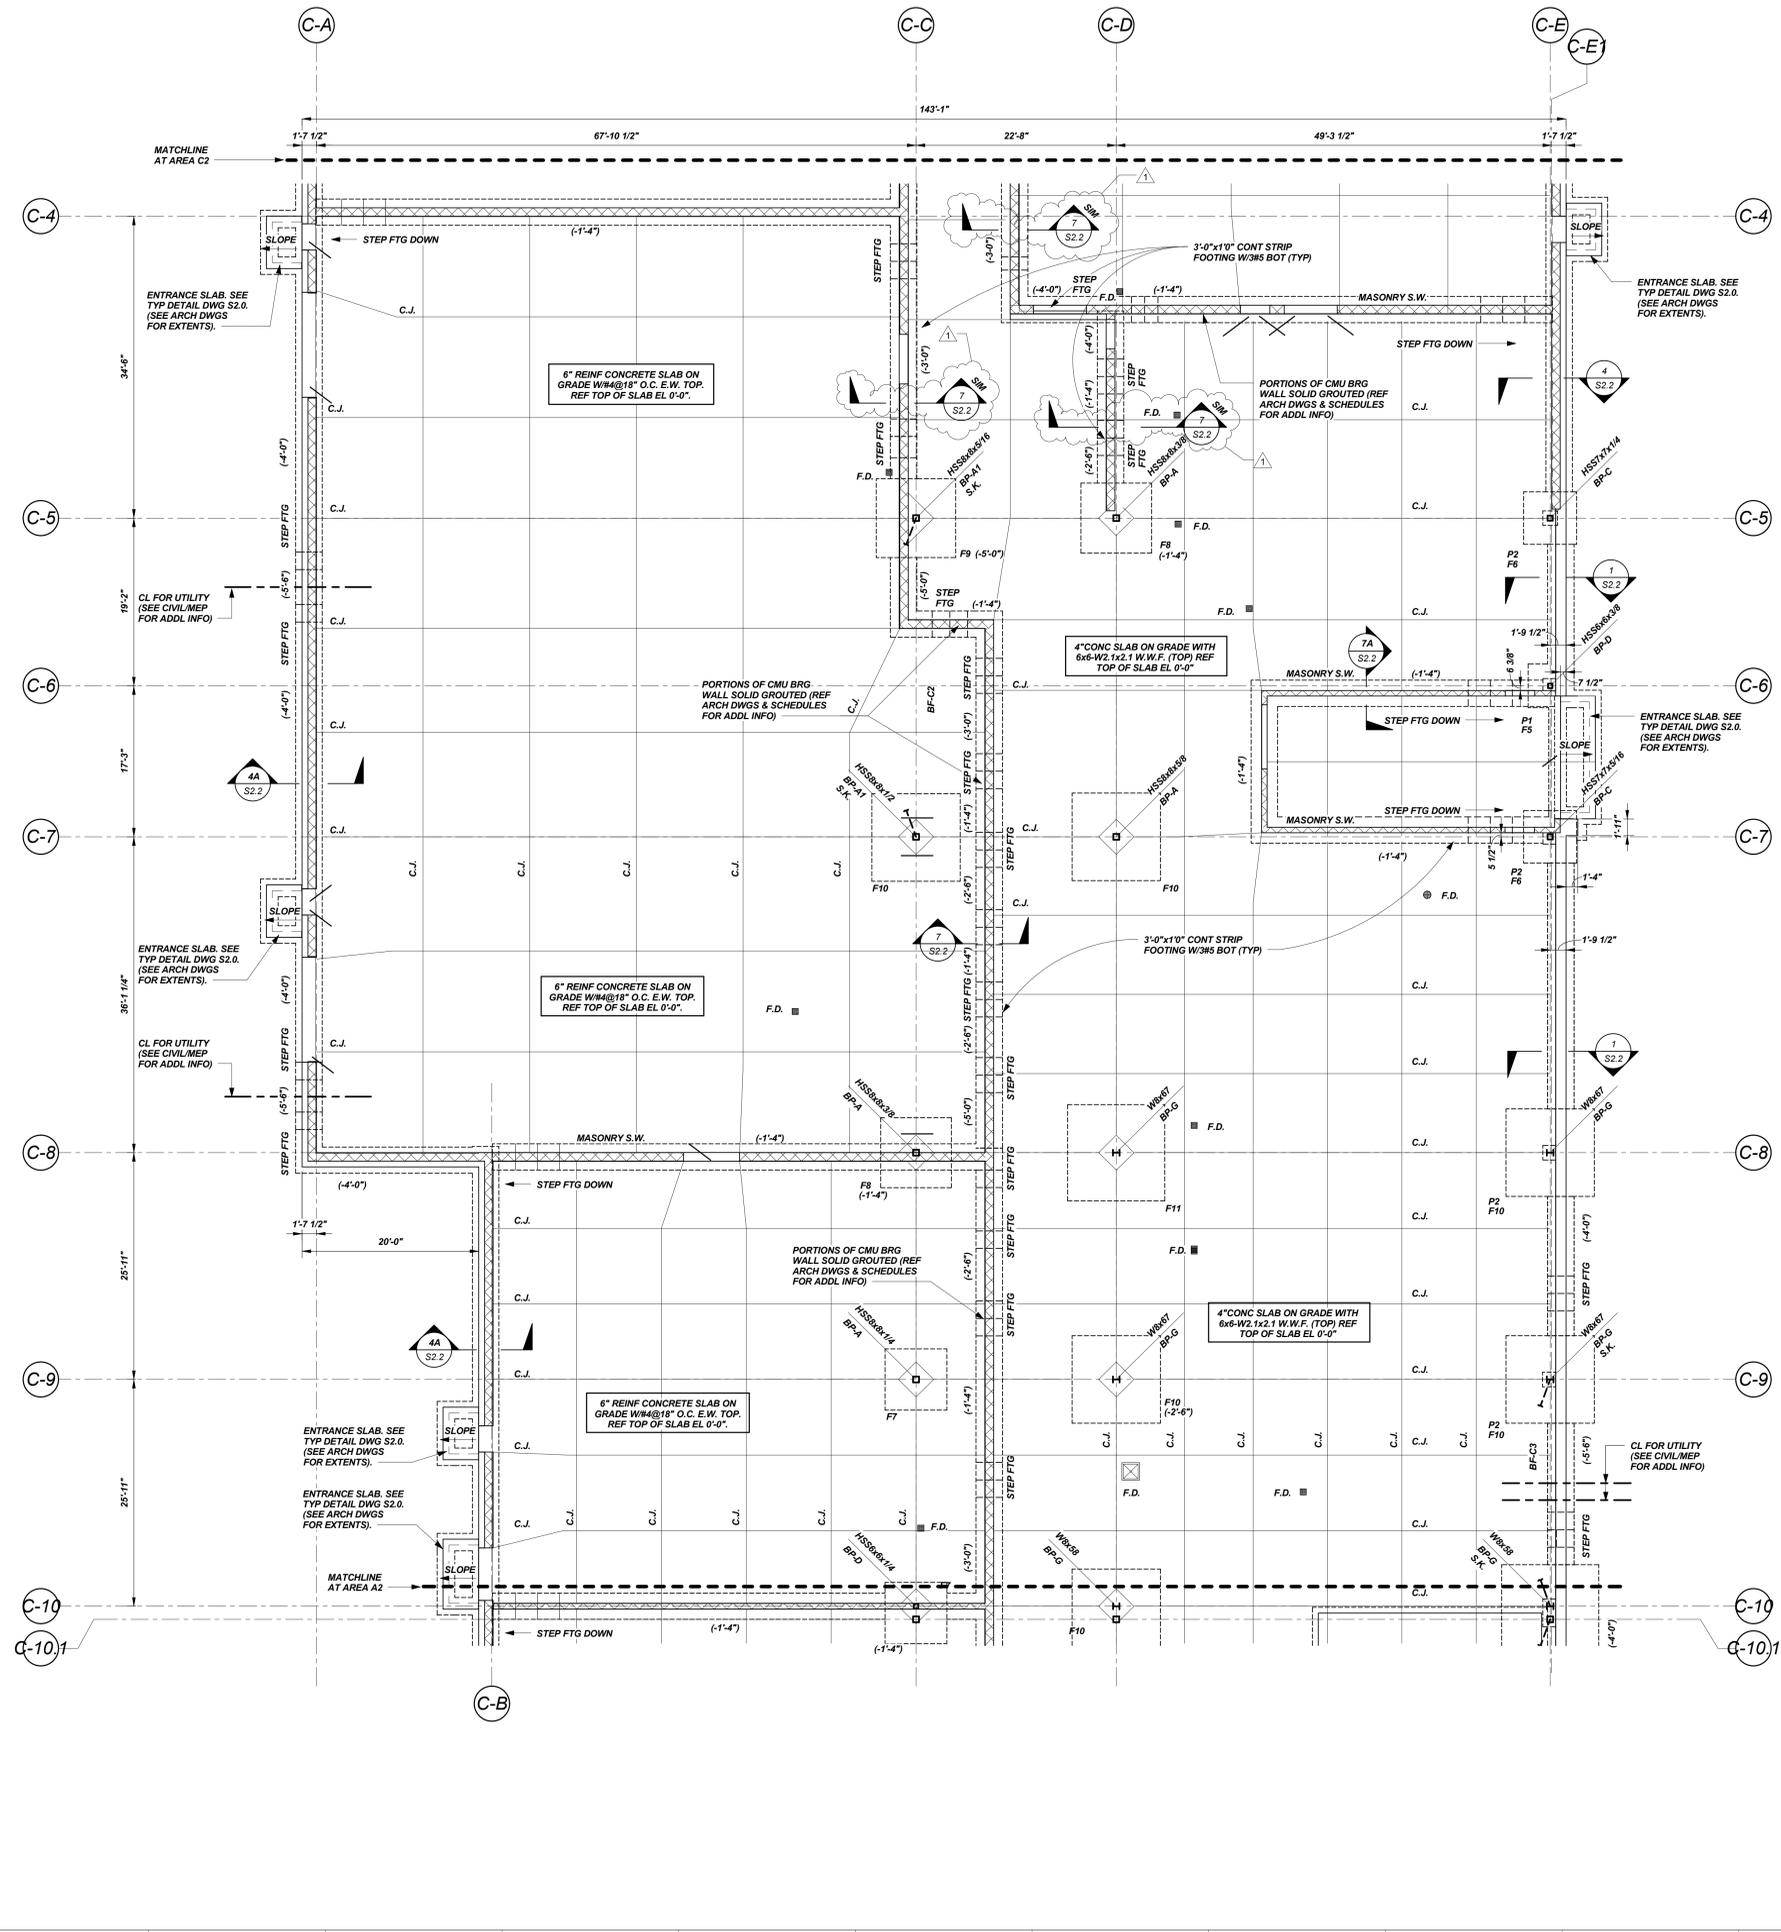


FOOTING MARK	FOOTING SIZE	REINFORCING
F3	3'-0\"x3'-0\"x1'-0\"	4#4 E.W.B.
F4	4'-0\"x4'-0\"x1'-0\"	4#4 E.W.B.
F5	5'-0\"x5'-0\"x1'-0\"	5#5 E.W.B.
F6	6'-0\"x6'-0\"x1'-2\"	6#6 E.W.B.
F7	7'-0\"x7'-0\"x1'-6\"	6#6 E.W.B.
F8	8'-0\"x8'-0\"x1'-8\"	6#7 E.W.B.
F9	9'-0\"x9'-0\"x1'-10\"	8#7 E.W.B.
F10	10'-0\"x10'-0\"x2'-0\"	9#7 E.W.B.
F11	11'-0\"x11'-0\"x2'-2\"	8#8 E.W.B.
F12	12'-0\"x12'-0\"x2'-4\"	10#8 E.W.B.
F57	5'-0\"x7'-0\"x1'-6\"	4#6 L.W.B. 6#6 S.W.B.
F810	8'-0\"x10'-0\"x1'-8\"	8#6 L.W.B. 10#6 S.W.B.
F912	9'-0\"x12'-0\"x2'-4\"	6#8 L.W.B. 10#8 S.W.B.
F1011	10'-0\"x11'-0\"x2'-2\"	7#8 L.W.B. 8#8 S.W.B.

\* INDICATES FOOTING W/ REINF TOP & BOTTOM.

- LEVEL 1 PART FOUNDATION PLAN**  
1/8\"=1'-0\"
- NOTES:**
- TOP OF WALL EL 0'-0\" U.N.O. BY (-0'-9\"), ETC.
  - F<sub>x</sub> INDICATES CONCRETE FOOTING. SEE SCHEDULE THIS DWG FOR SIZE & REINF.
  - TOP OF INTERIOR FOOTING EL (-1'-0\") U.N.O.
  - TOP OF EXTERIOR FOOTING EL (-3'-10\") U.N.O.
  - F<sub>x</sub> INDICATES REINFORCED CONCRETE PIER. SEE PIER DETAILS DWG S2.3. NOTE: BOND OUT WALL STEM AS READ FOR BASE PLATE. DO NOT BOND OUT BRICKSHELF.
  - TOP OF PIER EL (-0'-8\") U.N.O.
  - F.D. INDICATES FLOOR DRAIN. COORD ALL FLOOR DRAINS (W/ASSOCIATED SLOPES) & SLAB PENETRATIONS W/ARCH & MEP DWGS.
  - BP<sub>x</sub> INDICATES COLUMN BASE PLATE. SEE DWG S3.1 FOR BASE PLATE DETAILS.
  - C.J. INDICATES SLAB CONTRACTION/CONSTRUCTION JOINT. SEE TYP DETAILS DWG S2.1 FOR ADDL INFO.
  - S.K. INDICATES SHEAR KEY. SEE DETAIL A/S4.1 & BASE PLATES DETAILS, DWG S3.1 FOR ADDITIONAL INFORMATION.
  - BF-1, BF-2, ETC INDICATES BRACED FRAME. SEE BRACED FRAME ELEVATIONS DWG S4.X.
  - GB-1 INDICATES GRADE BEAM. SEE TYP DETAIL DWG S2.1.
  - WL.1, WL.2, ETC. INDICATES WALL LOCATIONS THAT REQUIRE THE RAMMED AGGREGATE PIER SYSTEM. SEE PLANS FOR LOCATIONS & DWG S01 FOR ADDL INFO.
  - PROVIDE THICKENED SLAB AT CMU PARTITIONS. SEE ARCH DWGS FOR LOCATIONS. SEE TYP DETAIL DWG S2.1.
  - G. C. TO COORDINATE ALL PLUMBING WITH FOOTING ELEVATIONS. DO NOT SLEEVE THROUGH FOOTINGS.




NO.	DESCRIPTION	DATE
1	Addendum 3	03/04/16

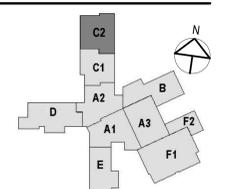

FOOTING MARK	FOOTING SIZE	REINFORCING
F3	3'-0"x3'-0"x1'-0"	4#4 E.W.B.
F4	4'-0"x4'-0"x1'-0"	4#4 E.W.B.
F5	5'-0"x5'-0"x1'-0"	5#5 E.W.B.
F6	6'-0"x6'-0"x1'-2"	6#6 E.W.B.
F7	7'-0"x7'-0"x1'-6"	6#6 E.W.B.
F8	8'-0"x8'-0"x1'-8"	6#7 E.W.B.
F9	9'-0"x9'-0"x1'-10"	8#7 E.W.B.
F10	10'-0"x10'-0"x2'-0"	9#7 E.W.B.
F11	11'-0"x11'-0"x2'-2"	8#8 E.W.B.
F12	12'-0"x12'-0"x2'-4"	10#8 E.W.B.
F57	5'-0"x7'-0"x1'-6"	4#6 L.W.B. 6#6 S.W.B.
F810	8'-0"x10'-0"x1'-8"	6#6 L.W.B. 10#6 S.W.B.
F912	9'-0"x12'-0"x2'-4"	6#8 L.W.B. 10#8 S.W.B.
F1011	10'-0"x11'-0"x2'-2"	7#8 L.W.B. 8#8 S.W.B.

\* INDICATES FOOTING W/ REINF TOP & BOTTOM.

- LEVEL 1 PART FOUNDATION PLAN**  
1/8"=1'-0"
- NOTES:**
- TOP OF WALL EL 0'-0" U.N.O. BY (0'-8") ETC.
  - Fx INDICATES CONCRETE FOOTING. SEE SCHEDULE THIS DWG FOR SIZE & REINF.
  - TOP OF INTERIOR FOOTING EL (-1'-0") U.N.O.
  - TOP OF EXTERIOR FOOTING EL (-3'-0") U.N.O.
  - Px INDICATES REINFORCED CONCRETE PIER. SEE PIER DETAILS DWG S2.3. NOTE: BOND OUT WALL STEM AS REQD FOR BASE PLATE. DO NOT BOND OUT BRICKSHELF.
  - TOP OF PIER EL (-4'-8") U.N.O.
  - F.D. INDICATES FLOOR DRAIN. COORD ALL FLOOR DRAINS (W/ASSOCIATED SLOPES) & SLAB PENETRATIONS W/ARCH & MEP DWGS.
  - BPx INDICATES COLUMN BASE PLATE. SEE DWG S3.1 FOR BASE PLATE DETAILS.
  - C.J. INDICATES SLAB CONTRACTION/CONSTRUCTION JOINT. SEE TYP DETAILS DWG S2.1 FOR ADDL INFO.
  - S.K. INDICATES SHEAR KEY. SEE DETAIL A/54-1& BASE PLATES DETAILS, DWG S3.1 FOR ADDITIONAL INFORMATION.
  - BF-1, BF-2, ETC INDICATES BRACED FRAME. SEE BRACED FRAME ELEVATIONS DWG S4.X.
  - GB-1 INDICATES GRADE BEAM. SEE TYP DETAIL DWG S2.1.
  - WL1, WL2, ETC. INDICATES WALL LOCATIONS THAT REQUIRE THE RAMMED AGGREGATE PIER SYSTEM. SEE PLANS FOR LOCATIONS & DWG S01 FOR ADDL INFO.
  - PROVIDE THICKENED SLAB AT CMU PARTITIONS. SEE ARCH DWGS FOR LOCATIONS. SEE TYP DETAIL DWG S2.1.
  - G. C. TO COORDINATE ALL PLUMBING WITH FOOTING ELEVATIONS. DO NOT SLEEVE THROUGH FOOTINGS.

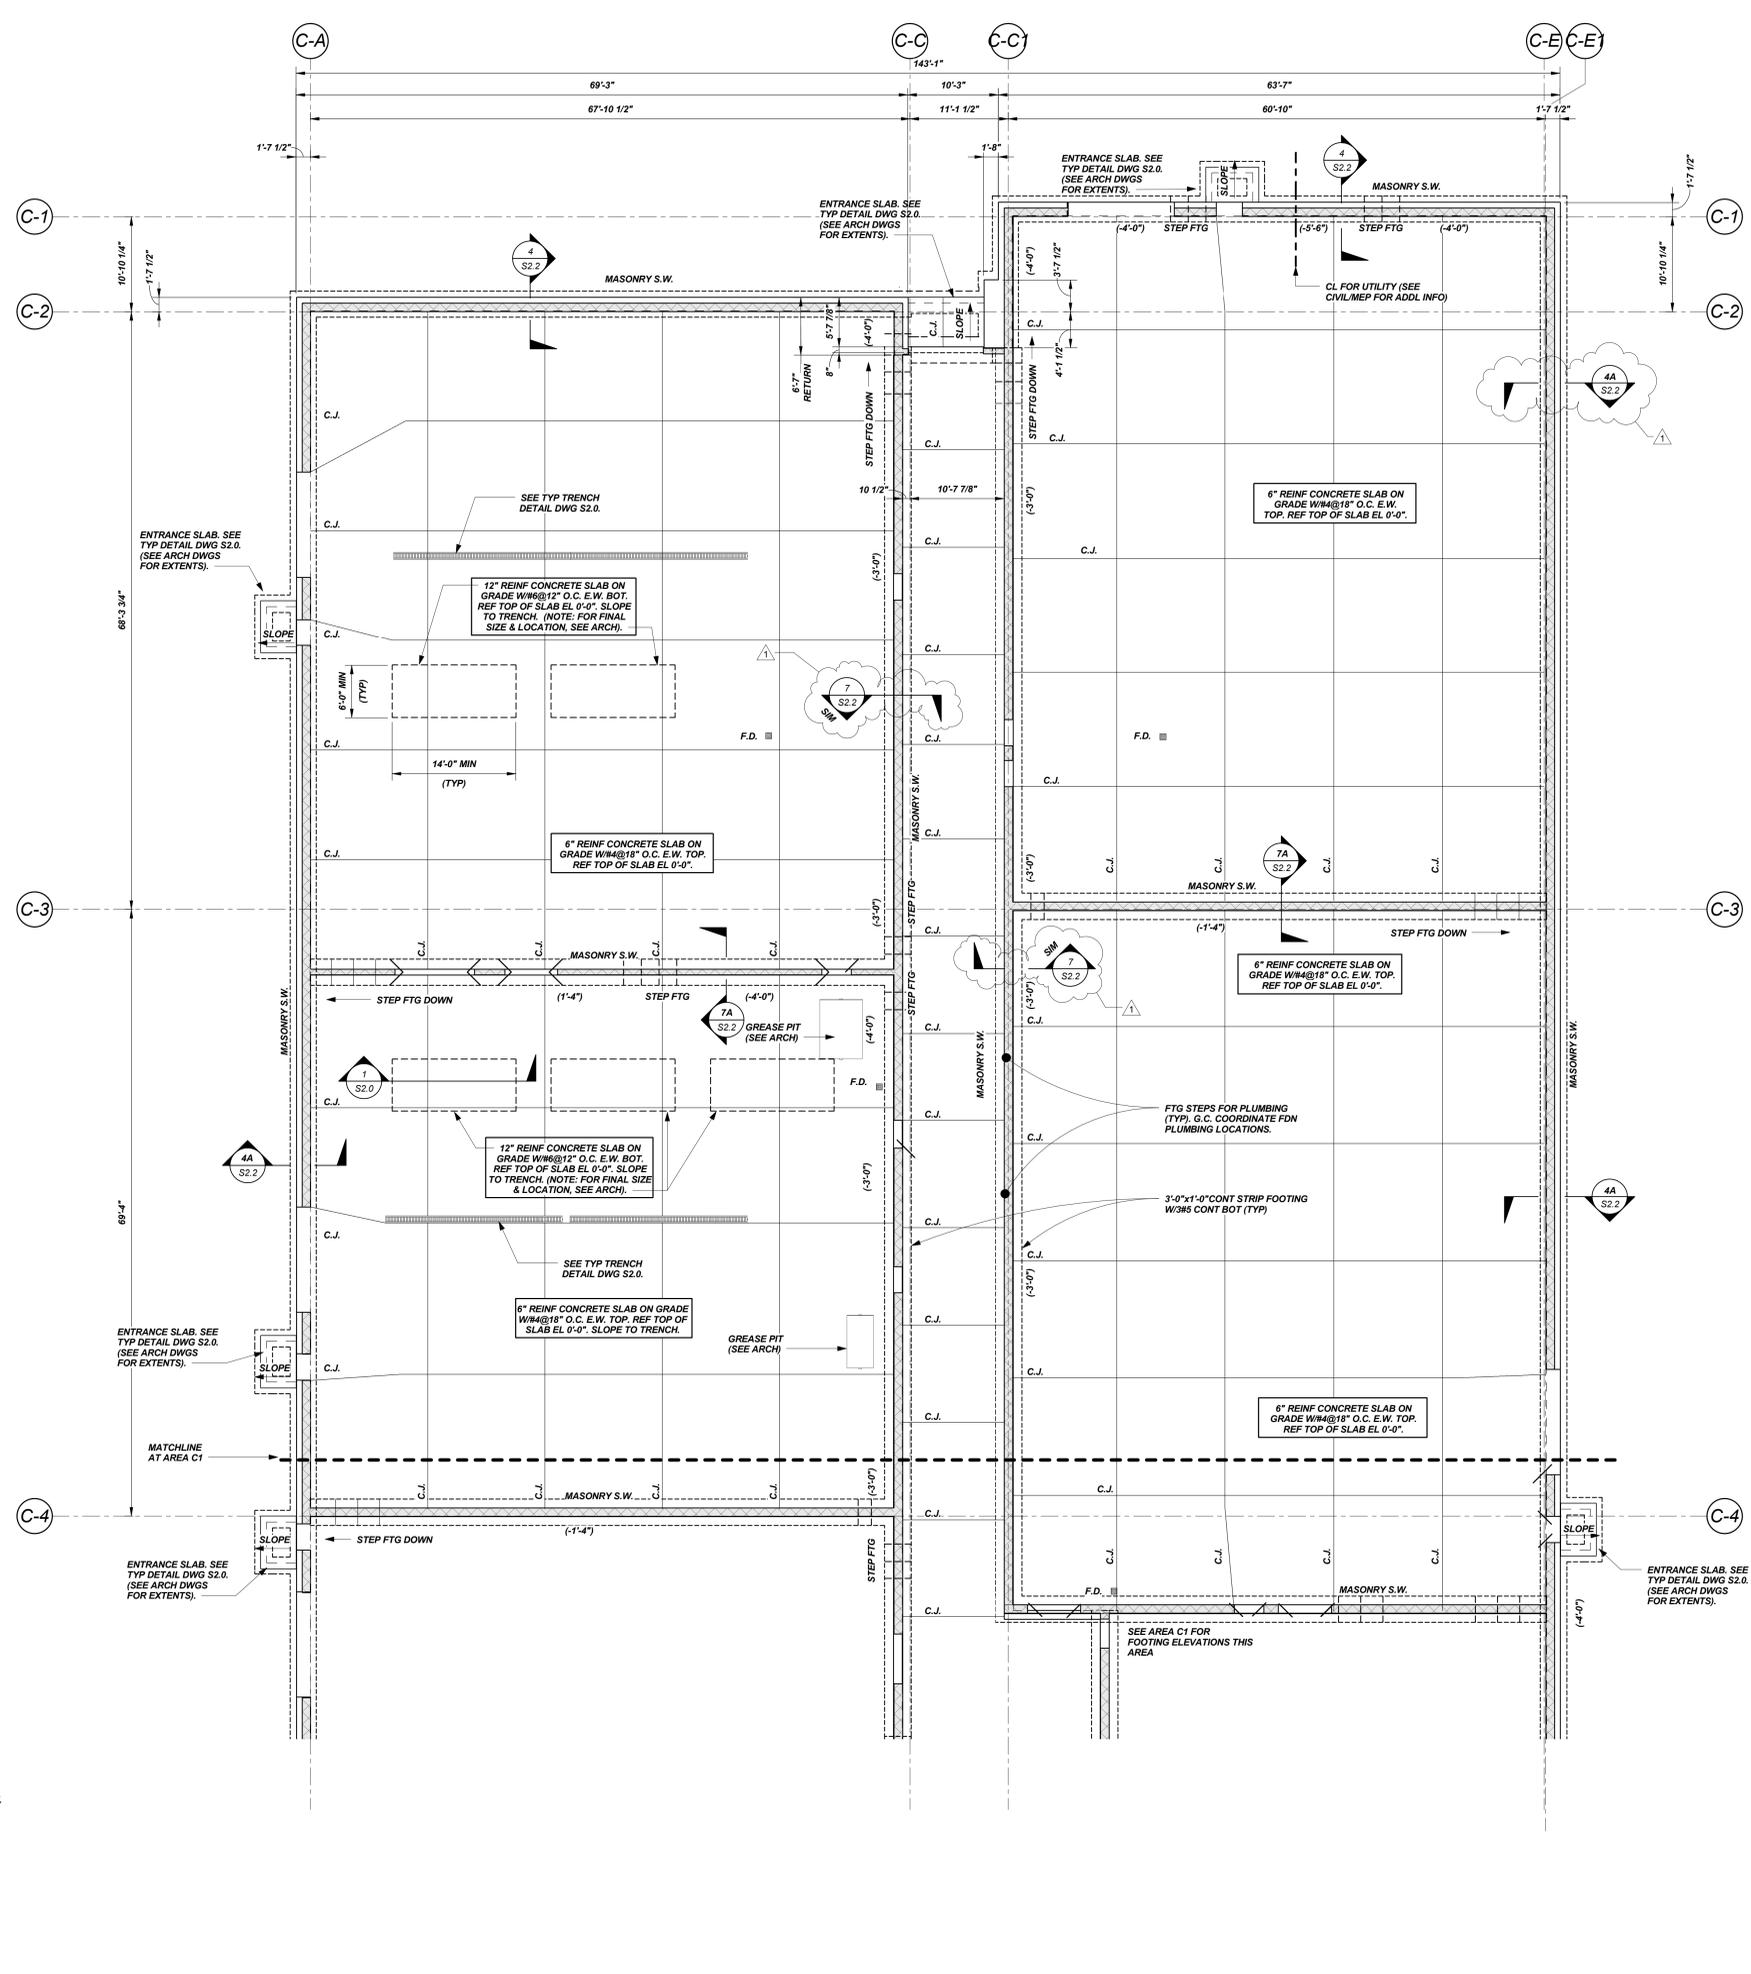

CONTENT:  
LEVEL 1 PART FOUNDATION PLAN - AREA C2

DRAWN BY: BSE

PROJECT NO: 12-067-00

DATE: 02/11/2016

REVISED:


SCALE: As indicated

**S1.6**

Project Phase

POST CD ADDENDUMS & REVISIONS

COPYRIGHT © BY LAVALLEEBRENSINGER PROFESSIONAL ASSOCIATION. ALL RIGHTS RESERVED. NO REPRODUCTION WITHOUT PERMISSION.

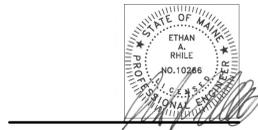


SANFORD SCHOOL  
DEPARTMENT AND STATE OF  
MAINE DEPARTMENT OF  
EDUCATION

**SANFORD HIGH  
SCHOOL AND  
TECHNICAL CENTER**

SANFORD, ME 04073

NO.	DESCRIPTION	DATE
1	Addendum 3	03/04/16

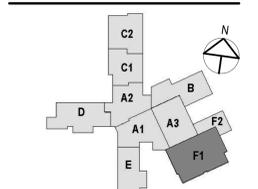

CONTENT:  
LEVEL 1 PART FOUNDATION PLAN - AREA F1

FOR ADDITIONAL INFORMATION, REFER TO PROJECT MANUAL.

DRAWN BY: BSE

PROJECT NO: 12-067-00

DATE: 02/11/2016

REVISED:


SCALE: As indicated

**S1.9**

Project Phase

POST CD ADDENDUMS & REVISIONS

COPYRIGHT © BY LAVALLEEBRENSINGER PROFESSIONAL ASSOCIATION. ALL RIGHTS RESERVED. NO REPRODUCTION WITHOUT PERMISSION.

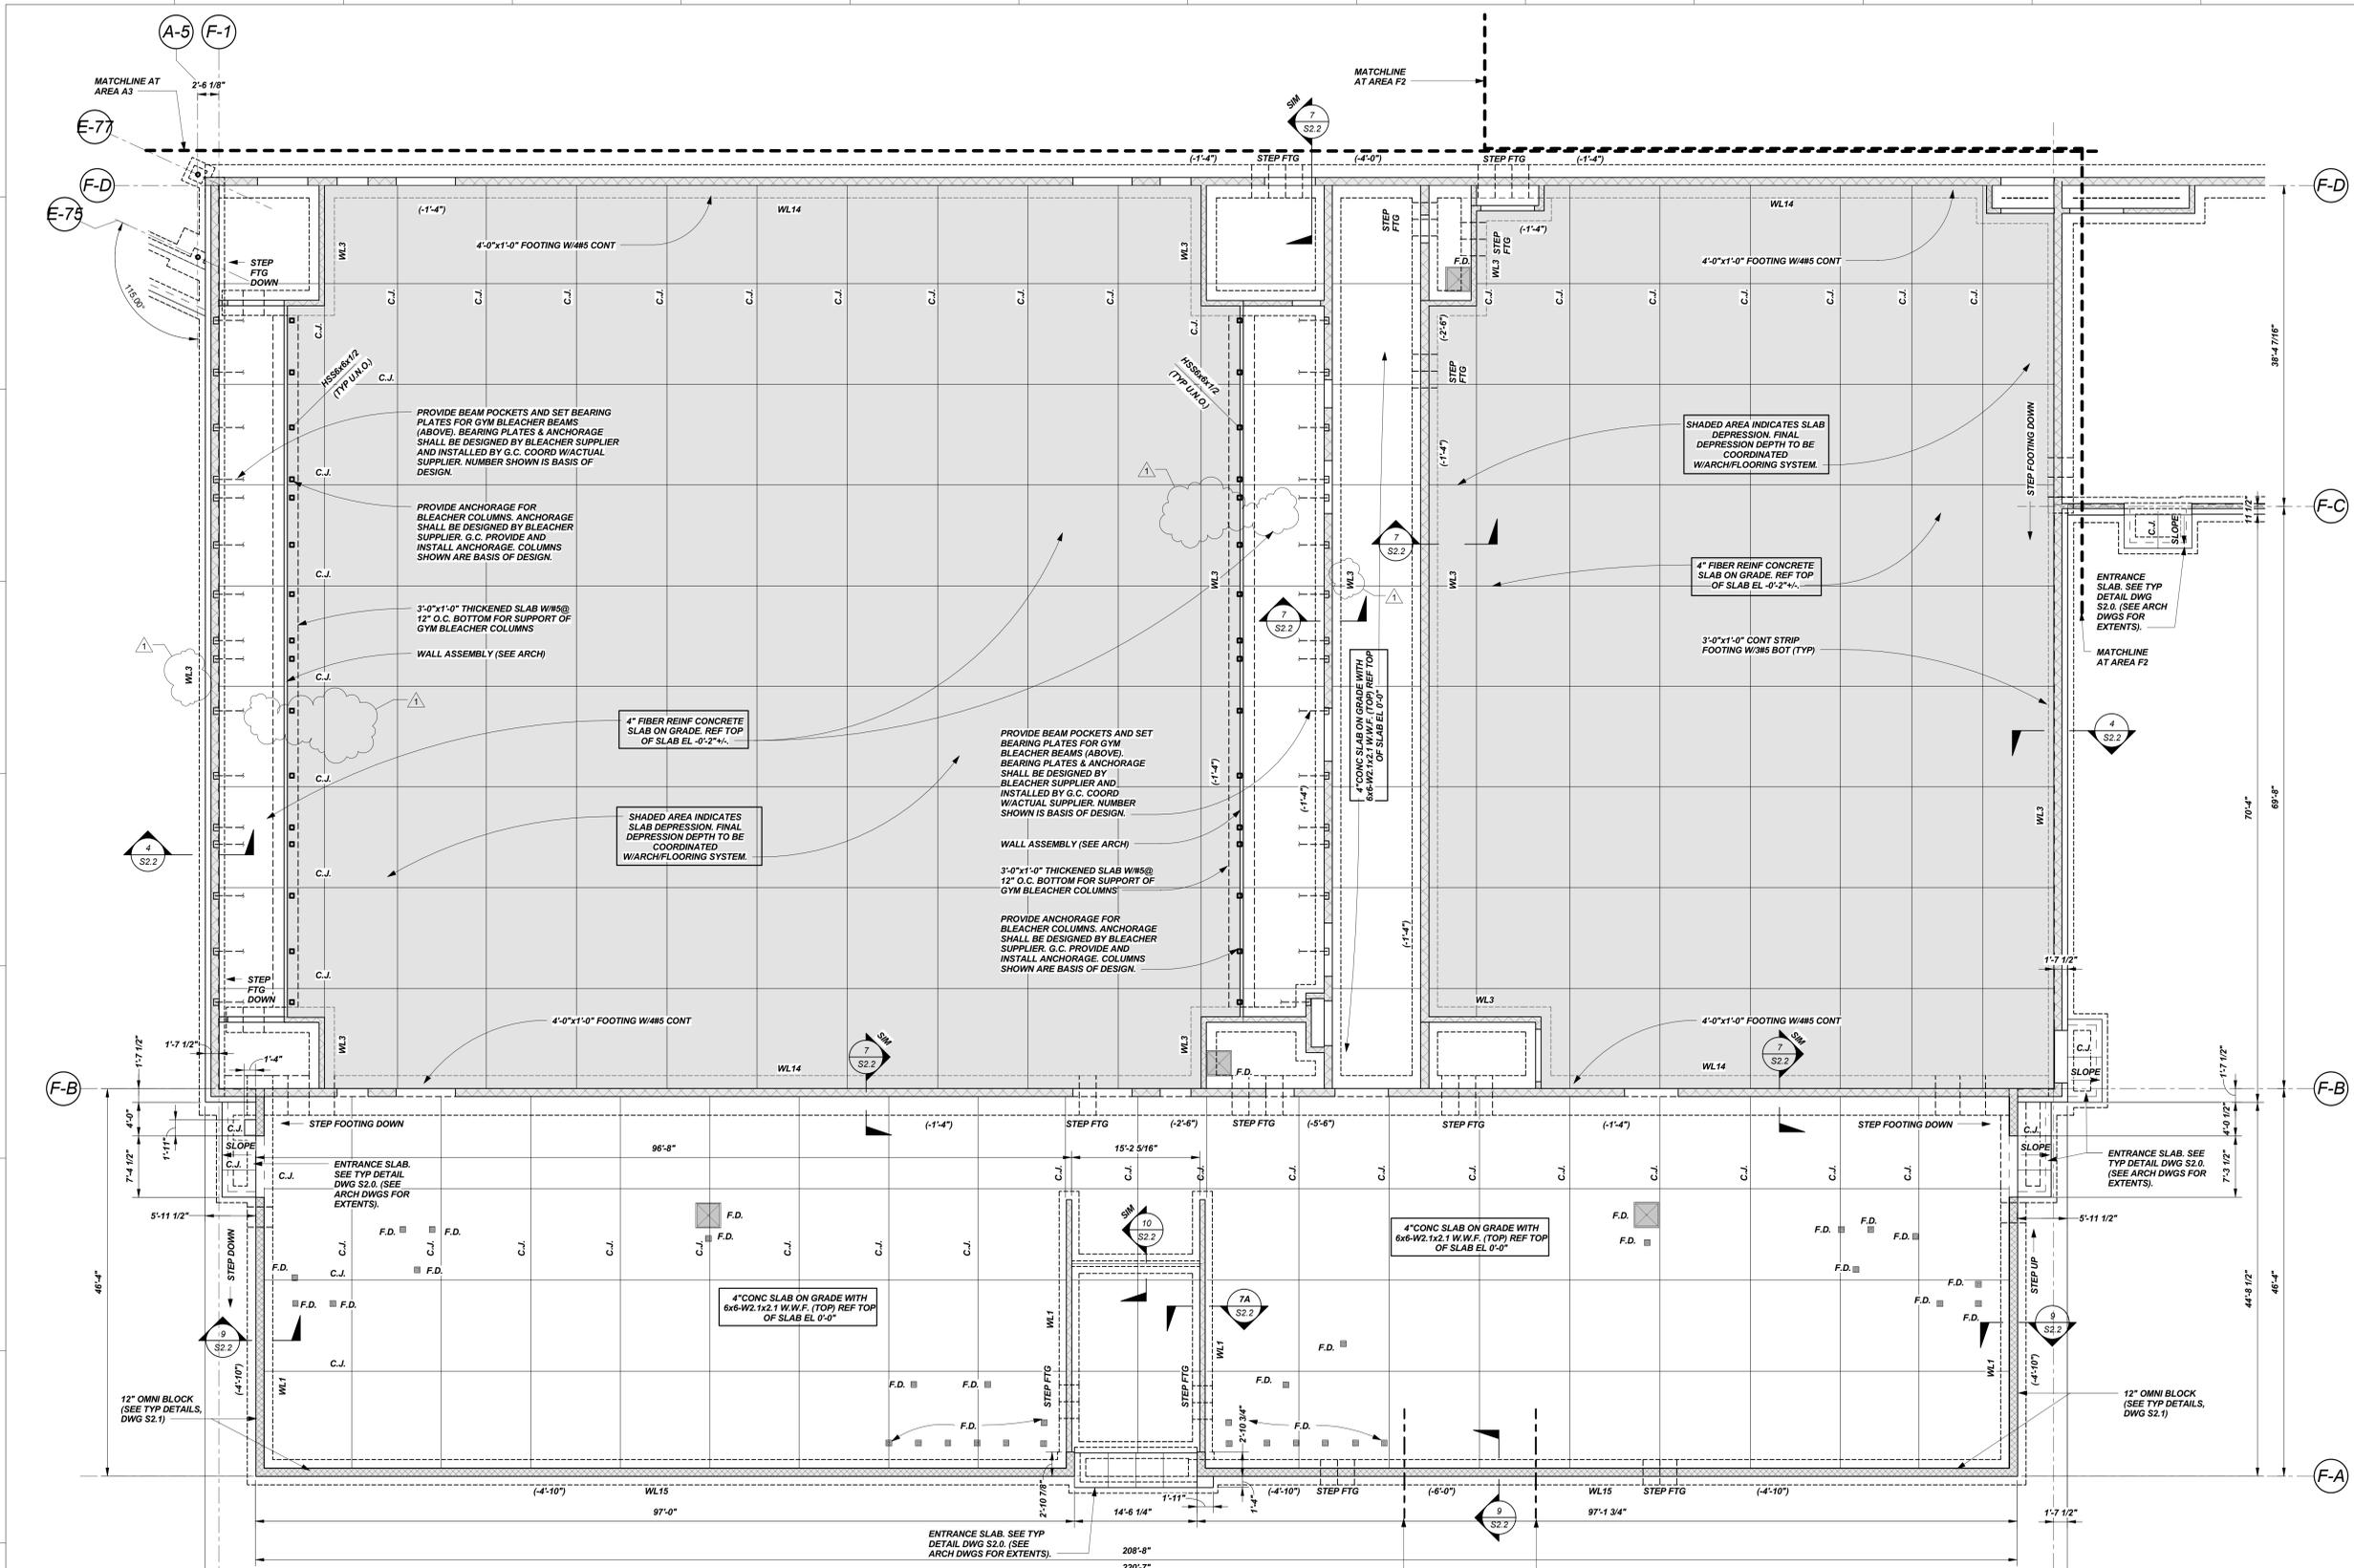


**FOOTING SCHEDULE**

FOOTING MARK	FOOTING SIZE	REINFORCING
F3	3'-0"x3'-0"x1'-0"	4#4 E.W.B.
F4	4'-0"x4'-0"x1'-0"	4#4 E.W.B.
F5	5'-0"x5'-0"x1'-0"	5#5 E.W.B.
F6	6'-0"x6'-0"x1'-2"	6#6 E.W.B.
F7	7'-0"x7'-0"x1'-6"	6#6 E.W.B.
F8	8'-0"x8'-0"x1'-8"	6#7 E.W.B.
F9	9'-0"x9'-0"x1'-10"	6#7 E.W.B.
F10	10'-0"x10'-0"x2'-0"	9#7 E.W.B.
F11	11'-0"x11'-0"x2'-2"	8#8 E.W.B.
F12	12'-0"x12'-0"x2'-4"	10#8 E.W.B.
F57	5'-0"x7'-0"x1'-6"	4#6 L.W.B. 6#6 S.W.B.
F810	8'-0"x10'-0"x1'-8"	6#6 L.W.B. 10#6 S.W.B.
F912	9'-0"x12'-0"x2'-4"	6#8 L.W.B. 10#8 S.W.B.
F1011	10'-0"x11'-0"x2'-2"	7#8 L.W.B. 8#6 S.W.B.

\* INDICATES FOOTING W/ REIN. TOP & BOTTOM.


- LEVEL 1 PART FOUNDATION PLAN**  
1/8"=1'-0"
- NOTES:
- TOP OF WALL EL 0'-0" U.N.O. BY (-0'-8"), ETC.
  - F<sub>x</sub> INDICATES CONCRETE FOOTING. SEE SCHEDULE THIS DWG FOR SIZE & REINF.
  - TOP OF INTERIOR FOOTING EL (-1'-0") U.N.O.
  - TOP OF EXTERIOR FOOTING EL (-3'-10") U.N.O.
  - P<sub>x</sub> INDICATES REIN. CONCRETE PIER. SEE PIER DETAILS DWG S2.3. NOTE: BOND OUT WALL STEM AS REQD FOR BASE PLATE. DO NOT BOND OUT BRICKSHELF.
  - TOP OF PIER EL (-0'-5") U.N.O.
  - F.D. INDICATES FLOOR DRAIN. COORD ALL FLOOR DRAINS (W/ASSOCIATED SLOPES) & SLAB PENETRATIONS W/ARCH & MEP DWGS.
  - 8P<sub>x</sub> INDICATES COLUMN BASE PLATE. SEE DWG S3.1 FOR BASE PLATE DETAILS.
  - C.J. INDICATES SLAB CONTRACTION/CONSTRUCTION JOINT. SEE TYP DETAILS DWG S2.1 FOR ADDL INFO.
  - S.A. INDICATES SHEAR KEY. SEE DETAIL A/4.1& BASE PLATES DETAILS, DWG S3.1 FOR ADDITIONAL INFORMATION.
  - BF-1, BF-2, ETC INDICATES BRACED FRAME. SEE BRACED FRAME ELEVATIONS DWG S4.X.
  - GB-1 INDICATES GRADE BEAM. SEE TYP DETAIL DWG S2.1.
  - WL1, WL2, ETC. INDICATES WALL LOCATIONS THAT REQUIRE THE RAMMED AGGREGATE PIER SYSTEM. SEE PLANS FOR LOCATIONS & DWG S01 FOR ADDL INFO.
  - PROVIDE THICKENED SLAB AT CMU PARTITIONS. SEE ARCH DWGS FOR LOCATIONS. SEE TYP DETAIL DWG S2.1.
  - G.C. TO COORDINATE ALL PLUMBING WITH FOOTING ELEVATIONS. DO NOT SLEEVE THROUGH FOOTINGS.

3/20/16 12:15 PM C:\Users\wherry\Documents\3261 SANFORD TECH FACILITY\CENTRAL\_1\F5\_Wherry.rvt

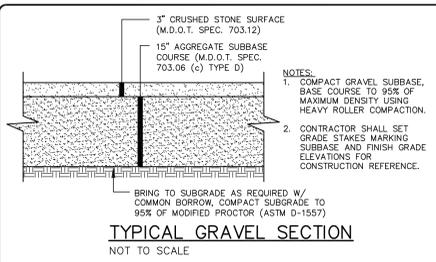


- NOTES:**
1. COMPACT GRAVEL SUBBASE AND BASE COURSES TO 95% OF MAXIMUM DENSITY USING HEAVY ROLLER COMPACTION.
  2. CONTRACTOR SHALL SET GRADE STAKES MARKING SUBBASE AND FINISH GRADE ELEVATIONS FOR CONSTRUCTION REFERENCE.

**TYPICAL GRAVEL SECTION**  
NOT TO SCALE

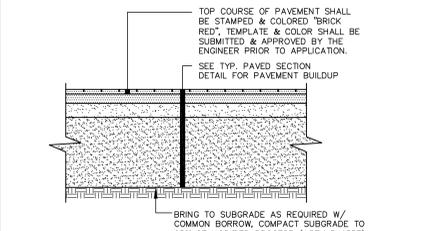


- NOTES:**
1. COMPACT GRAVEL SUBBASE AND BASE COURSES TO 95% OF MAXIMUM DENSITY USING HEAVY ROLLER COMPACTION.
  2. HOT MIX ASPHALT SHALL BE COMPACTED TO 92% TO 97% OF ITS THEORETICAL MAXIMUM DENSITY AS DETERMINED BY ASTM D-2041.
  3. APPLY TACK COAT BETWEEN SUCCESSIVE LIFTS OF BITUMINOUS PAVEMENT.
  4. CONTRACTOR SHALL SET GRADE STAKES MARKING SUBBASE AND FINISH GRADE ELEVATIONS FOR CONSTRUCTION REFERENCE.

**TYP. STAMPED PAVEMENT SECTION**  
NOT TO SCALE

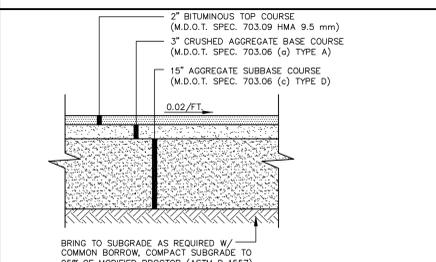


- NOTES:**
1. COMPACT GRAVEL SUBBASE AND BASE COURSES TO 95% OF MAXIMUM DENSITY USING HEAVY ROLLER COMPACTION.
  2. HOT MIX ASPHALT SURFACE COURSE SHALL BE COMPACTED TO 95% OF ITS THEORETICAL MAXIMUM DENSITY (ASTM D-2041). BASE COURSE SHALL BE COMPACTED TO 95% ±2.5% OF ITS THEORETICAL MAXIMUM DENSITY (ASTM D-2041).
  3. APPLY TACK COAT BETWEEN SUCCESSIVE LIFTS OF BITUMINOUS PAVEMENT.
  4. CONTRACTOR SHALL SET GRADE STAKES MARKING SUBBASE AND FINISH GRADE ELEVATIONS FOR CONSTRUCTION REFERENCE.

**PEDESTRIAN PAVING**  
NOT TO SCALE

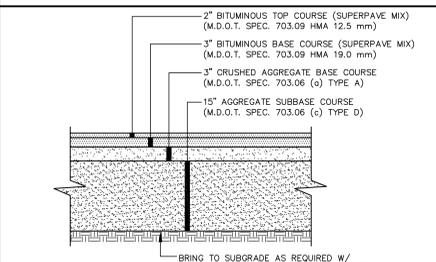

- NOTES:**
1. COMPACT GRAVEL SUBBASE AND BASE COURSES TO 95% OF MAXIMUM DENSITY USING HEAVY ROLLER COMPACTION.
  2. HOT MIX ASPHALT SURFACE COURSE SHALL BE COMPACTED TO 95% OF ITS THEORETICAL MAXIMUM DENSITY (ASTM D-2041). BASE COURSE SHALL BE COMPACTED TO 95% ±2.5% OF ITS THEORETICAL MAXIMUM DENSITY (ASTM D-2041).
  3. APPLY TACK COAT BETWEEN SUCCESSIVE LIFTS OF BITUMINOUS PAVEMENT.
  4. CONTRACTOR SHALL SET GRADE STAKES MARKING SUBBASE AND FINISH GRADE ELEVATIONS FOR CONSTRUCTION REFERENCE.

**SUPERPAVE HEAVY DUTY PAVEMENT AREA**  
NOT TO SCALE

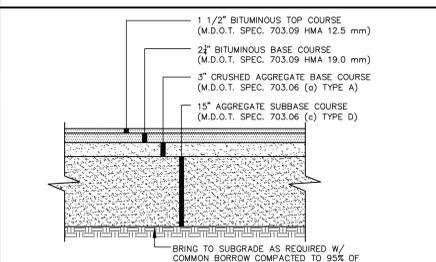


- NOTES:**
1. COMPACT GRAVEL SUBBASE AND BASE COURSES TO 95% OF MAXIMUM DENSITY USING HEAVY ROLLER COMPACTION.
  2. HOT MIX ASPHALT SURFACE COURSE SHALL BE COMPACTED TO 95% OF ITS THEORETICAL MAXIMUM DENSITY (ASTM D-2041). BASE COURSE SHALL BE COMPACTED TO 95% ±2.5% OF ITS THEORETICAL MAXIMUM DENSITY (ASTM D-2041).
  3. APPLY TACK COAT BETWEEN SUCCESSIVE LIFTS OF BITUMINOUS PAVEMENT.
  4. CONTRACTOR SHALL SET GRADE STAKES MARKING SUBBASE AND FINISH GRADE ELEVATIONS FOR CONSTRUCTION REFERENCE.
  5. SEE SITE PLANS FOR SUPERPAVE PAVEMENT AREAS.


**PARKING AREA PAVING SECTION**  
NOT TO SCALE




- NOTES:**
1. CONTRACTOR SHALL SET GRADE STAKES MARKING SUBBASE AND FINISH GRADE ELEVATIONS FOR CONSTRUCTION REFERENCE.
  2. POROUS PAVEMENT SECTION SHALL BE CONSTRUCTED PER MDT SPECIAL PROVISION 404 - ASPHALT TREATED PERMEABLE BASE.
  3. APPLY TACK COAT BETWEEN SUCCESSIVE LIFTS OF BITUMINOUS PAVEMENT.
  4. CONTRACTOR SHALL SET GRADE STAKES MARKING SUBBASE AND FINISH GRADE ELEVATIONS FOR CONSTRUCTION REFERENCE.

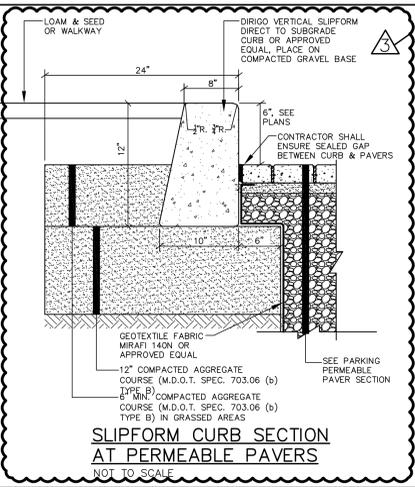


**SLIPFORM CURB SECTION AT PERMEABLE PAVERS**  
NOT TO SCALE

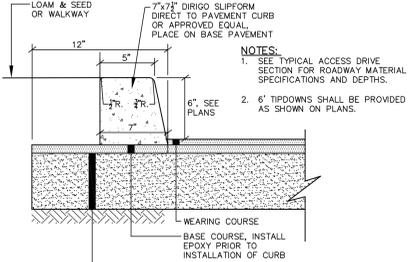


**LOAM AND SEED SECTION**  
NOT TO SCALE

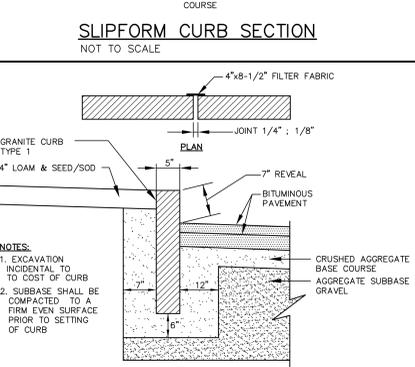


**TYPICAL PAVEMENT JOINT AT PUBLIC R.O.W.**  
NOT TO SCALE

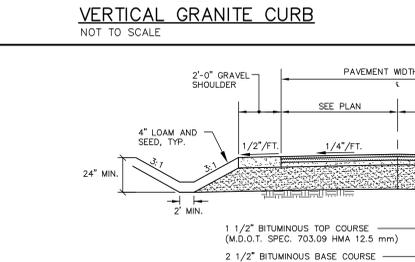

**CONSTRUCTION OVERSIGHT NOTES FOR PERMEABLE PAVERS:**

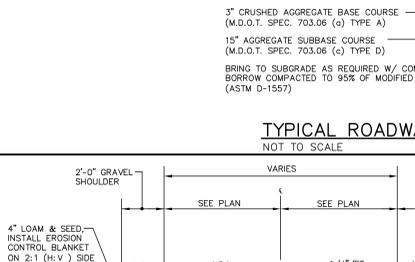


**CONSTRUCTION OVERSIGHT NOTES FOR POROUS PAVEMENT:**

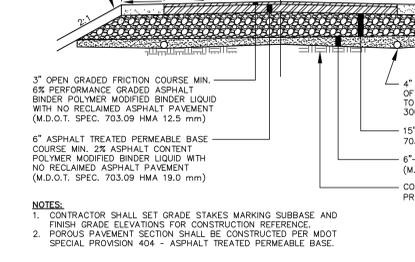


**PARKING PERMEABLE PAVERS SECTION**  
NOT TO SCALE


**WALKWAY PERMEABLE PAVERS SECTION**  
NOT TO SCALE

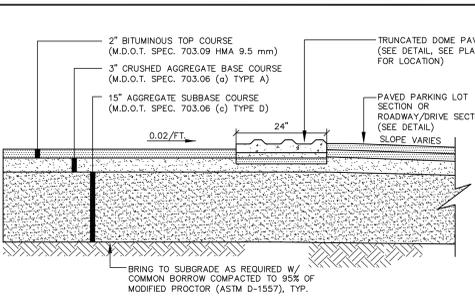


**SIDEWALK @ TRUNCATED DOMES**  
NOT TO SCALE

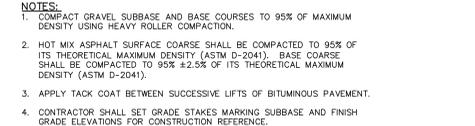


**PEDESTRIAN WALK W/ CURB**  
NOT TO SCALE

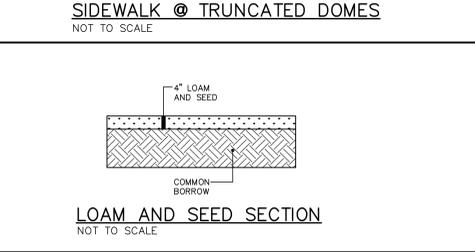


**STONE DUST FOOTPATH**  
NOT TO SCALE

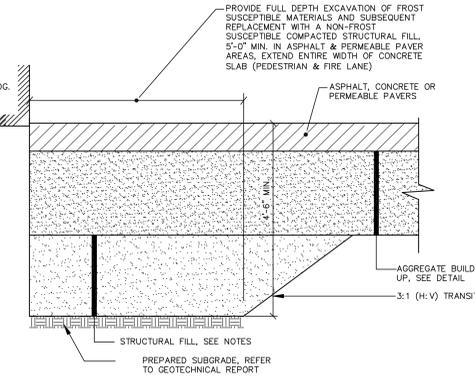



**PAVEMENT SECTION @ BUILDING**  
NOT TO SCALE

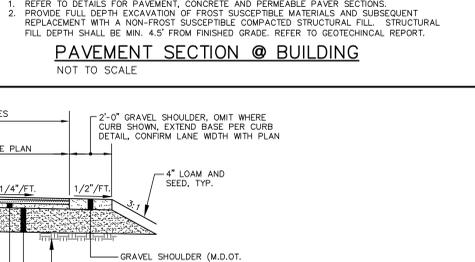

**TYPICAL ROADWAY/DRIVE SECTION**  
NOT TO SCALE

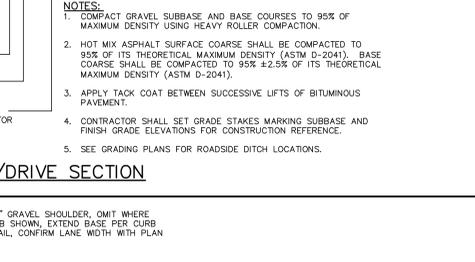

**PARKING PERMEABLE PAVERS SECTION**  
NOT TO SCALE

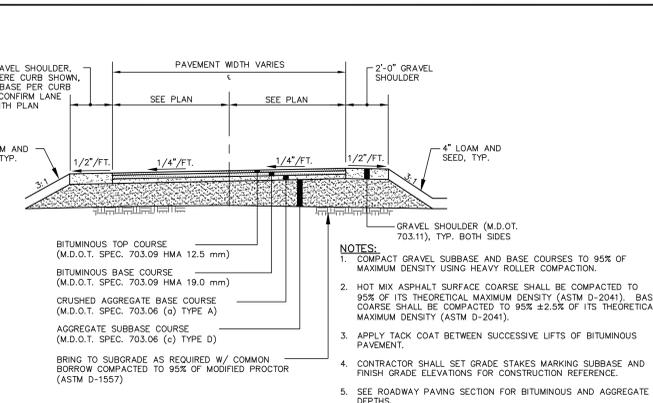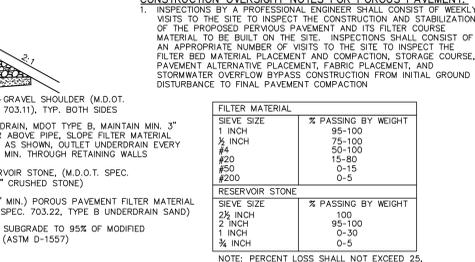


**SUPERELEVATED ACCESS DRIVE SECTION**  
NOT TO SCALE


**SUPERELEVATION TRANSITION TABLE**

SUPERELEVATION #	RUNOUT START (-2%-0%)	RUNOFF START/RUNOFF END (0%-2%)	FULL SUPERELEVATION (2%)	RUNOFF END/RUNOFF START (2%-0%)	RUNOUT END (0%-2%)
1	3+20.00	3+55.00	3+90.00 - 10+55.00	10+90.00	11+25.00
2	12+62.96	12+97.96	12.02.96 - 18+51.91	18+86.91	18+21.91
3	31+77.36	32+12.36	32+47.36 - 39+30.00	39+65.00	40+00.00


**SUPERELEVATED ACCESS DRIVE SECTION**  
NOT TO SCALE

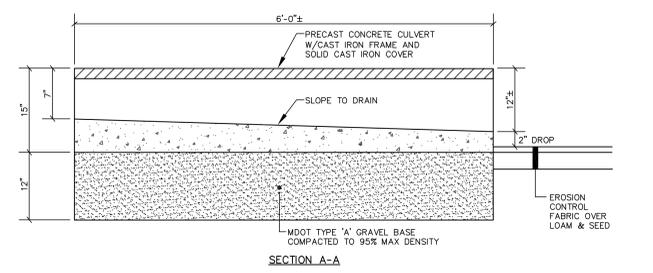


**SECTION A-A**

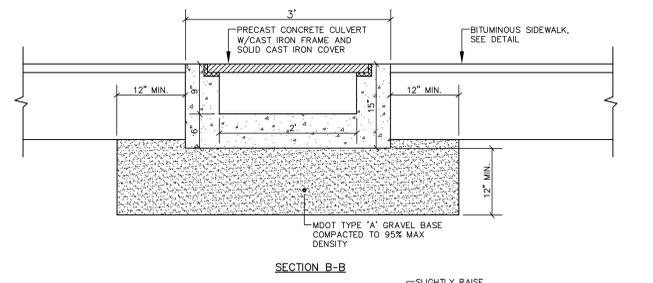


**SECTION B-B**

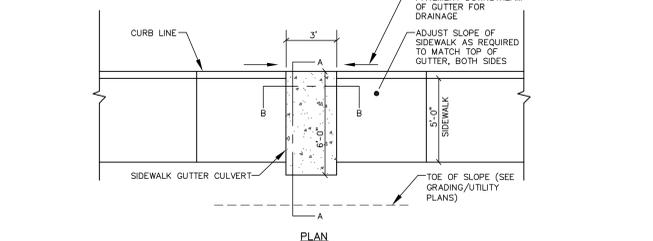



**SIDEWALK GUTTER DETAIL (MAYFLOWER DR.)**  
NOT TO SCALE

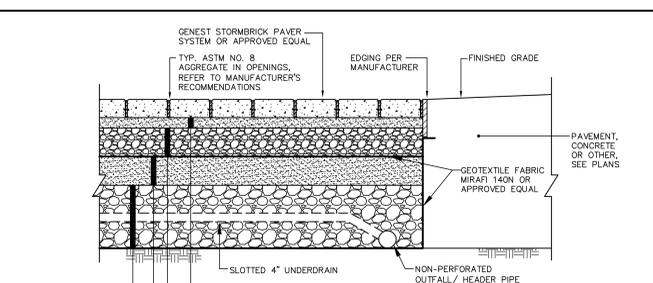

**PARKING PERMEABLE PAVERS SECTION**  
NOT TO SCALE

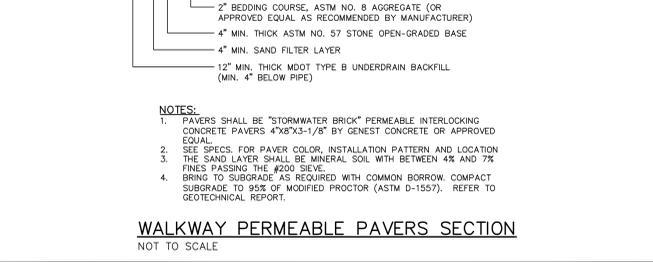

**WALKWAY PERMEABLE PAVERS SECTION**  
NOT TO SCALE

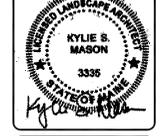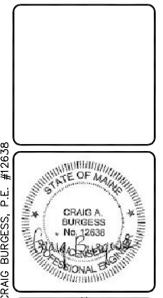

DESIGNED	CHECKED
CAB	KSM

ISSUED FOR ADDENDUM 3  
 CAB 02-11-16 BID DOCUMENTS  
 J CAB 02-11-16 PERMITS  
 H CAB 11-22-15 PERMITTED TO DEP  
 G CAB 11-22-15 REVISED PER CITY COMMENTS & REISSUED  
 F CAB 11-12-15 ISSUED FOR CITY SITE PLAN REVIEW & APPROVAL  
 E CAB 10-28-15 SUBMITTED FOR CITY SITE PLAN REVIEW & APPROVAL  
 REV. BY: DATE: STATUS:

**SEBAGO**  
 WWW.SEBAGOTECHNICS.COM  
 75 John Sullivan Rd. 250 Sohier Rd.  
 South Portland, ME 04106 Lewiston, ME 04240  
 Tel: 207-200-2100 Tel: 207-782-3656

**DETAILS OF:**  
 SANFORD HIGH SCHOOL & TECHNICAL CENTER  
 ROUTE 109 & ROUTE 4  
 SANFORD, MAINE 04073  
 SANFORD SCHOOL DEPARTMENT & STATE OF MAINE  
 DEPARTMENT OF EDUCATION  
 SANFORD, MAINE 04073

PROJECT NO.	SCALE
12233	NTS

SHEET C660FC75

**SOIL PROFILE/CLASSIFICATION INFORMATION**

Detailed Description of Subsurface Conditions at Project Sites

<b>Project Name:</b> MAIN STREET PARCEL	<b>Applicant Name:</b> SANFORD SCHOOL DEPARTMENT	<b>Project Location (municipality):</b> SANFORD
--	---	--

SOIL DESCRIPTION AND CLASSIFICATION			
Exploration Symbol: <b>TP-101</b> <input checked="" type="checkbox"/> Test Pit <input type="checkbox"/> Boring			
0-1" Depth of Organic Horizon Above Mineral Soil			
Texture	Consistency	Color	Mottling
		10YR 3/3	
SANDY LOAM		DARK BROWN	
		10YR 4/6	
LOAMY SAND		DARK YELLOWISH BROWN	
	FRIABLE		NONE OBSERVED
		2.5Y 6/3	
FINE SAND		LIGHT YELLOWISH BROWN	
		2.5Y 5/3	
GRAVELLY SAND		LIGHT OLIVE BROWN	
LIMIT OF EXCAVATION = 72"			
<input type="checkbox"/> hydric	Slope %	Limiting factor	<input type="checkbox"/> ground water
<input checked="" type="checkbox"/> non-hydric	0-3	>72"	<input type="checkbox"/> restrictive layer
C.S.S. Soil Series / phase name: <b>ADAMS SWED A</b>			
C.S.S. Drainage Class: <b>SWED</b> Hydrologic Group: <b>A</b>			
L.S.E. Soil Classification: Profile Drainage Class Design Class			

SOIL DESCRIPTION AND CLASSIFICATION			
Exploration Symbol: <b>TP-102</b> <input checked="" type="checkbox"/> Test Pit <input type="checkbox"/> Boring			
1-2" Depth of Organic Horizon Above Mineral Soil			
Texture	Consistency	Color	Mottling
		10YR 4/4	
GRAVELLY LOAMY SAND	FRIABLE	DARK YELLOWISH BROWN	
		2.5Y 5/3	
GRAVELLY COARSE SAND	LOOSE	LIGHT OLIVE BROWN	
LIMIT OF EXCAVATION = 72"			
<input type="checkbox"/> hydric	Slope %	Limiting factor	<input type="checkbox"/> ground water
<input checked="" type="checkbox"/> non-hydric	3-8	>72"	<input type="checkbox"/> restrictive layer
C.S.S. Soil Series / phase name: <b>COLTON ED A</b>			
C.S.S. Drainage Class: <b>ED</b> Hydrologic Group: <b>A</b>			
L.S.E. Soil Classification: Profile Drainage Class Design Class			

SOIL DESCRIPTION AND CLASSIFICATION			
Exploration Symbol: <b>TP-103</b> <input checked="" type="checkbox"/> Test Pit <input type="checkbox"/> Boring			
1-2" Depth of Organic Horizon Above Mineral Soil			
Texture	Consistency	Color	Mottling
		7.5YR 3/4	
		DARK BROWN	
LOAMY SAND	FRIABLE		
		10YR 4/6	
		DARK YELLOWISH BROWN	
		2.5Y 5/3	
GRAVELLY COARSE SAND	LOOSE BUT FIRM IN PLACE	LIGHT OLIVE BROWN	
LIMIT OF EXCAVATION = 72"			
<input type="checkbox"/> hydric	Slope %	Limiting factor	<input type="checkbox"/> ground water
<input checked="" type="checkbox"/> non-hydric	3-8	>72"	<input type="checkbox"/> restrictive layer
C.S.S. Soil Series / phase name: <b>COLTON ED A</b>			
C.S.S. Drainage Class: <b>ED</b> Hydrologic Group: <b>A</b>			
L.S.E. Soil Classification: Profile Drainage Class Design Class			

SOIL DESCRIPTION AND CLASSIFICATION			
Exploration Symbol: <b>TP-104</b> <input checked="" type="checkbox"/> Test Pit <input type="checkbox"/> Boring			
1-2" Depth of Organic Horizon Above Mineral Soil			
Texture	Consistency	Color	Mottling
		2.5Y 3/3	
SANDY LOAM		DARK OLIVE BROWN	
	FRIABLE	10YR 4/6	
LOAMY SAND		DARK YELLOWISH BROWN	
		2.5Y 5/6	
		LIGHT OLIVE BROWN	COMMON, MEDIUM, & DISTINCT
GRAVELLY COARSE SAND	SOMEWHAT CEMENTED	2.5Y 5/4	
		LIGHT OLIVE BROWN	
			MANY, COARSE, & PROMINENT
LIMIT OF EXCAVATION = 60"			
<input type="checkbox"/> hydric	Slope %	Limiting factor	<input checked="" type="checkbox"/> ground water
<input checked="" type="checkbox"/> non-hydric	0-3	14"	<input type="checkbox"/> restrictive layer
C.S.S. Soil Series / phase name: <b>NAUMBURG SWPD C</b>			
C.S.S. Drainage Class: <b>SWPD</b> Hydrologic Group: <b>C</b>			
L.S.E. Soil Classification: Profile Drainage Class Design Class			

**Professional Endorsements (as applicable)**

C.S.S. signature: 	Date: <b>6/4/15</b>
name printed/typed: <b>Gary M. Fullerton</b>	Lic.#: <b>462</b>
L.S.E. signature:	Date:
name printed/typed:	Lic.#:



affix professional seal

**SOIL PROFILE/CLASSIFICATION INFORMATION**

Detailed Description of Subsurface Conditions at Project Sites

<b>Project Name:</b> MAIN STREET PARCEL	<b>Applicant Name:</b> SANFORD SCHOOL DEPARTMENT	<b>Project Location (municipality):</b> SANFORD
--	---	--

SOIL DESCRIPTION AND CLASSIFICATION			
Exploration Symbol: <b>TP-105</b> <input checked="" type="checkbox"/> Test Pit <input type="checkbox"/> Boring			
2-3" Depth of Organic Horizon Above Mineral Soil			
0	Texture	Consistency	Color
1			
2	SANDY		10YR 3/4
3	LOAM		DARK YELLOWISH
4			BROWN
5			
6		FRIABLE	
7			
8	LOAMY		10YR 4/6
9	SAND		DARK
10			YELLOWISH
12			BROWN
14			
16			
18			
20			NONE
22			OBSERVED
24			
26	GRAVELLY		2.5Y 5/3
28	COARSE		
30	SAND	LOOSE	LIGHT
32			OLIVE
34			BROWN
36			
38			
LIMIT OF EXCAVATION = 96"			
<input type="checkbox"/> hydric	Slope %	Limiting factor	<input type="checkbox"/> ground water
<input checked="" type="checkbox"/> non-hydric	8-15	>96"	<input type="checkbox"/> restrictive layer
			<input type="checkbox"/> bedrock
C.S.S. Soil Series / phase name: <b>COLTON ED A</b>			
		Drainage Class	Hydrologic Group
L.S.E. Soil Classification: Profile Drainage Class Design Class			

SOIL DESCRIPTION AND CLASSIFICATION			
Exploration Symbol: <b>TP-106</b> <input checked="" type="checkbox"/> Test Pit <input type="checkbox"/> Boring			
0" Depth of Organic Horizon Above Mineral Soil			
0	Texture	Consistency	Color
1			
2			
3			
4			
5			
6			
7			
8	GRAVELLY		2.5Y 5/3
9	COARSE	LOOSE	
10	SAND		LIGHT
12			OLIVE
14			BROWN
16			
18			
LEDGE AT 54"			
<input type="checkbox"/> hydric	Slope %	Limiting factor	<input checked="" type="checkbox"/> ground water
<input checked="" type="checkbox"/> non-hydric	3-8	36"	<input type="checkbox"/> restrictive layer
			<input type="checkbox"/> bedrock
C.S.S. Soil Series / phase name: <b>TUNBRIDGE MWD C</b>			
		Drainage Class	Hydrologic Group
L.S.E. Soil Classification: Profile Drainage Class Design Class			

SOIL DESCRIPTION AND CLASSIFICATION			
Exploration Symbol: <b>TP-107</b> <input checked="" type="checkbox"/> Test Pit <input type="checkbox"/> Boring			
0-1" Depth of Organic Horizon Above Mineral Soil			
0	Texture	Consistency	Color
1			
2			
3			
4			
5			
6			
7	SANDY		10YR 3/3
8	LOAM	FRIABLE	NONE
9	FILL		OBSERVED
10	VARIES		DARK
12	0"-36" DEEP		BROWN
14			
16			
LIMIT OF EXCAVATION = 72"			
<input type="checkbox"/> hydric	Slope %	Limiting factor	<input type="checkbox"/> ground water
<input checked="" type="checkbox"/> non-hydric	3-8	>72"	<input type="checkbox"/> restrictive layer
			<input type="checkbox"/> bedrock
C.S.S. Soil Series / phase name: <b>COLTON ED A</b>			
		Drainage Class	Hydrologic Group
L.S.E. Soil Classification: Profile Drainage Class Design Class			

SOIL DESCRIPTION AND CLASSIFICATION			
Exploration Symbol: <b>TP-108</b> <input checked="" type="checkbox"/> Test Pit <input type="checkbox"/> Boring			
0-1" Depth of Organic Horizon Above Mineral Soil			
0	Texture	Consistency	Color
1			
2			
3			
4			
5			
6			
7			
8			
9			
10			
12	GRAVELLY		2.5Y 5/3
14	COARSE	LOOSE	
16	SAND		LIGHT
18			OLIVE
20			BROWN
22			
24			
LIMIT OF EXCAVATION = 60"			
<input type="checkbox"/> hydric	Slope %	Limiting factor	<input type="checkbox"/> ground water
<input checked="" type="checkbox"/> non-hydric	0-3	>60"	<input type="checkbox"/> restrictive layer
			<input type="checkbox"/> bedrock
C.S.S. Soil Series / phase name: <b>COLTON ED A</b>			
		Drainage Class	Hydrologic Group
L.S.E. Soil Classification: Profile Drainage Class Design Class			

**Professional Endorsements (as applicable)**

C.S.S. signature:  name printed/typed: <b>Gary M. Fullerton</b>	Date: <b>6/4/15</b> Lic.#: <b>462</b>
L.S.E. signature: name printed/typed:	Date: Lic.#:



affix professional seal







SOIL PROFILE/CLASSIFICATION INFORMATION

Detailed Description of Subsurface Conditions at Project Sites

<b>Project Name:</b> MAIN STREET PARCEL	<b>Applicant Name:</b> SANFORD SCHOOL DEPARTMENT	<b>Project Location (municipality):</b> SANFORD
--	---	--

SOIL DESCRIPTION AND CLASSIFICATION			
Exploration Symbol: <b>TP-121</b> <input checked="" type="checkbox"/> Test Pit <input type="checkbox"/> Boring			
2-3" Depth of Organic Horizon Above Mineral Soil			
Texture	Consistency	Color	Mottling
		10YR 3/3	
SANDY LOAM		DARK BROWN	
	FRIABLE		
LOAMY SAND		10YR 4/6 DARK YELLOWISH BROWN	
MEDIUM SAND		2.5Y 5/6 LIGHT OLIVE BROWN	
		2.5Y 5/3 LT. OLIVE BROWN	FEW, FINE & FAINT
LIMIT OF EXCAVATION = 65"			
<input type="checkbox"/> hydric <input checked="" type="checkbox"/> non-hydric	Slope % <b>3-8</b>	Limiting factor <b>55"</b>	<input type="checkbox"/> ground water <input type="checkbox"/> restrictive layer <input type="checkbox"/> bedrock
C.S.S. Soil Series / phase name: <b>ADAMS SWED A</b>			
S.E. Soil Classification: Profile Drainage Class Hydrologic Group Design Class			

SOIL DESCRIPTION AND CLASSIFICATION			
Exploration Symbol: <b>TP-122</b> <input checked="" type="checkbox"/> Test Pit <input type="checkbox"/> Boring			
1-2" Depth of Organic Horizon Above Mineral Soil			
Texture	Consistency	Color	Mottling
LOAMY SAND		10YR 3/3	
	FRIABLE		
GRAVELLY LOAMY SAND		10YR 4/6 DARK YELLOWISH BROWN	NONE OBSERVED
GRAVELLY SAND	LOOSE	10YR 5/4 YELLOWISH BROWN	
GRAVELLY COARSE SAND			
LIMIT OF EXCAVATION = 11"			
<input type="checkbox"/> hydric <input checked="" type="checkbox"/> non-hydric	Slope % <b>0-3</b>	Limiting factor <b>&gt;11"</b>	<input type="checkbox"/> ground water <input type="checkbox"/> restrictive layer <input type="checkbox"/> bedrock
C.S.S. Soil Series / phase name: <b>COLTON ED A</b>			
S.E. Soil Classification: Profile Drainage Class Hydrologic Group Design Class			

SOIL DESCRIPTION AND CLASSIFICATION			
Exploration Symbol: <b>TP-123</b> <input checked="" type="checkbox"/> Test Pit <input type="checkbox"/> Boring			
0" Depth of Organic Horizon Above Mineral Soil			
Texture	Consistency	Color	Mottling
LOAMY SAND		10YR 3/4 DARK BROWN	
	FRIABLE		
MEDIUM SAND		2.5Y 5/4 LIGHT OLIVE BROWN	
COARSE SAND		2.5Y 5/3 LIGHT OLIVE BROWN	COMMON, MEDIUM, & DISTINCT
LEDGE AT 48"			
<input type="checkbox"/> hydric <input checked="" type="checkbox"/> non-hydric	Slope % <b>3-8</b>	Limiting factor <b>40"</b>	<input type="checkbox"/> ground water <input type="checkbox"/> restrictive layer <input type="checkbox"/> bedrock
C.S.S. Soil Series / phase name: <b>ADAMS SWED A</b>			
S.E. Soil Classification: Profile Drainage Class Hydrologic Group Design Class			

SOIL DESCRIPTION AND CLASSIFICATION			
Exploration Symbol: <b>TP-124</b> <input checked="" type="checkbox"/> Test Pit <input type="checkbox"/> Boring			
0" Depth of Organic Horizon Above Mineral Soil			
Texture	Consistency	Color	Mottling
LOAMY SAND		10YR 4/3 BROWN	
	FRIABLE		
LOAMY SAND		10YR 4/4 DARK YELLOWISH BROWN	
MEDIUM SAND		2.5Y 5/3 LIGHT OLIVE BROWN	
COARSE SAND	LOOSE		COMMON, MEDIUM, & DISTINCT
LIMIT OF EXCAVATION = 10"			
<input type="checkbox"/> hydric <input checked="" type="checkbox"/> non-hydric	Slope % <b>0-3</b>	Limiting factor <b>30"</b>	<input type="checkbox"/> ground water <input type="checkbox"/> restrictive layer <input type="checkbox"/> bedrock
C.S.S. Soil Series / phase name: <b>CROGHAN MWD B</b>			
S.E. Soil Classification: Profile Drainage Class Hydrologic Group Design Class			

Professional Endorsements (as applicable)

C.S.S. signature: 	Date: <b>6/5/15</b>
name printed/typed: <b>Gary M. Fullerton</b>	Lic.#: <b>462</b>
L.S.E. signature:	Date:
name printed/typed:	Lic.#:



affix professional seal



**SOIL PROFILE/CLASSIFICATION INFORMATION**

Detailed Description of Subsurface Conditions at Project Sites

<b>Project Name:</b> MAIN STREET PARCEL	<b>Applicant Name:</b> SANFORD SCHOOL DEPARTMENT	<b>Project Location (municipality):</b> SANFORD
--	---	--

SOIL DESCRIPTION AND CLASSIFICATION				
Exploration Symbol: <b>TP-129</b> <input checked="" type="checkbox"/> Test Pit <input type="checkbox"/> Boring				
2-3" Depth of Organic Horizon Above Mineral Soil				
0	<b>Texture</b>	<b>Consistency</b>	<b>Color</b>	<b>Mottling</b>
1			10YR 3/4	
2	SANDY LOAM		DARK YELLOWISH BROWN	
3				
4				
5				
6			10YR 4/6	
7				
8				
9	GRAVELLY LOAMY SAND	FRIABLE	DARK YELLOWISH BROWN	
10				
11				
30	SANDY LOAM WITH STONES	FIRM	2.5Y 6/6 OLIVE YELLOW	MANY COARSE & PROMINENT
31				
32				
LIMIT OF EXCAVATION = 60"				
<input type="checkbox"/> hydric <input checked="" type="checkbox"/> non-hydric		Slope % <b>3-8</b>	Limiting factor <b>24"</b>	<input checked="" type="checkbox"/> ground water <input type="checkbox"/> restrictive layer <input type="checkbox"/> bedrock
C.S.S. Soil Series / phase name: <b>SKERRY MWD C</b>				
Drainage Class Hydrologic Group				
L.S.E. Soil Classification: Profile Drainage Class Design Class				

SOIL DESCRIPTION AND CLASSIFICATION				
Exploration Symbol: <b>TP-130</b> <input checked="" type="checkbox"/> Test Pit <input type="checkbox"/> Boring				
2-3" Depth of Organic Horizon Above Mineral Soil				
0	<b>Texture</b>	<b>Consistency</b>	<b>Color</b>	<b>Mottling</b>
1			10YR 3/4	
2			DARK YELLOWISH BROWN	
3				
4	LOAMY SAND	FRIABLE		
5				
6			10YR 4/6	
7			DARK YELLOWISH BROWN	
8				
9				
10				
11				
12				
13				
14				
15				
16				
17				
18				
19				
20	MEDIUM SAND	LOOSE	2.5Y 5/3	
21				
22				
LIMIT OF EXCAVATION = 60"				
<input type="checkbox"/> hydric <input checked="" type="checkbox"/> non-hydric		Slope % <b>0-3</b>	Limiting factor <b>10"</b>	<input type="checkbox"/> ground water <input type="checkbox"/> restrictive layer <input type="checkbox"/> bedrock
C.S.S. Soil Series / phase name: <b>NAUMBURG SWPD C</b>				
Drainage Class Hydrologic Group				
L.S.E. Soil Classification: Profile Drainage Class Design Class				

SOIL DESCRIPTION AND CLASSIFICATION				
Exploration Symbol: <b>TP-131</b> <input checked="" type="checkbox"/> Test Pit <input type="checkbox"/> Boring				
0" Depth of Organic Horizon Above Mineral Soil				
0	<b>Texture</b>	<b>Consistency</b>	<b>Color</b>	<b>Mottling</b>
1				
2				
3				
4				
5				
6				
7				
8			10YR 4/6	
9	GRAVELLY FINE SAND	FRIABLE	DARK YELLOWISH BROWN	
10				
11				
40	GRAVELLY COARSE SAND	LOOSE	2.5Y 5/4 LIGHT OLIVE BROWN	FEW, FINE, & FAINT
41				
42				
LIMIT OF EXCAVATION = 72"				
<input type="checkbox"/> hydric <input checked="" type="checkbox"/> non-hydric		Slope % <b>3-8</b>	Limiting factor <b>36"</b>	<input type="checkbox"/> ground water <input type="checkbox"/> restrictive layer <input type="checkbox"/> bedrock
C.S.S. Soil Series / phase name: <b>DUANE MWD B</b>				
Drainage Class Hydrologic Group				
L.S.E. Soil Classification: Profile Drainage Class Design Class				

SOIL DESCRIPTION AND CLASSIFICATION				
Exploration Symbol: <input type="checkbox"/> Test Pit <input type="checkbox"/> Boring				
" Depth of Organic Horizon Above Mineral Soil				
0	<b>Texture</b>	<b>Consistency</b>	<b>Color</b>	<b>Mottling</b>
1				
2				
LIMIT OF EXCAVATION = 72"				
<input type="checkbox"/> hydric <input checked="" type="checkbox"/> non-hydric		Slope % _____	Limiting factor _____	<input type="checkbox"/> ground water <input type="checkbox"/> restrictive layer <input type="checkbox"/> bedrock
C.S.S. Soil Series / phase name: _____				
Drainage Class Hydrologic Group				
L.S.E. Soil Classification: Profile Drainage Class Design Class				

Professional Endorsements (as applicable)			
C.S.S.	signature:	Date:	<b>6/5/15</b>
	name printed/typed: <b>Gary M. Fullerton</b>	Lic.#:	<b>462</b>
L.S.E.	signature: _____	Date:	_____
	name printed/typed: _____	Lic.#:	_____

**SOIL PROFILE/CLASSIFICATION INFORMATION**

Detailed Description of Subsurface Conditions at Project Sites

<b>Project Name:</b> MAIN STREET PARCEL	<b>Applicant Name:</b> SANFORD SCHOOL DEPARTMENT	<b>Project Location (municipality):</b> SANFORD
--	---	--

SOIL DESCRIPTION AND CLASSIFICATION					
DEPTH BELOW MINERAL SOIL SURFACE (inches)	Exploration Symbol: <b>TP-132</b>	<input checked="" type="checkbox"/> Test Pit	<input type="checkbox"/> Boring		
	_____ 1-2" Depth of Organic Horizon Above Mineral Soil				
	Texture	Consistency	Color	Mottling	
	0				
	1				
	2				
	3				
	4				
	5				
	6				
	7				
	8				
	9	SANDY LOAM	FRIABLE	DARK BROWN	
10	FILL W/ STONES				
12					
14					
16					
18					
20				NONE OBSERVED	
22					
24					
26					
28					
30					
32					
34					
36					
38					
40					
42					
44					
46	GRAVELLY SAND	LOOSE	YELLOWISH BROWN		
48					
50					
52					
54					
56					
58					
60					

**LIMIT OF EXCAVATION = 60"**

<input type="checkbox"/> hydric	Slope %	Limiting factor	<input type="checkbox"/> ground water
<input checked="" type="checkbox"/> non-hydric	<u>0-3</u>	<u>&gt;60"</u>	<input type="checkbox"/> restrictive layer
			<input type="checkbox"/> bedrock

SOIL DESCRIPTION AND CLASSIFICATION					
DEPTH BELOW MINERAL SOIL SURFACE (inches)	Exploration Symbol: _____	<input type="checkbox"/> Test Pit	<input type="checkbox"/> Boring		
	_____ 1-2" Depth of Organic Horizon Above Mineral Soil				
	Texture	Consistency	Color	Mottling	
	0				
	1				
	2				
	3				
	4				
	5				
	6				
	7				
	8				
	9				
10					
12					
14					
**LIMIT OF EXCAVATION = 60"**

<input type="checkbox"/> hydric	Slope %	Limiting factor	<input checked="" type="checkbox"/> ground water
<input checked="" type="checkbox"/> non-hydric			<input type="checkbox"/> restrictive layer
			<input type="checkbox"/> bedrock

C.S.S. Soil Series / phase name: \_\_\_\_\_  
 Drainage Class \_\_\_\_\_ Hydrologic Group \_\_\_\_\_

L.S.E. Soil Classification: \_\_\_\_\_  
 Profile \_\_\_\_\_ Drainage Class \_\_\_\_\_ Design Class \_\_\_\_\_

C.S.S. Soil Series / phase name: \_\_\_\_\_  
 Drainage Class \_\_\_\_\_ Hydrologic Group \_\_\_\_\_

L.S.E. Soil Classification: \_\_\_\_\_  
 Profile \_\_\_\_\_ Drainage Class \_\_\_\_\_ Design Class \_\_\_\_\_

SOIL DESCRIPTION AND CLASSIFICATION					
DEPTH BELOW MINERAL SOIL SURFACE (inches)	Exploration Symbol: _____	<input type="checkbox"/> Test Pit	<input type="checkbox"/> Boring		
	_____ 1-2" Depth of Organic Horizon Above Mineral Soil				
	Texture	Consistency	Color	Mottling	
	0				
	1				
	2				
	3				
	4				
	5				
	6				
	7				
	8				
	9				
10					
12					
14					
**LIMIT OF EXCAVATION = 60"**

<input type="checkbox"/> hydric	Slope %	Limiting factor	<input type="checkbox"/> ground water
<input checked="" type="checkbox"/> non-hydric			<input type="checkbox"/> restrictive layer
			<input type="checkbox"/> bedrock


SOIL DESCRIPTION AND CLASSIFICATION					
DEPTH BELOW MINERAL SOIL SURFACE (inches)	Exploration Symbol: _____	<input type="checkbox"/> Test Pit	<input type="checkbox"/> Boring		
	_____ 1-2" Depth of Organic Horizon Above Mineral Soil				
	Texture	Consistency	Color	Mottling	
	0				
	1				
	2				
	3				
	4				
	5				
	6				
	7				
	8				
	9				
10					
12					
14					


**LIMIT OF EXCAVATION = 60"**

<input type="checkbox"/> hydric	Slope %	Limiting factor	<input type="checkbox"/> ground water
<input checked="" type="checkbox"/> non-hydric			<input type="checkbox"/> restrictive layer
			<input type="checkbox"/> bedrock

Professional Endorsements (as applicable)

C.S.S. signature: 	Date: <b>10/15/15</b>
name printed/typed: <b>Gary M. Fullerton</b>	Lic.#: <b>462</b>
L.S.E. signature: _____	Date: _____
name printed/typed: _____	Lic.#: _____

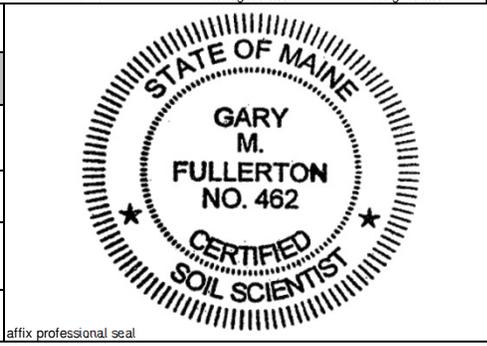

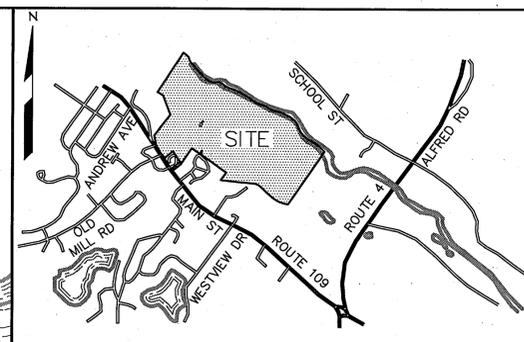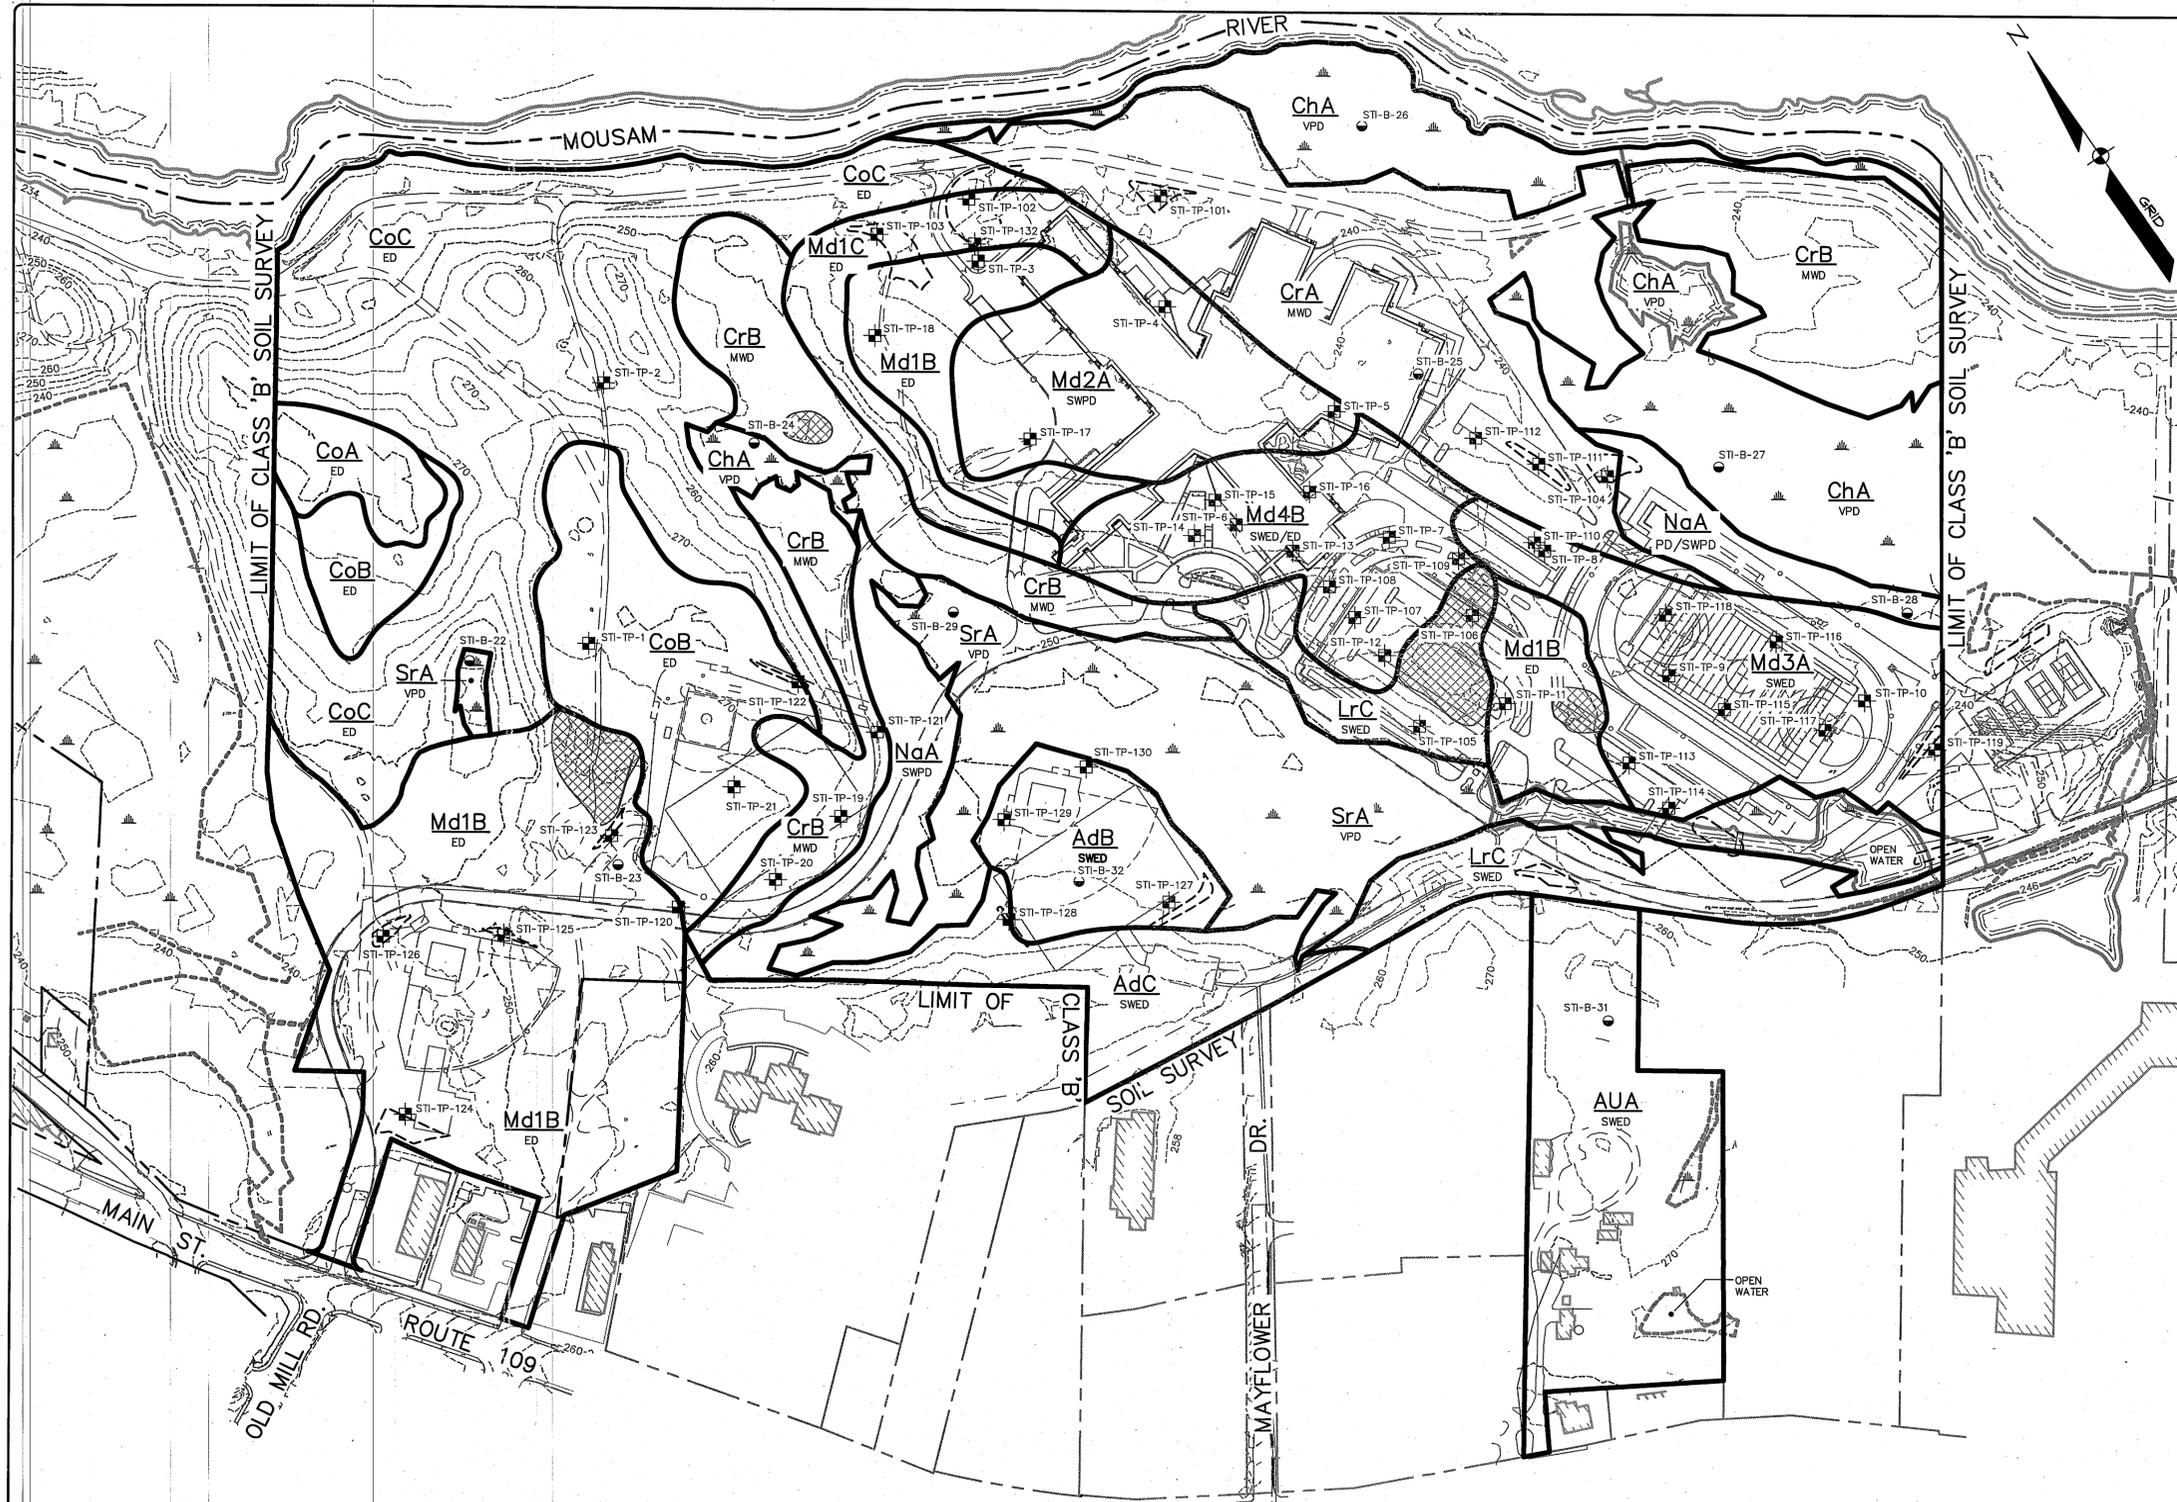

**GENERAL NOTES**

1. A WETLAND DELINEATION WAS PERFORMED ON THIS PROJECT SITE IN AUGUST 2013 AND AUGUST 2015 BY GARY M. FULLERTON, CERTIFIED SOIL SCIENTIST OF SEBAGO TECHNICS, INC. AND LOCATED BY GROUND SURVEY. THIS DELINEATION CONFORMS TO THE STANDARDS AND METHODS OUTLINED IN THE 1987 WETLANDS DELINEATION MANUAL AND NORTHEAST REGIONAL SUPPLEMENT AUTHORED AND PUBLISHED BY THE U.S. ARMY CORPS OF ENGINEERS. A WETLANDS REPORT WAS PREPARED BY GARY M. FULLERTON ON MARCH 25, 2014.
2. STORMWATER TEST PITS 101-132 WERE OBSERVED IN JUNE, 2015 AFTER THE SOIL SURVEY WAS COMPLETED.

**LEGEND**


SYMBOL	DESCRIPTION
---	PROPERTY LINE/R.O.W.
---	ABUTTER LINE/R.O.W.
+	SEBAGO TECHNICS TEST PIT
+	SEBAGO TECHNICS BORING
▭	BUILDING
---	EASEMENT
---	EDGE WETLAND
---	WETLANDS
---	LEDGE
---	EDGE PAVEMENT
---	EDGE GRAVEL
---	CURB LINE
---	EDGE OF WATER
---	CONTOURS
---	SOILS BOUNDARY

**SOIL TYPES**

SYMBOL	SOIL SERIES	PHASE	SLOPE	HSG	DRAINAGE CLASS	SYMBOL	SOIL SERIES	PHASE	SLOPE	HSG	DRAINAGE CLASS
AdB	ADAMS	LOAMY SAND	3-8%	A	SOMEWHAT EXCESSIVELY DRAINED	LrC	LYMAN-ROCK OUTCROP ASSOCIATION	FINE SANDY LOAM	8-15%	C/D	SOMEWHAT EXCESSIVELY DRAINED
AdC	ADAMS	LOAMY SAND	8-15%	A	SOMEWHAT EXCESSIVELY DRAINED	Md1B	COLTON-LIKE	N/A	3-8%	A	EXCESSIVELY DRAINED
AUA	ADAMS-URBAN LAND ASSOCIATION	LOAMY SAND	0-3%	A	SOMEWHAT EXCESSIVELY DRAINED	Md1C	COLTON-LIKE	N/A	8-15%	A	EXCESSIVELY DRAINED
ChA	CHOCORUA	MUCKY PEAT	0-3%	D	VERY POORLY DRAINED	Md2A	NAUMBURG-LIKE	N/A	0-3%	C	SOMEWHAT POORLY DRAINED
CoA	COLTON	GRAVELLY LOAMY COARSE SAND	0-3%	A	EXCESSIVELY DRAINED	Md3A	ADAMS-LIKE	N/A	0-3%	A	SOMEWHAT EXCESSIVELY DRAINED
CoB	COLTON	GRAVELLY LOAMY COARSE SAND	3-8%	A	EXCESSIVELY DRAINED	Md4B	COLTON/LYMAN-LIKE ASSOCIATION	N/A	3-8%	A/C/D	SOMEWHAT EXCESSIVELY DRAINED/ EXCESSIVELY DRAINED
CoC	COLTON	GRAVELLY LOAMY COARSE SAND	8-15%	A	EXCESSIVELY DRAINED	NaA	NAUMBURG	LOAMY SAND	0-3%	C	POORLY DRAINED/ SOMEWHAT POORLY DRAINED
CrA	CROGHAN	LOAMY SAND	0-3%	B	MODERATELY WELL DRAINED	SrA	SEARSPORT	MUCKY PEAT	0-3%	D	VERY POORLY DRAINED
CrB	CROGHAN	LOAMY SAND	3-8%	B	MODERATELY WELL DRAINED						

**NOTE**

THIS CLASS 'B' HIGH INTENSITY SOILS MAP CONFORMS TO THE GUIDELINES FOR MAINE CERTIFIED SOIL SCIENTISTS FOR SOIL IDENTIFICATION AND MAPPING, DATED MARCH 2009 FOR CLASS 'B' HIGH INTENSITY SOIL SURVEYS. THE SOIL MAP UNITS AS DEPICTED WERE IN PART INFLUENCED BY THE INTENDED USE FOR A PROPOSED HIGH SCHOOL AND THE SOILS WHICH WERE NON-LIMITING FOR ONE USE MAY BE CONSIDERED LIMITING FOR ANOTHER USE. THEREFORE, THIS CLASS 'B' HIGH INTENSITY SOILS MAP MAY NOT BE ADEQUATE FOR ANOTHER USE. (REFER TO SOIL NARRATIVE REPORT DATED JANUARY 14, 2014 AND SOIL PROFILE DESCRIPTIONS.)

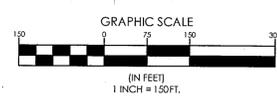

STATE OF MAINE  
 GARY M. FULLERTON  
 NO. 462  
 CERTIFIED SOIL SCIENTIST

GARY M. FULLERTON  
 CERTIFIED SOIL SCIENTIST #462  
 DATE 11/12/15

DESIGNED	CHECKED

REV	BY	DATE	STATUS	REVISION
A	GMF	11-12-15	REVISE MAP PER DEP COMMENTS	

THIS PLAN SHALL NOT BE MODIFIED WITHOUT WRITTEN PERMISSION FROM SEBAGO TECHNICS, INC. ANY ALTERATIONS, AUTHORIZED OR OTHERWISE, SHALL BE AT THE USER'S SOLE RISK AND WITHOUT LIABILITY TO SEBAGO TECHNICS, INC.

**SEBAGO**  
 TECHNICS

75 John Roberts Rd.  
 Suite 1A  
 South Portland, ME 04106  
 Tel. 207-500-2100

250 Goddard Rd.  
 Suite B  
 Lewiston, ME 04240  
 Tel. 207-783-5656

CLASS 'B' HIGH INTENSITY SOILS MAP  
 OF: SANFORD HIGH SCHOOL  
 ROUTE 109 & ROUTE 4  
 SANFORD, MAINE

FOR: LAVALLEE BRENSINGER ARCHITECTS  
 135 DOW STREET, SUITE 400  
 WASHINGTON, NH 03010

PROJECT NO. 12233 SCALE 1" = 150'  
 SHEET 1 OF 1