

BUILDING PERMIT BP-15387

Based on the information you have submitted in the attached application and supporting documents, the staff of the Land Use Planning Commission concludes that, if carried out in compliance with the conditions of approval below, your proposal will meet the criteria for approval, 12 M.R.S.A. §685-B(4) of the Commission's statutes and the provisions of the Commission's *Land Use Districts and Standards*. Any variation from the application or the conditions of approval is subject to prior Commission review and approval. Any variation undertaken without Commission approval constitutes a violation of Land Use Planning Commission law. In addition, any person aggrieved by this decision of the staff may, within 30 days, request that the Commission review the decision.


LUPC Authorized Signature

6/25/2015
Effective Date

CONDITIONS OF APPROVAL

General Conditions

1. Construction activities authorized in this permit must be substantially started within 2 years of the effective date of this permit and substantially completed within 5 years of the effective date of this permit. If such construction activities are not started and completed within this time limitation, this permit shall lapse and no activities shall then occur unless and until a new permit has been granted by the Commission.
2. This permit is dependent upon and limited to the proposal as set forth in the application and supporting documents, except as modified by the Commission in granting this permit. Any variation is subject to prior review and approval of the Maine Land Use Planning Commission. Any variation from the application or the conditions of approval undertaken without approval of the Commission constitutes a violation of Land Use Planning Commission law.
3. Structures authorized under this permit, as well as filling/grading/soil disturbance and cleared openings created as part of construction activities authorized under this permit, must be located to meet the road, property line, water and wetland setback distances, exterior dimensions and building heights listed in Sections 4, 7 and 8 and approved by this permit.
4. Temporary and permanent sedimentation control measures must be implemented to effectively stabilize all areas of disturbed soil and to catch sediment from runoff water before it leaves the construction site so that sediment does not enter water bodies, drainage systems, water crossings, wetlands or adjacent properties. Clearing and construction activities, except those necessary to establish sedimentation control devices, shall not begin until all erosion and sedimentation control devices (including ditches, culverts, sediment traps, settling basins, hay bales, silt fences, etc.) have been installed and stabilized. Once in place, such devices shall be maintained to ensure proper functioning.
5. Effective, temporary stabilization of all disturbed and stockpiled soil must be completed at the end of each work day. All temporary sedimentation and erosion control devices shall be removed after construction activity has ceased and a cover of healthy vegetation has established itself or other appropriate permanent control measures have been effectively implemented. Permanent soil stabilization shall be completed within one week of inactivity or completion of construction.
6. Cleared openings created as part of construction activities authorized under this permit must be effectively stabilized and revegetated.
7. All imported fill material must be free of hazardous or toxic materials and must not contain debris, trash, or rubbish.
8. Unless otherwise proposed in Question 8.4 and by the submittal of **Exhibit G, Erosion and Sediment Control Plan**, and approved by this permit, soil disturbance must not occur when the ground is frozen or saturated.
9. Topsoil must not be removed from the site except for that necessary for construction activities authorized in this permit. Topsoil must be stockpiled at least 100 feet from any water body.
10. The permittee shall not advertise Land Use Planning Commission approval without first obtaining approval for such advertising. Any such advertising shall refer to this permit only if it also notes that the permit is subject to conditions of approval.
11. In the event the permittee should sell or lease this property, the buyer or lessee shall be provided a copy of the approved permit and conditions of approval. The new owner or lessee should then contact the Land Use Planning Commission to have the permit transferred into his/her name. If there are no additional changes the transfer can be accomplished on a Minor Change Form.
12. All exterior lighting must be located and installed so as to illuminate only the target area to the extent possible. Exterior lighting must not produce a strong, dazzling light or reflection beyond lot lines onto neighboring properties, water bodies, or roadway so as to impair driver vision or to create nuisance conditions.

13. The scenic character and healthful condition of the area covered under this permit must be maintained. The area must be kept free of litter, trash, junk cars and other vehicles, and any other materials that may constitute a hazardous or nuisance condition.
14. The permittee shall secure and comply with all applicable licenses, permits, authorizations, and requirements of all federal, state, and local agencies including but not limited to: Air and Water Pollution Control Regulations; Subsurface Wastewater Disposal System approval from the Local Plumbing Inspector and/or Maine Department of Health and Human Services, Subsurface Wastewater Program; and the Maine Department of Transportation, Driveway Entrance Permit, a physical E-911 address from your County Commissioner's Office.
15. Structures authorized under this permit must not be sited on a ridge or knoll such that they are visible above the tree line from any water body. All authorized structures must be located, designed and landscaped to reasonably minimize their visual impact on the surrounding area, particularly when viewed from existing roadways or shorelines.
16. The dwelling unit expansion authorized under this permit must be set back a minimum of 54 feet from the normal high water mark of Boyd Lake, 50 feet from the traveled portion of the access road, and 15 feet from other property boundary lines.
17. The dwelling unit expansion authorized under this permit must not exceed 25 feet in height as measured as the vertical distance between the mean original (prior to construction) grade at the downhill side of the structure and the highest point of the structure, excluding chimneys, steeples, antennas, and similar appurtenances that have no floor area.
18. The shed authorized under this permit must be set back a minimum of 100 feet from the normal high water mark of Boyd Lake, 50 feet from the traveled portion of the access road, and 15 feet from other property boundary lines.
19. The parking area authorized under this permit must be set back a minimum of 100 feet from the normal high water mark of Boyd Lake, 50 feet from the traveled portion of the access road, and 15 feet from other property boundary lines.
20. Once construction is complete, the permittee shall submit a self-certification form, notifying the Commission that all conditions of approval of this permit have been met. The permittee shall submit all information requested by the Commission demonstrating compliance with the terms of this permit.

Development in Flood Prone Areas

21. The permitted structure(s) must be constructed according to the information submitted in the **Supplement S-4: Requirements for Development in Flood Prone Areas and associated Exhibits**.
22. Notwithstanding Condition 1, construction activities authorized within P-FP subdistricts, FEMA zones, and other areas prone to flooding must be substantially started within 180 days of the effective date of this permit and substantially completed within 5 years of the effective date of this permit. If such construction activities are not started and completed within this time limitation, this permit shall lapse and no activities shall then occur unless and until a new permit has been granted by the Commission.
23. All other required state or federal permits must be submitted to the Commission PRIOR to the start of construction.
24. The permitted structures must be designed or modified and adequately anchored to prevent flotation (excluding floating piers and docks), collapse or lateral movement resulting from hydrodynamic and hydrostatic loads, including the effects of buoyancy.
25. The permittee(s) must use construction materials that are resistant to flood damage, use construction methods and practices that will minimize flood damage, and use electrical, heating, ventilation, plumbing, and air conditioning equipment, and other service facilities that are designed and/or located so as to prevent water from entering or accumulating within the components during flooding conditions.
26. Unless your structure qualifies as an exempt accessory structure (Question 15 of the S4 Supplement) or lobster or fishing shed (Question 22), the top of the lowest floor of all new structures or substantial improvements of existing structures, including must be elevated to at least one foot above the BFE for the adjacent waterbody.
27. Upon completion of the lowest floor of all permitted structures, a FEMA Elevation Certificate completed by a professional land surveyor or professional engineer must be submitted to the Commission for review and approval prior to any further construction activities.
28. The permitted shed must be 500 square feet or less and have a value less than \$3,000, and have unfinished interiors and not be used for human habitation. The accessory structure(s) must be adequately anchored to prevent flotation, collapse, or lateral movement resulting from hydrodynamic and hydrostatic loads, including the effects of buoyancy.
29. The permitted shed must have hydraulic openings in at least two different walls having a total net area of not less than one square inch for every square foot of the enclosed area, must have the bottom of all openings no higher than one foot above the lowest grade. The openings must permit the entry and exit of flood waters automatically without any external influence or control such as human intervention, including the use of electrical and other non-automatic mechanical means. The shed must also have only ground fault interrupt electrical outlets. The electric service disconnect shall be located above the base flood elevation and when possible outside the Area of Special Flood Hazard.

For office use:

48254
~~48013~~

BP 15387

\$ 82.00

199.80 rec'd 4/15/15
check returned
2/11/15

RECEIVED

JUN 15 2015

MAINE LAND USE PLANNING COMMISSION
Department of Agriculture, Conservation and Forestry

Building Permit

LUPC - MILLINOCKET

For All Residential Development

1. APPLICANT INFORMATION

Applicant Name(s) Paul And Sandra Vaillancourt	Daytime Phone 827-6178	FAX 581-3325
Mailing Address 1245 main St	Email Sandra.vaillancourt@maine.edu	
Town Old Town	State ME	Zip Code 04468

2. PROJECT LOCATION AND PROPERTY DETAILS

Township, Town or Plantation Orneville	County Piscataquis
Tax Information (check tax bill) Map: PI 082 Plan: 06 Lot: 74.74.1	Deed or Lease Information (check deed or lease) Book: 6 Page: 51 Lease #:
Lot size (in acres, or in square feet if less than 1 acre) 15,482.48'	Lot Coverage (in square feet) 15,482.48'
All Zoning on Property (check the LUPC map) P-6P	Zoning at Development Site P-6P + P-FP by virtue of 10.23, C, 2 FEMA zone A
Road Frontage. List the name(s) and frontage(s) (in feet) for any public or private roads, or other rights-of-way adjacent to your lot: Road #1: Camp Road Frontage 51.8 ft.	Water Frontage. List the name(s) and frontage(s) (in feet) for any lakes, ponds, rivers, streams, or other waters on or adjacent to your lot: Waterbody #1: Boyd Lake Frontage 51.8 ft.
Road #2: _____ Frontage _____ ft.	Waterbody #2: _____ Frontage _____ ft.
LUPC Approved Subdivision. List the LUPC approved subdivision number: SP _____ and SP Lot #: _____	
If your property is not part of subdivision previously approved the Commission, please continue to Land Division History below. (check your deed or contact the LUPC office that serves your area)	
Land Division History. Using your deed as a starting point, trace the ownership history and configuration changes of your property back 20 years from today. List any division of those lots from which your property originated (use additional sheet of paper if needed).	(example: Amy Adams to Rob Roberts 1/12/1997 10 acres) Joan Leathers to Paul + Sandra Vaillancourt 3/4 (2014) Seldora A. (deceased) + Joan H. Leathers (surviving joint tenant) 0.31 ac Diamond Occidental Forest Inc to Seldora A. + Joan H. Leathers (2010) PRO/OK

3. EXISTING STRUCTURES OR USES (Fill in a line for each existing structure)

Previously issued Building Permit number (if applicable)

Type of structure (dwelling, garage, deck, porch, shed, driveway, parking area, etc.)	Year built	Exterior dimensions (in feet) (LxWxH)	Type of foundation (full basement, slab, post, etc.)	Horizontal Distance (in feet) of structure from nearest:						
				Road	Property line	Lake or pond	River or stream	Wetland	Ocean/Tidal waters	
Camp Privy		24x164"x14.6' 5'x6'	POST	110' 18' 26'	50 26' 100'					

JUN 15 2015

BP 15387

LUPC - MILLINOCKET

4. PROPOSED STRUCTURES OR USES (INCLUDING DRIVEWAYS AND PARKING AREAS) (Use additional sheet if needed)

4.1 What is the proposed use of your property? <input checked="" type="checkbox"/> Residential only <input type="checkbox"/> Residential with Home Occupation* <input type="checkbox"/> Personal Campsite**		Proposal (check all that apply)								Horizontal Distance (in feet) of structure from nearest:					
Type of structure (dwelling, garage, deck, porch, shed, driveway****, camper, RVs, parking lots, etc.)	New structure***	Reconstruct***	Expand	Relocate	Remove	Enclose deck/porch	Permanent foundation***	Change dimensions or setbacks	Exterior dimensions (in feet) (LxWxH)	Road	Property line	Lake or pond	River or stream	Wetland	Ocean/Tidal waters
Camp addition	<input type="checkbox"/>	<input type="checkbox"/>	<input checked="" type="checkbox"/>	<input type="checkbox"/>	<input type="checkbox"/>	<input type="checkbox"/>	<input type="checkbox"/>	<input type="checkbox"/>	10x16x16 34x16x16	100'	18'	25'			
Deck	<input type="checkbox"/>	<input type="checkbox"/>	<input type="checkbox"/>	<input type="checkbox"/>	<input type="checkbox"/>	<input type="checkbox"/>	<input type="checkbox"/>	<input type="checkbox"/>	8x24	100'	8'	30'			(obtain permission)
Privy	<input checked="" type="checkbox"/>	<input type="checkbox"/>	<input type="checkbox"/>	<input type="checkbox"/>	<input type="checkbox"/>	<input type="checkbox"/>	<input type="checkbox"/>	<input type="checkbox"/>	8x4x8	53'	20'	100'			
Shed	<input checked="" type="checkbox"/>	<input type="checkbox"/>	<input type="checkbox"/>	<input type="checkbox"/>	<input type="checkbox"/>	<input type="checkbox"/>	<input type="checkbox"/>	<input type="checkbox"/>	12x8x10	49'	28'	100'			
Parking Area	<input checked="" type="checkbox"/>	<input type="checkbox"/>	<input type="checkbox"/>	<input type="checkbox"/>	<input type="checkbox"/>	<input type="checkbox"/>	<input type="checkbox"/>	<input type="checkbox"/>	30x50	50	15	>100'			
	<input type="checkbox"/>	<input type="checkbox"/>	<input type="checkbox"/>	<input type="checkbox"/>	<input type="checkbox"/>	<input type="checkbox"/>	<input type="checkbox"/>	<input type="checkbox"/>							
	<input type="checkbox"/>	<input type="checkbox"/>	<input type="checkbox"/>	<input type="checkbox"/>	<input type="checkbox"/>	<input type="checkbox"/>	<input type="checkbox"/>	<input type="checkbox"/>							

* 4.2 HOME OCCUPATIONS: If use of your property includes expanding or starting a home occupation, you must complete Supplement S-1: Questions for Home Occupations. Contact the LUPC office serving your area or download at www.maine.gov/dacf/lupc/. Please note additional fees apply to home occupations, see instructions for the appropriate fees.

- ** 4.3 CAMPSITES: If use of your property includes a campsite for your personal use (e.g., will not be rented):
- a. Will the tents, tent trailer(s), pickup camper(s), recreational vehicle(s), trailer(s) or similar devices be located on the lot for less than 120 days in a calendar year? YES NO
 - b. Will the camper(s), trailer(s), and/or recreational vehicle(s) be registered and road ready? YES NO
 - c. Will the campsite have access to an on-site pressurized water supply (and not a self-contained water tank with pump)? YES NO
 - d. Will the campsite have access to permanent structures other than an outhouse, fireplace, picnic table, or lean-tos? YES NO

- *** 4.4 RECONSTRUCTIONS OR NEW ACCESSORY STRUCTURES: If you are constructing a new accessory structure, reconstructing an existing structure, or adding a permanent foundation:
- a. If the structure or foundation will not meet the LUPC's minimum setback distances from property lines, roads, water bodies or wetlands, explain what physical limitations (lot size, slope, location of septic system, etc.) prevent the structure or foundation from meeting setbacks:

 - b. For reconstructions, has the existing structure been damaged, destroyed or removed from your property? YES NO
If YES, was the structure in regular active use within a 2-year period preceding the damage, destruction or removal? YES NO
If YES, provide the date the structure was damaged, destroyed or removed: _____

- **** 4.5 DRIVEWAYS: If you are located on a public road:
- a. Are you constructing a new driveway or entrance or changing a current driveway in a way that will increase traffic volume, or create a safety or drainage concern regarding a State or State-Aid Highway? YES NO
If YES, you must submit Exhibit H: Driveway/Entrance Permit. Note: If your property is located along a County or Town/Plantation Road, you should check with that office before submitting this application to see what is required.

5. SUBSURFACE WASTEWATER DISPOSAL (SEPTIC SYSTEM) (Note: Exhibit may be required. See instructions)

- 5.1 Mark the existing type of system serving the property: None Combined Subsurface System (Tank, leach field)
 Primitive Subsurface Disposal (Privy, graywater - non-pressurized); Common Sewer (Connected to a sewer district)
 Holding Tank Self-Contained Camper or RV Other
- 5.2 Will any expanded, reconstructed, or new structures include new bedrooms or bathrooms; add plumbing, water fixtures, pressurized water, or the ability for human habitation; or otherwise generate additional wastewater? YES NO
 If YES, you may need to submit Exhibit E: Subsurface Wastewater Disposal. (see instructions on page iv)

JUN 15 2015

BP 15387

LUPC - MILLINOCKET

6. DEVELOPMENT IN FLOOD PRONE AREAS (Note: Supplement may be required. See instructions.)

- 6.1 Is your proposed activity located within a mapped P-FP (Flood Prone Area Protection) Subdistrict, a mapped FEMA (Federal Emergency Management Agency) flood zone, or an unmapped area prone to flooding?
 - P-FP Subdistrict YES NO
 - FEMA Flood Zone YES NO
 - Unmapped Area Prone to Flooding YES NO

If you answer YES to any of these questions, you must complete Supplement S-4: Development in Flood Prone Areas. Contact the LUPC office serving your area or download at www.maine.gov/dacf/lupc/application_forms/index.shtml.

7. VEGETATIVE CLEARING (Note: Exhibit may be required. See instructions.)

- 7.1 What is the total amount of proposed vegetative clearing not including the driveway and the footprint of proposed structures? NA 7,380 sq. ft.
If you answer NA (not applicable) for 7.1 go to Section 8.
- 7.2 Will the total amount of existing and proposed vegetative clearing within 250 feet of any lakes or rivers be less than 10,000 square feet? YES NO NA Total: 7,380 sq. ft.
- 7.3 Will the proposed clearing be located at least 50 feet from the right-of-way or similar boundary of all public roadways? YES NO NA How Close? 10 feet
- 7.4 Will the proposed clearing be located at least 75 feet from the normal high water mark of any body of standing water less than 10 acres in size, any tidal water, or flowing water draining less than 50 square miles? YES NO NA How Close? 100 feet
- 7.5 Will the proposed clearing be located at least 100 feet from the normal high water mark of the lake or river? YES NO NA How Close? 100 feet
- 7.6 If you answer NO to any of these questions, please explain why your vegetative clearing proposal is necessary and how it will not create an undue adverse impact on the resources and uses in the area:

- 7.7 Buffering in Prospectively Zoned Areas. Is your property located in one of the following Prospectively Zoned Plantations or Townships? YES NO
 - Adamstown Twp. Rangeley Plt.
 - Dallas Plt. Richardsontown Twp.
 - Lincoln Plt. Sandy River Plt.
 - Magalloway Plt. Townships C, D, and E.

If YES, please complete the following table regarding the width of the vegetative buffers at the narrowest point between the existing and proposed structures and the nearest applicable road, property line, and subdistrict setbacks as applicable:

Standard Minimum Required:	Width of Vegetated Buffers			
	Road	Side Property Line	Rear Property Line	Subdistrict Boundary (If D-ES or D-CI)
25 feet in D-GN, D-GN2, D-GN3 50 feet in D-RS, D-RS2, D-RS3 75 feet in D-ES and D-CI		15 feet	15 feet	50 feet Buffer to other Subdistricts
This property:	_____ feet	_____ feet	_____ feet	_____ feet

Note: You may be required to submit Exhibit F: Documentation for Exceptions to Buffering Requirements. (See instructions on page iv)

8. SOIL DISTURBANCE, FILLING AND GRADING AND EROSION CONTROL (Note: Exhibit may be required. See instructions.)

- 8.1 Will your project involve disturbing soil or filling and grading? YES NO
If YES, please answer the following questions. If NO, continue to Section 9.
- 8.2 What is the total area of proposed soil disturbance or filling and grading? 5000 sq. ft.
- 8.3 Will the area of soil disturbance or filling and grading within 250 of a lake or river be less than 5,000 sq. ft.? NA YES NO
a. If NO, what is the total square feet of soil disturbance or filling and grading within 250 feet? sq. ft.
- 8.4 Will all soil disturbance or filling and grading be done when the ground is NOT frozen or saturated? YES NO
If NO, you will need to submit Exhibit G: Erosion and Sedimentation Control Plan
- 8.5 What will be the closest distance from the area to be disturbed to the nearest waterbody or wetland? 100 feet
- 8.6 Will any removed topsoil be stockpiled at least 100 feet from water and wetlands? YES NO
- 8.7 Will any fill used be free of hazardous or toxic materials, trash and rubbish? YES NO

Question 8 continues onto the next page...

JUN 15 2015

LUPC - MILLINOCKET

BP 16387

8. SOIL DISTURBANCE, FILLING AND GRADING AND EROSION CONTROL (continued from previous page)

- 8.8 Will all disturbed or filled area (other than driveways or walkways) be properly seeded and mulched prior to September 15 OR be heavily mulched with hay that is tacked down and a minimum of 4 inches in depth to prevent sedimentation in the spring? YES NO
- 8.9 Will existing waterbodies, wetlands, and culverts in the area be protected by the use of hay bales, silt fence or other measures? YES NO
- 8.10 What is the average slope of land between the area to be disturbed and the nearest waterbody or wetland?
 - 10% or Less (Requires minimum setback of 100') 20% (Requires minimum setback of 130')
 - 30% (Requires minimum setback of 170') 40% (Requires minimum setback of 210')
 - 50% (Requires minimum setback of 250') 60% (Requires minimum setback of 290')
 - 70% (Requires minimum setback of 330')

(Note: Between 10% and 20% average slope, an additional 3 foot setback is required for each additional 1% of slope (example: an average slope of 12% requires a minimum setback of 106 feet.))

(Note: Between 21% and 70% average slope, an additional 4 foot setback is required for each additional 1% of slope (example: an average slope of 36% requires a minimum setback of 194 feet.))
- 8.11 If you answer NO to any of these questions, or your project will not meet the minimum setback for your slope in 8.10, please explain how your project will not create an undue adverse impact on the resources and uses in the area. Include information about erosion control devices and other plans to stabilize the site:

9. LAND AND WETLAND ALTERATION (Note: Exhibit or Supplement may be required. See instructions.)

- 9.1 Will your proposal alter a total of one acre or more of land area, whether upland or wetland? YES NO
If YES, you must also complete Exhibit G: Erosion and Sedimentation Control Plan and Supplement S-3: Requirements for Wetland Alterations.
- 9.2 Will your proposal alter any amount of land that is mapped P-WL Subdistrict, or any ground below the normal high water mark of any lake, pond, river, stream, or intertidal area? YES NO
If YES, you must also complete Supplement S-3: Requirements for Wetland Alterations.

10. APPLICANT SIGNATURE (REQUIRED) AND AGENT AUTHORIZATION (OPTIONAL)

Agent Name	Daytime Phone	FAX
Mailing Address	Email	
Town	State	Zip Code

I have personally examined and am familiar with the information submitted in this application, including the accompanying exhibits and supplements, and to the best of my knowledge and belief, this application is complete with all necessary exhibits. I understand that if the application is incomplete or without any required exhibits that it will result in delays in processing my permit decision. The information in this application is a true and adequate narrative and depiction of what currently exists on and what is proposed at the property. I certify that I will give a copy of this permit and associated conditions to any contractors working on my project. I understand that I am ultimately responsible for complying with all applicable regulations and with all conditions and limitations of any permits issued to me by the LUPC. If there is an Agent listed above, I hereby authorize that individual or business to act as my legal agent in all matters relating to this permit application. I understand that while there is a required Statewide Maine Uniform Building and Energy Code (MUBEC) administered by the Maine Department of Public Safety, Bureau of Building Codes & Standards, the Commission's review is limited only to land use issues and the Commission does not make any findings related to the MUBEC, nor do the LUPC staff inspect buildings or enforce any provisions of that Code.

Please check one of the boxes below: (see "Accessing the Project Site for Site Evaluation and Inspection" just prior to the application form)

- I authorize staff of the Land Use Planning Commission to access the project site as necessary at any reasonable hour for the purpose of evaluating the site to verify the application materials I have submitted, and for the purpose of inspecting for compliance with statutory and regulatory requirements, and the terms and conditions of my permit.
- I request that staff of the Land Use Planning Commission make reasonable efforts to contact me in advance to obtain my permission to fully access the project site for purposes of any necessary site evaluation and compliance inspection.

All appropriate persons listed on the deed, lease or sales contract must sign below.

Signature(s) Paul Villancourt Date 1-19-15
Sandra Villancourt Date 1-19-15

Tr # 48254

For office use:

~~48013~~

BP

15387

Tracking No.

Permit No.


RECEIVED

JUN 15 2015

LUPC - MILLINOCKET

EXHIBIT D-1: SITE PLAN

Prepare a bird's-eye view site plan that shows your entire property and includes all the elements described for Exhibit D in the instructions on page iv. Do not use colors. Refer to the instructions on page v for a sample site plan.

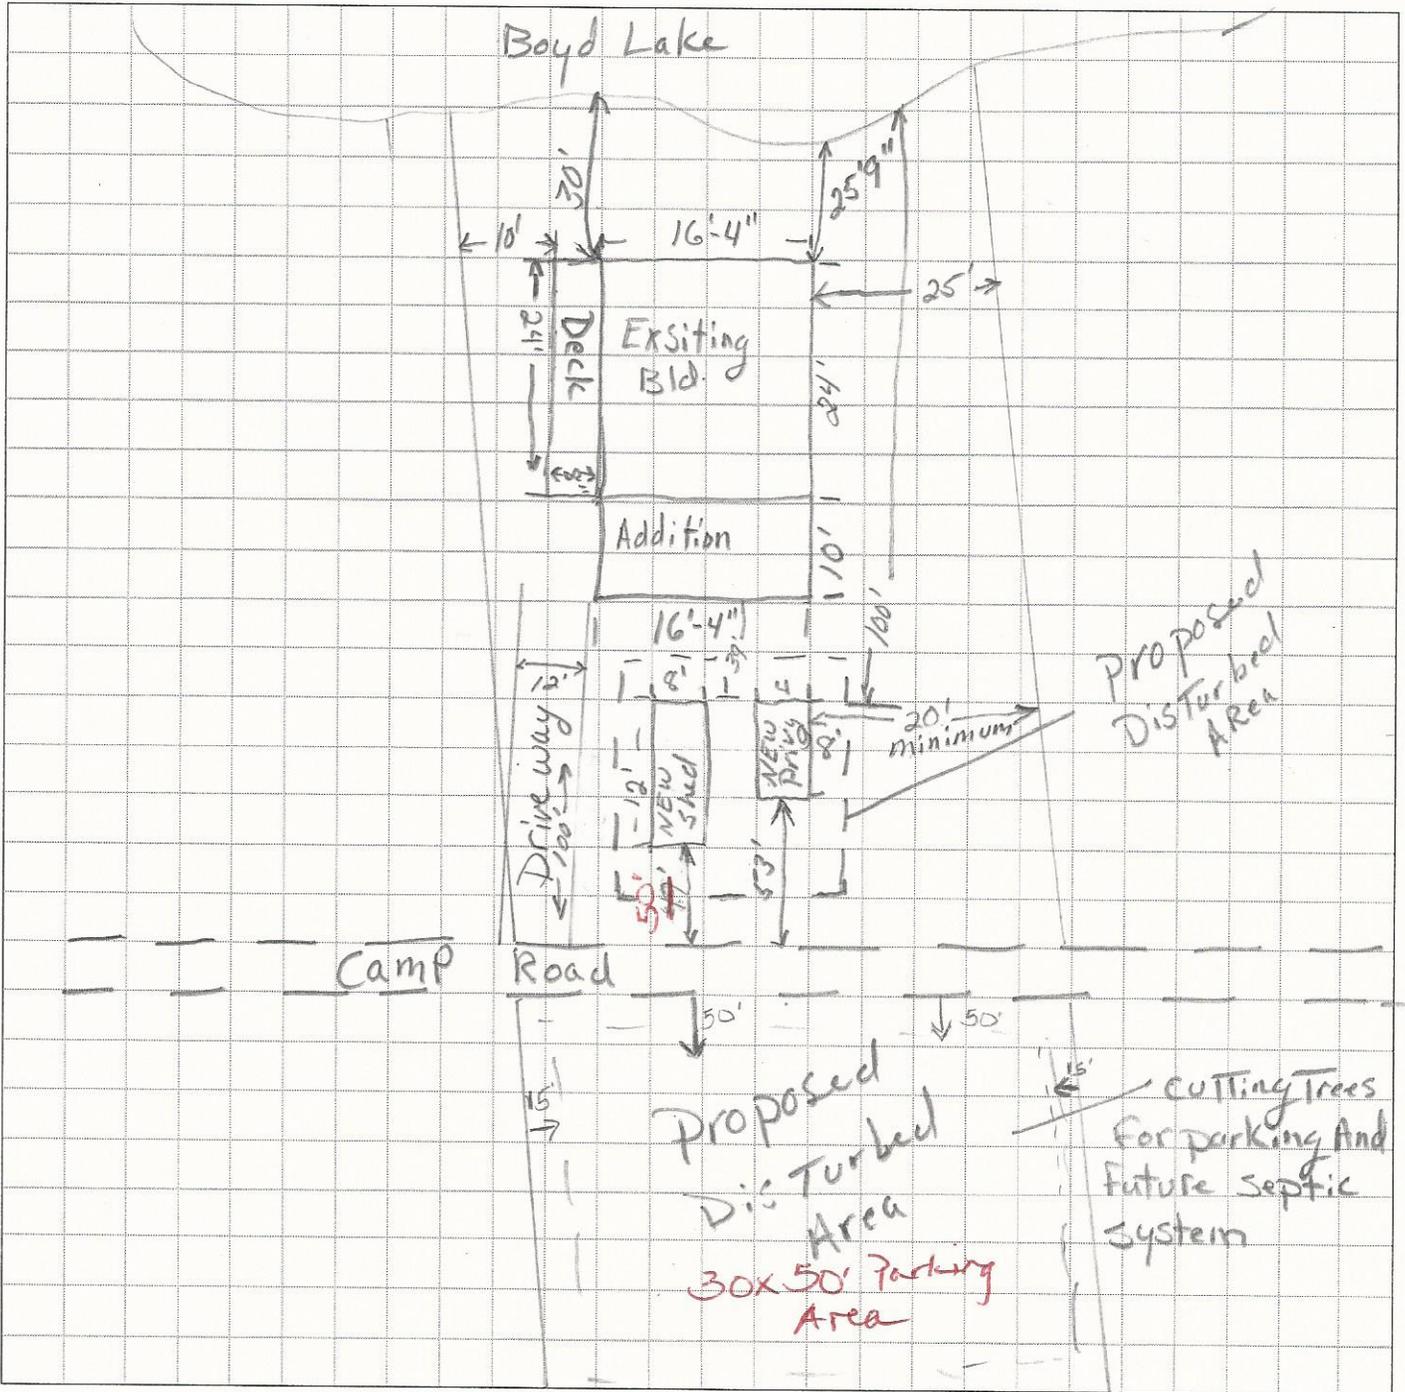

Notes/Legend:

I HEREBY CERTIFY THAT PROPOSED IMPROVEMENTS
DEPICTED HEREON ARE LOCATED ON EXISTING GRADES
WITH ELEVATIONS ABOVE THE BASE FLOOD ELEVATION



6/21/15

OSCAR F. EMERSON, JR., PLS #2102


DATE

APPROX. NORTH

RECEIVED

JUN 24 2015

LUPC - MILLINOCHET

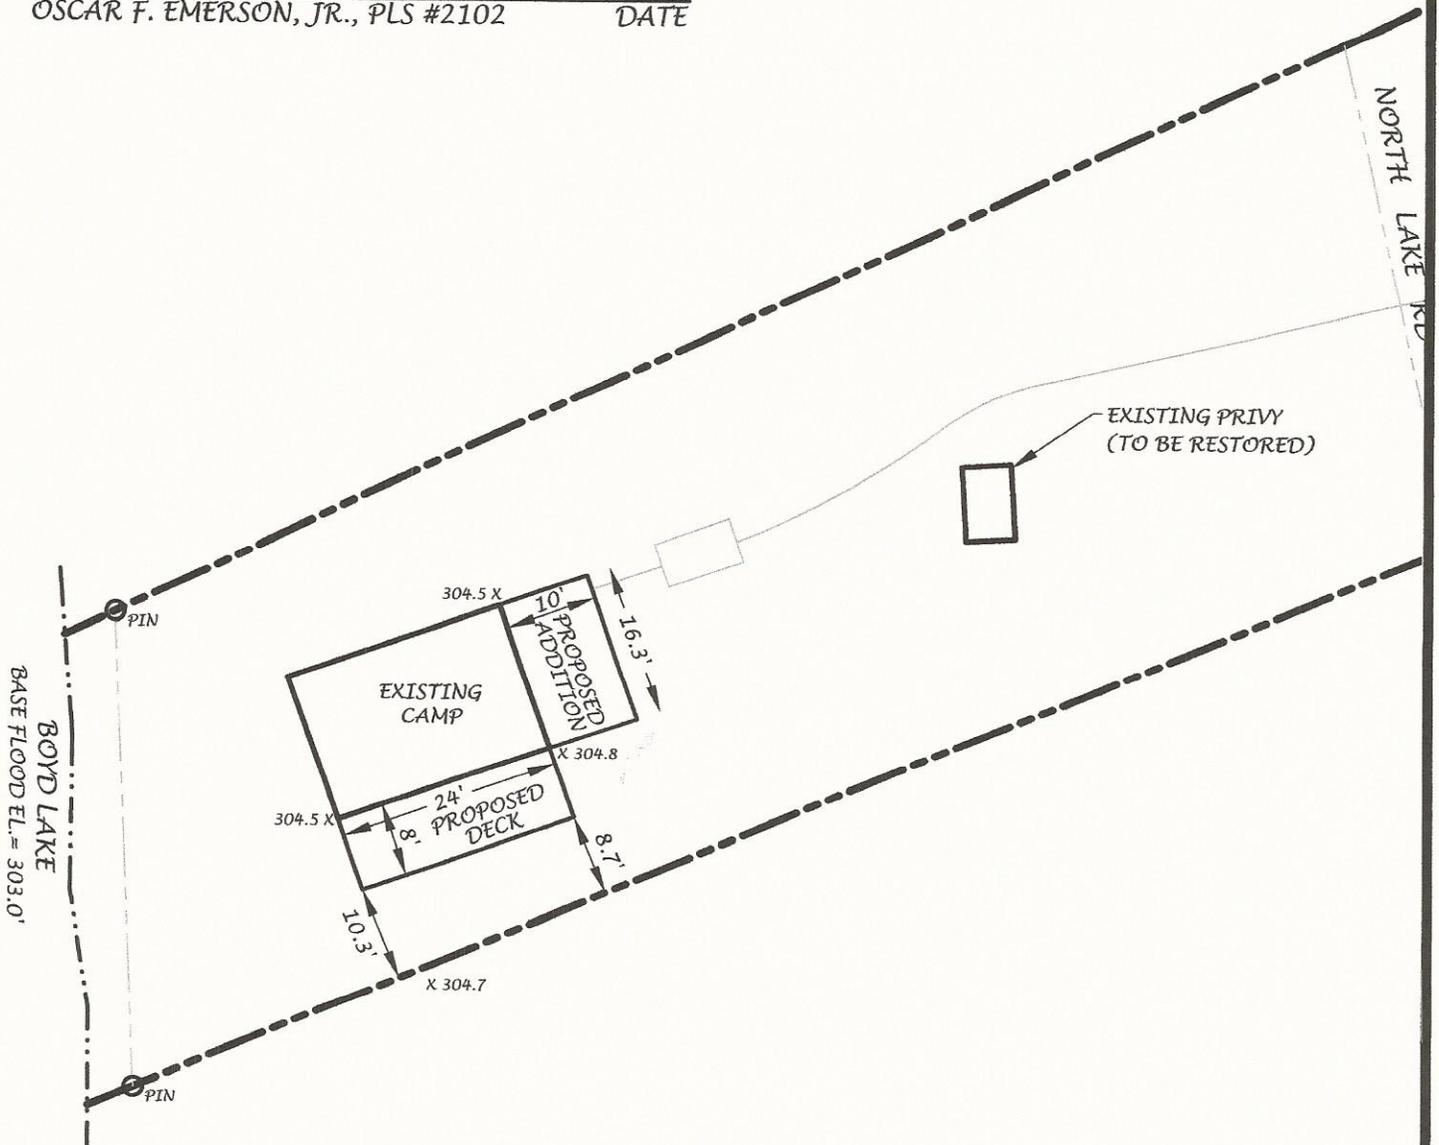

SITE SKETCH
TAX MAP PI 082
PLAN 6, LOT 74
KNOWLES LANDING
ORNEVILLE, MAINE

DATE: JUNE 2015, SCALE: 1"=20'



DOWN to EARTH
PROFESSIONAL LAND SERVICES, INC.
P.O. BOX 443
BRADLEY, MAINE 04411-0443
TEL. 207-827-6733