
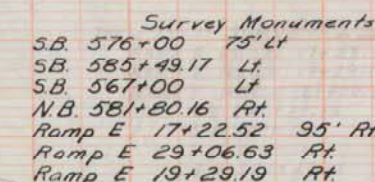


N.B. Sta. 592+00  
Installed 15" x 168" RCP CI

Constructed 1973

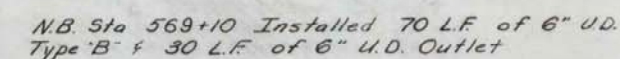

Brunswick 1-95-4(25)