



DATE
BY
CHECKED
DESIGNED
APPROVED
FINAL
SURVEY
NOTE BOOK
REVISIONS

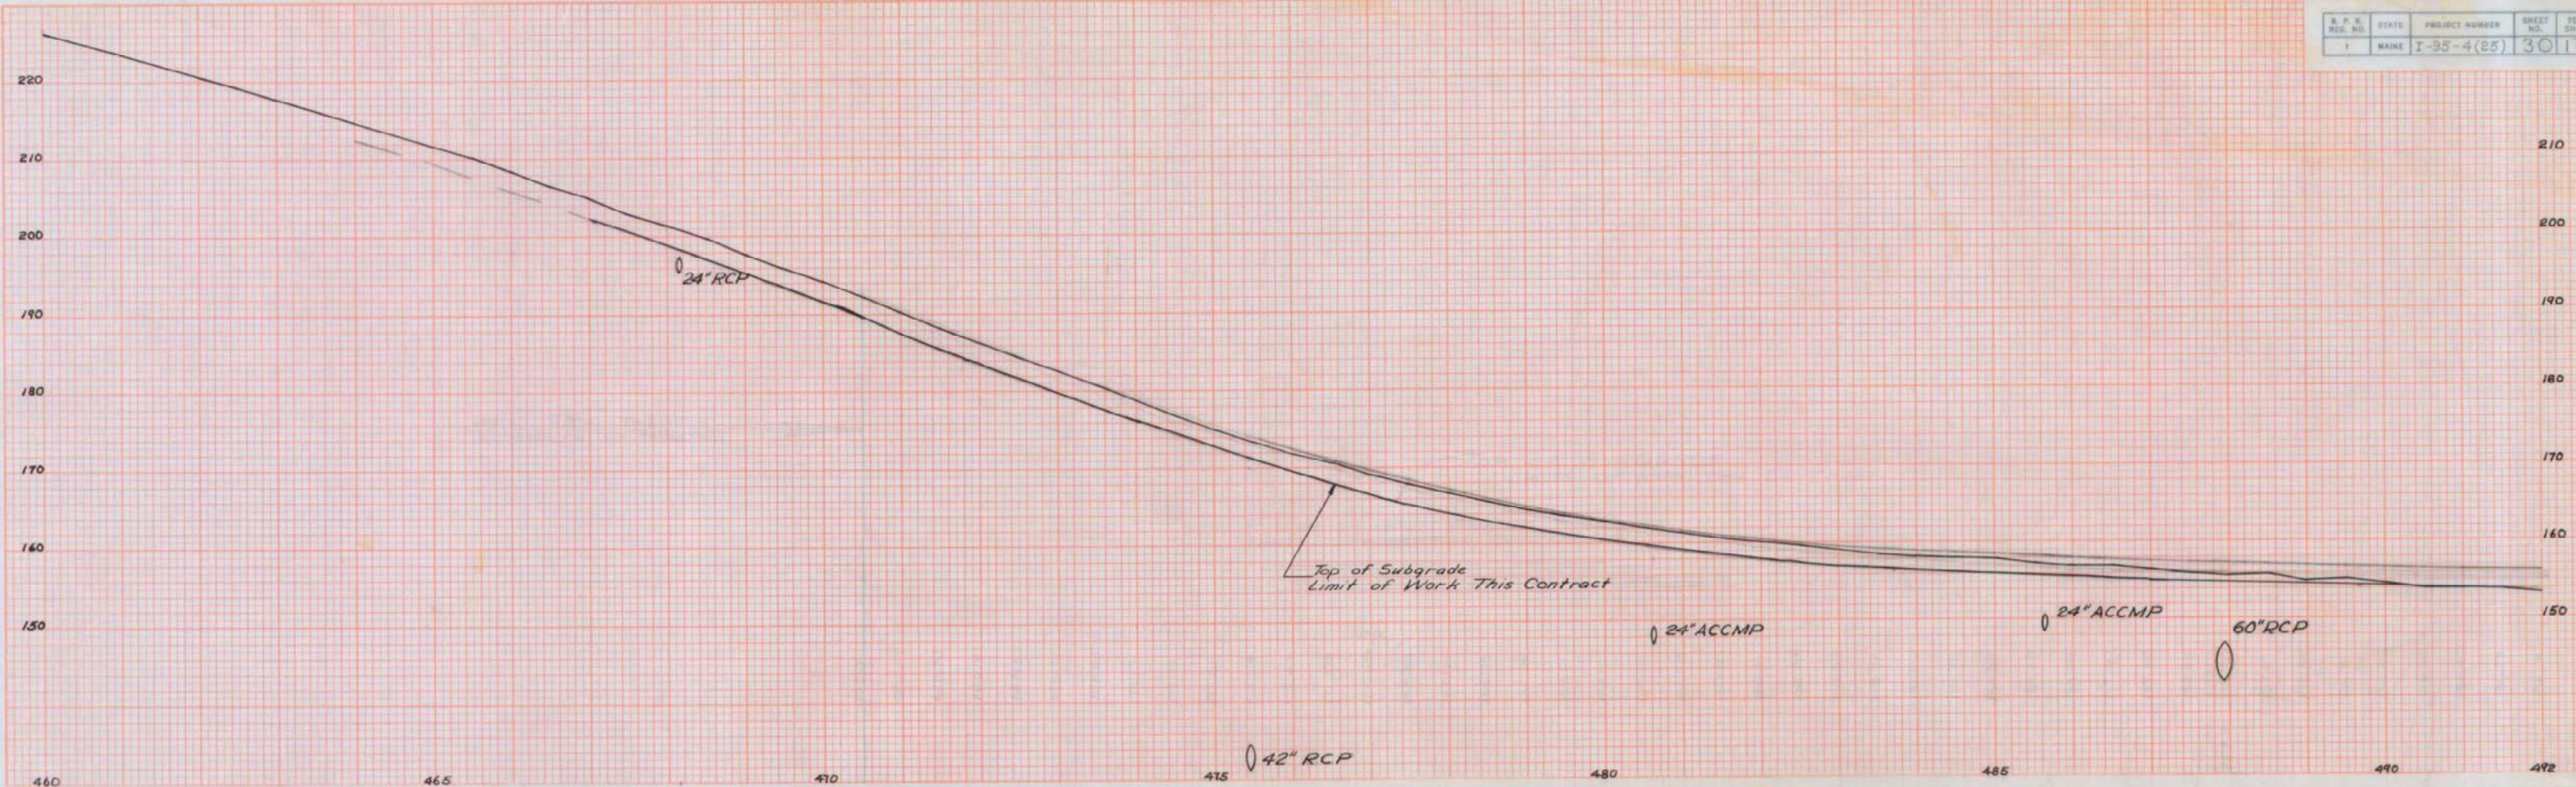

DATE
BY
CHECKED
DESIGNED
APPROVED
FINAL
SURVEY
NOTE BOOK
REVISIONS

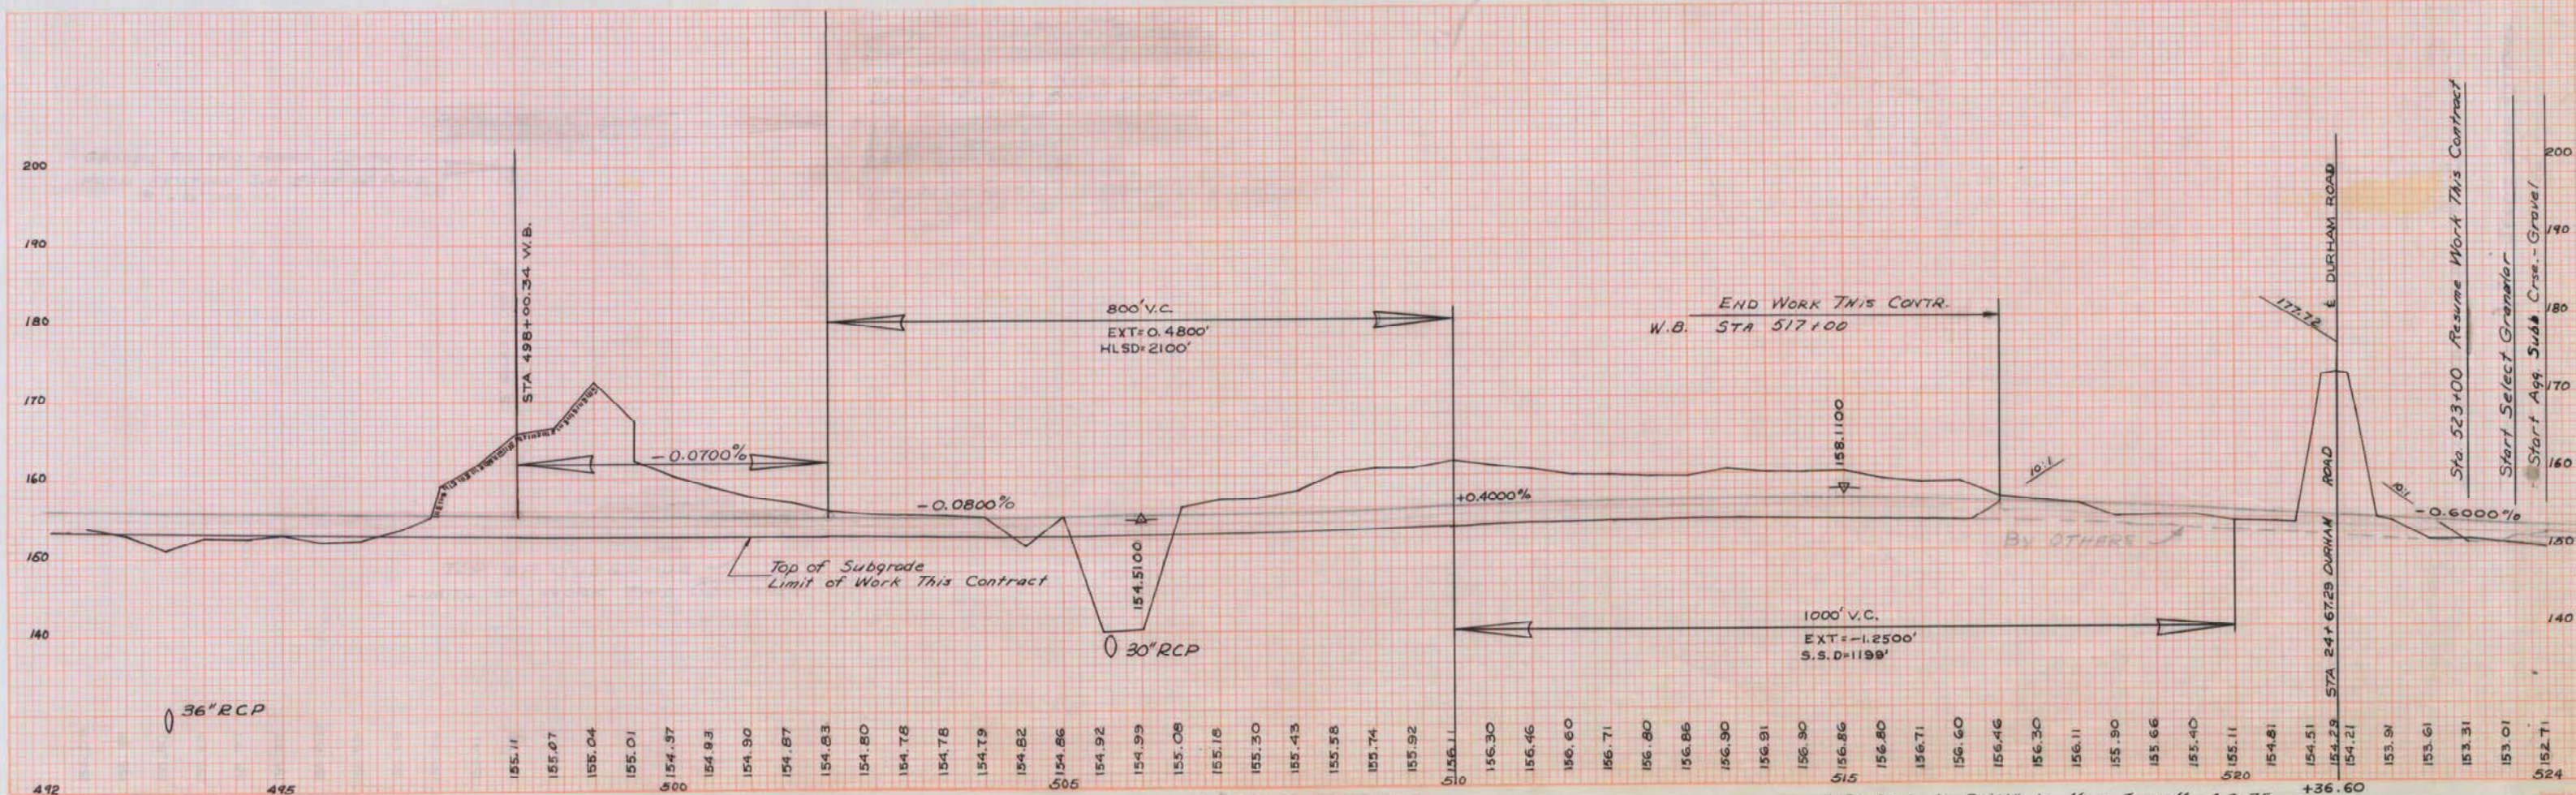

"Revised As Built" by Gary Russell 4-3-75

PLATE 3 CROSS SECTION OF I-95 STANDARD