


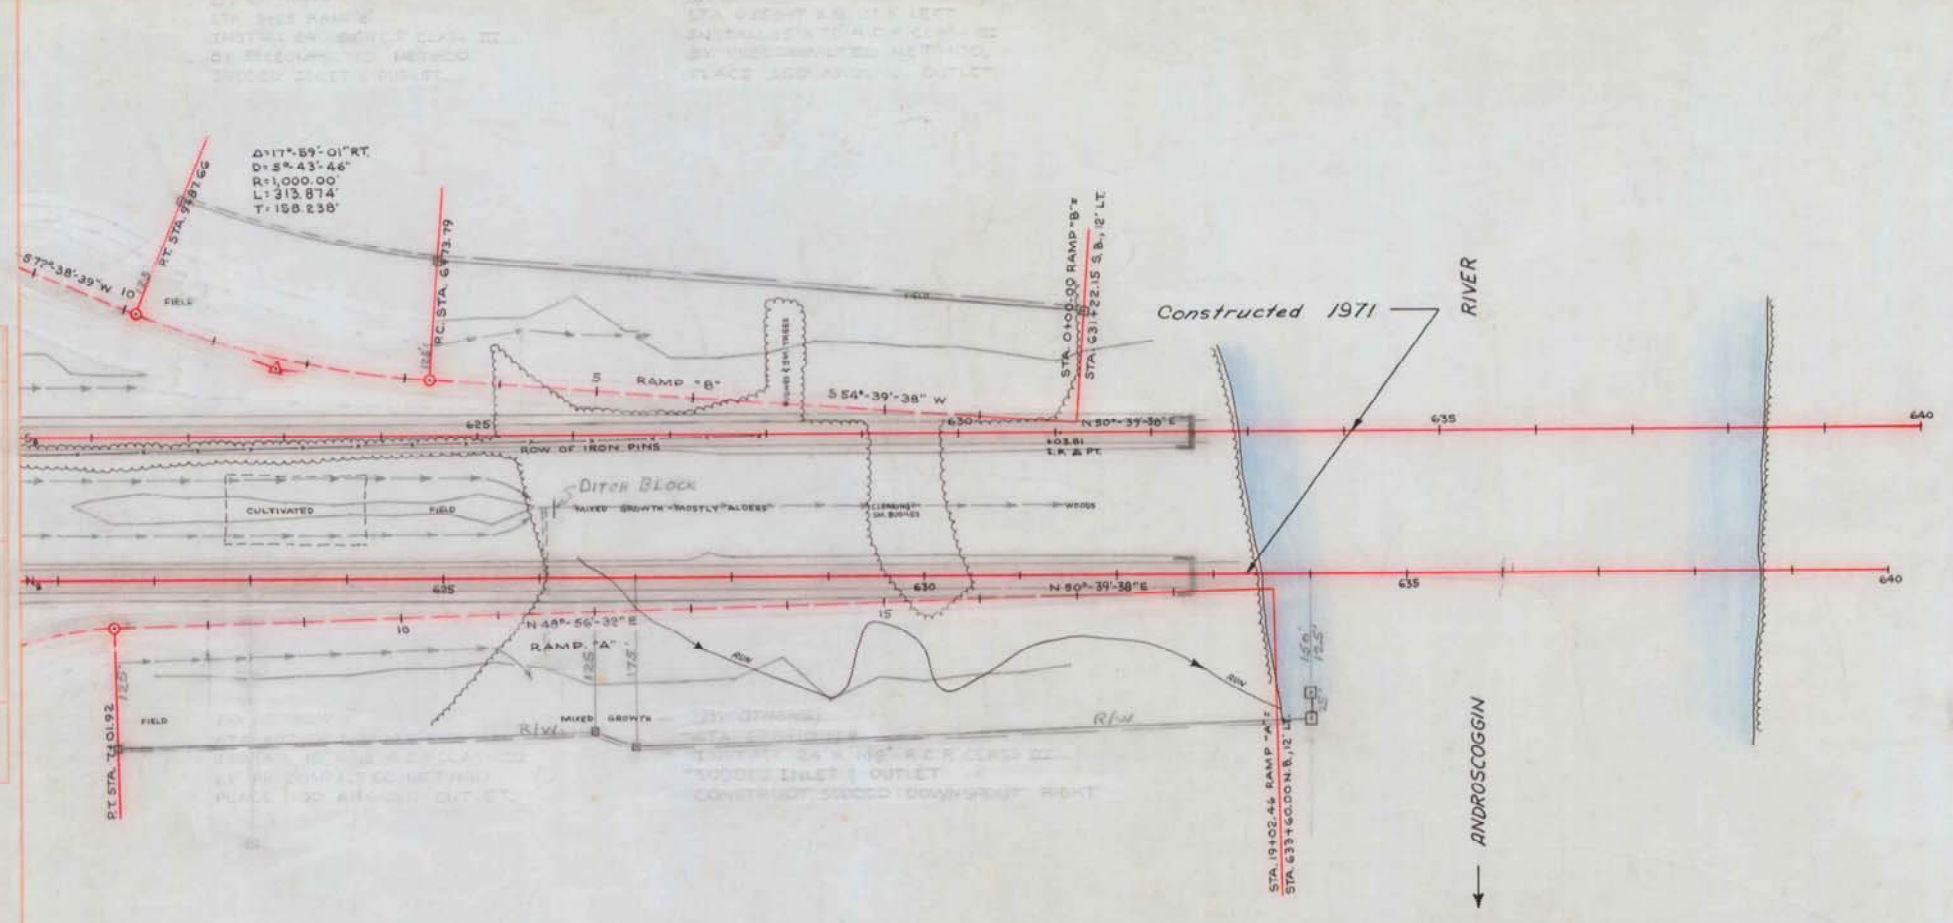


PLAN  
 DATE: 3-27-75  
 BY: Gary Truett  
 CHECKED: [blank]  
 SCALE: 1" = 100'



Bench Marks

BM 101.92 58.0610 130' RL VS. 101.92 58.0610 130' RL  
 BM 632.143 59.11 VS. 632.143 59.11

PROFILE  
 DATE: 3-27-75  
 BY: Gary Truett  
 CHECKED: [blank]  
 SCALE: 1" = 100'

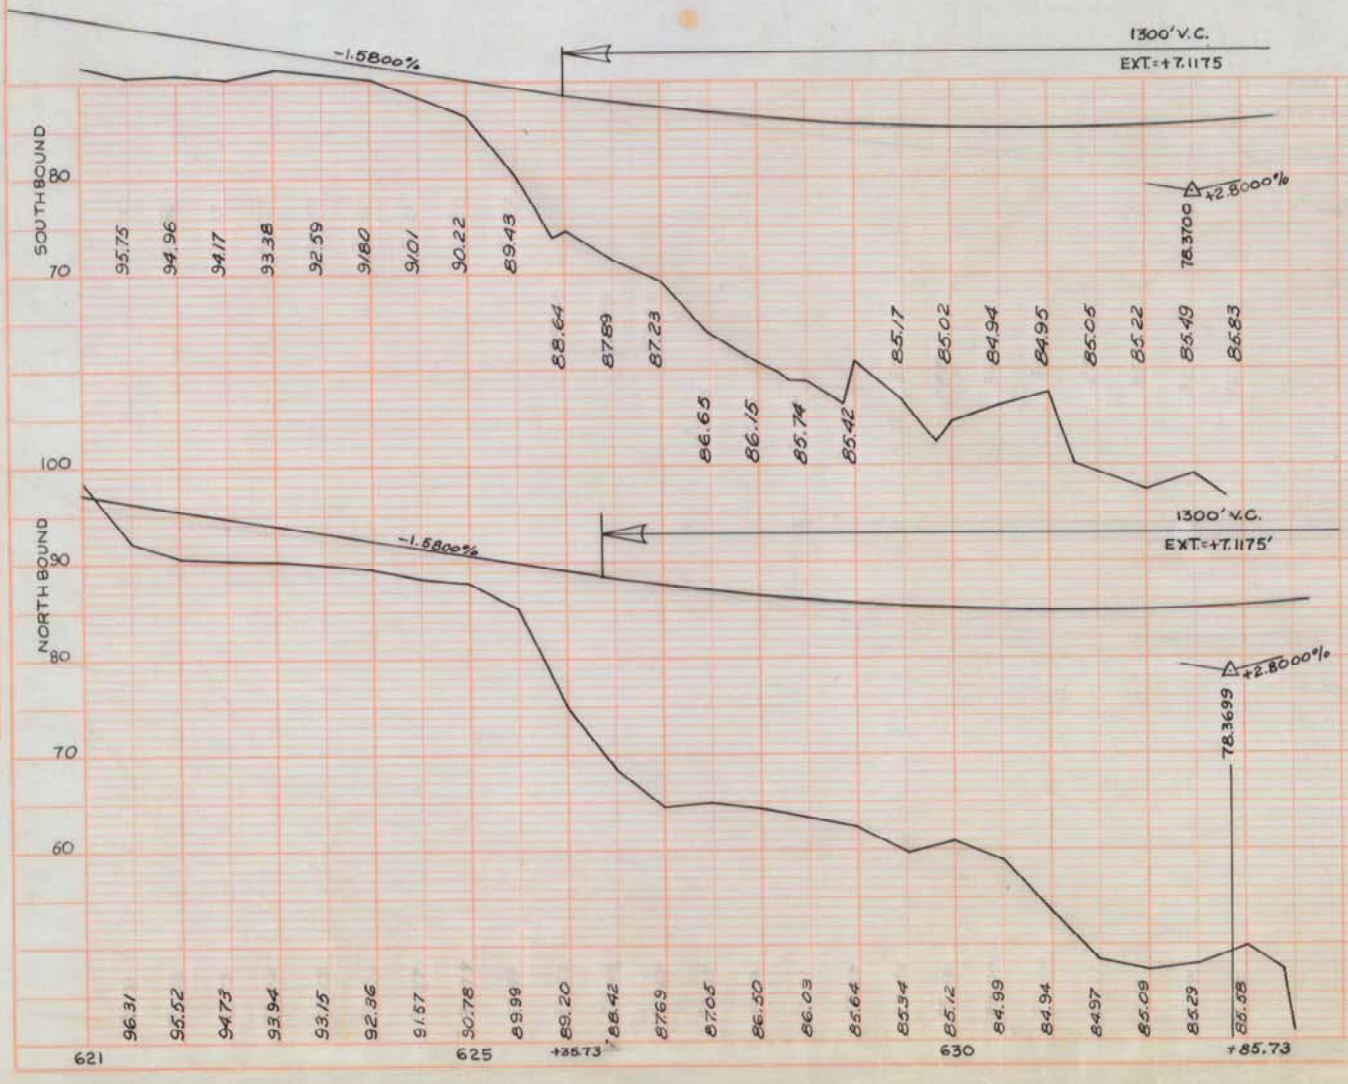

Revised As Built by Gary Truett 3-27-75