



DATE	BY
FINAL SURVEY	QUICK
NOTED	PLANNED
NO.	AREA
	CHECKED

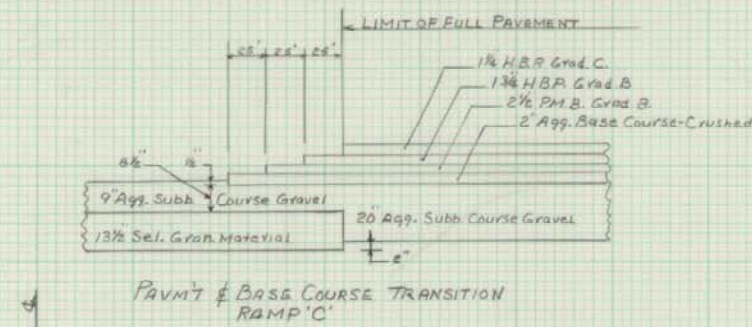


PAV'T. & BASE COURSE TRANSITION RAMP 'C'

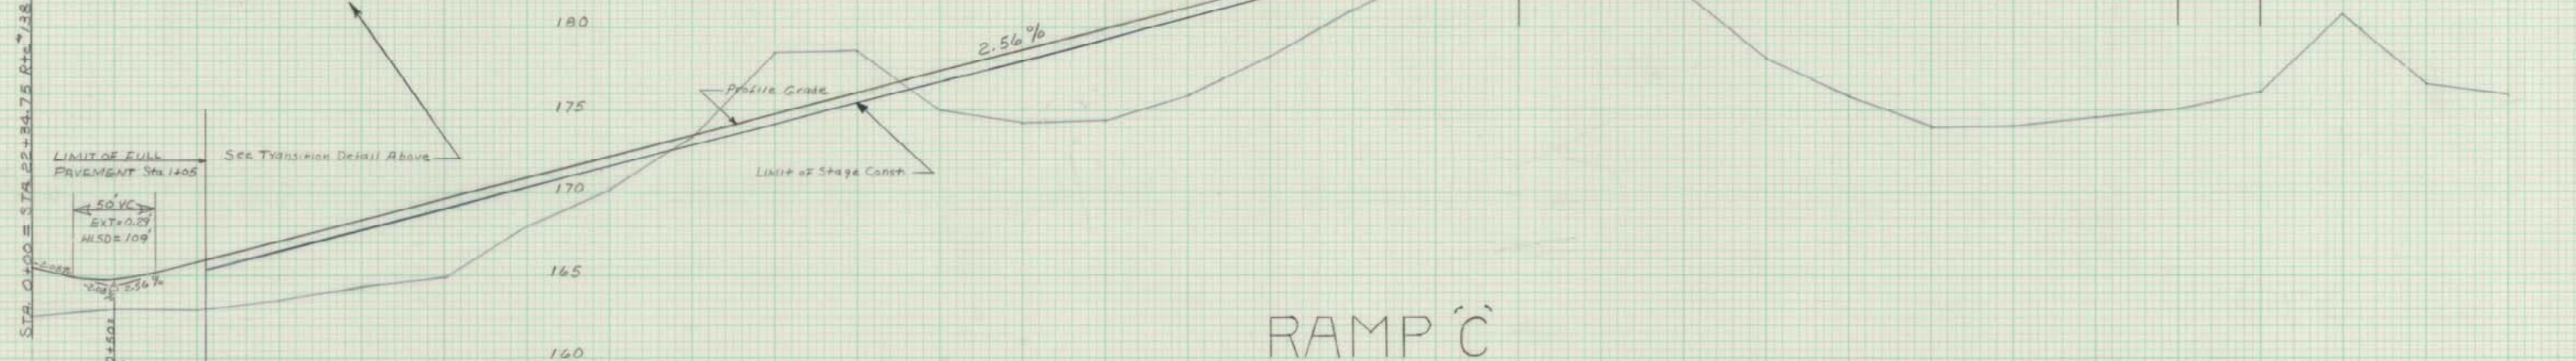


RAMP 'C'

0+00	165.49
0+50	164.74
1+00	165.73
1+50	167.01
2+00	168.29
2+50	169.27
3+00	170.85
3+50	172.13
4+00	173.41
4+50	174.69
5+00	175.97
5+50	177.25
6+00	178.53
6+50	179.81
7+00	181.09
7+50	182.37
8+00	183.65
8+50	184.93
9+00	186.21
9+50	187.41
10+00	189.44
10+50	189.30
11+00	189.99
11+50	190.52
12+00	190.88
12+50	191.07
13+00	191.09
13+50	191.04

DATE	BY
1-72	H. C. C. R.
ORIGINAL SURVEY	QUICK
NOTED	PLANNED
NO.	AREA
	CHECKED

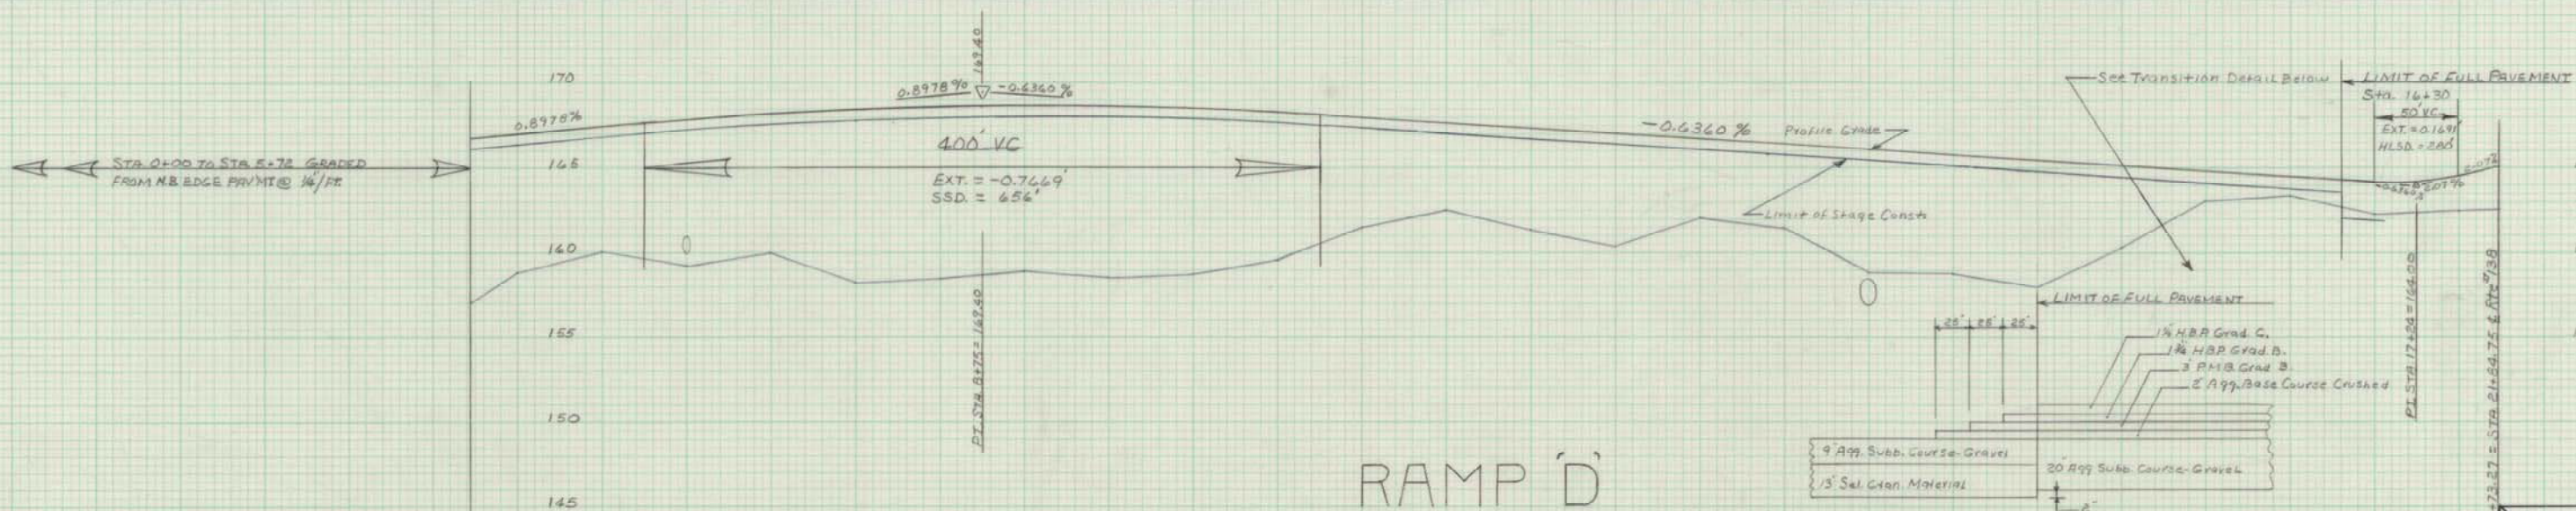

RAMP 'D'

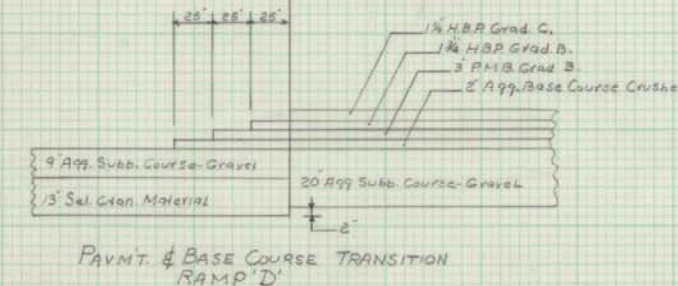

PAV'T. & BASE COURSE TRANSITION RAMP 'D'

5+72	166.68
6+00	166.93
6+50	167.38
7+00	167.82
7+50	168.17
8+00	168.43
8+50	168.59
9+00	168.65
9+50	168.62
10+00	168.50
10+50	168.27
11+00	167.97
11+50	167.65
12+00	167.33
12+50	167.01
13+00	166.70
13+50	166.38
14+00	166.06
14+50	165.74
15+00	165.42
15+50	165.11
16+00	164.79
16+50	164.47
17+00	164.15
17+50	164.84

STATE OF MAINE
DEPT. OF TRANS.
PROFILE RAMPS
C & D
AS BUILT 1975