

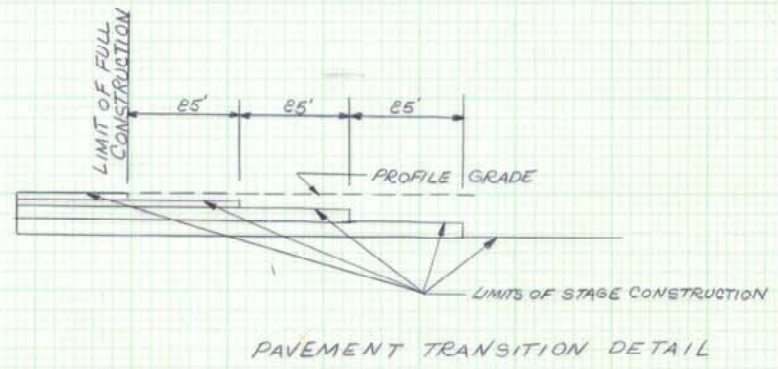
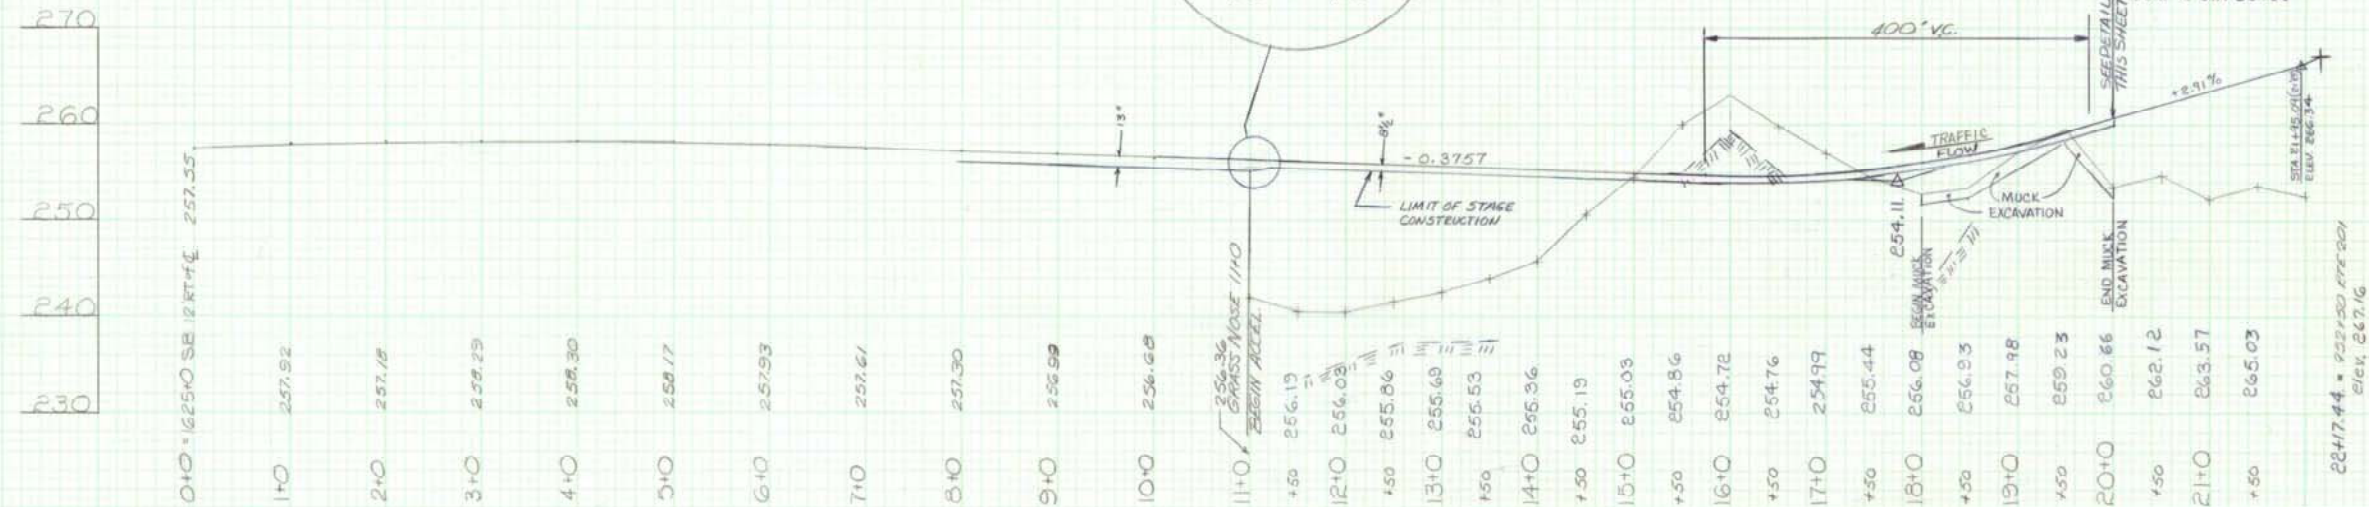
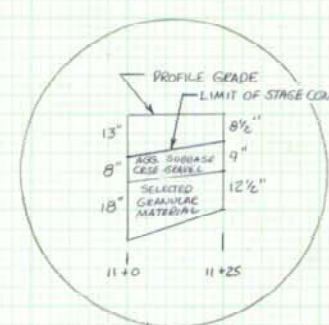


RAMP A

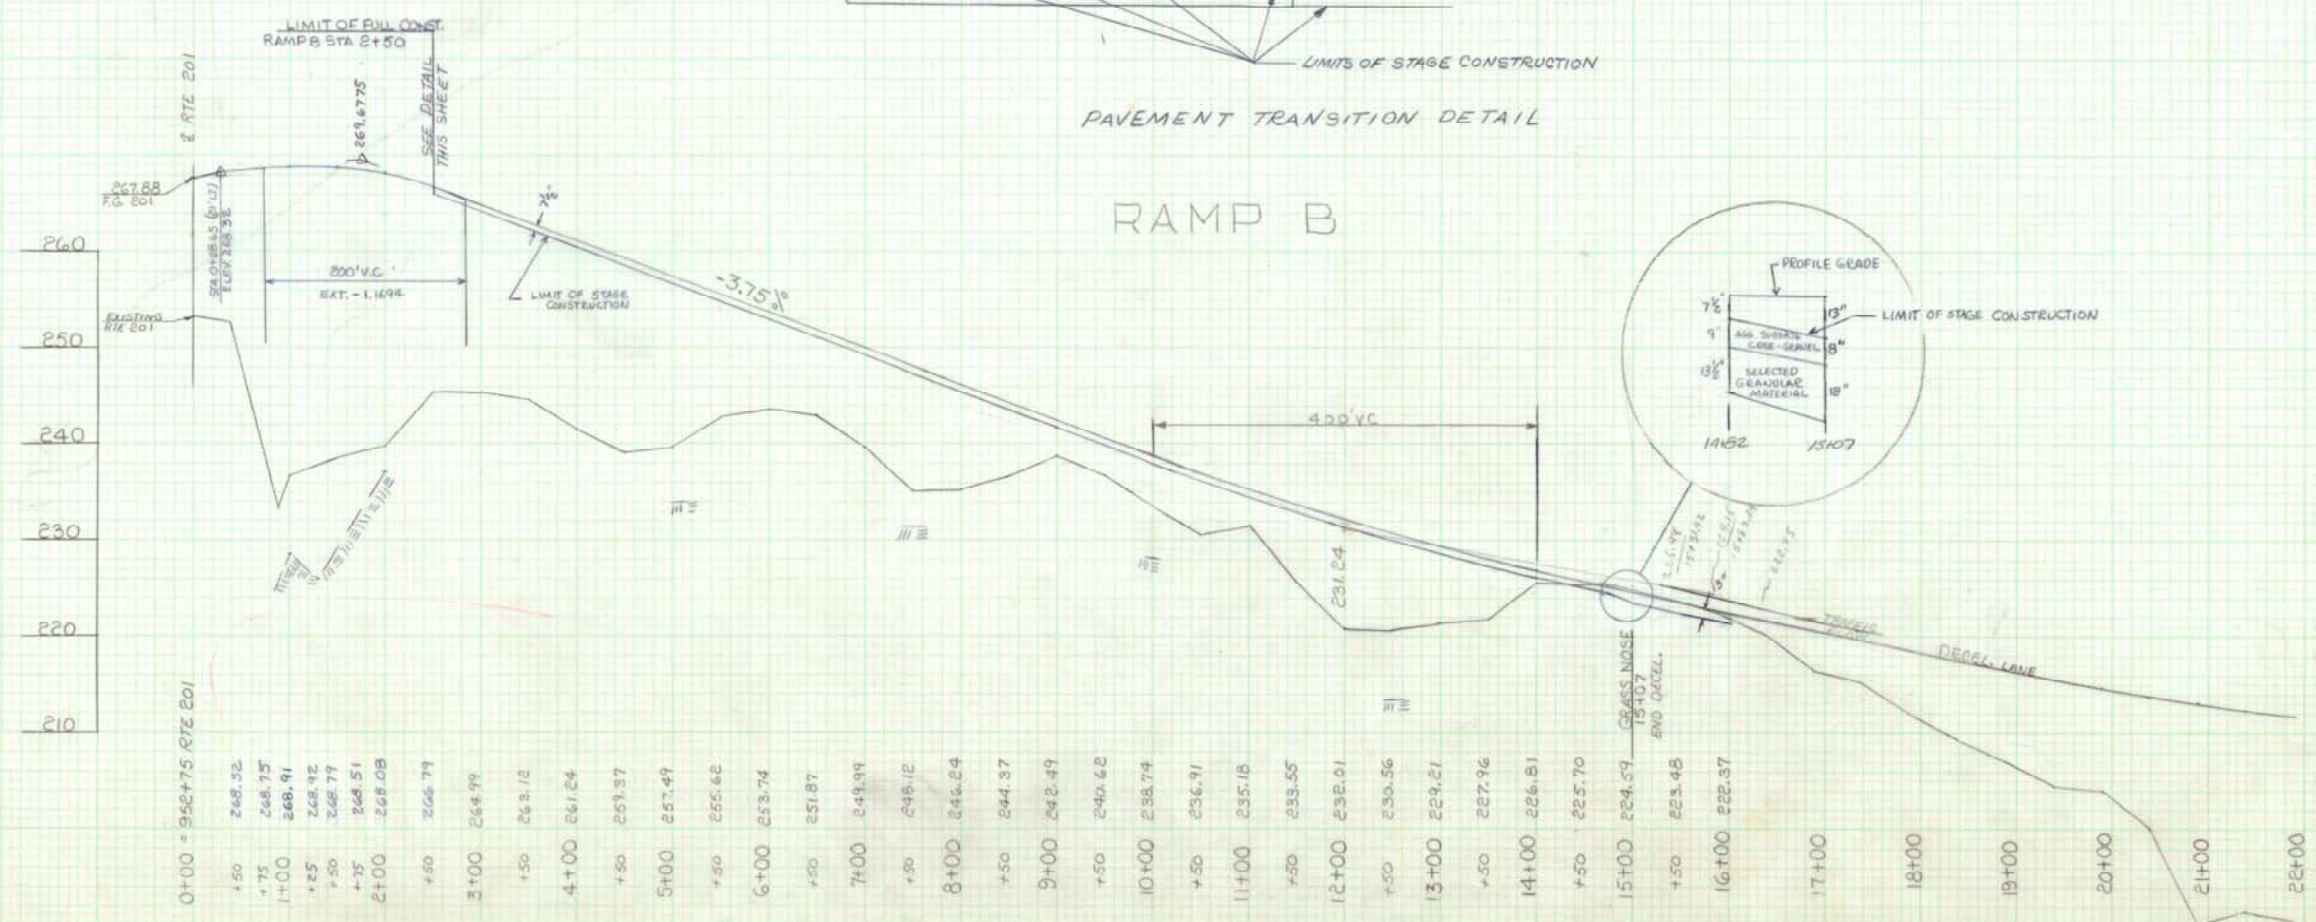

RAMP B

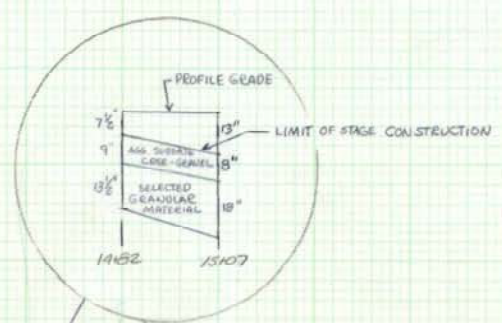

Revised as built H.E. Robinson 7/14
DEPARTMENT OF TRANSPORTATION

PROFILE RAMPS A & B