

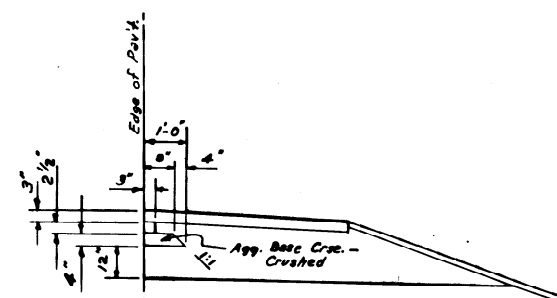


STAGE CONSTRUCTION-GRADING & SUBBASE


ONE WAY RAMPS

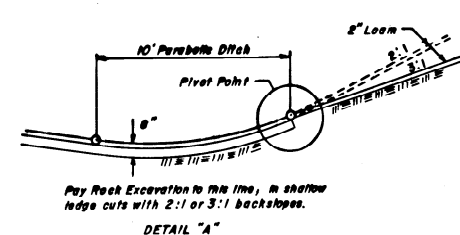

SHOULDER DETAIL

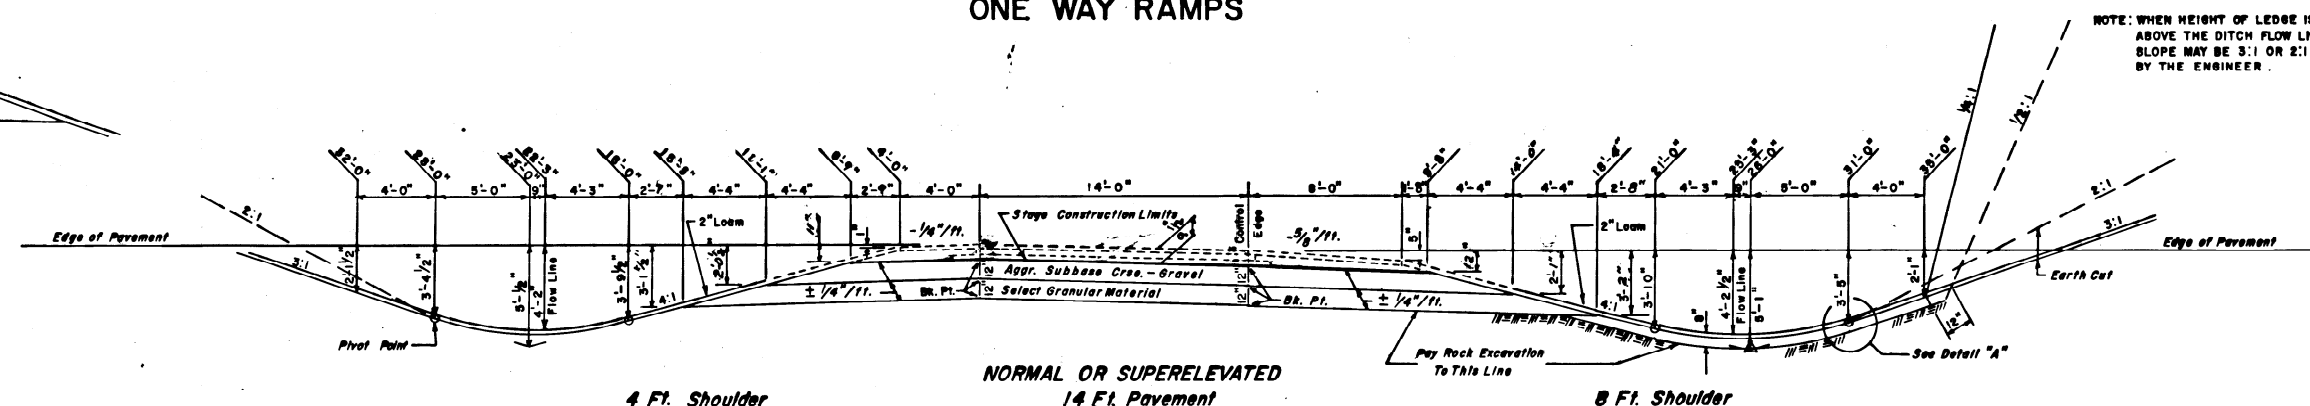


DETAIL "A"

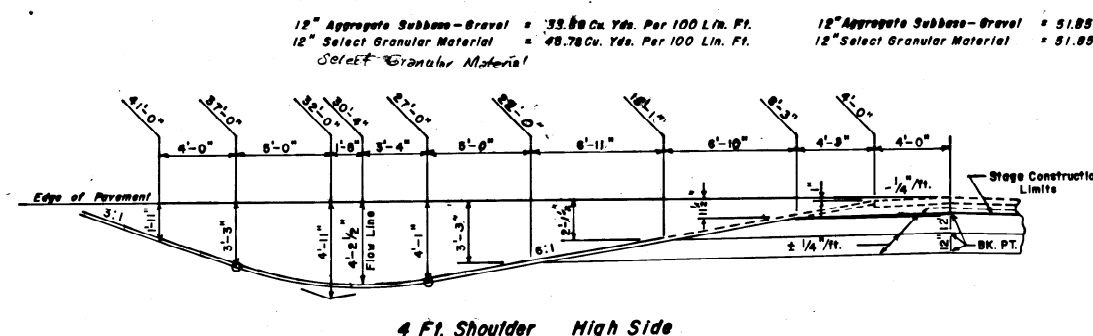


12" Aggregate Subbase - Gravel = 35.88 Cu. Yds. Per 100 Lin. Ft.
12" Select Granular Material = 48.78 Cu. Yds. Per 100 Lin. Ft.


12" Aggregate Subbase - Gravel = 43.68 Cu. Yds. Per 100 Lin. Ft.
12" Select Granular Material = 59.70 Cu. Yds. Per 100 Lin. Ft.

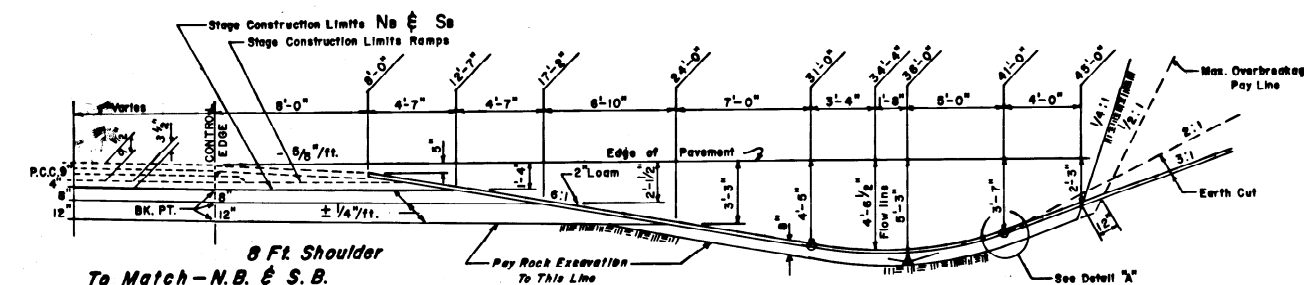

8" Aggregate Subbase - Gravel = 37.52 Cu. Yds. Per 100 Lin. Ft.
12" Select Granular Material = 75.46 Cu. Yds. Per 100 Lin. Ft.

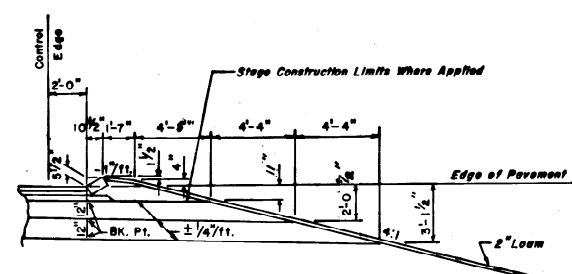


Curb Section

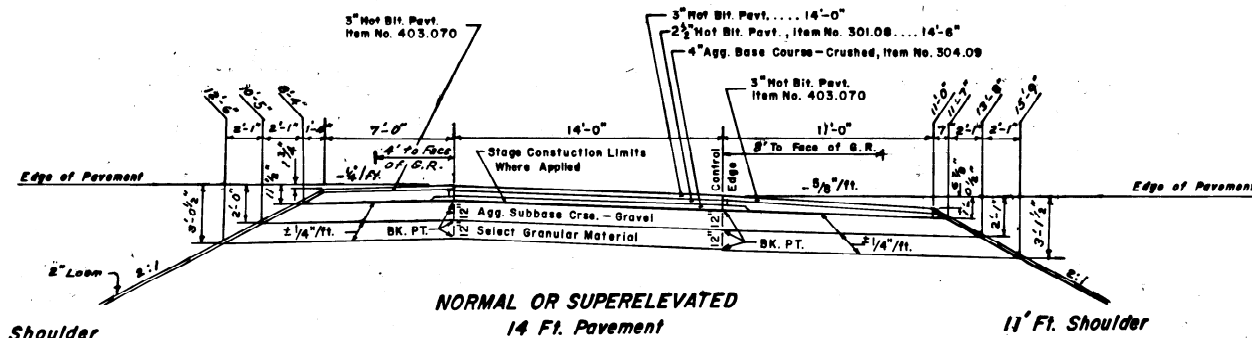

NORMAL OR SUPERELEVATED
14 Ft. Pavement

11' Ft. Shoulder

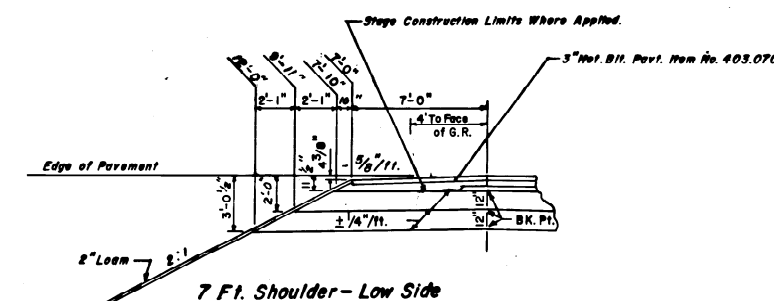

7 Ft. Shoulder - Low Side


4" Aggr. Base Crs. crushed Gravel = 1.03 Cu. Yds. Per 100 Lin. Ft.
Aggr. Base Crs. Gravel - (Above Stage Crs.) = 14.68 Cu. Yds. Per 100 Lin. Ft.
12" Aggr. Subbase - Gravel - (Stage Crs.) = 34.08 Cu. Yds. Per 100 Lin. Ft.
12" Select Granular Material = 49.25 Cu. Yds. Per 100 Lin. Ft.

4" Aggr. Base Crs. crushed Gravel = 1.03 Cu. Yds. Per 100 Lin. Ft.
Aggr. Base Crs. Gravel - (Above Stage Crs.) = 14.68 Cu. Yds. Per 100 Lin. Ft.
12" Aggr. Subbase - Gravel - (Stage Crs.) = 34.72 Cu. Yds. Per 100 Lin. Ft.
12" Select Granular Material = 49.25 Cu. Yds. Per 100 Lin. Ft.

4" Aggr. Base Crs. crushed Gravel = 1.03 Cu. Yds. Per 100 Lin. Ft.
12" Aggr. Subbase - Gravel - (Stage Crs.) = 34.72 Cu. Yds. Per 100 Lin. Ft.
12" Select Granular Material = 49.25 Cu. Yds. Per 100 Lin. Ft.

4" Aggr. Base Crs. crushed Gravel = 1.03 Cu. Yds. Per 100 Lin. Ft.
Aggr. Base Crs. Gravel - (Above Stage Crs.) = 14.68 Cu. Yds. Per 100 Lin. Ft.
12" Aggr. Subbase - Gravel - (Stage Crs.) = 34.08 Cu. Yds. Per 100 Lin. Ft.
12" Select Granular Material = 49.25 Cu. Yds. Per 100 Lin. Ft.

4" Aggr. Base Crs. crushed Gravel = 1.03 Cu. Yds. Per 100 Lin. Ft.
Aggr. Base Crs. Gravel - (Above Stage Crs.) = 14.68 Cu. Yds. Per 100 Lin. Ft.
12" Aggr. Subbase - Gravel - (Stage Crs.) = 34.08 Cu. Yds. Per 100 Lin. Ft.
12" Select Granular Material = 49.25 Cu. Yds. Per 100 Lin. Ft.

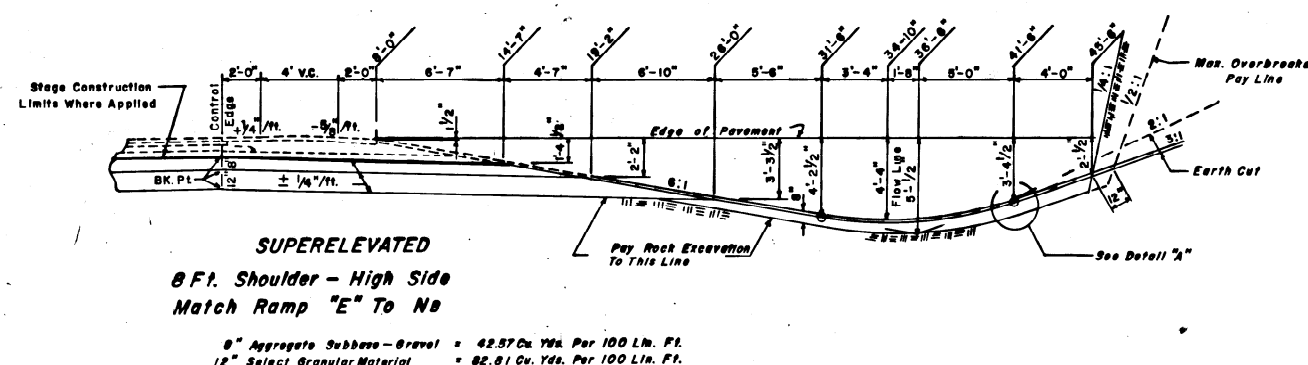

8" Aggregate Subbase - Gravel = 42.57 Cu. Yds. Per 100 Lin. Ft.
12" Select Granular Material = 82.81 Cu. Yds. Per 100 Lin. Ft.

SCALE 1" = 5'

STATE HIGHWAY COMMISSION
TYPICAL SECTIONS
ONE WAY RAMPS

SHEET OF AUGUSTA, MAINE

UNSWICK 1-95-4(25)

"Revised As Built" by Gary Russell 4-16-75

DATE 2-70
BY JAC
DESIGN - DETAILED
CHECKED
REVISIONS
FIELD CHANGES
PLANS