



Sta 25+70 Lt.  
Constructed Paved Drive

Sta 30+44 Lt. Constructed Gravel Drive &  
Installed Twin 18"x44' Culvert Pipe 1973

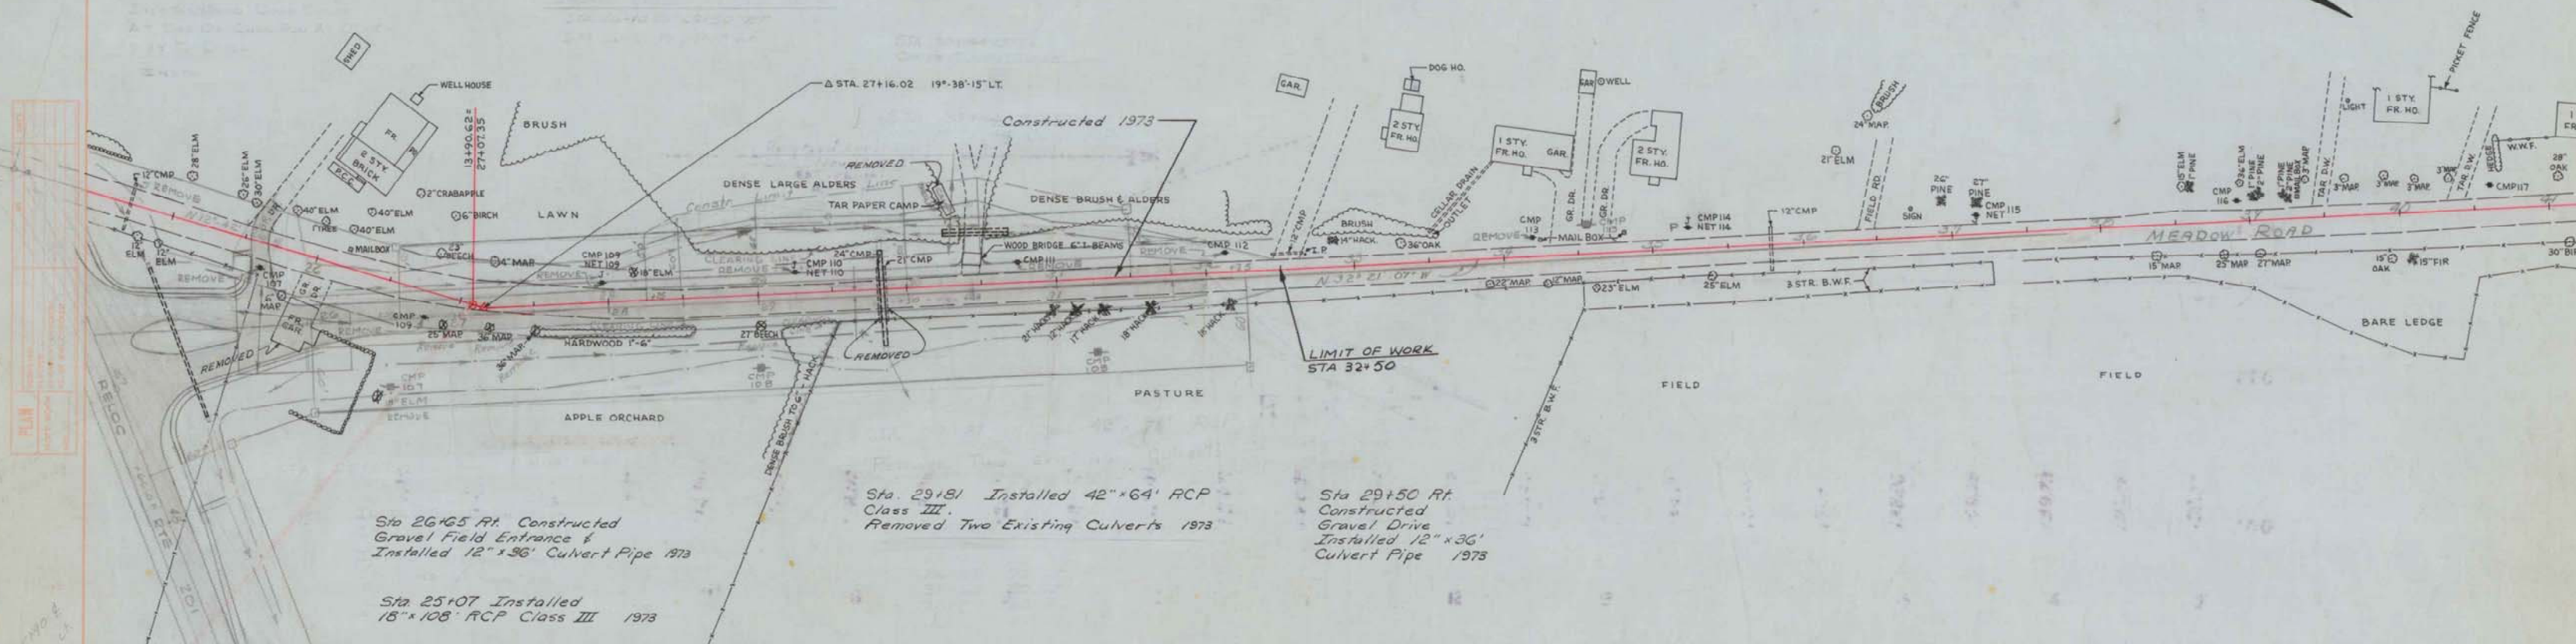

Removed Single Trees

STA.	OFFSET	TREE
26+50	51' RT.	18' ELM
26+90	10' RT.	25' MAPLE
27+20	10' RT.	30' MAPLE
27+50	15' RT.	34' MAPLE
28+20	22' LT.	20' ELM
29+00	18' RT.	34' ASH
29+00	20' RT.	11' ELM
31+15	18' RT.	15' LARCH
31+35	18' RT.	18' LARCH
31+65	18' RT.	17' LARCH
25+80	18' LT.	12' MAPLE

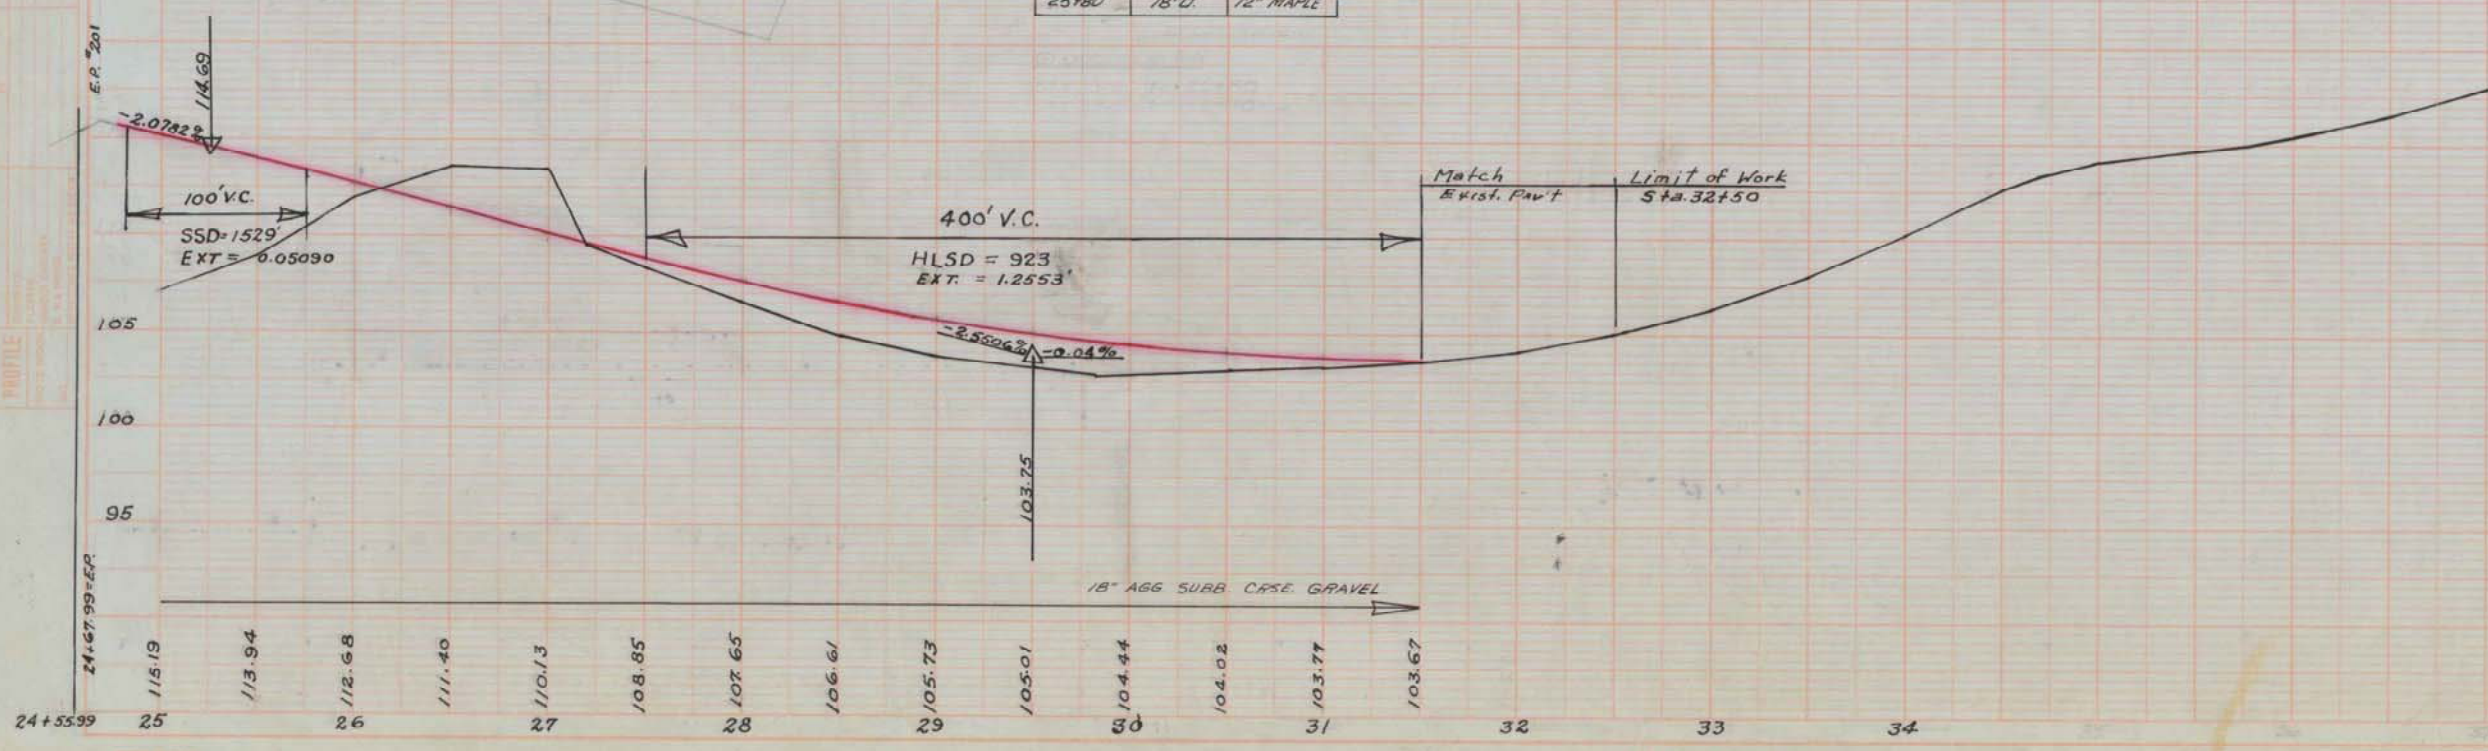

SCALE: HOR. 1"=50'  
VERT. 1"=5'

"Revised As Built" by Gary Russell 5-13-75

Meadow Rd. Relocation TOPSHAM