



STAGE CONSTRUCTION GRADING, DRAINAGE AND AGGREGATE SUBBASE COURSE *

F.H.W.A. REV. NO.	STATE	PROJECT NUMBER	SHEET NO.	TOTAL SHEETS
1	MAINE	I-95-5(36)	2	175


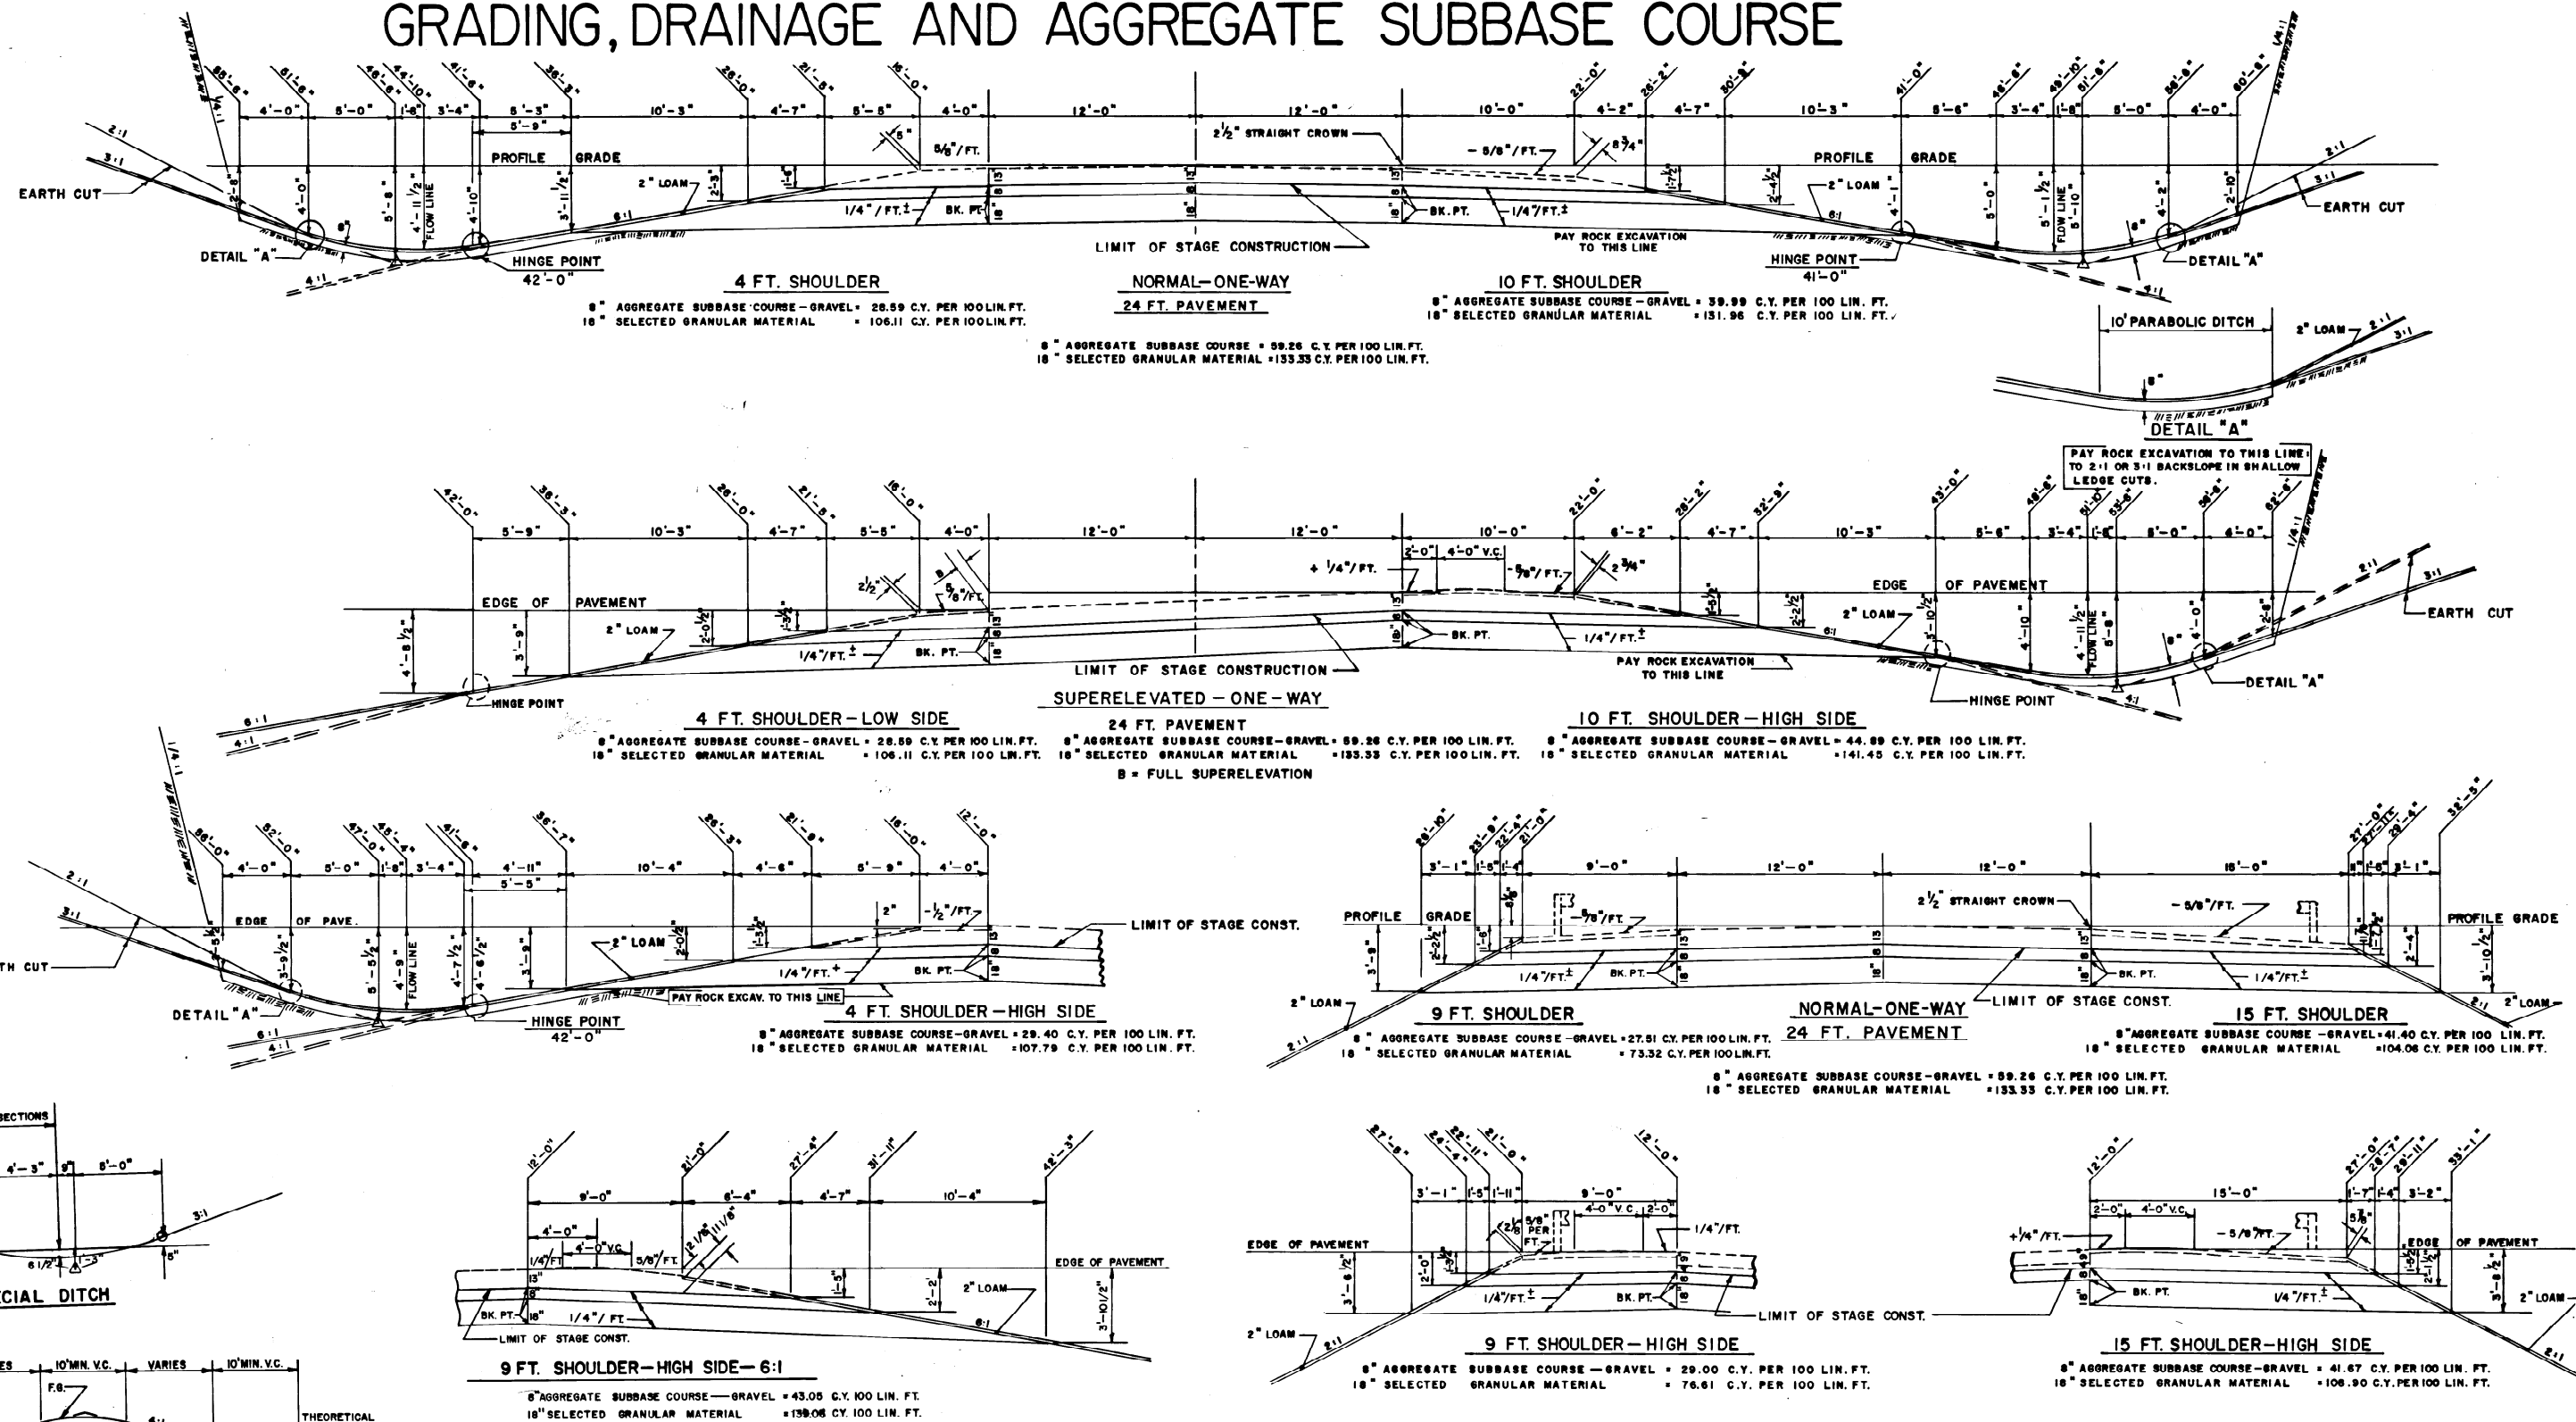


DESIGN - DETAILED	DATE
CHECKED	10/1/75
REVISIONS	
FIELD CHANGES	

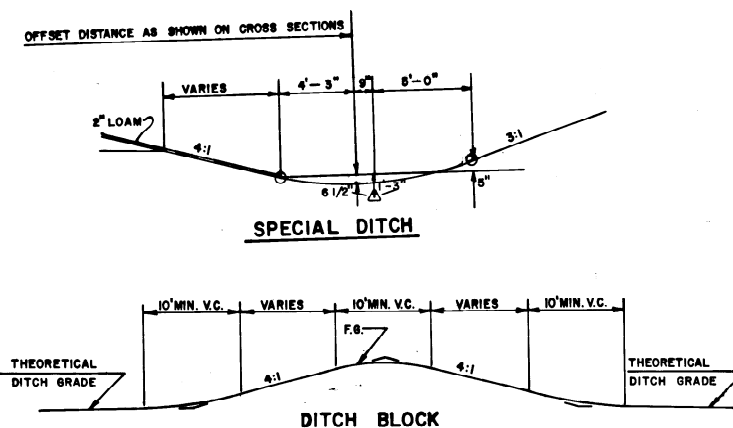


NOTE: Ditch blocks will be sodded on culvert side only, unless otherwise noted or directed by the engineer.

* NOTE: THE PAVEMENT AND BASE DEPTHS AS SHOWN ON THE PLANS ARE INTENDED TO BE NOMINAL.

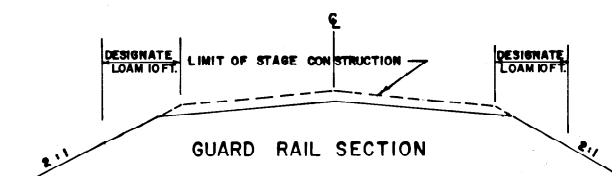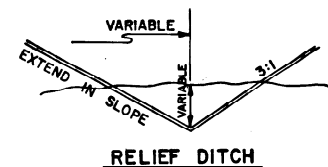

DETAIL FOR LOAMING

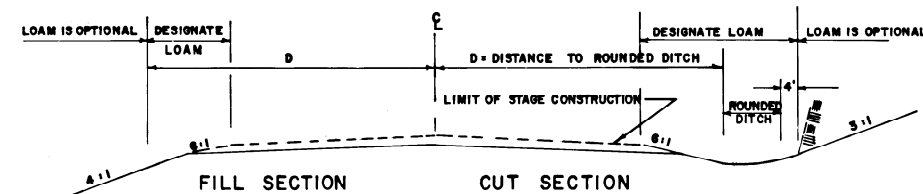

STATE OF MAINE
DEPARTMENT OF TRANSPORTATION
**MAIN LINE
TYPICAL SECTIONS**

SCALE: 0 5 10 15 (FEET)
SHEET OF AUGUSTA, MAINE

I-95-5(36) BOWDOINHAM

Revised "As Built" by Mary Russell 12-13-75