

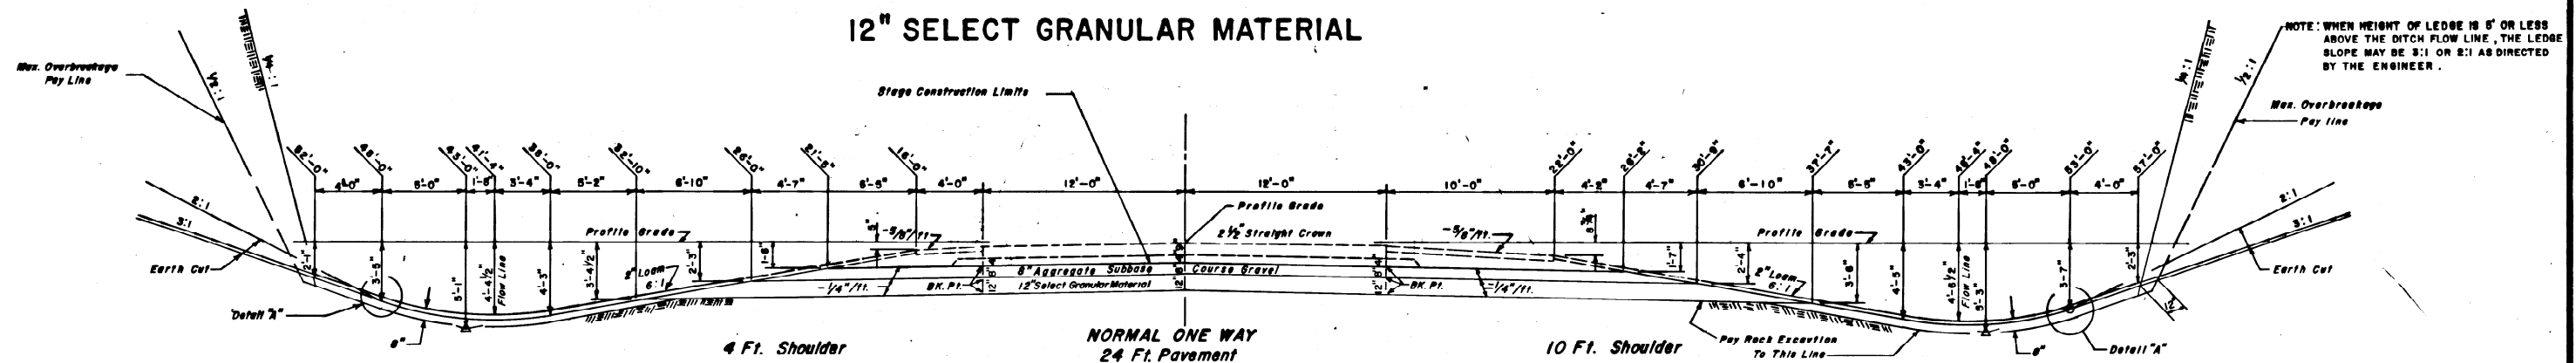


STAGE CONSTRUCTION—GRADING & SUBBASE


8" AGGREGATE SUBBASE COURSE—GRAVEL
12" SELECT GRANULAR MATERIAL

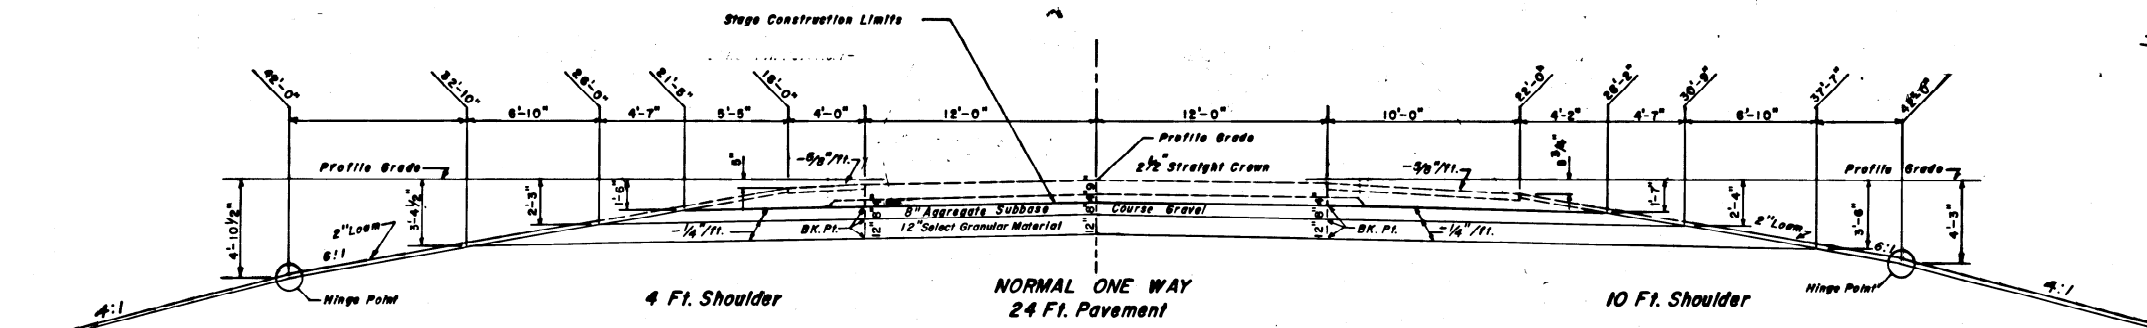

8" Aggr. Sub Base Course—Gravel = 28.59 Cu. Yds. Per 100 Lin. Ft.	8" Aggr. Sub Base Course—Gravel = 29.26 Cu. Yds. Per 100 Lin. Ft.	8" Aggr. Sub Base Course—Gravel = 40.35 Cu. Yds. Per 100 Lin. Ft.
12" Select Granular Material = 64.06 Cu. Yds. Per 100 Lin. Ft.	12" Select Granular Material = 66.89 Cu. Yds. Per 100 Lin. Ft.	12" Select Granular Material = 83.14 Cu. Yds. Per 100 Lin. Ft.

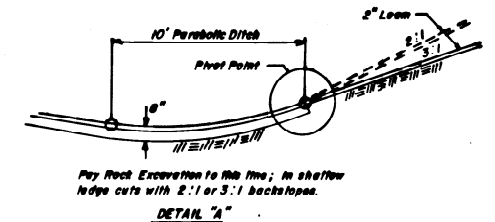

8" Aggr. Sub Base Course—Gravel = 28.59 Cu. Yds. Per 100 Lin. Ft.	8" Aggr. Sub Base Course—Gravel = 29.26 Cu. Yds. Per 100 Lin. Ft.	8" Aggr. Sub Base Course—Gravel = 40.35 Cu. Yds. Per 100 Lin. Ft.
12" Select Granular Material = 64.06 Cu. Yds. Per 100 Lin. Ft.	12" Select Granular Material = 66.89 Cu. Yds. Per 100 Lin. Ft.	12" Select Granular Material = 83.14 Cu. Yds. Per 100 Lin. Ft.

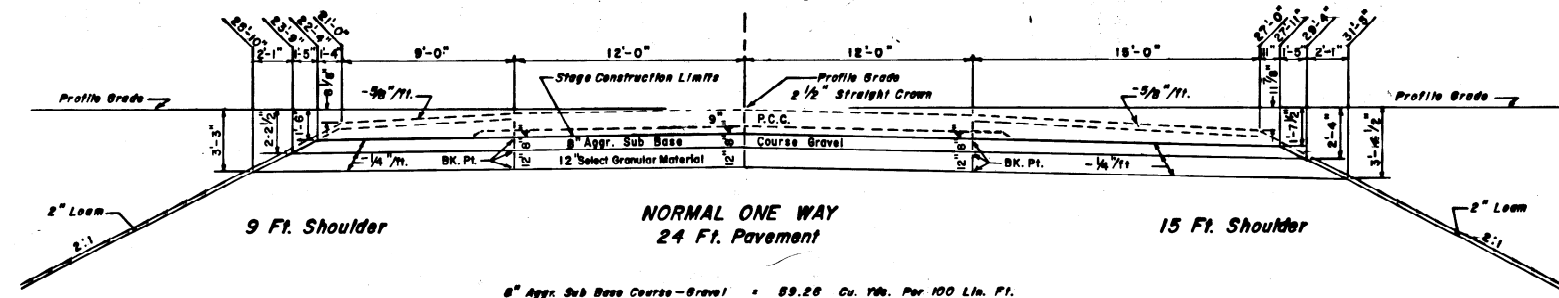

8" Aggr. Sub Base Course—Gravel = 27.51 Cu. Yds. Per 100 Lin. Ft.	8" Aggr. Sub Base Course—Gravel = 41.40 Cu. Yds. Per 100 Lin. Ft.
12" Select Granular Material = 47.32 Cu. Yds. Per 100 Lin. Ft.	12" Select Granular Material = 67.95 Cu. Yds. Per 100 Lin. Ft.

STATE HIGHWAY COMMISSION

TYPICAL SECTIONS

I 95 NB. & SB & ROUTE 1 WB

SCALE 1"=5'

SHEET OF AUGUSTA, MAINE

BRUNSWICK I-95-4(25)

"Revised As Built" by Hwy Russell 4-16-75

DATE	5-1-70
BY	JAC
DESIGN - DETAILED	✓
CHECKED	✓
REVISIONS	
FIELD CHANGES	
PLANS	