



PLAN  
 1. EXISTING  
 2. PROPOSED  
 3. REMOVED  
 4. SURVEY MONUMENTS  
 5. RIGHT OF WAY MONUMENTS

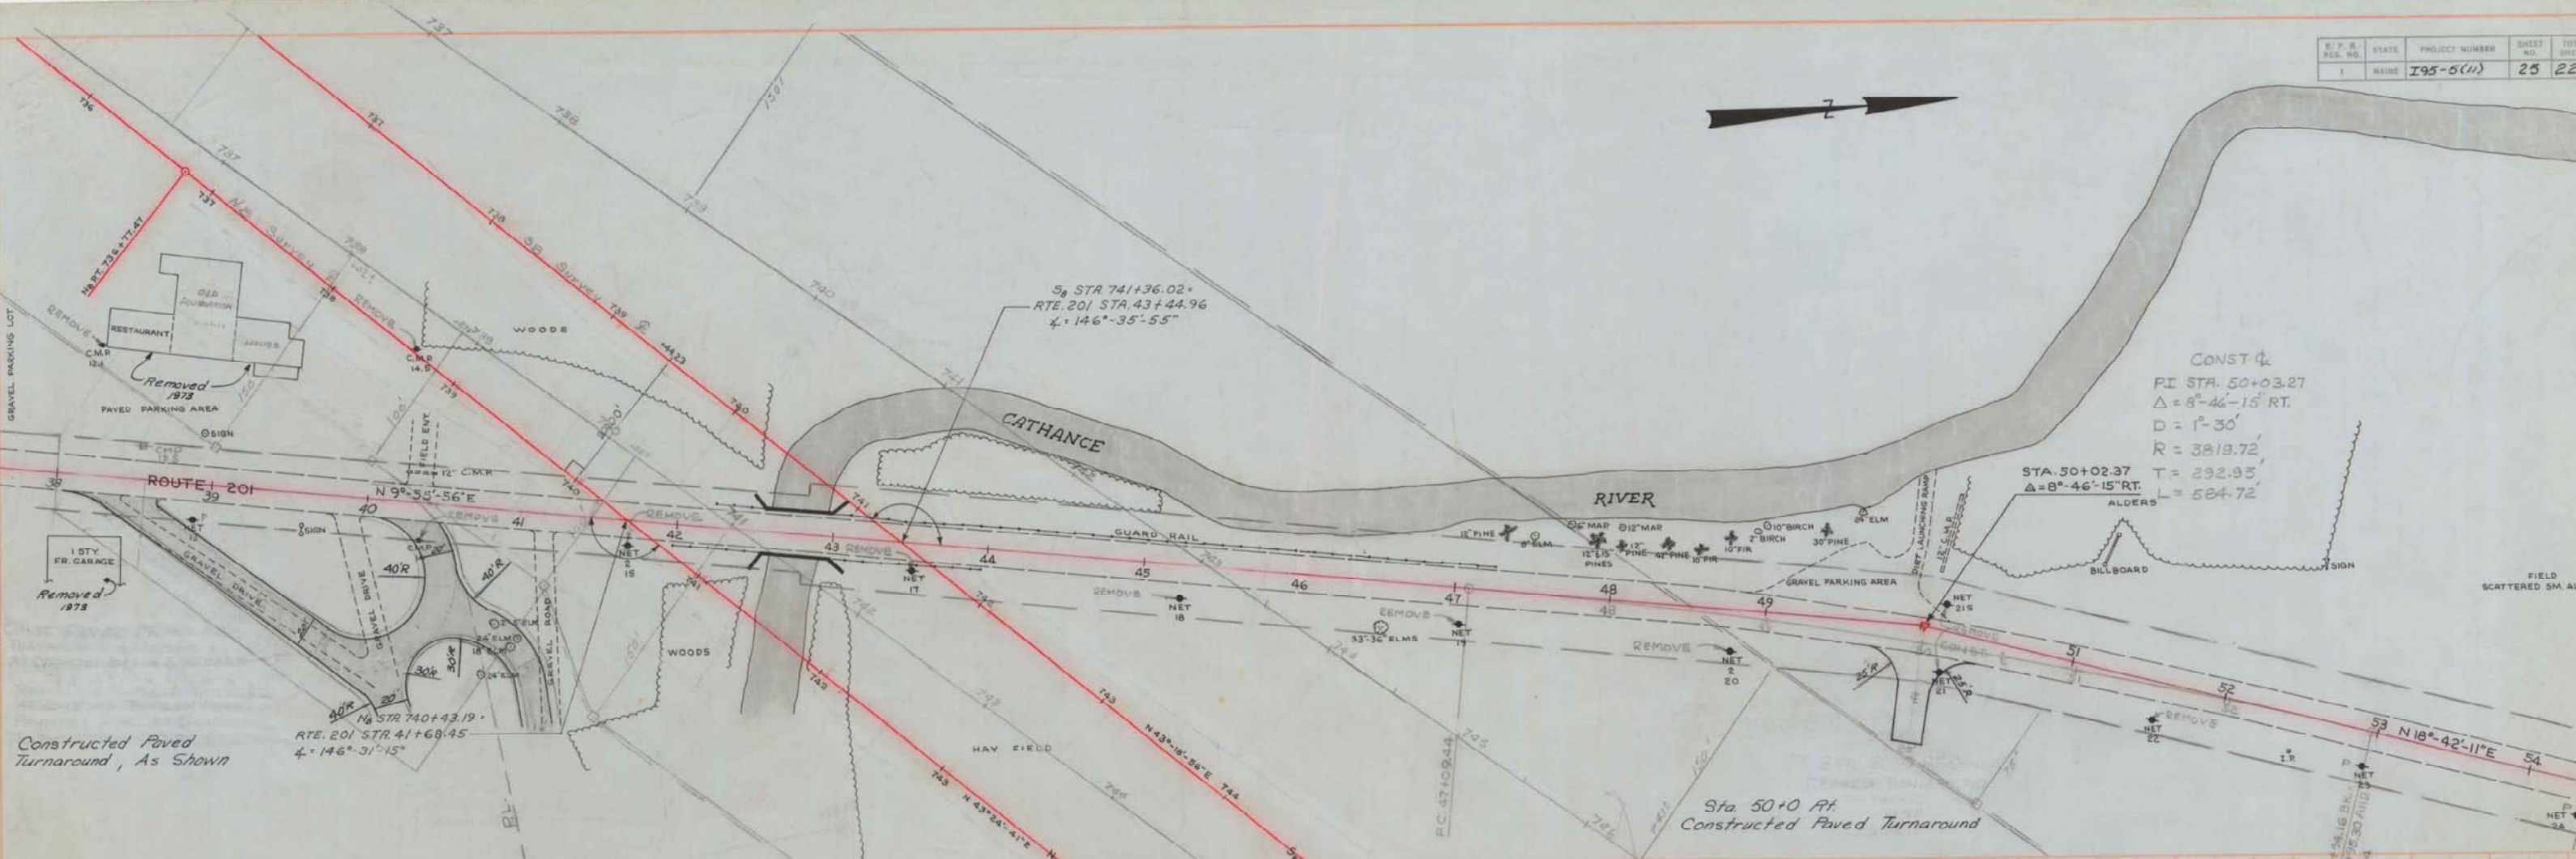

PROFILE  
 1. EXISTING  
 2. PROPOSED  
 3. REMOVED  
 4. SURVEY MONUMENTS  
 5. RIGHT OF WAY MONUMENTS

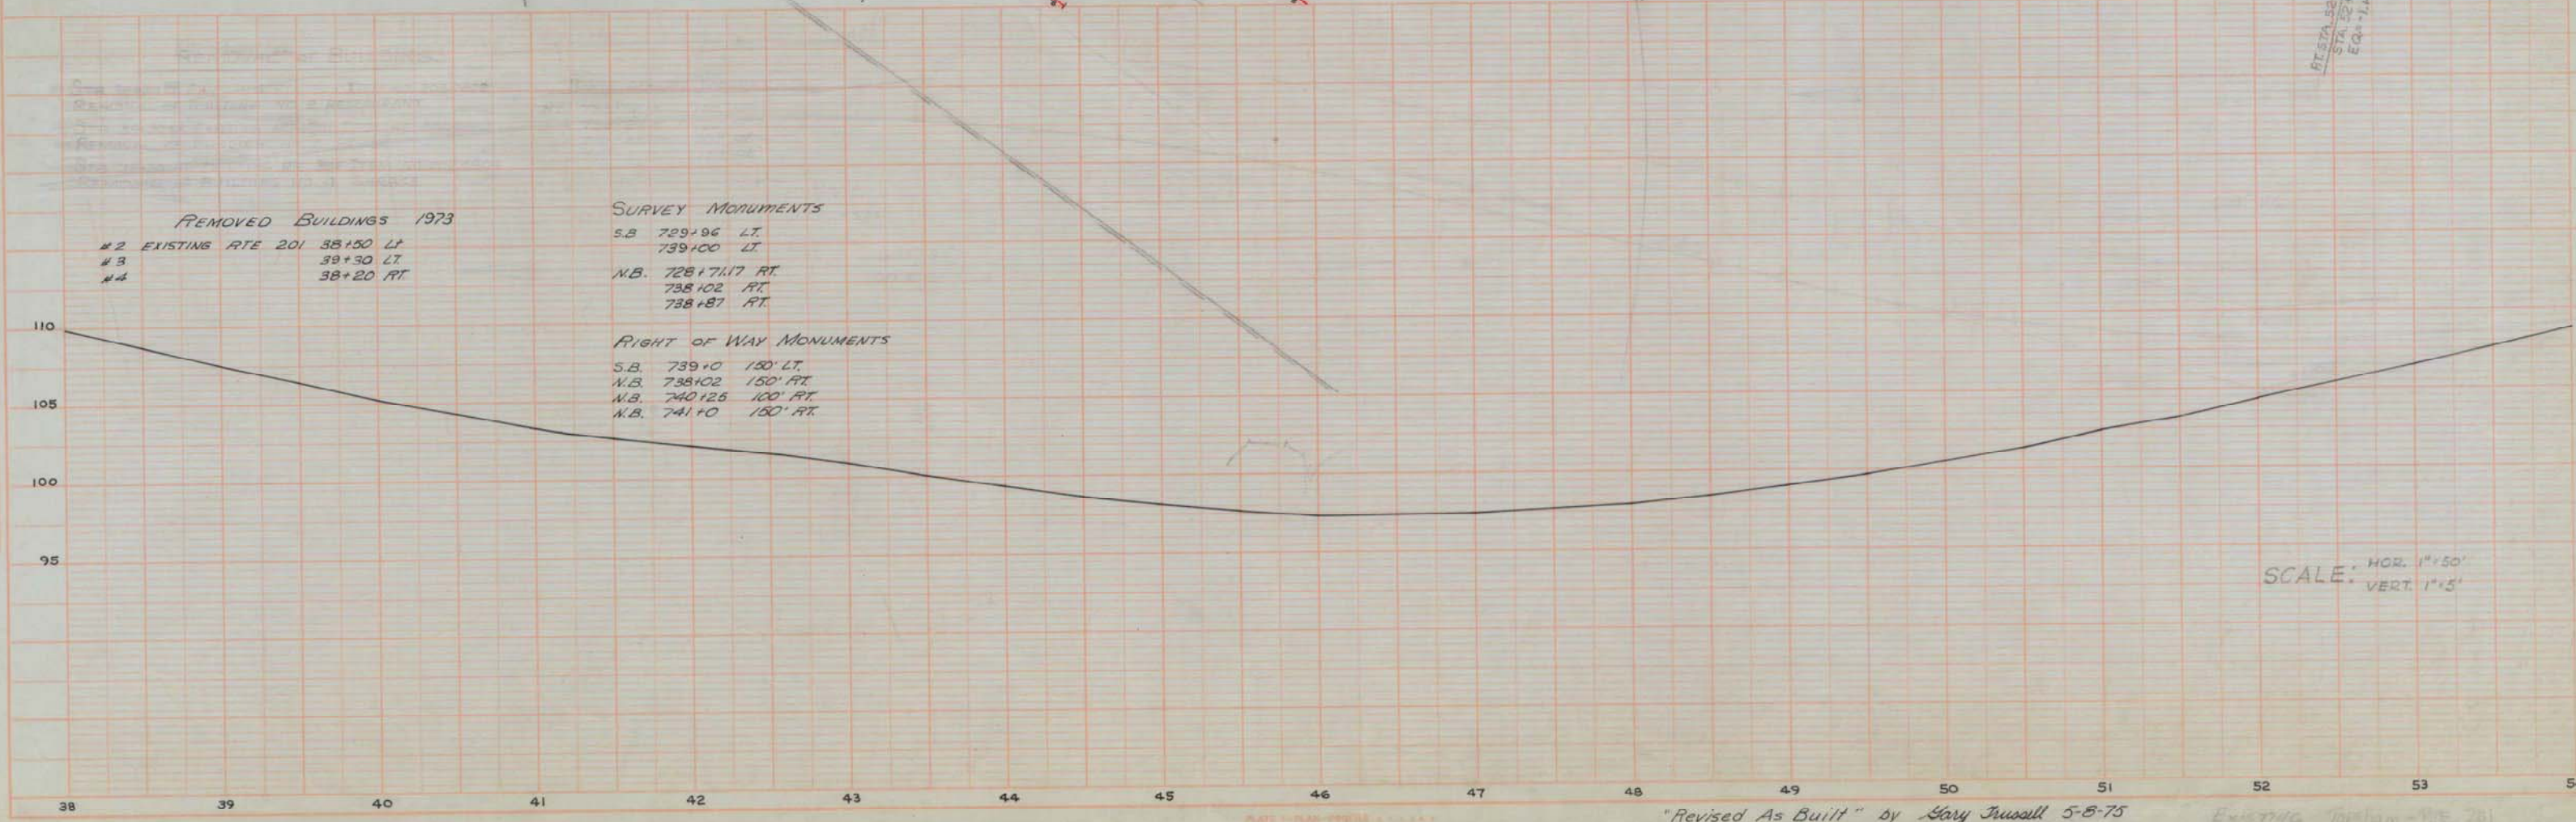

REMOVED BUILDINGS 1973  
 #2 EXISTING RTE 201 38+50 LT.  
 #3 39+30 LT.  
 #4 38+20 RT.

SURVEY MONUMENTS  
 S.B. 729+96 LT.  
 739+00 LT.  
 N.B. 728+71.17 RT.  
 738+102 RT.  
 738+87 RT.

RIGHT OF WAY MONUMENTS  
 S.B. 739+10 150' LT.  
 N.B. 738+102 150' RT.  
 N.B. 740+125 100' RT.  
 N.B. 741+10 150' RT.

SCALE: HOR. 1"=50'  
 VERT. 1"=5'

"Revised As Built" by Gary Russell 5-8-75

EXISTING Toplam - RTE 201