
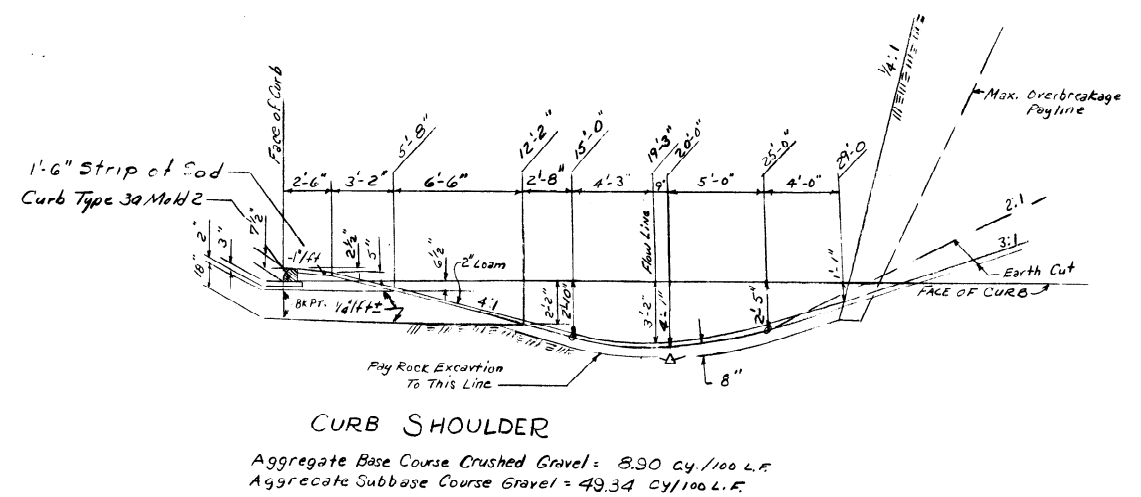
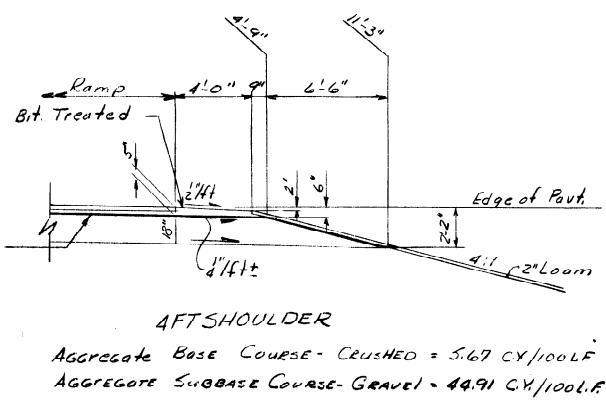
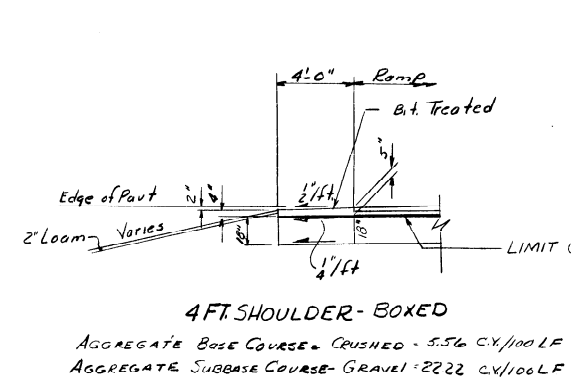
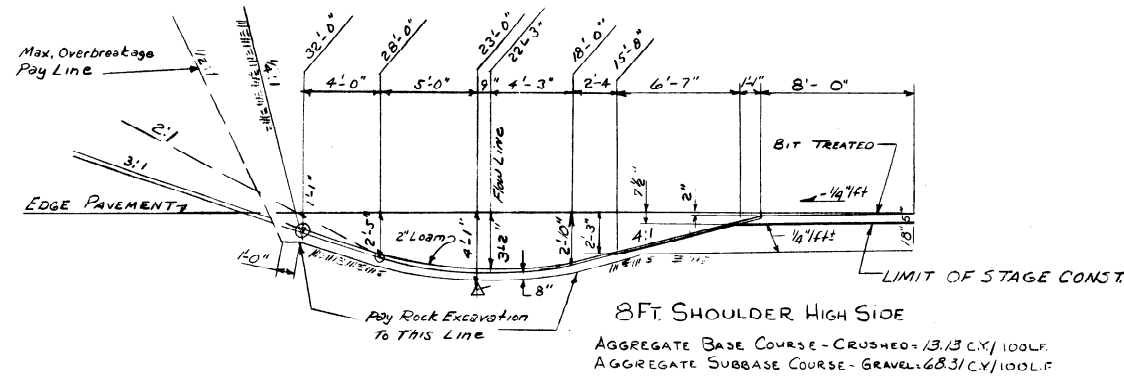


STAGE CONSTRUCTION-GRADING AND SUBBASE
TEMPORARY RAMPS F & G

S. F. R.	STATE	PROJECT NUMBER	SHEET NO.	TOTAL SHEETS
REG. NO.	MAINE	I-95-5(11)	7	P-6

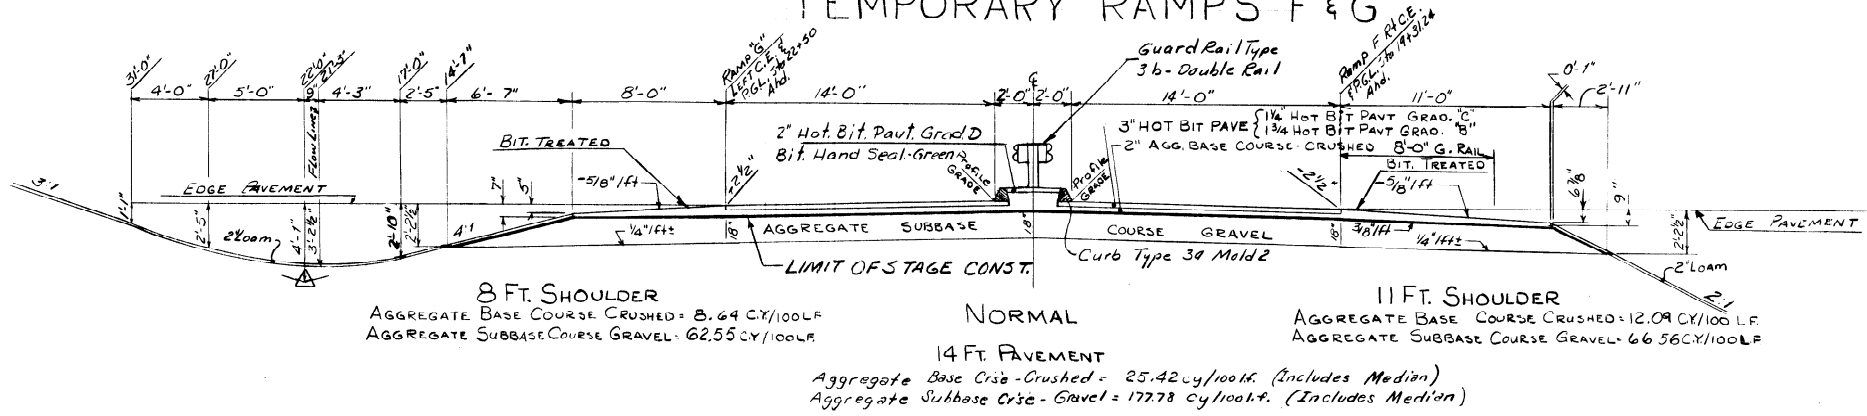

NOTE: THE AGG. BASE COURSE - CRUSHED AND 3" HOT BIT. PAVT. SHALL BE PLACED FROM RELOC 201 TO STA 12+00 UNDER THIS CONTRACT

DEPARTMENT OF TRANSPORTATION

TEMPORARY RAMPS
"F" AND "G"
TYPICAL SECTIONS

SCALE: 1" = 5'
SHEET OF AUGUSTA, MAINE

Revised As Built by Larry Jussell 4-30-75

I-95-5(11) TOP-MAIN

PLANS	DESIGN - DETAILED	CHECKED	REVISIONS	FIELD CHANGES
BY	DATE	BY	DATE	
McDonnell	10/14/71	Paras	10/14/71	
Compton				