


3" HOT BITUMINOUS PAVEMENT

RIVER ROAD

S. P. N.	STATE	PROJECT NUMBER	SHEET NO.	TOTAL SHEETS
1	MAINE	I-95-4(25)	6	73

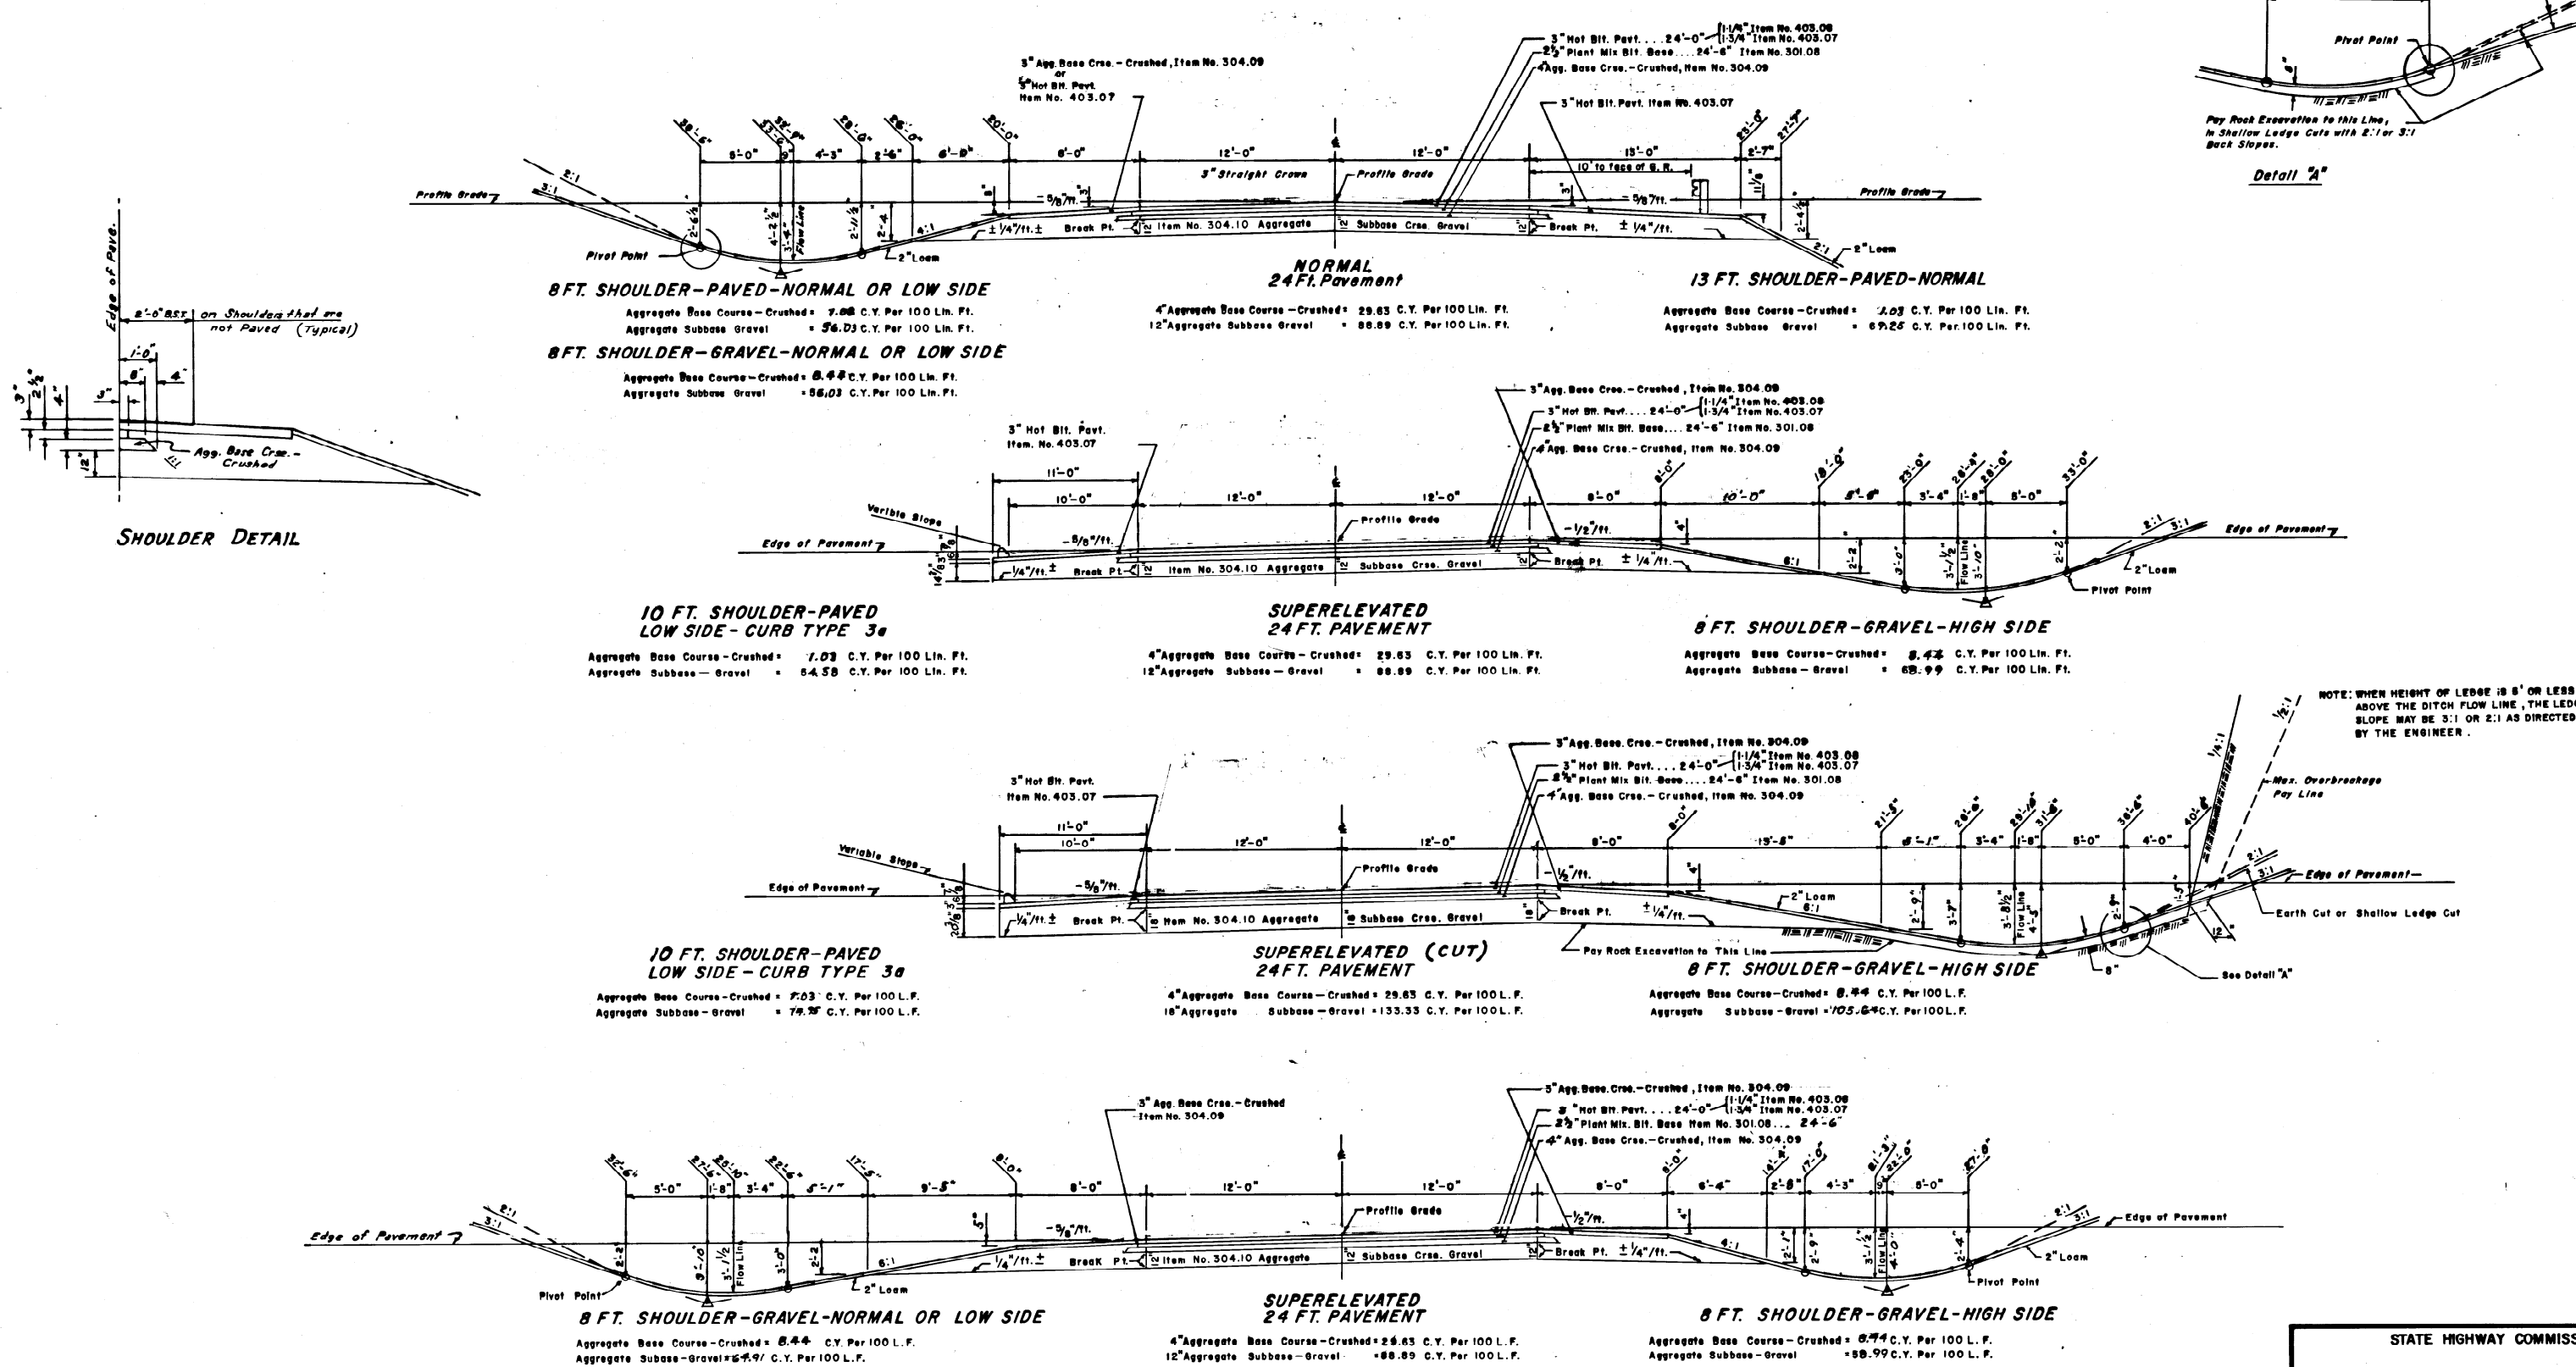

DATE	BY	DESIGN - DETAILED	CHECKED	REVISIONS	FIELD CHANGES
2-70	UAC				
4-16-70	CMH				
	CMH				

PLANS

STATE HIGHWAY COMMISSION

TYPICAL SECTIONS

RIVER ROAD

SHEET OF AUGUSTA, MAINE

SCALE 1"=5'

"Revised As Built" by Gary Russell 4-16-75