



- LEGEND
- EXIST. POWER POLE
 - EXIST. JUNCTION BOX
 - PROP. JUNCTION BOX
 - EXIST. LIGHT STANDARD (40' HEIGHT, 175 WATT LAMP)
 - PROP. LIGHT STANDARD (40' M.H., 150 WATT HPS LAMP, M250A OR APPROVED EQUIVALENT FIXTURE)
 - EXIST. 6" UNDERDRAIN OUTLET PIPE
 - PROP. 6" UNDERDRAIN OUTLET PIPE
 - - - EXIST. PREWIRED CONDUIT 4C#2 AWG., COPPER
 - - - PROP. PREWIRED CONDUIT 4C#2 AWG., COPPER

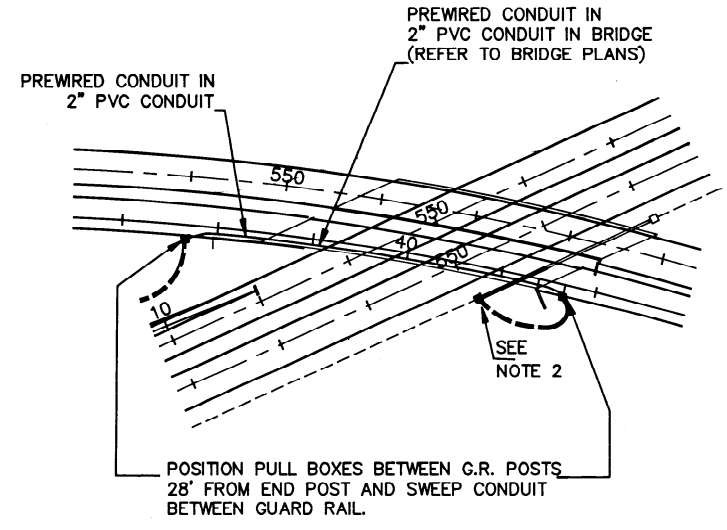

BRIDGE DETAIL
1" = 100'

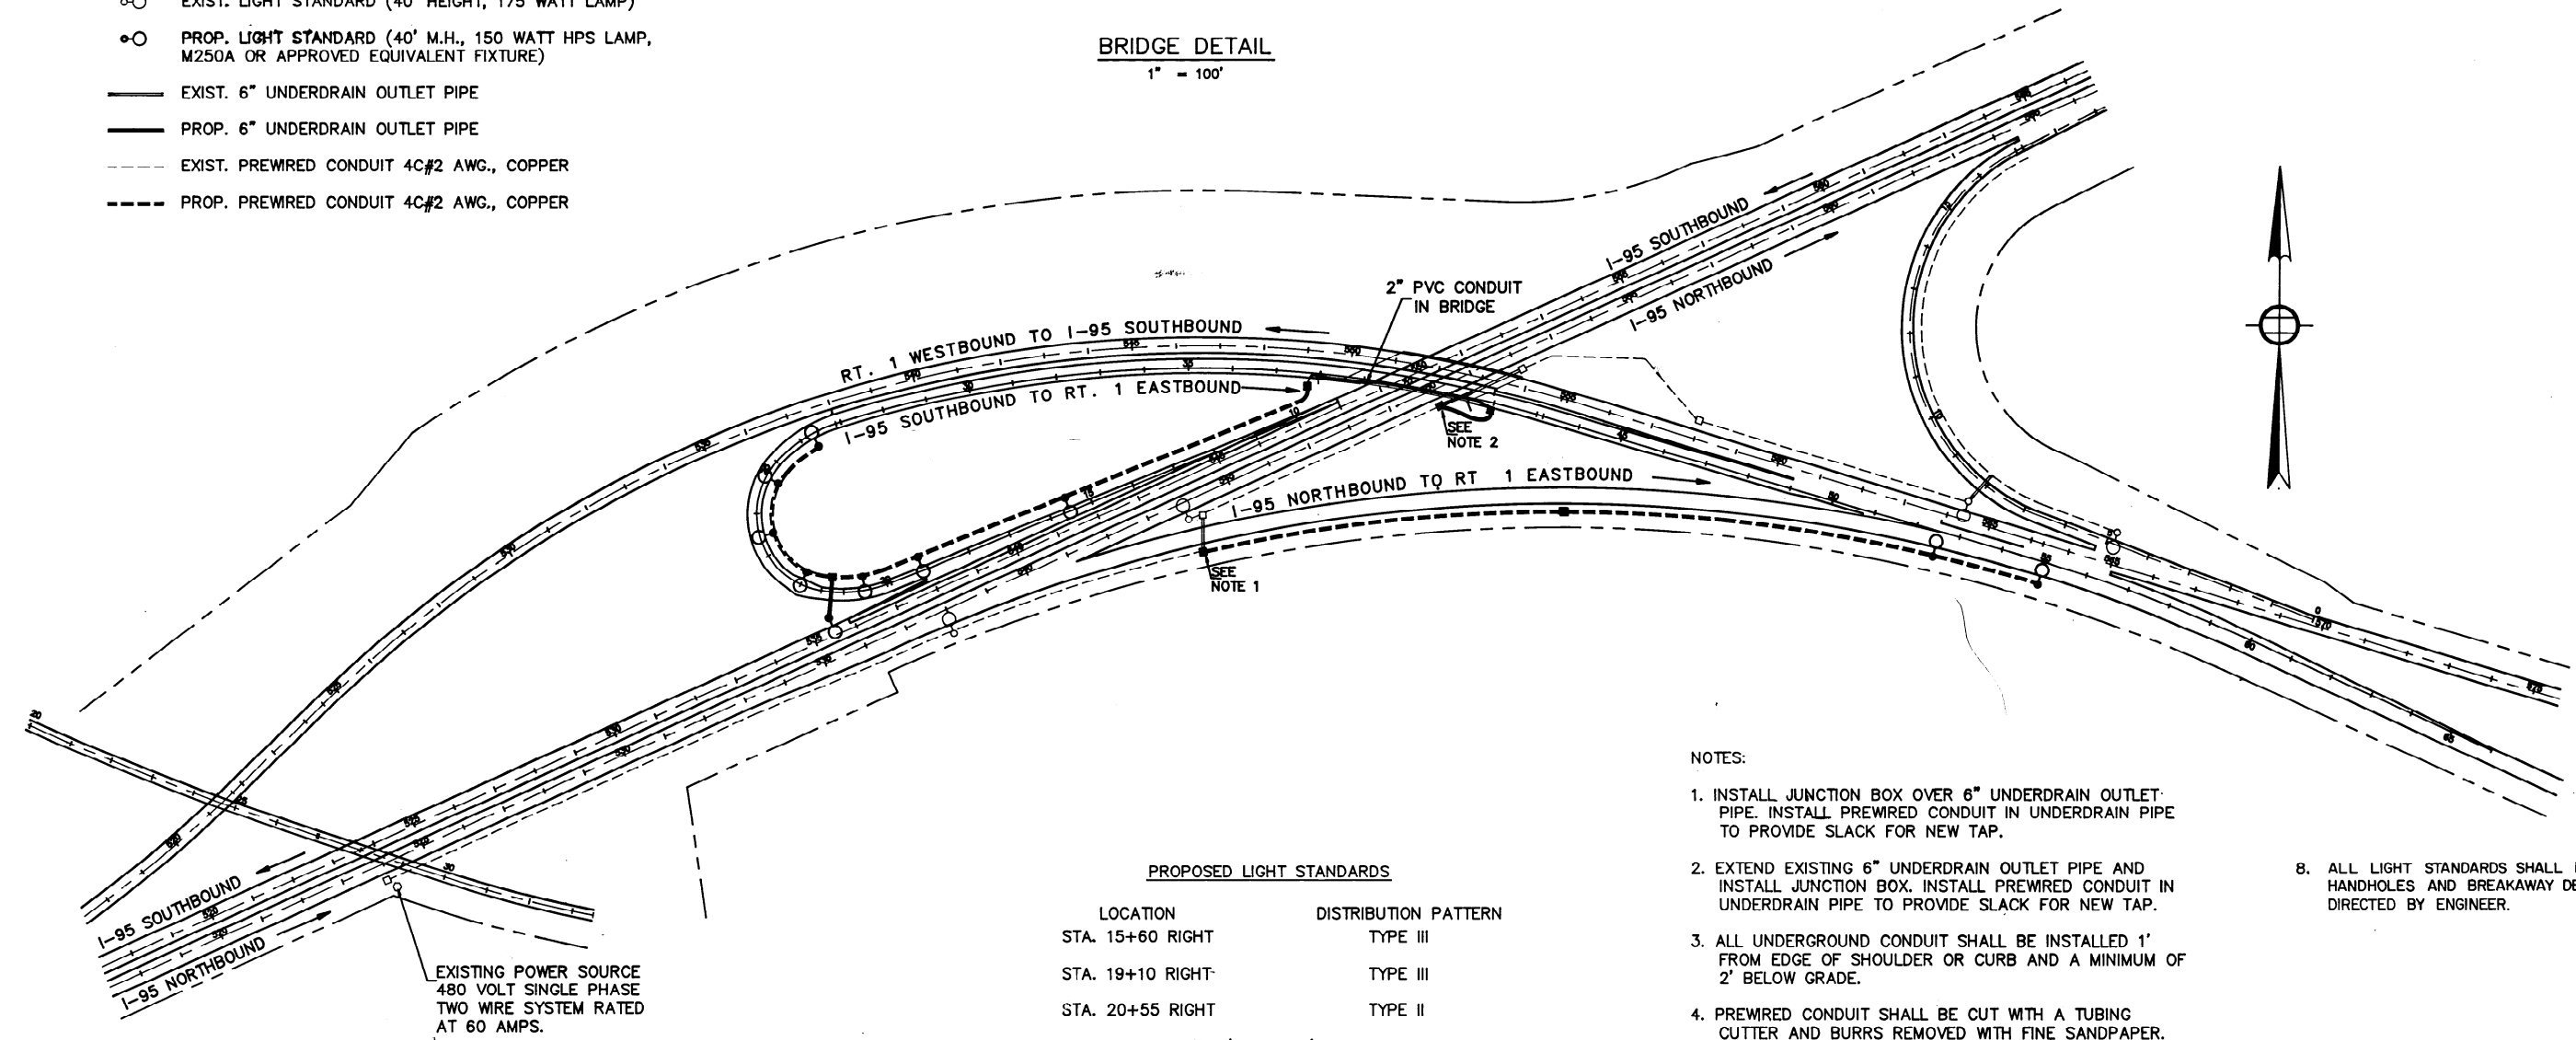


PROPOSED LIGHT STANDARDS

LOCATION	DISTRIBUTION PATTERN
STA. 15+60 RIGHT	TYPE III
STA. 19+10 RIGHT	TYPE III
STA. 20+55 RIGHT	TYPE II
STA. 535+50 LEFT (I-95 S.B.)	TYPE III
STA. 22+00 RIGHT	TYPE II
STA. 23+45 RIGHT	TYPE II
STA. 24+90 RIGHT	TYPE II
STA. 26+35 RIGHT	TYPE II
STA. 52+50 RIGHT	TYPE III
STA. 55+00 RIGHT	TYPE III

NOTES:

1. INSTALL JUNCTION BOX OVER 6" UNDERDRAIN OUTLET PIPE. INSTALL PREWIRED CONDUIT IN UNDERDRAIN PIPE TO PROVIDE SLACK FOR NEW TAP.
2. EXTEND EXISTING 6" UNDERDRAIN OUTLET PIPE AND INSTALL JUNCTION BOX. INSTALL PREWIRED CONDUIT IN UNDERDRAIN PIPE TO PROVIDE SLACK FOR NEW TAP.
3. ALL UNDERGROUND CONDUIT SHALL BE INSTALLED 1' FROM EDGE OF SHOULDER OR CURB AND A MINIMUM OF 2' BELOW GRADE.
4. PREWIRED CONDUIT SHALL BE CUT WITH A TUBING CUTTER AND BURRS REMOVED WITH FINE SANDPAPER.
5. CAST SPLICES SHALL BE USED IN UNDERGROUND JUNCTION BOXES.
6. LUMINAIRE TO BE POSITIONED OVER EDGE OF TRAVELED WAY.
7. THE CONTRACTOR SHALL REHABILITATE ALL AREAS DISTURBED BY HIS OPERATIONS. THIS WORK SHALL BE PERFORMED UNDER THE DIRECTION OF THE ENGINEER. COSTS FOR ALL REQUIRED REHABILITATION WILL BE CONSIDERED INCIDENTAL TO THE VARIOUS CONTRACT ITEMS AND NO SEPARATE PAYMENT WILL BE MADE.
8. ALL LIGHT STANDARDS SHALL HAVE 4" x 6" HANDHOLES AND BREAKAWAY DEVICES, UNLESS DIRECTED BY ENGINEER.

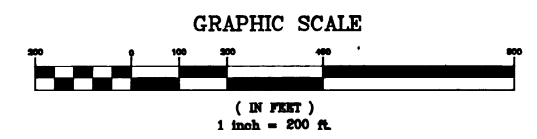

STATE OF MAINE
DEPARTMENT OF TRANSPORTATION

LIGHTING PLAN

SHEET 1 OF 1 AUGUSTA, MAINE

PROJECT DESIGN ENGINEER	BY	DATE
DESIGN - DETAILED		
CHECKED		
REVISIONS		
FIELD CHANGES		

BRUNSWICK 45710-1

Revised As Built, Richard W. Hamann 5/91