



DATE	BY	REVIEWED	DATE
ORIGINAL SURVEY PLOTTED	NO. BOOK	AREAS CHECKED	

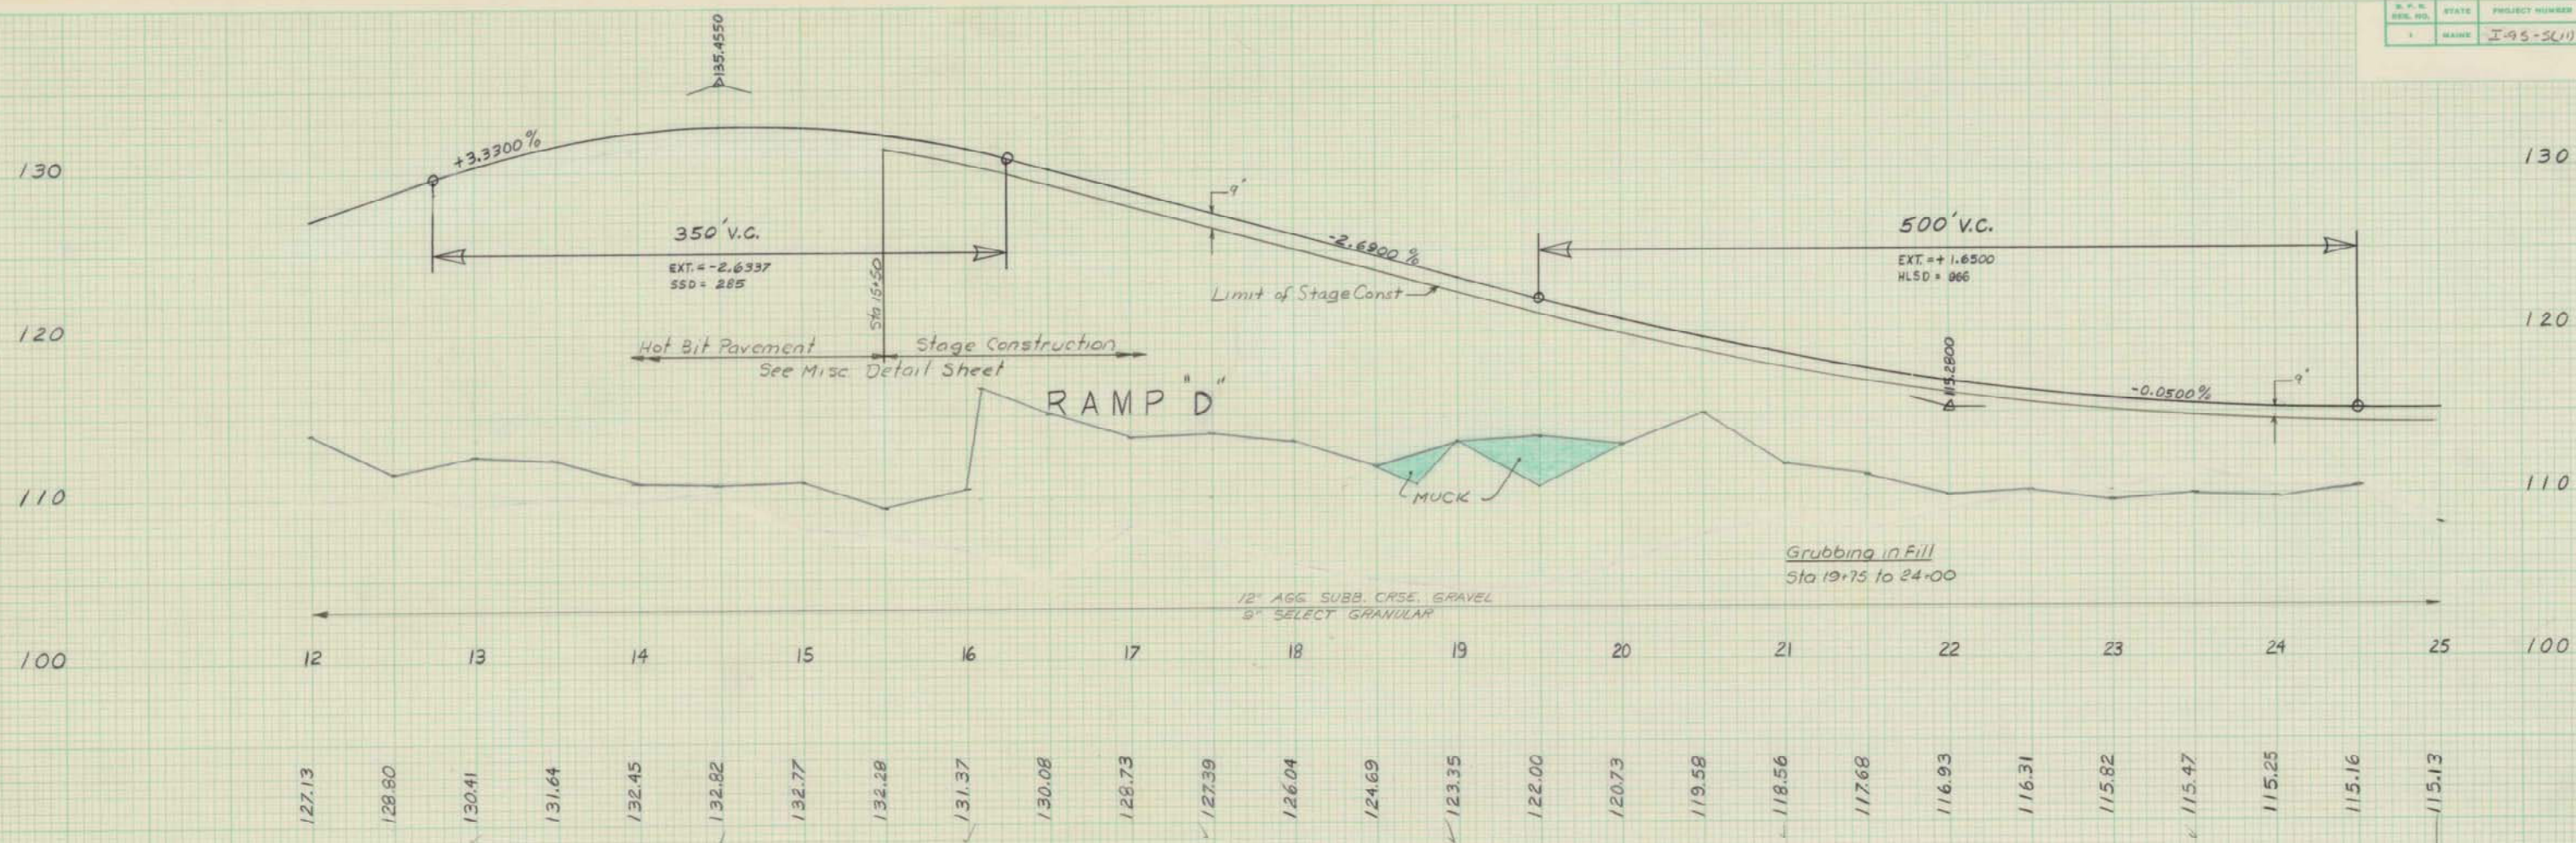

DATE	BY	REVIEWED	DATE
ORIGINAL SURVEY PLOTTED	NO. BOOK	AREAS CHECKED	

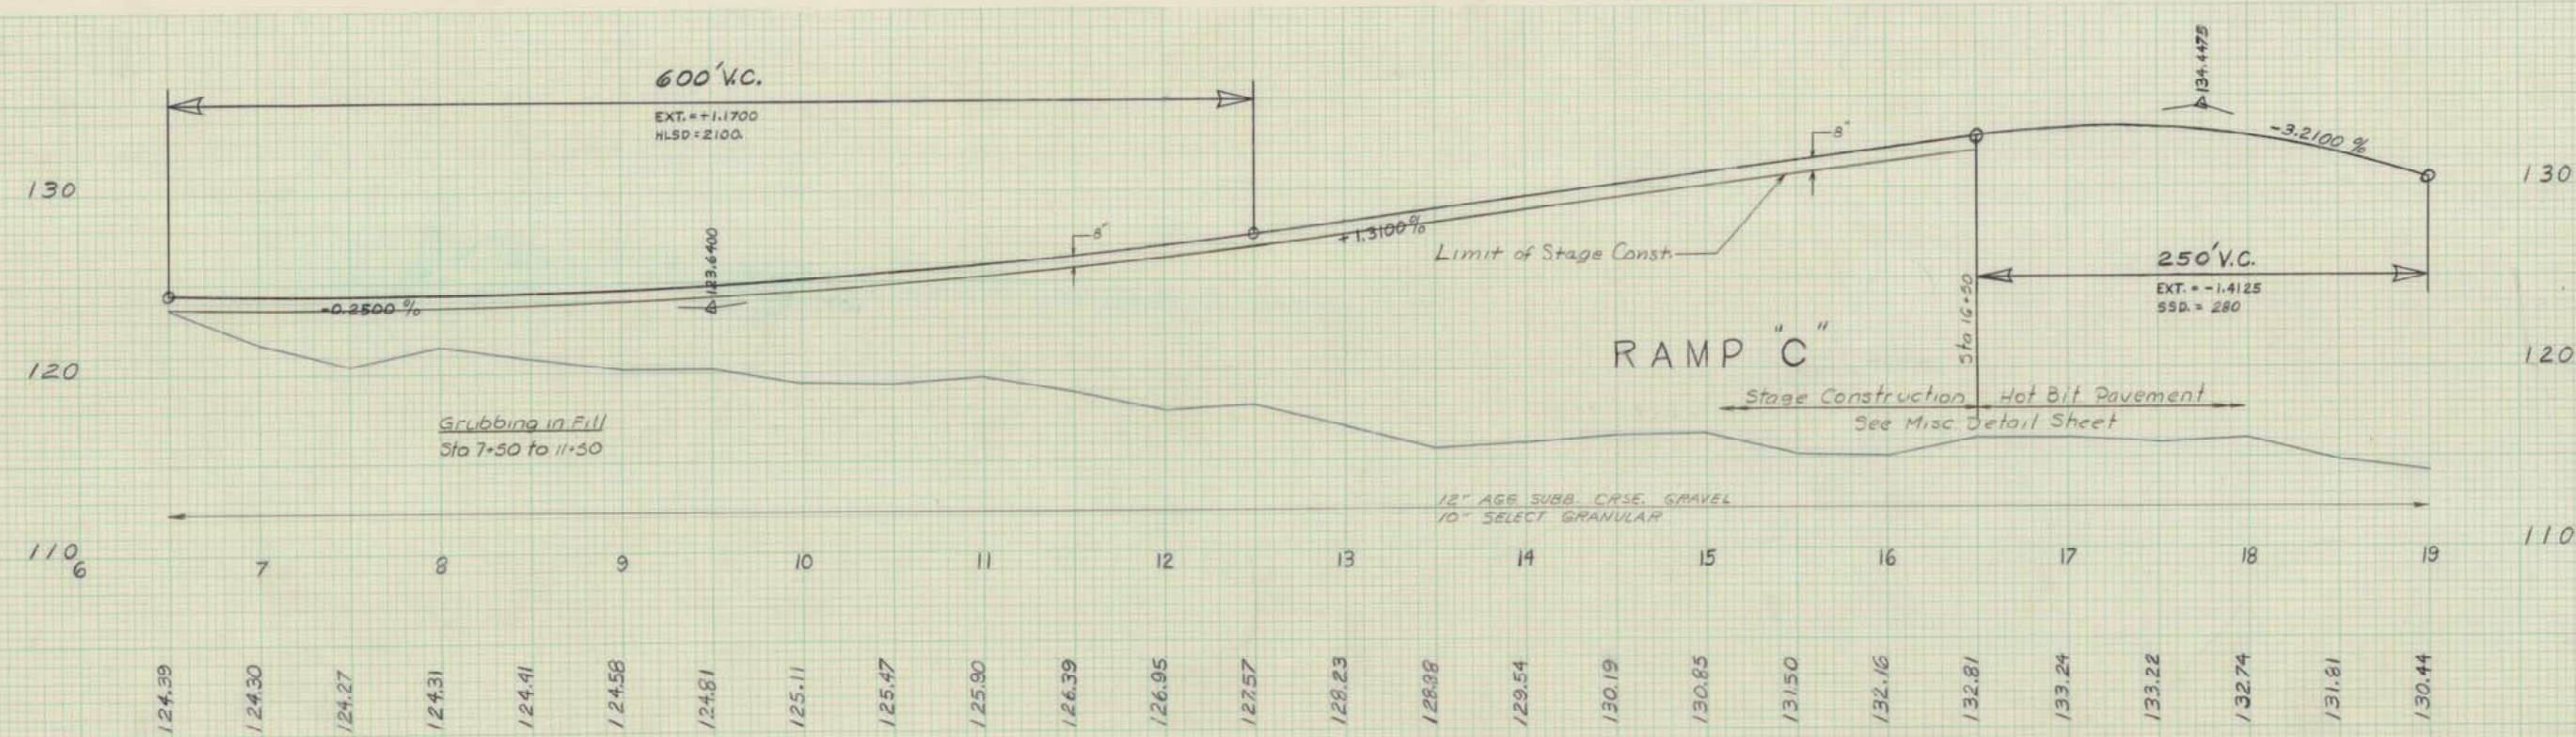

SCALE: HOR. 1"=50'  
VERT. 1"=5'

"Revised As Built" by Gary Jussell 5-15-75

I-95-5(11) 75

ROUTE 196 - TOPSHAM