
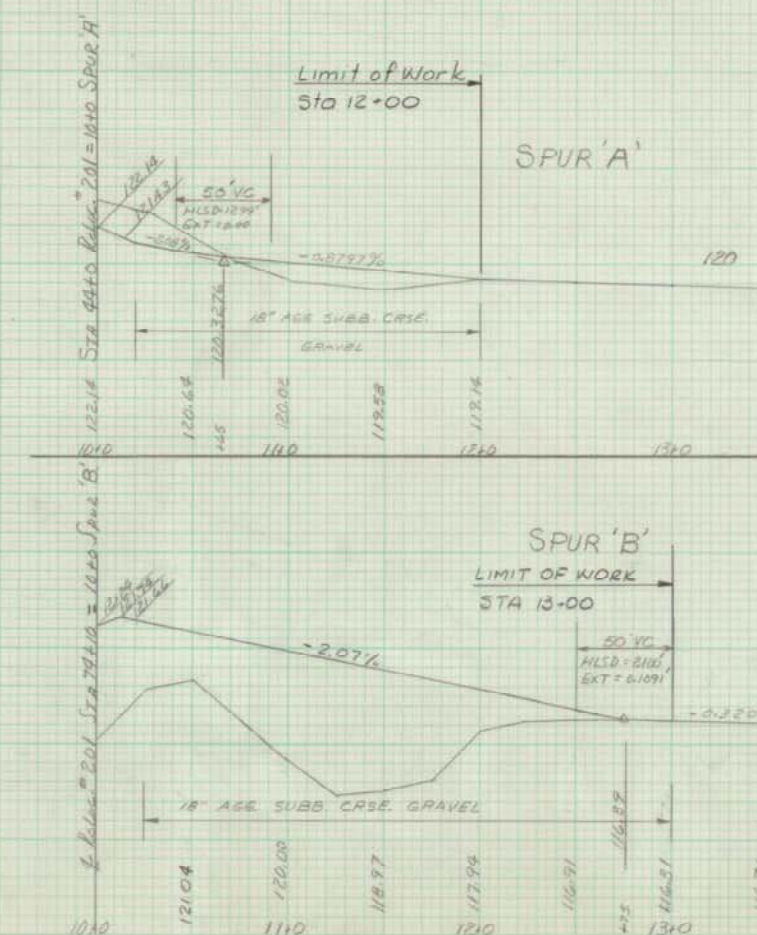
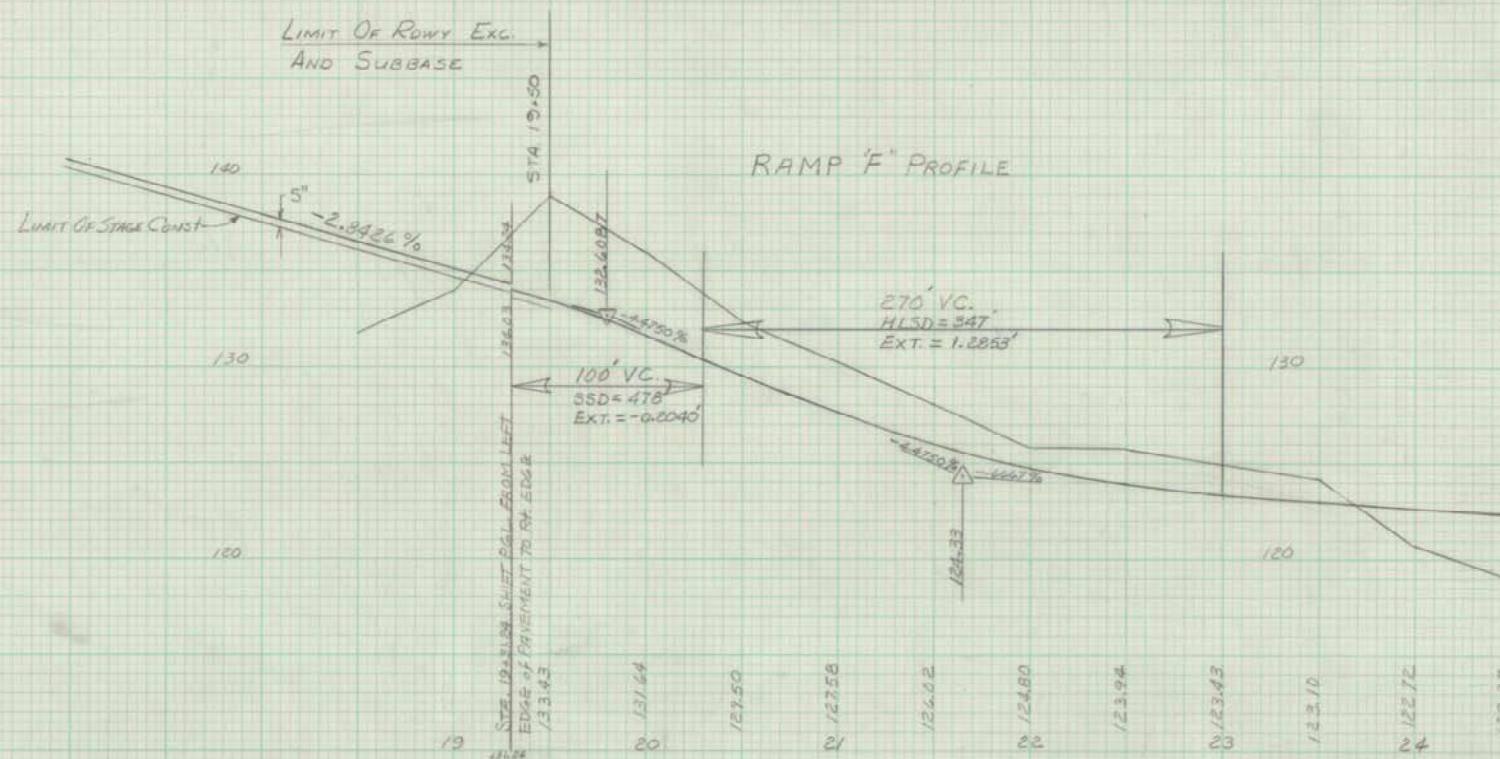


Grubbing in Fill
Sta 11+50 to 13+50
Sta 15+50 to 19+50

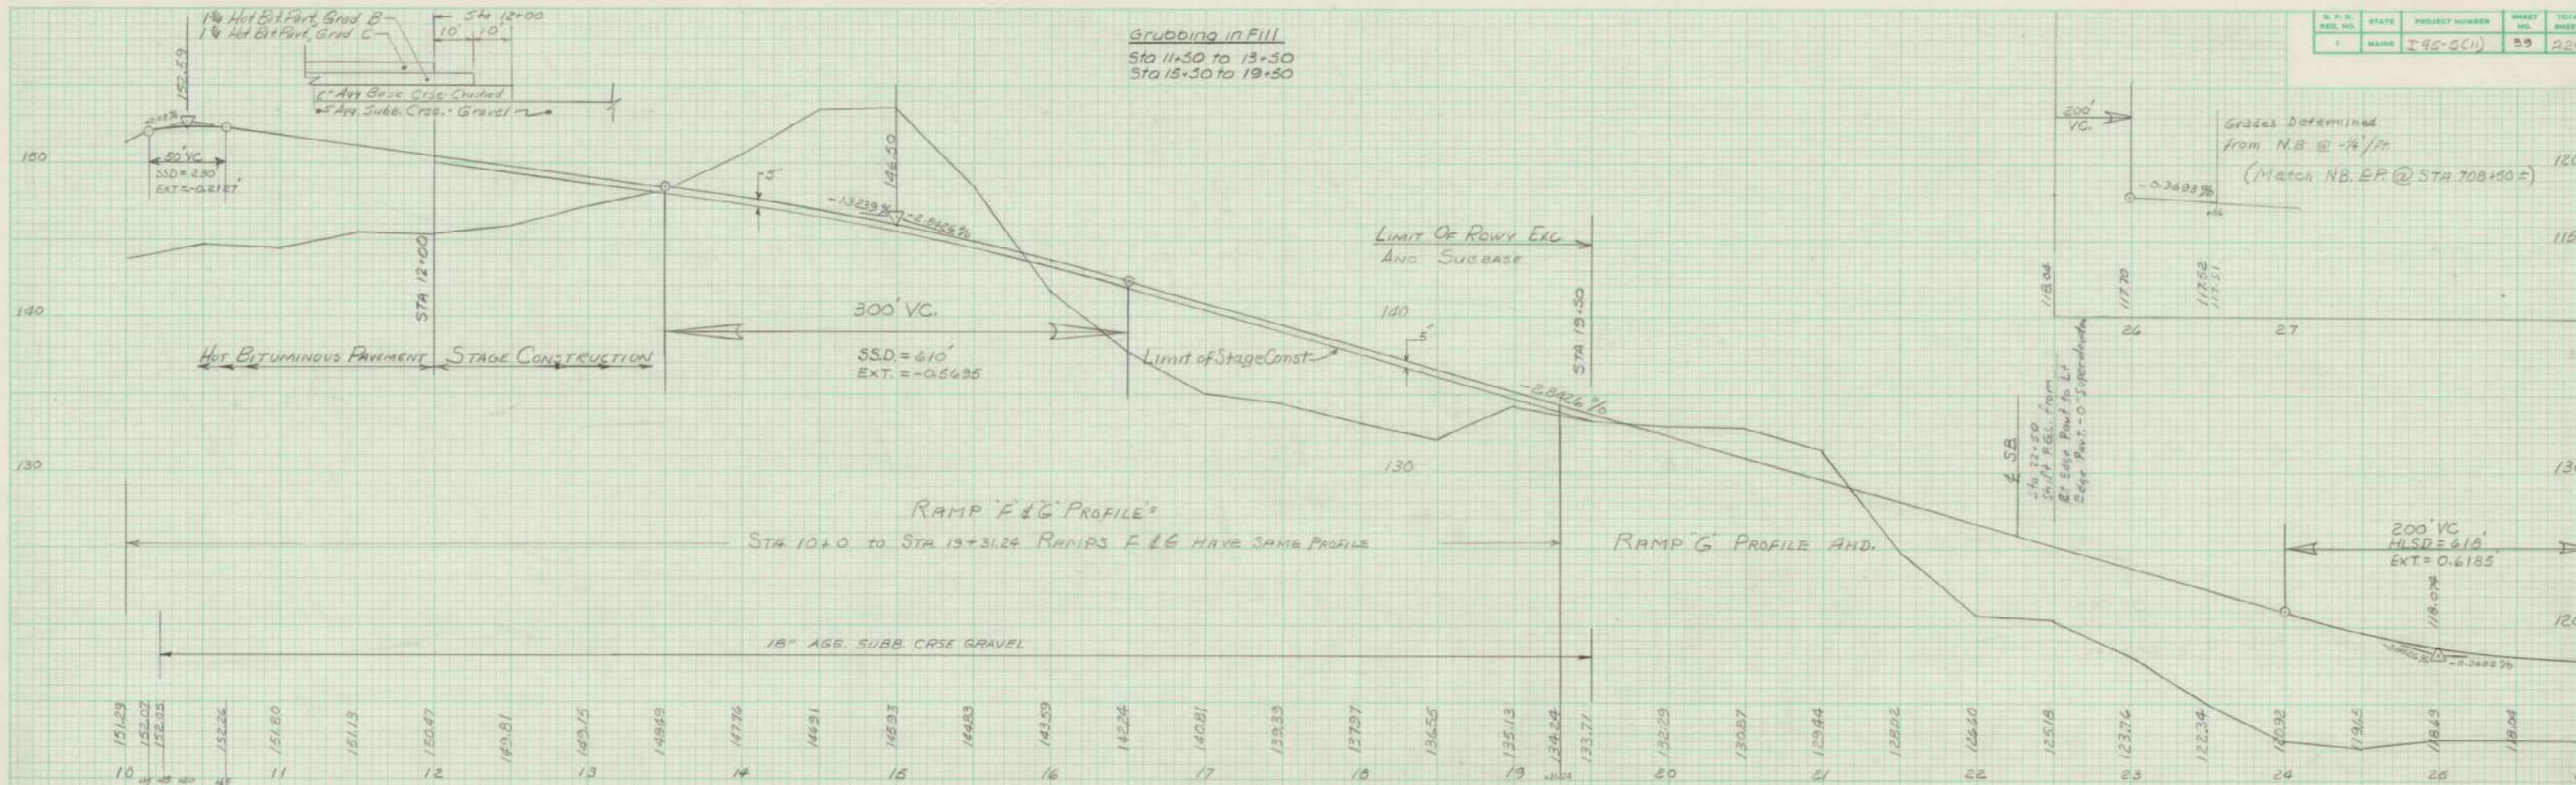

SCALE: HOR. 1"=50'
VERT. 1"=5'

TEMPORARY
RAMPS F & G PROFILES
AND
SPURS A' & B' PROFILES

"Revised As Built" by Doug Jewell 5-15-75

195-50(1)

Rte #201 TOPSHAM RAMPS F & G PROFILE