

STATE OF MAINE DEPARTMENT OF TRANSPORTATION



BUREAU OF HIGHWAYS TOWN OF RICHMOND COUNTY OF SAGadahoc MAINE FEDERAL AID INTERSTATE PROJECT NO. I-95-5(32)89 TOTAL LENGTH 2.708 MILES

A GRADING, DRAINAGE AND BASE PROJECT

ON MICROFILM Reel #184

CONVENTIONAL SIGNS


COUNTY LINES	---	TRAVELLED WAY - PROPOSED	=====
TOWN LINES	----	UNDERGROUND UTILITIES - EXISTING	----
PROPERTY LINES	-----	UNDERGROUND UTILITIES - PROPOSED	----
R/W LINES - EXISTING	=====	RAILROAD - SINGLE TRACK	-----
R/W LINES - NEW - ACCESS CONTROL	=====	RAILROAD - DOUBLE TRACK	-----
R/W LINES - NEW - NO ACCESS CONTROL	=====	UTILITY POLE - EXISTING	+
CULVERT - EXISTING	=====	UTILITY POLE - JOINT OCCUPANCY	+
CULVERT - PROPOSED	=====	PROPOSED UTILITY POLE - TEMPORARY	x
CURBING - EXISTING	=====	PROPOSED UTILITY POLE - PERMANENT	x
CURBING - PROPOSED	=====	TREES	⊙ hardwood ⊙ softwood
TRAVELLED WAY - EXISTING	=====	WOODS	~~~~~

INDEX OF SHEETS

SHEET NO.	DESCRIPTION
1	TITLE SHEET
2	TYPICAL SECTIONS
3	QUANTITY SHEET & LEDGE TRANSITION DETAIL
4	DRAINAGE SHEET & SEDIMENTATION BASIN DETAIL
5-12	STANDARD DETAILS
13	GENERAL NOTES & SETTLEMENT PLATFORM DETAIL
14-18	I-95 PLAN & PROFILE
19-20	BEEBLE ROAD PLAN & PROFILE
21-59	I-95 N.B. CROSS SECTIONS
60-90	I-95 S.B. CROSS SECTIONS
91-96	BEEBLE ROAD CROSS SECTIONS

AS CONSTRUCTED JULY 1975

PLAN.....1"=100'
SCALES.....PROFILE {HORIZ. 1"=100'
VERT. 1"=10'} OR AS SHOWN
CROSS SECTS.....1"=10'

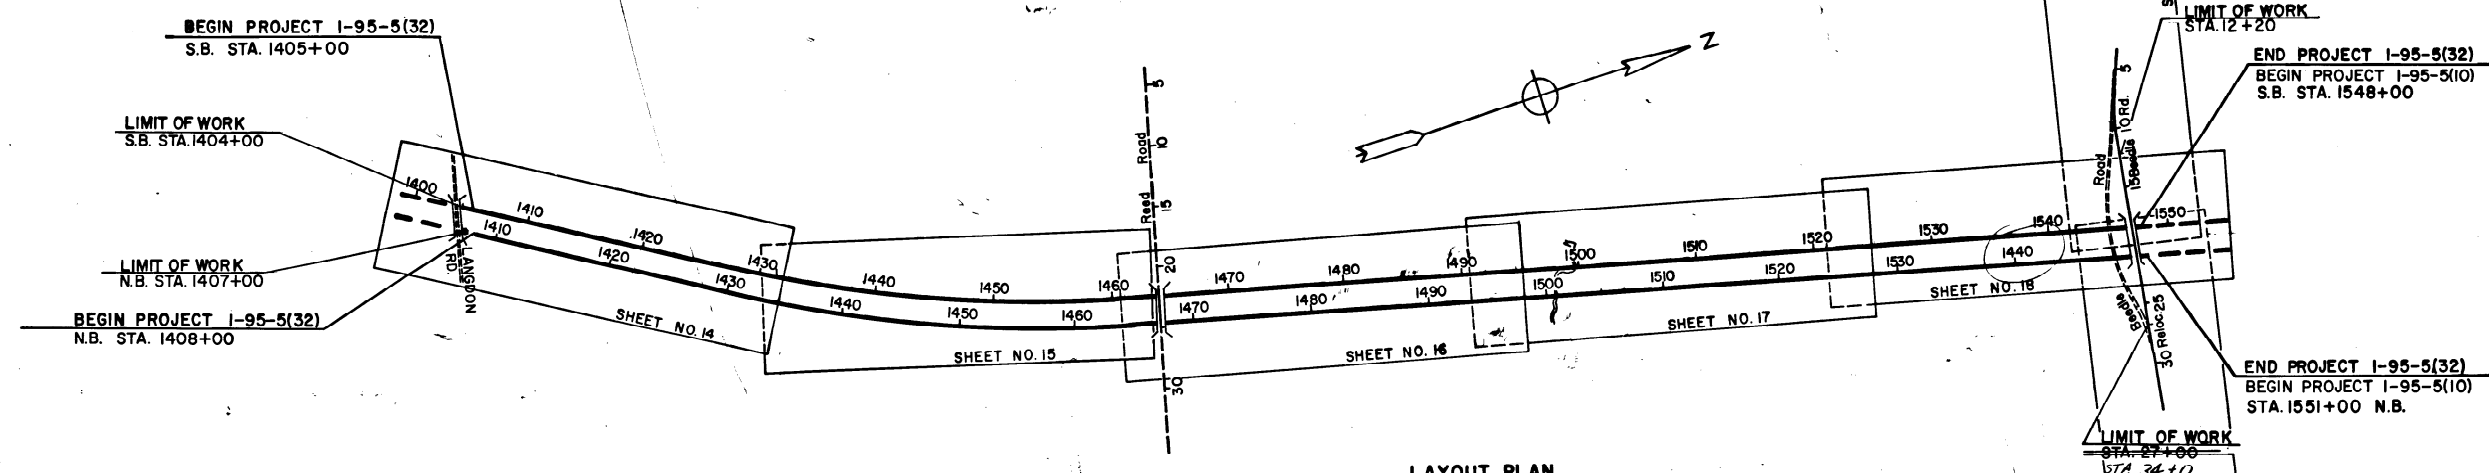

LAYOUT PLAN
0' 400' 800'



APPROVED:
STATE OF MAINE
DEPARTMENT OF TRANSPORTATION
DATE 4/25/73
COMMISSIONER
BUREAU DIRECTOR & CHIEF ENGINEER


UNITED STATES
DEPARTMENT OF TRANSPORTATION
FEDERAL HIGHWAY ADMINISTRATION
REGION 1
APPROVED:
DIVISION ENGINEER DATE

NOTE:
All Work Contemplated Under This Contract
To Be Governed By And In Conformity With The
Standard Specifications (Revision of June 1968)
And Supplements Thereto, Except As Modified
On The Plans And In The Special Provisions.

TRAFFIC DATA	
A.D.T. 1973	9,730
A.D.T. 1993	18,740
D.H.V.	2436
T. (%)	11
D. (%)	60
V.	70 M.P.H.
P.S.D. (%)	100%
18 KIPS	605

BEGIN PROJECT I-95-5(32)89
STA. 1405+00 S.B.
STA. 1408+00 N.B.
END PROJECT I-95-5(32)89
STA. 1548+00 S.B.
STA. 1551+00 N.B.

A PORTION OF SAGADAHOC COUNTY

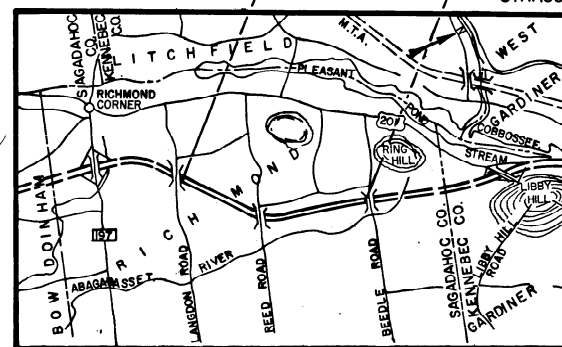

SCALE: 1"=1.25 MILES

RICHMOND I-95-5(32)89