



STA 1592+42 TO 1598+78 S.B. 46'21"
INSTALLED 18"x36" culv. (option I) 1973

R. P. R.	STATE	PROJECT NUMBER	SHEET NO.	TOTAL SHEETS
1	MAINE	I-95-5(10)	20	145

NORTHBOUND
PI = 1585+59.45
Δ = 11°-24'-07" LT
D = 0°-30'-00"
T = 1147.38'
L = 2287.05'
R = 11459.16'
E = 57.3

SOUTHBOUND
PI = 1581+23.63
Δ = 11°-18'-17" LT
D = 0°-30'-00"
T = 1154.13'
L = 2260.94'
R = 11459.16'
E = 55.99'

STA 1581+80 S.B. (SKEWED 30° BK)
INSTALL 48"x136" RCP CLASS III
STANDARD CULV. END TREATMENT - SOD & RIPRAP 1972
ALDER SWAMP

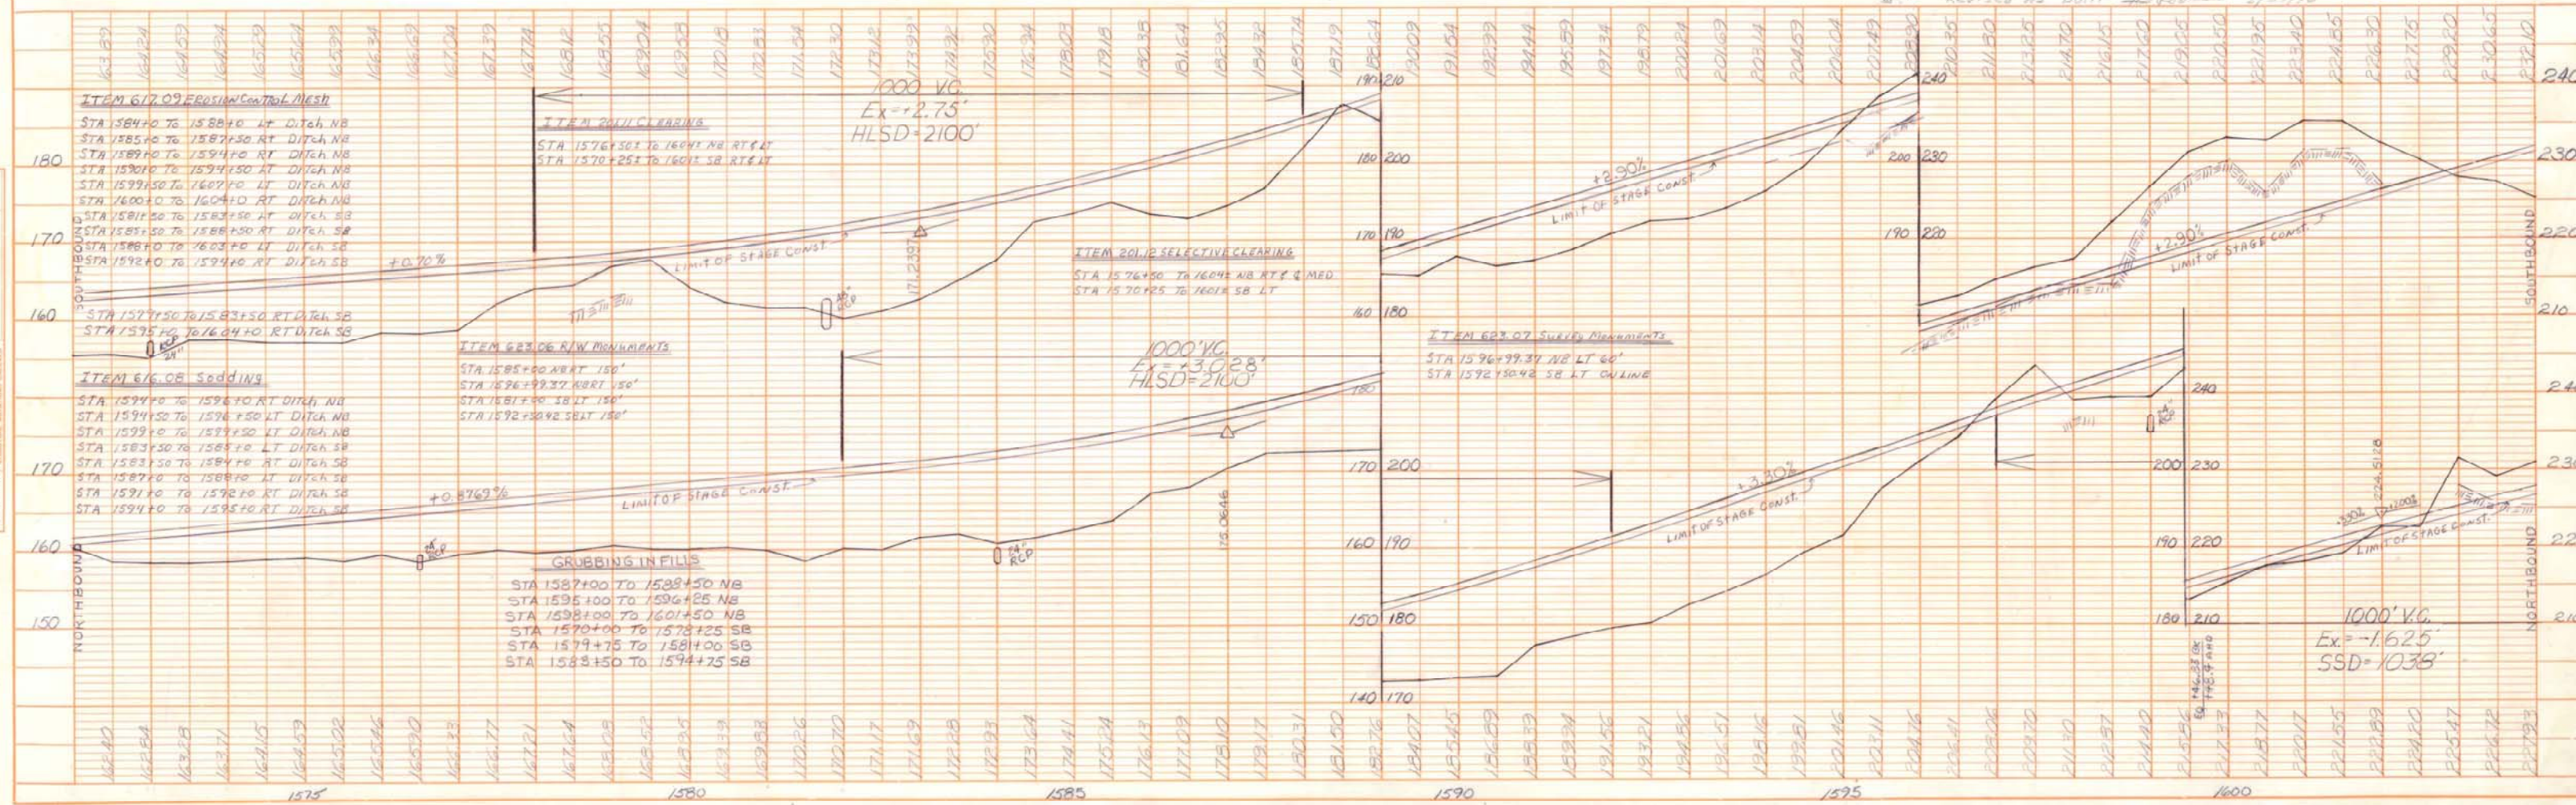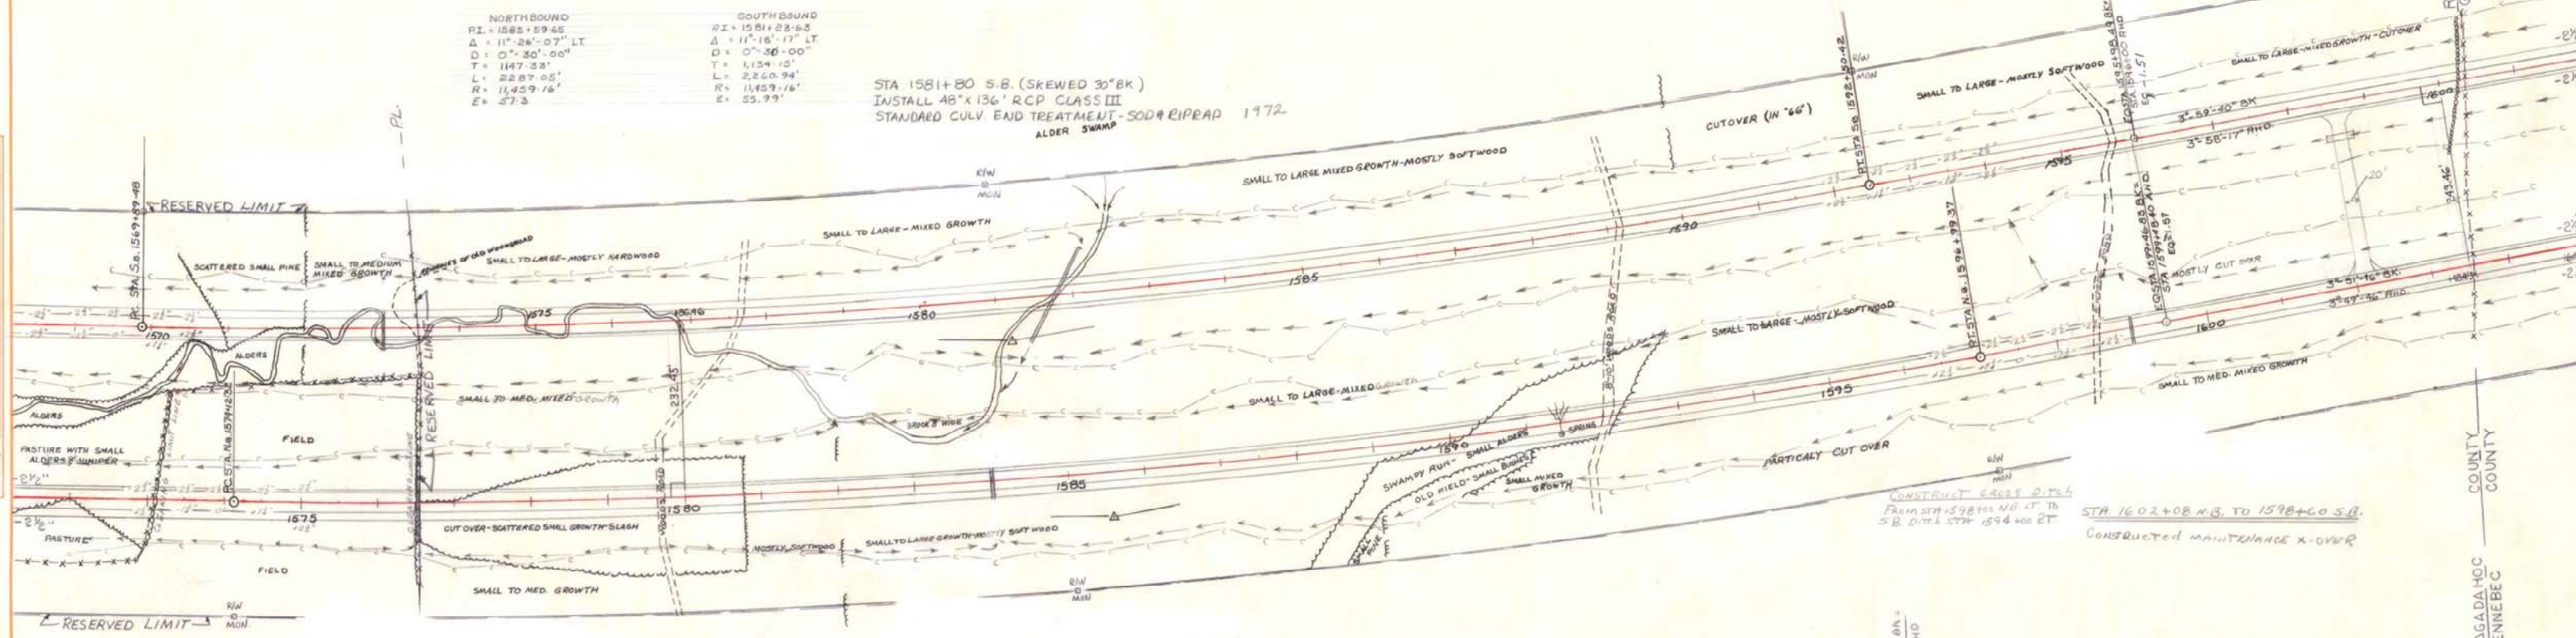

Richmond - Gardiner - West Gardiner