
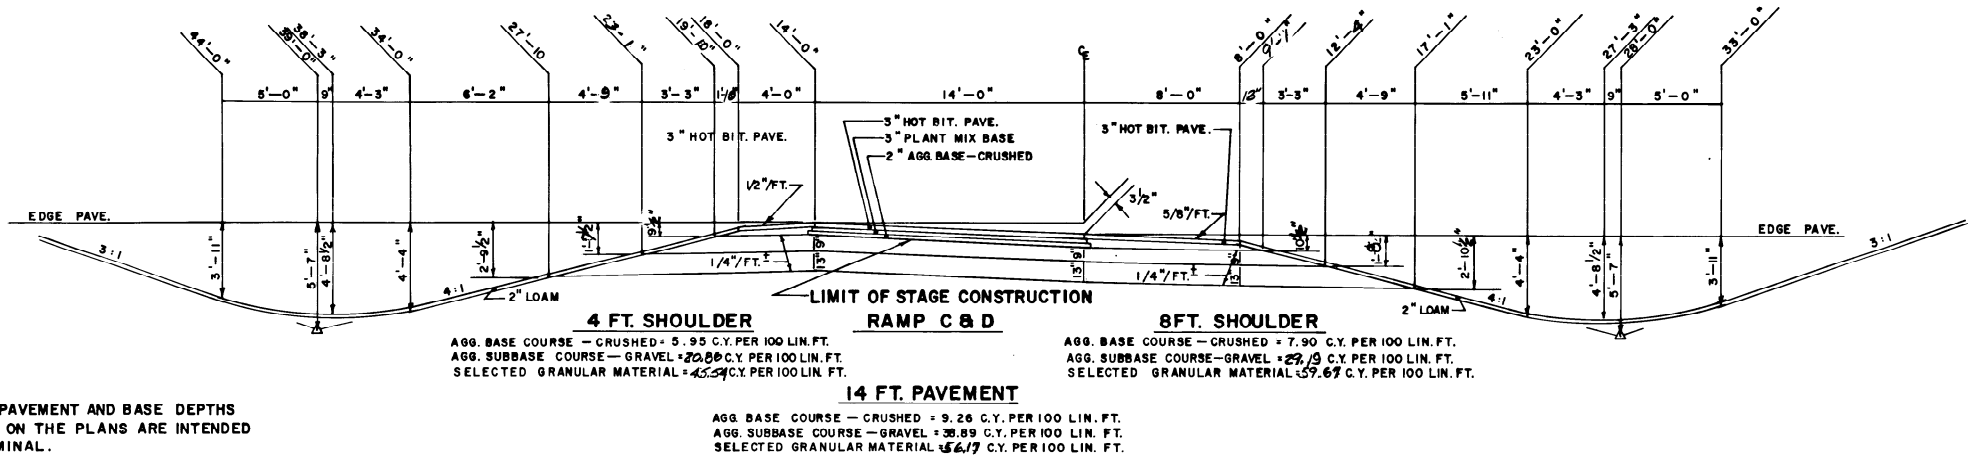
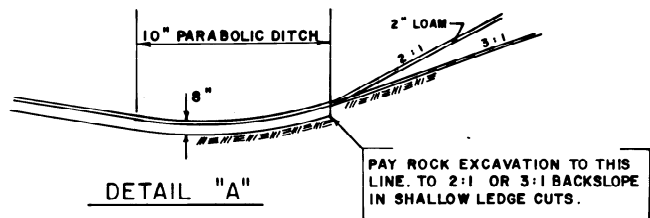
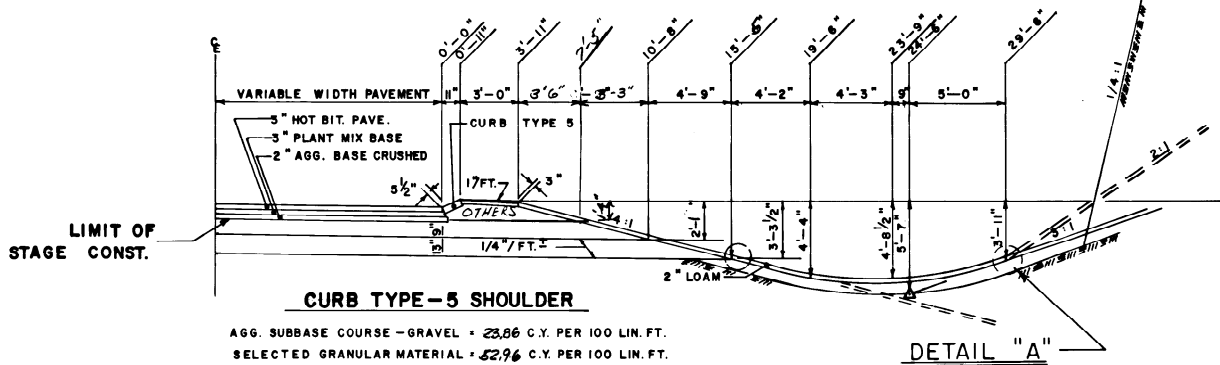
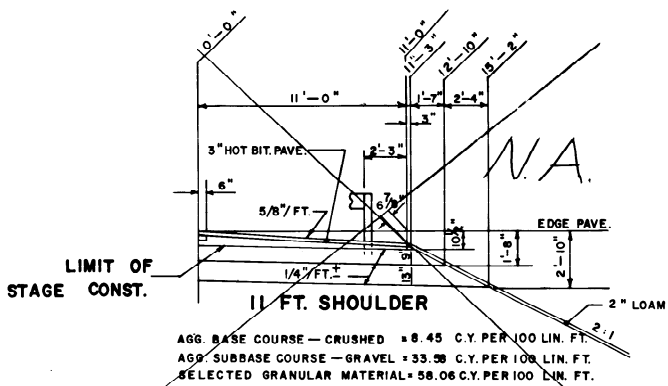
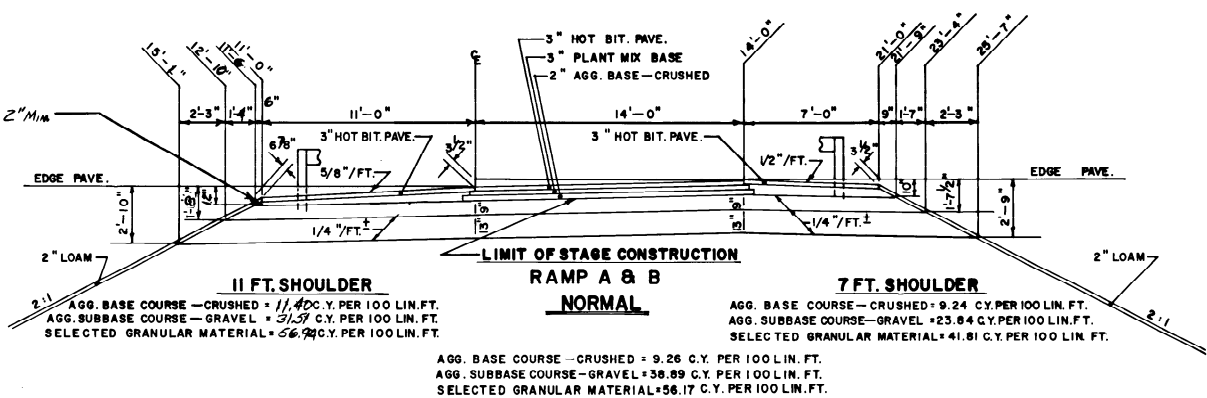


STAGE CONSTRUCTION
GRADING, DRAINAGE AND AGGREGATE SUBBASE COURSE *

F.H.W.A. SHEET NO.	STATE	PROJECT NUMBER	SHEET NO.	TOTAL SHEETS
1	MAINE	I-95-5(37)	3	155

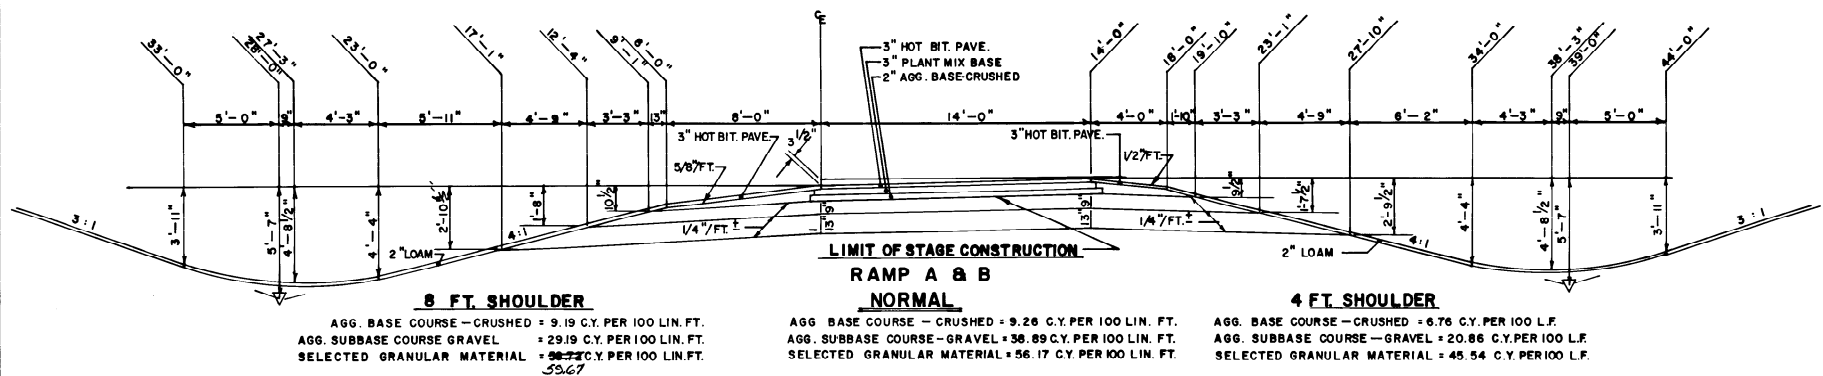

* **NOTE:**
THE PAVEMENT AND BASE DEPTHS
AS SHOWN ON THE PLANS ARE INTENDED
TO BE NOMINAL.

REVISED AS BUILT L.L. ROLLIN MAR 1976

STATE OF MAINE
DEPARTMENT OF TRANSPORTATION
RAMPS-A,B,C&D
TYPICAL SECTIONS

SCALE: 0 5 10 15 (FEET)

SHEET OF AUGUSTA, MAINE

BOWDOINHAM - RICHMOND I-95-5(37)

BY	DATE
DESIGN - DETAILED	12/20/75
CHECKED	1/14/76
REVISIONS	
FIELD CHANGES	

PLANS