


DATE	12-72
BY	Harley C. C. C.
DESIGN - DETAILED	
CHECKED	
REVISIONS	
FIELD CHANGES	
PLANS	

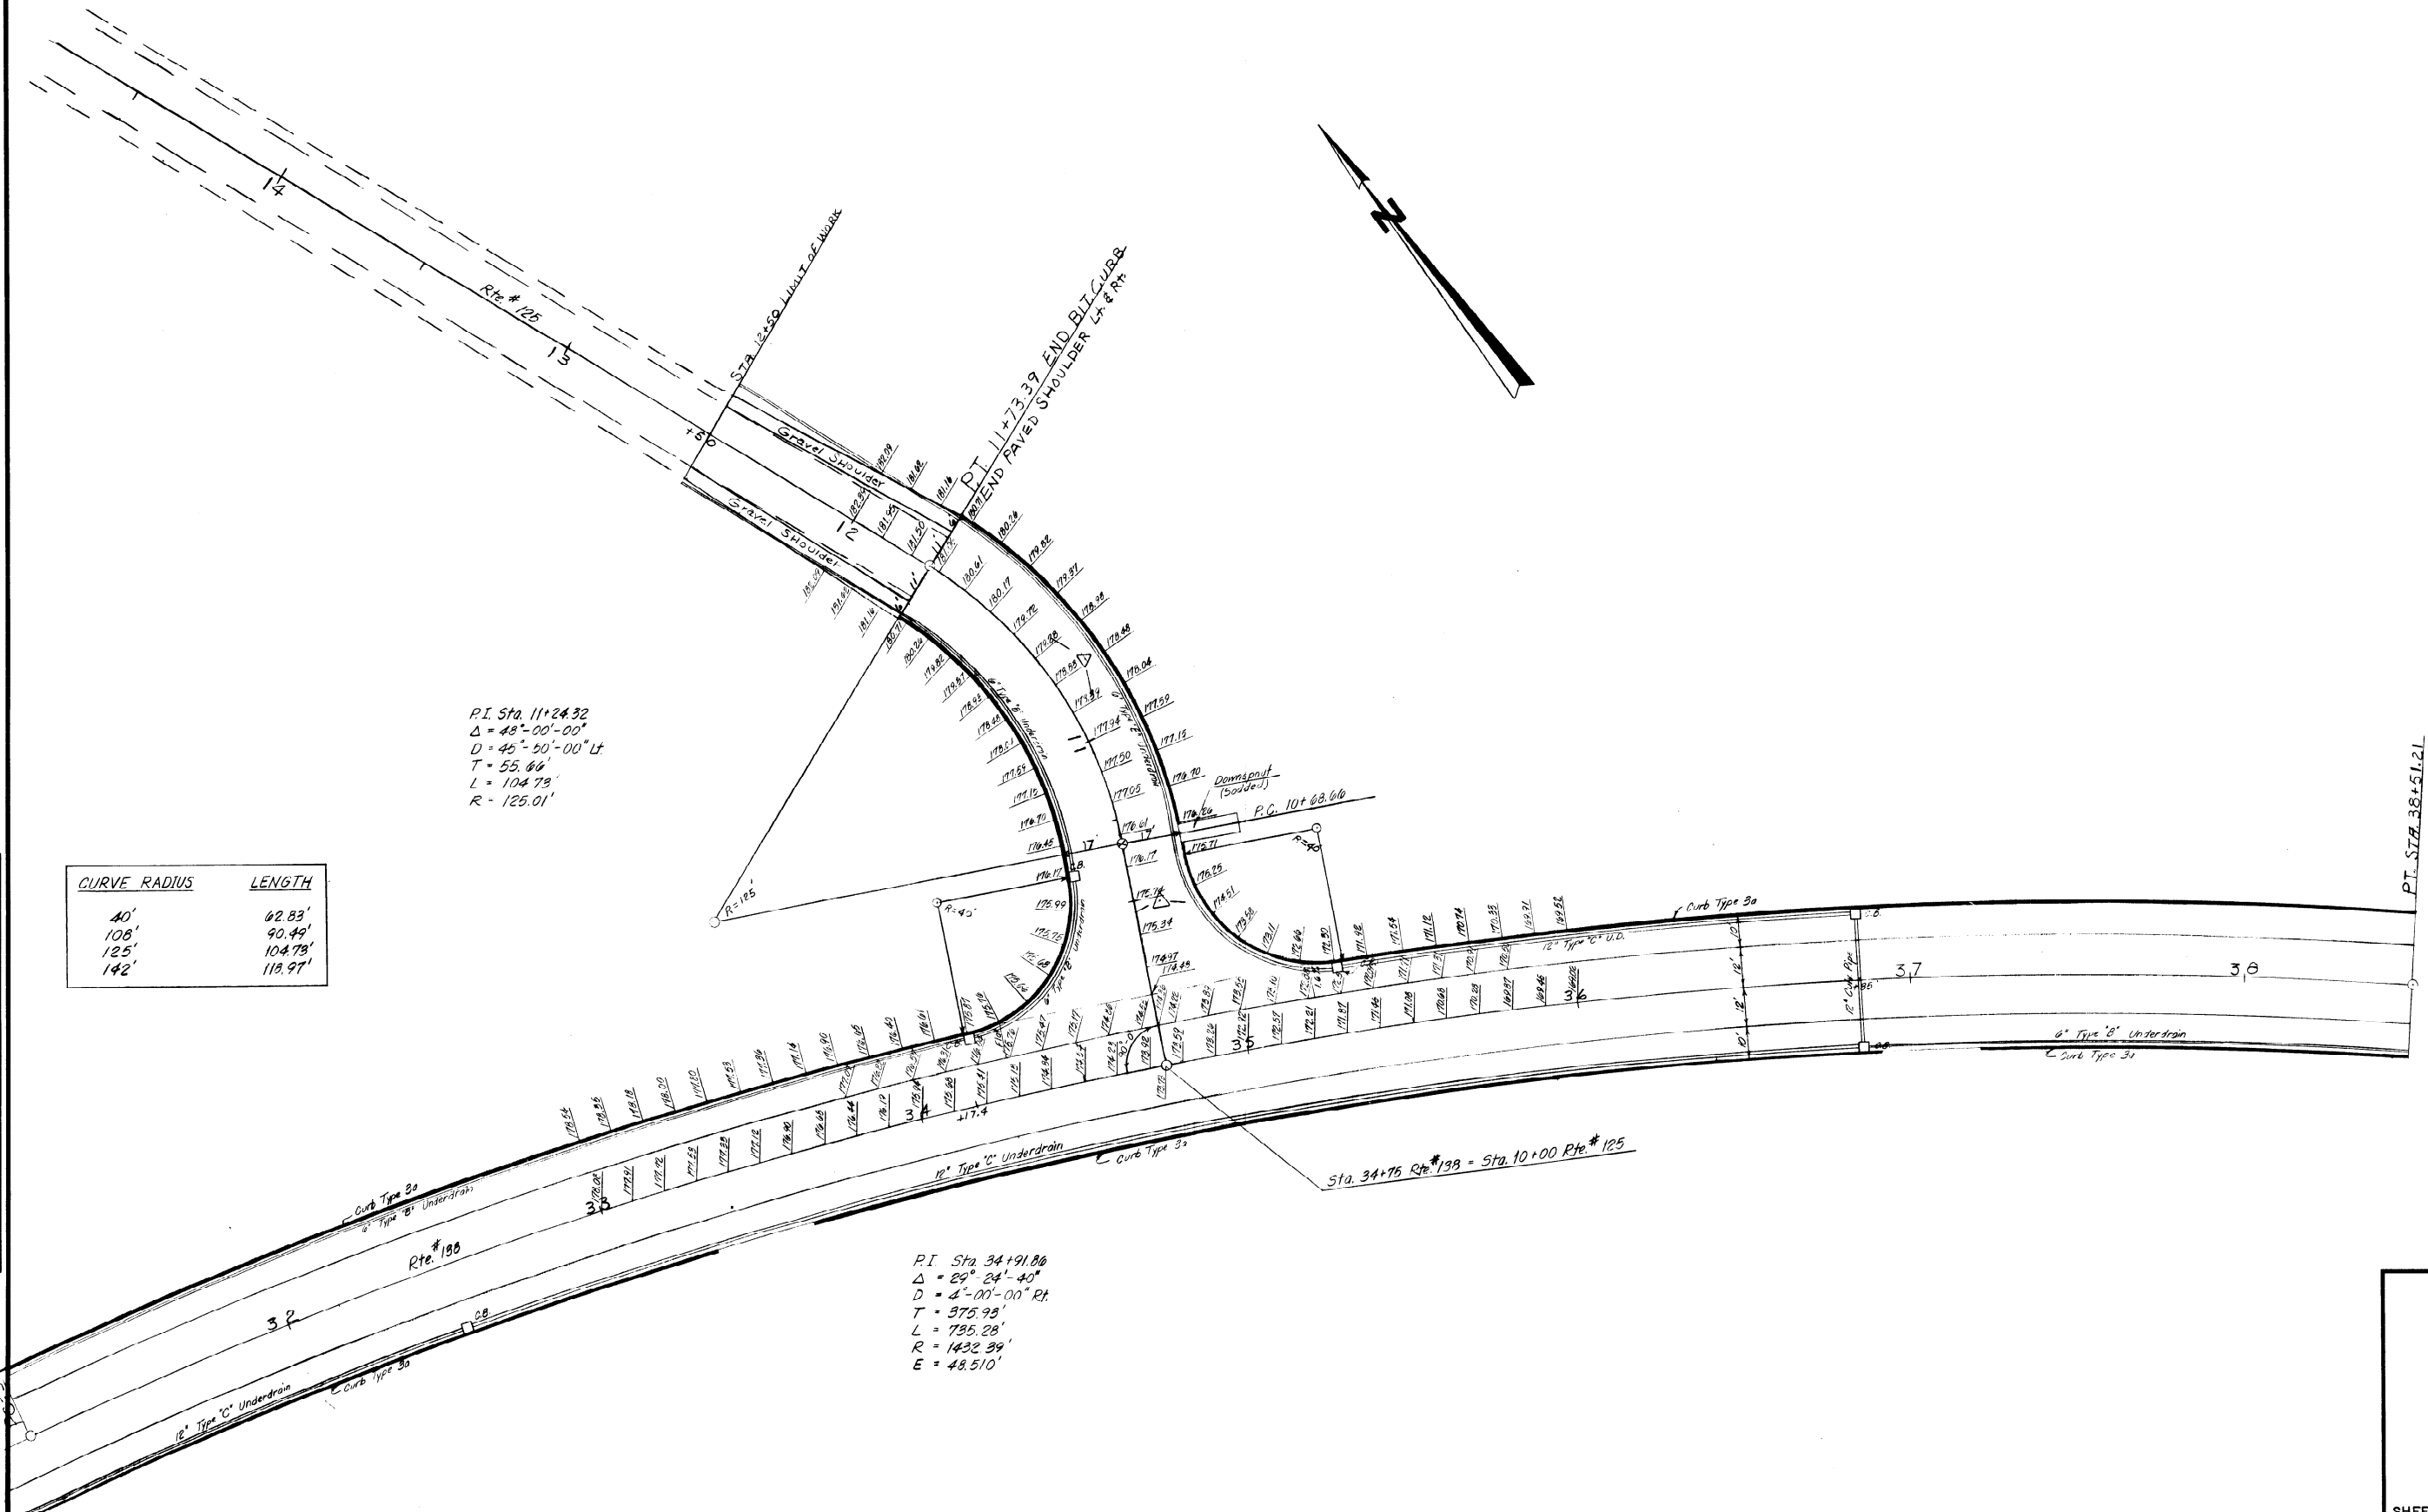

STATE OF MAINE
DEPARTMENT OF TRANSPORTATION

Geometric & Grading Plan
Rte. 125 & 138 Jct.

AS BUILT 1975

SHEET OF AUGUSTA, MAINE
TOPSHAM, BOWDOIN, BOWDOINHAM

0 25 50 FEET
205-1 2060