



FINAL SURVEY	DATE
FORWARDED	BY
PLANNED	
TEMPLATE	
NOTES	
CHECKED	
NO.	

ORIGINAL SURVEY	DATE
FORWARDED	BY
PLANNED	
TEMPLATE	
NOTES	
CHECKED	
NO.	

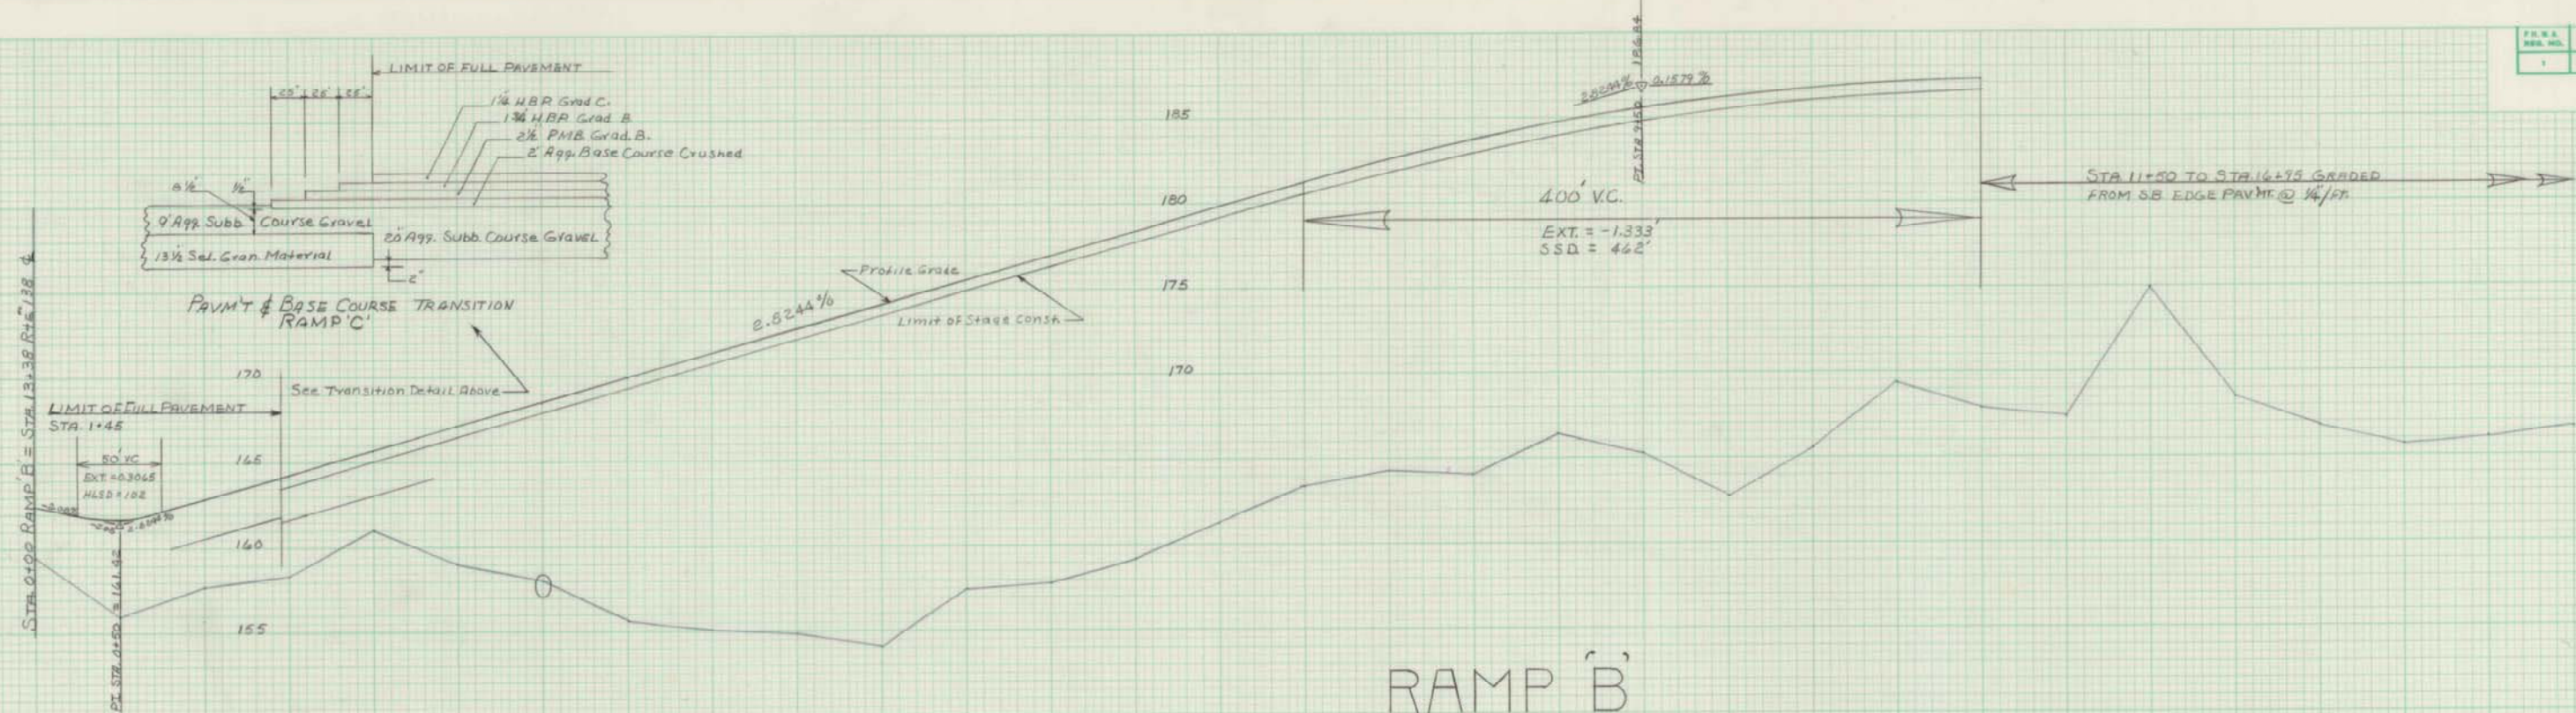

RAMP 'B'

0+00	162.46
0+50	161.73
1+00	162.83
1+50	164.24
2+00	165.66
2+50	167.07
3+00	168.48
3+50	169.89
4+00	171.31
4+50	172.72
5+00	174.13
5+50	175.54
6+00	176.95
6+50	178.37
7+00	179.78
7+50	181.19
8+00	182.52
8+50	183.48
9+00	184.48
9+50	185.51
10+00	186.17
10+50	186.46
11+00	186.39
11+50	187.11

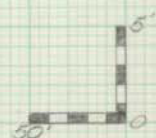

STATE OF MAINE
DEPT. OF TRANS.
PROFILE RAMP B
AS BUILT 1975