



DATE	
BY	
FINAL SURVEY	
FLIGHT	
MAP	
NO. BOOK	
AREAS CHECKED	

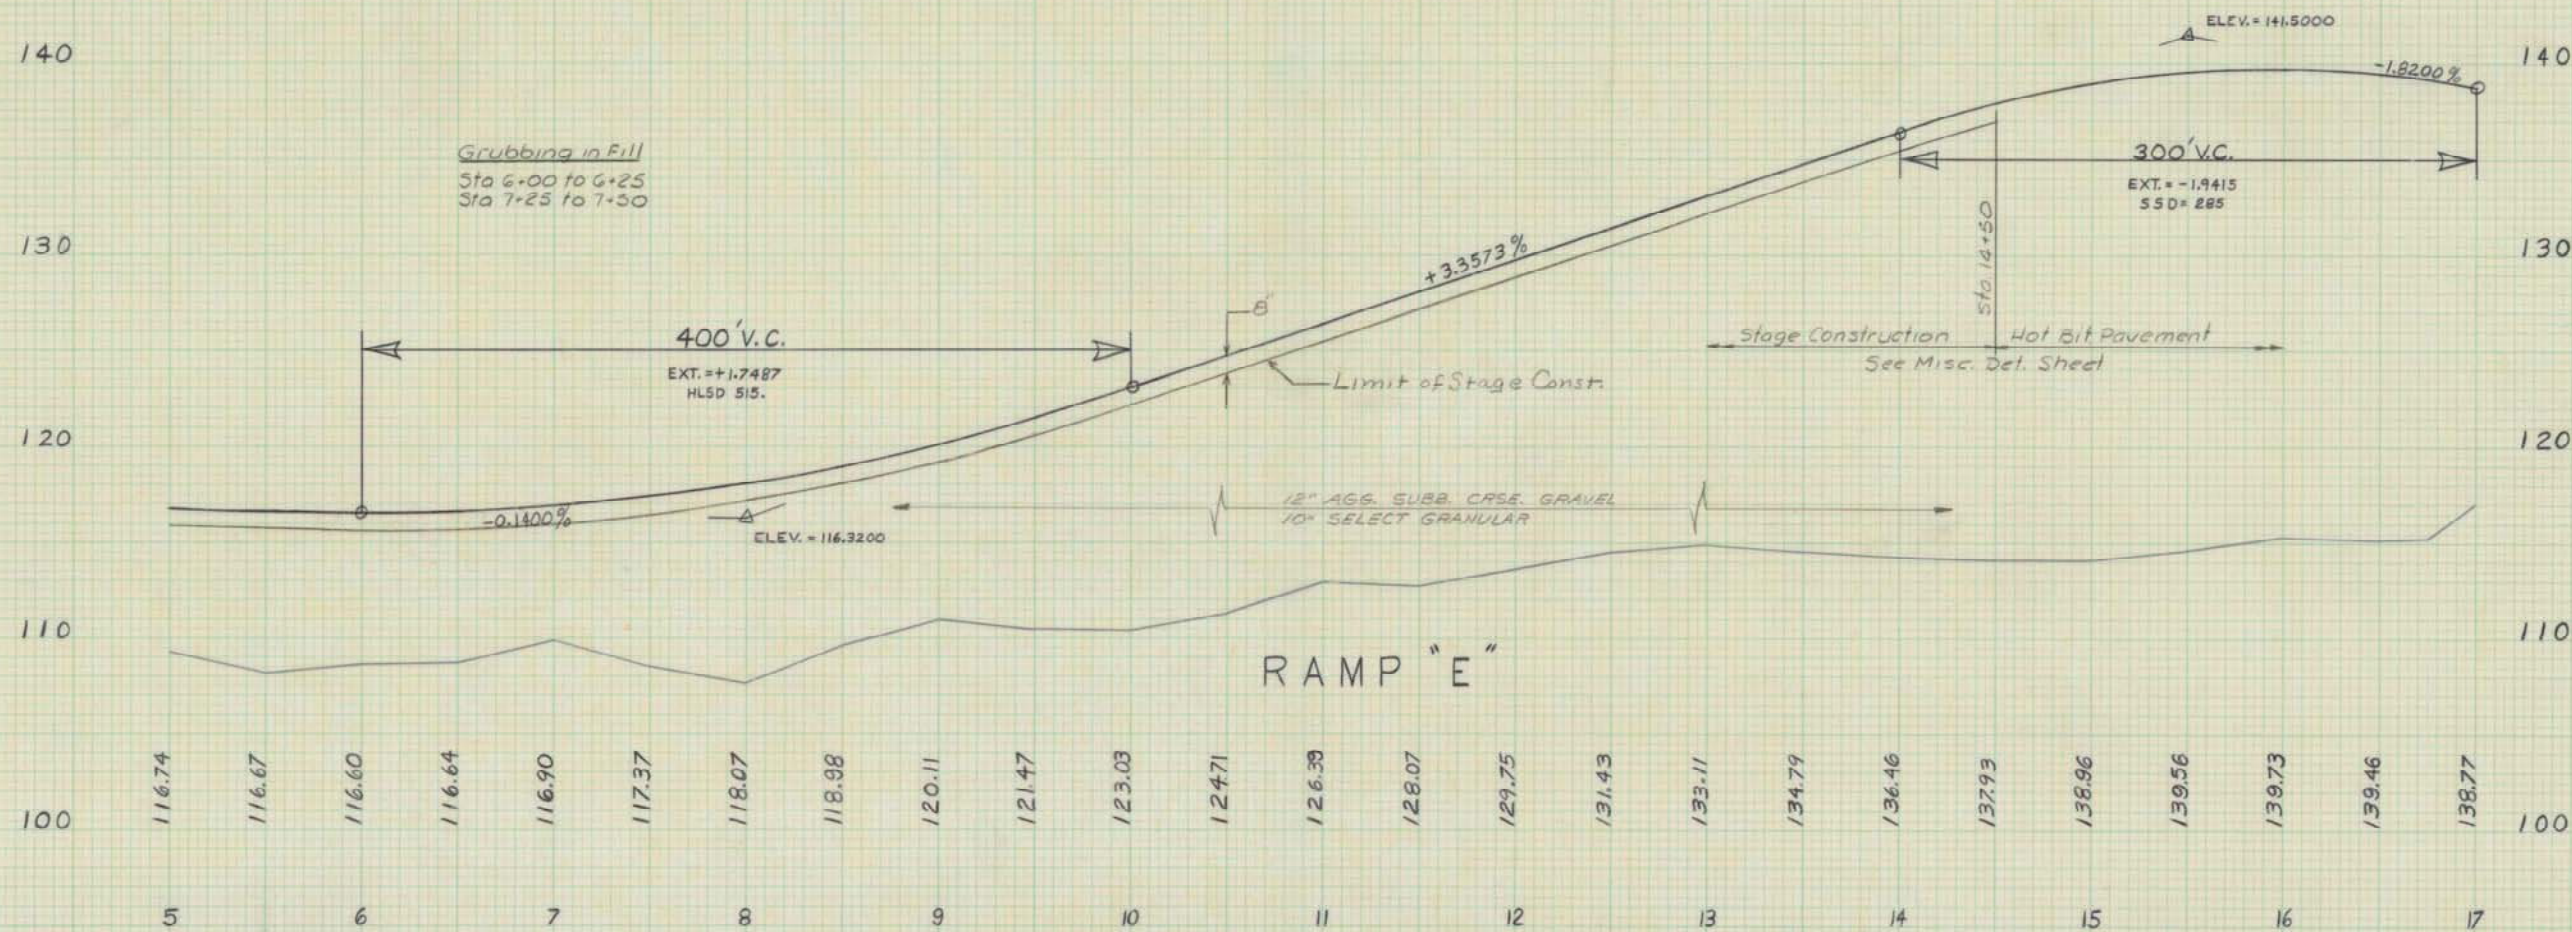

DATE	
BY	
ORIGINAL SURVEY	
FLIGHT	
MAP	
NO. BOOK	
AREAS CHECKED	

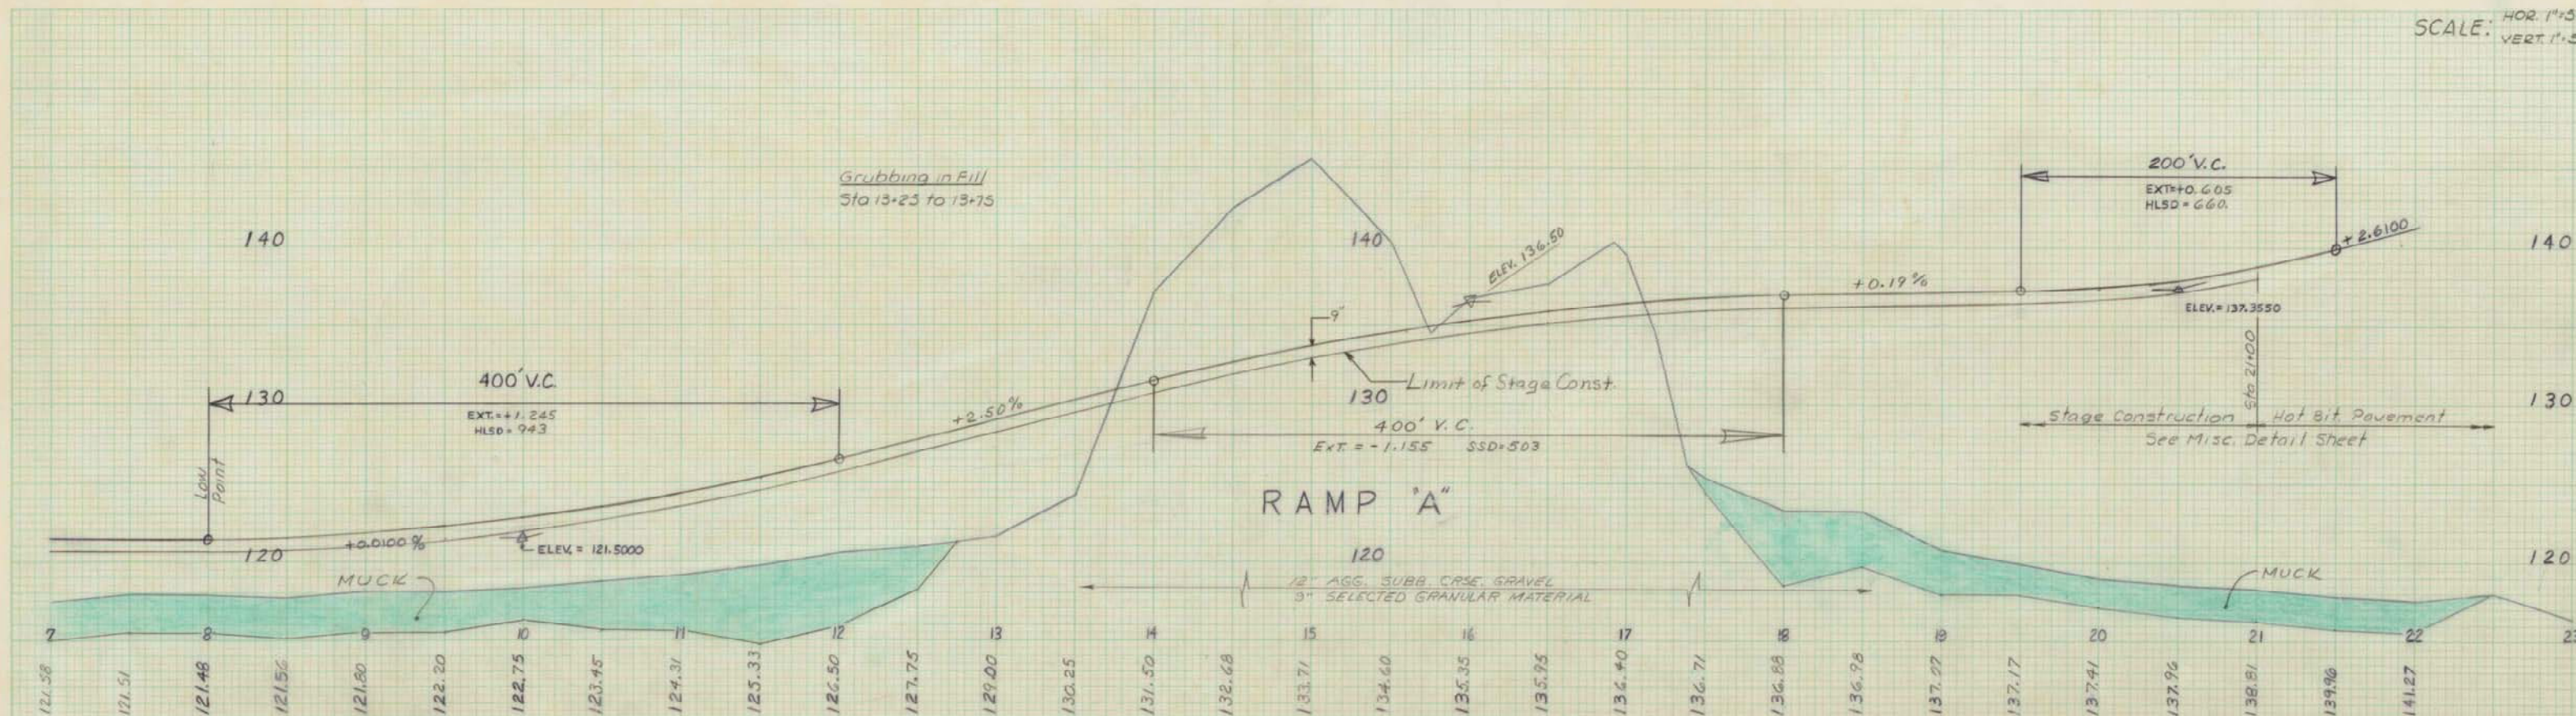

SCALE: HOR. 1"=50'
VERT. 1"=5'

Revised As Built by Gary Russell 5-14-75

I-95-5(11)75

ROUTE 196 - TOPSHAM