

STATE OF MAINE
DEPARTMENT OF TRANSPORTATION



BUREAU OF HIGHWAYS
RICHMOND-GARDINER-WEST GARDINER
SAGADAHOC & KENNEBEC COUNTIES

MAINE FEDERAL AID INTERSTATE
PROJECT NO. 1-95-5(10) 92
TOTAL LENGTH 3.002 MILES
A GRADING, DRAINAGE & BASE PROJECT

PLAN 1 IN. = 100 FT.
SCALES: PROFILE HOR. 1 IN. = 100 FT. VERT. 1 IN. = 10 FT. OR AS SHOWN
CROSS SECTION 1 IN. = 10 FT.

CONVENTIONAL SIGNS


COUNTY LINES	---	TRAVELLED WAY - PROPOSED	=====
TOWN LINES	----	UNDERGROUND UTILITIES - EXISTING	----
PROPERTY LINES	-----	UNDERGROUND UTILITIES - PROPOSED	-----
R/W LINES - EXISTING	=====	RAILROAD - SINGLE TRACK	=====
R/W LINES - NEW - ACCESS CONTROL	=====	RAILROAD - DOUBLE TRACK	=====
R/W LINES - NEW - NO ACCESS CONTROL	=====	UTILITY POLE - EXISTING	+
CULVERT - EXISTING	=====	UTILITY POLE - JOINT OCCUPANCY	+
CULVERT - PROPOSED	=====	PROPOSED UTILITY POLE - TEMPORARY	x
CURBING - EXISTING	=====	PROPOSED UTILITY POLE - PERMANENT	+
CURBING - PROPOSED	=====	TREES	+
TRAVELLED WAY - EXISTING	=====	WOODS	=====

ON MICROFILM REEL #182


INDEX OF SHEETS

SHEET NO.	DESCRIPTION
1	TITLE SHEET
2-4	TYPICAL SECTIONS
5	QUANTITY SHEET
6	DRAINAGE SHEET
7-15	STANDARD DETAILS
16	BRIDGE RAIL TRANSITIONS & APPROACH SLABS (Rte. 201)
17	SIGNING DETAIL
18	GENERAL NOTES & TRAFFIC DATA
19-24	1-95 PLAN & PROFILE
25-26	PROFILE RAMPS A,B,C,D
27-28	SPECIAL DETAILS-COBBOSSSECONTEE STREAM
29-31	ROUTE 201 PLAN & PROFILE
32-33	GEOMETRICS & GRADING RAMPS A,B,C,D
34-78	1-95 N.B. CROSS SECTIONS
79-117	1-95 S.B. CROSS SECTIONS
118-132	RAMPS A,B,C,D CROSS SECTIONS
133-144	ROUTE 201 CROSS SECTIONS
145	SERVICE ROAD CROSS SECTIONS

To STORAGE

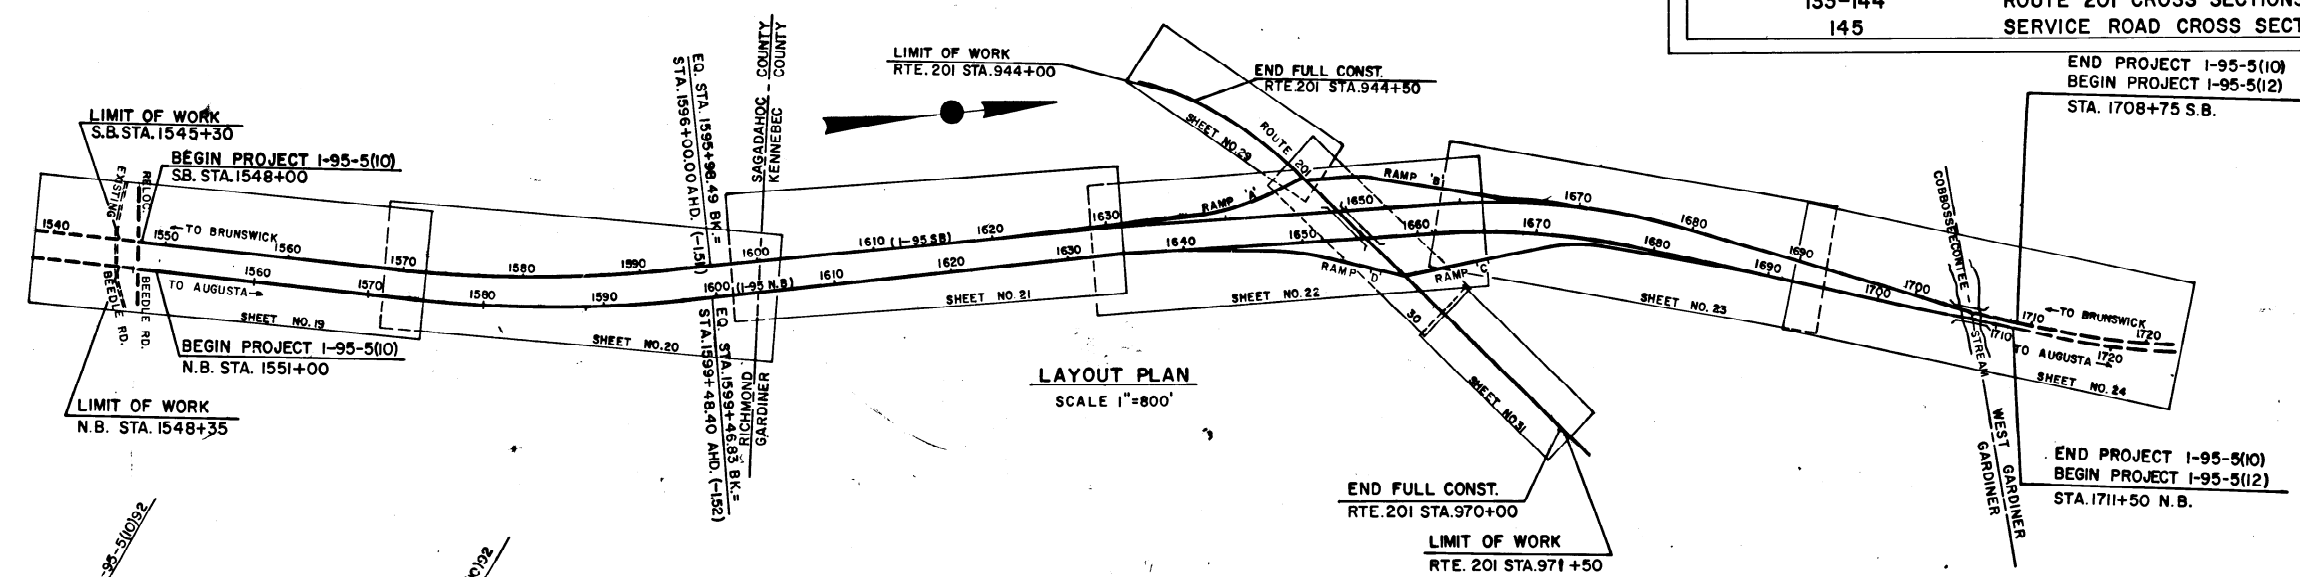

Project Completed 1974

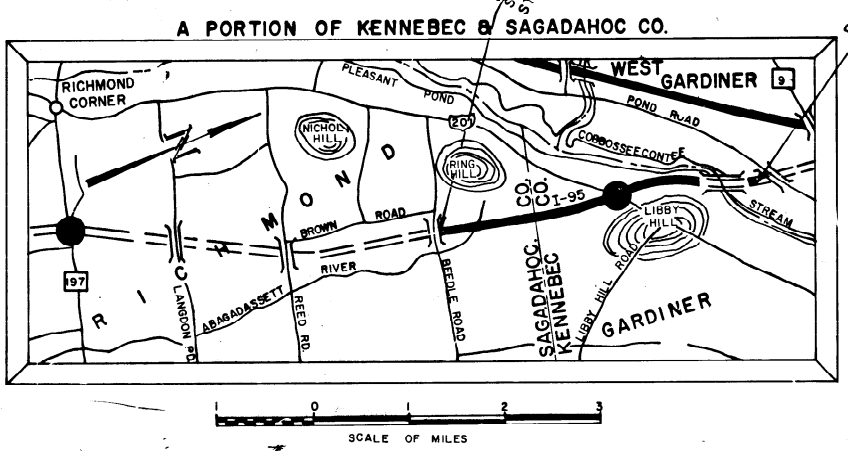

NOTE:
All Work Contemplated Under This Contract
To Be Governed By And In Conformity With The
Standard Specifications (Revision Of June 1968)
And Supplements Thereto, Except As Modified On
The Plans And In The Special Provisions.

TRAFFIC DATA

A.D.T.	1974	10240
A.D.T.	1994	19210
D.M.V.		2497
T. (%)		11
D. (%)		60
V.		60 mph
P.S.D. (%)		100 %
18 K		909

APPROVED:

STATE OF MAINE
DEPARTMENT OF TRANSPORTATION

DATE: JUNE 7, 1972

COMMISSIONER

BUREAU DIRECTOR

CHIEF ENGINEER



Revised AS BUILT 4/15/80

UNITED STATES
DEPARTMENT OF TRANSPORTATION
FEDERAL HIGHWAY ADMINISTRATION

REGION 1

APPROVED:

DIVISION ENGINEER DATE