
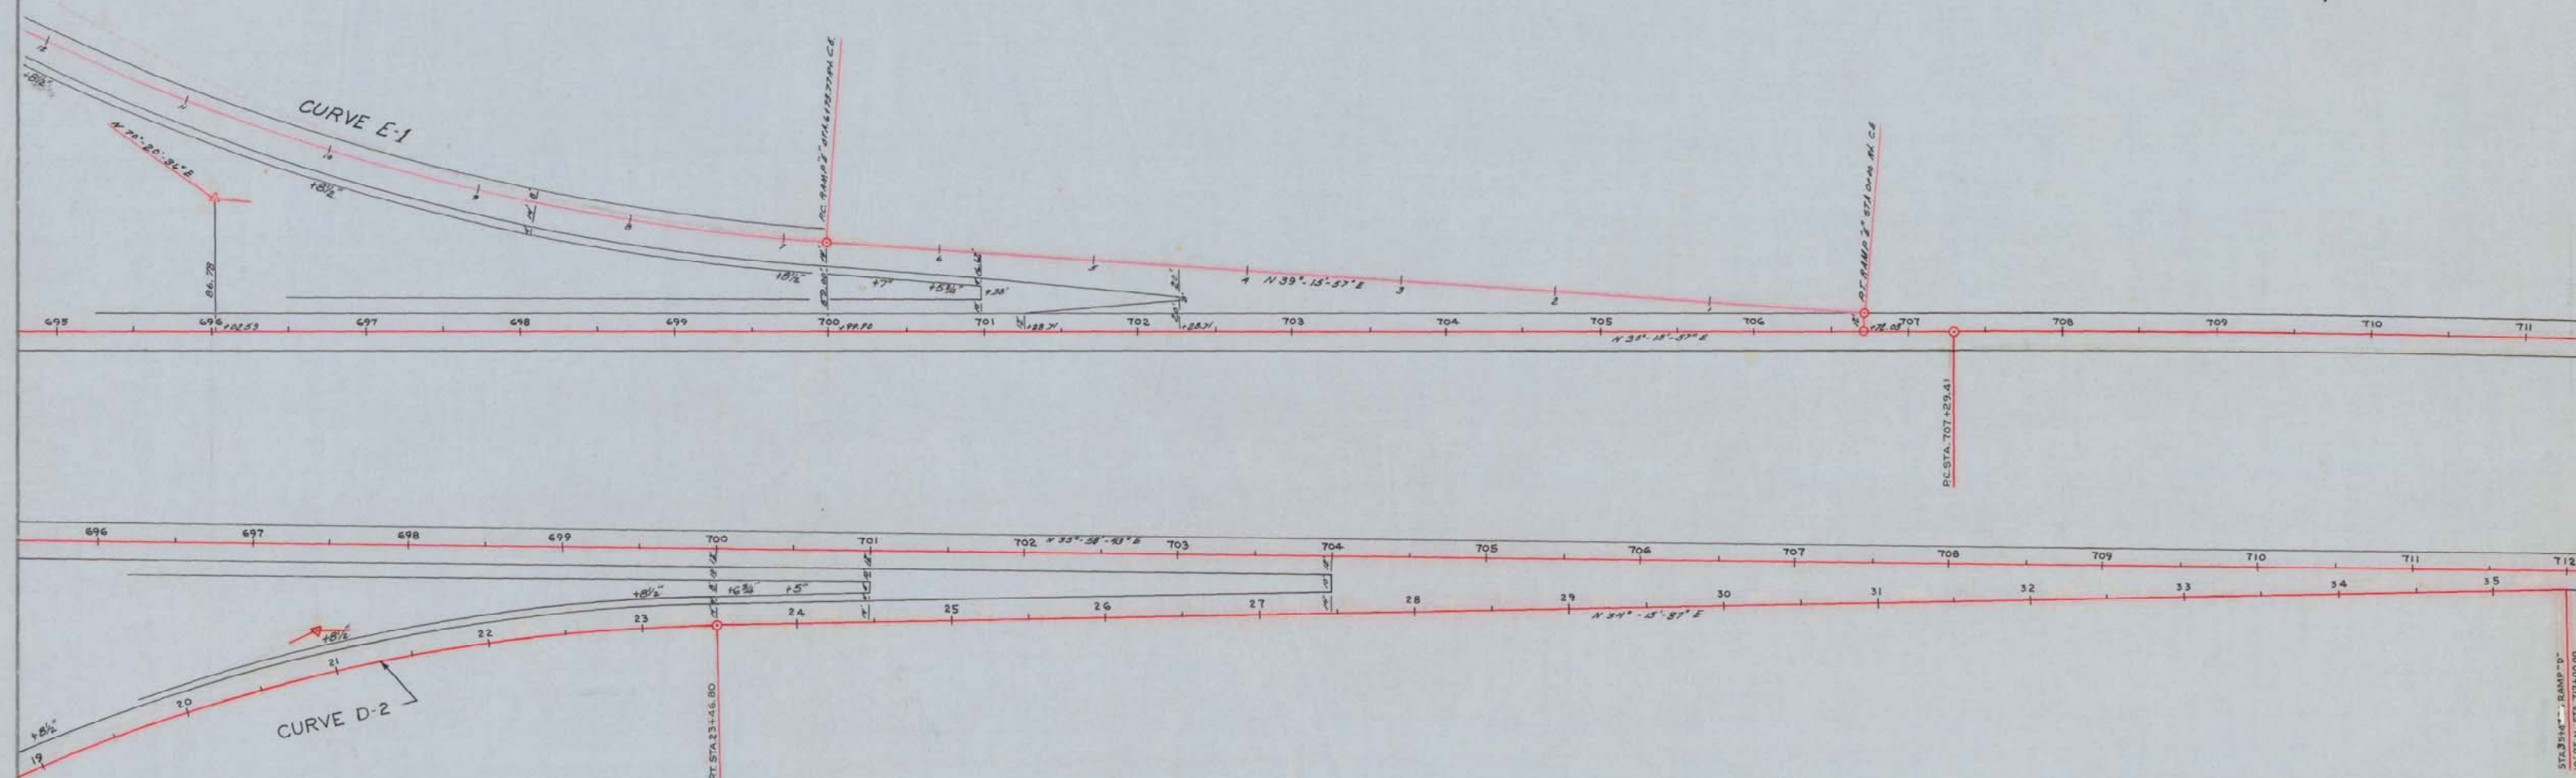


N. F. R. REG. NO.	STATE	PROJECT NUMBER	SHEET NO.	SHEET COUNT
1	MAINE	I-95-5(11)	43	2

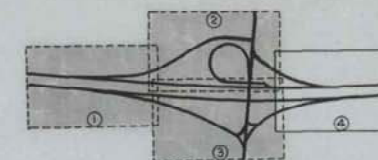

CURVE D-2
 $\Delta = 25^{\circ}-25'-14''$ RT
 $D = 5^{\circ}-00'$
 $T = 258.46'$
 $L = 508.41'$
 $R = 1145.92'$

CURVE E-1
 $\Delta = 31^{\circ} - 04' - 23''$ RT.
 $D = 4^{\circ} - 00'$
 $T = 396.28'$
 $L = 776.99'$
 $R = 1432.40'$

RTE. 196 INTERCHANGE
GEOMETRICS

Scale: 1" = 50'

"Revised As Built" by Gary Inouell 5-15-76

I-95-S(11)75 TOPHAM