


3" HOT BITUMINOUS PAVEMENT

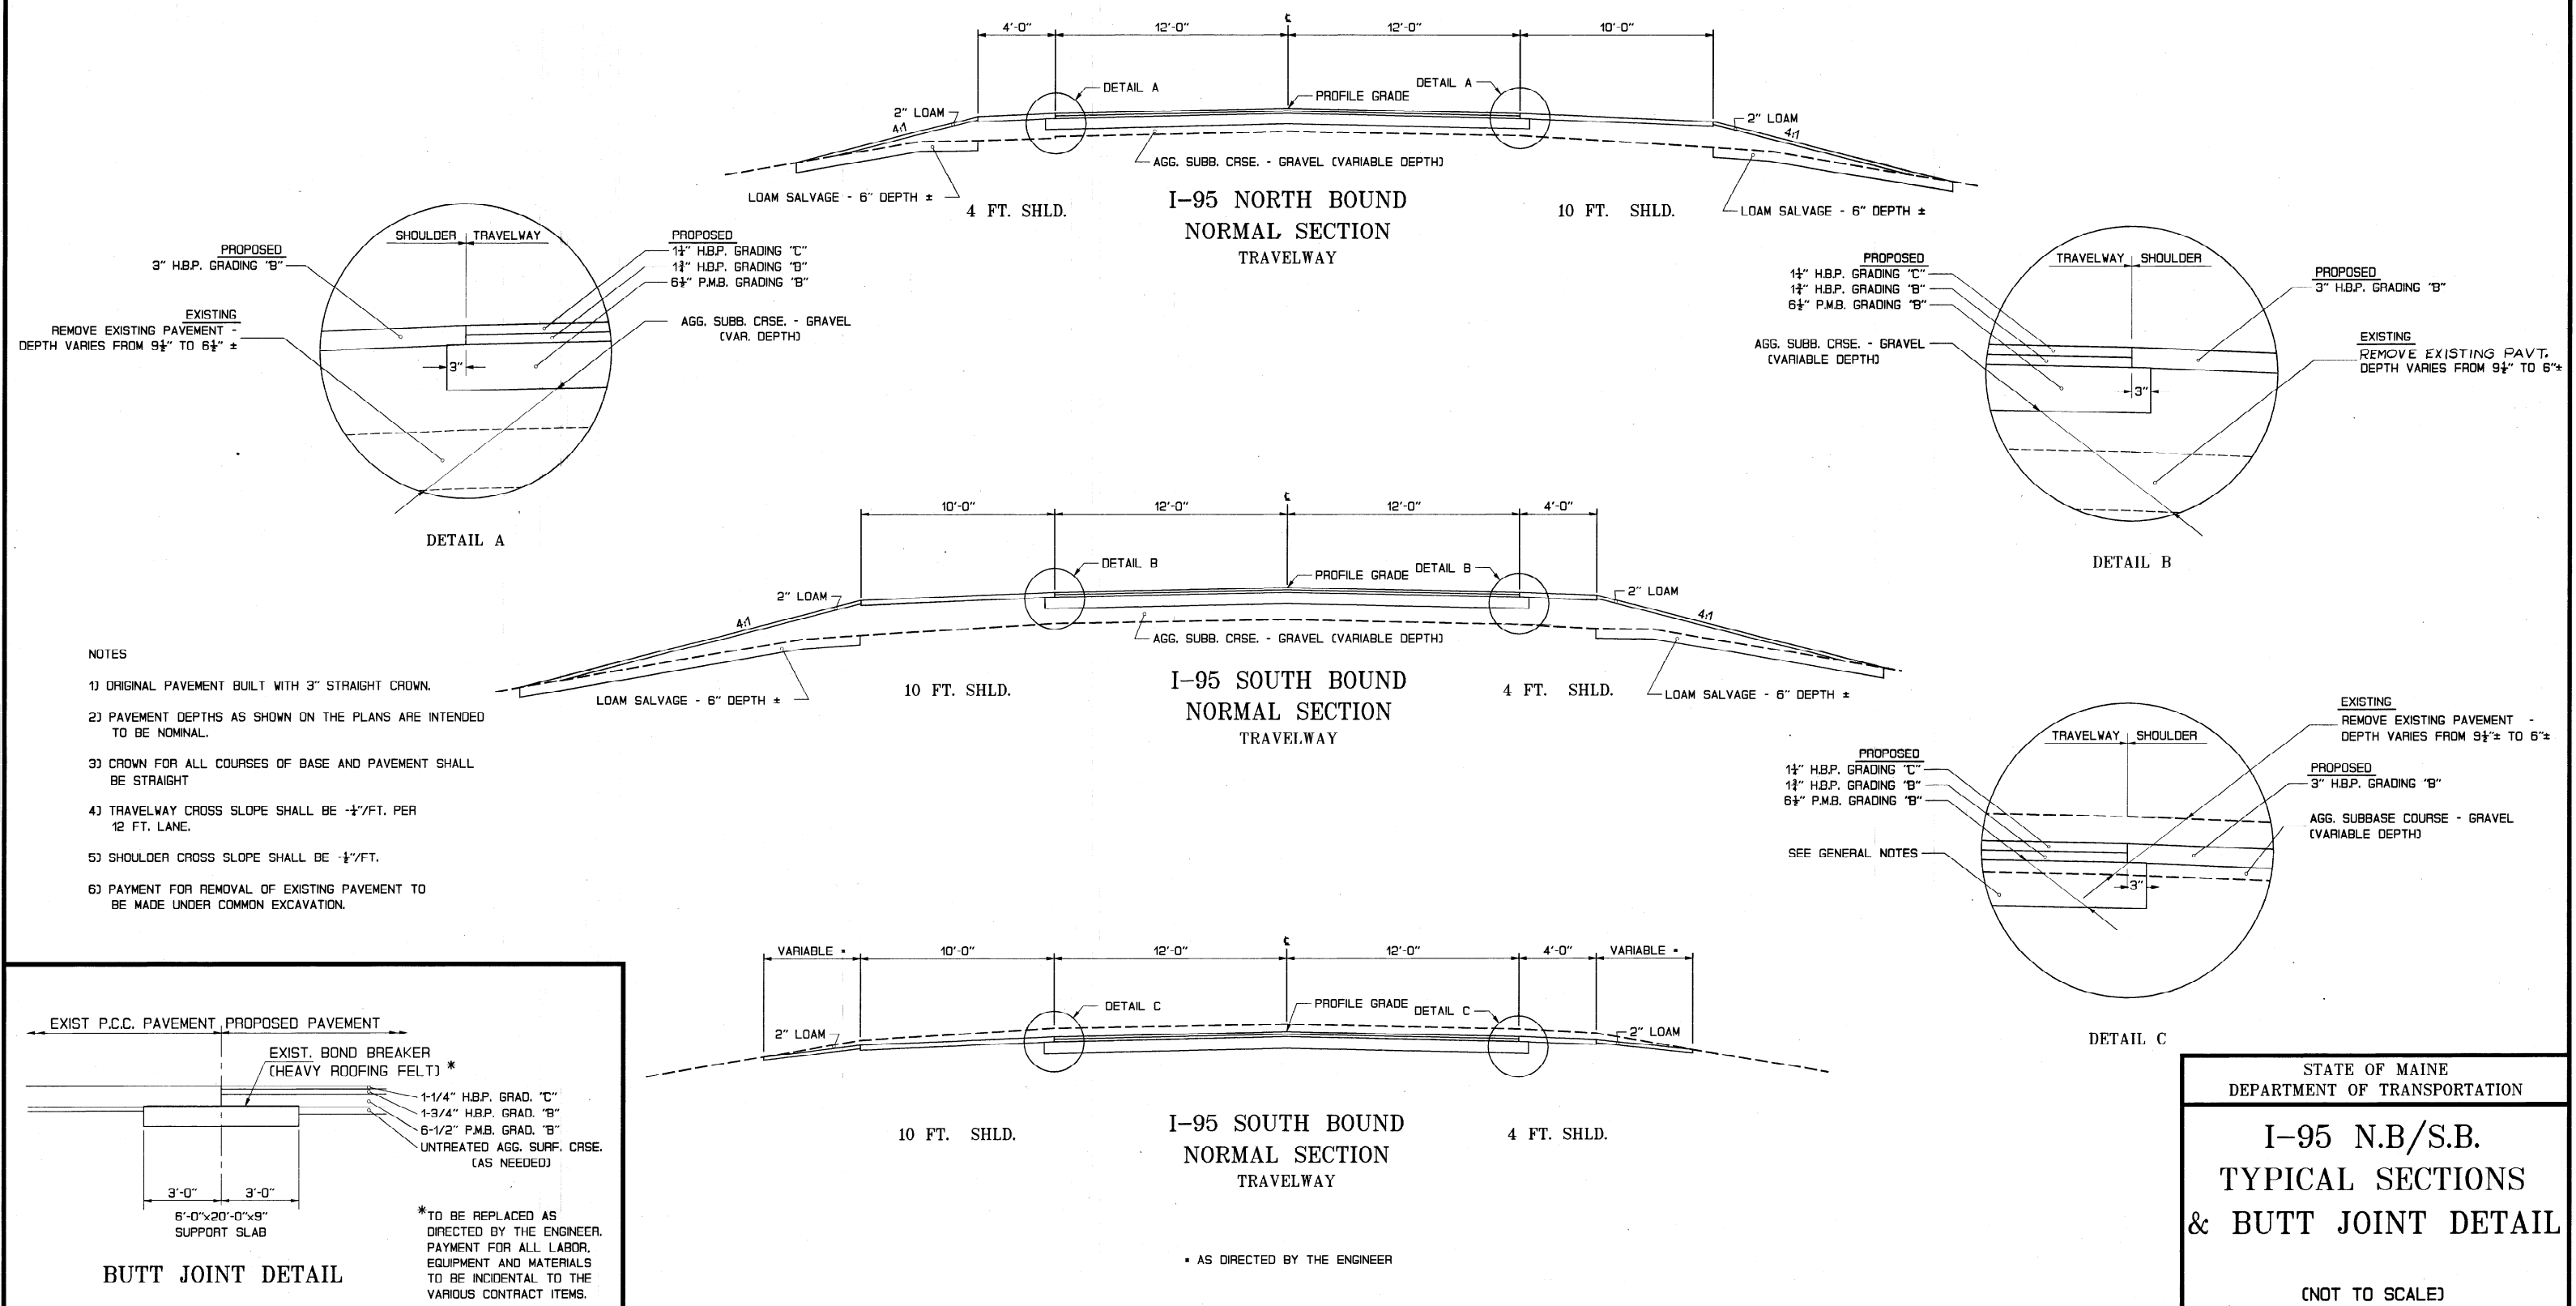

DATE 2/92
D.P.B. J.M.G.T.
DESIGN-DETAILED
CHECKED
REVISIONS
FIELD CHANGES
PLANS

As Built 1992 RSB 3/93