




STAGE CONSTRUCTION-GRADING & SUBBASE

S. F. S.	STATE	PROJECT NUMBER	SHEET	TOTAL
NO. 1	MAINE	I-95-4(25)	4	173





- 4" AGGREGATE BASE COURSE-CRUSHED
- 9" AGGREGATE SUBBASE COURSE-GRAVEL
- 1" POLYSTYRENE PLASTIC INSULATION
- 4" SELECT GRANULAR MATERIAL

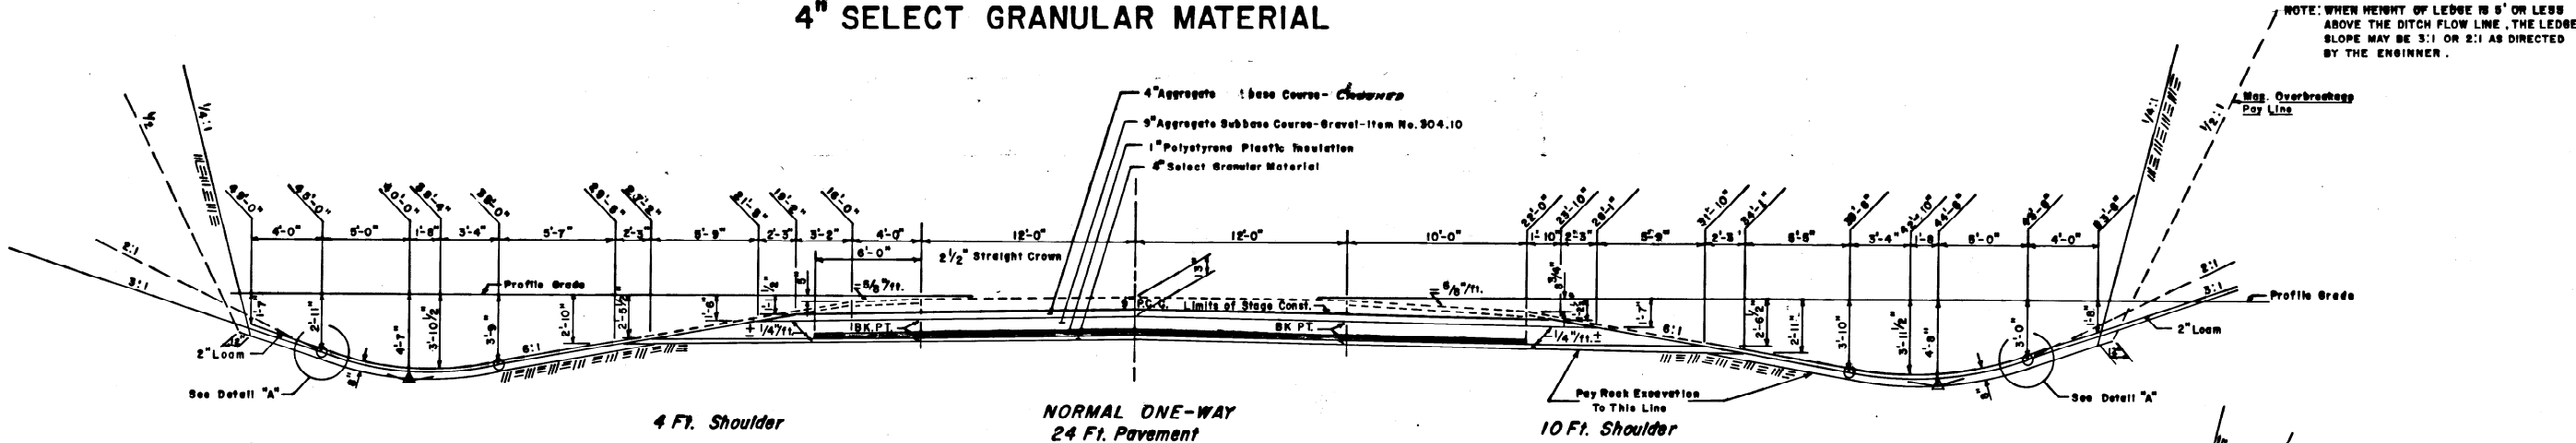

4" Aggr. Base Course-Crushed	= 10.10 Cu. Yds. Per 100 Lin. Ft.	4" Aggr. Base Course-Crushed	= 29.83 Cu. Yds. Per 100 Lin. Ft.	4" Aggr. Base Course-Crushed	= 15.87 Cu. Yds. Per 100 Lin. Ft.
9" Aggr. Sub Base Course-Gravel	= 36.05 Cu. Yds. Per 100 Lin. Ft.	9" Aggr. Sub Base Course-Gravel	= 66.67 Cu. Yds. Per 100 Lin. Ft.	9" Aggr. Sub Base Course-Gravel	= 49.41 Cu. Yds. Per 100 Lin. Ft.
4" Select Granular Material	= 19.89 Cu. Yds. Per 100 Lin. Ft.	4" Select Granular Material	= 29.83 Cu. Yds. Per 100 Lin. Ft.	4" Select Granular Material	= 28.67 Cu. Yds. Per 100 Lin. Ft.

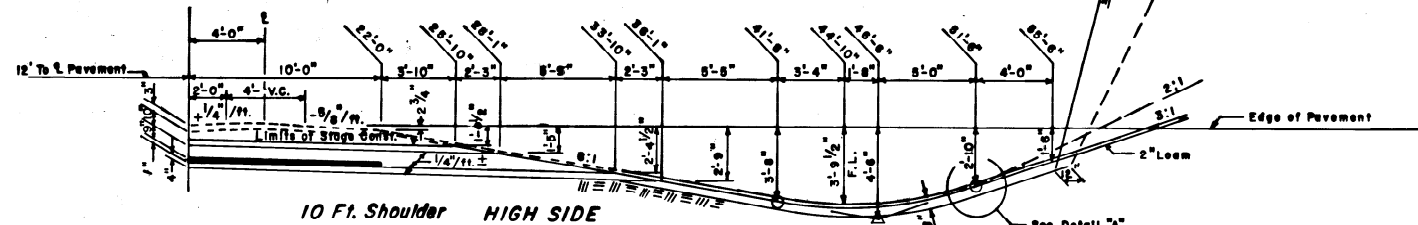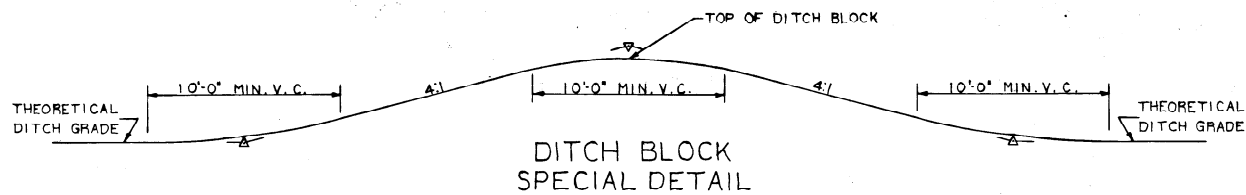

4" Aggr. Base Course-Crushed	= 78.32 Cu. Yds. Per 100 Lin. Ft.
9" Aggr. Sub Base Course-Gravel	= 88.80 Cu. Yds. Per 100 Lin. Ft.
4" Select Granular Material	= 28.12 Cu. Yds. Per 100 Lin. Ft.

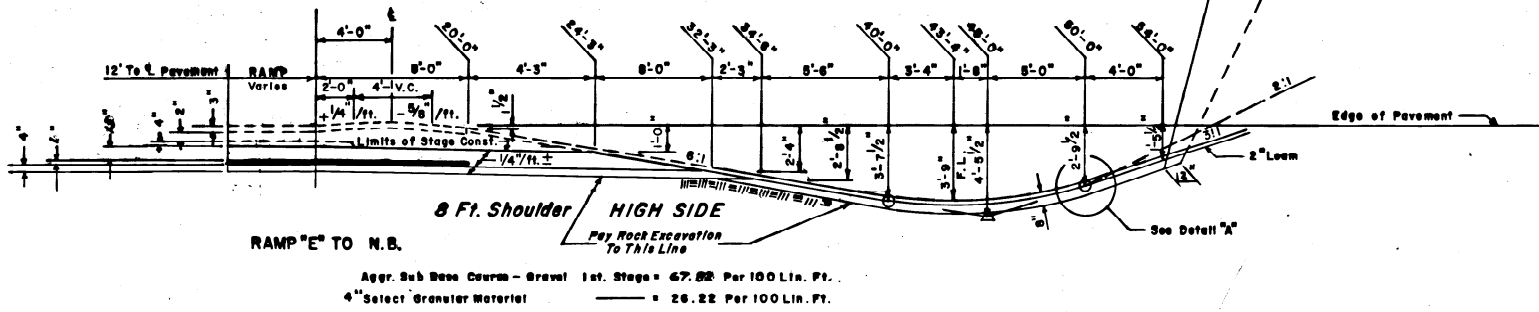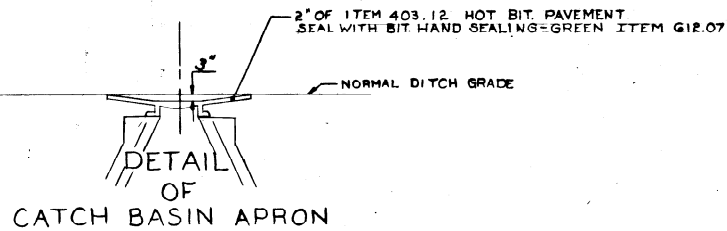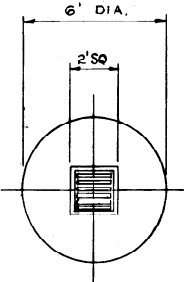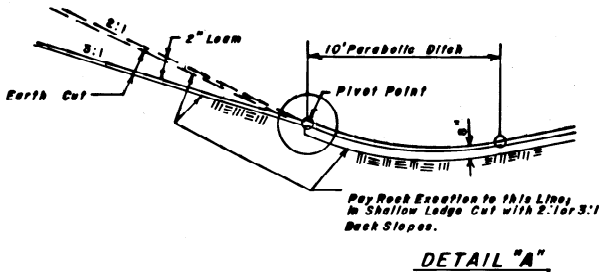

Aggr. Sub Base Course-Gravel	1st. Stage = 47.88 Per 100 Lin. Ft.
4" Select Granular Material	= 26.22 Per 100 Lin. Ft.

STATE HIGHWAY COMMISSION  
1" POLYSTYRENE PLASTIC INSULATION  
TYPICAL SECTIONS  
I-95 N.B. STA. 569+00 TO  
N.B. STA. 582+00  
CATCH BASIN APRON DETAIL  
SHEET OF AUGUSTA, MAINE

SCALE 1"=5'

"Revised As Built" by Gary Trussell 4-16-75

BRUNSWICK I-95-4(25)

DATE	BY	DESIGN - DETAILED	CHECKED	REVISIONS	FIELD CHANGES
3-20-70	CHM				
3-27-70	CHM				

PLANS