

STATE OF MAINE DEPARTMENT OF TRANSPORTATION



BUREAU OF HIGHWAYS TOWNS OF BOWDOINHAM - RICHMOND COUNTY - SAGADAHOC MAINE FEDERAL AID INTERSTATE PROJECT NO. 1-95-5(37)86 LENGTH 2.898 MILES

ON MICROFILM Reel #187

CONVENTIONAL SIGNS


COUNTY LINES	=====	TRAVELLED WAY - PROPOSED	=====
TOWN LINES	=====	UNDERGROUND UTILITIES - EXISTING	-----
PROPERTY LINES	=====	UNDERGROUND UTILITIES - PROPOSED	-----
R/W LINES - EXISTING	=====	RAILROAD - SINGLE TRACK	=====
R/W LINES - NEW - ACCESS CONTROL	=====	RAILROAD - DOUBLE TRACK	=====
R/W LINES - NEW - NO ACCESS CONTROL	=====	UTILITY POLE - EXISTING	+
CULVERT - EXISTING	=====	UTILITY POLE - JOINT OCCUPANCY	+
CULVERT - PROPOSED	=====	PROPOSED UTILITY POLE - TEMPORARY	x
CURBING - EXISTING	=====	PROPOSED UTILITY POLE - PERMANENT	x
CURBING - PROPOSED	=====	TREES	hardwood softwood
TRAVELLED WAY - EXISTING	=====	WOODS	=====

INDEX OF SHEETS

TITLE SHEET	1
TYPICAL SECTIONS	2-4
ESTIMATED QUANTITIES	5
DRAINAGE SHEET	6
STANDARD DETAILS	7-15
BRIDGE SHEETS	16-21
SOILS SHEETS	22-23
GENERAL NOTES	24
PLAN SHEETS - MAIN LINE	25-30
RAMP PROFILES A, B, C AND D	31-34
PLAN SHEETS ROUTE NO. 197	35-37
GEOMETRIC SHEETS	38-39
CROSS SECTIONS N.B.	40-87
CROSS SECTIONS S.B.	88-121
CROSS SECTIONS RAMP 'A'	122-125
CROSS SECTIONS RAMP 'B'	126-131
CROSS SECTIONS RAMP 'C'	132-136
CROSS SECTIONS RAMP 'D'	137-142
CROSS SECTIONS ROUTE NO. 197	143-155

Drainage Design Changes. 7 other sheets added 4/15/1975

A GRADING, DRAINAGE AND BASE PROJECT

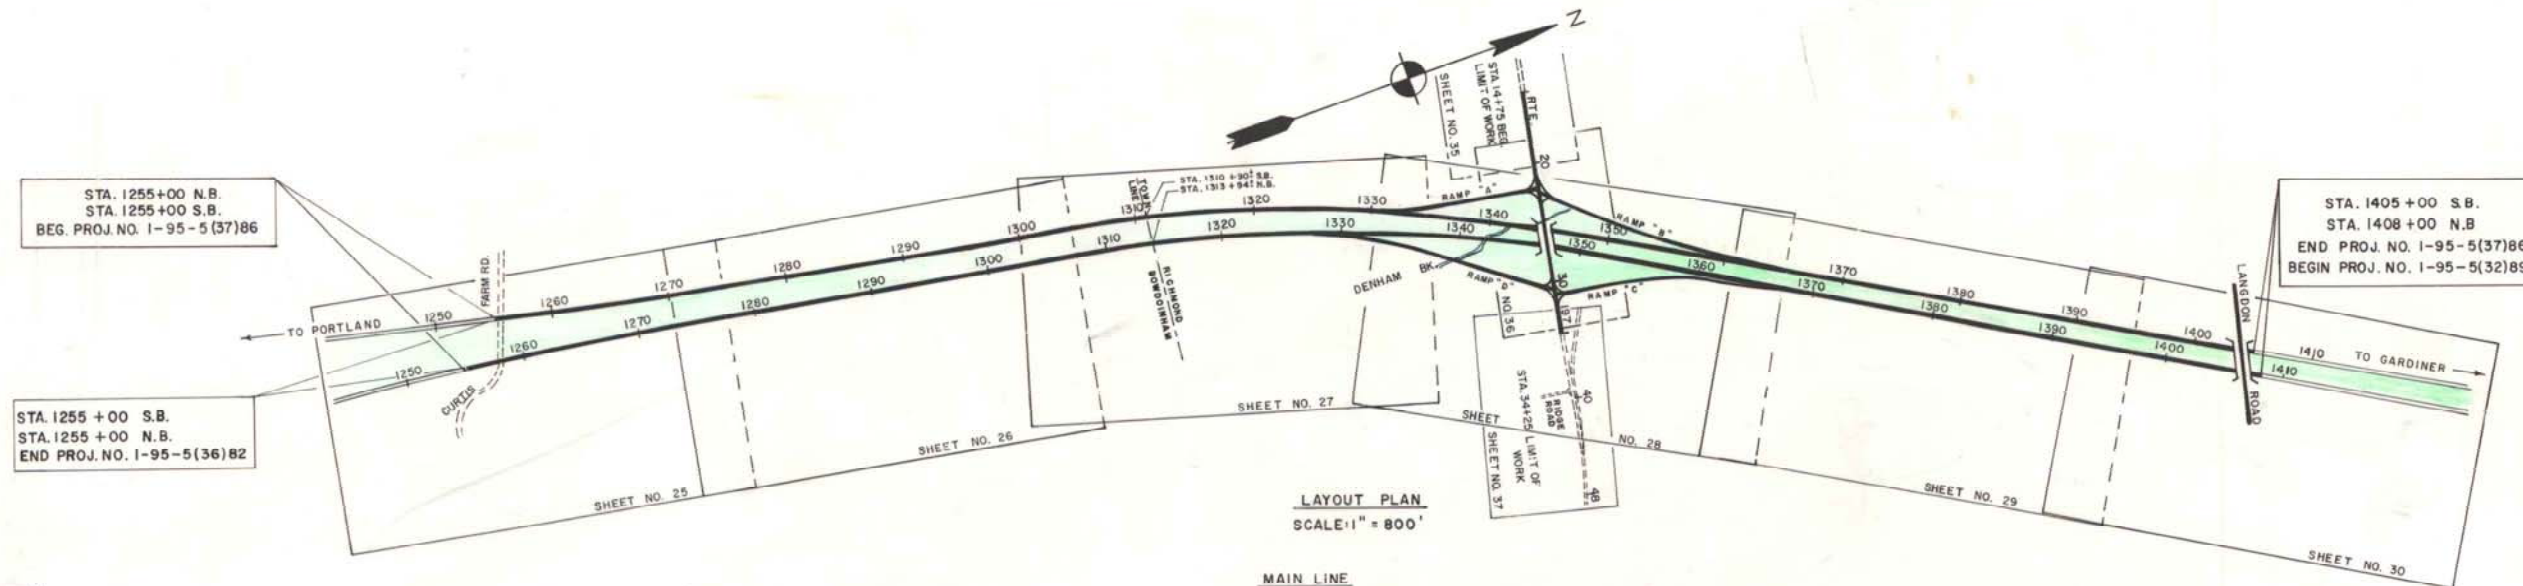


LAYOUT PLAN
SCALE: 1" = 800'

MAIN LINE
SCALE: PLANS - 1" = 100'
PROFILES - 1" = 100' HORIZ.
1" = 10' VERT.
CROSS SECTIONS - 1" = 10' HORIZ.
1" = 10' VERT.

RELOC RTE 197
SCALE: PLANS - 1" = 50' HORIZ.
PROFILES - 1" = 5' VERT.
1" = 50' HORIZ.
CROSS SECTIONS - 1" = 5' VERT.
1" = 5' HORIZ.

AS BUILT PLANS
OCT. 1975
LL ROULIN

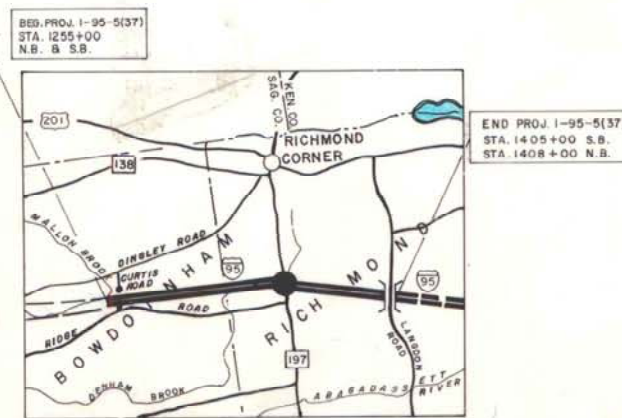

LOCATION MAP

A PORTION OF SAGADAHOC COUNTY

SCALE: 1" = 1 MILE

TRAFFIC DATA	ROUTE 197
A.D.T. 1974-19390	1620
A.D.T. 1994-19390	2540
D.H.V.	2521
T. (%) (DESIGN HOUR) 10 %	8 %
D. (%)	60 %
V.	70 mph
P.S.D. (%)	N/A
18 KIPS	952

NOTE:
ALL WORK CONTEMPLATED UNDER THIS CONTRACT SHALL BE GOVERNED BY AND IN CONFORMITY WITH THE STANDARD SPECIFICATIONS (REVISION OF 1968) AND SUPPLEMENTS THERETO, EXCEPT AS MODIFIED ON THE PLANS AND IN THE SPECIAL PROVISIONS.

APPROVED:

STATE OF MAINE
DEPARTMENT OF TRANSPORTATION
COMMISSIONER

DATE

DATE DEC. 5, 1973

CHIEF ENGINEER AND BUREAU DIRECTOR

DATE DEC. 5, 1973

UNITED STATES
DEPARTMENT OF TRANSPORTATION
FEDERAL HIGHWAY ADMINISTRATION
REGION 1

APPROVED:

DIVISION ENGINEER DATE