



DATE  
BY  
CHECKED  
APPROVED  
DATE  
BY

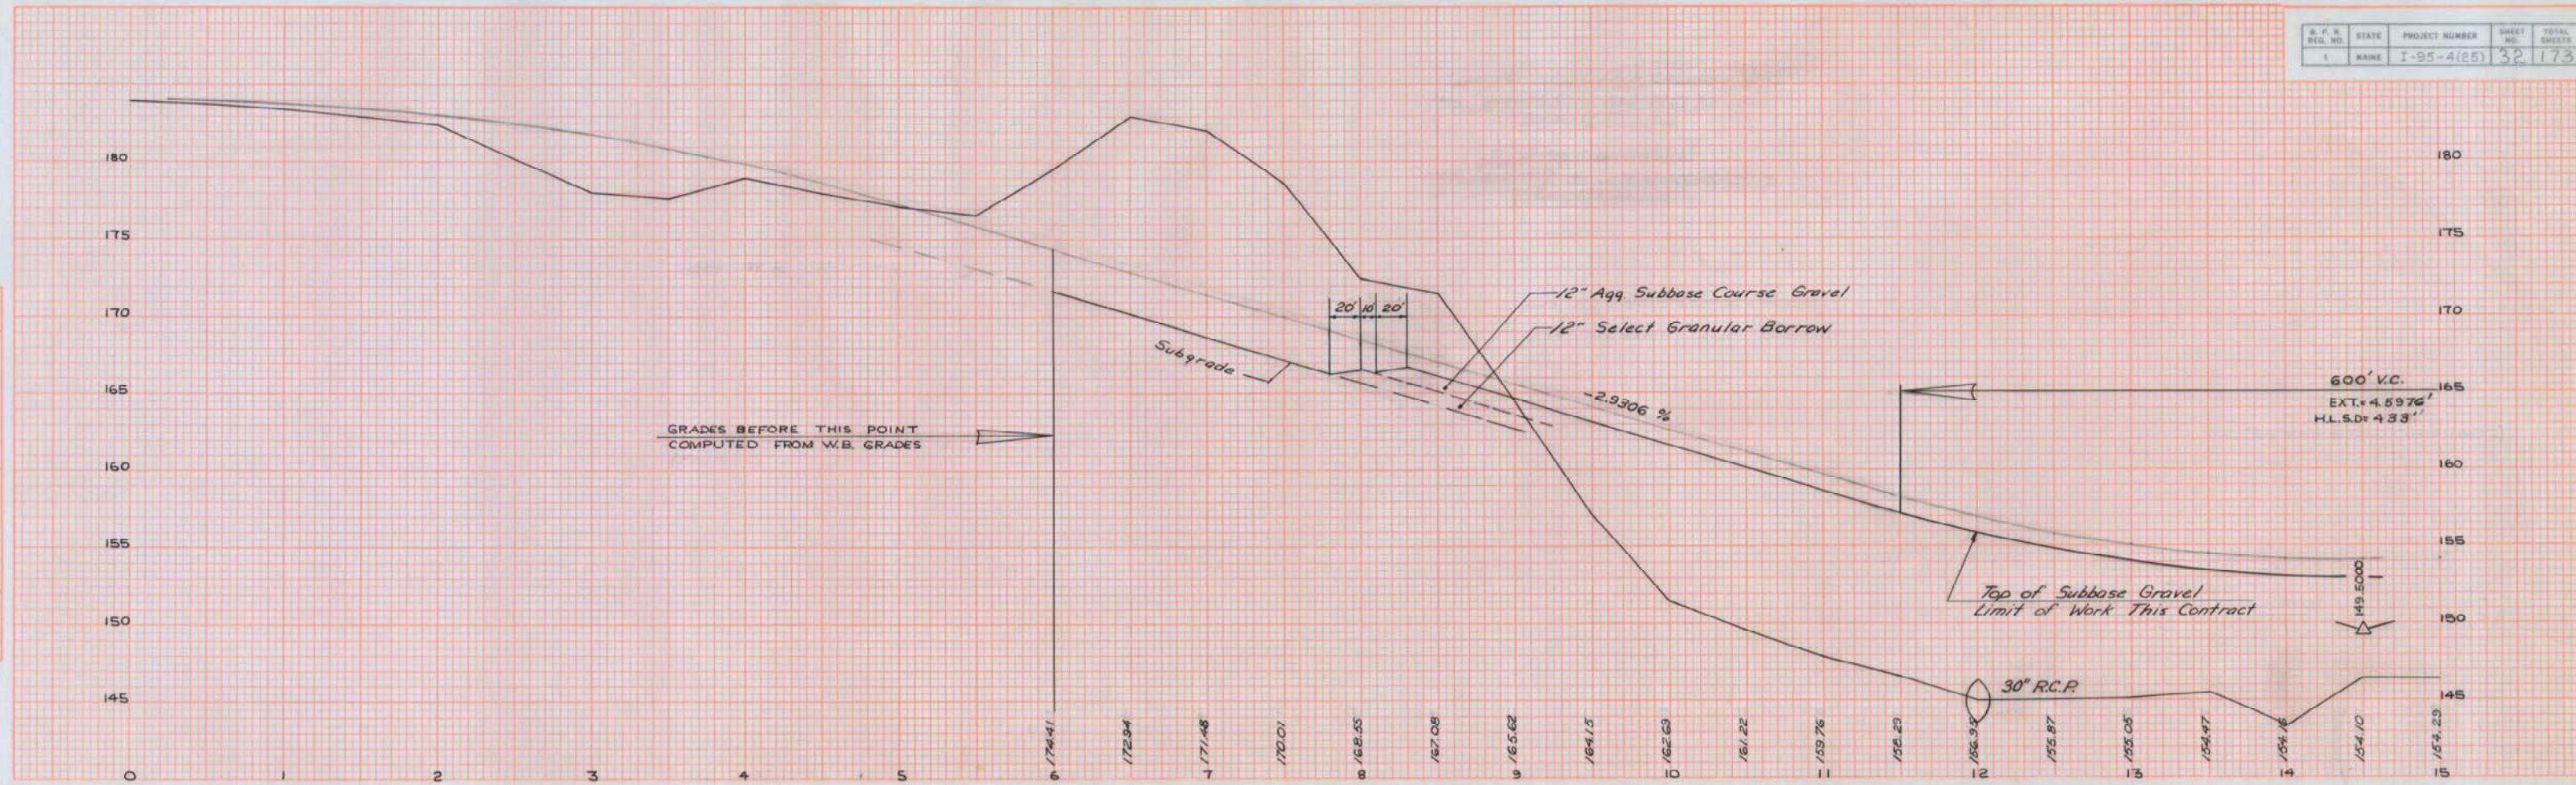

DATE  
BY  
CHECKED  
APPROVED  
DATE  
BY

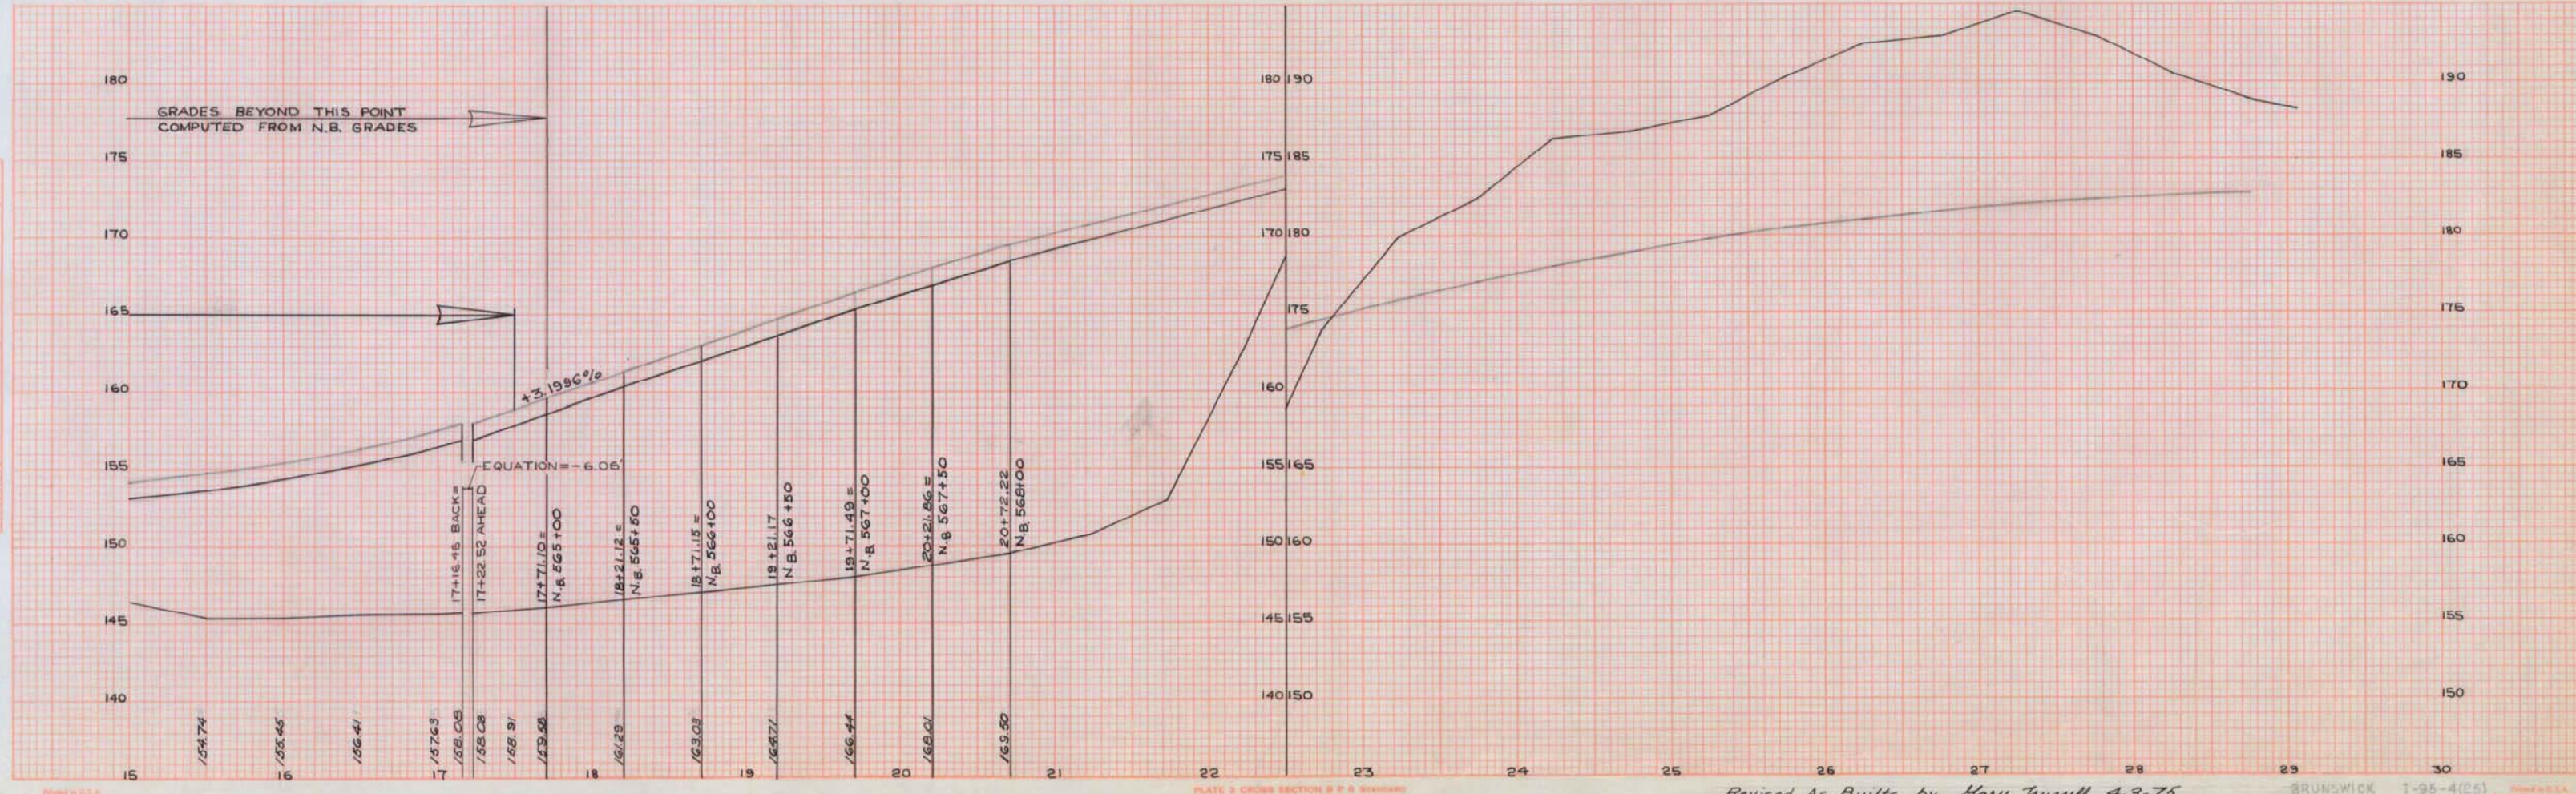

Revised As Built by Gary Jansell 4.3.75