

CHARLES E. MESERVE SR

U.S. GYPSUM Co.

NORTHBOUND
 R.I. STA. 882+01.68
 Δ: 129°-30'-50" LT.
 D: 0°-40'-00"
 T: 942.28'
 L: 1,877.06'
 R: 8,594.37'
 E: 51.50'

SOUTHBOUND
 R.I. STA. 883+33.20
 Δ: 139°-18'-35" LT.
 D: 1°-00'-00"
 T: 660.77'
 L: 1,331.51'
 R: 5,729.58'
 E: 38.90'

AS BUILT 1975

END PROJECT I-95-5(22)
 BEGIN PROJECT I-95-5(31)
 STA 883+00.5g

END PROJECT I-95-5(22)
 BEGIN PROJECT I-95-5(31)
 STA 883+00.5g

POND
 STA 889+50
 INST. 24" X 132" RCP CLASS III
 SKEWED AND 8° ON RT.
 STANDARD TREATMENT
 INLET & OUTLET RIPRAP & SOD

STA 890+00
 INST. 36" X 112" RCP CLASS III
 SKEWED AND 30° ON RT.
 STANDARD TREATMENT
 INLET & OUTLET RIPRAP & SOD

STA 891+00
 INST. 24" X 132" RCP CLASS III
 SKEWED AND 8° ON RT.
 STANDARD TREATMENT
 INLET & OUTLET RIPRAP & SOD

STA 894+50
 INST. 60" X 224" RCCMP
 SKEWED AND 15° ON RT.
 THE WALL THICKNESS SHALL BE 0.168
 STANDARD TREATMENT
 INLET & OUTLET RIPRAP & SOD


U.S. GYPSUM Co.

IVANCE WILLIAMS
 Ruby Williams

NORTHBOUND
 R.I. STA. 907+72.46
 Δ: 25°-10'-52" RT.
 D: 1°-15'
 T: 1,023.78'
 L: 2,016.49'
 R: 4,883.66'
 E: 112.94'

AS BUILT 1975

SOUTHBOUND
 R.I. STA. 907+66.32
 Δ: 27°-06'-50" RT.
 D: 1°-00'
 T: 1,381.57'
 L: 2,711.39'
 R: 5,729.58'
 E: 164.22'

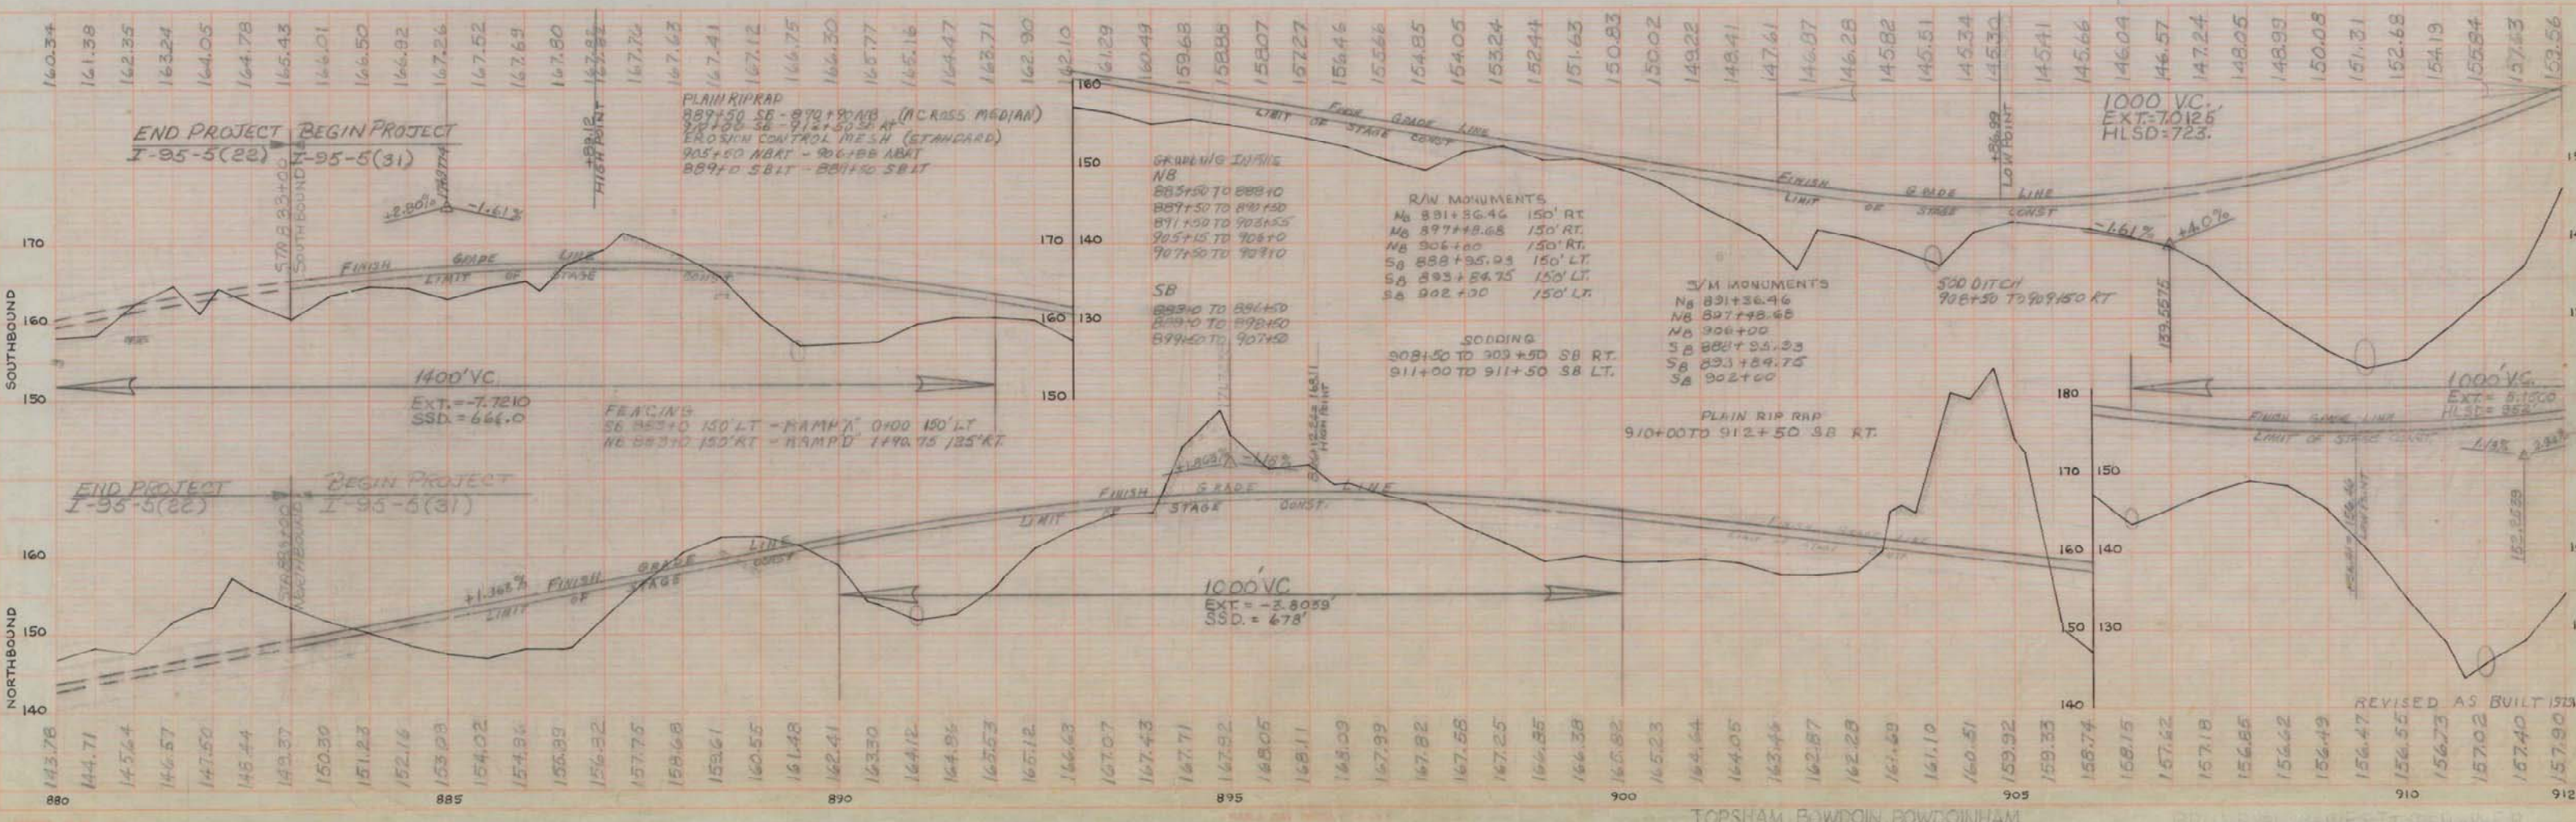

TOPSHAM, BOWDOIN, BOWDOINHAM

PROJ. BY R. L. WELLS, TOPSHAM, ME