
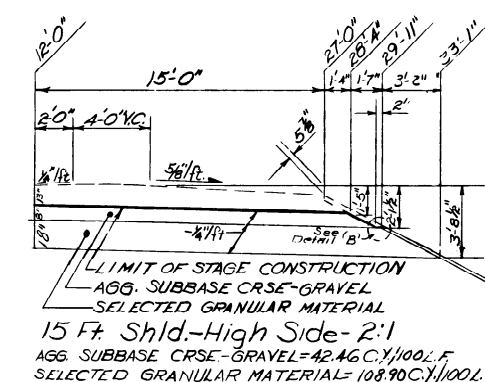
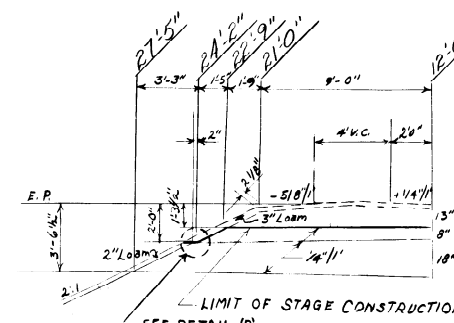
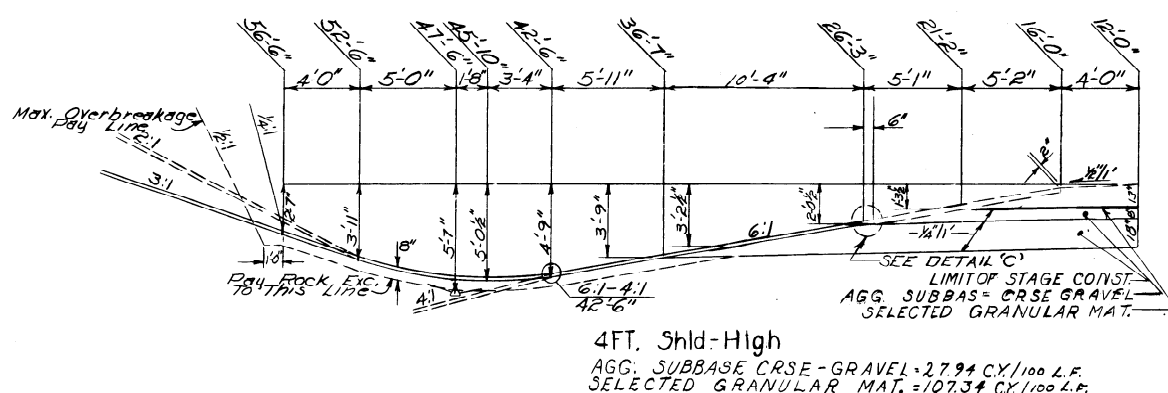
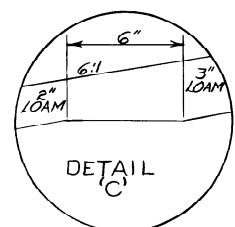
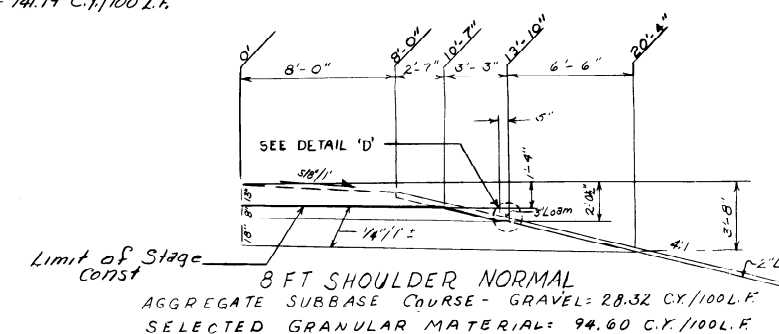
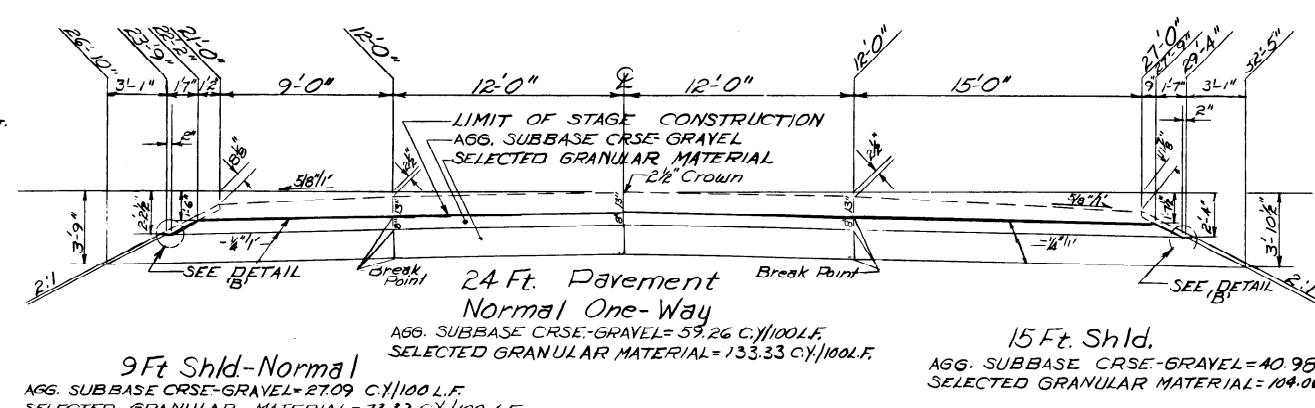
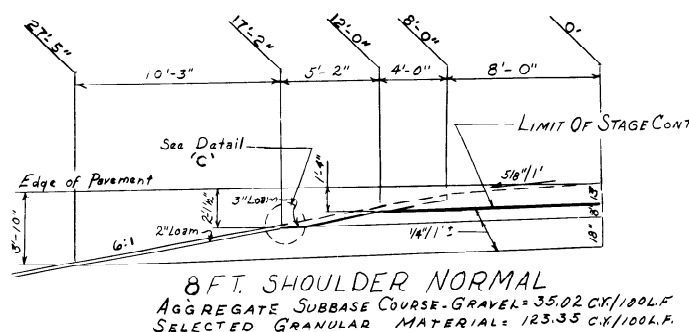
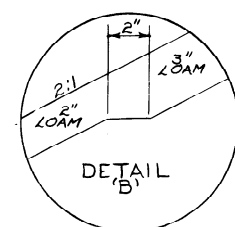
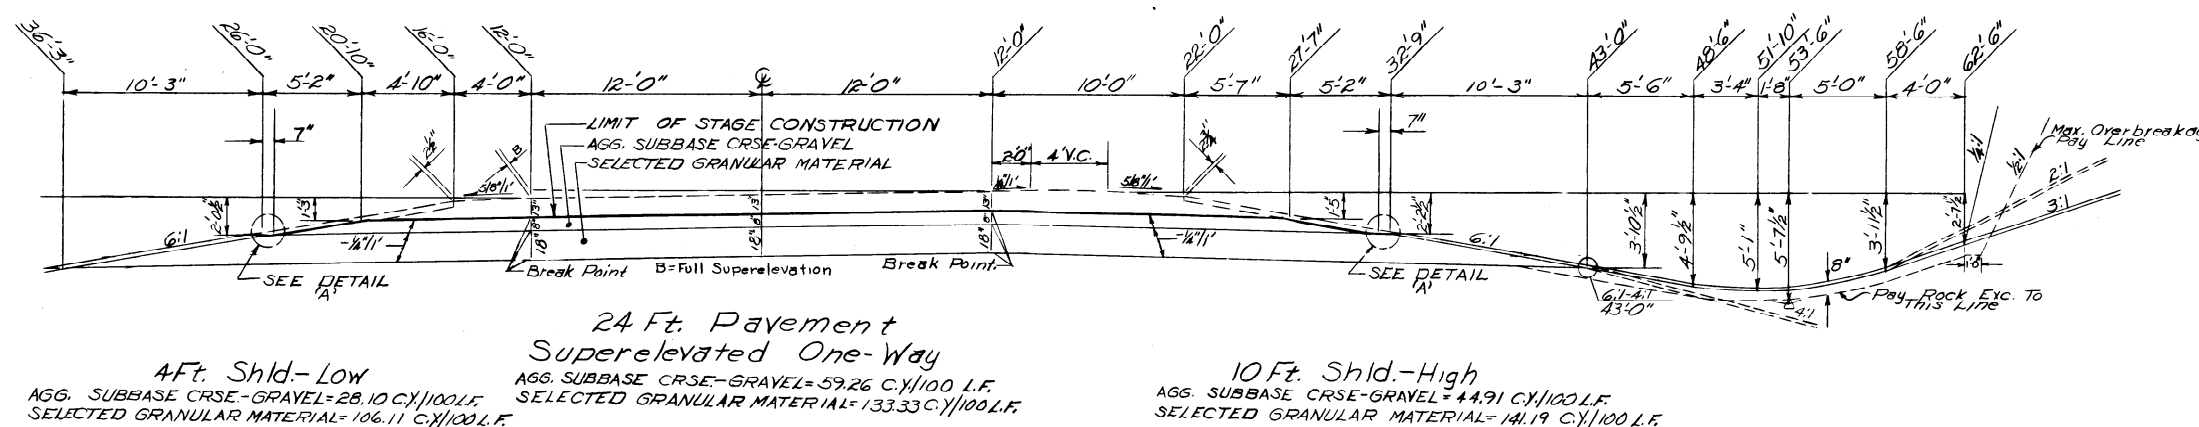
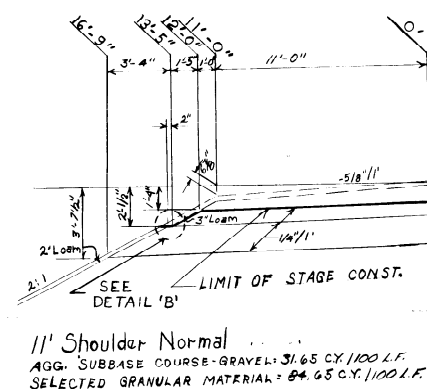
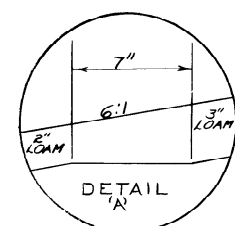
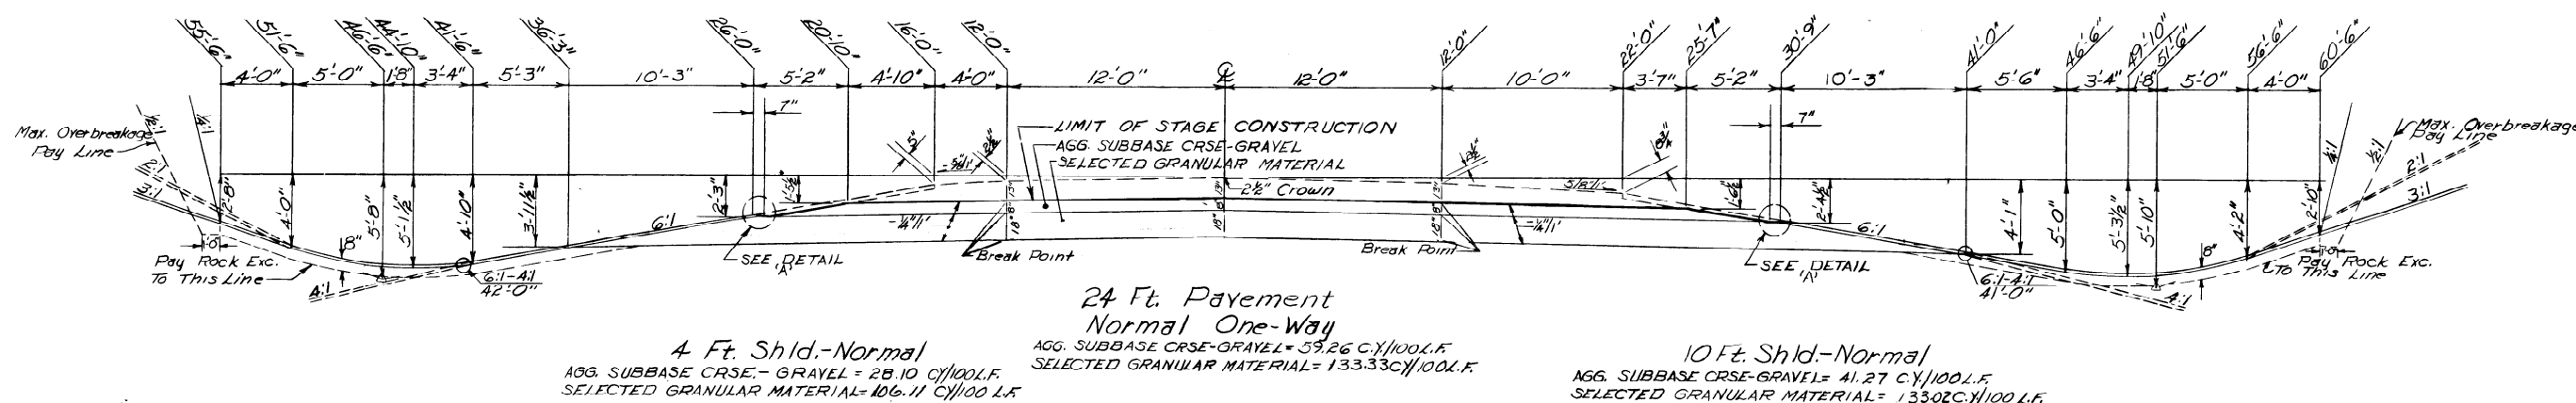


STAGE CONST.-GRADING & AGG. SUBBASE CRSE. GRAVEL*

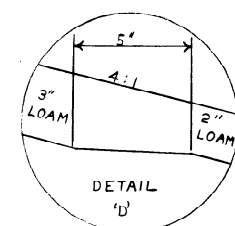

Revised AS BUILT *W.E. Kellogg 2/11/70*
DEPARTMENT OF TRANSPORTATION

TYPICAL SECTIONS
E 95

0' 1 2 3 4 5 10

SHEET OF AUGUSTA, MAINE

RICHMOND- GARDINER- W. GARDINER

* The pavement & base depths as shown on the plans are intended to be nominal.

| | | | |
|-------|-------------------|----------------|--------|
| PLANS | DESIGN - DETAILED | BY | DATE |
| | CHECKED | W. F. D. P. B. | 2/1/72 |
| | REVISIONS | G. R. J. | 2/1/72 |
| | FIELD CHANGES | | |