

BOWDOINHAM
RICHMOND
GARDINER

STATE OF MAINE DEPARTMENT OF TRANSPORTATION



BUREAU OF HIGHWAYS TOWNS OF BOWDOINHAM, RICHMOND & CITY OF GARDINER COUNTIES OF SAGadahoc AND KENNEBEC

MAINE FEDERAL AID INTERSTATE
PROJECT NO. 1-95-5 (44)81 CONTRACT 2
LENGTH 2.540 MILES

A PAVING PROJECT



Constructed 1977
SCALE: PLAN..... 1" = 100'
PROFILE..... HORIZ..... 1" = 100'
VERT..... 1" = 10' OR AS SHOWN

INDEX OF SHEETS

SHEET NO. 1	TITLE SHEET
" 2-3	TYPICAL SECTIONS - MAIN LINE
" 4-6	TYPICAL SECTIONS - RAMP
" 7	ESTIMATED QUANTITIES
" 8-16	STANDARD DETAILS - HIGHWAY
" 17-18	STANDARD DETAILS - BRIDGE
" 19	GENERAL NOTES & BRIDGE DETAILS
" 20-21	MISCELLANEOUS DETAILS
" 22	DETAILS FOR PORTLAND CEMENT CONCRETE PAVEMENT
" 23	GUARD RAIL ANCHORAGE
" 24-45	PLANS AND PROFILES - MAIN LINE
" 46-53	RAMP PROFILES

CONVENTIONAL SIGNS

COUNTY LINES	-----	TRAVELLED WAY - PROPOSED	=====
TOWN LINES	-----	UNDERGROUND UTILITIES - EXISTING	-----
PROPERTY LINES	-----	UNDERGROUND UTILITIES - PROPOSED	-----
R/W LINES - EXISTING	-----	RAILROAD - SINGLE TRACK	-----
R/W LINES - NEW - ACCESS CONTROL	-----	RAILROAD - DOUBLE TRACK	-----
R/W LINES - NEW - NO ACCESS CONTROL	-----	UTILITY POLE - EXISTING	-----
CULVERT - EXISTING	-----	UTILITY POLE - JOINT OCCUPANCY	-----
CULVERT - PROPOSED	-----	PROPOSED UTILITY POLE - TEMPORARY	-----
CURBING - EXISTING	-----	PROPOSED UTILITY POLE - PERMANENT	-----
CURBING - PROPOSED	-----	TREES	-----
TRAVELLED WAY - EXISTING	=====	WOODS	-----

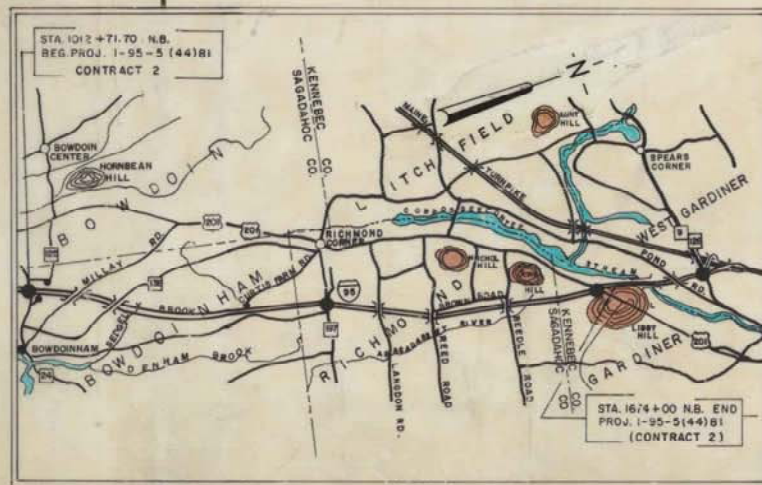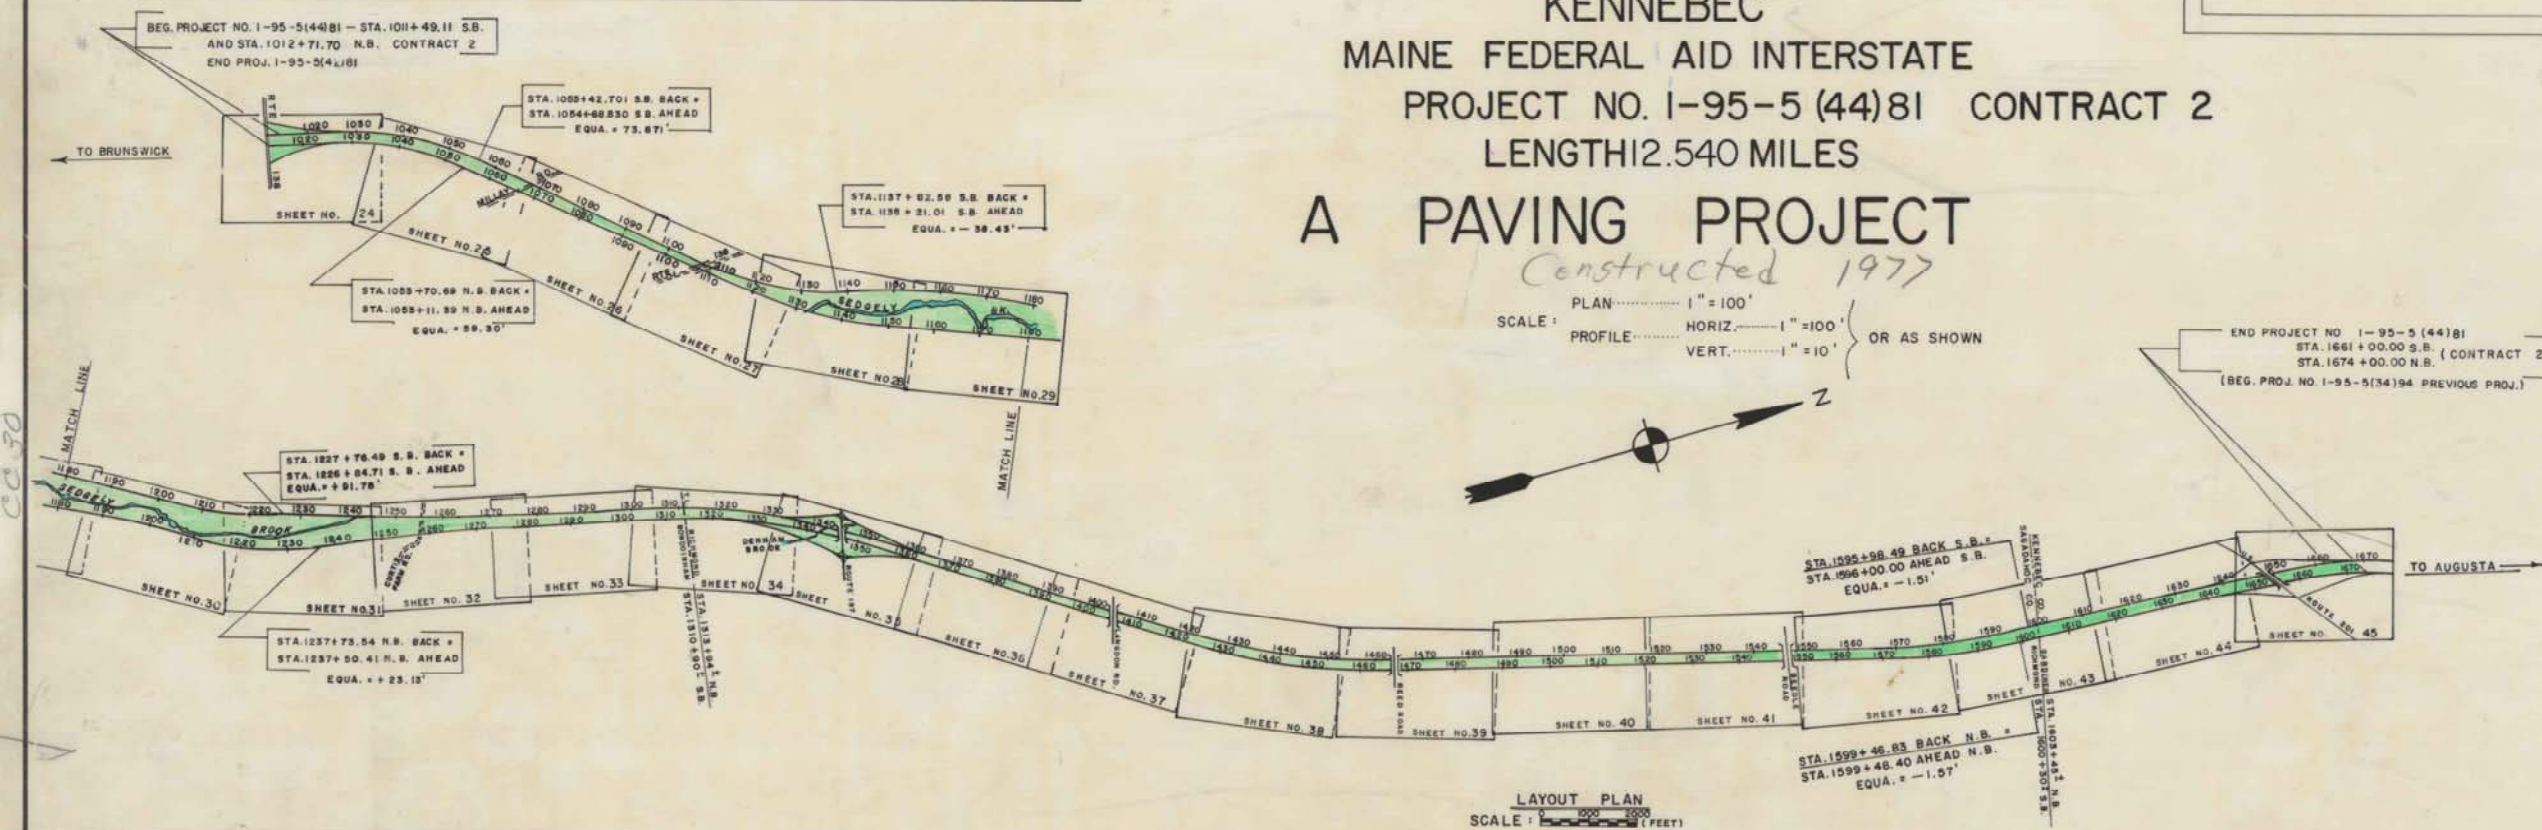

A PORTION OF KENNEBEC AND SAGADAHOC COUNTIES
Approx. Scale: 1" = 1 MILE

TRAFFIC DATA

A.D.T.	1976	11240
A.D.T.	1990	20340
D.H.V.		2644
T. (%)		11 %
D. (%)		80 %
V.		70 mph
P.S.D. (%)		N/A
18 KIPS		955 (RIGID)

NOTE:
ALL WORK CONTEMPLATED UNDER THIS CONTRACT SHALL BE GOVERNED BY AND IN CONFORMITY WITH THE STANDARD SPECIFICATIONS (REVISION OF 1968) AND SUPPLEMENTS THERETO, EXCEPT AS MODIFIED ON THE PLANS AND IN THE SPECIAL PROVISIONS.



APPROVED:

STATE OF MAINE
DEPARTMENT OF TRANSPORTATION

Richard A. Luetich
COMMISSIONER
Richard A. Luetich
CHIEF ENGINEER

DATE

MAY 6, 1975

MAY 6, 1975

REVIEWED AS BUILT *Richard A. Luetich*

UNITED STATES
DEPARTMENT OF TRANSPORTATION
FEDERAL HIGHWAY ADMINISTRATION
REGION 1

APPROVED:

DIVISION ENGINEER DATE