
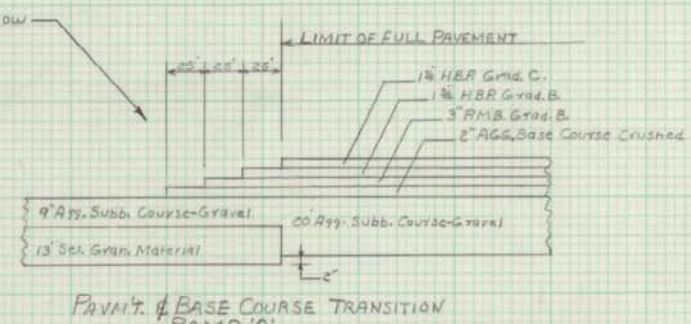
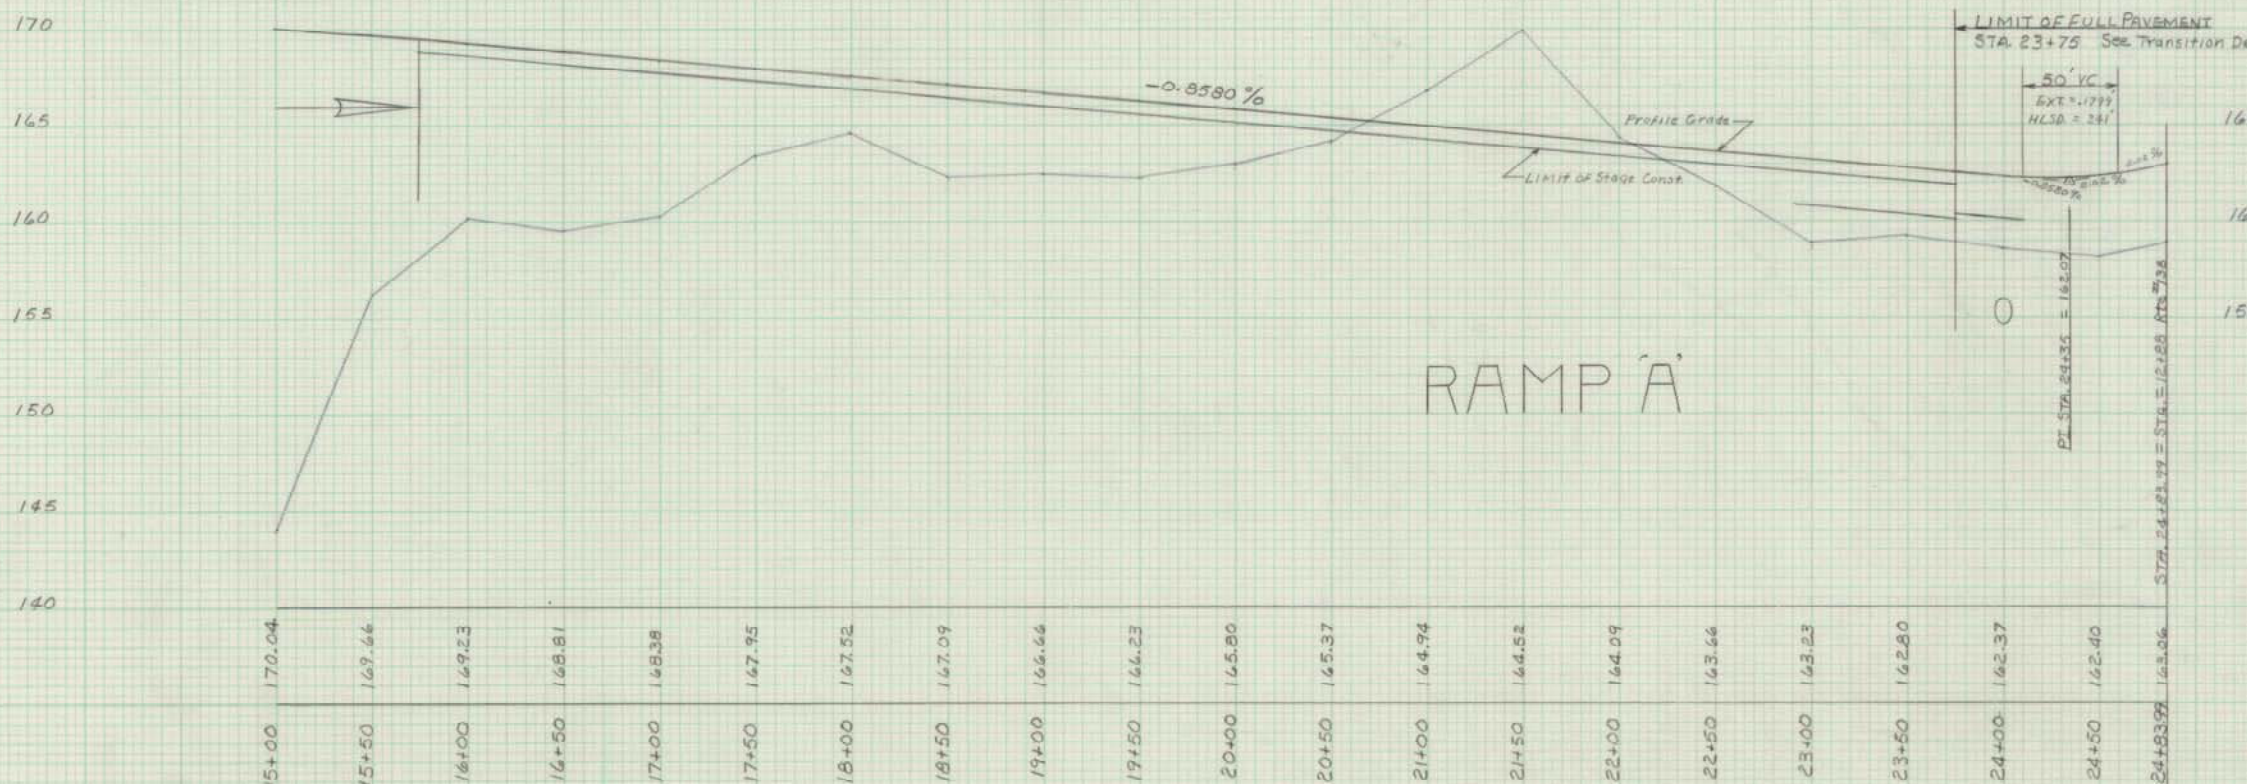


FINAL SURVEY	QUANTITY PLOTTED	DATE
NOTE BOOK	TEMPLATE	BY
NO.	AREA CHECKED	

ORIGINAL SURVEY	QUANTITY PLOTTED	DATE
NOTE BOOK	TEMPLATE	BY
NO.	AREA CHECKED	

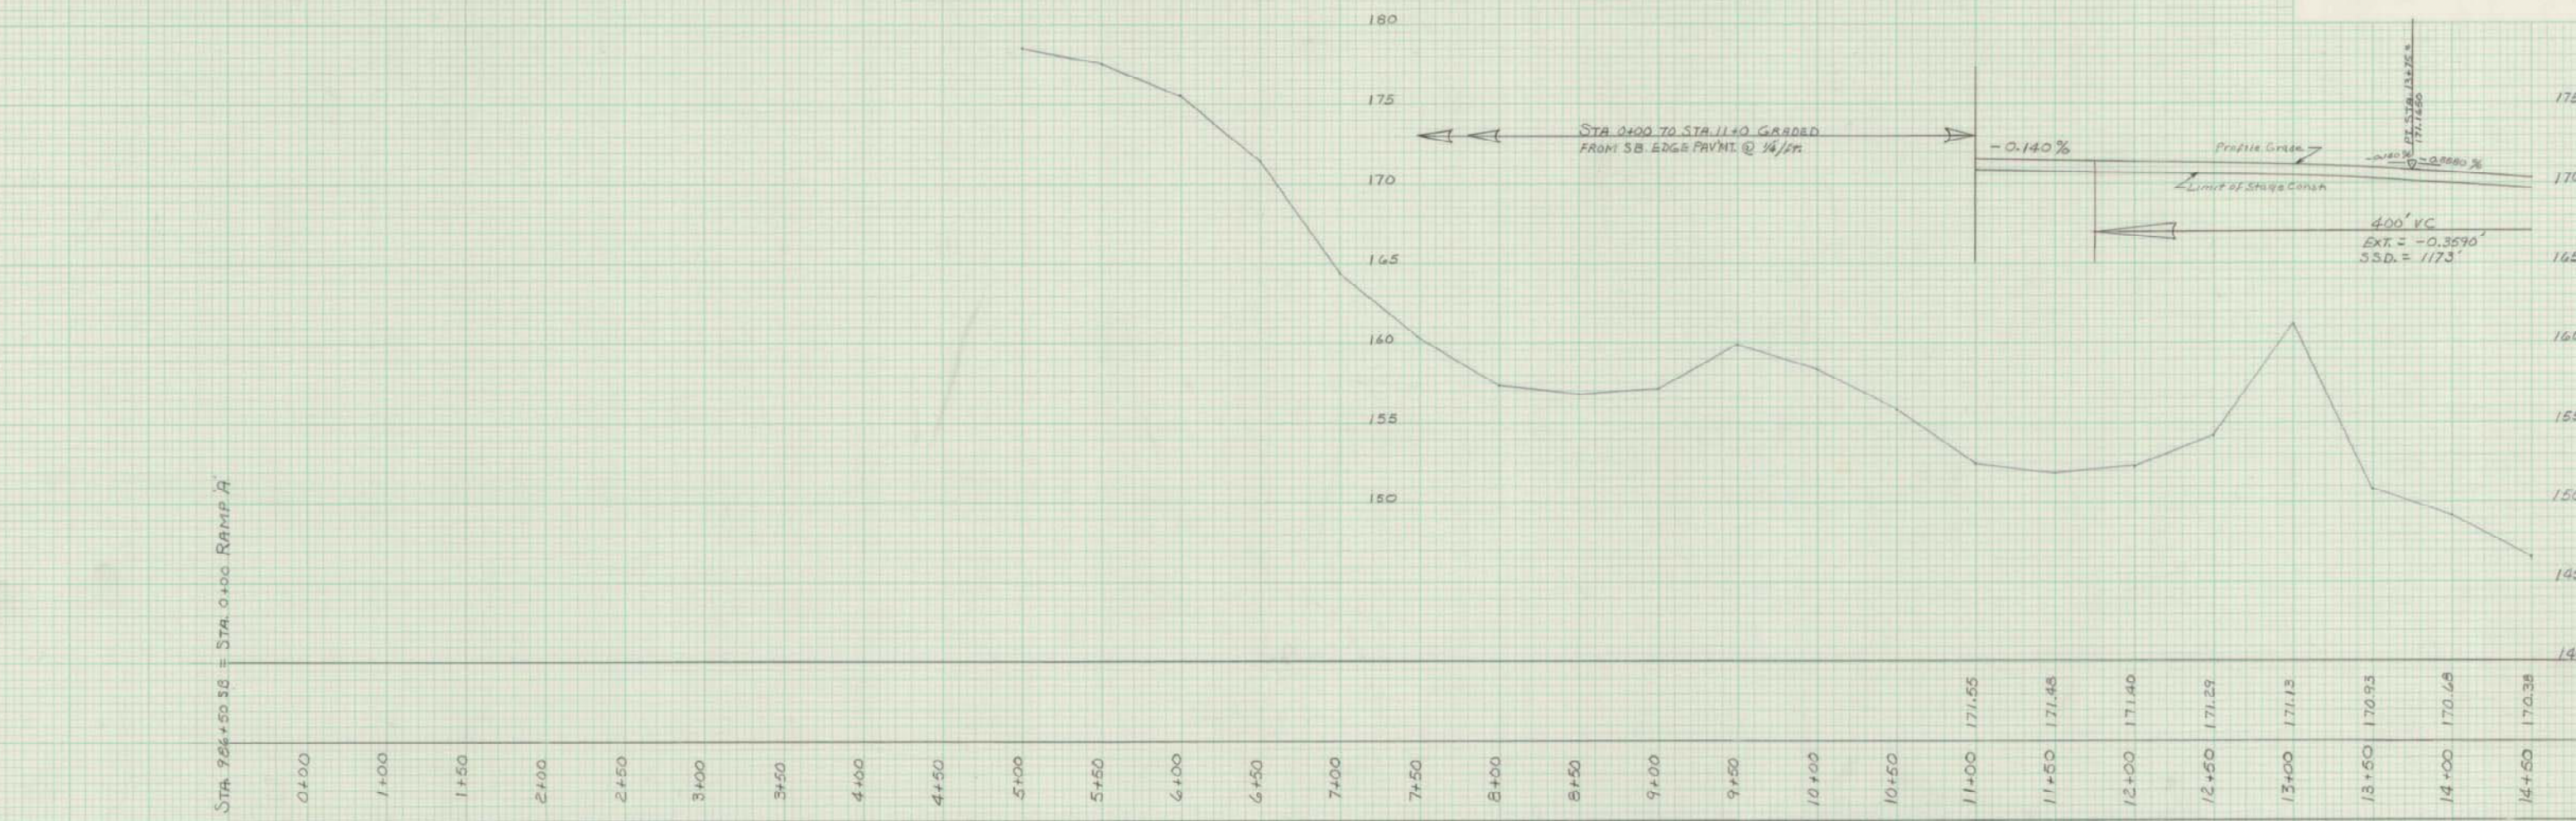

STATE OF MAINE  
DEPT. OF TRANS.  
PROFILE RAMP A  
AS BUILT 1975

TOPSHAM, BOWDOIN, BOWDOINHAM