


DATE	
BY	
REVISIONS	
1	AS BUILT

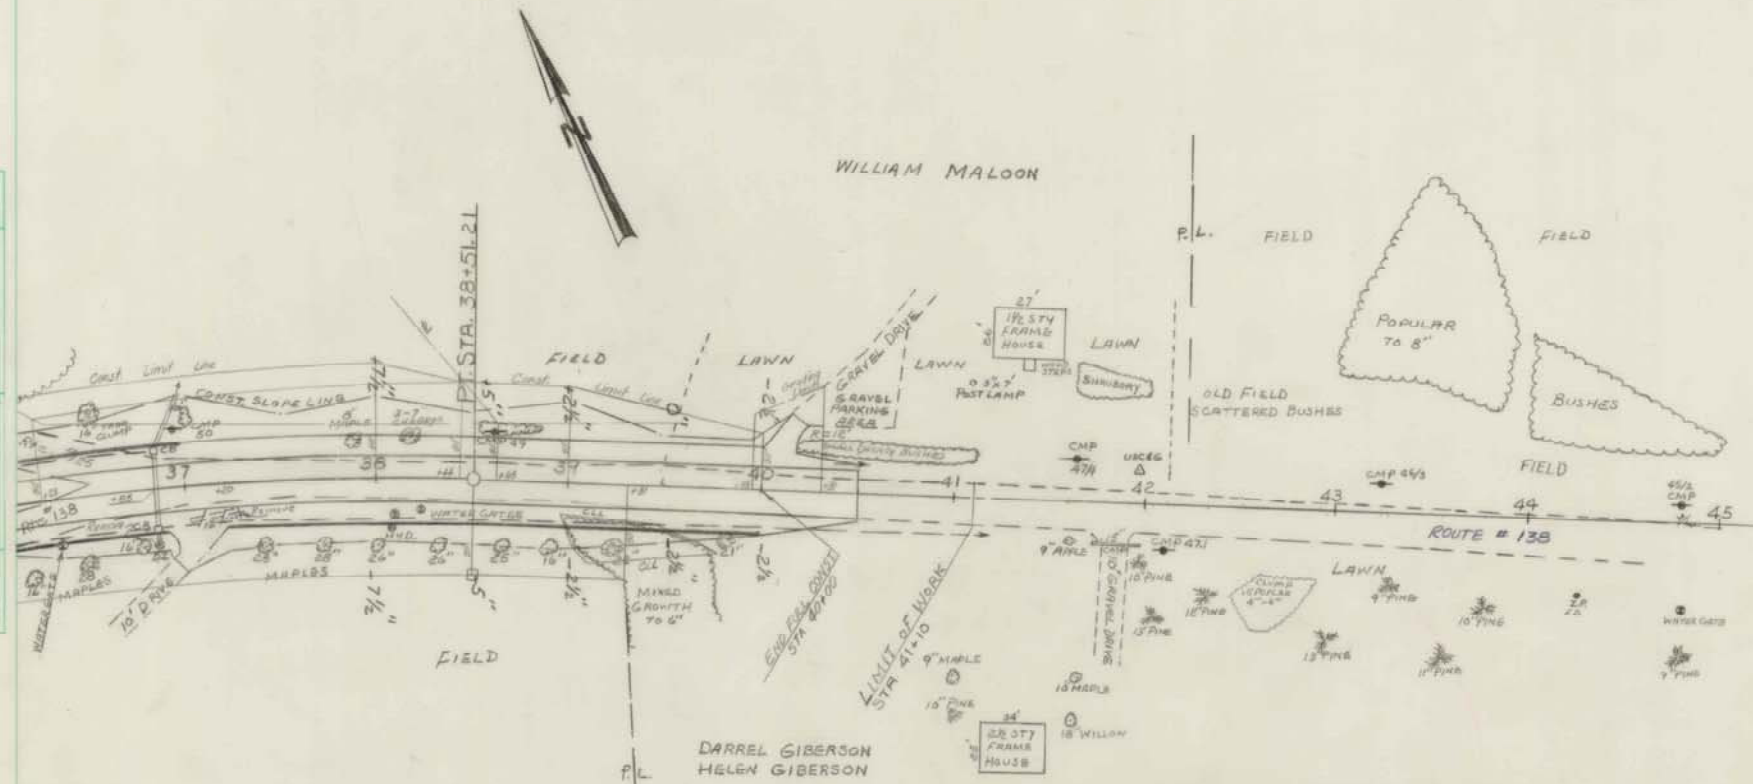

Curb Type 3a
Sta. 37+25, 22' Rt. Rte. 138 to Sta. 40+00, 22' Rt. Rte. 138 = 280.00 L.F.
Note: For additional curb notes see previous sheet

Grubbing in Fill
Sta. 37+50 to Sta. 38+50

DATE	
BY	L. Miller
REVISIONS	
1	AS BUILT



AS BUILT
1975

TOPSHAM, BOWDOIN, BOWDOINHAM

138 SO. XING.