


PROJECT DESIGN ENGINEER	BY	DATE
DESIGN - DETAILED		
CHECKED		
REVISIONS		
FIELD CHANGES		

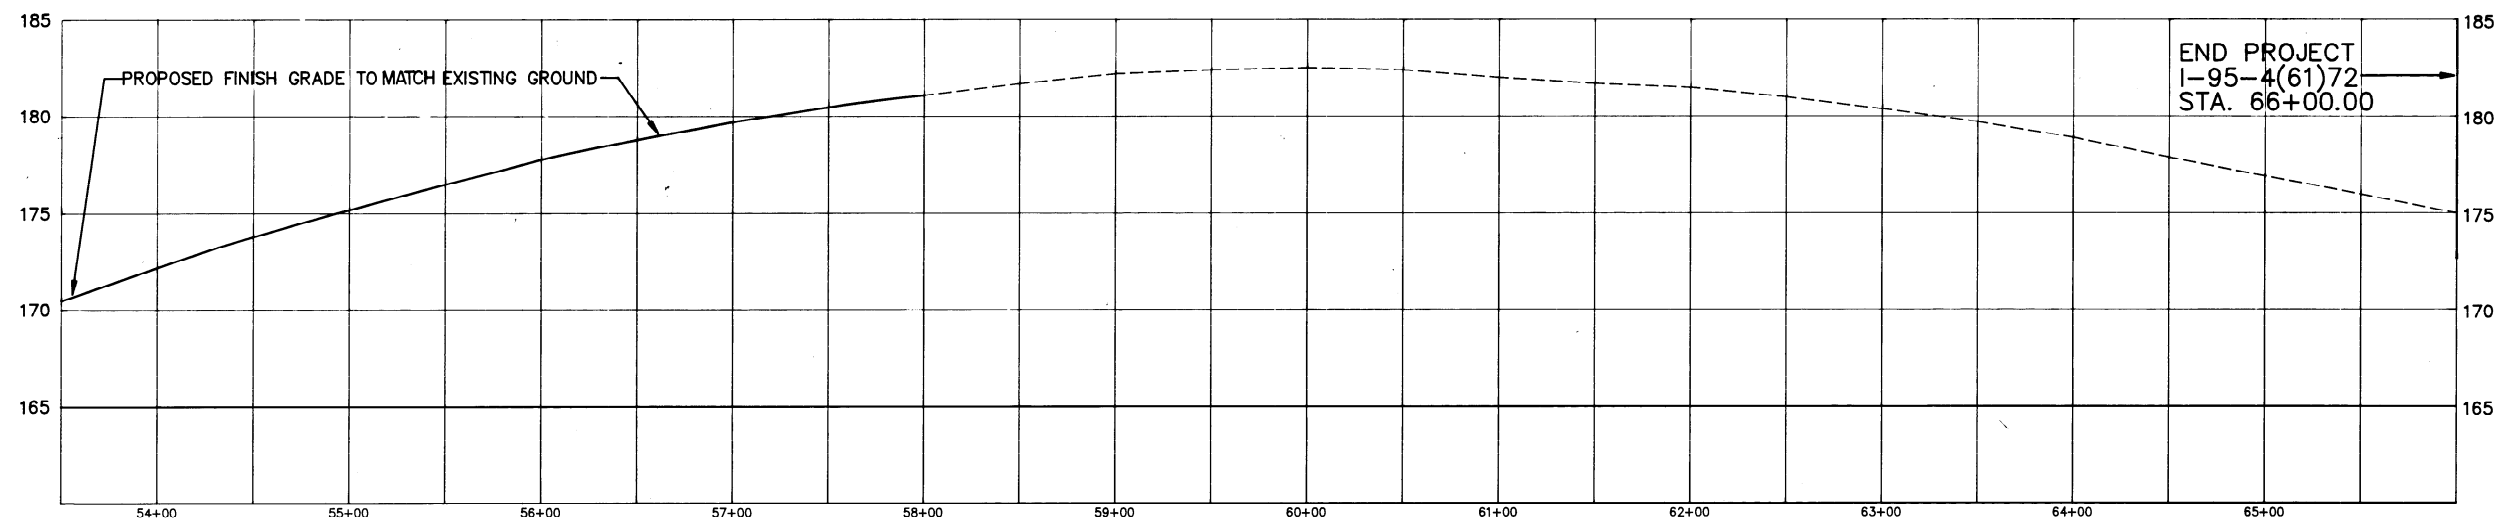

END PROJECT	
1-95-4(61)72	
STA. 66+00.00	

RAMP PROFILE

STA. 38+00 TO STA. 66+00

SHEET OF AUGUSTA, MAINE

BRUNSWICK IR-95-4(61)72

Revised As Built Richard Klamanich 5/91