

STATE OF MAINE
DEPARTMENT OF TRANSPORTATION



PLANS

RICHMOND
SAGadahoc COUNTY
MAINE FEDERAL AID INTERSTATE
PROJECT NO. IR-IM-95-5(53) (Built 1992)
PROJECT LENGTH { 0.189 MILES S.B.
0.189 MILES N.B.
A SETTLEMENT REPAIR PROJECT



P.I.N.	F.H.V.A. REG. NO.	STATE	PROJECT NUMBER	SHEET NO.	TOTAL SHEETS
4826.00	1	MAINE	IR-IM-95-5(53)	1	15

RICHMOND

Reel 289

INDEX OF SHEETS



SHEET NO.	DESCRIPTION
1	TITLE SHEET
2	I-95 N.B. & S.B. TYPICAL SECTIONS; BUTT JOINT DETAIL
3	GENERAL NOTES; PROFILE N.B. & S.B.; ESTIMATED QUANTITIES
4-9	NORTHBOUND CROSS SECTIONS
10-15	SOUTHBOUND CROSS SECTIONS
(FOR STANDARD DETAILS SEE PROJECT IR-95-5(54))	

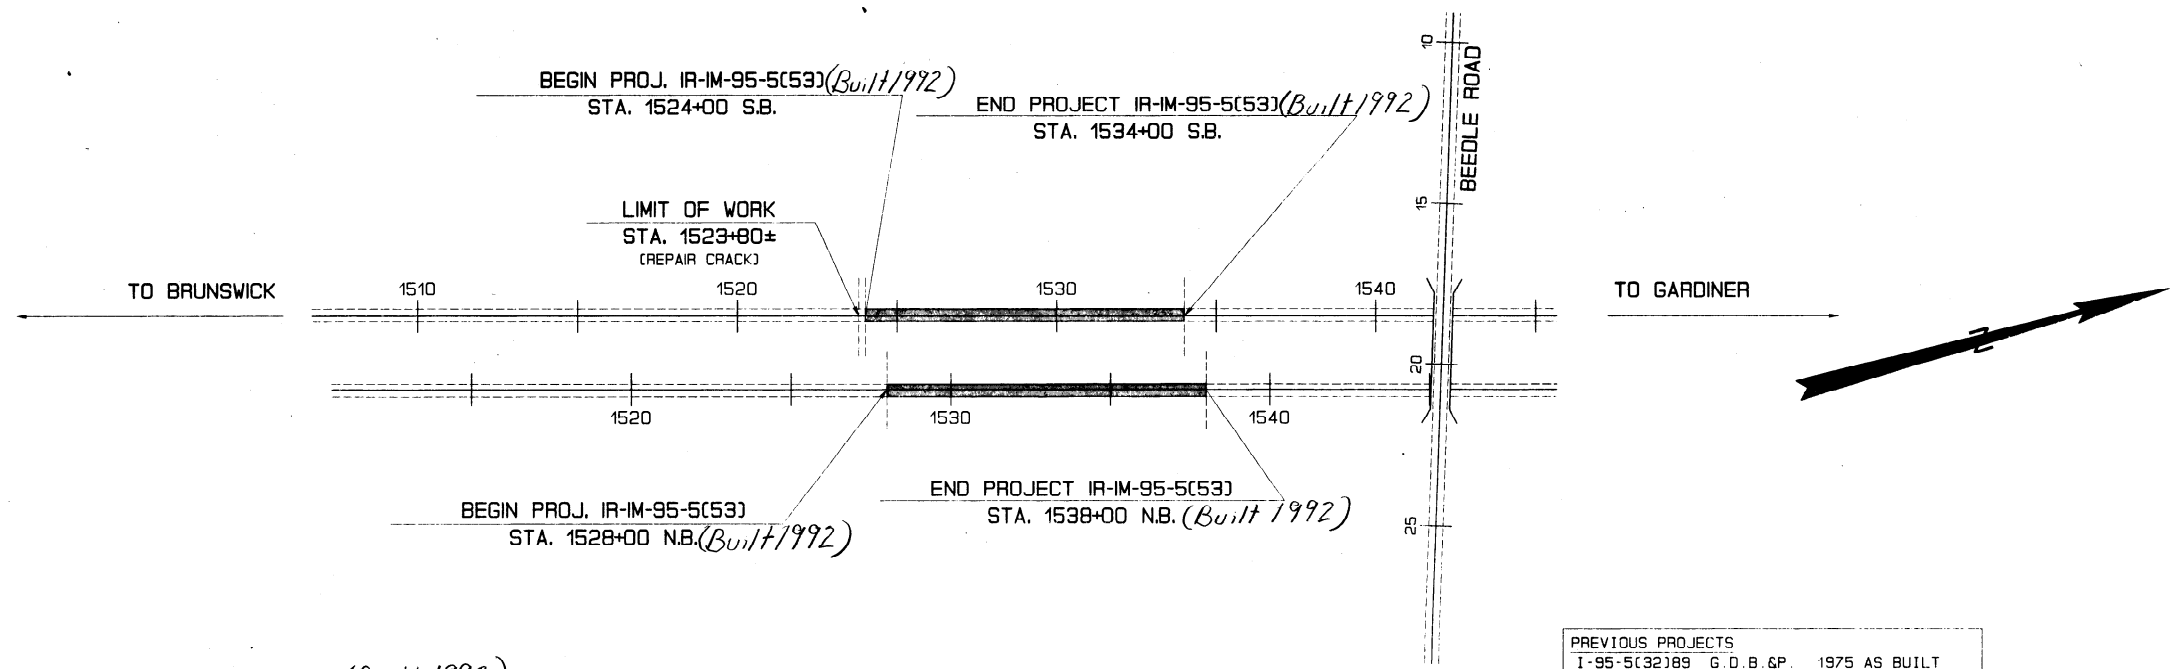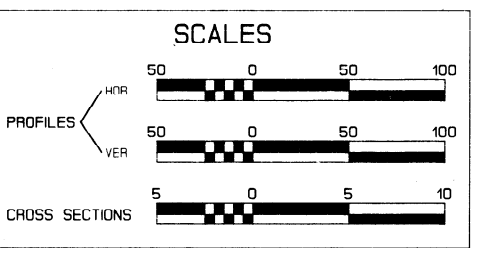

PREVIOUS PROJECTS

I-95-5(32)89	G.D.B.&P.	1975	AS BUILT
I-95-5(44)81	PAVING "P.C.C."	1977	AS BUILT
I-95-5(50)91	G.D.B.&P.	1984	AS BUILT


(SETTLEMENT REPAIR)

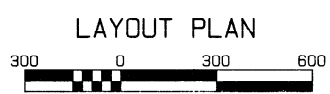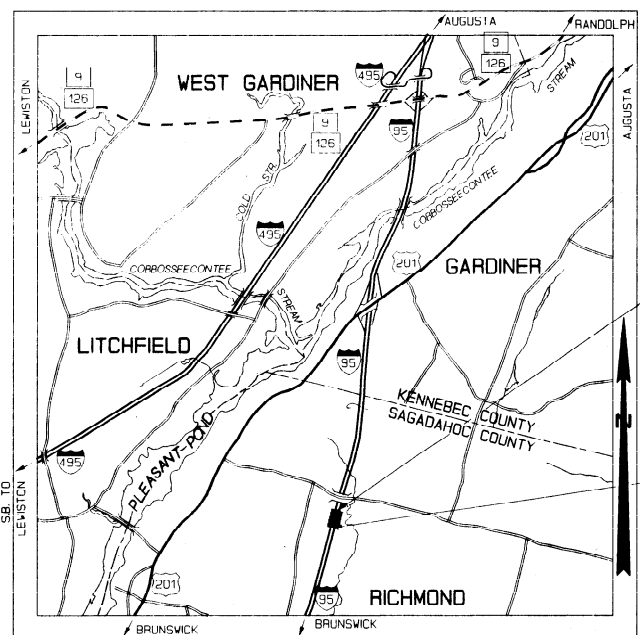

	N.B.	S.B.
A.A.D.T. (1992)	7,900	8,370
A.A.D.T. (2012)	14,240	15,070
D.H.V.	1,851	1,959
T.(%D.H.V.)	5	5
D.(%D.H.V.)	100	100
V. (AS POSTED)	65	65
18 KIPS	900	952

NOTE
ALL WORK CONTEMPLATED UNDER THIS CONTRACT TO BE GOVERNED BY AND IN CONFORMITY WITH THE STANDARD SPECIFICATIONS (REVISION OF OCTOBER 1990) AND SUPPLEMENTALS THERETO AS MODIFIED ON THE PLANS AND IN THE SPECIAL PROVISIONS.

APPROVED:
STATE OF MAINE
DEPARTMENT OF TRANSPORTATION
Richard A. Coleman
COMMISSIONER
CHIEF ENGINEER

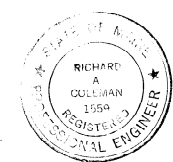

3.27.92
DATE
3.27.92
DATE

UNITED STATES
DEPARTMENT OF TRANSPORTATION
FEDERAL HIGHWAY ADMINISTRATION
REGION 1
APPROVED:
DIVISION ADMINISTRATOR
DATE

As Built 1992 N.B. 3/93

MTA-29

PROJECT ACTION ENGINEER	DATE
DESIGN-DETAILED	2-92
CHECKED	
REVISIONS	
FIELD CHANGES	

PLANS