

N.B. Sta 605+50  
Installed 15"x160' RCP C.I.V

Installed Type B1 Catch Basins  
S.B. Sta 597+25 75' Rt.  
N.B. Sta 605+50 75' Lt.

S.B. Sta 597+25 Installed  
15" x 168' RCP Class III

N.B. Sta 614+50 Skewed Ahd Rt.  
Installed 24" x 148' RCP Class III


Culverts & Catch Basins Constructed 1972

Constructed 1973

Installed Type "B" U.D. Outlet

S.B. Rt. 616+50 to 617+20 80'  
S.B. Lt. 616+50 to 617+20 80'  
N.B. Rt. 617+25 to 617+90 70'  
N.B. Lt. 617+25 to 617+90 70'

Installed Type "B" Underdrain  
S.B. 615+0 to 616+50 23' Lt. 150' Elbow  
S.B. 615+0 to 616+50 17' Rt. 150' Elbow  
N.B. 615+75 to 617+25 23' Lt. 150' Elbow  
N.B. 615+75 to 617+25 17' Rt. 150' Elbow  
Installed 1972

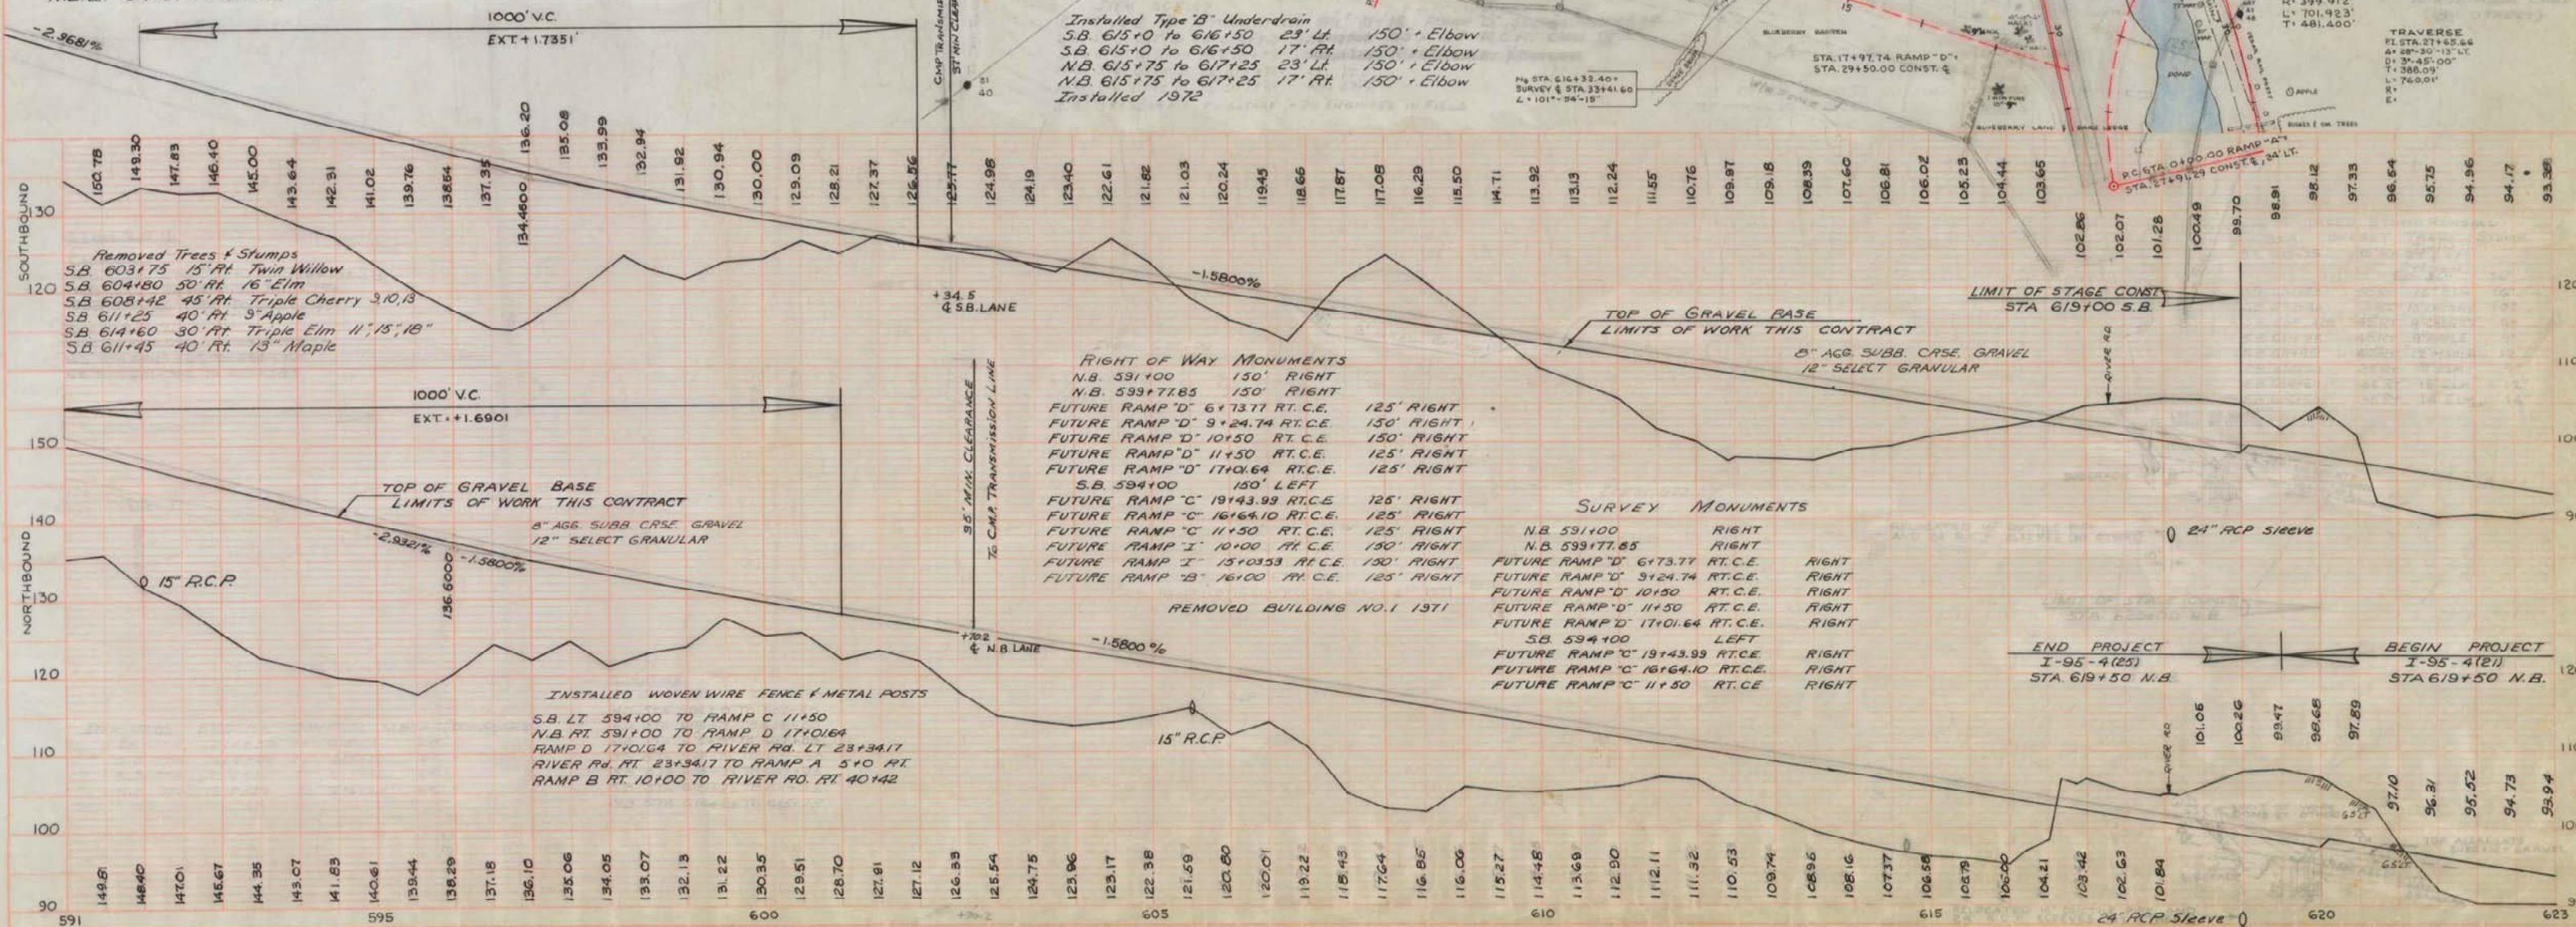

Revised As Built by Gary Jewell 4-7-75