

William H. Small

S.B. Sta. 1091+22
Installed 60"x184" RCP Class I
Skewed Ahead Lt. 30°
Used Class 'B' Bedding
1974

Constructed 1975

S.B. Sta. 1083+00
Skewed Ahead Lt. 30°00'
Installed 24"x128" RCP CI III
1974


Clyde M. Fossett
Natalie M. Estabrook

S.B. Sta. 1079+56
Installed 36"x100" RCP CI III
1974

STA. 1069+50 S.B.
BEGIN PROJECT I95-5(36)82

Carl C. Billings
Jean M. Billings

Holman C. Petrell
Anne E. Petrell

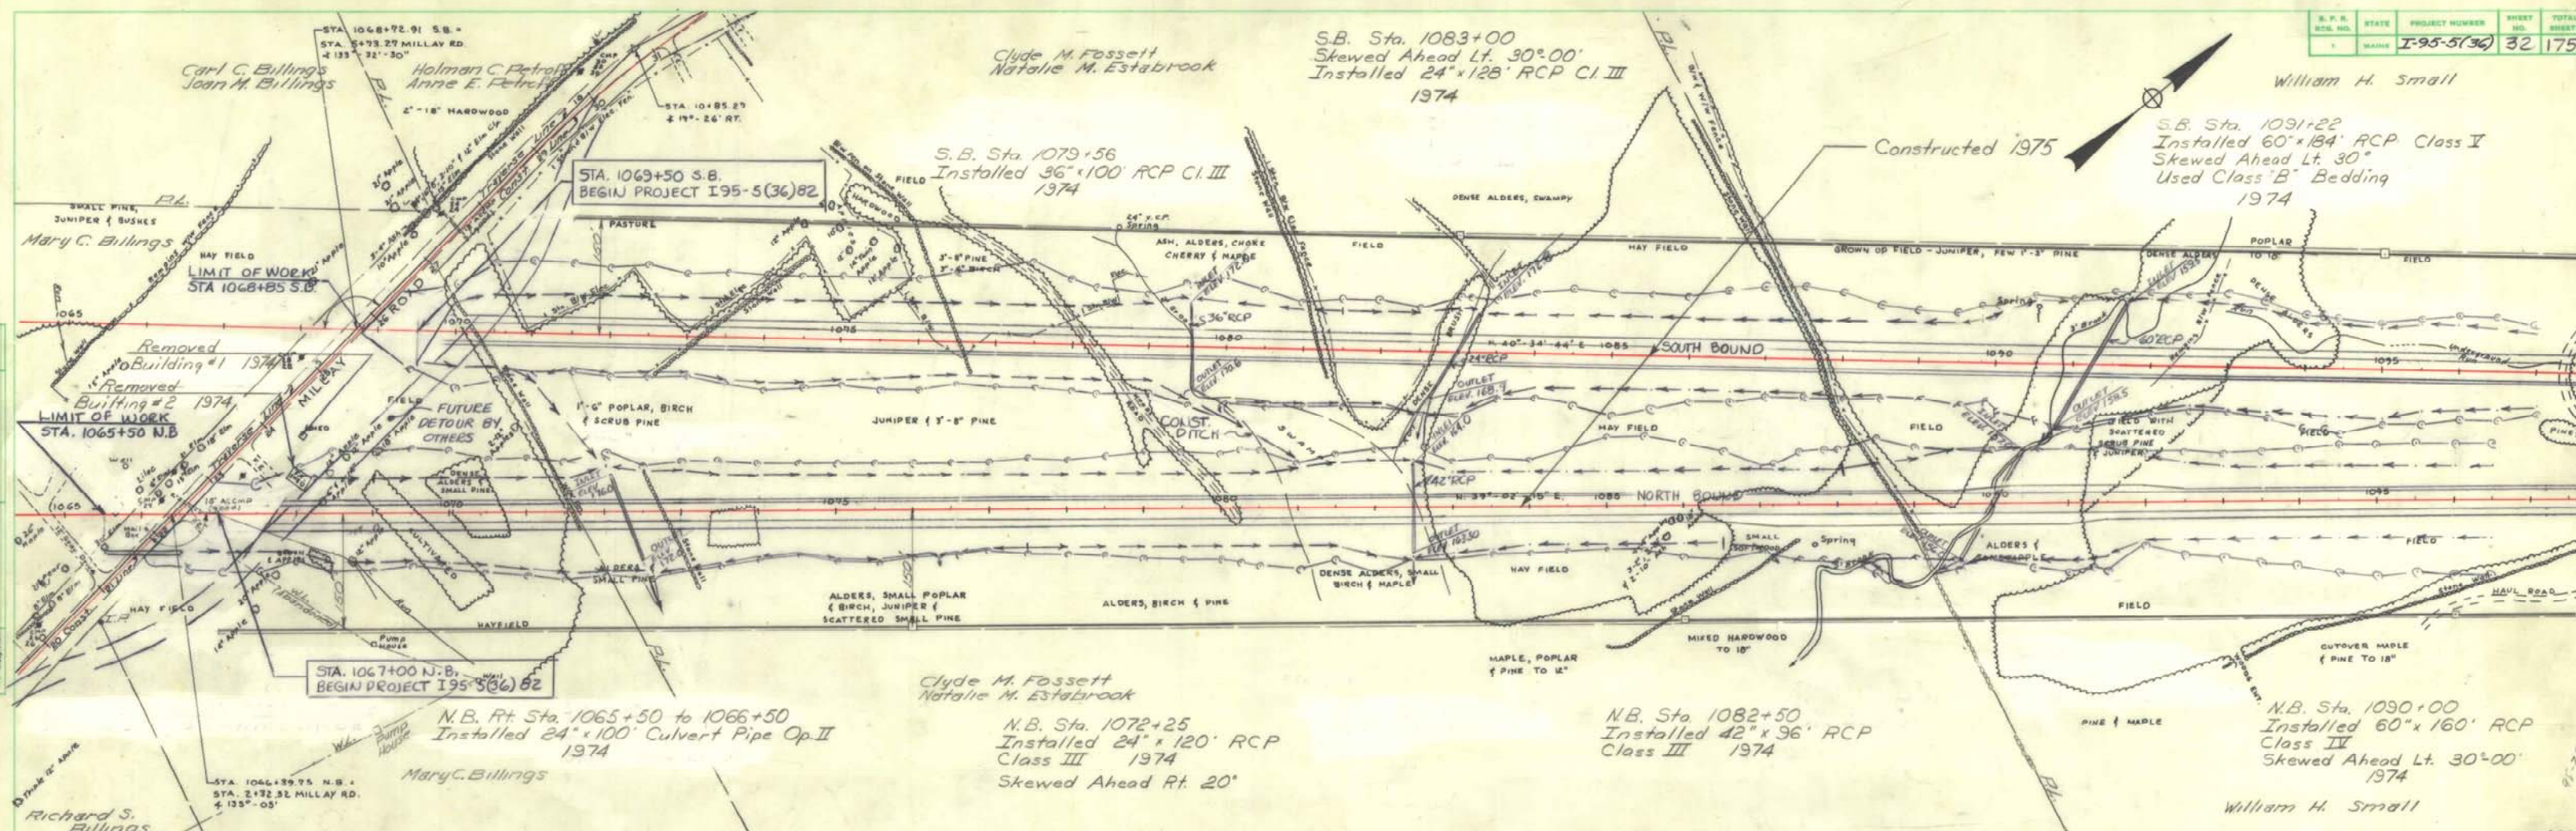


N.B. Sta. 1082+50
Installed 42"x96" RCP
Class III 1974

N.B. Sta. 1072+25
Installed 24"x120" RCP
Class III 1974
Skewed Ahead Rt. 20°

N.B. Pt. Sta. 1065+50 to 1066+50
Installed 24"x100" Culvert Pipe Op. II
1974

STA. 1067+00 N.B.
BEGIN PROJECT I95-5(36)82

William H. Small

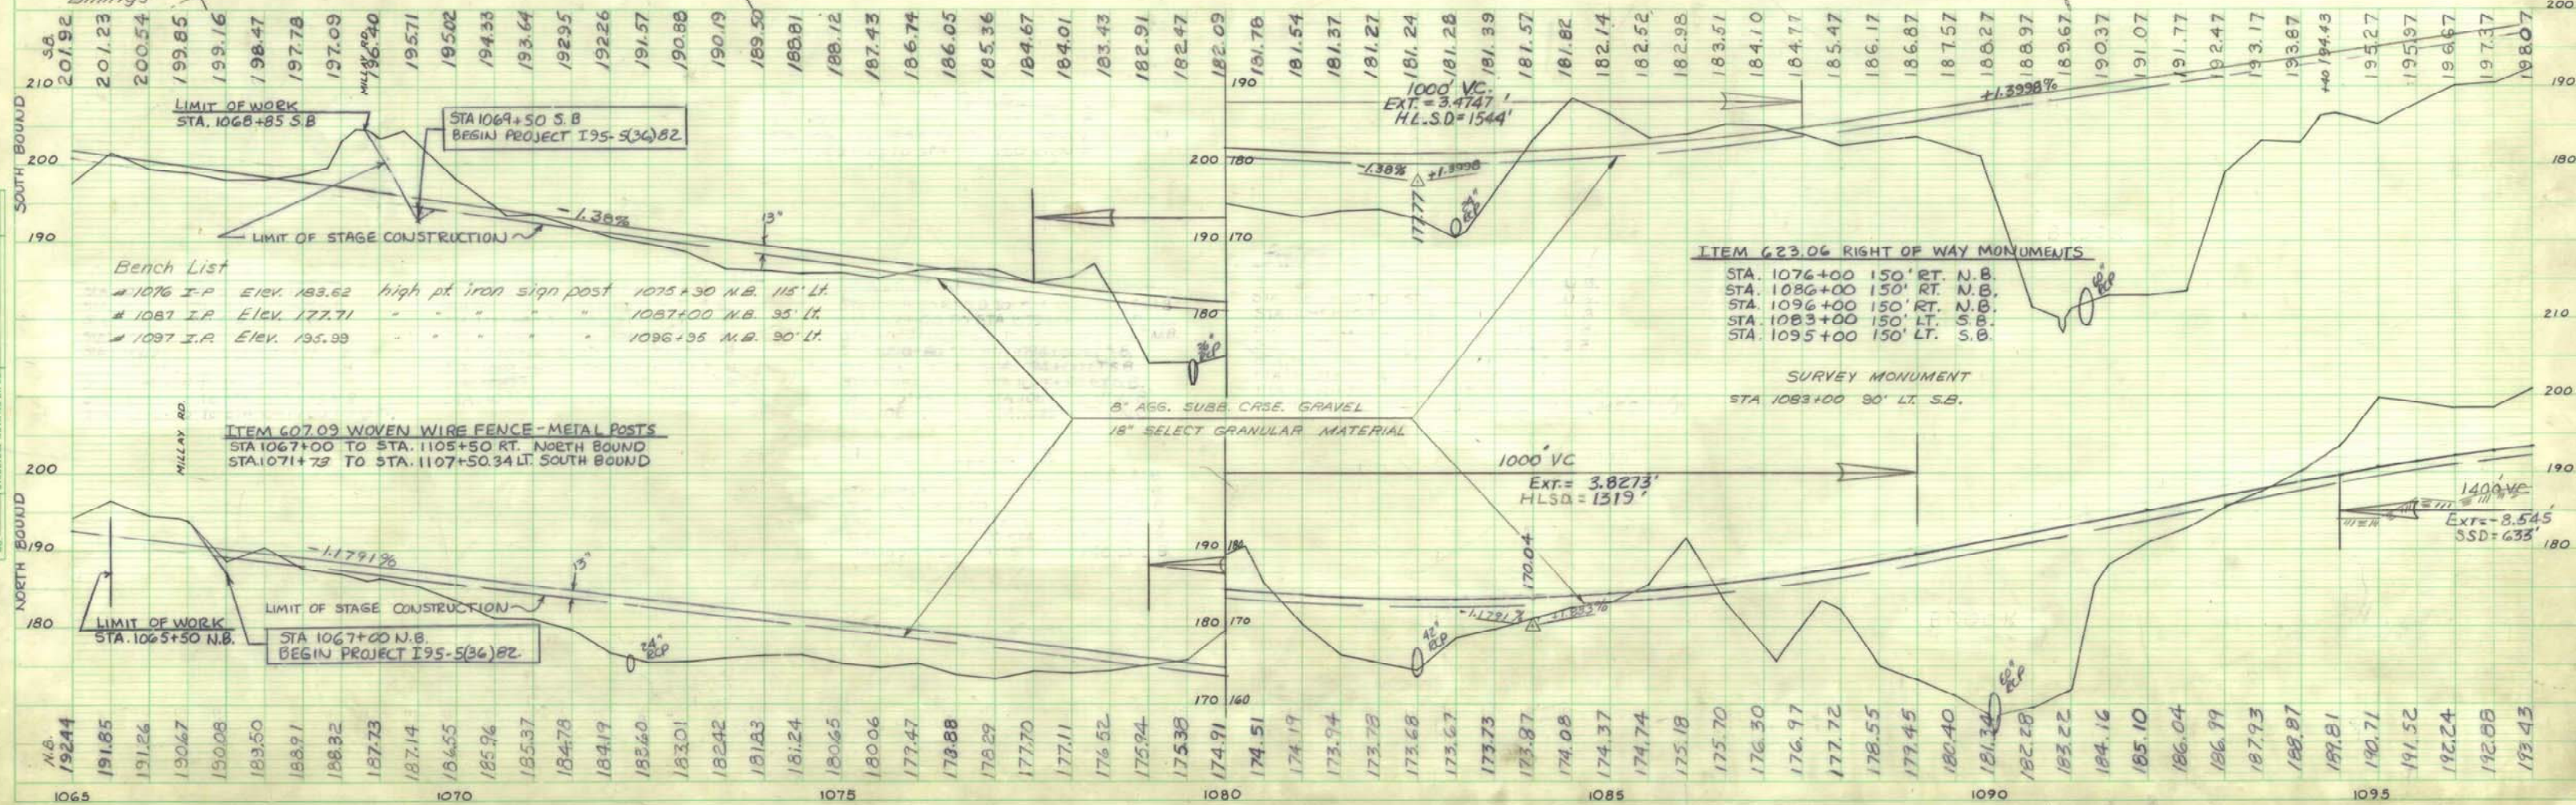

ITEM 623.06 RIGHT OF WAY MONUMENTS
STA. 1076+00 150' RT. N.B.
STA. 1086+00 150' RT. N.B.
STA. 1096+00 150' RT. N.B.
STA. 1083+00 150' LT. S.B.
STA. 1095+00 150' LT. S.B.

SURVEY MONUMENT
STA. 1093+00 30' LT. S.B.

ITEM 607.09 WOVEN WIRE FENCE-METAL POSTS
STA. 1067+00 TO STA. 1105+50 RT. NORTH BOUND
STA. 1071+73 TO STA. 1107+50.34 LT. SOUTH BOUND

PLAN
DATE: 10-17-74
BY: J.P.
CHECKED: J.P.
NOTED: J.P.
STRUCTURE: 10/17/74

PROFILE
DATE: 10/17/74
BY: J.P.
CHECKED: J.P.
NOTED: J.P.
STRUCTURE: 10/17/74