
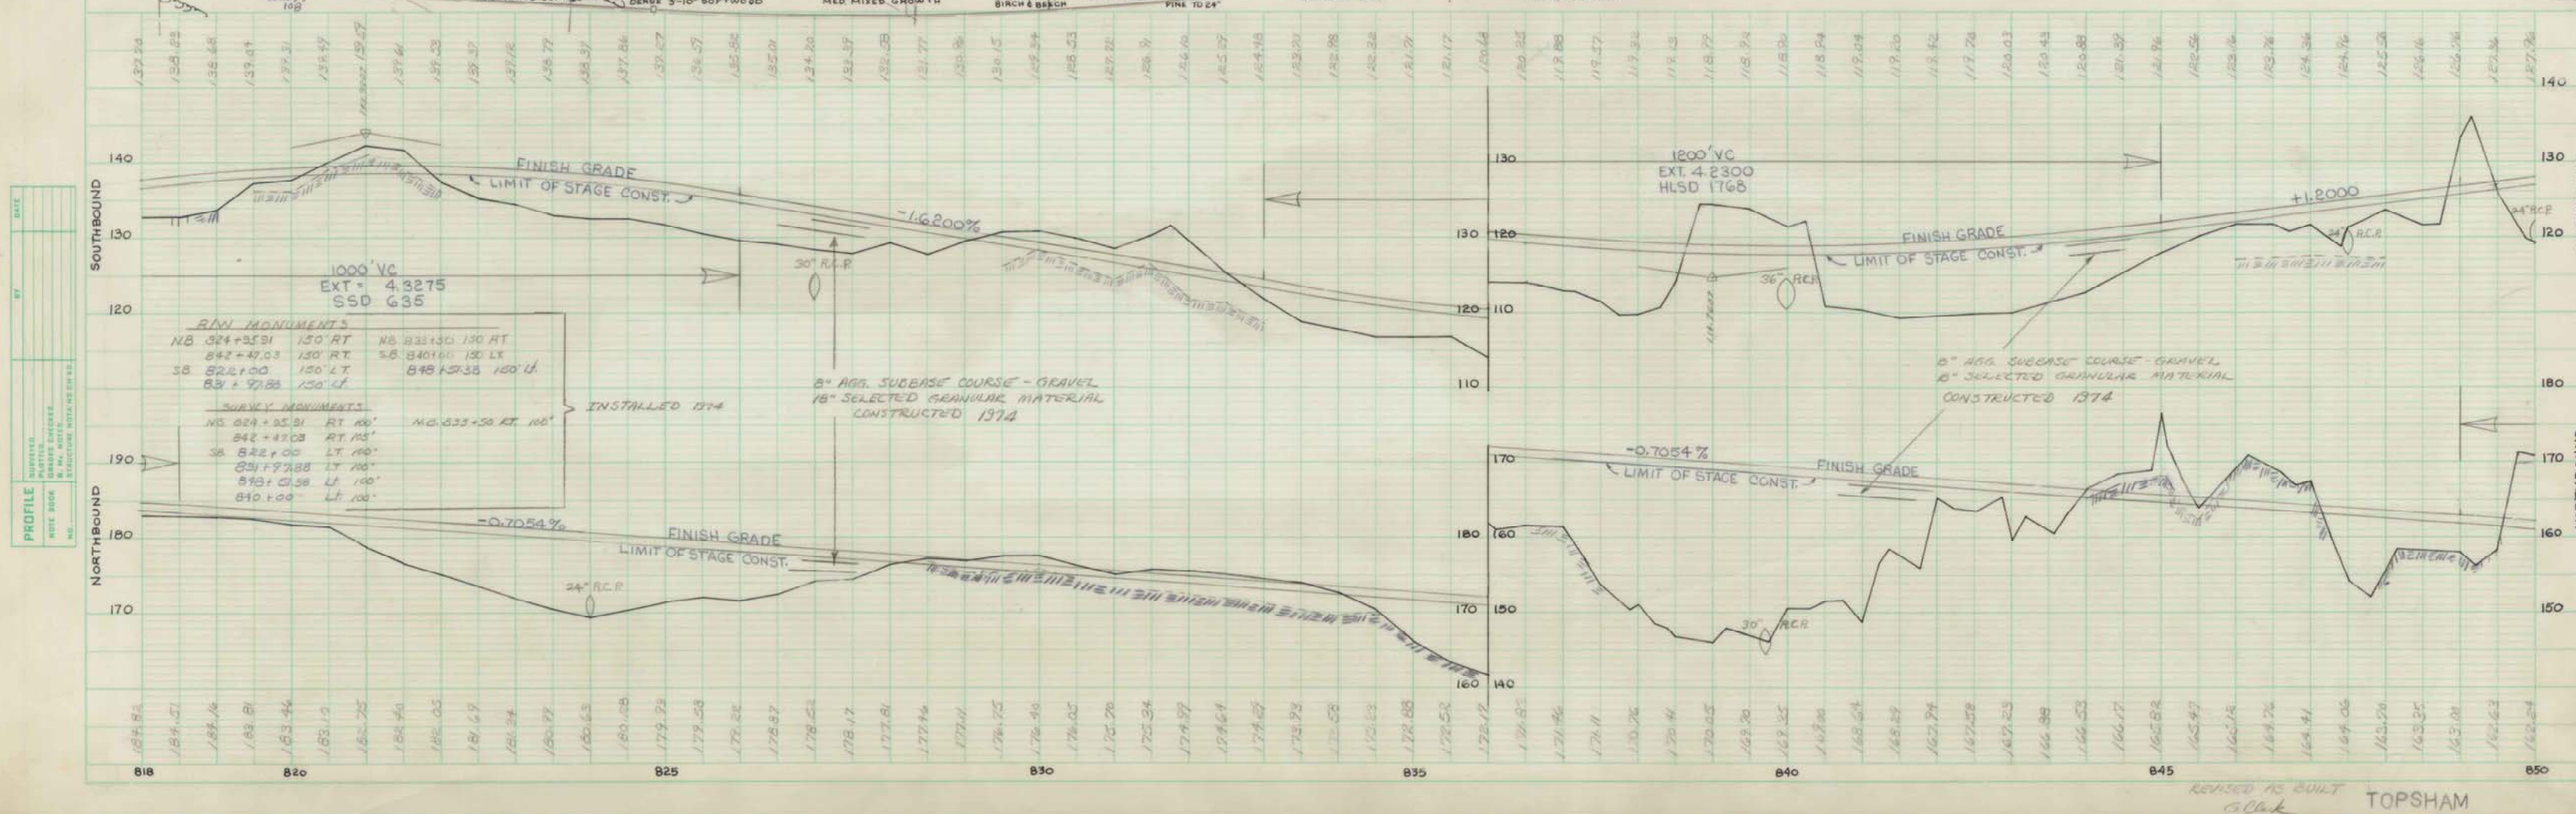


S. F. R. REG. NO.	STATE	PROJECT NUMBER	SHEET NO.	TOTAL SHEET
1	MAINE	I-95-5(22)	18	117

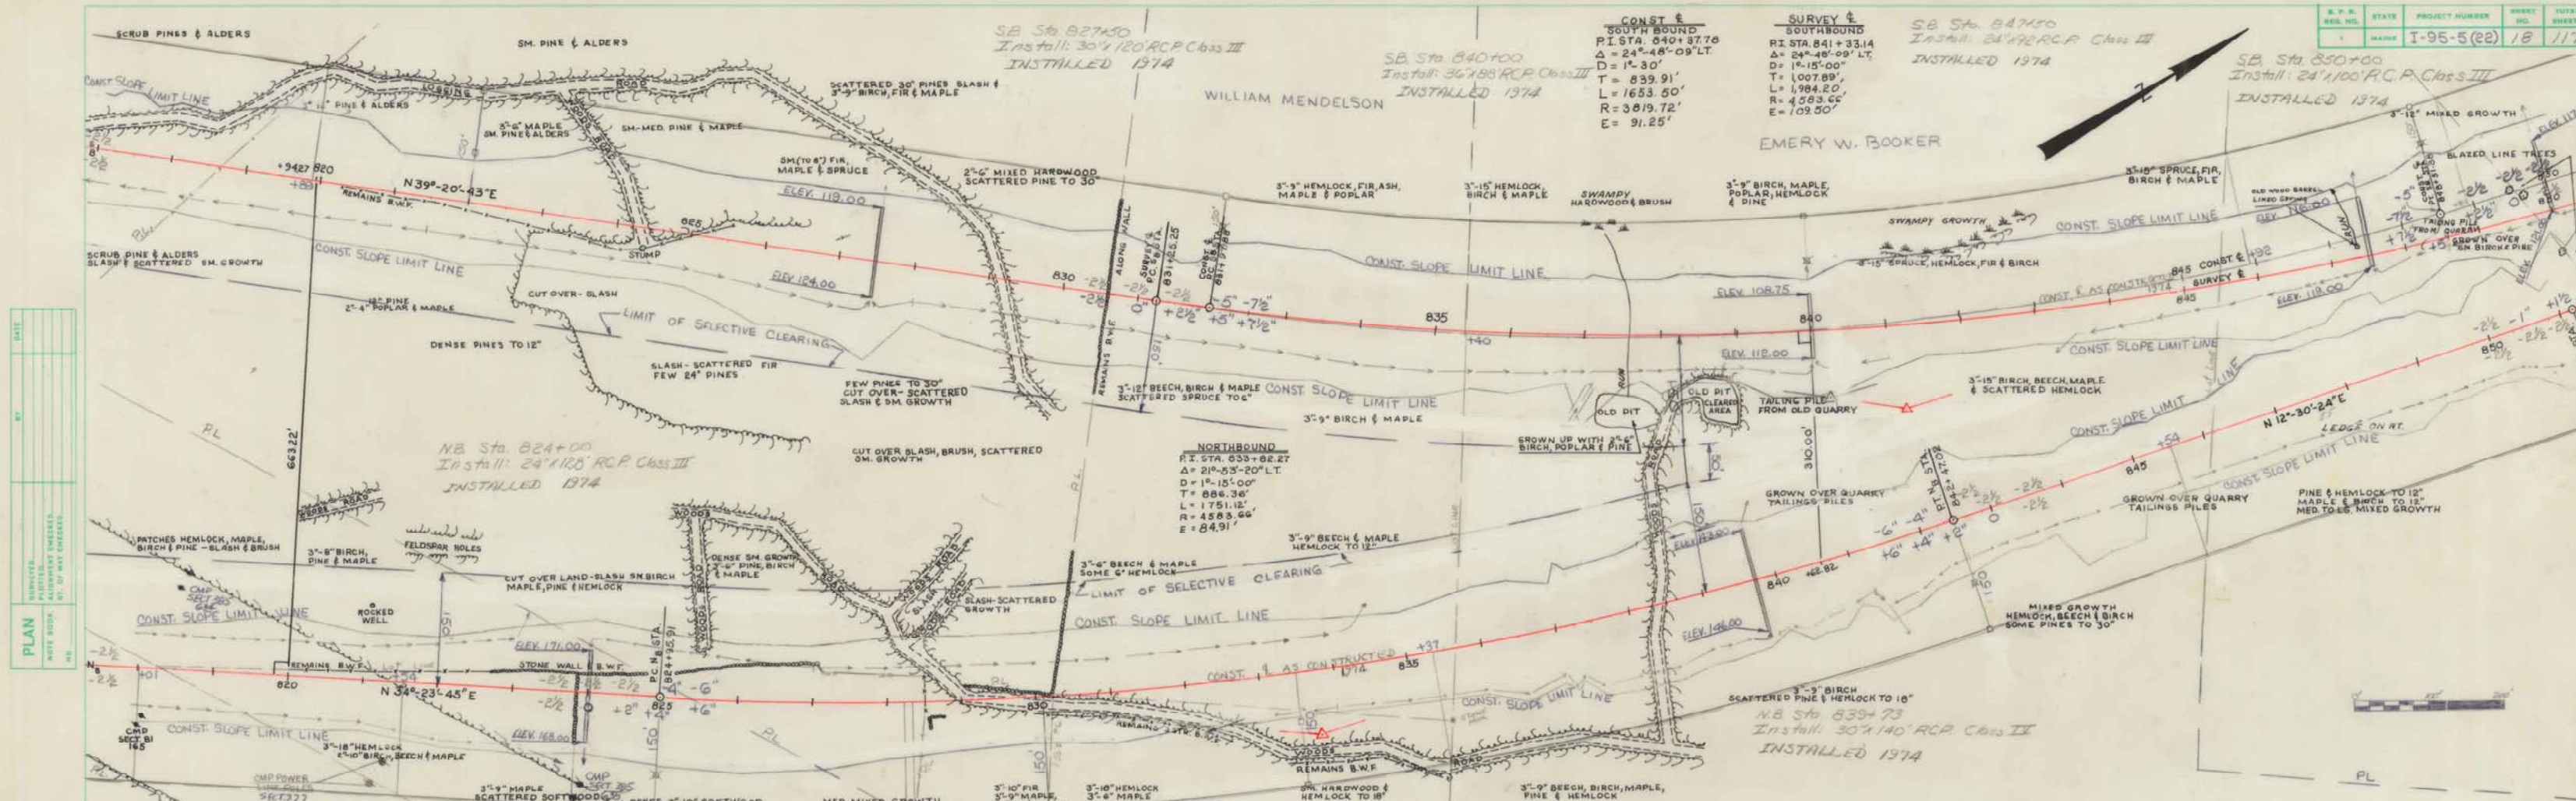

REVISED AS BUILT TOPSHAM
G. Clark