

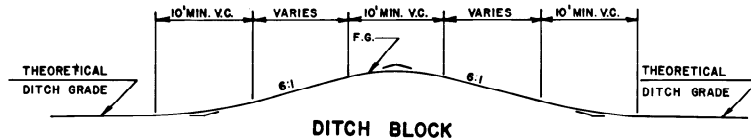
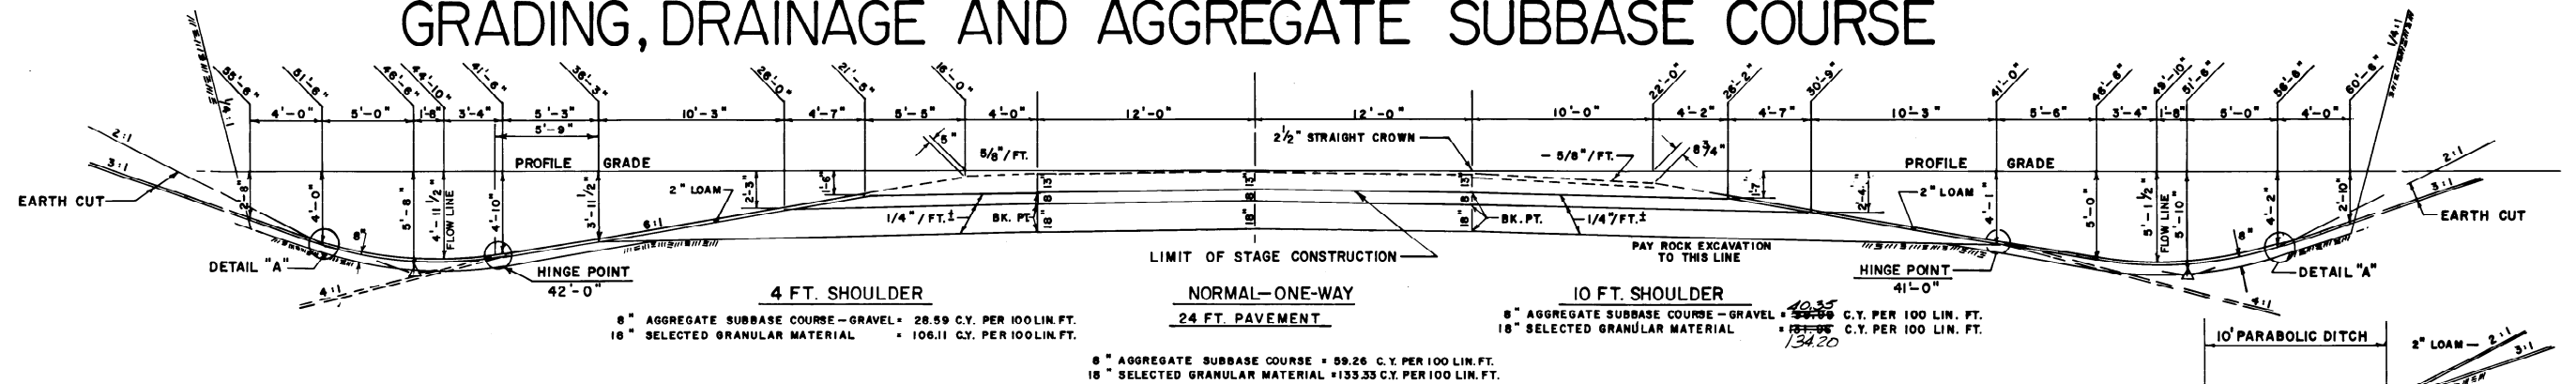
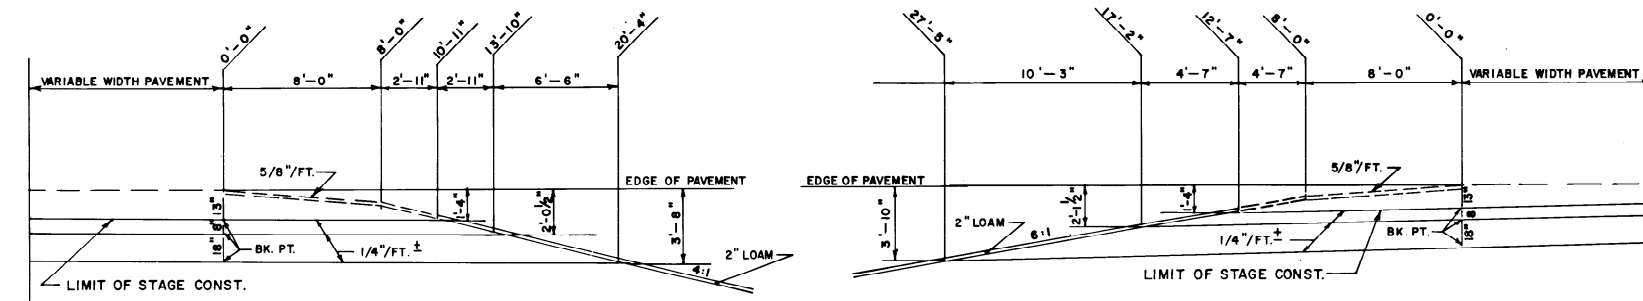


# STAGE CONSTRUCTION GRADING, DRAINAGE AND AGGREGATE SUBBASE COURSE \*


P.H.A. REG. NO.	STATE	PROJECT NUMBER	SHEET NO.	TOTAL SHEETS
1	MAINE	I-95-5(37)	2	155

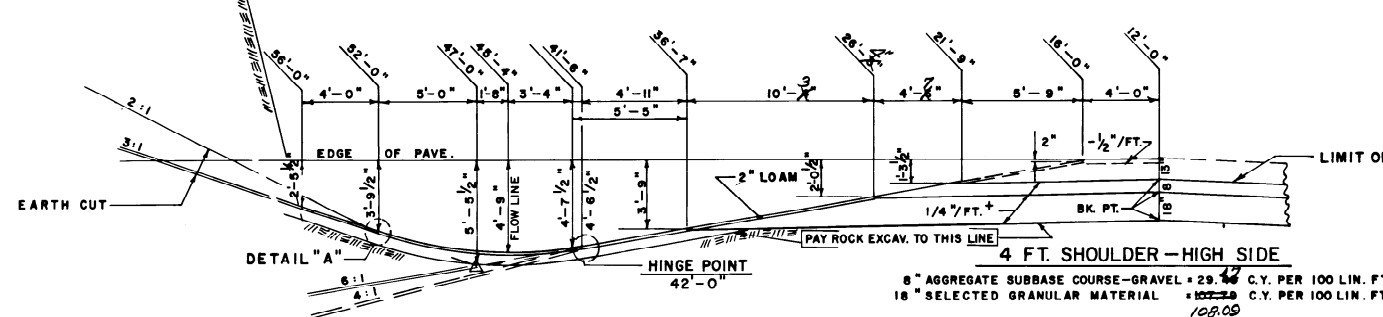

NOTE: Ditch blocks will be sodded on culvert side only, unless otherwise noted or directed by the engineer.


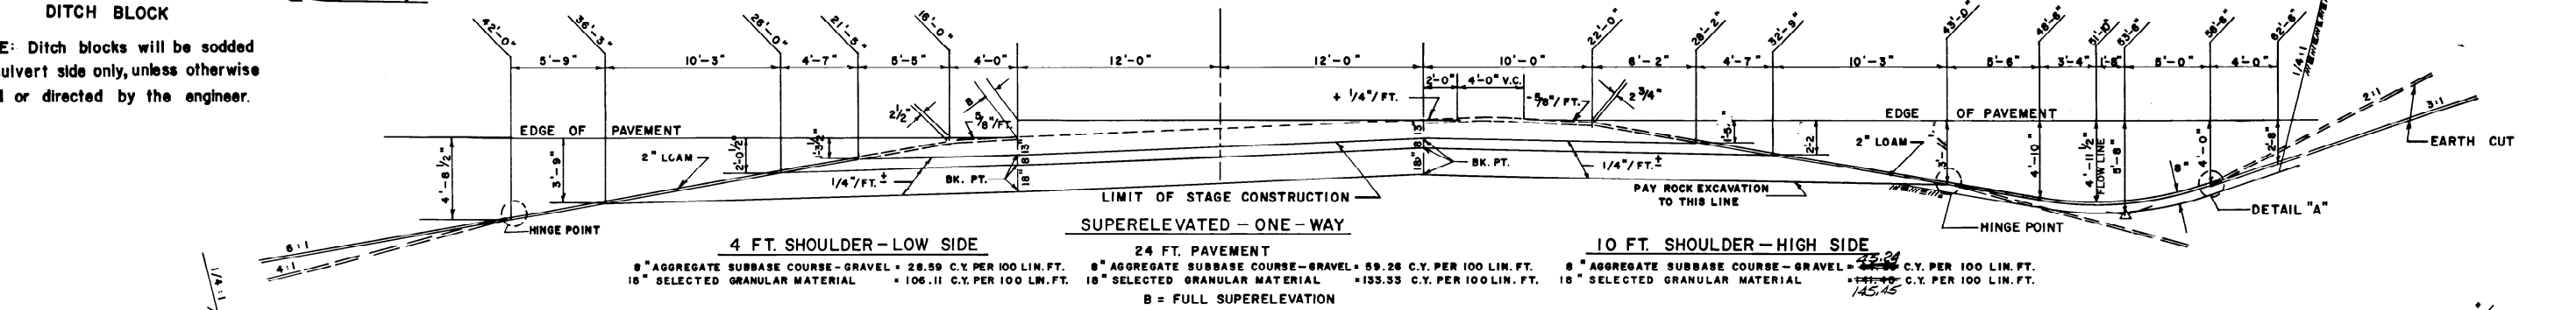


OFFSET DISTANCE AS SHOWN ON CROSS SECTIONS

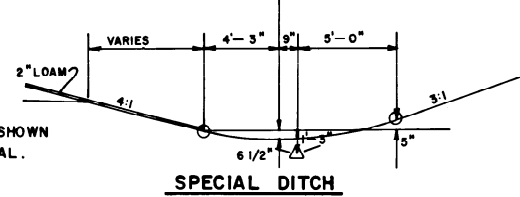

\* NOTE: THE PAVEMENT AND BASE DEPTHS AS SHOWN ON THE PLANS ARE INTENDED TO BE NOMINAL.

## DETAIL FOR LOADING

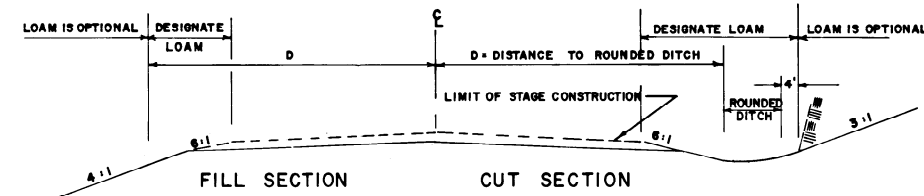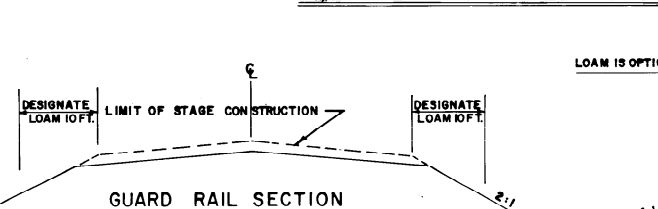

AS BUILT L.L. ROUTE 1 MAR 1976

STATE OF MAINE  
DEPARTMENT OF TRANSPORTATION

**MAIN LINE  
TYPICAL SECTIONS**

SCALE: 0 5 10 15 (FEET)

SHEET OF AUGUSTA, MAINE