


SOLOMON KLEIN  
JEANNETTE KLEIN

STA 140400 TO 1402100, N.B.  
PLACE EROSION CONTROL MESH (STO)  
IN DITCH RT.


LAWRENCE HUNTINGTON  
LOUISE M. HUNTINGTON

VERNON H. YOUNG  
DOROTHY M. YOUNG

END PROJECT I-95-5(37)86  
BEGIN PROJECT I-95-6(32)89  
STA 1408+00 N.B.  
STA 1406+00 S.B.

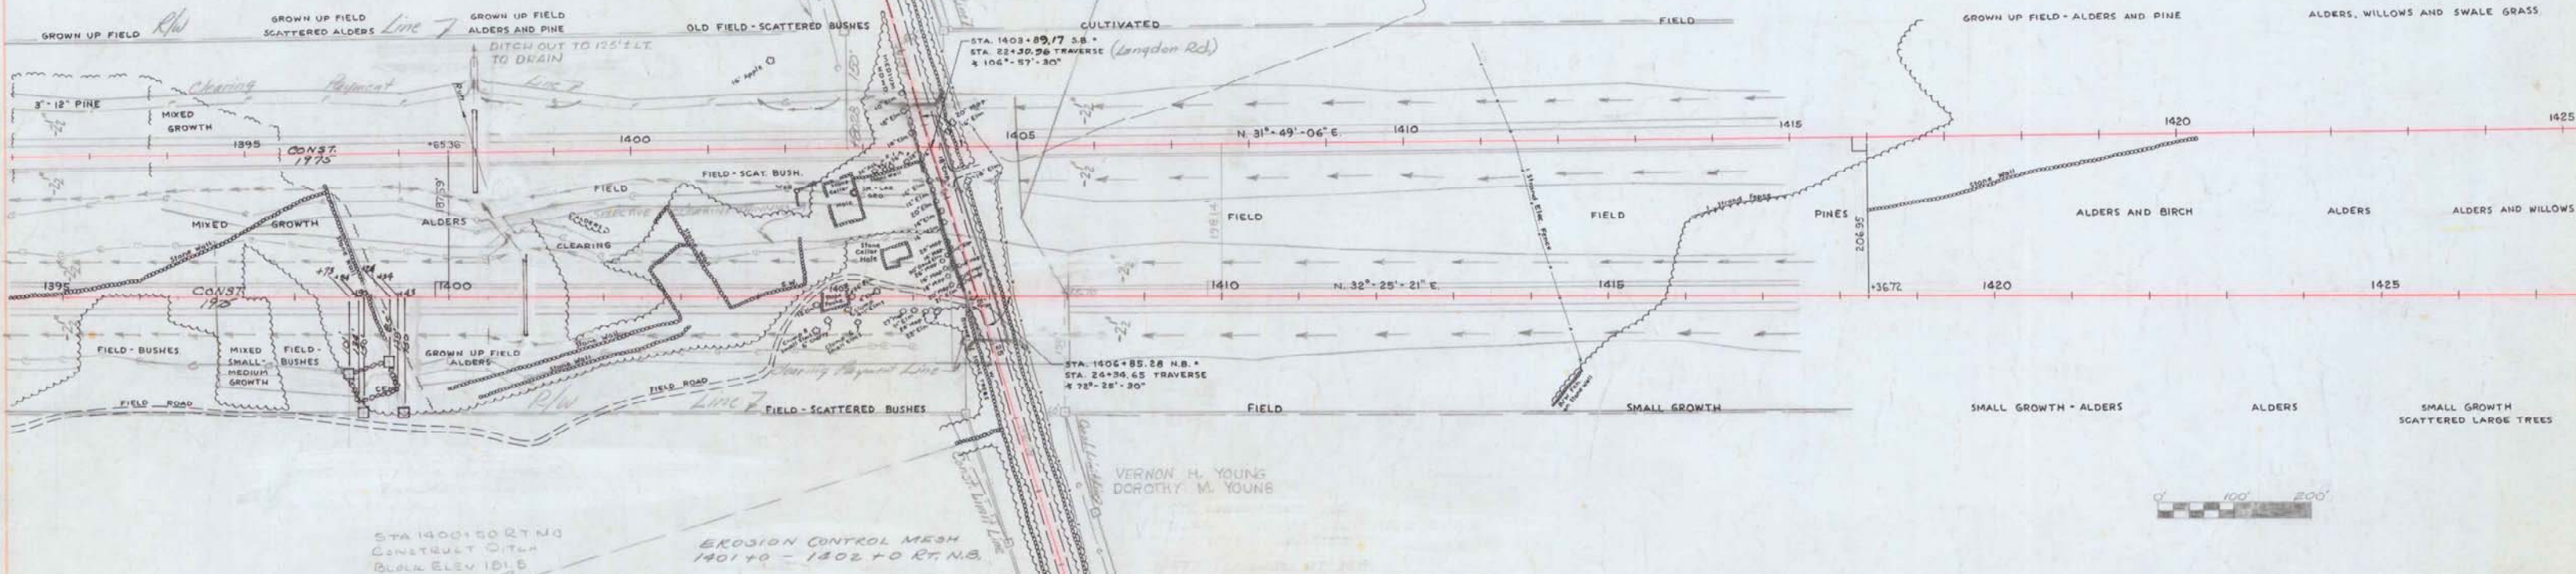

PETER B. FLYNN  
LINDA A. LEONARD

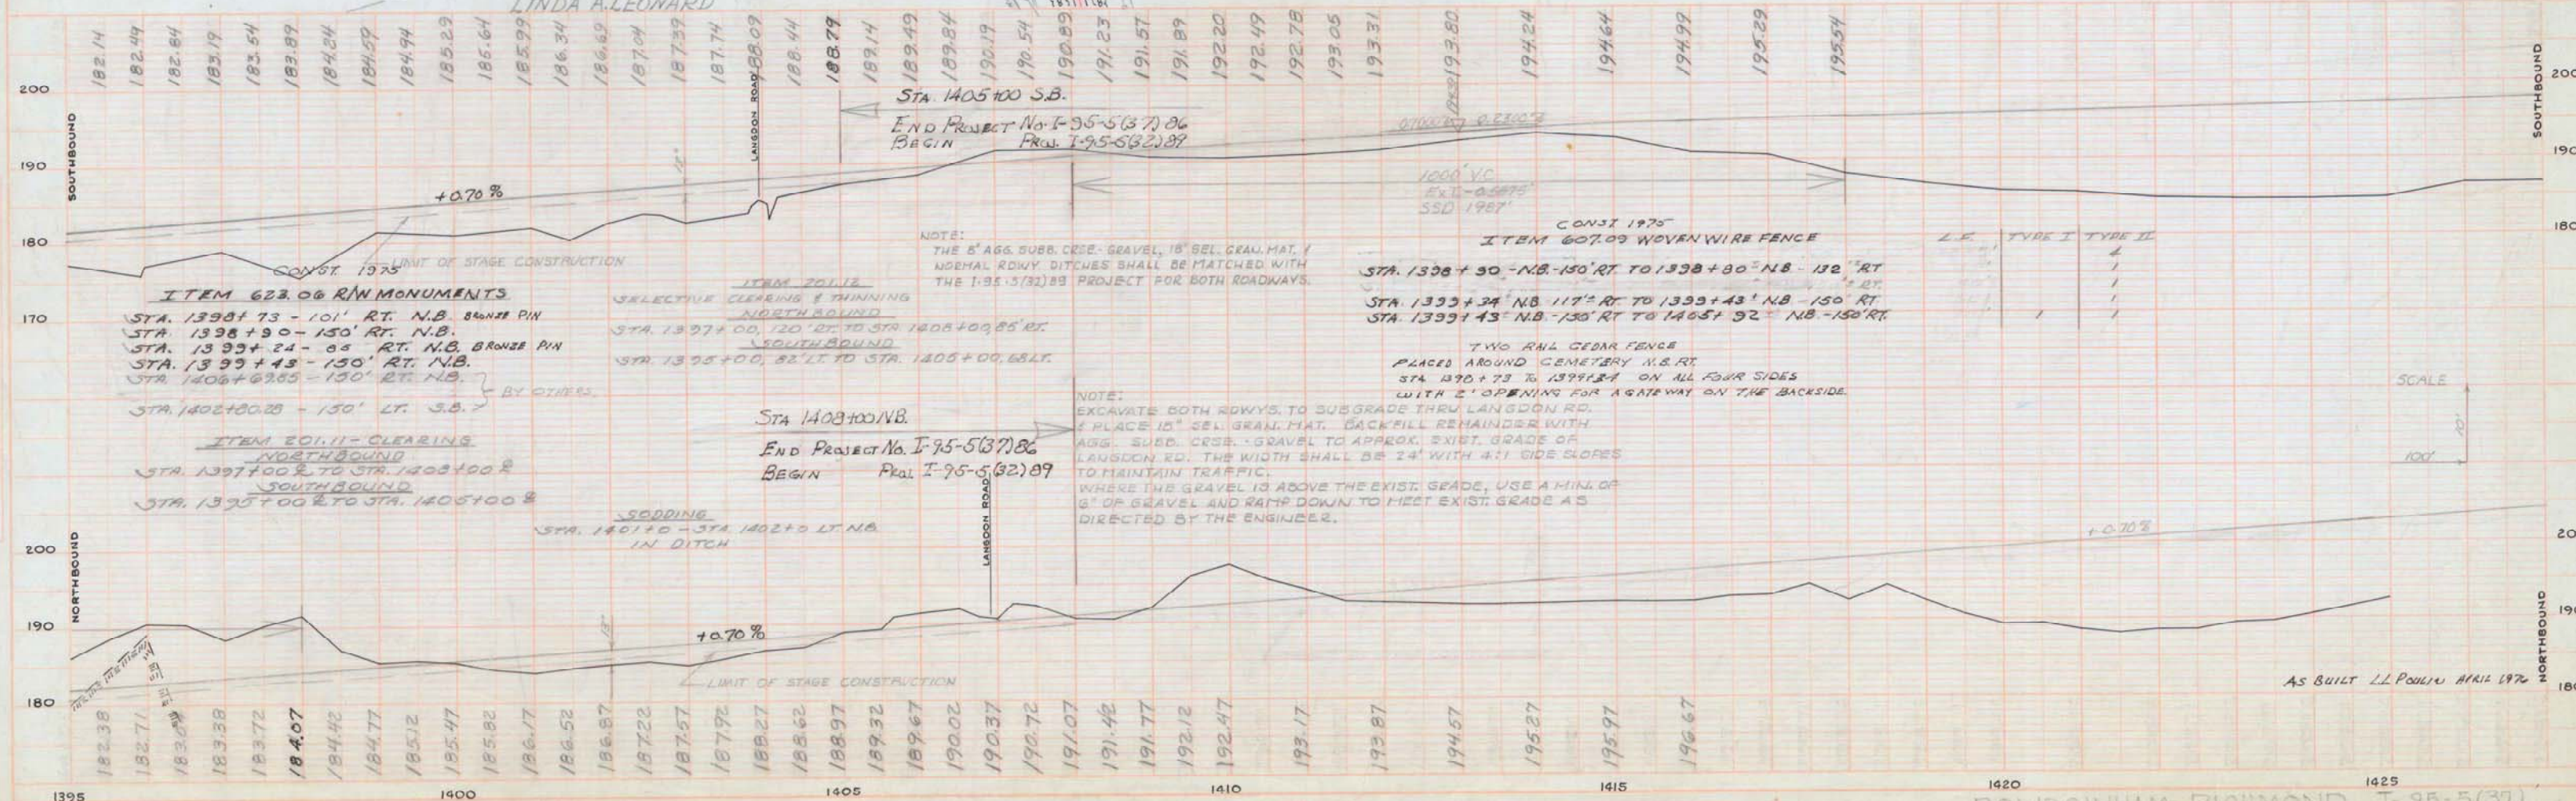

AS BUILT LL POUIN APRIL 1970

BOWDOINHAM- RICHMOND I- 95-5(37)