



DATE 1-30-69
BY ALEX ASA
SUBMITTED 95-5(11) 31
PLANNED 95-5(11) 31
PLAN

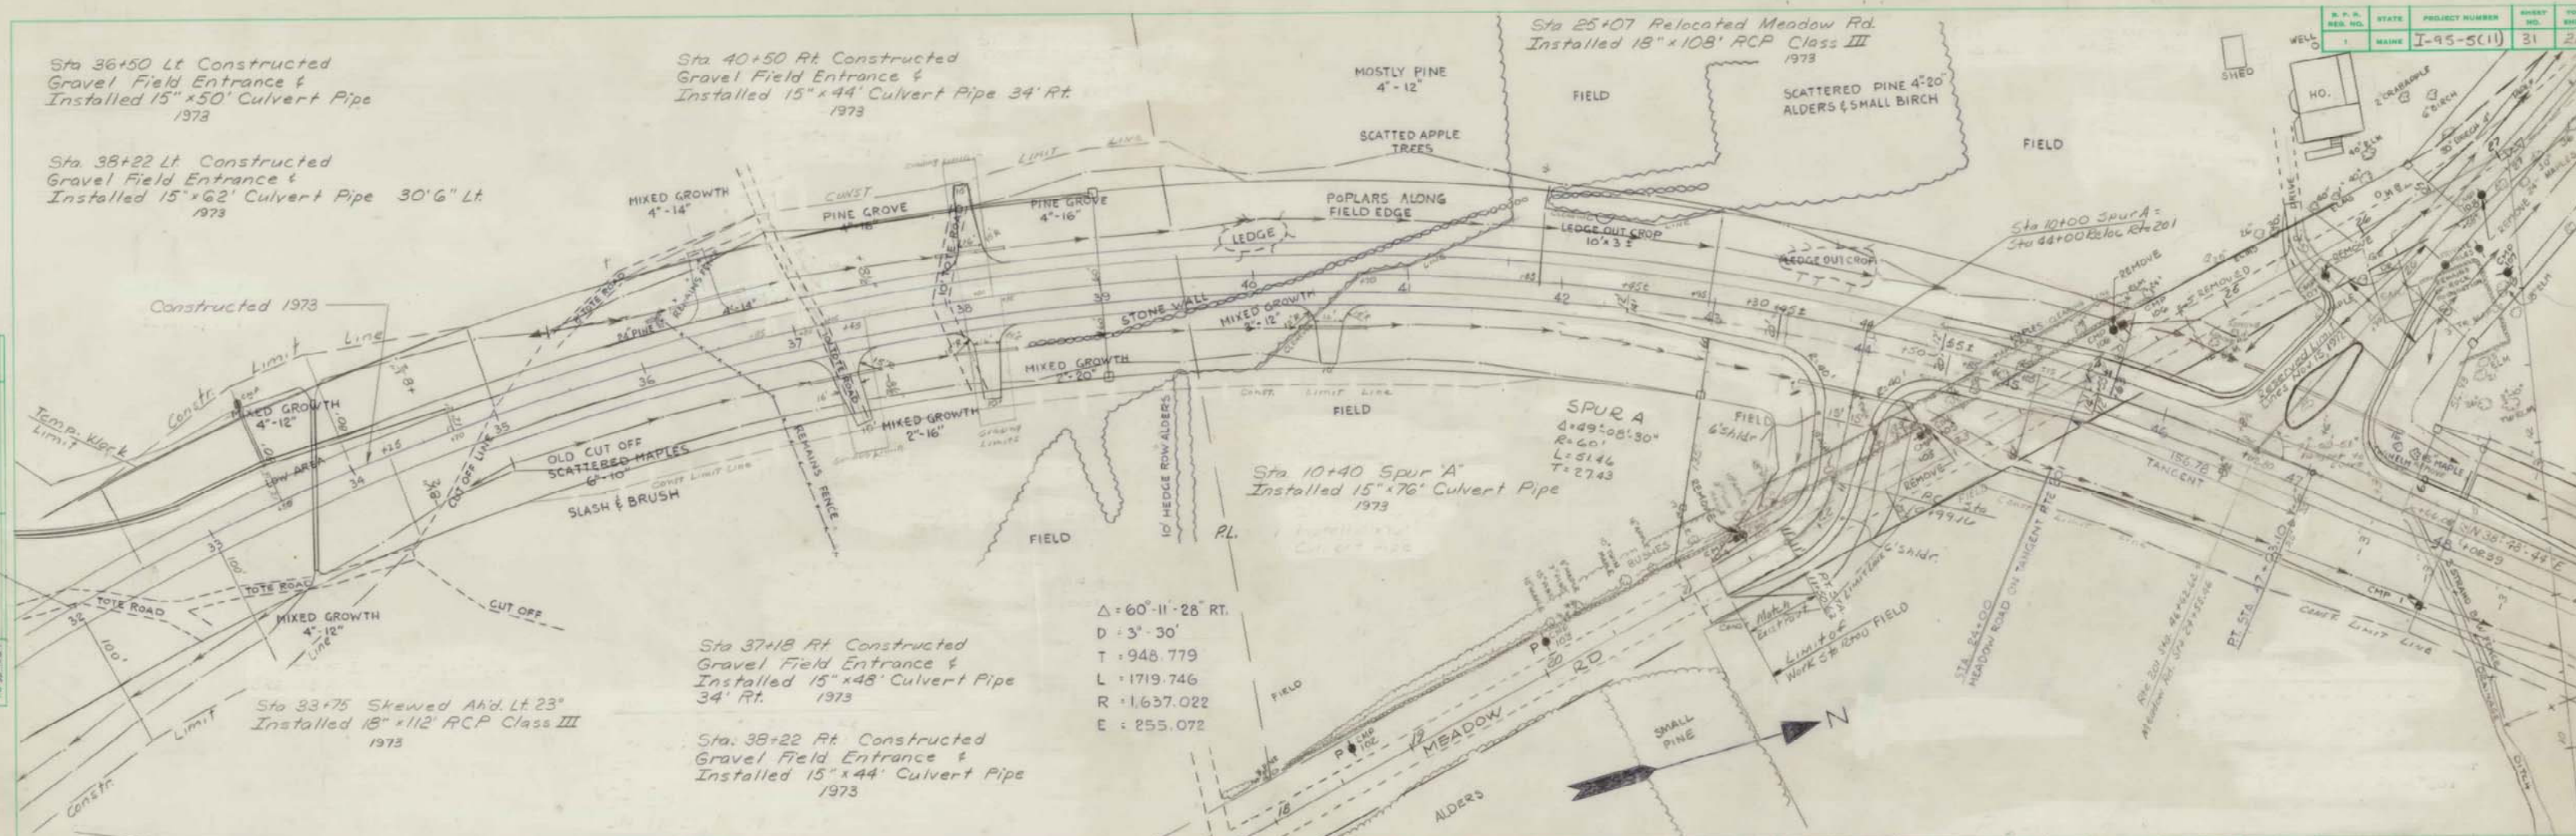

DATE 2-6-69
BY ALEX ASA
SUBMITTED 95-5(11) 31
PROFILE

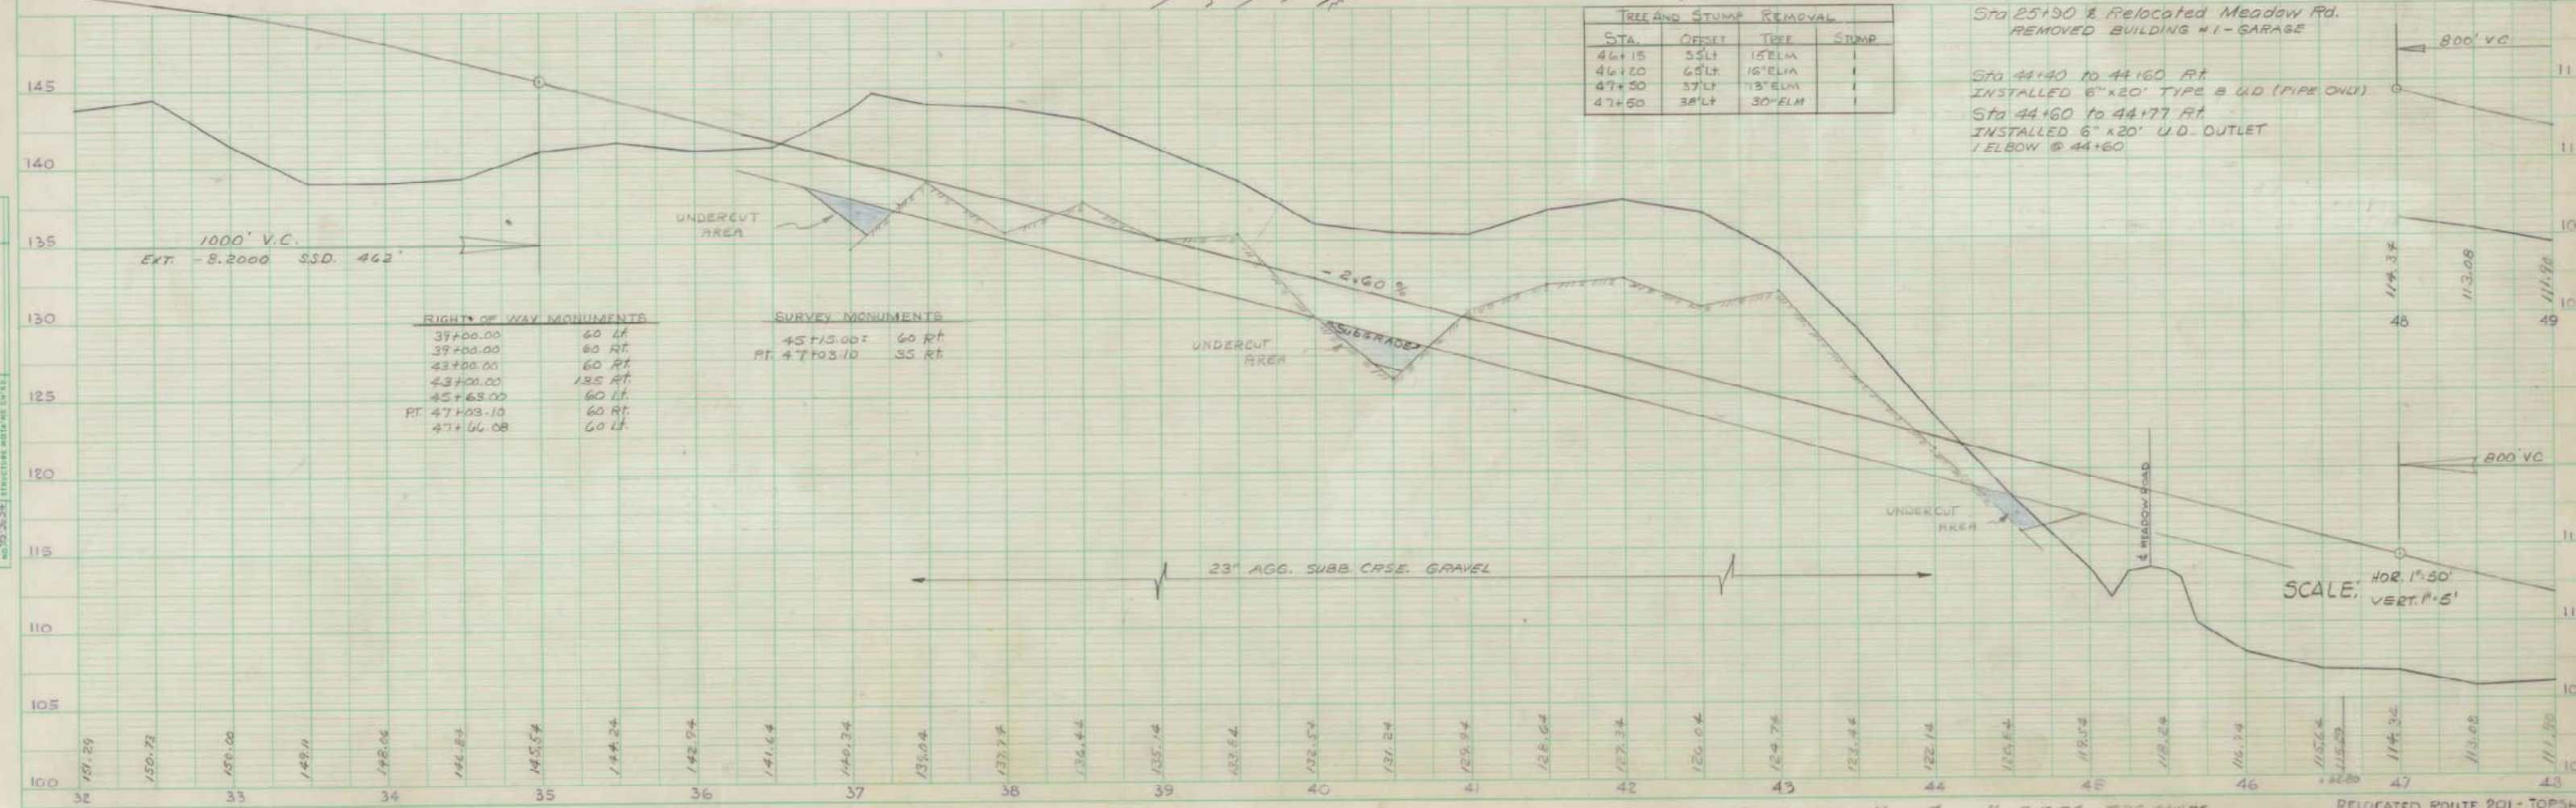

TREE AND STUMP REMOVAL			
STA.	OFFSET	TREE	STUMP
46+15	55'LT	15'ELM	
46+20	65'LT	16'ELM	
47+30	57'LT	13'ELM	
47+50	38'LT	30'ELM	

Sta 25+90 Relocated Meadow Rd.
REMOVED BUILDING #1 - GARAGE
Sta 44+40 to 44+60 Rt.
INSTALLED 6"x20" TYPE B U.D. (PIPE ONLY)
Sta 44+60 to 44+77 Rt.
INSTALLED 6"x20" U.D. OUTLET
ELBOW @ 44+60

"Revised As Built" by Gary Jussell 5-13-75 I-95-5(11)75

RELOCATED ROUTE 201 - TOPSHA