

EMERY W. BOOKER


Ruth Milroy

PI STA = 23+77.25
Δ = 69°46'30"
D = 7'-00"
R = 018.51'
T = 570.74'
L = 996.70'
E = 179°55'

15" BRUSH
CLUMP
STA. 21+62.30 Lt. Rte 125 RELOC.
INST. 15' x 36" CULVERT PIPE OPTION I

STA. 24+50 CONST APPROACH
TO EXISTING Rte 125 of
2" Aggr Base Course - Crushed &
12" Aggr Subbase Course - Gravel


S. F. R.	STATE	PROJECT NUMBER	SHEET NO.	TOTAL SHEETS
1	MAINE	95-5(3)79	31	219

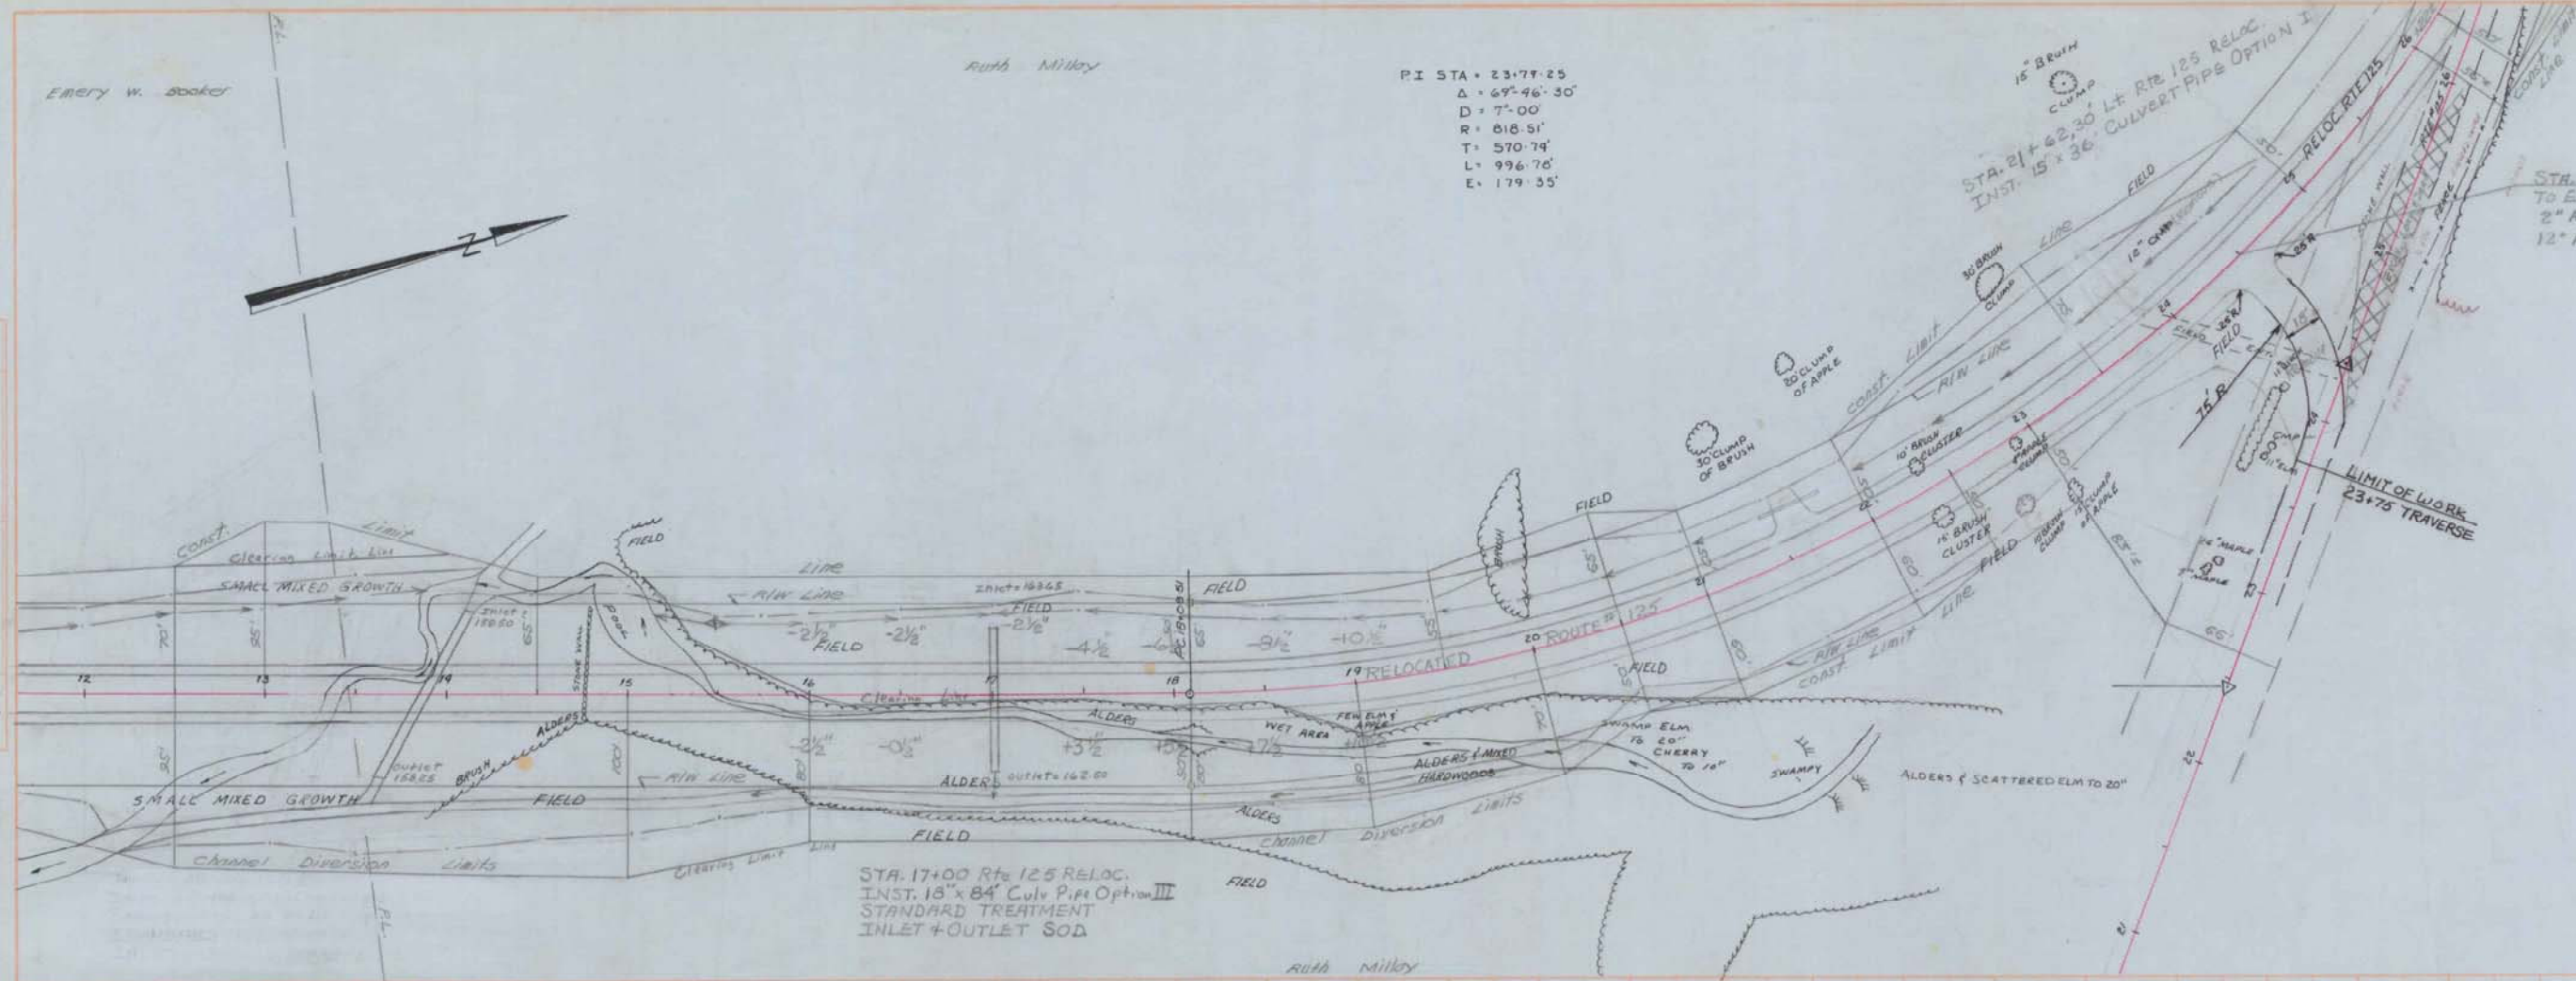

STA. 17+00 Rte 125 RELOC.
INST. 16" x 84" CULV PIPE OPTION III
STANDARD TREATMENT
INLET + OUTLET SOD

R/W MONUMENTS
Rte 125 Sta. 18+08.51 50' LT
Rte 125 Sta. 18+08.51 50' RT

GRUBBING IN FILLS
Rte 125 Sta. 14+50 - Sta. 23+9
Rte 125 Sta. 24+50 - Sta. 28+0

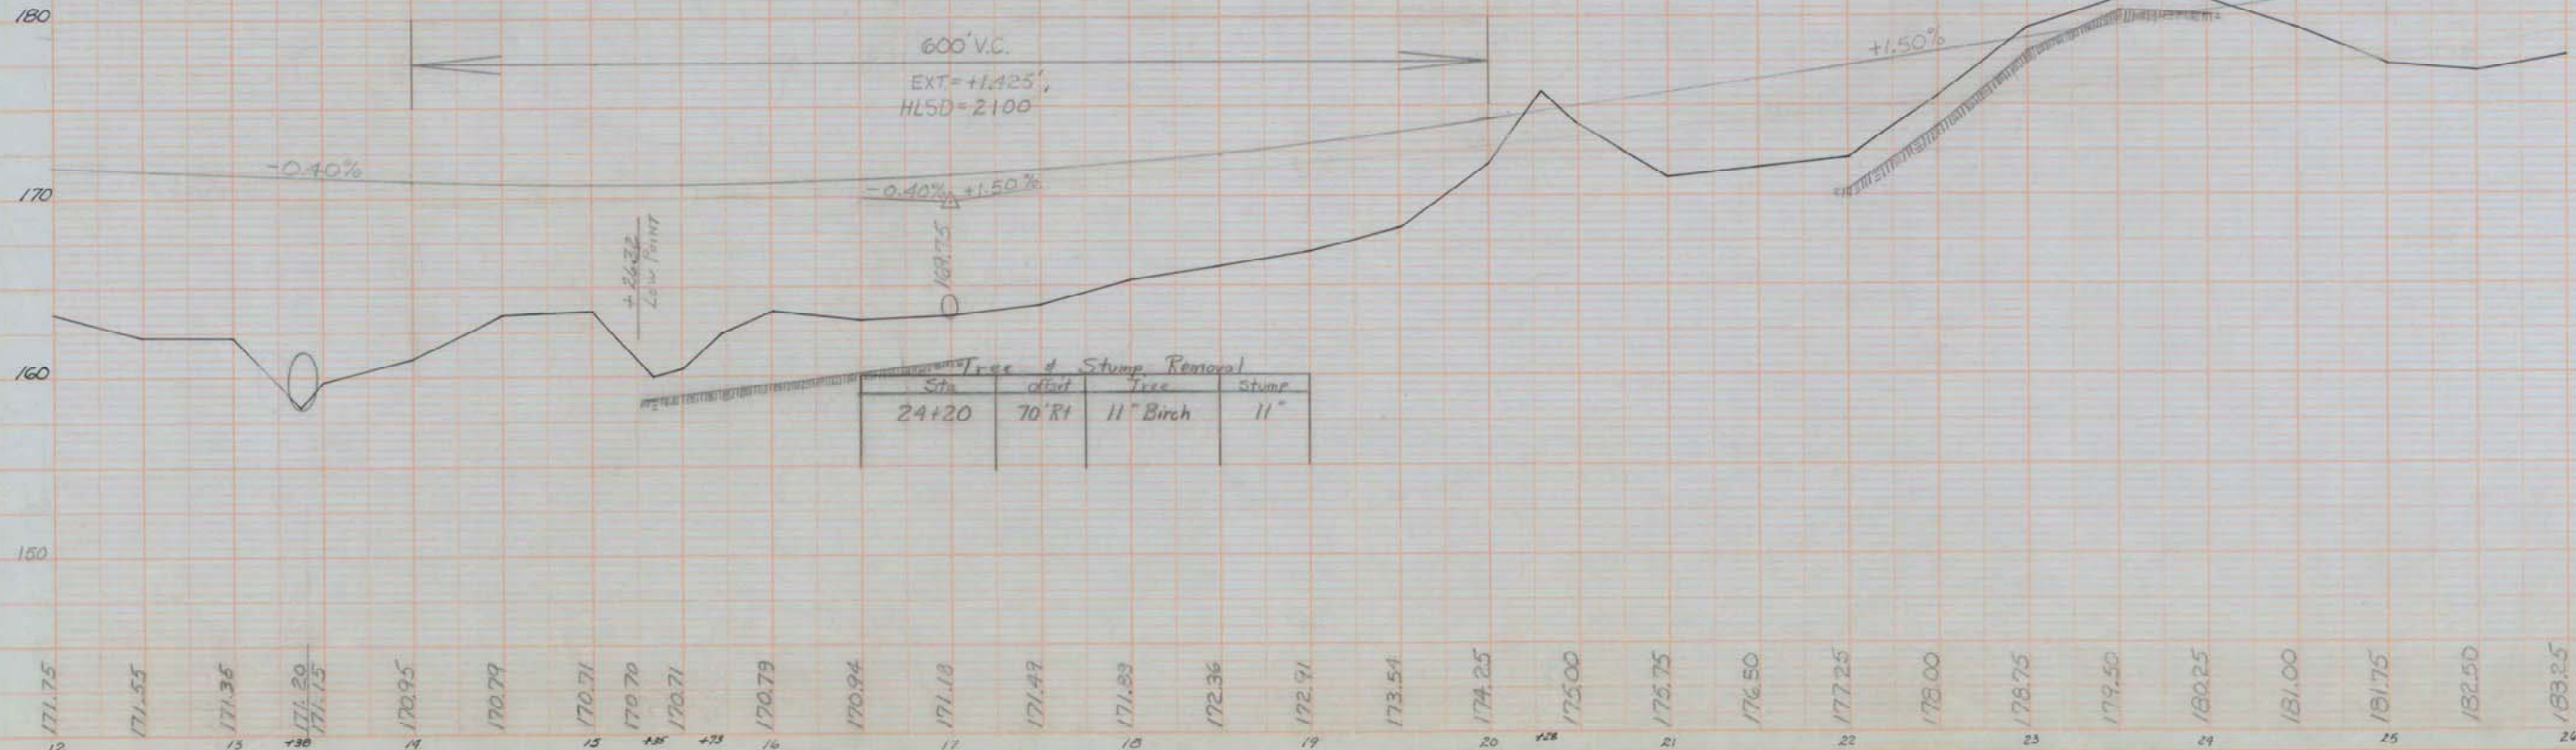

REVISED AS BUILT
1975

TOPSHAM BOWDOIN, BOWDOINHAM

Reloc Rte 125