


CHARLES E. MESERVESE

LONG BRANCH SHEEP FARM

S. P. N.	STATE	PROJECT NUMBER	SHEET NO.	TOTAL SHEETS
1	MAINE	I-95-5(31)	18	21

STA. 909+00 L+SB TO STA. 913+00 L+SB
CONST. 40' TO E.B.M. Sec. 2-Sections

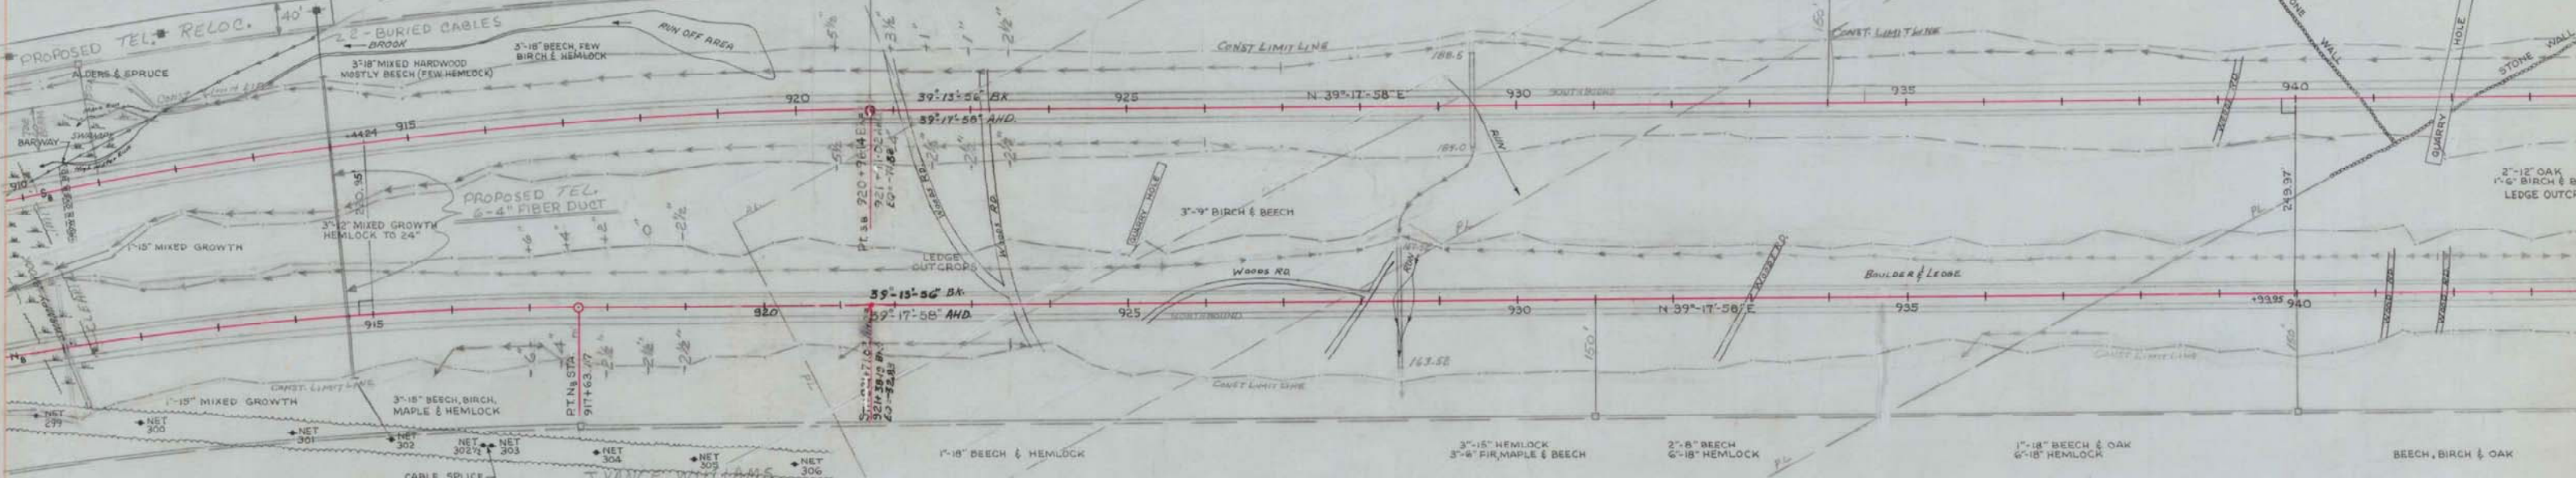

NORTHBOUND
RI STA. 907+72.46
Δ: 25°-10'-52" RT.
D: 1°-15'
T: 1,023.78'
L: 2,014.49'
R: 4,589.66'
E: 112.94'

AS BUILT
1975

SOUTHBOUND
RI STA. 907+66.32
Δ: 27°-06'-50" RT.
D: 1°-00'
T: 1,381.57'
L: 2,711.39'
R: 5,729.58'
E: 164.22'


J. VANCE WILLIAMS
RUBY E. WILLIAMS

STA. S.B. 929+35
INST. 36" X 156" RCP CLASS IV
STANDARD TREATMENT
INLET + OUTLET, RIPRAP + SOD

STA. N.B. 928+50
INST. 36" X 156" CLASS III
STA. TREATMENT
INLET + OUTLET, RIPRAP + SOD

EMERY W. BOOKER

WILFRED A. MORGAN

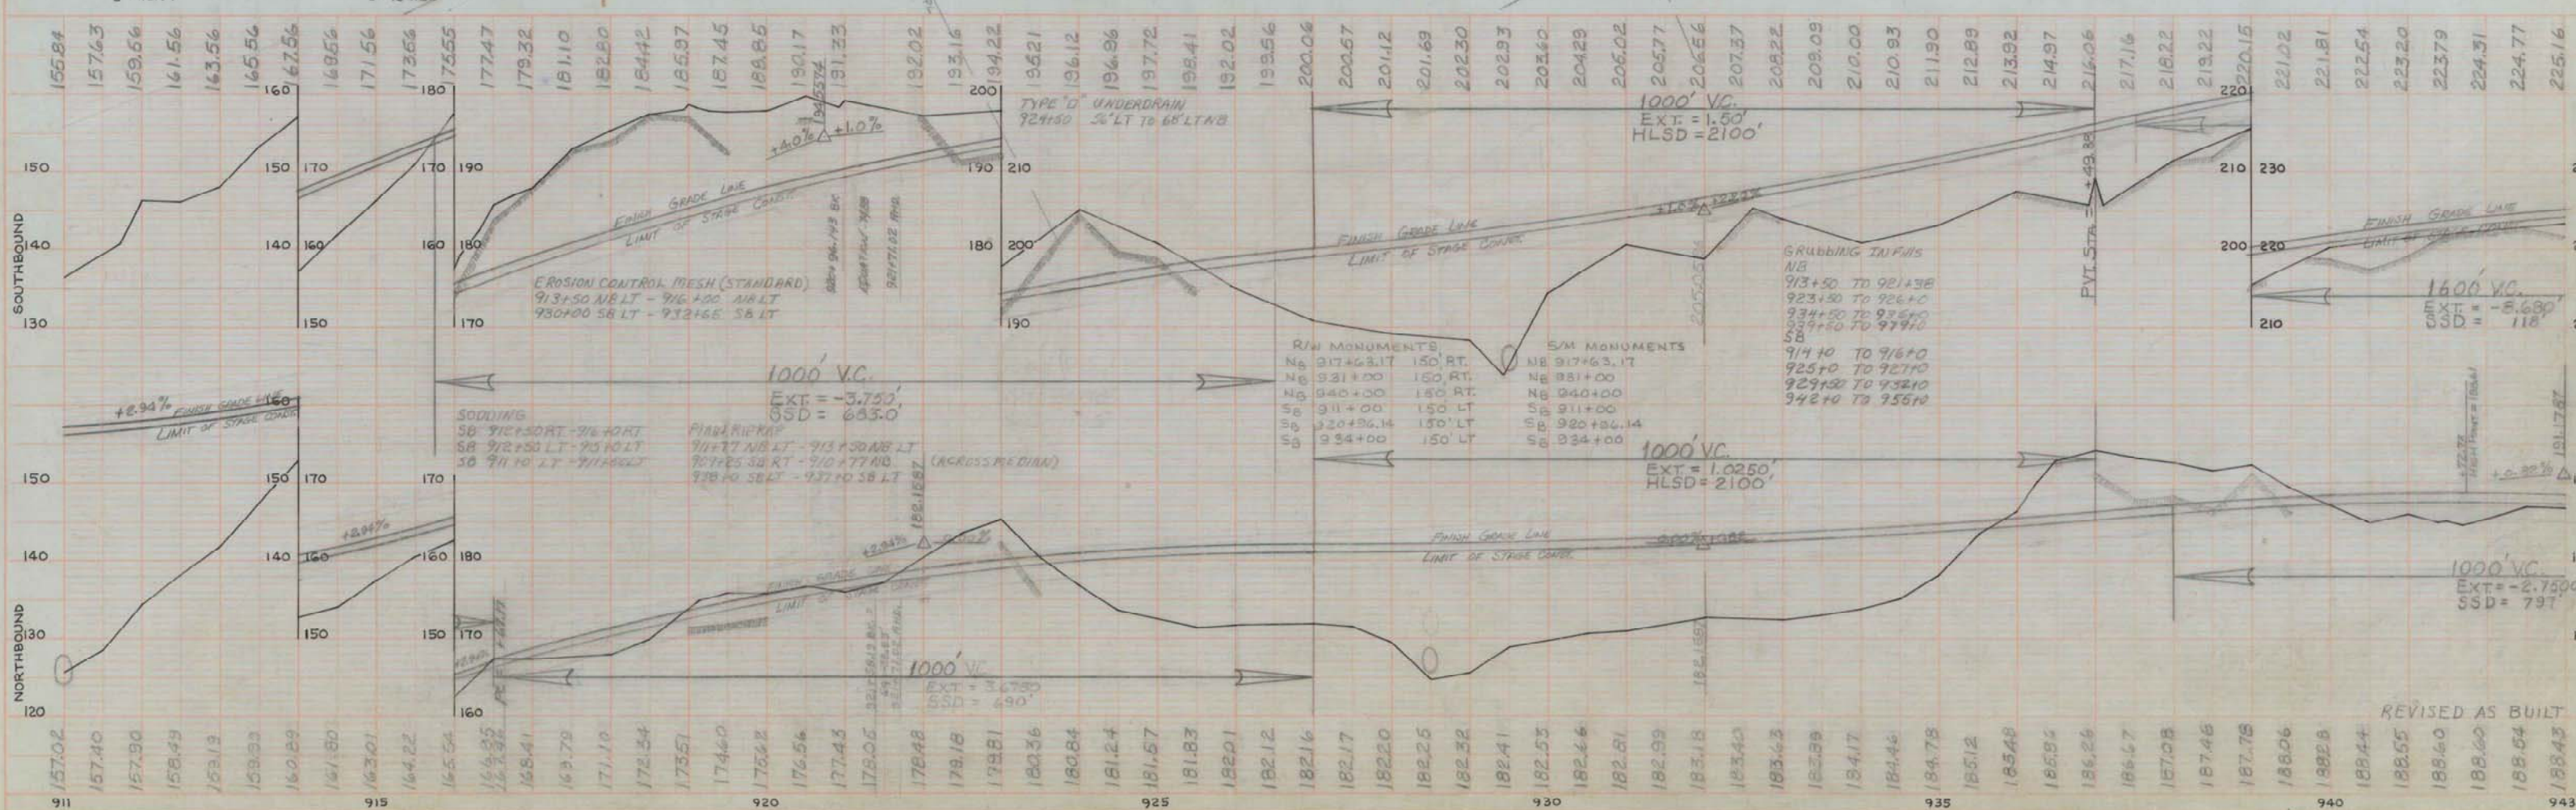

TOPSHAM, BOWDOIN, BOWDOINHAM

BRUNSWICK, WEST GARDEN

REVISED AS BUILT