

Addendum #2

Lewiston Readiness Center POV Parking Addition

Project No. 23SC16-306, Bid Number #20-036

Directorate of Facilities Engineering

31 March 2020

This Addendum forms a part of the Contract Documents and modifies the original Bidding Documents dated 11 March 2020 as noted below. Acknowledge receipt of the Addendum in the space provided on the Bid Form. Failure to do so may subject the Bidder to disqualification. This Addendum consists of the following:

Administrative Bidding Items:

1. The square yardage for ABI #1 was misidentified in the original bidding documents. That is our authorized POV parking area but some of that area is not impacted by that ABI. The actual square yardage for ABI #1 is approximately 2,582 Square Feet. There are two specification changes as part of this addendum being corrected due to this.

Specification Items: (Both of these items deal with the revised square yardage for ABI#1.)

1. **Remove** Section 00 41 13, Contractor Bid Form, and **Insert** attached Section 00 41 13. Contractor Bid Form.
2. **Remove** page 2, Section 01 00 00, Administrative Provisions, and **Insert** attached page 2, Section 00 41 13. Contractor Bid Form.

Drawing Items:

1. **Remove** Sheet CP-101 and **Insert** Attached Sheet CP-101. See notes for Addendum 2 on this sheet.
2. **Insert** Attached Sheet C-102, Striping Plan.
3. **Insert** Attached Sheet C-103, Details.

Attachments:

- 1- Section 00 41 13, Contractor Bid Form
- 2- Page 2, Section 01 00 00, Administrative Provisions
- 3- Sheet CP-101
- 4- Sheet C-102
- 5- Sheet C-103

00 41 13
Contractor Bid Form

Lewiston Readiness Center POV Parking Addition

To: Mrs. Sherrill Hallett
Directorate of Facilities Engineering
Bldg. 8 Camp Keyes
194 Winthrop Street
Augusta, Maine 04330

The undersigned, or Bidder, having carefully examined the form of contract, general conditions, specifications and drawings dated March 11, 2020, prepared by Harriman for Lewiston Readiness Center POV Parking Addition, as well as the premises and conditions relating to the work, proposes to furnish all labor, equipment and materials necessary for and reasonably incidental to the construction and completion of this project for the **Base Bid** amount of:

\$ _____ .00

- 1. Allowances are not included on this project.
No Allowances

\$ 0

- 2. Alternate Bids are included on this project.
Alternate Bids are as shown below
Any dollar amount line below that is left blank by the Bidder shall be read as a bid of **\$0.00**.

1	ABI#1 Repair Existing Asphalt amd stripe (approx. 2,581 SY)	\$ _____ .00
2	insert title of Alternate or "not used"	\$ _____ .00
3	insert title of Alternate or "not used"	\$ _____ .00
4	insert title of Alternate or "not used"	\$ _____ .00
5	insert title of Alternate or "not used"	\$ _____ .00

**00 41 13
Contractor Bid Form**

3. The Bidder acknowledges receipt of the following addenda to the specifications and drawings:

Addendum No. _____ Dated: _____

Addendum No. _____ Dated: _____

4. Bid security *is required* on this project.

If noted above as required, the Bidder shall include a satisfactory Bid Bond (section 00 43 13) or a certified or cashier's check for 5% of the bid amount with this completed bid form submitted to the Owner.

5. Filed Sub-bids *are not required* on this project.

**00 41 13
Contractor Bid Form**

Lewiston Readiness Center POV Parking Addition

- 6. The Bidder agrees, if the Owner offers to award the contract, to provide any and all bonds and certificates of insurance, as well as Schedule of Values, Project Schedule, and List of Subcontractors and Suppliers if required by the Owner, and to sign the designated Construction Contract within twelve calendar days after the date of notification of such acceptance, except if the twelfth day falls on a State of Maine government holiday or other closure day, or a Saturday, or a Sunday, in which case the aforementioned documents must be received before 12:00 noon on the first available business day following the holiday, other closure day, Saturday, or Sunday.

As a guarantee thereof, the Bidder submits, together with this bid, a bid bond or other acceptable instrument as and if required by the Bid Documents.

- 7. This bid is hereby submitted by:

Signature: _____

Printed name and title: _____

Company name: _____

Mailing address: _____

City, state, zip code: _____

Phone number: _____

Email address: _____

State of incorporation, if a corporation: _____

List of all partners, if a partnership: _____


- a. Base Bid: No limitations on days and time work may be performed provided all local ordinances are complied with.
- b. ABI #1:
 - i. Dates that work cannot be performed on ABI #1 are as follow:
 - 1. June 5-June 7.
 - 2. June 14-July 4
 - 3. July 31-Aug 2
 - 4. Sep 4-7
 - ii. Work in areas adjacent to the separate kitchen facility cannot be performed from Monday-Thursday throughout the duration of the project. Project site must be able to be used for parking starting on every Monday. This may be existing conditions, compacted gravel, asphalt binder or asphalt surface.
 - iii. Work adjacent to Goddard Rd (excluding the area noted in item ii above) must be coordinated with the unit prior to start.
 - iv. In the event of a weekend facility rental the front parking lot must be left in a usable condition by end of day the Friday before the rental under the same condition as indicated in item ii above.
 - v. All areas must be available for parking during the June 14-July 4 time period. Same conditions as listed in item ii above apply.

- 5. The Contractor must work with each organization to gain access to certain area through-out the building. When the Contractor needs to gain access to certain areas, he must notify each organization seven working days in advance.
- 6. Coordinate use of premises under direction of Owner.
- 7. The Contractor shall be responsible for his/her security in Construction Area until substantial completion. The contractor shall coordinate security of Building with Owner.

E. Owner Occupancy

- 1. Owner will occupy surrounding areas during entire period of construction, to conduct Owner's normal operations. The Contractor shall cooperate with Owner to minimize conflict to the Owner's operations.

- F. Owner-furnished Products: Not Used
- G. Schedule of Allowances: Not Used
- H. Additive Alternate: ABI#1: Repair Existing Asphalt and stripe (approx. 2,581 SY)
- I. Unit Prices: Not Used

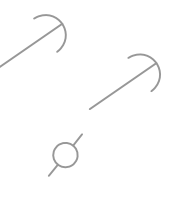

ALFRED A. PLOURDE PARKWAY

GODDARD ROAD

SEE SPECIFIC NOTE

MAIN BUILDING

KITCHEN BUILDING

MAINTENANCE BUILDING

2ND PLATOON STORAGE BUILDING

3RD PLAT. STORAGE BLDG.

smoker's shed

fuel tank & pump

GATE

GATE

paved parking area

paved parking area

area of broken pavement

regiole

- NEW EXISTING PAVEMENT
- ARMORY POV PARKING
- KITCHEN POV PARKING

PROJECT SCOPE OF WORK

1. REMOVE EXISTING PAVEMENT
2. REMOVE UNSUITABLE GRAVEL BASE AND SUB BASE
3. REPLACE SUBBASE (12" MDOT TYPE D GRAVEL 95% COMPACTION)
4. REPLACE BASE (6" MDOT TYPE A 95% COMPACTION)
5. INSTALL 2" BINDER (MDOT 19.0mm 95% COMPACTION)
6. INSTALL 1 1/2" SURFACE (MDOT 12.5mm 95% COMPACTION) STRIPE LOT
7. STRIPE LOT

GENERAL NOTES


1. MAINTAIN EXISTING ELEVATIONS AND DRAINAGE
2. KITCHEN POV PARKING CAN ONLY BE WORKED ON FRIDAYS AND WHEN THIS PROJECT IS BE SHALE MONDAY THROUGH THURSDAY CONTRACTOR RESPONSIBLE FOR COORDINATION WITH DISSAFE AND THE CITY OF LEWISTON
3. OTHER WORK TIME LIMITATIONS CAN BE FOUND IN SECTION 01 00 00.
4. ALL REQUIRED SAWCUTS SHALL BE STRAIGHT

SPECIFIC NOTES

1. END NEW PAVEMENT 1 FOOT FROM EXISTING FENCING.

ADDENDUM 2 NOTES:

1. SEE DETAIL C-3/C-403 FOR NEW TO EXISTING INTERFACE.
2. EDGES OF PAVEMENT STRAIGHTENED OUT TO PROVIDE A CLEAN EDGE.
3. EROSION CONTROL MEASURES SAME AS IN BASE BID SEE SHEET C-102.
4. PAVEMENT DETAIL CAN BE FOUND IN DETAIL C-103.

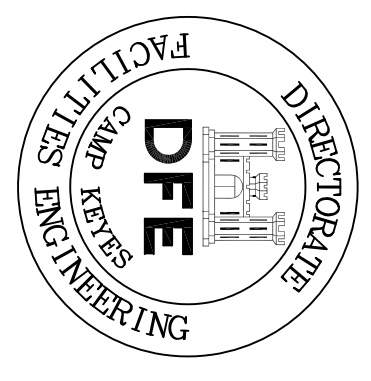

PLAN REVISIONS		
Rev#	Description	Date
0	BID DOCUMENTS	3-31-20

DESIGNED BY: PRL
 DRAWN BY: PRL
 CHECKED BY:
 DATE: 3-14-20
 SCALE: 1"=20'
 DFE PROJECT NO: 23SC16-306


STATE OF MAINE
 DEPARTMENT OF DEFENSE, VETERANS
 AND EMERGENCY MANAGEMENT
 DIRECT OF FAC ENGINEERING
 BLDG. 8, CAMP KEYES
 AUGUSTA, MAINE 04330
 1 (207) 430-6329

LEWISTON RDY CTR PARKING ADDITION
 LEWISTON, ME


 SITE LAYOUT PLAN

PLAN PROGRESS
 DRAFT
 35% REVIEW
 65% REVIEW
 95% REVIEW
 FINAL REVIEW
 FOR BIDDING
 ISSUED FOR CONSTRUCTION
 RECORD DRAWINGS

SHEET ID:
 CP101
 SHEET: 1 OF 1

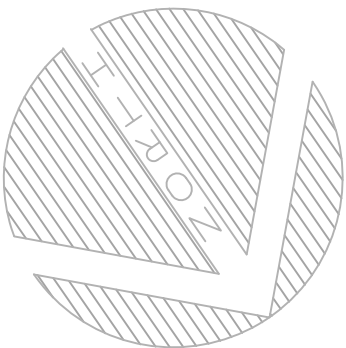

GENERAL NOTES:
 1. PAINT SHALL BE WHITE AND APPLIED IN MANUFACTURERS SPECIFICATIONS.

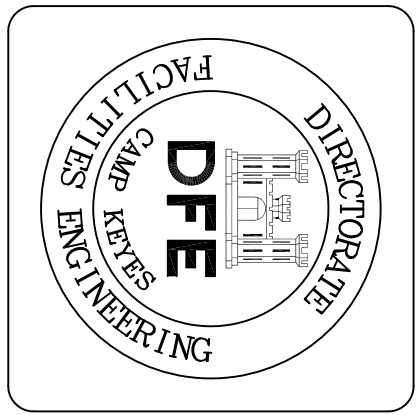

PLAN REVISIONS		
Rev#	Description	Date
0	ADDENDUM 2	3-31-20


DESIGNED BY:
 DRAWN BY: PRL
 CHECKED BY:
 DATE: 3-31-20
 SCALE: 1"=20'
 DFE PROJECT NO: 23SC16-306

STATE OF MAINE
 DEPARTMENT OF DEFENSE, VETERANS AND EMERGENCY MANAGEMENT
 DFE
 BLDG. 8, CAMP KEYS
 AUGUSTA, MAINE 04330
 1 (207) 430-6329

LEWISTON RDY CTR PARKING ADDITION
 LEWISTON, ME
 --
 STRIPING PLAN

PLAN PROGRESS
 DRAFT
 35% REVIEW
 65% REVIEW
 95% REVIEW
 FINAL REVIEW
 FOR BIDDING
 ISSUED FOR CONSTRUCTION
 RECORD DRAWINGS

SHEET ID:
 C-102
 SHEET: 2 OF 3

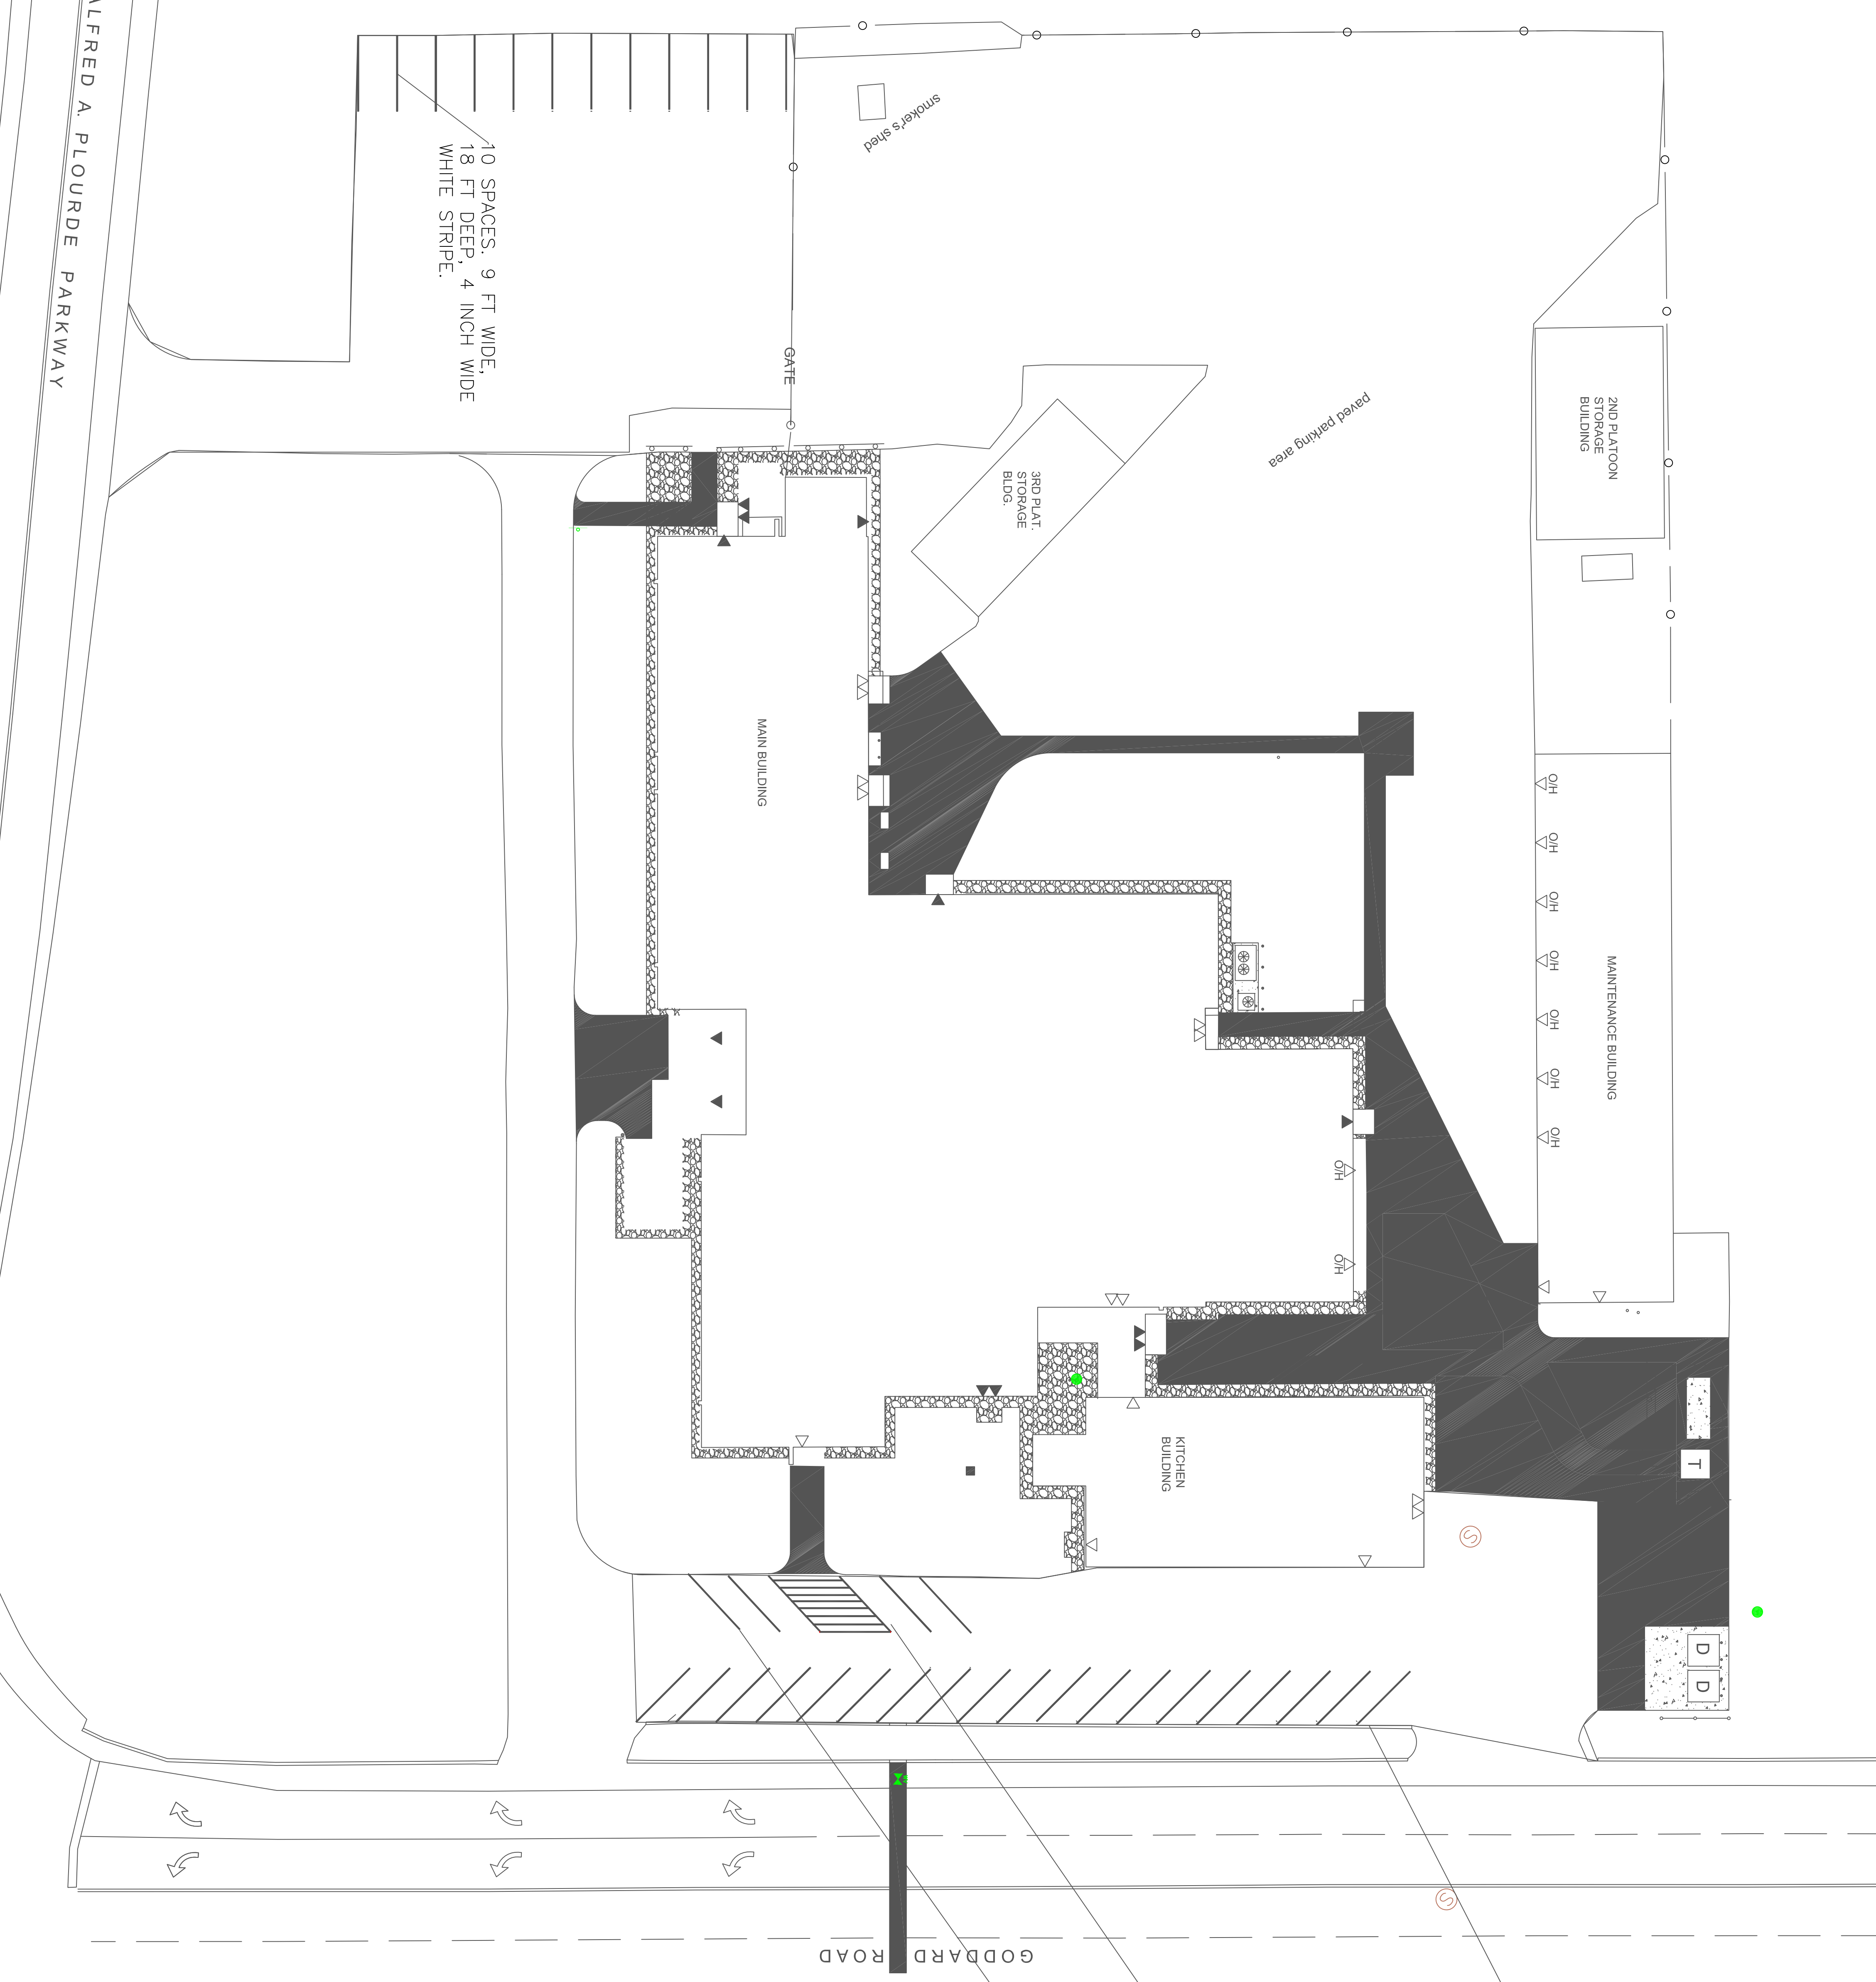

18 SPACES, 9 FT WIDE,
 18 FT DEEP, 4 INCH WIDE
 WHITE STRIPE, ANGLES 45 DEGREES.

STRIPED AREA SEE DETAIL
 C4/C-103.

4 ADA SPACES, SAME
 DIMENSIONS AS 18
 SPACES ACROSS
 SEE DETAIL C1/C-103

10 SPACES, 9 FT WIDE,
 18 FT DEEP, 4 INCH WIDE
 WHITE STRIPE.

ALFRED A. PLOURDE PARKWAY

GODDARD ROAD

