



1	GENERAL REVISIONS	Date	Appr.
1.28.19			

DESIGNED BY: **KFM**
 DRAWN BY: **KFM**
 CHECKED BY: **KFM/MAD**
 DATE: **12/28/2018**
 SCALE: **1/4" = 1'-0"**
 DFE PROJECT NO: **23SR18-458-D**


STATE OF MAINE
 DEPARTMENT OF DEFENSE, VETERANS
 AND EMERGENCY MANAGEMENT
 Cordija Capital Projects Group
 16 Tannery Lane, Suite 23
 Cambridge, Maine, 04843
 207-236-9970 / mdaigle@cordjagp.com

CAMP KEYS REUTILIZATION PROJECT
 CAMP KEYS, AUGUSTA, MAINE
 BUILDING NO. 7 RENOVATIONS
 PLUMBING DRAIN & VENT PLANS
 FIRST & SECOND FLOOR - NW WING


PLAN PROGRESS

<input type="checkbox"/>	DRAFT
<input type="checkbox"/>	35% REVIEW
<input type="checkbox"/>	65% REVIEW
<input type="checkbox"/>	95% REVIEW
<input type="checkbox"/>	FINAL REVIEW
<input checked="" type="checkbox"/>	FOR BIDDING
<input type="checkbox"/>	ISSUED FOR CONSTRUCTION
<input type="checkbox"/>	RECORD DRAWINGS


SHEET ID:
P-102
 SHEET: 62 OF 126

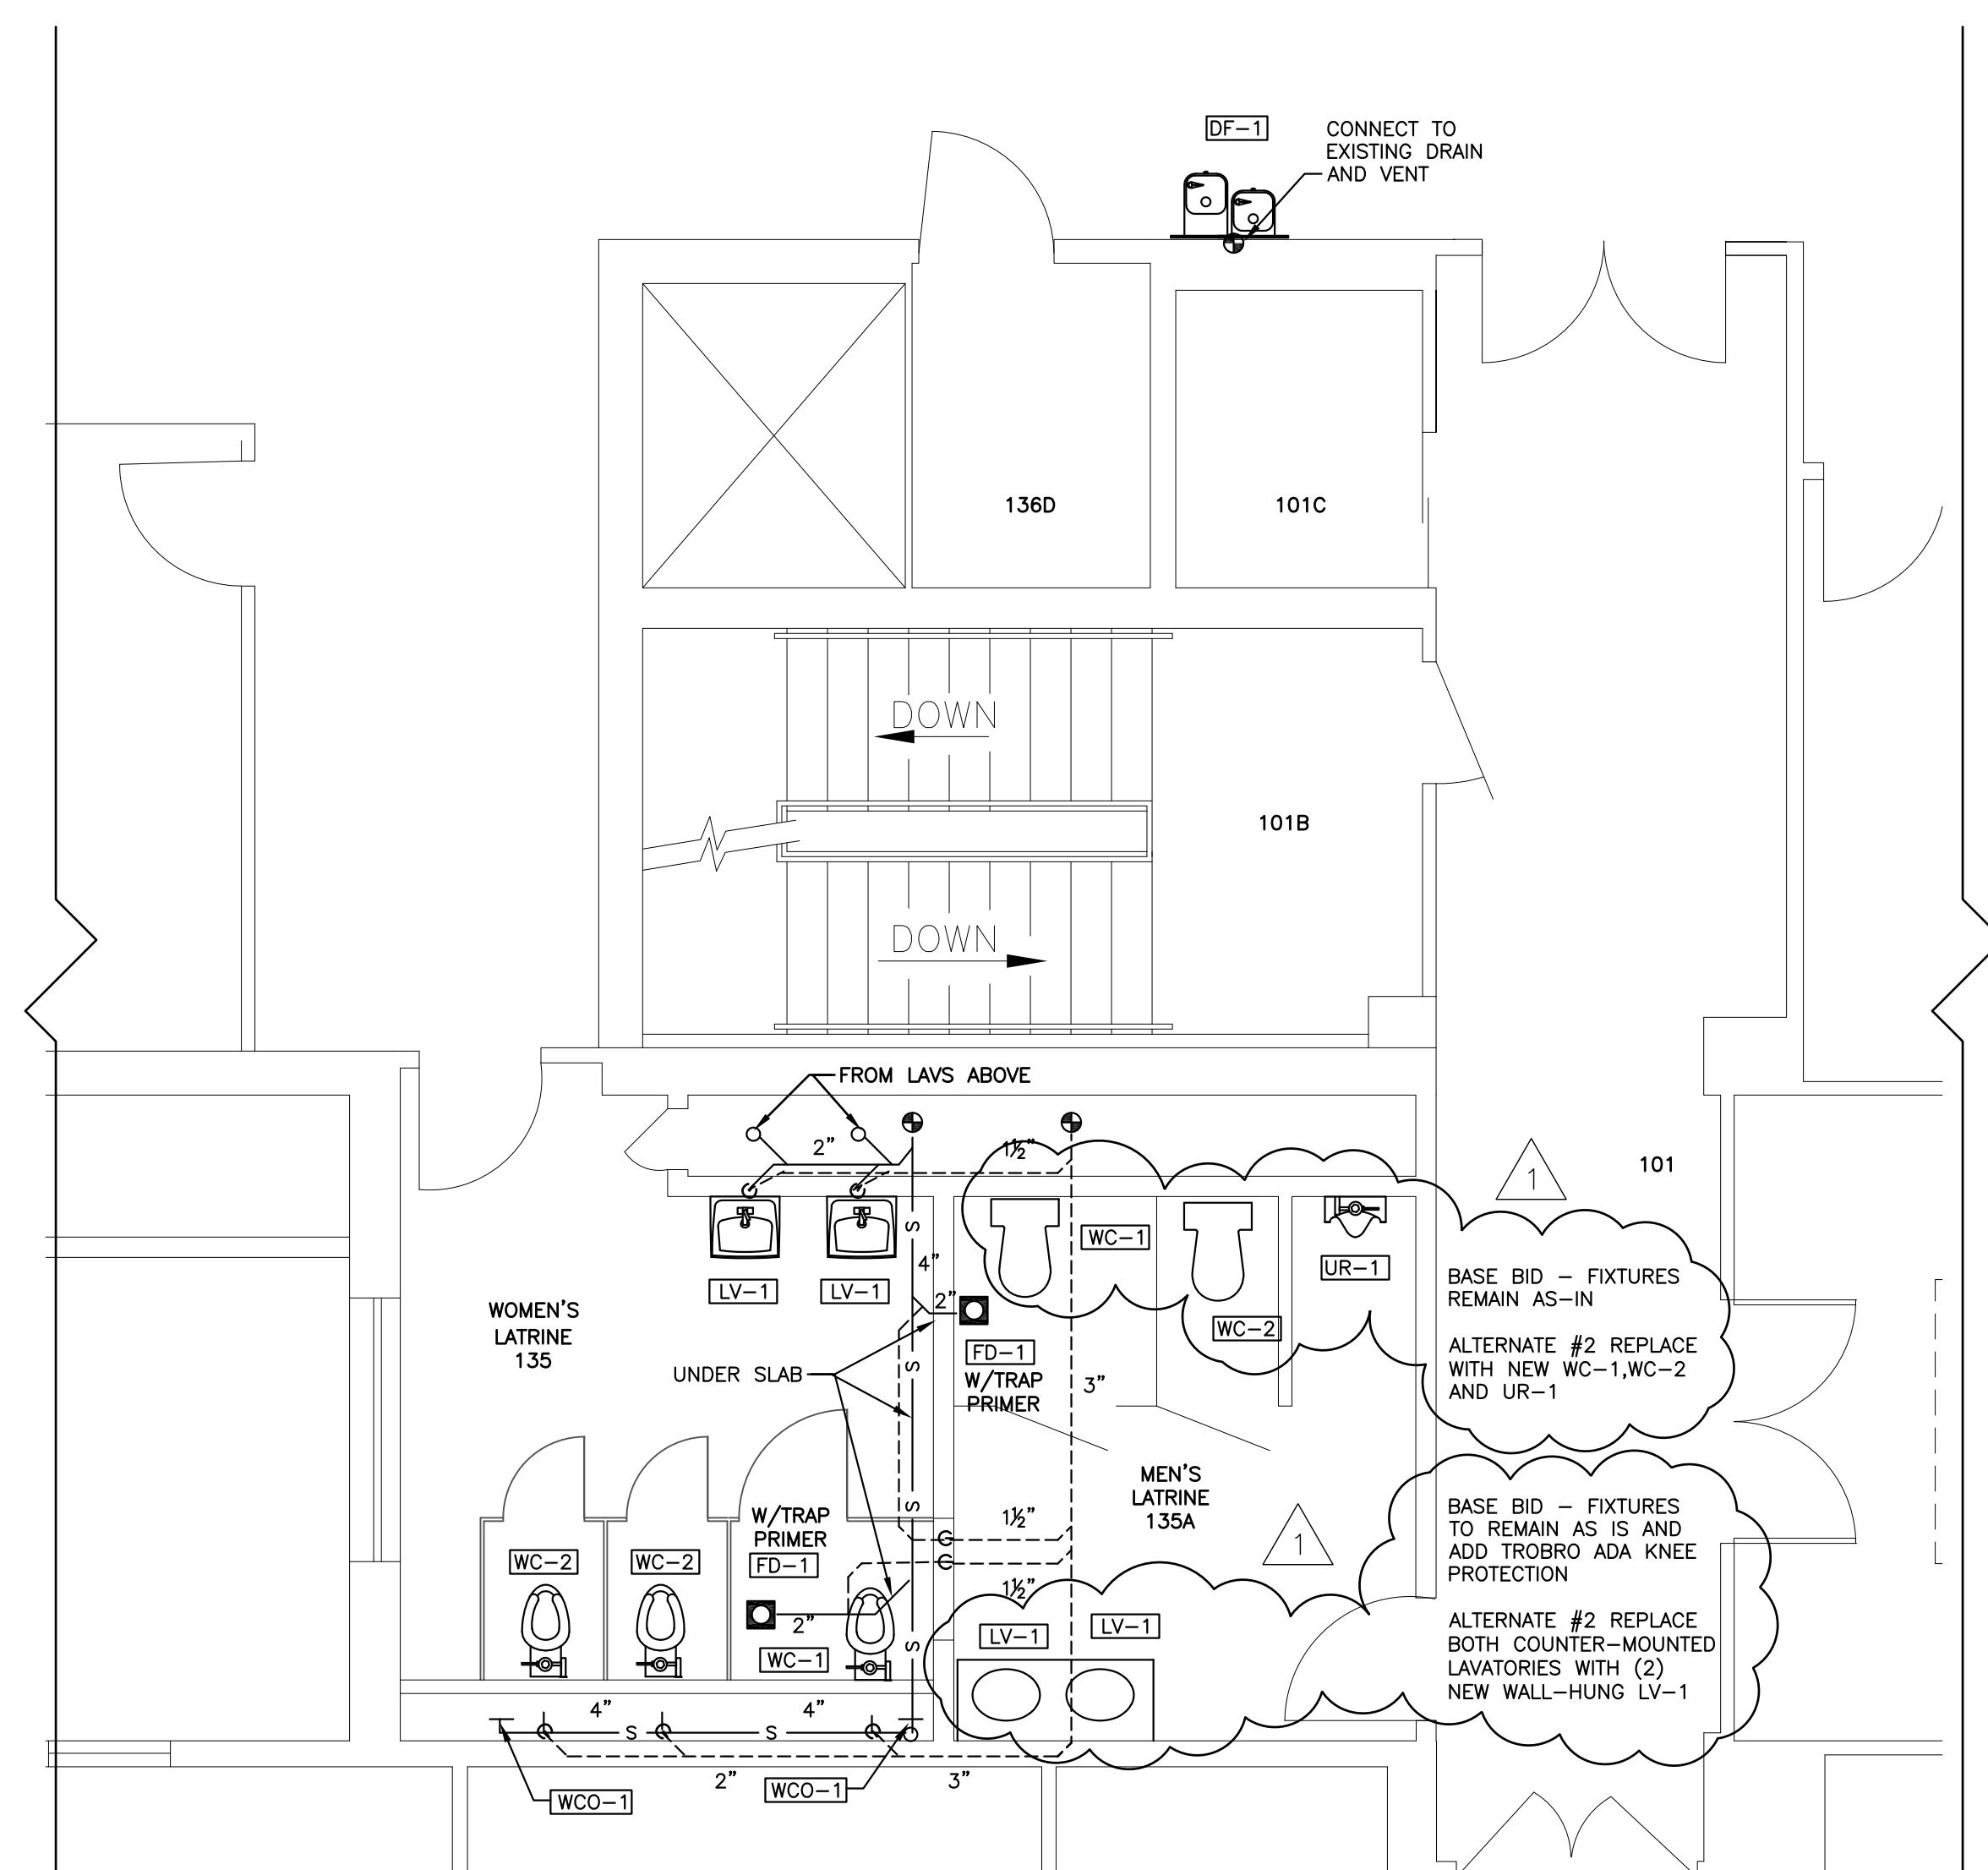

1 PLUMBING DRAIN & VENT PARTIAL PLAN
 FIRST FLOOR - NORTHWEST WING
 SCALE: 1/4" = 1'-0"

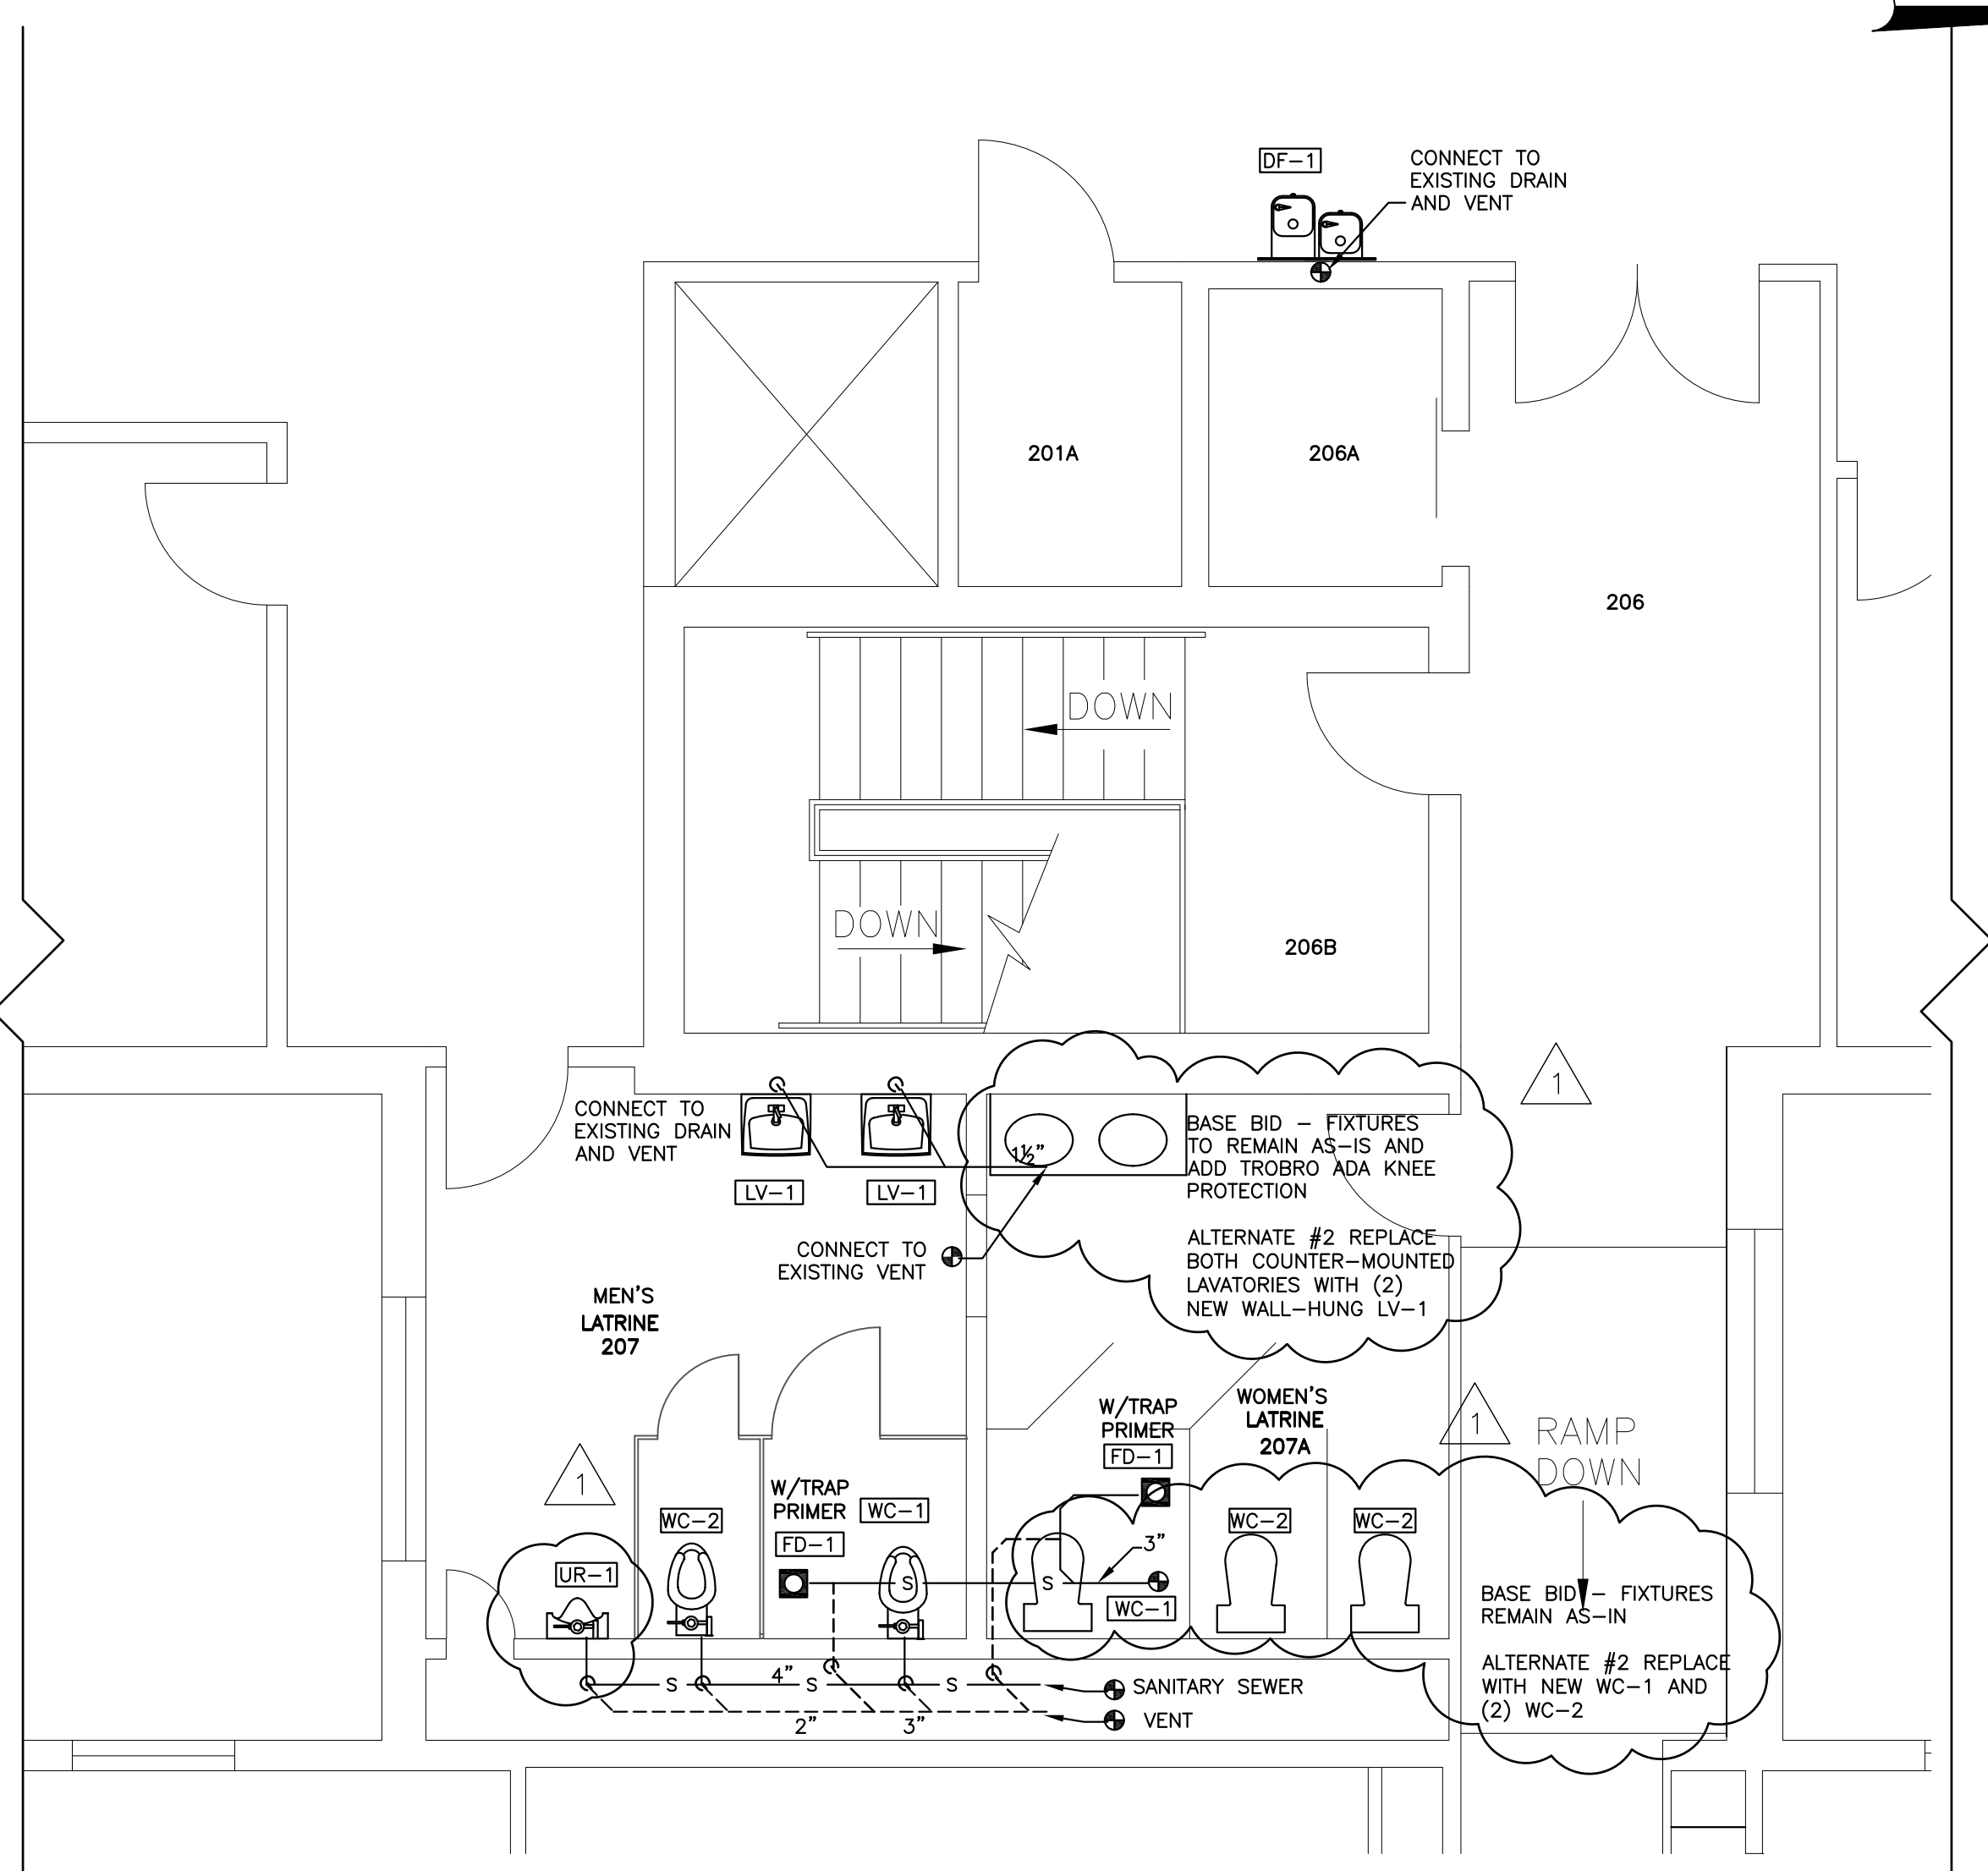


2 PLUMBING DRAIN & VENT PARTIAL PLAN
 SECOND FLOOR - NORTHWEST WING
 SCALE: 1/4" = 1'-0"

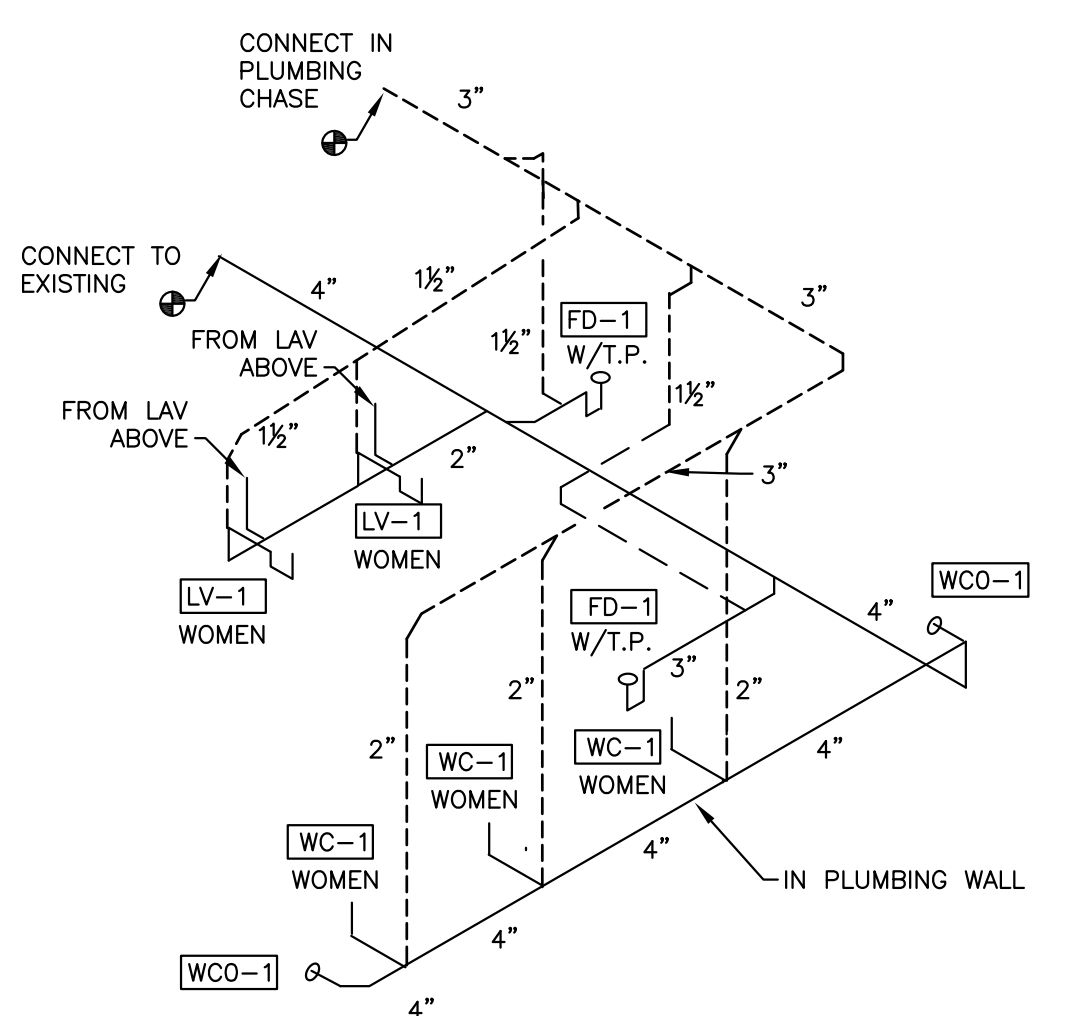


3 PLUMBING DRAIN & VENT ISOMETRIC
 FIRST FLOOR - NORTHWEST WING
 SCALE: NONE

ISOMETRIC PIPING LEGEND



SANITARY PIPING	—————
VENT PIPING - BELOW SLAB	- - - - -
VENT PIPING - ABOVE SLAB	- · - · -

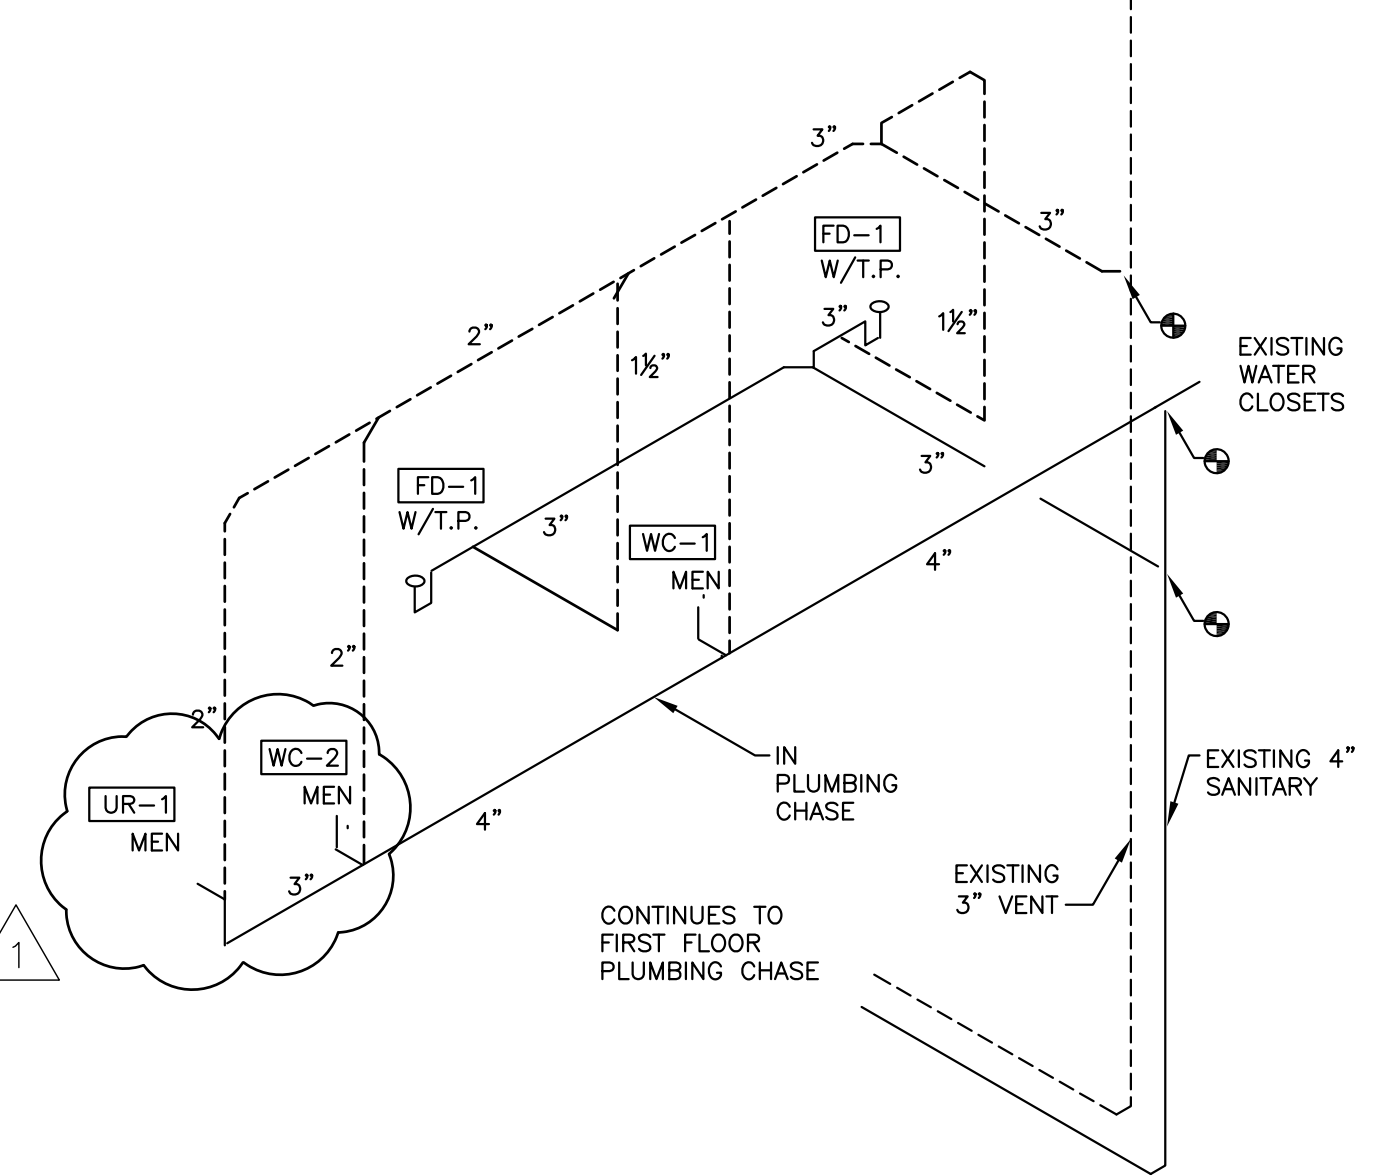

4 PLUMBING DRAIN & VENT ISOMETRIC
 SECOND FLOOR - NORTHWEST WING
 SCALE: NONE

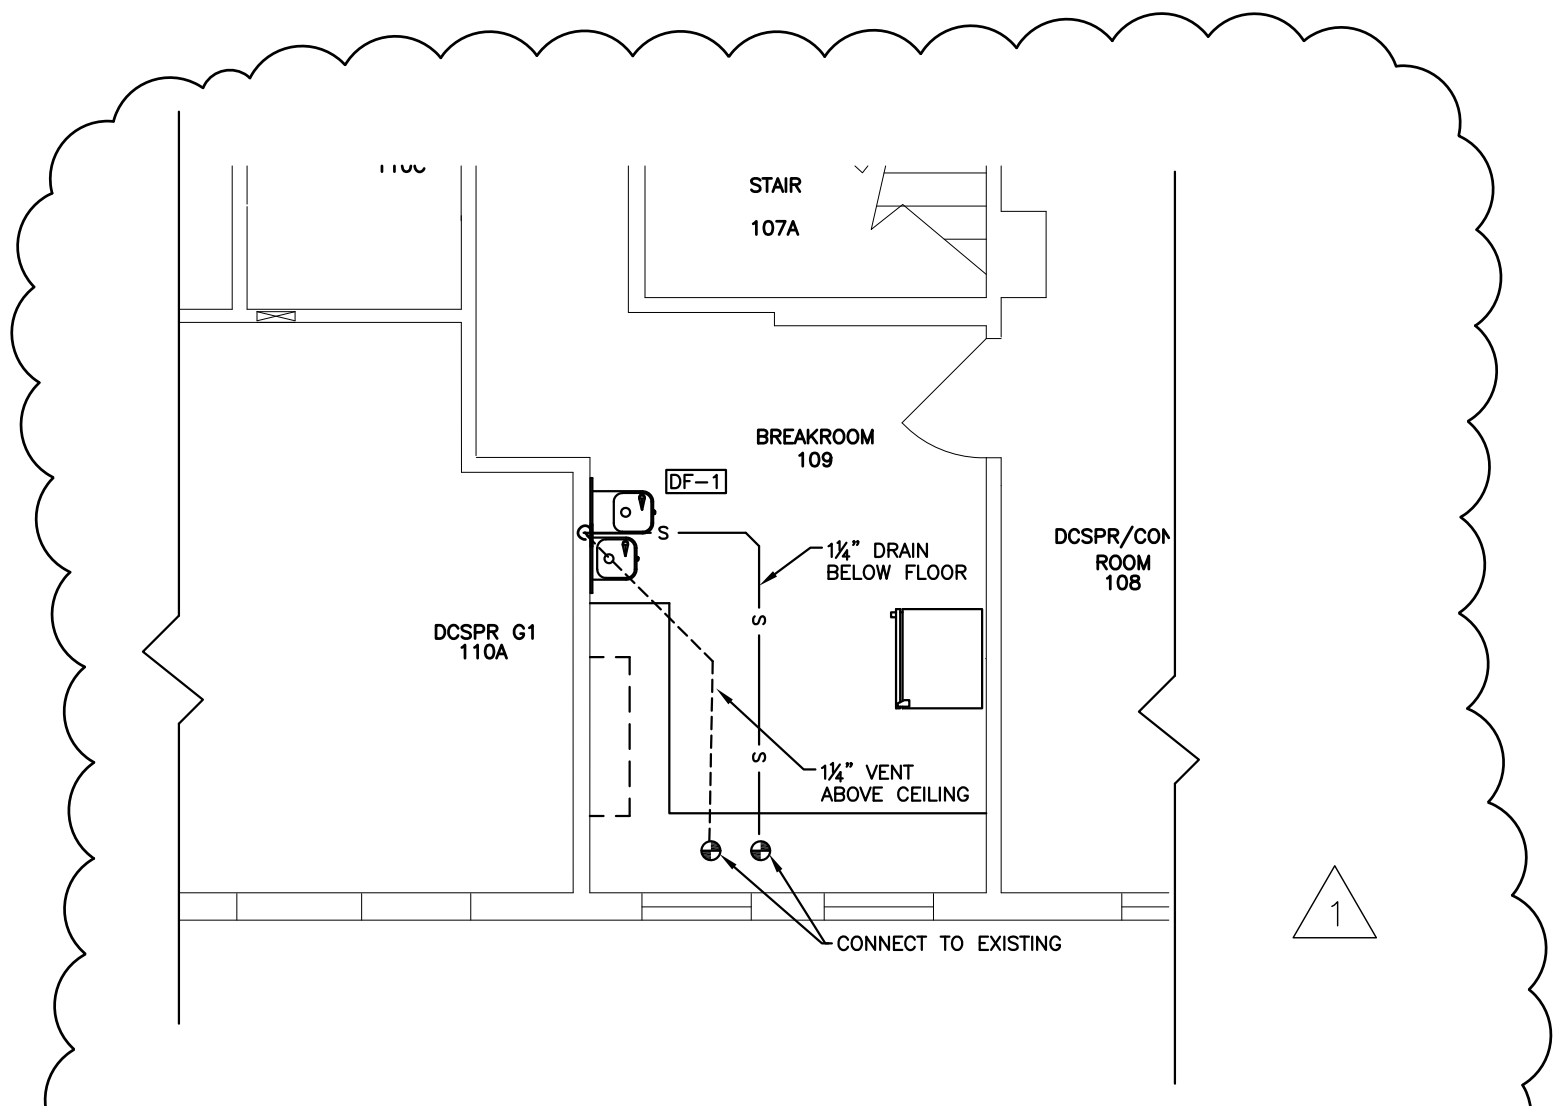



5 PLUMBING DRAIN & VENT PARTIAL PLAN
 ROOM 109 - ADA WATER FOUNTAIN
 SCALE: 1/4" = 1'-0"

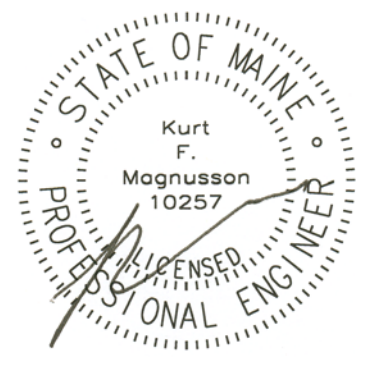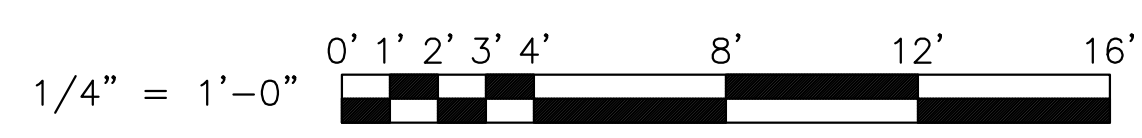

MECHANICAL SYSTEMS ENGINEERS
 ROYAL RIVER CENTER, UNIT 10B
 10 FOREST FALLS DRIVE, YARMOUTH, MAINE 04096
 (207) 948-1441
 FACEBOOK: MECHANICAL SYSTEMS ENGINEERS
 CELEBRATING 50 YEARS IN BUSINESS
 © COPYRIGHT 2018



January 28, 2019 - 8:44 am
 K:\Projects\1813 Camp Keys Bldg 7 P101-P104 & P201 (01-23-2019).dwg

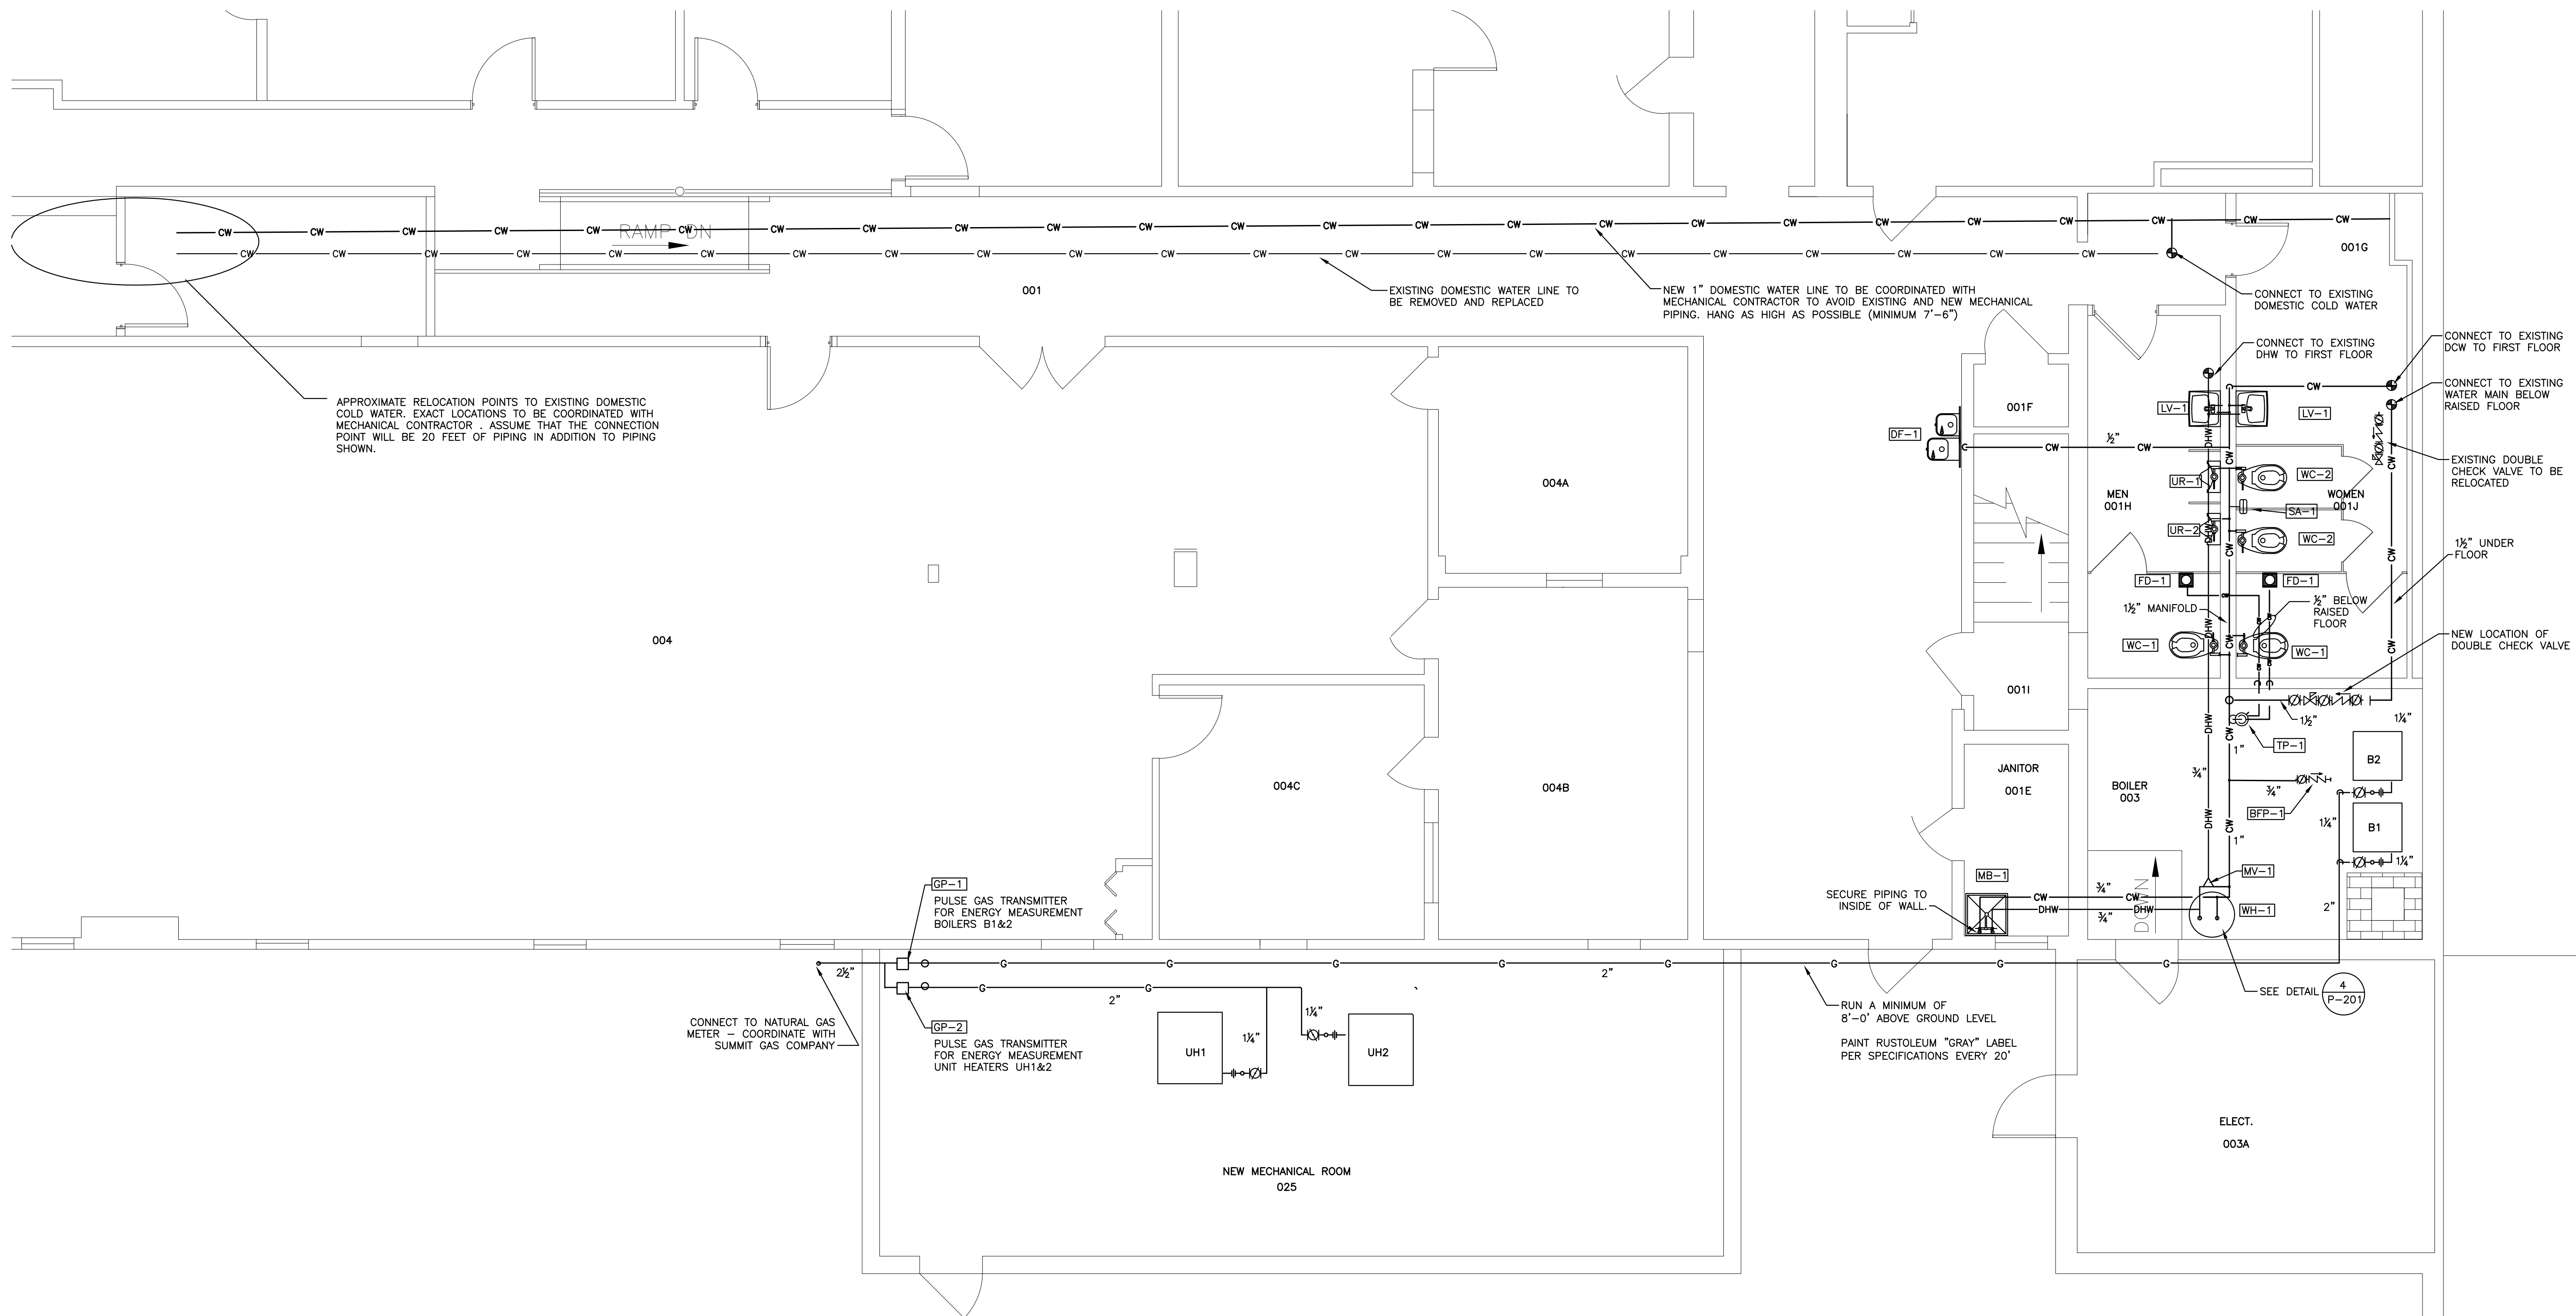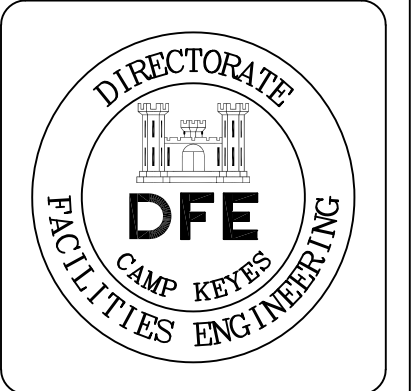

PLAN REVISIONS	
1	GENERAL REVISIONS
1.28.19	Date
	Appr.
	Rev# Description

DESIGNED BY:	KM
DRAWN BY:	KFM/MAD
CHECKED BY:	KFM/MAD
DATE:	12/28/2018
SCALE:	1/4" = 1'-0"
DFE PROJECT NO.:	235R18-458-D
STATE OF MAINE DEPARTMENT OF DEFENSE, VETERANS AND EMERGENCY MANAGEMENT	
Cordja Capital Projects Group	
16 Tannery Lane, Suite 23 Camden, Maine 04843	
207-236-9970 / mdsigle@cordjagroup.com	



CAMP KEYES REUTILIZATION PROJECT
CAMP KEYES, AUGUSTA, MAINE
BUILDING NO. 7 RENOVATIONS
PLUMBING WATER & GAS PIPING PLAN
LOWER LEVEL NORTH END

PLAN PROGRESS	
<input type="checkbox"/>	DRAFT
<input type="checkbox"/>	35% REVIEW
<input type="checkbox"/>	65% REVIEW
<input type="checkbox"/>	95% REVIEW
<input type="checkbox"/>	FINAL REVIEW
<input checked="" type="checkbox"/>	FOR BIDDING
<input type="checkbox"/>	ISSUED FOR CONSTRUCTION
<input type="checkbox"/>	RECORD DRAWINGS

SHEET ID:
P-103
SHEET: 63 OF 126

1 PLUMBING WATER & GAS PIPING PLAN
LOWER LEVEL NORTH END
SCALE: 1/4" = 1'-0"

January 28, 2019 - 7:39 am
X:\Projects\1813 Camp Keyes Bldg 7\Address\1813 Bldg 7 P101-P104 & P201 (01-23-2019).dwg

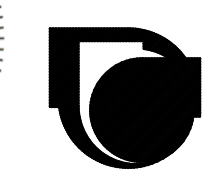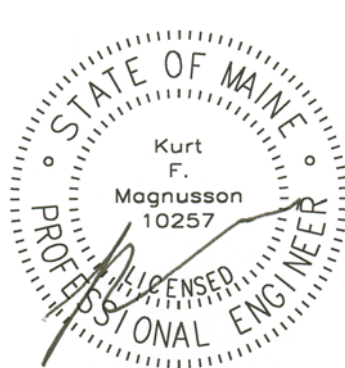


MECHANICAL SYSTEMS ENGINEERS
ROYAL RIVER CENTER, UNIT 108
10 FOREST FALLS DRIVE, YARMOUTH, MAINE 04096
(207) 846-1441
FACEBOOK: MECHANICAL SYSTEMS ENGINEERS
CELEBRATING 50 YEARS IN BUSINESS
© COPYRIGHT 2018




KEY PLAN
NO SCALE


January 28, 2019 - 7:39 am
 X:\Projects\1813 Camp Keyes Bldg 7\Address\1813 Bldg 7 P101-P104 & P201 (01-23-2019).dwg

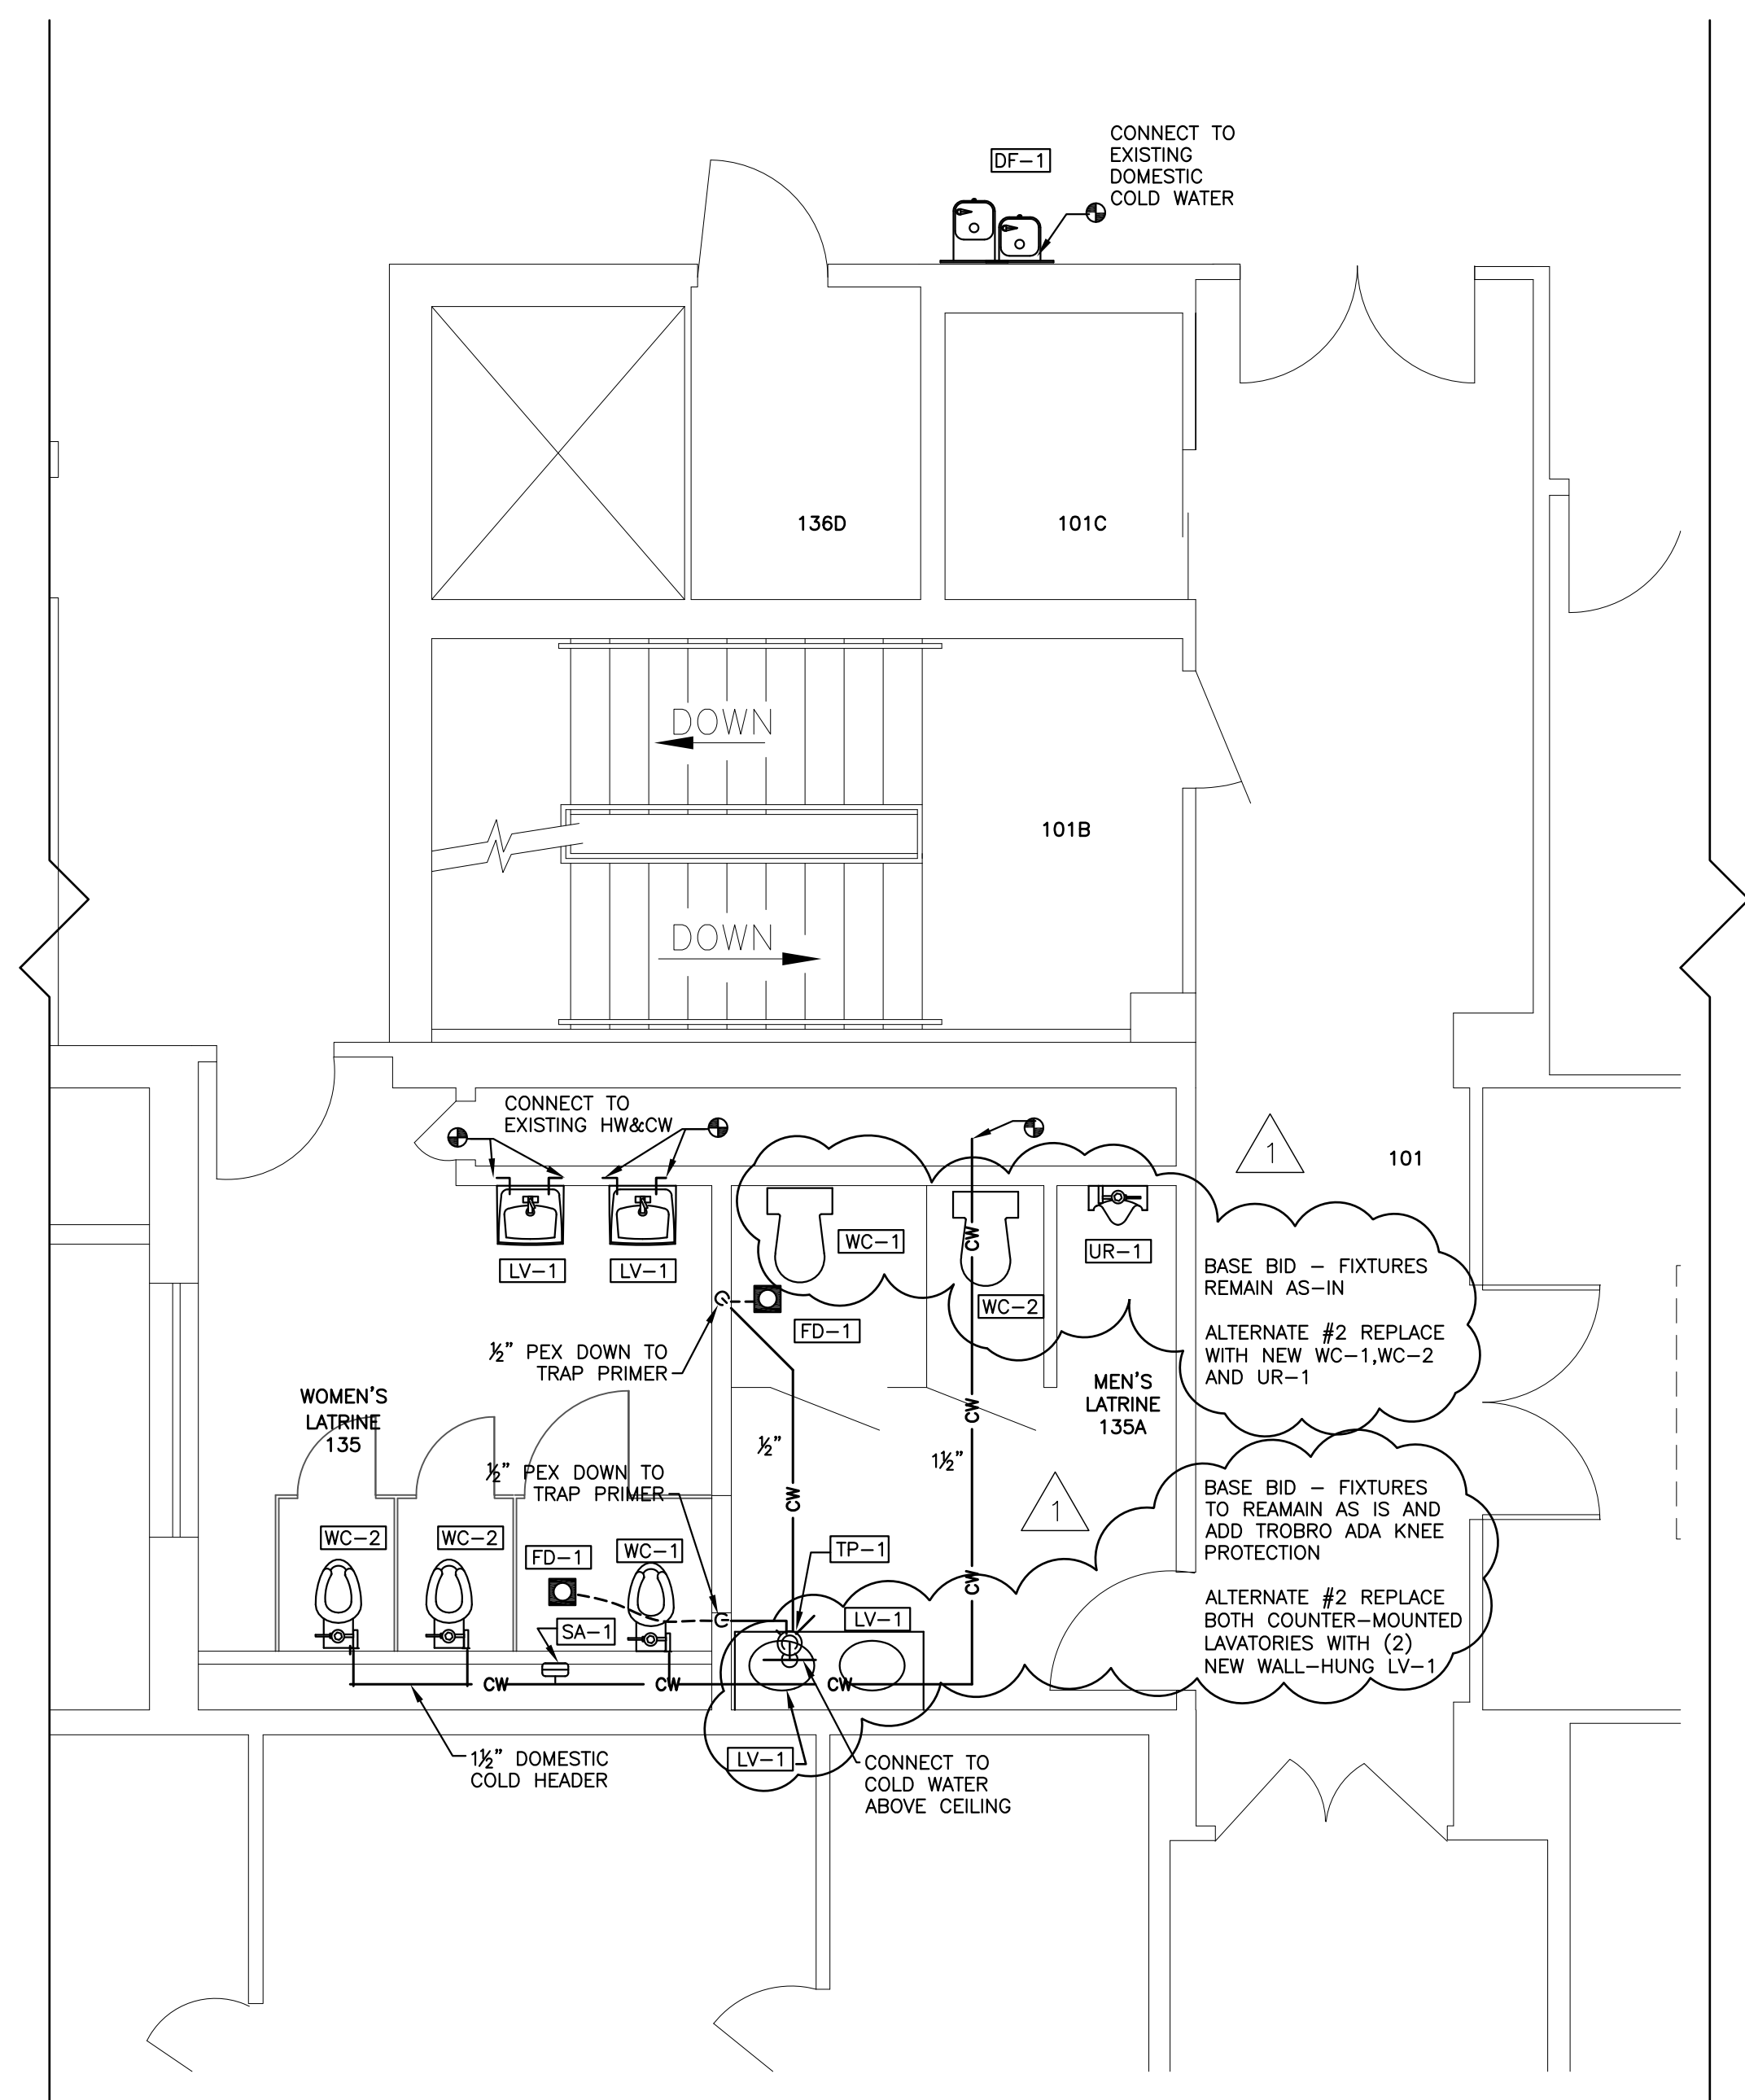



1 PLUMBING WATER PARTIAL PLAN
 FIRST FLOOR - NORTHWEST WING
 SCALE: 1/4" = 1'-0"

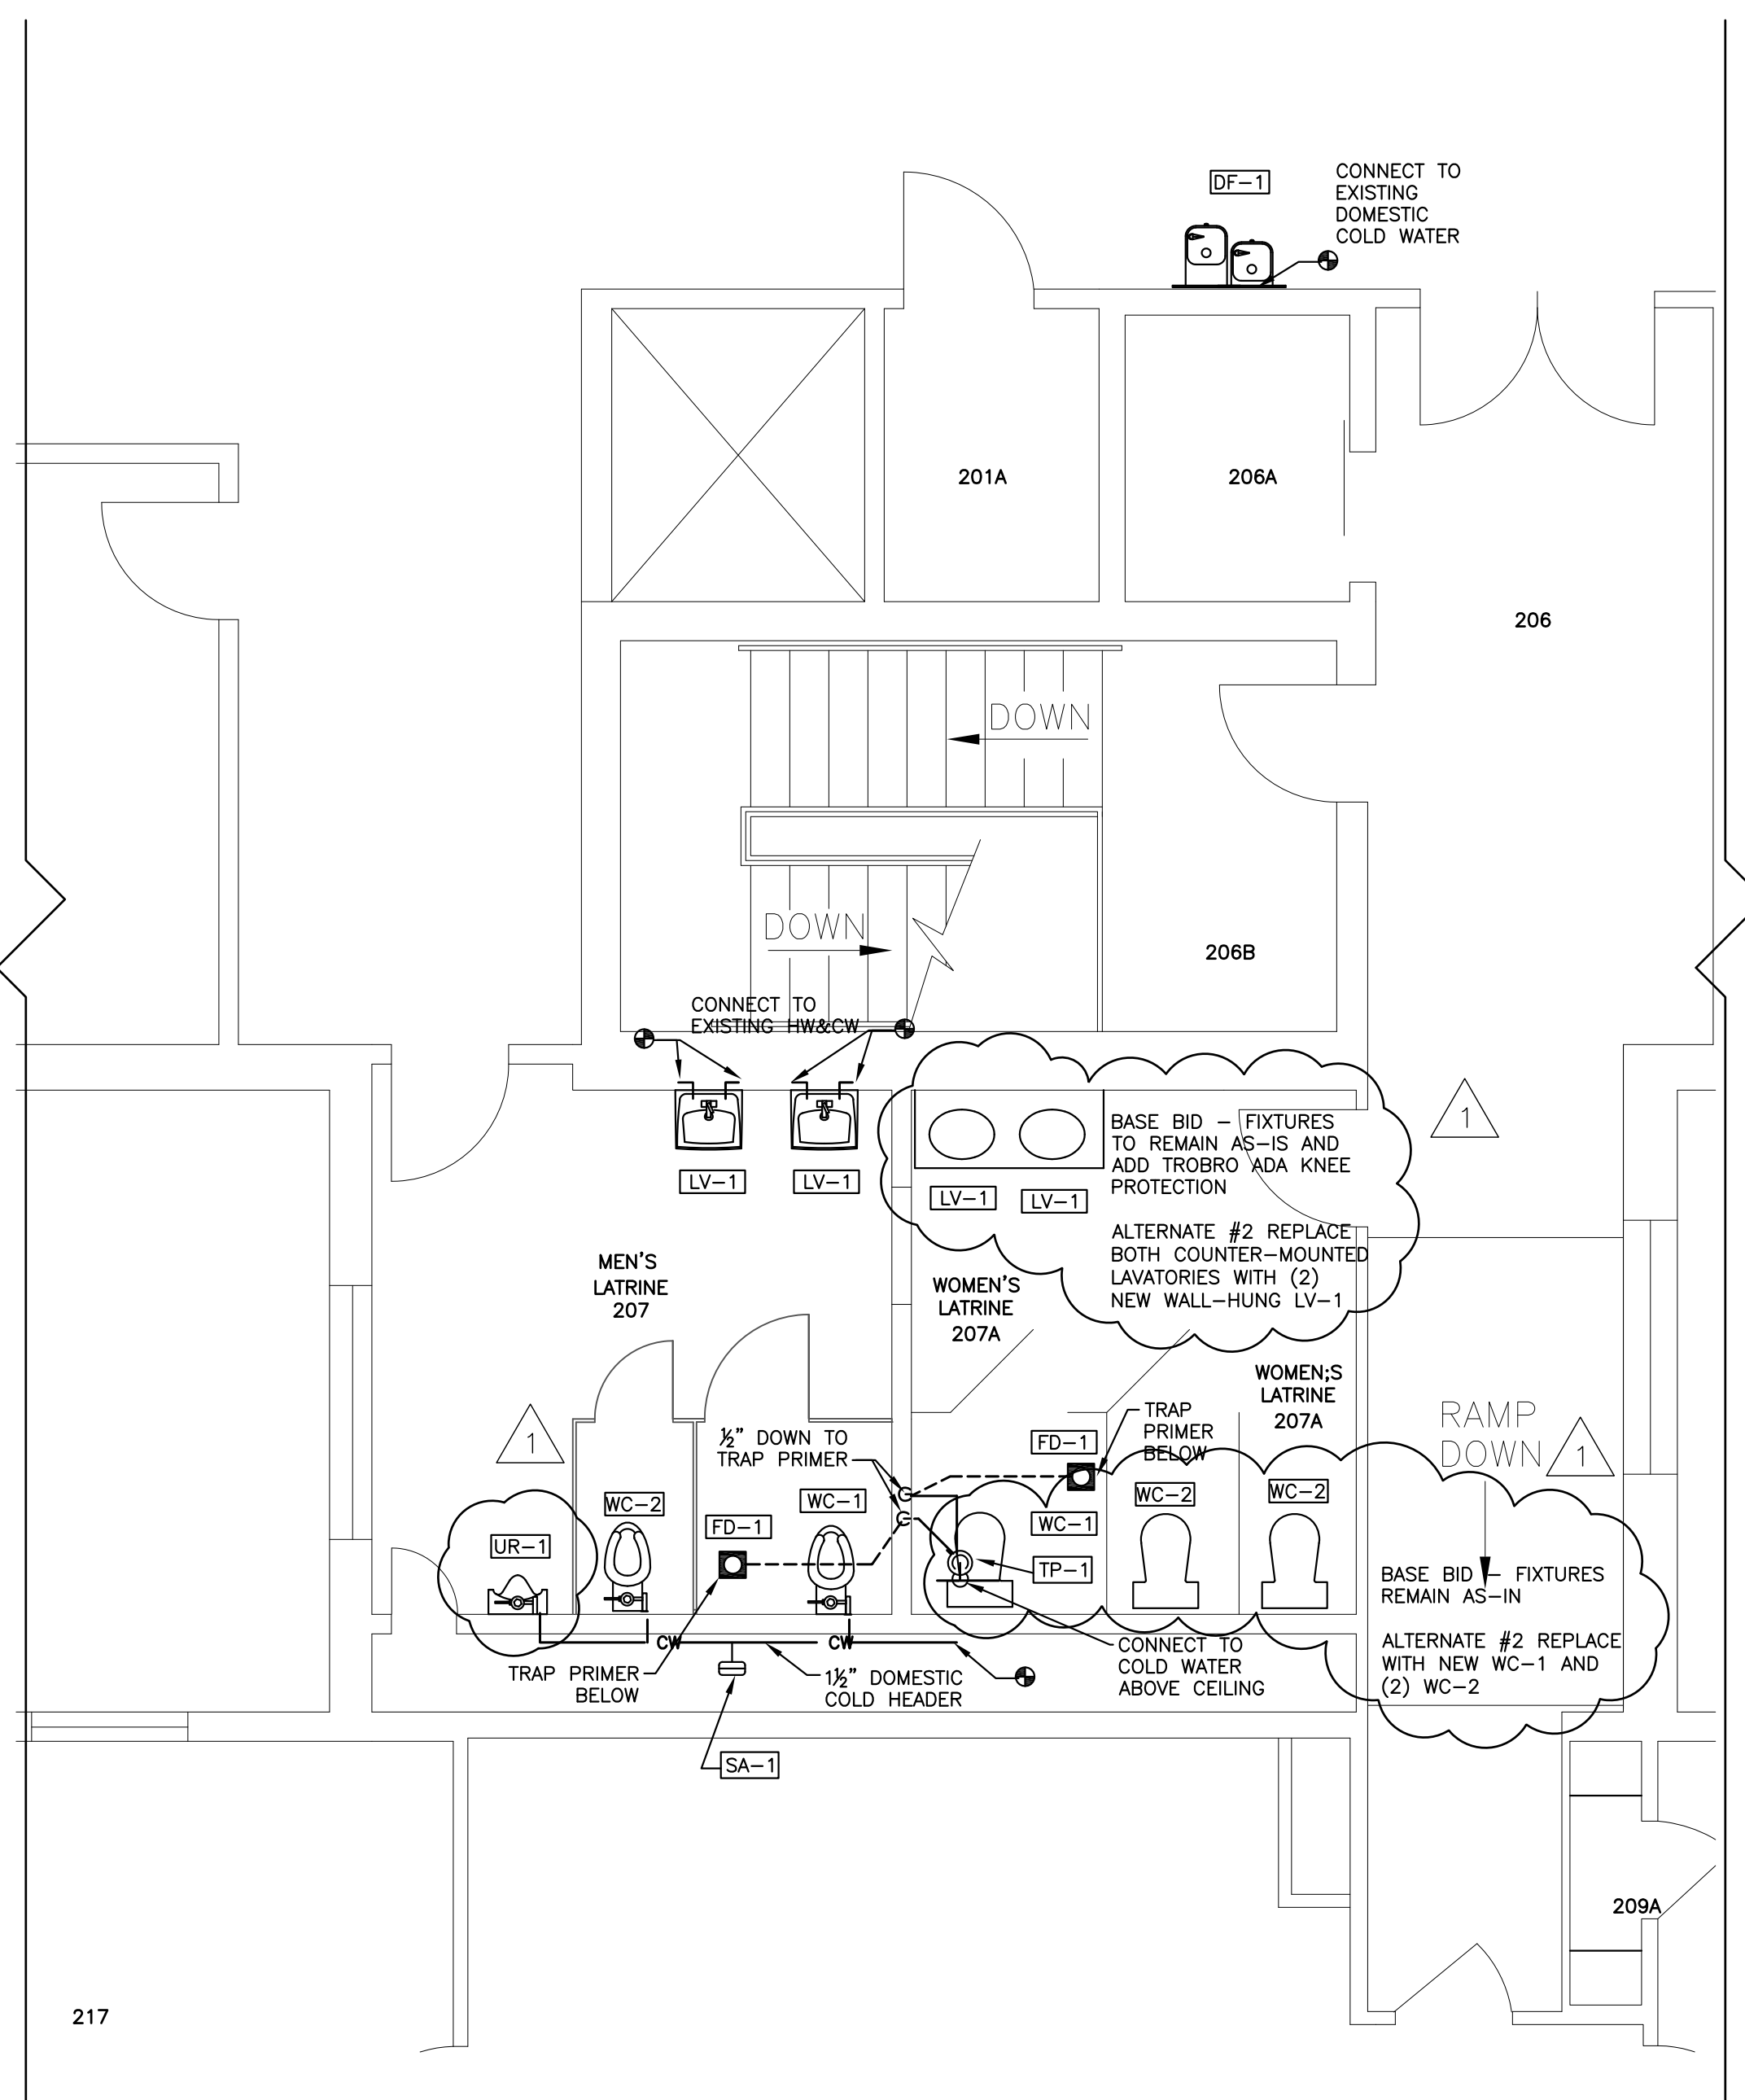

2 PLUMBING WATER PARTIAL PLAN
 SECOND FLOOR - NORTHWEST WING
 SCALE: 1/4" = 1'-0"

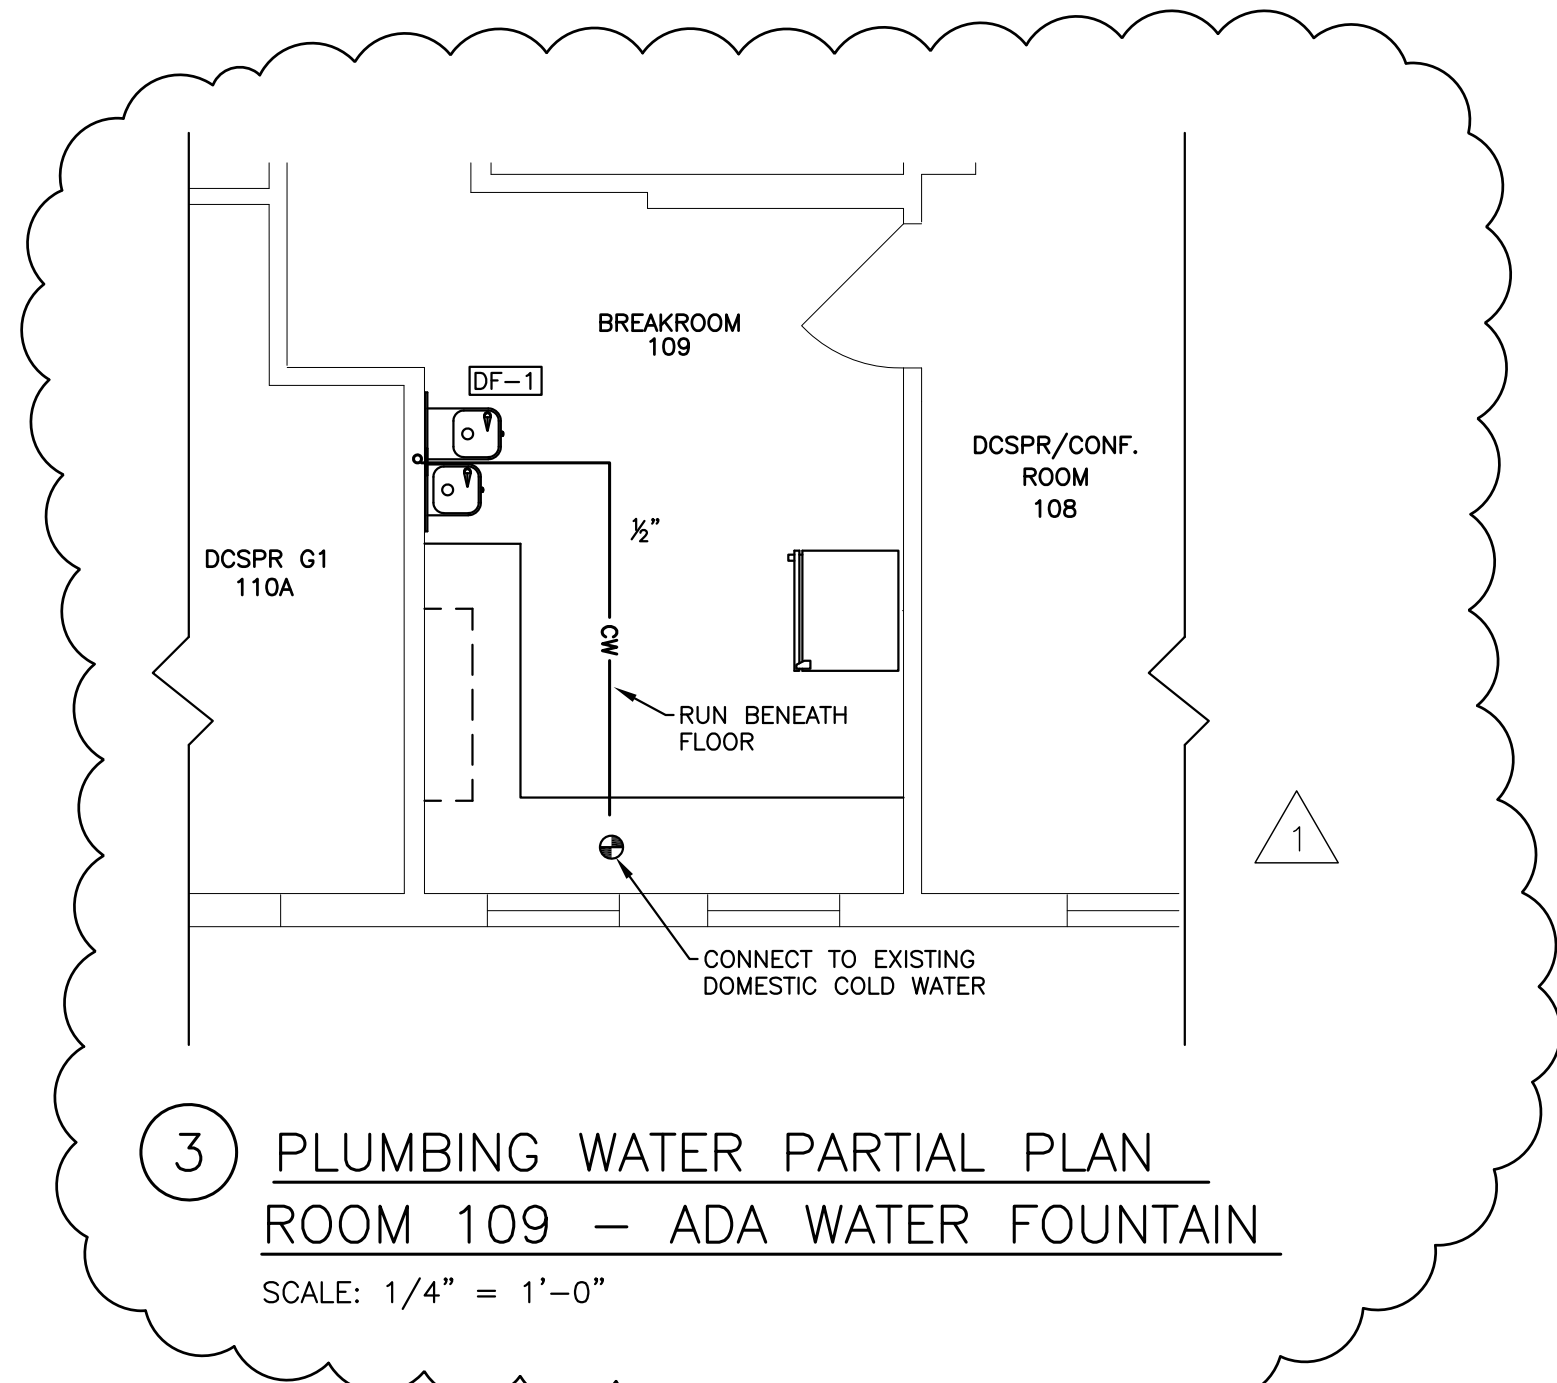

3 PLUMBING WATER PARTIAL PLAN
 ROOM 109 - ADA WATER FOUNTAIN
 SCALE: 1/4" = 1'-0"

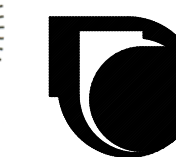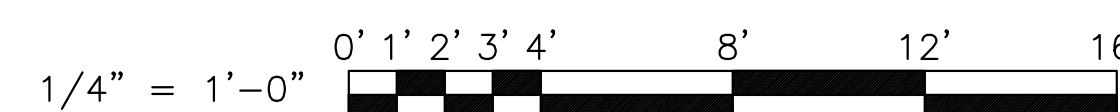

MECHANICAL SYSTEMS ENGINEERS
 ROYAL RIVER CENTER, UNIT 108
 10 FOREST FALLS DRIVE, YARMOUTH, MAINE 04096
 (207) 846-1441
 FACEBOOK: MECHANICAL SYSTEMS ENGINEERS
 CELEBRATING 50 YEARS IN BUSINESS
 © COPYRIGHT 2018

KEY PLAN
 NO SCALE

	DRAFT
	35% REVIEW
	65% REVIEW
	95% REVIEW
	FINAL REVIEW
	FOR BIDDING
	ISSUED FOR CONSTRUCTION
	RECORD DRAWINGS



PLAN REVISIONS

Rev#	Description	Date	Appr.
1	GENERAL REVISIONS	1.28.19	

DESIGNED BY: **STATE OF MAINE**
 DRAWN BY: **DEPARTMENT OF DEFENSE, VETERANS AND EMERGENCY MANAGEMENT**
 CHECKED BY: **KM**
 DATE: **12/28/2018**
 SCALE: **1/4" = 1'-0"**
 DFE PROJECT NO: **235R18-458-D**
 Cordja Capital Projects Group
 16 Tannery Lane, Suite 23
 Camden, Maine 04843
 207-236-9970 / mdsigle@cordjagroup.com

CAMP KEYES REUTILIZATION PROJECT
 CAMP KEYES, AUGUSTA, MAINE
 BUILDING NO. 7 RENOVATIONS
 PLUMBING WATER PARTIAL PLANS
 FIRST & SECOND FLOORS - NNW WING

PLAN PROGRESS

<input type="checkbox"/>	DRAFT
<input type="checkbox"/>	35% REVIEW
<input type="checkbox"/>	65% REVIEW
<input type="checkbox"/>	95% REVIEW
<input type="checkbox"/>	FINAL REVIEW
<input checked="" type="checkbox"/>	FOR BIDDING
<input type="checkbox"/>	ISSUED FOR CONSTRUCTION
<input type="checkbox"/>	RECORD DRAWINGS

SHEET ID:
P-104
 SHEET: 64 OF 126

LEGEND

120	120 DEG F HOT WATER	IDW	INDIRECT WASTE		SANITARY / WASTE PIPING ABOVE SLAB
●	AT	IM	ICE MAKER		
A	AMPS, AQUASTAT	LT	LAUNDRY TUB		SANITARY/ WASTE PIPING BELOW SLAB
ADA	AMERICANS WITH DISABILITIES ACT	LV	LAVATORY		
AFF	ABOVE FINISHED FLOOR	M	METER		VENT PIPING ABOVE SLAB
AP	ACCESS PANEL	MTD	MOUNTED		VENT PIPING BELOW SLAB
BFP	BACKFLOW PREVENTER	NB	NICKEL BRONZE		
BLV	BALL VALVE	PC	PLUMBING CONTRACTOR		DOMESTIC COLD WATER PIPING
BV	BALANCE VALVE	PDI	PLUMBING & DRAINAGE INSTITUTE		DOMESTIC 120 HOT WATER PIPING
CNTR	COUNTER	PG	PRESSURE GAUGE		GAS PIPING ABOVE SLAB
CO	CLEANOUT	PH	PHASE		COMPRESSED AIR PIPING
CONT	CONTINUATION	PRV	PRESSURE REDUCING VALVE		
COORD	COORDINATION	PSI	POUNDS PER SQUARE INCH		
COTG	CLEANOUT TO GRADE	RAW	RISE AT WALL		CHECK VALVE
CW	COLD WATER, CLOTHES WASHER	RD	ROOF DRAIN		RELIEF VALVE
C&HW	COLD & HOT WATER	RH	RIGHT HAND		
DAW	DROP AT WALL	RIC	RISE IN CHASE		PRESSURE REDUCING VALVE
DCP	DOMESTIC CIRCULATING PUMP	RW	RISE IN WALL		THERMOMETER
DEG	DEGREES	RUC	RUN UNDER COUNTER		PRESSURE GAUGE
DIC	DROP IN CHASE	RUF	RUN UNDER FLOOR		
DIW	DROP IN WALL	RV	RELIEF VALVE		
DN	DOWN	S	SANITARY WASTE		
DN&U	DOWN AND UP	SA	SHOCK ABSORBER		DROP/RISE IN LINE
DNW	DOWN IN WALL	SH	SHOWER		
DO	DRAWOFF	SK	SINK		LINE UP TO FLOOR ABOVE
DW	DISHWASHER	SS	STAINLESS STEEL		
EA	EACH	T	THERMOMETER		TEE -DROP
ET	EXPANSION TANK	T.P.	TRAP PRIMER		SHOCK ABSORBER
FCO	FLOOR CLEANOUT	TYP	TYPICAL		
FD	FLOOR DRAIN	UIC	UP IN CHASE		UNION
FFE	FINISHED FLOOR ELEVATION	U&DNIC	UP & DOWN IN CHASE		
FV	FLUSHVALVE	U&DNW	UP & DOWN IN WALL		MIXING VALVE
G	GAS (FUEL)	UIW	UP IN WALL		
GAL	GALLONS	V	VENT		FLOOR CLEANOUT
GC	GENERAL CONTRACTOR	VB	VACUUM BREAKER		
GHT	GARDEN HOSE THREAD	VC	VITREOUS CHINA		FLOOR DRAIN
GPF	GALLONS PER FLUSH	VIF	VERIFY IN FIELD		
GV	GATE VALVE	VRV	VACUUM RELIEF VALVE		VENT THROUGH ROOF
GW	GEAR WASHER	VTR	VENT THRU ROOF		
HB	HOSE BIB	W	WASTE		HOSE BIB
HC	HEATING CONTRACTOR	W/	WITH		
HW	HOT WATER	WC	WATER CLOSET, WATER COLUMN		PLUMBING FIXTURE/EQUIPMENT NUMBER TAG
HWR	HOT WATER RETURN	WCO	WALL CLEANOUT		
IE	INVERT ELEVATION	WSI	WARM SIDE OF INSULATION		CONNECT TO EXISTING

PLUMBING FIXTURE SCHEDULE

TAG	FIXTURE	COLD WATER	HOT WATER	SAN/WASTE	VENT	REMARKS
DF-1	DRINKING FOUNTAIN ADA	1/2"	-	1 1/4"	1 1/4"	DUAL HEIGHT ELECTRIC COOLING
LV-1	LAVATORY, WALL HUNG ADA	1/2"	1/2"	1 1/4" x 1 1/2"	1 1/2"	V.C. SINGLE HANDLE FAUCET, 0.5 GPM W/ ADA GUARD 34" TO RIM
MB-1	MOP BASIN	3/4"	3/4"	3"	1 1/2"	TWO HANDLE VB FAUCET, MOLDED STONE
UR-1	URINAL, WALL-MOUNT ADA	1"	-	2"	1 1/2"	V.C. MANUAL FLUSHOMETER 17" TO RIM
UR-2	URINAL, WALL-MOUNT	1"	-	2"	1 1/2"	V.C. MANUAL FLUSHOMETER
WC-1	WATER CLOSET WALL-MOUNT ADA	1"	-	4"	2"	V.C. MANUAL FLUSHOMETER 16 1/2" HEIGHT
WC-2	WATER CLOSET WALL-MOUNT	1"	-	4"	2"	WITH MANUAL FLUSHOMETER
WC-3	WATER CLOSET FLOOR-MOUNT ADA	1"	-	4"	2"	V.C. MANUAL FLUSHOMETER 16 1/2" HEIGHT
WC-4	WATER CLOSET FLOOR-MOUNT	1"	-	4"	2"	WITH MANUAL FLUSHOMETER

DRAIN SPECIALTIES SCHEDULE

TAG	ITEM	WASTE	VENT	REMARKS
FCO-1	ROUND, FINISHED AREA FLOOR CLEANOUT	SIZE OF PIPE	-	ADJUSTABLE
WCO-1	ROUND, FINISHED AREA WALL CLEANOUT	SIZE OF PIPE	-	ADJUSTABLE
FD-1	GENERAL ROUND FLOOR DRAIN	3"	1 1/2"	ADJUSTABLE WITH TRAP PRIMER

WATER SPECIALTIES SCHEDULE






TAG	ITEM	CW	HW	OUTLET	REMARKS
BFP-1	BOILER MAKE-UP BACKFLOW PREVENTER	3/4"	-	-	
MV-1	MIXING VALVE	3/4"	3/4"	3/4"	
SA-1	SHOCK ABSORBER		3/4"	-	P.D.I. B
TP-1	TRAP SEAL PRIMER	1/2"	-	-	WITH 4-PORT DISTRIBUTION

HOT WATER HEATER SCHEDULE

TAG	ITEM	CAPACITY	EFFICIENCY	1ST HOUR	WEIGHT
WH-1	HYBRID HEATER HEAT PUMP & ELECTRIC	66 GALLONS	3.44 ENERGY FACTOR	62.5 GALLONS	289 LBS


GAS ENERGY METER SCHEDULE

TAG	ITEM	CAPACITY	REMARKS
GP-1	GAS ENERGY PULSE TRANSMITTER	800 MBH	PULSOMATIC TRANSMITTER PULSE KIT HONEYWELL AMERICAN MODEL AL800 GAS METER
GP-2	GAS ENERGY PULSE TRANSMITTER	800 MBH	PULSOMATIC TRANSMITTER PULSE KIT HONEYWELL AMERICAN MODEL AL800 GAS METER

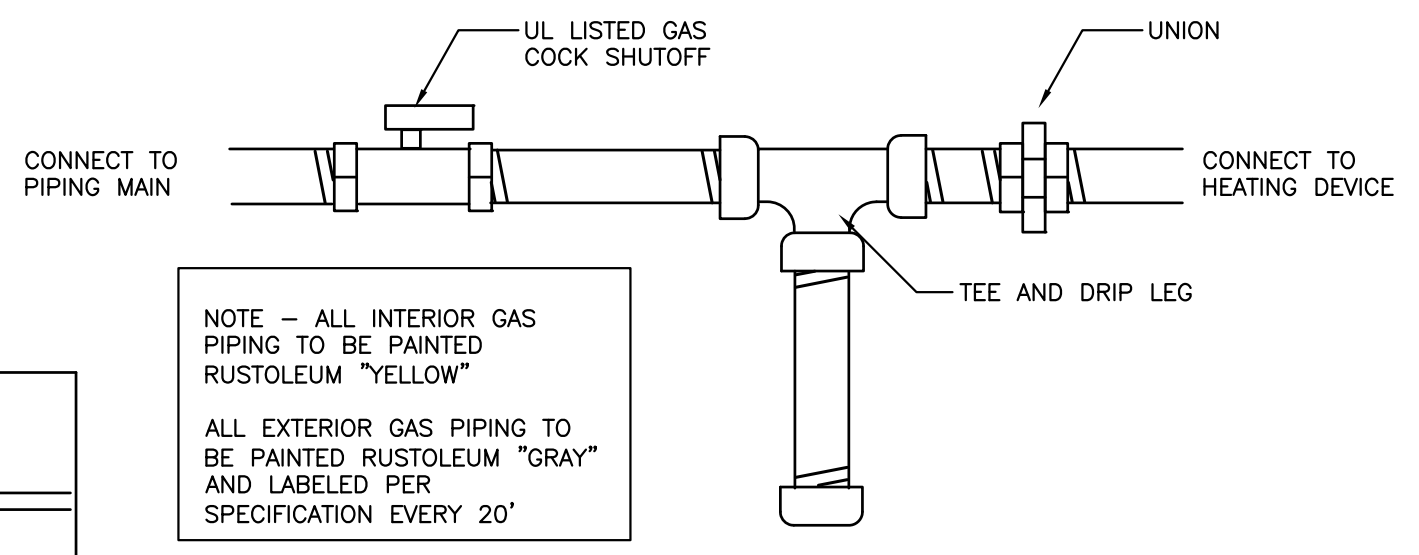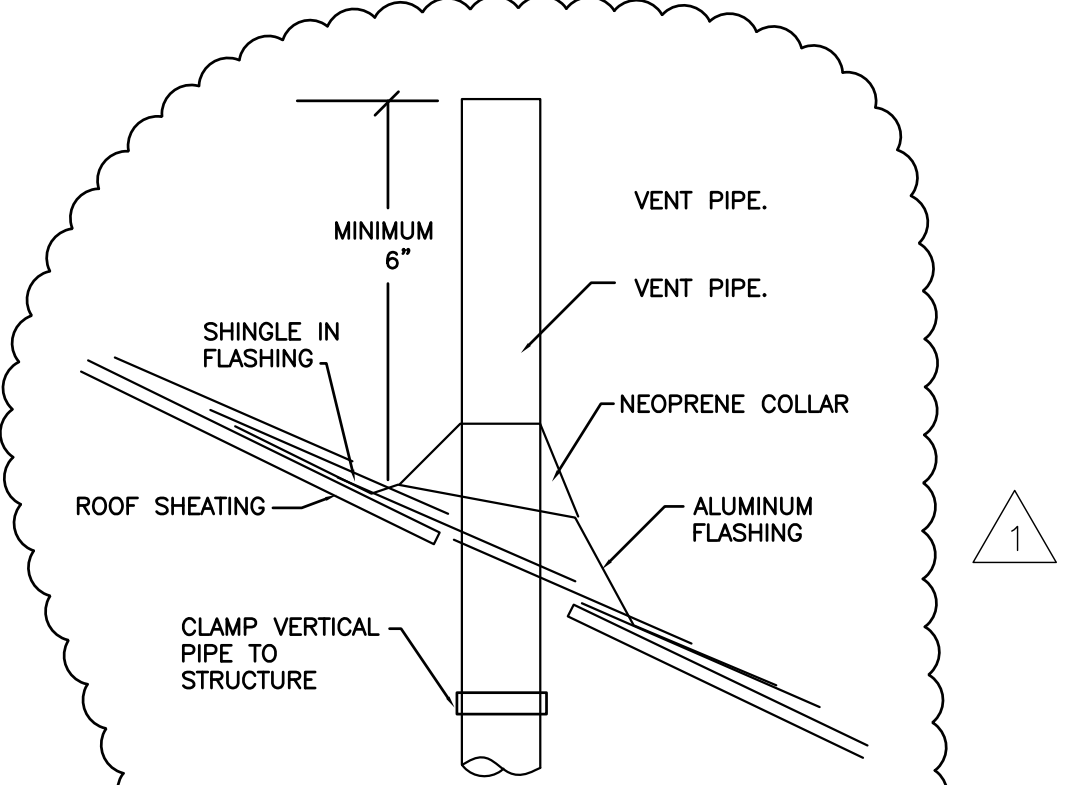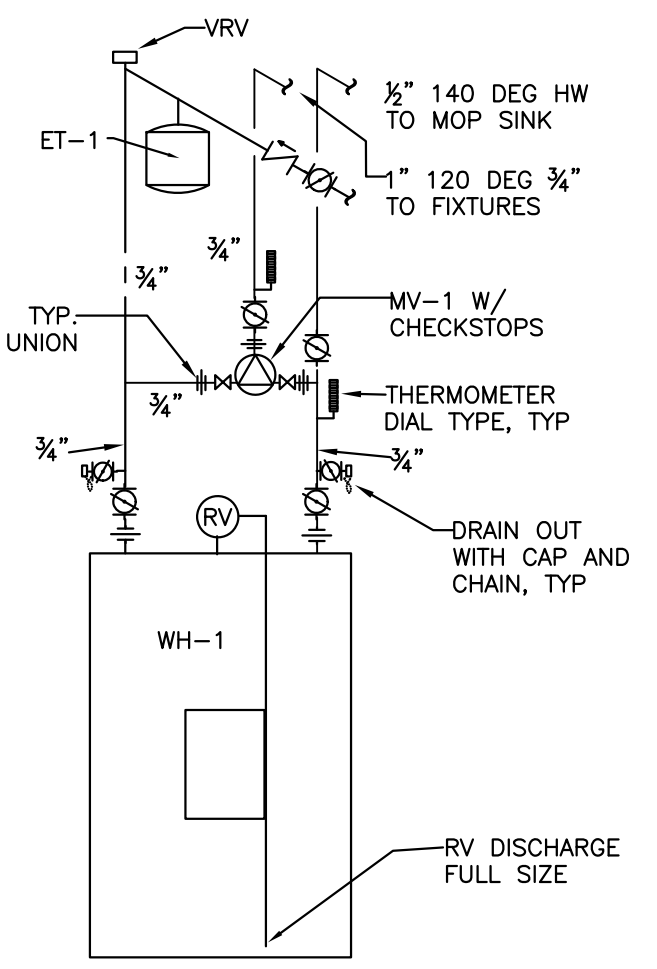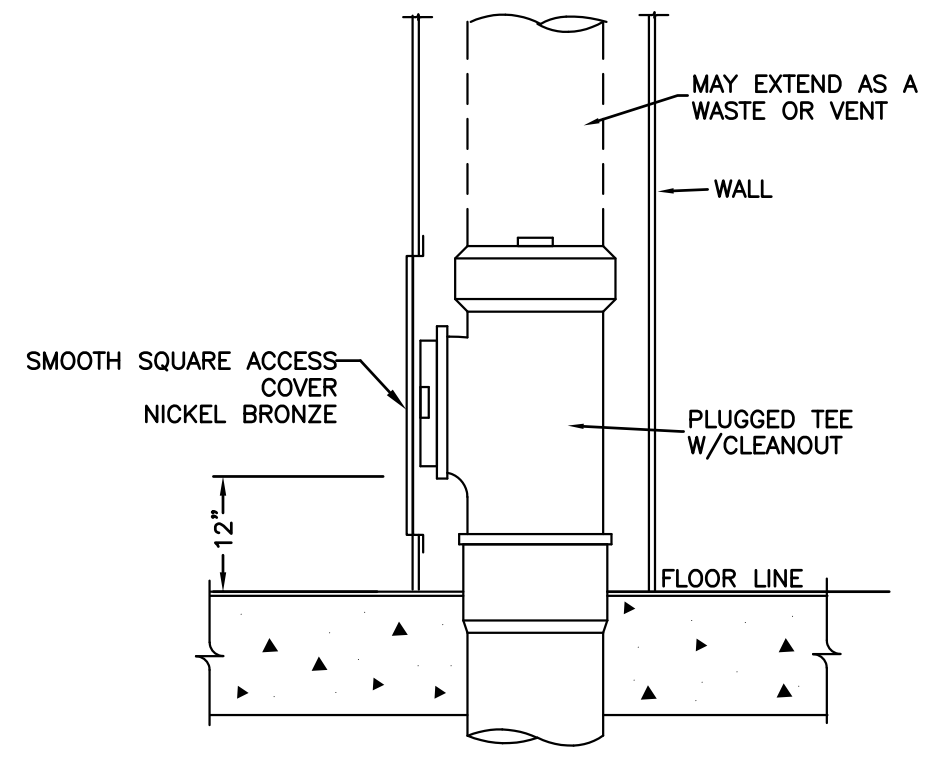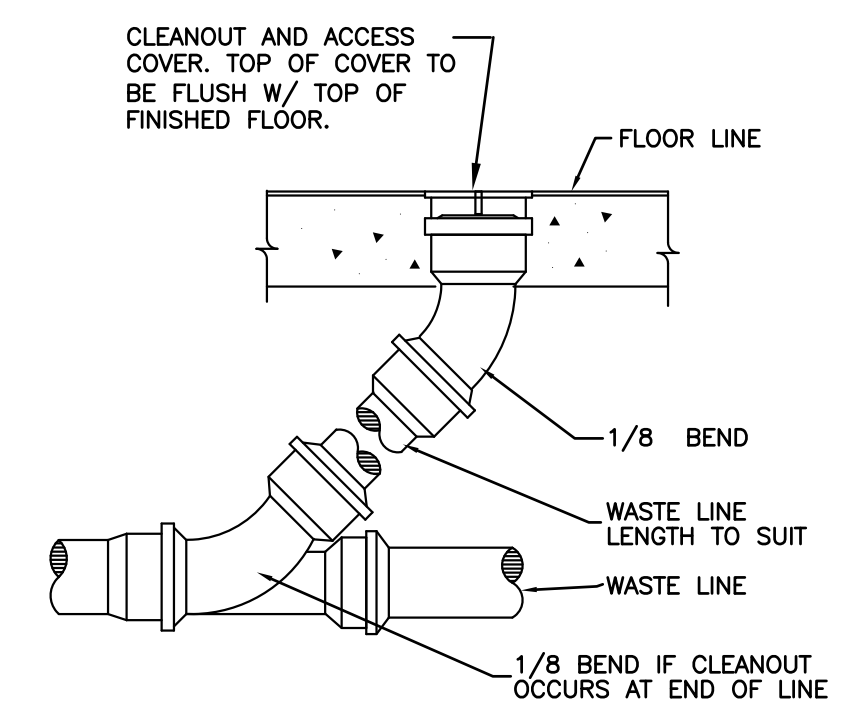

NOTES

- ALL WORK SHALL BE IN ACCORDANCE WITH THE STATE PLUMBING CODE, LOCAL CODES AND ORDINANCES, NATIONAL FIRE CODE (NFPA), OR THESE PLANS OR SPECIFICATIONS, WHICHEVER IS MORE STRICT.
- ALL DRAWINGS ARE SCHEMATIC ONLY, AND ARE INTENDED TO INDICATE THE INTENT, EXTENT, AND GENERAL ARRANGEMENT OF WORK. THEY ARE NOT MEANT TO SHOW EVERY FITTING, CHANGE OF DIRECTION OR EVERY SITUATION. VERIFY LOCATIONS IN THE FIELD. WORK INDICATED SHALL BE FURNISHED COMPLETE TO PERFORM THE FUNCTION INTENDED.
- CAREFULLY COORDINATE THE SPACE REQUIREMENTS AND LOCATION OF PIPING WITH THE OTHER TRADE CONTRACTORS. IF COORDINATION FAILS, CONFLICTS WILL BE DECIDED IN FAVOR OF THE OTHER CONTRACTORS WITH THIS CONTRACTOR RELOCATING HIS PIPING AND EQUIPMENT AT NO EXPENSE TO THE OWNER.
- ALL PLUMBING FIXTURES SHALL BE VENTED.
- THIS CONTRACTOR SHALL MAKE ALL FINAL PLUMBING CONNECTIONS TO EQUIPMENT/ FIXTURES PROVIDED BY OTHER CONTRACTORS.
- FOR PIPE SIZES NOT SHOWN ON FLOOR PLANS, REFER TO: ADJACENT OR ENLARGED PLUMBING PLANS, THEN APPROPRIATE SCHEDULES, DETAILS, SPECIFICATIONS, EQUIPMENT CONNECTION SIZES AND MINIMUM CODE REQUIREMENTS. FOR OTHERWISE INDETERMINABLE PIPE SEGMENTS, THE SIZE SHALL BE THE SAME AS THE LARGEST ADJACENT SEGMENT. WHERE PIPE SIZES ARE ERRONEOUSLY SHOWN TO DECREASE THEN INCREASE, THE SMALLER SEGMENT SHALL BE INCREASED TO MATCH THE LARGER SEGMENT. WHEN A CONFLICT EXISTS, THE LARGER SIZE SHALL GOVERN. PIPE SIZES ARE NOMINAL (NOT O.D.) UNLESS SPECIFICALLY NOTED OTHERWISE.
- ALL PIPING SHALL RUN CONCEALED ABOVE CEILINGS, IN WALLS, IN SOFFITS AND IN CHASES UNLESS NOTED OTHERWISE. SPECIAL CARE SHALL BE TAKEN WHEN DROPPING 3" NOMINAL PIPE IN 3-1/2" WALL CAVITIES TO ENSURE CORRECT FIT AND ALIGNMENT.
- ALL PLUMBING SHALL BE SUPPORTED FROM THE BUILDING STRUCTURE. ALL PIPING CONTAINING LIQUID 2" AND LARGER SHALL BE SUPPORTED FROM THE TOP CHORD OF BAR JOISTS UNLESS PERMISSION TO DO OTHERWISE IS OBTAINED FROM THE STRUCTURAL CONSULTANT. ALL PIPING DROPS TO FIXTURES SHALL BE ANCHORED SOLID TO WALLS WITH A STEEL SUPPORT BRACKET WITH ADJUSTABLE CLIP.
- ALL WATER PIPING SHALL BE INSTALLED PARALLEL TO BUILDING LINES AND PITCHED TO LOW POINTS. PROVIDE DRAW-OFFS AT LOW POINTS. PIPING SHALL BE RUN NEATLY GROUPED TOGETHER WHEN PRACTICAL. ALLOW ROOM BETWEEN ALL PIPING AND OTHER OBSTRUCTIONS TO ALLOW FOR THE INSTALLATION OF THE SPECIFIED PIPE INSULATION.
- ALL PIPING THROUGH CONCRETE WALLS AND MASONRY PARTITIONS SHALL HAVE STEEL PIPE SLEEVES. OPENINGS BETWEEN PIPES AND SLEEVES SHALL BE CAULKED AND SEALED SMOKE AND WATER TIGHT. ALL PIPE PENETRATIONS THROUGH A FIRE RATED WALL OR FLOOR SHALL HAVE A UL RATED FIRE STOP SYSTEM RATED TO MATCH THE RATING OF THE WALL, AS PER THE NFPA.
- ALL WALL FIXTURES SHALL BE CARRIER MOUNTED UNLESS OTHERWISE SPECIFIED.
- ALL DOMESTIC WATER PIPING SHALL BE INSULATED UNLESS OTHERWISE SPECIFIED.
- RUN ALL PIPING ON WARM SIDE OF BUILDING INSULATION. NO WATER, OR WASTE LINES SHALL BE RUN IN EXTERIOR WALLS, UNLESS DIRECTLY INDICATED.
- PROVIDE SHOCK ABSORBERS WHERE SHOWN ON DRAWINGS, AND ON TOPS OF RISERS TO ALL FLUSH VALVES, DISHWASHERS AND CLOTHESWASHERS. SIZES SHALL CONFORM TO P.D.I. STANDARDS.
- ALL SANITARY WASTE PIPING LESS THAN 4" SHALL PITCH DOWN AT 1/8" PER L.F. ALL 4" AND LARGER PIPING SHALL PITCH AT 1/4" PER L.F. WHENEVER POSSIBLE. NO SANITARY/ WASTE PIPING UNDER SLAB SHALL BE LESS THAN 2" IN DIAMETER.
- ALL DOMESTIC COPPER WATER PIPING SHALL BE TYPE "K" OR "L" COPPER, TYPE "M" IS PROHIBITED.

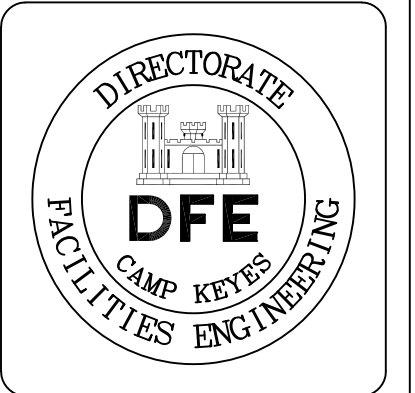

NO.	REVISIONS	DATE	DESCRIPTION
1	GENERAL REVISIONS	1.28.19	


DESIGNED BY: KM
 DRAWN BY: KFM/MAD
 CHECKED BY: KFM/MAD
 DATE: 12/28/2018
 SCALE: NO SCALE
 DFE PROJECT NO: 235R18-458-D

STATE OF MAINE
 DEPARTMENT OF DEFENSE, VETERANS
 AND EMERGENCY MANAGEMENT
 Cordjia Capital Projects Group
 16 Tannery Lane, Suite 23
 Camden, Maine 04843
 207-236-9970 / mdaigle@cordjia.com

CAMP KEYS REUTILIZATION PROJECT
 CAMP KEYS, AUGUSTA, MAINE
 BUILDING NO. 7 RENOVATIONS
 PLUMBING LEGENDS, NOTES & DETAILS



PLAN PROGRESS
<input type="checkbox"/> DRAFT
<input type="checkbox"/> 35% REVIEW
<input type="checkbox"/> 65% REVIEW
<input type="checkbox"/> 95% REVIEW
<input type="checkbox"/> FINAL REVIEW
<input checked="" type="checkbox"/> FOR BIDDING
<input type="checkbox"/> ISSUED FOR CONSTRUCTION
<input type="checkbox"/> RECORD DRAWINGS

SHEET ID:
P-201
 SHEET: 65 of 126

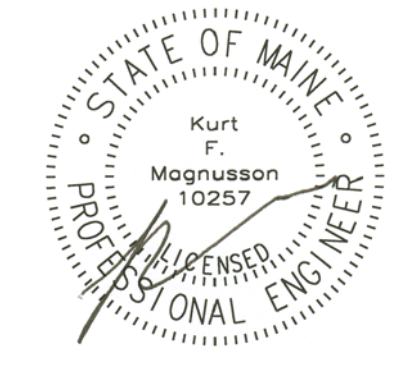

MECHANICAL SYSTEMS ENGINEERS
 ROYAL RIVER CENTER, UNIT 108
 10 FOREST FALLS DRIVE, YARMOUTH, MAINE 04866
 (207) 948-1441
 FACEBOOK: MECHANICAL SYSTEMS ENGINEERS
 CELEBRATING 50 YEARS IN BUSINESS
 © COPYRIGHT 2018



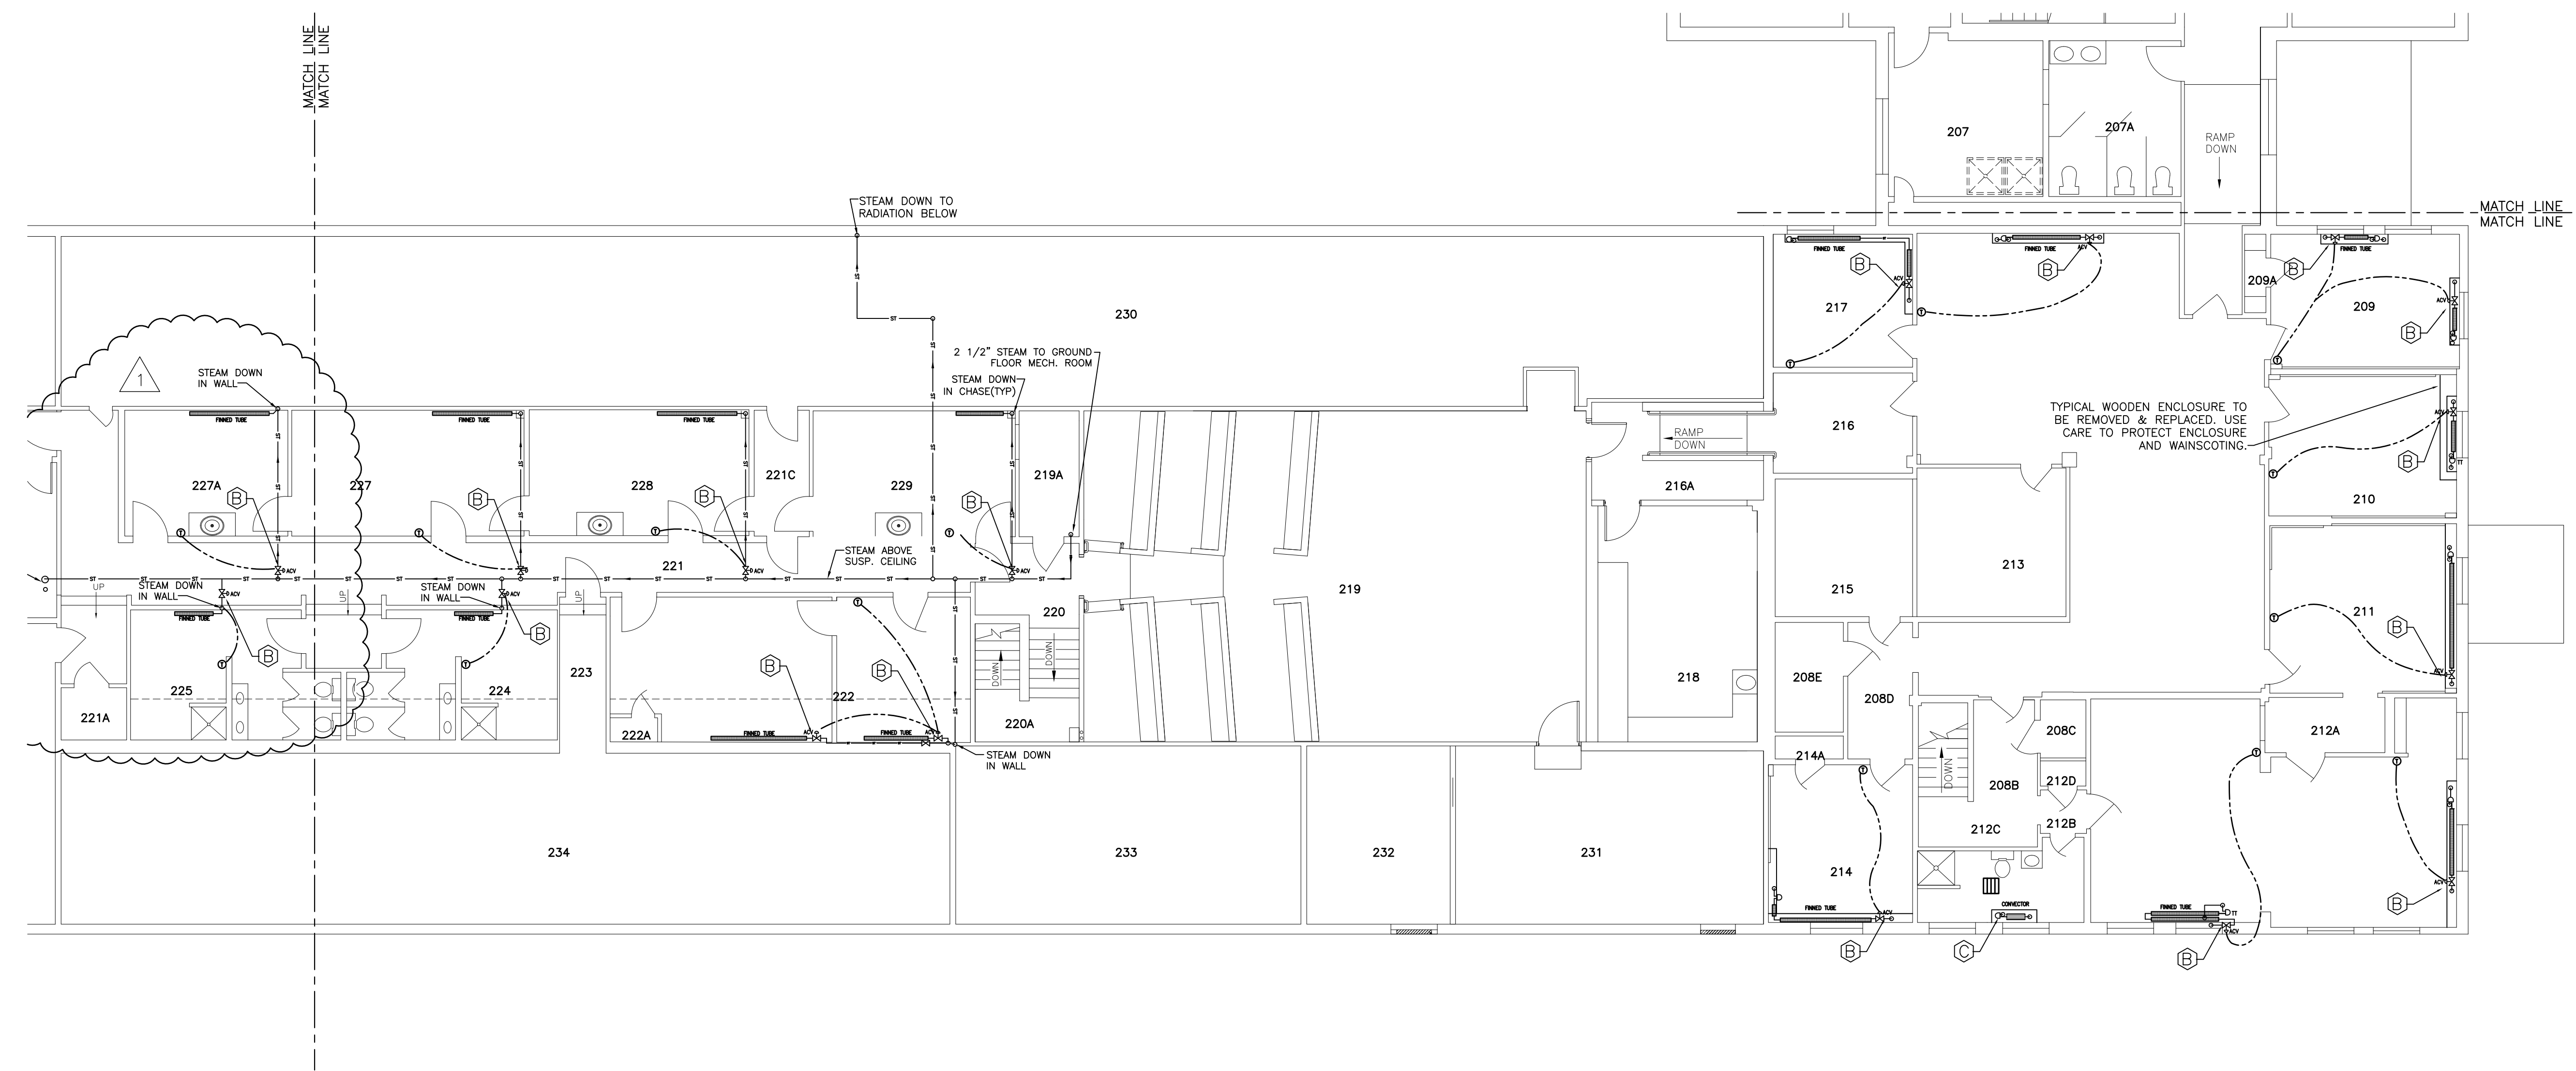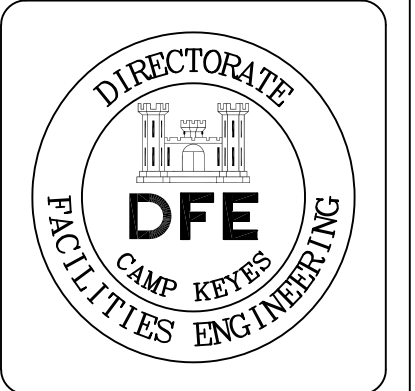

Rev#	Description	Date	Appr.

DESIGNED BY: KFM
 DRAWN BY: KFM
 CHECKED BY: KFM/MAD
 DATE: 12/28/2018
 SCALE: 1/8" = 1'-0"
 DFE PROJECT NO: 235F18-458-D

STATE OF MAINE
 DEPARTMENT OF DEFENSE, VETERANS
 AND EMERGENCY MANAGEMENT
 Cordja Capital Projects Group
 16 Tannery Lane, Suite 23
 Camden, Maine 04843
 207-236-9970 / mdsie@cordjagroup.com

1 MECHANICAL STEAM SYSTEM REMOVAL PLAN
SECOND FLOOR – NORTH END
 SCALE: 1/8" = 1'-0"

LEGEND & KEYED NOTES

(A) UNIT HEATER, FLOAT TRAP AND SHUTOFF VALVES
 (B) CONTROL VALVE, THERMOSTAT AND CONTROL WIRING
 (C) THERMOSTATIC TRAP
 (D) END OF MAIN DRIP
 (E) VALVE, FLOAT & THERMOSTATIC TRAP, TEMPERATURE TRAP

FINNED TUBE C.I. RAD CONVECTOR

CR CONDENSATE RETURN
 CWR CONDENSATE RETURN BOILER ROOM
 ST STEAM SUPPLY
 CV CONDENSATE VENT
 DHW DOMESTIC HOT WATER
 DCW DOMESTIC COLD WATER
 HWS HEATING WATER SUPPLY
 HWR HEATING WATER RETURN
 OIL OIL PIPING




- STEAM SYSTEM REMOVAL GENERAL NOTES**
- THE INTENTION OF THIS DRAWING AND NOTES IS TO SHOW THE GENERAL LOCATION AND DESCRIPTION OF ITEMS TO BE REMOVED. IT DOES NOT INCLUDE ALL THE DETAILS AND ACCESSORIES ASSOCIATED WITH THE ITEM TO BE REMOVED – IT WILL BE THE CONTRACTOR'S RESPONSIBILITY TO REMOVE ALL ACCESSORIES NORMALLY ASSOCIATED WITH THE ITEM DESIGNATED.
 - THE CONTRACTOR IS TO REMOVE ALL DEMOLISHED MATERIALS AND EQUIPMENT FROM THE JOBSITE. CONTRACTOR IS TO DISPOSE OF ALL MATERIAL AND EQUIPMENT PER EPA STANDARDS.
 - THE CONTRACTOR IS RESPONSIBLE TO REMOVE FROM THE JOBSITE ALL MATERIALS AND EQUIPMENT ASSOCIATED WITH THE EXISTING STEAM HEATING SYSTEM. ITEMS TO BE REMOVED INCLUDE, BUT ARE NOT LIMITED TO:
 - A) ALL STEAM SUPPLY PIPING.
 - B) ALL CONDENSATE PIPING.
 - C) ALL STEAM TRAPS.
 - D) ALL STEAM CONTROL VALVES.
 - E) ALL STEAM ACCESSORIES.
 - F) ALL HANGERS AND SUPPORTS ASSOCIATED WITH THE STEAM SYSTEM
 - G) ALL STEAM VENT LINES
 - H) THE STEAM BOILER, AND ASSOCIATED ACCESSORIES.
 - I) BOILER FEED PUMPS, RECEIVERS AND ACCESSORIES
 - J) CONDENSATE PUMPS AND RECEIVERS.
 - K) STEAM TO HOT WATER HEAT EXCHANGERS.
 - L) HOT WATER HEATING PUMPS NOT BEING REUSED.
 - M) ALL STEAM FINNED TUBE, CONVECTORS, AND UNIT HEATERS.
 - N) STEAM BOILER MAKE-UP WATER PIPING.
 - O) INSULATION ON PIPING (NON-ASBESTOS INSULATION ONLY).
 - P) ALL CONTROLS AND CONTROL WIRING

CAMP KEYES REUTILIZATION PROJECT
 CAMP KEYES, AUGUSTA, MAINE
 BUILDING NO. 7 RENOVATIONS
 MECHANICAL STEAM REMOVAL PLAN
 SECOND FLOOR – NORTH END

PLAN PROGRESS


<input type="checkbox"/>	DRAFT
<input type="checkbox"/>	35% REVIEW
<input type="checkbox"/>	65% REVIEW
<input type="checkbox"/>	95% REVIEW
<input type="checkbox"/>	FINAL REVIEW
<input checked="" type="checkbox"/>	FOR BIDDING
<input type="checkbox"/>	ISSUED FOR CONSTRUCTION
<input type="checkbox"/>	RECORD DRAWINGS

SHEET ID:
MD-106
 SHEET: 71 of 126

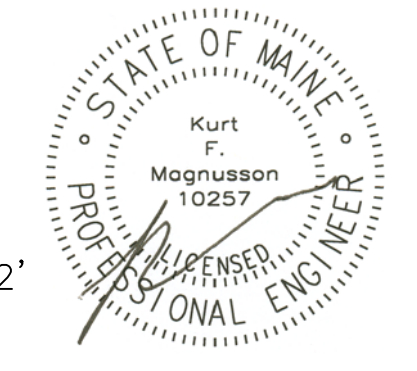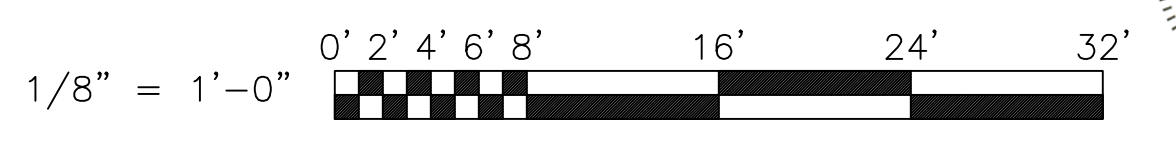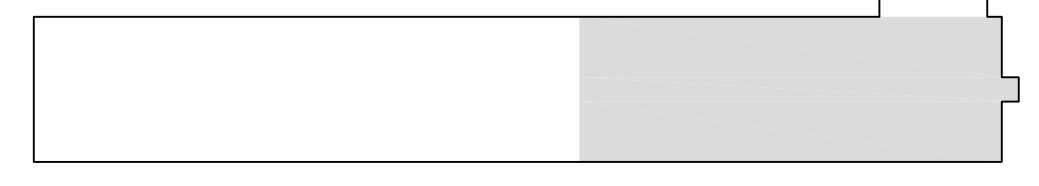

MECHANICAL SYSTEMS ENGINEERS
 ROYAL RIVER CENTER, UNIT 108
 10 FOREST FALLS DRIVE, YARMOUTH, MAINE 04096
 (207) 846-1441
 FACEBOOK: MECHANICAL SYSTEMS ENGINEERS
 CELEBRATING 50 YEARS IN BUSINESS
 © COPYRIGHT 2018



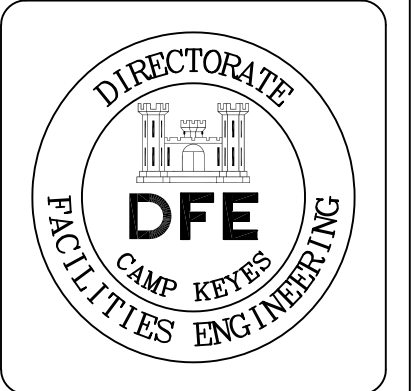

Rev#	Description	Date	Appr.
1	GENERAL REVISIONS		
1	PLAN REVISIONS	1-28-19	

DESIGNED BY: KFM
 DRAWN BY: KFM
 CHECKED BY: KFM/MAD
 DATE: 12/28/2018
 SCALE: 1/8" = 1'-0"
 DFE PROJECT NO: 235F18-458-D


STATE OF MAINE
 DEPARTMENT OF DEFENSE, VETERANS
 AND EMERGENCY MANAGEMENT
 Cordja Capital Projects Group
 16 Tannery Lane, Suite 23
 Camden, Maine 04843
 207-236-9970 / mdsjle@cdjocpg.com

CAMP KEYS REUTILIZATION PROJECT
 CAMP KEYS, AUGUSTA, MAINE
 BUILDING NO. 7 RENOVATIONS
 MECHANICAL HVAC REMOVAL PLAN
 LOWER LEVEL SOUTH END

PLAN PROGRESS

<input type="checkbox"/>	DRAFT
<input type="checkbox"/>	35% REVIEW
<input type="checkbox"/>	65% REVIEW
<input type="checkbox"/>	95% REVIEW
<input type="checkbox"/>	FINAL REVIEW
<input checked="" type="checkbox"/>	FOR BIDDING
<input type="checkbox"/>	ISSUED FOR CONSTRUCTION
<input type="checkbox"/>	RECORD DRAWINGS

SHEET ID:
 MD-107
 SHEET: 72 OF 126

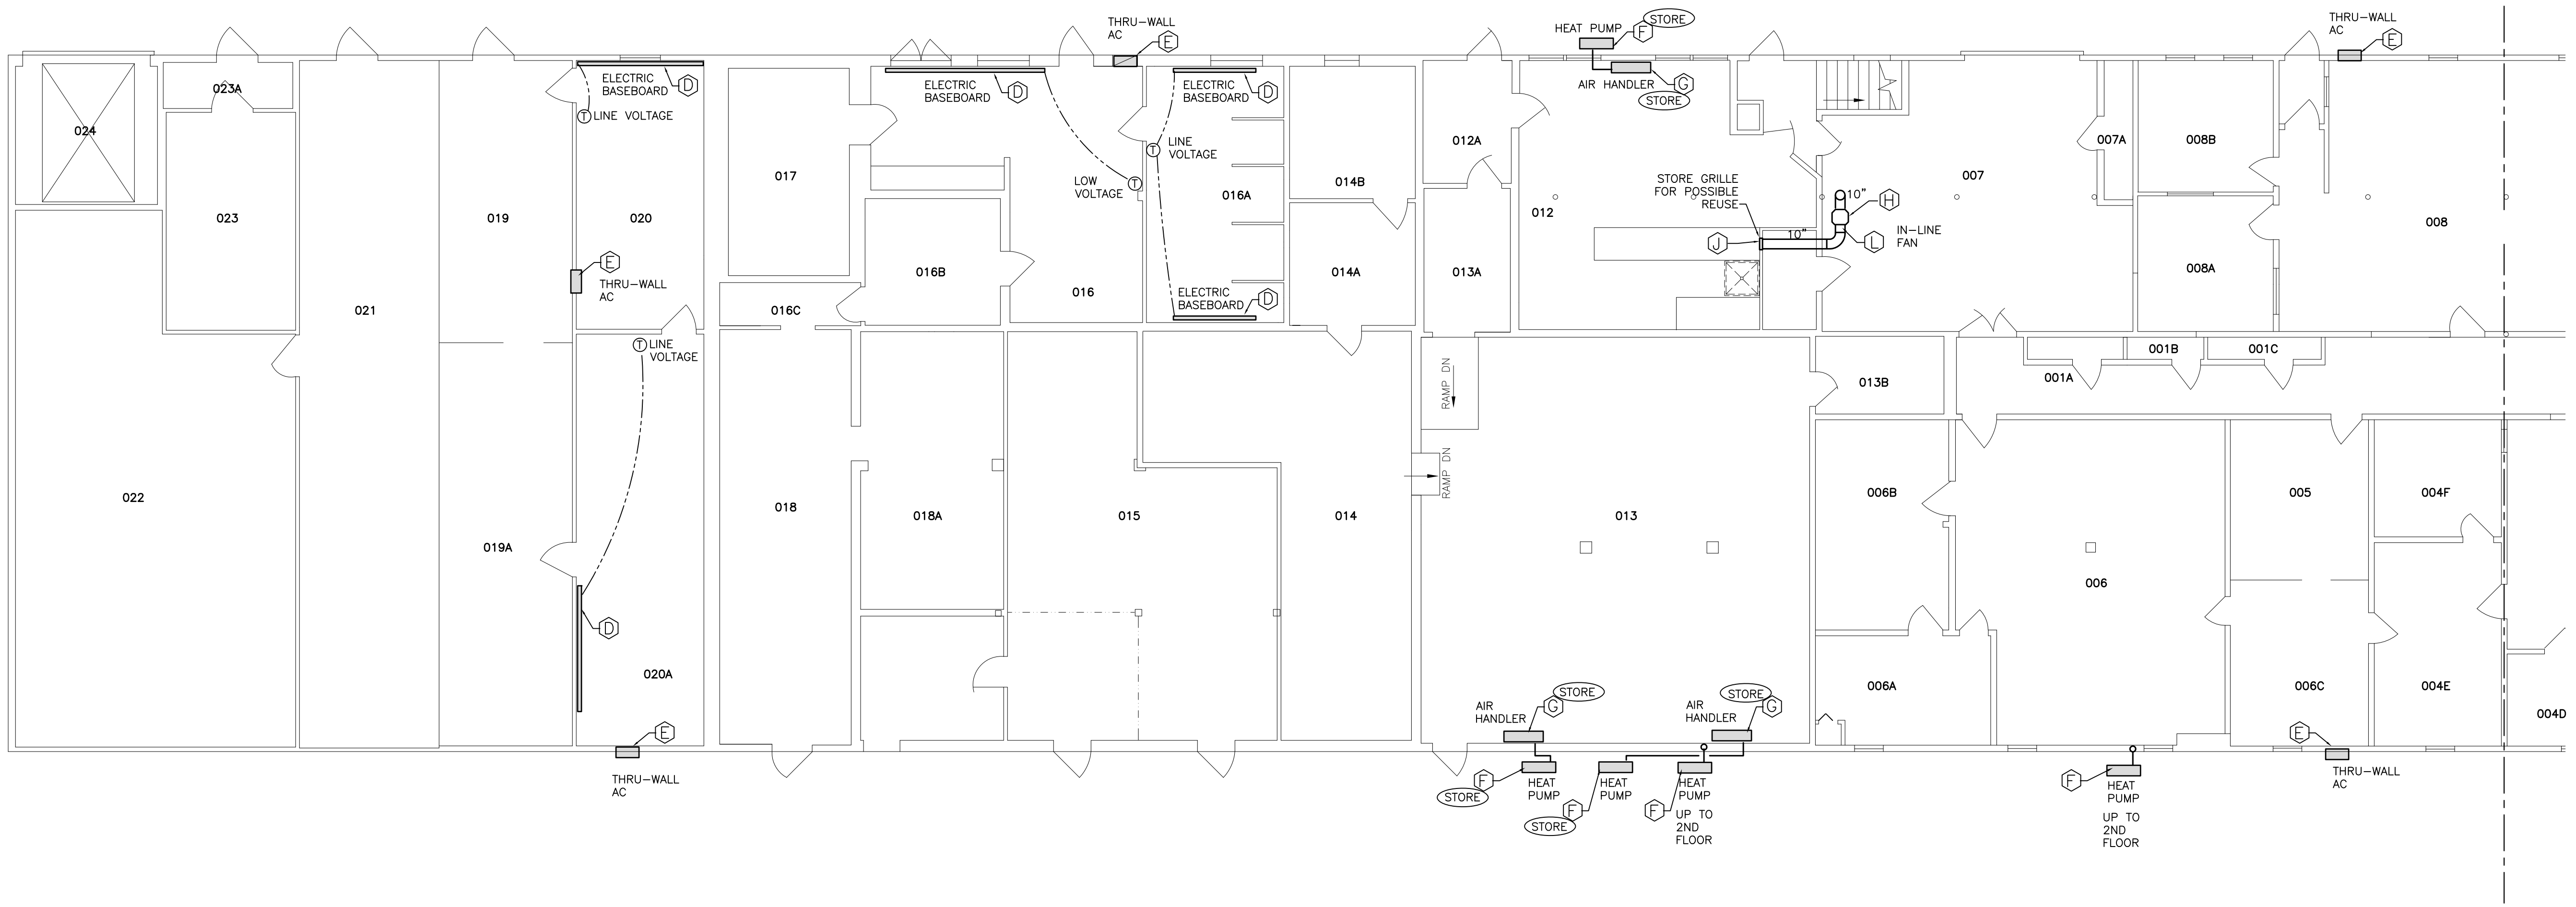

1 MECHANICAL HVAC REMOVAL PLAN
 LOWER LEVEL - SOUTH END
 SCALE: 1/8" = 1'-0"

REMOVAL AND DEMOLITION KEYED NOTES



<p>A REMOVE HOT WATER COIL. DISCONNECT HOT WATER SUPPLY AND RETURN LINES. REMOVE CONTROL VALVE AND ACCESSORIES. REMOVE DUCTWORK TRANSITIONS AND DUCTWORK NOT BEING REUSED.</p> <p>B REMOVE ROOF-MOUNTED FAN. EXISTING ROOF CURB TO REMAIN AS-IS FOR REUSE.</p> <p>C REMOVE 68"x24" OUTSIDE AIR GOOSENECK. RE-INSTALL ON EXTENDED DUCT.</p> <p>D ELECTRIC BASEBOARD HEAT TO BE REMOVED BY ELECTRICAL CONTRACTOR. REMOVE ASSOCIATED THERMOSTAT AND CONTROL WIRING.</p> <p>E REMOVE THROUGH-WALL AIR CONDITIONING UNIT.</p> <p>F REMOVE HEAT PUMP MINI-SPLIT OUTDOOR UNIT. REMOVE ASSOCIATED WALL-BRACKET OR GROUND PAD. REMOVE ALL REFRIGERANT PER EPA STANDARDS. REMOVE ALL REFRIGERANT PIPING FROM HEAT PUMP TO AIR HANDLER.</p> <p>G REMOVE HEAT PUMP MINI-SPLIT OUTDOOR UNIT. REMOVE ASSOCIATED WALL-BRACKET OR GROUND-PAD. REMOVE ALL REFRIGERANT PER EPA STANDARDS. REMOVE ALL REFRIGERANT PIPING FROM HEAT PUMP TO AIR HANDLER. CAP GAS AND LIQUID LINE MOISTURE-TIGHT (FLARE JOINT CAP). PLACE ALL REMOVED INDOOR & OUTDOOR UNITS ON PALLETS AND PACKAGE FOR OVER-THE ROAD TRANSPORT TO A OWNER DESIGNATED LOCATION WITHIN CAMP KEYS.</p>	<p>H REMOVE THROUGH-WALL FAN AND FAN SWITCH.</p> <p>I REMOVE CEILING-MOUNTED ELECTRIC HEATER.</p> <p>J REMOVE CEILING OR WALL-MOUNTED RETURN, EXHAUST OR SUPPLY GRILLE. REMOVE ASSOCIATED BRANCH DUCT.</p> <p>K REMOVE ENERGY RECOVERY UNIT.</p> <p>L REMOVE DUCTWORK MAIN. REMOVE ENTIRE MAIN AND BRANCH DUCTS.</p> <p>STORE THIS COMMENT ON THE DRAWINGS INDICATES THE MAJOR COMPONENTS OF THE MINI-SPLIT SYSTEMS THAT ARE TO BE REMOVED, PACKED, AND DELIVERED FOR STORAGE.</p>
--	--

REMOVAL AND DEMOLITION GENERAL NOTES

- THE INTENTION OF THIS DRAWING AND NOTES IS TO SHOW THE GENERAL LOCATION AND DESCRIPTION OF ITEMS TO BE REMOVED. IT DOES NOT INCLUDE ALL THE DETAILS AND ACCESSORIES ASSOCIATED WITH THE ITEM TO BE REMOVED - IT WILL BE THE CONTRACTOR'S RESPONSIBILITY TO REMOVE ALL ACCESSORIES NORMALLY ASSOCIATED WITH THE ITEM DESIGNATED.
- THE CONTRACTOR IS TO REMOVE ALL DEMOLISHED MATERIALS AND EQUIPMENT FROM THE JOBSITE. CONTRACTOR IS TO DEPOSE OF ALL MATERIAL AND EQUIPMENT PER EPA STANDARDS.
- ALL REFRIGERANTS MUST BE RECOVERED PER EPA STANDARDS AND REMOVED FROM THE JOBSITE. THE CONTRACTOR PERFORMING THE REMOVAL, PUMPING AND CAPPING OF REFRIGERANT LINES SHALL PROVIDE DOCUMENTATION THEY HAVE PASSED AN EPA APPROVED SECTION 608 TECHNICIAN CERTIFICATION (TYPE II) TEST PRIOR TO REMOVAL OF THE HVAC UNITS.
- MATERIALS AND EQUIPMENT THAT ARE DESIGNATED **STORE** SHALL BE PACKED ON PALLETS AND SHRINK WRAPPED FOR OVER-THE-ROAD TRANSPORT AND DELIVERED TO A LOCATION WITHIN CAMP KEYS SPECIFIED BY THE OWNER.



CONTROL AND BALANCING VALVE REMOVAL NOTES

- REMOVE CONTROL VALVES, BALANCING VALVES BALL VALVES AND STRAINERS FOR CONNECTIONS THAT ARE SHOWN TO BE REPLACED ON DRAWING M108.
- EXISTING FIN-TUBE RADIATION, UNIT HEATERS AND CONVECTORS ARE TO REMAIN IN-PLACE AN IN-USE.

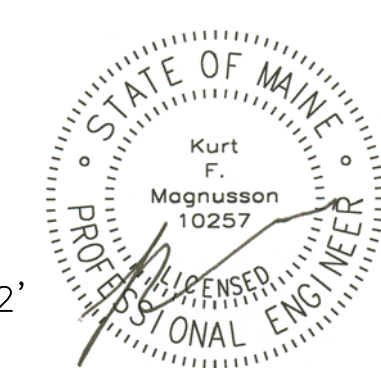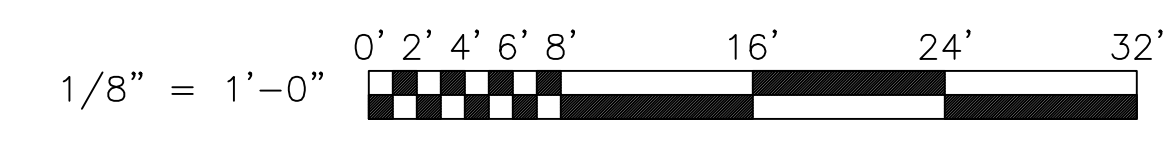

MECHANICAL SYSTEMS ENGINEERS
 ROYAL RIVER CENTER, UNIT 108
 10 FOREST FALLS DRIVE, YARMOUTH, MAINE 04096
 (207) 846-1441
 FACEBOOK: MECHANICAL SYSTEMS ENGINEERS
 CELEBRATING 50 YEARS IN BUSINESS
 © COPYRIGHT 2018



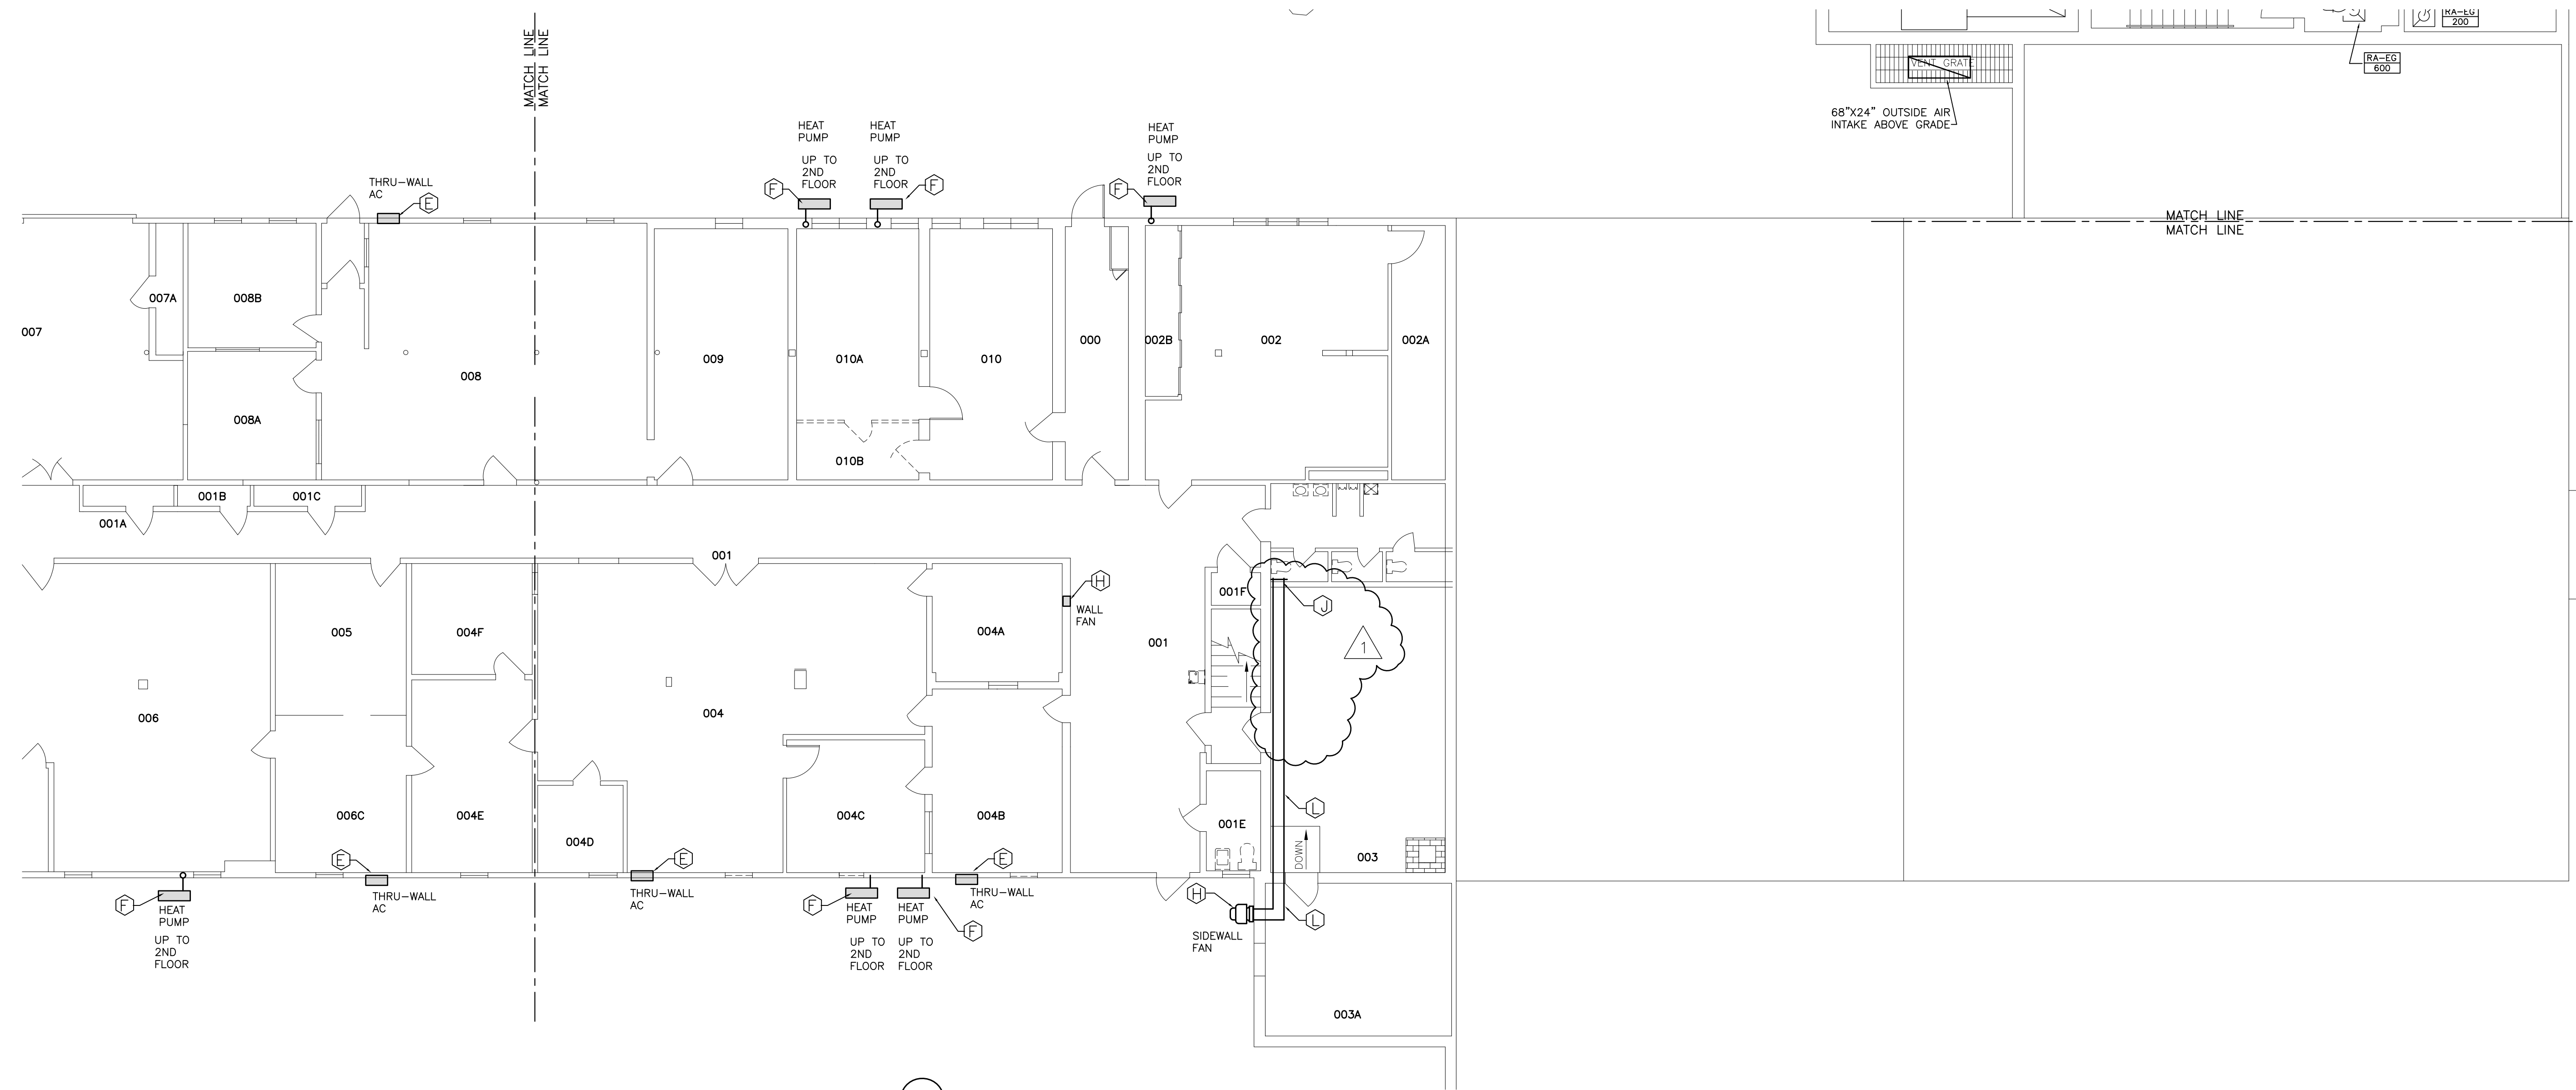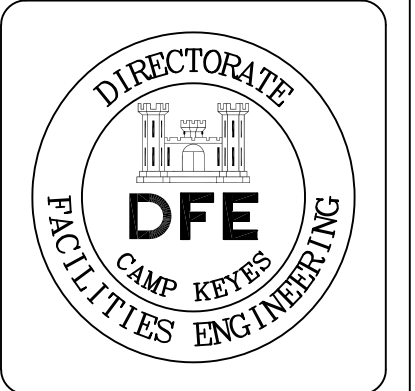

1 MECHANICAL HVAC REMOVAL PLAN
LOWER LEVEL - NORTH END
SCALE: 1/8" = 1'-0"

Rev#	Description	Date	Appr.
1	GENERAL REVISIONS		
	PLAN REVISIONS	1.28.19	

DESIGNED BY: KFM
 DRAWN BY: KFM
 CHECKED BY: KFM/MAD
 DATE: 12/28/2018
 SCALE: 1/8" = 1'-0"
 DFE PROJECT NO: 235F18-458-D

STATE OF MAINE
 DEPARTMENT OF DEFENSE, VETERANS
 AND EMERGENCY MANAGEMENT
 Cordja Capital Projects Group
 16 Tannery Lane, Suite 23
 Camden, Maine 04843
 207-236-9970 / mdsigle@cordjagcp.com

CAMP KEYS REUTILIZATION PROJECT
 CAMP KEYS, AUGUSTA, MAINE
 BUILDING NO. 7 RENOVATIONS
 MECHANICAL HVAC REMOVAL PLAN
 LOWER LEVEL - NORTH END

PLAN PROGRESS

<input type="checkbox"/>	DRAFT
<input type="checkbox"/>	35% REVIEW
<input type="checkbox"/>	65% REVIEW
<input type="checkbox"/>	95% REVIEW
<input type="checkbox"/>	FINAL REVIEW
<input checked="" type="checkbox"/>	FOR BIDDING
<input type="checkbox"/>	ISSUED FOR CONSTRUCTION
<input type="checkbox"/>	RECORD DRAWINGS

SHEET ID:
 MD-108
 SHEET: 73 OF 126

REMOVAL AND DEMOLITION KEYED NOTES


- A REMOVE HOT WATER COIL. DISCONNECT HOT WATER SUPPLY AND RETURN LINES. REMOVE CONTROL VALVE AND ACCESSORIES. REMOVE DUCTWORK TRANSITIONS AND DUCTWORK NOT BEING REUSED.
- B REMOVE ROOF-MOUNTED FAN. EXISTING ROOF CURB TO REMAIN AS-IS FOR REUSE.
- C REMOVE 68"x24" OUTSIDE AIR GOOSENECK. RE-INSTALL ON EXTENDED DUCT.
- D ELECTRIC BASEBOARD HEAT TO BE REMOVED BY ELECTRICAL CONTRACTOR. REMOVE ASSOCIATED THERMOSTAT AND CONTROL WIRING.
- E REMOVE THROUGH-WALL AIR CONDITIONING UNIT.
- F REMOVE HEAT PUMP MINI-SPLIT OUTDOOR UNIT. REMOVE ASSOCIATED WALL-BRACKET OR GROUND PAD. REMOVE ALL REFRIGERANT PER EPA STANDARDS. REMOVE ALL REFRIGERANT PIPING FROM HEAT PUMP TO AIR HANDLER.
- G REMOVE HEAT PUMP MINI-SPLIT OUTDOOR UNIT. REMOVE ASSOCIATED WALL-BRACKET OR GROUND-PAD. REMOVE ALL REFRIGERANT PER EPA STANDARDS. REMOVE ALL REFRIGERANT PIPING FROM HEAT PUMP TO AIR HANDLER. CAP GAS AND LIQUID LINE MOISTURE-TIGHT (FLARE JOINT CAP). PLACE ALL REMOVED INDOOR & OUTDOOR UNITS ON PALLETS AND PACKAGE FOR OVER-THE ROAD TRANSPORT TO A OWNER DESIGNATED LOCATION WITHIN CAMP KEYS.
- H REMOVE HEAT PUMP MINI-SPLIT AIR HANDLER. REMOVE ASSOCIATED WALL-BRACKET. REMOVE ALL CONDENSATE PIPING NOT BEING REUSED.
- I REMOVE HEAT PUMP MINI-SPLIT AIR HANDLER. REMOVE ASSOCIATED WALL-BRACKET. CAP GAS AND LIQUID LINE MOISTURE-TIGHT (FLARE JOINT CAP). REMOVE CONDENSATE PIPING. TRANSPORT OUTDOOR UNIT TO OWNER DESIGNATED LOCATION WITHIN CAMP KEYS.
- J REMOVE THROUGH-WALL FAN AND FAN SWITCH.
- K REMOVE CEILING-MOUNTED ELECTRIC HEATER.
- L REMOVE CEILING OR WALL-MOUNTED RETURN, EXHAUST OR SUPPLY GRILLE. REMOVE ASSOCIATED BRANCH DUCT.
- M REMOVE ENERGY RECOVERY UNIT.
- N REMOVE DUCTWORK MAIN. REMOVE ENTIRE MAIN AND BRANCH DUCTS.
- STORE THIS COMMENT ON THE DRAWINGS INDICATES THE MAJOR COMPONENTS OF THE MINI-SPLIT SYSTEMS THAT ARE TO BE REMOVED, PACKED, AND DELIVERED FOR STORAGE.

REMOVAL AND DEMOLITION GENERAL NOTES



- 1) THE INTENTION OF THIS DRAWING AND NOTES IS TO SHOW THE GENERAL LOCATION AND DESCRIPTION OF ITEMS TO BE REMOVED. IT DOES NOT INCLUDE ALL THE DETAILS AND ACCESSORIES ASSOCIATED WITH THE ITEM TO BE REMOVED - IT WILL BE THE CONTRACTORS RESPONSIBILITY TO REMOVE ALL ACCESSORIES NORMALLY ASSOCIATED WITH THE ITEM DESIGNATED.
- 2) THE CONTRACTOR IS TO REMOVE ALL DEMOLISHED MATERIALS AND EQUIPMENT FROM THE JOBSITE. CONTRACTOR IS TO DEPOSE OF ALL MATERIAL AND EQUIPMENT PER EPA STANDARDS.
- 3) ALL REFRIGERANTS MUST BE RECOVERED PER EPA STANDARDS AND REMOVED FROM THE JOBSITE. THE CONTRACTOR PERFORMING THE REMOVAL, PUMPING AND CAPPING OF REFRIGERANT LINES SHALL PROVIDE DOCUMENTATION THEY HAVE PASSED AN EPA APPROVED SECTION 608 TECHNICIAN CERTIFICATION (TYPE II) TEST PRIOR TO REMOVAL OF THE HVAC UNITS.
- 4) MATERIALS AND EQUIPMENT THAT ARE DESIGNATED STORE SHALL BE PACKED ON PALLETES AND SHRINK WRAPPED FOR OVER-THE-ROAD TRANSPORT AND DELIVERED TO A LOCATION WITHIN CAMP KEYS SPECIFIED BY THE OWNER.

CONTROL AND BALANCING VALVE REMOVAL NOTES

- 1) REMOVE CONTROL VALVES, BALANCING VALVES BALL VALVES AND STRAINERS FOR CONNECTIONS THAT ARE SHOWN TO BE REPLACED ON DRAWING M108.
- 2) EXISTING FIN-TUBE RADIATION, UNIT HEATERS AND CONVECTORS ARE TO REMAIN IN-PLACE AN IN-USE.

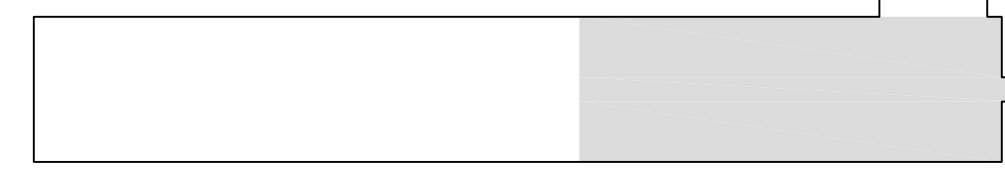


KEY PLAN
NO SCALE

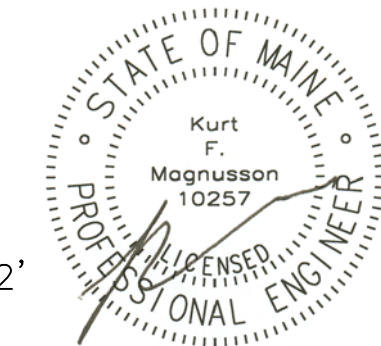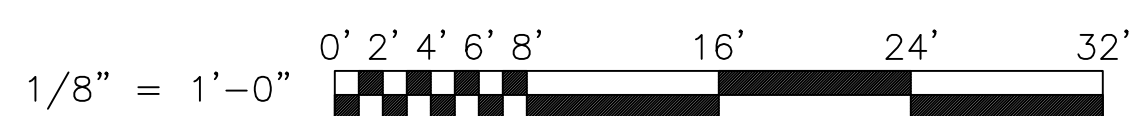

MECHANICAL SYSTEMS ENGINEERS
 ROYAL RIVER CENTER, UNIT 108
 10 FOREST FALLS DRIVE, YARMOUTH, MAINE 04096
 (207) 846-1441
 FACEBOOK: MECHANICAL SYSTEMS ENGINEERS
 CELEBRATING 50 YEARS IN BUSINESS
 © COPYRIGHT 2018



January 28, 2019 - 7:18 am
 X:\Projects\1813 Camp Keys Bldg 7\Address\1813 Bldg 7 MD101-MD113 & PD101 (01-23-2019).dwg

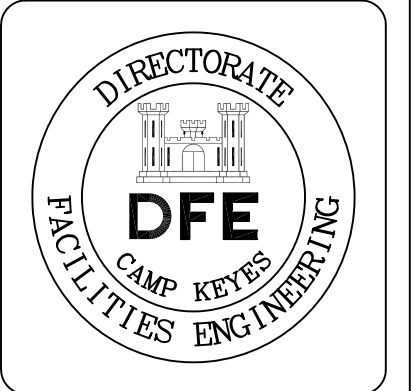

1 MECHANICAL HVAC REMOVAL PLAN
FIRST FLOOR – SOUTH END
SCALE: 1/8" = 1'-0"

Rev#	Description	Date	Appr.
1	GENERAL REVISIONS	1.28.19	
	PLAN REVISIONS		

DESIGNED BY: **KM**
 DRAWN BY: **KFM/MAD**
 CHECKED BY: **KM**
 DATE: **12/28/2018**
 SCALE: **1/8" = 1'-0"**
 DFE PROJECT NO: **235R18-458-D**

STATE OF MAINE
 DEPARTMENT OF DEFENSE, VETERANS
 AND EMERGENCY MANAGEMENT
 Cordja Capital Projects Group
 16 Tannery Lane, Suite 23
 Camden, Maine 04843
 207-236-9970 / mdsigle@cdjcapg.com

CAMP KEYS REUTILIZATION PROJECT
 CAMP KEYS, AUGUSTA, MAINE
 BUILDING NO. 7 RENOVATIONS
 MECHANICAL HVAC REMOVAL PLAN
 FIRST FLOOR – SOUTH END

PLAN PROGRESS

<input type="checkbox"/>	DRAFT
<input type="checkbox"/>	35% REVIEW
<input type="checkbox"/>	65% REVIEW
<input type="checkbox"/>	95% REVIEW
<input type="checkbox"/>	FINAL REVIEW
<input checked="" type="checkbox"/>	FOR BIDDING
<input type="checkbox"/>	ISSUED FOR CONSTRUCTION
<input type="checkbox"/>	RECORD DRAWINGS

SHEET ID:
MD-109
 SHEET: 74 OF 126

REMOVAL AND DEMOLITION KEYED NOTES




(A) REMOVE HOT WATER COIL. DISCONNECT HOT WATER SUPPLY AND RETURN LINES. REMOVE CONTROL VALVE AND ACCESSORIES. REMOVE DUCTWORK TRANSITIONS AND DUCTWORK NOT BEING REUSED.	(G) REMOVE HEAT PUMP MINI-SPLIT SPLIT AIR HANDLER. REMOVE ASSOCIATED WALL-BRACKET. REMOVE ALL CONDENSATE PIPING NOT BEING REUSED.
(B) REMOVE ROOF-MOUNTED FAN. EXISTING ROOF CURB TO REMAIN AS-IS FOR REUSE.	(H) REMOVE THROUGH-WALL FAN AND FAN SWITCH.
(C) REMOVE 68"x24" OUTSIDE AIR GOOSENECK. RE-INSTALL ON EXTENDED DUCT.	(I) REMOVE CEILING-MOUNTED ELECTRIC HEATER.
(D) ELECTRIC BASEBOARD HEAT TO BE REMOVED BY ELECTRICAL CONTRACTOR. REMOVE ASSOCIATED THERMOSTAT AND CONTROL WIRING.	(J) REMOVE CEILING OR WALL-MOUNTED RETURN, EXHAUST OR SUPPLY GRILLE. REMOVE ASSOCIATED BRANCH DUCT.
(E) REMOVE THROUGH-WALL AIR CONDITIONING UNIT.	(K) REMOVE ENERGY RECOVERY UNIT.
(F) REMOVE HEAT PUMP MINI-SPLIT OUTDOOR UNIT. REMOVE ASSOCIATED WALL-BRACKET OR GROUND-PAD. REMOVE ALL REFRIGERANT PER EPA STANDARDS. REMOVE ALL REFRIGERANT PIPING FROM HEAT PUMP TO AIR HANDLER.	(L) REMOVE DUCTWORK MAIN. REMOVE ENTIRE MAIN AND BRANCH DUCTS.
(F) REMOVE HEAT PUMP MINI-SPLIT OUTDOOR UNIT. REMOVE ASSOCIATED WALL-BRACKET OR GROUND-PAD. REMOVE ALL REFRIGERANT PER EPA STANDARDS. REMOVE ALL REFRIGERANT PIPING FROM HEAT PUMP TO AIR HANDLER. CAP GAS AND LIQUID LINE MOISTURE-TIGHT (FLARE JOINT CAP). PLACE ALL REMOVED INDOOR & OUTDOOR UNITS ON PALLETS AND PACKAGE FOR OVER-THE-ROAD TRANSPORT TO A OWNER DESIGNATED LOCATION WITHIN CAMP KEYS.	(STORE) THIS COMMENT ON THE DRAWINGS INDICATES THE MAJOR COMPONENTS OF THE MINI-SPLIT SYSTEMS THAT ARE TO BE REMOVED, PACKED, AND DELIVERED FOR STORAGE.

REMOVAL AND DEMOLITION GENERAL NOTES

- 1) THE INTENTION OF THIS DRAWING AND NOTES IS TO SHOW THE GENERAL LOCATION AND DESCRIPTION OF ITEMS TO BE REMOVED. IT DOES NOT INCLUDE ALL THE DETAILS AND ACCESSORIES ASSOCIATED WITH THE ITEM TO BE REMOVED - IT WILL BE THE CONTRACTOR'S RESPONSIBILITY TO REMOVE ALL ACCESSORIES NORMALLY ASSOCIATED WITH THE ITEM DESIGNATED.
- 2) THE CONTRACTOR IS TO REMOVE ALL DEMOLISHED MATERIALS AND EQUIPMENT FROM THE JOBSITE. CONTRACTOR IS TO DEPOSE OF ALL MATERIAL AND EQUIPMENT PER EPA STANDARDS.
- 3) ALL REFRIGERANTS MUST BE RECOVERED PER EPA STANDARDS AND REMOVED FROM THE JOBSITE. THE CONTRACTOR PERFORMING THE REMOVAL, PUMPING AND CAPPING OF REFRIGERANT LINES SHALL PROVIDE DOCUMENTATION THEY HAVE PASSED AN EPA APPROVED SECTION 608 TECHNICIAN CERTIFICATION (TYPE II) TEST PRIOR TO REMOVAL OF THE HVAC UNITS.
- 4) MATERIALS AND EQUIPMENT THAT ARE DESIGNATED **(STORE)** SHALL BE PACKED ON PALLETS AND SHRINK-WRAPPED FOR OVER-THE-ROAD TRANSPORT AND DELIVERED TO A LOCATION WITHIN CAMP KEYS SPECIFIED BY THE OWNER.



CONTROL AND BALANCING VALVE REMOVAL NOTES

- 1) REMOVE CONTROL VALVES, BALANCING VALVES BALL VALVES AND STRAINERS FOR CONNECTIONS THAT ARE SHOWN TO BE REPLACED ON DRAWING M108.
- 2) EXISTING FIN-TUBE RADIATION, UNIT HEATERS AND CONVECTORS ARE TO REMAIN IN-PLACE AN IN-USE.

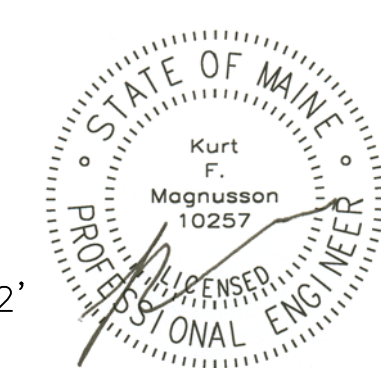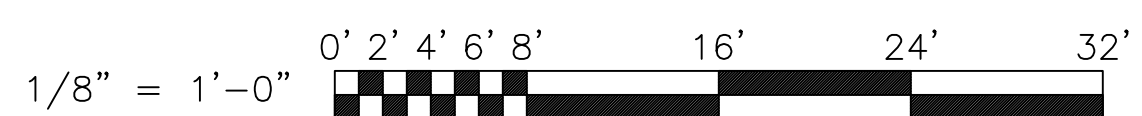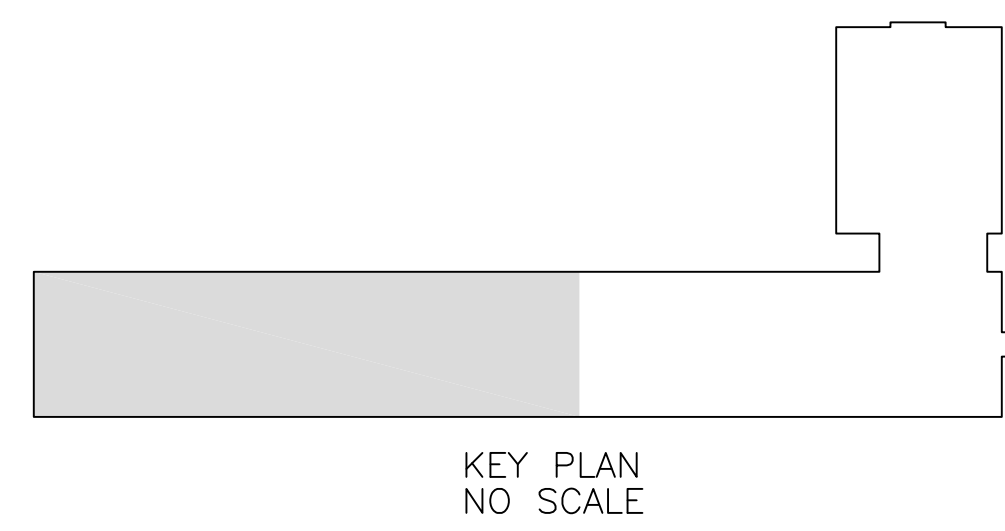

MECHANICAL SYSTEMS ENGINEERS
 ROYAL RIVER CENTER, UNIT 108
 10 FOREST FALLS DRIVE, YARMOUTH, MAINE 04096
 (207) 846-1441
 FACEBOOK: MECHANICAL SYSTEMS ENGINEERS
 CELEBRATING 50 YEARS IN BUSINESS
 © COPYRIGHT 2018



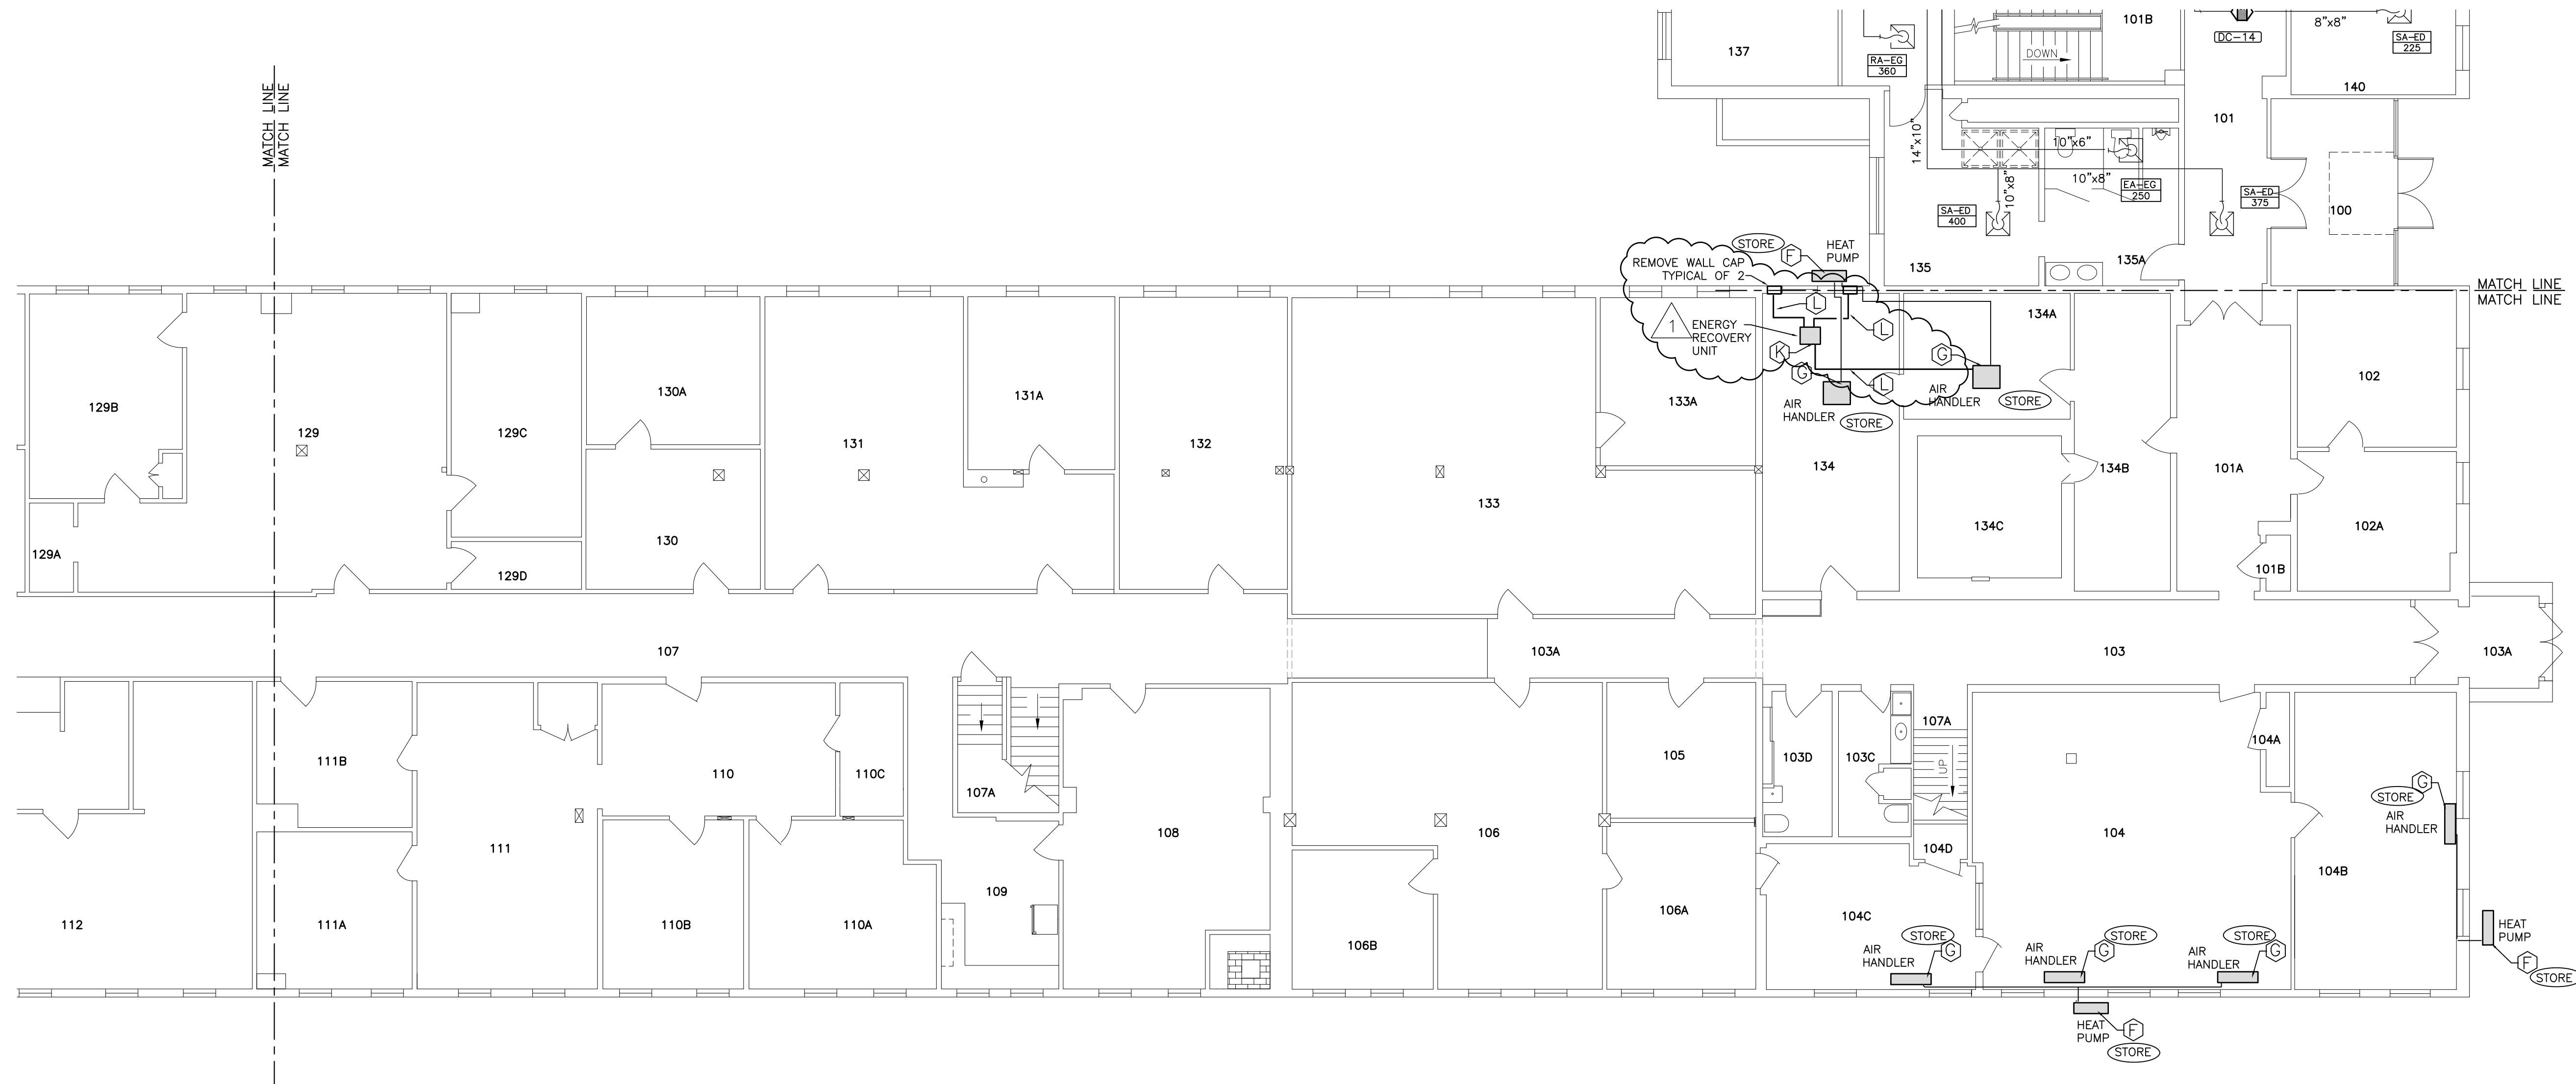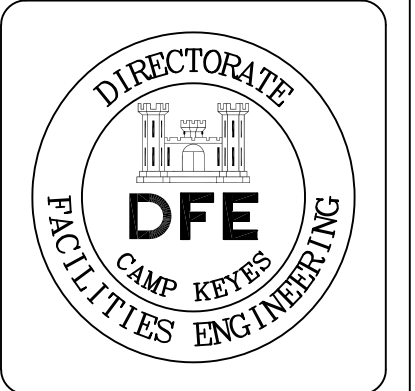

1 MECHANICAL HVAC REMOVAL PLAN
FIRST FLOOR – NORTH END
SCALE: 1/8" = 1'-0"

Rev#	Description	Date	Appr.
1	GENERAL REVISIONS	1-28-19	

DESIGNED BY: **KM**
 DRAWN BY: **KM**
 CHECKED BY: **KFM/MAD**
 DATE: **12/28/2018**
 SCALE: **(1/8" = 1'-0")**
 DFE PROJECT NO.: **235F18-458-D**

STATE OF MAINE
 DEPARTMENT OF DEFENSE, VETERANS
 AND EMERGENCY MANAGEMENT
 Cordja Capital Projects Group
 16 Tannery Lane, Suite 23
 Camden, Maine 04843
 207-236-9970 / mdsigle@cordjagroup.com

CAMP KEYS REUTILIZATION PROJECT
 CAMP KEYS, AUGUSTA, MAINE
 BUILDING NO. 7 RENOVATIONS
 MECHANICAL HVAC REMOVAL PLAN
 FIRST FLOOR – NORTH END

PLAN PROGRESS



<input type="checkbox"/>	DRAFT
<input type="checkbox"/>	35% REVIEW
<input type="checkbox"/>	65% REVIEW
<input type="checkbox"/>	95% REVIEW
<input type="checkbox"/>	FINAL REVIEW
<input checked="" type="checkbox"/>	FOR BIDDING
<input type="checkbox"/>	ISSUED FOR CONSTRUCTION
<input type="checkbox"/>	RECORD DRAWINGS

SHEET ID:
MD-110
 SHEET: 75 of 126

- REMOVAL AND DEMOLITION KEYED NOTES**
- (A) REMOVE HOT WATER COIL. DISCONNECT HOT WATER SUPPLY AND RETURN LINES. REMOVE CONTROL VALVE AND ACCESSORIES. REMOVE DUCTWORK TRANSITIONS AND DUCTWORK NOT BEING REUSED.
 - (B) REMOVE ROOF-MOUNTED FAN. EXISTING ROOF CURB TO REMAIN AS-IS FOR REUSE.
 - (C) REMOVE 68"x24" OUTSIDE AIR GOOSENECK. RE-INSTALL ON EXTENDED DUCT.
 - (D) ELECTRIC BASEBOARD HEAT TO BE REMOVED BY ELECTRICAL CONTRACTOR. REMOVE ASSOCIATED THERMOSTAT AND CONTROL WIRING.
 - (E) REMOVE THROUGH-WALL AIR CONDITIONING UNIT.
 - (F) REMOVE HEAT PUMP MINI-SPLIT OUTDOOR UNIT. REMOVE ASSOCIATED WALL-BRACKET OR GROUND PAD. REMOVE ALL REFRIGERANT PER EPA STANDARDS. REMOVE ALL REFRIGERANT PIPING FROM HEAT PUMP TO AIR HANDLER.
 - (G) REMOVE HEAT PUMP MINI-SPLIT OUTDOOR UNIT. REMOVE ASSOCIATED WALL-BRACKET OR GROUND-PAD. REMOVE ALL REFRIGERANT PER EPA STANDARDS. REMOVE ALL REFRIGERANT PIPING FROM HEAT PUMP TO AIR HANDLER. CAP GAS AND LIQUID LINE MOISTURE-TIGHT (FLARE JOINT CAP). PLACE ALL REMOVED INDOOR & OUTDOOR UNITS ON PALLETS AND PACKAGE FOR OVER-THE ROAD TRANSPORT TO A OWNER DESIGNATED LOCATION WITHIN CAMP KEYS.
 - (H) REMOVE THROUGH-WALL FAN AND FAN SWITCH.
 - (I) REMOVE CEILING-MOUNTED ELECTRIC HEATER.
 - (J) REMOVE CEILING OR WALL-MOUNTED RETURN, EXHAUST OR SUPPLY GRILLE. REMOVE ASSOCIATED BRANCH DUCT.
 - (K) REMOVE ENERGY RECOVERY UNIT.
 - (L) REMOVE DUCTWORK MAIN. REMOVE ENTIRE MAIN AND BRANCH DUCTS.
 - (STORE) REMOVE HEAT PUMP MINI-SPLIT SPLIT AIR HANDLER. REMOVE ASSOCIATED WALL-BRACKET. REMOVE ALL CONDENSATE PIPING NOT BEING REUSED.
 - (STORE) REMOVE HEAT PUMP MINI-SPLIT AIR HANDLER. REMOVE ASSOCIATED WALL-BRACKET. CAP GAS AND LIQUID LINE MOISTURE-TIGHT (FLARE JOINT CAP). REMOVE CONDENSATE PIPING. TRANSPORT OUTDOOR UNIT TO OWNER DESIGNATED LOCATION WITHIN CAMP KEYS.
 - (STORE) THIS COMMENT ON THE DRAWINGS INDICATES THE MAJOR COMPONENTS OF THE MINI-SPLIT SYSTEMS THAT ARE TO BE REMOVED, PACKED, AND DELIVERED FOR STORAGE.

- REMOVAL AND DEMOLITION GENERAL NOTES**
- THE INTENTION OF THIS DRAWING AND NOTES IS TO SHOW THE GENERAL LOCATION AND DESCRIPTION OF ITEMS TO BE REMOVED. IT DOES NOT INCLUDE ALL THE DETAILS AND ACCESSORIES ASSOCIATED WITH THE ITEM TO BE REMOVED - IT WILL BE THE CONTRACTORS RESPONSIBILITY TO REMOVE ALL ACCESSORIES NORMALLY ASSOCIATED WITH THE ITEM DESIGNATED.
 - THE CONTRACTOR IS TO REMOVE ALL DEMOLISHED MATERIALS AND EQUIPMENT FROM THE JOBSITE. CONTRACTOR IS TO DEPOSE OF ALL MATERIAL AND EQUIPMENT PER EPA STANDARDS.
 - ALL REFRIGERANTS MUST BE RECOVERED PER EPA STANDARDS AND REMOVED FROM THE JOBSITE. THE CONTRACTOR PERFORMING THE REMOVAL, PUMPING AND CAPPING OF REFRIGERANT LINES SHALL PROVIDE DOCUMENTATION THEY HAVE PASSED AN EPA APPROVED SECTION 608 TECHNICIAN CERTIFICATION (TYPE II) TEST PRIOR TO REMOVAL OF THE HVAC UNITS.
 - MATERIALS AND EQUIPMENT THAT ARE DESIGNATED (STORE) SHALL BE PACKED ON PALLETS AND SHRINK WRAPPED FOR OVER-THE-ROAD TRANSPORT AND DELIVERED TO A LOCATION WITHIN CAMP KEYS SPECIFIED BY THE OWNER.



- CONTROL AND BALANCING VALVE REMOVAL NOTES**
- REMOVE CONTROL VALVES, BALANCING VALVES BALL VALVES AND STRAINERS FOR CONNECTIONS THAT ARE SHOWN TO BE REPLACED ON DRAWING M108.
 - EXISTING FIN-TUBE RADIATION, UNIT HEATERS AND CONNECTORS ARE TO REMAIN IN-PLACE AN IN-USE.

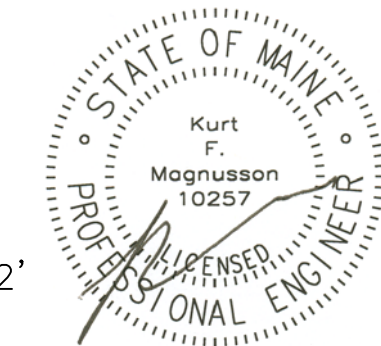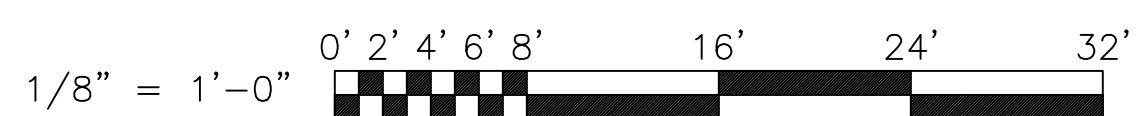

MECHANICAL SYSTEMS ENGINEERS
 ROYAL RIVER CENTER, UNIT 108
 10 FOREST FALLS DRIVE, YARMOUTH, MAINE 04096
 (207) 846-1441
 FACEBOOK: MECHANICAL SYSTEMS ENGINEERS
 CELEBRATING 50 YEARS IN BUSINESS
 © COPYRIGHT 2018



January 28, 2019 - 7:19 am
 X:\Projects\1813 Camp Keys\Bldg 7\MD101-MD113 & PD101 (01-23-2019).dwg

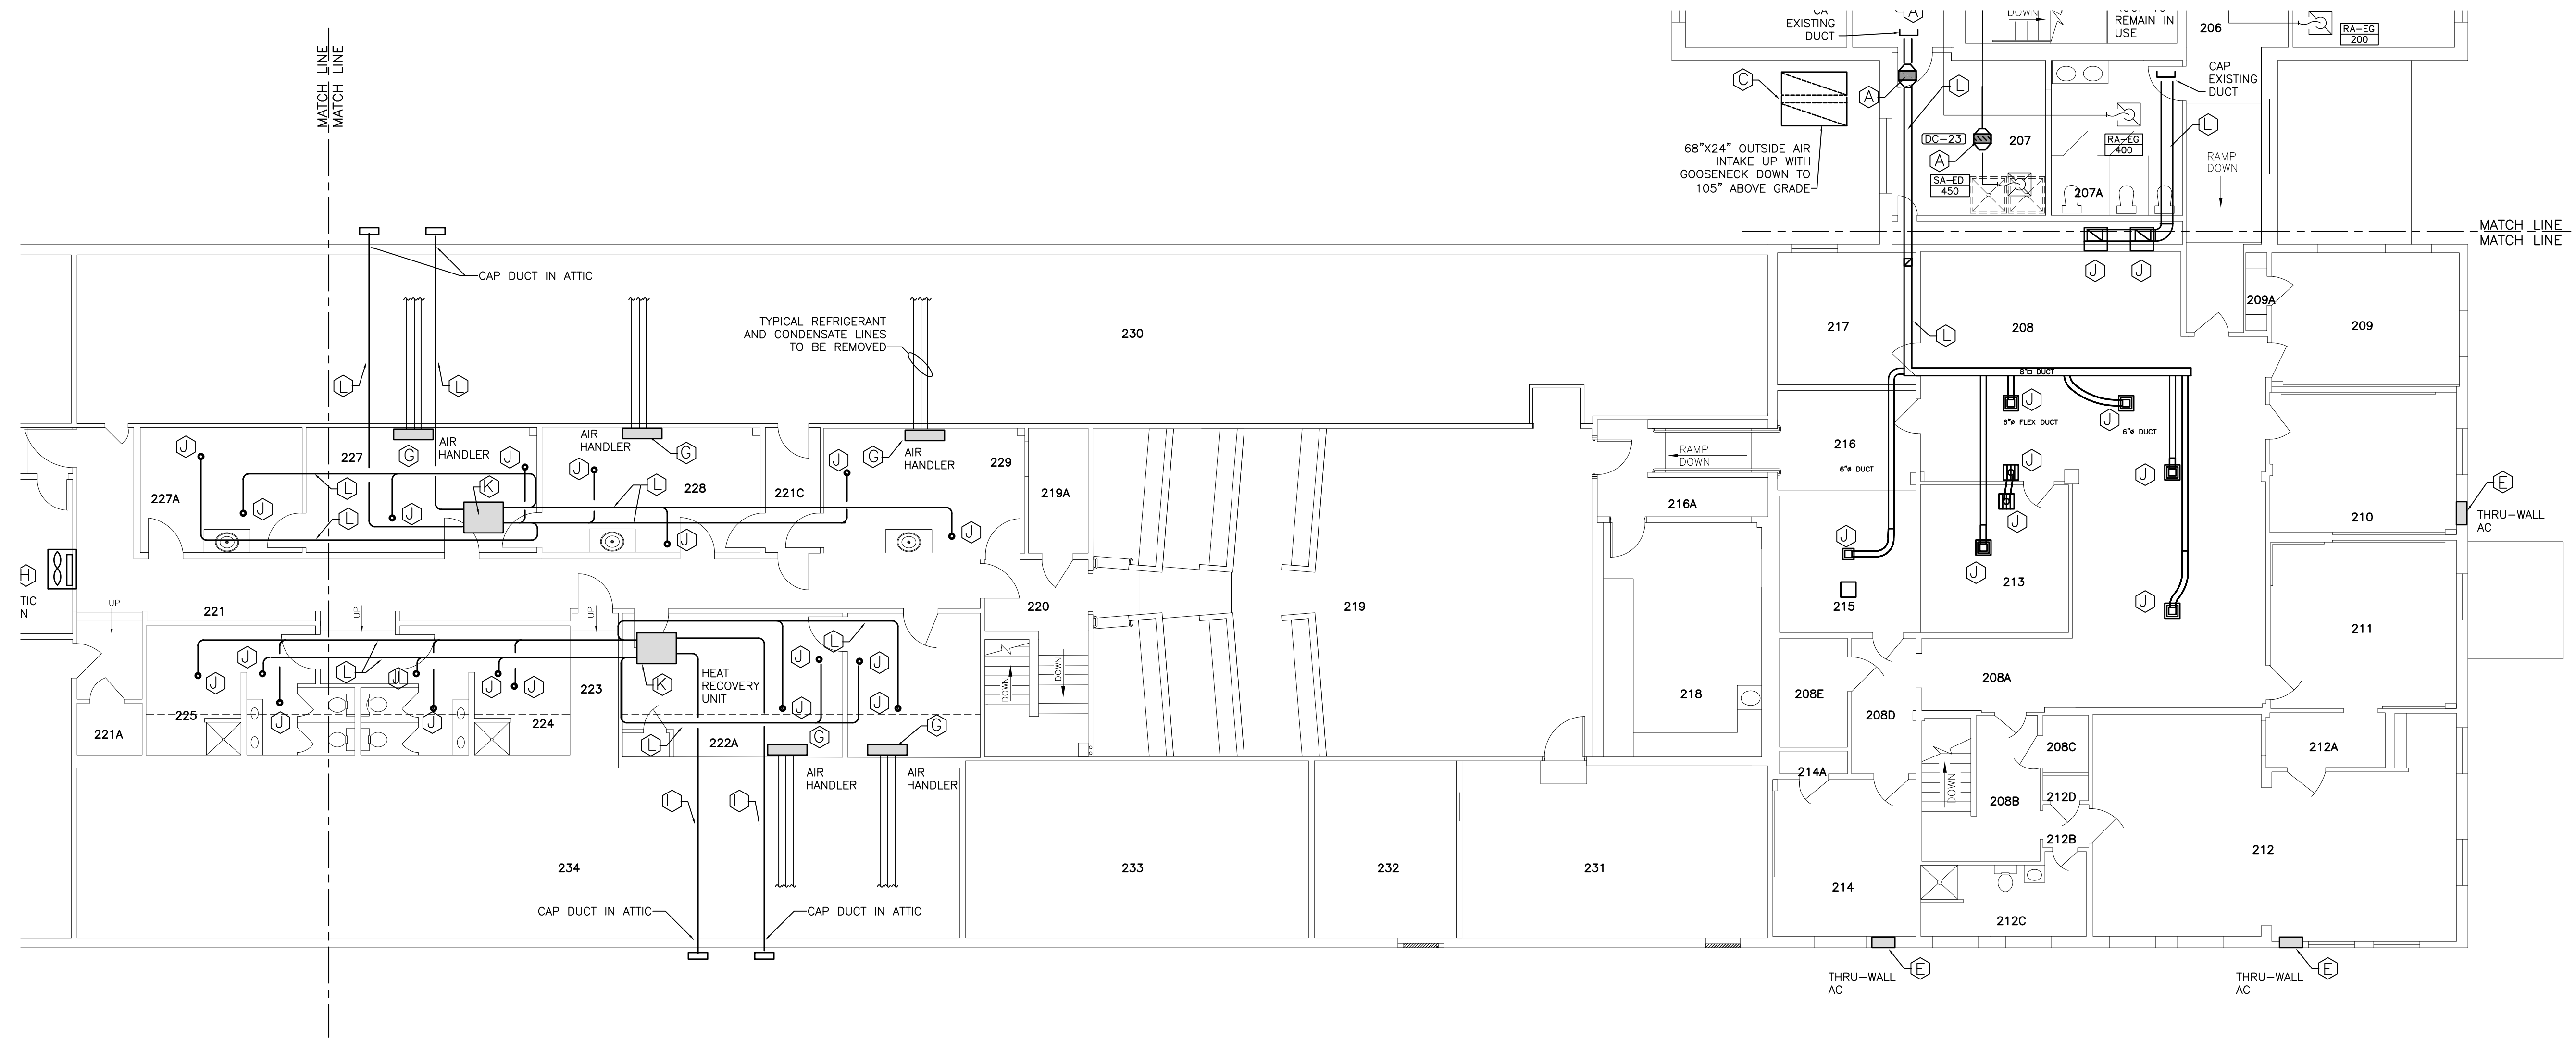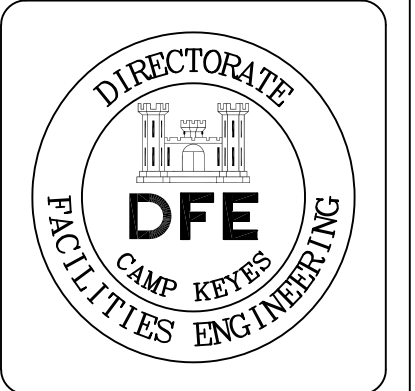

Rev#	Description	Date	Appr.
1	GENERAL REVISIONS	1.28.19	
	PLAN REVISIONS		

DESIGNED BY: **STATE OF MAINE**
 DRAWN BY: **DEPARTMENT OF DEFENSE, VETERANS AND EMERGENCY MANAGEMENT**
 CHECKED BY: **KM**
 DATE: **12/28/2018**
 SCALE: **1/8" = 1'-0"**
 DFE PROJECT NO: **235F18-458-D**
 Cordja Capital Projects Group
 16 Tannery Lane, Suite 23
 Camden, Maine 04843
 207-236-9970 / mdsigle@cordjagroup.com

1 MECHANICAL HVAC REMOVAL PLAN
SECOND FLOOR – NORTH END
 SCALE: 1/8" = 1'-0"

- REMOVAL AND DEMOLITION KEYED NOTES**
- (A)** REMOVE HOT WATER COIL. DISCONNECT HOT WATER SUPPLY AND RETURN LINES. REMOVE CONTROL VALVE AND ACCESSORIES. REMOVE DUCTWORK TRANSITIONS AND DUCTWORK NOT BEING REUSED.
 - (B)** REMOVE ROOF-MOUNTED FAN. EXISTING ROOF CURB TO REMAIN AS-IS FOR REUSE.
 - (C)** REMOVE 68"x24" OUTSIDE AIR GOOSENECK. RE-INSTALL ON EXTENDED DUCT.
 - (D)** ELECTRIC BASEBOARD HEAT TO BE REMOVED BY ELECTRICAL CONTRACTOR. REMOVE ASSOCIATED THERMOSTAT AND CONTROL WIRING.
 - (E)** REMOVE THROUGH-WALL AIR CONDITIONING UNIT.
 - (F)** REMOVE HEAT PUMP MINI-SPLIT OUTDOOR UNIT. REMOVE ASSOCIATED WALL-BRACKET OR GROUND PAD. REMOVE ALL REFRIGERANT PER EPA STANDARDS. REMOVE ALL REFRIGERANT PIPING FROM HEAT PUMP TO AIR HANDLER.
 - (STORE)** REMOVE HEAT PUMP MINI-SPLIT OUTDOOR UNIT. REMOVE ASSOCIATED WALL-BRACKET OR GROUND-PAD. REMOVE ALL REFRIGERANT PER EPA STANDARDS. REMOVE ALL REFRIGERANT PIPING FROM HEAT PUMP TO AIR HANDLER. CAP GAS AND LIQUID LINE MOISTURE-TIGHT (FLARE JOINT CAP). PLACE ALL REMOVED INDOOR & OUTDOOR UNITS ON PALLETS AND PACKAGE FOR OVER-THE ROAD TRANSPORT TO A OWNER DESIGNATED LOCATION WITHIN CAMP KEYS.
 - (G)** REMOVE HEAT PUMP MINI-SPLIT AIR HANDLER. REMOVE ASSOCIATED WALL-BRACKET. REMOVE ALL CONDENSATE PIPING NOT BEING REUSED.
 - (STORE)** REMOVE HEAT PUMP MINI-SPLIT AIR HANDLER. REMOVE ASSOCIATED WALL-BRACKET. CAP GAS AND LIQUID LINE MOISTURE-TIGHT (FLARE JOINT CAP). REMOVE CONDENSATE PIPING. TRANSPORT OUTDOOR UNIT TO OWNER DESIGNATED LOCATION WITHIN CAMP KEYS.
 - (H)** REMOVE THROUGH-WALL FAN AND FAN SWITCH.
 - (I)** REMOVE CEILING-MOUNTED ELECTRIC HEATER.
 - (J)** REMOVE CEILING OR WALL-MOUNTED RETURN, EXHAUST OR SUPPLY GRILLE. REMOVE ASSOCIATED BRANCH DUCT.
 - (K)** REMOVE ENERGY RECOVERY UNIT.
 - (L)** REMOVE DUCTWORK MAIN. REMOVE ENTIRE MAIN AND BRANCH DUCTS.
 - (STORE)** THIS COMMENT ON THE DRAWINGS INDICATES THE MAJOR COMPONENTS OF THE MINI-SPLIT SYSTEMS THAT ARE TO BE REMOVED, PACKED, AND DELIVERED FOR STORAGE.

- REMOVAL AND DEMOLITION GENERAL NOTES**
- THE INTENTION OF THIS DRAWING AND NOTES IS TO SHOW THE GENERAL LOCATION AND DESCRIPTION OF ITEMS TO BE REMOVED. IT DOES NOT INCLUDE ALL THE DETAILS AND ACCESSORIES ASSOCIATED WITH THE ITEM TO BE REMOVED - IT WILL BE THE CONTRACTORS RESPONSIBILITY TO REMOVE ALL ACCESSORIES NORMALLY ASSOCIATED WITH THE ITEM DESIGNATED.
 - THE CONTRACTOR IS TO REMOVE ALL DEMOLISHED MATERIALS AND EQUIPMENT FROM THE JOBSITE. CONTRACTOR IS TO DEPOSE OF ALL MATERIAL AND EQUIPMENT PER EPA STANDARDS.
 - ALL REFRIGERANTS MUST BE RECOVERED PER EPA STANDARDS AND REMOVED FROM THE JOBSITE. THE CONTRACTOR PERFORMING THE REMOVAL PUMPING AND CAPPING OF REFRIGERANT LINES SHALL PROVIDE DOCUMENTATION THEY HAVE PASSED AN EPA APPROVED SECTION 608 TECHNICIAN CERTIFICATION (TYPE II) TEST PRIOR TO REMOVAL OF THE HVAC UNITS.
 - MATERIALS AND EQUIPMENT THAT ARE DESIGNATED **(STORE)** SHALL BE PACKED ON PALLETES AND SHRINK WRAPPED FOR OVER-THE-ROAD TRANSPORT AND DELIVERED TO A LOCATION WITHIN CAMP KEYS SPECIFIED BY THE OWNER.




- CONTROL AND BALANCING VALVE REMOVAL NOTES**
- REMOVE CONTROL VALVES, BALANCING VALVES BALL VALVES AND STRAINERS FOR CONNECTIONS THAT ARE SHOWN TO BE REPLACED ON DRAWING M108.
 - EXISTING FIN-TUBE RADIATION, UNIT HEATERS AND CONVECTORS ARE TO REMAIN IN-PLACE AN IN-USE.

CAMP KEYS REUTILIZATION PROJECT
 CAMP KEYS, AUGUSTA, MAINE
 BUILDING NO. 7 RENOVATIONS
 MECHANICAL HVAC REMOVAL PLAN
 SECOND FLOOR – NORTH END

- PLAN PROGRESS**
- DRAFT
 - 35% REVIEW
 - 65% REVIEW
 - 95% REVIEW
 - FINAL REVIEW
 - FOR BIDDING
 - ISSUED FOR CONSTRUCTION
 - RECORD DRAWINGS

SHEET ID:
MD-112
 SHEET: 77 OF 126

January 28, 2019 - 7:20 am
 X:\Projects\1813 Camp Keys\Bldg 7\Address\1813 Bldg 7 MD101-MD113 & PD101 (01-23-2019).dwg

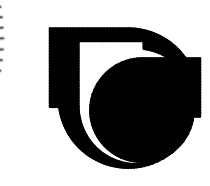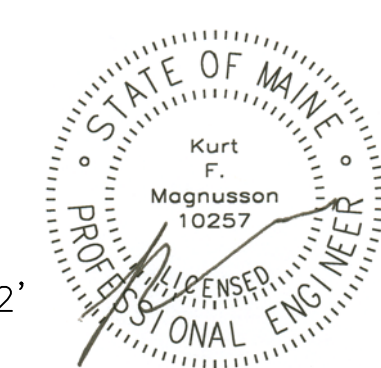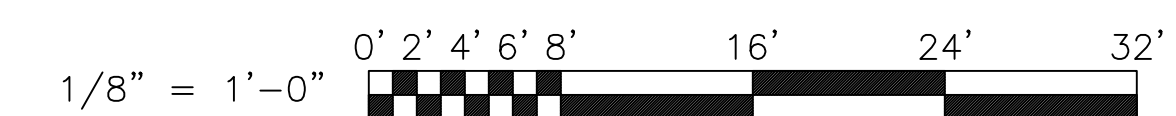

MECHANICAL SYSTEMS ENGINEERS
 ROYAL RIVER CENTER, UNIT 108
 10 FOREST FALLS DRIVE, YARMOUTH, MAINE 04096
 (207) 846-1441
 FACEBOOK: MECHANICAL SYSTEMS ENGINEERS
 CELEBRATING 50 YEARS IN BUSINESS
 © COPYRIGHT 2018




January 28, 2019 - 7:21 am
 X:\Projects\1813 Comp Keyes Bldg 7\Address\1813 Bldg 7 M001 (01-23-2019).dwg

GENERAL NOTES

- MECHANICAL CONTRACTOR SHALL COORDINATE WORK WITH ALL OTHER TRADES.
- ALL PIPING AND DUCTWORK SHALL BE RUN CONCEALED AND ON THE WARM SIDE OF THE BUILDING INSULATION UNLESS SHOWN OTHERWISE.
- PIPING AND DUCTWORK IS SHOWN DIAGRAMATICALLY. EXACT LOCATIONS TO BE ADJUSTED AS REQUIRED TO CONFORM TO FIELD CONDITIONS.
- ALL DUCT SIZES INDICATED ARE OUTSIDE (SHEET METAL) DIMENSIONS.
- ALL CUTTING AND PATCHING BY THE GENERAL CONTRACTOR.
- ALL SQUARE DUCT ELBOWS OVER 12 INCHES IN WIDTH TO HAVE TURNING VANES.
- REFER TO ARCHITECTURAL REFLECTED CEILING PLANS FOR EXACT LOCATIONS OF ALL CEILING REGISTERS, DIFFUSERS AND GRILLES.
- ALL DUCT COILS, FIRE DAMPERS, MOTORIZED DAMPERS AND DUCT SMOKE DETECTORS SHALL HAVE DUCT ACCESS DOORS AS LARGE AS POSSIBLE UP TO 12"X12".
- DUCT BRANCHES TO INDIVIDUAL DIFFUSERS SHALL BE THE SAME SIZE AS THE DIFFUSER NECK.
- ALL DIMENSIONS ASSOCIATED WITH EXISTING CONDITIONS ARE APPROXIMATE AND ARE TO BE FIELD VERIFIED.
- HEATING SYSTEM IS BASED ON 180°F. WATER LEAVING THE BOILER.
- ALL BRANCH WATER PIPING TO INDIVIDUAL TERMINAL HEATING UNITS OR ZONES SHALL BE NOT LESS THAN 3/4 INCHES IN SIZE UNLESS NOTED OTHERWISE.
- ALL REDUCTIONS IN WATER PIPE SIZES IN THE DIRECTION OF FLOW SHALL BE ACCOMPLISHED WITH INVERTED ECCENTRIC REDUCING FITTINGS. DO NOT USE REDUCING TEES.
- PROVIDE AUTOMATIC AIR VENTS AT ALL LOCATIONS WHERE WATER PIPING DROPS IN THE DIRECTION OF FLOW, AT ALL HIGH POINTS IN THE SYSTEM AND ELSEWHERE AS SHOWN.
- PROVIDE DRAINS WITH A BALL COCK, HOSE THREADS AND METAL CAPS AND CHAIN AT ALL LOW POINTS IN THE WATER PIPING SYSTEM.
- ALL REMOVED MATERIALS SHALL REMAIN THE PROPERTY OF THE OWNER UNTIL SUCH TIME THE OWNER'S AUTHORIZED REPRESENTATIVE HAS REVIEWED THE REMOVED ITEMS AND TAKEN WHAT THE OWNER WISHES TO RETAIN. ALL REMAINING ITEMS SHALL BECOME THE PROPERTY OF THE CONTRACTOR AND SHALL BE IMMEDIATELY REMOVED FROM THE PREMISES BY THE CONTRACTOR.

SYMBOLS AND ABBREVIATIONS

ABV	AUTOMATIC BALANCING VALVE	HVAC	HEATING, VENTILATING AND AIR CONDITIONING	---	HWR	---	HOT WATER RETURN PIPING
AC	AIR CONDITIONING	IER	INVERTED ECCENTRIC REDUCER	---	HWS	---	HOT WATER SUPPLY PIPING
AD	ACCESS DOOR	L	LOUVER	---	---	---	COLD WATER PIPING
ADJ	ADJUSTABLE	LAT	LEAVING AIR TEMPERATURE	---	RG	---	REFRIGERANT GAS PIPING
AFF	ABOVE FINISH FLOOR	LDB	LEAVING DRY BULB	---	RL	---	REFRIGERANT LIQUID PIPING
AH	AIR HANDLER	LWB	LEAVING WET BULB	---	RS	---	REFRIGERANT SUCTION PIPING
AP	ACCES PANEL	LWCO	LOW WATER CUT-OFF	---	E	---	EXISTING PIPING
APD	AIR PRESSURE DROP	MBH	THOUSAND BTU PER HOUR	---	X	X	PIPING TO BE REMOVED
ATC	AUTOMATIC TEMP. CONTROL	MBV	MANUAL BALANCING VALVE	---	X	D	DRAIN PIPING
ATFP	ANTI-TERRORISM FORCE PROTECTION	MD	MANUAL DAMPER	---	---	---	UNION
AV	AUTOMATIC VENT	MOD	MOTOR OPERATED DAMPER	---	---	---	HOSE CONNECTION
B	BOILER	MV	MANUAL VENT	---	---	---	FLANGE
BD	BACKDRAFT DAMPER	NG	NATURAL GAS	---	---	---	GATE VALVE
BV	BALL VALVE	NTS	NOT TO SCALE	---	---	---	GLOBE VALVE
C	CONVECTOR	OA	OUTDOOR AIR	---	---	---	CHECK VALVE
CAR	CONSTANT AIRFLOW REGULATOR	OD	OUTSIDE DIMENSION	---	---	---	BALANCING VALVE
CD	CONDENSATE DRAIN	OD	OUTSIDE DIMENSION	---	---	---	CONTROL VALVE (TWO WAY)
CFH	CUBIC FEET PER HOUR	P	PUMP	---	---	---	CONTROL VALVE (THREE WAY)
CFM	CUBIC FEET PER MINUTE	PG	PRESSURE GAUGE	---	---	---	PRESSURE REDUCING VALVE
CTE	CONNECT TO EXISTING	PP	POLYPROPYLENE PIPE	---	---	---	FLOW CONTROL VALVE
CU	CONDENSING UNIT	PRV	PRESSURE REDUCING VALVE	---	---	---	BALL VALVE
CUH	CABINET UNIT HEATER	R	RETURN	---	---	---	STRAINER
CV	CONTROL VALVE	RA	RETURN AIR	---	---	---	ECCENTRIC REDUCER
D	DRAIN	RG	RETURN/RELIEF GRILLE	---	---	---	INVERTED ECCENTRIC REDUCER
DIC	DOWN IN CORNER/CHASE	RIC	RETURN IN COVER	---	---	---	CONVECTOR NUMBER
DHC	DUCT HEATING COIL	RIS	RUBBER-IN-SHEAR	---	---	---	LOUVER NUMBER
DIFF	DIFFUSER	RL	REFRIGERANT LIQUID	---	---	---	TEMPERATURE SENSOR
DIW	DOWN IN WALL	RS	REFRIGERANT SUCTION	---	---	---	THERMOSTAT
DO	DRAW-OFF	RR	RETURN REGISTER	---	---	---	THERMOSTAT WITH GUARD
DSD	DUCT SMOKE DETECTOR	RV	RELIEF VALVE	---	---	---	CONNECT TO EXISTING
EAT	ENTERING AIR TEMPERATURE	S	SUPPLY	---	---	---	MANUAL DAMPER
EDB	ENTERING DRY BULB	SA	SUPPLY AIR	---	---	---	FLEXIBLE DUCT
EF	EXHAUST FAN	SD	SMOKE DAMPER	---	---	---	LAY-IN DIFFUSER
EG	EXHAUST GRILLE	SFM	SIGHT FLOW MONITOR	---	---	---	SUPPLY AIR DUCT
ER	EXHAUST REGISTER	SG	SUPPLY GRILLE	---	---	---	RETURN / RELIEF AIR DUCT
ERV	ENERGY RECOVERY VENTILATOR	SP	STATIC PRESSURE	---	---	---	
ESP	EXTERNAL STATIC PRESSURE	SR	SUPPLY REGISTER	---	---	---	
EWB	ENTERING WET BULB	SV	SAFETY VALVE	---	---	---	
EWT	ENTERING WATER TEMPERATURE	T	THERMOMETER	---	---	---	
FC	FLEXIBLE CONNECTOR	TC	TEMPERATURE CONTROL PANEL	---	---	---	
FCV	FLOW CONTROL VALVE	TCG	TRANSFER CEILING GRILLE	---	---	---	
FD	FIRE DAMPER	TG	TRANSFER GRILLE	---	---	---	
FP	FINNED PIPE	TSP	TOTAL STATIC PRESSURE	---	---	---	
FS	FLOW SENSOR	T'STAT	THERMOSTAT	---	---	---	
FMS	FLOW MEASURING STATION	TV	TURNING VANE	---	---	---	
FV	FACE VELOCITY	UC	UNDERCUT	---	---	---	
GPH	GALLONS PER HOUR	UH	UNIT HEATER	---	---	---	
GPM	GALLONS PER MINUTE	UIC	UP IN CHASE	---	---	---	
HC	HEATING CONTRACTOR	V	VENT	---	---	---	
HWR	HOT WATER RETURN	VI	VIBRATION ISOLATOR	---	---	---	
HWS	HOT WATER SUPPLY	VRV	VARIABLE REFRIGERANT VOLUME	---	---	---	
H&V	HEATING & VENTILATING	WPD	WATER PRESSURE DROP	---	---	---	
		WTD	WATER TEMPERATURE DROP	---	---	---	

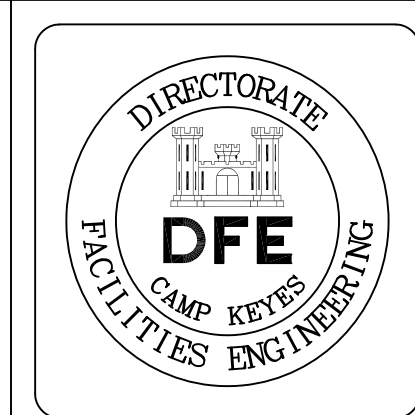

PLAN REVISIONS	Date	Appr.
1	1.28.19	

DESIGNED BY: REM
 DRAWN BY: REM
 CHECKED BY: KFM/MAD
 DATE: 12/28/2018
 SCALE: NONE
 DFE PROJECT NO: 235R18-458-D


STATE OF MAINE
 DEPARTMENT OF DEFENSE, VETERANS
 AND EMERGENCY MANAGEMENT

Cordja Capital Projects Group
 16 Tannery Lane, Suite 23
 Camden, Maine 04843
 207-236-9970 / mdsigle@cordjagroup.com

CAMP KEYES REUTILIZATION PROJECT
 CAMP KEYES, AUGUSTA, MAINE
 BUILDING NO. 7 RENOVATIONS
 MECHANICAL
 SYMBOLS AND ABBREVIATIONS



PLAN PROGRESS
<input type="checkbox"/> DRAFT
<input type="checkbox"/> 35% REVIEW
<input type="checkbox"/> 65% REVIEW
<input type="checkbox"/> 95% REVIEW
<input type="checkbox"/> FINAL REVIEW
<input checked="" type="checkbox"/> FOR BIDDING
<input type="checkbox"/> ISSUED FOR CONSTRUCTION
<input type="checkbox"/> RECORD DRAWINGS

SHEET ID:
M-001
 SHEET: 79 of 126

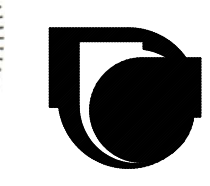


MECHANICAL SYSTEMS ENGINEERS
 ROYAL RIVER CENTER, UNIT 108
 10 FOREST FALLS DRIVE, YARMOUTH, MAINE 04096
 (207) 846-1441
 FACEBOOK: MECHANICAL SYSTEMS ENGINEERS
 CELEBRATING 50 YEARS IN BUSINESS
 © COPYRIGHT 2018



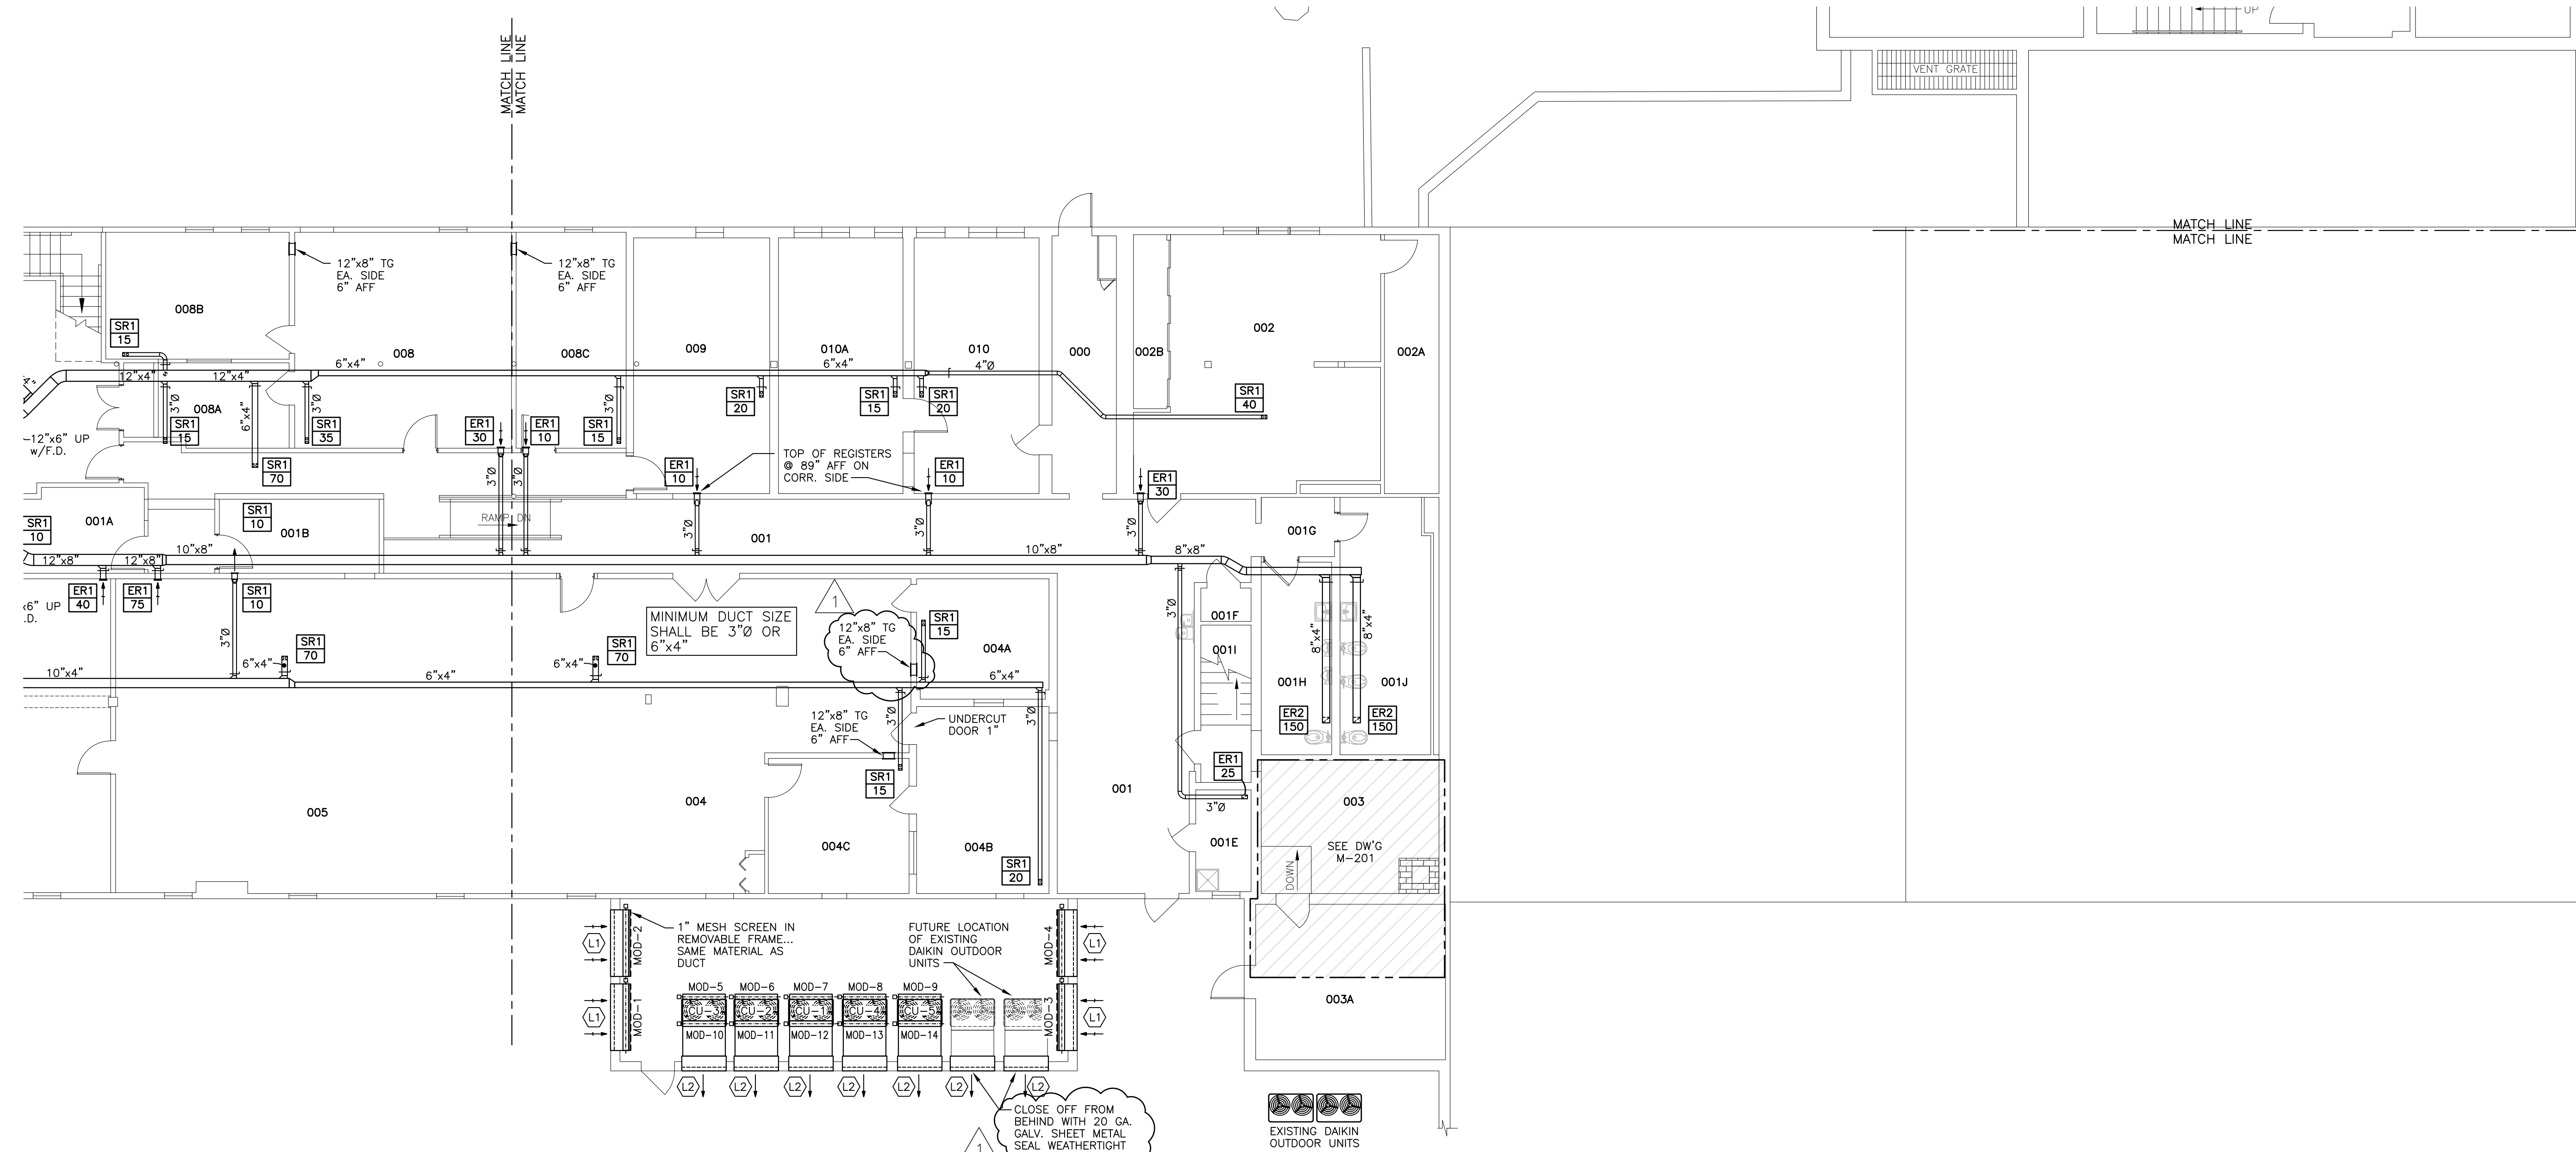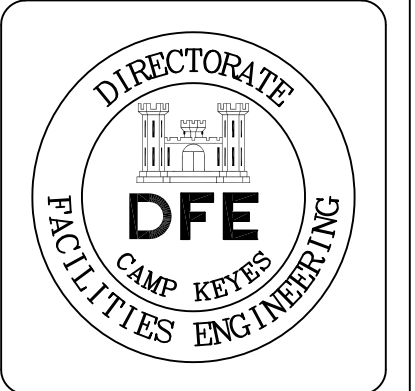

1 MECHANICAL DUCTWORK PLAN
LOWER LEVEL-NORTH END
SCALE: 1/8" = 1'-0"

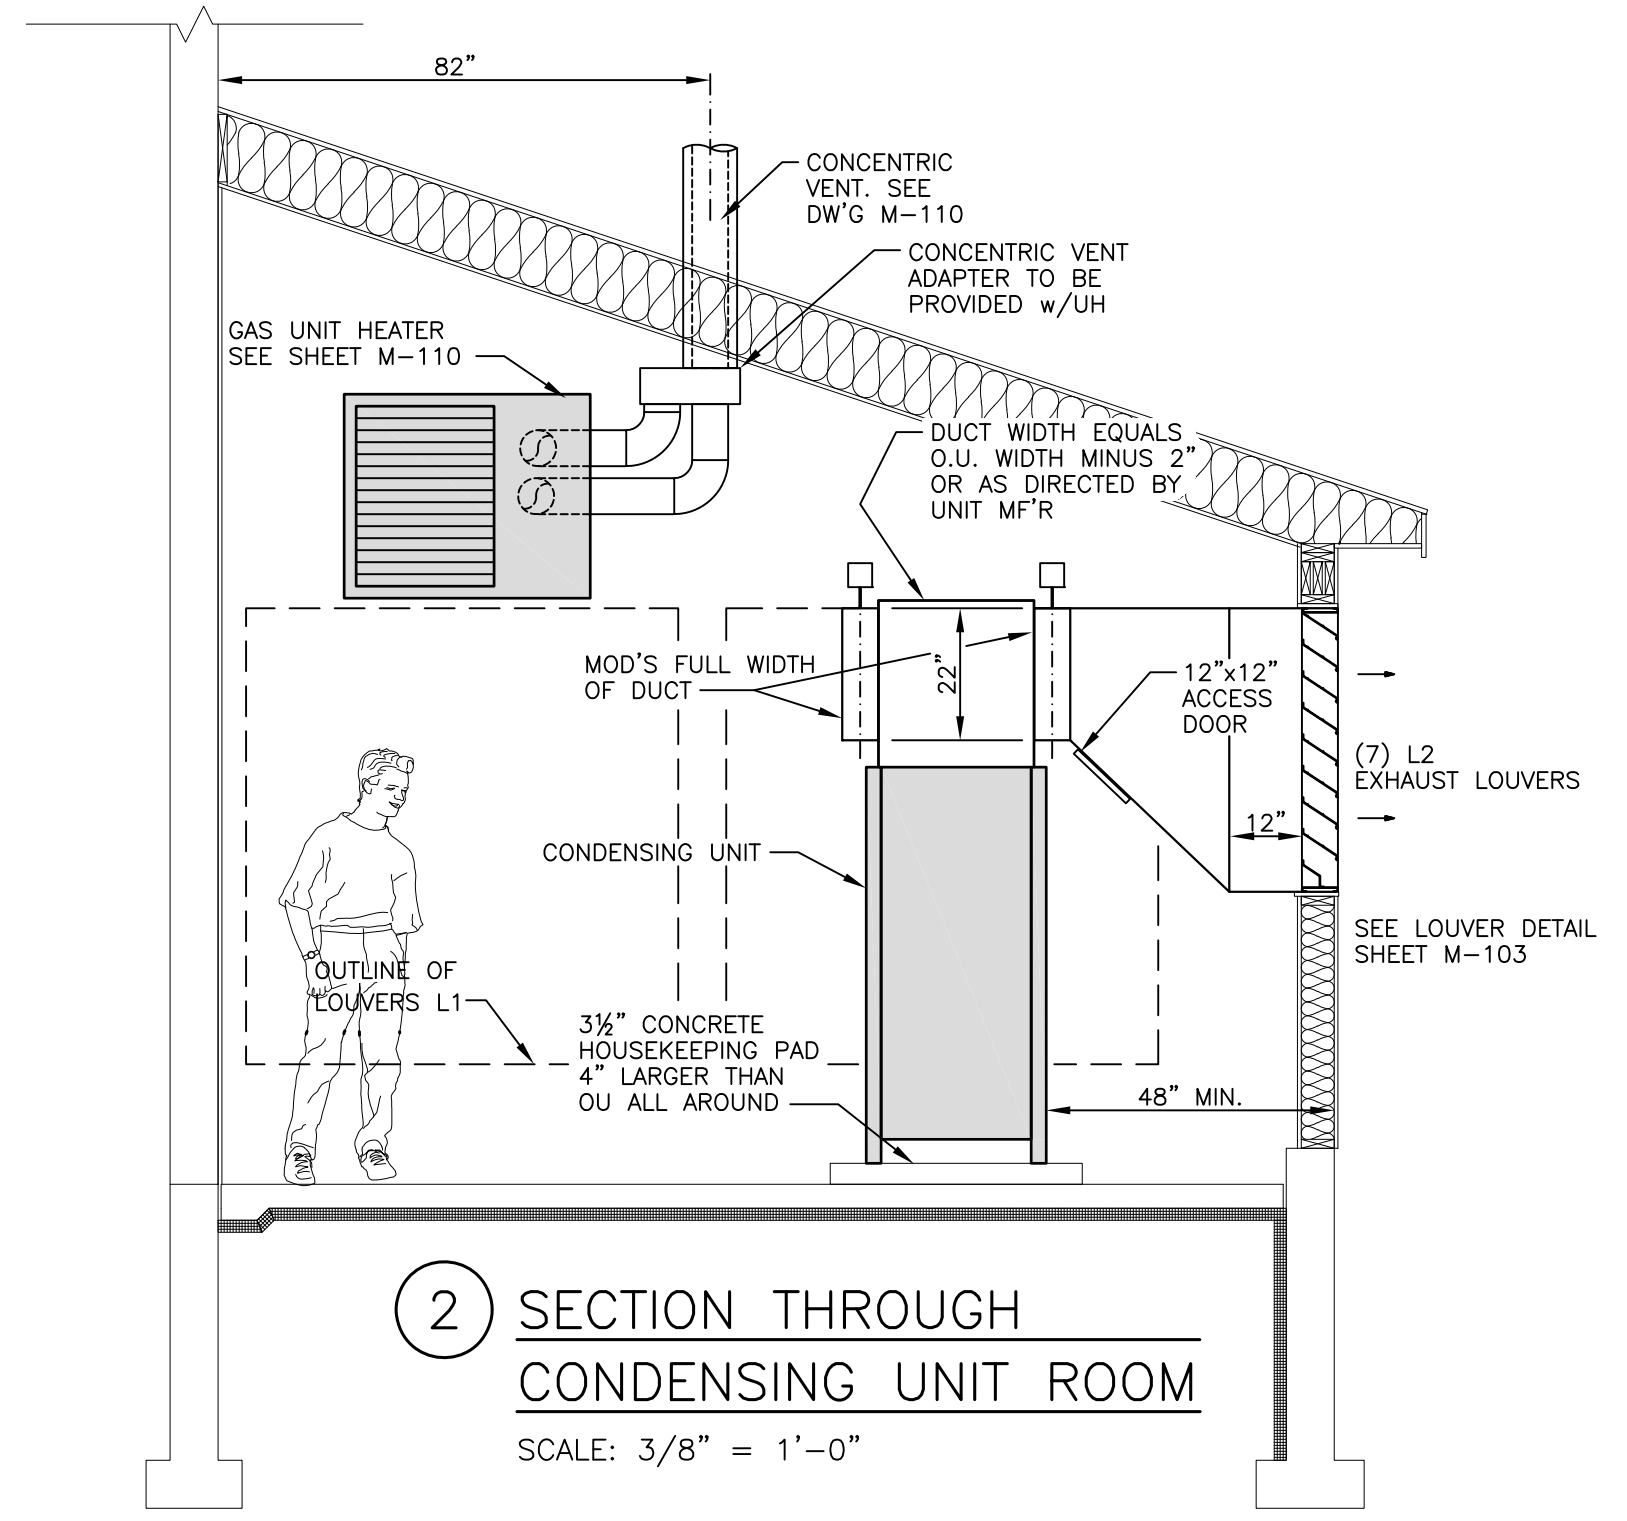

2 SECTION THROUGH
CONDENSING UNIT ROOM
SCALE: 3/8" = 1'-0"

Rev#	Description	Date	Appr.
1	REVISIONS	1.28.19	

DESIGNED BY: REM
 DRAWN BY: REM
 CHECKED BY: KFM/MAD
 DATE: 12/28/2018
 SCALE: 1/8" = 1'-0"
 DFE PROJECT NO: 235R18-458-D





STATE OF MAINE
 DEPARTMENT OF DEFENSE, VETERANS
 AND EMERGENCY MANAGEMENT
 Cordja Capital Projects Group
 16 Tannery Lane, Suite 23
 Camden, Maine 04843
 207-236-9970 / mdsjle@cdjcapg.com

CAMP KEYES REUTILIZATION PROJECT
 CAMP KEYES, AUGUSTA, MAINE
 BUILDING NO. 7 RENOVATIONS
 MECHANICAL DUCTWORK PLAN
 LOWER LEVEL-NORTH END

PLAN PROGRESS	
<input type="checkbox"/>	DRAFT
<input type="checkbox"/>	35% REVIEW
<input type="checkbox"/>	65% REVIEW
<input type="checkbox"/>	95% REVIEW
<input type="checkbox"/>	FINAL REVIEW
<input checked="" type="checkbox"/>	FOR BIDDING
<input type="checkbox"/>	ISSUED FOR CONSTRUCTION
<input type="checkbox"/>	RECORD DRAWINGS



SHEET ID:
 M-102
 SHEET: 81 of 126

January 28, 2019 - 7:23 am
 X:\Projects\1813 Camp Keyes Bldg 7\M101-N106 (01-24-2019).dwg

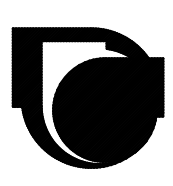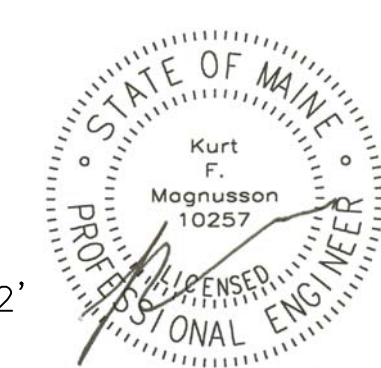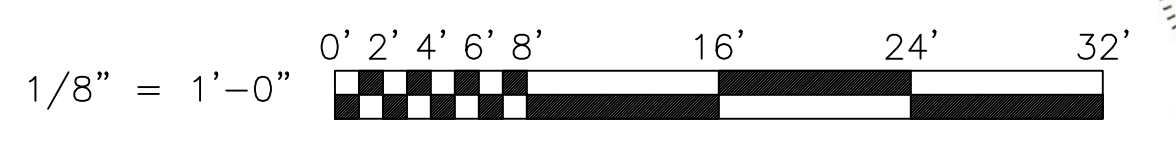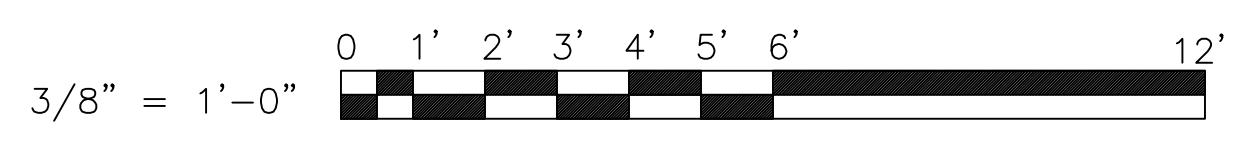

MECHANICAL SYSTEMS ENGINEERS
 ROYAL RIVER CENTER, UNIT 108
 10 FOREST FALLS DRIVE, YARMOUTH, MAINE 04096
 (207) 846-1441
 FACEBOOK: MECHANICAL SYSTEMS ENGINEERS
 CELEBRATING 50 YEARS IN BUSINESS
 © COPYRIGHT 2018



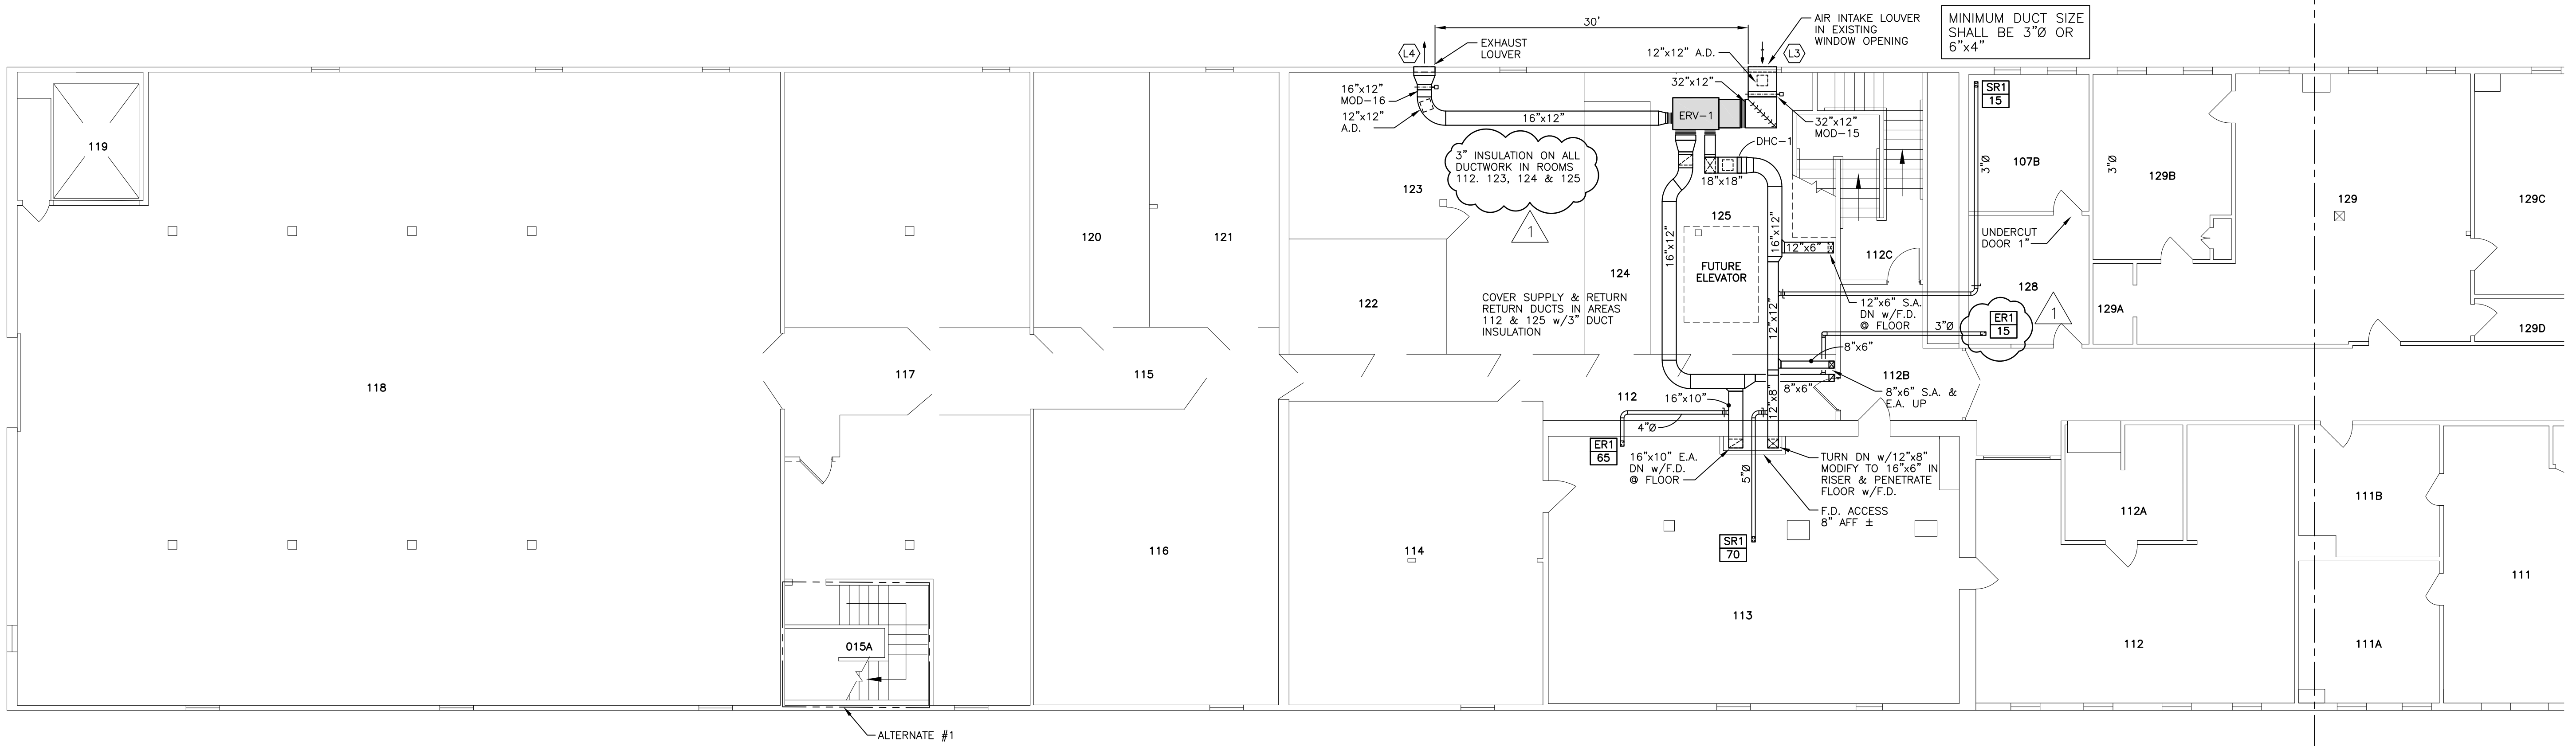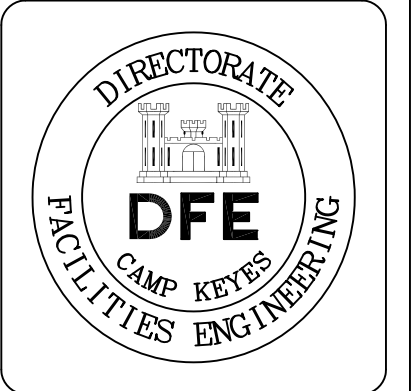

1 MECHANICAL DUCTWORK PLAN
FIRST FLOOR-SOUTH END
SCALE: 1/8" = 1'-0"

Rev#	Description	Date	Appr.
1	GENERAL REVISIONS		
1.28.19			


DESIGNED BY: REM
 DRAWN BY: REM
 CHECKED BY: KFM/MAD
 DATE: 12/28/2018
 SCALE: AS NOTED
 DFE PROJECT NO: 235R18-458-D

STATE OF MAINE
 DEPARTMENT OF DEFENSE, VETERANS
 AND EMERGENCY MANAGEMENT
 Cordja Capital Projects Group
 16 Tannery Lane, Suite 23
 Camden, Maine 04843
 207-236-9970 / mdsigle@cordjagroup.com


CAMP KEYES REUTILIZATION PROJECT
 CAMP KEYES, AUGUSTA, MAINE
 BUILDING NO. 7 RENOVATIONS
 MECHANICAL DUCTWORK PLAN
 FIRST FLOOR - SOUTH END

PLAN PROGRESS	
<input type="checkbox"/>	DRAFT
<input type="checkbox"/>	35% REVIEW
<input type="checkbox"/>	65% REVIEW
<input type="checkbox"/>	95% REVIEW
<input type="checkbox"/>	FINAL REVIEW
<input checked="" type="checkbox"/>	FOR BIDDING
<input type="checkbox"/>	ISSUED FOR CONSTRUCTION
<input type="checkbox"/>	RECORD DRAWINGS


SHEET ID:
 M-103
 SHEET: 82 OF 126

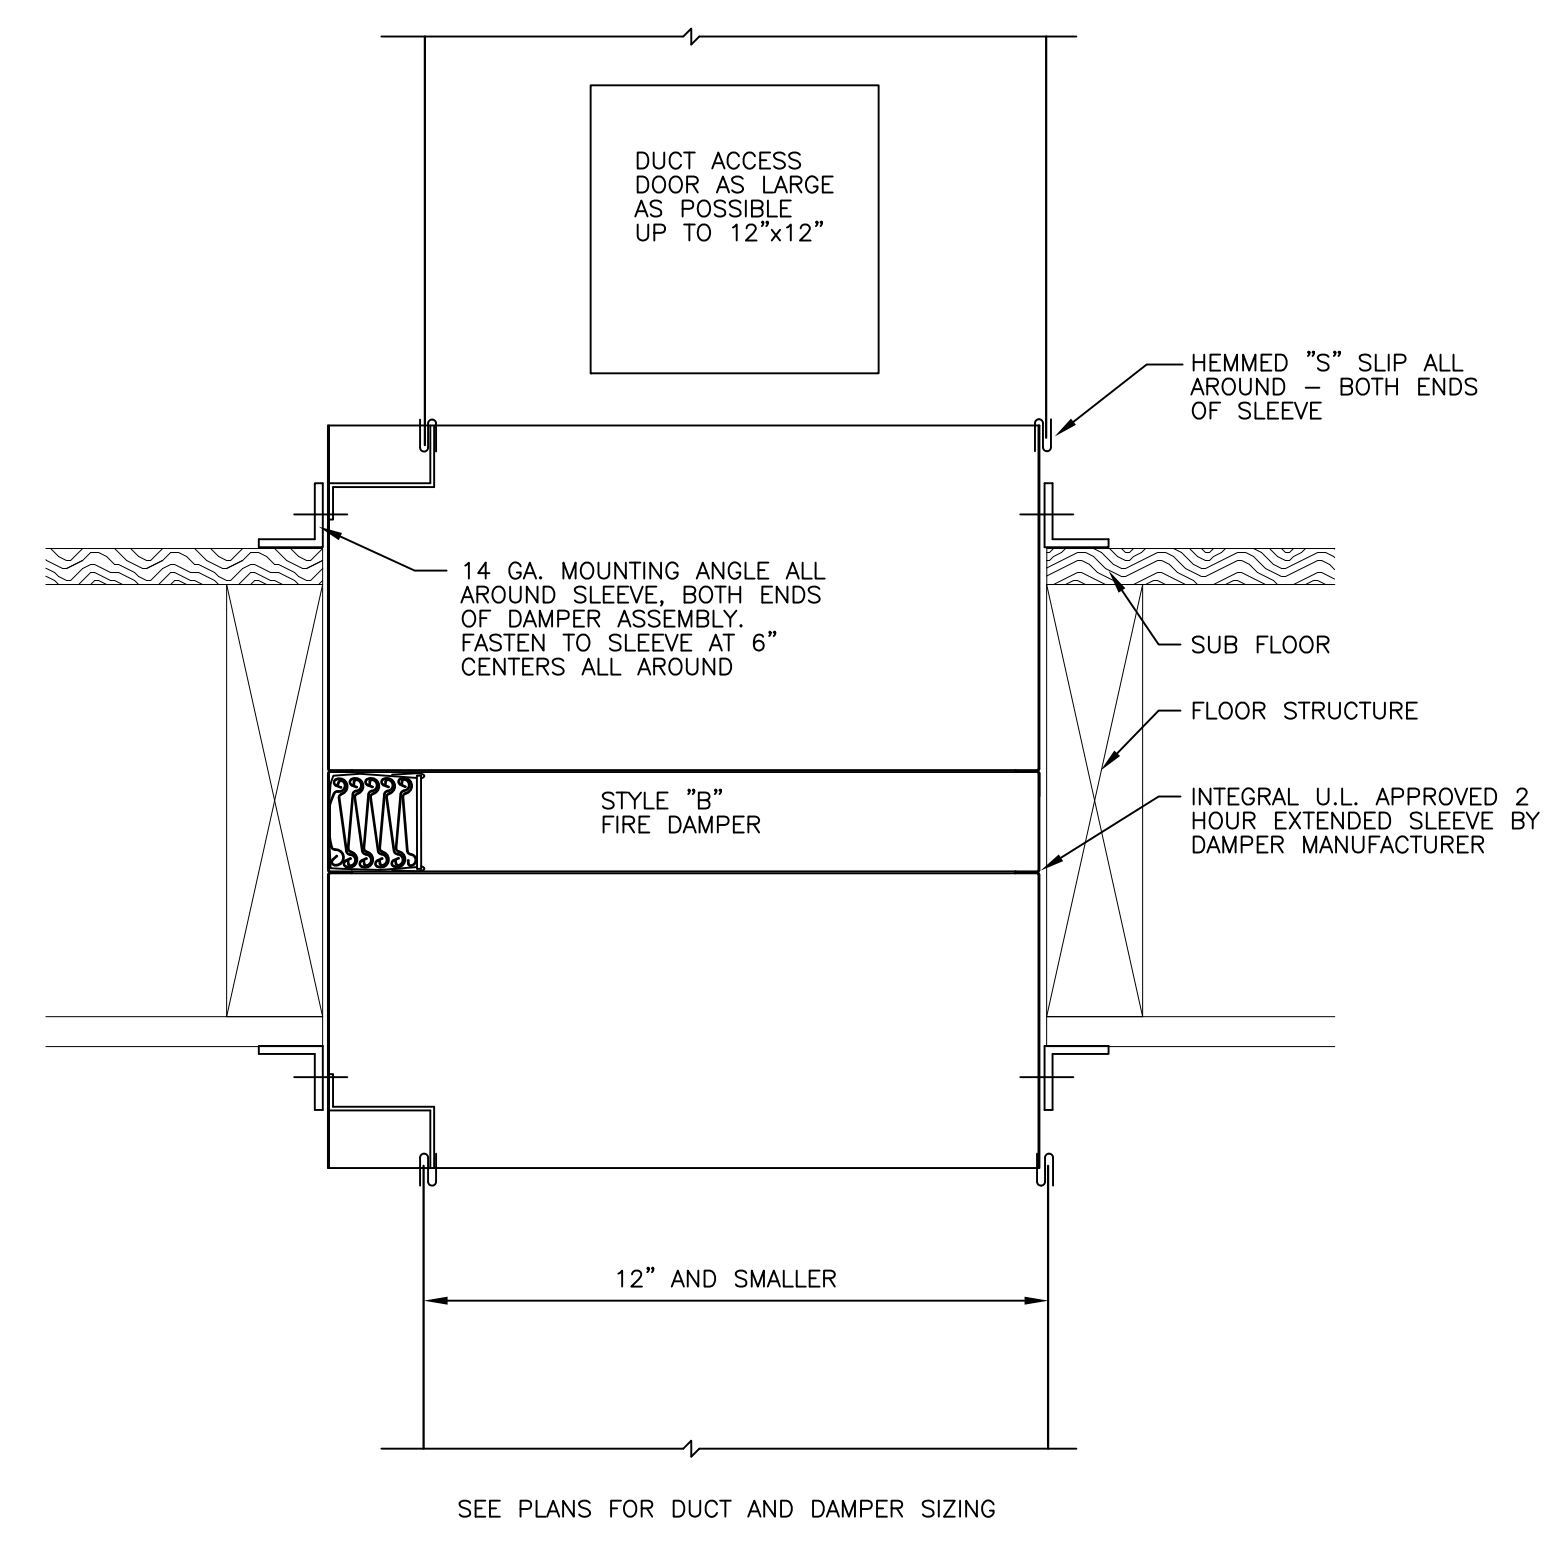


2 FLOOR FIRE DAMPER STYLE "B"
NO SCALE

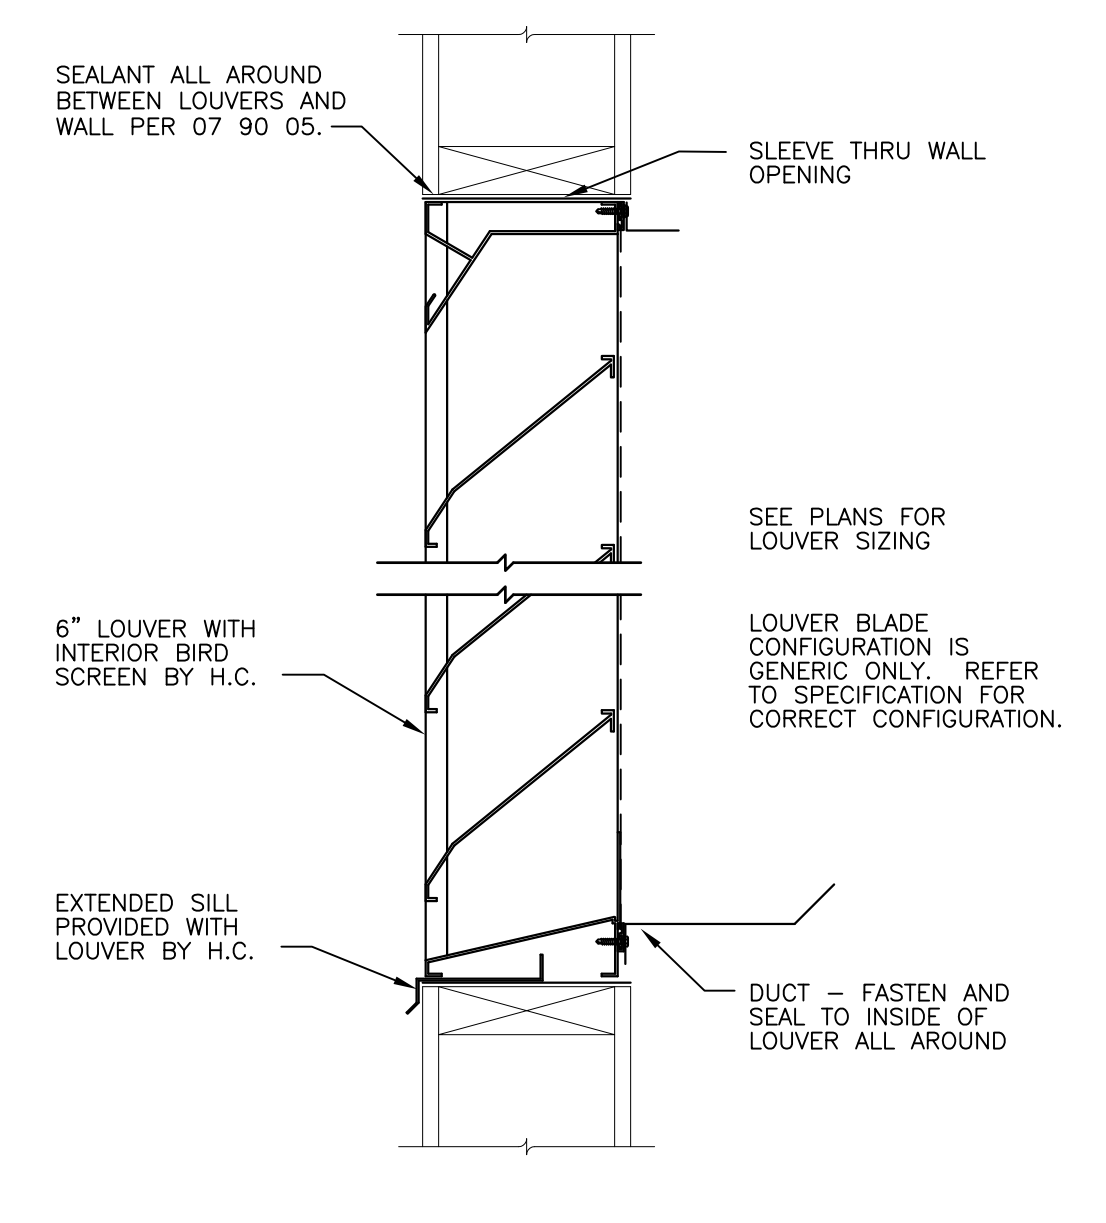


3 EXTERIOR LOUVER DETAIL
FOR FRAME WALLS
NO SCALE

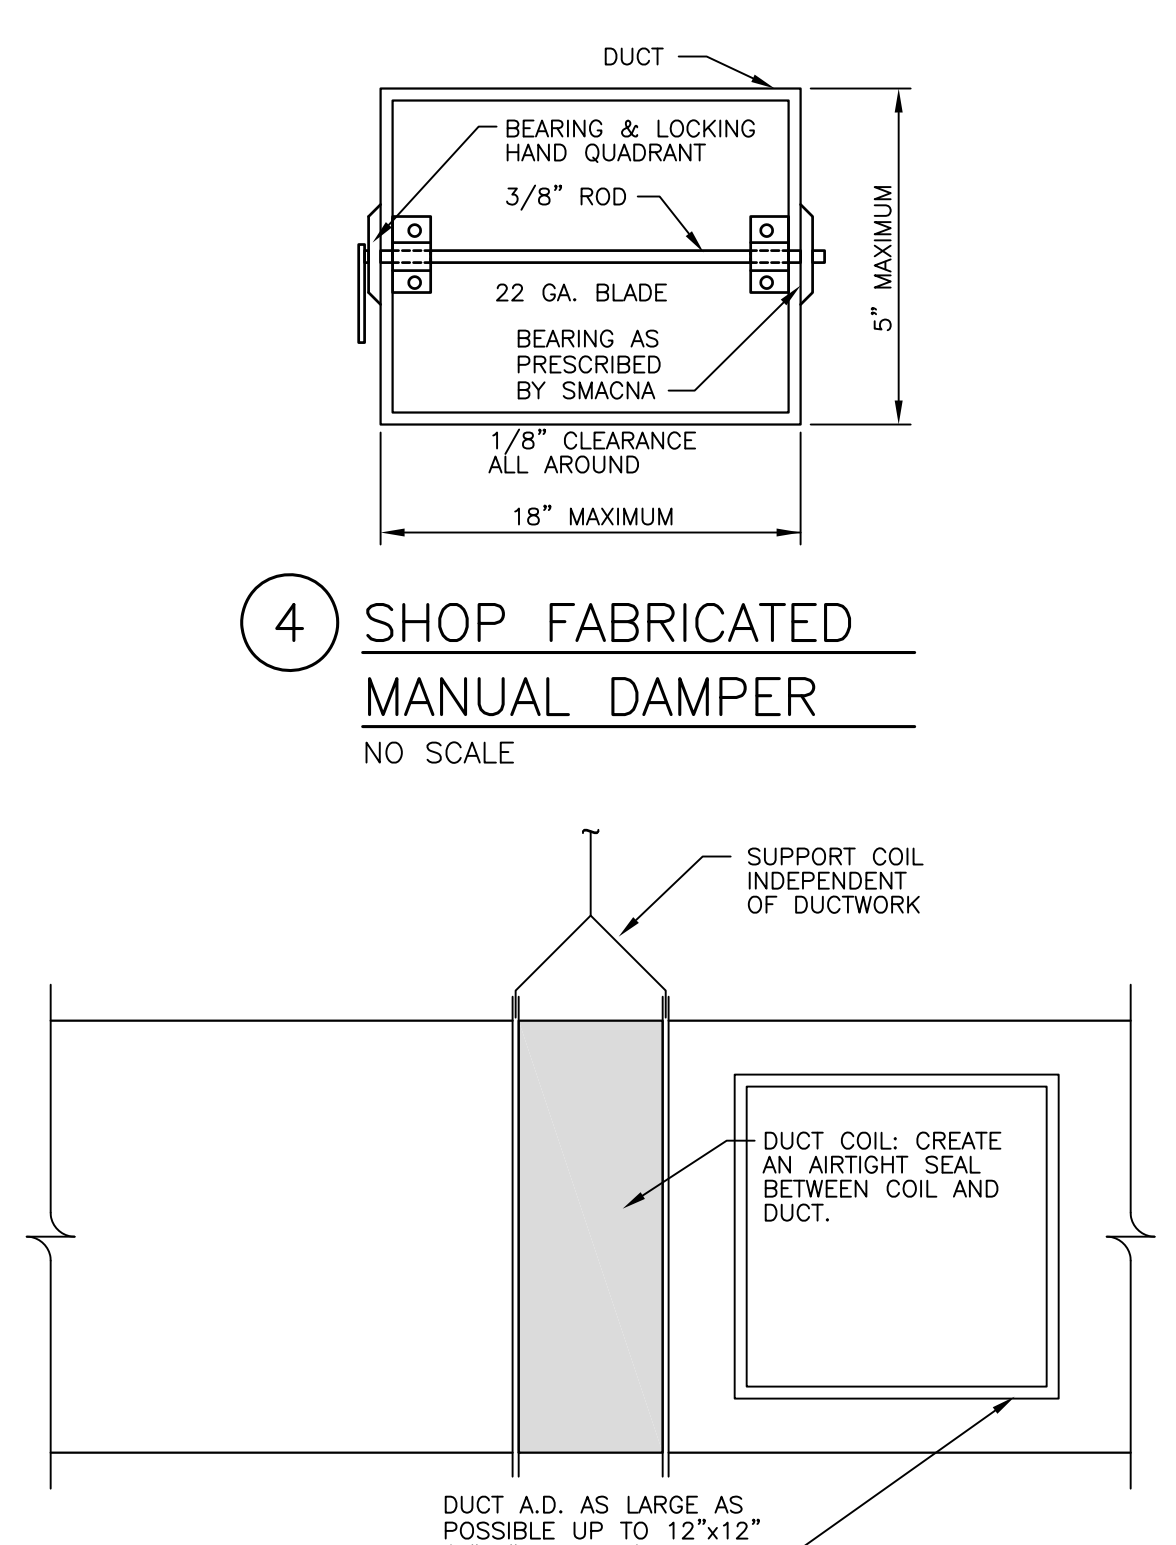



4 SHOP FABRICATED
MANUAL DAMPER
NO SCALE

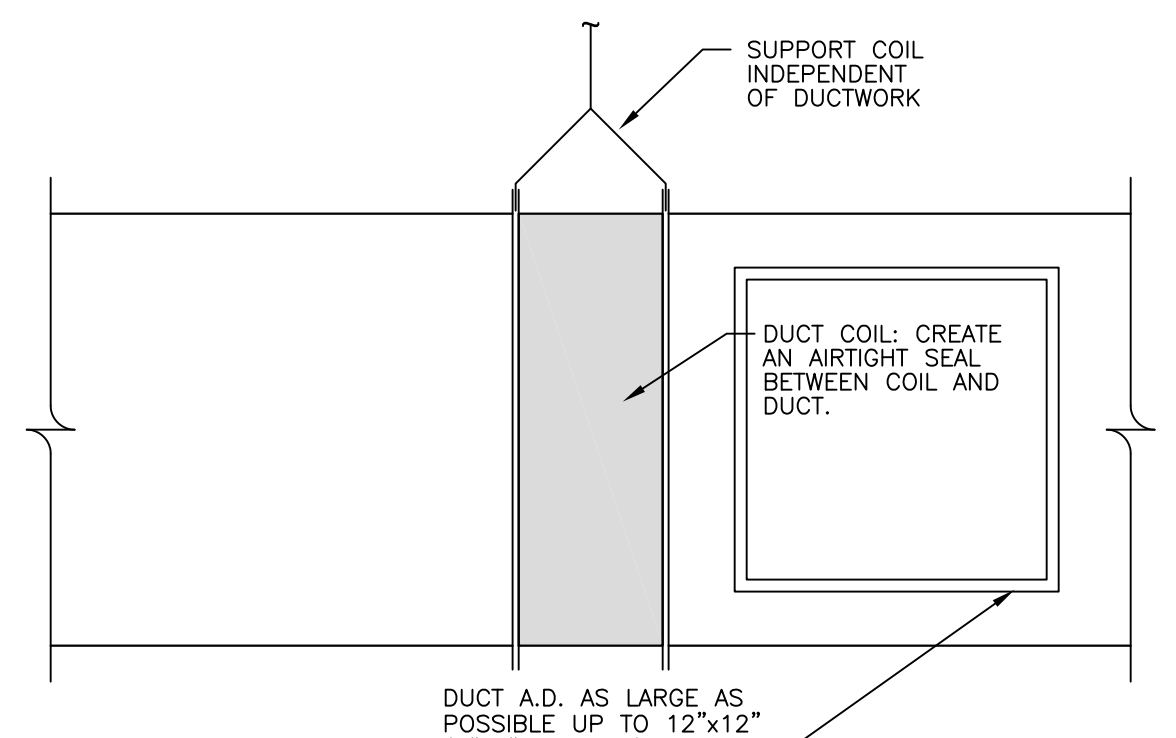

5 DUCT HEATING COIL MOUNTING
NO SCALE

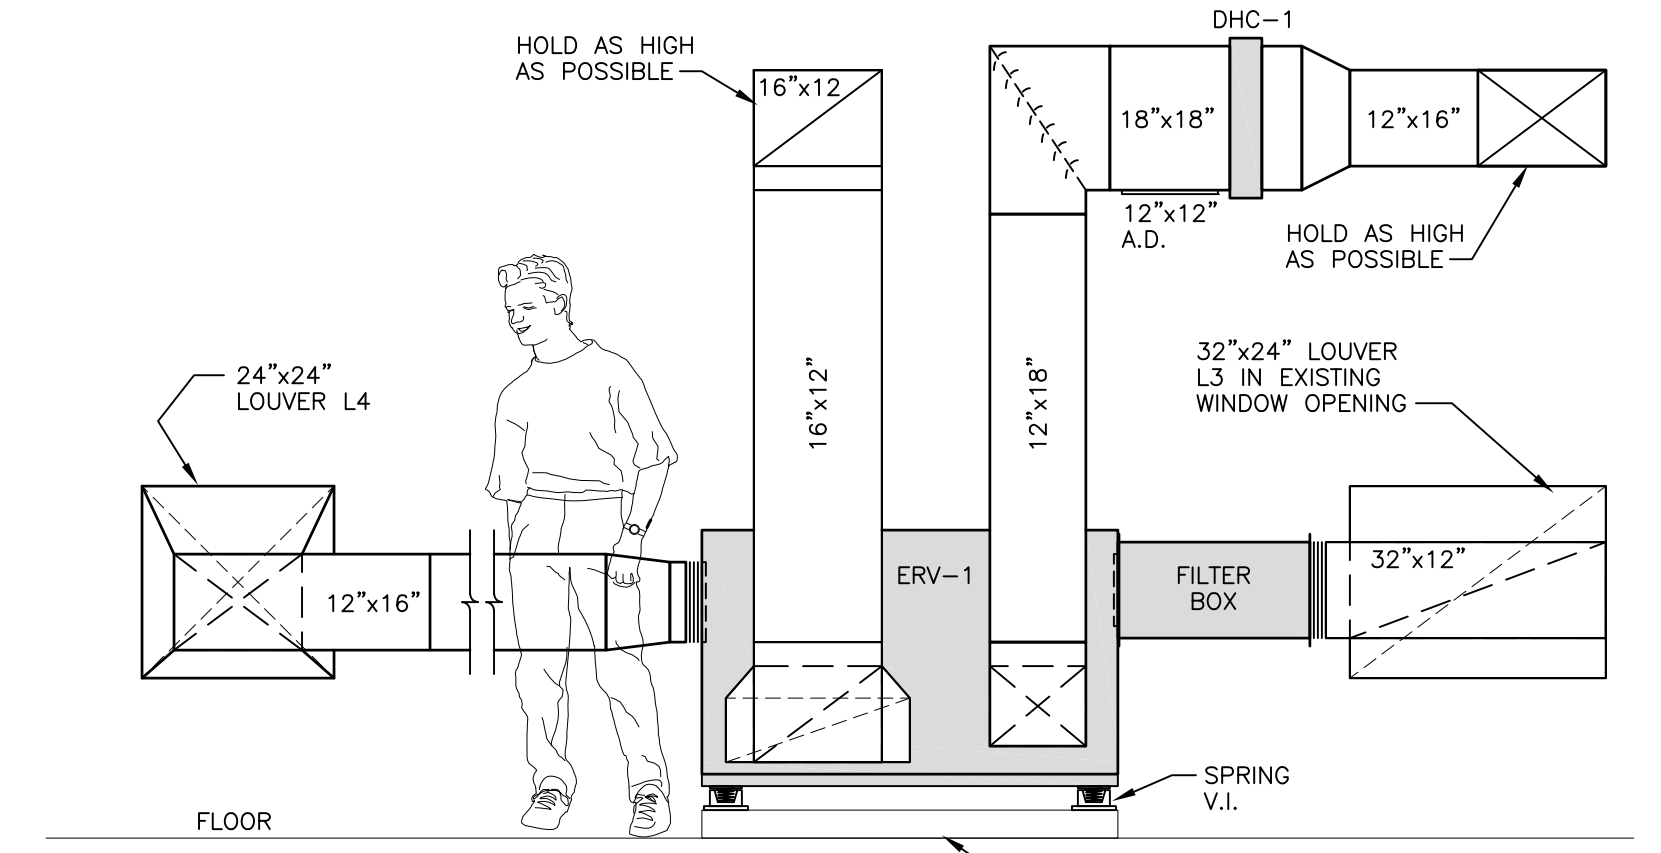



6 ELEVATION OF ERV-1
SCALE: 1/2" = 1'-0"

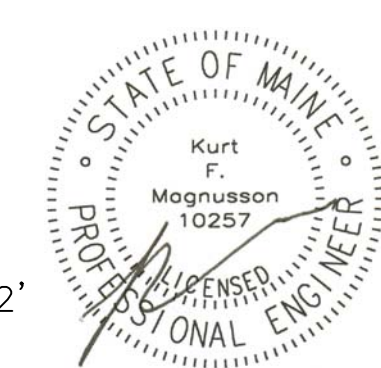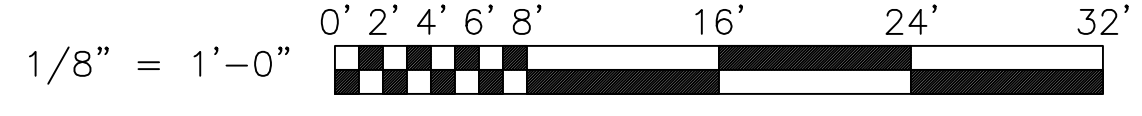


MECHANICAL SYSTEMS ENGINEERS
 ROYAL RIVER CENTER, UNIT 108
 10 FOREST FALLS DRIVE, YARMOUTH, MAINE 04096
 (207) 846-1441
 FACEBOOK: MECHANICAL SYSTEMS ENGINEERS
 CELEBRATING 50 YEARS IN BUSINESS
 © COPYRIGHT 2018




January 28, 2019 - 7:23 am
 X:\Projects\1813 Camp Keyes Bldg 7\M101-M106 (01-24-2019).dwg

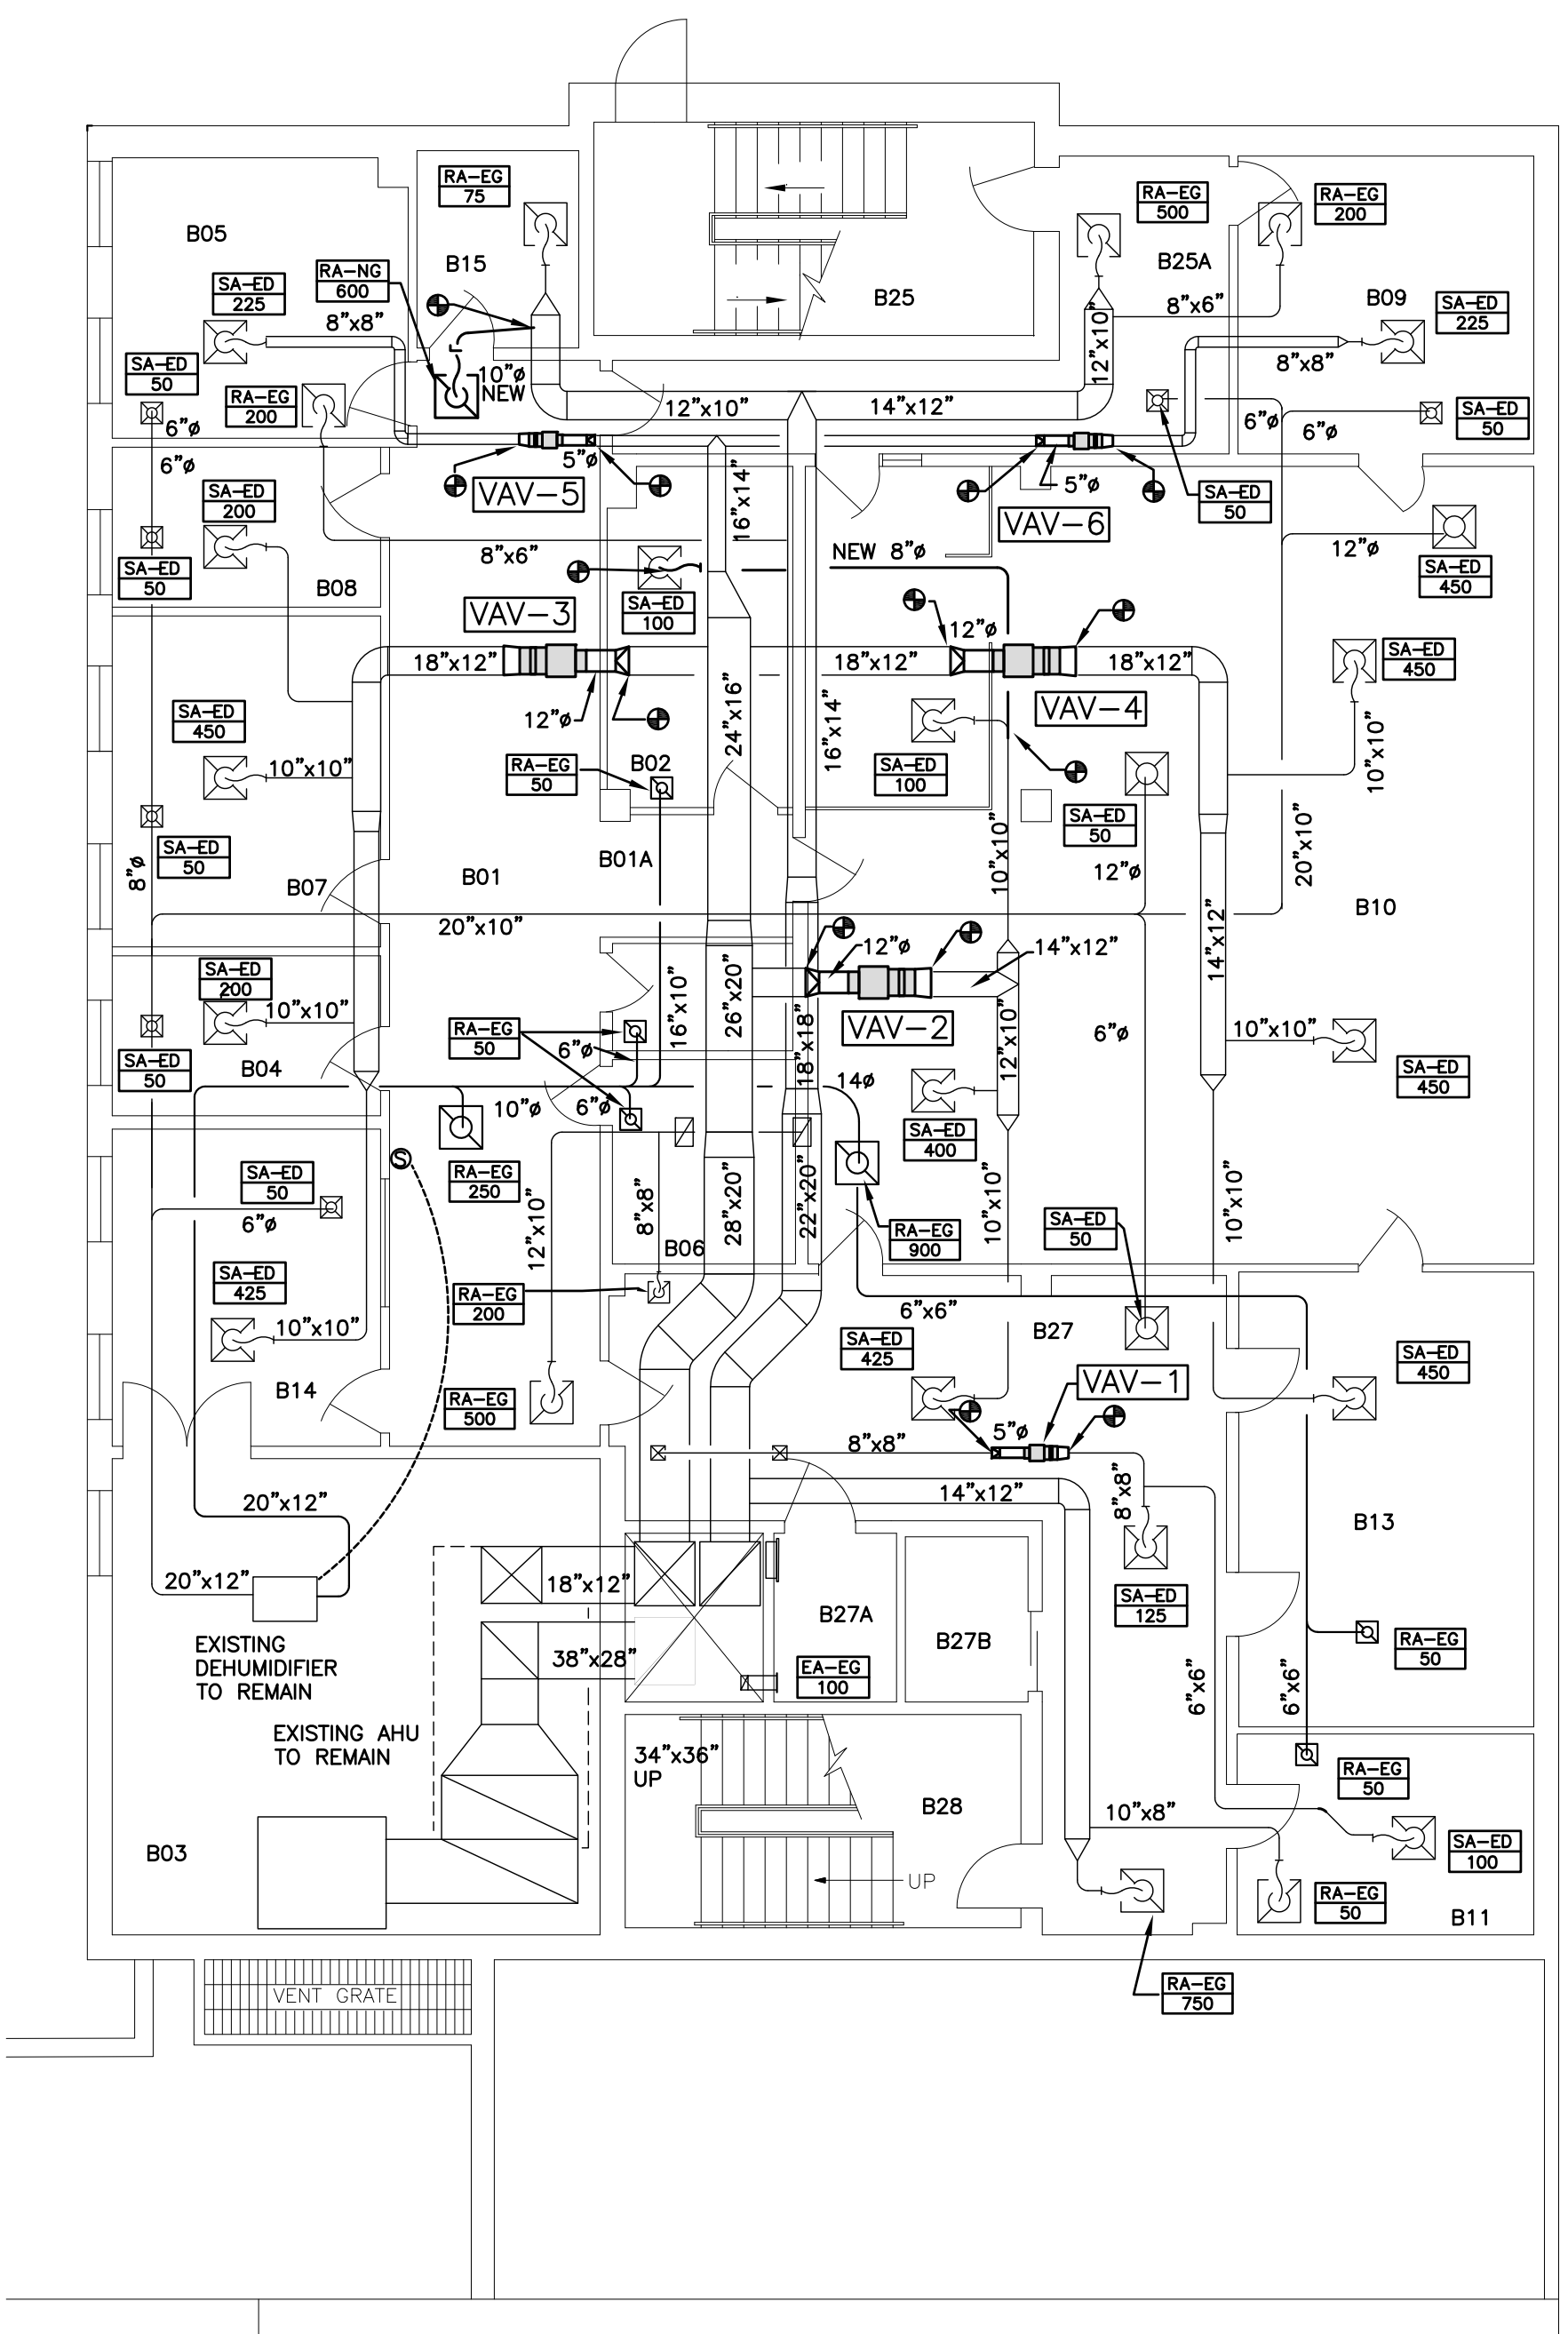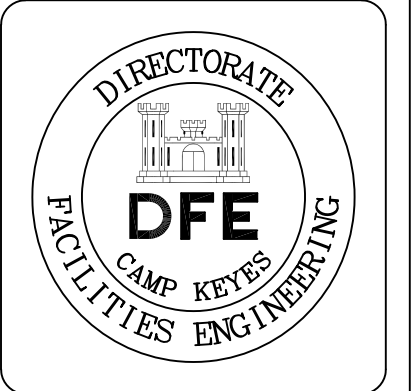


1 MECHANICAL DUCTWORK PLAN
LOWER LEVEL - NORTH WEST WING
SCALE: 1/8" = 1'-0"

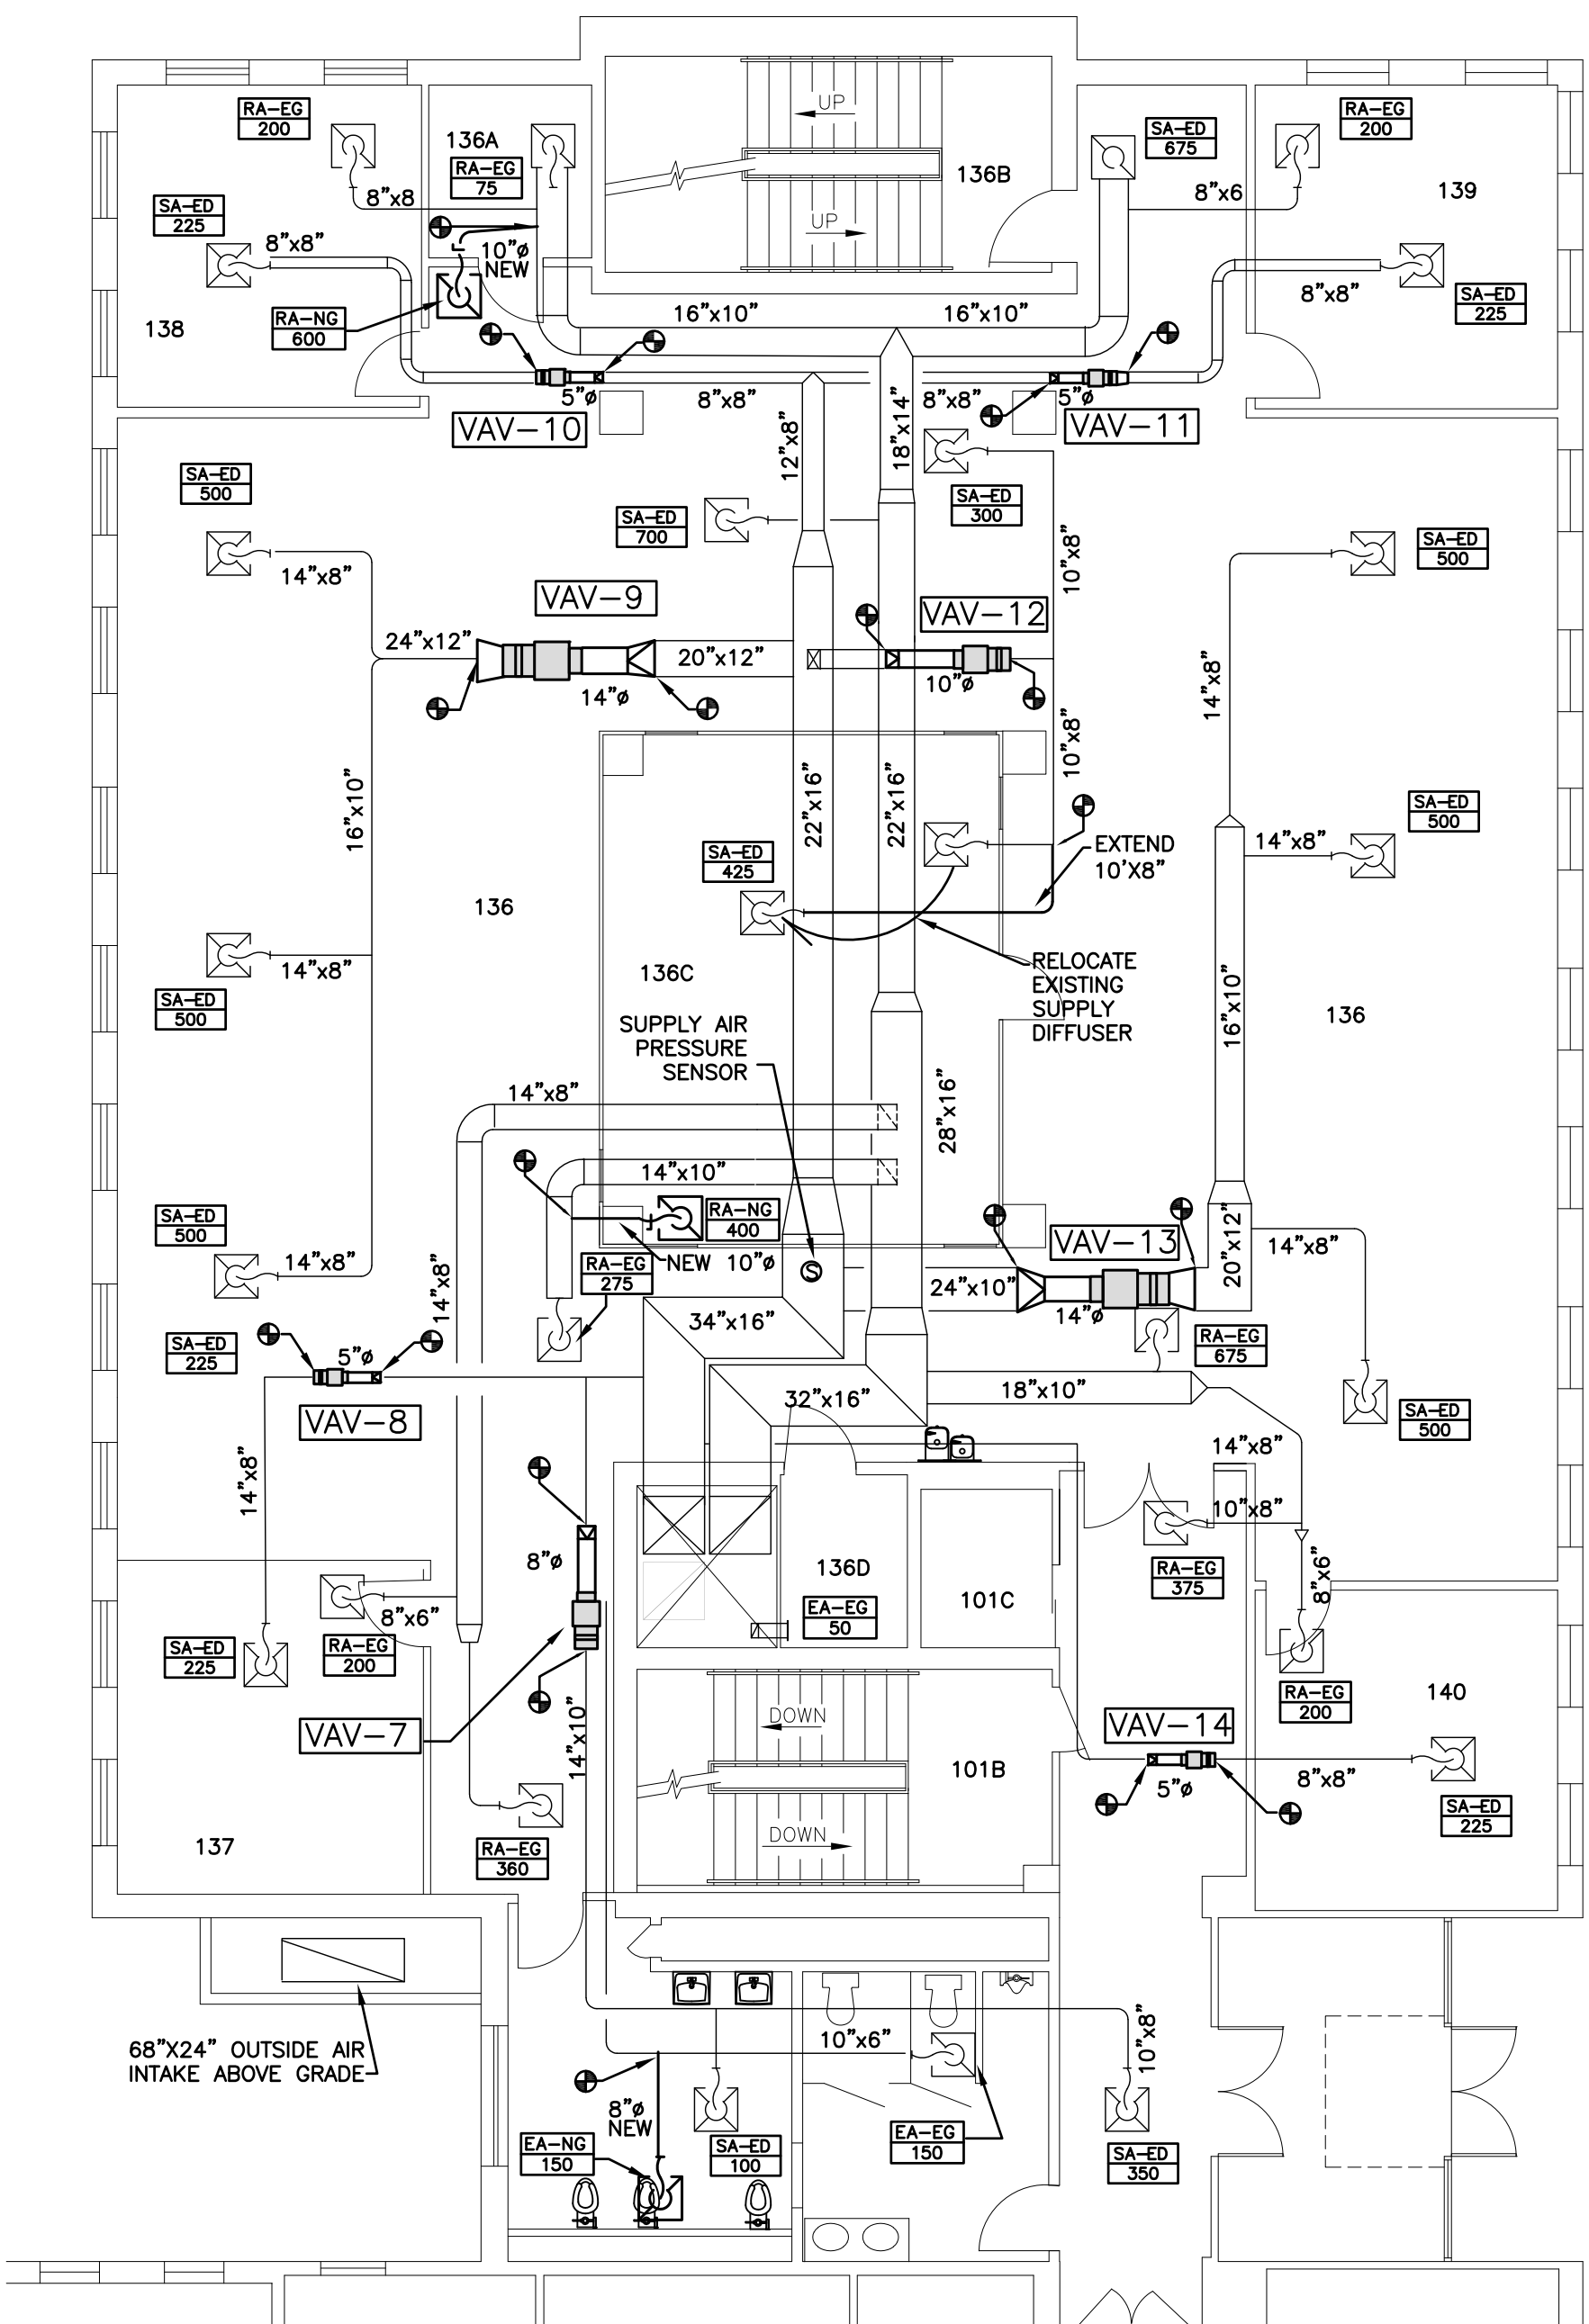


2 MECHANICAL DUCTWORK PLAN
FIRST FLOOR - NORTH WEST WING
SCALE: 1/8" = 1'-0"

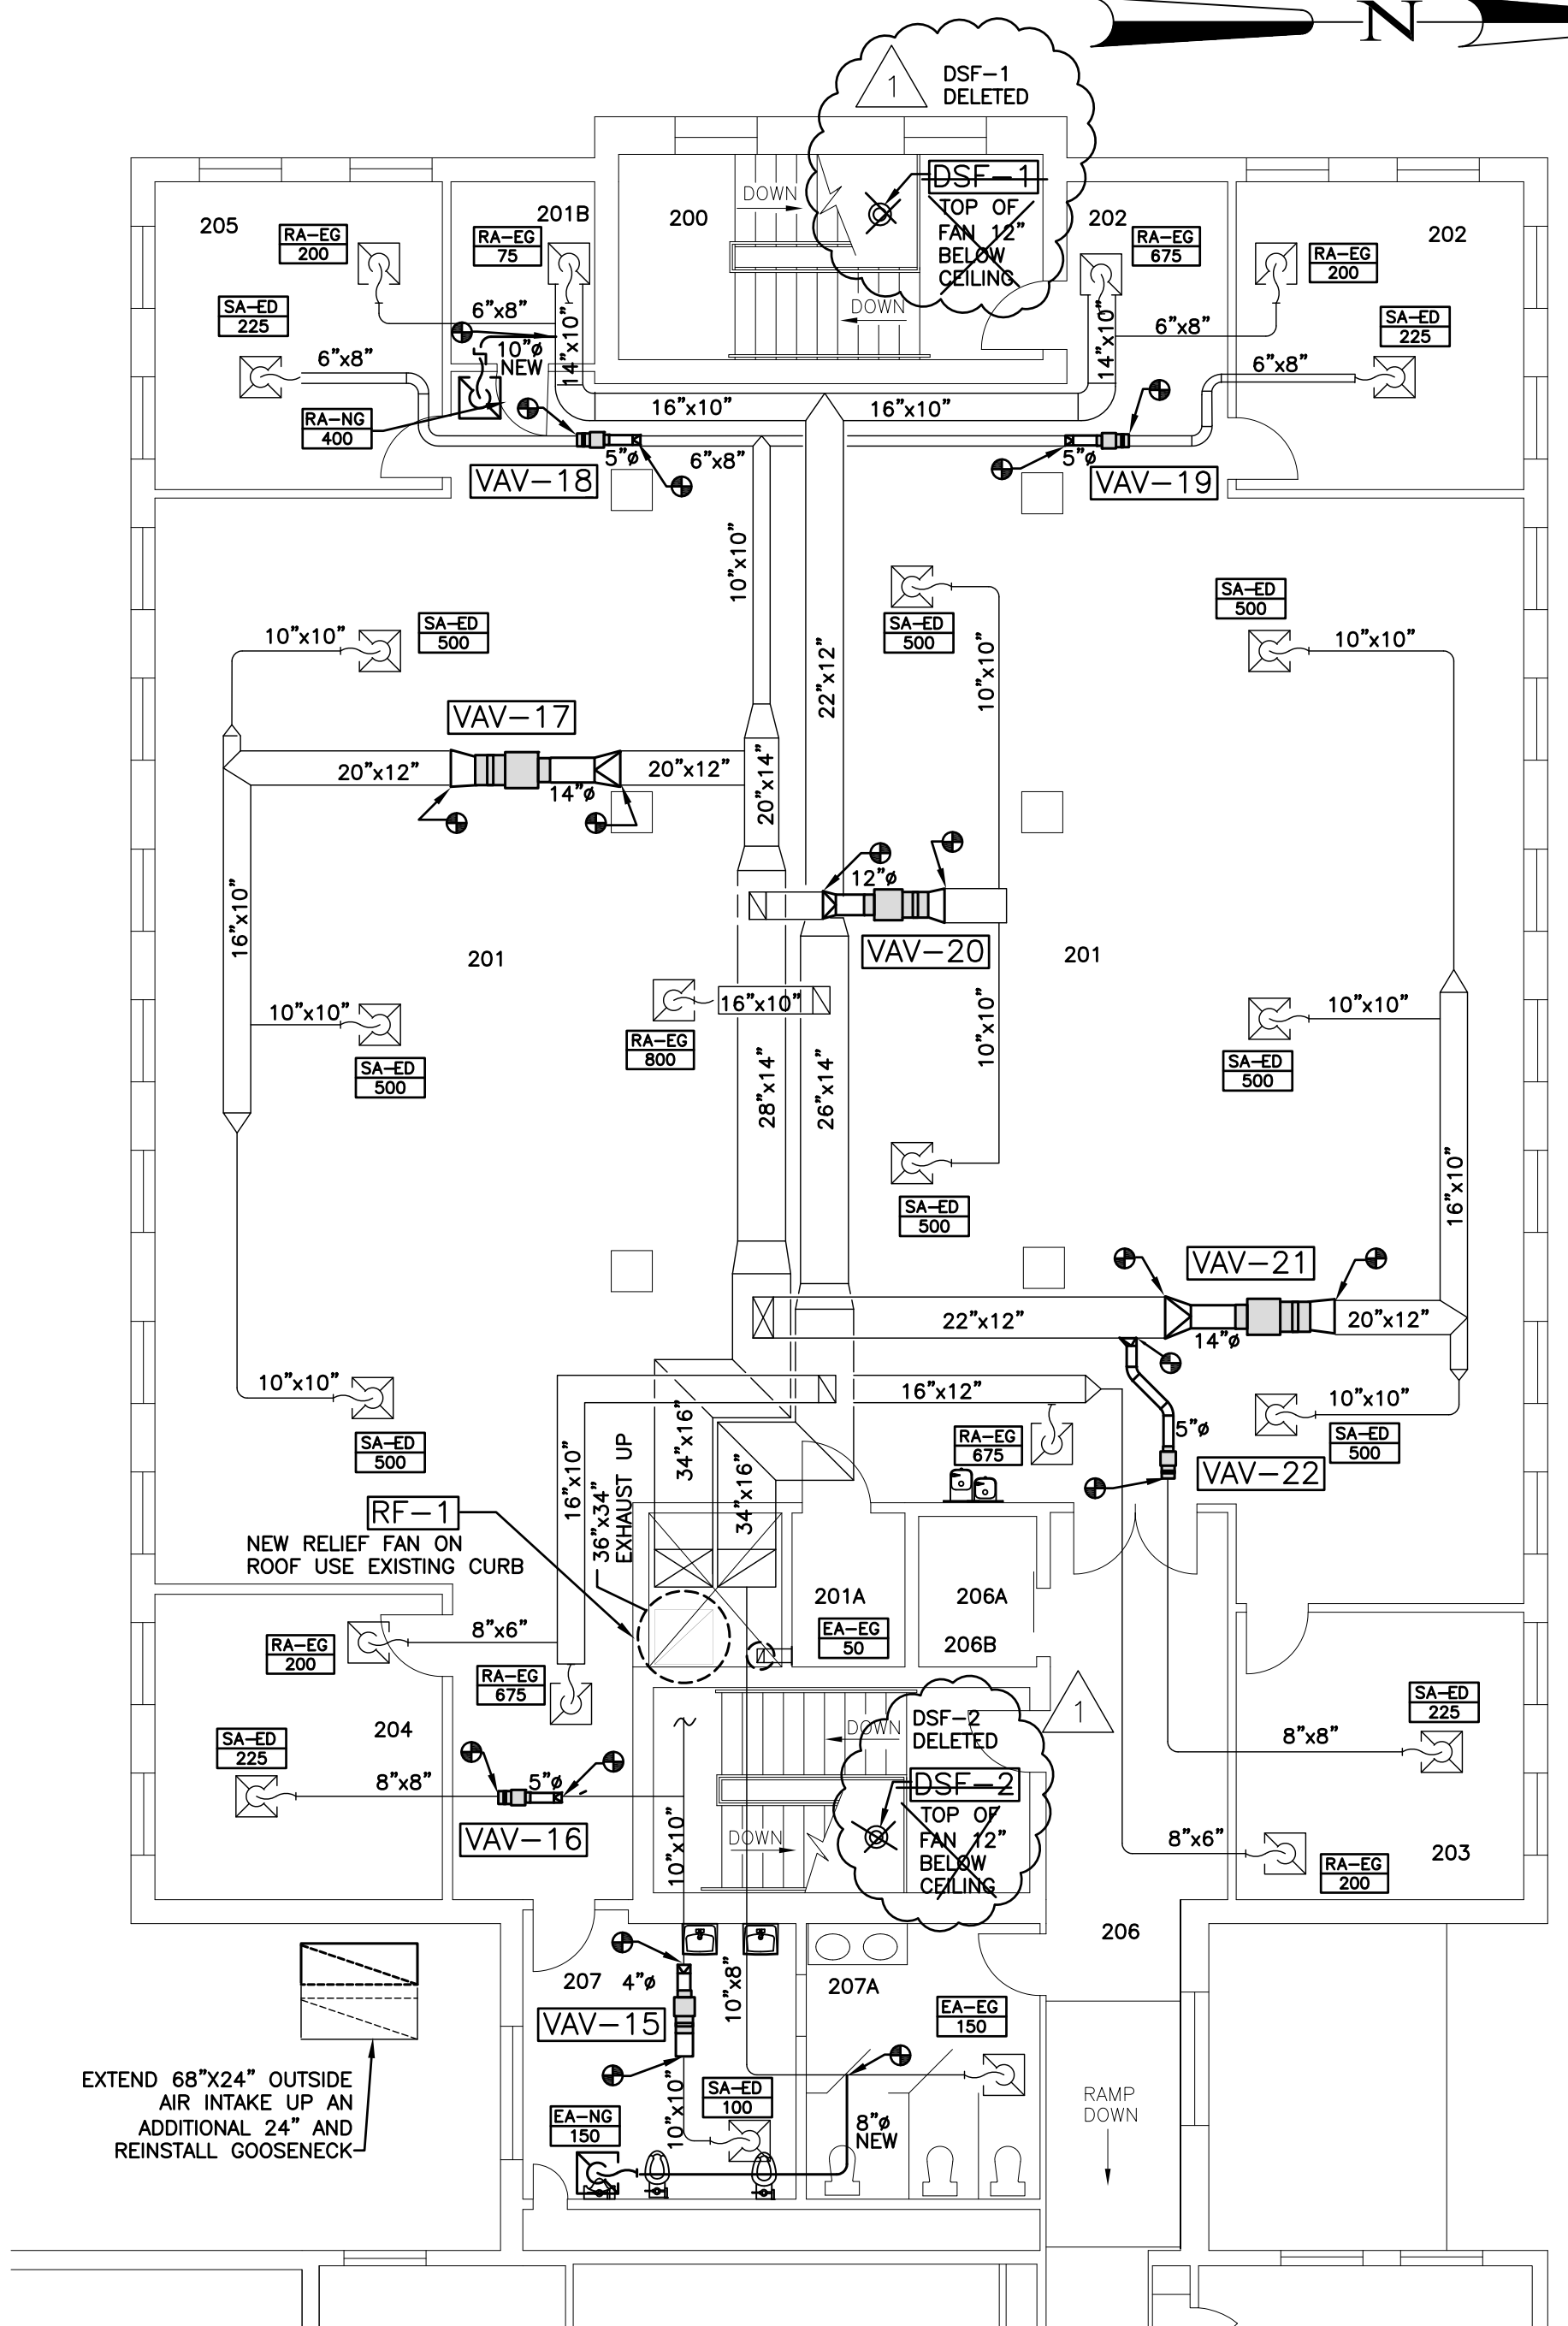


3 MECHANICAL DUCTWORK PLAN
SECOND FLOOR NORTH WEST WING
SCALE: 1/8" = 1'-0"

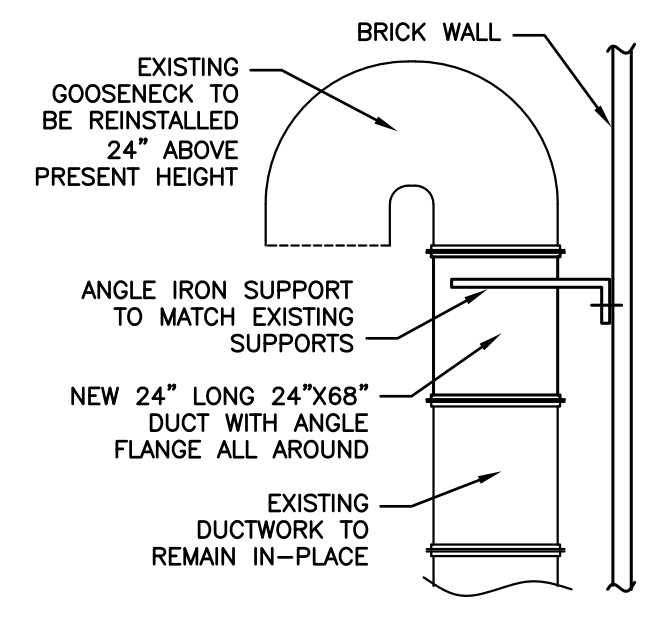

4 OUTSIDE AIR DUCT
ELEVATION VIEW
NO SCALE

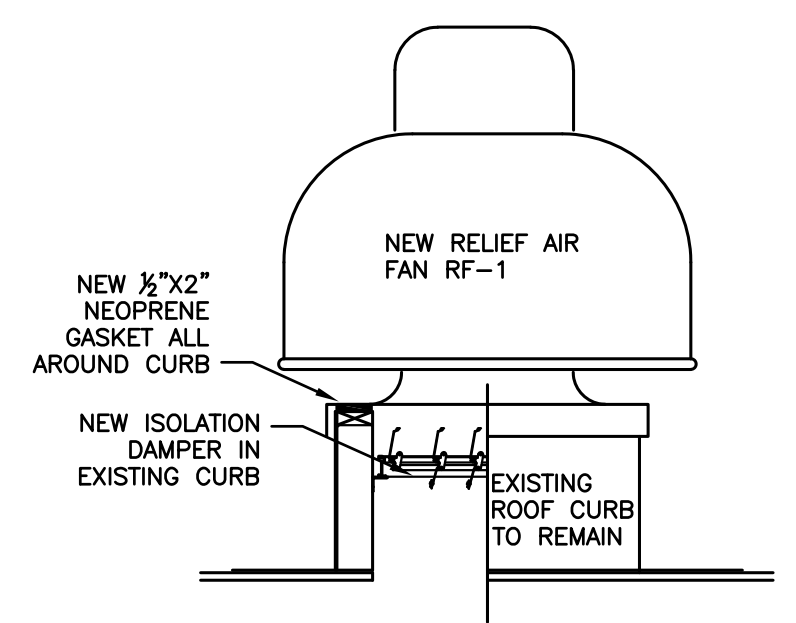

5 RELIEF FAN RF-1 DETAIL
NO SCALE

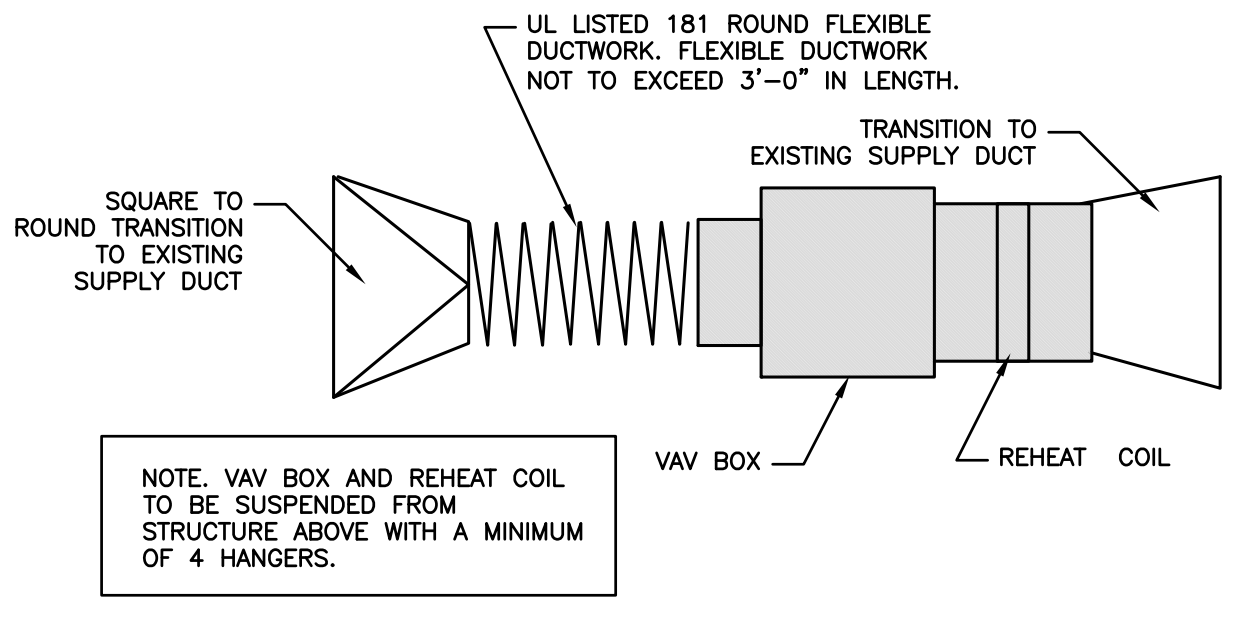


6 VAV BOX DETAIL
NO SCALE

SHEETMETAL LEGEND

	CONNECT TO EXISTING AT THIS LOCATION
	EXISTING CEILING-MOUNTED DIFFUSER WITH VOLUME DAMPER TO REMAIN IN-PLACE AND IN-USE
	EXISTING CEILING-MOUNTED RETURN OR EXHAUST GRILLE TO REMAIN IN-PLACE AND IN-USE
	NEW CEILING RETURN OR EXHAUST GRILLE
	EXISTING DUCTWORK TO REMAIN IN-PLACE AND IN-USE
	TO REMAIN IN-PLACE AND IN-USE
	SA-ED SUPPLY AIR - EXISTING DIFFUSER
	RA-EG RETURN AIR - EXISTING GRILLE
	EA-EG EXHAUST AIR - EXISTING GRILLE
	RA-NG RETURN AIR - NEW GRILLE
	EA-NG EXHAUST AIR - NEW GRILLE
	XX-XX DESIGN AIRFLOW CFM

- SHEETMETAL GENERAL NOTES**
- 1) ALL DUCTWORK IS SHOWN DIAGRAMMATICALLY AND DOES NOT INDICATE ALL THE OFFSETS THAT MAY BE REQUIRED FOR INSTALLATION.
 - 2) ALL DUCTWORK IS TO BE FABRICATED AND INSTALLED PER SMACNA LOW PRESSURE DUCTWORK STANDARDS.
 - 3) FLEXIBLE DUCT CONNECTIONS SHALL NOT EXCEED 6'-0" AND THE FLEXIBLE DUCTWORK SHALL MEET UL 181 STANDARDS. MAXIMUM BEND PER RUN - 90 DEGREES.
 - 4) SQUARE ELBOWS REQUIRE TURNING VANES.
 - 5) RETURN AIR & EXHAUST AIR GRILLES NOTED TO BE NEW SHALL BE 24"x24" LAY-PANEL WITH 45 DEG. LOUVERS WITH 3/4" SPACING. GRILLE AREA IN PANEL TO BE 16"x16" WITH NECK SIZE THE BRANCH DUCT SIZE

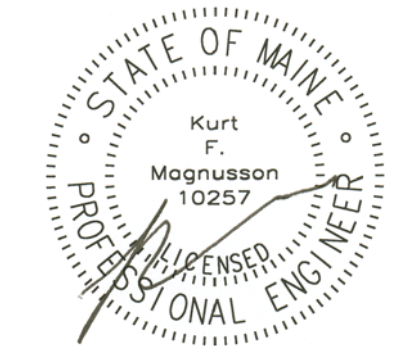

MECHANICAL SYSTEMS ENGINEERS
ROYAL RIVER CENTER, UNIT 108
10 FOREST FALLS DRIVE, YARMOUTH, MAINE 04096
(207) 846-1441
FACEBOOK: MECHANICAL SYSTEMS ENGINEERS
CELEBRATING 50 YEARS IN BUSINESS
© COPYRIGHT 2018

KEY PLAN
NO SCALE

PLAN REVISIONS

Rev#	Description	Date	Appr.
1	GENERAL REVISIONS	1.28.19	

DESIGNED BY: KFM
DRAWN BY: KFM
CHECKED BY: KFM/MAD
DATE: 12/28/2018
SCALE: 1/8" = 1'-0"
DFE PROJECT NO: 235R18-458-D

STATE OF MAINE
DEPARTMENT OF DEFENSE, VETERANS
AND EMERGENCY MANAGEMENT
Cordja Capital Projects Group
16 Tannery Lane, Suite 23
Camden, Maine 04843
207-236-9970 / mdsigle@cordjapcg.com


CAMP KEYES REUTILIZATION PROJECT
CAMP KEYES, AUGUSTA, MAINE
BUILDING NO. 7 RENOVATIONS
MECHANICAL DUCTWORK PLANS
NORTHWEST WING - DUCWORK

PLAN PROGRESS


<input type="checkbox"/>	DRAFT
<input type="checkbox"/>	35% REVIEW
<input type="checkbox"/>	65% REVIEW
<input type="checkbox"/>	95% REVIEW
<input type="checkbox"/>	FINAL REVIEW
<input checked="" type="checkbox"/>	FOR BIDDING
<input type="checkbox"/>	ISSUED FOR CONSTRUCTION
<input type="checkbox"/>	RECORD DRAWINGS

SHEET ID:
M-107
SHEET: 86 OF 126


January 28, 2019 - 7:25 am
X:\Projects\1813 Comp Keyes Bldg 7\M107 & M108 (01-23-2019).dwg

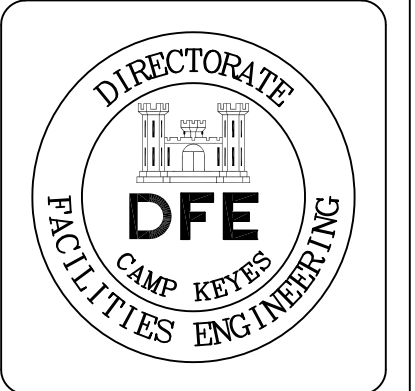


Rev#	Description	Date	Appr.
1	GENERAL REVISIONS		
		1.28.19	

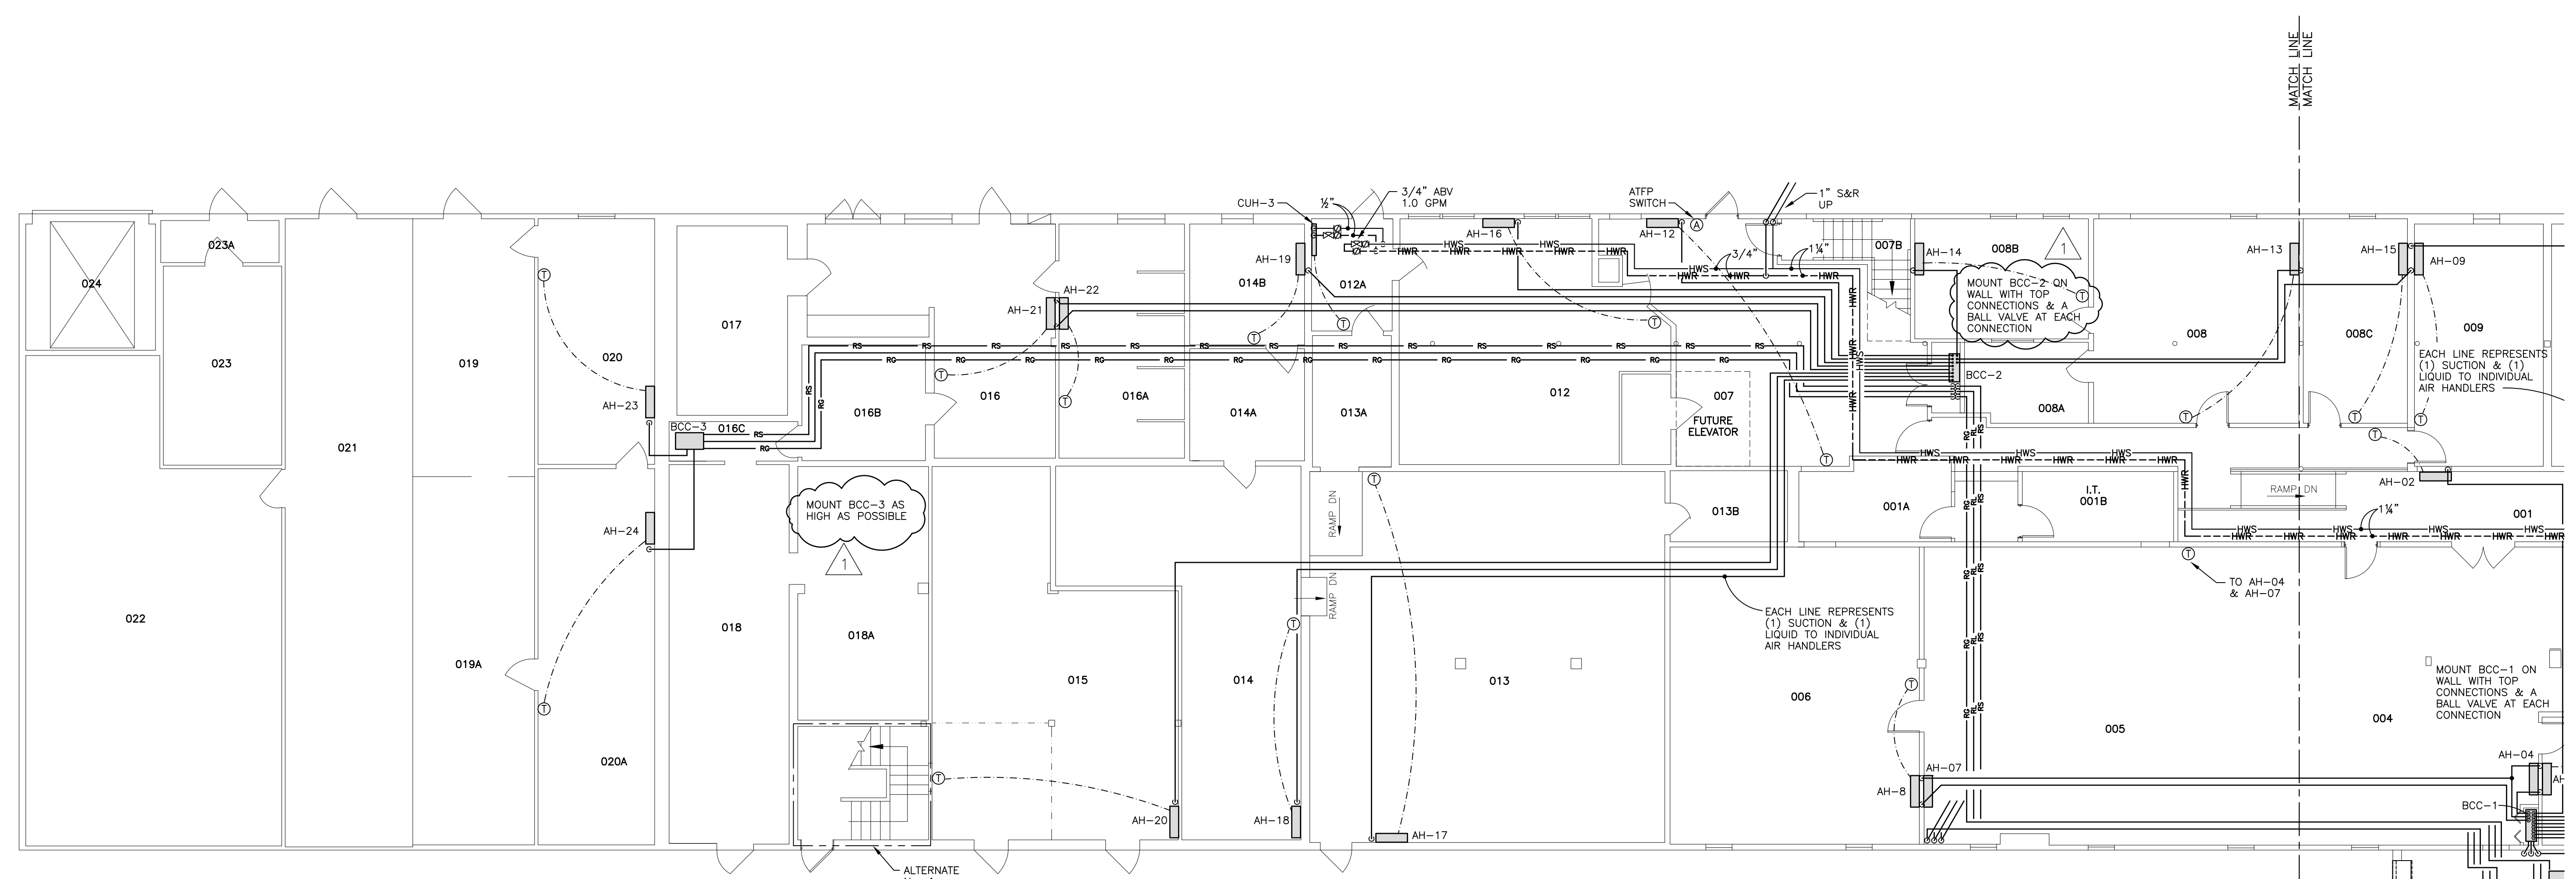

1 MECHANICAL PIPING PLAN
LOWER LEVEL-SOUTH END
SCALE: 1/8" = 1'-0"

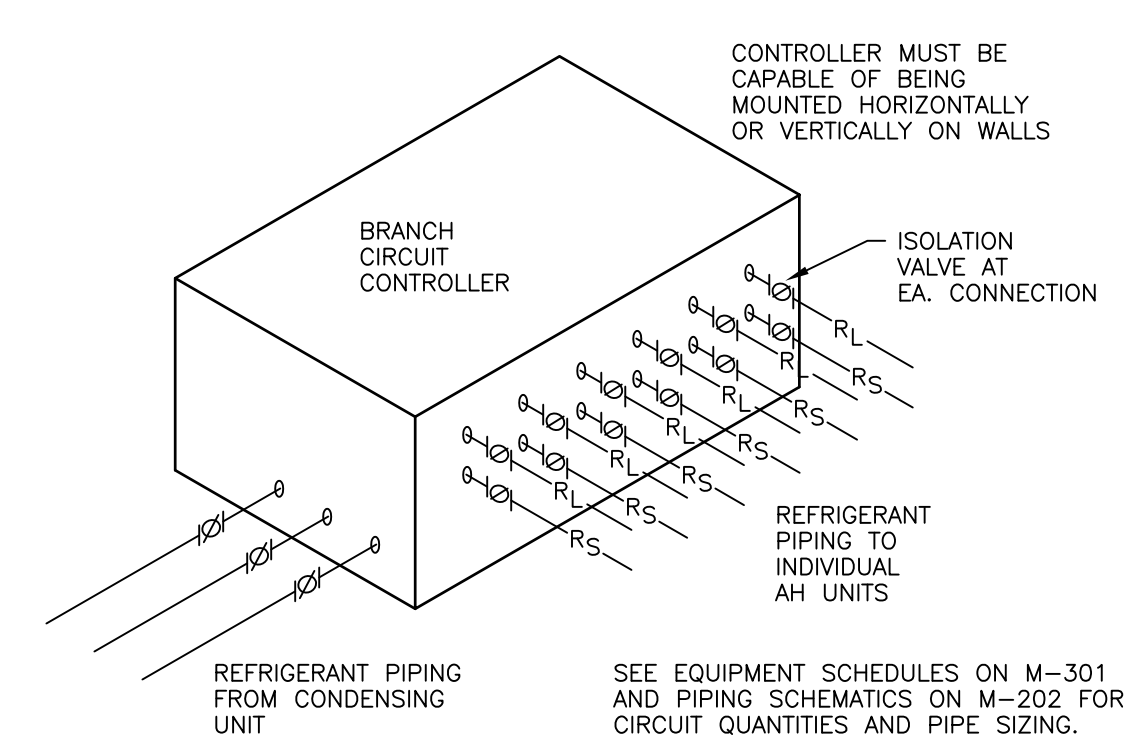

2 BRANCH CIRCUIT CONTROLLER
PIPING DIAGRAM
NO SCALE

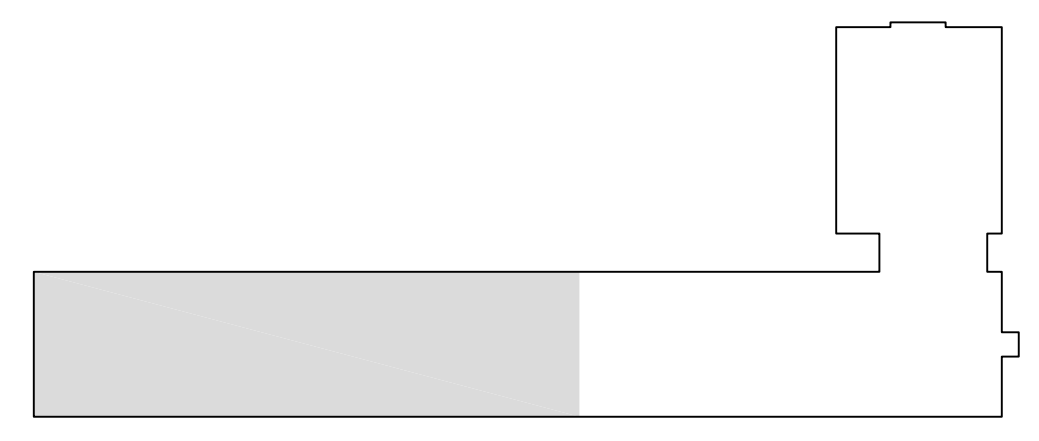

KEY PLAN
NO SCALE

DESIGNED BY: REM
DRAWN BY: REM
CHECKED BY: KFM/MAD
DATE: 12/28/2018
SCALE: 1/8" = 1'-0"
DFE PROJECT NO: 235R18-458-D

STATE OF MAINE
DEPARTMENT OF DEFENSE, VETERANS
AND EMERGENCY MANAGEMENT
Cordja Capital Projects Group
16 Tannery Lane, Suite 23
Camden, Maine 04843
207-236-9970 / mdsigle@cordjagp.com



CAMP KEYES REUTILIZATION PROJECT
CAMP KEYES, AUGUSTA, MAINE
BUILDING NO. 7 RENOVATIONS
MECHANICAL PIPING PLAN
LOWER LEVEL-SOUTH END

PLAN PROGRESS

<input type="checkbox"/>	DRAFT
<input type="checkbox"/>	35% REVIEW
<input type="checkbox"/>	65% REVIEW
<input type="checkbox"/>	95% REVIEW
<input type="checkbox"/>	FINAL REVIEW
<input checked="" type="checkbox"/>	FOR BIDDING
<input type="checkbox"/>	ISSUED FOR CONSTRUCTION
<input type="checkbox"/>	RECORD DRAWINGS



SHEET ID:
M-109
SHEET: 88 OF 126

January 28, 2019 - 7:27 am
X:\Projects\1813 Camp Keyes Bldg 7\Address\1813 Bldg 7 M109-M114 (01-24-2019).dwg

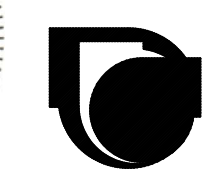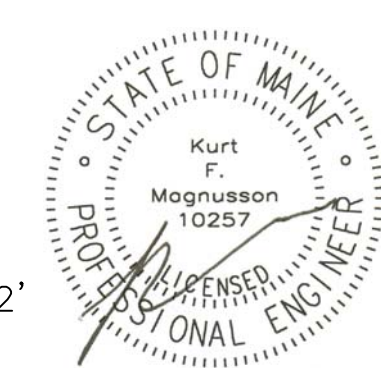

MECHANICAL SYSTEMS ENGINEERS
ROYAL RIVER CENTER, UNIT 108
10 FOREST FALLS DRIVE, YARMOUTH, MAINE 04096
(207) 846-1441
FACEBOOK: MECHANICAL SYSTEMS ENGINEERS
CELEBRATING 50 YEARS IN BUSINESS
© COPYRIGHT 2018



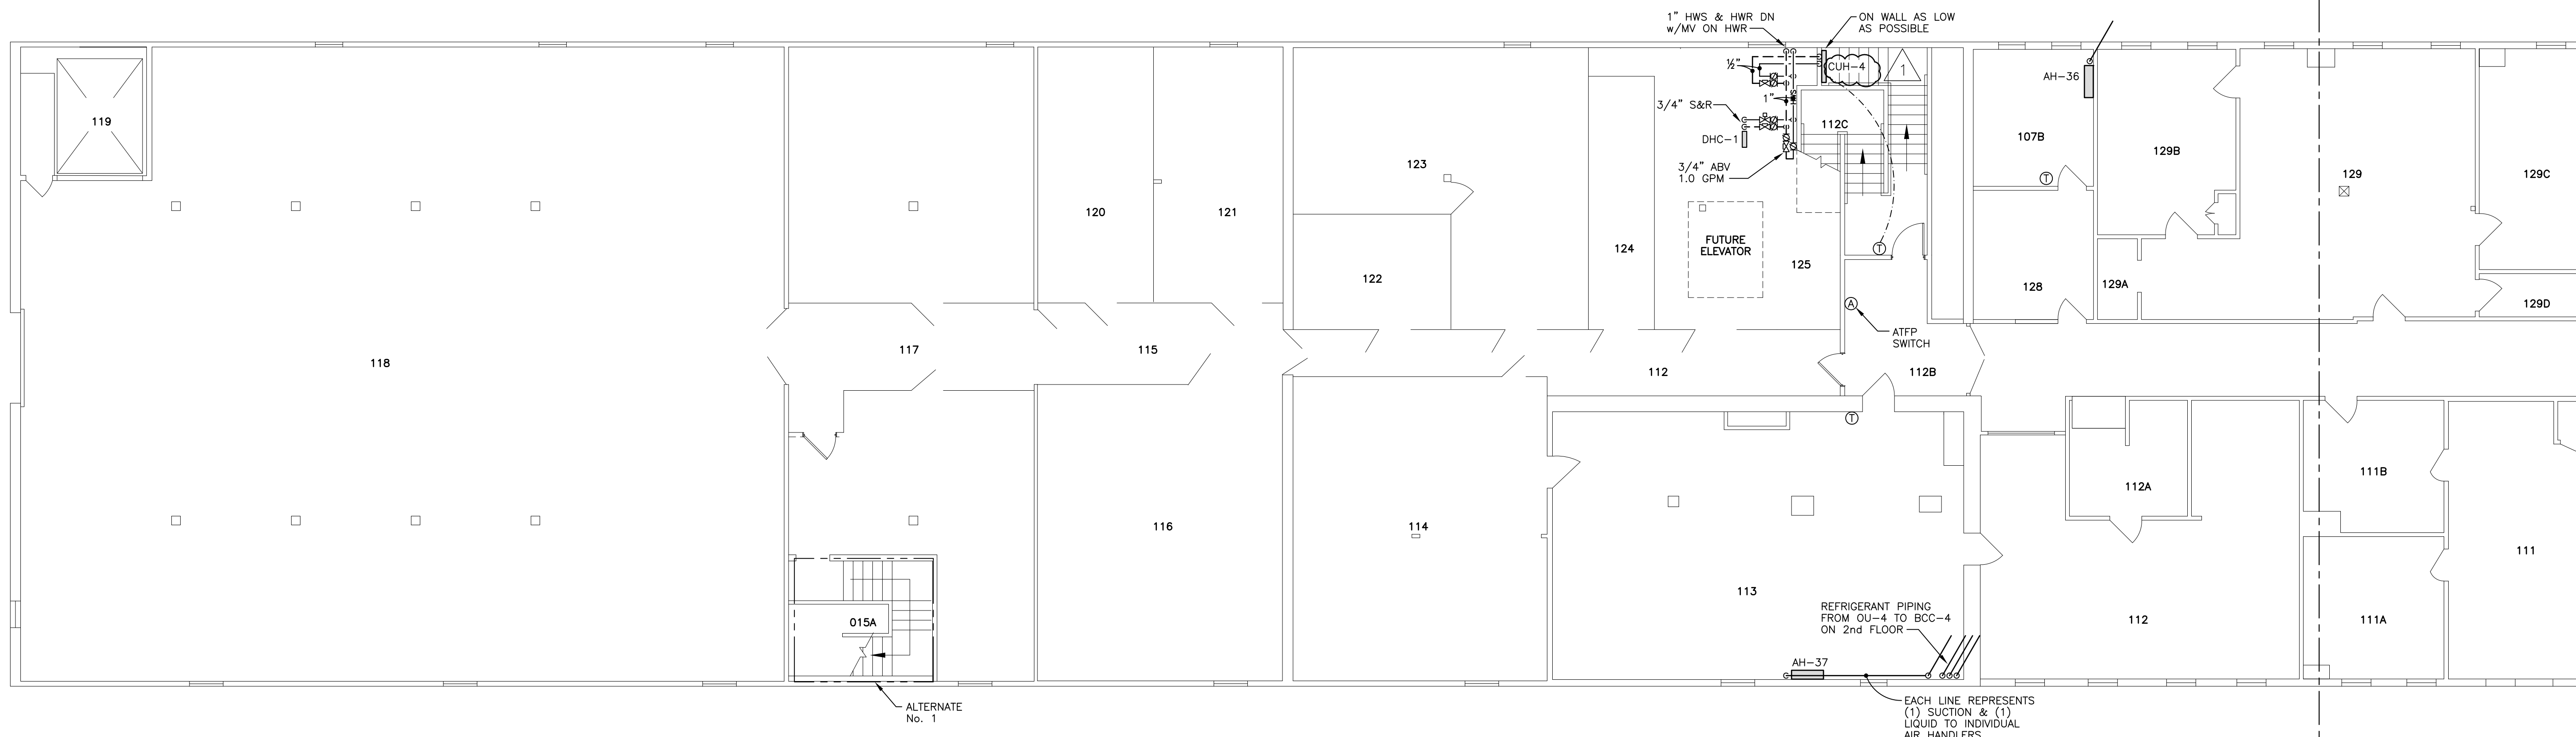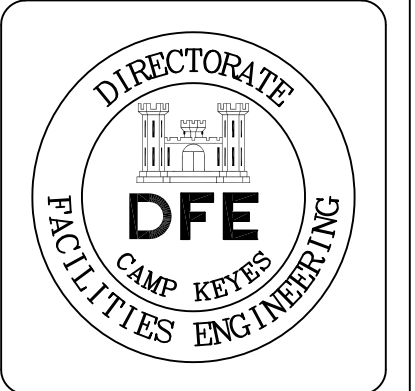


1 MECHANICAL PIPING PLAN
FIRST FLOOR—SOUTH END
SCALE: 1/8" = 1'-0"

Rev#	Description	Date	Appr.
1	GENERAL REVISIONS		
1.28.19			

DESIGNED BY: REM
 DRAWN BY: REM
 CHECKED BY: KFM/MAD
 DATE: 12/28/2018
 SCALE: 1/8" = 1'-0"
 DFE PROJECT NO: 235R18-458-D

STATE OF MAINE
 DEPARTMENT OF DEFENSE, VETERANS
 AND EMERGENCY MANAGEMENT
 Cordja Capital Projects Group
 16 Tannery Lane, Suite 23
 Camden, Maine 04843
 207-236-9970 / mdsigle@cordjagroup.com

CAMP KEYES REUTILIZATION PROJECT
 CAMP KEYES, AUGUSTA, MAINE
 BUILDING NO. 7 RENOVATIONS
 MECHANICAL PIPING PLAN
 FIRST FLOOR—SOUTH END

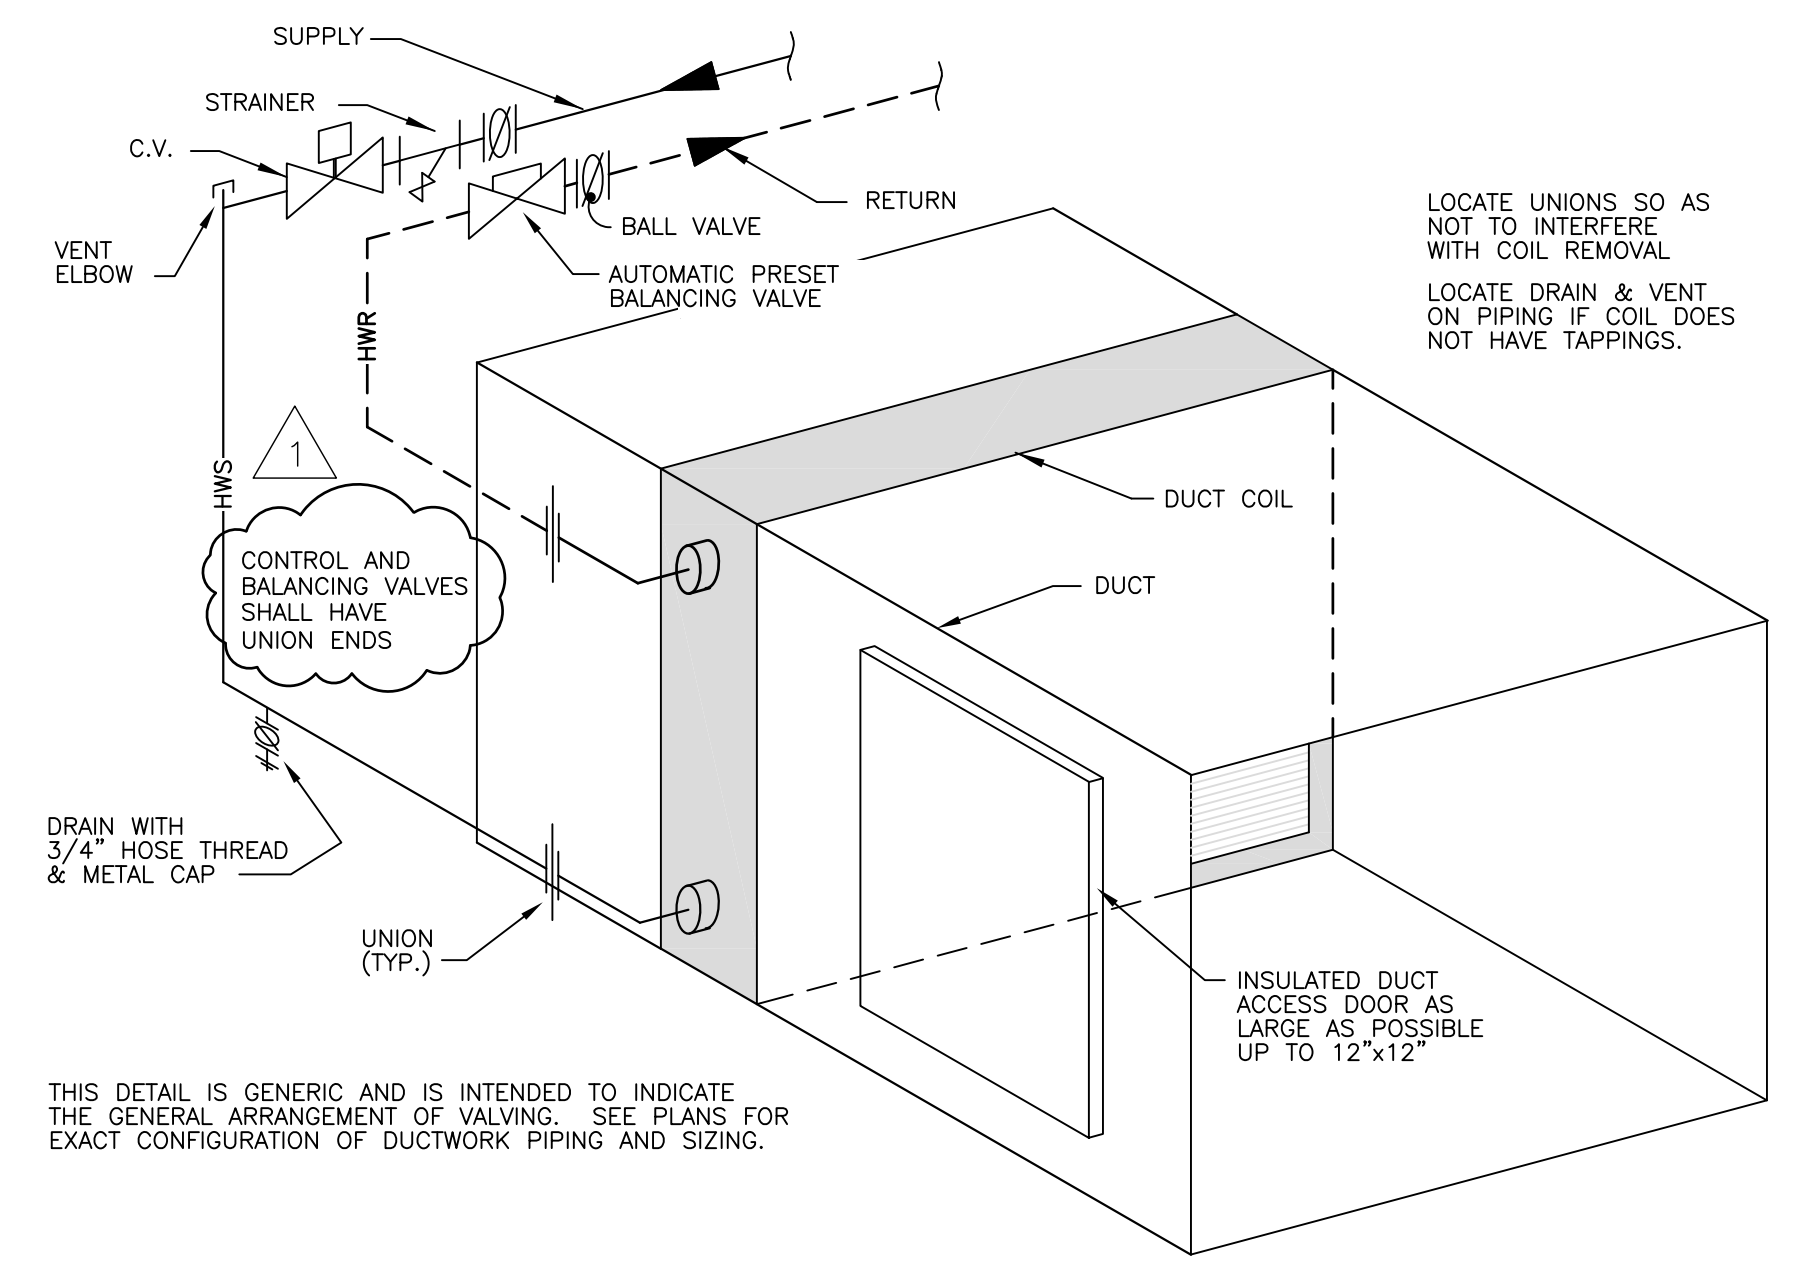

2 DUCT HOT WATER COIL PIPING
NO SCALE

THIS DETAIL IS GENERIC AND IS INTENDED TO INDICATE THE GENERAL ARRANGEMENT OF VALVING. SEE PLANS FOR EXACT CONFIGURATION OF DUCTWORK PIPING AND SIZING.

LOCATE UNIONS SO AS NOT TO INTERFERE WITH COIL REMOVAL
LOCATE DRAIN & VENT ON PIPING IF COIL DOES NOT HAVE TAPPINGS.

EACH LINE REPRESENTS (1) SUCTION & (1) LIQUID TO INDIVIDUAL AIR HANDLERS

REFRIGERANT PIPING FROM OU-4 TO BCC-4 ON 2nd FLOOR

ATFP SWITCH

1" HWS & HWR DN w/MV ON HWR
ON WALL AS LOW AS POSSIBLE

3/4" S&R

DHC-1

3/4" ABV 1.0 GPM

CUH-4

112C

AH-36

107B

129B

129

129C

128

129A

129D

112A

111B



111

111A

AH-37

ALTERNATE No. 1

January 28, 2019 - 7:28 am
X:\Projects\1813 Camp Keyes Bldg 7\1009-M114 (01-24-2019).dwg

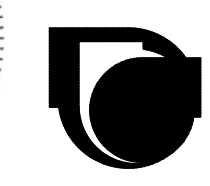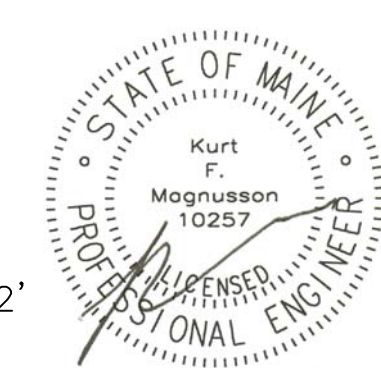


MECHANICAL SYSTEMS ENGINEERS
ROYAL RIVER CENTER, UNIT 10B
10 FOREST FALLS DRIVE, YARMOUTH, MAINE 04096
(207) 846-1441
FACEBOOK: MECHANICAL SYSTEMS ENGINEERS
CELEBRATING 50 YEARS IN BUSINESS
© COPYRIGHT 2018



PLAN PROGRESS

<input type="checkbox"/>	DRAFT
<input type="checkbox"/>	35% REVIEW
<input type="checkbox"/>	65% REVIEW
<input type="checkbox"/>	95% REVIEW
<input type="checkbox"/>	FINAL REVIEW
<input checked="" type="checkbox"/>	FOR BIDDING
<input type="checkbox"/>	ISSUED FOR CONSTRUCTION
<input type="checkbox"/>	RECORD DRAWINGS

SHEET ID:
M-111
SHEET: 90 OF 126

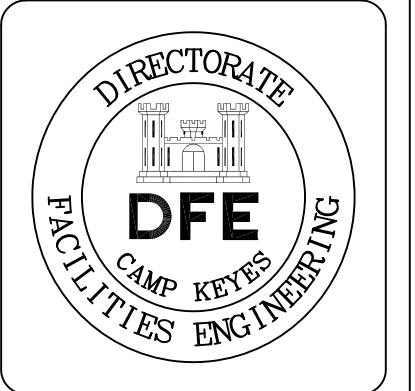

Rev#	Description	Date	Appr.
1	GENERAL REVISIONS		
1.28.19			

DESIGNED BY: REM
 DRAWN BY: REM
 CHECKED BY: KFM/MAD
 DATE: 12/28/2018
 SCALE: 1/8" = 1'-0"
 DFE PROJECT NO: 235F18-458-D


STATE OF MAINE
 DEPARTMENT OF DEFENSE, VETERANS
 AND EMERGENCY MANAGEMENT
 Cordja Capital Projects Group
 16 Tannery Lane, Suite 23
 Camden, Maine 04843
 207-236-9970 / mdsigle@cordjagroup.com

CAMP KEYES REUTILIZATION PROJECT
 CAMP KEYES, AUGUSTA, MAINE
 BUILDING NO. 7 RENOVATIONS
 MECHANICAL PIPING PLAN
 FIRST FLOOR-NORTH END


PLAN PROGRESS

<input type="checkbox"/>	DRAFT
<input type="checkbox"/>	35% REVIEW
<input type="checkbox"/>	65% REVIEW
<input type="checkbox"/>	95% REVIEW
<input type="checkbox"/>	FINAL REVIEW
<input checked="" type="checkbox"/>	FOR BIDDING
<input type="checkbox"/>	ISSUED FOR CONSTRUCTION
<input type="checkbox"/>	RECORD DRAWINGS




SHEET ID:
 M-112
 SHEET: 91 of 126

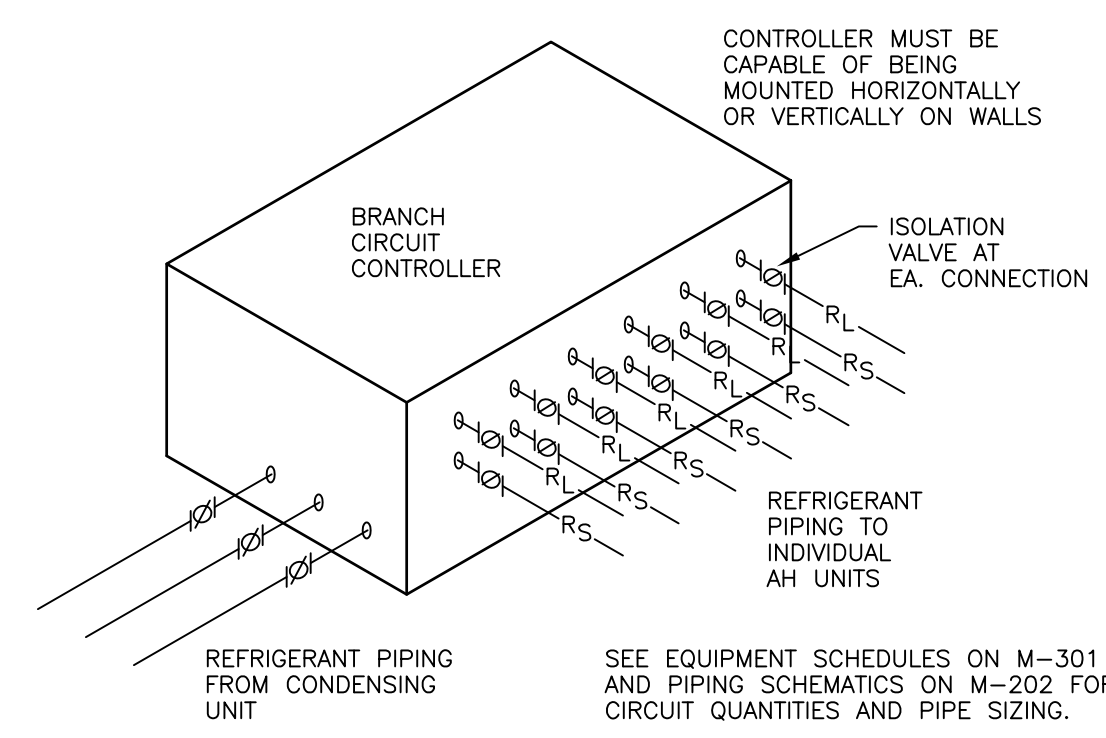

2 BRANCH CIRCUIT CONTROLLER
 PIPING DIAGRAM
 NO SCALE

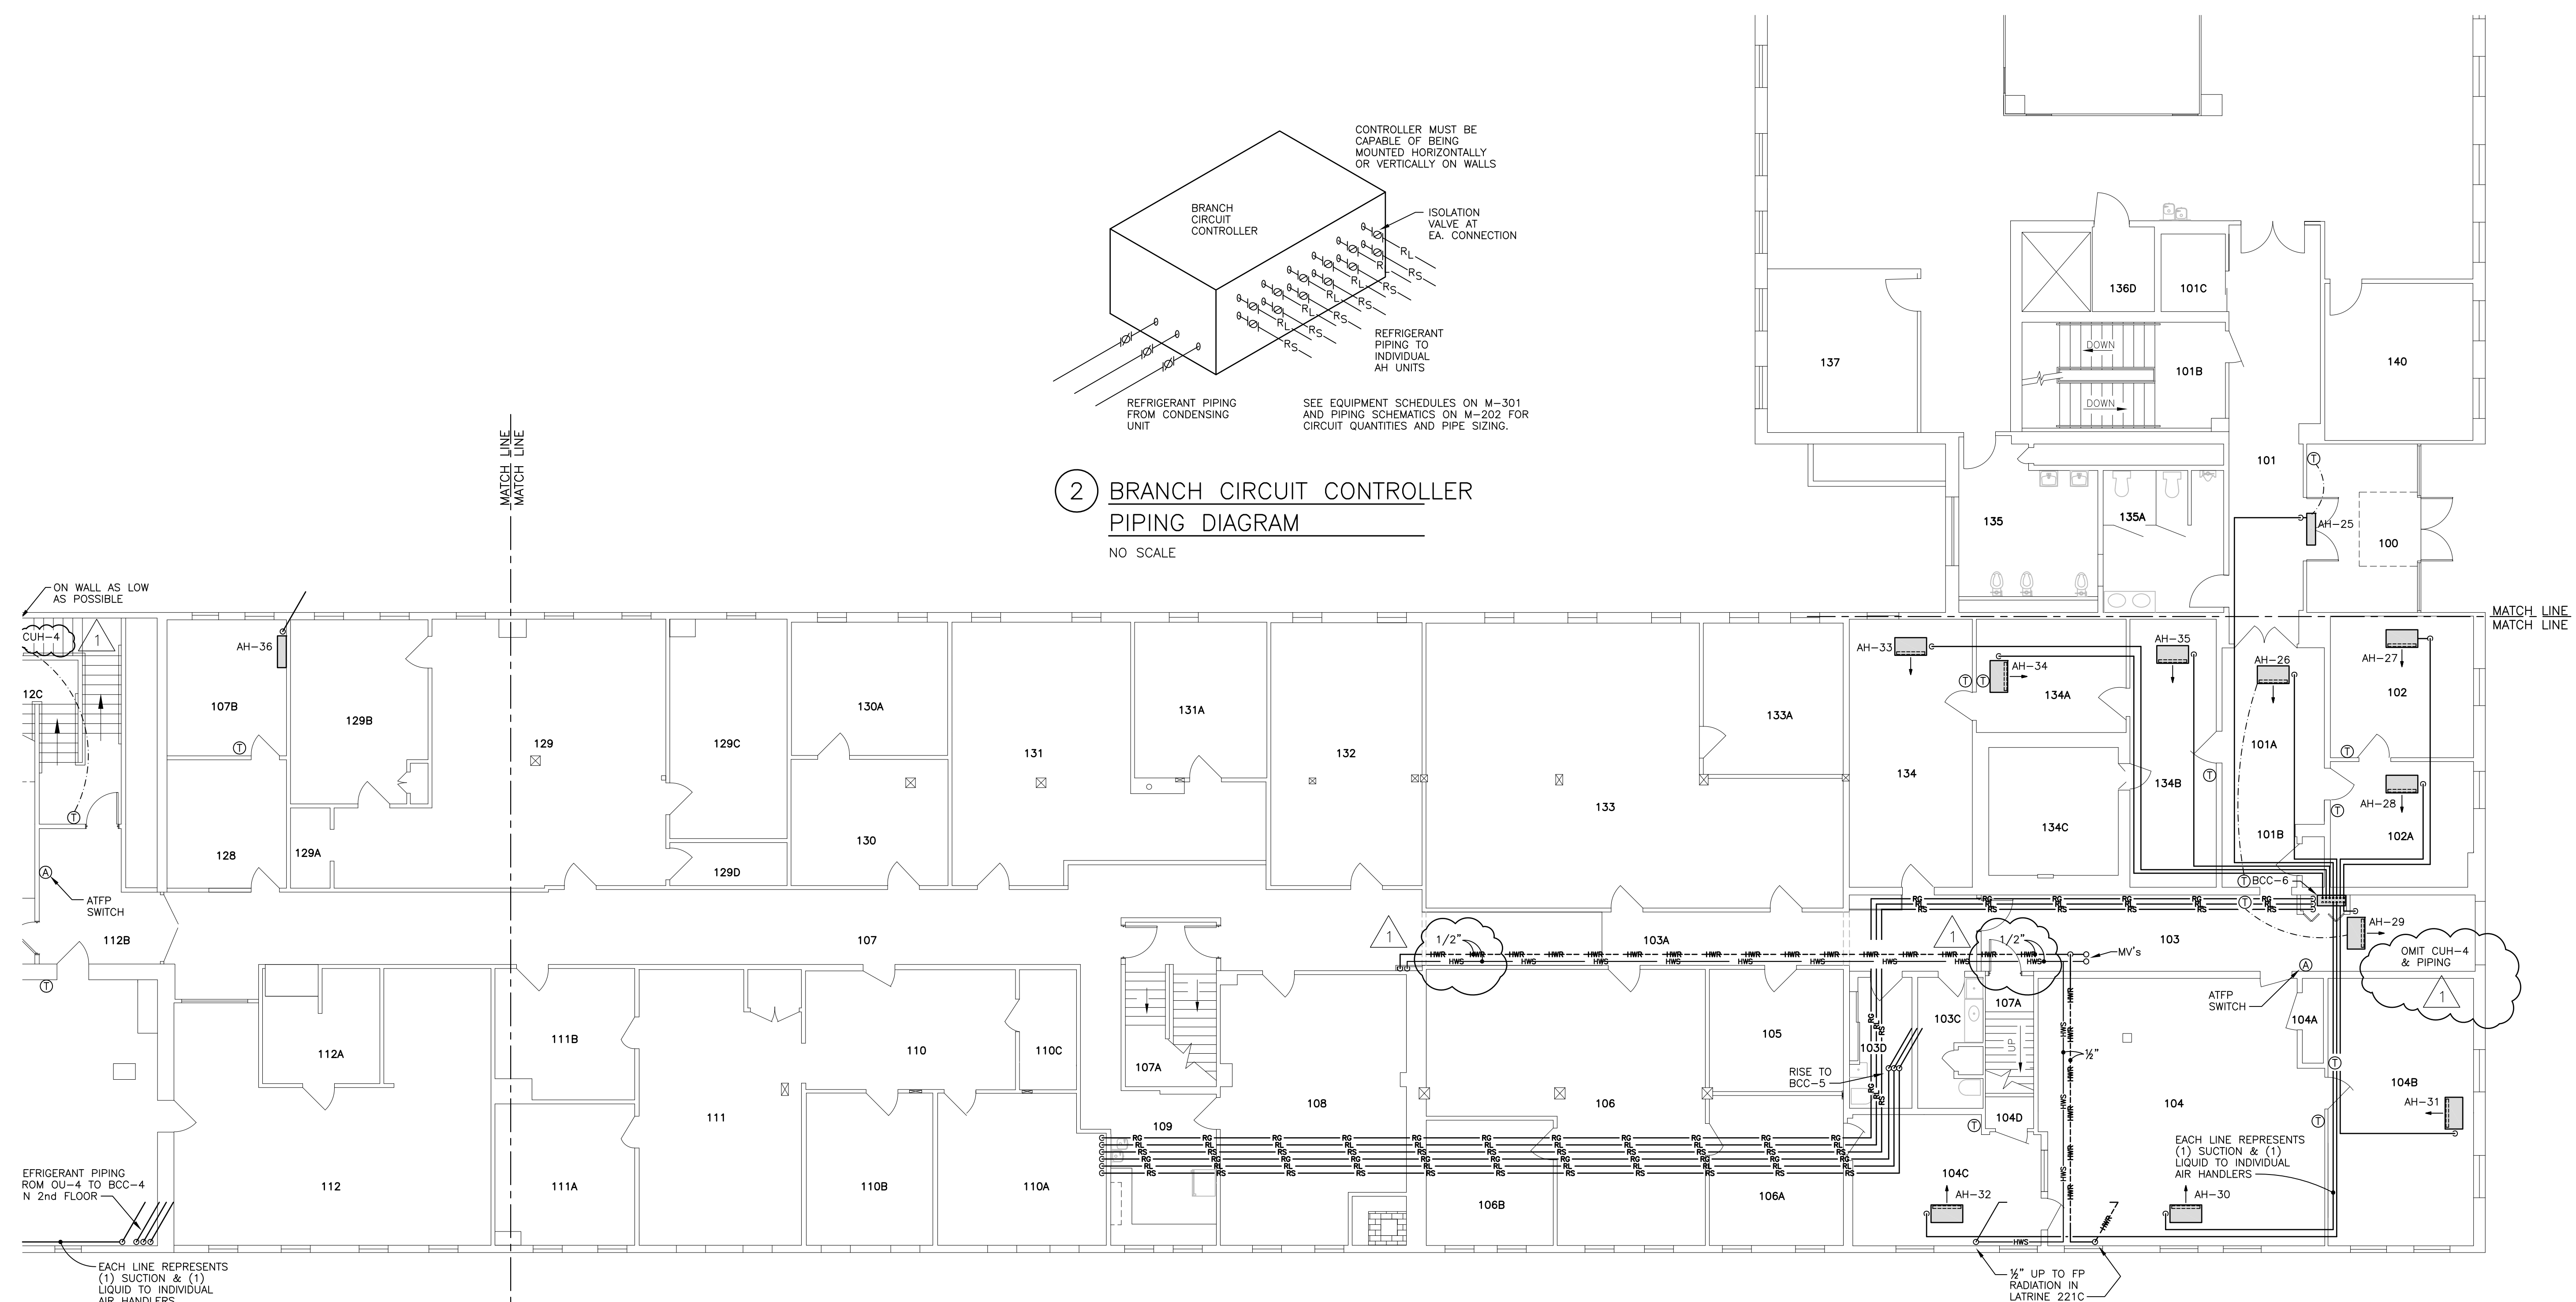


1 MECHANICAL PIPING PLAN
 FIRST FLOOR-NORTH END
 SCALE: 1/8" = 1'-0"

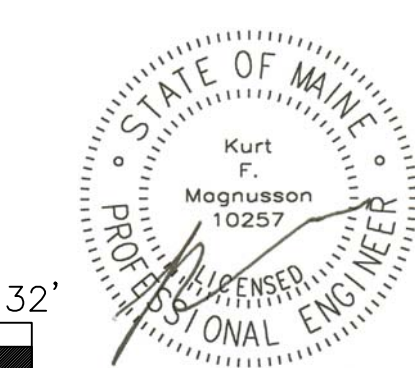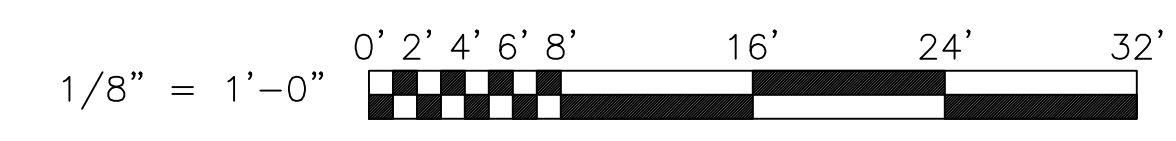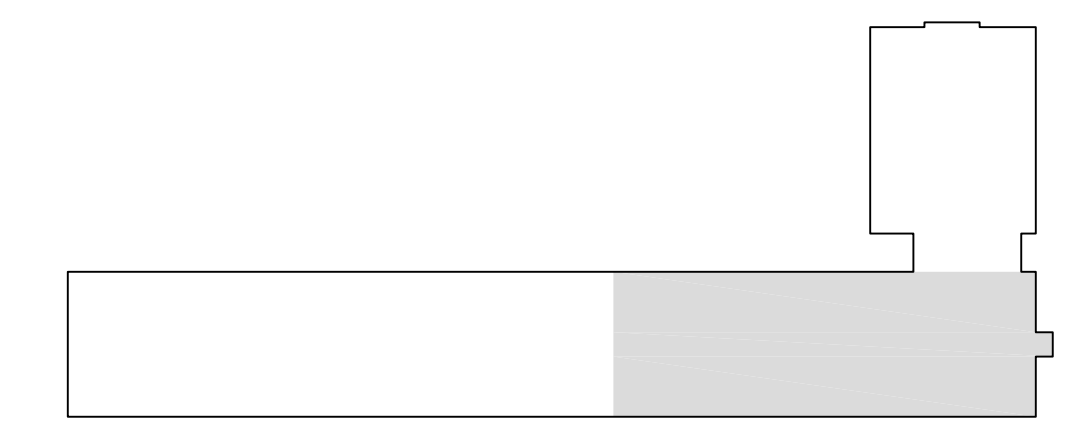

MECHANICAL SYSTEMS ENGINEERS
 ROYAL RIVER CENTER, UNIT 108
 10 FOREST FALLS DRIVE, YARMOUTH, MAINE 04096
 (207) 846-1441
 FACEBOOK: MECHANICAL SYSTEMS ENGINEERS
 CELEBRATING 50 YEARS IN BUSINESS
 © COPYRIGHT 2018



January 28, 2019 - 7:29 am
 X:\Projects\1813 Camp Keyes Bldg 7\Address\1813 Bldg 7 M109-M114 (01-24-2019).dwg

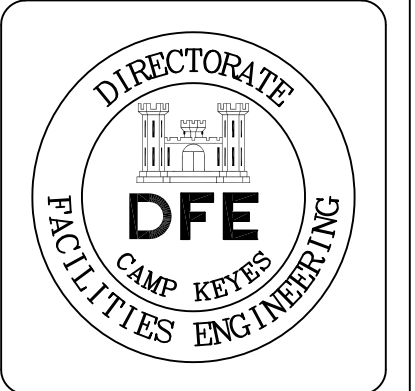

Rev#	Description	Date	Appr.
1	GENERAL REVISIONS	1.28.19	

DESIGNED BY: REM
 DRAWN BY: REM
 CHECKED BY: KFM/MAD
 DATE: 12/28/2018
 SCALE: 1/8" = 1'-0"
 DFE PROJECT NO: 235R18-458-D


STATE OF MAINE
 DEPARTMENT OF DEFENSE, VETERANS
 AND EMERGENCY MANAGEMENT
 Cordja Capital Projects Group
 16 Tannery Lane, Suite 23
 Camden, Maine 04843
 207-236-9970 / mdsigle@cordjagp.com

CAMP KEYES REUTILIZATION PROJECT
 CAMP KEYES, AUGUSTA, MAINE
 BUILDING NO. 7 RENOVATIONS
 MECHANICAL PIPING PLAN
 SECOND FLOOR—SOUTH END


PLAN PROGRESS

<input type="checkbox"/>	DRAFT
<input type="checkbox"/>	35% REVIEW
<input type="checkbox"/>	65% REVIEW
<input type="checkbox"/>	95% REVIEW
<input type="checkbox"/>	FINAL REVIEW
<input checked="" type="checkbox"/>	FOR BIDDING
<input type="checkbox"/>	ISSUED FOR CONSTRUCTION
<input type="checkbox"/>	RECORD DRAWINGS


SHEET ID:
M-113
 SHEET: 92 OF 126

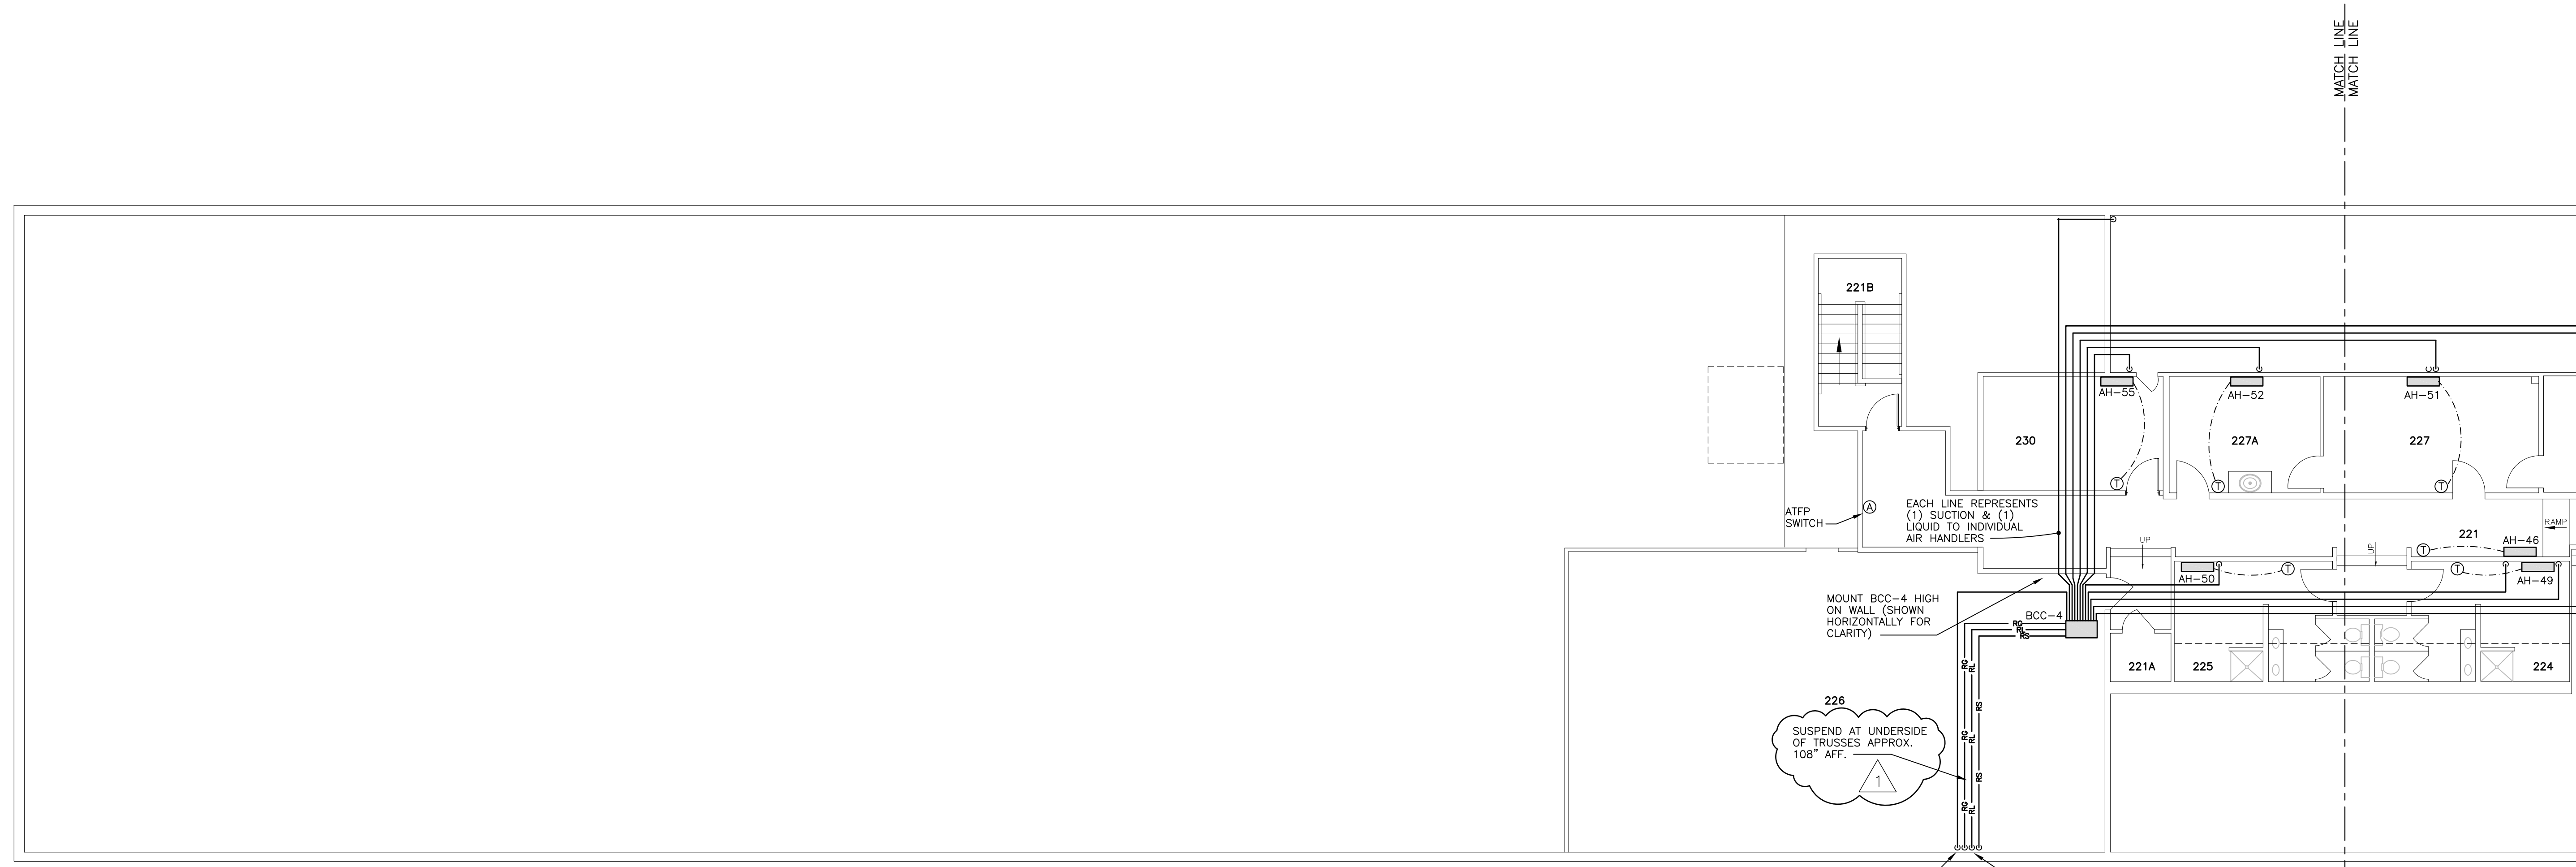




1 MECHANICAL PIPING PLAN
 SECOND FLOOR—SOUTH END
 SCALE: 1/8" = 1'-0"

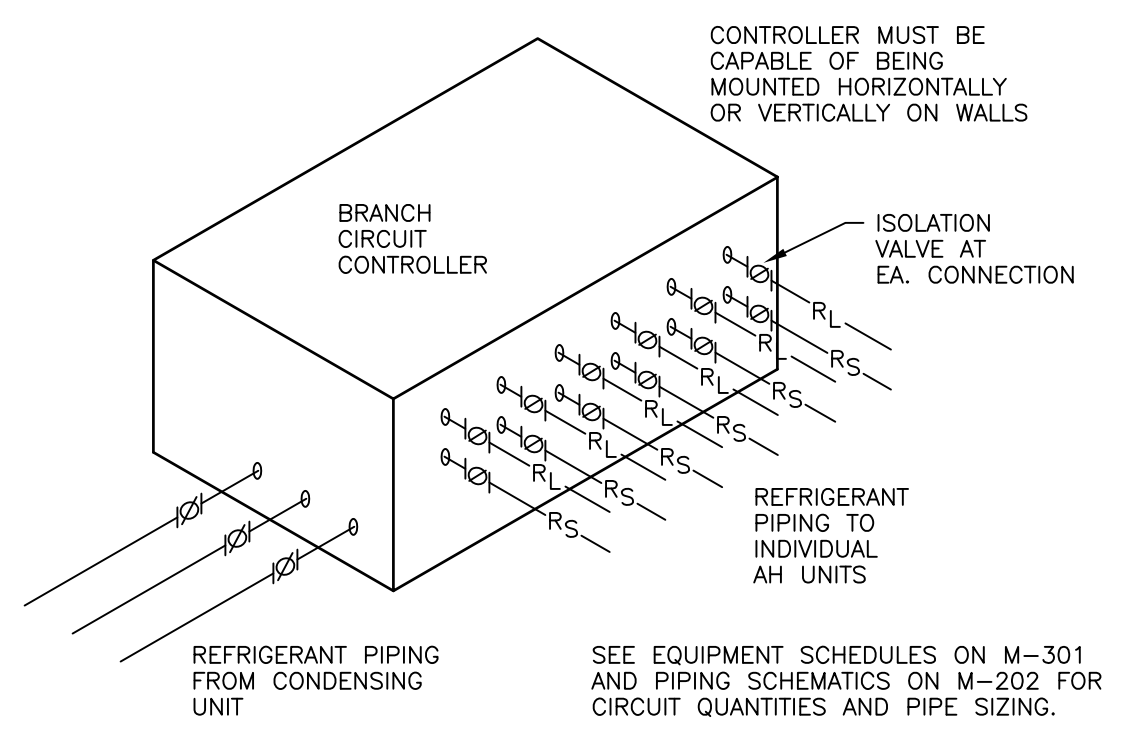

2 BRANCH CIRCUIT CONTROLLER
 PIPING DIAGRAM
 NO SCALE

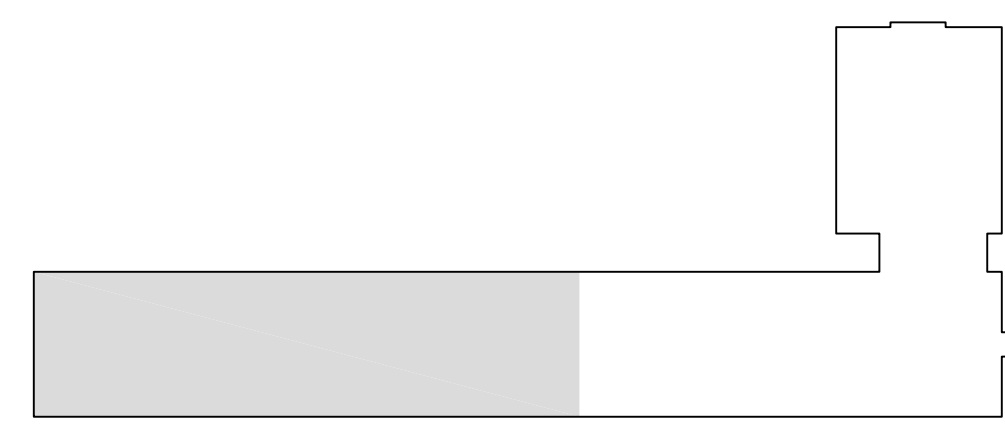



KEY PLAN
 NO SCALE

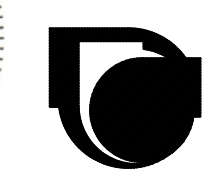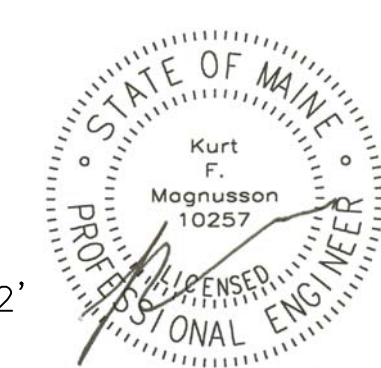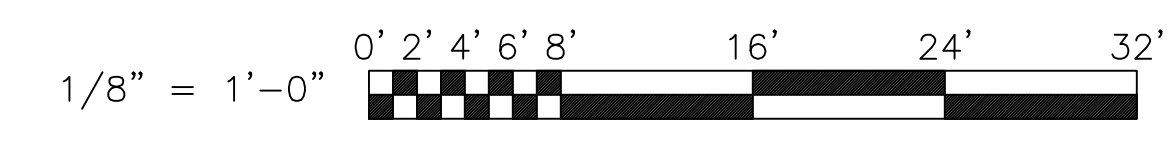



MECHANICAL SYSTEMS ENGINEERS
 ROYAL RIVER CENTER, UNIT 108
 10 FOREST FALLS DRIVE, YARMOUTH, MAINE 04096
 (207) 846-1441
 FACEBOOK: MECHANICAL SYSTEMS ENGINEERS
 CELEBRATING 50 YEARS IN BUSINESS
 © COPYRIGHT 2018



January 28, 2019 - 7:29 am
 X:\Projects\1813 Comp Keyes Bldg 7\Address\1813 Bldg 7 M109-M114 (01-24-2019).dwg

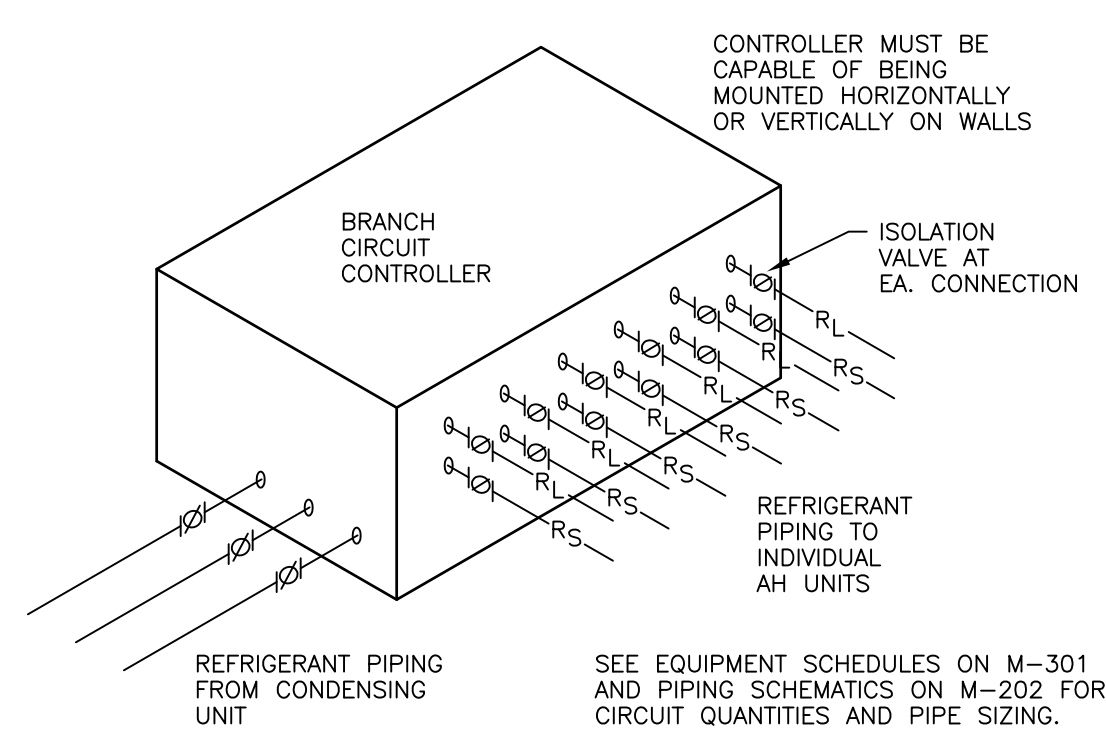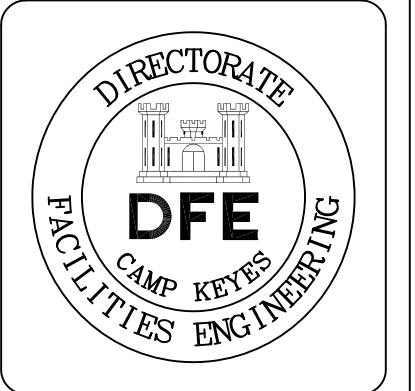

2 BRANCH CIRCUIT CONTROLLER PIPING DIAGRAM
NO SCALE

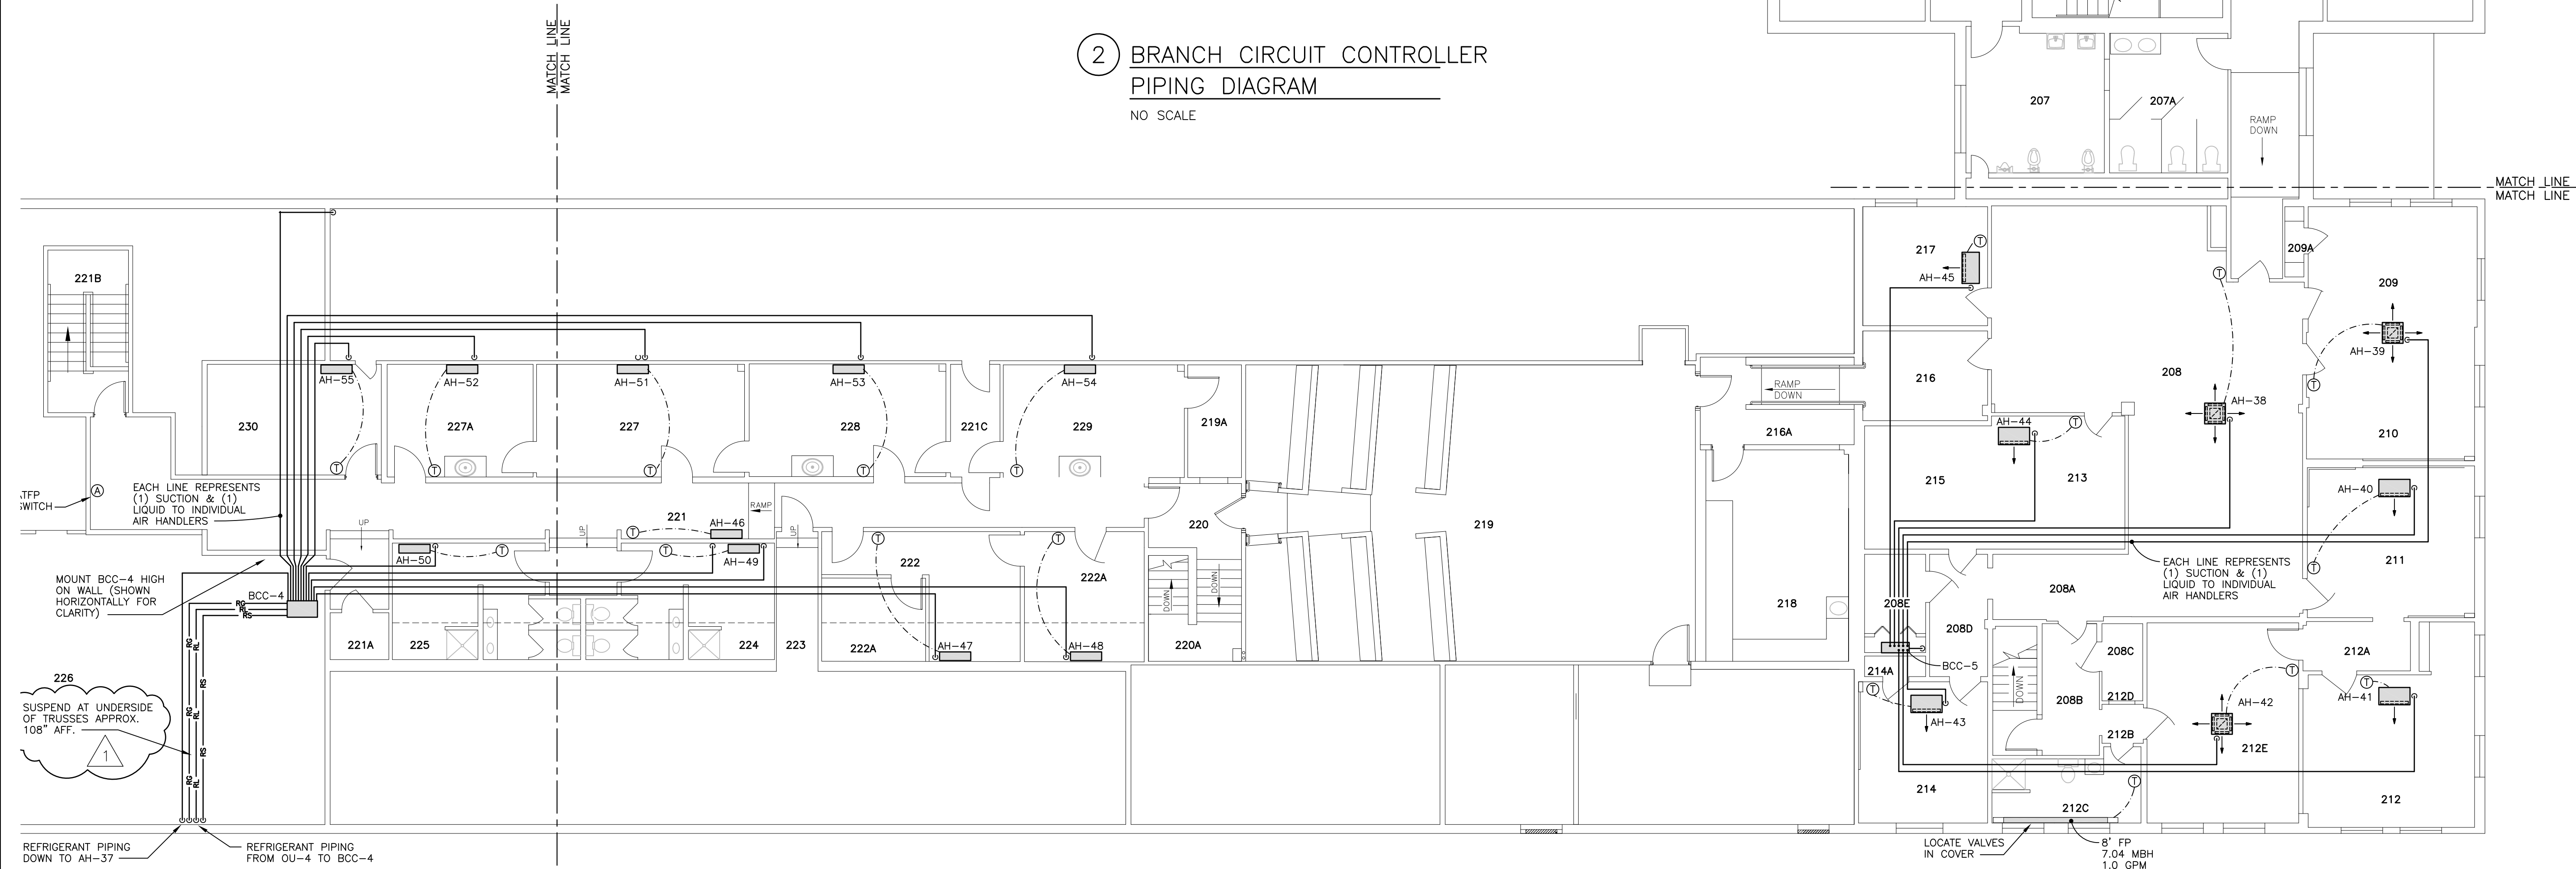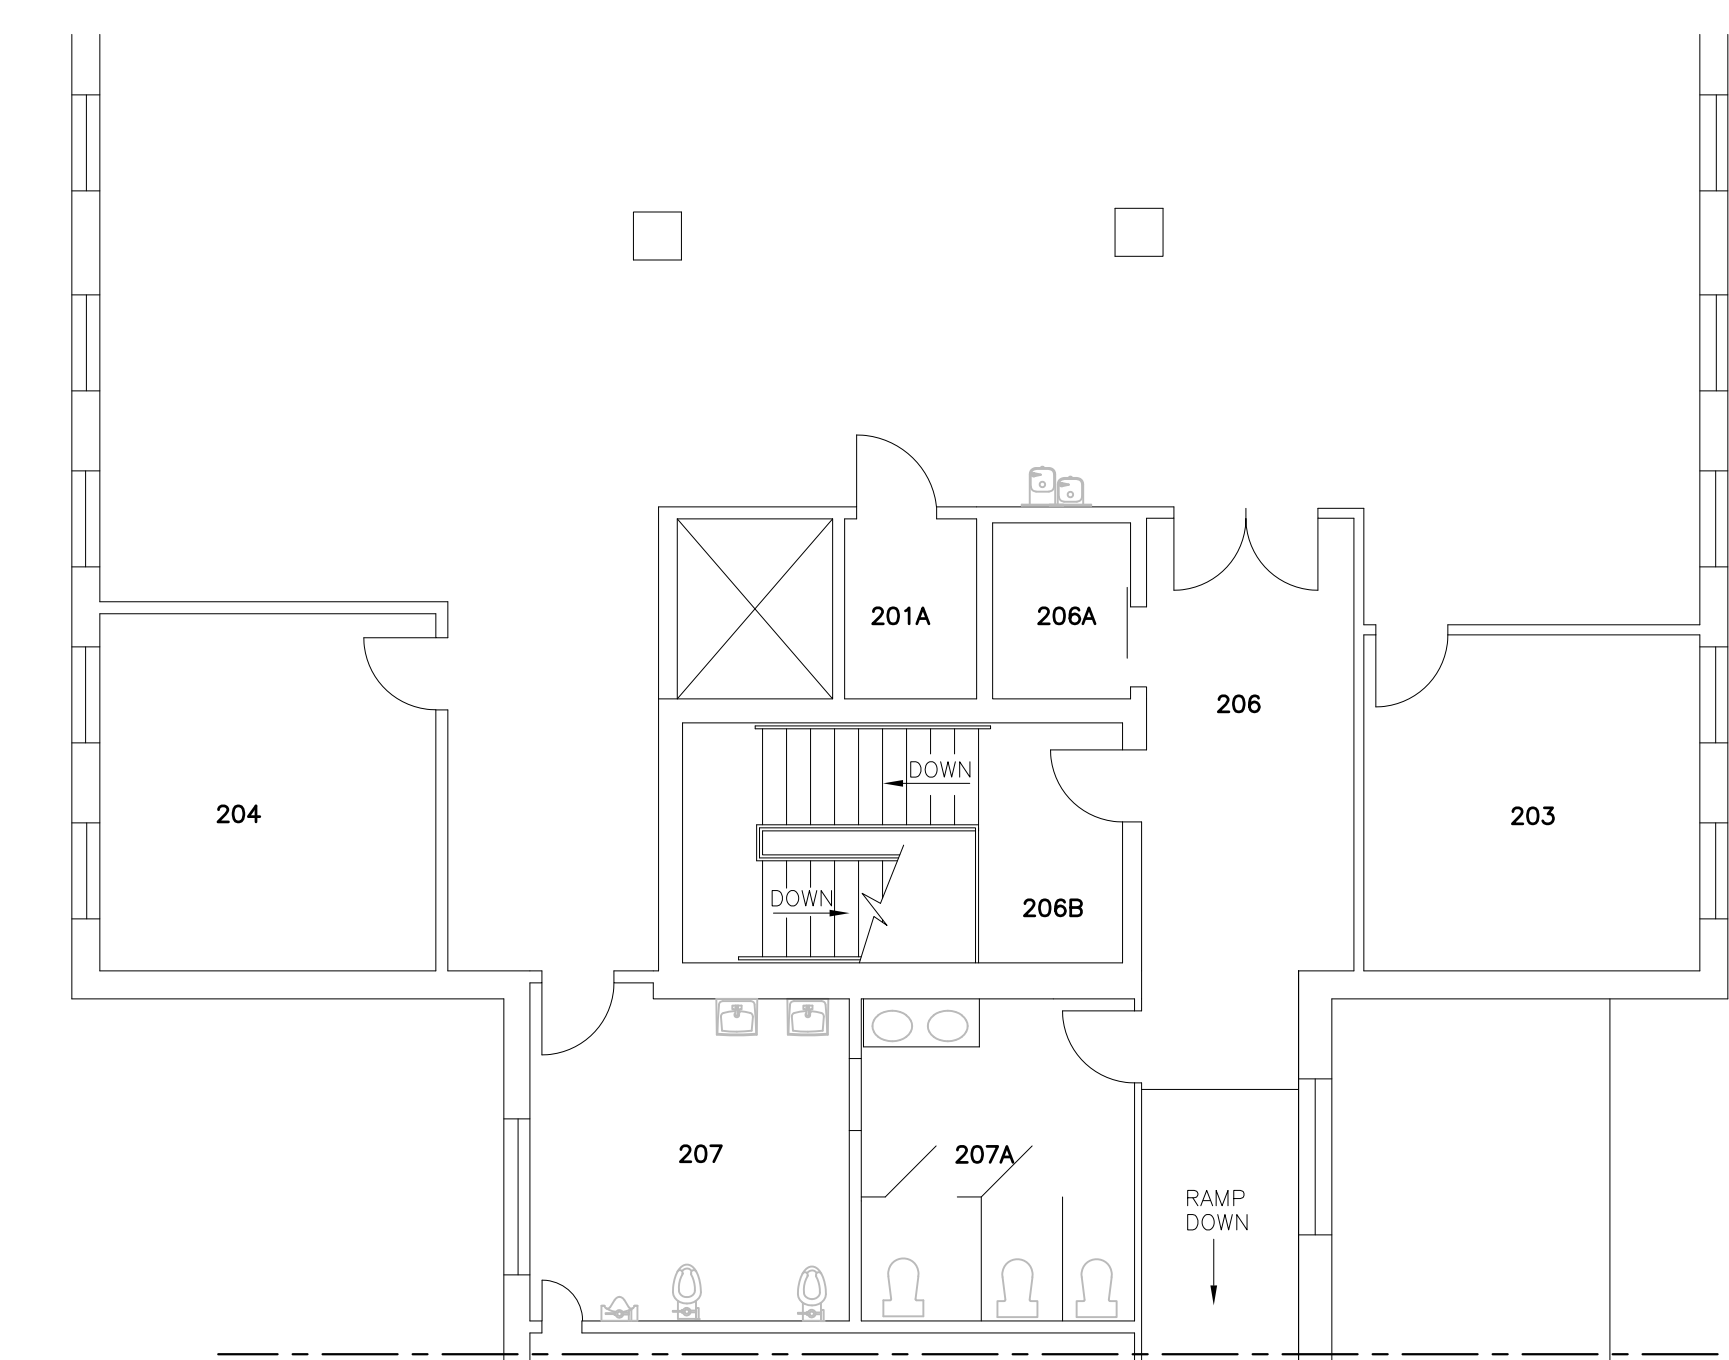

1 MECHANICAL PIPING PLAN SECOND FLOOR-NORTH END
SCALE: 1/8" = 1'-0"

Rev#	Description	Date	Appr.
1	GENERAL REVISIONS	1.28.19	
	PLAN REVISIONS		

DESIGNED BY: REM
DRAWN BY: REM
CHECKED BY: KFM/MAD
DATE: 12/28/2018
SCALE: 1/8" = 1'-0"
DPE PROJECT NO: 235R18-458-D


STATE OF MAINE
DEPARTMENT OF DEFENSE, VETERANS AND EMERGENCY MANAGEMENT
Cordja Capital Projects Group
16 Tannery Lane, Suite 23
Camden, Maine 04843
207-236-9970 / mdsigle@cordjaprog.com

CAMP KEYES REUTILIZATION PROJECT
CAMP KEYES, AUGUSTA, MAINE
BUILDING NO. 7 RENOVATIONS
MECHANICAL PIPING PLAN
SECOND FLOOR-NORTH END

PLAN PROGRESS	
<input type="checkbox"/>	DRAFT
<input type="checkbox"/>	35% REVIEW
<input type="checkbox"/>	65% REVIEW
<input type="checkbox"/>	95% REVIEW
<input type="checkbox"/>	FINAL REVIEW
<input checked="" type="checkbox"/>	FOR BIDDING
<input type="checkbox"/>	ISSUED FOR CONSTRUCTION
<input type="checkbox"/>	RECORD DRAWINGS


SHEET ID:
M-114
SHEET: 93 OF 126

January 28, 2019 - 7:29 am
X:\Projects\1813 Camp Keyes Bldg 7\Address\1813 Bldg 7 M109-M114 (01-24-2019).dwg

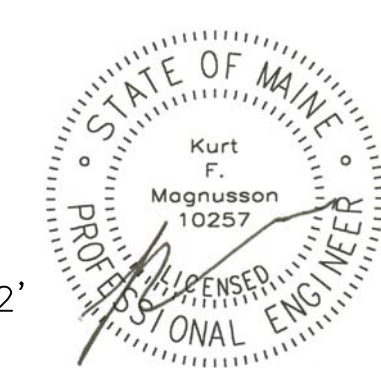

MECHANICAL SYSTEMS ENGINEERS
ROYAL RIVER CENTER, UNIT 108
10 FOREST FALLS DRIVE, YARMOUTH, MAINE 04096
(207) 846-1441
FACEBOOK: MECHANICAL SYSTEMS ENGINEERS
CELEBRATING 50 YEARS IN BUSINESS
© COPYRIGHT 2018



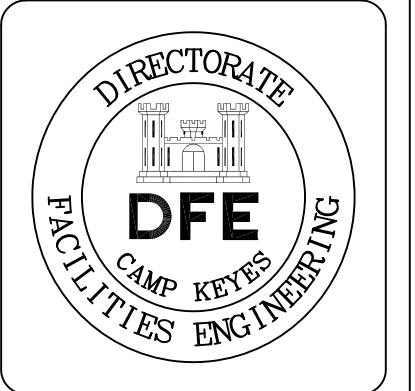


PLAN REVISIONS		Date	Appr.
1	GENERAL REVISIONS	1.28.19	

DESIGNED BY: REM	CHECKED BY: REM	DATE: 12/28/2018	SCALE: 1/8" = 1'-0"	D/E PROJECT NO: 235R18-458-D
STATE OF MAINE DEPARTMENT OF DEFENSE, VETERANS AND EMERGENCY MANAGEMENT				
Cordja Capital Projects Group 16 Tannery Lane, Suite 23 Camden, Maine 04843 207-236-9970 / mdsigle@cordjapcg.com				

CAMP KEYES REUTILIZATION PROJECT CAMP KEYES, AUGUSTA, MAINE BUILDING NO. 7 RENOVATIONS MECHANICAL CONDENSATE PLAN FIRST FLOOR-NORTH END


PLAN PROGRESS
<input type="checkbox"/> DRAFT
<input type="checkbox"/> 35% REVIEW
<input type="checkbox"/> 65% REVIEW
<input type="checkbox"/> 95% REVIEW
<input type="checkbox"/> FINAL REVIEW
<input checked="" type="checkbox"/> FOR BIDDING
<input type="checkbox"/> ISSUED FOR CONSTRUCTION
<input type="checkbox"/> RECORD DRAWINGS

SHEET ID: M-118 SHEET: 97 of 126

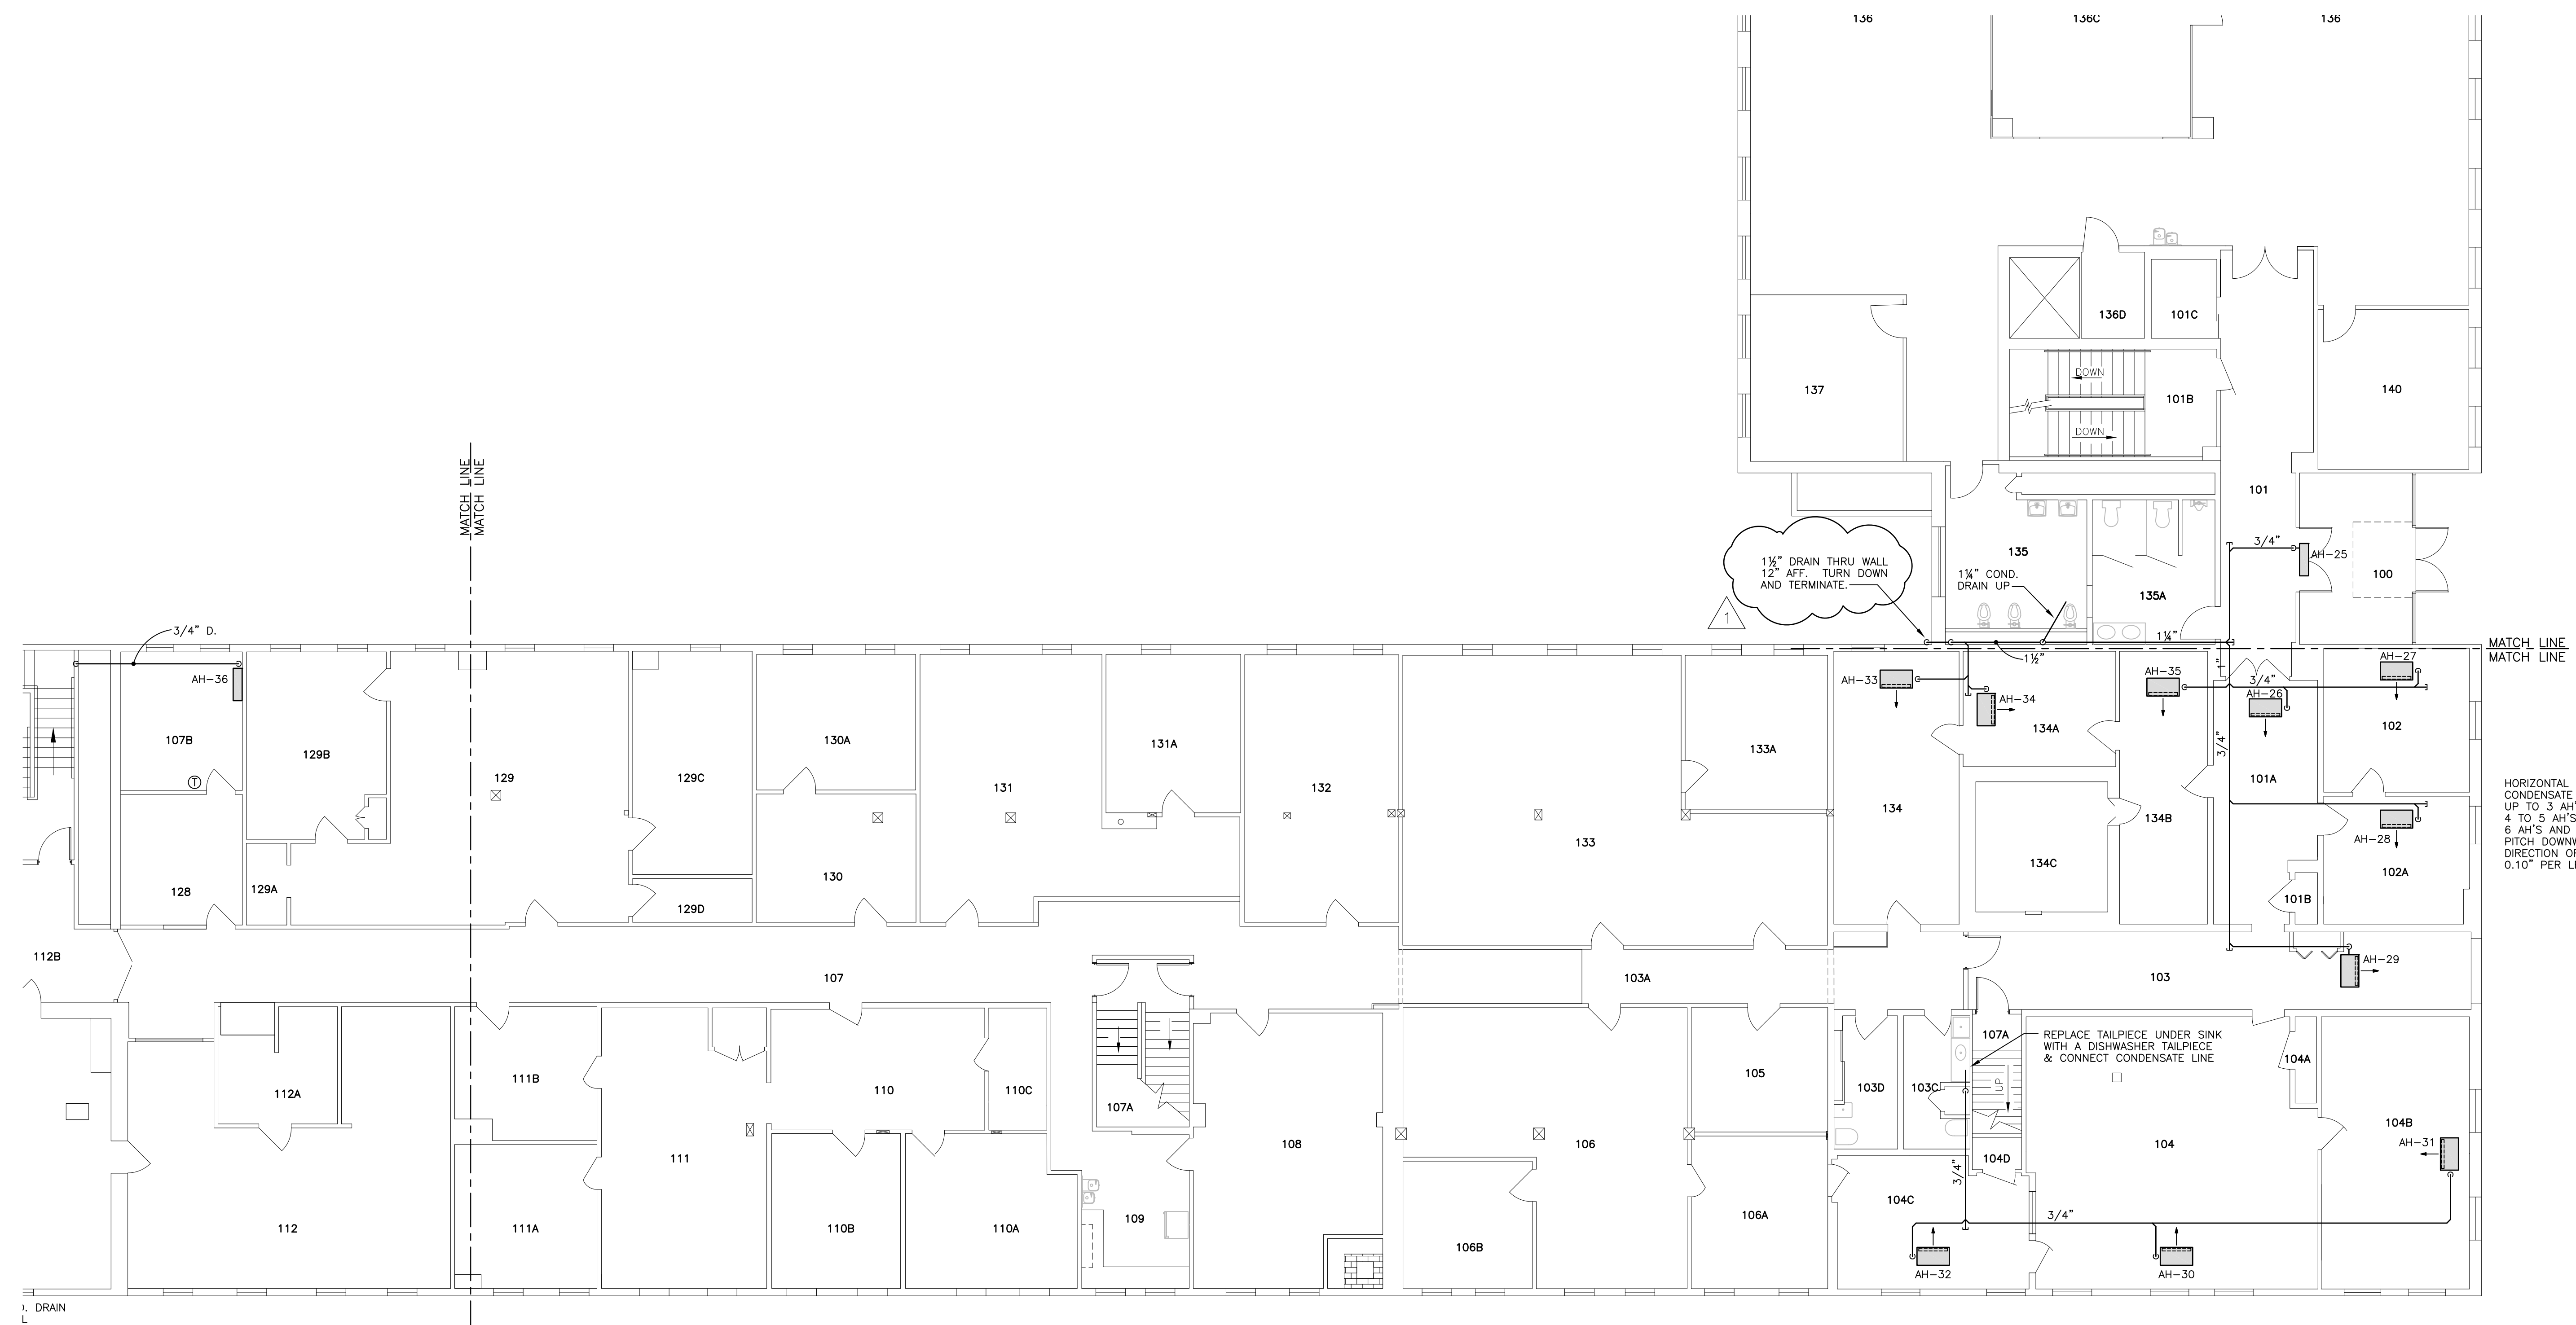


1 MECHANICAL CONDENSATE DRAIN PLAN
FIRST FLOOR-NORTH END
SCALE: 1/8" = 1'-0"

HORIZONTAL GRAVITY
CONDENSATE PIPE SIZING:
UP TO 3 AH'S = 3/4"
4 TO 5 AH'S = 1"
6 AH'S AND UP = 1 1/4"
PITCH DOWNWARD IN
DIRECTION OF FLOW
0.10" PER LF.

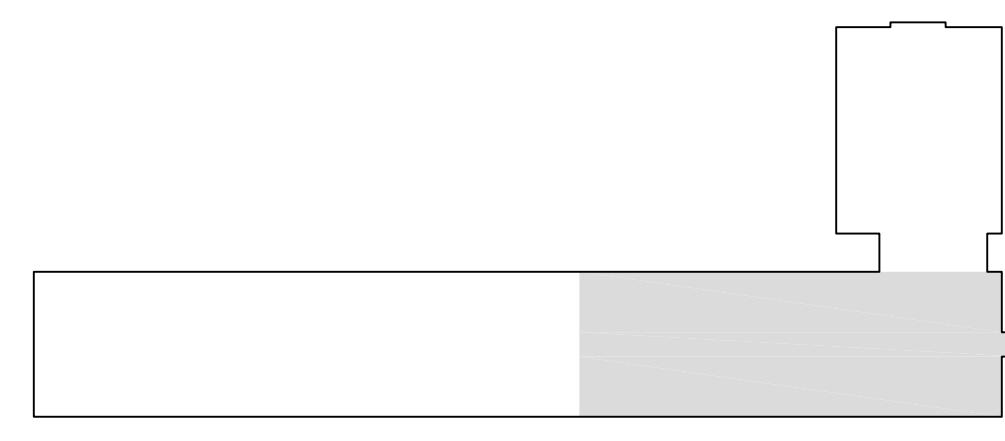


KEY PLAN
NO SCALE

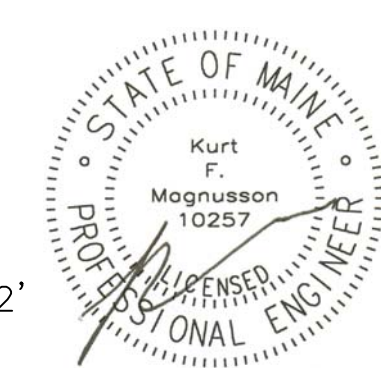

MECHANICAL SYSTEMS ENGINEERS
ROYAL RIVER CENTER, UNIT 108
10 FOREST FALLS DRIVE, YARMOUTH, MAINE 04096
(207) 846-1441
FACEBOOK: MECHANICAL SYSTEMS ENGINEERS
CELEBRATING 50 YEARS IN BUSINESS
© COPYRIGHT 2018



January 28, 2019 - 7:31 am
X:\Projects\1813 Camp Keyes Bldg 7\M115-M119 (01-24-2019).dwg

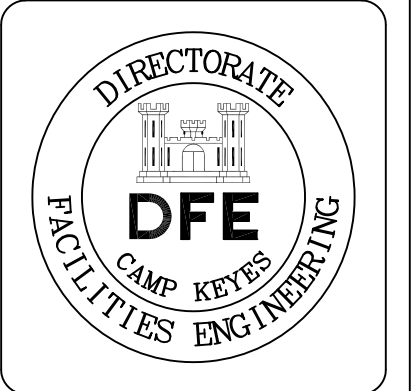


PLAN REVISIONS		1.28.19	Date	Appr.
1	GENERAL REVISIONS			

DESIGNED BY: REM	DRAWN BY: REM	CHECKED BY: KFM/MAD	DATE: 12/28/2018	SCALE: AS NOTED	DFE PROJECT NO: 235F18-458-D
STATE OF MAINE DEPARTMENT OF DEFENSE, VETERANS AND EMERGENCY MANAGEMENT					
Cordja Capital Projects Group 16 Tannery Lane, Suite 23 Camden, Maine 04843 207-236-9970 / mdsigle@cordjagp.com					


CAMP KEYES REUTILIZATION PROJECT CAMP KEYES, AUGUSTA, MAINE	BUILDING NO. 7 RENOVATIONS
ENLARGED BOILER ROOM 003 MECHANICAL PLAN AND DETAILS	

PLAN PROGRESS	
<input type="checkbox"/> DRAFT	<input type="checkbox"/> 35% REVIEW
<input type="checkbox"/> 65% REVIEW	<input type="checkbox"/> 95% REVIEW
<input type="checkbox"/> FINAL REVIEW	<input checked="" type="checkbox"/> FOR BIDDING
<input type="checkbox"/> ISSUED FOR CONSTRUCTION	<input type="checkbox"/> RECORD DRAWINGS


SHEET ID:
M-201
SHEET: 99 OF 126

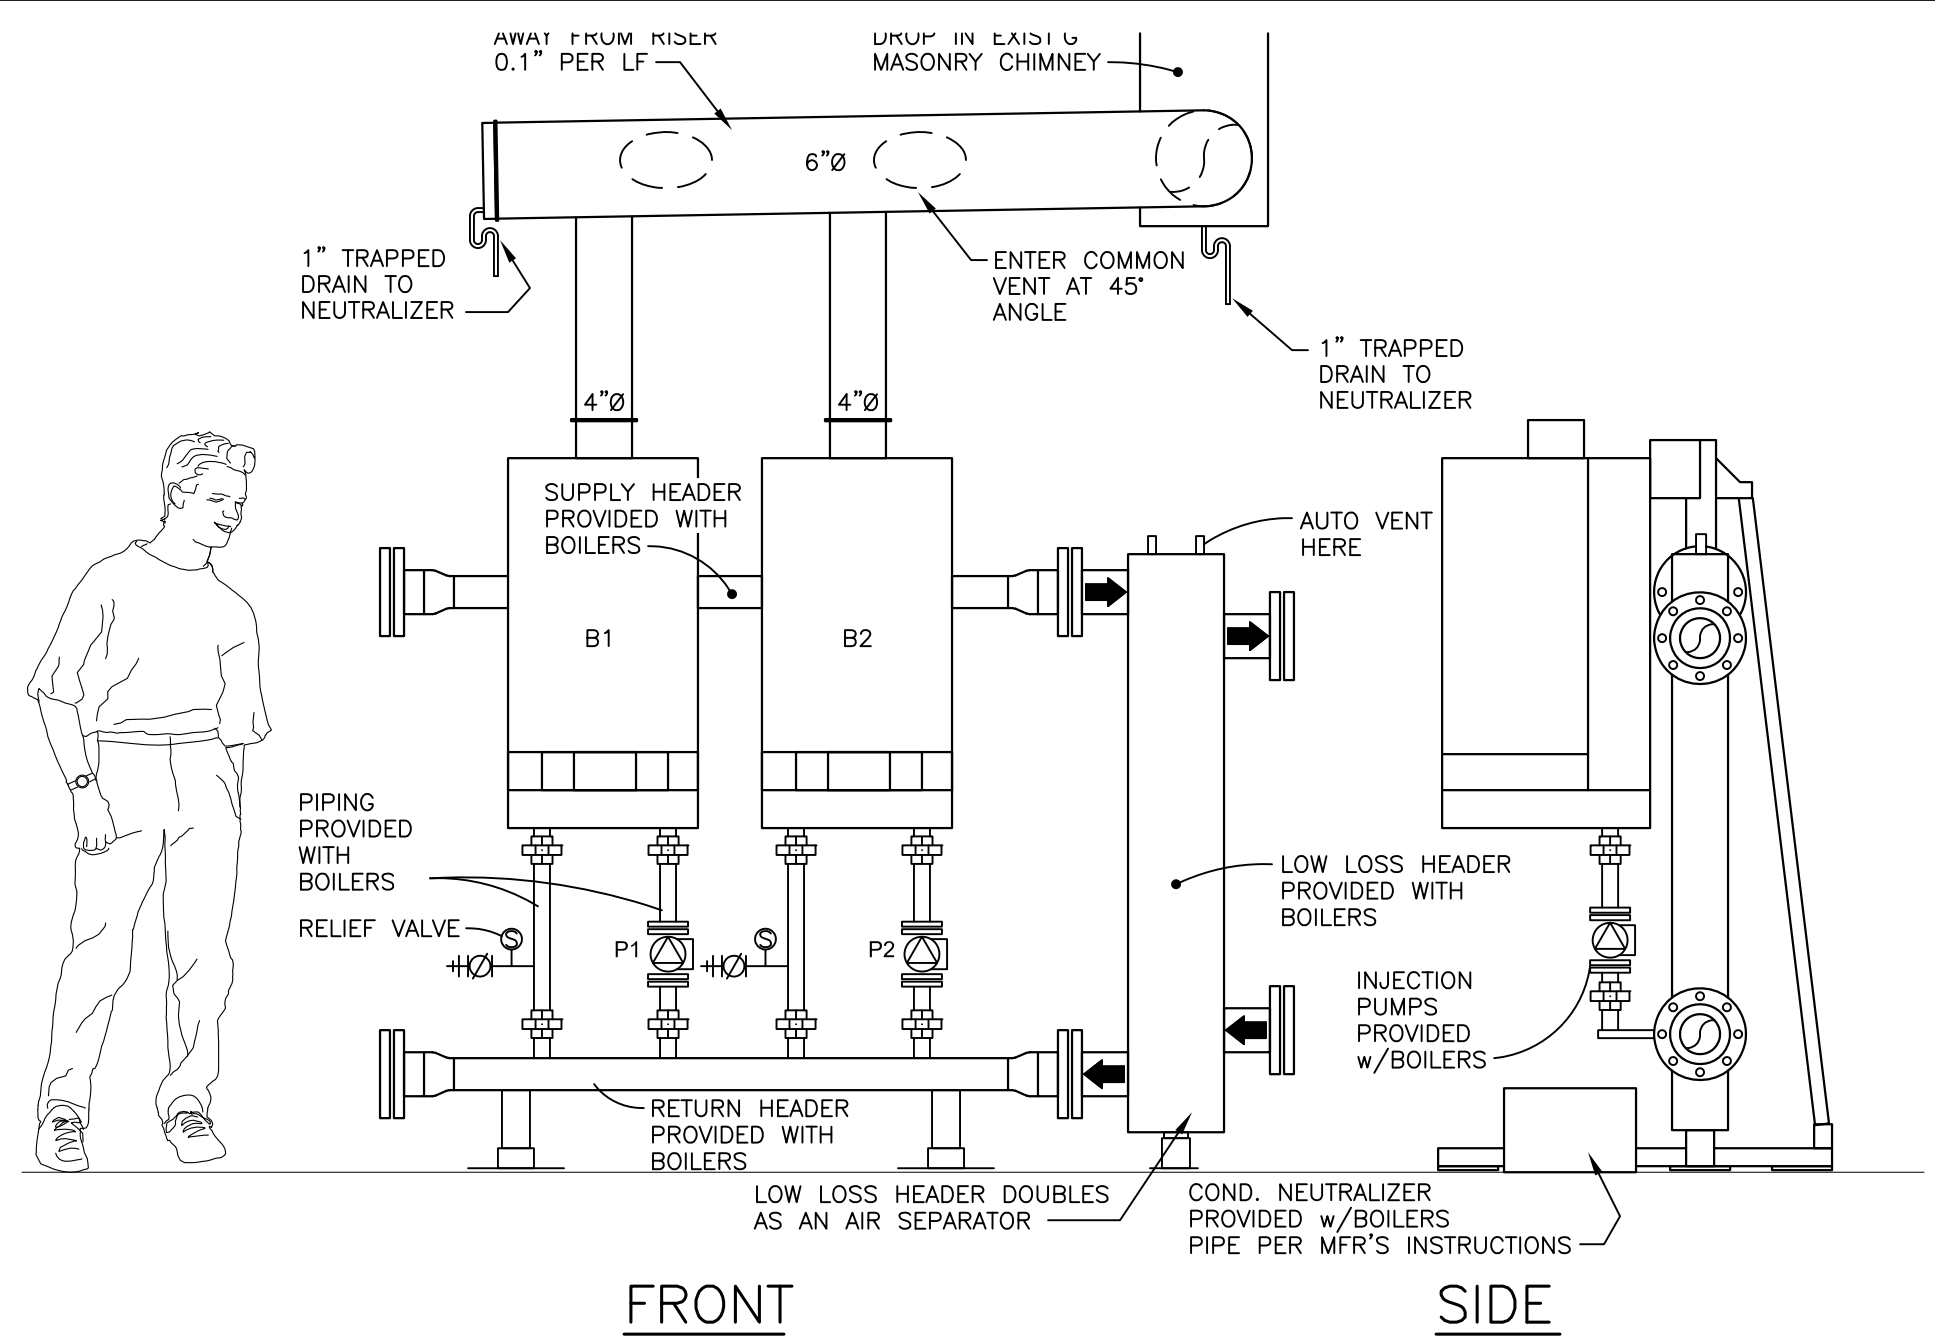


2 BOILER PIPING AND VENTING DIAGRAM
NO SCALE

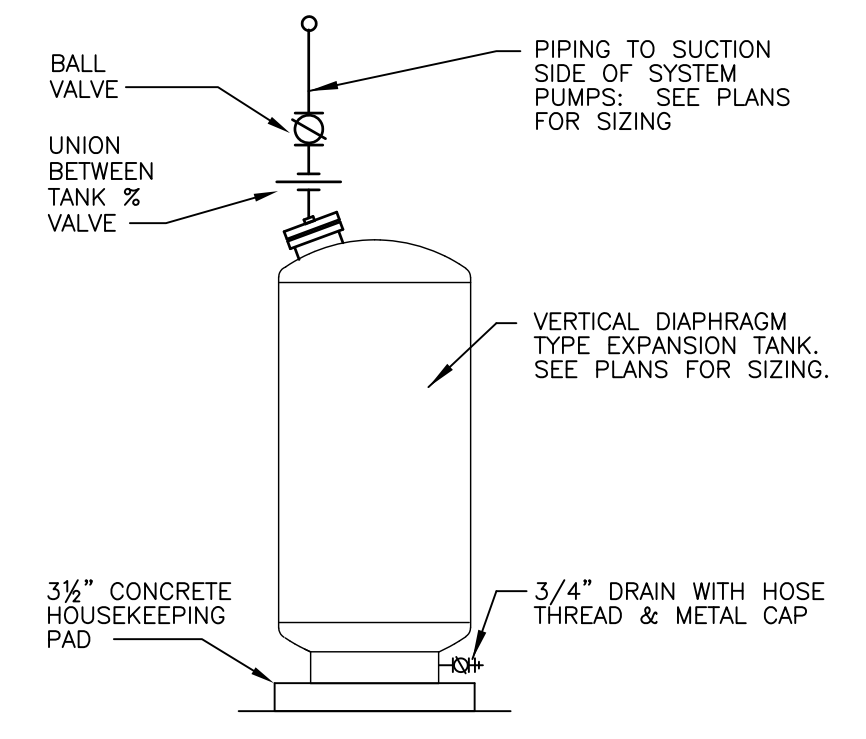


1 DIAPHRAGM TYPE EXPANSION TANK
NO SCALE

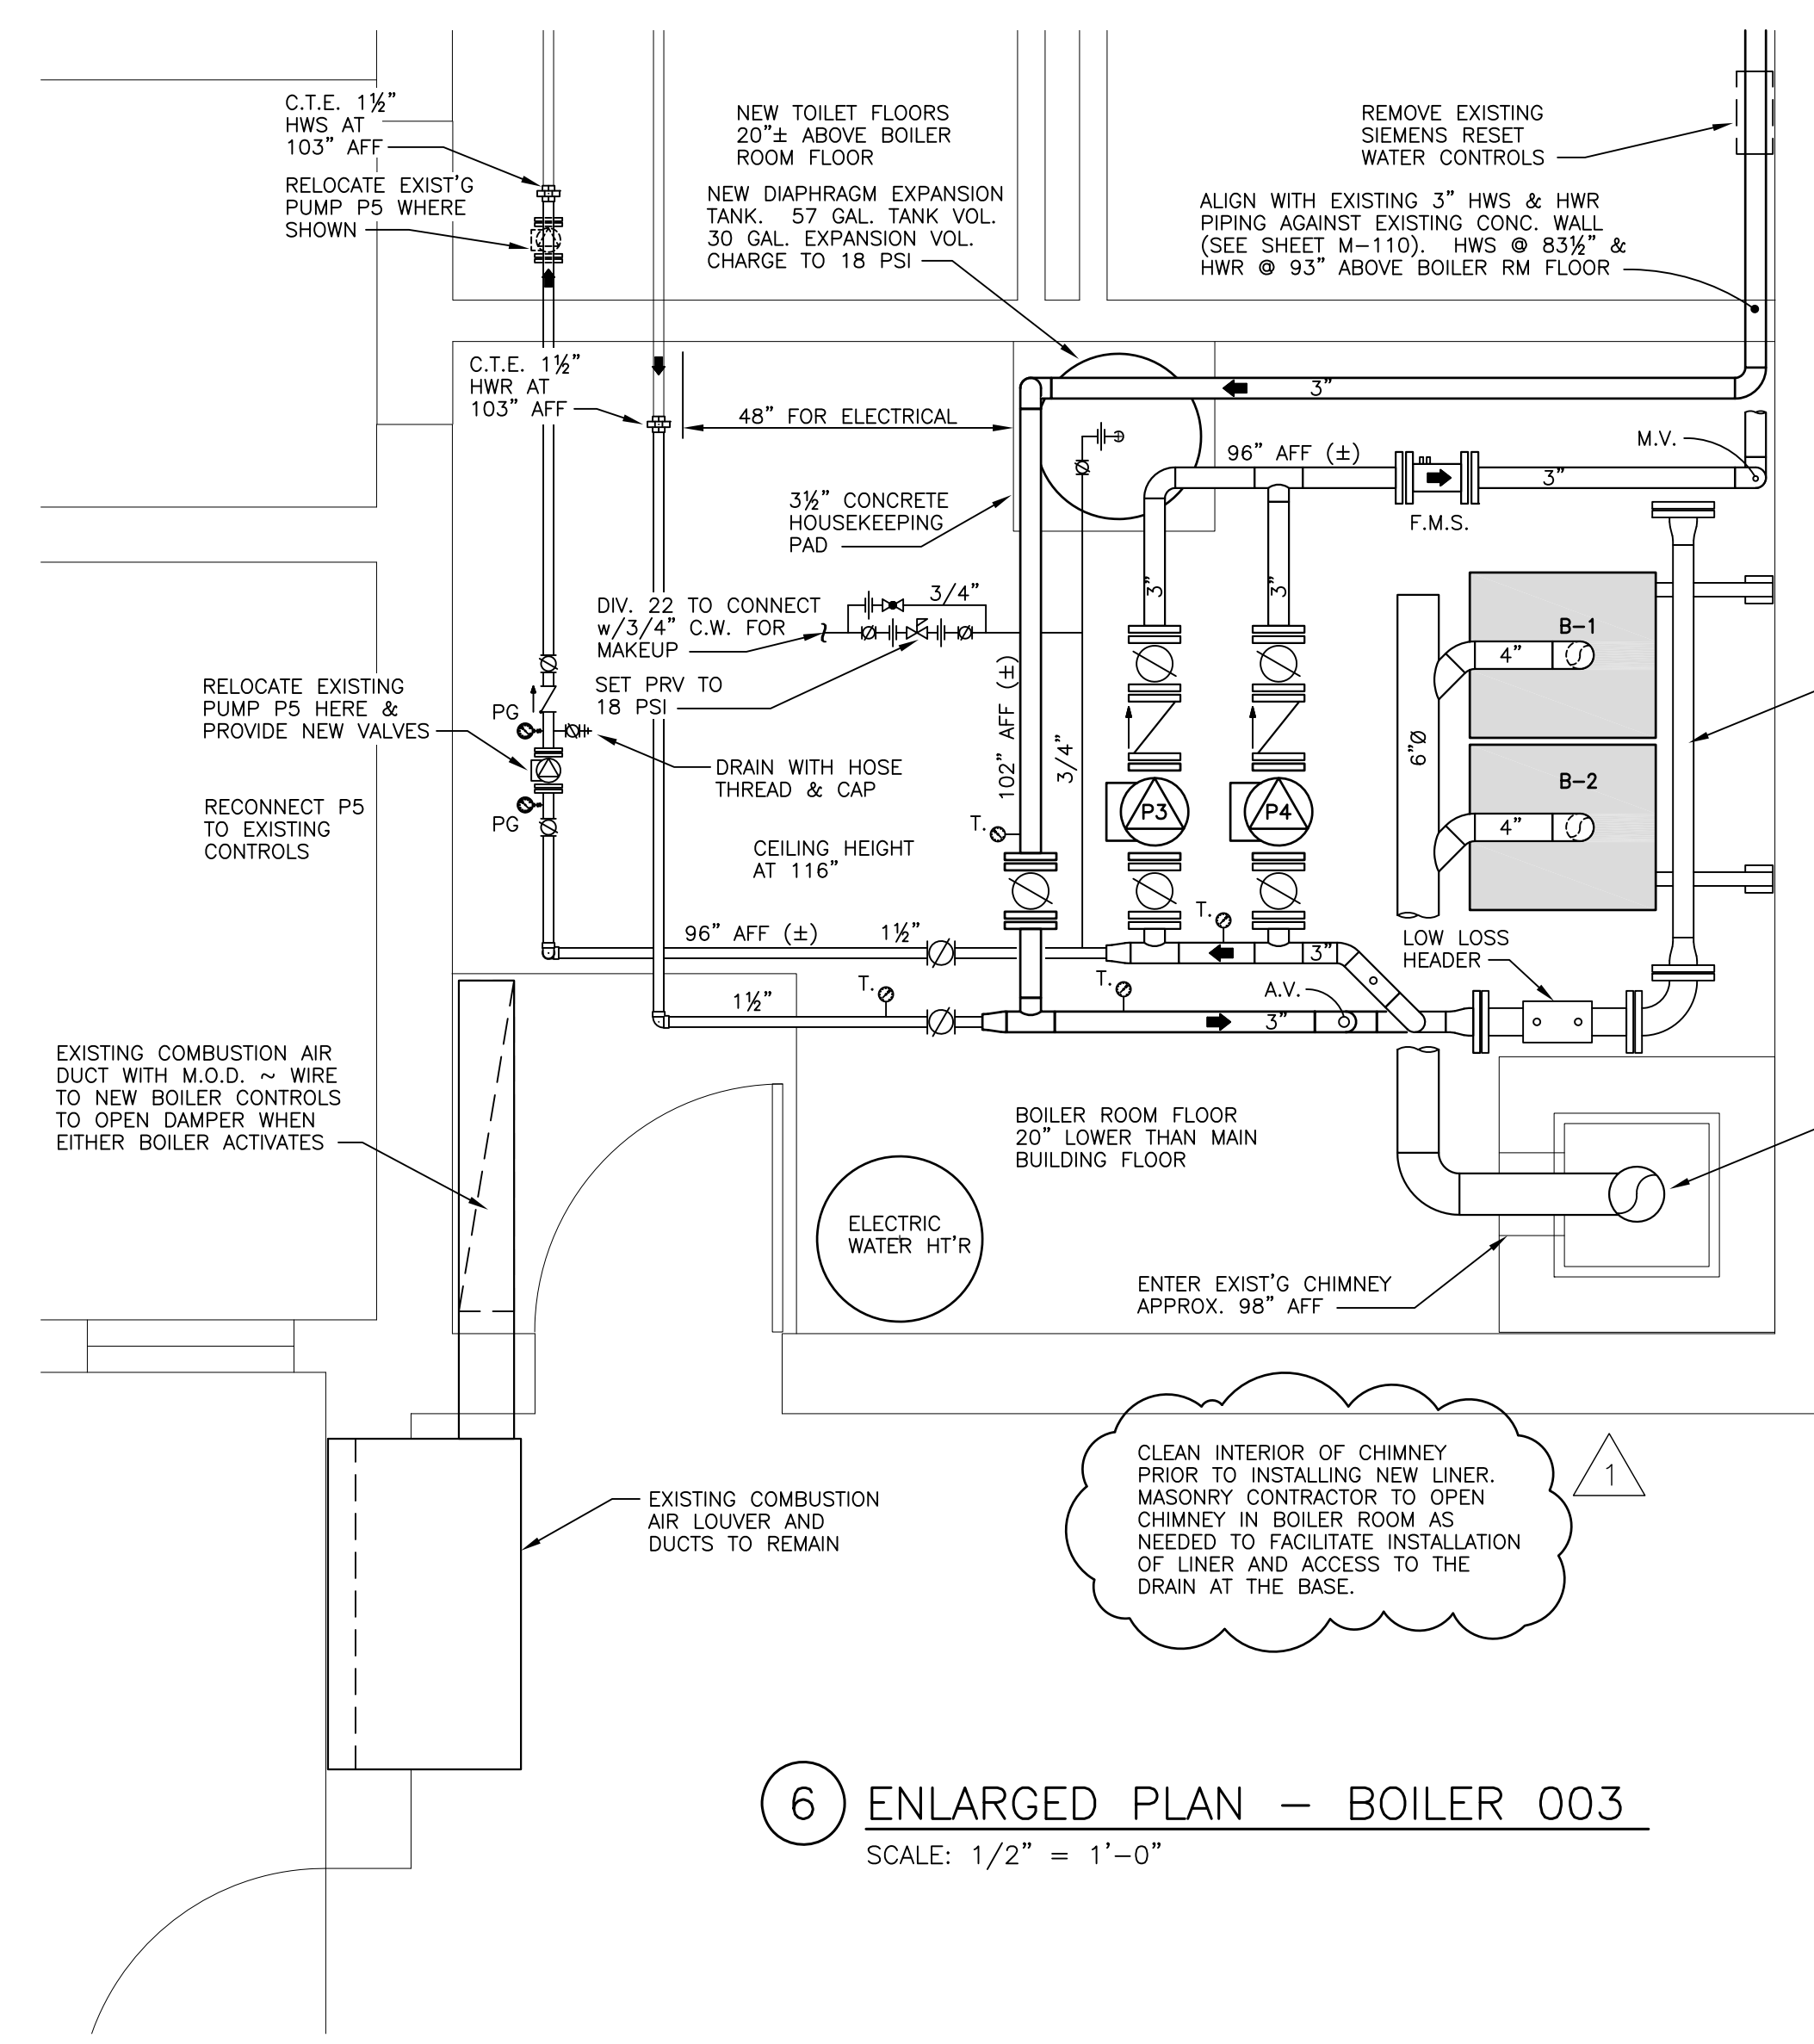

6 ENLARGED PLAN - BOILER 003
SCALE: 1/2" = 1'-0"

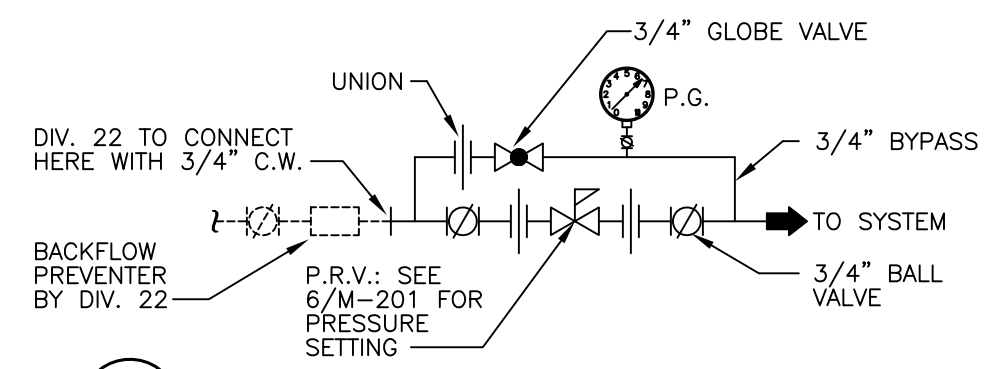


3 HEATING SYSTEM WATER MAKE-UP DETAIL
NO SCALE

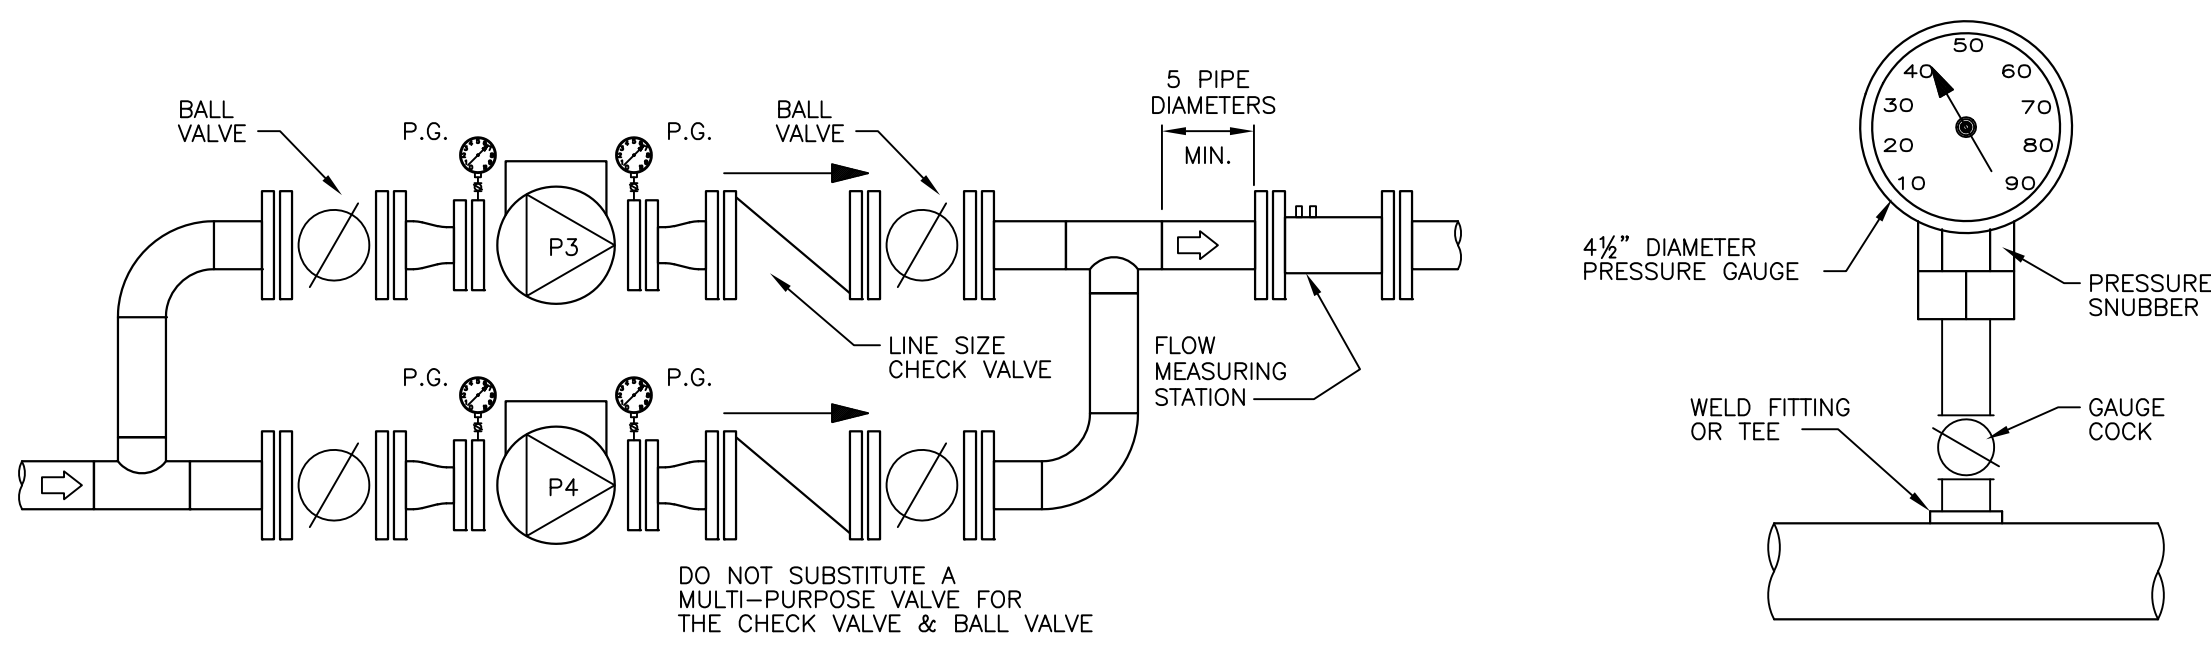


4 GENERAL DIAGRAM - PUMPS P3 & P4
NO SCALE


5 WATER PRESSURE GAUGE
NO SCALE

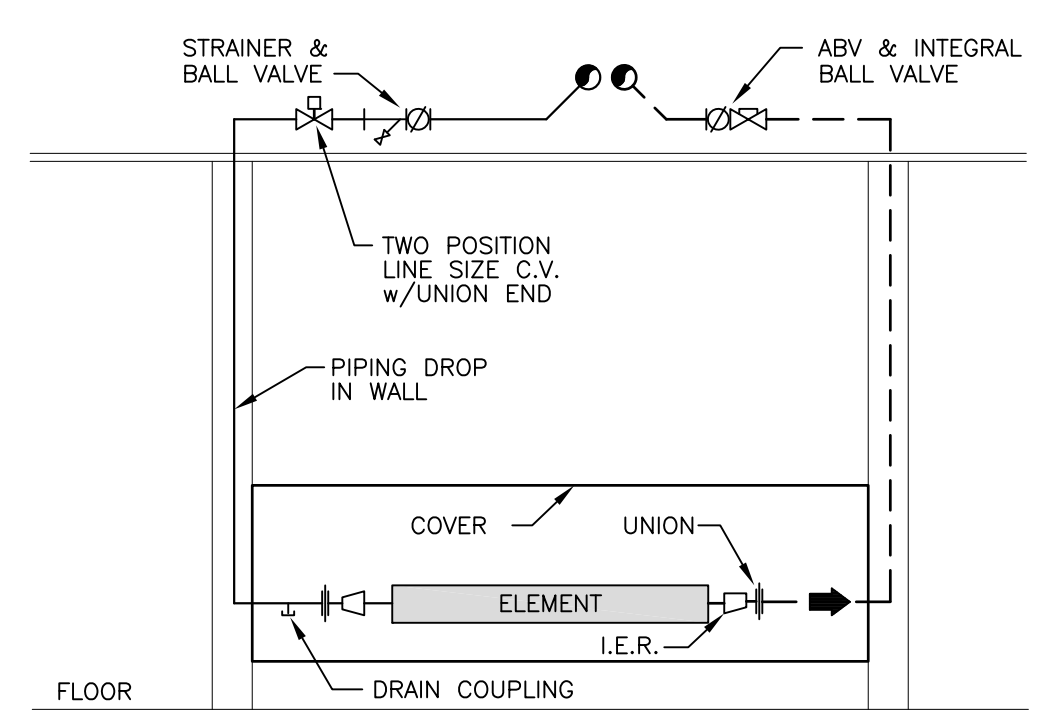

7 DOWNFEED FINNED PIPE OPPOSITE END FEED
NO SCALE ANNEX BUILDING

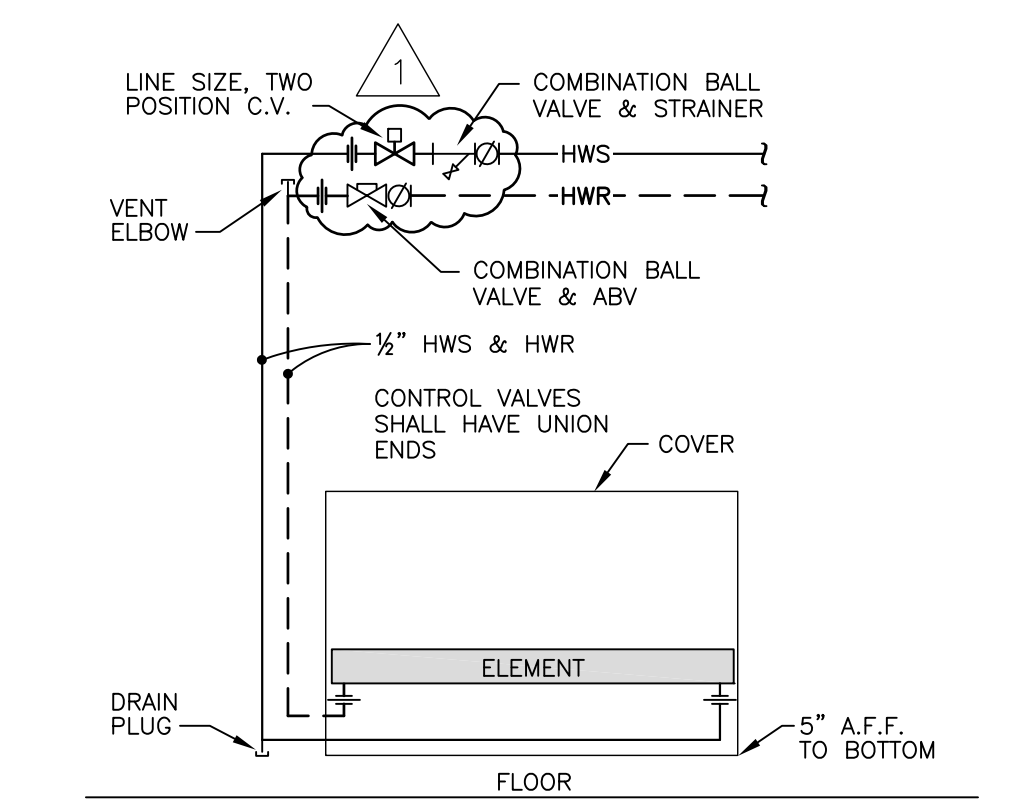


9 DOWNFEED CONVECTOR PIPING
NO SCALE

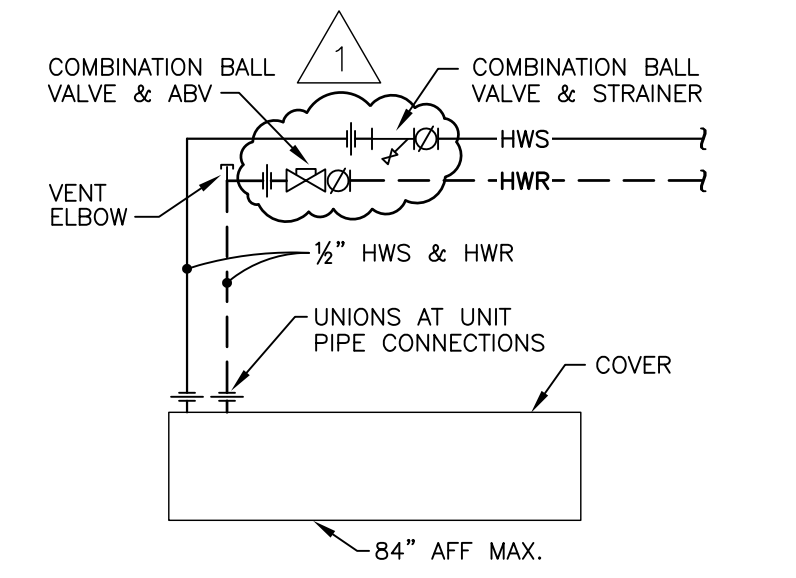


11 CABINET UNIT HEATER PIPING
NO SCALE




13 EXISTING SIEMENS RESET WATER CONTROLS TO BE REMOVED
NO SCALE

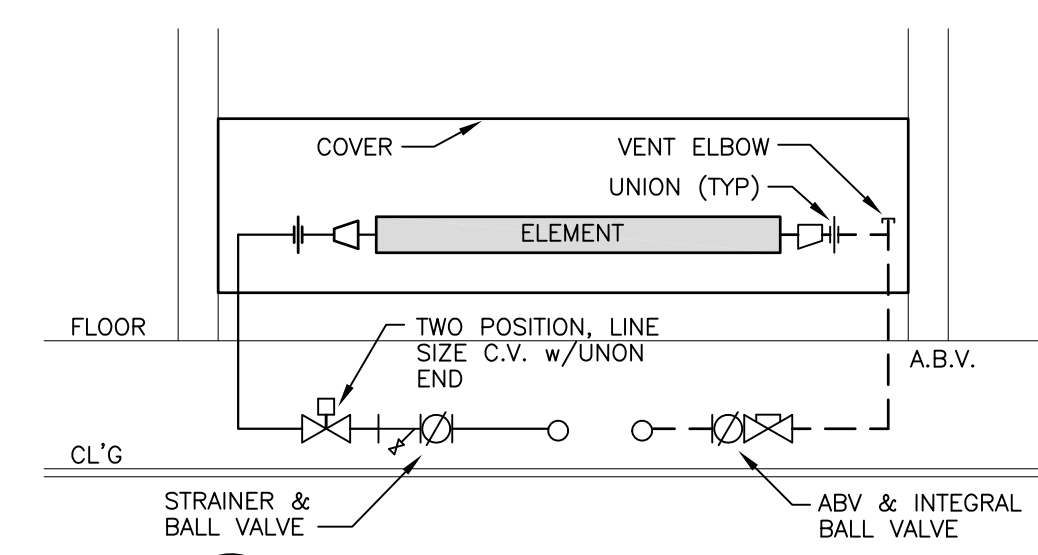



8 UPFEED FINNED PIPE OPPOSITE END FEED
NO SCALE ANNEX BUILDING

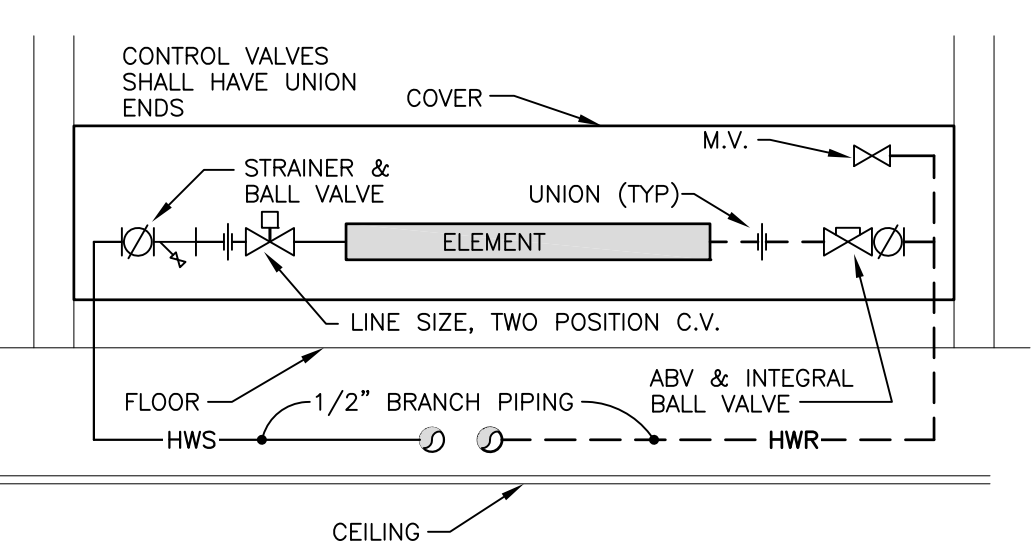

10 UPFEED FINNED PIPE OPPOSITE END FEED
NO SCALE ROOM 212C

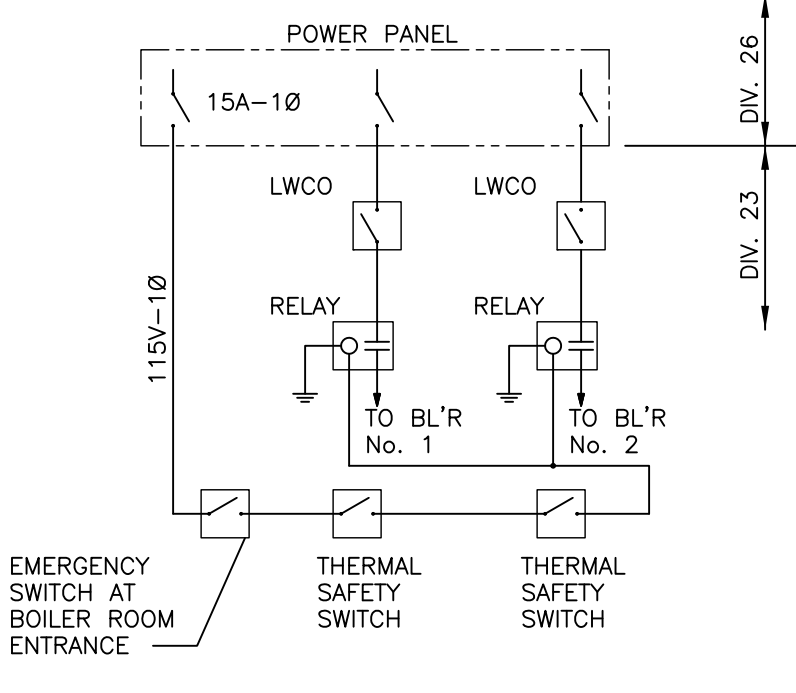


12 BOILER POWER WIRING
NO SCALE

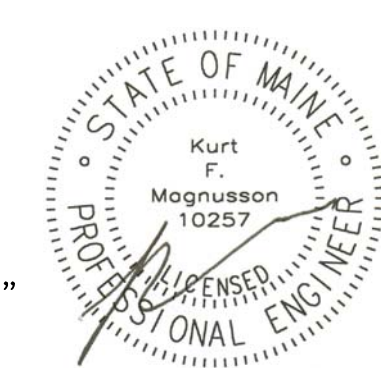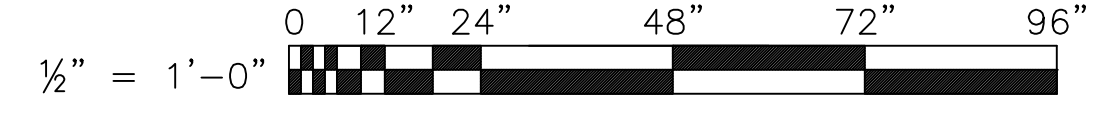


MECHANICAL SYSTEMS ENGINEERS
ROYAL RIVER CENTER, UNIT 108
10 FOREST FALLS DRIVE, YARMOUTH, MAINE 04096
(207) 846-1441
FACEBOOK: MECHANICAL SYSTEMS ENGINEERS
CELEBRATING 50 YEARS IN BUSINESS
© COPYRIGHT 2018




January 28, 2019 - 7:32 am
X:\Projects\1813 Camp Keyes Bldg 7\Address\1813 Bldg 7 M201-M202 (01-24-2019).dwg

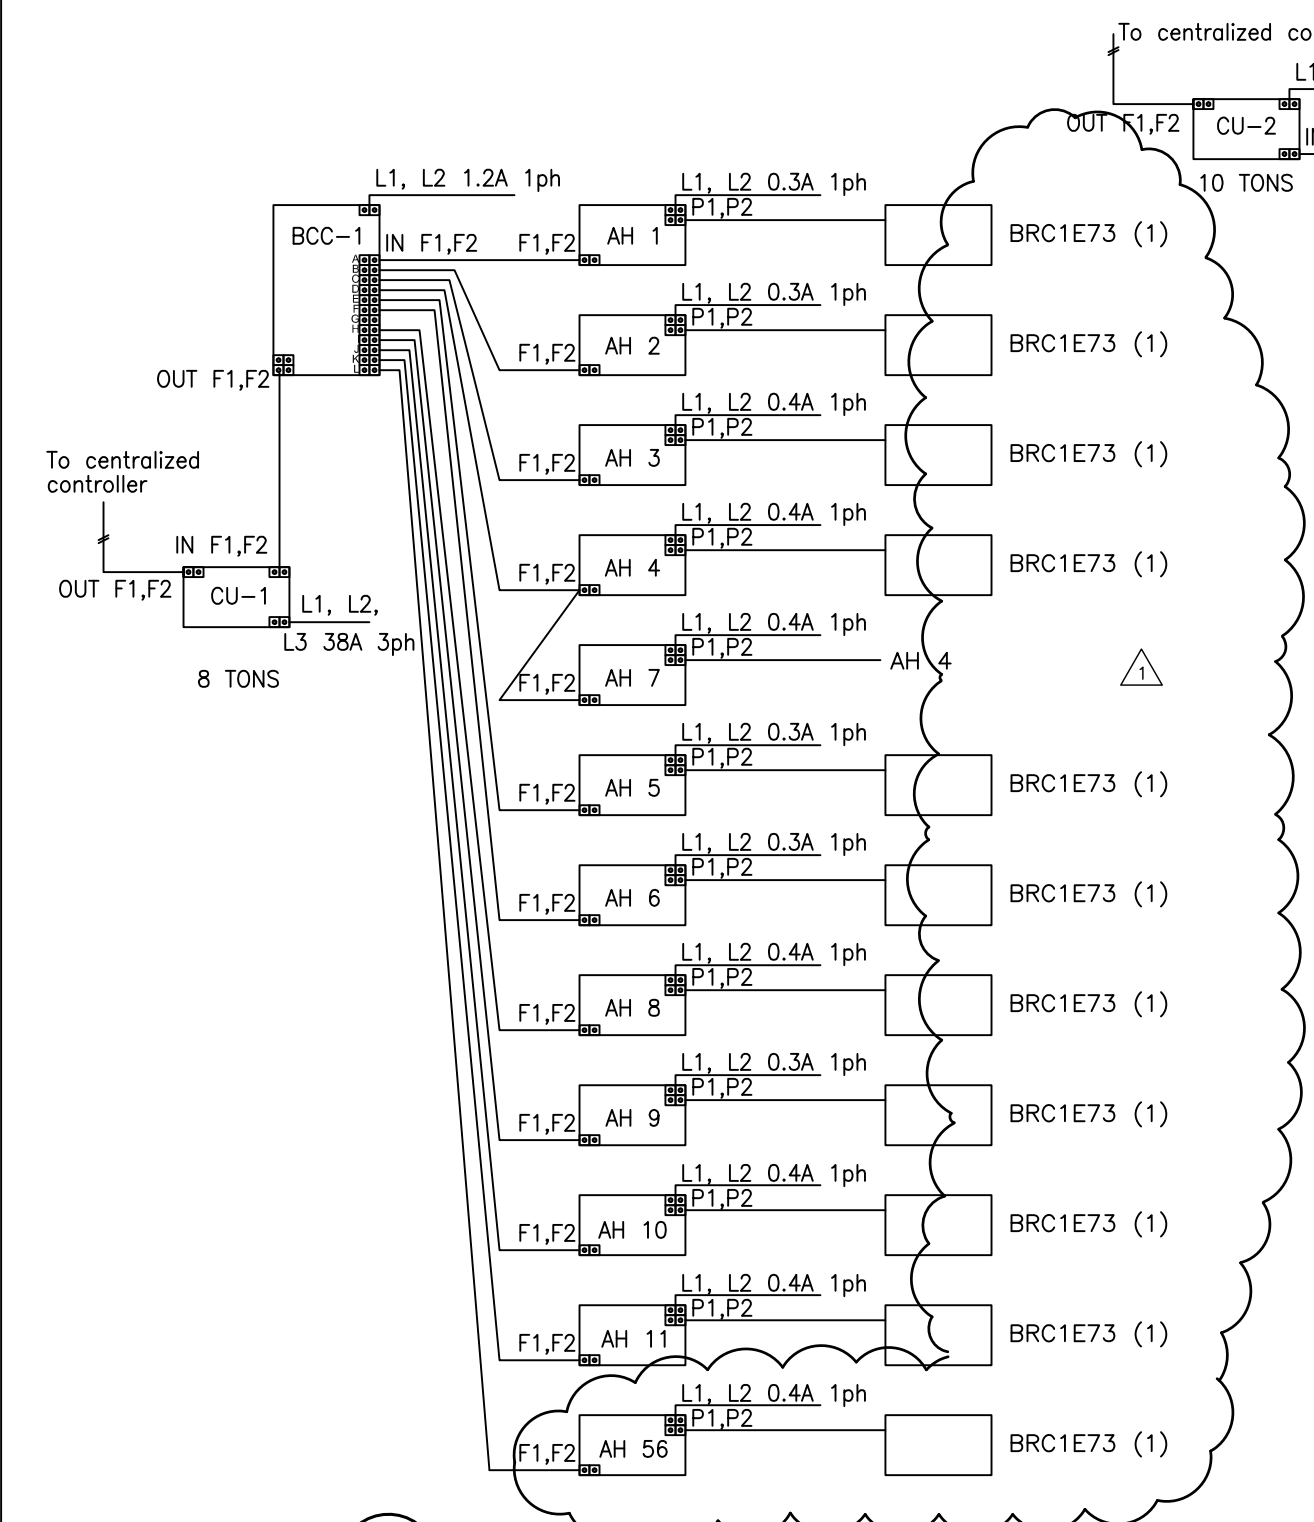


1 SYSTEM CONTROL DIAGRAM CU-1 NO SCALE

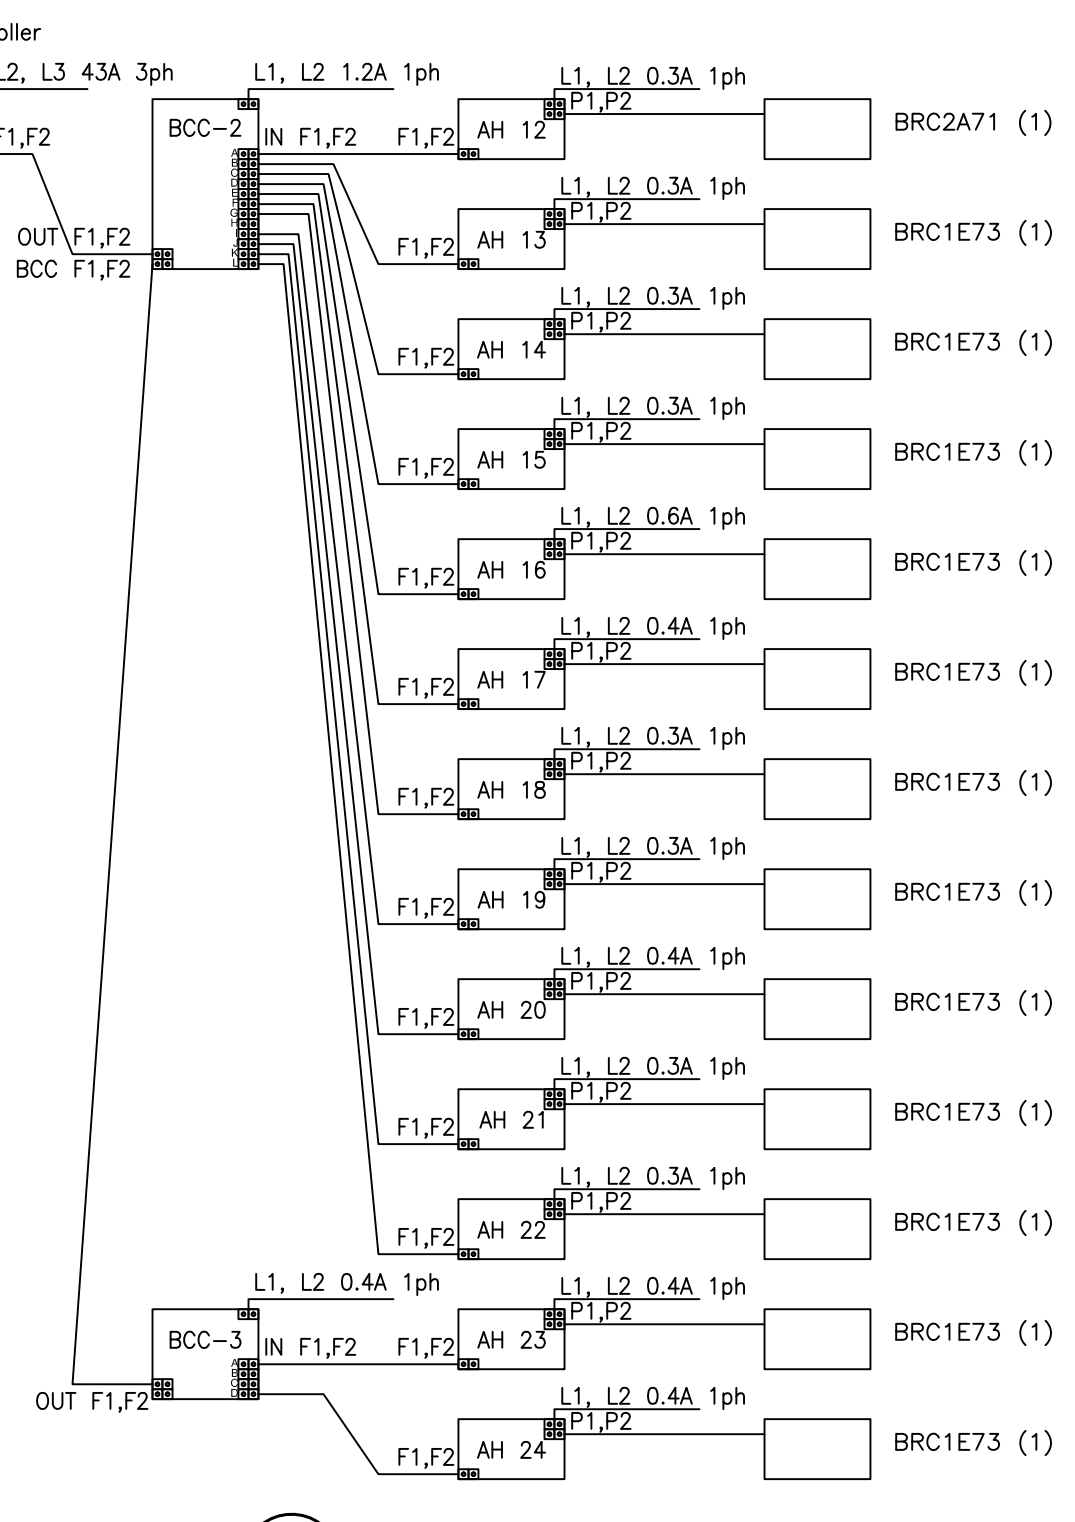


2 SYSTEM CONTROL DIAGRAM CU-2 NO SCALE

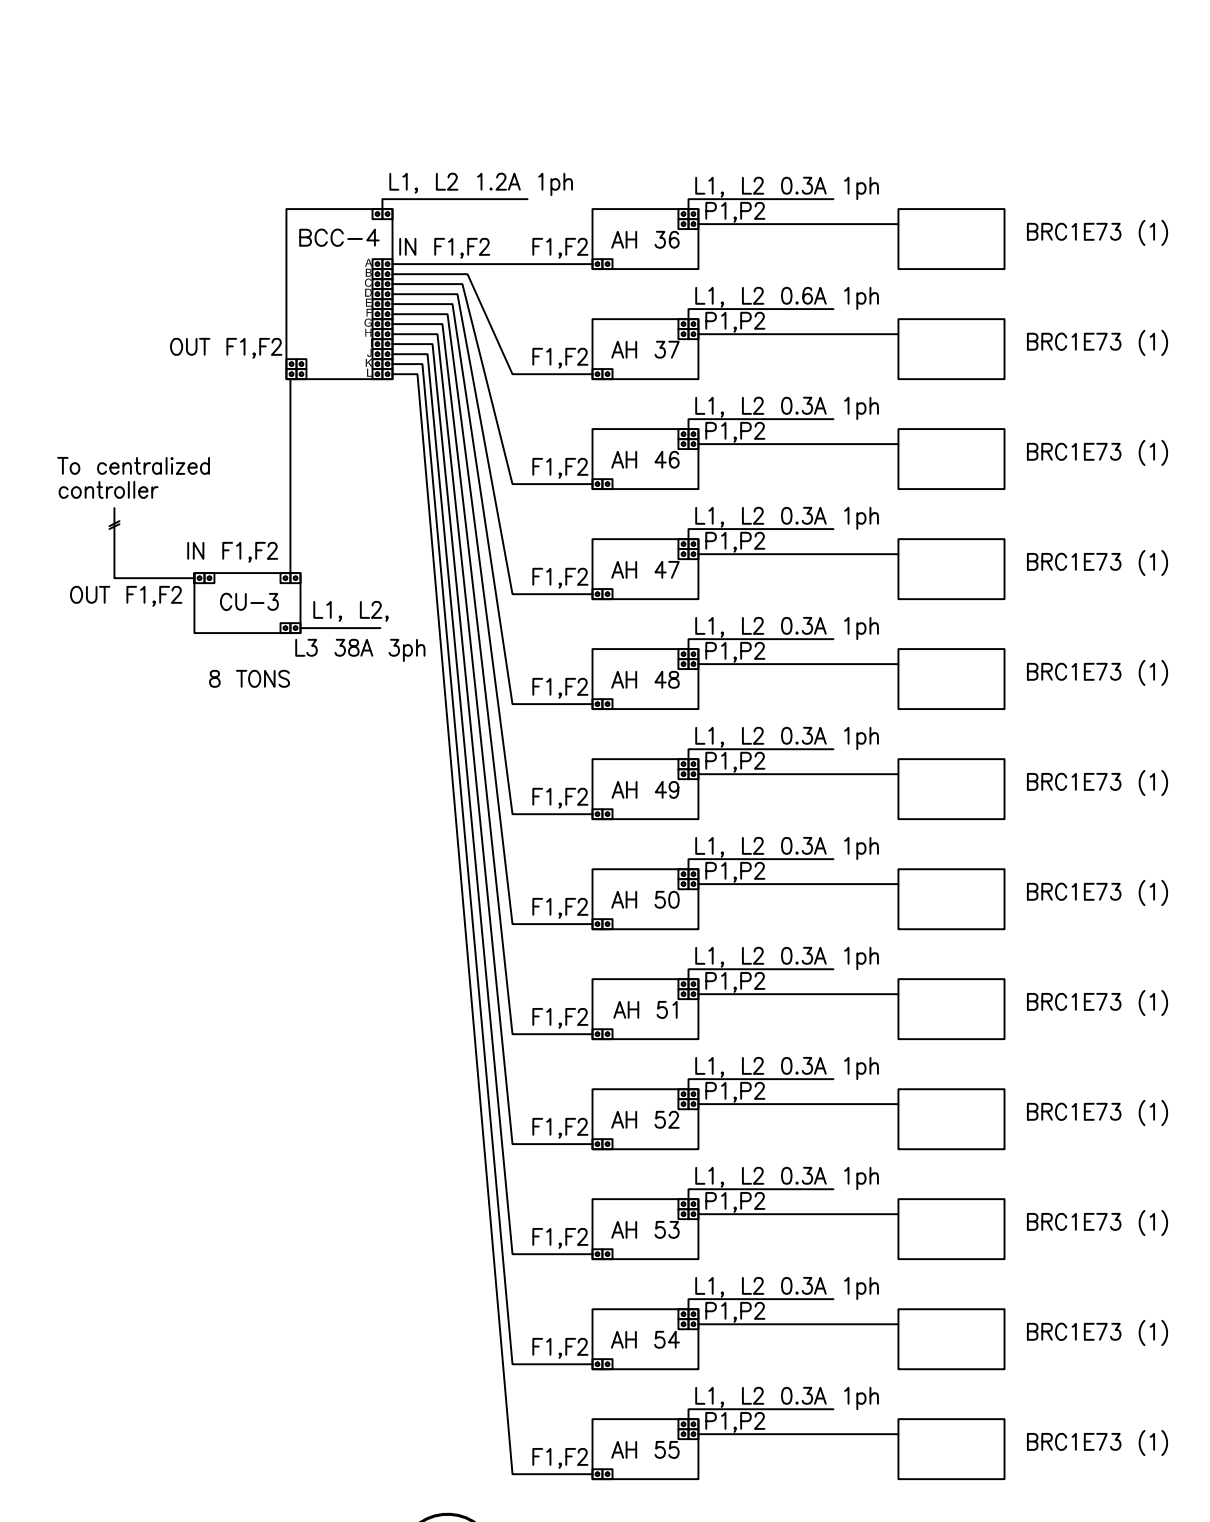


3 SYSTEM CONTROL DIAGRAM CU-3 NO SCALE

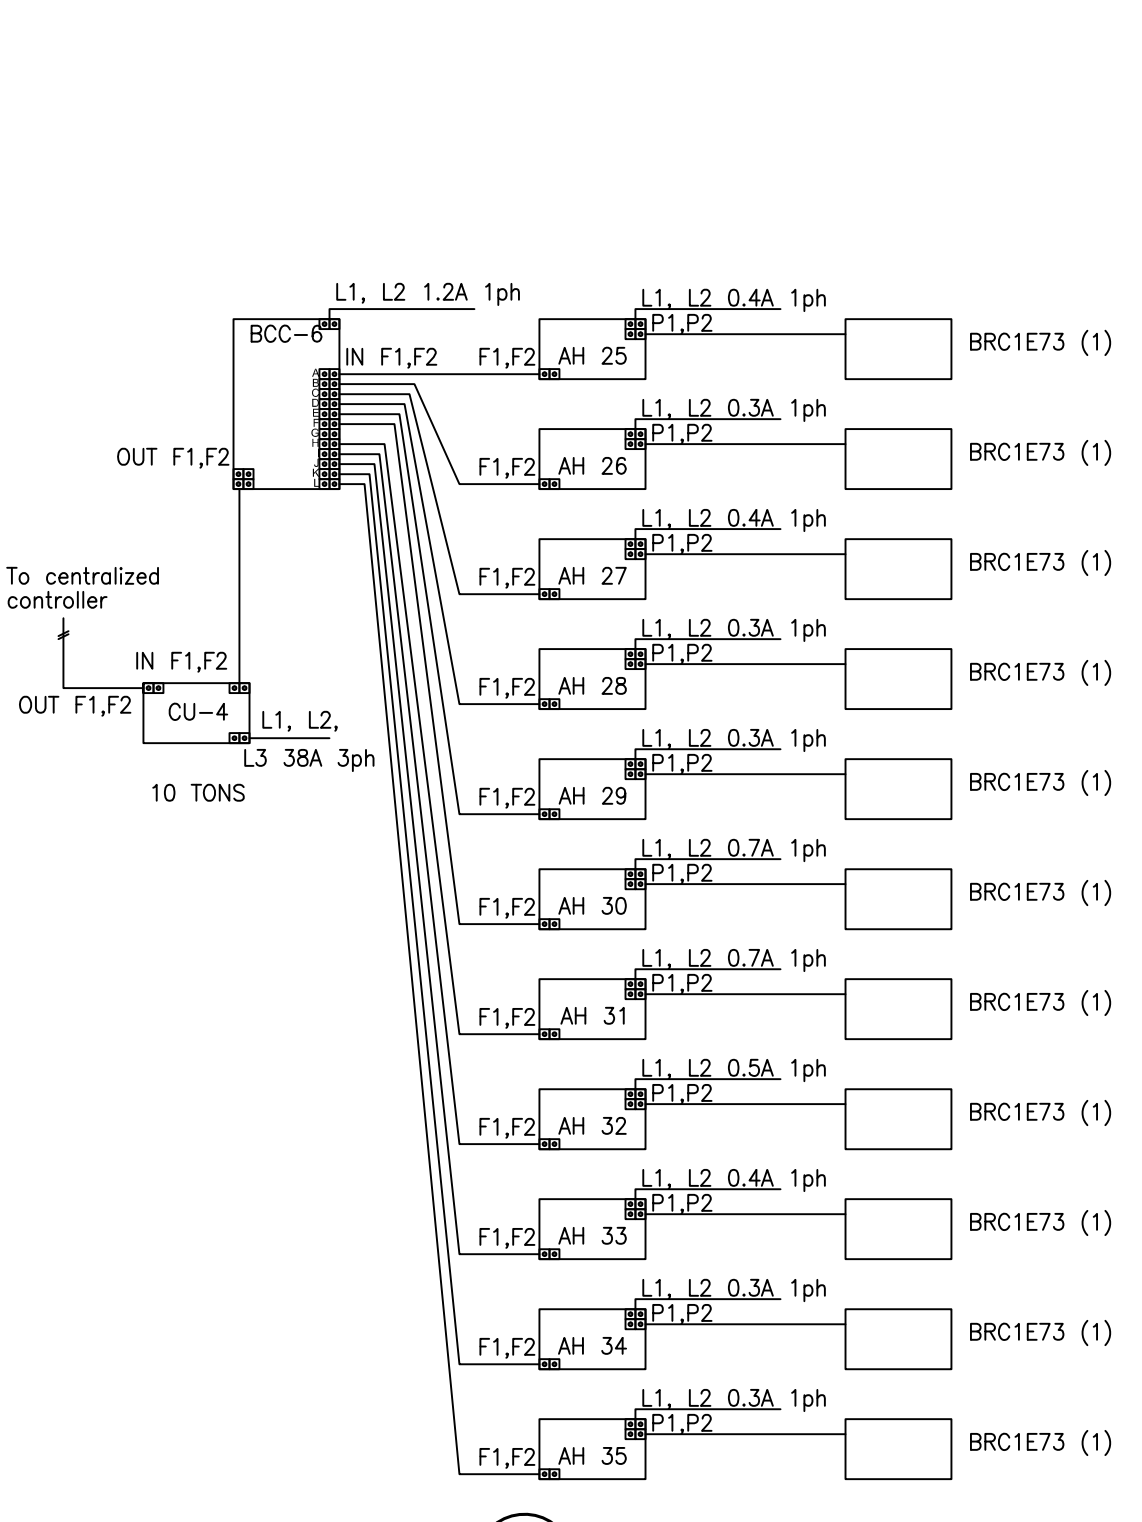


4 SYSTEM CONTROL DIAGRAM CU-4 NO SCALE

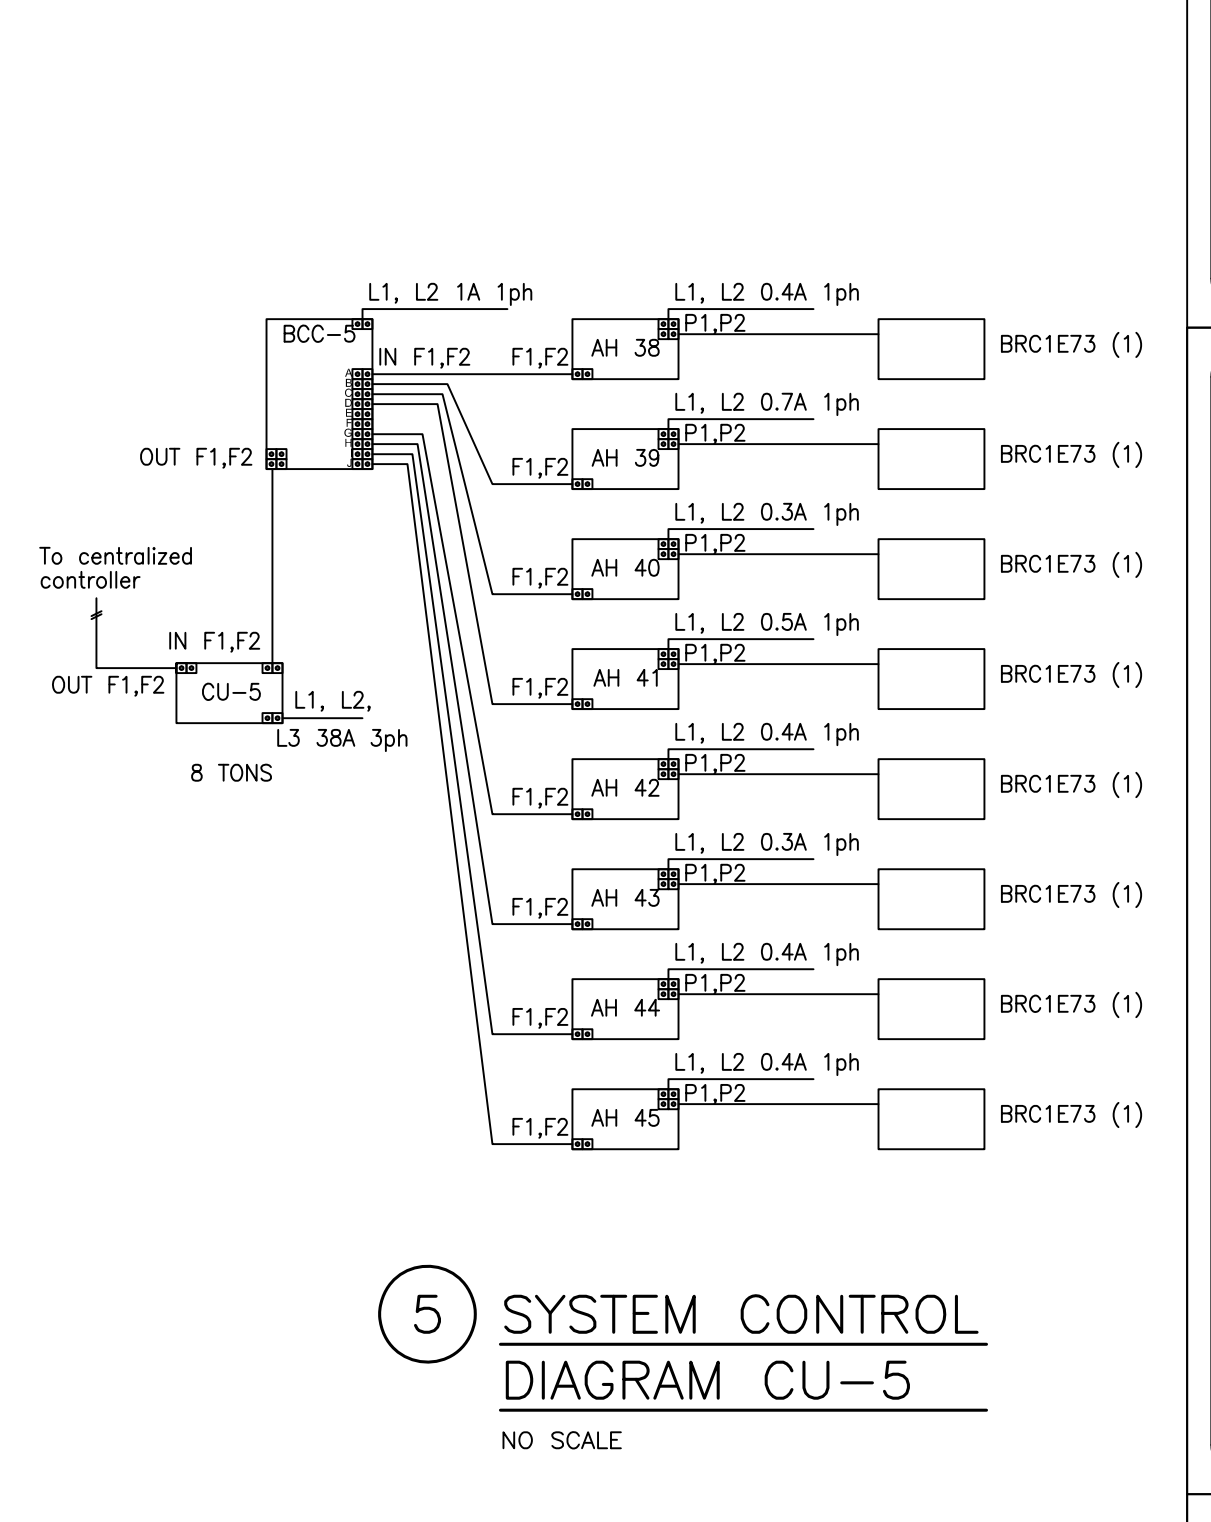


5 SYSTEM CONTROL DIAGRAM CU-5 NO SCALE

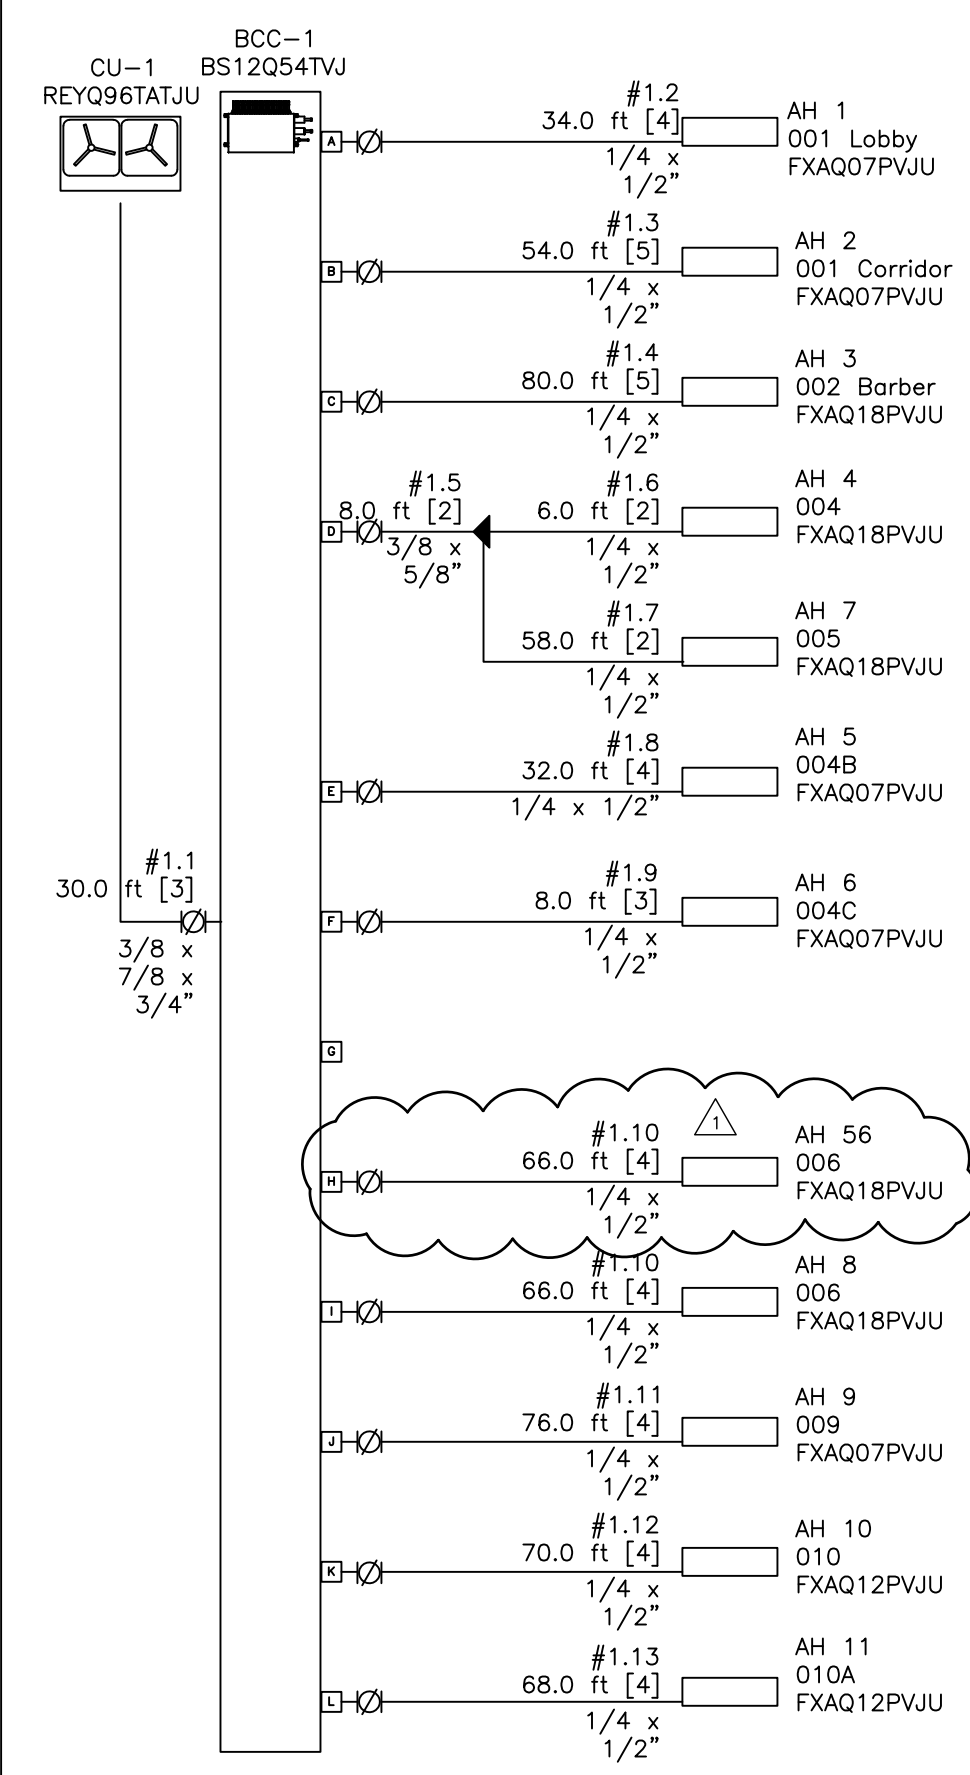


6 SYSTEM PIPING DIAGRAM OU-1 NO SCALE

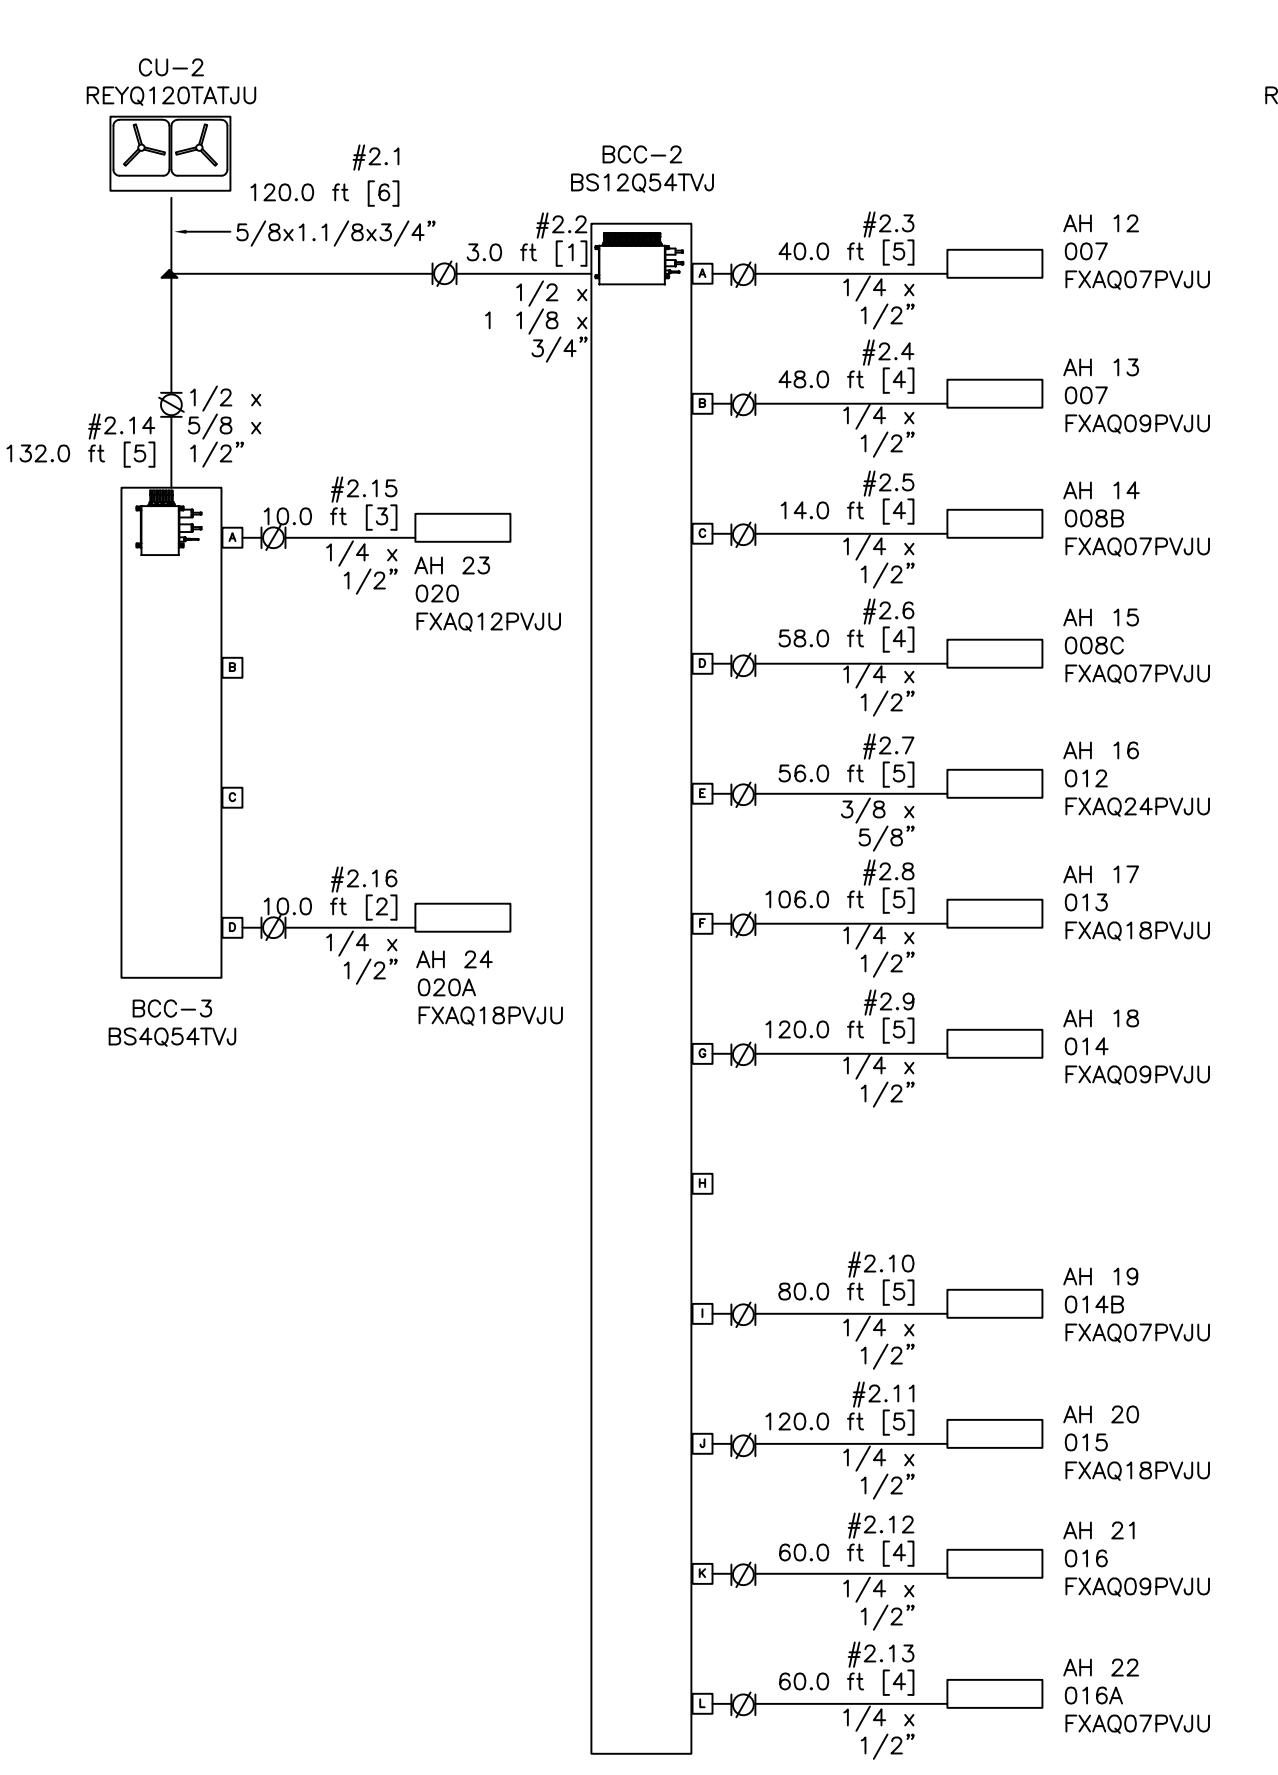


7 SYSTEM PIPING DIAGRAM CU-2 NO SCALE

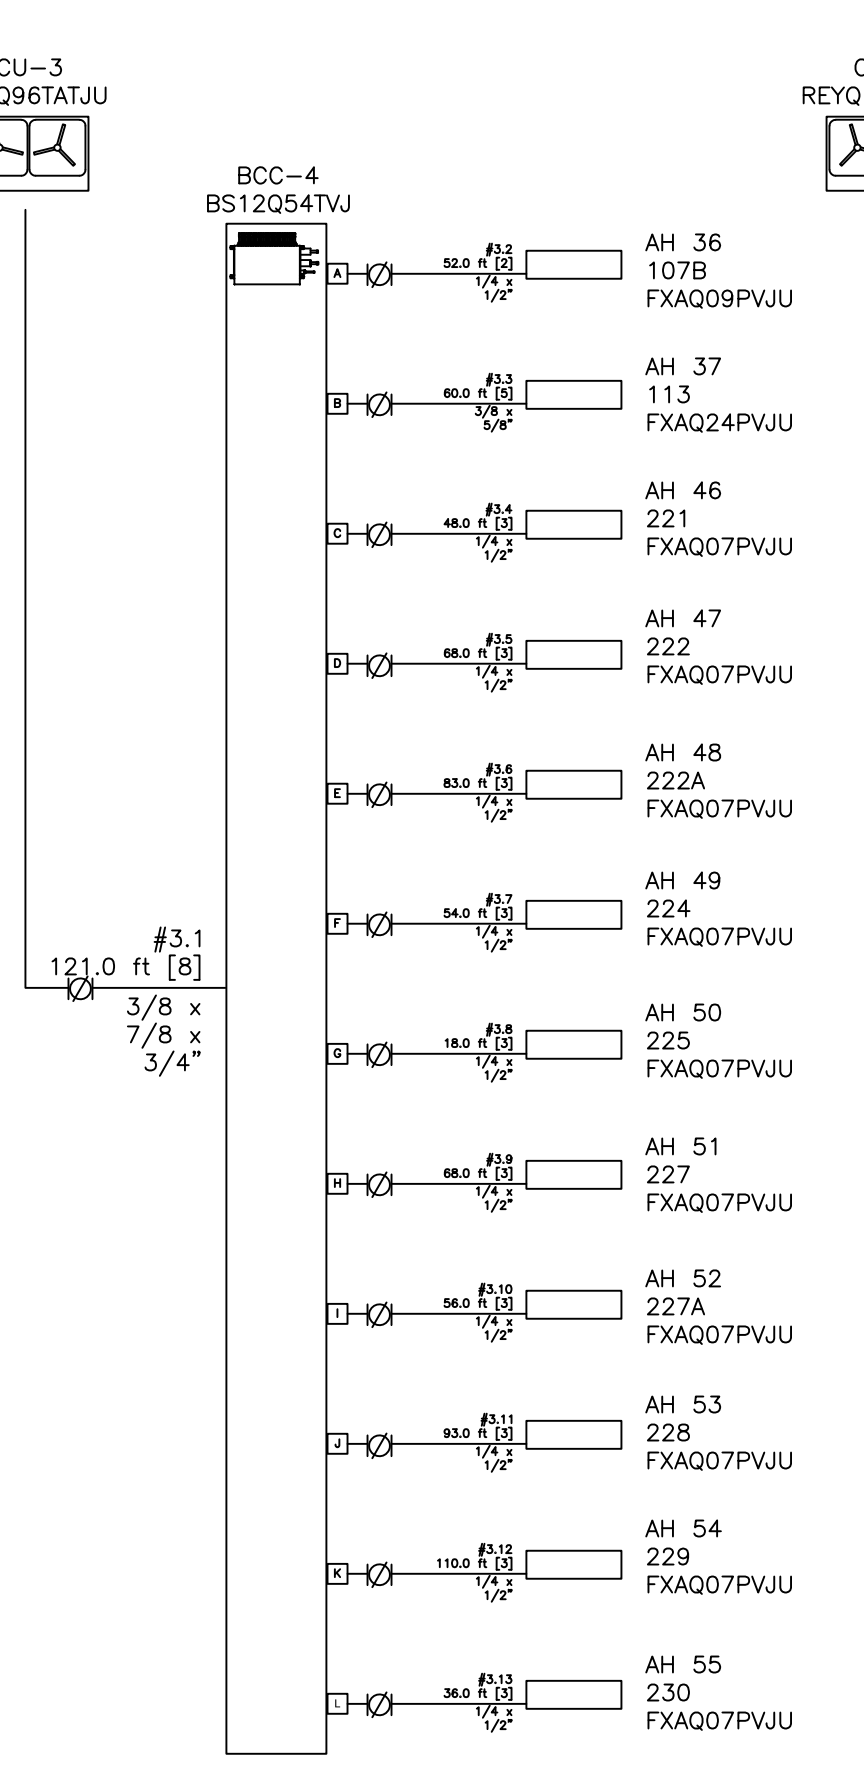


8 SYSTEM PIPING DIAGRAM OU-3 NO SCALE

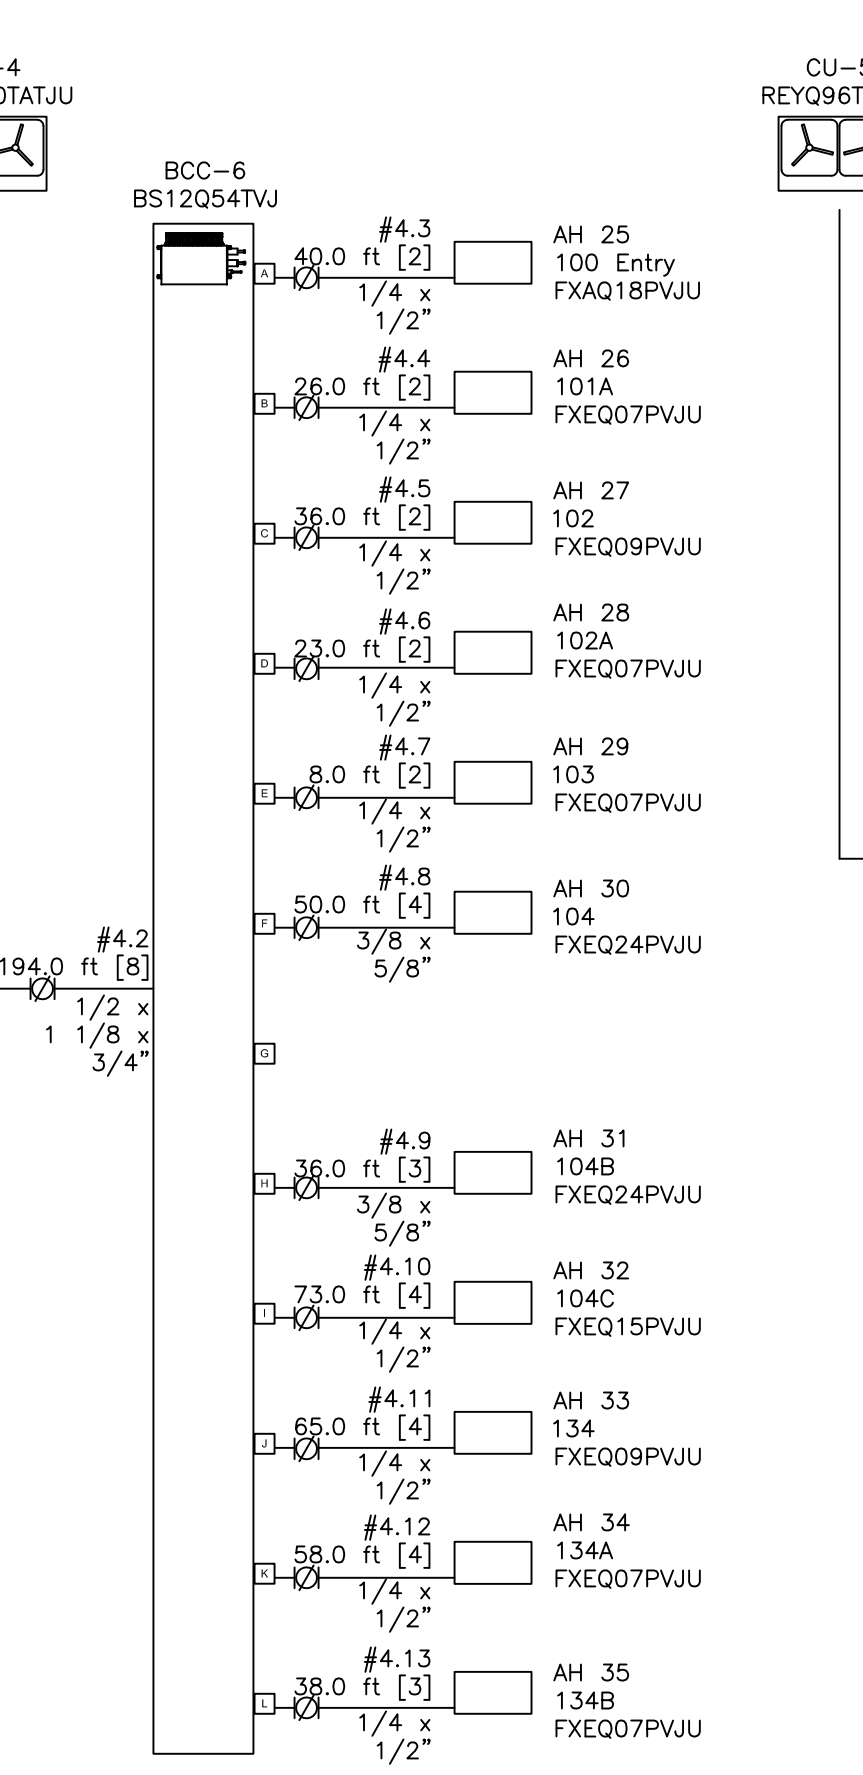

9 SYSTEM PIPING DIAGRAM OU-4 NO SCALE

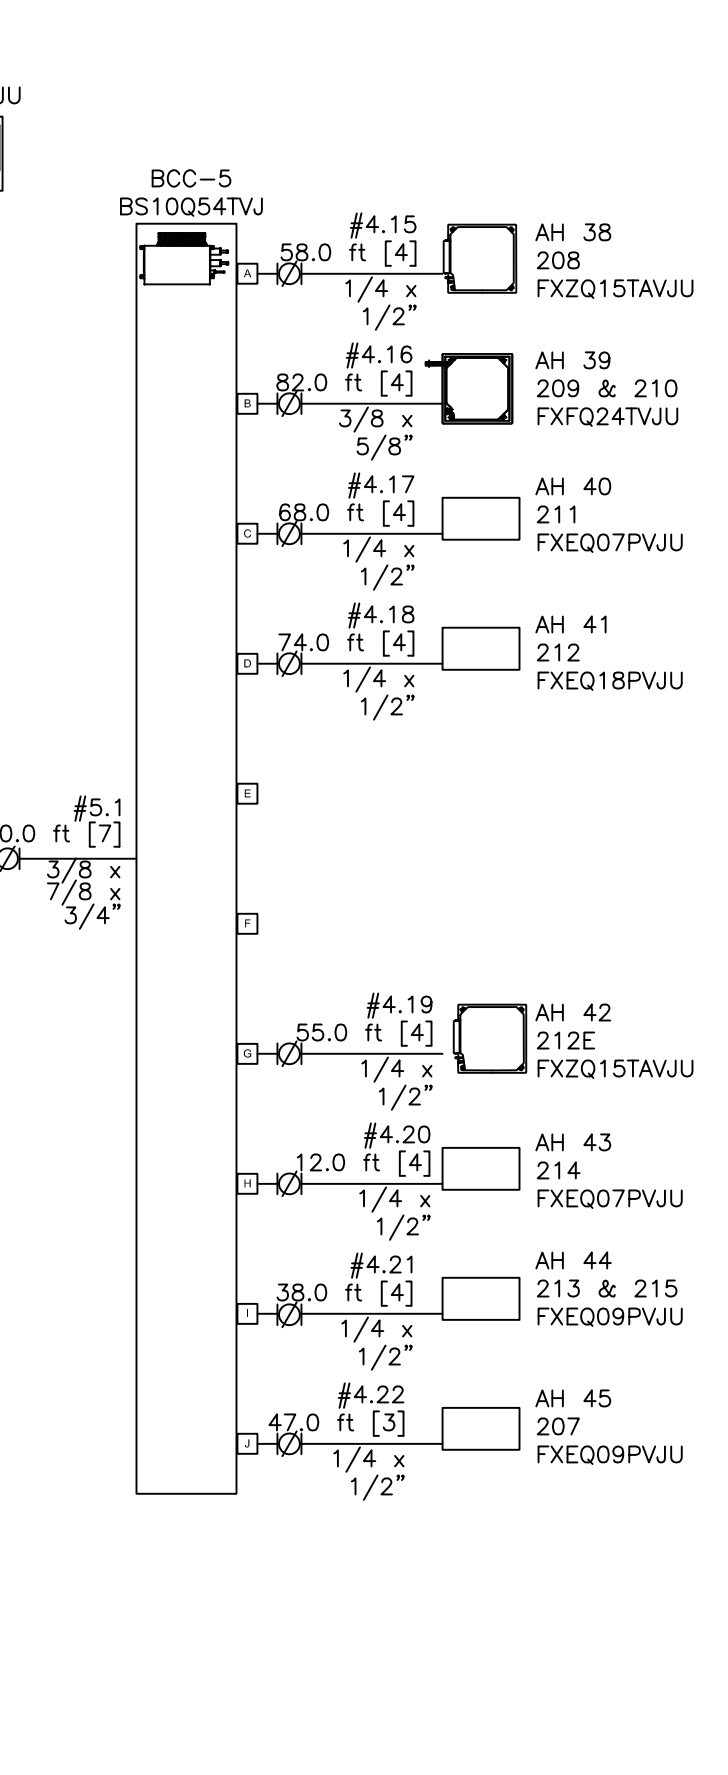

10 SYSTEM PIPING DIAGRAM OU-5 NO SCALE

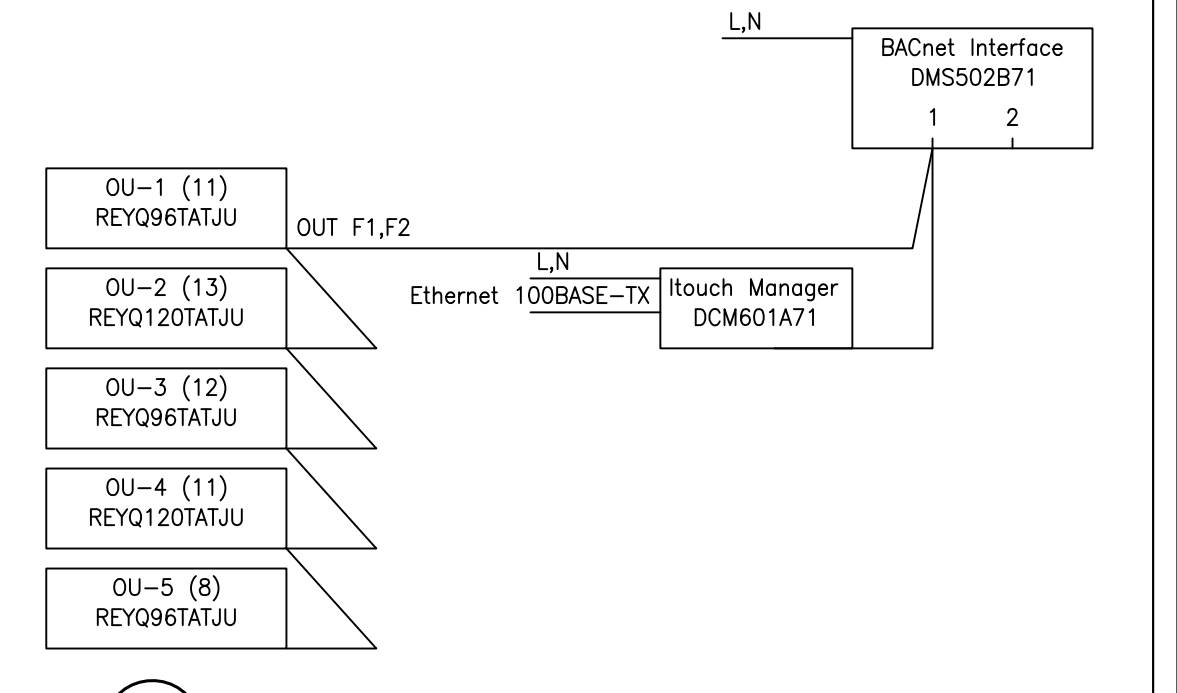

11 VRV SYSTEM CENTRALIZED CONTROL GROUP DIAGRAM NO SCALE

ALL EQUIPMENT AND MODEL NUMBERS THIS SHEET ARE BASED ON DAIKIN

GENERAL REVISIONS	PLAN REVISIONS	Date	Appr.
1		1.28.19	

DESIGNED BY: REM	CHECKED BY: REM	DATE: 12/28/2018	SCALE: NONE	DFE PROJECT NO: 235F18-458-D
STATE OF MAINE DEPARTMENT OF DEFENSE, VETERANS AND EMERGENCY MANAGEMENT				
Cordjia Capital Projects Group				
16 Tannery Lane, Suite 23 Camden, Maine 04843				
207-236-9970 / mdsj@cordjia.com				

CAMP KEYES REUTILIZATION PROJECT
CAMP KEYES, AUGUSTA, MAINE
BUILDING NO. 7 RENOVATIONS
PIPING AND CONTROL DIAGRAMS
VRV HEAT PUMP SYSTEMS

PLAN PROGRESS	
<input type="checkbox"/>	DRAFT
<input type="checkbox"/>	35% REVIEW
<input type="checkbox"/>	65% REVIEW
<input type="checkbox"/>	95% REVIEW
<input type="checkbox"/>	FINAL REVIEW
<input checked="" type="checkbox"/>	FOR BIDDING
<input type="checkbox"/>	ISSUED FOR CONSTRUCTION
<input type="checkbox"/>	RECORD DRAWINGS

SHEET ID:
M-202
SHEET:100 OF 126

January 28, 2019 7:32 am
X:\Projects\1813_Comp_Keys_Bldg 7\Address\1813_Bldg 7_M201-M202 (01-24-2019).dwg



MECHANICAL SYSTEMS ENGINEERS
ROYAL RIVER CENTER, UNIT 108
10 FOREST FALLS DRIVE, YARMOUTH, MAINE 04096
(207) 846-1441
FACEBOOK: MECHANICAL SYSTEMS ENGINEERS
CELEBRATING 50 YEARS IN BUSINESS
© COPYRIGHT 2018




- GENERAL SHEET NOTES
- DFE PROJECT MANAGER IS RESPONSIBLE FOR IDENTIFYING LAN LOCAL COMMUNICATIONS.
 - CONTRACTOR IS RESPONSIBLE FOR CONNECTING JACE TO GOVERNMENT'S LAN USING CAT #6 IN CONDUIT.
 - NETWORK CONTROLLER LOCATION(S) TO BE DETERMINED IN THE FIELD.
 - CONTRACTOR TO VERIFY EXACT COMPONENTS REQUIRED TO MEET THE INTENT OF THE OPERATIONS.
 - CONTRACTOR IS RESPONSIBLE FOR 3 FOOT MINIMUM LOOP AT THE JACE CONNECTION AND 8' MIN AT THE LAN ROOM CONNECTION USING CAT #6.
 - CONTRACTOR TO PROVIDE SUBMITTAL WITH LAYOUT AND CONTROLS.
 - CONTRACTOR TO VERIFY SEQUENCE OF OPERATION ON ALL EQUIPMENT.

- GENERAL NOTES (ALL CONTROLS DRAWINGS)
- GRAPHICS SHALL BE DISPLAYED AND ALARMS SHALL BE ANNUNCIATED ON THE EXISTING GRAPHICAL USER INTERFACE (GUI) COMPUTER IN AUGUSTA AND ON PORTABLE COMPUTER PROVIDED AS PART OF THIS PROJECT
 - SETTINGS, MODES AND SET POINTS, THAT ARE INDICATED BELOW AS BEING ADJUSTABLE, SHALL BE ADJUSTABLE BY THE BUILDING OPERATORS THROUGH THE GUI WITHOUT THE NEED TO CHANGE OR EDIT PROGRAMMING.
 - THE GRAPHICAL USER INTERFACE (GUI) SHALL DISPLAY THE FOLLOWING VALUES; MOTOR RUN TIME TOTALS, CURRENT RATE OF ENERGY DELIVERY (GALLONS, KW/KWH, AND BTU/HR), TOTAL ENERGY DELIVERED DURING THE PAST HOUR, THE PAST DAY, THE PAST WEEK, THE PAST MONTH, THE PAST QUARTER, SEMI-ANNUALLY, AND THE PAST YEAR COMPARED TO THE PREVIOUS YEAR. DATA SHALL BE PROVIDED BOTH IN TABULAR FORM AND GRAPHICALLY WITH VISUAL GAUGES AND COUNTERS ON AN ENERGY SCREEN, INCLUDING OUTSIDE AIR TEMPERATURE AND CALCULATED HEATING AND COOLING DEGREE DAYS.
 - ANALOG DATA SHALL BE TRENDED AT REGULAR INTERVALS, DETERMINED BY THE EXPECTED RATE OF CHANGE OF THE DATA, AND SHALL BE ARCHIVED AND STORED ON THE GUI COMPUTER. TREND DATA SHALL BE CONFIGURED AND STORED TO SATISFY MEARNG REQUIREMENTS FOR FUTURE MEASUREMENT AND VERIFICATION.
 - BINARY DATA SHALL BE TRENDED ON A CHANGE OF STATE BASIS AND SHALL BE ARCHIVED AND STORED ON THE GUI COMPUTER. TREND DATA SHALL BE CONFIGURED AND STORED TO SATISFY MEARNG REQUIREMENTS FOR FUTURE EXPORTING FOR MEASUREMENT AND VERIFICATION.
 - COORDINATE FINAL GUI COMPUTER LOCATION WITH OWNER.
 - CONTROL UNITS, GUI AND NETWORK DEVICES SHALL BE CONNECTED TO AN EXISTING EMERGENCY POWER CIRCUIT. (WHERE APPLICABLE).
 - ALL LOW-VOLTAGE AND CONTROL WIRING SHALL BE RUN IN CONDUIT. CONDUIT SHALL BE RUN CONCEALED IN WALLS EXCEPT FOR NEW AND EXISTING MASONRY WALLS WITHOUT FURRING AND GWB.
 - CONTROLS CONTRACTOR SHALL DEMONSTRATE TO OWNER VIA GUI PRESENTATION THAT ALL CONTROL POINTS ARE OPERATING, TRENDED, ADJUSTABLE, DOWNLOADABLE, POPULATING TABLES (PER NOTE 3 ABOVE) AND GUI'S.


VRF SYSTEM KEY NOTES (THIS SHEET ONLY)

- VRF SYSTEM CONTROLLER SHALL BE LOCATED AT THE OWNER'S DIRECTION.
- PROVIDE QUANTITY OF JACE UNITS TO SUIT FINAL DDC SYSTEM
- PROVIDE VRF SYSTEM MANUFACTURER'S BACNET INTERFACE HARDWARE AND SOFTWARE AS REQUIRED TO ACHIEVE FULL INTEGRATION WITH CONNECTED EQUIPMENT.
- PROVIDE LOW VOLTAGE AND CONTROL WIRING AND DEVICES REQUIRED TO CONNECT VRF SYSTEM COMPONENTS IN ACCORDANCE WITH VRF SYSTEM MANUFACTURER'S WRITTEN INSTRUCTIONS. VRF SYSTEM START-UP AND PROGRAMMING

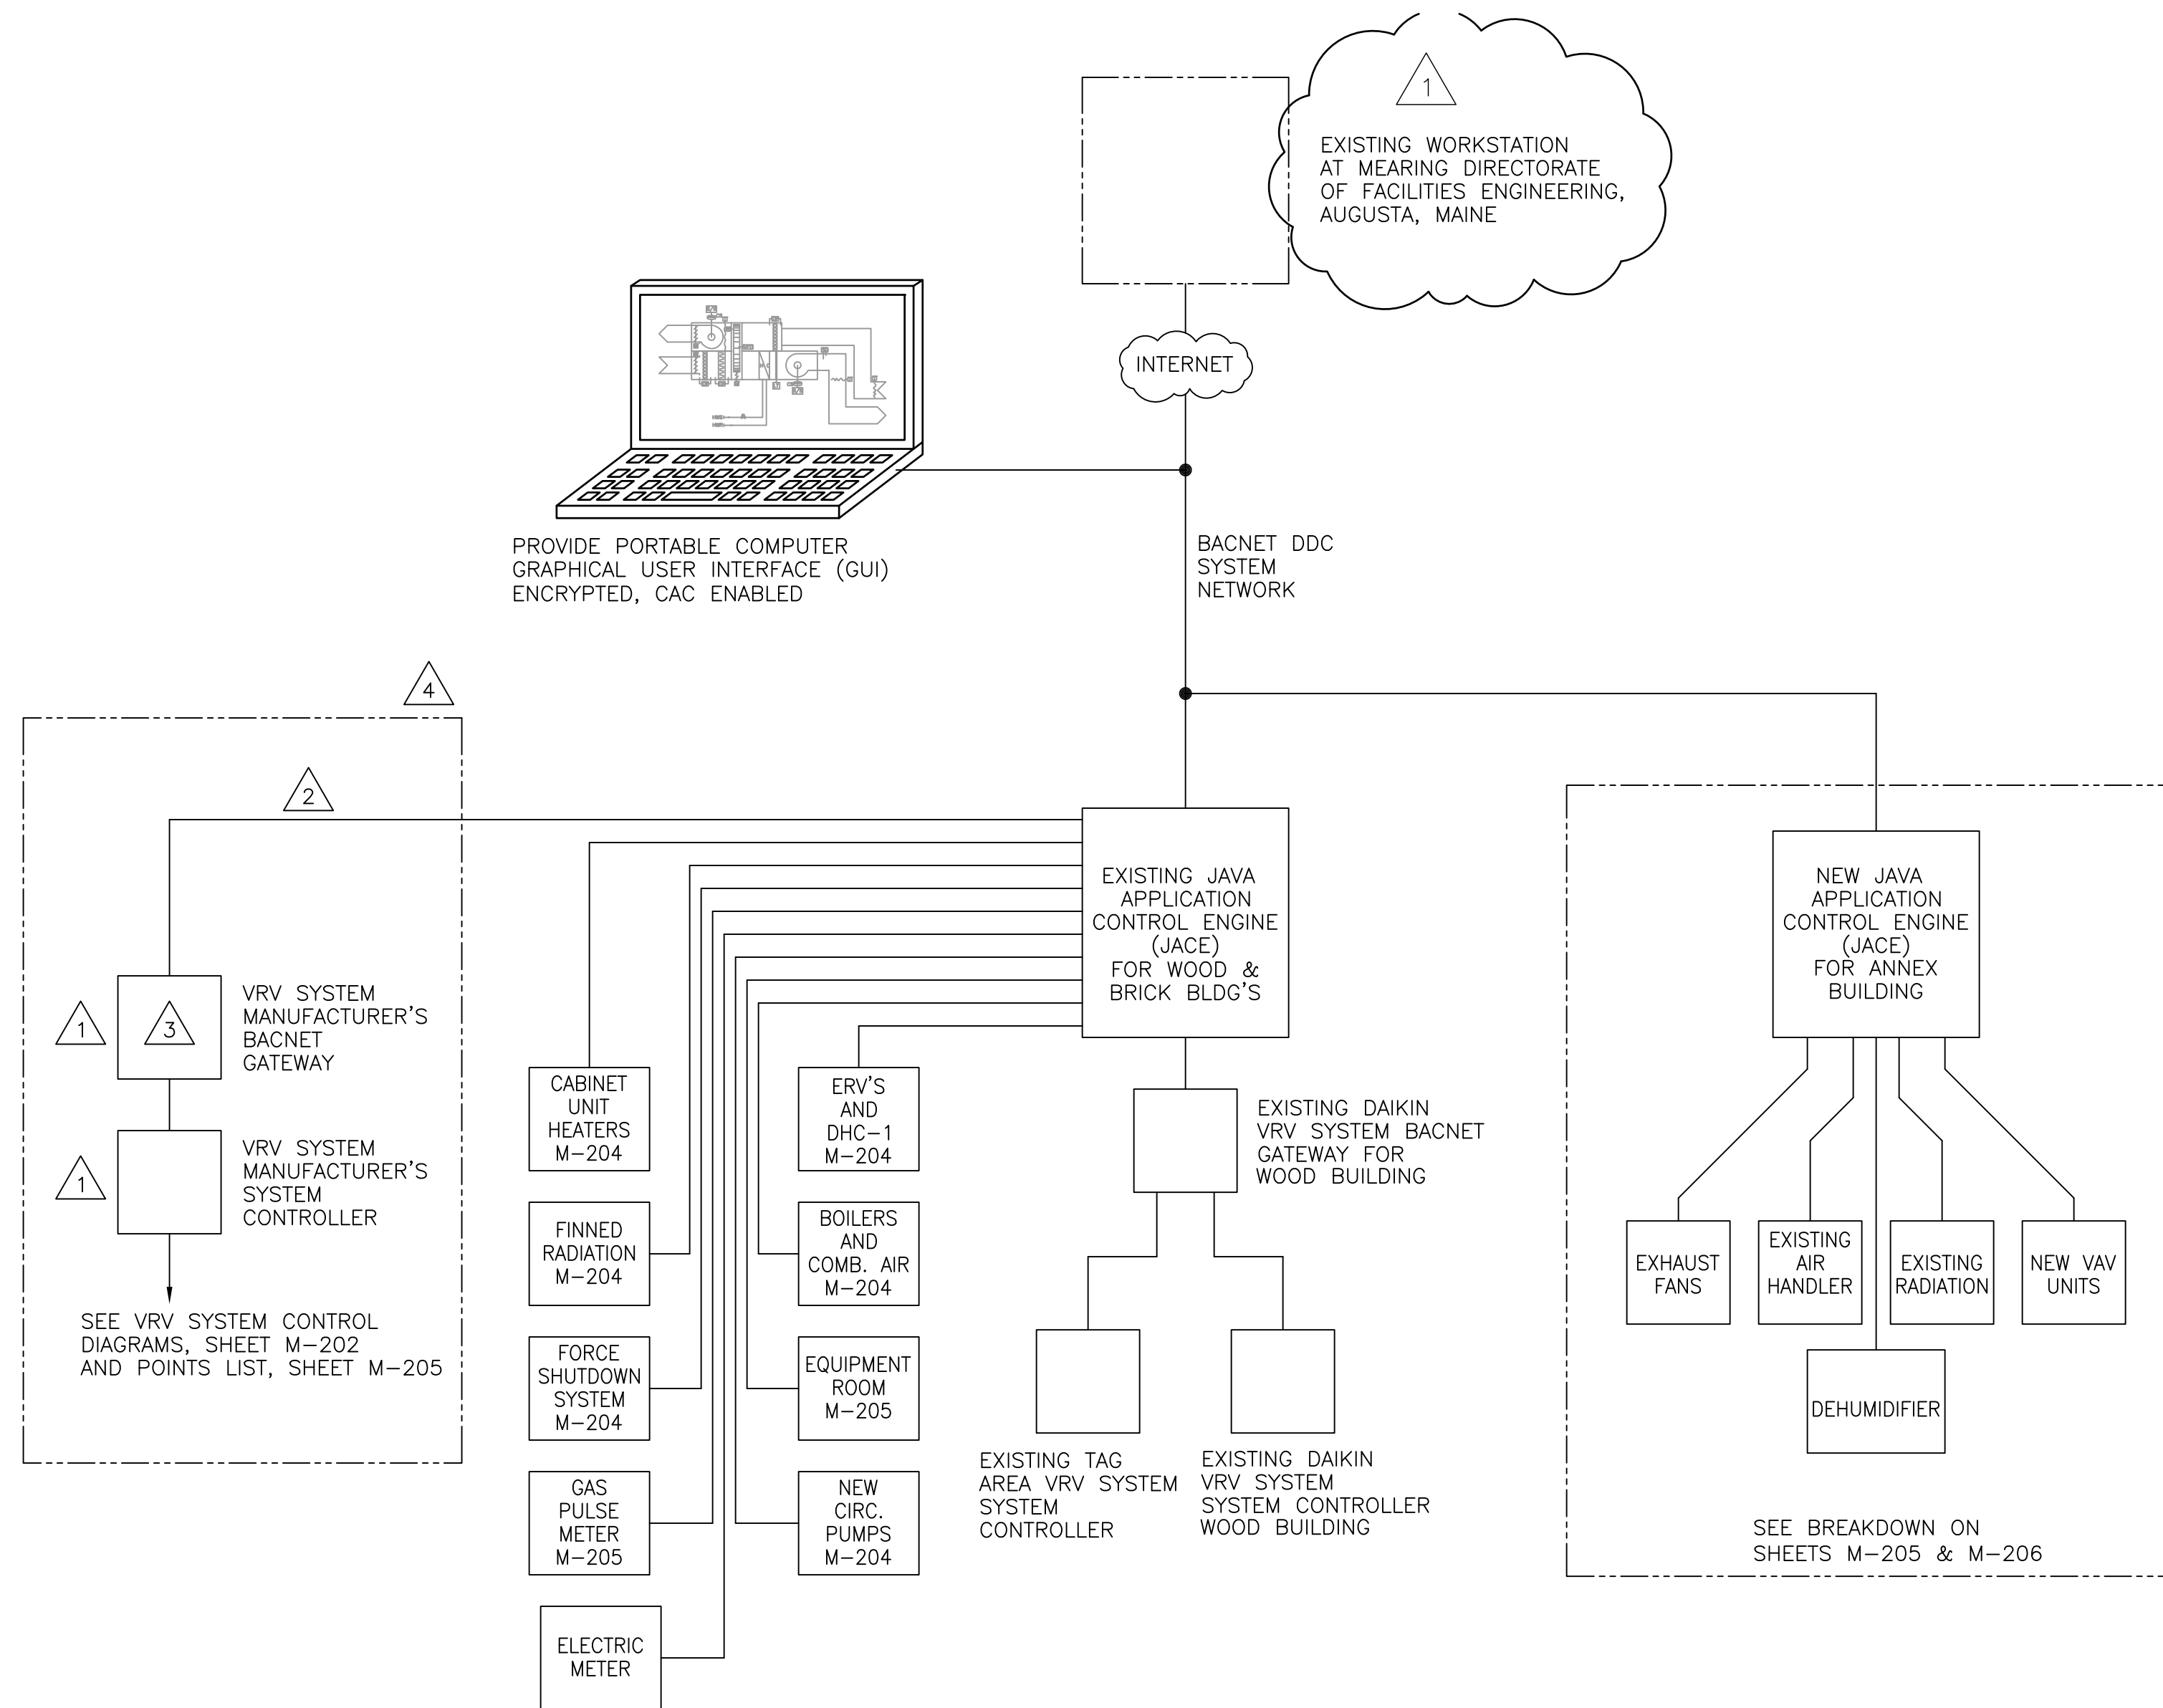

DIRECT DIGITAL CONTROL SYSTEM ARCHITECTURE

NO SCALE

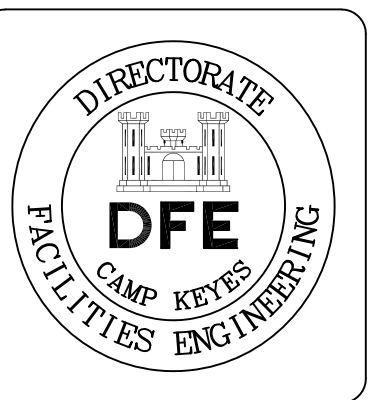

Rev#	Description	Date	Appr.
1	GENERAL REVISIONS	1.28.19	
	PLAN REVISIONS		


DESIGNED BY: REM	CHECKED BY: REM	DATE: 12/28/2018	SCALE: NONE	DFE PROJECT NO: 235918-458-D
DRAWN BY: KFM/MAD				

STATE OF MAINE
DEPARTMENT OF DEFENSE, VETERANS AND EMERGENCY MANAGEMENT
Cordjia Capital Projects Group
16 Tannery Lane, Suite 23
Camden, Maine 04843
207-236-9970 / mdsigle@cordjia.com

CAMP KEYES REUTILIZATION PROJECT
CAMP KEYES, AUGUSTA, MAINE
BUILDING NO. 7 RENOVATIONS
MECHANICAL SEQUENCE OF OPERATION AND CONTROL DIAGRAMS


PLAN PROGRESS	
<input type="checkbox"/>	DRAFT
<input type="checkbox"/>	35% REVIEW
<input type="checkbox"/>	65% REVIEW
<input type="checkbox"/>	95% REVIEW
<input type="checkbox"/>	FINAL REVIEW
<input checked="" type="checkbox"/>	FOR BIDDING
<input type="checkbox"/>	ISSUED FOR CONSTRUCTION
<input type="checkbox"/>	RECORD DRAWINGS

SHEET ID:
M-203
SHEET: 101 of 126

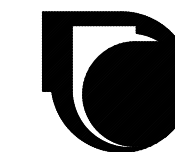

MECHANICAL SYSTEMS ENGINEERS
ROYAL RIVER CENTER, UNIT 108
10 FOREST FALLS DRIVE, YARMOUTH, MAINE 04096
(207) 846-1441
FACEBOOK: MECHANICAL SYSTEMS ENGINEERS
CELEBRATING 50 YEARS IN BUSINESS
© COPYRIGHT 2018



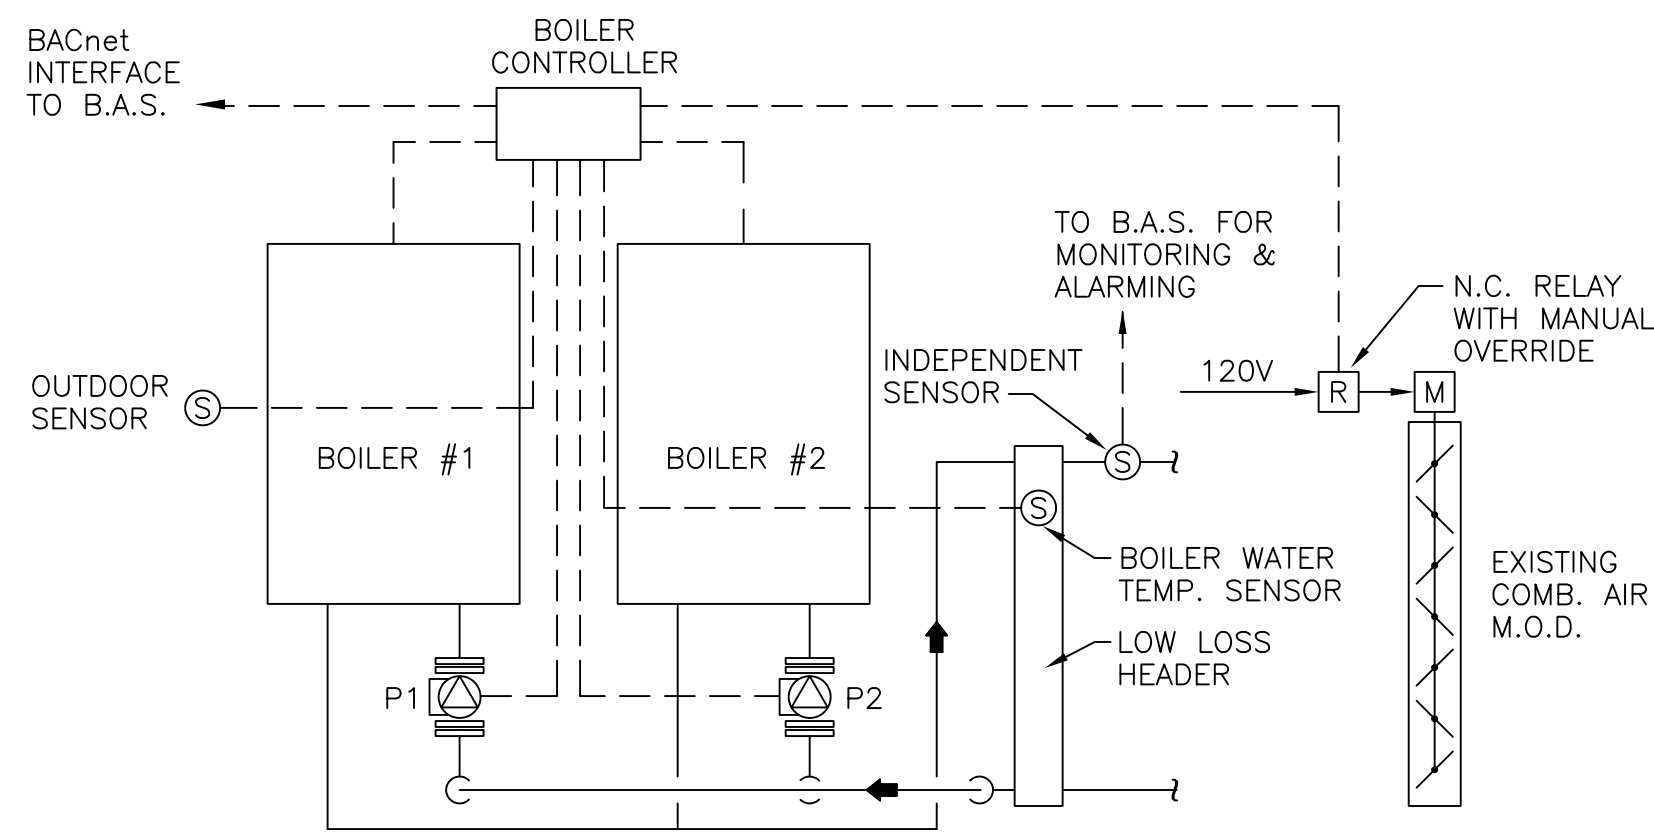

BOILER ROOM COMBUSTION AIR SEQUENCE OF OPERATION

EXISTING COMBUSTION AIR DUCTWORK AND MOTORIZED DAMPERS SHALL REMAIN IN PLACE. CONNECT NEW BOILER CONTROLS TO EXISTING DAMPER OPERATORS TO OPEN WHEN EITHER BOILER FIRES.


BOILER SEQUENCE OF OPERATION

- BOILERS SHALL FUNCTION ON INTERNAL CONTROLS TO MAINTAIN TEMPERATURE TO THE HEATING SYSTEM AS PRESCRIBED BY THE RESET WATER SCHEDULE PROGRAMMED INTO THEM.
- PROVIDE, INSTALL AND WIRE AN OUTDOOR AIR TEMPERATURE SENSOR (ON A NORTH WALL SHADED FROM SUNSHINE AND REFLECTION FROM SNOW) TO THE BOILER CONTROLS.
- SEE SPECIFICATION 23 52 16, "CONDENSING BOILERS" FOR BOILER COMPONENTS AND INTERNAL SEQUENCE OF OPERATION.
- EACH BOILER SHALL CYCLE ITS OWN INJECTION PUMP (P1 AND P2) TO INJECT HEAT INTO THE MAIN SYSTEM.
- CONNECT BOILER CONTROLS TO BAS USING BACNET PROTOCOL TO PERMIT MONITORING OF BOILER OPERATION AND ALARMING OF LOW TEMPERATURE.
- PROVIDE A TEMPERATURE SENSOR IN THE MAIN SUPPLY HEADER FROM THE BOILERS TO PROVIDE INDEPENDENT MONITORING OF SUPPLY WATER TEMPERATURE THROUGH THE BAS AND SIGNAL AN ALARM SHOULD TEMPERATURE FALL 5°F. BELOW SETPOINT OF THE RESET WATER SCHEDULE.

EXTERNAL BOILER CONTROLS POINTS LIST

POINT DESCRIPTION	GRAPHIC	ANALOG INPUT	ANALOG OUTPUT	BINARY INPUT	BINARY OUTPUT	ALARM	ANALOG VARIABLE	BINARY VARIABLE	TREND LOG	NOTES
BOILER INTERNAL CONTROLS	X	X								1
OUTDOOR AIR TEMPERATURE	X	X	X				X	X		
DISCHARGE WATER TEMPERATURE	X	X	X				X	X		

NOTES:
1. BOILER CONTROLS TO FEED A BACnet SIGNAL TO THE B.A.S. FOR REMOTE MONITORING AND SETTING OF INTERNAL CONTROLS INCLUDING BOILER STATUS (LEAD/LAG), SUPPLY TEMPERATURE, RETURN TEMPERATURE, ETC., RUN TIME, GAS VALVE STATUS, PUMPS P1 & P2

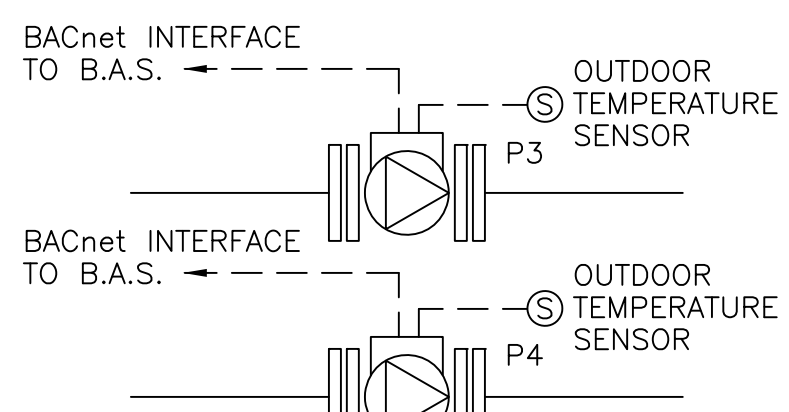


CIRCULATING PUMPS P3 AND P4 SEQUENCE OF OPERATION

- PUMPS SHALL OPERATE FROM INTERNAL CONTROLS AND REGULATE THEIR OWN SPEED BASED ON SYSTEM PRESSURES. PUMPS SHALL HAVE INTERNAL OR B.A.S. LEAD/LAG CONTROL PROTOCOLS. PUMPS SHALL NOT REQUIRE EXTERNAL VFD'S. SEE SPECIFICATION 23 21 23, "HYDRONIC PUMPS" FOR ADDITIONAL INFORMATION REGARDING PUMP CONTROLS.
- CONNECT PUMP CONTROLS TO THE OUTDOOR AIR SENSOR CONTROLLING THE BOILERS.
- PROVIDE COMMUNICATING WIRING BETWEEN THE TWO PUMPS TO PERMIT LEAD/LAG CONTROLS.
- CONNECT PUMPS TO THE BAS USING BACNET PROTOCOL TO PERMIT MONITORING OF PUMP OPERATION AND ALARMING UPON FAILURE.

PUMPS P3 AND P4 CONTROLS POINTS LIST

POINT DESCRIPTION	GRAPHIC	ANALOG INPUT	ANALOG OUTPUT	BINARY INPUT	BINARY OUTPUT	ALARM	ANALOG VARIABLE	BINARY VARIABLE	TREND LOG	NOTES
OUTDOOR AIR TEMPERATURE	X	X								
PUMP 3 ON/OFF	X			X	X				X	1
PUMP 4 ON/OFF	X			X	X				X	1
PUMP 3 SPEED	X	X		X	X				X	1
PUMP 4 SPEED	X	X		X	X				X	1
LEAD/LAG PROGRAMMING	X			X	X				X	1
NO FLOW / PUMP FAILURE	X	X		X	X				X	1

NOTES:
1. PUMP INTERNAL CONTROLS TO FEED DATA TO B.A.S. VIA BACnet FOR REMOTE MONITORING OF INTERNAL CONTROLS.

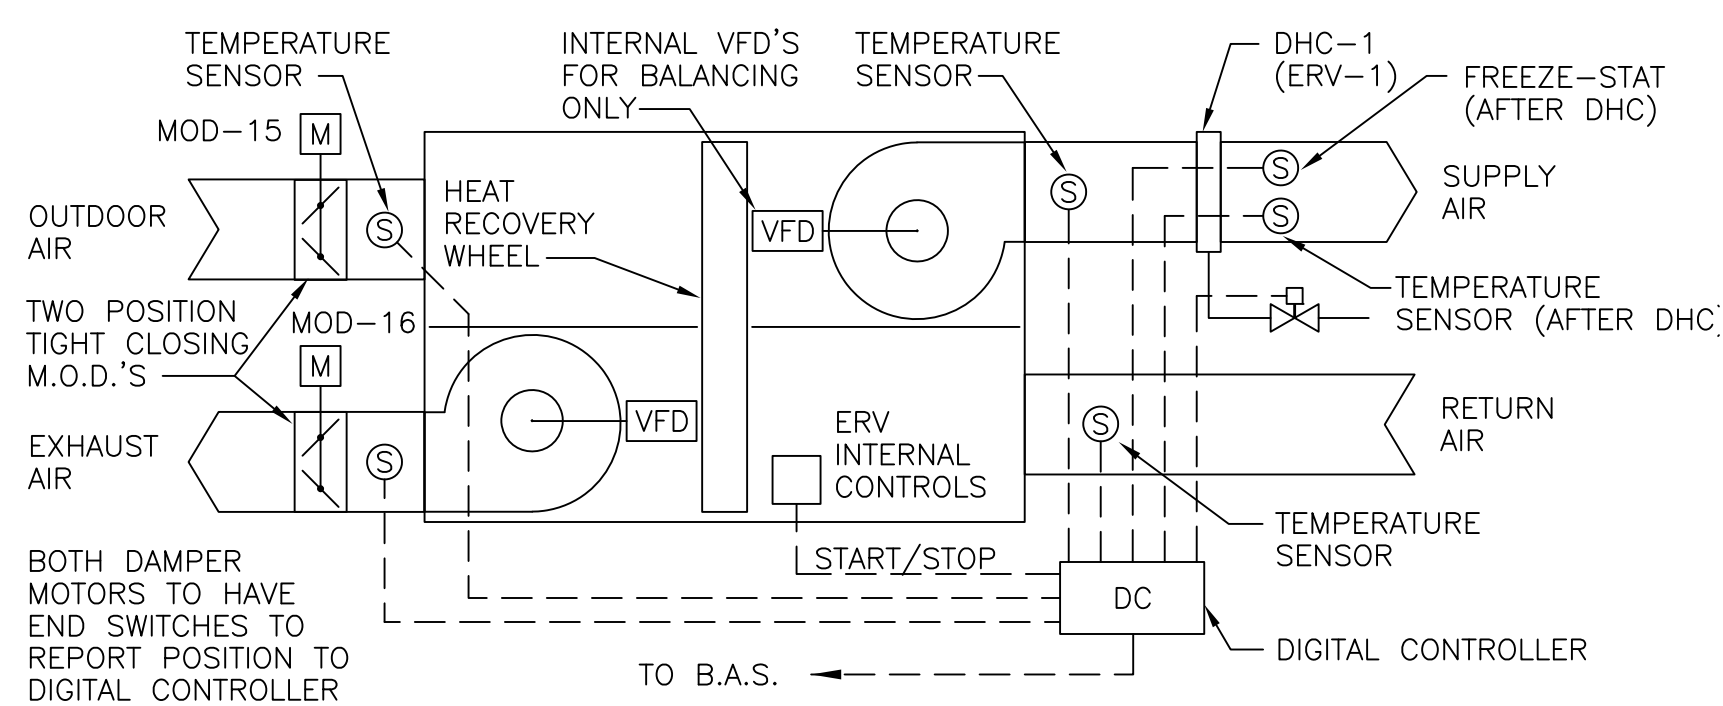


ENERGY RECOVERY UNITS (ERV) AND DUCT HEATING COIL #1 SEQUENCE OF OPERATION

- UNITS SHALL HAVE INTERNAL CONTROLS TO MAINTAIN DISCHARGE TEMPERATURE AND DEFROST CYCLES. REFERENCE SPECIFICATION SECTION 23 72 00, "AIR-TO-AIR ENERGY RECOVERY EQUIPMENT".
- UNITS SHALL HAVE THE CAPABILITY OF CONNECTING TO THE BAS VIA BAC-NET.
- UNITS SHALL BE CONNECTED TO THE BAS TO OPERATE ON THE SAME OCCUPIED / UNOCCUPIED CYCLES AS THE HEAT PUMP SYSTEMS ASSOCIATED WITH EACH UNIT.
 - ERV-1 ASSOCIATED WITH OUTDOOR UNITS 1, 2 & 3
 - ERV-2 ASSOCIATED WITH OUTDOOR UNIT 4
- WHEN OCCUPIED CYCLES ARE ACTIVATED EACH ERV SHALL START AND THE OUTDOOR AND EXHAUST AIR DAMPERS SHALL OPEN. UNITS SHALL RUN CONTINUOUSLY AND THE HEAT RECOVERY WHEEL SPEED SHALL MODULATE TO MAINTAIN SET DISCHARGE TEMPERATURE. TEMPERATURE SHALL BE ADJUSTABLE BOTH AT THE UNITS AND THROUGH THE BAS. SEE DRAWINGS FOR CONTROL POINT SCHEDULE.
- SHOULD UNIT CONTROLS GO INTO DEFROST MODE THE OUTDOOR AIR INTAKE DAMPER SHALL CLOSE AND THE SUPPLY FAN STOP. WHEEL AND EXHAUST FAN SHALL CONTINUE TO OPERATE UNTIL CYCLE IS COMPLETE WHEN THE OUTDOOR AIR DAMPER SHALL OPEN AND THE SUPPLY FAN START AGAIN.
- ERV-1 SHALL HAVE A DUCT HEATING COIL TO BOOST THE DISCHARGE AIR FROM THE ERV TO ROOM TEMPERATURE PLUS 2°F. (ADJUSTABLE THROUGH BAS). A TWO WAY MODULATING VALVE ON THE HOT WATER SUPPLY PIPING TO THE COIL SHALL MODULATE TO MAINTAIN DISCHARGE TEMPERATURE. DISCHARGE TEMPERATURE SHALL BE MONITORED THROUGH THE BAS. SHOULD DISCHARGE TEMPERATURE FALL TO 60°F. A LOW TEMPERATURE ALARM SHALL BE SIGNED AT THE BAS. SHOULD DISCHARGE TEMPERATURE FALL TO 40°F. A FREEZE WARNING BE SIGNED AT THE BAS. ERV-1 SHALL SHUT DOWN AND THE OUTDOOR AIR & EXHAUST AIR DAMPERS SHALL CLOSE. THE VALVE ON THE HOT WATER SUPPLY TO THE COIL SHALL REMAIN OPEN.
- FORCE PROTECTION SHUTDOWN: IN THE EVENT THE FORCE PROTECTION SHUTDOWN SWITCH IS ACTIVATED (SEE DETAIL THIS SHEET) THE SUPPLY AND EXHAUST FANS SHALL STOP AND THE OUTSIDE AIR AND EXHAUST AIR DAMPERS SHALL CLOSE AND REMAIN CLOSED UNTIL THE FORCE PROTECTION SWITCH IS MANUALLY RELEASED.
- ALL TEMPERATURE SETPOINTS SHALL BE ADJUSTABLE.

ERV AND DHC-1 POINTS LIST

POINT DESCRIPTION	GRAPHIC	ANALOG INPUT	ANALOG OUTPUT	BINARY INPUT	BINARY OUTPUT	ALARM	ANALOG VARIABLE	BINARY VARIABLE	TREND LOG	NOTES
ADJUSTABILITY OF DHC-1 DISCHARGE TEMP	X		X							
CONTROL VALVE ON HWS TO DHC-1	X	X								
EXHAUST AIR DAMPER POSITION	X			X	X					
EXHAUST AIR TEMPERATURE	X			X						
EXHAUST FAN CURRENT SENSOR (STATUS)	X			X		X			X	2,3
EXHAUST FAN START / STOP	X			X					X	1
OUTDOOR AIR DAMPER POSITION	X			X	X				X	
OUTDOOR AIR TEMPERATURE SENSOR	X	X								
RETURN AIR TEMPERATURE	X	X							X	
SUPPLY AIR TEMPERATURE AFTER DHC-1	X	X							X	
SUPPLY AIR TEMPERATURE AT ERV OUTLET	X	X							X	
SUPPLY FAN CURRENT SENSOR (STATUS)	X			X		X			X	2,3
SUPPLY FAN START / STOP	X			X					X	1

NOTES:
1. UNIT RECEIVES START / STOP SIGNAL FROM B.A.S.
2. GENERATE ALARM AT GUI IF MOTOR FAILS TO SHOW PROOF OF OPERATION
3. PROVIDE RUN-TIME TOTALIZATION AND DISPLAY DATA ON GUI

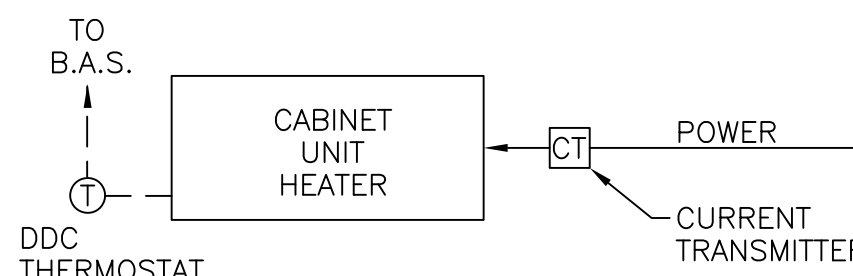

CABINET UNIT HEATERS SEQUENCE OF OPERATION

- CABINET UNIT HEATERS COME WITH INTERNAL CONTROLS AND ABILITY TO CONNECT TO EXTERNAL THERMOSTATS. PROVIDE A DDC TEMPERATURE SENSOR WITH NO SETPOINT OR TEMPERATURE DISPLAY. ON CALL FOR HEAT THE SENSOR SHALL SIGNAL THE CABINET UNIT HEATER TO START. AN INTERNAL AQUASTAT ON THE HOT WATER SUPPLY PIPE TO THE COIL SHALL ALLOW THE FAN TO START WHEN WATER TEMPERATURE TO THE COIL REACHES SETPOINT (PRESET AT THE FACTORY). WHEN SPACE TEMPERATURE IS SATISFIED THE UNIT SHALL BE SIGNED TO STOP. TEMPERATURE SETPOINT AND ROOM TEMPERATURE STATUS SHALL BE ACCESSED FROM THE BAS.

CABINET UNIT HEATERS POINTS LIST

POINT DESCRIPTION	GRAPHIC	ANALOG INPUT	ANALOG OUTPUT	BINARY INPUT	BINARY OUTPUT	ALARM	ANALOG VARIABLE	BINARY VARIABLE	TREND LOG	NOTES
SPACE TEMPERATURE	X			X	X					
SPACE TEMPERATURE SETPOINT	X			X					X	1


NOTES:
1. UNIT CONTROL IS ENERGIZED BY THE THERMOSTAT AND FAN RUNS WHEN INTERNAL AQUASTAT SENSES HOT WATER IN HWS

FINNED RADIATION AND CONVECTORS POINTS LIST

POINT DESCRIPTION	GRAPHIC	ANALOG INPUT	ANALOG OUTPUT	BINARY INPUT	BINARY OUTPUT	ALARM	ANALOG VARIABLE	BINARY VARIABLE	TREND LOG	NOTES
SPACE TEMPERATURE	X			X	X				X	
SPACE TEMPERATURE SETPOINT	X			X					X	1
VALVE POSITION	X			X	X				X	2

NOTES:
1. LIMITS SETPOINT RANGE AT THE THERMOSTAT
2. REPORTS POSITION OF VALVE (OPEN/CLOSED)

BUTTON SPECIFICATION: BUTTON SHALL BE STI SERIES 2000 STOPPER STATION OR APPROVED EQUAL. BUTTON AND SHELL SHALL BE YELLOW. BUTTON SHALL BE OCTAGONAL, PUSH TO ACTIVATE, TURN TO RESET TYPE. BUTTON SHALL BE UL LISTED. PROVIDE PROTECTION COVER, STI MINI STOPPER II COVER WITHOUT HORN OR APPROVED EQUAL. THE BUTTON SHALL HAVE TWO SETS OF FORM "C" CONTACTS RATED AT 10A, 120/250 VAC, 1/2 HP, 30 VDC, 6A. THEY SHALL BE LABELLED "HVAC SYSTEM SHUTDOWN" AND THE "PROTECTIVE COVER LABELLED "HVAC SYSTEM SHUTDOWN. LIFT COVER PUSH BUTTON".

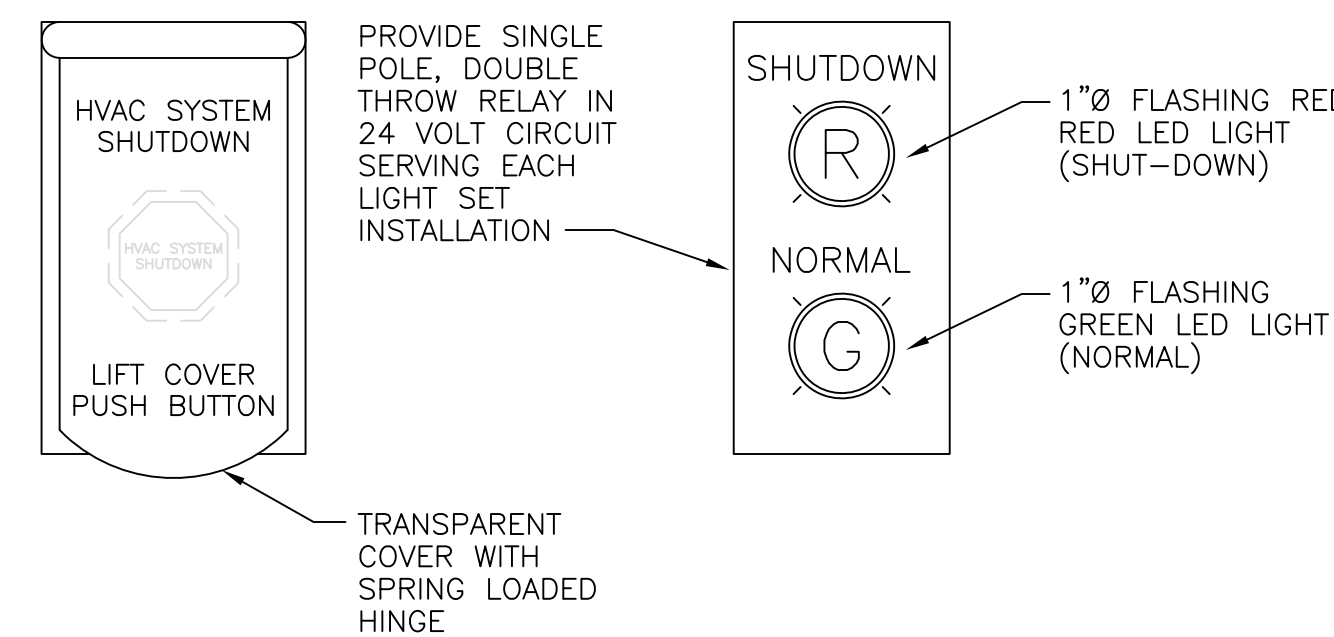

ATFP SHUTDOWN BUTTON DETAIL

NO SCALE

SEQUENCE OF OPERATION - FORCE SHUTDOWN SHUT-DOWN SWITCH (ATFP)


THE EMERGENCY STOP BUTTON SHALL OVERRIDE ALL OTHER BUILDING CONTROL FUNCTIONS AS FOLLOWS:

- PROVIDE AN EMERGENCY HVAC DISABLE SWITCH FOR ATFP FORCE PROTECTION. FINAL LOCATIONS TO BE AS FOLLOWS:
 - ROOM B25A
 - ROOM 007
 - ROOM 107
 - ROOM 112B
 - ROOM 206
 - ROOM 221
- ON ACTIVATION OF ANY EMERGENCY SWITCH, BUILDING HVAC EQUIPMENT SUPPLIED DIRECTLY WITH OUTSIDE AIR AND /OR EXHAUST FANS SHALL BE SHUT DOWN AND RELATED OUTSIDE AIR AND EXHAUST AIR DAMPERS SHALL CLOSE WITHIN 30 SECONDS. THIS INCLUDES ERV-1, ERV-2 AND THE EXISTING AIR HANDLER IN THE ANNEX BUILDING.
- INDIVIDUAL TERMINAL HEAT PUMP UNITS SHALL CONTINUE TO OPERATE WITHOUT OUTSIDE AIR.
- A CRITICAL ALARM SHALL BE GENERATED AT THE GUI.
- EACH EMERGENCY SWITCH SHALL BE MANUALLY RESET VIA THE GUI AND WHEN RESET THE BACS SHALL SOFT START THE HVAC EQUIPMENT SEQUENTIALLY BY PROVIDING ADJUSTABLE TIME-DELAY BETWEEN EQUIPMENT STARTS.
- REFER TO SPECIFIC EQUIPMENT CONTROL DIAGRAMS FOR ADDITIONAL FORCE PROTECTION SHUT-DOWN PROTOCOLS.
- WHEN A FORCE PROTECTION SWITCH IS ACTIVATED, A RED LED INDICATOR LAMP SHALL BE ILLUMINATED. OTHERWISE A GREEN LED INDICATOR LAMP SHALL BE ILLUMINATED.

GLOBAL BUILDING POINTS LIST

POINT DESCRIPTION	GRAPHIC	ANALOG INPUT	ANALOG OUTPUT	BINARY INPUT	BINARY OUTPUT	ALARM	ANALOG VARIABLE	BINARY VARIABLE	TREND LOG	NOTES
OUTSIDE AIR TEMPERATURE	X	X							X	4
OUTSIDE AIR RELATIVE HUMIDITY	X	X							X	4
FIRE ALARM CONTROL PANEL	X	X		X	X	X	X	X	X	1
MASS NOTIFICATION PANEL	X	X		X	X	X	X	X	X	1
FORCE PROTECTION SHUT DOWN SWITCH	X	X		X					X	2,4
FORCE PROTECTION NORMAL - GREEN	X			X					X	3,4
FORCE PROTECTION ACTIVATED - RED	X			X		X			X	3,4

NOTES:
1. GENERATE AN ALARM ON THE GUI WHEN FIRE ALARM SYSTEM OR MASS NOTIFICATION SYSTEM IS ENABLED
2. GENERATE ALARM IF FORCE PROTECTION SHUT DOWN SWITCH (ATFP) IS PRESSED.
3. FOR INDICATOR LIGHT PANEL DETAIL, REFER TO DETAIL THIS SHEET
4. LOCATE DEVICES IN ROOMS IDENTIFIED IN DESCRIPTION OF OPERATION.

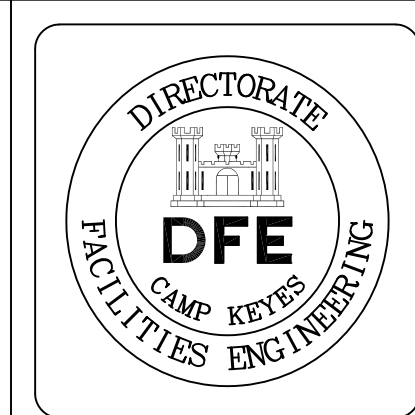

GENERAL REVISIONS	PLAN REVISIONS	Date	Appr.
1		1.28.19	


DESIGNED BY: REM	DRAWN BY: REM	CHECKED BY: KFM/MAD	DATE: 12/28/2018	SCALE: NONE	DFE PROJECT NO: 235R18-458-D
------------------	---------------	---------------------	------------------	-------------	------------------------------

STATE OF MAINE
DEPARTMENT OF DEFENSE, VETERANS
AND EMERGENCY MANAGEMENT
Cordja Capital Projects Group
16 Tannery Lane, Suite 23
Camden, Maine 04843
207-236-9970 / mdsigle@cordjagroup.com

CAMP KEYES REUTILIZATION PROJECT
CAMP KEYES, AUGUSTA, MAINE
BUILDING NO. 7 RENOVATIONS
MECHANICAL SEQUENCE OF OPERATION
AND CONTROL DIAGRAMS


- PLAN PROGRESS
- DRAFT
 - 35% REVIEW
 - 65% REVIEW
 - 95% REVIEW
 - FINAL REVIEW
 - FOR BIDDING
 - ISSUED FOR CONSTRUCTION
 - RECORD DRAWINGS

SHEET ID:
M-204
SHEET: 102 OF 126

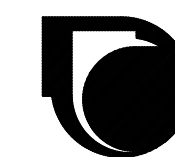

MECHANICAL SYSTEMS ENGINEERS
ROYAL RIVER CENTER, UNIT 108
10 FOREST FALLS DRIVE, YARMOUTH, MAINE 04096
(207) 846-1441
FACEBOOK: MECHANICAL SYSTEMS ENGINEERS
CELEBRATING 50 YEARS IN BUSINESS
© COPYRIGHT 2018




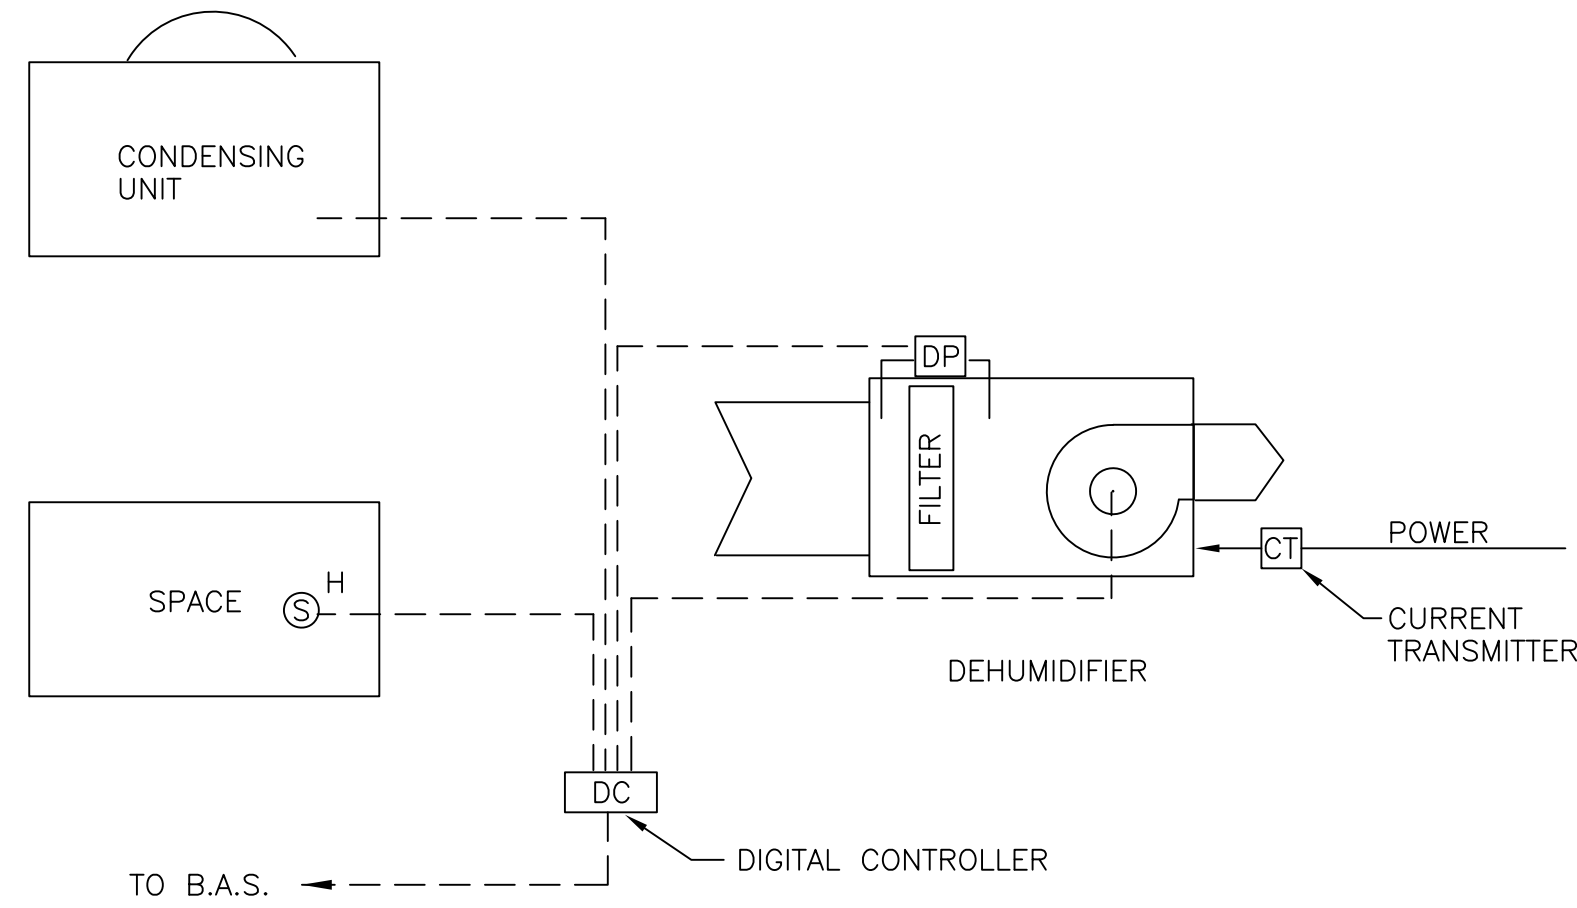


DEHUMIDIFIER - NORTHWEST WING LOWER LEVEL SEQUENCE OF OPERATION

- OCCUPIED AND UNOCCUPIED MODE: WHEN THE LOWER LEVEL SPACE WALL-MOUNTED HUMIDITY SENSOR MEASURES RELATIVE HUMIDITY GREATER THAN 60% (ADJUSTABLE ON BMS) ENERGIZE THE INDOOR AIR HANDLER AND OUTDOOR CONDENSING UNIT.
- STANDBY STATUS WILL BE NO AIR HANDLER OR CONDENSING UNIT OPERATION.
- CONDENSER REHEAT IS CONTROLLED BY THE INTERNAL CONTROLS OF THE DEHUMIDIFIER.

NORTH WEST WING DEHUMIDIFIER CONTROL POINTS										
POINT DESCRIPTION	GRAPHIC	ANALOG INPUT	ANALOG OUTPUT	BINARY INPUT	BINARY OUTPUT	ALARM	ANALOG VARIABLE	BINARY VARIABLE	TREND LOG	NOTES
START/STOP	X			X	X					1
ROOM WALL-MOUNTED HUMIDITY SENSOR	X			X	X					
FILTER STATUS	X			X	X					
NOTES										
1. ENABLED 24/7.										

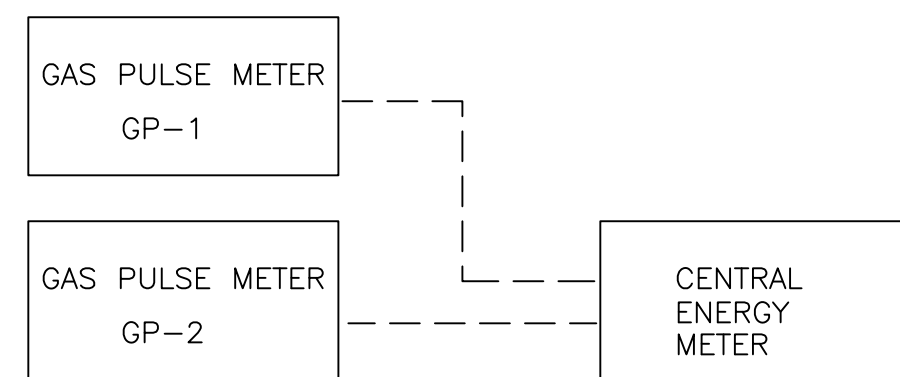


GAS PULSE METER CONTROL POINTS										
POINT DESCRIPTION	GRAPHIC	ANALOG INPUT	ANALOG OUTPUT	BINARY INPUT	BINARY OUTPUT	ALARM	ANALOG VARIABLE	BINARY VARIABLE	TREND LOG	NOTES
COMMUNICATION WITH CENTRAL ENERGY METER	X			X	X					1,2
NOTES										
1. LOCATED IN NEW ADDITION EQUIPMENT ROOM										
2. PULSE OUTPUT										

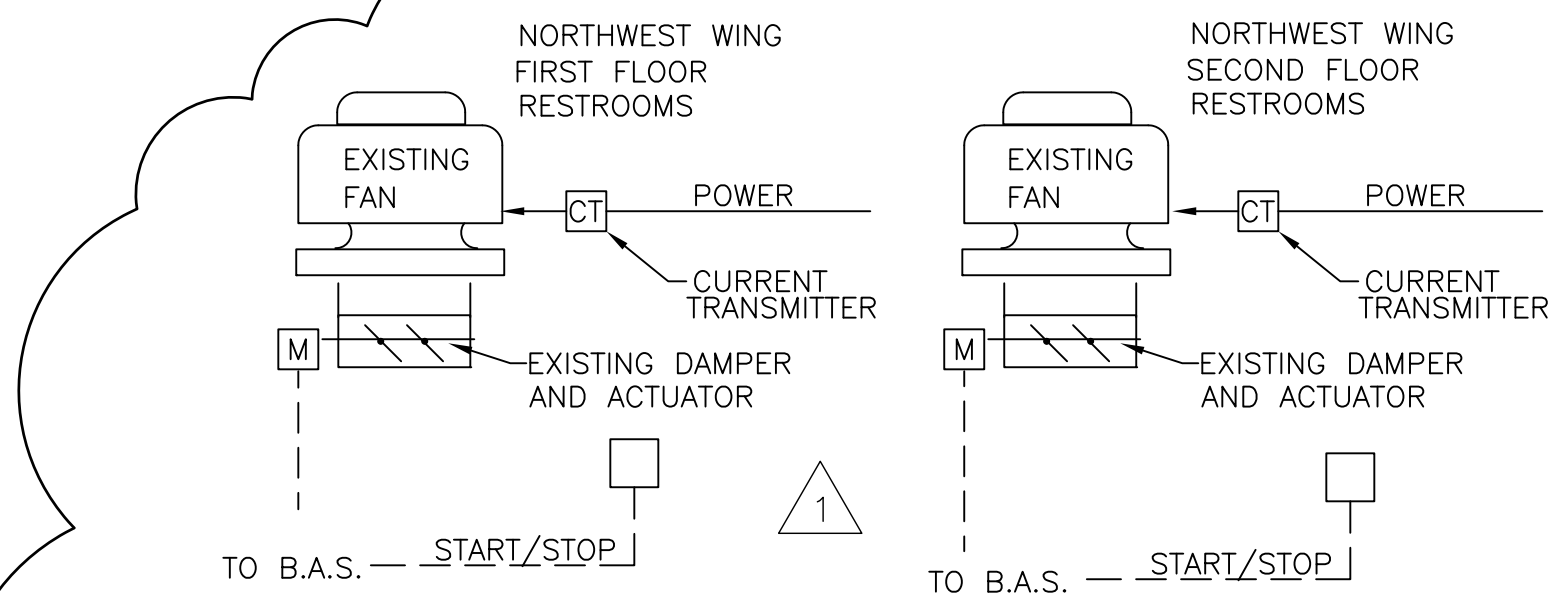

EXHAUST FANS - NORTHWEST WING SEQUENCE OF OPERATION

- OCCUPIED MODE ALL FANS TO BE ENERGIZED AND ASSOCIATED DAMPERS OPENED 100%
- UNOCCUPIED MODE ALL FANS WILL BE DISABLED AND ASSOCIATED DAMPER CLOSED 100%
- OVERRIDE MODE IF ANY OVERRIDE THERMOSTAT BUTTON IN THE NORTHWEST WING IS ACTIVATED ENERGIZE FANS AND OPEN ALL DAMPERS

WEST WING RESTROOM EXHAUST FANS CONTROL POINTS										
POINT DESCRIPTION	GRAPHIC	ANALOG INPUT	ANALOG OUTPUT	BINARY INPUT	BINARY OUTPUT	ALARM	ANALOG VARIABLE	BINARY VARIABLE	TREND LOG	NOTES
START/STOP	X			X	X					1
ISOLATION DAMPER	X			X	X					2
NOTES										
1. START/STOP ON OCCUPIED/UNOCCUPIED CYCLE.										
2. END SWITCH ON DAMPER ACTUATOR										

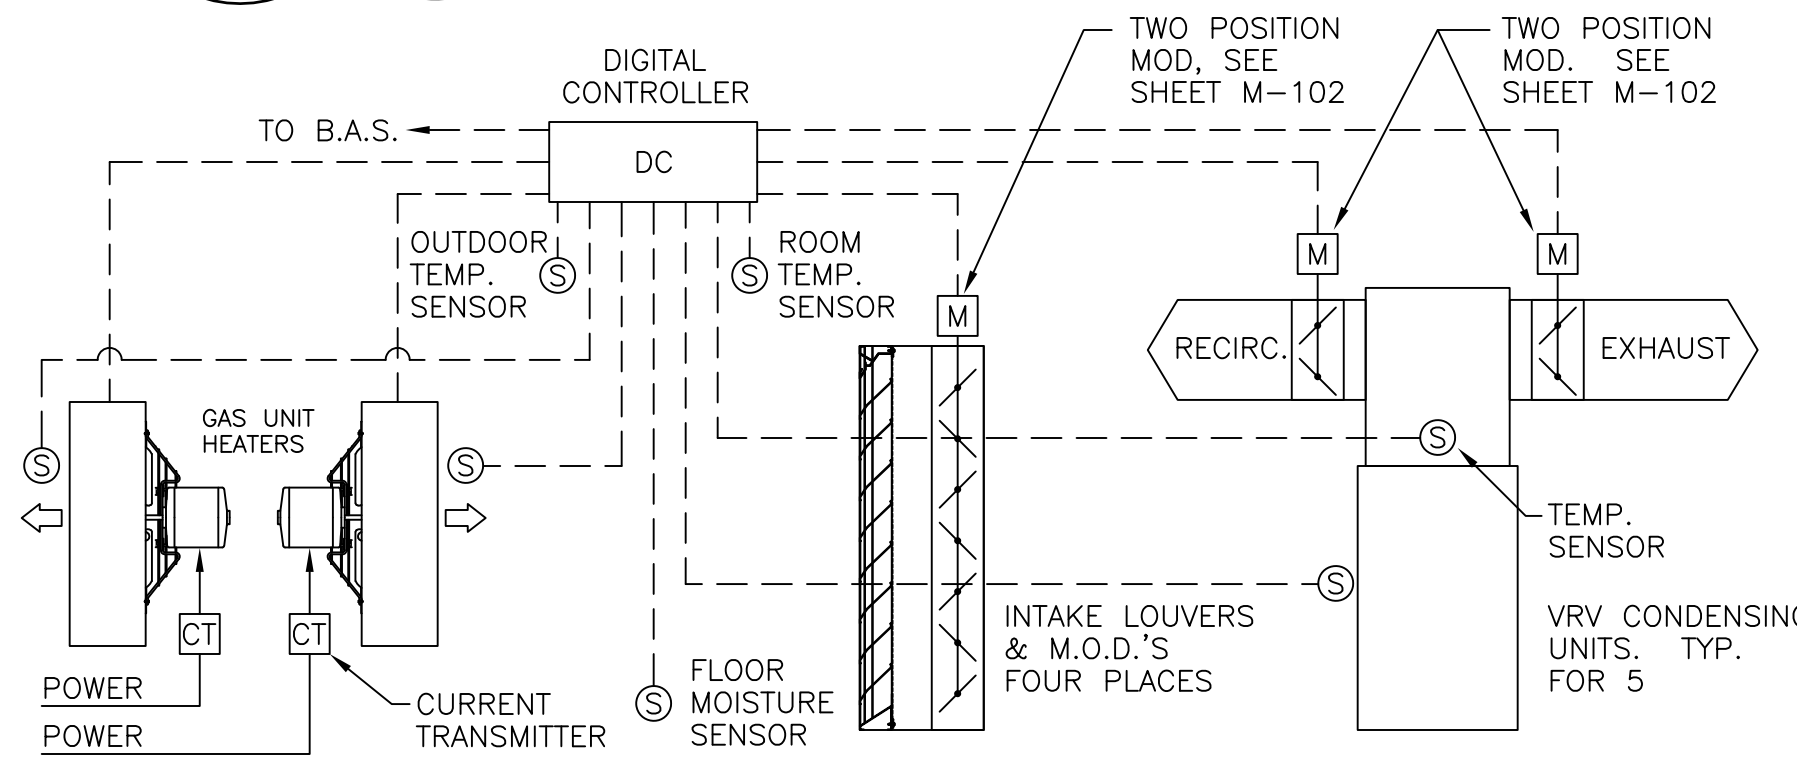

GAS FIRED UNIT HEATERS AND EQUIPMENT ROOM SEQUENCE OF OPERATION

- THE DDC SYSTEM SHALL MONITOR THE OPERATING MODE (HEAT OR COOL) OF THE VRV SYSTEM VIA THE VRV MANUFACTURER'S BACNET GATEWAY.
- IF THE VRV SYSTEM CONDENSING UNITS ARE IN THE COOLING MODE (HEAT REJECTION) THE VRV SYSTEM AIR INTAKE DAMPERS SHALL BE OPEN. THE CONDENSING UNIT EXHAUST AIR DAMPERS SHALL BE OPEN AND THE CONDENSING UNIT RECIRCULATING AIR DAMPERS SHALL BE CLOSED.
- IF THE VRV SYSTEM OUTDOOR (CONDENSING) UNITS ARE IN THE HEATING MODE (HEAT ABSORPTION) AND OUTSIDE AIR TEMPERATURE IS ABOVE 25°F. (ADJUSTABLE THROUGH THE DDC CONTROLS) THE VRV SYSTEM AIR INTAKE DAMPERS SHALL BE OPEN. THE CONDENSING UNIT EXHAUST AIR DAMPERS SHALL BE OPEN AND THE CONDENSING UNIT RECIRCULATING AIR DAMPERS SHALL BE CLOSED.
- WHEN OUTSIDE AIR TEMPERATURE FALLS BELOW 25°F. (ADJUSTABLE THROUGH THE DDC CONTROLS) THE VRV SYSTEM AIR INTAKE DAMPERS SHALL CLOSE. THE CONDENSING UNIT EXHAUST AIR DAMPERS SHALL CLOSE AND THE CONDENSING UNIT RECIRCULATING AIR DAMPERS SHALL OPEN.
- MECHANICAL ROOM SPACE TEMPERATURE SHALL BE MAINTAINED AT 25°F. BY CYCLING FOUR STAGES OF HEATING (2 STAGES AT EACH GAS FIRED UNIT HEATER) USING LEAD-1/LEAD-2/LAG-1/LAG-2 SEQUENCING. THE LEAD UNIT HEATER SHALL ROTATE EACH MONTH FOR EQUAL WEAR ON THE EQUIPMENT. EQUIPMENT RUN TIME TOTAL SHALL BE DISPLAYED ON THE GUI.
- REFER TO NOTES ASSOCIATED WITH POINTS LIST FOR SYSTEM ALARMS TO BE REPORTED TO THE GUI.
- ALL TEMPERATURE SETPOINTS SHALL BE ADJUSTABLE.

EQUIPMENT ROOM GAS UNIT HEATERS AND DAMPERS										
POINT DESCRIPTION	GRAPHIC	ANALOG INPUT	ANALOG OUTPUT	BINARY INPUT	BINARY OUTPUT	ALARM	ANALOG VARIABLE	BINARY VARIABLE	TREND LOG	NOTES
CURRENT TRANSMITTER (2)	X		X							X
DISCHARGE TEMP. (EA OUTDOOR UNIT)	X	X				X	X			X
DISCHARGE TEMP. (EA UNIT HEATER)	X	X				X	X			X
EQUIPMENT ROOM FLOOR MOISTURE SENSOR	X			X		X	X			2
EQUIPMENT ROOM SPACE TEMPERATURE	X	X				X	X			4
INLET TEMP SENSOR (EA OUTDOOR UNIT)	X		X			X	X			X
OU-X EXHAUST AIR DAMPER	X			X	X					1,6
OU-X RECIRCULATION AIR DAMPER	X			X	X					1,6
UH-X ALARM FAULT	X			X	X					4,5
UH-X HEATING STAGE 1	X			X						4,6
UH-X HEATING STAGE 2	X			X						4,6
VRV SYSTEM INTAKE DAMPERS	X			X	X					6

- NOTES:
- POINT TYPICAL FOR EACH CONDENSING UNIT.
 - GENERATE MAINTENANCE ALARM AT GUI IF WATER IS SENSED ON FLOOR AT INTAKE LOUVER
 - GENERATE ALARM AT GUI IF SPACE TEMPERATURE DROPS BELOW 15°F.
 - POINT TYPICAL FOR TWO GAS FIRED UNIT HEATERS.
 - GENERATE ALARM AT GUI IF UNIT HEATER CONTROLLER INDICATED AN ALARM CONDITION.
 - TOTALIZE RUN TIME AND DISPLAY RUN TIME ON GUI GRAPHICS

VRV SYSTEMS SEQUENCE OF OPERATION

- EACH CONDENSING UNIT AND ASSOCIATED INDOOR AIR HANDLERS SHALL BE CONTROLLED BY EQUIPMENT PROVIDED BY THE MANUFACTURER OF THE VRV SYSTEMS. CONTROLS SHALL CONSIST OF (BUT NOT LIMITED TO) THE FOLLOWING:
 - REMOTE WALL MOUNTED THERMOSTATS FOR EACH AIR HANDLER (OR GROUP OF AIR HANDLERS) AS INDICATED ON DRAWINGS.
 - A CENTRALIZED CONTROLLER WITH GUI TO INDICATE...
 - STATUS OF EACH SYSTEM
 - TEMPERATURE SETPOINTS OF EACH THERMOSTAT
 - ACTUAL SPACE CONDITIONS
 - AUTOMATIC TEMPERATURE CHANGEOVER FROM HEATING TO COOLING FOR EACH SPACE.
- SYSTEM MANAGER WHICH SHALL SERVE AS A BACNET INTERFACE FOR AN EXTERNAL BUILDING AUTOMATION SYSTEM (BAS) FOR REMOTE MONITORING, SETPOINT ADJUSTMENT, ALARMING AND CONTROL OF THE VRV SYSTEMS. SEE SYSTEM DIAGRAMS ON SHEET M-202 AND POINTS LIST BELOW.
- CONDENSING UNITS SHALL HAVE INTERNAL CONTROLS TO VARY REFRIGERANT VOLUME TO AIR HANDLERS BASED ON LOAD CONDITIONS, ANTI-CYCLING, DEFROST, ETC.
- PROVIDE A MEANS OF OVERRIDING THE OCCUPIED/UNOCCUPIED SEQUENCE AT THE BAS AT EACH ROOM THERMOSTAT FOR A PERIOD OF TIME TO BE SET AT THE BAS. THE SETPOINT DIFFERENCES BETWEEN OCCUPIED AND UNOCCUPIED TIMES AND TEMPERATURES SHALL BE DETERMINED AT THE BAS.
- ALL POINTS LISTED BELOW SHALL BE DISPLAYED ON THE BAS G.U.I.

VRV SYSTEM BACnet/IP SERVER GATEWAY POINTS LIST

SYSTEM CONFIGURATION POINTS LINKED TO ITM (INTELLIGENT TOUCH MANAGER) CONTROL LOGIC (ONE SET OF POINTS PER ITM):


POINT NAME	POINT DESCRIPTION
ENABLE ITM SCHEDULE OPERATION	ENABLE OR DISABLE ITM SCHEDULE OPERATION
ENABLE ITM AUTO CHANGEOVER OPERATION	ENABLE OR DISABLE ITM AUTO CHANGEOVER LOGIC.
TIMED OVERRIDE MINUTES	SET OVERRIDE TIME IN MINUTES
SYSTEM FORCED OFF	THE FORCED SYSTEM STOP COMMAND WILL FORCE THE INDOOR UNIT TO STOP RUNNING. REMOTE CONTROLLERS WILL BE LOCKED OUT FROM RESTARTING INDOOR UNITS DURING THE FORCED SYSTEM STOP EVENT.

INDOOR UNIT MONITORING POINTS (ONE SET OF POINTS PER INDOOR UNIT):

POINT NAME	POINT DESCRIPTION
UNIT ON/OFF STATUS	MONITORS IF THE INDOOR UNIT FAN IS ON OR OFF
ALARM STATUS	MONITORS WHETHER OR NOT THE INDOOR UNIT IS OPERATING NORMALLY, AND ISSUES AN ALARM IF THE INDOOR UNIT HAS A MALFUNCTION. ERROR CODE IS SHOWN IN THE DESCRIPTION.
ROOM TEMPERATURE	MONITORS AND DISPLAYS THE ROOM TEMPERATURE.
UNIT ON DETAILS	INDOOR UNIT DETAILS OPERATION OFF - NORMAL (ON) - OVERRIDE - SETBACK
FILTER SIGN STATUS	MONITORS FILTER RUN TIME AND PROVIDES SERVICE ALERT.
INDOOR FAN STATUS	MONITORS IF THE INDOOR UNIT FAN IS ON OR OFF
COMMUNICATION STATUS	MONITOR IF THE COMMUNICATION IS NORMAL OR IN ALARM
THERMO-ON STATUS	MONITORS WHETHER OR NOT THE INDOOR UNIT IS ACTIVELY COOLING OR HEATING.
COMPRESSOR STATUS	MONITORS IF THE COMPRESSOR OF THE OUTDOOR UNIT IS ON/OFF/DEFROST
AUX HEATER STATUS	MONITORS IF THE EXTERNAL HEATER (IF PROVIDED) CONTROLLED BY THE INDOOR UNIT IS OPERATING.
CHANGEOVER OPTION	MONITOR IF ITM CHANGEOVER LOGIC IS ACTIVE.

INDOOR UNIT MONITORING AND CONTROL POINTS (ONE SET OF POINTS PER INDOOR UNIT):

POINT NAME	POINT DESCRIPTION
OCCUPANCY MODE	SET THE OCCUPANCY OF THE INDOOR UNIT OCCUPIED, UNOCCUPIED OR STANDBY
OPERATION MODE	SET COOL - HEAT - FAN - DRY OPERATION MODE. FOR THE INDOOR UNIT AND MONITORS THE LATEST MODE
OCC COOLING SETPOINT	SETS THE OCCUPIED COOLING SETPOINT OF THE INDOOR UNIT AND MONITORS THE LATEST SETPOINT VALUE.
OCC HEATING SETPOINT	SETS THE OCCUPIED HEATING SETPOINT OF THE INDOOR UNIT AND MONITORS THE LATEST SETPOINT VALUE.
UNOCC COOLING SETPOINT	SETS THE UNOCCUPIED COOLING SETPOINT OF THE INDOOR UNIT AND MONITORS THE LATEST SETPOINT VALUE.
UNOCC HEATING SETPOINT	SETS THE UNOCCUPIED HEATING SETPOINT OF THE INDOOR UNIT AND MONITORS THE LATEST SETPOINT VALUE.
MAX COOLING SETPOINT	SETS THE MAXIMUM COOLING SETPOINT OF THE INDOOR UNIT AND MONITORS THE LATEST SETPOINT VALUE.
MIN COOLING SETPOINT	SETS THE MINIMUM COOLING SETPOINT OF THE INDOOR UNIT AND MONITORS THE LATEST SETPOINT VALUE.
MAX HEATING SETPOINT	SETS THE MAXIMUM HEATING SETPOINT OF THE INDOOR UNIT AND MONITORS THE LATEST SETPOINT VALUE.
MIN HEATING SETPOINT	SETS THE MINIMUM HEATING SETPOINT OF THE INDOOR UNIT AND MONITORS THE LATEST SETPOINT VALUE.
MIN SETPOINT DIFFERENTIAL (COOLING & HEATING)	SET THE MINIMUM DIFFERENTIAL VALUE BETWEEN COOLING AND HEATING SETPOINT AND MONITOR THE LATEST DIFFERENTIAL VALUE.
COOLING & HEATING SETPOINT TRACKING MODE	ENABLE OR DISABLE ITM SETPOINT TRACKING MODE.
FAN SPEED	SETS THE INDOOR UNIT FAN SPEED AND MONITORS THE LATEST SETTING
TIMED OVERRIDE OPERATION	ENABLE OR DISABLE ITM OVERRIDE TIMER
REMOTE CONTROLLER PROHIBIT (ON/OFF)	PERMITS OR PROHIBITS THE REMOTE CONTROLLER TO CONTROL THE INDOOR UNIT'S ON/OFF.
REMOTE CONTROLLER PROHIBIT (OPERATION MODE)	PERMITS OR PROHIBITS THE REMOTE CONTROLLER TO CONTROL THE INDOOR UNIT'S OPERATION MODE.
REMOTE CONTROLLER PROHIBIT (SETPOINT)	PERMITS OR PROHIBITS THE REMOTE CONTROLLER TO CONTROL THE INDOOR UNIT'S SETPOINT.
FILTER SIGN RESET	CLEAR THE FILTER SIGN STATUS.
FORCED THERMO-OFF	FORCE THE INDOOR UNIT TO STOP ACTIVELY COOLING OR HEATING.

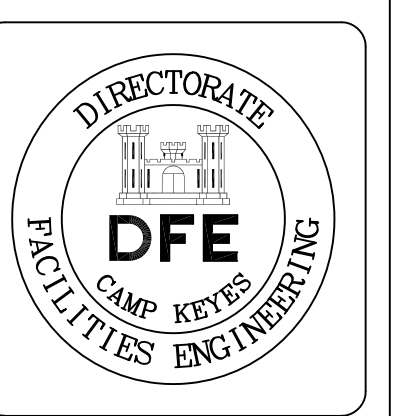


PLAN REVISIONS		Date	Appr.
1	GENERAL REVISIONS	1.28.19	

DESIGNED BY: REM	CHECKED BY: REM	DATE: 12/28/2018	SCALE: NONE	DFE PROJECT NO: 235R18-458-D
STATE OF MAINE DEPARTMENT OF DEFENSE, VETERANS AND EMERGENCY MANAGEMENT				
Corjia Capital Projects Group				
16 Tenney Lane, Suite 23 Carmen, Maine 04843				
207-236-9970 / mdaig@corjia.com				

CAMP KEYES REUTILIZATION PROJECT
CAMP KEYES, AUGUSTA, MAINE
BUILDING NO. 7 RENOVATIONS
MECHANICAL SEQUENCE OF OPERATION AND CONTROL DIAGRAMS


PLAN PROGRESS	
<input type="checkbox"/>	DRAFT
<input type="checkbox"/>	35% REVIEW
<input type="checkbox"/>	65% REVIEW
<input type="checkbox"/>	95% REVIEW
<input type="checkbox"/>	FINAL REVIEW
<input checked="" type="checkbox"/>	FOR BIDDING
<input type="checkbox"/>	ISSUED FOR CONSTRUCTION
<input type="checkbox"/>	RECORD DRAWINGS

SHEET ID:
M-205
SHEET: 103 OF 126

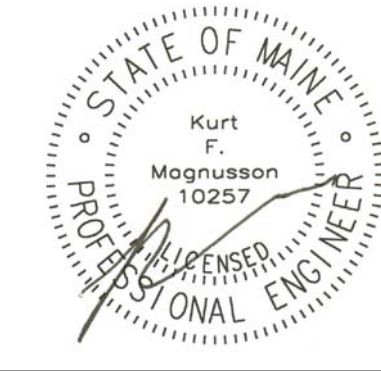

MECHANICAL SYSTEMS ENGINEERS
ROYAL RIVER CENTER, UNIT 108
10 FOREST FALLS DRIVE, YARMOUTH, MAINE 04096
(207) 948-1441
FACEBOOK: MECHANICAL SYSTEMS ENGINEERS
CELEBRATING 50 YEARS IN BUSINESS
© COPYRIGHT 2018



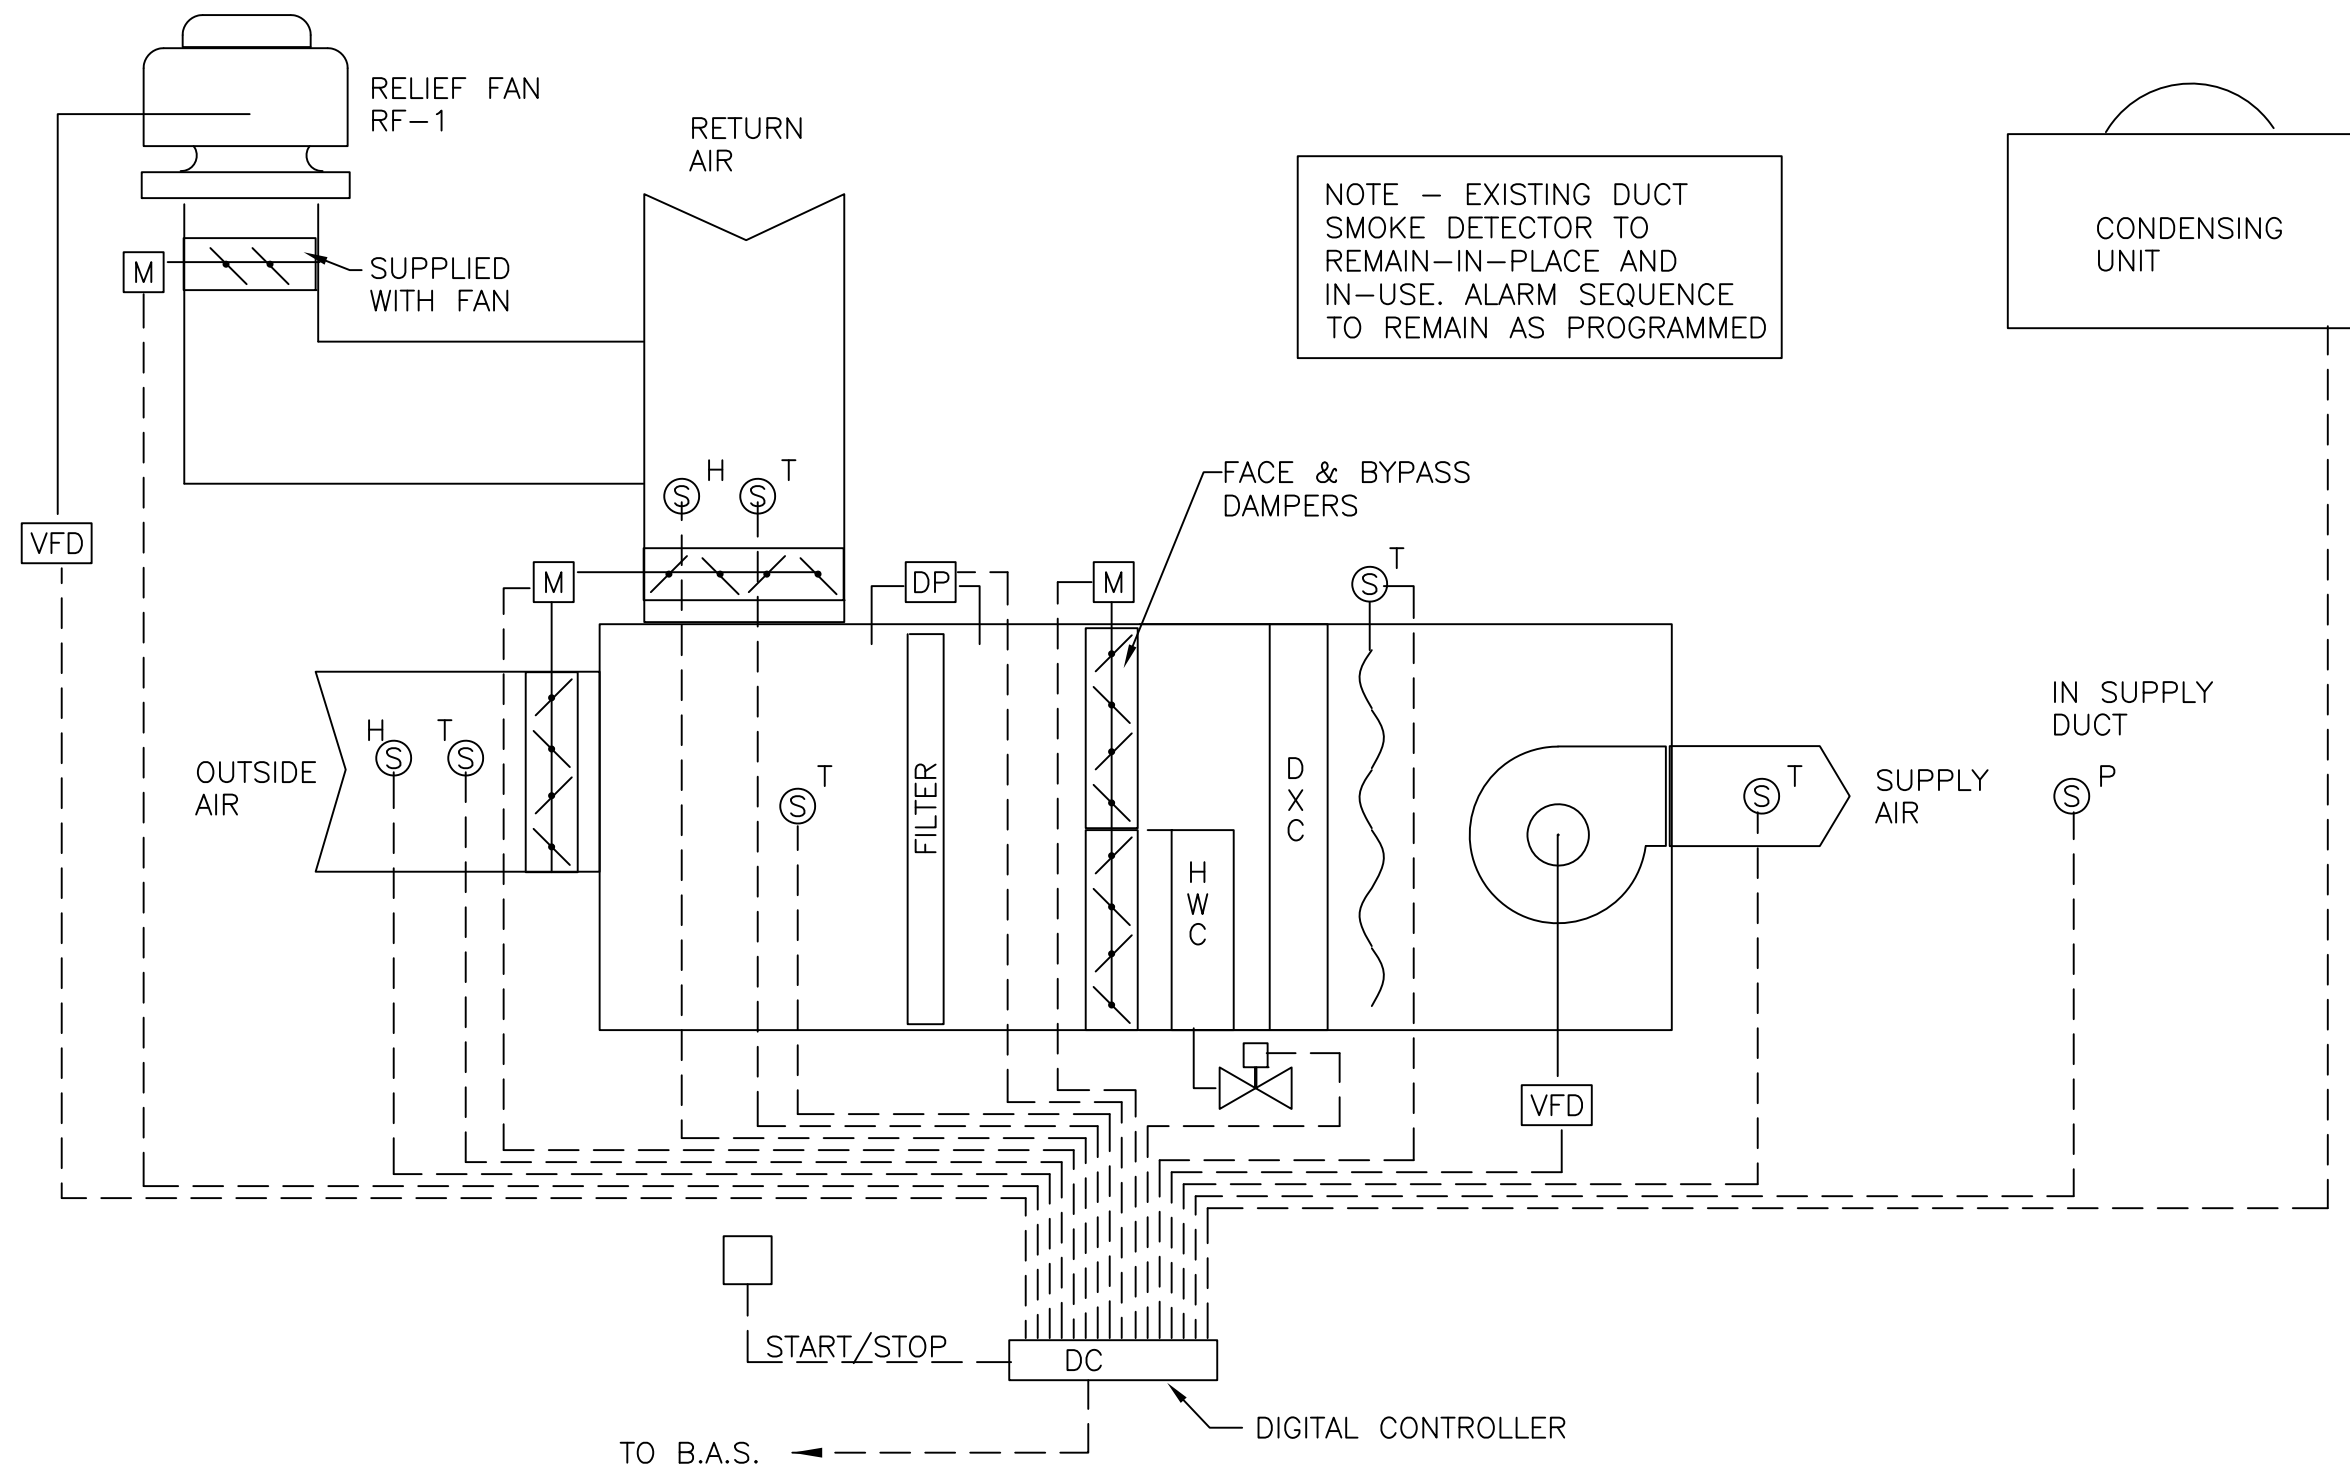


AIR HANDLER - NORTHWEST WING SEQUENCE OF OPERATION

- A. OCCUPIED MODE**
 ENABLE SUPPLY FAN AND CONTROL FAN SPEED VIA THE EXISTING VFD TO MAINTAIN A CONSTANT PRESSURE SET AT 0.75"W.C. (ADJUSTABLE).
 MAINTAIN A CONSTANT SUPPLY AIR TEMPERATURE OF 55-60 DEG. F (ADJUSTABLE). FIRST STAGE TO BE THE ECONOMIZER CYCLE MIXING OUTDOOR AIR WITH RETURN AIR. THE MIX OF RETURN AIR TO OUTSIDE AIR TO BE DETERMINED BY OUTSIDE ENTHALPY/INSIDE AIR ENTHALPY COMPARATIVE ALGORITHM CALCULATION. SECOND STAGE COOLING TO BE FIRST STAGE DX COOLING, THIRD STAGE COOLING TO BE SECOND STAGE DX COOLING. ON A CALL FOR HEATING ENABLE MODULATING HEATING COIL VALVE IN AIR HANDLER WHEN OUTDOOR TEMPERATURE IS ABOVE 40 DEG. F. (ADJUSTABLE) - BELOW 40 DEG. F, OUTDOOR TEMPERATURE OPEN VALVE 100% AND MODULATED FACE AND BYPASS DAMPERS TO MAINTAIN SUPPLY AIR TEMPERATURE AT SETPOINT.
- B. UNOCCUPIED MODE**
 DISABLE AIR HANDLING UNIT, CONDENSING UNIT AND HEATING VALVE. CLOSE ALL DAMPERS.
- C. OVERRIDE MODE**
 ALL WALL SENSORS WILL HAVE OCCUPIED OVERRIDE BUTTON. ENABLE OCCUPIED CYCLE FOR 4 HOURS (ADJUSTABLE).
- D. SAFETY MODE - SMOKE DETECTOR**
 IF THE SMOKE DETECTOR ALARM CONDITION IS DETECTED DISABLE AIR HANDLING UNIT, CONDENSING UNIT AND CLOSE ALL DAMPERS.
- E. SAFETY MODE - EMERGENCY SHUTDOWN**
 WHEN ANY OF THE SIX BUILDING EMERGENCY SHUTDOWN BUTTONS IS ACTIVATED DISABLE AIR HANDLING UNIT, CONDENSING UNIT AND CLOSE ALL DAMPERS.
- F. SAFETY MODE - HOT WATER COIL FREEZE PROTECTION**
 UPON DETECTION OF POSSIBLE FREEZING CONDITIONS AT THE FULL-FACE SENSOR AT THE DISCHARGE OF THE HEATING COIL OPEN THE HEATING VALVE TO THE FULL OPEN POSITION AND ACTIVATE THE FACE AND BYPASS DAMPER TO ACCOMPLISH 100% BYPASS OF THE HEATING COIL.

POINT DESCRIPTION	GRAPHIC	ANALOG INPUT	ANALOG OUTPUT	BINARY INPUT	BINARY OUTPUT	ALARM	ANALOG VARIABLE	BINARY VARIABLE	TREND LOG	NOTES
START/STOP	X	X	X							
OUTSIDE AIR INTAKE TEMPERATURE	X	X	X							X
OUTSIDE AIR HUMIDITY	X	X	X							X
RETURN AIR TEMPERATURE	X	X	X							X
RETURN AIR HUMIDITY	X	X	X							X
SUPPLY AIR TEMPERATURE SETPOINT	X	X	X							X
SUPPLY AIR TEMPERATURE COMMAND	X	X	X							X
SUPPLY AIR TEMPERATURE	X	X	X							X
MIXED AIR TEMPERATURE COMMAND	X	X	X							X
MIXED AIR TEMPERATURE	X	X	X							X
RELIEF FAN VFD STATUS	X	X	X				X			X
RELIEF FAN ISOLATION DAMPER STATUS	X			X	X					2
FILTER DIFFERENTIAL PRESSURE SETPOINT	X			X	X					
FILTER DIFFERENTIAL STATUS	X			X	X					
COIL LEAVING TEMPERATURE SENSOR	X	X	X				X			X
OUTSIDE AIR DAMPER POSITION	X	X	X							X
RETURN AIR DAMPER POSITION	X	X	X							X
SUPPLY AIR PRESSURE SETPOINT	X			X	X					X
SUPPLY AIR PRESSURE	X			X	X					X
SUPPLY AIR VFD STATUS	X	X	X							X
CONDENSING UNIT COMMAND	X									X
HOT WATER CONTROL VALVE STATUS	X	X	X							X

NOTES
 1. RESULT OF ALGORITHM CALCULATION
 2. END SWITCH ON DAMPER

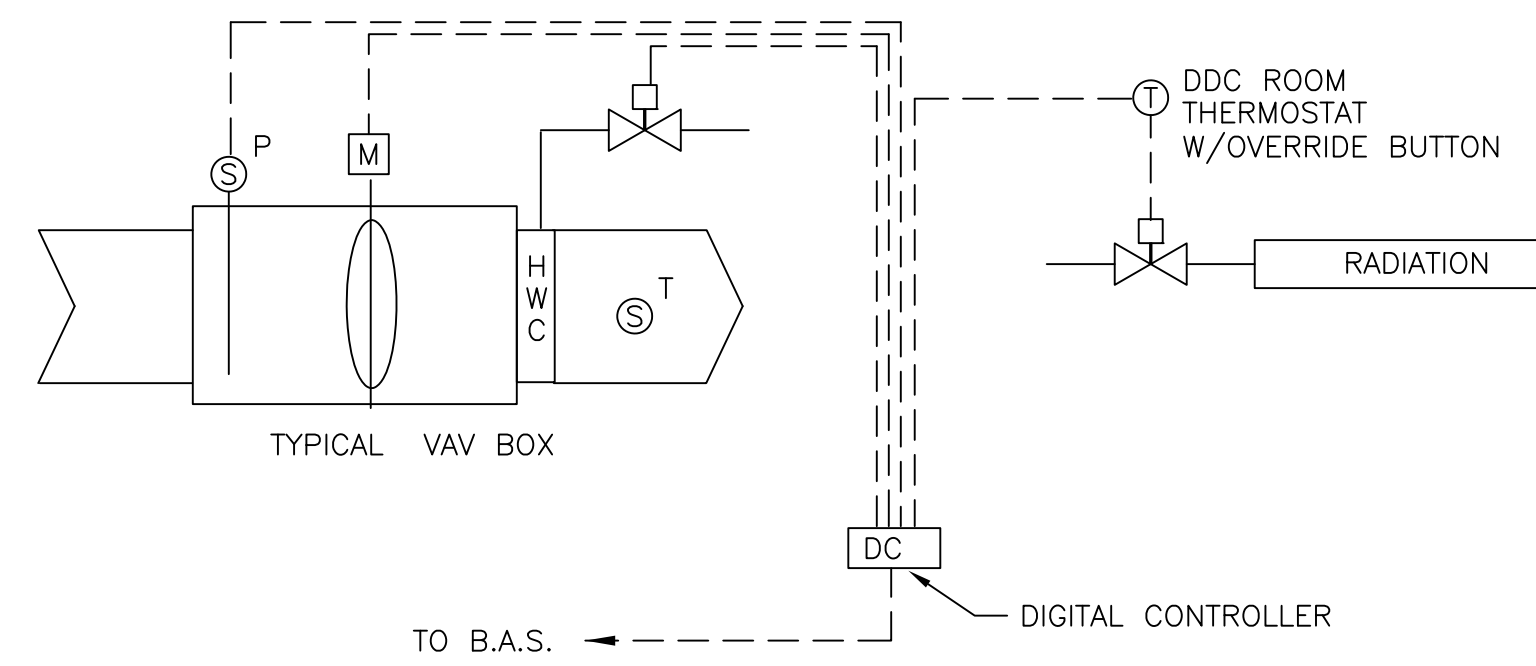


VAV BOXES - NORTHWEST WING SEQUENCE OF OPERATION

- A. OCCUPIED MODE**
 WHEN IN COOLING MODE MODULATE THE DAMPER ABOVE MINIMUM POSITION TO MAINTAIN ROOM SETPOINT.
 WHEN IN HEATING MODE DAMPER TO BE IN MINIMUM POSITION (UNLESS OVERRIDDEN BY THE CO2 CONTROL SEQUENCE) ALSO MAINTAIN A MINIMUM DISCHARGE TEMPERATURE OF 65 DEG F. (ADJUSTABLE). FIRST STAGE HEATING TO ENERGIZE ASSOCIATED 2-POSITION RADIATION VALVE. SECOND STAGE HEATING TO MODULATE HEATING COIL CONTROL VALVE TO MAINTAIN ROOM SETPOINT.
- B. UNOCCUPIED MODE**
 VAV AND AIR HANDLING SYSTEM WILL BE DISABLED AND HEATING TEMPERATURE (ADJUSTABLE) MAINTAINED BY THE RADIATION.
- C. OVERRIDE MODE**
 ALL WALL SENSORS WILL HAVE OCCUPIED OVERRIDE BUTTON. ENABLE OCCUPIED CYCLE FOR ONLY THE VAV BOXES ON THE FLOOR WITH THE OVERRIDE CALL.

POINT DESCRIPTION	GRAPHIC	ANALOG INPUT	ANALOG OUTPUT	BINARY INPUT	BINARY OUTPUT	ALARM	ANALOG VARIABLE	BINARY VARIABLE	TREND LOG	NOTES
MINIMUM DAMPER POSITION SETPOINT - CFM	X	X	X							X
MAXIMUM DAMPER POSITION SETPOINT - CFM	X	X	X							X
COMMAND DAMPER SETPOINT - CFM	X	X	X							X
ACTUAL CFM	X	X	X							X
HOT WATER CONTROL VALVE POSITION	X	X	X			X				X
DISCHARGE AIR TEMPERATURE	X	X	X			X				X
ROOM THERMOSTAT SETPOINT	X	X	X							X
OVERRIDE BUTTON ACTIVATED	X			X	X					
ROOM AIR TEMPERATURE AT THERMOSTAT	X	X	X			X				X
RADIATION CONTROL VALVE COMMAND				X	X					X
RADIATION CONTROL VALVE POSITION				X	X	X				X

NOTES
 1. RESULTS OF ALGORITHM
 2. LIMITS SET ON A PER THERMOSTAT BASIS

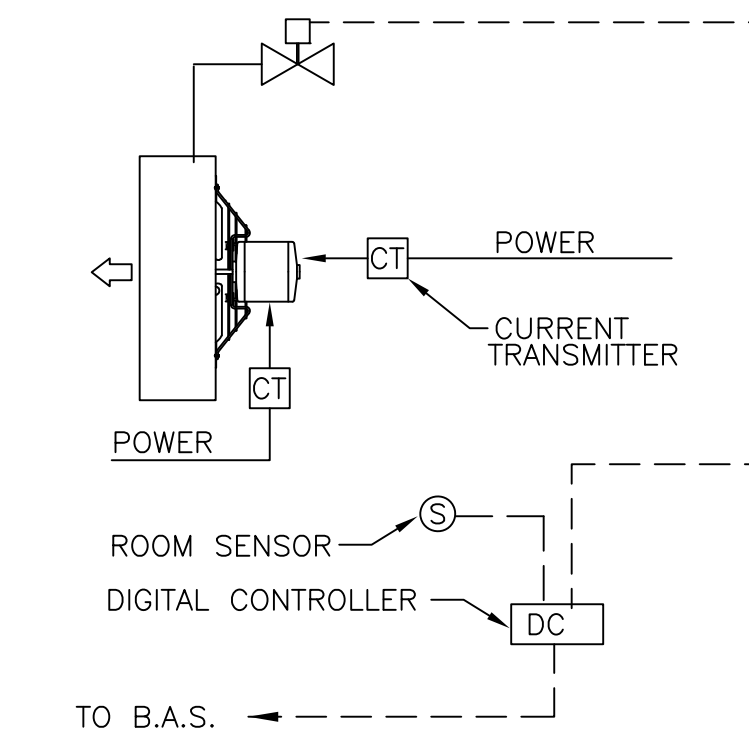


UH-1 - NORTHWEST WING SEQUENCE OF OPERATION

ON A CALL FOR HEAT ENERGIZE CONTROL VALVE & FAN

POINT DESCRIPTION	GRAPHIC	ANALOG INPUT	ANALOG OUTPUT	BINARY INPUT	BINARY OUTPUT	ALARM	ANALOG VARIABLE	BINARY VARIABLE	TREND LOG	NOTES
SENSOR SETPOINT	X									1
FAN STATUS				X	X					X
ROOM TEMPERATURE	X			X	X	X				X

NOTES
 1. ENABLED 24/7.

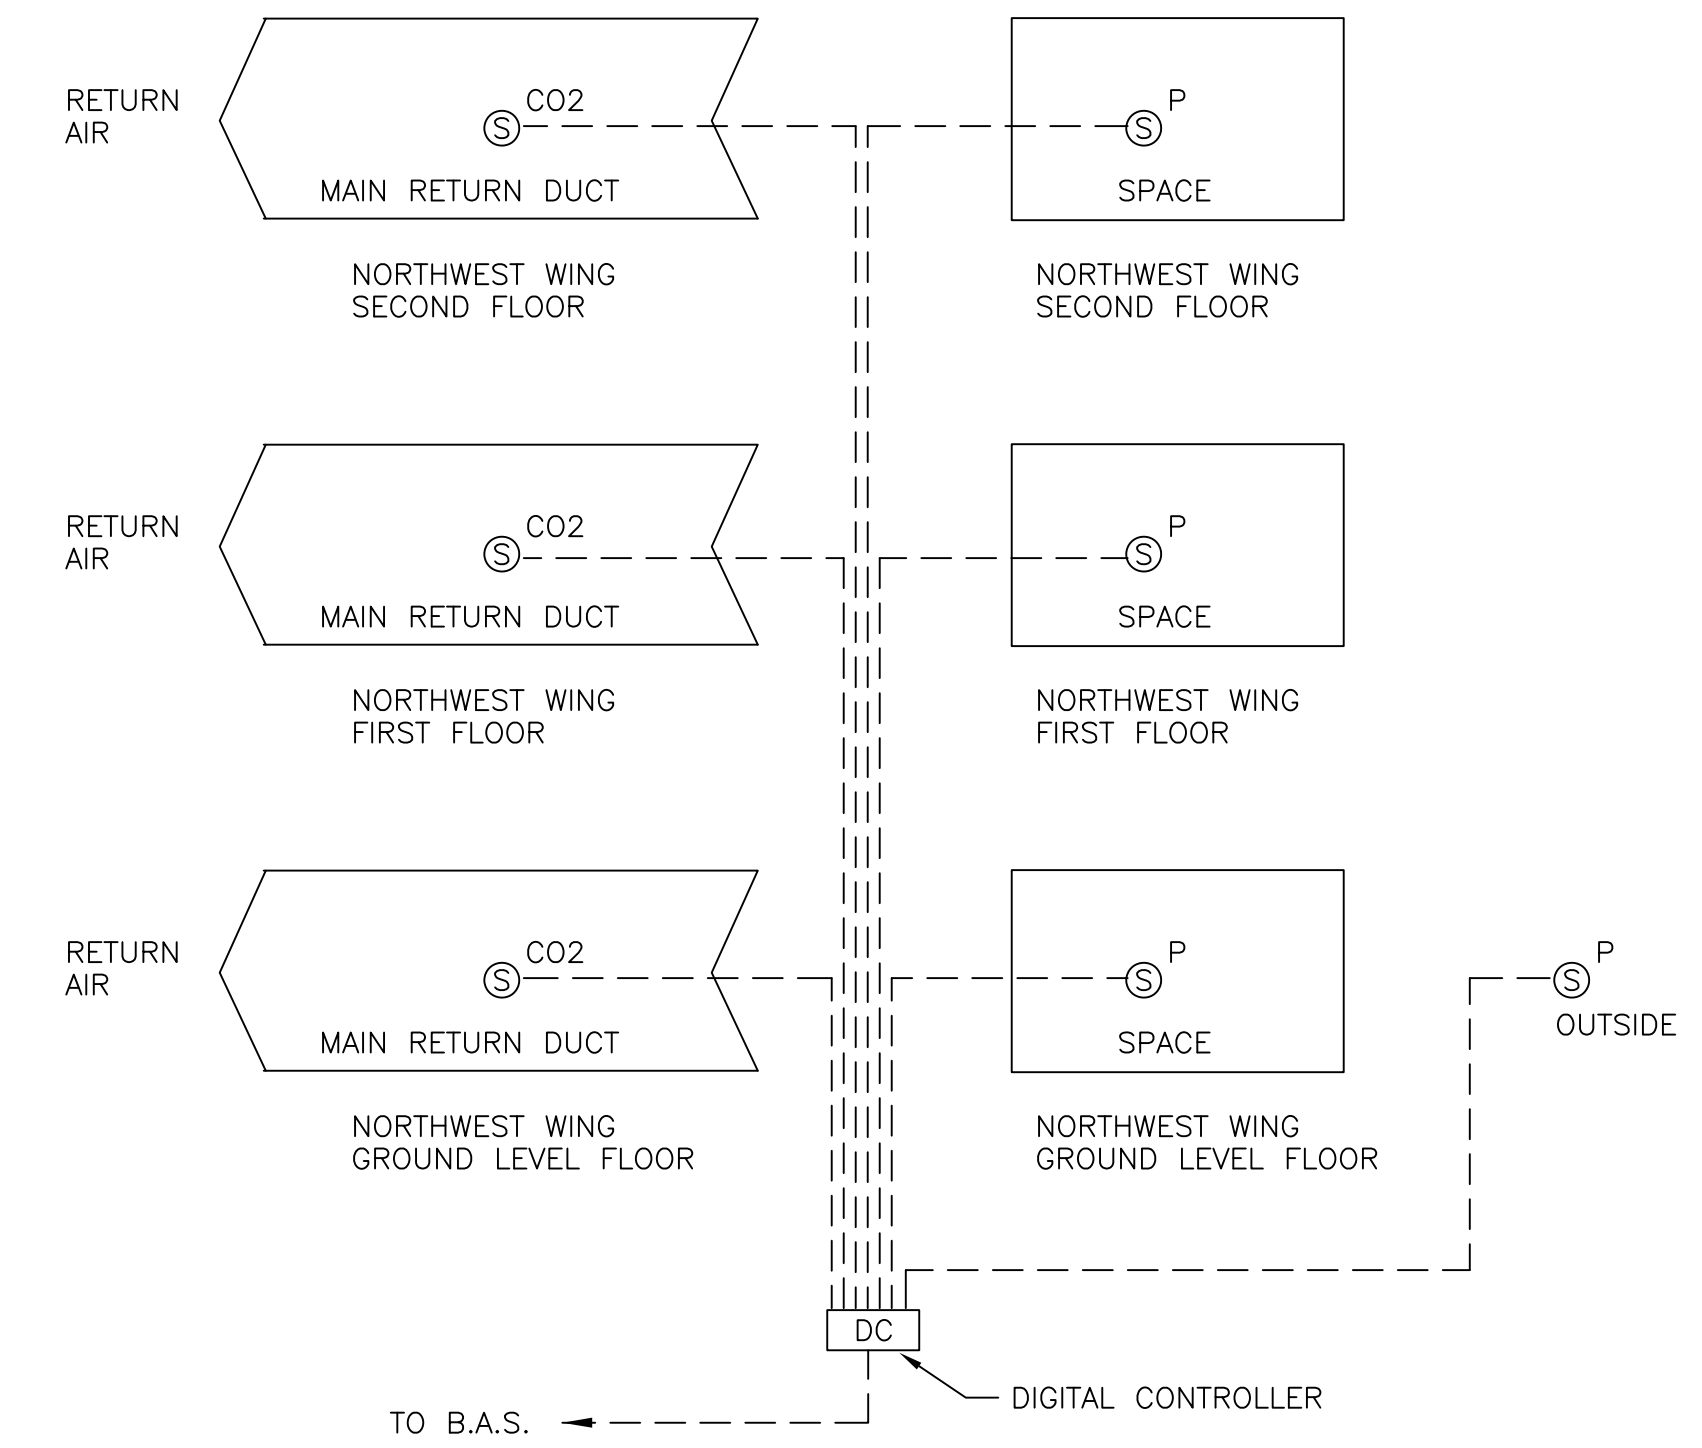


SPACE CO2 LEVEL & BUILDING PRESSURE - NORTHWEST WING SEQUENCE OF OPERATION

- A. OCCUPIED MODE**
 SET AN INCREASE OF THE MINIMUM DAMPER POSITION OF VAV BOXES BASED ON MAINTAINING A MAXIMUM CO2 LEVEL OF 1000 PPM (ADJUSTABLE). MODULATE THE MINIMUM DAMPER POSITION. THIS IS TO BE DONE ON A FLOOR-BY-FLOOR BASIS WITH ALL BOXES ON AN INDIVIDUAL FLOOR PROPORTIONALLY INCREASING DAMPER POSITION.
 THE OUTSIDE AIR DAMPER (UNLESS OVERRIDDEN BY THE ECONOMIZER CONTROL) TO BE A MAXIMUM OF 20% OPEN AND MODULATE DOWN TO MAINTAIN A MAXIMUM OF 800 PPM (ADJUSTABLE).
 AVERAGE THE 3 ROOM PRESSURE CONTROLS AND COMPARE TO THE AMBIENT OUTSIDE PRESSURE TO MAINTAIN A POSITIVE PRESSURE IN THE BUILDING OF 0.05"W.C. (ADJUSTABLE) VIA MODULATING THE VFD OF RELIEF FAN RF-1.
- B. UNOCCUPIED MODE**
 ALL DAMPERS TO BE CLOSED AND RF-1 TO BE DISABLED.
- C. OVERRIDE MODE**
 ALL WALL SENSORS WILL HAVE OCCUPIED OVERRIDE BUTTON. ENABLE OCCUPIED CYCLE FOR ONLY THE VAV BOXES ON THE FLOOR WITH THE OVERRIDE CALL HOURS

POINT DESCRIPTION	GRAPHIC	ANALOG INPUT	ANALOG OUTPUT	BINARY INPUT	BINARY OUTPUT	ALARM	ANALOG VARIABLE	BINARY VARIABLE	TREND LOG	NOTES
RETURN CO2 LEVEL EACH FLOOR	X	X	X							X
RETURN CO2 LEVEL AVE OF 3 FLOORS	X	X	X			X				X
RETURN CO2 SETPOINT EACH FLOOR	X	X	X							X
RETURN CO2 SETPOINT AVERAGE	X	X	X							X
SPACE PRESSURE EACH FLOOR	X	X	X							X
SPACE PRESSURE AVERAGE	X	X	X							X
OUTSIDE PRESSURE	X	X	X							X
COMMAND PRESSURE DIFFERENTIAL	X	X	X							X

NOTES
 1. SET AT POSITIVE PRESSURE 0.05" ADJUSTABLE

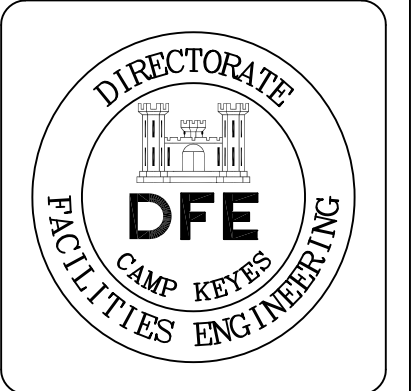

Rev#	Description	Date	Appr.
1	GENERAL REVISIONS		
1.28.19			

DESIGNED BY: KFM
 DRAWN BY: KFM
 CHECKED BY: KFM/MAD
 DATE: 12/28/2018
 SCALE: NONE
 DFE PROJECT NO: 235918-458-D

STATE OF MAINE
 DEPARTMENT OF DEFENSE, VETERANS AND EMERGENCY MANAGEMENT
 Cordja Capital Projects Group
 16 Tannery Lane, Suite 23
 Camden, Maine 04843
 207-236-9970 / mdsigle@cdjocpg.com

CAMP KEYES REUTILIZATION PROJECT
 CAMP KEYES, AUGUSTA, MAINE
 BUILDING NO. 7 RENOVATIONS
 MECHANICAL SEQUENCE OF OPERATION AND CONTROL DIAGRAMS

PLAN PROGRESS

DRAFT
 35% REVIEW
 65% REVIEW
 95% REVIEW
 FINAL REVIEW
 FOR BIDDING
 ISSUED FOR CONSTRUCTION
 RECORD DRAWINGS

SHEET ID:
M-206
 SHEET: 104 OF 126



MECHANICAL SYSTEMS ENGINEERS
 ROYAL RIVER CENTER, UNIT 108
 10 FOREST FALLS DRIVE, YARMOUTH, MAINE 04096
 (207) 846-1441
 FACEBOOK: MECHANICAL SYSTEMS ENGINEERS
 CELEBRATING 50 YEARS IN BUSINESS
 © COPYRIGHT 2018



COMPRESSOR/CONDENSER UNIT SCHEDULE

TAG	AREA SERVED	NOM. TONS	COOLING				HEATING				CONDENSER FAN		ELECTRIC (TOTAL LOAD)				REFRIGERANT		WEIGHT LBS	REMARKS
			BTU	AMBIENT	KW	EER	BTU	AMBIENT	KW	COP17	QUAN.	TOTAL CFM	POWER	MCA	BRKR	TYPE	SYSTEM LBS			
CJ-1	SEE AIR HANDLER SCHEDULE	8.0	97,800	95°	5.59	14.6 / 12.6	96,702	20°	7.69	2.52 / 2.25	2	5,827	208V-60-3Ø	38.0	45	R410A	40.7	703	SINGLE POWER CONNECTION	
CJ-2	SEE AIR HANDLER SCHEDULE	10.0	118,790	95°	8.21	13.1 / 12.3	99,703	20°	12.40	2.46 / 2.25	2	6,286	208V-60-3Ø	43.0	50	R410A	71.4	703	SINGLE POWER CONNECTION	
CJ-3	SEE AIR HANDLER SCHEDULE	8.0	90,615	95°	5.59	14.6 / 12.6	93,413	20°	7.69	2.52 / 2.25	2	5,827	208V-60-3Ø	38.0	45	R410A	48.7	703	SINGLE POWER CONNECTION	
CJ-4	SEE AIR HANDLER SCHEDULE	10.0	117,586	95°	8.21	13.1 / 12.3	102,617	20°	12.40	2.46 / 2.25	2	6,286	208V-60-3Ø	43.0	50	R410A	44.8	703	SINGLE POWER CONNECTION	
CJ-5	SEE AIR HANDLER SCHEDULE	8.0	93,518	95°	5.59	14.6 / 12.6	96,871	20°	7.69	2.52 / 2.25	2	5,827	208V-60-3Ø	38.0	45	R410A	40.2	703	SINGLE POWER CONNECTION	

BASIS OF DESIGN: DAIKIN

ENERGY RECOVERY VENTILATOR SCHEDULE

TAG	AREA SERVED	SUPPLY AIR			RETURN / EXHAUST AIR			WINTER CONDITIONS				SUMMER CONDITIONS				WHEEL MOTOR	ELECTRIC	WEIGHT	REMARKS				
		CFM	ESP	HP	CFM	ESP	HP	DB	WB	DB	WB	DB	WB	DB	WB					DB	WB		
ERV-1	WOOD BLDG	1,375	1.10"	1/12	1,310	1.00"	1/12	0.0	-1.0	70.0	58.5	51.5	48.2	94.0	80.0	75.0	62.0	80.0	67.5	>1.0 AMP	208V-60-3Ø	550	HORIZONTAL AIRFLOW
ERV-2	BRICK BLDG	480	0.75"	3/4	455	0.65"	3/4	0.0	-1.0	70.0	58.5	54.1	50.0	94.0	80.0	75.0	62.0	80.0	66.8	>1.0 AMP	208V-60-3Ø	500	VERTICAL AIRFLOW

BASIS OF DESIGN: SEMCO

GAS UNIT HEATER SCHEDULE

TAG	TYPE	AREA SERVED	FUEL	E.A.T.	INPUT MBH	OUTPUT MBH	CFM	MOTOR HP	FAN RPM	FAN RPM	ELECTRIC			WEIGHT	REMARKS	
											POWER	WATTS	FLA			
UH-1	HORIZONTAL	OUTDOOR UNIT ROOM	NAT.	0"	350.00	290.50	4,483	1/2	1,050	1,550	115V-60-1Ø	1,050	11.0	20	295	SEPARATED COMBUSTION
UH-2	HORIZONTAL	OUTDOOR UNIT ROOM	NAT.	0"	350.00	290.50	4,483	1/2	1,050	1,100	115V-60-1Ø	1,050	11.0	20	295	SEPARATED COMBUSTION

BASIS OF DESIGN: REZ NOR

AIR HANDLER SCHEDULE

TAG	AREA SERVED	CU NO.	NOM. TONS	CFM	FAN KW	ELECTRIC		COOLING BTU	HEATING BTU	REFRIGERANT			OUTDOOR AIR CFM	WEIGHT LBS	REMARKS
						POWER	MCA			TYPE	LIQUID	GAS			
AH-01	001	CJ-1	0.60	260	0.040	208V-60-1Ø	0.40	7,500	8,500	R410A	1/4	1/2	N/A	26	DUCTLESS WALL MOUNTED
AH-02	001	CJ-1	0.60	260	0.040	208V-60-1Ø	0.40	7,500	8,500	R410A	1/4	1/2	N/A	26	DUCTLESS WALL MOUNTED
AH-03	002	CJ-1	1.50	500	0.043	208V-60-1Ø	0.50	18,000	20,000	R410A	1/4	1/2	N/A	31	DUCTLESS WALL MOUNTED
AH-04	004	CJ-1	1.50	500	0.043	208V-60-1Ø	0.50	18,000	20,000	R410A	1/4	1/2	N/A	31	DUCTLESS WALL MOUNTED
AH-05	004B	CJ-1	0.60	260	0.040	208V-60-1Ø	0.40	7,500	8,500	R410A	1/4	1/2	N/A	26	DUCTLESS WALL MOUNTED
AH-06	004C	CJ-1	0.60	260	0.040	208V-60-1Ø	0.40	7,500	8,500	R410A	1/4	1/2	N/A	26	DUCTLESS WALL MOUNTED
AH-07	005	CJ-1	1.50	500	0.043	208V-60-1Ø	0.50	18,000	20,000	R410A	1/4	1/2	N/A	31	DUCTLESS WALL MOUNTED
AH-08	006	CJ-1	1.50	500	0.043	208V-60-1Ø	0.50	18,000	20,000	R410A	1/4	1/2	N/A	31	DUCTLESS WALL MOUNTED
AH-09	009	CJ-1	0.60	260	0.040	208V-60-1Ø	0.40	7,500	8,500	R410A	1/4	1/2	N/A	26	DUCTLESS WALL MOUNTED
AH-10	010	CJ-1	1.00	290	0.040	208V-60-1Ø	0.40	12,000	13,500	R410A	1/4	1/2	N/A	26	DUCTLESS WALL MOUNTED
AH-11	010A	CJ-1	1.00	290	0.040	208V-60-1Ø	0.40	12,000	13,500	R410A	1/4	1/2	N/A	26	DUCTLESS WALL MOUNTED
AH-12	007	CJ-2	0.60	260	0.040	208V-60-1Ø	0.40	7,500	8,500	R410A	1/4	1/2	N/A	26	DUCTLESS WALL MOUNTED
AH-13	008	CJ-2	0.60	260	0.040	208V-60-1Ø	0.40	7,500	8,500	R410A	1/4	1/2	N/A	26	DUCTLESS WALL MOUNTED
AH-14	008B	CJ-2	0.60	260	0.040	208V-60-1Ø	0.40	7,500	8,500	R410A	1/4	1/2	N/A	26	DUCTLESS WALL MOUNTED
AH-15	008C	CJ-2	0.60	260	0.040	208V-60-1Ø	0.40	7,500	8,500	R410A	1/4	1/2	N/A	26	DUCTLESS WALL MOUNTED
AH-16	012	CJ-2	2.00	635	0.043	208V-60-1Ø	0.60	24,000	26,500	R410A	3/8	5/8	N/A	31	DUCTLESS WALL MOUNTED
AH-17	013	CJ-2	1.50	500	0.043	208V-60-1Ø	0.50	18,000	20,000	R410A	1/4	1/2	N/A	31	DUCTLESS WALL MOUNTED
AH-18	014	CJ-2	0.60	260	0.040	208V-60-1Ø	0.40	7,500	8,500	R410A	1/4	1/2	N/A	26	DUCTLESS WALL MOUNTED
AH-19	014B	CJ-2	0.60	260	0.040	208V-60-1Ø	0.40	7,500	8,500	R410A	1/4	1/2	N/A	26	DUCTLESS WALL MOUNTED
AH-20	015	CJ-2	1.50	500	0.043	208V-60-1Ø	0.50	18,000	20,000	R410A	1/4	1/2	N/A	31	DUCTLESS WALL MOUNTED
AH-21	016	CJ-2	0.60	260	0.040	208V-60-1Ø	0.40	7,500	8,500	R410A	1/4	1/2	N/A	26	DUCTLESS WALL MOUNTED
AH-22	016A	CJ-2	0.60	260	0.040	208V-60-1Ø	0.40	7,500	8,500	R410A	1/4	1/2	N/A	26	DUCTLESS WALL MOUNTED
AH-23	020	CJ-2	1.00	290	0.040	208V-60-1Ø	0.40	12,000	13,500	R410A	1/4	1/2	N/A	26	DUCTLESS WALL MOUNTED
AH-24	020A	CJ-2	1.50	500	0.043	208V-60-1Ø	0.50	18,000	20,000	R410A	1/4	1/2	N/A	31	DUCTLESS WALL MOUNTED
AH-25	100	CJ-4	1.50	500	0.043	208V-60-1Ø	0.50	18,000	20,000	R410A	1/4	1/2	N/A	31	DUCTLESS WALL MOUNTED
AH-26	101A	CJ-4	0.60	212	0.087	208V-60-1Ø	0.30	7,500	8,500	R410A	1/4	1/2	15	18	CEILING CASSETTE - 1 WAY
AH-27	102	CJ-4	0.60	245	0.087	208V-60-1Ø	0.40	9,500	10,500	R410A	1/4	1/2	25	18	CEILING CASSETTE - 1 WAY
AH-28	102A	CJ-4	0.60	212	0.087	208V-60-1Ø	0.30	7,500	8,500	R410A	1/4	1/2	15	18	CEILING CASSETTE - 1 WAY
AH-29	103	CJ-4	0.60	212	0.087	208V-60-1Ø	0.30	7,500	8,500	R410A	1/4	1/2	25	18	CEILING CASSETTE - 1 WAY
AH-30	104	CJ-4	2.00	530	0.117	208V-60-1Ø	0.70	24,000	27,000	R410A	3/8	5/8	55	22	CEILING CASSETTE - 1 WAY
AH-31	104B	CJ-4	2.00	530	0.117	208V-60-1Ø	0.70	24,000	27,000	R410A	3/8	5/8	55	22	CEILING CASSETTE - 1 WAY
AH-32	104C	CJ-4	1.30	345	0.087	208V-60-1Ø	0.50	15,000	17,000	R410A	1/4	1/2	25	18	CEILING CASSETTE - 1 WAY
AH-33	134	CJ-4	0.60	245	0.087	208V-60-1Ø	0.40	9,500	10,500	R410A	1/4	1/2	25	18	CEILING CASSETTE - 1 WAY
AH-34	134A	CJ-4	0.60	212	0.087	208V-60-1Ø	0.30	7,500	8,500	R410A	1/4	1/2	15	18	CEILING CASSETTE - 1 WAY
AH-35	134B	CJ-4	0.60	212	0.087	208V-60-1Ø	0.30	7,500	8,500	R410A	1/4	1/2	20	18	CEILING CASSETTE - 1 WAY
AH-36	107B	CJ-3	0.60	260	0.040	208V-60-1Ø	0.40	7,500	8,500	R410A	1/4	1/2	N/A	26	DUCTLESS WALL MOUNTED
AH-37	113	CJ-3	2.00	635	0.043	208V-60-1Ø	0.60	24,000	26,500	R410A	3/8	5/8	N/A	31	DUCTLESS WALL MOUNTED
AH-38	208	CJ-5	1.30	405	0.055	208V-60-1Ø	0.40	15,000	17,000	R410A	1/4	1/2	90	36	CEILING CASSETTE - 4 WAY
AH-39	208 & 210	CJ-5	2.00	777	0.056	208V-60-1Ø	0.70	24,000	27,000	R410A	3/8	5/8	40	48	CEILING CASSETTE - 4 WAY
AH-40	211	CJ-5	0.60	212	0.087	208V-60-1Ø	0.30	7,500	8,500	R410A	1/4	1/2	20	18	CEILING CASSETTE - 1 WAY
AH-41	212	CJ-5	1.50	494	0.010	208V-60-1Ø	0.50	18,000	20,000	R410A	1/4	1/2	20	51	CEILING CASSETTE - 1 WAY
AH-42	212E	CJ-5	1.30	405	0.055	208V-60-1Ø	0.40	15,000	17,000	R410A	1/4	1/2	90	36	CEILING CASSETTE - 4 WAY
AH-43	214	CJ-5	0.60	212	0.087	208V-60-1Ø	0.30	7,500	8,500	R410A	1/4	1/2	15	18	CEILING CASSETTE - 1 WAY
AH-44	213 & 215	CJ-5	0.60	245	0.087	208V-60-1Ø	0.40	9,500	10,500	R410A	1/4	1/2	15	18	CEILING CASSETTE - 1 WAY
AH-45	217	CJ-5	0.60	245	0.087	208V-60-1Ø	0.40	9,500	10,500	R410A	1/4	1/2	15	18	CEILING CASSETTE - 1 WAY
AH-46	221	CJ-3	0.60	260	0.040	208V-60-1Ø	0.40	7,500	8,500	R410A	1/4	1/2	N/A	26	DUCTLESS WALL MOUNTED
AH-47	222	CJ-3	0.60	260	0.040	208V-60-1Ø	0.40	7,500	8,500	R410A	1/4	1/2	N/A	26	DUCTLESS WALL MOUNTED
AH-48	223A	CJ-3	0.60	260	0.040	208V-60-1Ø	0.40	7,500	8,500	R410A	1/4	1/2	N/A	26	DUCTLESS WALL MOUNTED
AH-49	224	CJ-3	0.60	260	0.040	208V-60-1Ø	0.40	7,500	8,500	R410A	1/4	1/2	N/A	26	DUCTLESS WALL MOUNTED
AH-50	225	CJ-3	0.60	260	0.040	208V-60-1Ø	0.40	7,500	8,500	R410A	1/4	1/2	N/A	26	DUCTLESS WALL MOUNTED
AH-51	227	CJ-3	0.60	260	0.040	208V-60-1Ø	0.40	7,500	8,500	R410A	1/4	1/2	N/A	26	DUCTLESS WALL MOUNTED
AH-52	227A	CJ-3	0.60	260	0.040	208V-60-1Ø	0.40	7,500	8,500	R410A	1/4	1/2	N/A	26	DUCTLESS WALL MOUNTED
AH-53	228	CJ-3	0.60	260	0.040	208V-60-1Ø	0.40	7,500	8,500	R410A	1/4	1/2	N/A	26	DUCTLESS WALL MOUNTED
AH-54	229	CJ-3	0.60	260	0.040	208V-60-1Ø	0.40	7,500	8,500	R410A	1/4	1/2	N/A	26	DUCTLESS WALL MOUNTED
AH-55	230	CJ-3	0.60	260	0.040	208V-60-1Ø	0.40	7,500	8,500	R410A	1/4	1/2	N/A	26	DUCTLESS WALL MOUNTED
AH-56	004A	CJ-1	0.60	260	0.040	208V-60-1Ø	0.40	7,500	8,500	R410A	1/4	1/2	N/A	26	DUCTLESS WALL MOUNTED

BASIS OF DESIGN: DAIKIN

COOLING CAPACITIES BASED ON 80°/67°F. ENTERING AIR & 95 °F. AT THE CONDENSER (OUTDOOR UNIT)
 HEATING CAPACITIES BASED ON 70°F. INDOOR AND 20°F. AT THE CONDENSER (OUTDOOR UNIT)

BRANCH CIRCUIT CONTROLLER SCHEDULE

TAG	AIR HANDLERS SERVED	OUTDOOR UNIT	POWER	COOLING KW	HEATING KW	MCA	CIRCUITS		REFRIGERANT TYPE	WEIGHT LBS	REMARKS
							USED	PORTS			



NOTES:

1. SEE E-000 FOR LEGEND, ABBREVIATIONS AND GENERAL NOTES.

REMOVAL NOTES:

- (A) REMOVE ELECTRIC BASEBOARD AND WIRING BACK TO SOURCE.
- (B) REMOVE LINE VOLTAGE THERMOSTAT AND WIRING.
- (C) REMOVE THRU WALL A/C UNIT. UNPLUG AND RETAIN WALL RECEPTACLE.
- (D) REMOVE HEAT PUMP, SAFETY SWITCH DISCONNECT, CONDUIT AND WIRING BACK TO SOURCE.
- (E) REMOVE AIR HANDLER AND WIRING BACK TO SOURCE.
- (F) RELOCATE THE SEVEN (7) HALLWAY LIGHTS IN CORRIDOR 001 AS REQUIRED TO ACCOMODATE NEW MECHANICAL DUCTWORK.
- (G) DOOR BEING REMOVED. REMOVE PULL STATION AND EXIT SIGN IN THIS AREA.
- (H) REMOVE ALL RECEPTACLES AND WIRING FROM WALLS BEING DEMOLISHED. PROVIDE ADDITIONAL WIRING AS REQUIRED TO MAINTAIN DEVICES ON EXISTING WALLS TO REMAIN.
- (I) DEMO EXISTING GARAGE DOOR OPENER AND ALL WIRING AND CONTROLS BACK TO SOURCE.
- (J) RELOCATE COMPRESSOR TO CORRIDOR. SEE E100 FOR NEW LOCATION.
- (K) STAIRWELL AND WALLS BEING DEMOLISHED IN THIS AREA. REMOVE ALL LIGHTING AND EXIT SIGNS IN THIS AREA. REMOVE ANY RECEPTACLES AND RELOCATE ANY WIRING IN WALLS TO BE DEMOLISHED. RELOCATE PULL STATION TO NEW DOOR. (SEE E100 FOR LOCATION).
- (L) REMOVE SYSTEM UNIT HEATER DISCONNECT AND WIRING BACK TO SOURCE.
- (M) REMOVE FAN DISCONNECT AND WIRING BACK TO SOURCE.
- (N) DEMO ALL LIGHTING IN THIS ROOM.
- (O) ALL WORK ASSOCIATED WITH INSTALLATION OF NEW STAIR 6 SHALL BE FURNISHED AS BID ALTERNATE NO. 1.

Rev#	Description	Date	Appr.
1	GENERAL REVISIONS		
	PLAN REVISIONS		

DESIGNED BY: TMD	DATE: 12/28/2018
DRAWN BY: JMD	SCALE: AS NOTED
CHECKED BY: TMD/JMD	DFE PROJECT NO: 23SR18-458-D


STATE OF MAINE
 DEPARTMENT OF DEFENSE, VETERANS
 AND EMERGENCY MANAGEMENT
 Cordja Capital Projects Group
 16 Tenney Lane, Suite 23
 Camden, Maine 04843
 207-236-9970 / mds@cordjagroup.com

CAMP KEYES REUTILIZATION PROJECT
 CAMP KEYES, AUGUSTA, MAINE
 BUILDING NO. 7 RENOVATIONS
 ELECTRICAL REMOVALS PLAN
 LOWER LEVEL - SOUTH END


PLAN PROGRESS

<input type="checkbox"/>	DRAFT
<input type="checkbox"/>	35% REVIEW
<input type="checkbox"/>	65% REVIEW
<input type="checkbox"/>	95% REVIEW
<input type="checkbox"/>	FINAL REVIEW
<input checked="" type="checkbox"/>	FOR BIDDING
<input type="checkbox"/>	ISSUED FOR CONSTRUCTION
<input type="checkbox"/>	RECORD DRAWINGS


SHEET ID:
ED-100
 SHEET: 107 OF 126

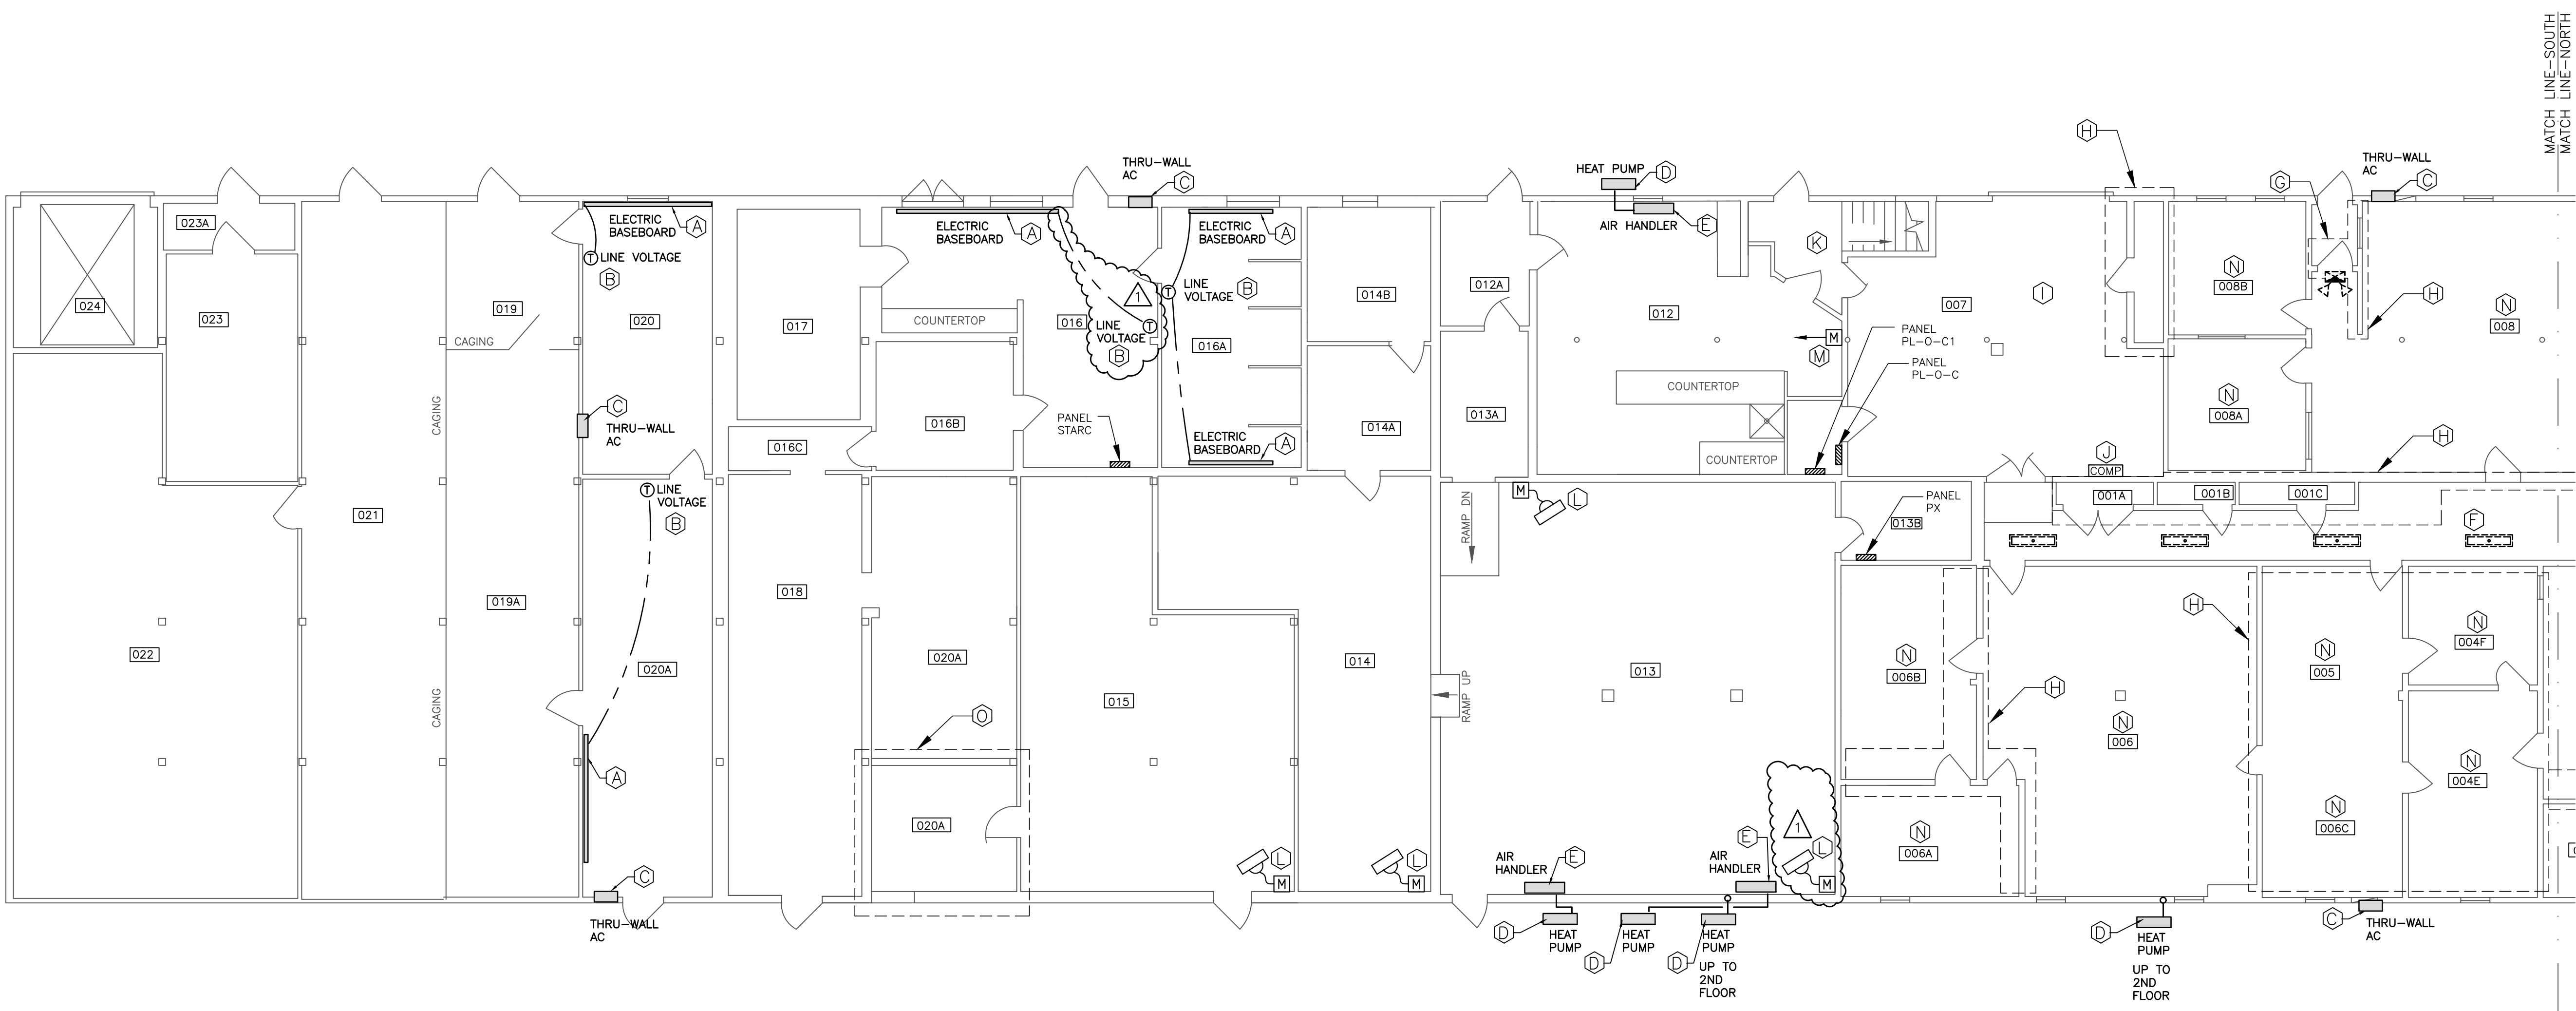


1 ELECTRICAL REMOVALS PLAN - LOWER LEVEL - SOUTH END
 SCALE: 1/8"=1'

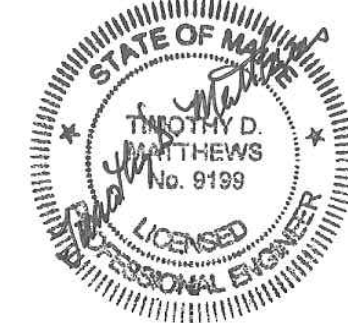

SWIFTCURRENT
 Engineering Services
 10 Forest Falls Dr. Unit 4B
 Yarmouth, ME 04096
 Tel: (207) 847-9280

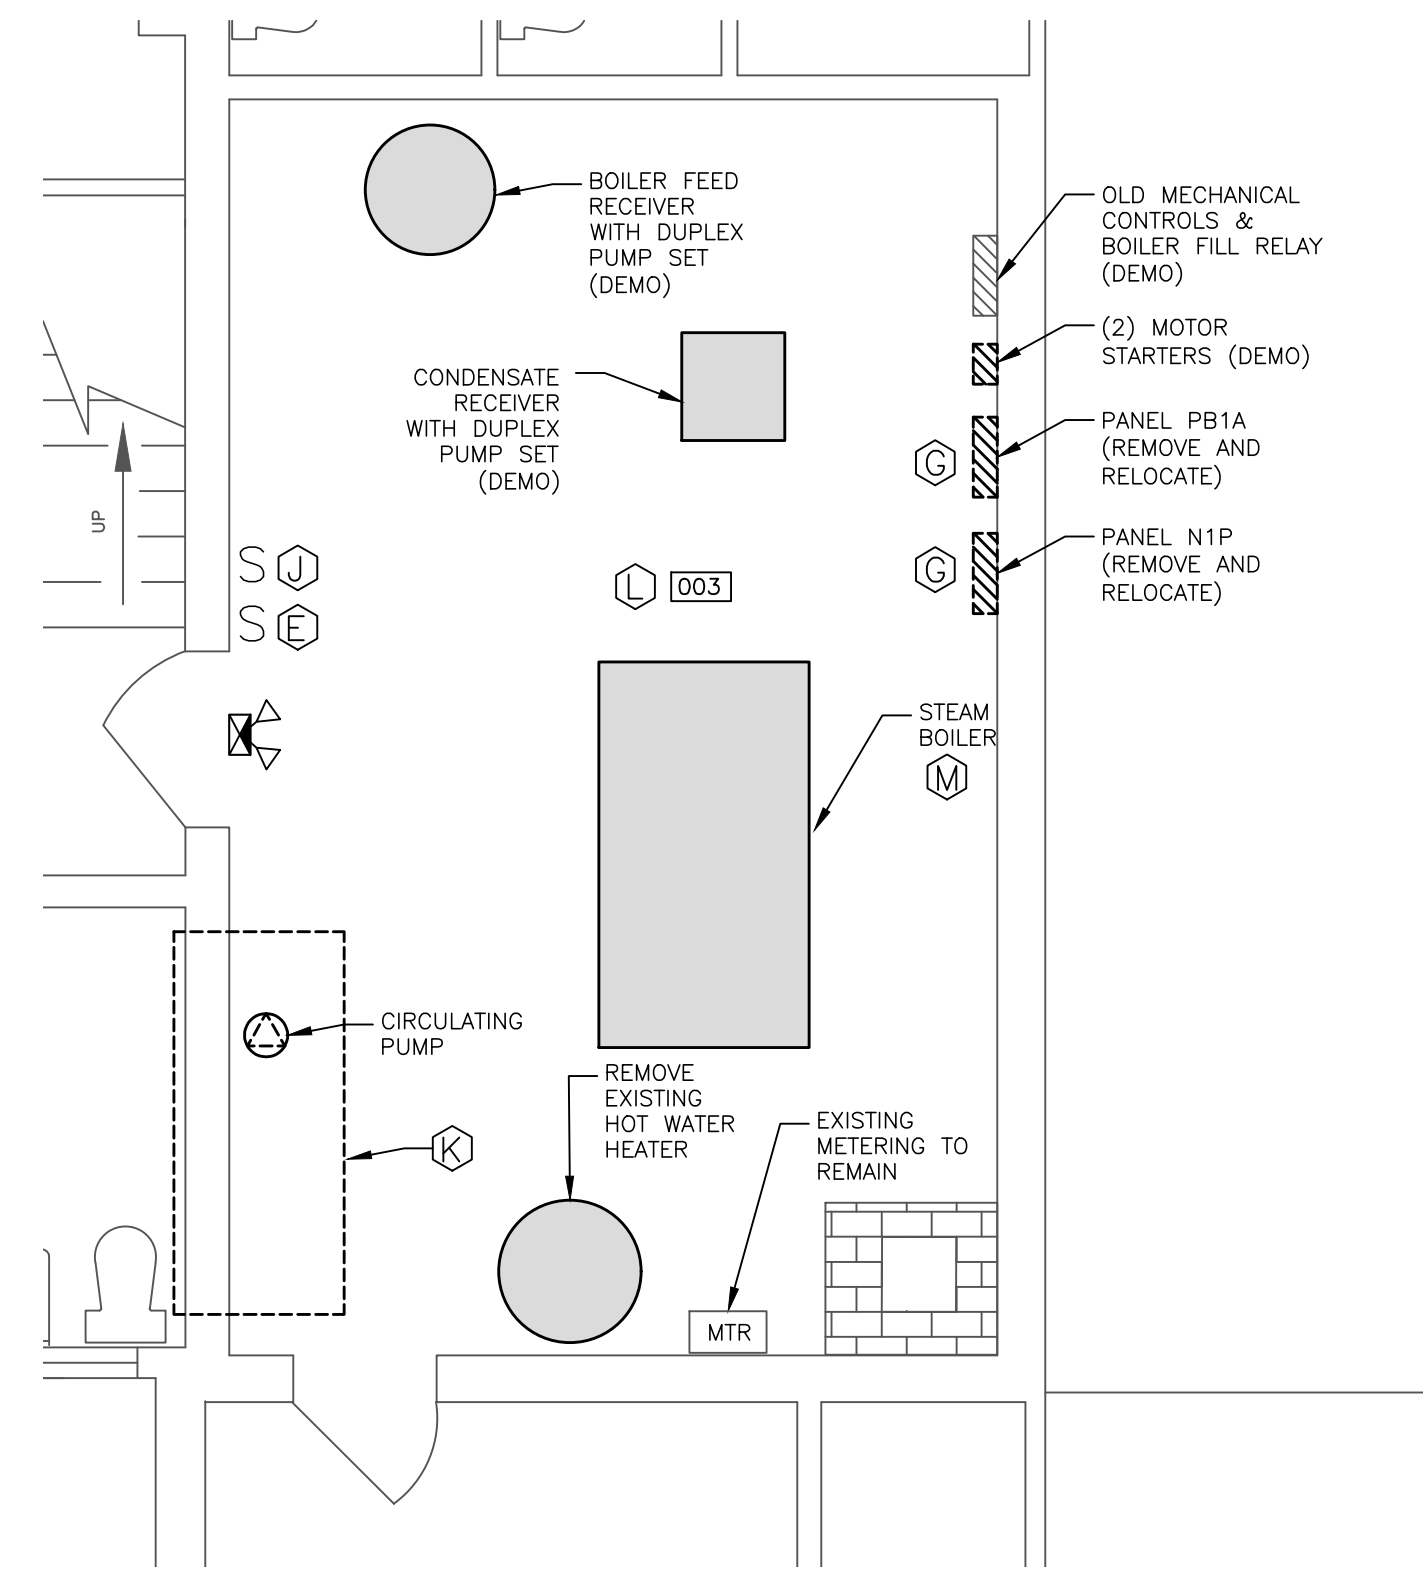

2 ELECTRICAL REMOVALS - EXISTING BOILER ROOM
SCALE: 1/4"=1'

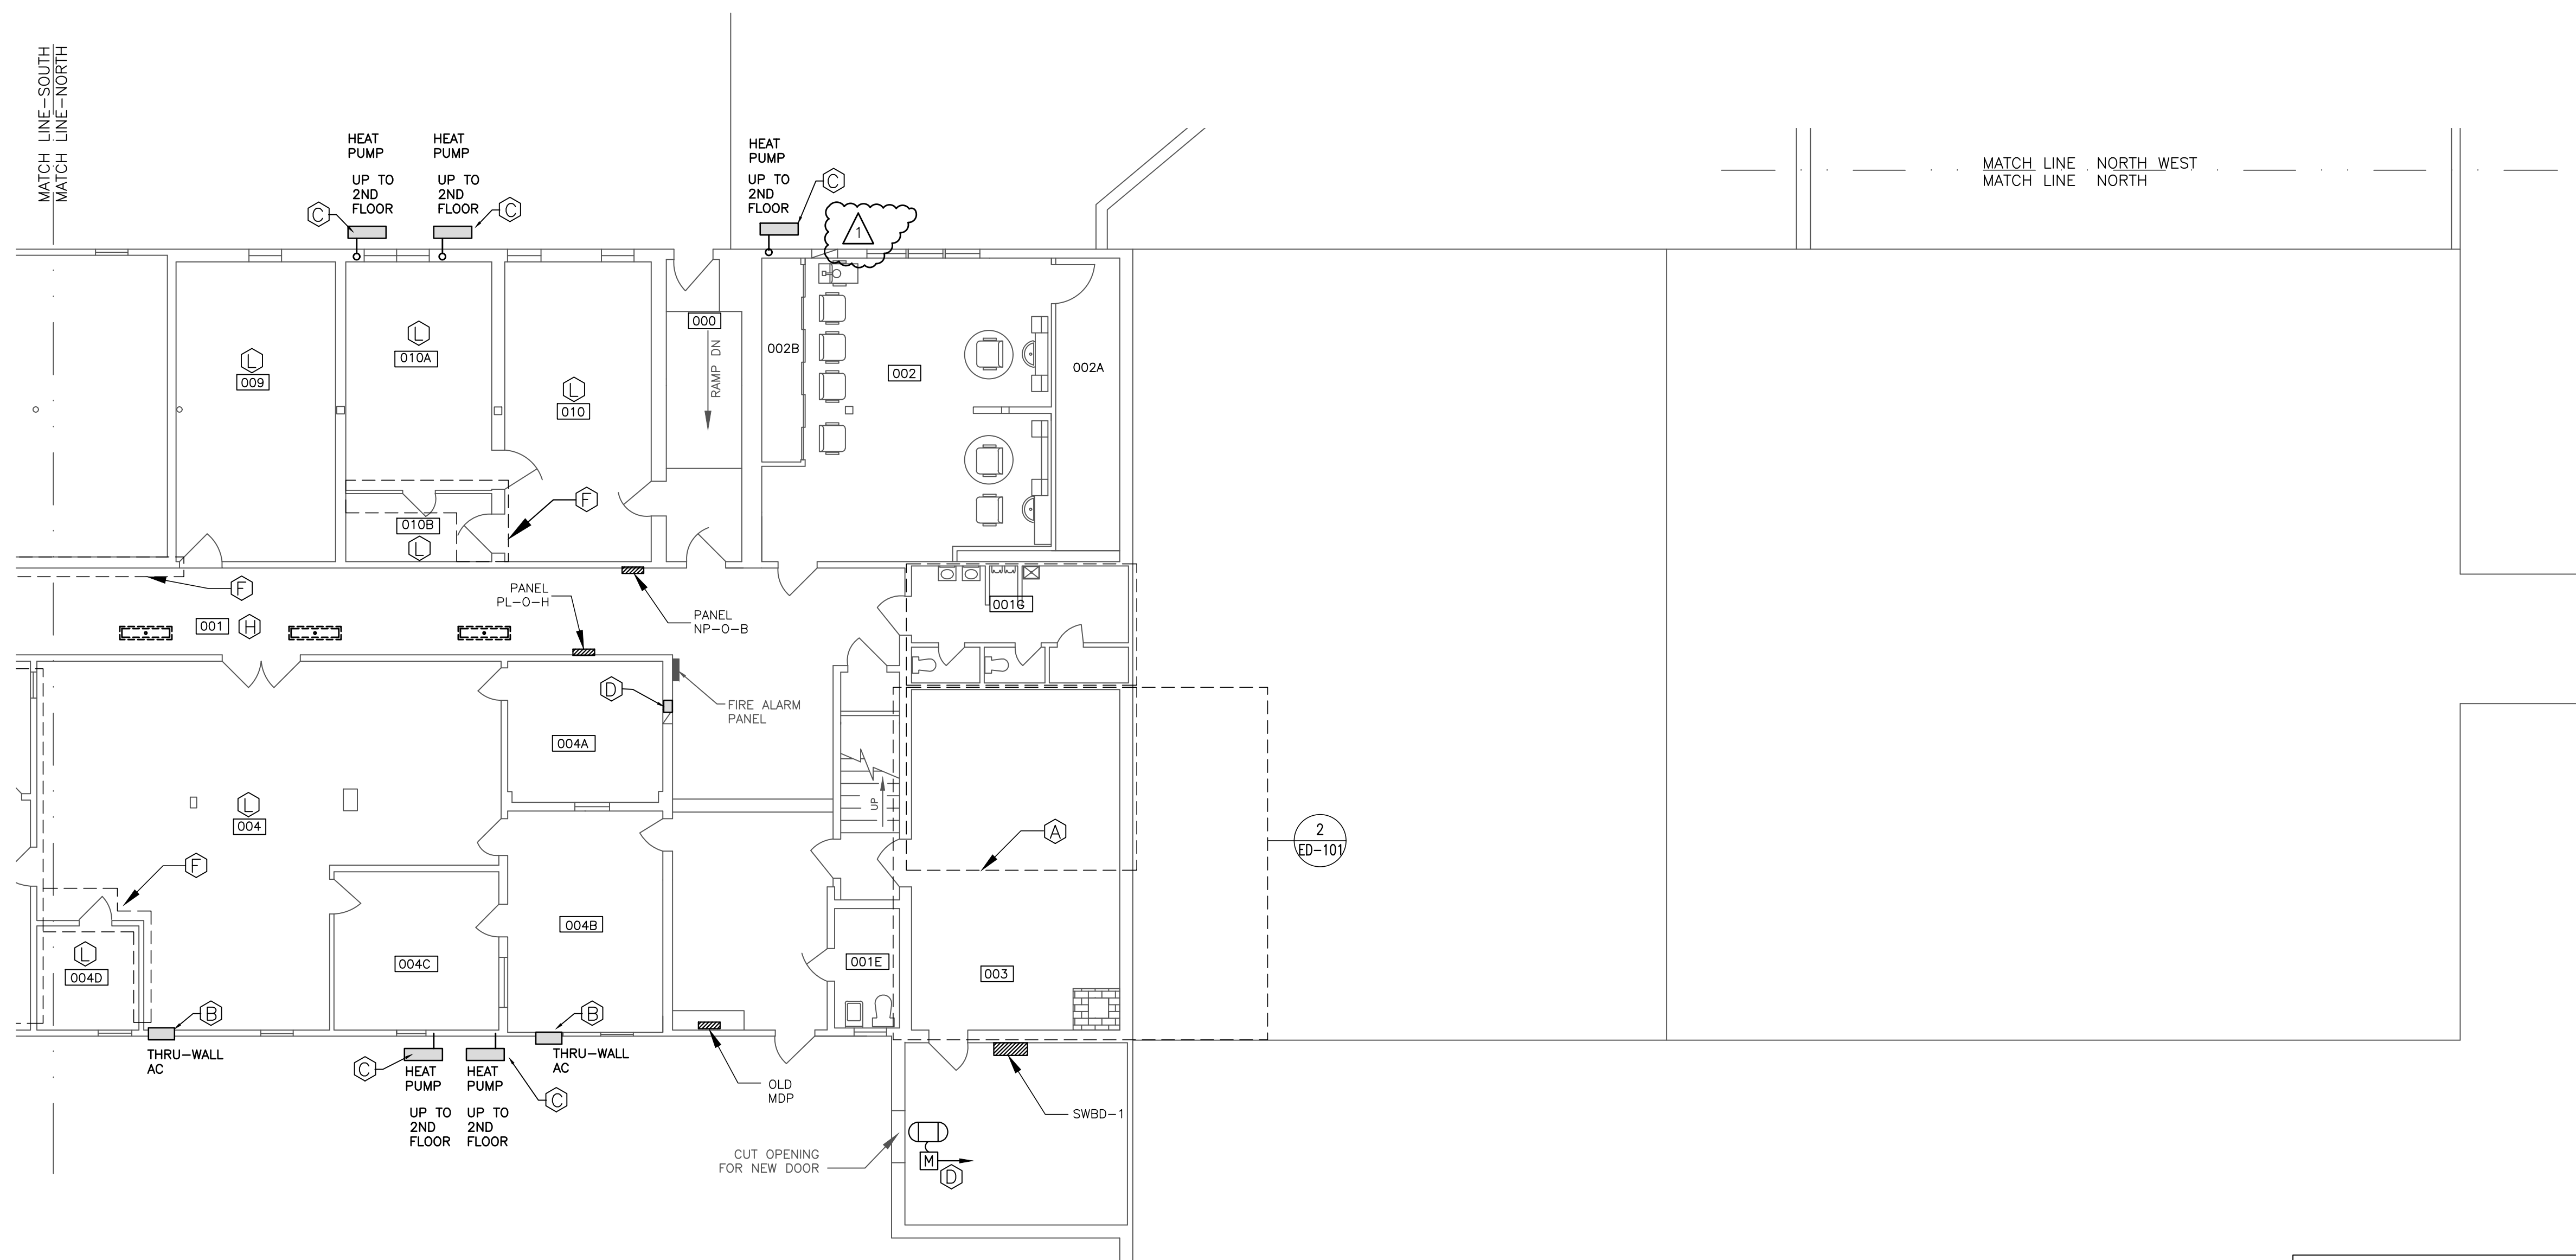

1 ELECTRICAL REMOVALS PLAN - LOWER LEVEL - NORTH END
SCALE: 1/8"=1'

NOTES:

1. SEE E-000 FOR LEGEND, ABBREVIATIONS AND GENERAL NOTES.

REMOVAL NOTES:

- (A) DEMOLISH ALL ELECTRICAL WIRING TO EQUIPMENT BEING DEMOLISHED IN THIS AREA BACK TO SOURCE. REMOVE ALL LIGHTS AND RECEPTACLES FROM THIS AREA AND RELOCATE LIGHT SWITCH ADJACENT TO DOOR IN ELECTRIC ROOM.
- (B) REMOVE THRU WALL A/C UNIT. UNPLUG AND RETAIN WALL RECEPTACLE.
- (C) REMOVE HEAT PUMP, SAFETY SWITCH DISCONNECT, CONDUIT AND WIRING BACK TO SOURCE.
- (D) REMOVE FAN AND WIRING AND CONDUIT BACK TO SOURCE.
- (E) REMOVE AND RELOCATE LIGHT SWITCH. SEE E101 FOR NEW LOCATION.
- (F) REMOVE ALL RECEPTACLES AND WIRING FROM WALLS BEING DEMOLISHED. PROVIDE ADDITIONAL WIRING AS REQUIRED TO MAINTAIN DEVICES ON EXISTING WALLS TO REMAIN.
- (G) RELOCATE PANELS EAST AS REQUIRED TO ACCOMMODATE NEW BOILER ROOM LAYOUT.
- (H) RELOCATE THE SEVEN (7) HALLWAY LIGHTS IN CORRIDOR 001 AS REQUIRED TO ACCOMMODATE NEW MECHANICAL DUCTWORK.
- (I) REMOVE EXIT SIGN WITH INTEGRAL EMERGENCY LIGHT. REINSTALL AS SHOWN ON E101.
- (J) REMOVE EMERGENCY BOILER SWITCH. FOR BOILER BEING REPLACED.
- (K) COORDINATE WITH MECHANICAL, EQUIPMENT CONTROL, AND WIRING TO BE REMOVED FROM THIS AREA.
- (L) DEMO ALL LIGHTING IN THIS ROOM.
- (M) REMOVE ALL WIRING, CONDUIT AND ELECTRICAL DEVICES FOR THE STEAM BOILER AND AUXILIARY SYSTEMS.



Rev#	Description	Date	Appr.
1	GENERAL REVISIONS		
	PLAN REVISIONS	1.28.19	

DESIGNED BY: TMD
DRAWN BY: JMD
CHECKED BY: TMD/JMD
DATE: 12/28/2018
SCALE: AS NOTED
D/E PROJECT NO: 23SR18-458-D


STATE OF MAINE
DEPARTMENT OF DEFENSE, VETERANS
AND EMERGENCY MANAGEMENT
Cordja Capital Projects Group
16 Tenney Lane, Suite 23
Comden, Maine 04843
207-236-9970 / mds@cordjagroup.com

CAMP KEYES REUTILIZATION PROJECT
CAMP KEYES, AUGUSTA, MAINE
BUILDING NO. 7 RENOVATIONS
ELECTRICAL REMOVALS PLAN
LOWER LEVEL - NORTH END

PLAN PROGRESS

<input type="checkbox"/>	DRAFT
<input type="checkbox"/>	35% REVIEW
<input type="checkbox"/>	65% REVIEW
<input type="checkbox"/>	95% REVIEW
<input type="checkbox"/>	FINAL REVIEW
<input checked="" type="checkbox"/>	FOR BIDDING
<input type="checkbox"/>	ISSUED FOR CONSTRUCTION
<input type="checkbox"/>	RECORD DRAWINGS

SHEET ID:
ED-101
SHEET: 108 OF 126

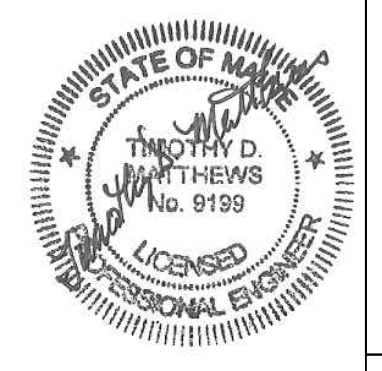

SWIFTCURRENT
Engineering Services
10 Forest Falls Dr. Unit 4B
Yarmouth, ME 04096
Tel: (207) 847-9280



NOTES:

1. SEE E-000 FOR LEGEND, ABBREVIATIONS AND GENERAL NOTES.

REMOVAL NOTES:

- (A) REMOVE HEAT PUMP, SAFETY SWITCH DISCONNECT, CONDUIT AND WIRING BACK TO SOURCE.
- (B) REMOVE AIR HANDLER AND WIRING BACK TO SOURCE.
- (C) DEMO EXISTING LIGHTING, RECEPTACLES, & FIRE ALARM DEVICES IN THIS ROOM. RETAIN CIRCUIT FOR LIGHTING NEW SPACES.
- (D) DEMO EXISTING LIGHTING IN THIS AREA. CIRCUIT RETAIN WIRING FOR NEW FIXTURES.
- (E) RELOCATE PULL STATION AND ANY OTHER DEVICES REQUIRED TO INSTALL NEW WALL SHOWN ON E111.
- (F) REMOVE LIGHTS AND CEILING EQUIPMENT IN THIS ROOM. RETAIN FOR REINSTALL.
- (G) DEMO EXISTING EXIT SIGN.
- (H) ENTRY BEING DEMOLISHED. REMOVE ALL ELECTRICAL INCLUDING BUT NOT LIMITED TO LIGHTING, POWER DOOR OPERATIONS, SECURITY WIRING.
- (I) DEMO EXISTING ERV AND WIRING BACK TO SOURCE.

Rev#	Description	Date	Appr.
1	GENERAL REVISIONS		

DESIGNED BY: TMD
 DRAWN BY: JMD
 CHECKED BY: TMD/JMD
 DATE: 12/28/2018
 SCALE: AS NOTED
 DFE PROJECT NO: 23SR18-458-D

STATE OF MAINE
 DEPARTMENT OF DEFENSE, VETERANS
 AND EMERGENCY MANAGEMENT


Cordja Capital Projects Group
 16 Tenney Lane, Suite 23
 Camden, Maine 04843
 207-236-9970 / mds@cordjagroup.com

CAMP KEYS REUTILIZATION PROJECT
 CAMP KEYS, AUGUSTA, MAINE
 BUILDING NO. 7 RENOVATIONS
 ELECTRICAL REMOVALS PLAN
 FIRST FLOOR - NORTH END



PLAN PROGRESS

<input type="checkbox"/>	DRAFT
<input type="checkbox"/>	35% REVIEW
<input type="checkbox"/>	65% REVIEW
<input type="checkbox"/>	95% REVIEW
<input type="checkbox"/>	FINAL REVIEW
<input checked="" type="checkbox"/>	FOR BIDDING
<input type="checkbox"/>	ISSUED FOR CONSTRUCTION
<input type="checkbox"/>	RECORD DRAWINGS

SHEET ID:
ED-111
 SHEET: 110 OF 126

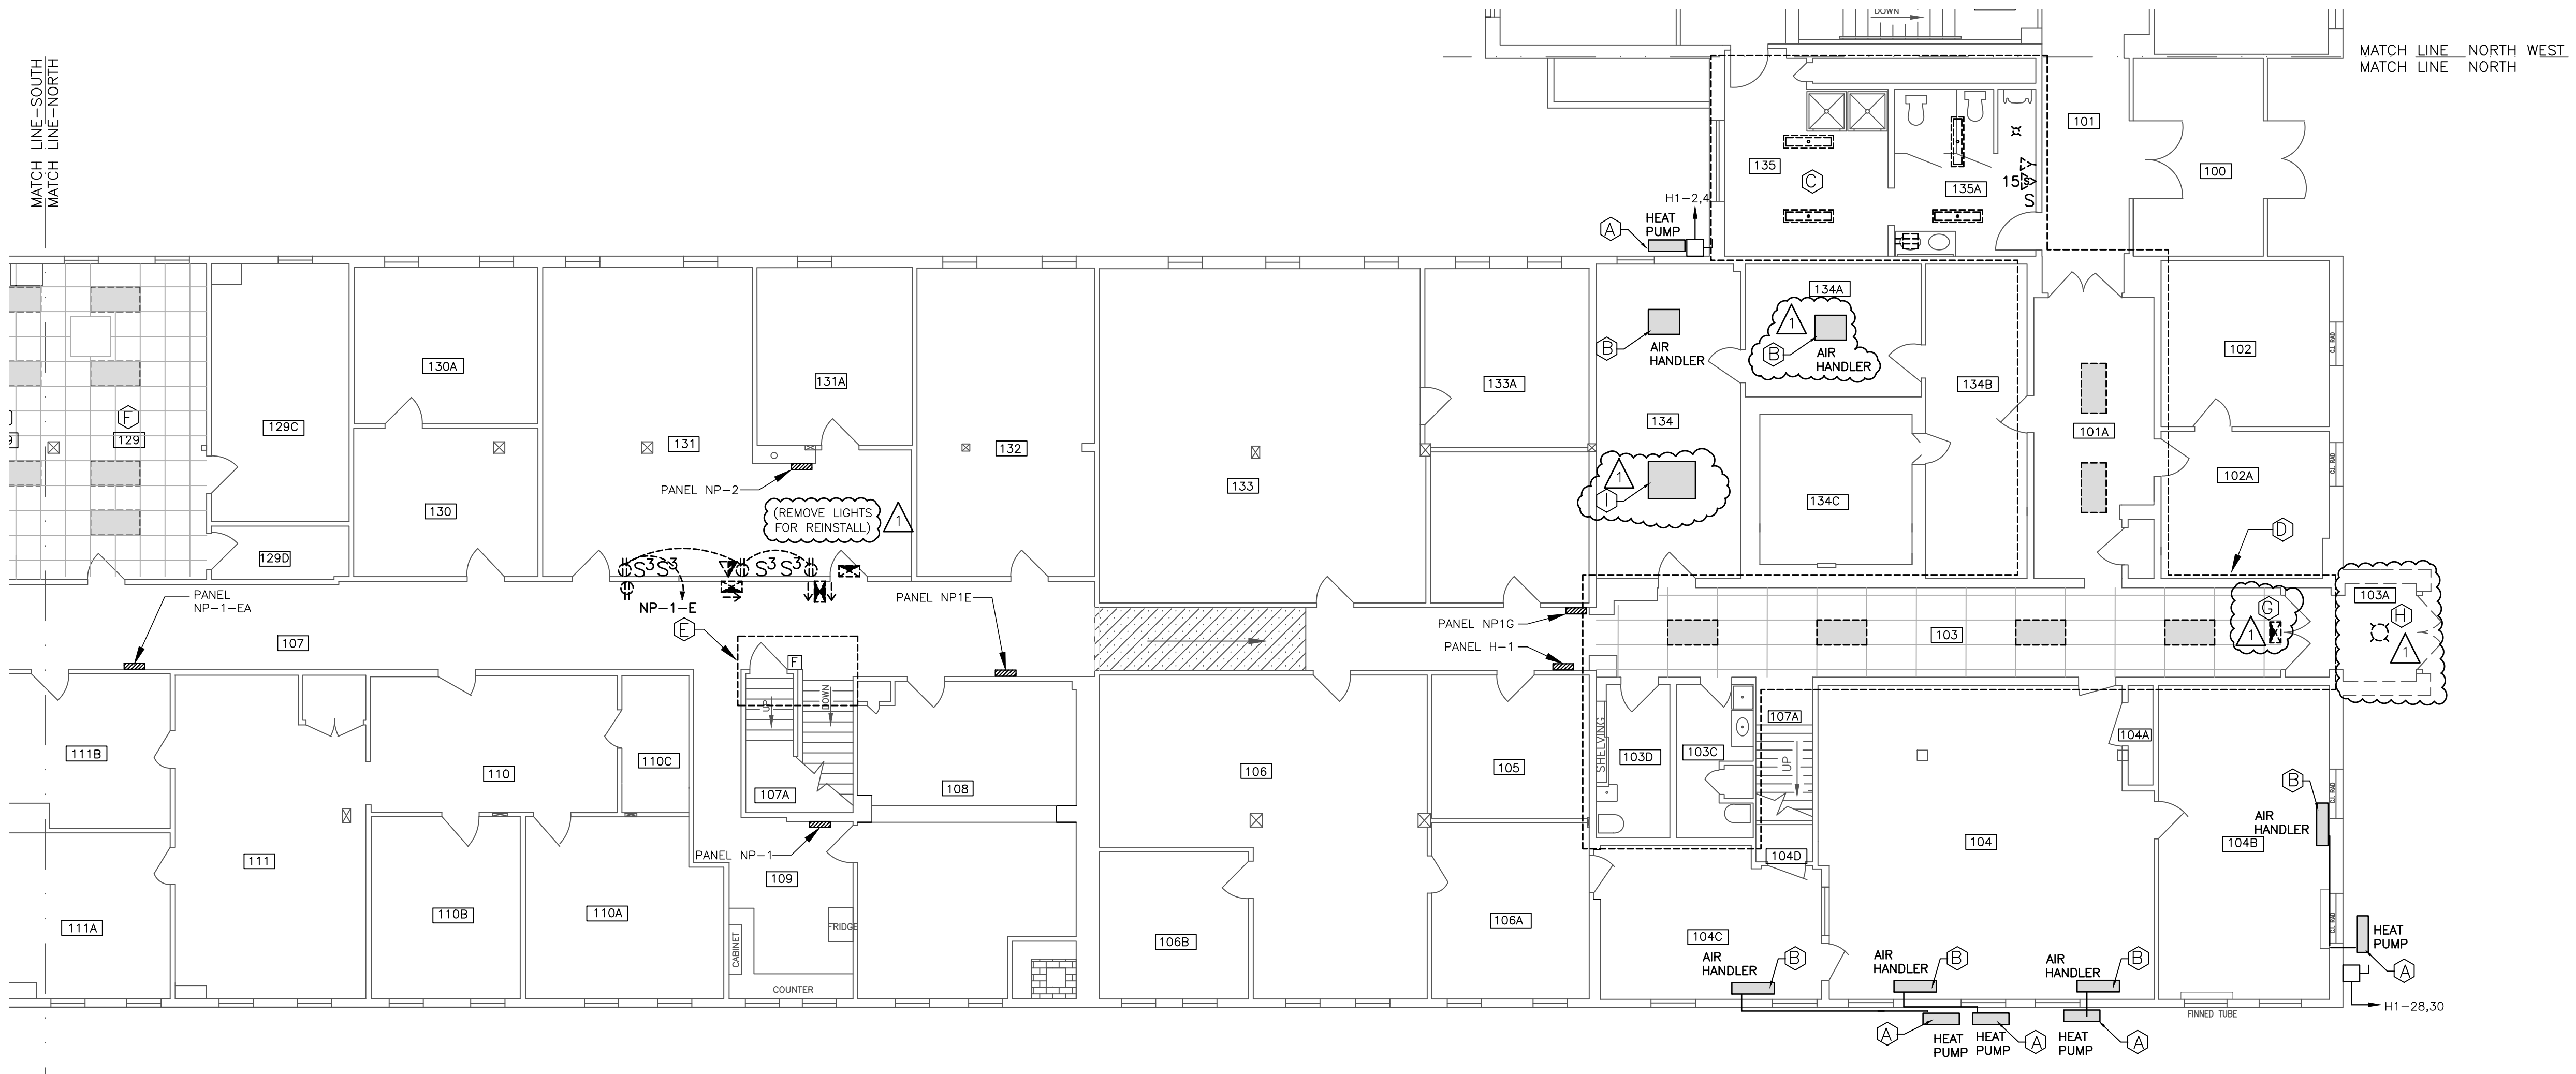

1 ELECTRICAL REMOVALS PLAN - FIRST LEVEL - NORTH END
 SCALE: 1/8"=1'

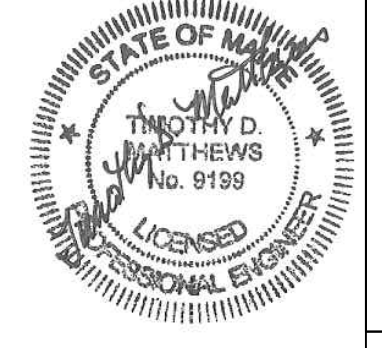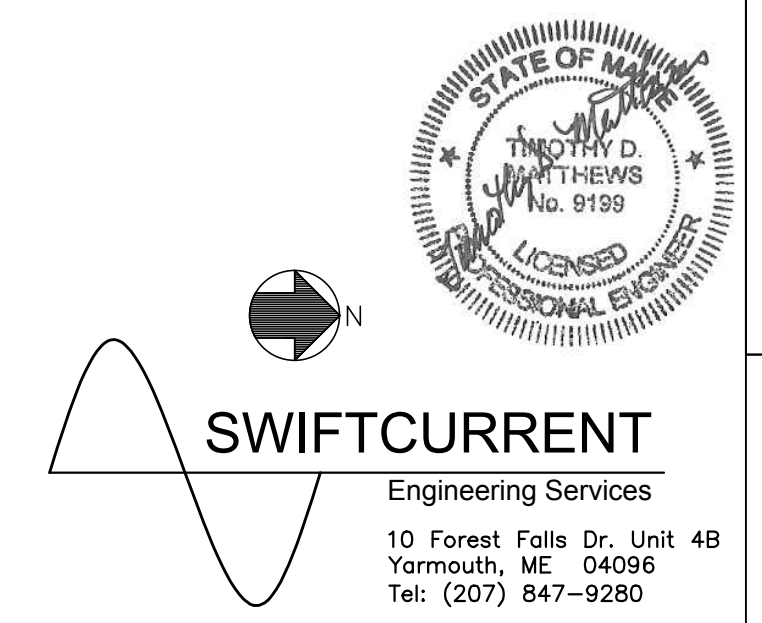



NOTES:

1. SEE E-000 FOR LEGEND, ABBREVIATIONS AND GENERAL NOTES.

REMOVAL NOTES:

- (A) REMOVE LIGHTING AND SMOKE DETECTORS IN CORRIDOR. CEILING BEING REPLACED.
- (B) WALL BEING REMOVED TO EXPAND DATA ROOM. REMOVE AND REINSTALL LIGHT AS REQUIRED FOR NEW CEILING. RELOCATE LIGHT SWITCH. SEE E121 FOR LOCATION.
- (C) REMOVE THRU WALL A/C UNIT. UNPLUG AND RETAIN WALL RECEPTACLE.
- (D) REMOVE AIR HANDLER, CONDUIT, AND WIRING BACK TO SOURCE.
- (E) REMOVE ERV AND WIRING BACK TO SOURCE.
- (F) REMOVE FAN AND WIRING AND CONDUIT BACK TO SOURCE.
- (G) REMOVE LIGHTS AND CEILING EQUIPMENT IN THIS ROOM. RETAIN FOR REINSTALL.
- (H) REMOVE ALL RECEPTACLES AND WIRING FROM WALLS BEING DEMOLISHED. PROVIDE ADDITIONAL WIRING AS REQUIRED TO MAINTAIN DEVICES ON EXISTING WALLS TO REMAIN.

Rev#	Description	Date	Appr.
1	GENERAL REVISIONS		

DESIGNED BY: TMD
 DRAWN BY: JMD
 CHECKED BY: TMD/JMD
 DATE: 12/28/2018
 SCALE: AS NOTED
 DFE PROJECT NO: 23SR18-458-D


STATE OF MAINE
 DEPARTMENT OF DEFENSE, VETERANS
 AND EMERGENCY MANAGEMENT
 Cordja Capital Projects Group
 16 Tenney Lane, Suite 23
 Camden, Maine 04843
 207-236-9970 / mds@cordjagroup.com

CAMP KEYS REUTILIZATION PROJECT
 CAMP KEYS, AUGUSTA, MAINE
 BUILDING NO. 7 RENOVATIONS
 ELECTRICAL REMOVALS PLAN
 SECOND FLOOR - NORTH END


PLAN PROGRESS


<input type="checkbox"/>	DRAFT
<input type="checkbox"/>	35% REVIEW
<input type="checkbox"/>	65% REVIEW
<input type="checkbox"/>	95% REVIEW
<input type="checkbox"/>	FINAL REVIEW
<input checked="" type="checkbox"/>	FOR BIDDING
<input type="checkbox"/>	ISSUED FOR CONSTRUCTION
<input type="checkbox"/>	RECORD DRAWINGS

SHEET ID:
ED-121
 SHEET: 112 OF 126

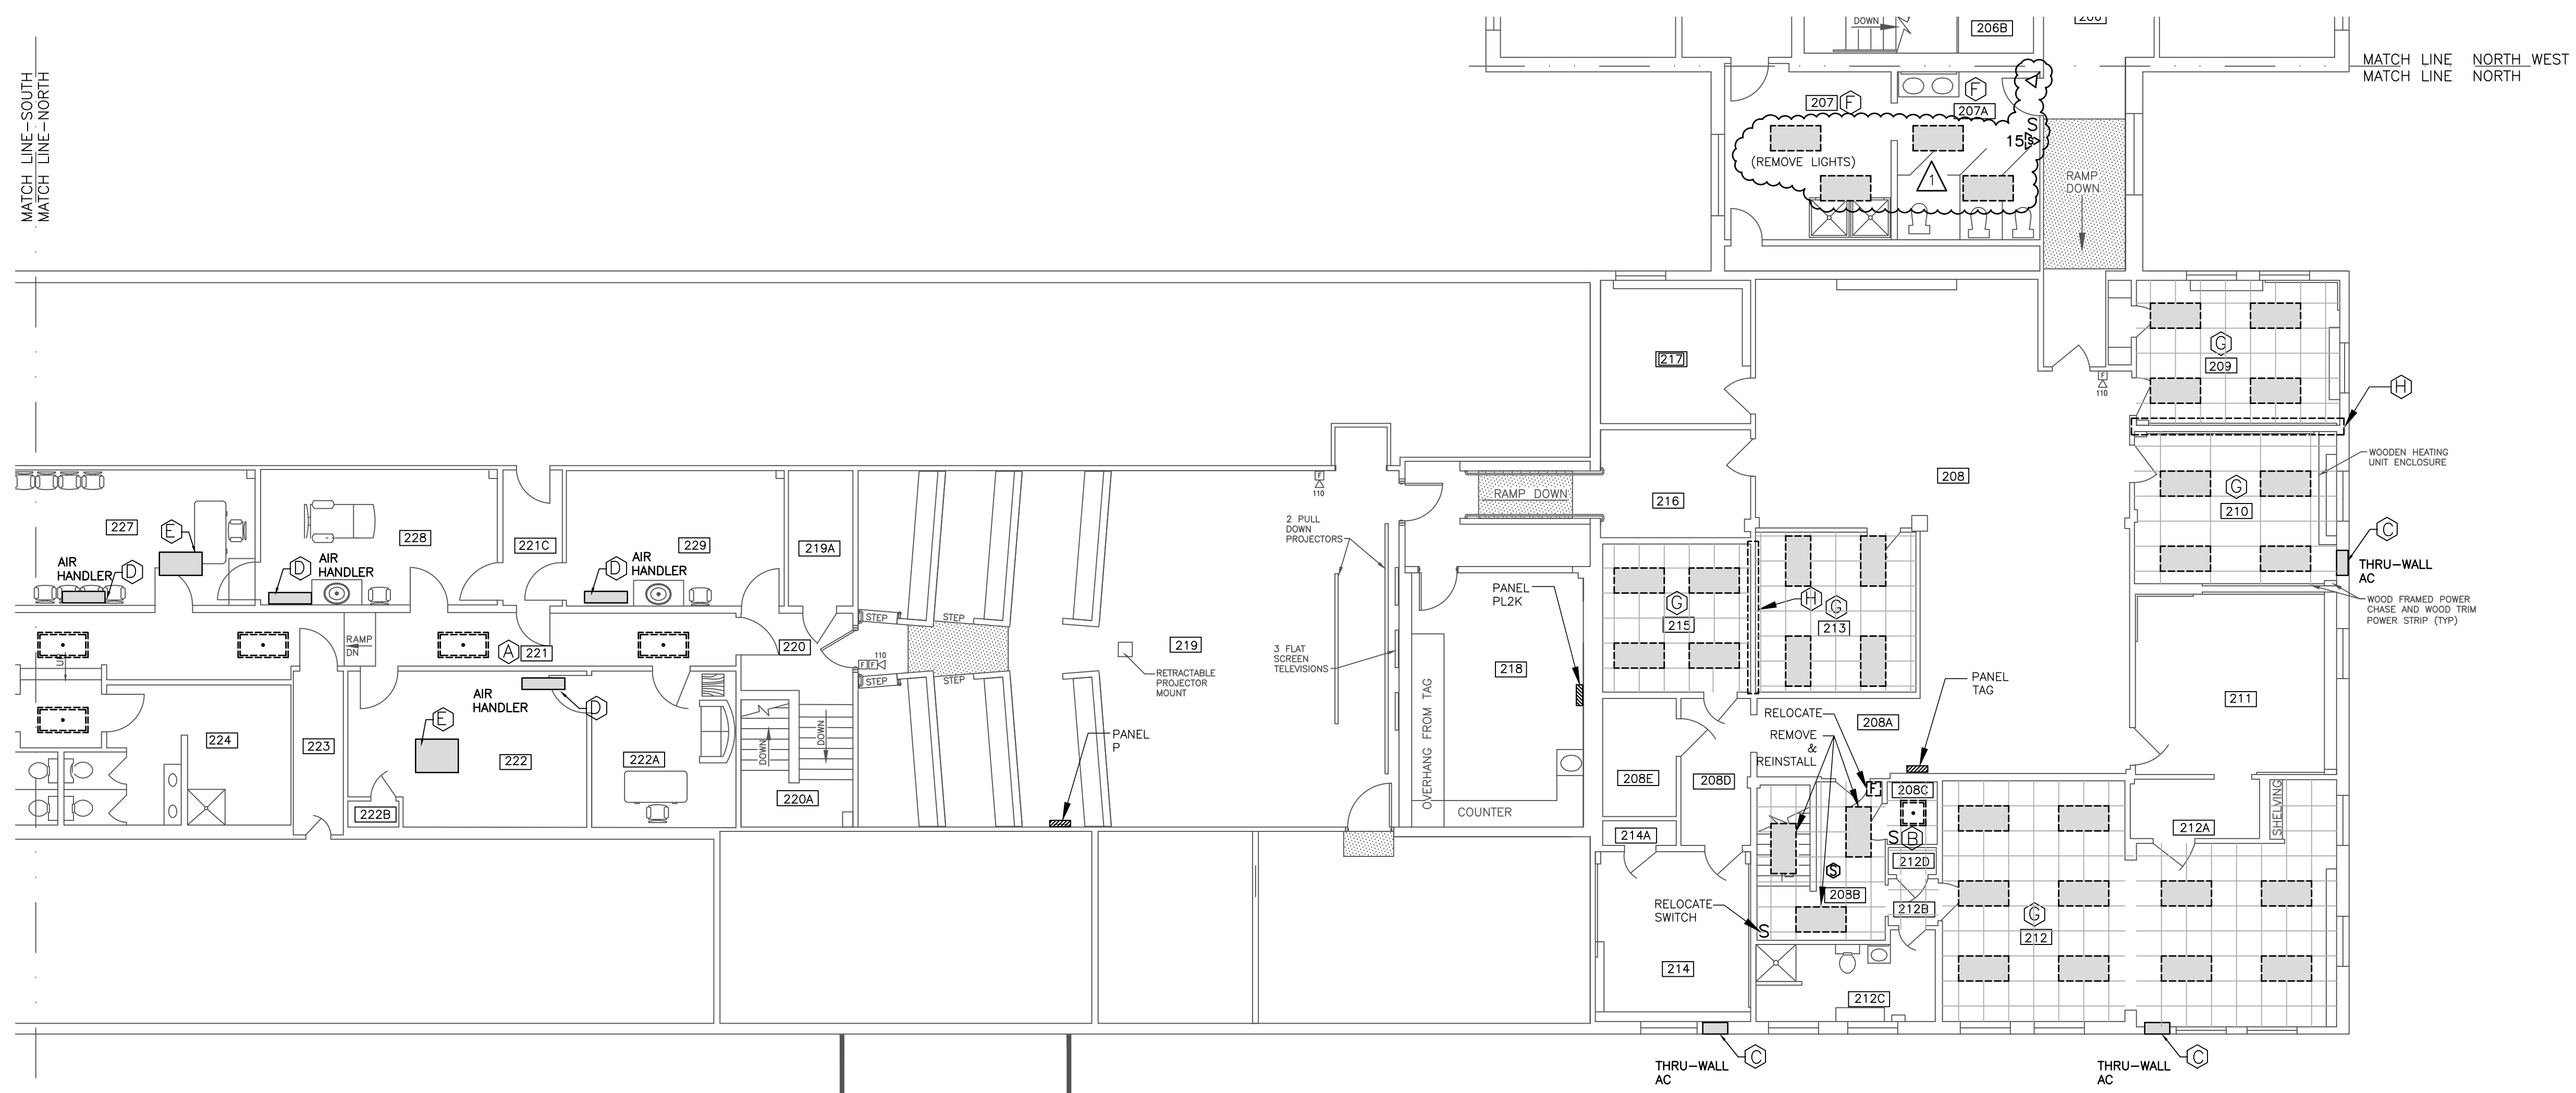


1 ELECTRICAL REMOVALS PLAN - SECOND LEVEL - NORTH END
 SCALE: 1/8"=1'

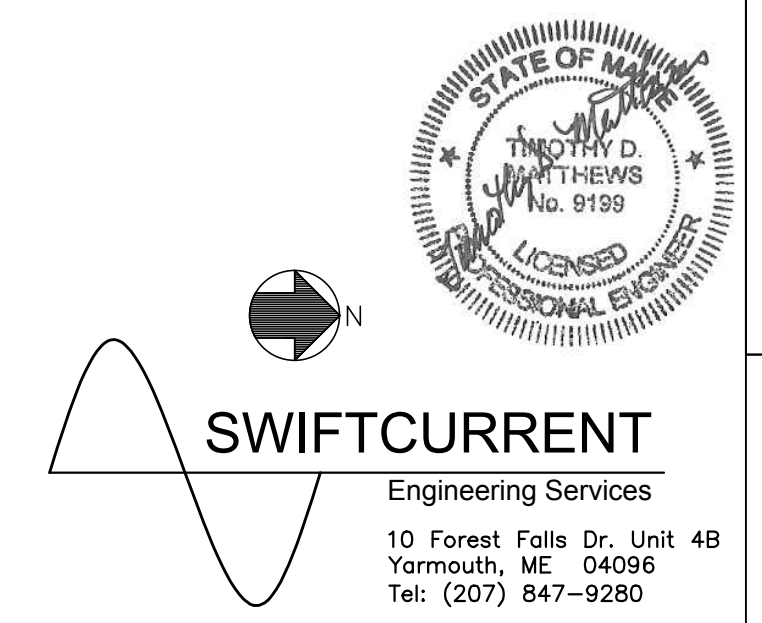

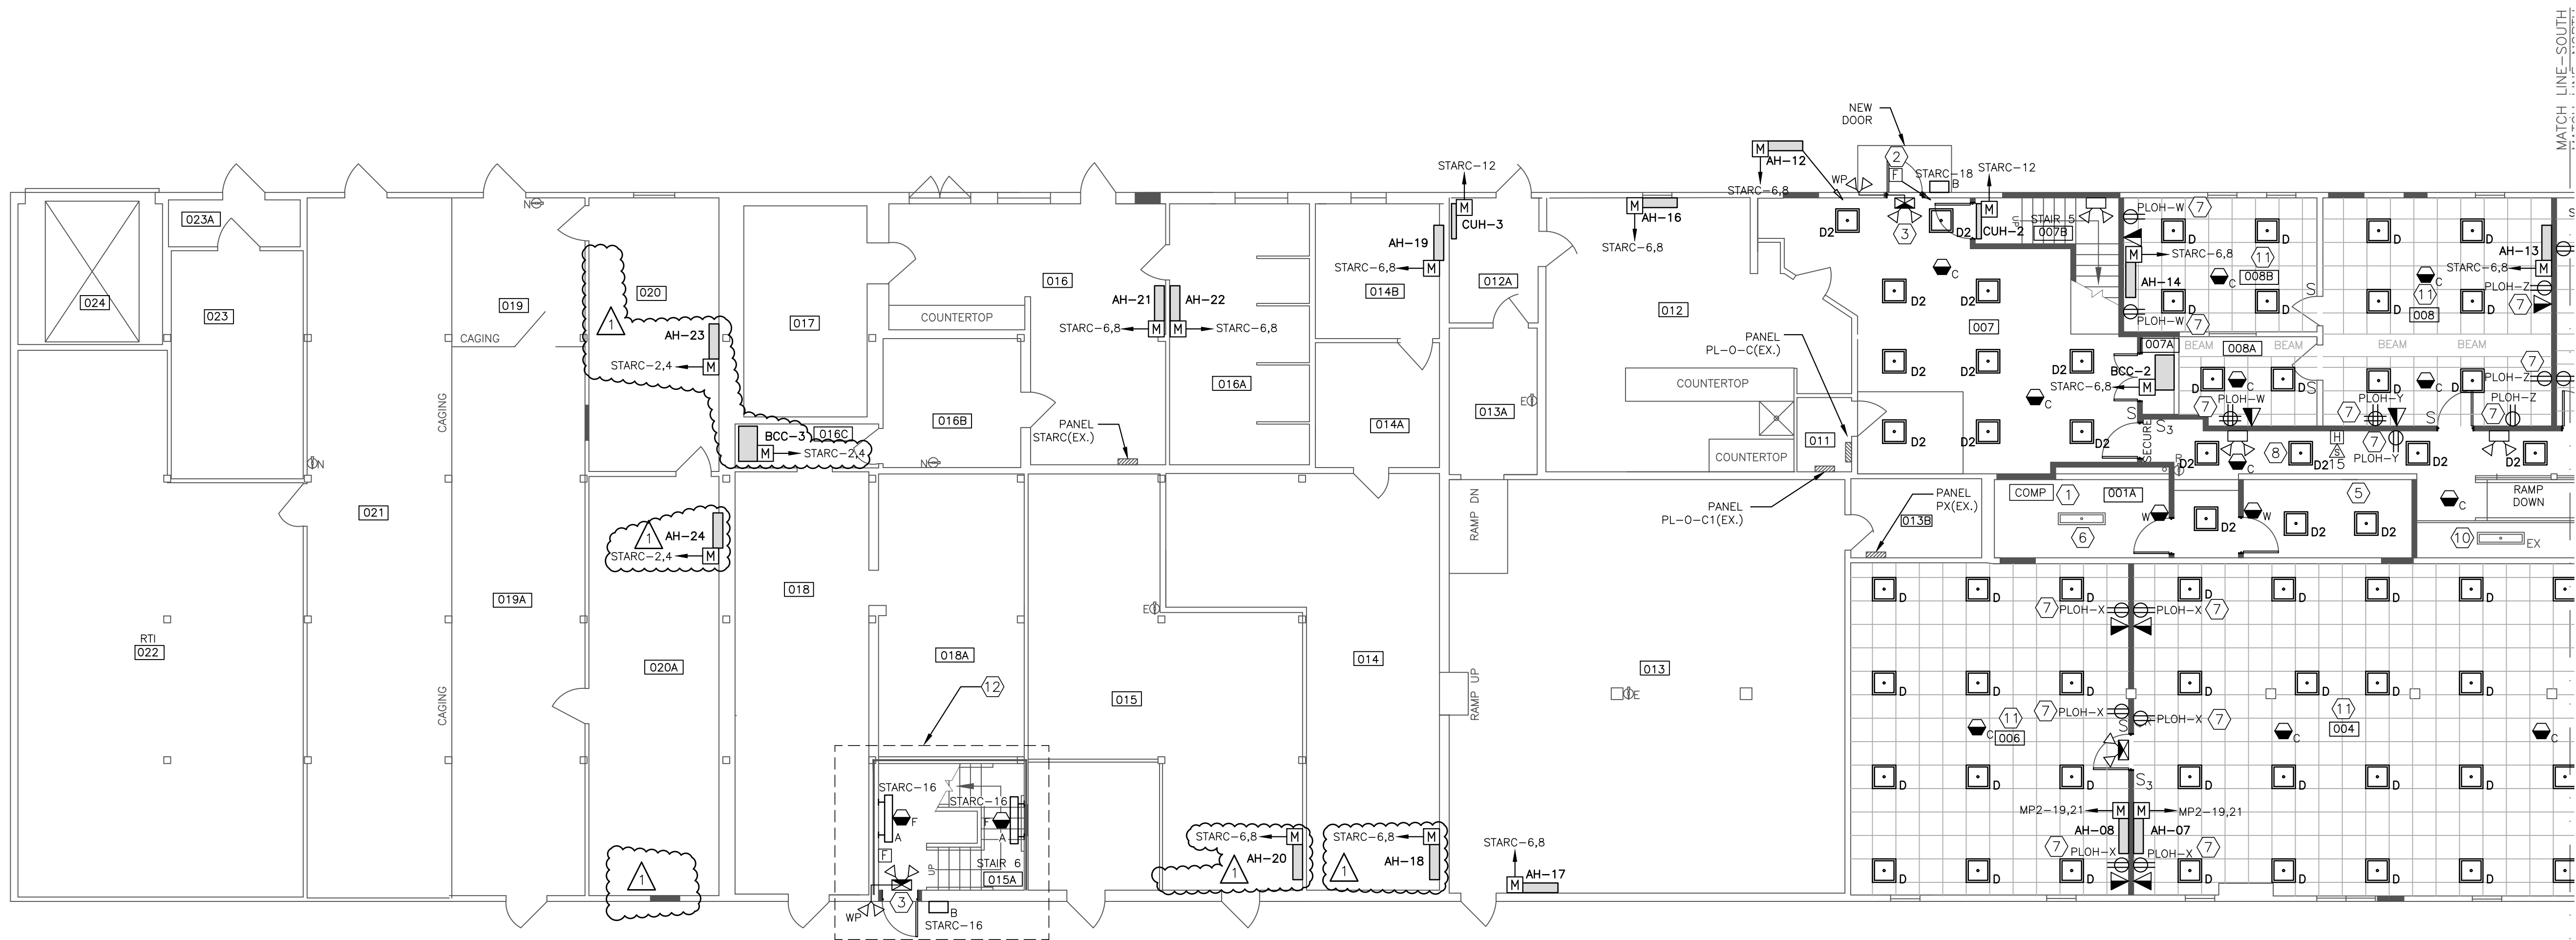

1 PROPOSED ELECTRICAL PLAN - LOWER LEVEL - SOUTH END
 SCALE: 1/8"=1'

- NOTES:**
- SEE E-000 FOR LEGEND, ABBREVIATIONS AND GENERAL NOTES.
 - NEW DATA DEVICES SHALL HAVE (1)VOICE/(1)DATA. RUN BACK TO LOCAL DATA ROOM. PROVIDE ENOUGH SLACK TO REACH ALONG CEILING TO FURTHEST POINT IN DATA ROOM AND FROM THERE TO FLOOR.
- KEYED NOTES:**
- RELOCATE COMPRESSOR. CONTROLS, STROBES AND HORN. REUSE EXISTING WIRING AND DISCONNECT.
 - RELOCATE PULL STATION TO NEW DOOR. (SEE ED100).
 - WIRE TO LOCAL LIGHTING CIRCUIT.
 - WIRE FIXTURE TO EXISTING LOCAL LIGHTING CIRCUIT.
 - INTENT IS TO FEED THIS FUTURE IT ROOM FROM A NEW 100A, 3P CIRCUIT BREAKER IN SWBD-1. (BY OTHERS)
 - FEED EXISTING LIGHTING IN THIS AREA FROM "SPARE" CIRCUIT IN PANEL PX (PX-6). ADD WALL MOUNTED OCCUPANCY SENSOR FOR CONTROL.
 - INTENT IS TO REUSE EXISTING CIRCUITS CURRENTLY FEEDING RECEPTACLES BEING DEMOLISHED. SEE ED-100 FOR MORE INFORMATION. W, X, Y & Z ARE SHOWN TO SHOW GROUPINGS OF CIRCUITS. CONFIRM CIRCUITS IN FIELD.
 - WIRE FIXTURES IN THIS CORRIDOR TO EXISTING CORRIDOR LIGHTING CIRCUIT.
 - USE EXISTING CORRIDOR LIGHTING CIRCUIT FOR IT ROOM LIGHTS. PULL IN UNSWITCHED LEG AS REQUIRED FOR SEPARATE OPERATION.
 - EXISTING CORRIDOR FIXTURE RELOCATED AS REQUIRED TO ACCOMMODATE NEW DUCTWORK.
 - INSTALL NEW LIGHTS AND CONTROLS IN THIS ROOM. CONNECT TO EXISTING LIGHTING CIRCUIT.
 - ALL WORK ASSOCIATED WITH INSTALLATION OF NEW STAIR 6 SHALL BE FURNISHED AS BID ALTERNATE NO. 1.

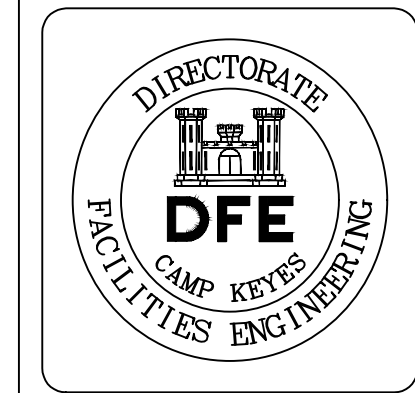

Rev#	Description	Date	Appr.
1	GENERAL REVISIONS		
1.2819			

DESIGNED BY: TMD
 DRAWN BY: JMD
 CHECKED BY: TMD/JMD
 DATE: 12/28/2018
 SCALE: AS NOTED
 DFE PROJECT NO: 23SR18-458-D


STATE OF MAINE
 DEPARTMENT OF DEFENSE, VETERANS
 AND EMERGENCY MANAGEMENT
 Cordja Capital Projects Group
 16 Tenney Lane, Suite 23
 Camden, Maine 04843
 207-236-9970 / mds@cordjagroup.com

CAMP KEYES REUTILIZATION PROJECT
 CAMP KEYES, AUGUSTA, MAINE
 BUILDING NO. 7 RENOVATIONS
 PROPOSED ELECTRICAL PLAN
 LOWER LEVEL - SOUTH END


PLAN PROGRESS

<input type="checkbox"/>	DRAFT
<input type="checkbox"/>	35% REVIEW
<input type="checkbox"/>	65% REVIEW
<input type="checkbox"/>	95% REVIEW
<input type="checkbox"/>	FINAL REVIEW
<input checked="" type="checkbox"/>	FOR BIDDING
<input type="checkbox"/>	ISSUED FOR CONSTRUCTION
<input type="checkbox"/>	RECORD DRAWINGS


SHEET ID:
 E-100
 SHEET: 114 OF 126

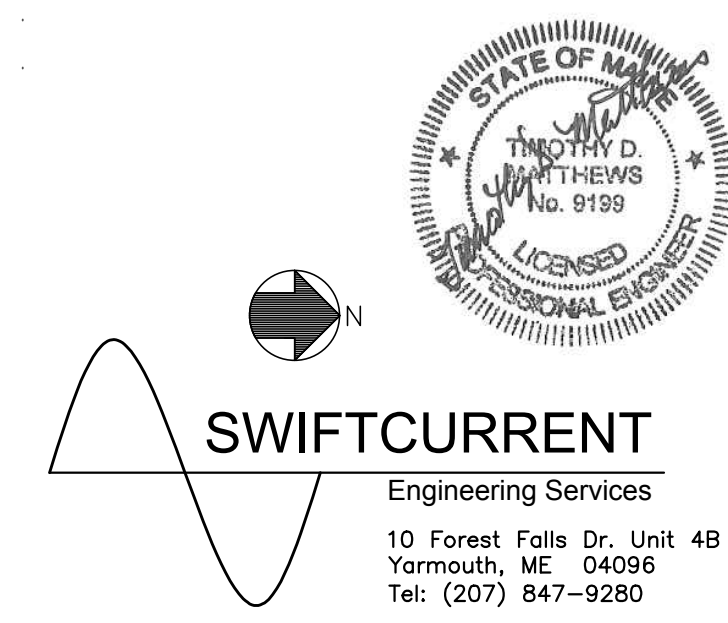


SWIFTCURRENT
 Engineering Services
 10 Forest Falls Dr. Unit 4B
 Yarmouth, ME 04096
 Tel: (207) 847-9280

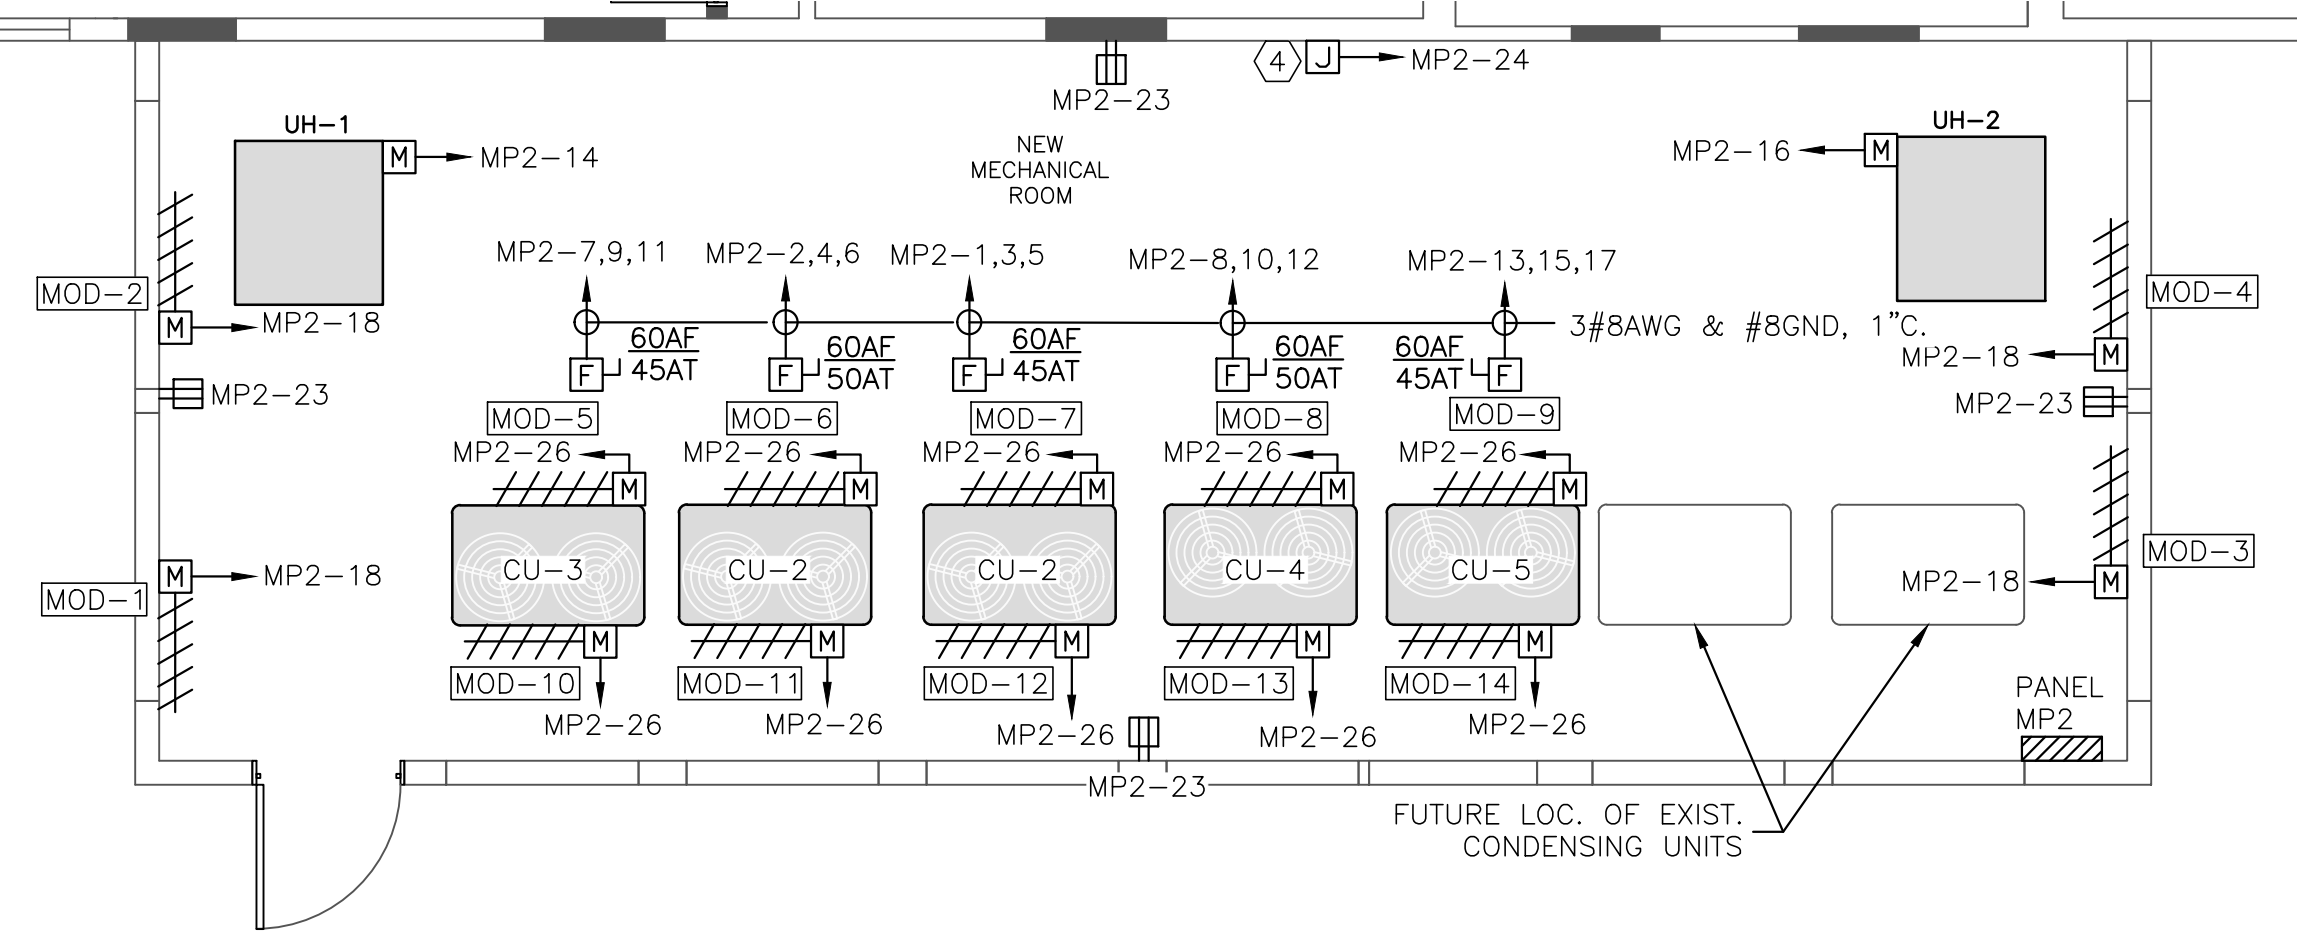


2 ELECTRICAL DETAIL - MECHANICAL ROOM
SCALE: 1/4"=1'

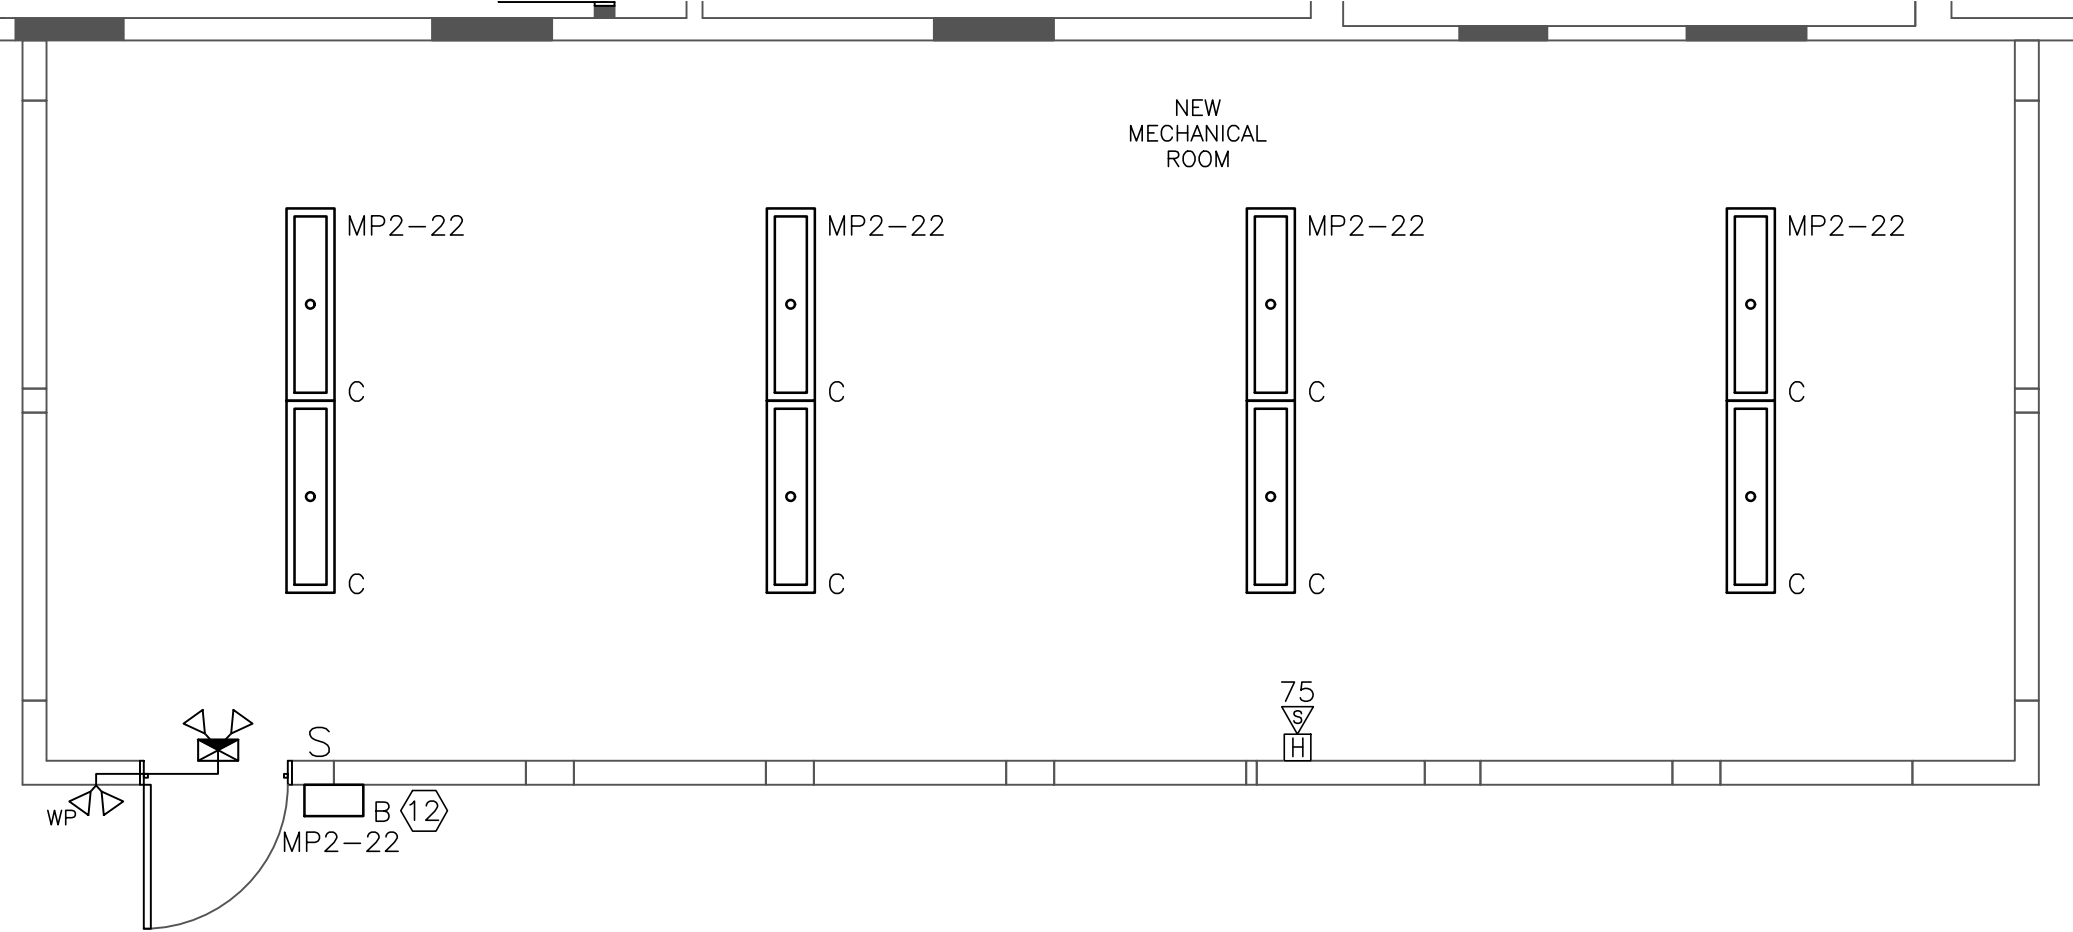

3 LIGHTING DETAIL - MECHANICAL ROOM
SCALE: 1/4"=1'

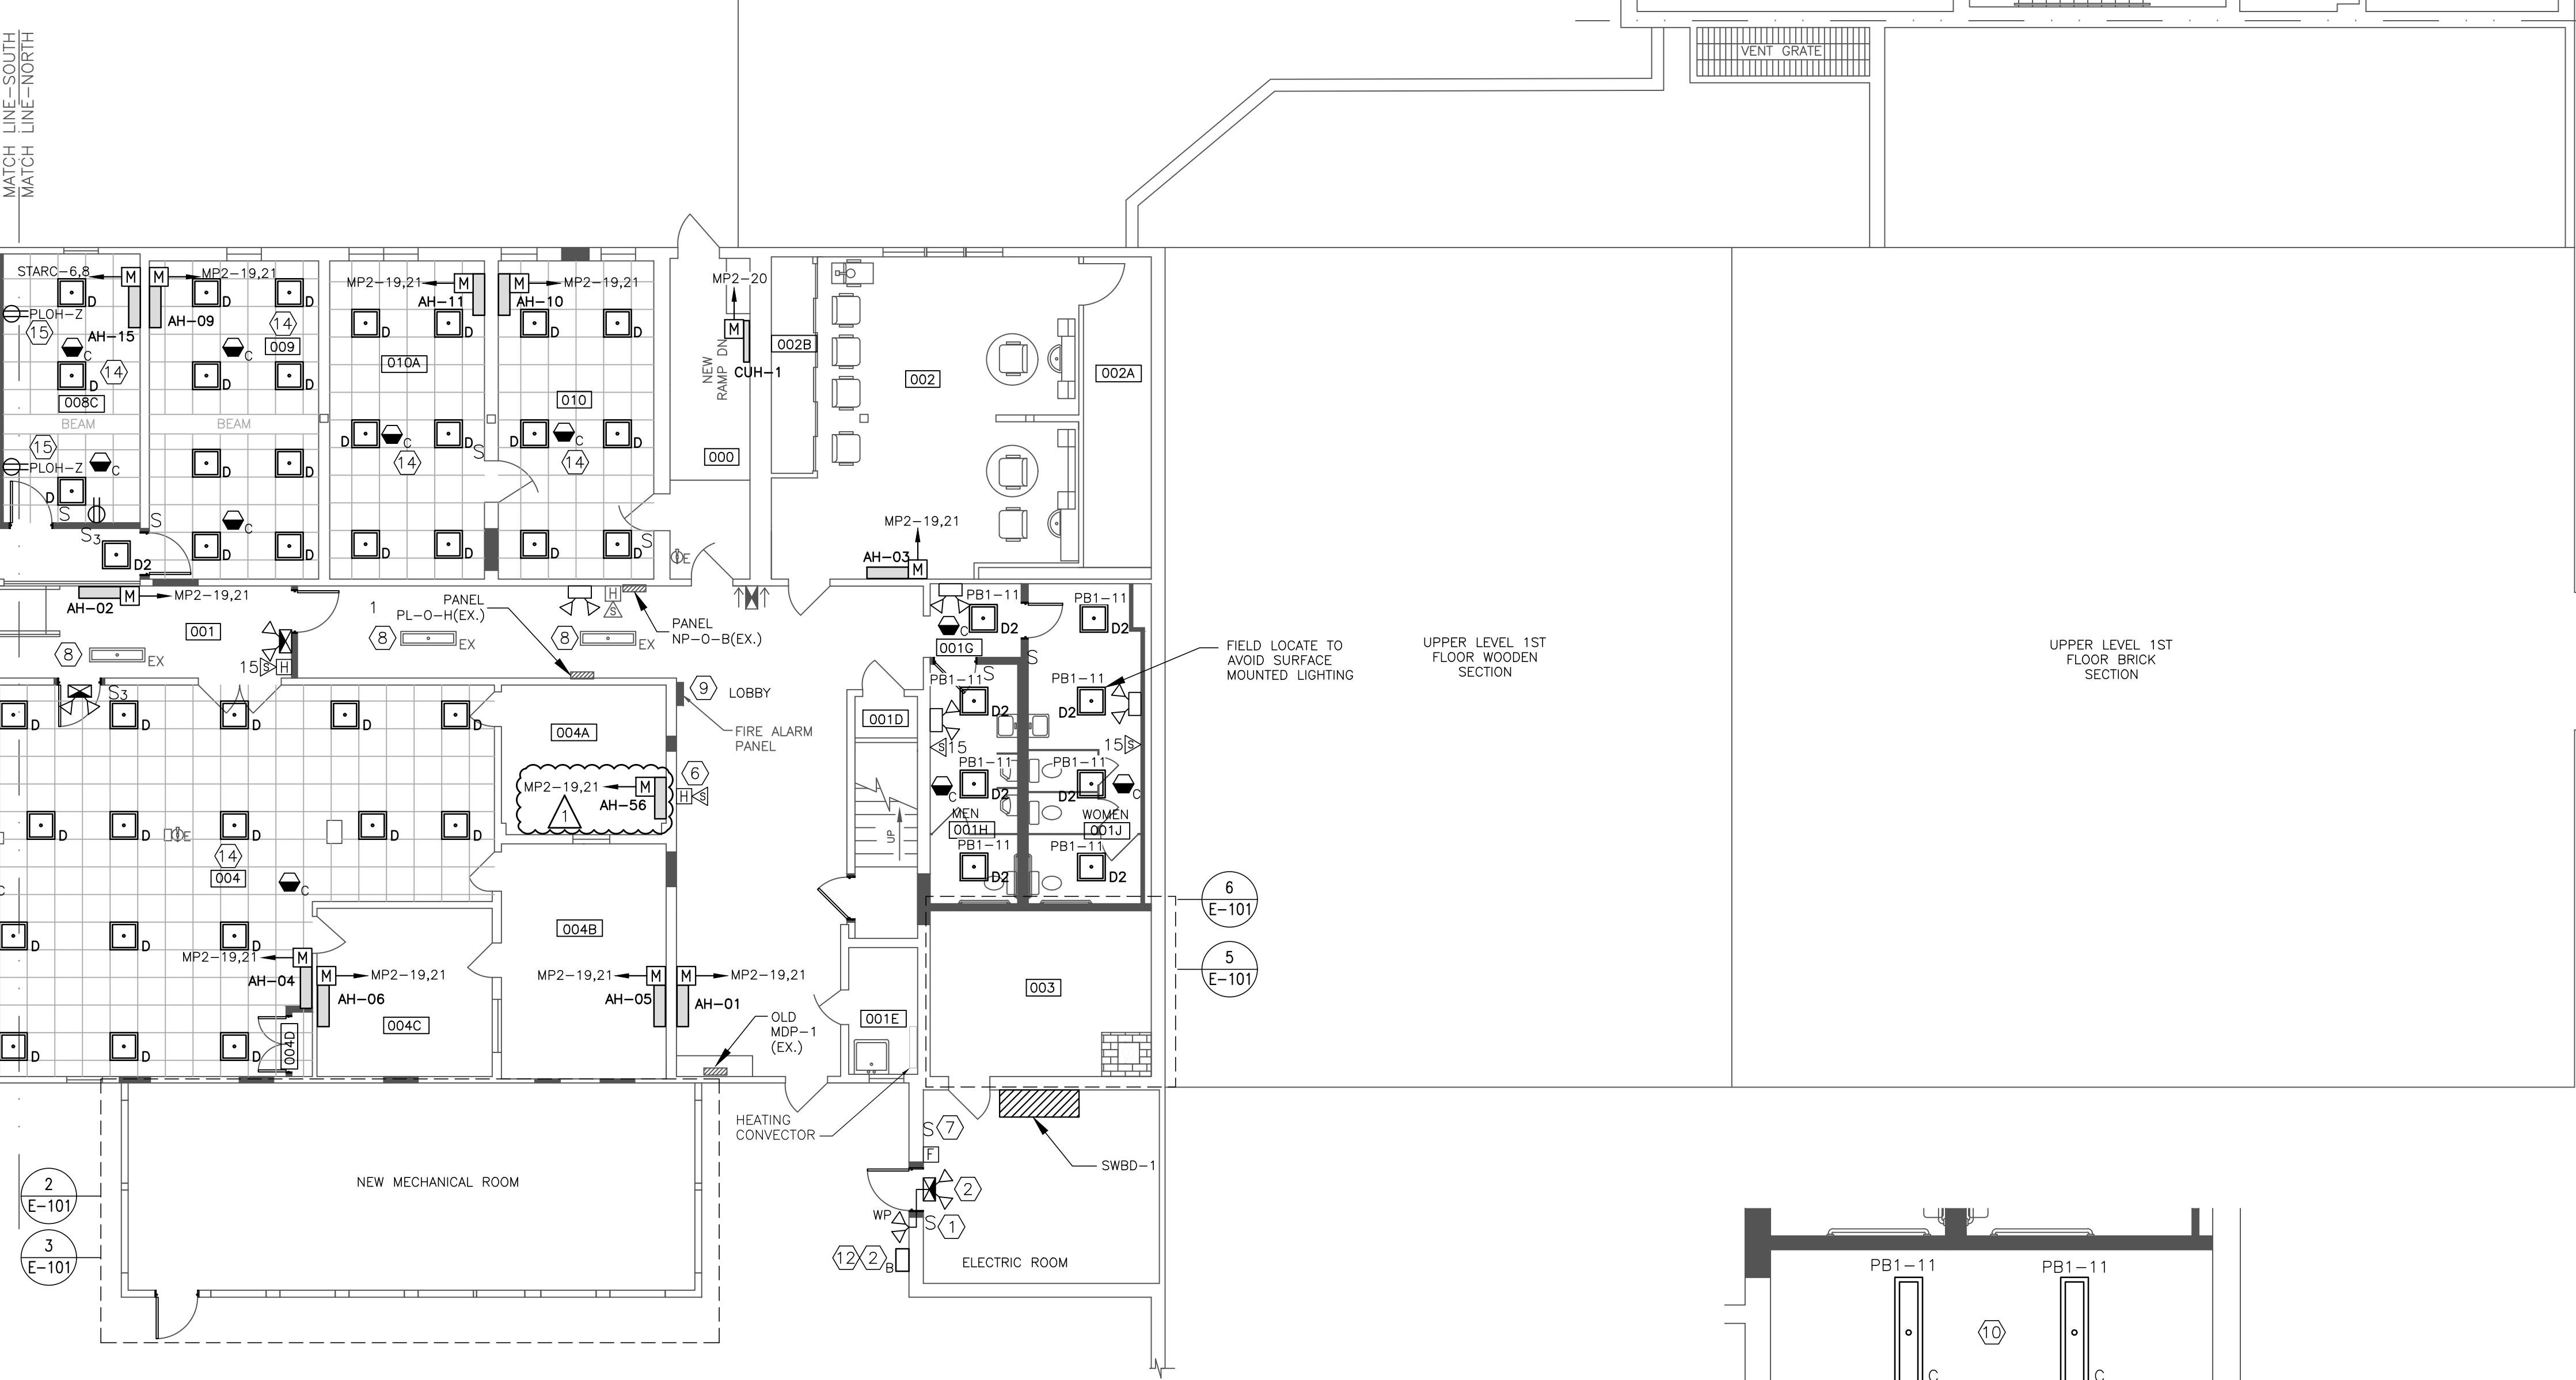


1 PROPOSED ELECTRICAL PLAN - LOWER LEVEL - NORTH END
SCALE: 1/8"=1'

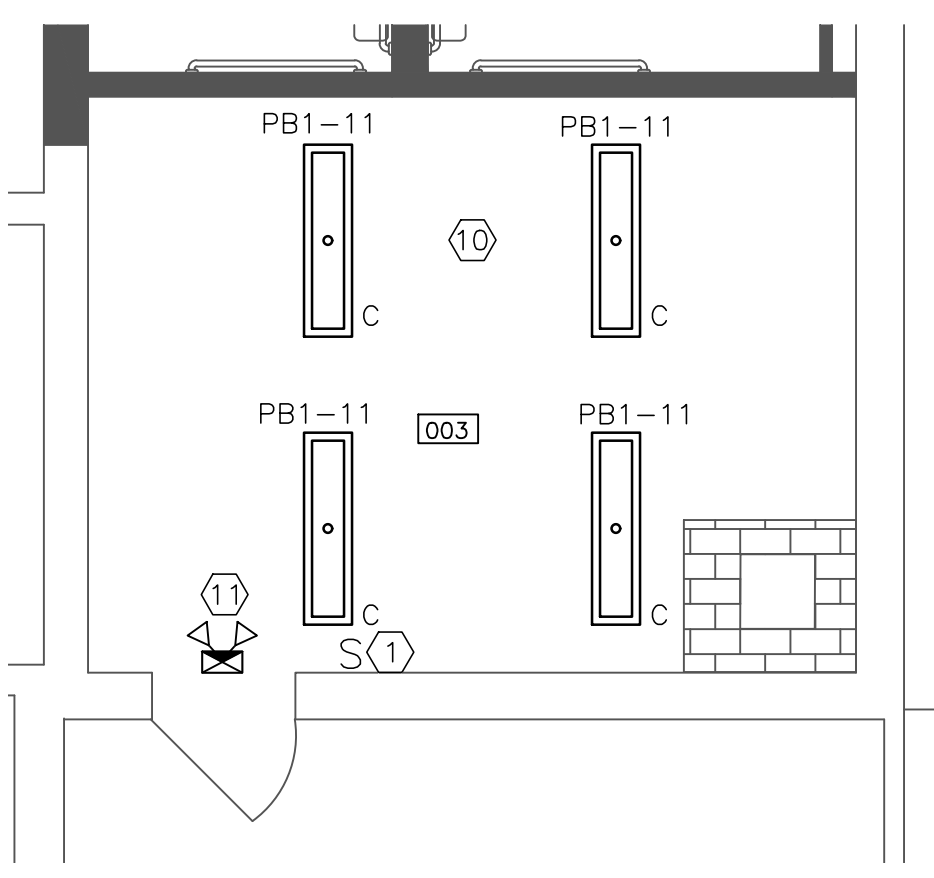


6 ELECTRICAL DETAIL - BOILER ROOM
SCALE: 1/4"=1'

NOTES:


- SEE E-000 FOR LEGEND, ABBREVIATIONS AND GENERAL NOTES.
- RELOCATE LIGHT SWITCH AND ASSOCIATED CONDUIT AND WIRE. RECONNECT TO EXISTING CIRCUIT.
- CONNECT TO EXISTING LIGHTING CIRCUIT.
- INTENT IS TO DISCONNECT EXISTING PUMPS. REMOVE CONDUIT AND WIRING AND RE-WIRE TO NEW LOCATION AS SHOWN FROM EXISTING BREAKER.
- MECHANICAL CONTROLS CIRCUIT. LOCATE AS PER MECHANICAL CONTRACTOR.
- RELOCATE EXISTING PANELS TO NEW LOCATION. RELOCATE EXISTING CIRCUIT WIRING THAT REMAINS BACK TO NEW LOCATION.
- NEW HORN STROBE.
- NEW EMERGENCY BOILER SWITCH (SEE DETAIL).
- EXISTING CORRIDOR FIXTURE RELOCATED AS REQUIRED TO ACCOMMODATE NEW DUCTWORK.
- FARADAY MODEL MPC 7000 FIRE ALARM CONTROL PANEL. COORDINATE ALL NEW EQUIPMENT OR OLD EQUIPMENT BEING REMOVED AND RELOCATED WITH EXISTING PANEL. INTENT IS TO MAINTAIN EXISTING ZONE WIRING AND SUPPLEMENT WITH NEW DEVICES WHERE SHOWN. CONTRACTOR SHALL FURNISH ALL DEVICES, WIRING, CONDUIT, POWER SUPPLIES, TESTING, PROGRAMMING REQUIRED FOR A COMPLETE OPERATIONAL SYSTEM.
- COORDINATE LOCATIONS OF FIXTURES IN FIELD WITH DUCTWORK AND PIPING.
- REINSTALL EXISTING COMBINATION EXIT/EMERGENCY LIGHT HERE.
- CONTROLLED BY PHOTOCELL.
- BUILDING AUTOMATION CONTROLS CIRCUIT. LOCATE AS PER DIVISION 25 CONTRACTOR.
- INSTALL NEW LIGHTS AND CONTROLS IN THIS ROOM. CONNECT TO EXISTING LIGHTING CIRCUIT.
- INTENT IS TO REUSE EXISTING CIRCUITS CURRENTLY FEEDING RECEPTACLES BEING DEMOLISHED. SEE ED-100 FOR MORE INFORMATION. Z SHOWN TO SHOW GROUPING RECEPTACLES ON SAME CIRCUIT. CONFIRM CIRCUIT NUMBER IN FIELD.

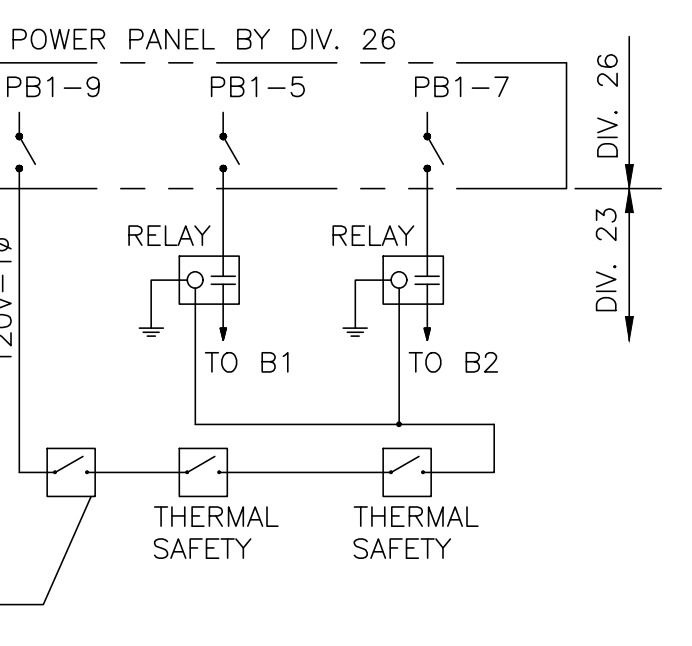

4 BOILER SAFETY INTERLOCK POWER WIRING

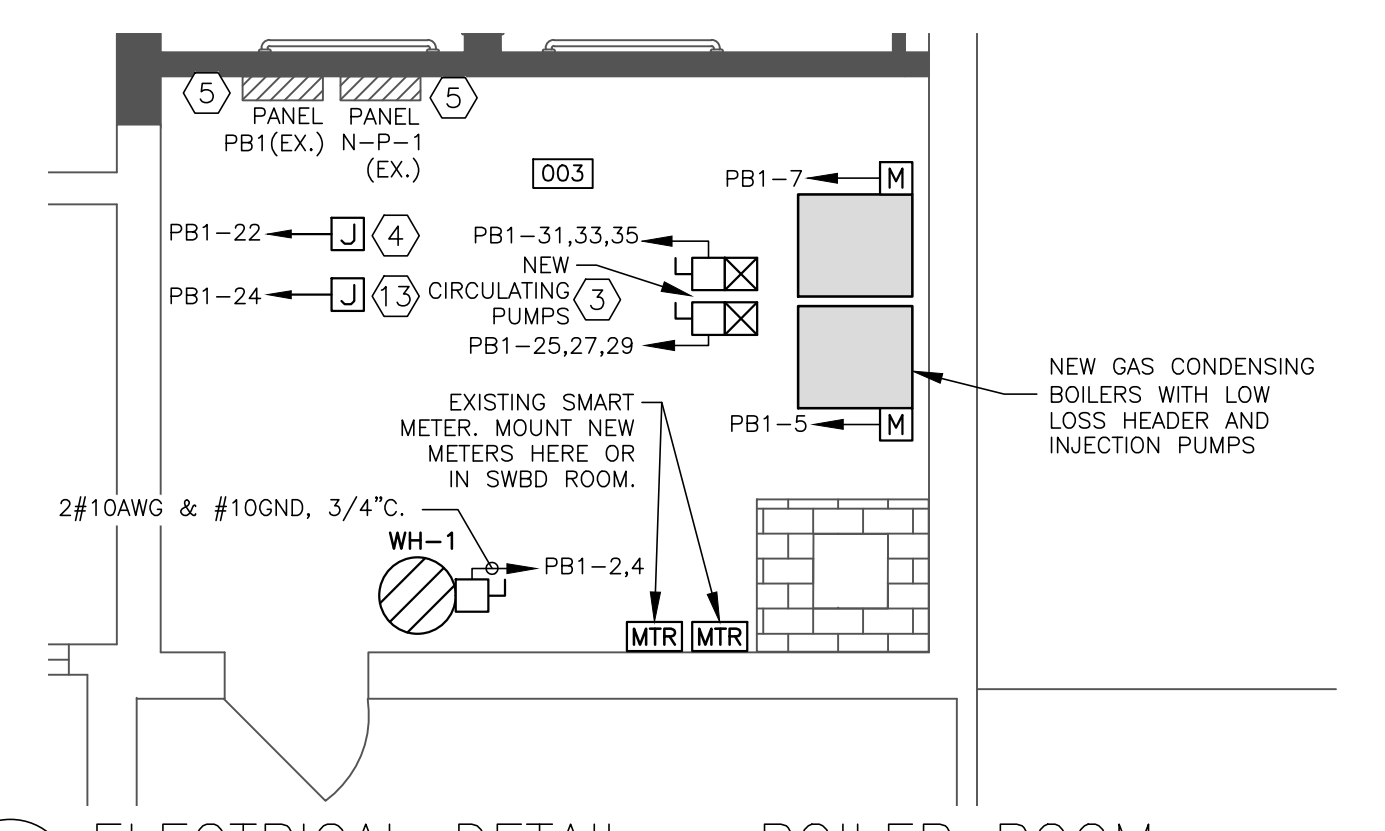

5 ELECTRICAL DETAIL - BOILER ROOM
SCALE: 1/4"=1'

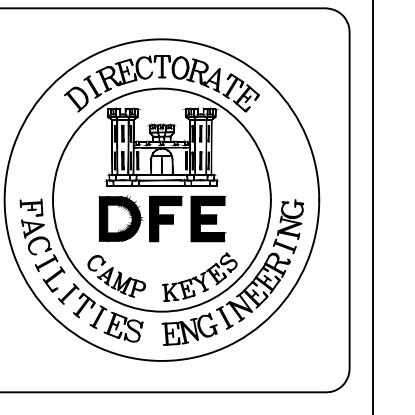

PLAN REVISIONS	Date	Appr.
1	1.28.19	

DESIGNED BY: TMD
DRAWN BY: JMD
CHECKED BY: TMD/JMD
DATE: 12/28/2018
SCALE: AS NOTED
DPE PROJECT NO: 23SR18-458-D

STATE OF MAINE
DEPARTMENT OF DEFENSE, VETERANS
AND EMERGENCY MANAGEMENT

Cordja Capital Projects Group
16 Tenney Lane, Suite 23
Comden, Maine 04843
207-236-9970 / mds@cordjagroup.com



CAMP KEYS REUTILIZATION PROJECT
CAMP KEYS, AUGUSTA, MAINE

BUILDING NO. 7 RENOVATIONS

PROPOSED ELECTRICAL PLAN
LOWER LEVEL - NORTH END

PLAN PROGRESS
<input type="checkbox"/> DRAFT
<input type="checkbox"/> 35% REVIEW
<input type="checkbox"/> 65% REVIEW
<input type="checkbox"/> 95% REVIEW
<input type="checkbox"/> FINAL REVIEW
<input checked="" type="checkbox"/> FOR BIDDING
<input type="checkbox"/> ISSUED FOR CONSTRUCTION
<input type="checkbox"/> RECORD DRAWINGS

SHEET ID:
E-101
SHEET: 115 OF 126

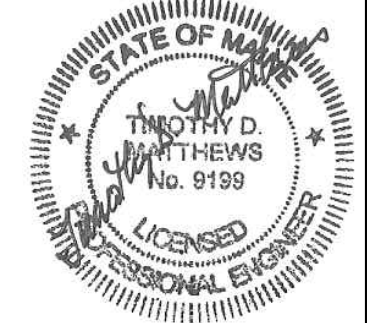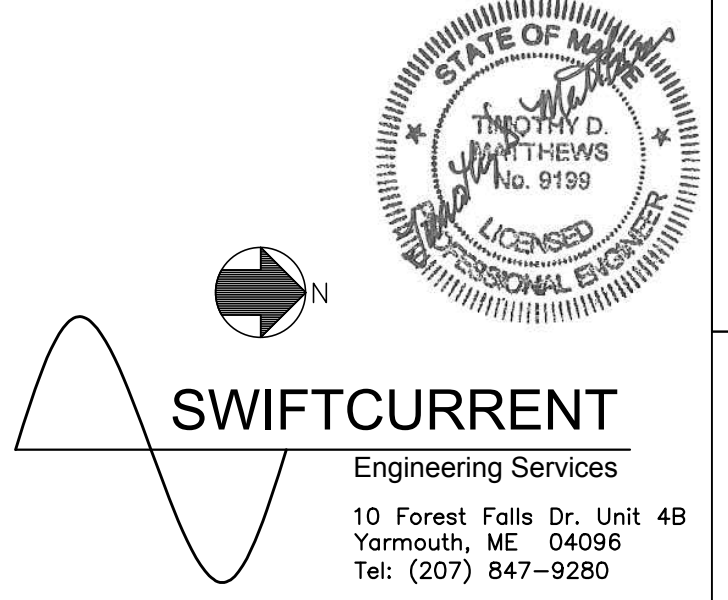

10 Forest Falls Dr. Unit 4B
Yarmouth, ME 04096
Tel: (207) 847-9280



NOTES:

1. SEE E-000 FOR LEGEND, ABBREVIATIONS AND GENERAL NOTES.

KEYED NOTES:

- ① RELOCATE EXISTING RECEPTACLE. REWIRE TO EXISTING CIRCUIT.
- ② CEILING IN THIS AREA TO BE RECONFIGURED DUE TO RELOCATION OF WALL. RELOCATE EFFECTED LIGHT FIXTURES WITHIN GRID AS REQUIRED.
- ③ REUSE EXISTING SWITCH.
- ④ CEILING IN THIS AREA BEING REPLACED. REPLACE EXISTING LIGHT WITH NEW FIXTURE AND REWIRE TO EXISTING CIRCUIT AND CONTROLS.
- ⑤ REUSE EXISTING BATHROOM LIGHTING CIRCUIT FOR NEW FIXTURES. CUT IN NEW SWITCHES FOR SEPARATE ROOM OPERATION.
- ⑥ REMOVE AND REPLACE LIGHTING FOR STRUCTURAL UPGRADES IN THIS AREA.
- ⑦ FURNISH NEW SQUARE D BREAKER 20A, 1P GFI FOR NEW DRINKING FOUNTAIN.
- ⑧ FURNISH GFI PROTECTED RECEPTACLE FOR DRINKING FOUNTAIN. COORDINATE MOUNTING HEIGHT WITH EQUIPMENT FURNISHED.

Rev#	Description	Date	Appr.
1	GENERAL REVISIONS		

DESIGNED BY: TMD
 DRAWN BY: JMD
 CHECKED BY: TMD/JMD
 DATE: 12/28/2018
 SCALE: AS NOTED
 DFE PROJECT NO: 23SR18-458-D


STATE OF MAINE
 DEPARTMENT OF DEFENSE, VETERANS
 AND EMERGENCY MANAGEMENT
 Cordja Capital Projects Group
 16 Tenney Lane, Suite 23
 Comden, Maine 04843
 207-236-9970 / mds@cordjagroup.com

CAMP KEYES REUTILIZATION PROJECT
 CAMP KEYES, AUGUSTA, MAINE
 BUILDING NO. 7 RENOVATIONS
 PROPOSED ELECTRICAL PLAN
 FIRST FLOOR - NORTH END



PLAN PROGRESS

<input type="checkbox"/>	DRAFT
<input type="checkbox"/>	35% REVIEW
<input type="checkbox"/>	65% REVIEW
<input type="checkbox"/>	95% REVIEW
<input type="checkbox"/>	FINAL REVIEW
<input checked="" type="checkbox"/>	FOR BIDDING
<input type="checkbox"/>	ISSUED FOR CONSTRUCTION
<input type="checkbox"/>	RECORD DRAWINGS


SHEET ID:
 E-111
 SHEET: 117 OF 126

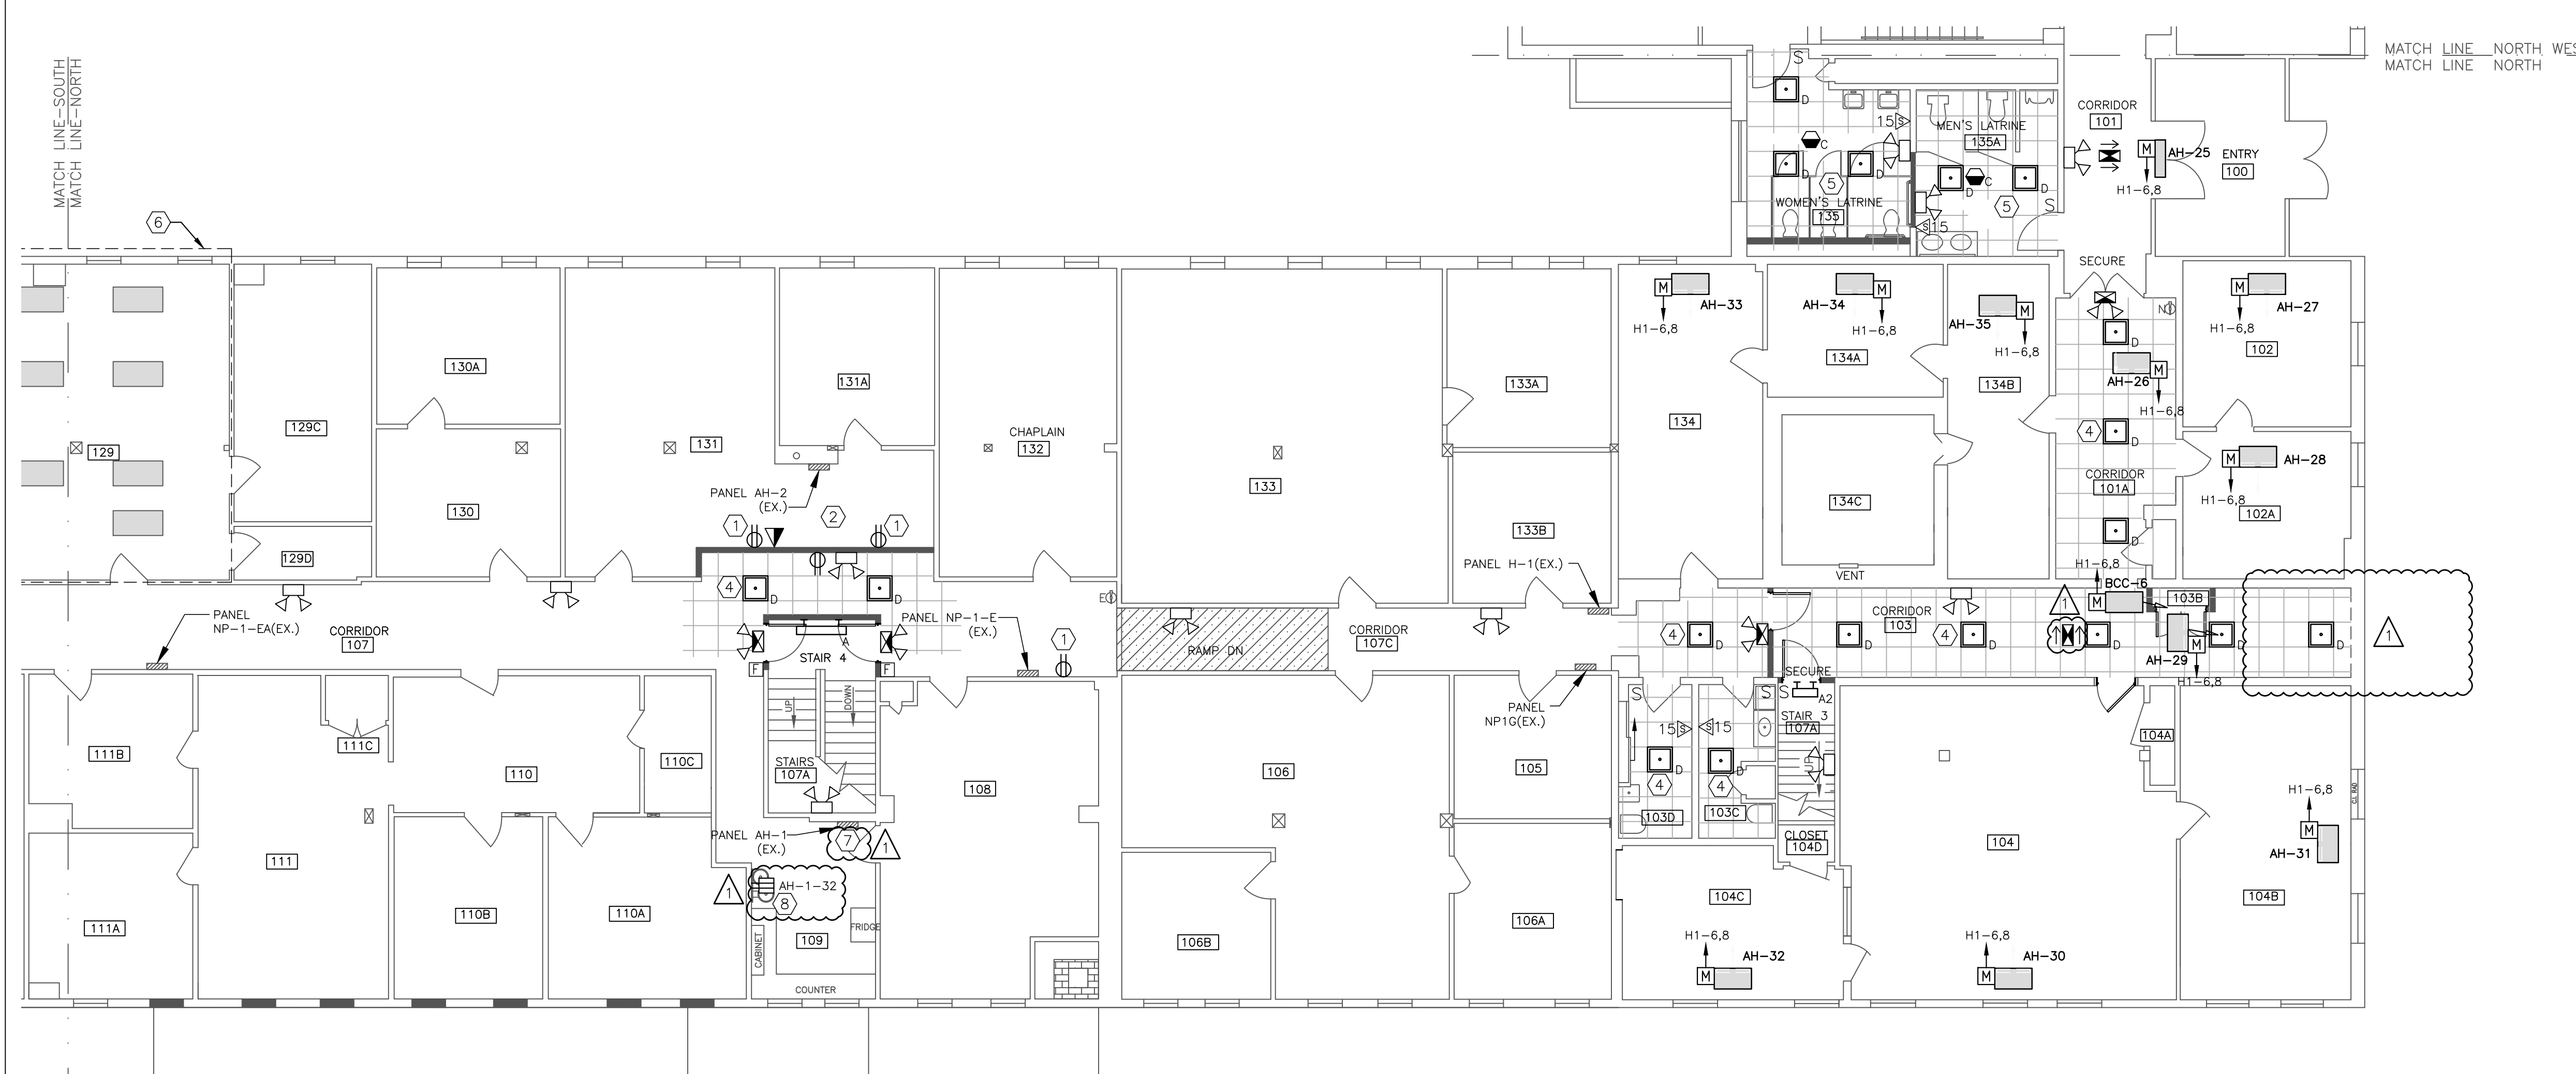

1 PROPOSED ELECTRICAL PLAN - FIRST FLOOR - NORTH END
 SCALE: 1/8"=1'

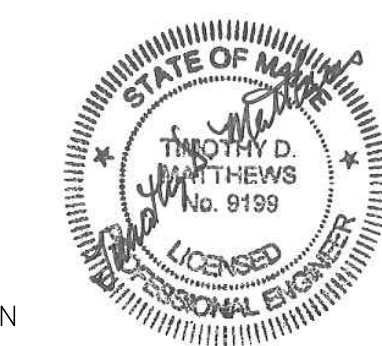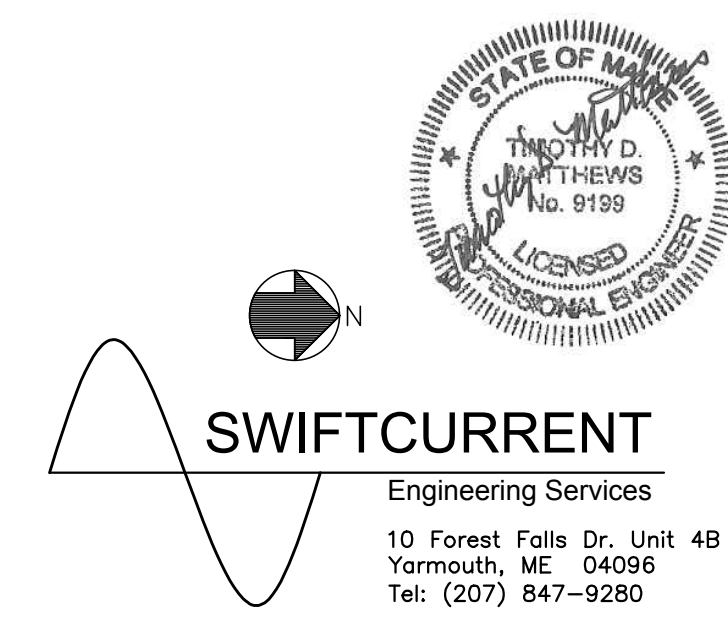


10 Forest Falls Dr. Unit 4B
 Yarmouth, ME 04096
 Tel: (207) 847-9280

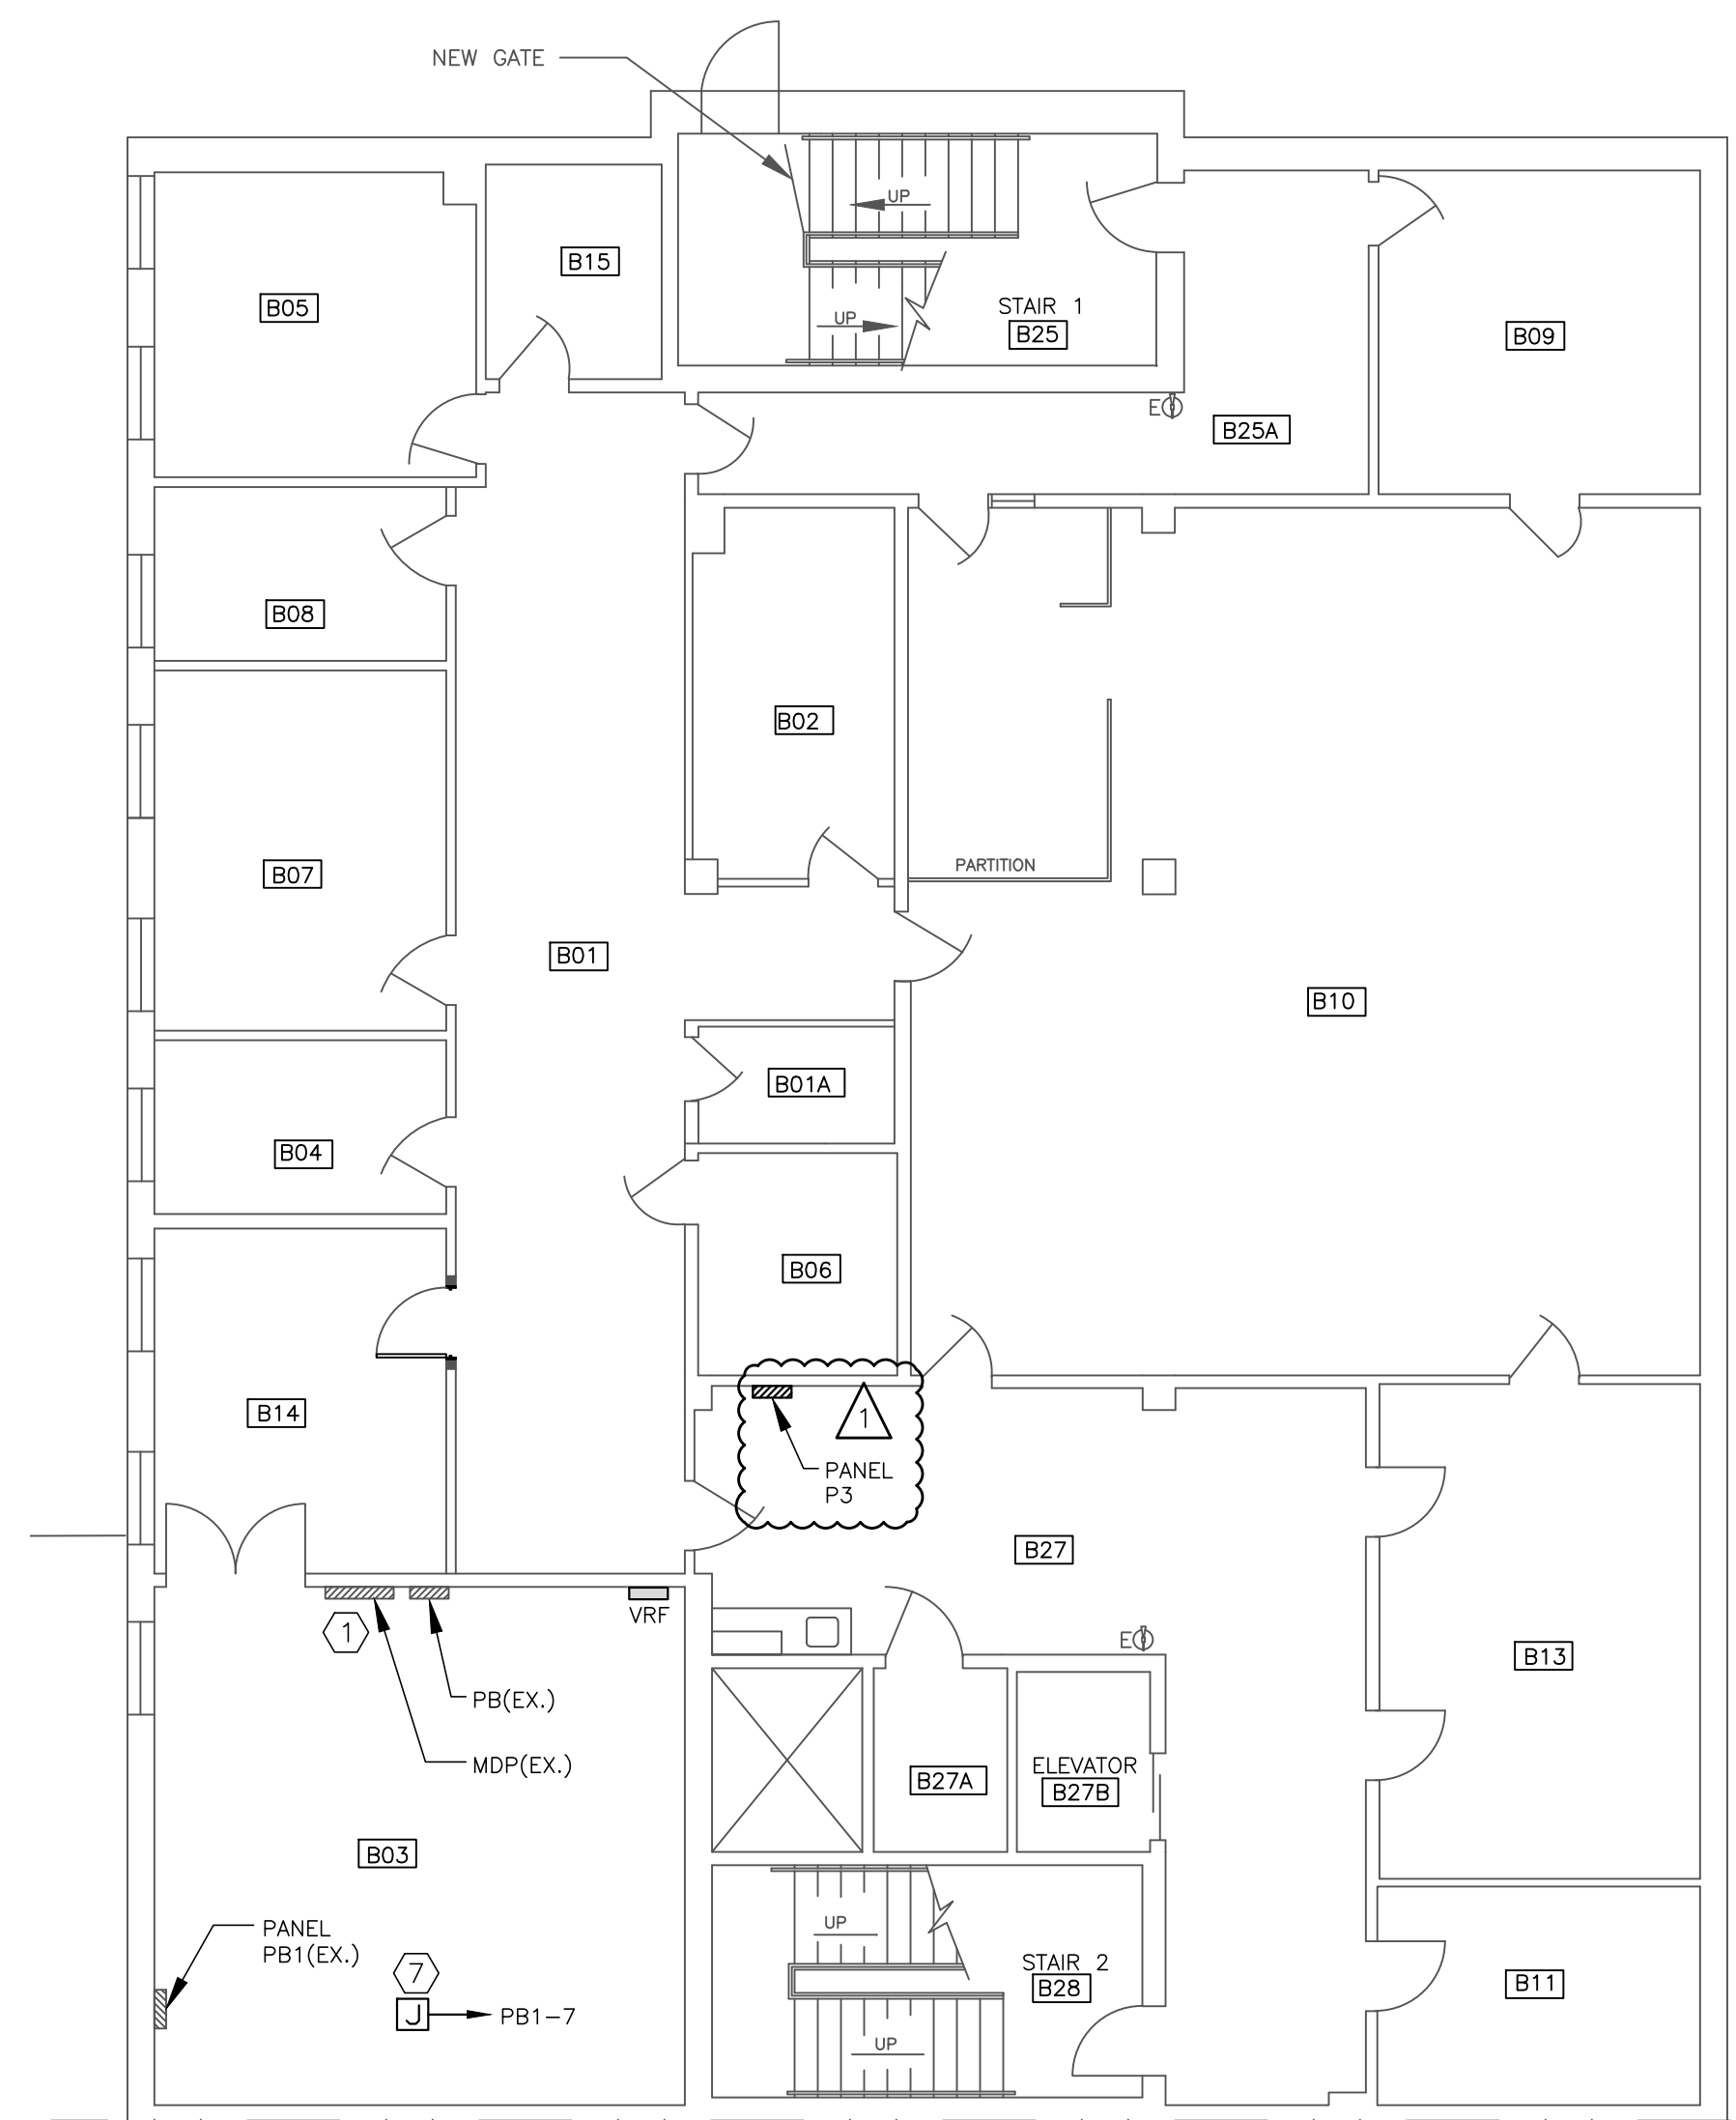


PROPOSED ELECTRICAL PLAN – LOWER LEVEL
– NORTH WEST WING

1 SCALE: 1/8"=1'

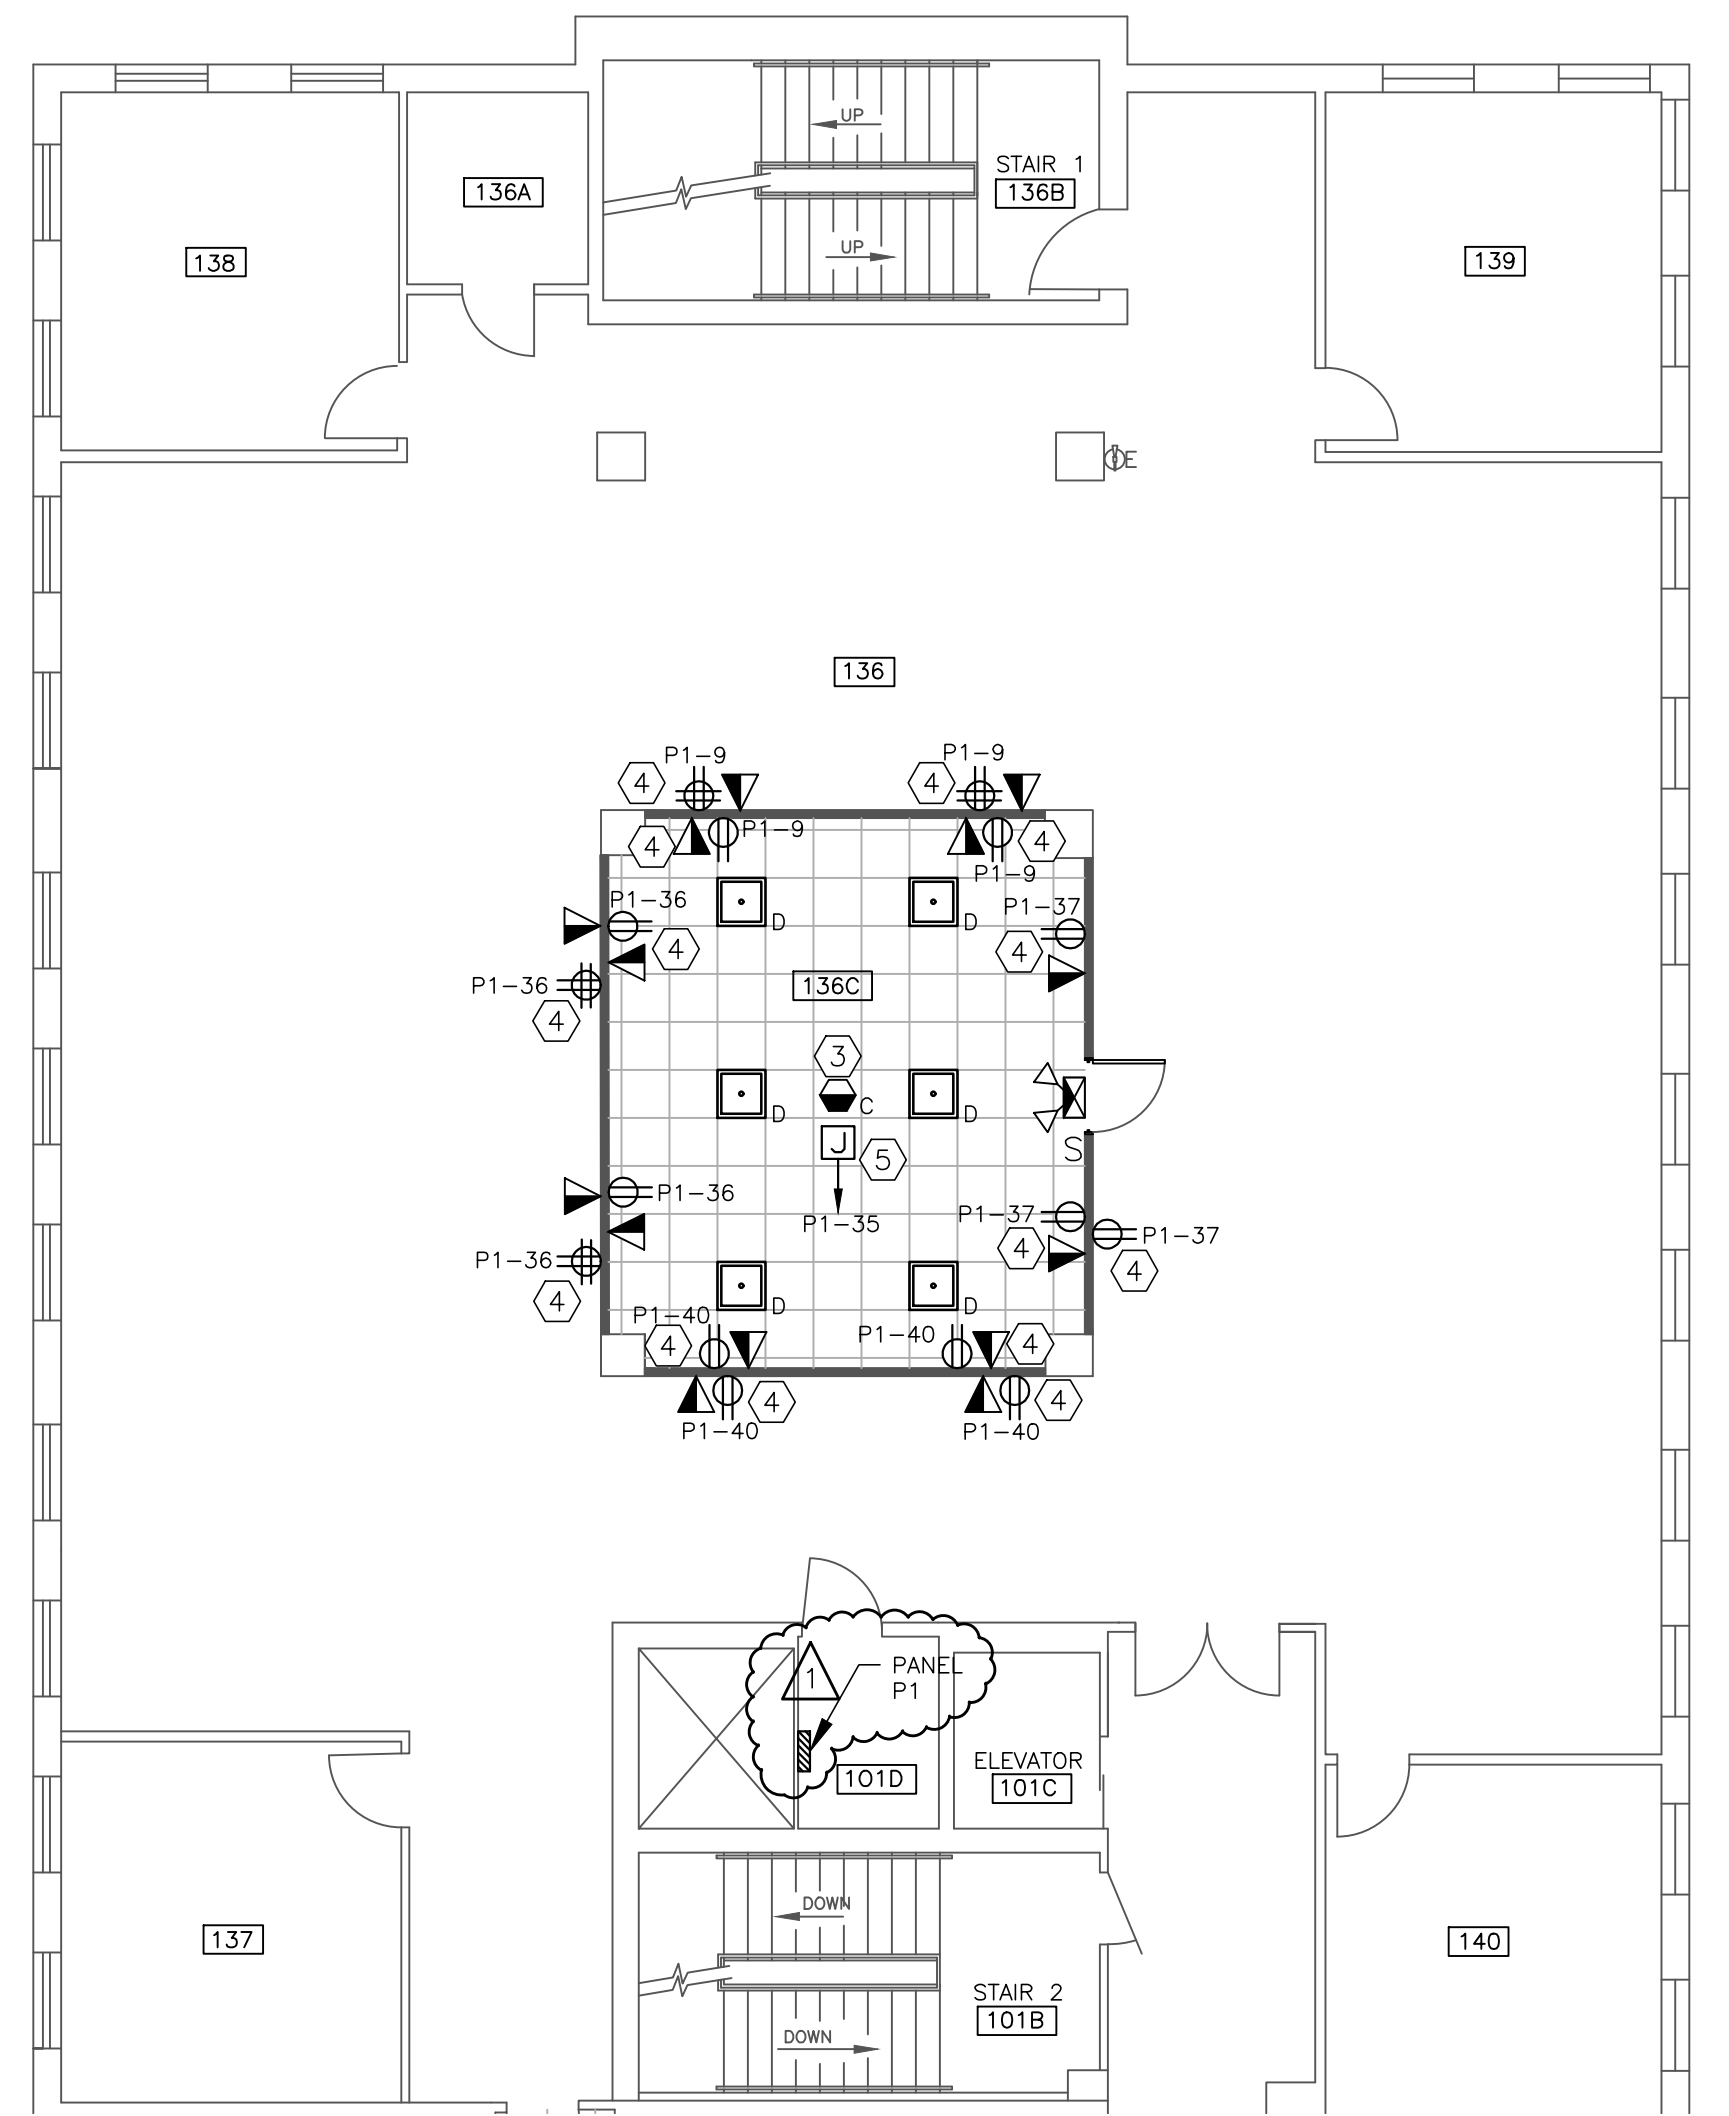

PROPOSED ELECTRICAL PLAN – FIRST FLOOR
– NORTH WEST WING

2 SCALE: 1/8"=1'

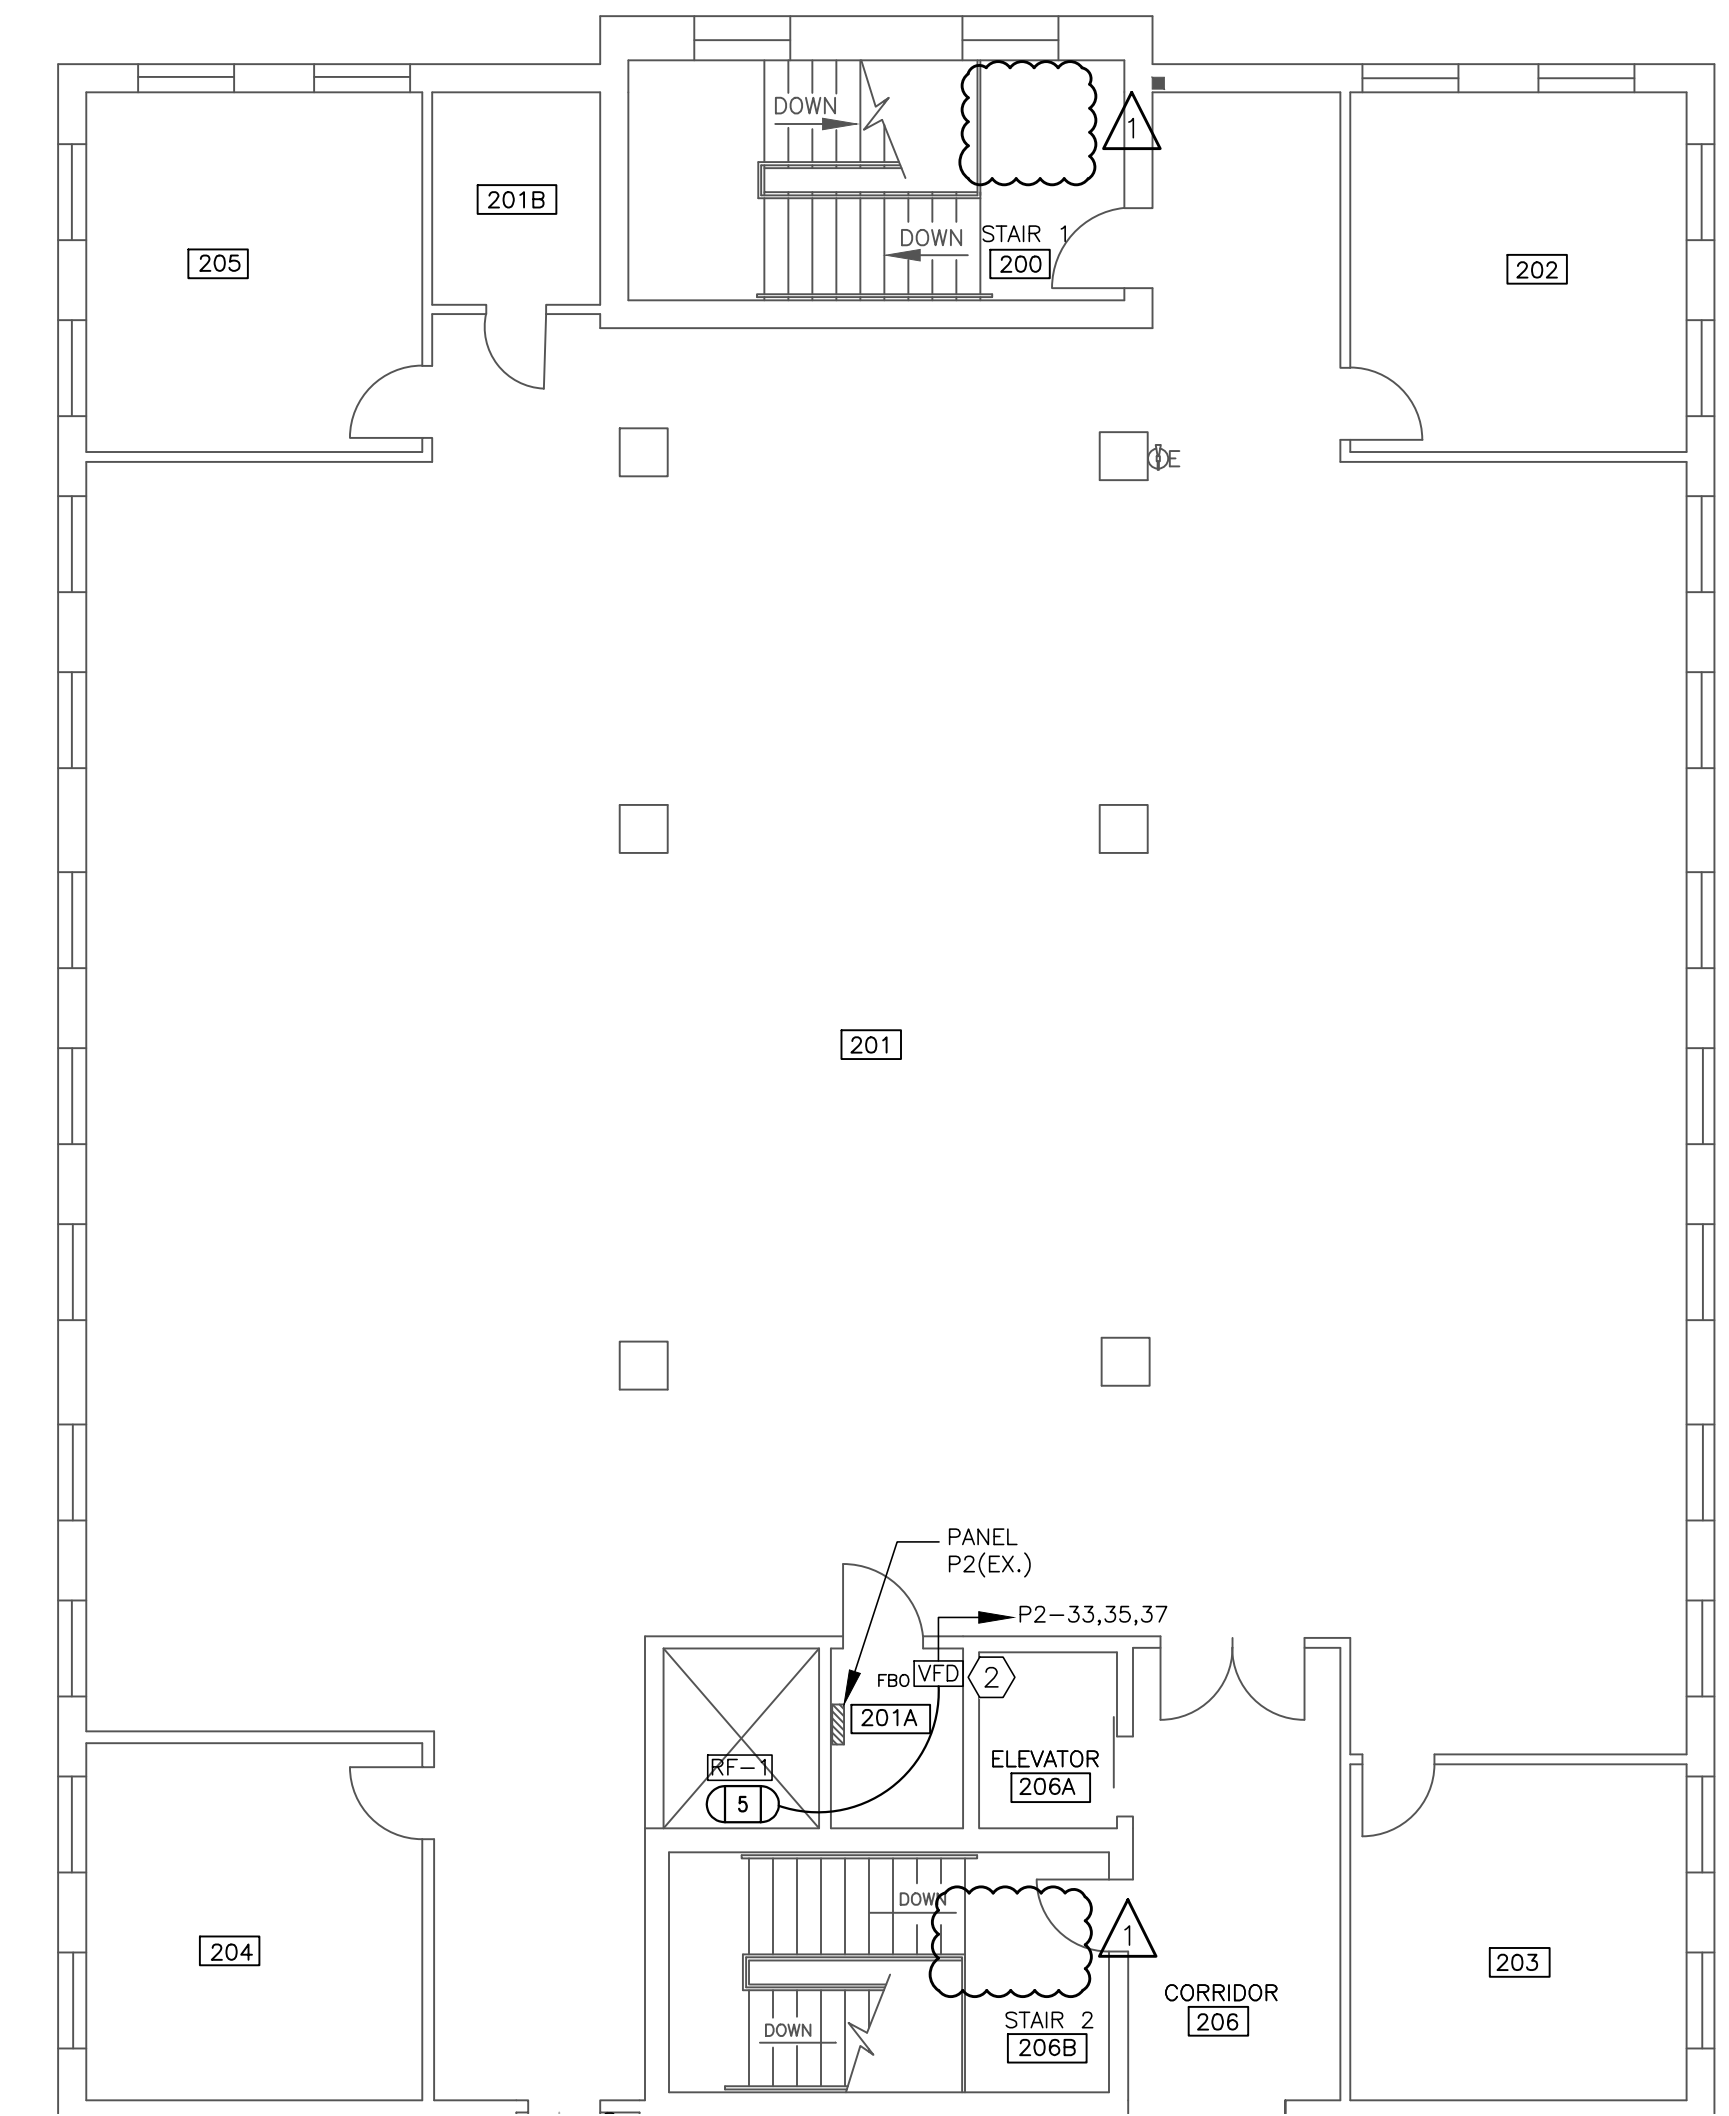

PROPOSED ELECTRICAL PLAN – SECOND FLOOR
– NORTH WEST WING

3 SCALE: 1/8"=1'

- NOTES:**
- SEE E-000 FOR LEGEND, ABBREVIATIONS AND GENERAL NOTES.
 - NEW DATA DEVICES SHALL HAVE (1)VOICE/(1)DATA. RUN BACK TO LOCAL DATA ROOM. PROVIDE ENOUGH SLACK TO REACH ALONG CEILING TO FURTHEST POINT IN DATA ROOM AND FROM THERE TO FLOOR.

- KEYED NOTES:**
- INTENT IS TO REPLACE 20A, 3P BREAKER IN PANEL MDP WITH NEW 100A, 3P BREAKER FOR FUTURE IT ROOM PANEL TO BE FURNISHED BY OTHERS OUTSIDE OF SCOPE.
 - NEW RF-1 REPLACING EF-3 ON ROOF. RECONNECT FAN AND INSTALL VFD FURNISHED BY DIVISION 25 CONTROLS TO EXISTING CIRCUIT.
 - INSTALL NEW LIGHTS AND REWIRE AS REQUIRED TO CONTROL SEPARATELY FROM FIXTURES IN AREA 136.
 - CIRCUITS SHOWN ARE FROM PANEL SCHEDULE. VERIFY IN FIELD. INTENT IS TO REUSE EXISTING CIRCUITS.
 - EXISTING CEILING POWER CIRCUIT. IN JUNCTION BOX ABOVE CEILING FOR FUTURE USE.
 - NOT USED.
 - FURNISH 120V POWER AS REQUIRED FOR BUILDING AUTOMATION SYSTEM.



PLAN REVISIONS	Date	Appr.
1 GENERAL REVISIONS	1.28.19	

DESIGNED BY: TMD
 DRAWN BY: JMD
 CHECKED BY: TMD/JMD
 DATE: 12/28/2018
 SCALE: AS NOTED
 DFE PROJECT NO: 235R18-458-D


STATE OF MAINE
 DEPARTMENT OF DEFENSE, VETERANS
 AND EMERGENCY MANAGEMENT
 Cordja Capital Projects Group
 16 Tenney Lane, Suite 23
 Comden, Maine 04843
 207-236-9970 / mds@cordjagroup.com

CAMP KEYS REUTILIZATION PROJECT
 CAMP KEYS, AUGUSTA, MAINE
 BUILDING NO. 7 RENOVATIONS
 PROPOSED ELECTRICAL PLAN
 1st, 2nd, 3rd FLOOR – N.W. WING


PLAN PROGRESS

<input type="checkbox"/>	DRAFT
<input type="checkbox"/>	35% REVIEW
<input type="checkbox"/>	65% REVIEW
<input type="checkbox"/>	95% REVIEW
<input type="checkbox"/>	FINAL REVIEW
<input checked="" type="checkbox"/>	FOR BIDDING
<input type="checkbox"/>	ISSUED FOR CONSTRUCTION
<input type="checkbox"/>	RECORD DRAWINGS

SHEET ID:
 E-122
 SHEET: 120 OF 126

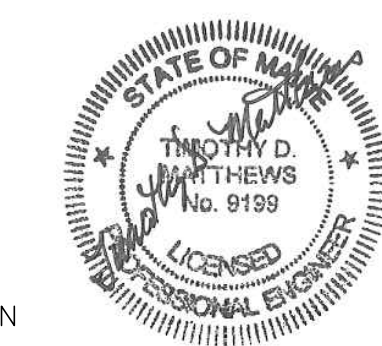

SWIFTCURRENT
 Engineering Services
 10 Forest Falls Dr. Unit 4B
 Yarmouth, ME 04096
 Tel: (207) 847-9280



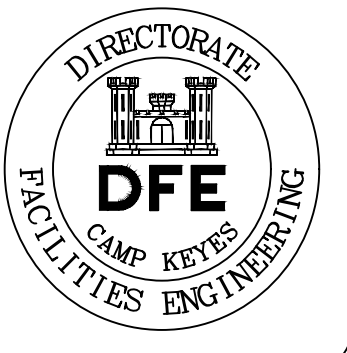


NOTES:

- SEE E0.0 FOR LEGEND, ABBREVIATIONS AND GENERAL NOTES.
- ONE-LINE DIAGRAM IS PARTIAL AND BASED ON FIELD LABELING. IT IS PROVIDED ONLY FOR INFORMATIONAL PURPOSES. CONTRACTOR SHALL FIELD VERIFY ALL INFORMATION DURING CONSTRUCTION.

KEYED NOTES:

- REPLACE PANEL CS2 IN CRAWL SPACE OF SECOND FLOOR DENTAL AREA. REUSE EXISTING CIRCUIT.
- FURNISH NEW 400A, 3P BREAKER IN EXISTING SQUARE D, QED STYLE SWITCHBOARD. BREAKER SHALL BE SQUARE D MODEL LH36400.
- FURNISH NEW 20A, 3P BREAKERS IN EXISTING SQUARE D, QED STLE SWITCHBOARD TO FEED NEW ERV UNITS.
- RELOCATE EXISTING PANEL N/P IN BOILER ROOM. RE-FEED FROM EXISTING BREAKER AND RE-ROUTE CIRCUIT TO NEW LOCATION.
- RELOCATE PANEL B1 IN BOILER ROOM. IDENTIFY THE BREAKER FEEDING THIS PANEL. RE-FEED FROM EXISTING BREAKER AND RE-ROUTE CIRCUIT TO NEW LOCATION.
- FURNISH NEW POWERLOGIC PM5000 POWER METER AND CT/PT EQUIPMENT TO MEASURE MAIN POWER IN. UNIT SHALL BE CAPABLE OF READING PULSES FROM THE WATER AND GAS METERS. MECHANICAL CONTROLS CONTRACTOR SHALL BE RESPONSIBLE FOR INSTALLING WIRING FROM REMOTE WATER AND GAS METERS AND CONNECTION FROM POWER METER TO MECHANICAL CONTROLLER/LOGGER.
- FURNISH NEW POWERLOGIC PM5000 POWER METER AND CT/PT TO EQUIPMENT TO MEASURE POWER ON NEW PANEL MP2.
- EXISTING CIRCUIT FOR AHU-1. FURNISH NEW POWERLOGIC PM5000 POWER METER AND CT/PT TO CIRCUIT TO MEASURE POWER USED BY AHU-1.

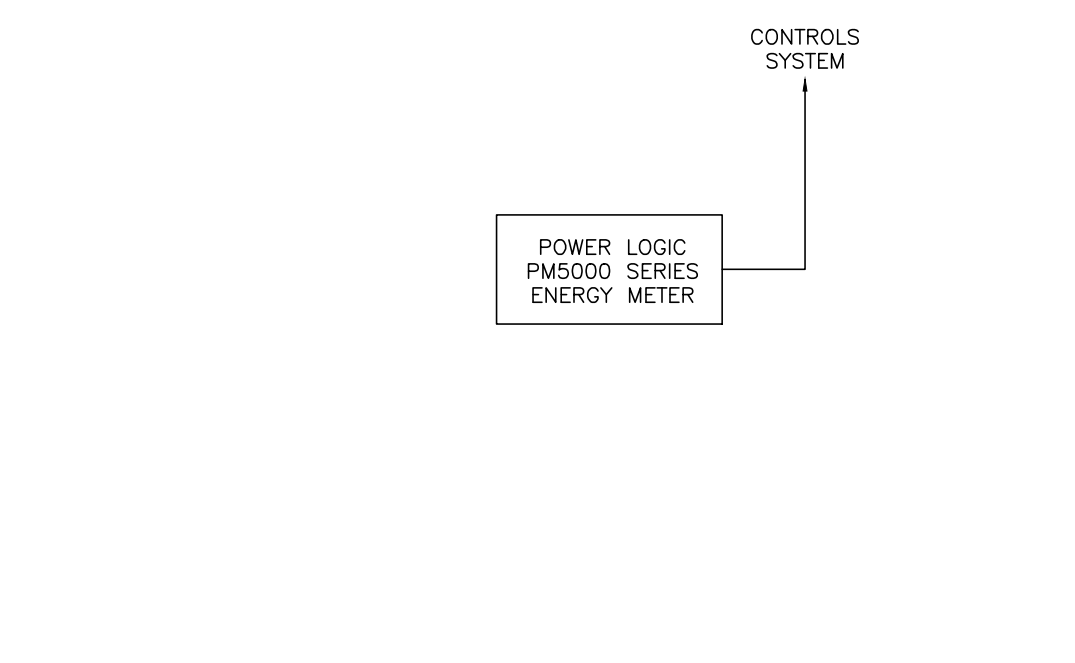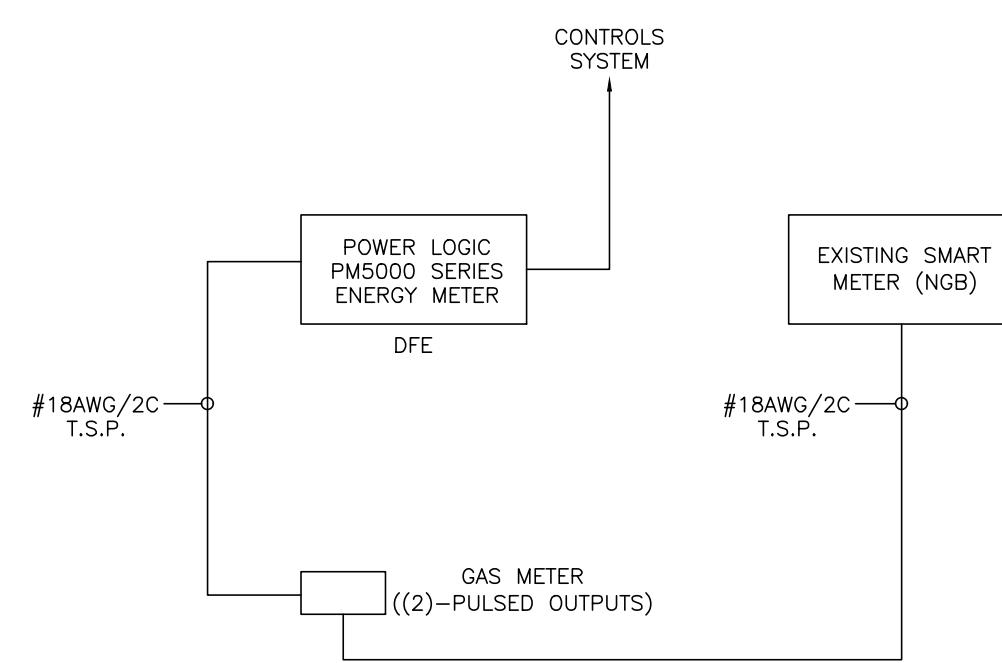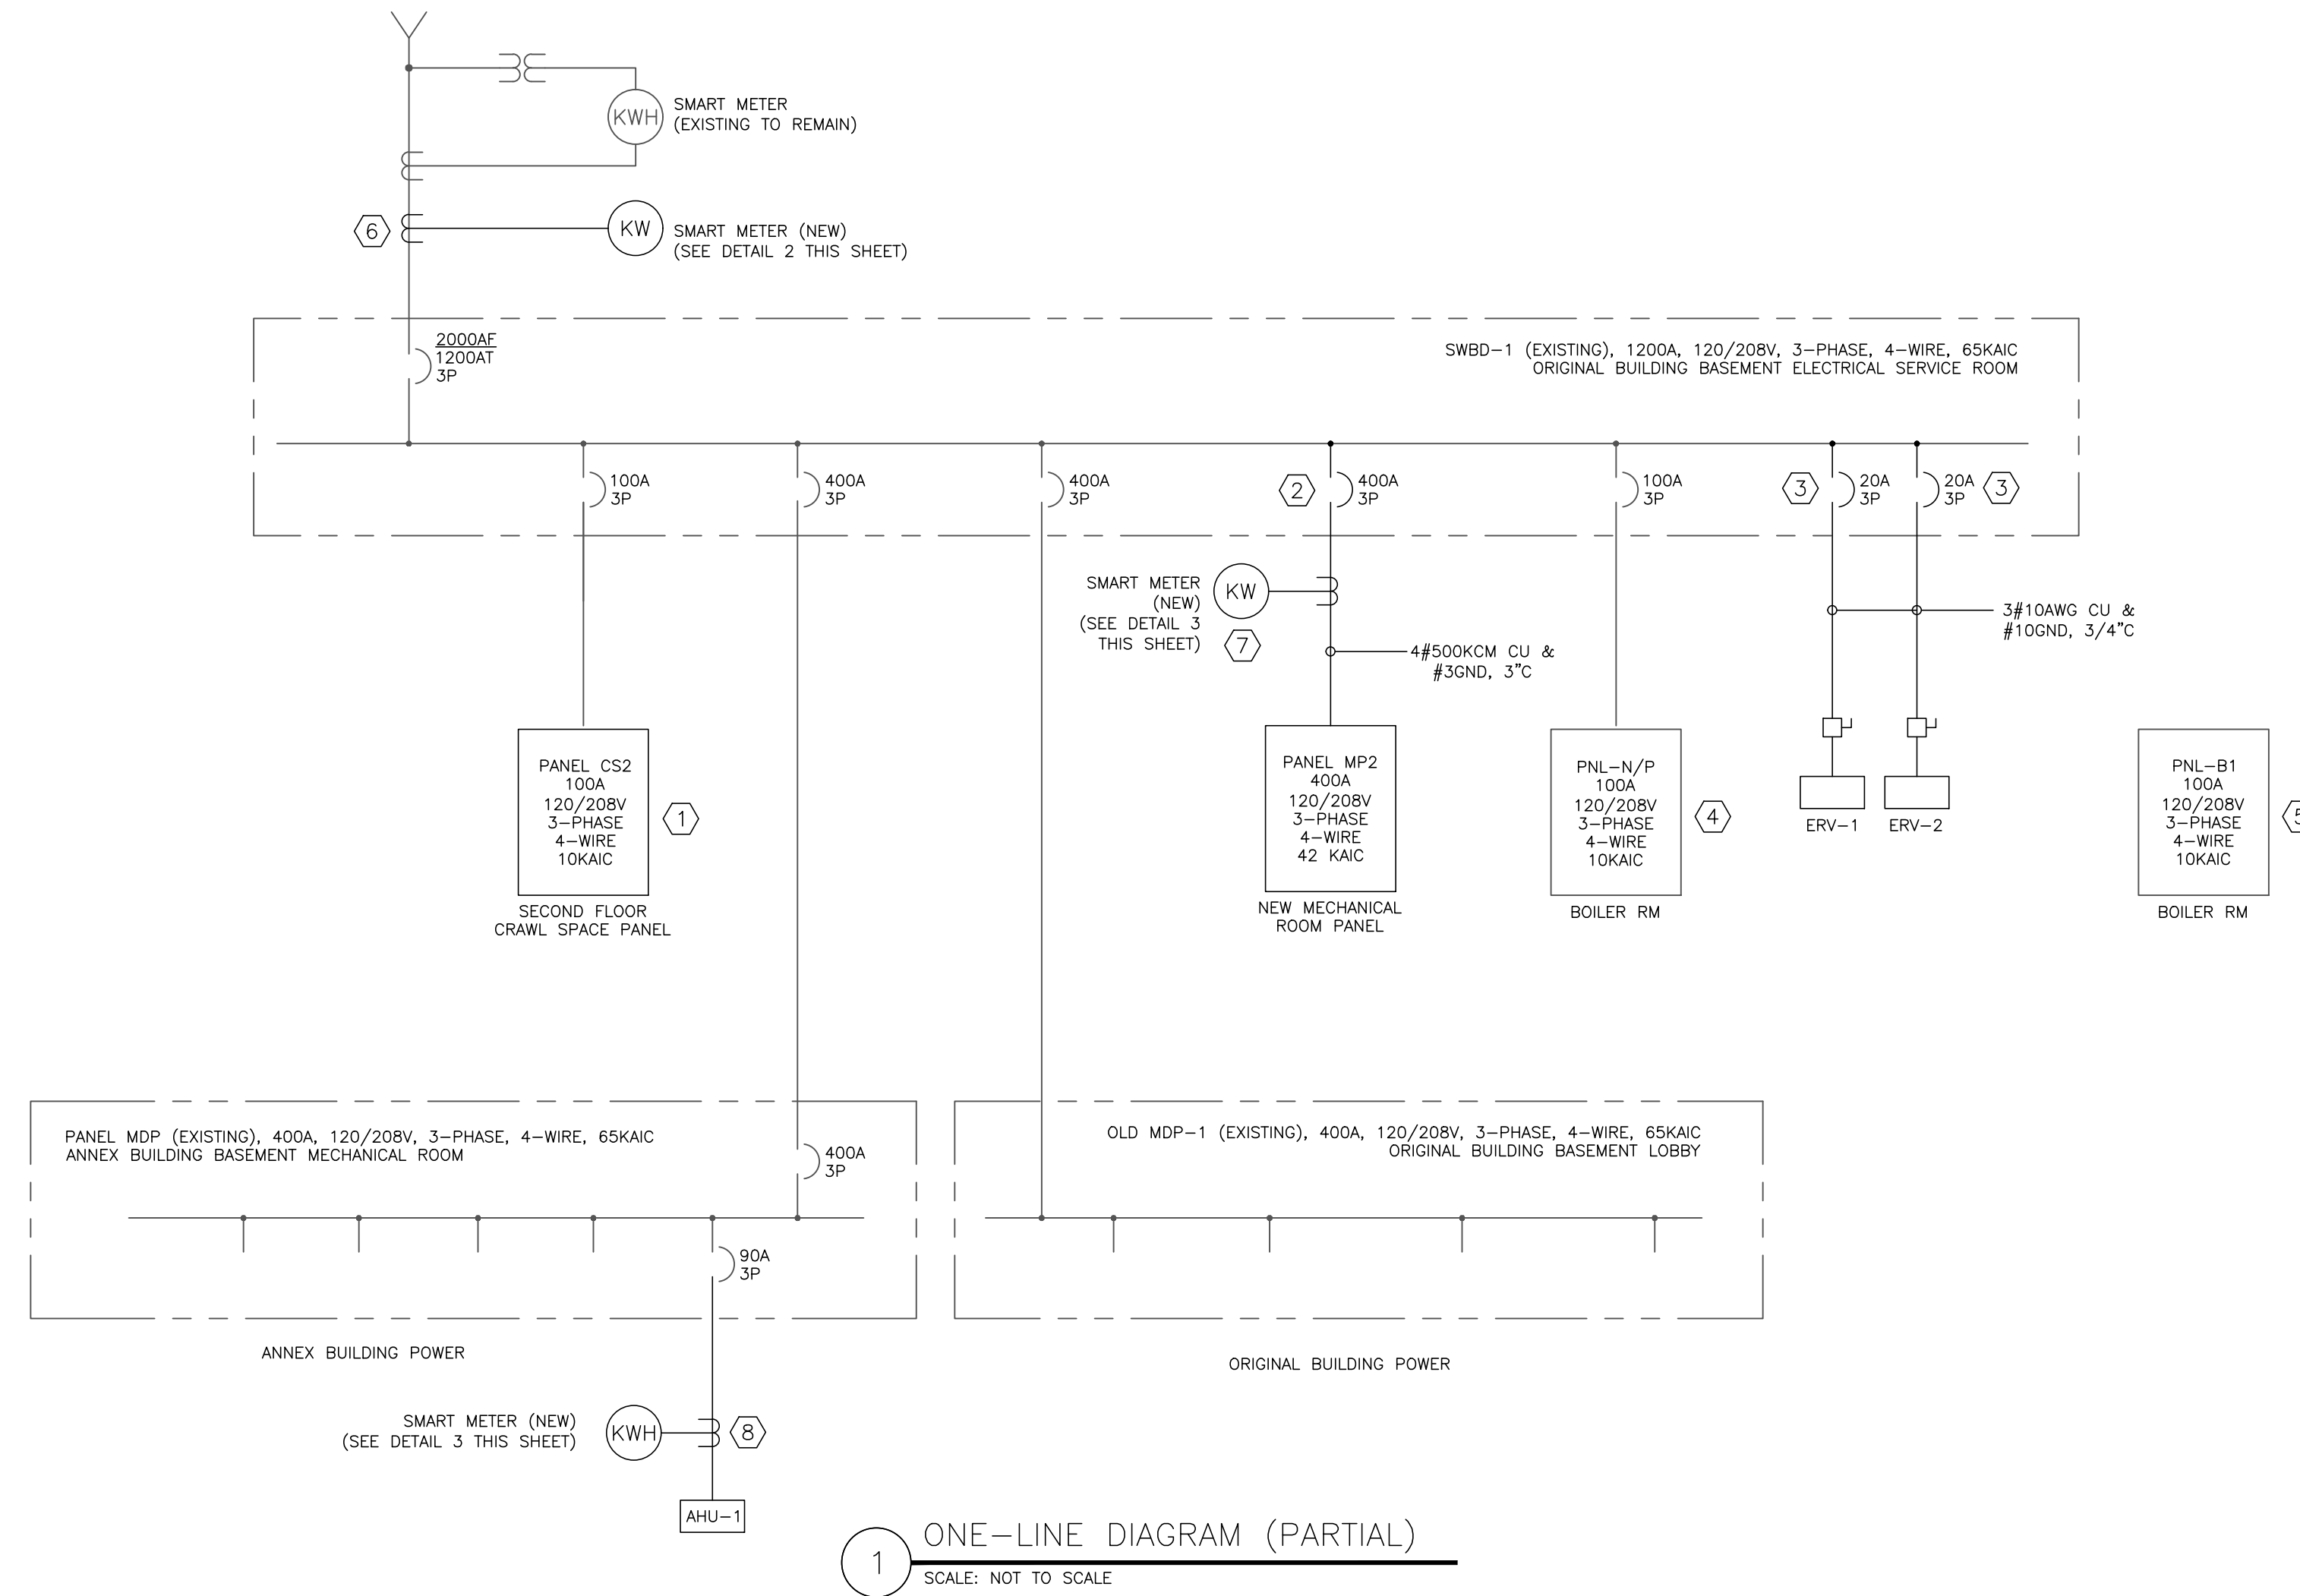

ADDENDUM #	Date	Appr.
1	1.28.19	

DESIGNED BY: TMD
 DRAWN BY: JMD
 CHECKED BY: TMD/JMD
 DATE: 12/28/2018
 SCALE: AS NOTED
 DFE PROJECT NO: 23SR18-458-D


STATE OF MAINE
 DEPARTMENT OF DEFENSE, VETERANS
 AND EMERGENCY MANAGEMENT
 Cordja Capital Projects Group
 16 Tenney Lane, Suite 23
 Camden Maine 04843
 207-236-9970 / mds@cordjagroup.com

CAMP KEYES REUTILIZATION PROJECT
 CAMP KEYES, AUGUSTA, MAINE
 BUILDING NO. 7 RENOVATIONS
 ELECTRICAL ONE-LINE DIAGRAM

PLAN PROGRESS

<input type="checkbox"/>	DRAFT
<input type="checkbox"/>	35% REVIEW
<input type="checkbox"/>	65% REVIEW
<input type="checkbox"/>	95% REVIEW
<input type="checkbox"/>	FINAL REVIEW
<input checked="" type="checkbox"/>	FOR BIDDING
<input type="checkbox"/>	ISSUED FOR CONSTRUCTION
<input type="checkbox"/>	RECORD DRAWINGS



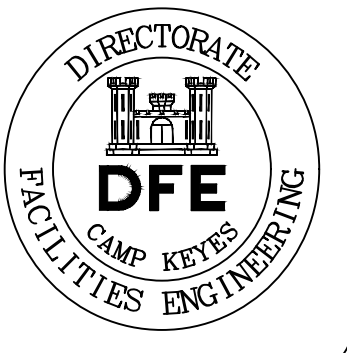

NOTES:

- 1. ALL PANEL DIRECTORIES SHOWN ARE FROM PANEL DIRECTORIES OBSERVED IN THE FIELD. ALL CIRCUITING MUST BE CONFIRMED IN THE FIELD DURING CONSTRUCTION.
2. PROVIDE SPACE COVERS IN ANY PANELS WHERE THE WORK PROVIDED RESULTS IN VACANT SPACES.

KEYED NOTES:

- (1) CIRCUIT BECOMES SPARE. SEE DEMO PLAN FOR EQUIPMENT TO BE REMOVED.
(2) REUSE EXISTING "SPARE" CIRCUIT BREAKER TO POWER NEW EQUIPMENT LISTED.

Table with columns: DIRECTORY, KVA LOAD (A, B, C), CKT #, BRK AMPS, PHASE, BRK AMPS, CKT #, KVA LOAD (A, B, C), DIRECTORY. Includes subtotals and panel info for P1.

Table with columns: DIRECTORY, KVA LOAD (A, B, C), CKT #, BRK AMPS, PHASE, BRK AMPS, CKT #, KVA LOAD (A, B, C), DIRECTORY. Includes subtotals and panel info for P2.

Table with columns: DIRECTORY, KVA LOAD (A, B, C), CKT #, BRK AMPS, PHASE, BRK AMPS, CKT #, KVA LOAD (A, B, C), DIRECTORY. Includes subtotals and panel info for PB.

Table with columns: DIRECTORY, KVA LOAD (A, B, C), CKT #, BRK AMPS, PHASE, BRK AMPS, CKT #, KVA LOAD (A, B, C), DIRECTORY. Includes subtotals and panel info for MP2.

Table with columns: DIRECTORY, KVA LOAD (A, B, C), CKT #, BRK AMPS, PHASE, BRK AMPS, CKT #, KVA LOAD (A, B, C), DIRECTORY. Includes subtotals and panel info for P3.

Table with columns: DIRECTORY, KVA LOAD (A, B, C), CKT #, BRK AMPS, PHASE, BRK AMPS, CKT #, KVA LOAD (A, B, C), DIRECTORY. Includes subtotals and panel info for PB1.



Table for PLAN REVISIONS with columns: Description, Date, Appr.

DESIGNED BY: TMD
DRAWN BY: JMD
CHECKED BY: TMD/JMAD
DATE: 12/28/2018
SCALE: AS NOTED
DPE PROJECT NO: 23SR18-458-D

CAMP KEYS REUTILIZATION PROJECT
CAMP KEYS, AUGUSTA, MAINE
BUILDING NO. 7 RENOVATIONS
ELECTRICAL PANEL SCHEDULES

- PLAN PROGRESS
[] DRAFT
[] 35% REVIEW
[] 65% REVIEW
[] 95% REVIEW
[] FINAL REVIEW
[] FOR BIDDING
[] ISSUED FOR CONSTRUCTION
[] RECORD DRAWINGS

SHEET ID: E-204
SHEET: 125 of 126

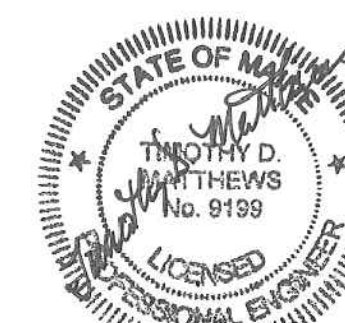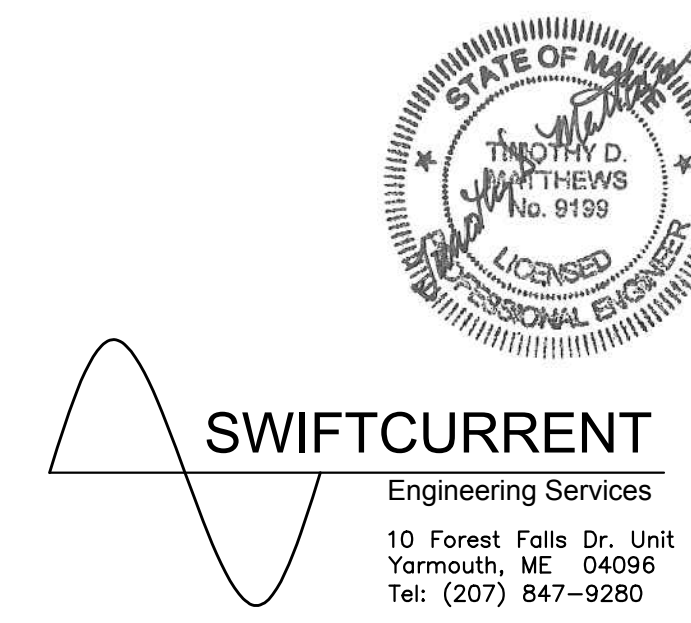


DIRECTORY	KVA LOAD			CKT #	BKR AMPS	PHASE	BKR AMPS	CKT #	KVA LOAD			DIRECTORY		
	A	B	C						A	B	C			
PANEL AH-2	*			1	100	A	40	2	*			9KW HEATERS UPSTAIRS		
		*		3		B		4		*				
			*	5		C		6			*			
VRV & BSU #7	*			7	15	A	15	8	*			VRV & BSU #8		
		*		9		B		10		*				
VRV & BSU #9			*	11	15	C	15	12			*	VRV & BSU #10		
	*			13		A		14	*					
VRV & BSU #11		*		15	15	B	15	16		*		VRV & BSU #12		
			*	17		C		18		*				
VRV & BSU #13	*			19	15	A	15	20	*			VRV & BSU #14		
		*		21		B		22		*				
VRV & BSU #15			*	23	15	C	15	24			*	VRV & BSU #16		
	*			25		A		26	*					
VRV & BSU #17		*		27	15	B	20	28		*		AHE-1		
			*	29		C		20	30		*		HEAT TAPE	
SPACE	*			31		A	20	32	*			DRINKING FOUNTAIN		
SPACE		*		33		B		34		*		SPACE		
SPACE			*	35		C		36		*		SPACE		
SPACE	*			37		A		38	*			SPACE		
SPACE		*		39		B		40	*			SPACE		
SPACE			*	41		C		42		*		SPACE		
SUBTOTAL	###	###	###					###	###	###		SUBTOTAL		
VOLTAGE: 208Y/120V PHASE: 3 POLES: 4			TOTAL KVA A-PHASE			###			PANEL			AH-1		
MAIN LUGS ONLY BUS AMPS: 200A			TOTAL KVA B-PHASE			###			LOCATION			ROOM 131		
MOUNTING: SURFACE			TOTAL KVA C-PHASE			###			TOTAL KVA			###		
SHORT CIRCUIT RATING: *KAIC			TOTAL KVA			###			NOTES: EXISTING SQUARE D PANEL BOARD, TYPE 1 ENCLOSURE, SERIES S01 Q0C42UF.					

DIRECTORY	KVA LOAD			CKT #	BKR AMPS	PHASE	BKR AMPS	CKT #	KVA LOAD			DIRECTORY		
	A	B	C						A	B	C			
VRV & BSU #1	*			1	15	A	15	2	*			VRV & BSU #18		
		*		3		B		4		*				
			*	5		C		6		*				
VRV & BSU #8	*			7	15	A	15	8	*			VRV & BSU #2		
		*		9		B		10		*				
VRV & BSU #5		*		11	15	C	15	12			*	VRV & BSU #4		
	*			13		A		14	*					
VRV & BSU #19		*		15	15	B	15	16		*		VRV & BSU #6		
	*			17		C		18		*				
VRV & BSU #21	*			19	15	A	15	20	*			VRV & BSU #20		
		*		21		B		22		*				
HEAT TAPE		*		23	20	C		24		*		8 KW HEATER		
HEAT TAPE	*			25	20	A		26	*					
SPACE		*		27		B		28		*		SPACE		
SPACE			*	29		C		30		*		SPACE		
SPACE	*			31		A		32	*			SPACE		
SPACE		*		33		B		34	*			SPACE		
SPACE			*	35		C		36		*		SPACE		
SPACE	*			37		A		38	*			SPACE		
SPACE		*		39		B		40	*			SPACE		
SPACE			*	41		C		42		*		SPACE		
SUBTOTAL	###	###	###					###	###	###		SUBTOTAL		
VOLTAGE: 208Y/120V PHASE: 3 POLES: 4			TOTAL KVA A-PHASE			###			PANEL			AH-2		
MAIN LUGS ONLY BUS AMPS: 200A			TOTAL KVA B-PHASE			###			LOCATION			ROOM 109		
MOUNTING: SURFACE			TOTAL KVA C-PHASE			###			TOTAL KVA			###		
SHORT CIRCUIT RATING: *KAIC			TOTAL KVA			###			NOTES: EXISTING SQUARE D PANEL BOARD, TYPE 1 ENCLOSURE, SERIES S01 Q0C42UF.					

NOTES:

- ALL PANEL DIRECTORIES SHOWN ARE FROM PANEL DIRECTORIES OBSERVED IN THE FIELD. ALL CIRCUITING MUST BE CONFIRMED IN THE FIELD DURING CONSTRUCTION.
- PROVIDE SPACE COVERS IN ANY PANELS WHERE THE WORK PROVIDED RESULTS IN VACANT SPACES.

KEYED NOTES:
 ① FURNISH NEW BREAKER IN EXISTING PANEL.

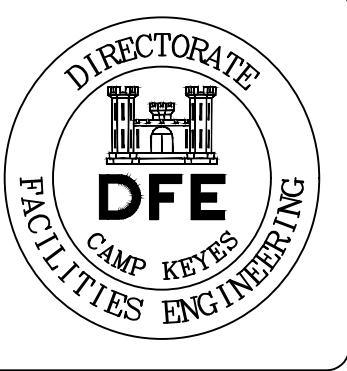

Rev#	Description	Date	Appr.
1	GENERAL REVISIONS	1.28.19	
	PLAN REVISIONS		


DESIGNED BY: TMD
 DRAWN BY: JMD
 CHECKED BY: TMD/JMD
 DATE: 12/28/2018
 SCALE: AS NOTED
 DFE PROJECT NO: 235F18-458-D

STATE OF MAINE
 DEPARTMENT OF DEFENSE, VETERANS
 AND EMERGENCY MANAGEMENT
 Cordja Capital Projects Group
 16 Tenney Lane, Suite 23
 Camden, Maine 04843
 207-236-9970 / mds@cordjagroup.com

CAMP KEYES REUTILIZATION PROJECT
 CAMP KEYES, AUGUSTA, MAINE
 BUILDING NO. 7 RENOVATIONS
 ELECTRICAL PANEL SCHEDULES

- PLAN PROGRESS
- DRAFT
 - 35% REVIEW
 - 65% REVIEW
 - 95% REVIEW
 - FINAL REVIEW
 - FOR BIDDING
 - ISSUED FOR CONSTRUCTION
 - RECORD DRAWINGS

SHEET ID:
 E-205
 SHEET: 126 of 126

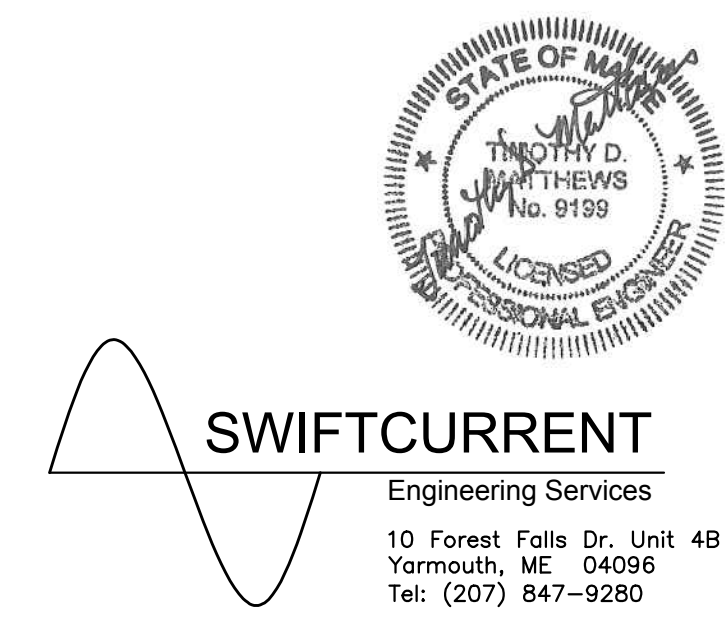

SWIFTCURRENT
 Engineering Services
 10 Forest Falls Dr. Unit 4B
 Yarmouth, ME 04096
 Tel: (207) 847-9280