


GENERAL NOTES

1. SEE SHEET G-108 FOR GENREAL NOTES.

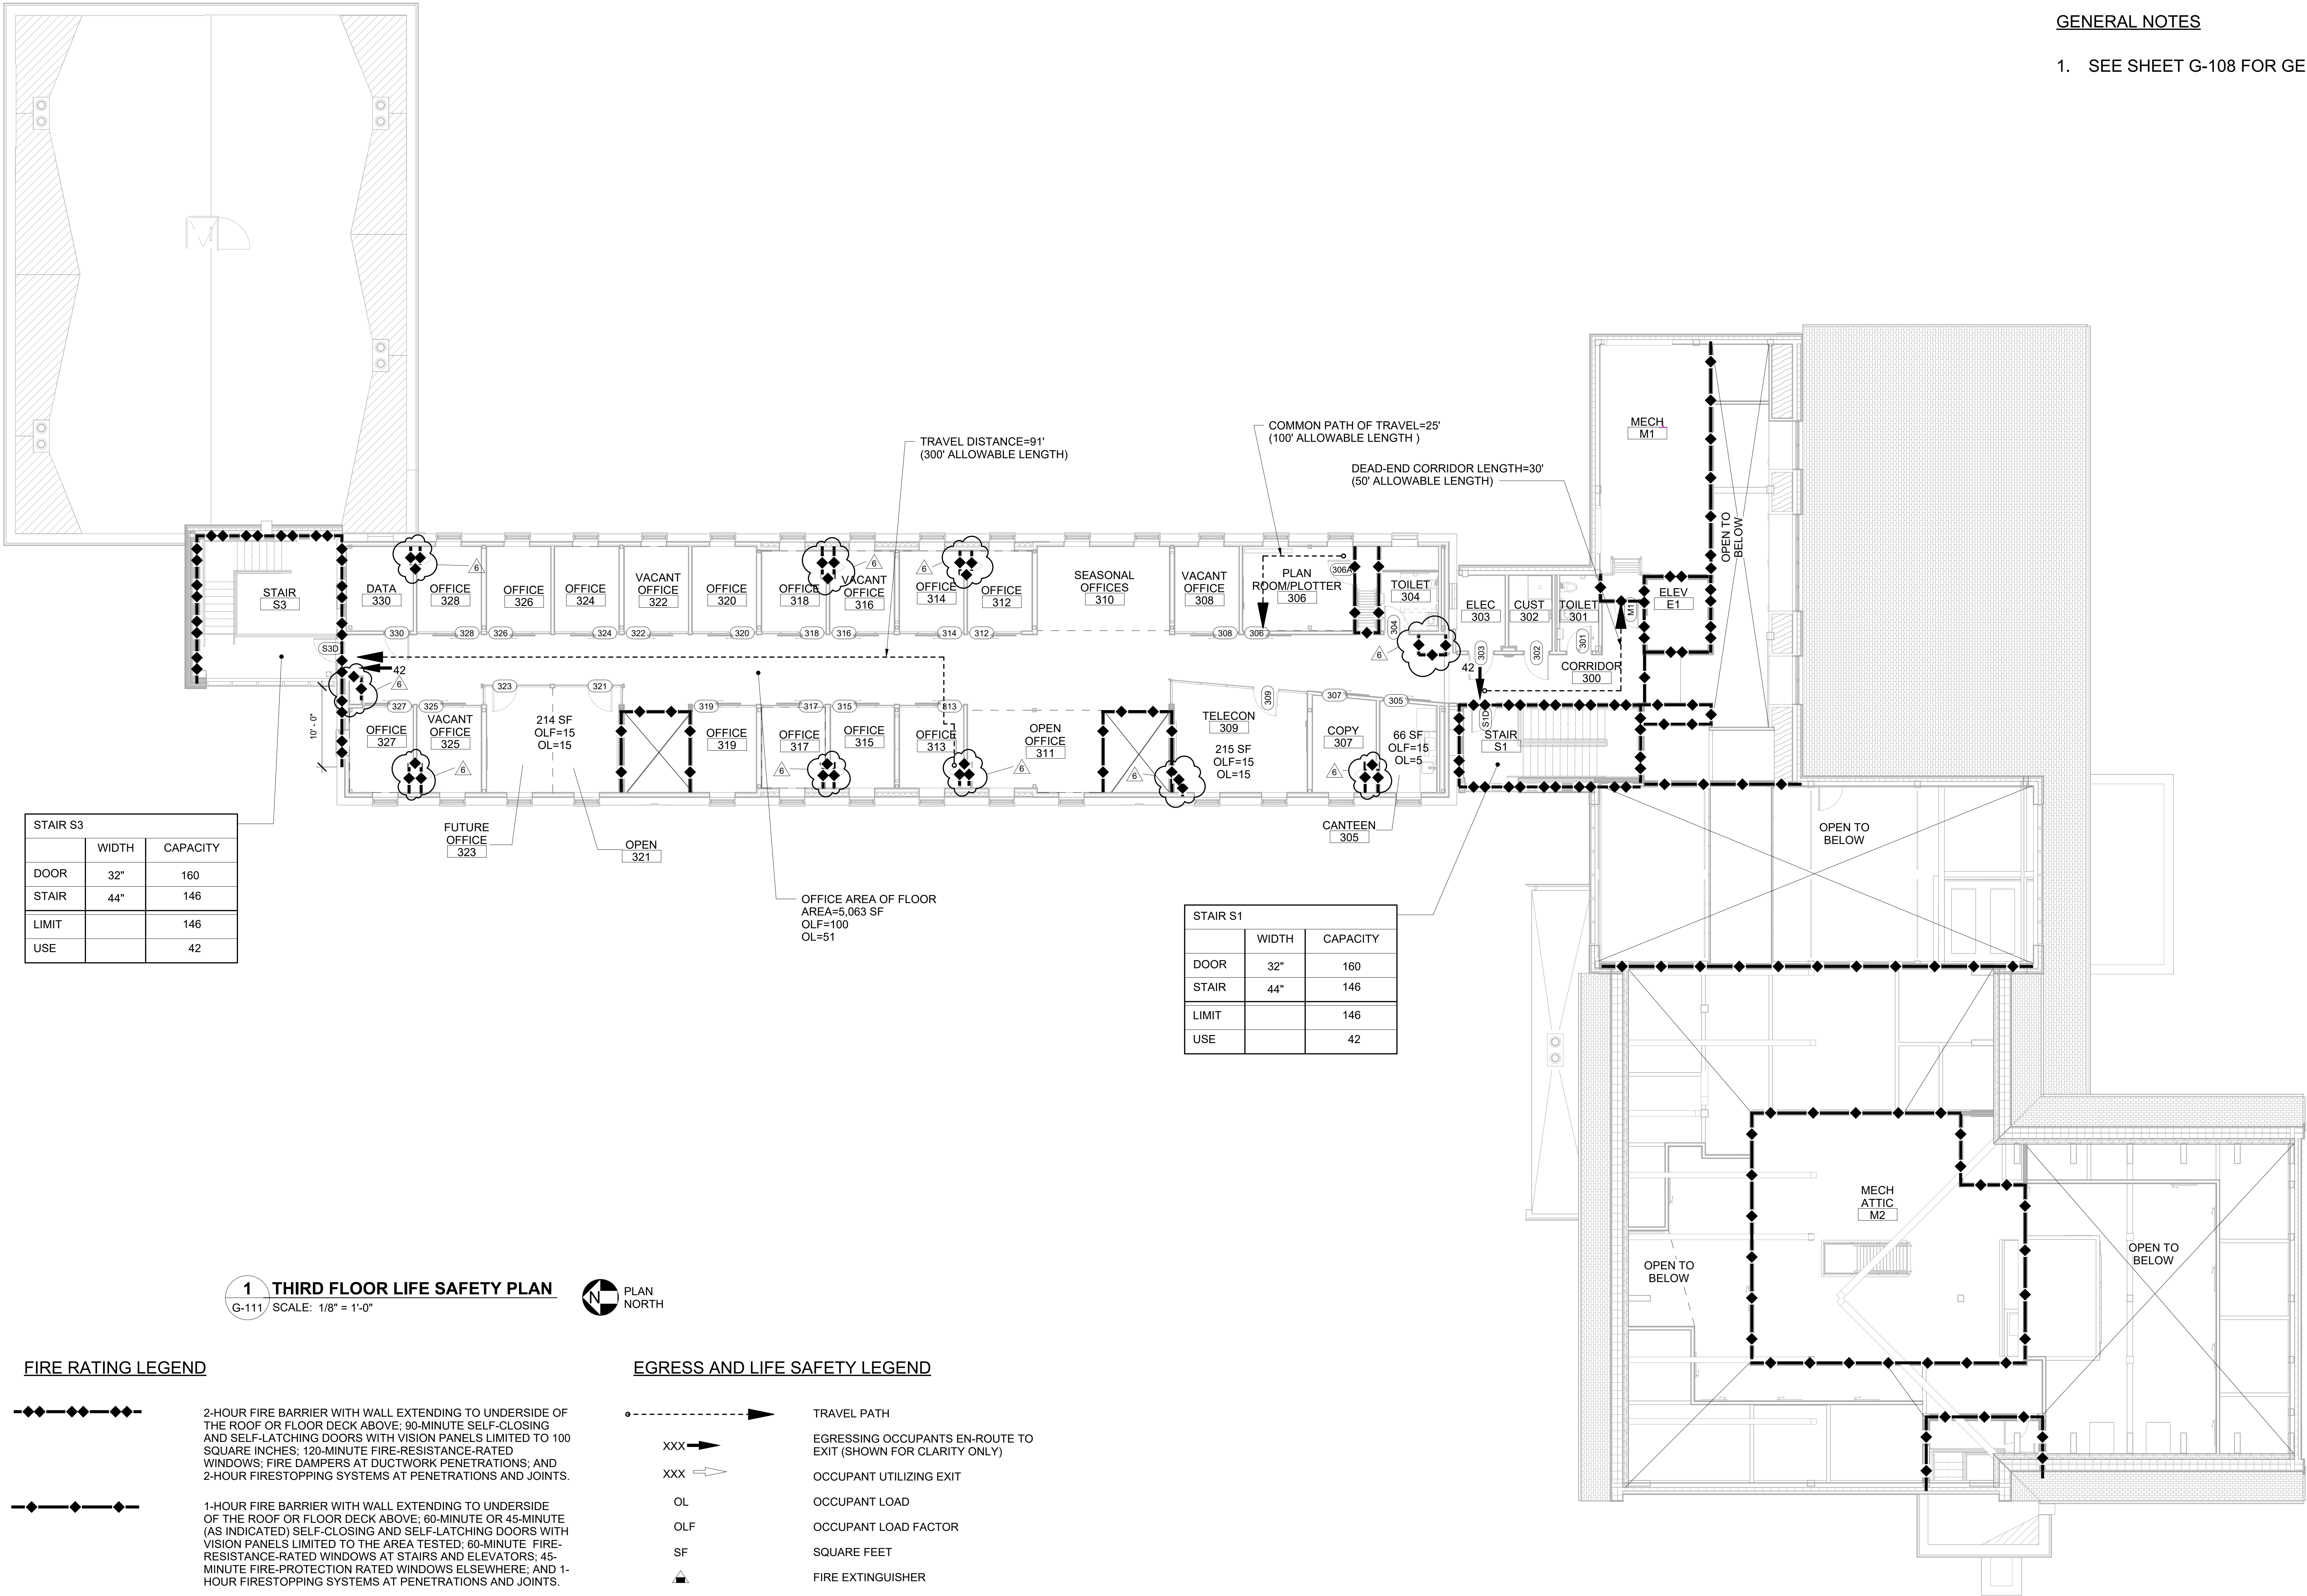

STAIR S3		
DOOR	WIDTH	CAPACITY
STAIR	32"	160
LIMIT		146
USE		42

STAIR S1		
DOOR	WIDTH	CAPACITY
STAIR	32"	160
LIMIT		146
USE		42

1 THIRD FLOOR LIFE SAFETY PLAN
G-111 SCALE: 1/8" = 1'-0"




FIRE RATING LEGEND



2-HOUR FIRE BARRIER WITH WALL EXTENDING TO UNDERSIDE OF THE ROOF OR FLOOR DECK ABOVE; 90-MINUTE SELF-CLOSING AND SELF-LATCHING DOORS WITH VISION PANELS LIMITED TO 100 SQUARE INCHES; 120-MINUTE FIRE-RESISTANCE-RATED WINDOWS; FIRE DAMPERS AT DUCTWORK PENETRATIONS; AND 2-HOUR FIRESTOPPING SYSTEMS AT PENETRATIONS AND JOINTS.




1-HOUR FIRE BARRIER WITH WALL EXTENDING TO UNDERSIDE OF THE ROOF OR FLOOR DECK ABOVE; 60-MINUTE OR 45-MINUTE (AS INDICATED) SELF-CLOSING AND SELF-LATCHING DOORS WITH VISION PANELS LIMITED TO THE AREA TESTED; 60-MINUTE FIRE-RESISTANCE-RATED WINDOWS AT STAIRS AND ELEVATORS; 45-MINUTE FIRE-PROTECTION RATED WINDOWS ELSEWHERE; AND 1-HOUR FIRESTOPPING SYSTEMS AT PENETRATIONS AND JOINTS.

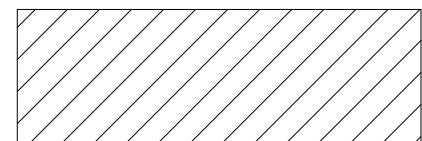


1-HOUR FLOOR/CEILING OR ROOF/CEILING ASSEMBLY ABOVE HATCHED AREA WITH 1-HOUR FIRESTOPPING SYSTEMS AT PENETRATIONS AND JOINTS.


EGRESS AND LIFE SAFETY LEGEND

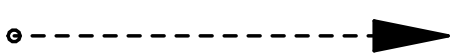


TRAVEL PATH

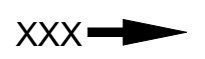


EGRESSING OCCUPANTS EN-ROUTE TO EXIT (SHOWN FOR CLARITY ONLY)

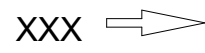

OCCUPANT UTILIZING EXIT

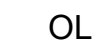

OCCUPANT LOAD

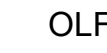

OCCUPANT LOAD FACTOR




SQUARE FEET



FIRE EXTINGUISHER

GRAPHIC SCALE

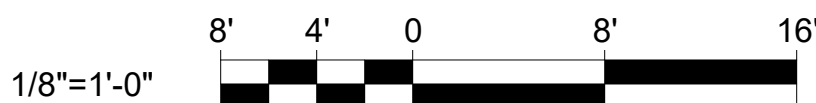

CHECK GRAPHIC SCALE BEFORE USING

6

03/13/2025

ADDENDUM NO.6

NO.

DATE

DESCRIPTION

BY

DATE

01/29/2025

REVISIONS

DESCRIPTION

TYLER

1-23-25

STATE OF MAINE

1-23-25

STATE OF MAINE

DRAWN BY:

CET

CHECK BY:

TGB

DEPARTMENT OF INLAND FISHERIES & WILDLIFE

NEW OFFICE HEADQUARTERS

AUGUSTA, ME

THIRD FLOOR LIFE SAFETY PLAN

OAK POINT ASSOCIATES

231 Main Street, Biddeford, Maine 04005

207.283.9193

DRAWING NO.

G-111

SHEET NO.

14 OF 239

STRUCTURAL NOTES

CONCRETE

- CONFORM WITH ACI 117, ACI 201, ACI 211.1, ACI 301, ACI 302.1R, ACI 305R, ACI 306.1, ACI 308.1, ACI 309R, ACI 315, ACI 318, ACI 330 AND ACI 347R.
- CONCRETE EXPOSED TO WEATHER: NORMAL WEIGHT, F'c=5000 PSI WITH A MAXIMUM WATER/CEMENT RATIO=0.40.
CONCRETE FOR FOOTINGS: NORMAL WEIGHT, F'c=3000 PSI WITH A MAXIMUM WATER/CEMENT RATIO=0.50.
CONCRETE FOR FOUNDATION WALLS AND PIERS: NORMAL WEIGHT, F'c=5000 PSI WITH A MAXIMUM WATER/CEMENT RATIO=0.40.
CONCRETE FOR SLABS-ON-GROUND, PILE CAPS, AND GRADE BEAMS: NORMAL WEIGHT, F'c=4000 PSI WITH A MAXIMUM WATER/CEMENT RATIO=0.45.
CONCRETE FOR TOPPING SLABS: LIGHTWEIGHT, F'c=4000 PSI WITH A MAXIMUM WATER/CEMENT RATIO=0.50.
- COMPACT THE STRUCTURAL FILL BENEATH ISOLATED AND SPREAD FOOTINGS WITH A VIBRATING PLATE COMPACTOR AND PRIOR TO CONCRETE REINFORCEMENT PLACEMENT.
- DEFORMED REINFORCING BARS: ASTM A615/A615M (GRADE 60).
- SOUTH ADDITION PIER REINFORCING: ASTM A615/A615M (GRADE 75).
- WELDED WIRE FABRIC: ASTM A185 (EPOXY COATED AS INDICATED).
- LAP SPLICE CONCRETE REINFORCEMENT IN ACCORDANCE WITH ACI 301/ACI 318. LAP BARS AS INDICATED IN THE LAP SPLICE SCHEDULE ON SHEET S-001. WELDING OF STEEL REINFORCEMENT IS NOT PERMITTED.
- MINIMUM REINFORCING STEEL COVER: FOOTINGS 3", WALLS AND PIERS 2", ELEVATED SLABS 3/4", UNLESS INDICATED OTHERWISE.
- SUPPORT STEEL REINFORCEMENT AND WELDED WIRE FABRIC BY APPROVED MATERIALS.
- CURE ELEVATED SLABS BY MOIST CURING ONLY.
- CURE CONCRETE AS SPECIFIED. CONCRETE NOT CURED WILL NOT BE ACCEPTED.
- NONSHRINK GROUT: ASTM C1107, NONMETALLIC.
- EPOXY GROUT: ASTM C881, TYPE IV OR V.
- EPOXY ADHESIVE: ASTM C881.
- CONCRETE SLAB FINISH:

FLOOR FLATNESS AND LEVELNESS				
SLAB LOCATION	OVERALL VALUE		MIN LOCAL VALUE	
	F ₁	F ₂	F ₃	F ₄
SLAB ON GRADE	35	25	24	17

- PERFORM FLATNESS/LEVELNESS TESTS WITHIN 48 HOURS OF CONCRETE PLACEMENT. SUBMIT TEST RESULTS TO THE STRUCTURAL ENGINEER OF RECORD AND OWNER WITHIN 24 HOURS OF TEST COMPLETION.
- INTERIOR SLABS-ON-GRADE: PROVIDE CONCRETE SLAB PROTECTION (BEYOND THE 7-DAY CURING PERIOD) UNTIL THE BUILDING ENVELOPE COMPLETELY ENCLOSSES AND PROTECTS THE SLAB FROM WIND, SUN AND PRECIPITATION.
- TAPE AND SEAL JOINTS IN VAPOR RETARDER AT EDGES AND UTILITY PENETRATIONS. SEAL VAPOR RETARDER TO CONCRETE AT EDGES.
- SECURE ANCHOR RODS IN PLACE PRIOR TO PLACING CONCRETE. INCORRECTLY LOCATED OR OUT-OF-PLUMB ANCHORS MUST BE REPLACED AT NO COST TO THE OWNER. REPLACEMENT METHODS MUST BE AS DIRECTED BY THE OWNER.
- COORDINATE FOUNDATION WORK WITH SOIL AND SOIL EXPLORATION NOTES ON SHEET C-001.
- COORDINATE SLAB FINISH REQUIRED FOR FLOORING TESTING AND INSTALLATION WITH FLOORING MANUFACTURER.
- SLEEVES: AT SLEEVES LESS THAN 12" DIAMETER, NO ADDITIONAL REINFORCING REQUIRED. AT SLEEVES GREATER THAN 12", PROVIDE (2) #5'S HORIZONTAL OVER OPENING, EXTEND 1'-0" PAST OPENING ON EACH SIDE. BOND OUTS: AT RECTANGULAR BOND OUTS UP TO 9'-0" WIDE, PROVIDE (2) #5'S HORIZONTAL OVER OPENING, EXTEND 1'-0" PAST OPENING ON EACH SIDE AND (2) #5'S, 1'-0" LONG, CORNER BARS AT A 45 DEGREE ANGLE AT EACH CORNER OF BOND OUT ON EACH FACE OF FOUNDATION WALL.

STRUCTURAL STEEL

- CONFORM WITH THE AMERICAN INSTITUTE OF STEEL CONSTRUCTION'S "MANUAL OF STEEL CONSTRUCTION FIFTEENTH EDITION".
- STEEL FOR ROLLED SECTIONS: ASTM A992/A992M (Fy=50 KSI).
STEEL FOR CONNECTIONS, ANGLES AND PLATES: ASTM A36 (Fy=36 KSI).
STEEL FOR COLUMN BASE PLATES: ASTM A572/A572M (Fy=50 KSI).
RECTANGULAR HOLLOW STRUCTURAL SECTIONS: ASTM A500, GRADE C, (Fy=50 KSI).
ROUND HOLLOW STRUCTURAL SECTIONS: ASTM A500, GRADE C, (Fy=46 KSI).
- ANCHOR RODS: ASTM F1554, GRADE 55 (Fy=55 KSI).
NUTS: ASTM A563, GRADE A.
WASHERS: ASTM F436, TYPE 1.
- STRUCTURAL BOLTS: ASTM A325/A325M N, TYPE 1 OR ASTM F1852, TYPE 1, TENSION CONTROL.
WASHERS: ASTM F436M.
NUTS: ASTM A563M.
- WELDING: AWS D1.1 AND AWS D1.3, E70 ELECTRODE.
- GRIND EXPOSED WELDS SMOOTH.
- LATERAL FORCE RESISTING COLLECTOR CONNECTIONS ARE AS INDICATED.
- BEAM TO BEAM AND BEAM TO COLUMN CONNECTIONS ARE AS INDICATED. ALTERNATE CONNECTIONS THAT HAVE EQUAL OR GREATER STRENGTH ARE PERMITTED PROVIDED CALCULATIONS PREPARED AND SIGNED AND SEALED BY A LICENSED PROFESSIONAL ENINEER IN THE STATE OF MAINE ARE SUBMITTED FOR REVIEW.
- BRACING CONNECTIONS SCHEDULES AND DESIGN FORCES ARE INDICATED ON SHEET SF201. SUBMIT SHOP DRAWINGS AND DESIGN CALCULATIONS PREPARED BY A LICENSED PROFESSIONAL ENGINEER IN THE STATE OF MAINE.
- FULLY TENSION BOLTS. USE TENSION CONTROL BOLTS ONLY.
- COORDINATE TESTING AND INSPECTION OF FIELD-BOLTED CONNECTIONS ACCORDING TO RCSC'S LOAD AND RESISTANCE FACTOR DESIGN SPECIFICATION FOR STRUCTURAL JOINTS USING ASTM A325 OR A490 BOLTS.
- STONE VENEER LINTELS PER LINTEL SCHEDULE ON SHEET S-002. COORDINATE LOCATIONS AND SPANS WITH ARCHITECTURAL PLANS.

COLD-FORMED STEEL

- COLD-FORMED METAL FRAMING: GALVANIZED STEEL ASTM A653/A653M, GRADE 33 FOR TRACKS (Fy=33 KSI) G90 COATING.
GRADE 50 FOR STUDS: (Fy=50 KSI) G90 COATING.
- PNEUMATIC FASTENING OF COLD-FORMED FRAMING IS NOT PERMITTED.
- SECTION PROPERTIES FOR WALL STUDS, TRACKS, HEADERS, AND SOFFIT FRAMING MUST BE AS REQUIRED BY STRUCTURAL PERFORMANCE.
- DESIGN COLD-FORMED STEEL CONNECTIONS IN ACCORDANCE WITH THE LATEST REVISION OF AISI'S "DESIGN OF COLD-FORMED STEEL STRUCTURAL MEMBERS", FOR THE REACTIONS REQUIRED. DESIGN COLD-FORMED CURTAIN WALLS FOR THE COMPONENT AND CLADDING WIND PRESSURES INDICATED ON SHEET S-003.
- DESIGN COLD-FORMED STEEL MEMBERS TO SUPPORT SUNSHADES FOR DEAD LOAD, SNOW LOAD AND COMPONENT AND CLADDING WIND FORCES. WIND FORCES MAY ACT IN POSITIVE AND NEGATIVE DIRECTIONS.
- LIMIT MAXIMUM PERMITTED WIND LOAD DEFLECTION OF EXTERIOR WALLS TO L/360 AT METAL PANEL SYSTEM.
- EXTERIOR WALL DEFLECTION TRACK MUST ALLOW FOR 1-1/2" OF DEFLECTION AT ROOF LEVELS.
- PREPARE DESIGN CALCULATIONS AND SHOP DRAWINGS BY A LICENSED PROFESSIONAL ENGINEER IN THE STATE OF MAINE AND SUBMIT FOR REVIEW PRIOR TO CONSTRUCTION OF FRAMING.

MASONRY

- CONFORM TO ACI 530-11/ASCE 5-11/TMS 402-11.
- CONCRETE MASONRY UNITS: ASTM C90, TYPE 1, NORMAL WEIGHT.
MORTAR: ASTM C270.
GROUT: ASTM C476 FINE.
DEFORMED REINFORCEMENT: ASTM A615/A615M, GRADE 60.
- CONCRETE MASONRY ASSEMBLIES TO HAVE THE FOLLOWING STRENGTHS: MASONRY UNIT ASSEMBLY STRENGTH: Fm=3000 PSI.
CONCRETE MASONRY UNITS COMPRESSIVE STRENGTH: Fc=4500 PSI.
GROUT STRENGTH: Fg=3000 PSI.
- SUBMIT SPECIFIED PRE-CONSTRUCTION TESTS TO THE STRUCTURAL ENGINEER OF RECORD AND THE OWNER PRIOR TO STARTING MASONRY CONSTRUCTION. DO NOT CONSTRUCT MASONRY WITHOUT THE REQUIRED PRE-CONSTRUCTION TESTING BEING PERFORMED. MASONRY CONSTRUCTED WITHOUT THE REQUIRED PRE-CONSTRUCTION TESTING WILL NOT BE ACCEPTED.
- COORDINATE DAILY MASONRY INSPECTIONS AS SPECIFIED. MASONRY CONSTRUCTED WITHOUT THE COMPLETION OF DAILY MASONRY INSPECTIONS WILL NOT BE ACCEPTED AND WILL BE REMOVED AND REPLACED AT NO ADDITIONAL COST TO THE OWNER.
- REINFORCE CONCRETE MASONRY WALLS AND PARTITIONS AS INDICATED WITH REINFORCED CELLS GROUTED SOLID AND GROUT REMAINING EMPTY CELLS SOLID, UNLESS NOTED OTHERWISE.
- DO NO MAKE HOLES OR PENETRATIONS THROUGH CMU BOND BEAMS.
- LAP SPLICE REINFORCING AS INDICATED ON FOUNDATION DETAILS AND MASONRY WALL ELEVATION SHEETS.

POST INSTALLED ANCHORS

- INSTALL POST INSTALLED ANCHORS IN ACCORDANCE WITH THE MANUFACTURER'S PRINTED INSTRUCTIONS. BASIS OF DESIGN ARE HILTI PRODUCTS. ALTERNATE PRODUCTS ARE ACCEPTABLE PROVIDED THEY HAVE EQUAL OR GREATER CAPACITIES. SUBMIT FOR REVIEW PRIOR TO INSTALLATION.
- 5/8" DIAMETER ANCHORS/EXPANSION BOLTS MUST HAVE THE FOLLOWING MINIMUM ULTIMATE STRENGTH:
 - SHEAR = 14,725 LBS.
 - TENSION = 6,835 LBS.
- ADHESIVE ANCHORS: HILTI HY-200 A V36 ADHESIVE. RODS = 5/8" DIAMETER.

STRUCTURAL GLUED LAMINATED TIMBER

- PROVIDE STRUCTURAL GLUED LAMINATED TIMBER IN ACCORDANCE WITH ANSI A190.1, AITC 110 AND ANSI 117.
- PROTECT STRUCTURAL GLUED LAMINATED TIMBER IN ACCORDANCE WITH AITC 111. REMOVE AND REPLACE DAMAGED FRAMING.
- SPECIES AND GRADES:
VISUALLY GRADED SOUTHERN PINE (NO "WANE" PERMITTED) FOR ALL GLUED LAMINATED TIMBER.

BEAMS,PURLINS, AND BRACES:
BEAM STRESS CLASSIFICATION = 24F-1.8E
COMBINATION SYMBOL = SP/SP, 24V-8 BALANCED.
Fb = 2,400 PSI
Fv = 300 PSI
Ft = 1,150 PSI
Fc = 1,650 PSI
E = 1,800,000 PSI

COLUMNS:
COMBINATION SYMBOL = SOUTHERN PINE, 49.
Fb = 1,550 PSI
Fv = 300 PSI
Ft = 1,350 PSI
Fc = 2,100 PSI (4 OR MORE LAMINATIONS)
E = 1,700,000 PSI
- INTERIOR METAL PLATES AND CONNECTORS MUST BE SHOP PRIMED AND PAINTED. FASTENERS SHALL BE FIELD PRIMED AND PAINTED. COORDINATE WITH ARCHITECTURAL.
- EXTERIOR MEMBERS MUST BE TREATED WITH AN APPROVED PRESERVATIVE WHICH PROVIDES A NATURAL APPEARANCE. INTERIOR MEMBERS MUST BE TREATED AS INDICATED IN THE SPECIFICATIONS.
- EXTERIOR METAL PLATES AND CONNECTORS MUST BE HOT-DIP GALVANIZED WITH A G90 COATING. FASTENERS SHALL BE HOT-DIP GALVANIZED. FIELD PAINT METAL PLATES, CONNECTORS, AND FASTENERS.
- DESIGN BRACED FRAME CONNECTIONS FOR THE FORCES INDICATED ON SHEET SF204. SUBMIT SHOP DRAWINGS AND DESIGN CALCULATIONS PREPARED BY A LICENSED PROFESSIONAL ENGINEER IN THE STATE OF MAINE.
- SEE BRACED FRAME CONNECTION DESIGN CRITERIA ON SHEET SF204.
- BASIS OF DESIGN FOR GLU-LAM CONNECTION HARDWARE IS BASED ON SIMPSON STRONG-TIE AND MTC SOLUTIONS. ALTERNATE PRODUCTS WITH EQUAL OR GREATER CAPACITIES ARE ACCEPTABLE. SUBMIT ALTERNATE PRODUCTS FOR REVIEW. SEE SHEET SF601 FOR GLU-LAM CONNECTION SCHEDULES AND DETAILS.

STEEL DECK

- STEEL DECKS: AISI S303-3 AND STEEL DECK INSTITUTE "DESIGN MANUAL FOR COMPOSITE DECKS: FORM DECKS AND ROOF DECKS". DECK UNITS ASTM A653/A653 SQ, GRADE 40, COATING G90 FOR ASTM A653/A653M. FASTEN FLOOR DECK WITH 5/8" WELDS ON A 36/4 PATTERN WITH (6) #10 SCREWS PER SPAN (STITCH CONNECTION).

STEEL COMPOSITE DECK = NON-CELLULAR, GRADE 40.
MINIMUM DEPTH = 2" (MINIMUM DESIGN THICKNESS: 0.0598 IN (16 GAUGE))
MINIMUM SECTION MODULUS = Sx = 0.611 IN³
MINIMUM MOMENT OF INERTIA = Ix = 0.653 IN⁴
- PROVIDE CONCRETE POUR STOPS/CLOSURE ANGLES AT EDGES OF SLABS. SEE POUR STOP SCHEDULE ON THIS SHEET FOR POUR STOP SIZE AND MAXIMUM OVER HANG DISTANCE.

CROSS LAMINATED TIMBER


- PROVIDE CROSS LAMINATED TIMBER IN ACCORDANCE WITH ANSI/APA PRG 320-2012 ENTITLED STANDARD FOR PERFORMANCE RATED CROSS-LAMINATED TIMBER.
- CLT PANELS MUST NOT BE MODIFIED IN THE FIELD WITHOUT WRITTEN APPROVAL BY THE STRUCTURAL ENGINEER OF RECORD.
- CLT GRADE=E3
- PLY THICKNESS= 1 3/8 IN
- MAJOR STRENGTH DIRECTION ALLOWABLE STRESS:
Fb= 1,200 PSI
E1= 1,700,000 PSI
Ft= 600 PSI
Fc=1,400 PSI
Fv=110 PSI
Fs=35 PSI
- MINOR STRENGTH DIRECTION ALLOWABLE STRESS:
Fb= 350 PSI
E= 900,000 PSI
Ft= 150 PSI
Fc= 475 PSI
Fv= 110 PSI
Fs= 35 PSI

WOOD

- WOOD FRAMING AND FASTENERS TO BE IN ACCORDANCE WITH THE 2015 INTERNATIONAL BUILDING CODE AND THE AMERICAN FOREST AND PAPER ASSOCIATION NATIONAL DESIGN SPECIFICATION (2015)(AFPA NDS).
- EACH PIECE OF LUMBER MUST BE "S-DRY" AND BEAR THE GRADE STAMP OF A GRADING RULES AGENCY APPROVED BY THE PS-20 "AMERICAN SOFTWOOD LUMBER STANDARDS COMMITTEE".
- MINIMUM STRUCTURAL PROPERTIES OF WOOD FRAMING ARE AS FOLLOWS:
ROOF RAFTERS:
SPRUCE-PINE-FIR NO. 2 OR BETTER WITH MINIMUM DESIGN VALUES:
Fb=875 PSI, Fv=135 PSI, Ft=450 PSI, Fc₉₀ =1,150 PSI AND E=1,400,00 PSI.
SPECIALTY TIMBER HEADER:
WHITE OAK NO. 2 OR BETTER WITH MINIMUM DESIGN VALUES:
Fb=600 PSI, Fv=205 PSI, Ft=400 PSI, Fc₉₀ =400 PSI AND E=800,00 PSI.
- ROOF SHEATHING AT CETA BUILDING IS DESIGNED TO ACT AS A DIAPHRAGM.
- PROVIDE NAILING (OTHER THAN ROOF DIAPHRAGM) IN ACCORDANCE WITH TABLE 2304.9.1 OF THE 2015 INTERNATIONAL BUILDING CODE UNLESS NOTED OTHERWISE.
- CONNECTION HARDWARE TO HAVE MINIMUM ALLOWABLE CAPACITIES AS INDICATED. INSTALL IN ACCORDANCE WITH THE MANUFACTURER'S PRINTED INSTRUCTIONS. DESIGN BASED ON SIMPSON STRONG TIE PRODUCTS. ALTERNATE DESIGNS THAT MEET OR EXCEED THE REQUIRED DESIGN CAPACITIES ARE PERMITTED.
- BOLT HEADS AND NUTS BEARING ON WOOD TO HAVE STANDARD CUT WASHERS. DRILL BOLT HOLES 1/32-INCH IN DIAMETER LARGER THAN BOLT DIAMETER.
- BASIS OF DESIGN FOR CLT CONNECTION HARDWARE IS BASED ON SIMPSON STRONG-TIE PRODUCTS. ALTERNATE PRODUCTS WITH EQUAL OR GREATER CAPACITIES ARE ACCEPTABLE. SUBMIT ALTERNATE PRODUCTS FOR REVIEW.

MICROPILE NOTES

- LOCATION OF MICROPILES ARE INDICATED ON SHEET SB103.
- INCREASE MICROPILE DESIGN WALL THICKNESS BY 1/16-INCH TO ACCOUNT FOR CORROSION LOSS.
- DEPTH OF DRILLED MICROPILE TO BE DETERMINED BY PILE INSTALLATION SUBCONTRACTOR. MINIMUM EMBEDMENT INTO SOLID BEDROCK IS 5'-0".
- SUBMIT MICROPILE INSTALLATION PLAN AND DESIGN CALCULATIONS SIGNED AND SEALED BY A LICENSED PROFESSIONAL ENGINEER IN THE STATE OF MAINE FOR REVIEW PRIOR TO INSTALLATION OF PILES.
- MICROPILE CASING SHALL EXTEND AT LEAST 8" INTO THE PILE CAP WITH ADDITIONAL REINFORCING EMBEDMENT TO PROVIDE FULL BEARING CAPACITY AND NOMINAL TENSILE CAPACITY.
- PERFORM ONE ACCEPTABLE MICROPILE COMPRESSION LOAD TEST AND ONE TENSION LOAD TEST IN ACCORDANCE WITH ASTM D1143. DO NOT LOAD MICROPILES UNTIL THE CEMENT GROUT HAS ATTAINED ITS FULL DESIGN STRENGTH. PILE TEST LOCATION TO BE DETERMINED BY ENGINEER OF RECORD FOR THE DESIGN OF THE DRILLED PILE SYSTEM.
- PERFORM CONTINUOUS SPECIAL INSPECTIONS DURING PILE INSTALLATION OPERATIONS. REFER TO SPECIFICATION SECTION 01 45 35 FOR REQUIREMENTS. SUBMIT INSPECTION REPORTS TO THE OWNER WITHIN 48 HOURS OF COMPLETING INSPECTION.

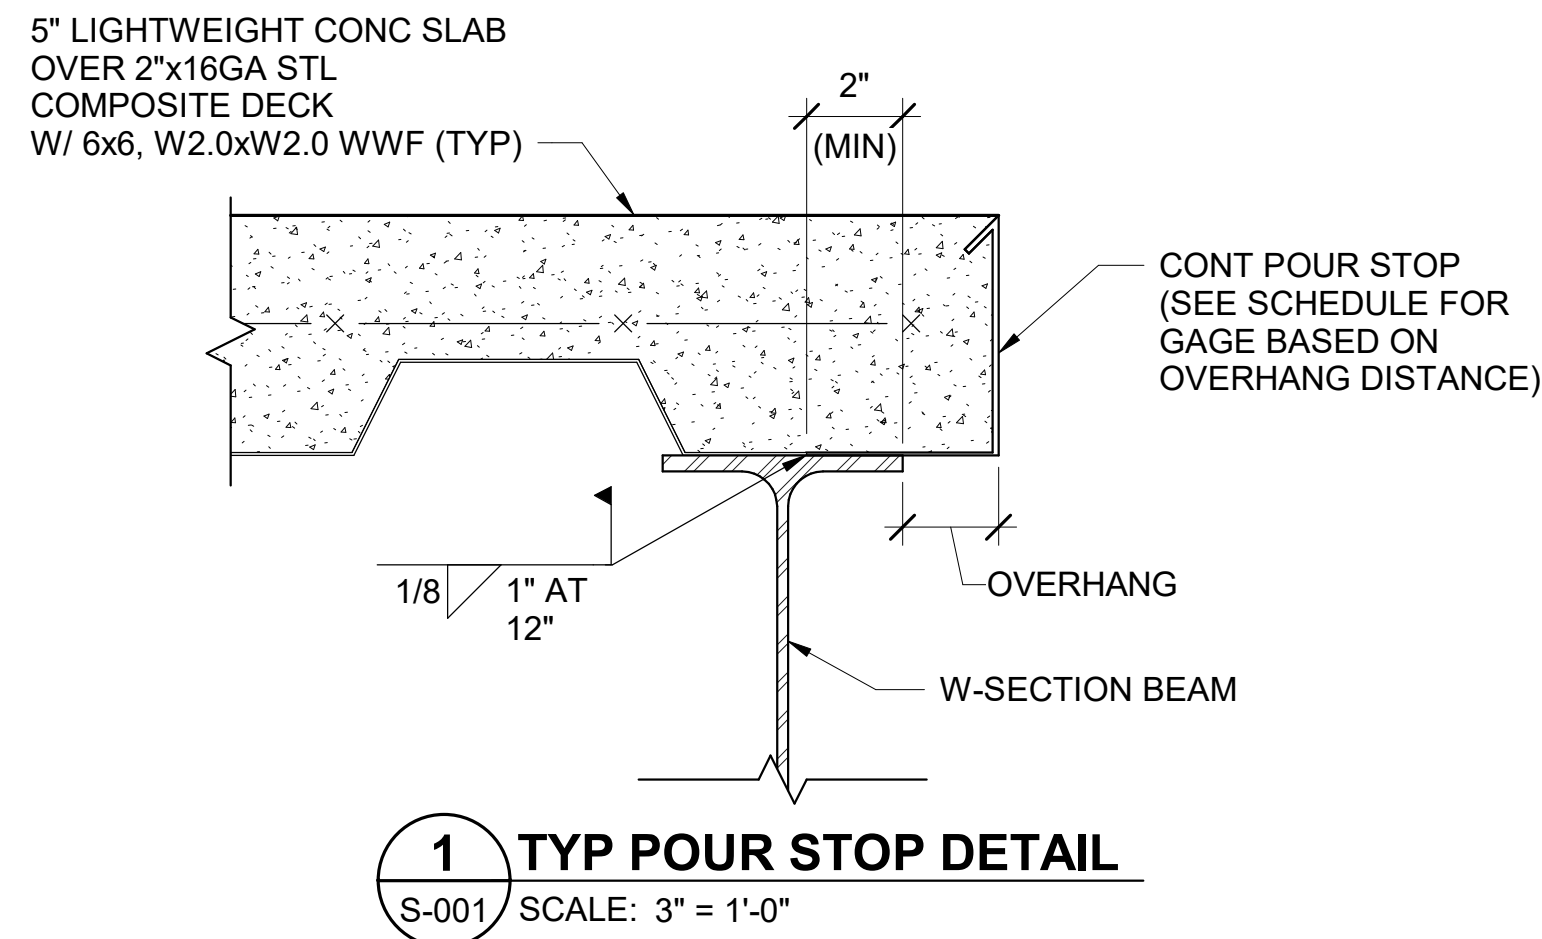

TEMPORARY SHORING/BRACING NOTES
FOR THE EXISTING BRICK MASONRY WALLS

- PROVIDE TEMPORARY SHORING/BRACING OF EXISTING PERIMETER UNREINFORCED MASONRY WALLS AND THE EXISTING PERIMETER BASEMENT FOUNDATION WALLS.
- SUBMIT TEMPORARY BRACING/SHORING PLANS AND DESIGN CALCULATIONS SIGNED AND SEALED BY THE LICENSED PROFESSIONAL ENGINEER RESPONSIBLE FOR THEIR PREPARATION PRIOR TO START OF WORK.
- TEMPORARY BRACING/SHORING MUST BE DESIGNED FOR THE FOLLOWING FORCES:
 - WIND PRESSURES ACTING PERPENDICULAR TO THE EXISTING EXTERIOR WALLS (WITH EXISTING FLOOR FRAMING REMOVED) FOR THE WIND VELOCITY, RISK CATEGORY AND EXPOSURE INDICATED ON SHEET S-002. INTERNAL WIND PRESSURES MUST INCLUDE MODIFICATIONS TO EXTERNAL WIND PRESSURE COEFFICIENT C DUE TO ANY OPENINGS IN ROOF STRUCTURE MADE FOR INSTALLATION OF FRAMING. REDUCTION FOR SHORT TERM LOADING PER ASCE 37 MAY BE APPLIED.
 - SEISMIC FORCES ACTING PERPENDICULAR TO THE WALLS FOR THE GROUND ACCELERATIONS AND SITE CLASS INDICATED ON SHEET S-002.
 - EXISTING FLOOR DEAD LOAD AND CONSTRUCTION LIVE LOADS THAT MAY ACT ON SHORING/BRACING SYSTEM.
- DESIGN MUST INCLUDE ALL ASSOCIATED CONNECTIONS TO THE EXISTING WALLS AND ASSOCIATED TEMPORARY FOUNDATIONS OR ANCHORAGE POINTS WITH THE EXISTING STRUCTURE.
- DESIGN MUST INCLUDE METHODS OF PATCHING/REPAIRING WALLS AT CONNECTIONS POINTS TO MATCH EXISTING AS APPROVED BY THE OWNER.
- PREPARATION OF SHORING/BRACING PLAN MUST INCLUDE COORDINATION WITH THE DEMOLITION OF EXISTING FLOOR FRAMING AS INDICATED ON SHEETS D-101, D-102, D-201, AND D-221.
- TEMPORARY BRACING/SHORING PLAN MUST INCLUDE THE SEQUENCE OF THE ERECTION OF TEMPORARY SHORING/BRACING AND SEQUENCE OF DEMOLITION OF EXISTING FLOOR FRAMING.
- INSTALLATION OF TEMPORARY SHORING/BRACING MUST BE COORDINATED WITH INSTALLATION OF FLOOR FRAMING INCLUDING CROSS LAMINATED TIMBER FLOORS/TOPPING SLABS AND ANCHORAGE TO PERIMETER UN-REINFORCED MASONRY.
- CROSS LAMINATED TIMBER FLOORS/TOPPING SLABS AND ASSOCIATED ANCHORAGE TO PERIMETER UN-REINFORCED MASONRY WALLS WILL PROVIDE PERMANENT BRACING OF THE WALLS.
- DEMOLITION OF EXISTING FRAMING MUST NOT START UNTIL TEMPORARY SHORING/BRACING PLAN HAS BEEN REVIEWED AND APPROVED BY THE OWNER.
- DEMOLITION OF EXISTING FRAMING MUST NOT START UNTIL TEMPORARY SHORING/BRACING INSTALLATION HAS BEEN REVIEWED AND APPROVED BY THE BRACING/SHORING ENGINEER OF RECORD.
- TEMPORARY SHORING/BRACING MUST REMAIN IN PLACE UNTIL PERMANENT WALL BRACING IS IN PLACE AS APPROVED BY THE BRACING/SHORING ENGINEER OF RECORD AND OWNER.

GENERAL NOTES

- PROVIDE TEMPORARY SUPPORT OF FRAMING DURING CONSTRUCTION TO PREVENT FAILURE AND DAMAGE.
- COORDINATE THE LOCATION OF CONCRETE AND STEEL MEMBERS WITH ARCHITECTURAL, CIVIL, MECHANICAL, PLUMBING, FIRE PROTECTION, SECURITY, COMMUNICATIONS, AND ELECTRICAL PLANS AND DETAILS.
- COORDINATE THE REQUIRED TESTS AND INSPECTIONS THAT ARE TO BE COMPLETED AND SUBMITTED PRIOR TO ACCEPTANCE OF COMPLETED WORK. MATERIAL PLACED WITHOUT THE REQUIRED QUALITY CONTROL TESTS OR REQUIRED INSPECTIONS BEING PERFORMED WILL NOT BE ACCEPTED. TESTS AND INSPECTIONS PERFORMED BY OWNER'S INSPECTION/TESTING AGENCY.
- CONSTRUCTION IS SUBJECT TO SPECIAL INSPECTIONS IN ACCORDANCE WITH CHAPTER 17 OF IBC 2015. NOTIFY THE OWNER OF IDENTIFIED DEFICIENCIES. NOTIFY THE OWNER AFTER DEFICIENCIES HAVE BEEN CORRECTED.
- NO DEVIATIONS FROM CONTRACT DRAWINGS ARE PERMITTED.
- REFER TO CIVIL DRAWINGS REGARDING INFORMATION AND LIMITATIONS PERTINENT TO SITE SUBSURFACE SOIL CONDITIONS.

REINFORCED CONCRETE
REINFORCING STEEL
LAP SPLICE SCHEDULE

BAR SIZE	MINIMUM LAP LENGTH
#4	2'-5"
#5	3'-0"
#6	3'-0"
#7	3'-9"
#8	4'-6"
#9	5'-1"

NOTES:
1. LAP SPLICE LENGTH MUST BE AS SHOWN ABOVE UNLESS NOTED OTHERWISE.

2. INCREASE SPLICE LENGTH BY 1.3 FACTOR FOR HORIZONTAL REINFORCEMENT WITH MORE THAN 12" OF FRESH CONCRETE CAST BELOW.

POUR STOP
SCHEDULE

OVERHANG (IN)	GAGE
0-1	20
2-3	18
4-5	16
6-7	14
8-9	12
10-11	10

NOTES:
1. SEE DETAIL 1/S-001.

GRAPHIC SCALE



CHECK GRAPHIC SCALE BEFORE USING

REVISIONS				DATE	
3	03/13/2025	ADDENDUM NO. 6	DNM	DRAWN BY: MJC	
2	03/06/2025	ADDENDUM NO. 5	DNM	CHECK BY: DNM	
1	02/28/2025	ADDENDUM NO. 3	DNM		
NO.	DATE	DESCRIPTION	BY	NO.	
				01/29/2025	

STATE OF MAINE DAVID N. MARTIN No. 9622 REGISTERED PROFESSIONAL ENGINEER		DEPARTMENT OF INLAND FISHERIES & WILDLIFE	
TITLE: NEW OFFICE HEADQUARTERS		OAK POINT ASSOCIATES	
LOCATION: AUGUSTA, ME		DRAWING NO: S-001	
TITLE THIS DWG: STRUCTURAL NOTES		SHEET NO:	
ARCHITECTURE • ENGINEERING • PLANNING		231 Main Street, Biddeford, Maine 04005	
		207.283.9193	

STRUCTURAL ABBREVIATIONS:

±	PLUS OR MINUS
∠, L	ANGLE
ACI	AMERICAN CONCRETE INSTITUTE
AESS	ARCHITECTURAL EXPOSED STRUCTURAL STEEL
AFF	ABOVE FINISH FLOOR
AISI	AMERICAN IRON AND STEEL INSTITUTE
AITC	AMERICAN INSTITUTE OF TIMBER CONSTRUCTION
ALT	ALTERNATE
APA	AMERICAN PLYWOOD ASSOCIATION
ARCH	ARCHITECTURAL
ASCE	AMERICAN SOCIETY OF CIVIL ENGINEERS
ASTM	AMERICAN SOCIETY FOR TESTING AND MATERIALS
AWS	AMERICAN WELDING SOCIETY
BGBE	BOTTOM OF GRADE BEAM ELEVATION
BF	BRACED FRAME
BFE	BOTTOM OF FOOTING ELEVATION
BLOG	BUILDING
BME	BOTTOM OF MAT ELEVATION
BP	BASE PLATE
BPCE	BOTTOM OF PILE CAP ELEVATION
BSE	BRICK/BLOCK SHELF ELEVATION
CF	COMBINED FOOTING
CJ	CONTROL JOINT
CL	CENTERLINE
CLG	CEILING
CLT	CROSS LAMINATED TIMBER
CMU	CONCRETE MASONRY UNIT
COL	COLUMN
CONC	CONCRETE
CONN	CONNECTION
CONT	CONTINUOUS
DIA	DIAMETER
DWG	DRAWING
E	MODULUS OF ELASTICITY
EA	EACH
EJ	EXPANSION JOINT
ELEC	ELECTRICAL
ELEV	ELEVATION
EOD	EDGE OF DECK
EOS	EDGE OF SLAB
EQ	EQUAL
EQUIP	EQUIPMENT
EXIST	EXISTING
EXT	EXTERIOR
F _c	CONCRETE COMPRESSIVE STRENGTH
F _m	MASONRY COMPRESSIVE STRENGTH
FND	FOUNDATION
FTG	FOOTING
F _y	YIELD STRESS
GA	GAUGE
GALV	GALVANIZED
GYP BD	GYP SUM BOARD
HGT	HEIGHT
HORIZ	HORIZONTAL
HSS	HOLLOW STRUCTURAL SECTION
IBC	INTERNATIONAL BUILDING CODE
IN	INCH
INSUL	INSULATION
INV	INVERT
K	KIPS
KSI	KIPS PER SQUARE INCH
LBS	POUNDS
MAX	MAXIMUM
MECH	MECHANICAL
MF	MOMENT FRAME
MFR	MANUFACTURER
MIN	MINIMUM
MO	MASONRY OPENING
MPH	MILES PER HOUR
MTL	METAL
NA	NOT APPLICABLE
#, NO	NUMBER
OC	ON CENTER
OPNG	OPENING
PCF	POUNDS PER CUBIC FOOT
PSF	POUNDS PER SQUARE FOOT
PSI	POUNDS PER SQUARE INCH
RCSC	RESEARCH COUNCIL ON STRUCTURAL CONNECTIONS
REINF	REINFORCED
REQ'D	REQUIRED
SAT	SUSPENDED ACOUSTICAL TILE
SIM	SIMILAR
STL	STEEL
TMS	THE MASONRY SOCIETY
TOS	TOP OF STEEL
TPE	TOP OF PIER ELEVATION
TSE	TOP OF SHELF ELEVATION
TWE	TOP OF WALL ELEVATION
TYP	TYPICAL
VERT	VERTICAL
W/	WITH
WP	WORKING POINT
WWF	WELDED WIRE FABRIC

BUILDING DESIGN LOADS (EXISTING BUILDING)

ROOF SNOW LOAD (ROOF LIVE LOAD) ASCE 7-10/IBC 2015
GROUND SNOW LOAD (Pg) = 70 PSF
SNOW EXPOSURE FACTOR (Ce) = 1.0
SNOW LOAD ROOF SLOPE FACTOR (Cs) = 1.0
SNOW LOAD THERMAL FACTOR (Ci) = 1.1
SNOW LOAD IMPORTANCE FACTOR (I) = 1.0
BALANCED ROOF SNOW LOAD (Pf) = 56 PSF
SNOW DRIFTING (Pd) = VARIES, SEE SHEET S-005

ROOF DEAD LOAD = 18 PSF
FLOOR DEAD LOAD = 58 PSF

FLOOR LIVE LOADS:
OFFICE = 50 PSF + 15 PSF (PARTITIONS)
FIRST FLOOR CORRIDOR = 100 PSF
SECOND FLOOR CORRIDOR = 80 PSF

ESTIMATED EXISTING ELEVATED FLOOR SLAB DEAD LOAD = 35 PSF
ESTIMATED EXISTING ELEVATED FLOOR SLAB LIVE LOAD CAPACITY = 20 PSF

WIND LOAD ASCE 7-10/IBC 2015
BASIC WIND SPEED V_{ULT} = 109 MPH
BASIC WIND SPEED V_{ASD} = 85 MPH
WIND RISK CATEGORY = II
WIND EXPOSURE = EXPOSURE C
BUILDING TYPE = "ENCLOSED"
WIND DESIGN PRESSURE:
MAIN WIND FORCE RESISTING SYSTEM = 30 PSF (MAXIMUM PRESSURE)

SEISMIC DESIGN DATA ASCE 7-10/IBC 2015
SHORT PERIOD SPECTRAL RESPONSE ACCELERATION (S_s) = 0.317
ONE SECOND SPECTRAL RESPONSE ACCELERATION (S₁) = 0.078
OCCUPANCY CATEGORY = II
SEISMIC DESIGN CATEGORY = B
SEISMIC IMPORTANCE FACTOR = 1.00
SITE CLASS = D
TOTAL BASE SHEAR = 217 KIPS

BASIC STRUCTURAL SYSTEM
INTERMEDIATE REINFORCED CONCRETE MASONRY SHEAR WALLS
RESPONSE MODIFICATION COEFFICIENT (R) = 3.50
DEFLECTION AMPLIFICATION FACTOR (Cd) = 2.25
SYSTEM OVER STRENGTH FACTOR (φ) = 2.50
STEEL BRACED FRAMES (NOT DETAILED)
RESPONSE MODIFICATION COEFFICIENT (R) = 3.00
DEFLECTION AMPLIFICATION FACTOR (Cd) = 3.00
SYSTEM OVER STRENGTH FACTOR (φ) = 3.00

ANALYSIS PROCEDURE = EQUIVALENT LATERAL FORCE PROCEDURE
DESIGN SOIL BEARING PRESSURE = 1,500 PSF

MECHANICAL EQUIPMENT MAXIMUM WEIGHTS USED IN DESIGN:
MAXIMUM MECHANICAL UNIT DEAD LOAD MUST NOT EXCEED 50 POUNDS PER SQUARE FOOT (PSF).

- NOTES:
- SEISMIC LOAD RESISTING SYSTEM CONSISTS OF THE FOLLOWING:
 - VERTICAL ELEMENTS - REINFORCED CONCRETE MASONRY SHEAR WALLS AND STEEL BRACED FRAMES (NOT DETAILED).
 - HORIZONTAL ELEMENTS - COMPOSITE STEEL DECK AND CONCRETE SLAB DIAPHRAGMS.
 - COLLECTOR ELEMENTS - BEAMS WHERE INDICATED.

EXCAVATION BRACING/SHORING NOTES

- PROVIDE EXCAVATION BRACING/SHORING DESIGN AND EXCAVATION PLAN REQUIRED FOR THE INSTALLATION OF FOUNDATIONS ON SHEETS SB102 AND SB104 THAT ARE ADJACENT, AND HAVE BOTTOM OF FOOTING ELEVATIONS LOWER THAN ADJACENT EXISTING FOOTINGS. TEMPORARY BRACING/SHORING MUST BE DESIGNED TO PREVENT DAMAGE TO ADJACENT EXISTING STRUCTURE AND TO PREVENT UNDERMINING OF EXISTING FOUNDATIONS. IDENTIFY ANY BRACING/SHORING ELEMENTS THAT ARE TO REMAIN IN PLACE, IF REQUIRED.
- BRACING/SHORING DESIGN MUST, AS A MINIMUM, INCLUDE THE FOLLOWING:
 - CALCULATION OF LATERAL SOIL PRESSURES USED FOR DESIGN.
 - CALCULATION OF IMPOSED CONSTRUCTION DEAD AND LIVE LOADS.
 - DESIGN OF BRACING/SHORING MEMBERS AND ASSOCIATED CONNECTIONS.
- EXCAVATION PLAN, AS A MINIMUM, MUST INCLUDE THE FOLLOWING:
 - PRE-CONSTRUCTION SURVEY OF EXISTING BUILDING FOUNDATION WALLS THAT MUST INCLUDE ELEVATIONS OF TOPS OF EXISTING FOUNDATION WALLS, DOCUMENTATION OF ANY EXISTING CRACKS OR OTHER DISTRESS IN THE EXISTING FOUNDATIONS AND SUPPORTED STRUCTURE. DOCUMENTATION MUST INCLUDED MEASURED ELEVATIONS AND LOCATIONS OF ANY EXISTING CRACKS OR DISTRESS. PHOTOGRAPHIC DOCUMENTATION MUST BE PROVIDED FOR ALL OBSERVED EXISTING CRACKS OR DISTRESS.
 - SEQUENCE OF THE INSTALLATION OF EXCAVATION BRACING/SHORING SYSTEM. INSTALLATION OF EXCAVATION BRACING AND SHORING MUST BE INSPECTED BY THE LICENSED PROFESSIONAL ENGINEER RESPONSIBLE FOR THE DESIGN PRIOR TO COMMENCING EXCAVATION FOR CONSTRUCTION OF FOUNDATIONS.
 - METHODS USED TO MONITOR BUILDING SETTLEMENT/MOVEMENT DURING INSTALLATION OF EXCAVATION BRACING/SHORING SYSTEM AS WELL AS DURING CONSTRUCTION OF ADJACENT FOUNDATIONS.
 - POST-CONSTRUCTION SURVEY OF EXISTING FOUNDATION WALLS THAT MUST INCLUDE ELEVATIONS OF TOPS OF EXISTING FOUNDATION WALLS, DOCUMENTATION OF ANY CRACKS OR OTHER DISTRESS IN THE EXISTING FOUNDATIONS AND SUPPORTED STRUCTURE. DOCUMENTATION MUST INCLUDE MEASURED ELEVATIONS AND LOCATIONS OF ANY EXISTING CRACKS OR DISTRESS. PHOTOGRAPHIC DOCUMENTATION MUST BE PROVIDED FOR ALL OBSERVED EXISTING CRACKS OR DISTRESS. FINAL POST CONSTRUCTION SURVEY MUST BE SUBMITTED TO OWNER FOR REVIEW.

BUILDING DESIGN LOADS (NEW BUILDINGS)

ROOF SNOW LOAD (ROOF LIVE LOAD) ASCE 7-10/IBC 2015
GROUND SNOW LOAD (Pg) = 70 PSF
SNOW EXPOSURE FACTOR (Ce) = 1.0
SNOW LOAD ROOF SLOPE FACTOR (Cs) = 1.0
SNOW LOAD THERMAL FACTOR (Ci) = 1.1
SNOW LOAD IMPORTANCE FACTOR (I) = 1.0
BALANCED ROOF SNOW LOAD (Pf) = 56 PSF
SNOW DRIFTING (Pd) = VARIES, SEE SHEET S-005

ROOF DEAD LOAD = 18 PSF
FLOOR DEAD LOAD = 58 PSF

FLOOR LIVE LOADS:
OFFICE = 50 PSF + 15 PSF (PARTITIONS)
STORAGE = 125 PSF
FIRST FLOOR CORRIDOR = 100 PSF
SECOND FLOOR CORRIDOR = 80 PSF

WIND LOAD ASCE 7-10/IBC 2015
BASIC WIND SPEED V_{ULT} = 109 MPH
BASIC WIND SPEED V_{ASD} = 85 MPH
WIND RISK CATEGORY = II
WIND EXPOSURE = EXPOSURE C
BUILDING TYPE = "ENCLOSED"
WIND DESIGN PRESSURE:
MAIN WIND FORCE RESISTING SYSTEM = 24 PSF (MAXIMUM PRESSURE)

SEISMIC DESIGN DATA ASCE 7-10/IBC 2015
SHORT PERIOD SPECTRAL RESPONSE ACCELERATION (S_s) = 0.317
ONE SECOND SPECTRAL RESPONSE ACCELERATION (S₁) = 0.078
OCCUPANCY CATEGORY = II
SEISMIC DESIGN CATEGORY = B
SEISMIC IMPORTANCE FACTOR = 1.00
SITE CLASS = D
TOTAL BASE SHEAR = 295 KIPS (SOUTH ADDITION)
46 KIPS (NORTH ADDITION)

BASIC STRUCTURAL SYSTEM
INTERMEDIATE REINFORCED CONCRETE MASONRY SHEAR WALLS
RESPONSE MODIFICATION COEFFICIENT (R) = 3.50
DEFLECTION AMPLIFICATION FACTOR (Cd) = 2.25
SYSTEM OVER STRENGTH FACTOR (φ) = 2.50
CROSS LAMINATED TIMBER SHEAR WALLS
RESPONSE MODIFICATION COEFFICIENT (R) = 3.00
DEFLECTION AMPLIFICATION FACTOR (Cd) = 3.00
SYSTEM OVER STRENGTH FACTOR (φ) = 3.00

ANALYSIS PROCEDURE = EQUIVALENT LATERAL FORCE PROCEDURE
DESIGN SOIL BEARING PRESSURE = 1,500 PSF

MECHANICAL EQUIPMENT MAXIMUM WEIGHTS USED IN DESIGN:
MAXIMUM MECHANICAL UNIT DEAD LOAD MUST NOT EXCEED 50 POUNDS PER SQUARE FOOT (PSF).

- NOTES:
- SEISMIC LOAD RESISTING SYSTEM CONSISTS OF THE FOLLOWING:
 - VERTICAL ELEMENTS - REINFORCED CONCRETE MASONRY SHEAR WALLS AND CROSS LAMINATED TIMBER SHEAR WALLS.
 - HORIZONTAL ELEMENTS - CROSS LAMINATED TIMBER DIAPHRAGMS.
 - COLLECTOR ELEMENTS - BEAMS AND HORIZONTAL BRACES WHERE INDICATED.

BUILDING DESIGN LOADS (BRIDGE)

ROOF SNOW LOAD (ROOF LIVE LOAD) ASCE 7-10/IBC 2015
GROUND SNOW LOAD (Pg) = 70 PSF
SNOW EXPOSURE FACTOR (Ce) = 1.0
SNOW LOAD ROOF SLOPE FACTOR (Cs) = 1.0
SNOW LOAD THERMAL FACTOR (Ci) = 1.2
SNOW LOAD IMPORTANCE FACTOR (I) = 1.0
BALANCED ROOF SNOW LOAD (Pf) = 44 PSF

DEAD LOAD = 70 PSF
LIVE LOADS = 100 PSF


WIND LOAD ASCE 7-10/IBC 2015
BASIC WIND SPEED V_{ULT} = 109 MPH
BASIC WIND SPEED V_{ASD} = 85 MPH
WIND RISK CATEGORY = II
WIND EXPOSURE = EXPOSURE C
BUILDING TYPE = "ENCLOSED"
WIND DESIGN PRESSURE:
MAIN WIND FORCE RESISTING SYSTEM = 30 PSF (MAXIMUM PRESSURE)

SEISMIC DESIGN DATA ASCE 7-10/IBC 2015
SHORT PERIOD SPECTRAL RESPONSE ACCELERATION (S_s) = 0.317
ONE SECOND SPECTRAL RESPONSE ACCELERATION (S₁) = 0.078
OCCUPANCY CATEGORY = II
SEISMIC DESIGN CATEGORY = B
SEISMIC IMPORTANCE FACTOR = 1.00
SITE CLASS = D
TOTAL BASE SHEAR = 11 KIPS

ANALYSIS PROCEDURE = EQUIVALENT LATERAL FORCE PROCEDURE
DESIGN SOIL BEARING PRESSURE = 1,500 PSF

STONE VENEER LINTEL SCHEDULE

LENGTH	LINTEL SIZE	END BEARING
≤ 4'-0"	∠ 3-1/2x3-1/2x1/4	8"
> 4'-0" TO 8'-6"	∠ 5x3-1/2x3/8 (LLV)	8"
> 8'-6" TO 11'-6"	∠ 6x4x3/8 (LLV)	8"
NOTE GALVANIZE LINTELS.		

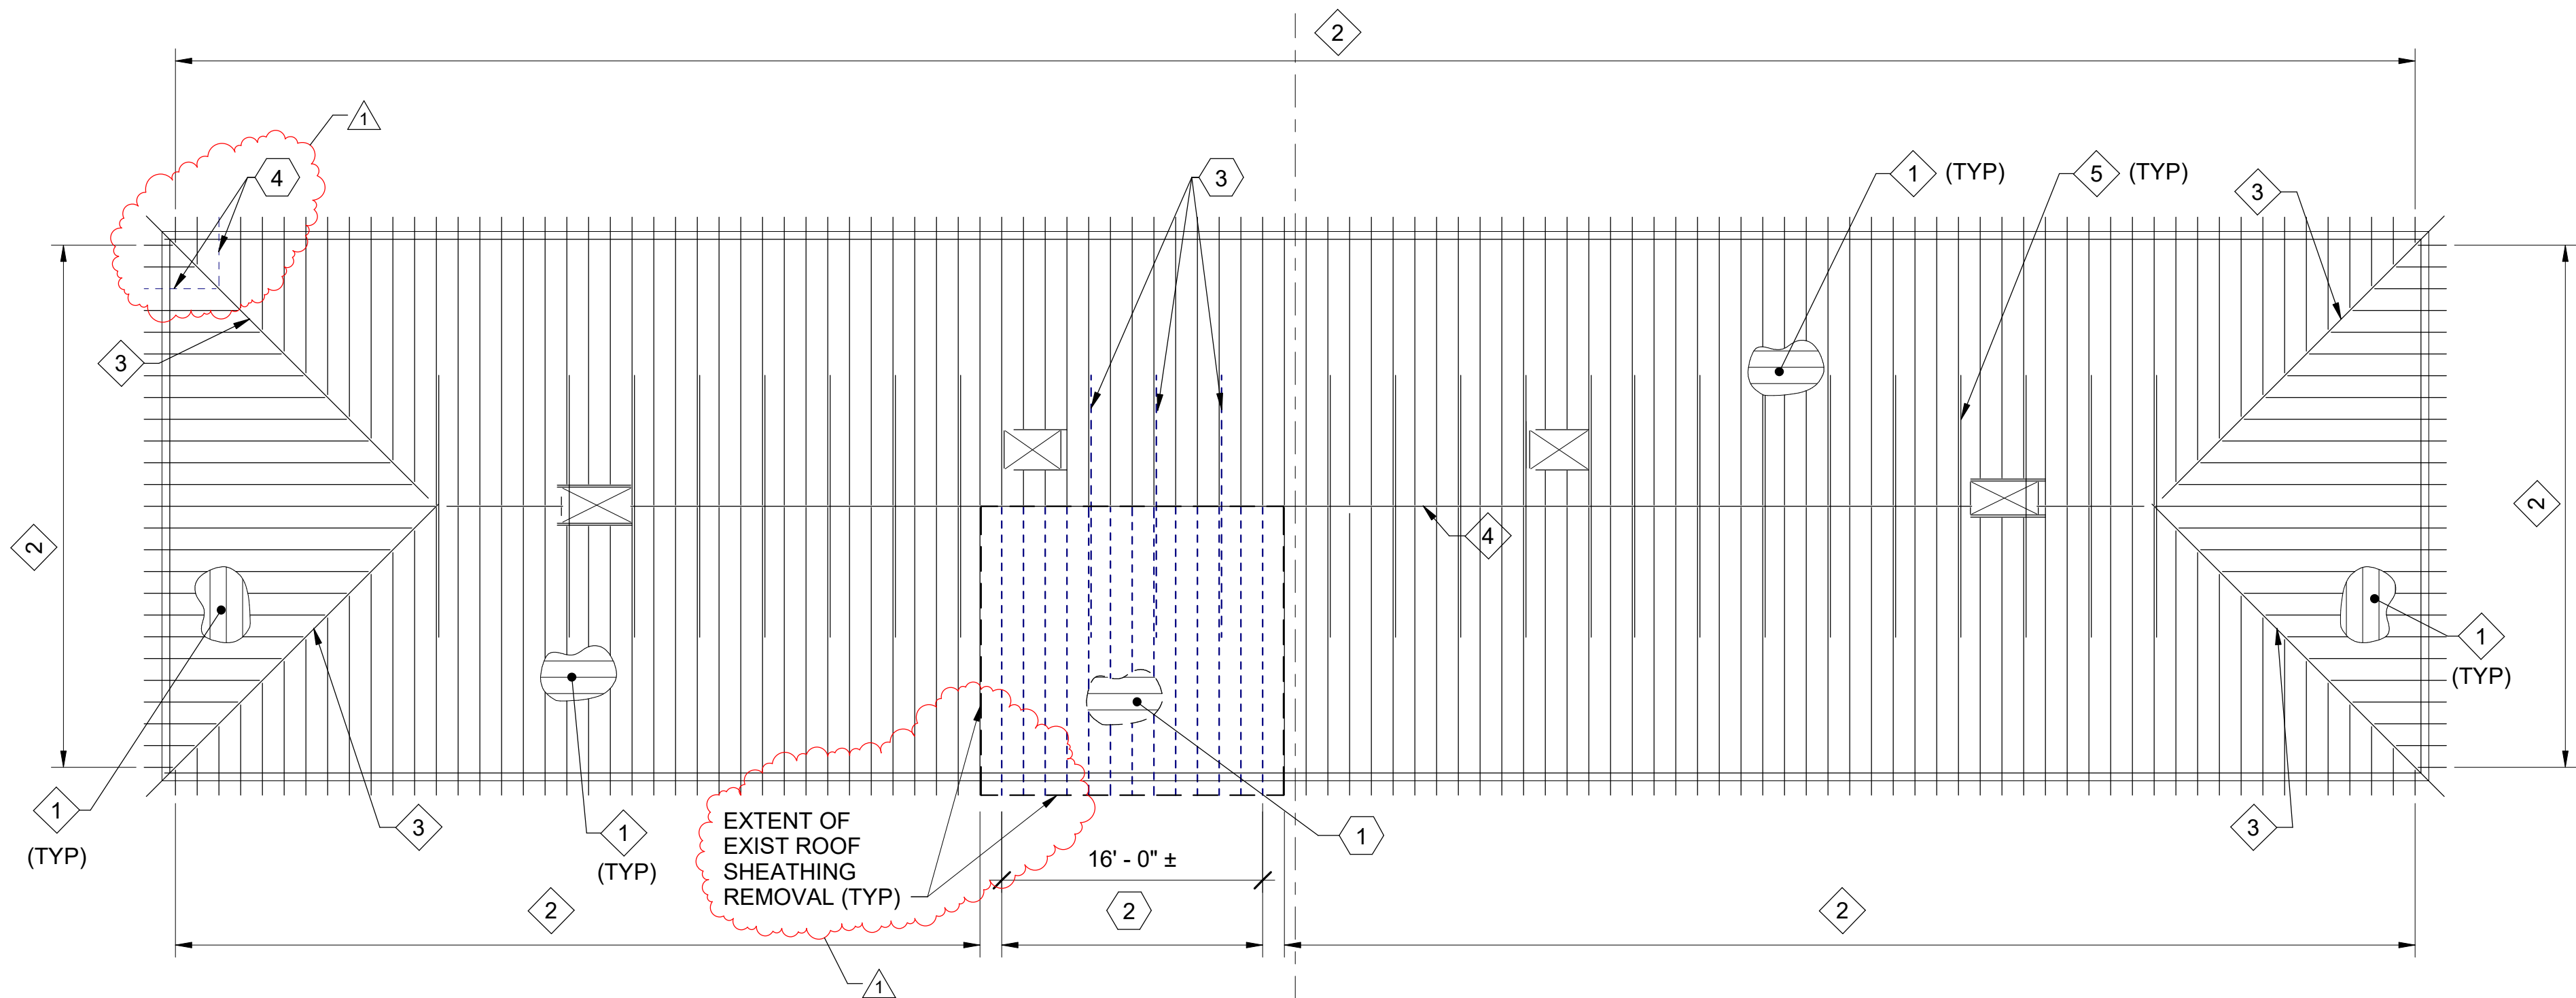


NOTE
COORDINATE REMOVALS WITH
TEMPORARY SHORING/BRACING
DESIGN.

EXISTING KEYNOTES (THIS SHEET ONLY)

- 1 EXISTING WOOD BOARD ROOF SHEATHING.
- 2 EXISTING 2x10± WOOD RAFTERS AT 1'-4"± ON-CENTER.
- 3 EXISTING 3x12± WOOD HIP MEMBER.
- 4 EXISTING 2x12± WOOD RIDGE BOARD.
- 5 EXISTING COLLAR TIE.

REMOVALS KEYNOTES (THIS SHEET ONLY)

- 1 REMOVE EXISTING WOOD BOARD ROOF SHEATHING.
- 2 REMOVE EXISTING 2x10± WOOD JOISTS AT 1'-4"± ON-CENTER.
- 3 REMOVE EXISTING COLLAR TIE.
- 4 REMOVE (2) EXISTING 2x10± RAFTERS AT THE EXISTING CRACKED HIP MEMBER. TEMPORARILY SHORE EXISTING ROOF DECK UNTIL THE HIP MEMBER HAS BEEN REPAIRED. COORDINATE WITH CRACK REPAIR KEYNOTE 15 ON SHEET SF105.

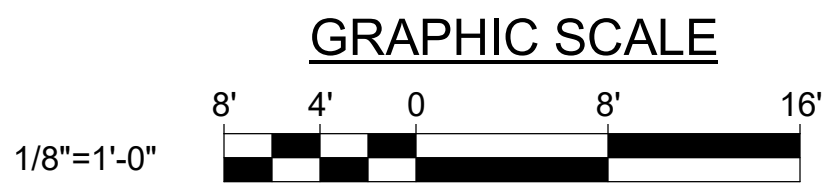

CHECK GRAPHIC SCALE BEFORE USING



DEPARTMENT OF INLAND
FISHERIES & WILDLIFE

TITLE NEW OFFICE HEADQUARTERS
LOCATION AUGUSTA, ME

TITLE THIS DWG.
ROOF FRAMING REMOVALS PLAN

OAK POINT
ASSOCIATES


DRAWING NO.
SD101

SHEET NO.

ARCHITECTURE • ENGINEERING • PLANNING
231 Main Street, Biddeford, Maine 04005 207.283.9193

NO.	DATE	DESCRIPTION	BY	DATE
1	03/13/2025	ADDENDUM NO. 6	DNM	01/29/2025

DRAWN BY: MJC	CHECK BY: DNM
DATE: 01/29/2025	

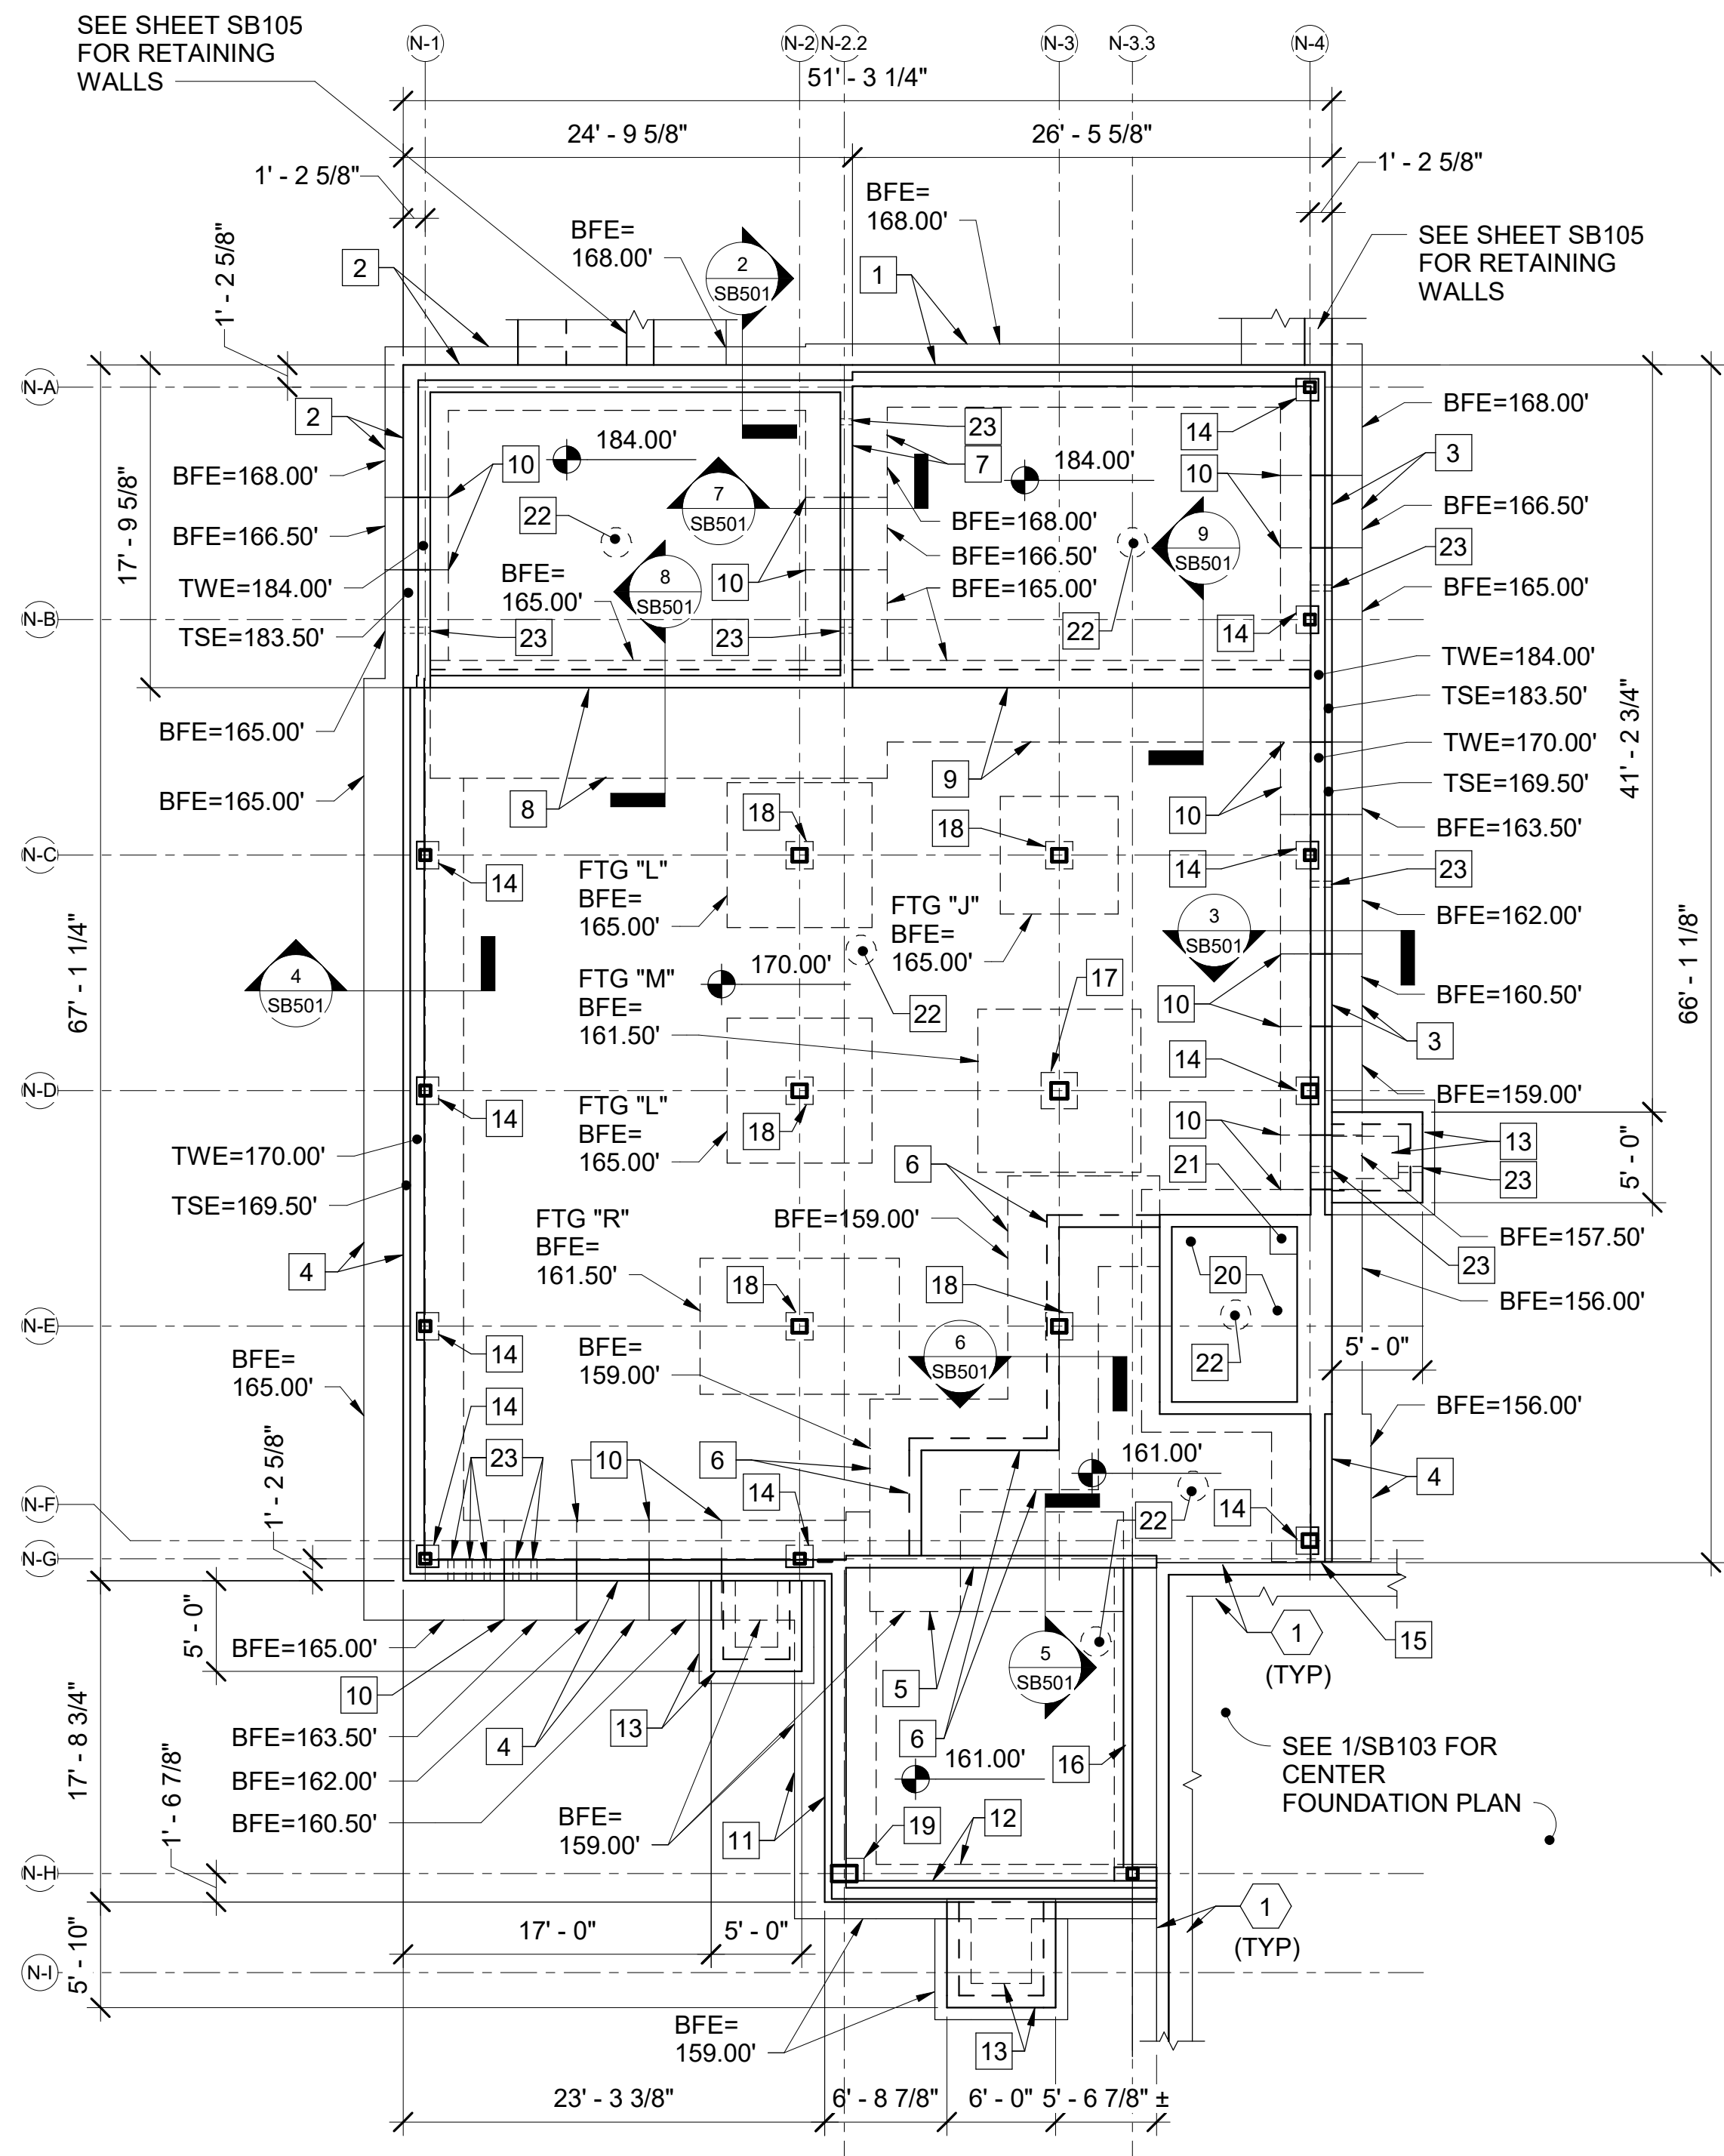

1 NORTH ADDITION FOUNDATION PLAN

SB101_SB103 SCALE: 1/8\"/>



COMBINED FOOTING SCHEDULE			
TYPE	SIZE	LONG WAY REINFORCING	SHORT WAY REINFORCING
CF1	11'-8"x5'-0"x1'-0"	TOP: (5) #5'S BOTTOM: (5) #5'S	TOP: NR BOTTOM: (8) #5'S
CF2	12'-8"x7'-0"x1'-0"	TOP: (6) #5'S BOTTOM: (6) #5'S	TOP: NR BOTTOM: (11) #5'S
CF3	13'-8"x11'-0"x1'-0"	TOP: (10) #5'S BOTTOM: (10) #5'S	TOP: NR BOTTOM: (12) #5'S
CF4	19'-6"x12'-0"x1'-6"	TOP: (16) #5'S BOTTOM: (16) #5'S	TOP: NR BOTTOM: (18) #5'S
CF5	NOT USED	-	-
CF6	16'-3"x9'-0"x1'-6"	TOP: (12) #5'S BOTTOM: (12) #5'S	TOP: NR BOTTOM: (15) #5'S

SPREAD FOOTING SCHEDULE				
LABEL	SIZE	BOTTOM REINFORCING	TOP REINFORCING	REMARKS
A	3'-0"x3'-0"x1'-0"	(4) #5'S EW	NR	
B	3'-6"x3'-6"x1'-0"	(4) #5'S EW	NR	
C	4'-0"x4'-0"x1'-0"	(6) #5'S EW	NR	
D	4'-0"x4'-0"x1'-6"	(6) #5'S EW	NR	MATCH CONT FTG THICKNESS
E	4'-6"x4'-6"x1'-0"	(5) #5'S EW	NR	
F	5'-0"x5'-0"x1'-4"	(6) #5'S EW	NR	
G	5'-6"x5'-6"x1'-4"	(7) #5'S EW	NR	
H	6'-0"x6'-0"x1'-4"	(7) #5'S EW	NR	
J	6'-6"x6'-6"x1'-0"	(7) #5'S EW	NR	
K	7'-0"x7'-0"x1'-4"	(8) #5'S EW	NR	
L	8'-0"x8'-0"x1'-0"	(9) #5'S EW	NR	
M	9'-0"x9'-0"x1'-0"	(8) #5'S EW	NR	
N	10'-0"x10'-0"x1'-0"	(9) #5'S EW	NR	
P	11'-0"x11'-0"x1'-3"	(12) #5'S EW	NR	
Q	12'-0"x12'-0"x1'-3"	(10) #5'S EW	NR	
R	7'-6"x11'-0"x1'-0"	(7)#5'S LW, (11) #5'S SW	NR	

GENERAL NOTES (THIS SHEET ONLY)


- REFER TO SHEET SB101 FOR SLAB CONTROL JOINTS AND EXPANSION JOINT LAYOUTS.
- REFER TO THIS SHEET FOR FOOTING SCHEDULES.
- REFER TO SHEET SF604 FOR COLUMN BASE PLATE SCHEDULE.
- REFER TO PLUMBING DRAWINGS FOR FLOOR DRAIN LOCATIONS IN SLABS. PITCH SLAB-ON-GROUND TO FLOOR DRAINS AS REQUIRED.
- BOTTOM OF ISOLATED INTERIOR COLUMN FOOTINGS SHALL BE 165.00', UNLESS NOTED OTHERWISE.
- REFER TO SHEET SB404 FOR ENLARGED PIER PLANS.
- PROVIDE FOUNDATION WALL AND SLAB-ON-GROUND CONSTRUCTION JOINTS AT EACH EDGE OF CONCRETE PLACEMENT IN ACCORDANCE WITH DETAILS 3/SB101 AND 5/SB502.
- REFER TO SHEET S-006 FOR COLUMN GRID SPACING.
- PROVIDE CONTROL JOINTS IN FOUNDATION WALLS LOCATED BELOW STONE VENEER CONTROL JOINTS AND AT A MAXIMUM SPACING OF 20'-0". COORDINATE WITH ARCHITECTURAL WALL ELEVATIONS FOR LOCATION OF CONTROL JOINTS. CONTROL JOINTS SHALL BE MADE BY 3/4" x 3/4" INSERTS ATTACHED TO FOUNDATION WALL FORMWORK.
- COORDINATE WITH EXCAVATION BRACING/SHORING NOTES ON SHEET S-002 FOR WORK ADJACENT TO EXISTING STRUCTURE.

EXISTING KEYNOTES (THIS SHEET ONLY)


EXISTING TAPERED FOUNDATION WALL.

KEYNOTES (THIS SHEET ONLY)


- 1'-2" REINFORCED CONCRETE FOUNDATION WALL AND 3'-0"x1'-0" THICK REINFORCED CONCRETE WALL FOOTING. SEE DETAIL 1/SB501.
- 1'-6" REINFORCED CONCRETE FOUNDATION WALL AND 3'-6"x1'-0" THICK REINFORCED CONCRETE WALL FOOTING. SEE DETAIL 2/SB501.
- 1'-2" REINFORCED CONCRETE FOUNDATION WALL AND 4'-6"x1'-0" THICK REINFORCED CONCRETE WALL FOOTING. SEE DETAIL 3/SB501.
- 1'-2" REINFORCED CONCRETE FOUNDATION WALL AND 5'-6"x1'-0" THICK REINFORCED CONCRETE WALL FOOTING. SEE DETAIL 4/SB501.
- 8" REINFORCED CONCRETE FOUNDATION WALL AND 6'-6"x1'-0" THICK REINFORCED CONCRETE WALL FOOTING. SEE DETAIL 5/SB501.
- 8" REINFORCED CONCRETE RETAINING WALL AND 5'-0"x1'-4" THICK REINFORCED CONCRETE WALL FOOTING. SEE DETAIL 6/SB501.
- 8" REINFORCED CONCRETE FOUNDATION WALL AND 4'-6"x1'-0" THICK REINFORCED CONCRETE WALL FOOTING. SEE DETAIL 7/SB501.
- 1'-0" REINFORCED CONCRETE RETAINING WALL AND 6'-6"x1'-6" THICK REINFORCED CONCRETE WALL FOOTING. SEE DETAIL 8/SB501.
- 1'-0" REINFORCED CONCRETE RETAINING WALL AND 4'-6"x1'-6" THICK REINFORCED CONCRETE WALL FOOTING. SEE DETAIL 9/SB501.
- STEP FOOTING. SEE DETAIL 4/SB502.
- 1'-2" REINFORCED CONCRETE FOUNDATION WALL AT CLT WALL PANEL WITH 4'-6"x1'-0" THICK REINFORCED CONCRETE WALL FOOTING. SEE DETAILS 3/SB501 (SIMILAR) AND 7/SF511.
- 1'-2" REINFORCED CONCRETE FOUNDATION WALL AND 3'-0"x1'-0" THICK REINFORCED CONCRETE WALL FOOTING. SEE DETAIL 10/SB501.
- REINFORCED CONCRETE STOOP. SEE DETAIL 10/SB501.
- REINFORCED CONCRETE PILASTER. SEE DETAIL 3/SB503.
- PIN FOUNDATION WALL TO EXISTING FOUNDATION WALL.
- REINFORCED CONCRETE WALL CAST AGAINST EXISTING TAPERED FOUNDATION WALL. SEE DETAIL 4/SB503.
- 2'-0"x2'-0" REINFORCED CONCRETE PIER. SEE DETAIL 4/SF604.
- 1'-6"x1'-6" REINFORCED CONCRETE PIER. SEE DETAIL 5/SF604.
- 1'-0"x1'-3" REINFORCE CONCRETE PILASTER. TOP OF PILASTER ELEVATION = 169.58'. SEE DETAIL 2/SB404.
- REINFORCED CONCRETE ELEVATOR PIT. SEE DETAIL 6/SB502 (SIMILAR).
- 1'-6"x1'-6"x2'-0" DEEP REINFORCED SUMP PIT. SEE DETAIL 7/SB502 (SIMILAR).
- RADON PIT. SEE DETAIL 3/SB502.
- CORE/SLEEVE HOLE IN FOUNDATION WALL FOR UTILITY PENETRATION. COORDINATE EXACT SIZE, LOCATION, ELEVATION, AND QUANTITY WITH CIVIL, PLUMBING, AND ELECTRICAL PLANS.

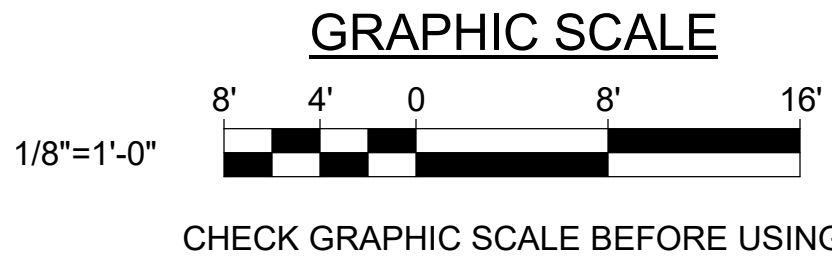

CHECK GRAPHIC SCALE BEFORE USING

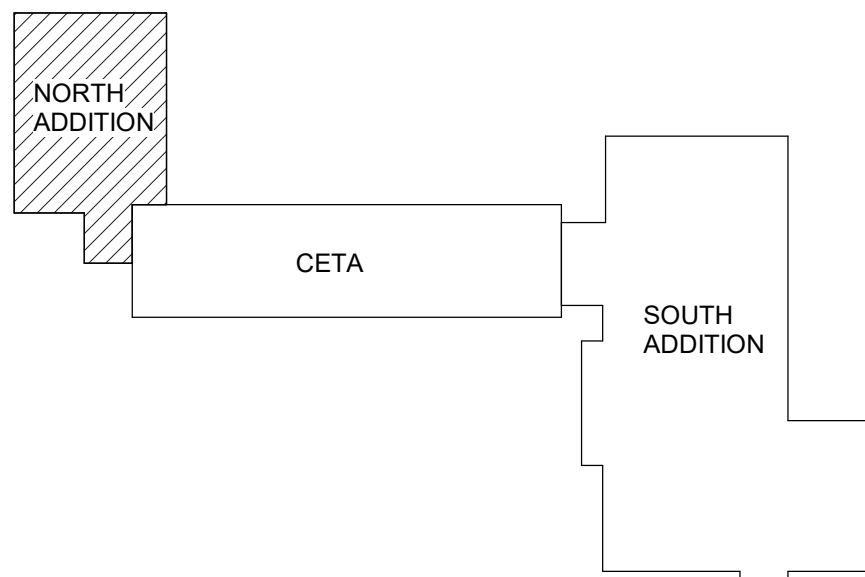

DRAWN BY: MJC		CHECK BY: DNM		DATE: 01/29/2025	
NO.		DESCRIPTION		BY	
2		03/13/2025 ADDENDUM NO. 6		DNM	
1		02/28/2025 ADDENDUM NO. 3		DNM	
NO.		DATE		DESCRIPTION	
2		03/13/2025		ADDENDUM NO. 6	
1		02/28/2025		ADDENDUM NO. 3	
NO.		DATE		DESCRIPTION	
2		03/13/2025		ADDENDUM NO. 6	
1		02/28/2025		ADDENDUM NO. 3	
NO.		DATE		DESCRIPTION	

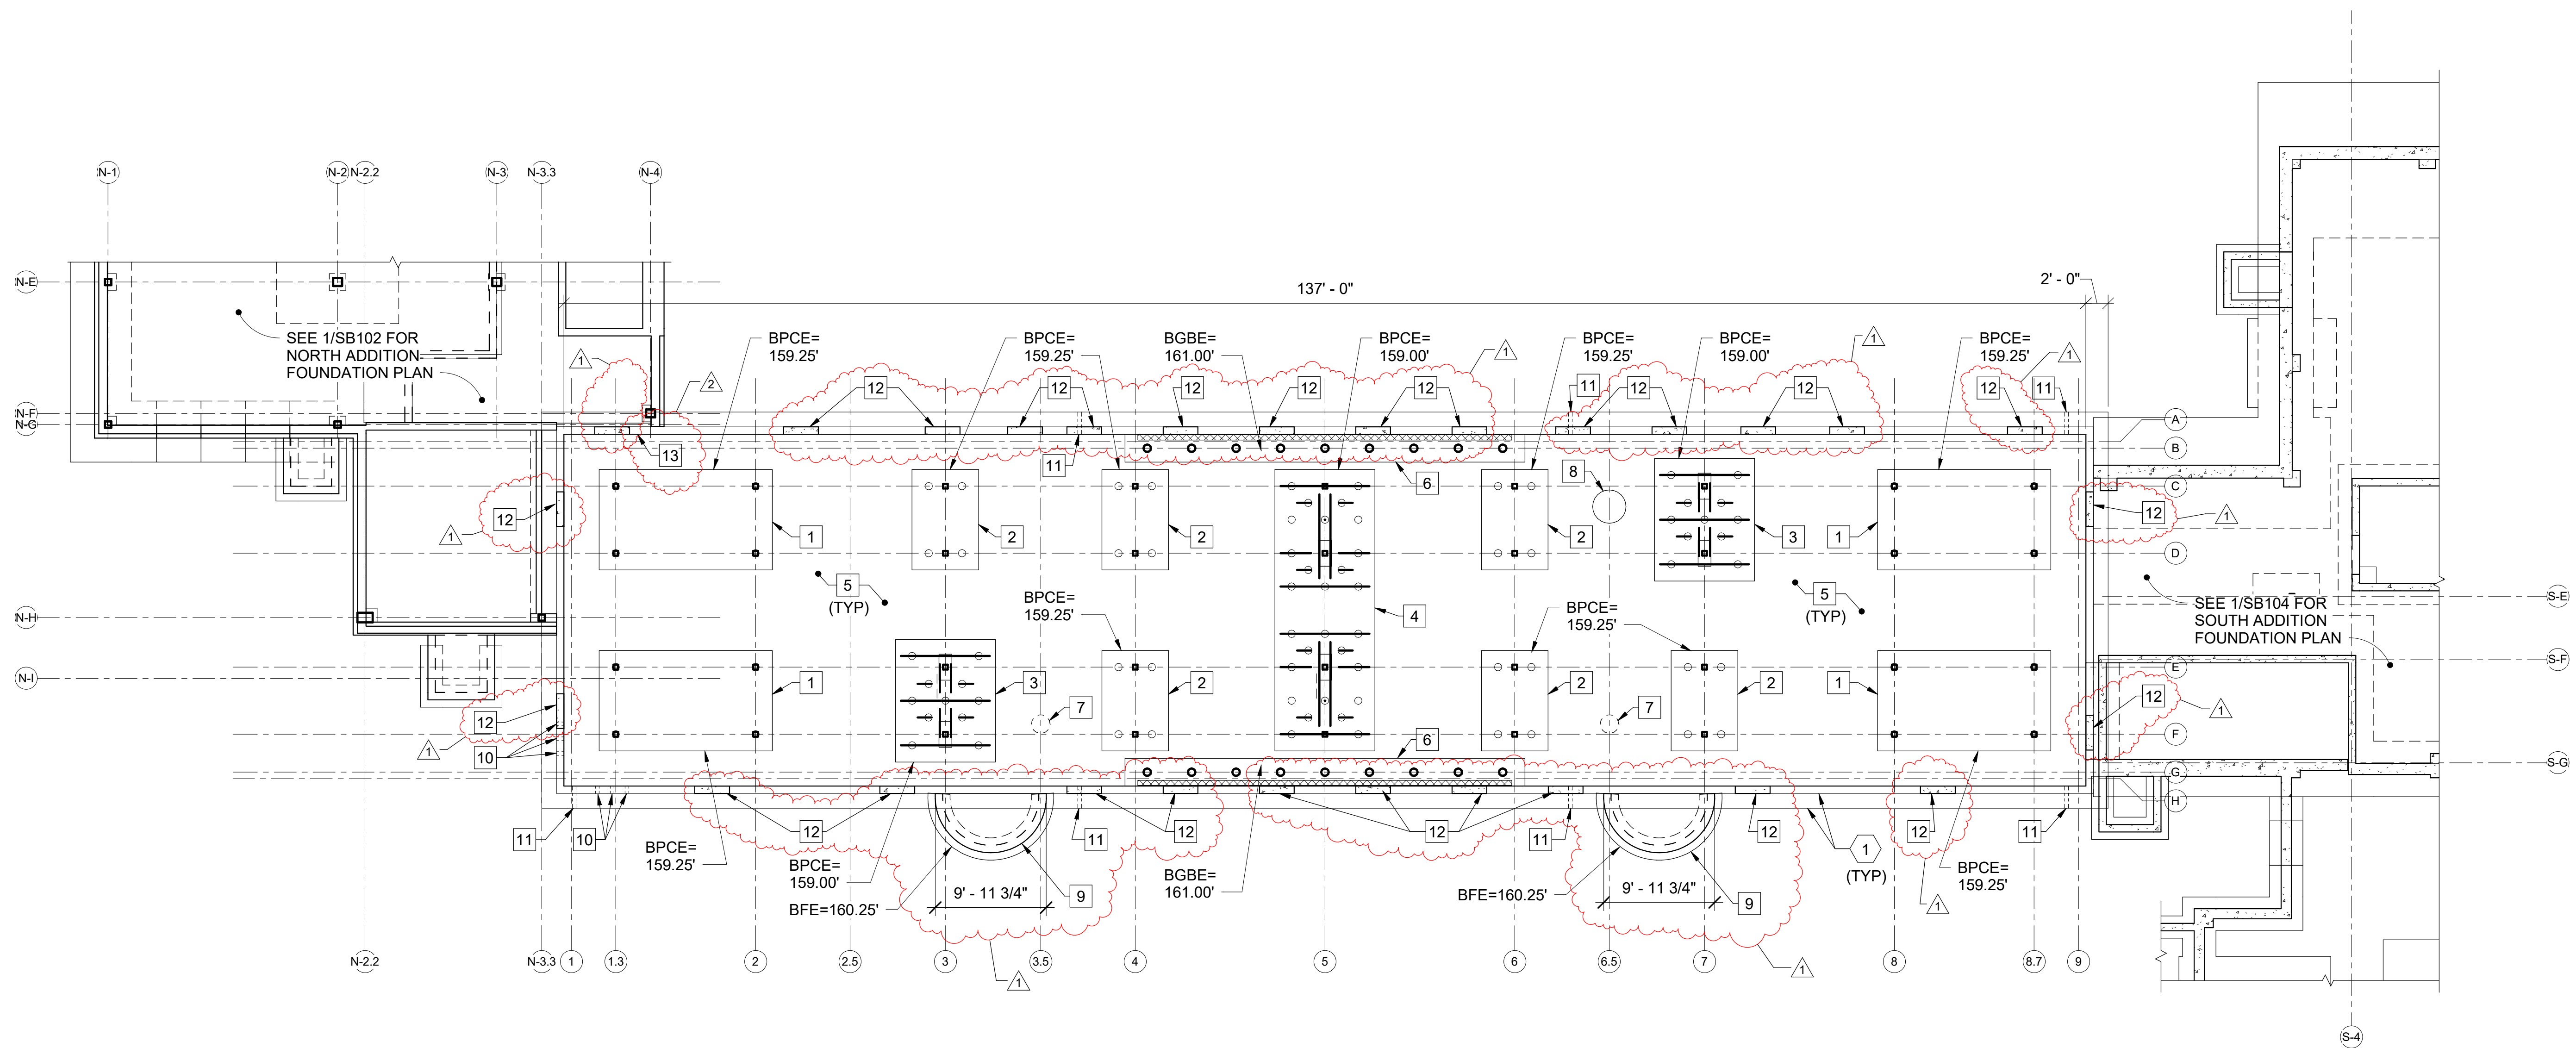

1 CENTER FOUNDATION PLAN
SB103 SCALE: 1/8" = 1'-0"
PLAN NORTH



NOTES

- REMOVE LOOSE MATERIAL FROM CRACK.
- INJECT CRACK REPAIR MATERIAL THROUGH INJECTION PORTS STARTING AT HIGHEST POINT OF THE CRACK.
- CRACK REPAIR MATERIAL MUST HAVE THE FOLLOWING MINIMUM PROPERTIES:
COMPRESSIVE STRENGTH, ASTM D695:
3,000 PSI AT 1 DAY AT TEMPERATURE OF 68 F.
8,500 PSI AT 3 DAYS AT TEMPERATURE OF 68 F.
9,000 PSI AT 7 DAYS AT TEMPERATURE OF 68 F.
TENSILE STRENGTH = 6,000 PSI, ASTM D 638.
MODULUS OF ELASTICITY = 200,000 PSI, ASTM D 695.
ELONGATION AT BREAK = 25 PERCENT, ASTM D 638.
WATER ABSORPTION = 0.24 PERCENT, ASTM D 570.
- CURE IN ACCORDANCE WITH MANUFACTURER'S PRINTED INSTRUCTIONS.

2 FOUNDATION WALL CRACK REPAIR DETAIL
SB103 SCALE: NOT TO SCALE

GENERAL NOTES (THIS SHEET ONLY)


- REFER TO SHEET SB101 FOR SLAB CONTROL JOINTS AND EXPANSION JOINT LAYOUTS.
- REFER TO PLUMBING DRAWINGS FOR FLOOR DRAIN LOCATIONS IN SLABS. PITCH SLAB-ON-GROUND TO FLOOR DRAINS AS REQUIRED.
- PROVIDE FOUNDATION WALL AND SLAB-ON-GROUND CONSTRUCTION JOINTS AT EACH EDGE OF CONCRETE PLACEMENT IN ACCORDANCE WITH DETAILS 3/SB101 AND 5/SB502.
- REFER TO SHEET S-006 FOR COLUMN GRID SPACING.
- TOP OF PILE CAP ELEVATION = 161.00'.

EXISTING KEYNOTES (THIS SHEET ONLY)


- 1 EXISTING TAPERED FOUNDATION WALL

KEYNOTES (THIS SHEET ONLY)


- REINFORCED CONCRETE PILE CAP 1. SEE DETAIL 1/SB401.
- REINFORCED CONCRETE PILE CAP 2. SEE DETAIL 2/SB401.
- REINFORCED CONCRETE PILE CAP 3. SEE DETAIL 3/SB401.
- REINFORCED CONCRETE PILE CAP 4. SEE DETAIL 4/SB401.
- 6" REINFORCED CONCRETE SLAB-ON-GROUND WITH 6x6, W2.9xW2.9 WELDED WIRE FABRIC. TOP OF SLAB ELEVATION = 161.00'.
- 2'-0"x2'-6" REINFORCED CONCRETE GRADE BEAM. SEE DETAIL 8/SB401.
- RADON PIT. SEE DETAIL 3/SB502.
- SUMP PIT. COORDINATE WITH PLUMBING PLANS AND DETAIL 8/P-501.
- REINFORCED CONCRETE STOOP AT GRANITE STOOP AT PORTICO. COORDINATE WITH CIVIL, LANDSCAPE AND ARCHITECTURAL PLANS. SEE DETAIL 10/SB501 (SIMILAR), 12/AE404, AND 13/AE404.
- CORE/SLEEVE HOLE IN FOUNDATION WALL FOR UTILITY PENETRATION. COORDINATE EXACT, SIZE, LOCATION, ELEVATION, AND QUANTITY WITH CIVIL, PLUMBING, AND ELECTRICAL PLANS.
- FOUNDATION DRAIN BELOW EXISTING TAPERED FOUNDATION WALL. COORDINATE WITH 1/CU102 AND DETAIL 4/CU102.
- REINFORCED CONCRETE FOUNDATION WALL INFILL AT EXISTING WINDOW OPENINGS. MATCH PROFILE OF EXISTING ADJACENT FOUNDATION WALL. SEE DETAIL 7/SB503.
- FOUNDATION WALL CRACK REPAIR. SEE DETAIL 2/SB203.

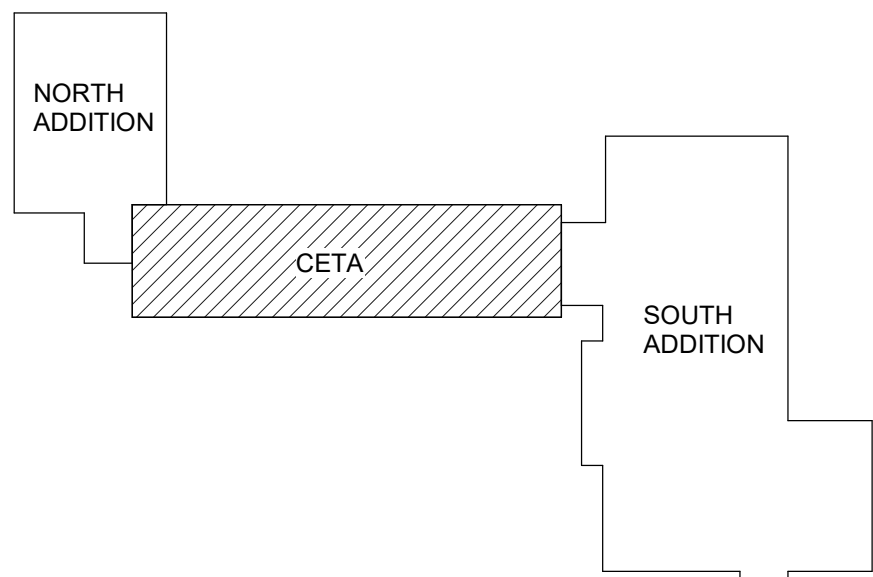

KEYPLAN PLAN
NOT TO SCALE NORTH

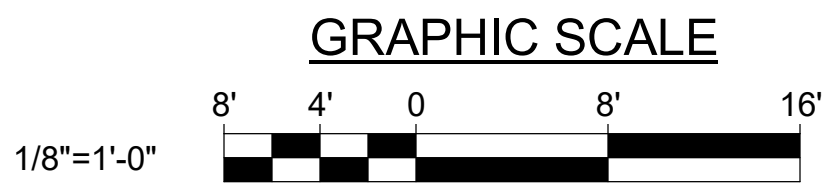

CHECK GRAPHIC SCALE BEFORE USING

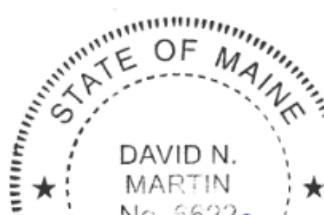						DEPARTMENT OF INLAND FISHERIES & WILDLIFE			
						TITLE NEW OFFICE HEADQUARTERS			
						LOCATION AUGUSTA, ME			
						TITLE THIS DWG CENTER FOUNDATION PLAN			




1. REFER TO SHEET SB101 FOR SLAB CONTROL JOINTS AND EXPANSION JOINT LAYOUTS.
2. REFER TO SHEET SB102 FOR FOOTING SCHEDULES.
3. REFER TO SHEET SF604 FOR COLUMN BASE PLATE DETAILS.
4. REFER TO PLUMBING DRAWINGS FOR FLOOR DRAIN LOCATIONS IN SLABS. PITCH SLAB-ON-GROUND TO FLOOR DRAINS AS REQUIRED.
5. BOTTOM OF THE EXTERIOR AND INTERIOR CONTINUOUS FOUNDATION WALL FOOTINGS, EXTERIOR SPREAD FOOTINGS, EXTERIOR COMBINED FOOTINGS, AND EXTERIOR MAT FOOTINGS SHALL BE 164.25', UNLESS NOTED OTHERWISE.
6. BOTTOM OF ISOLATED AND COMBINED INTERIOR COLUMN FOOTINGS AND MAT FOOTINGS SHALL BE 164.25', UNLESS NOTED OTHERWISE.
7. TOP OF EXTERIOR FOUNDATION WALL SHALL BE 170.00'. UNLESS NOTED OTHERWISE. COORDINATE INTEGRAL SHELF ELEVATIONS WITH FOUNDATION PLAN AND DETAILS.
8. REFER TO SHEET SB404 FOR ENLARGED PIER PLANS.
9. PROVIDE FOUNDATION WALL AND SLAB-ON-GROUND CONSTRUCTION JOINTS AT EACH EDGE OF CONCRETE PLACEMENT IN ACCORDANCE WITH DETAILS 3/SB101 AND 5/SB502.
10. REFER TO SHEET S-006 FOR COLUMN GRID SPACING.
11. PROVIDE CONTROL JOINTS IN FOUNDATION WALLS LOCATED BELOW STONE VENEER CONTROL JOINTS AND AT A MAXIMUM SPACING OF 20'-0". COORDINATE WITH ARCHITECTURAL WALL ELEVATIONS FOR LOCATION OF CONTROL JOINTS. CONTROL JOINTS SHALL BE MADE BY 3/4" x 3/4" INSERTS ATTACHED TO FOUNDATION WALL FORMWORK.
12. COORDINATE WITH EXCAVATION BRACING/SHORING NOTES ON SHEET S-002 FOR WORK ADJACENT TO EXISTING STRUCTURE.

1 EXISTING TAPERED FOUNDATION WALL


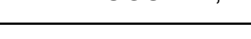
 
KEYNOTES (THIS SHEET ONLY)









- 1 1'-2" REINFORCED CONCRETE FOUNDATION WALL AND FOOTING. SEE DETAIL 1/SB501 (SIMILAR).
- 2 11" REINFORCED CONCRETE FOUNDATION WALL AT CURTAIN WALL. SEE DETAIL 5/SB503 (SIMILAR).
- 3 11" REINFORCED CONCRETE FOUNDATION WALL AND FOOTING. SEE DETAIL 5/SB503.
- 4 REINFORCED CONCRETE FOUNDATION WALL AT STOREFRONT.
- 5 REINFORCED CONCRETE ELEVATOR PIT. SEE DETAIL 6/SB502.
- 6 REINFORCED CONCRETE STOOP. SEE DETAIL 10/SB501 (SIMILAR).
- 7 STEP FOOTING. SEE DETAIL 4/SB502.
- 8 1'-2" REINFORCED CONCRETE RETAINING WALL AND FOOTING. SEE DETAIL 1/SB503.
- 9 1'-0" REINFORCED CONCRETE RETAINING WALL AND FOOTING. SEE DETAIL 2/SB503.
- 10 MAT FOOTING 1. SEE DETAIL 1/SB402.
- 11 MAT FOOTING 2. SEE DETAIL 2/SB402.
- 12 MAT FOOTING 3. SEE DETAIL 3/SB402.
- 13 MAT FOOTING 4. SEE DETAIL 4/SB402.
- 14 MAT FOOTING 5. SEE DETAIL 2/SB403.
- 15 1'-6"x1'-6"x2'-0" DEEP REINFORCED CONCRETE SUMP PIT. SEE DETAIL 7/SB502.
- 16 SUMP PIT. COORDINATE WITH PLUMBING PLANS AND DETAIL 8/P-501.
- 17 RADON PIT. SEE DETAIL 3/SB502.
- 18 CORE/SLEEVE HOLE IN FOUNDATION WALL FOR UTILITY PENETRATION. COORDINATE EXACT SIZE, LOCATION, ELEVATION, AND QUANTITY WITH CIVIL, PLUMBING, AND ELECTRICAL PLANS.
- 19 REINFORCED CONCRETE STOOP AT GRANITE ENTRY PLAZA. COORDINATE WITH CIVIL AND LANDSCAPE PLANS. SEE DETAIL 10/SB501 (SIMILAR) AND 7/L-501.
- 20 8" REINFORCED CONCRETE FOUNDATION WALL. SEE DETAIL 5/SB501 (SIMILAR).
- 21 1'-6" REINFORCED CONCRETE FOUNDATION WALL. SEE DETAIL 6/SB503.
- 22 1'-0" REINFORCED CONCRETE FOUNDATION WALL. SEE DETAIL 1/SB503 (SIMILAR).
- 23 AT OPENING IN REINFORCED CONCRETE WALL, PROVIDE ADDITIONAL (2) 5'S HORIZONTAL ABOVE OPENING. EXTEND REINFORCING 1'-0" PAST EDGES OF OPENING.

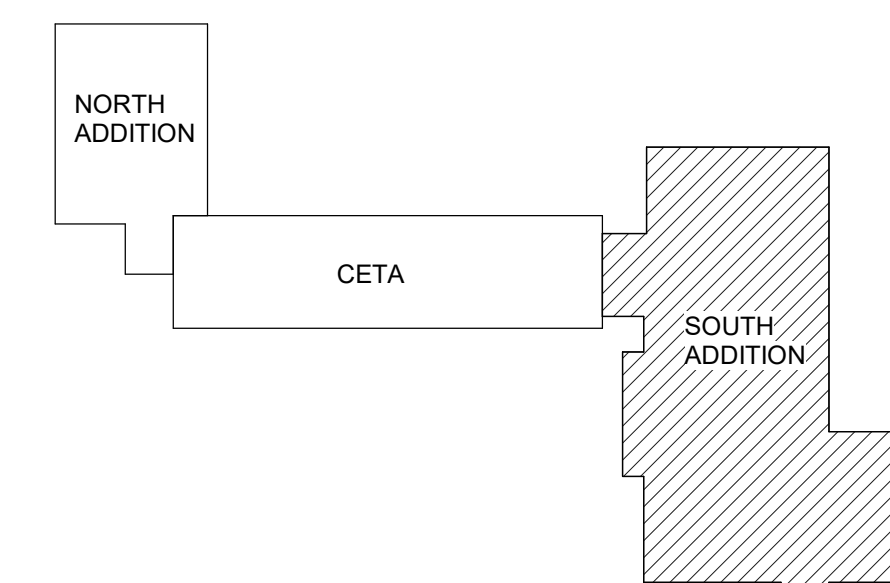








8' 4' 0 8' 16

CHECK GRAPHIC SCALE BEFORE USING


					DEPARTMENT OF INLAND FISHERIES & WILDLIFE			
					TITLE NEW OFFICE HEADQUARTERS			
					LOCATION AUGUSTA, ME			
					TITLE THIS DWG. SOUTH ADDITION FOUNDATION PLAN			
3	03/13/2025	ADDENDUM NO. 6	DNM	DRAWN BY: MJC CHECK BY: DNM	 OAK POINT ASSOCIATES  SB104			
2	03/06/2025	ADDENDUM NO. 5	DNM					
1	02/02/2025	ADDENDUM NO. 1	DNM					
NO.	DATE	DESCRIPTION	BY	NO.	DATE 01/29/2025 211 Main Street, Ellsworth, Maine 04805 202-283-2883 (989)			
REVISIONS				SHEET NO. 55 of 239				

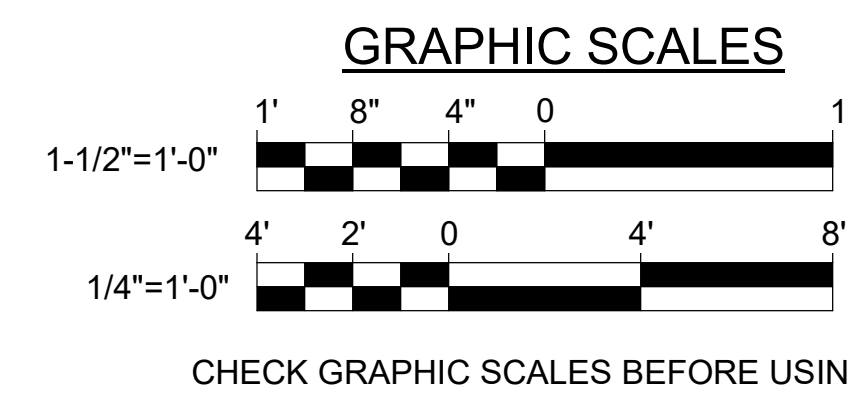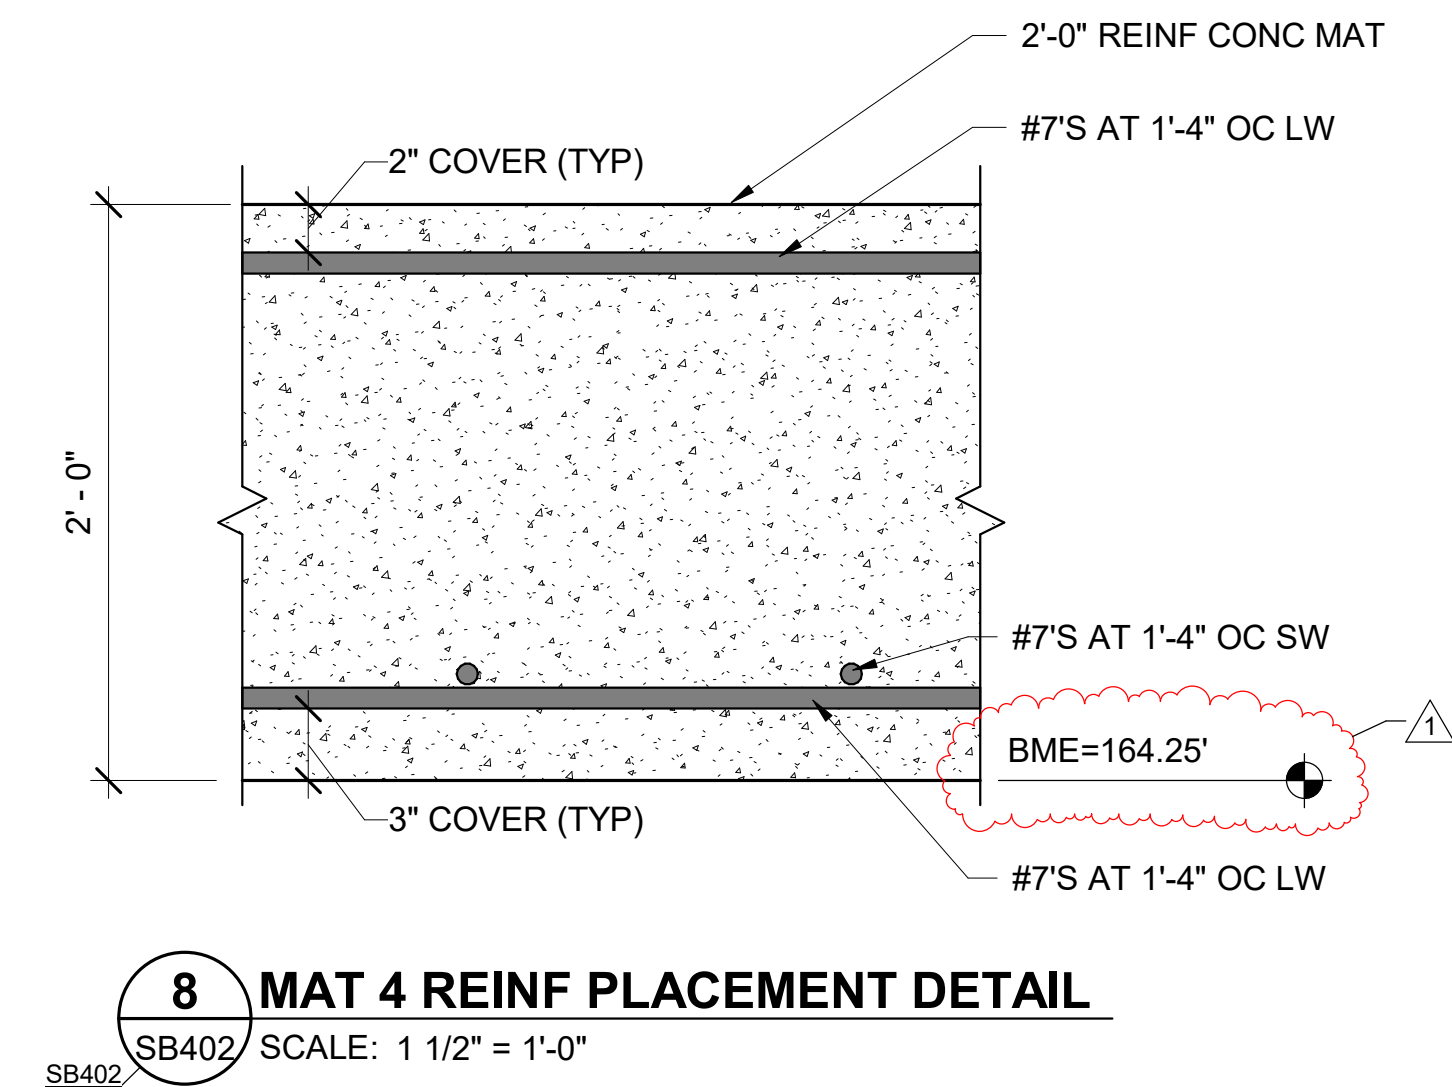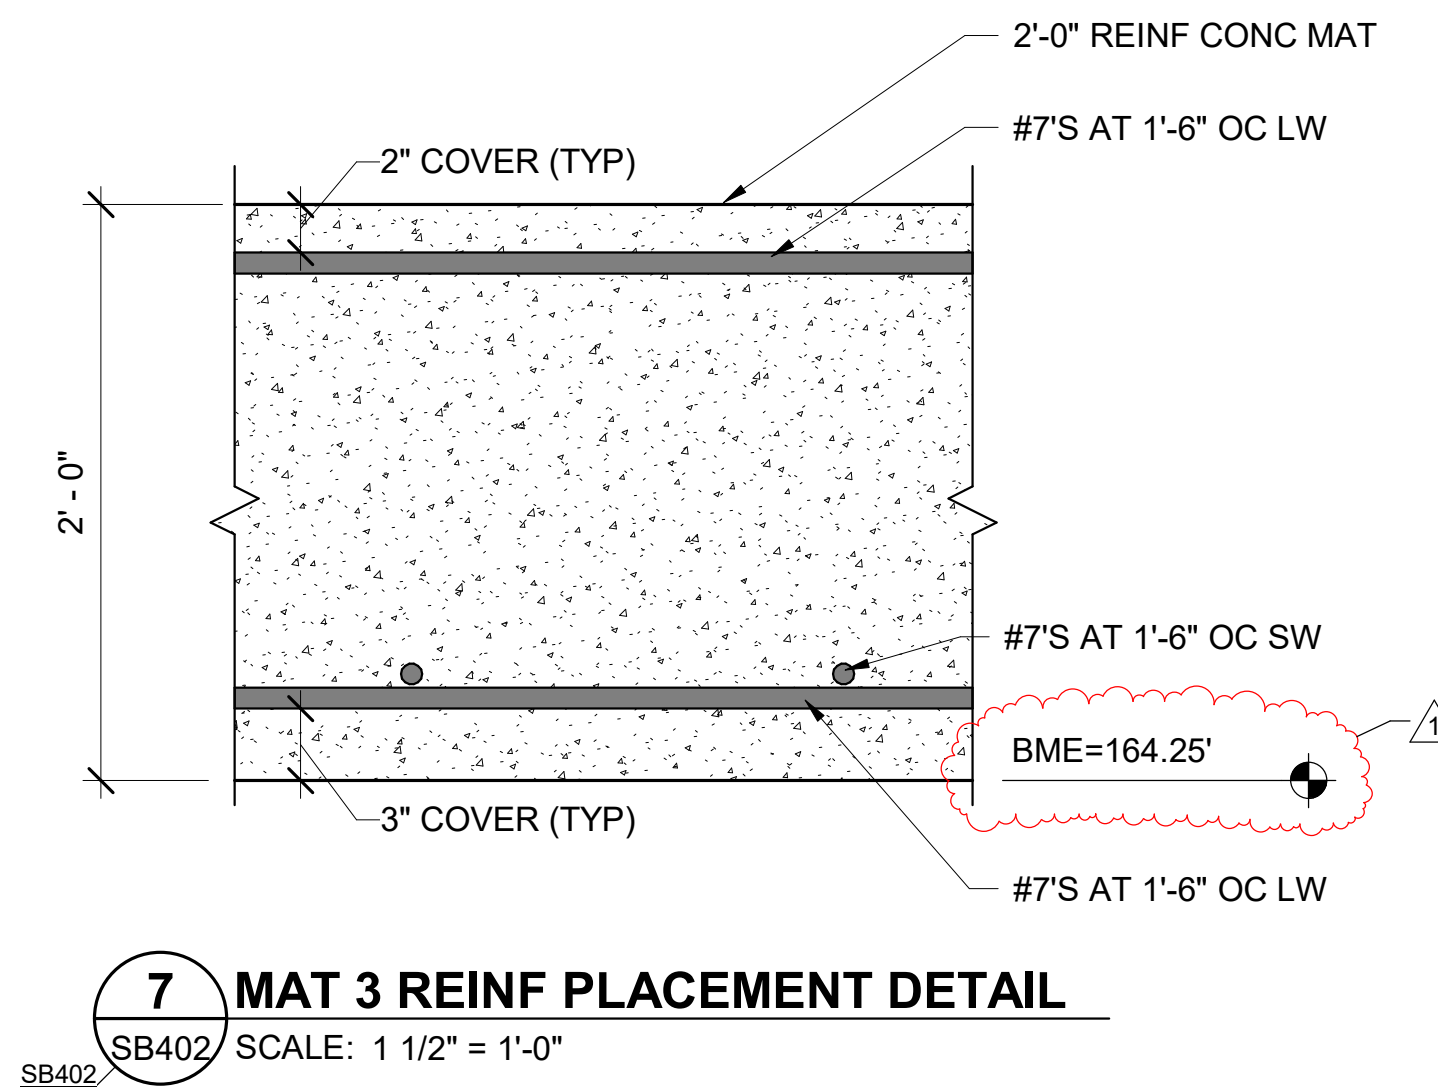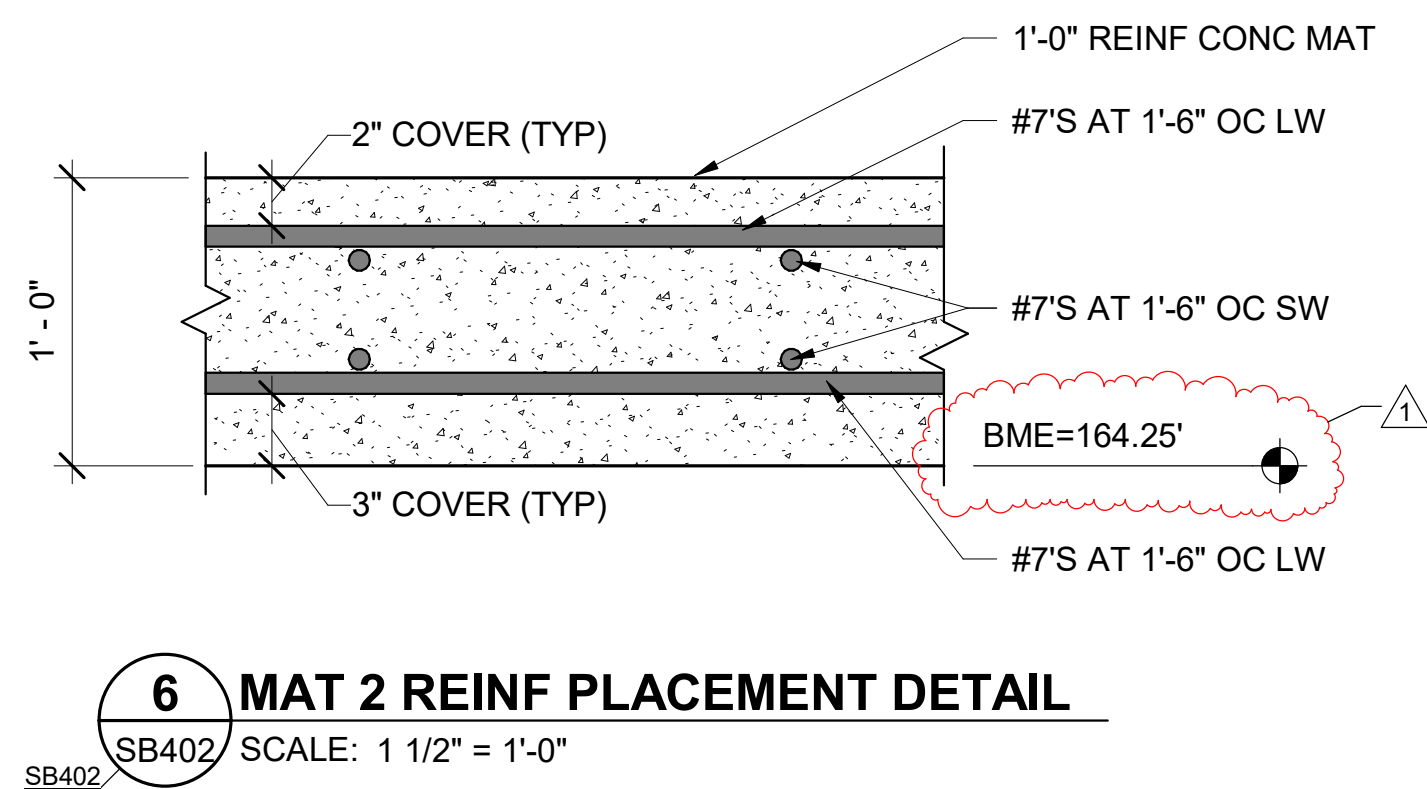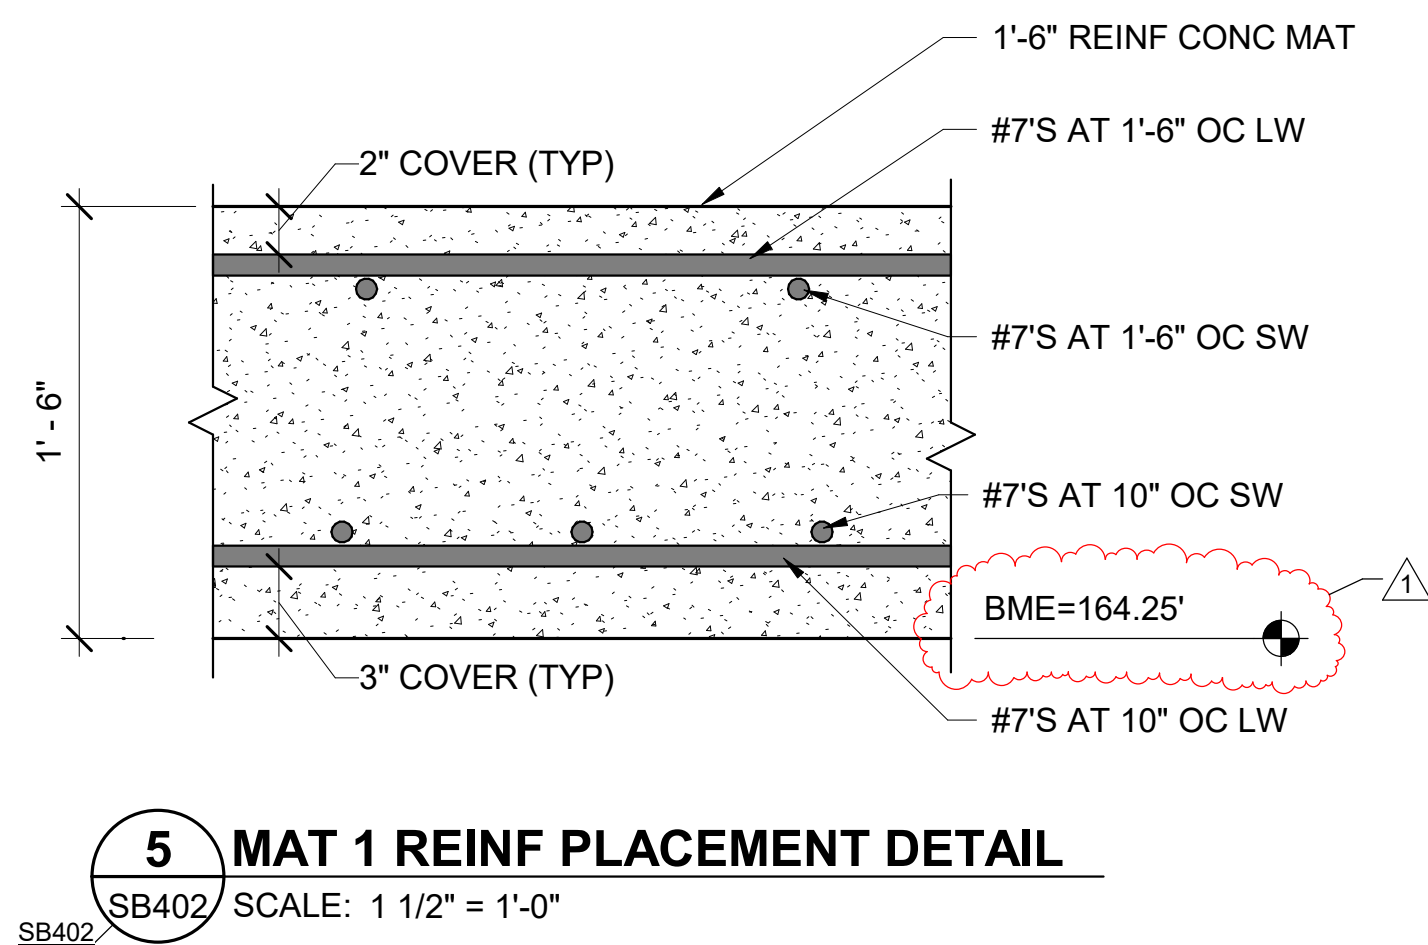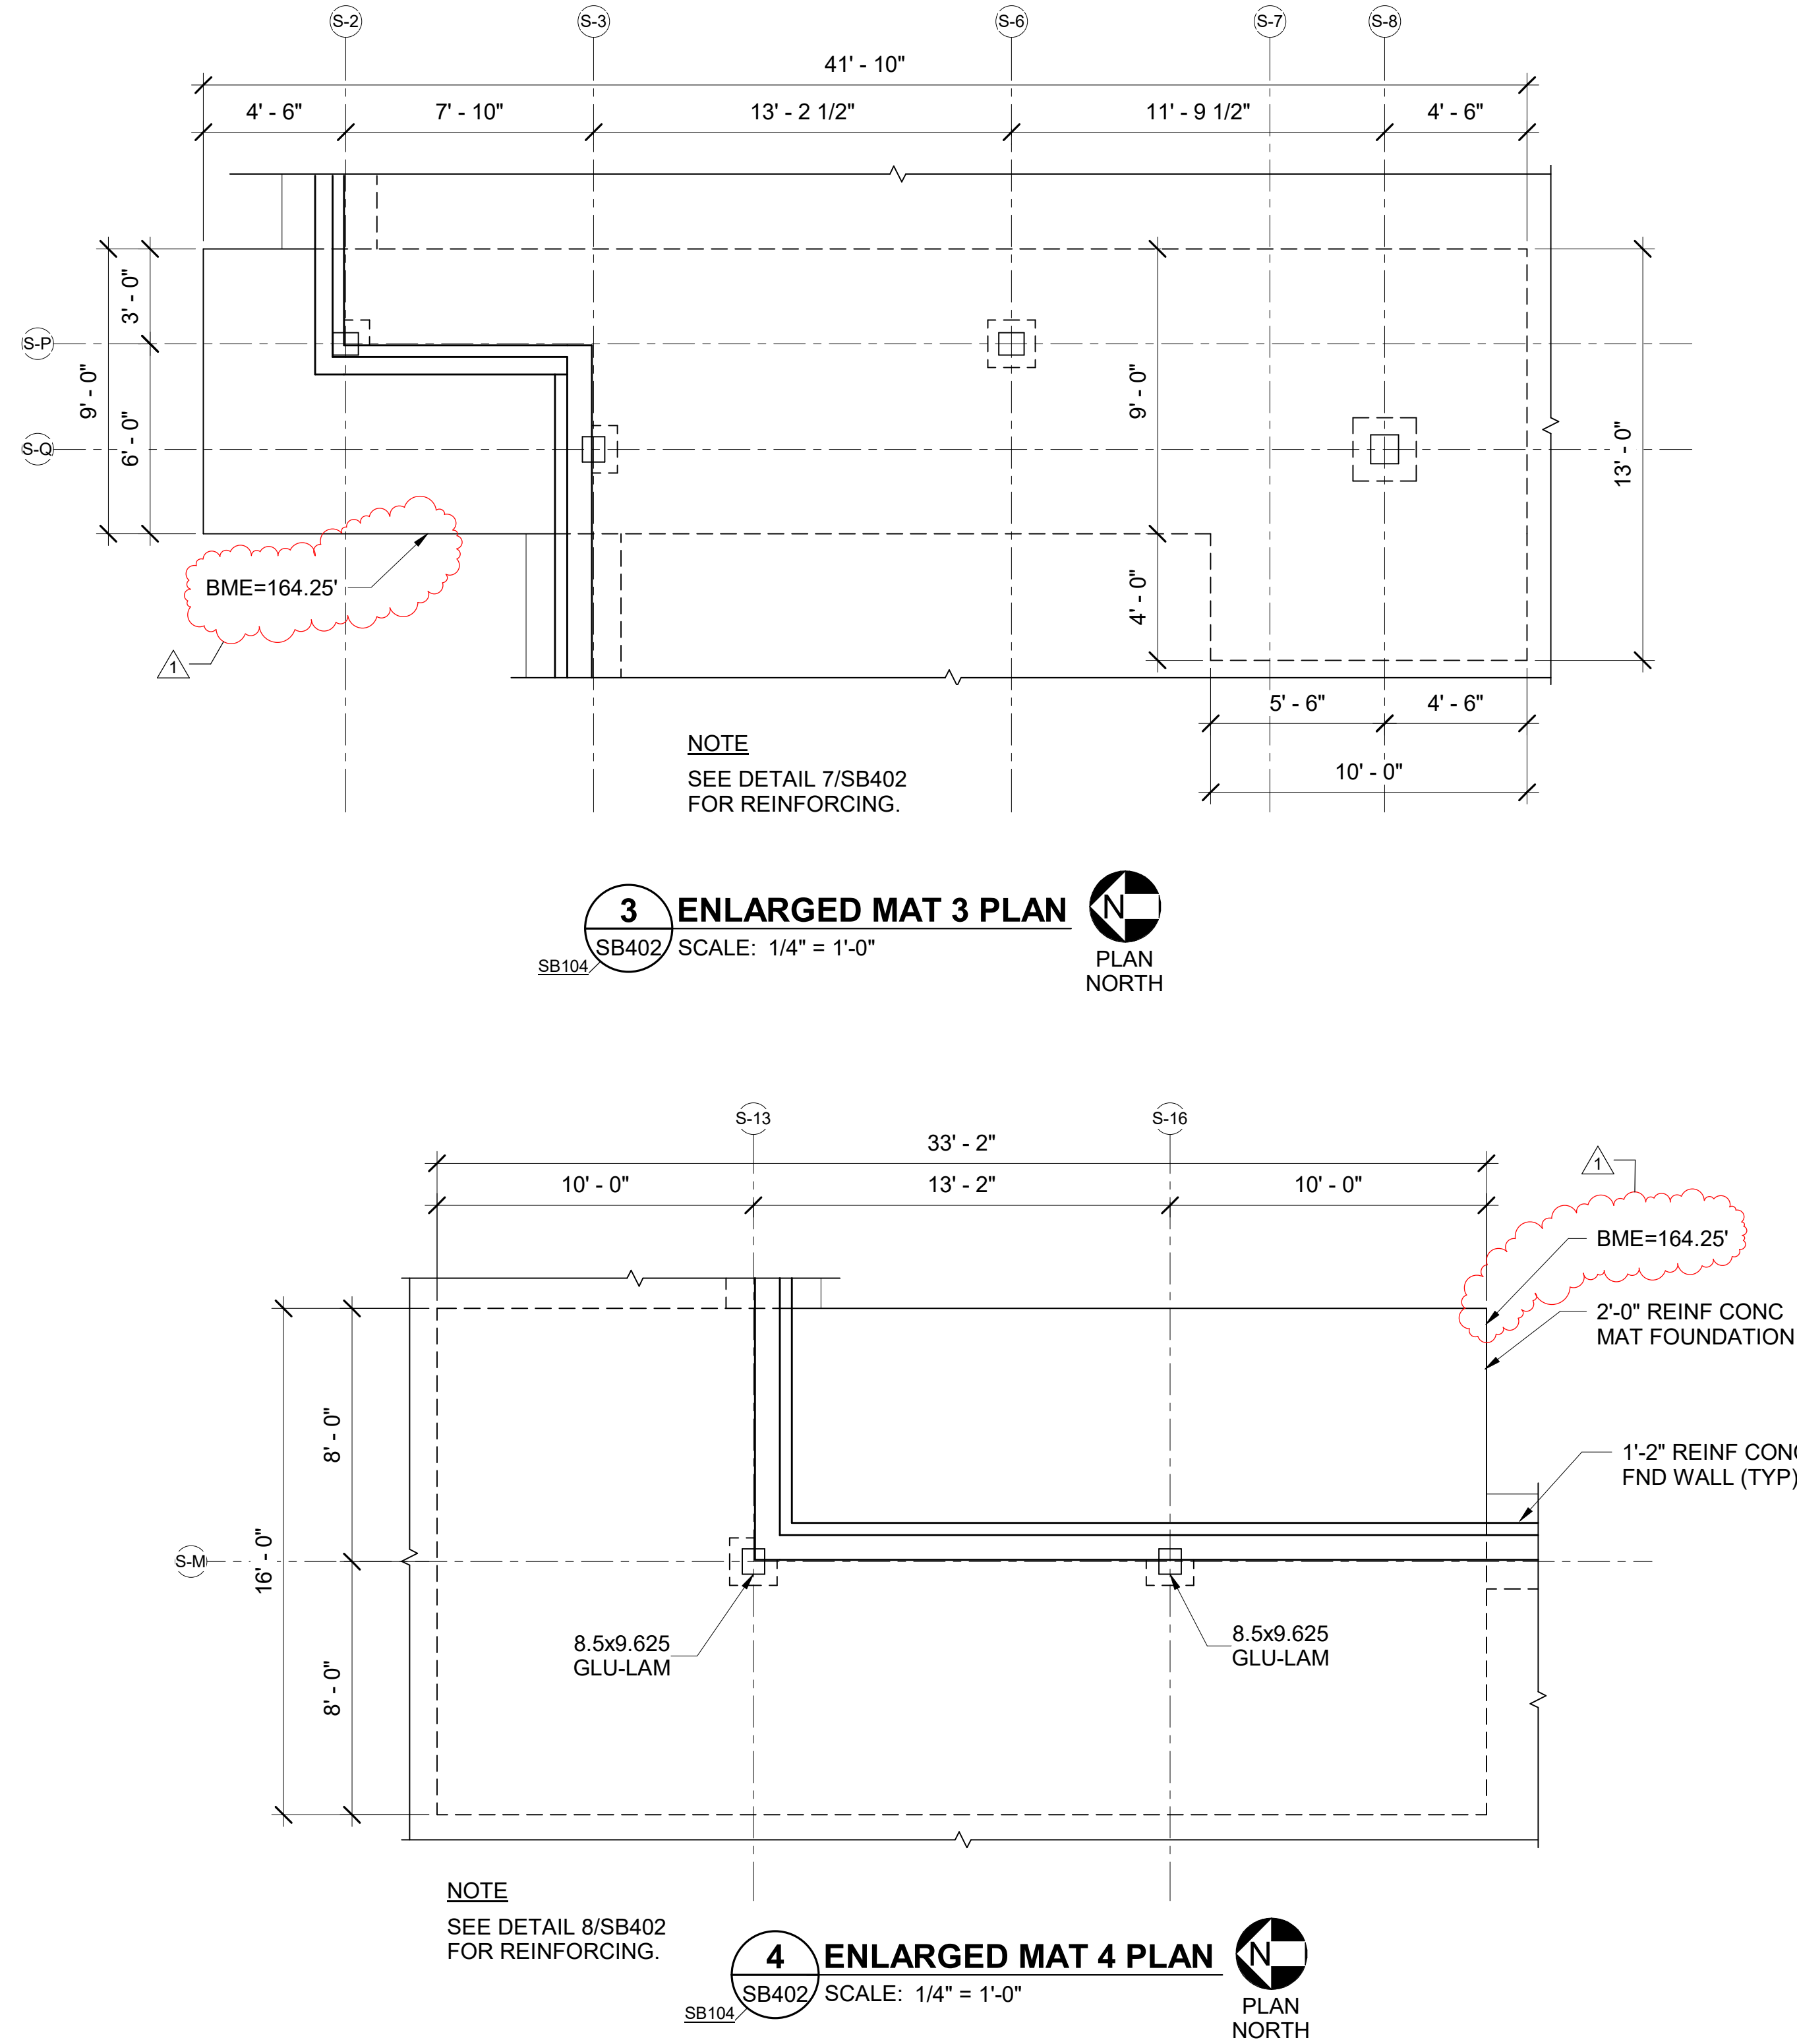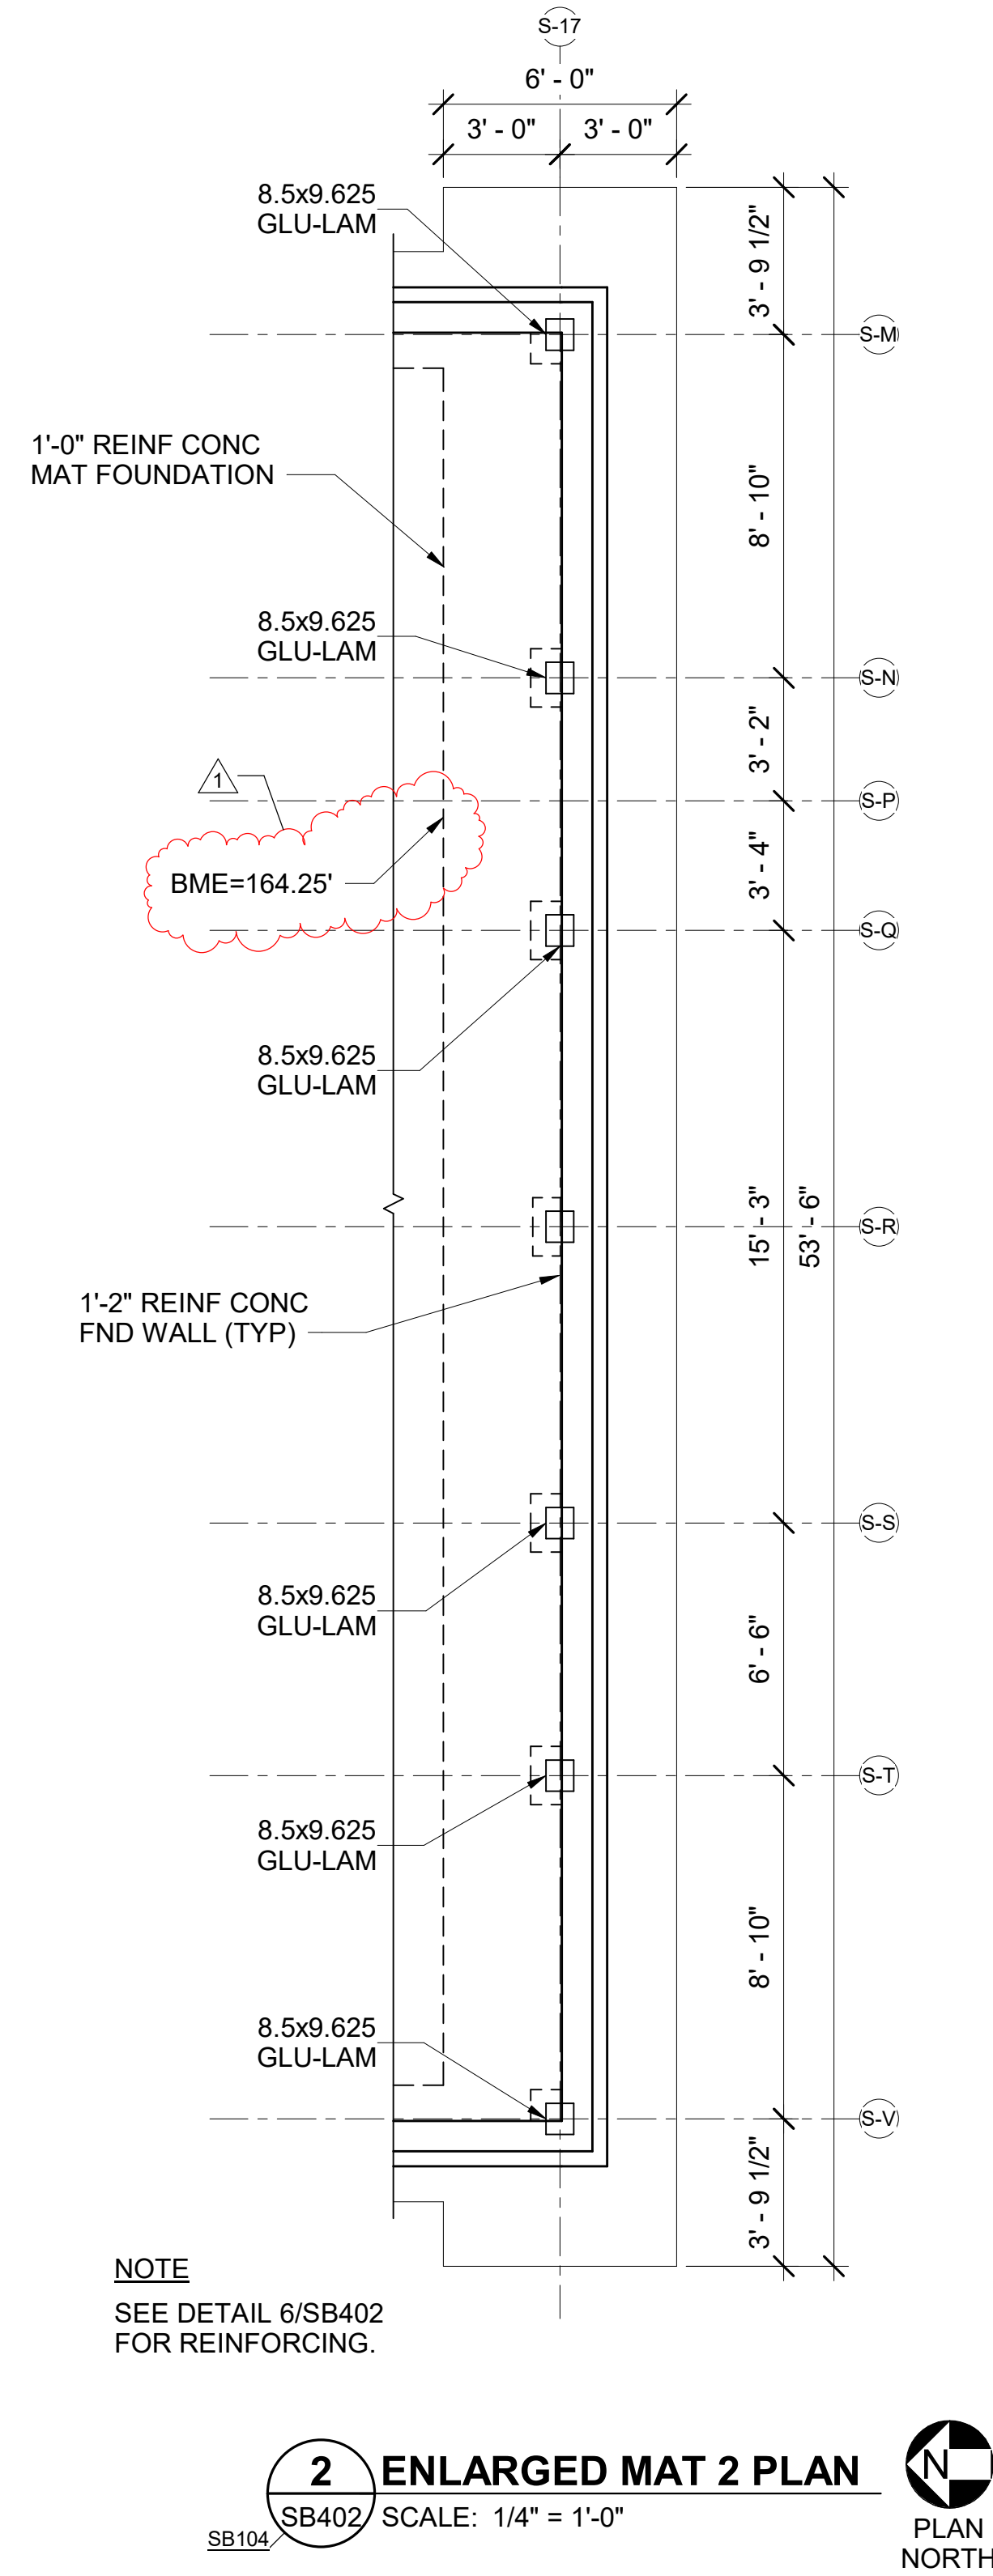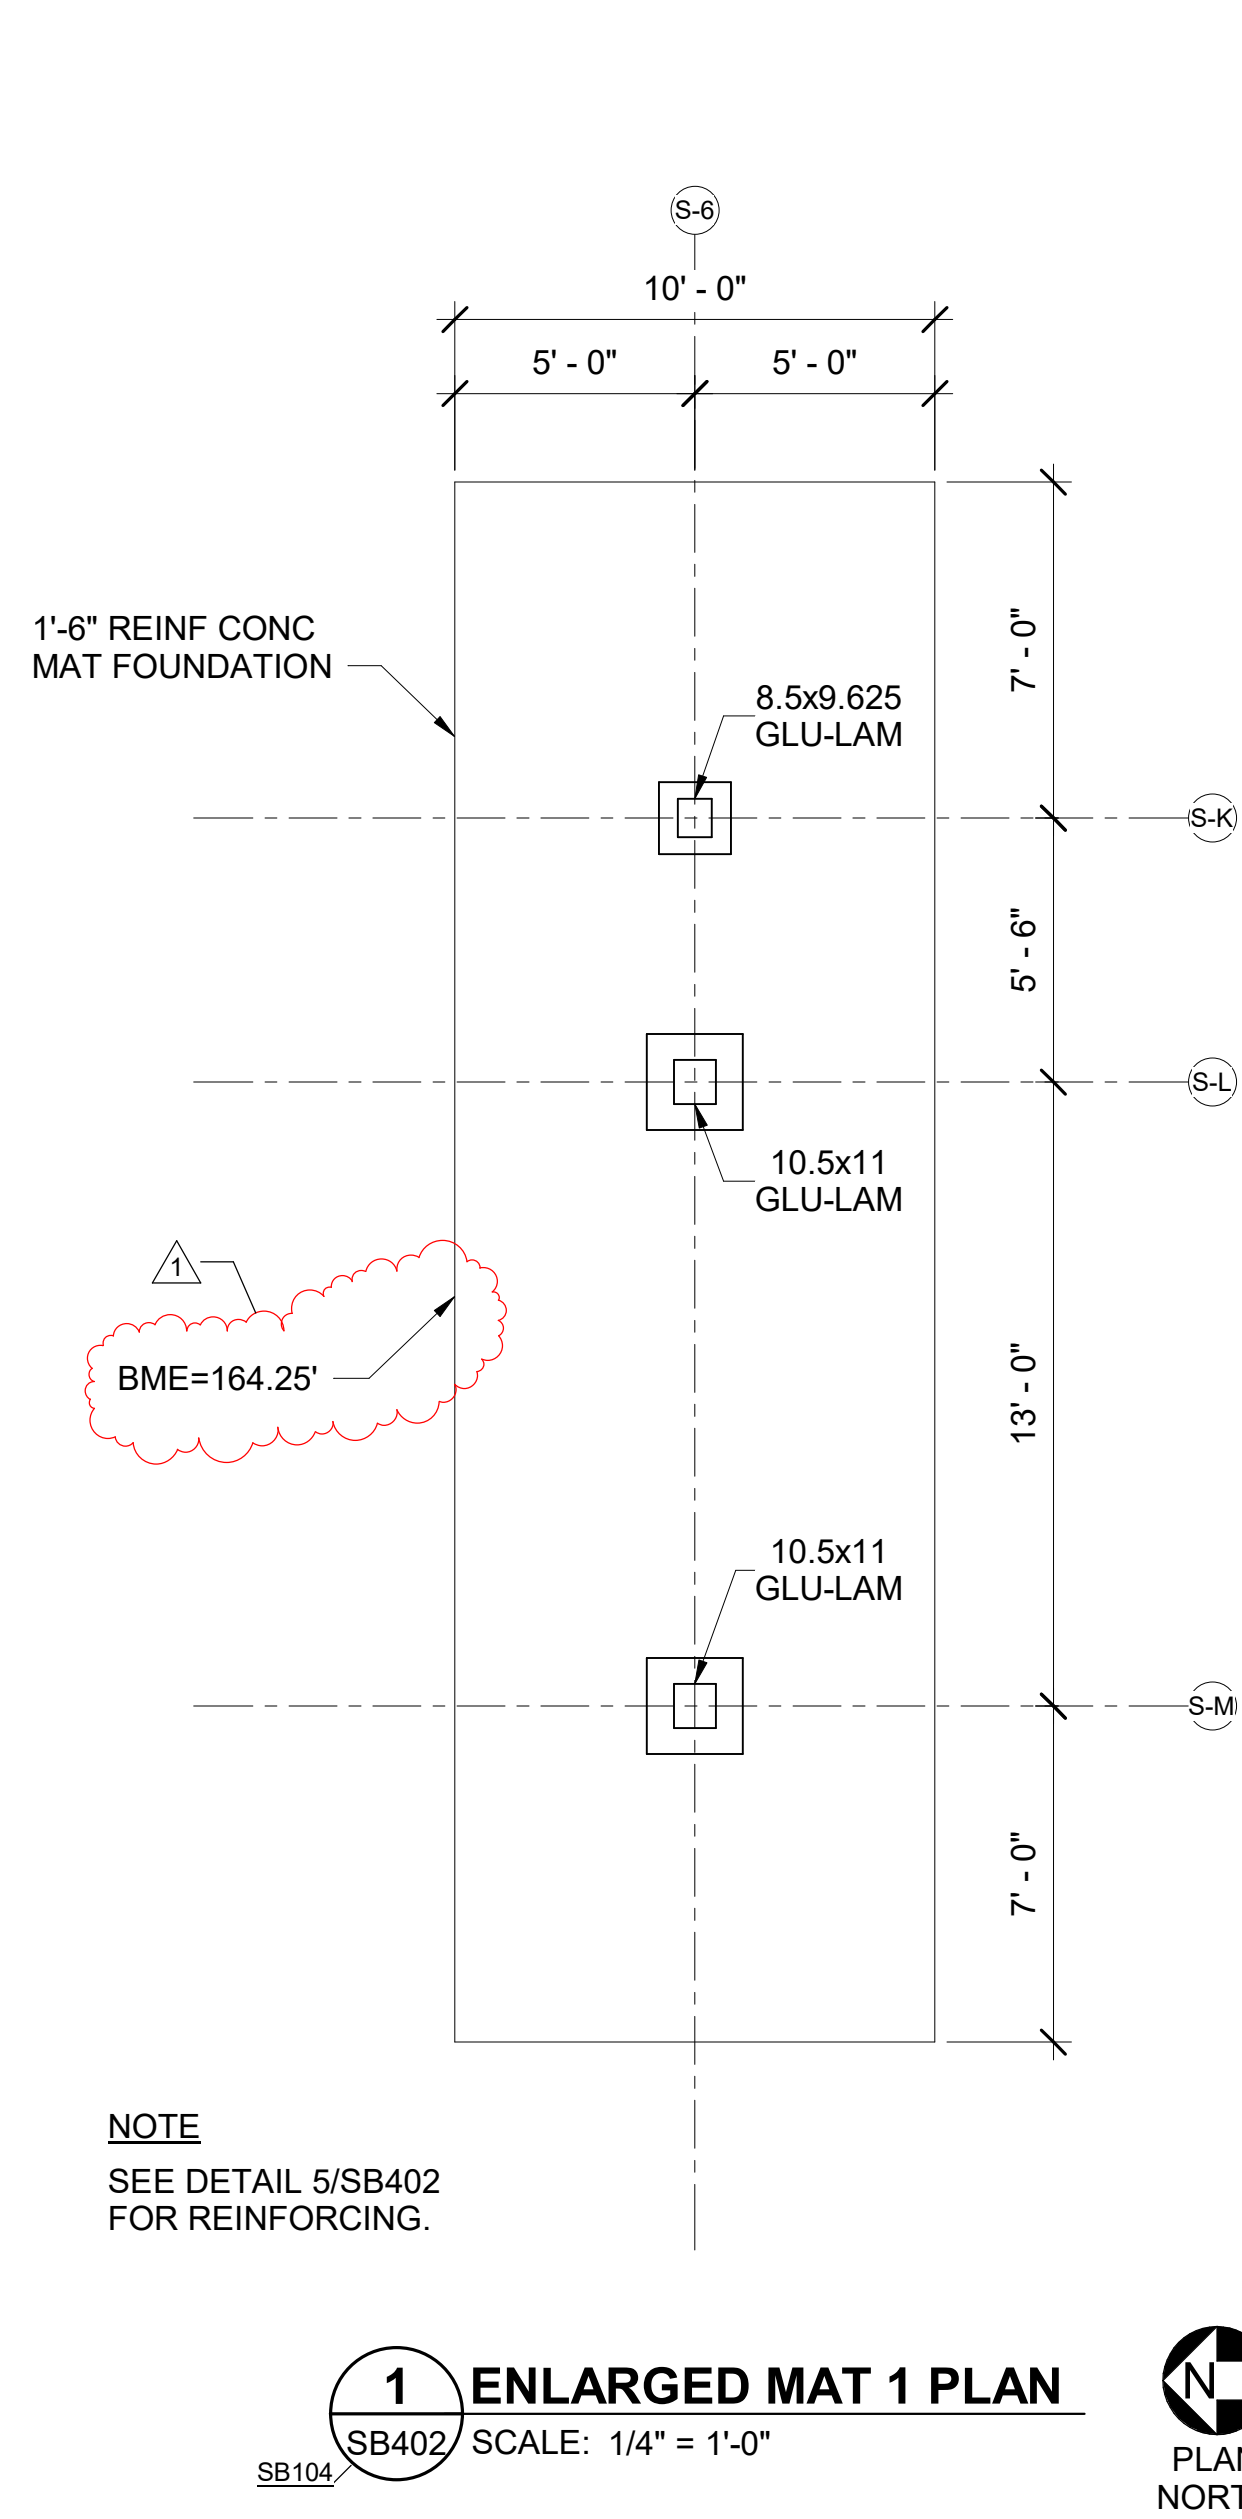

STATE OF MAINE DAVID N. MARTIN No. 9629 PROFESSIONAL ENGINEER				DEPARTMENT OF INLAND FISHERIES & WILDLIFE			
TITLE NEW OFFICE HEADQUARTERS				LOCATION AUGUSTA, ME			
DRAWN BY: MJC				CHECK BY: DNM			
DATE 03/13/2025				DATE 01/29/2025			
ADDENDUM NO. 6				DESCRIPTION			
NO.				REVISIONS			
1				207.283.9193			
OAK POINT ASSOCIATES				ARCHITECTURE • ENGINEERING • PLANNING			
231 Main Street, Biddeford, Maine 04005				207.283.9193			
DRAWING NO. SB402				SHEET NO. 58 OF 239			

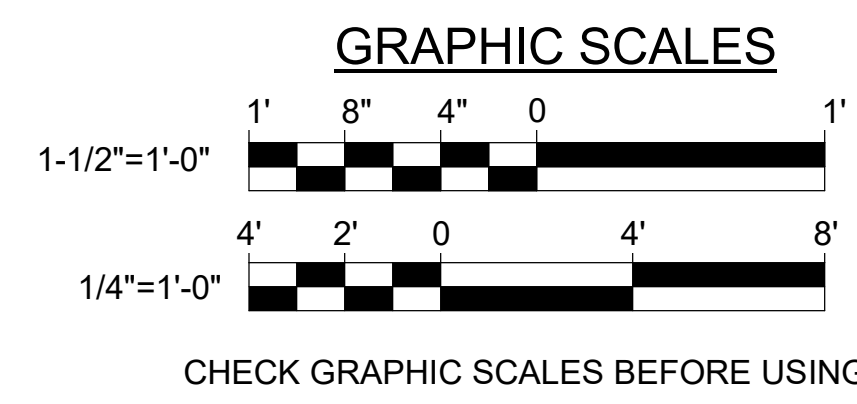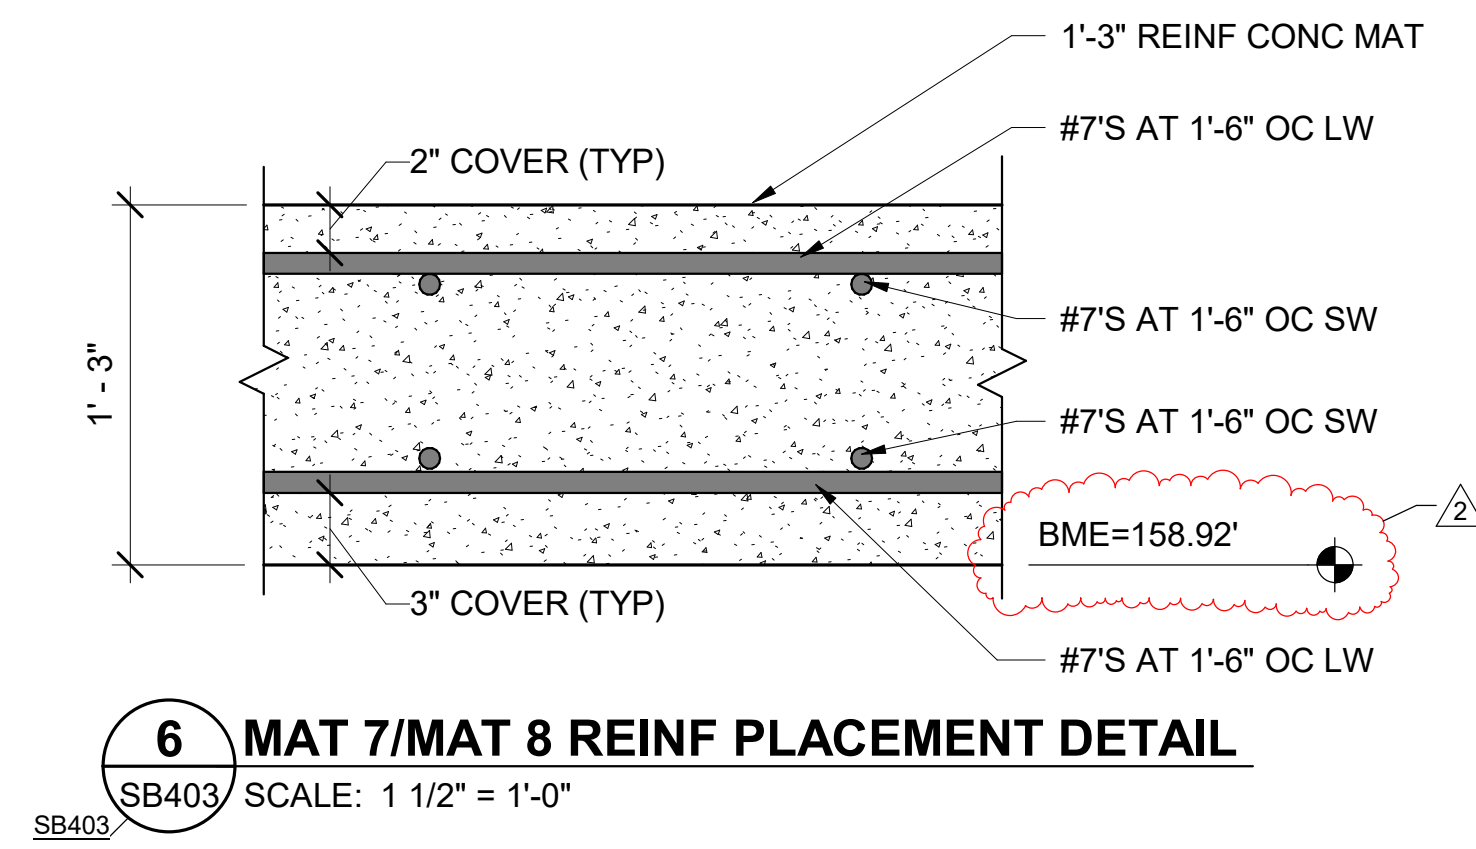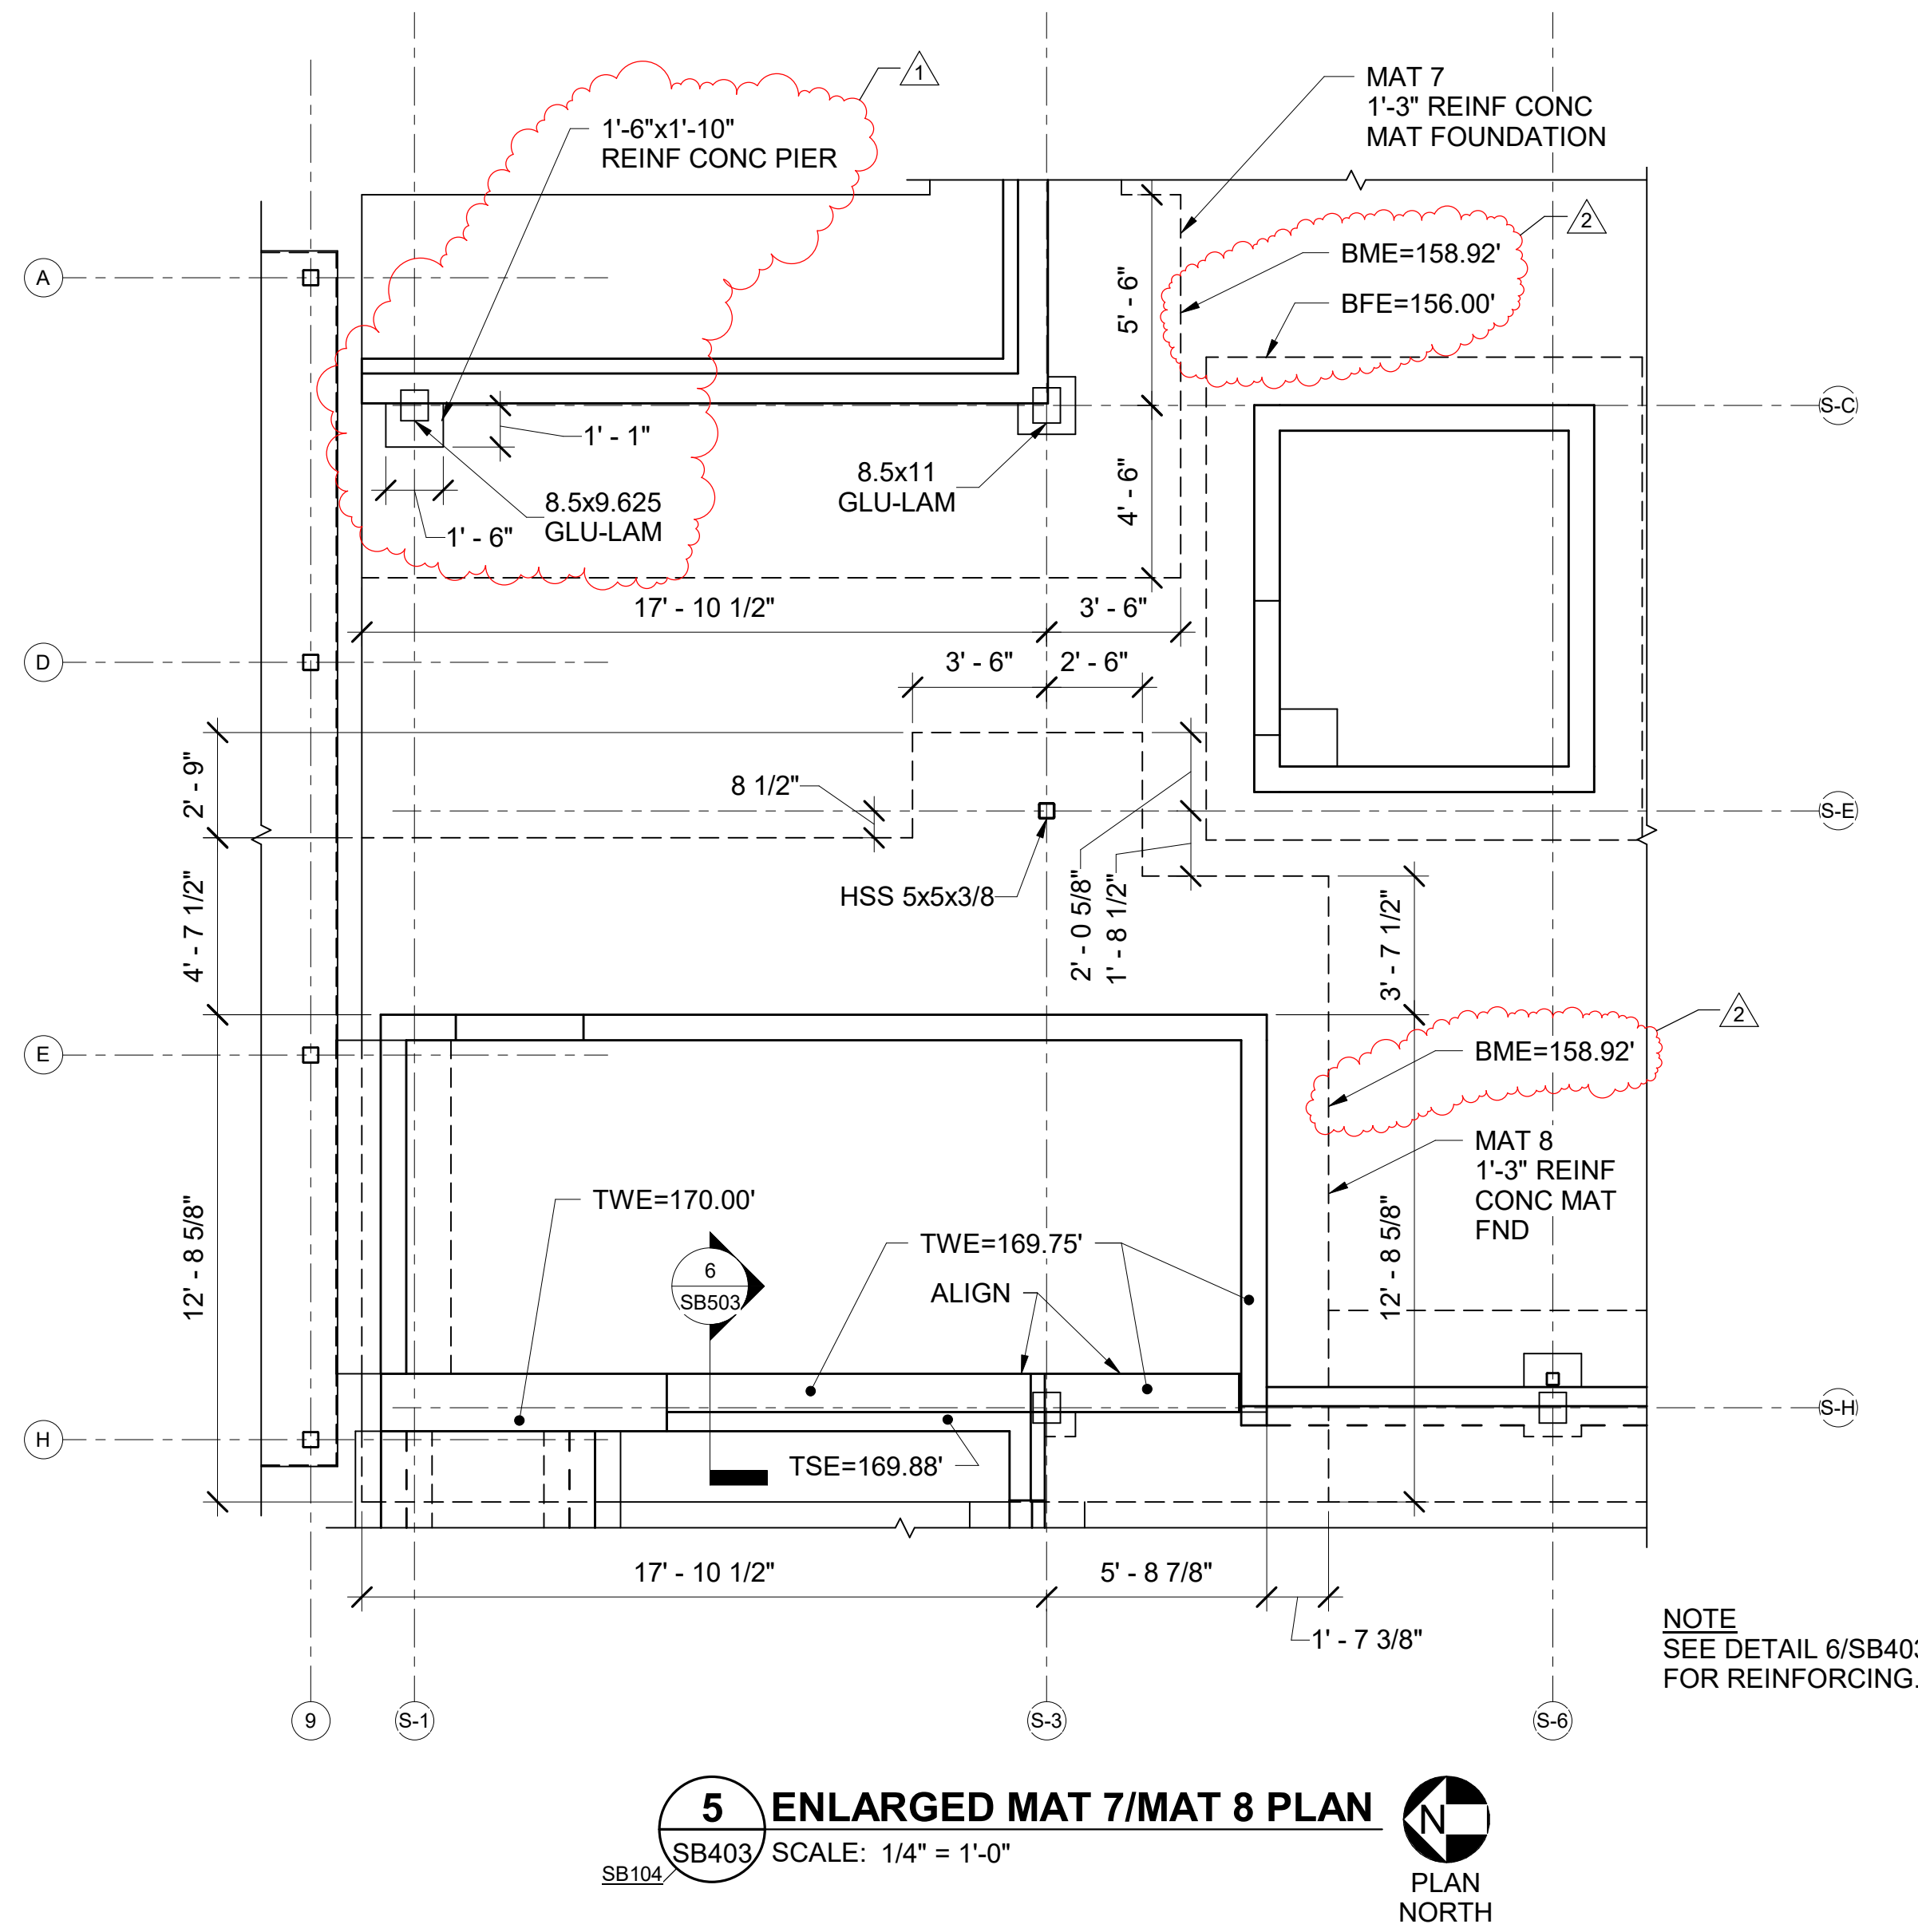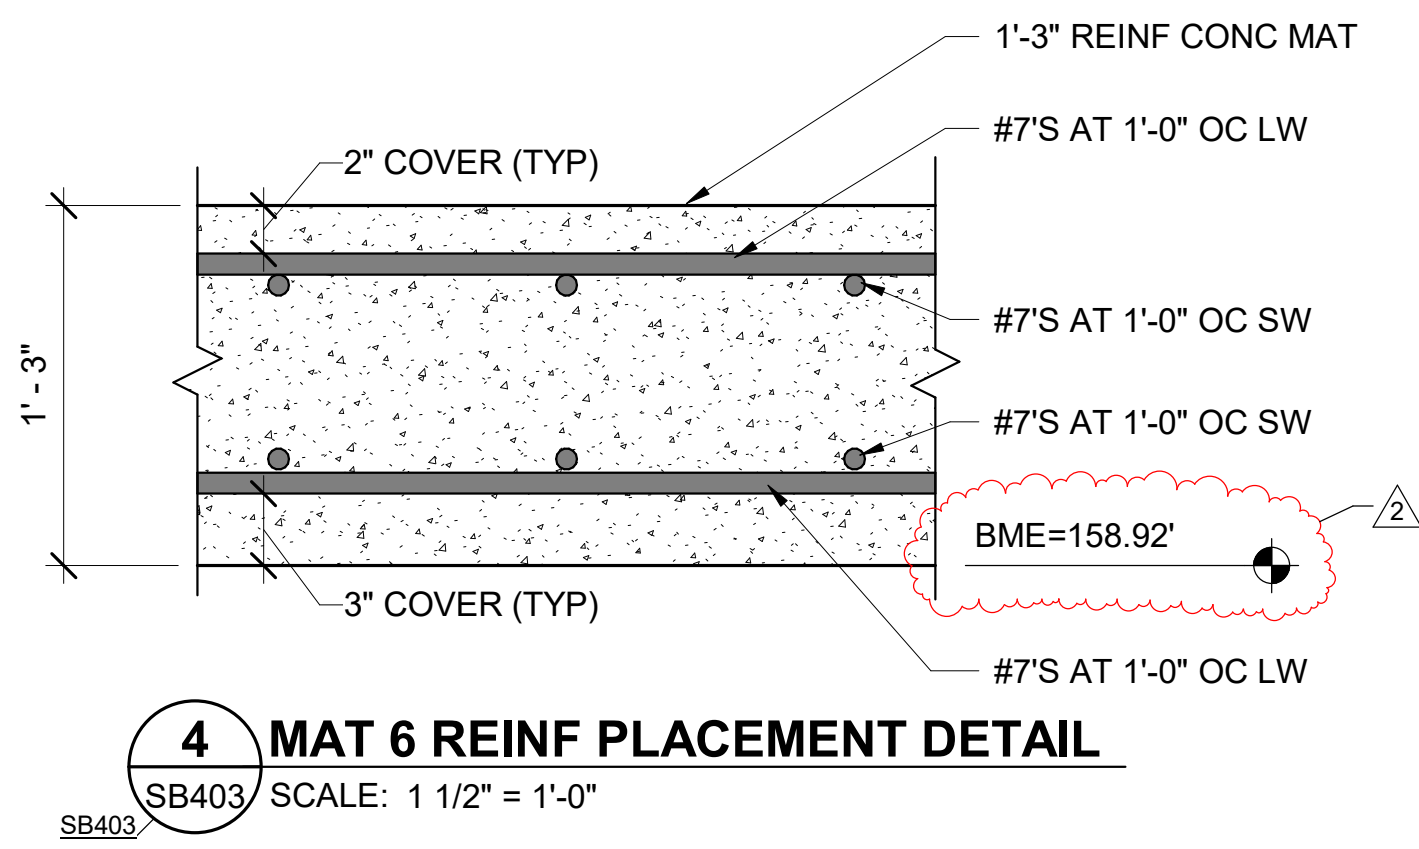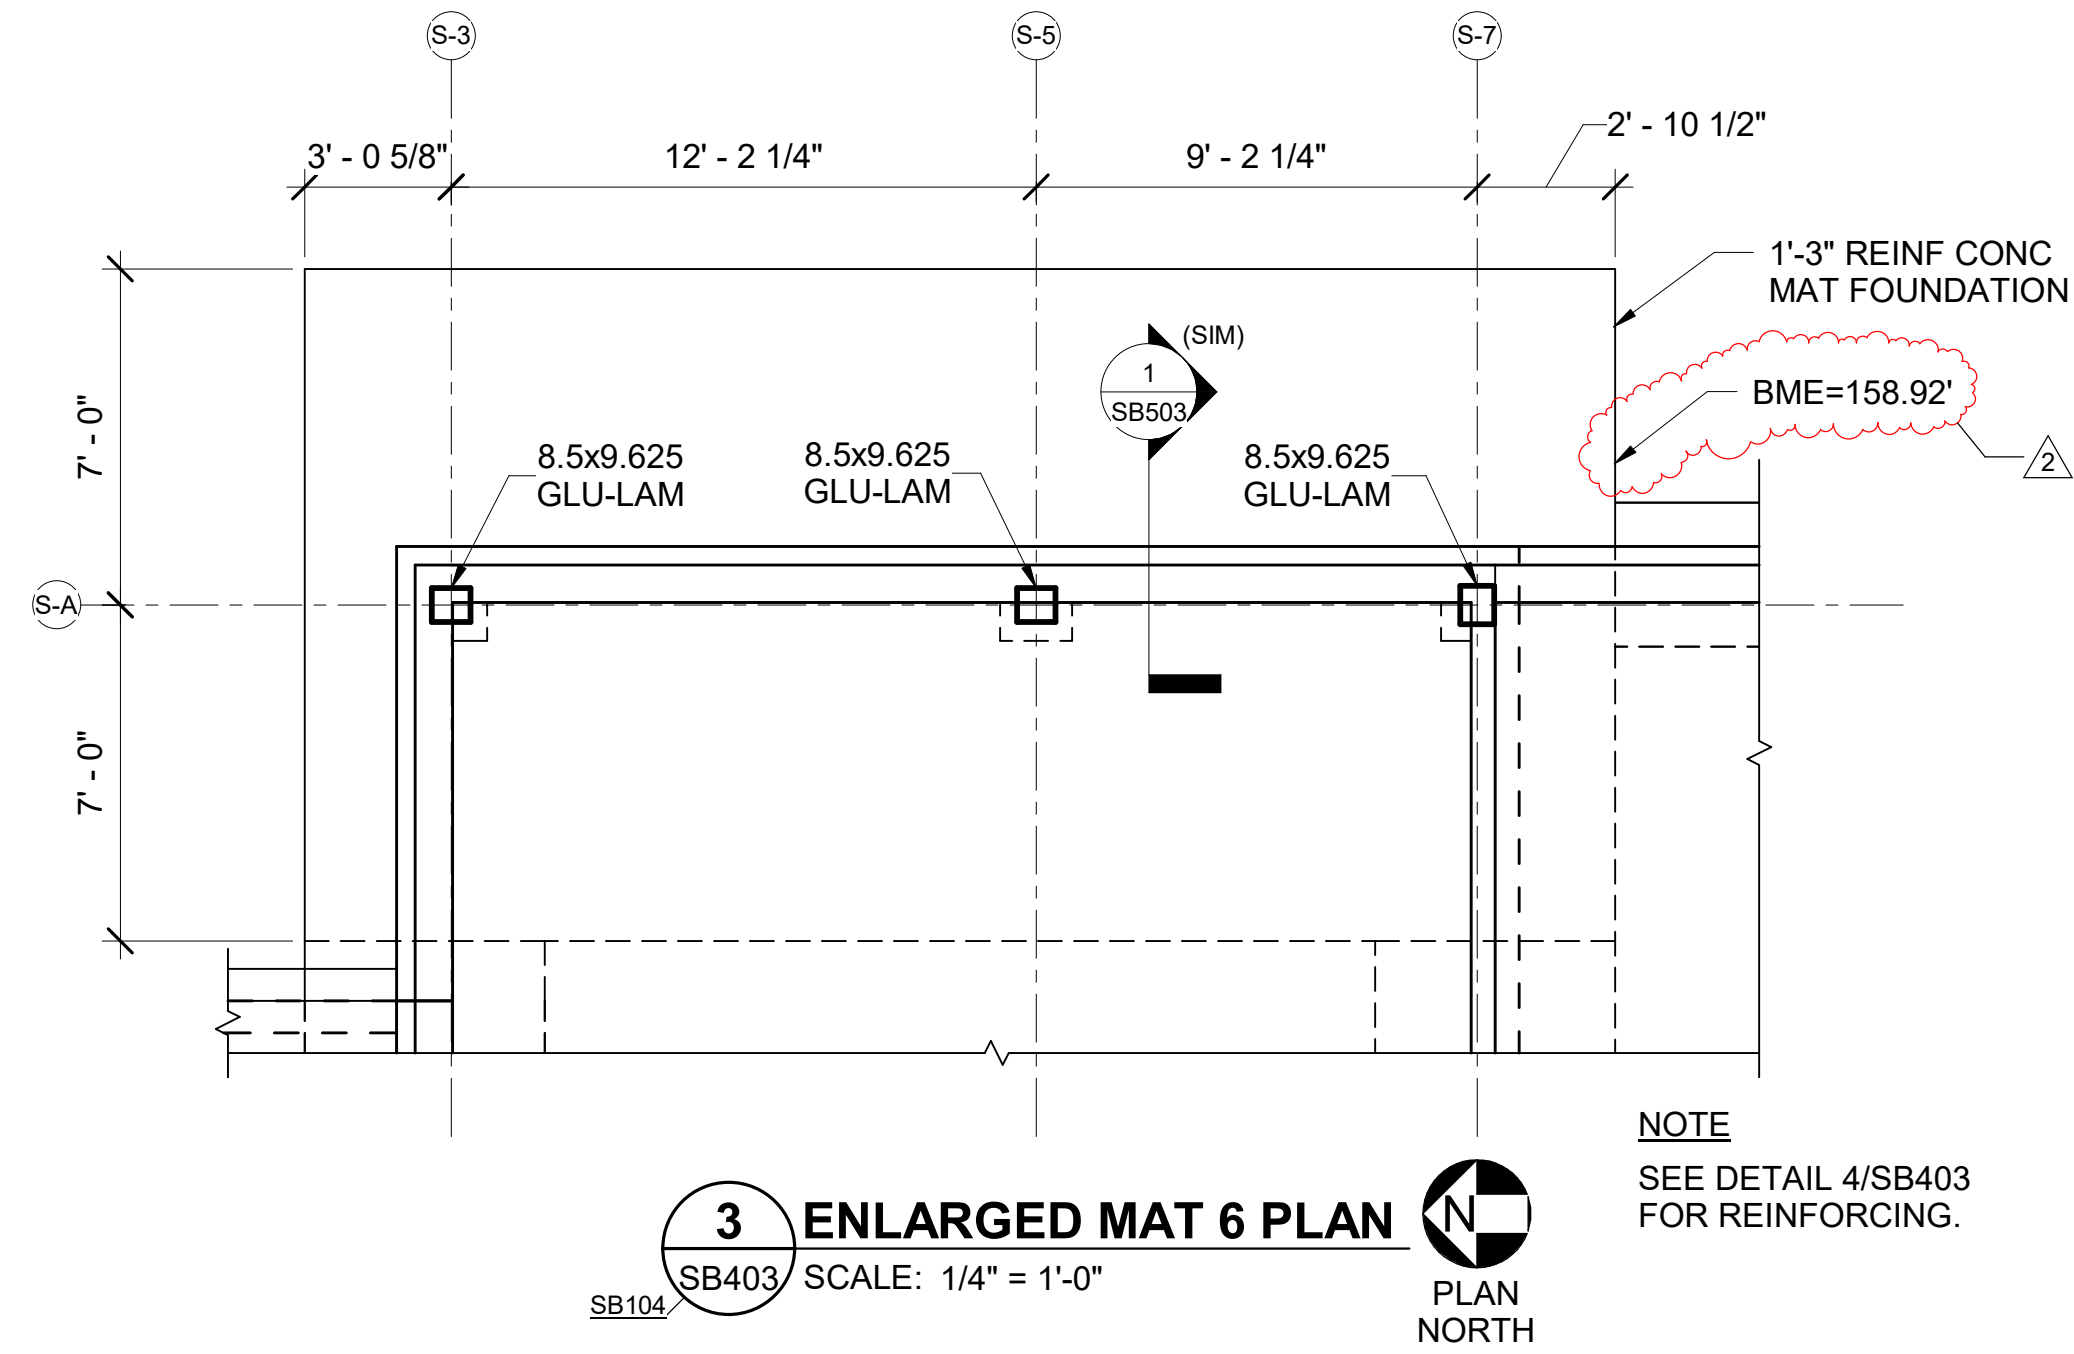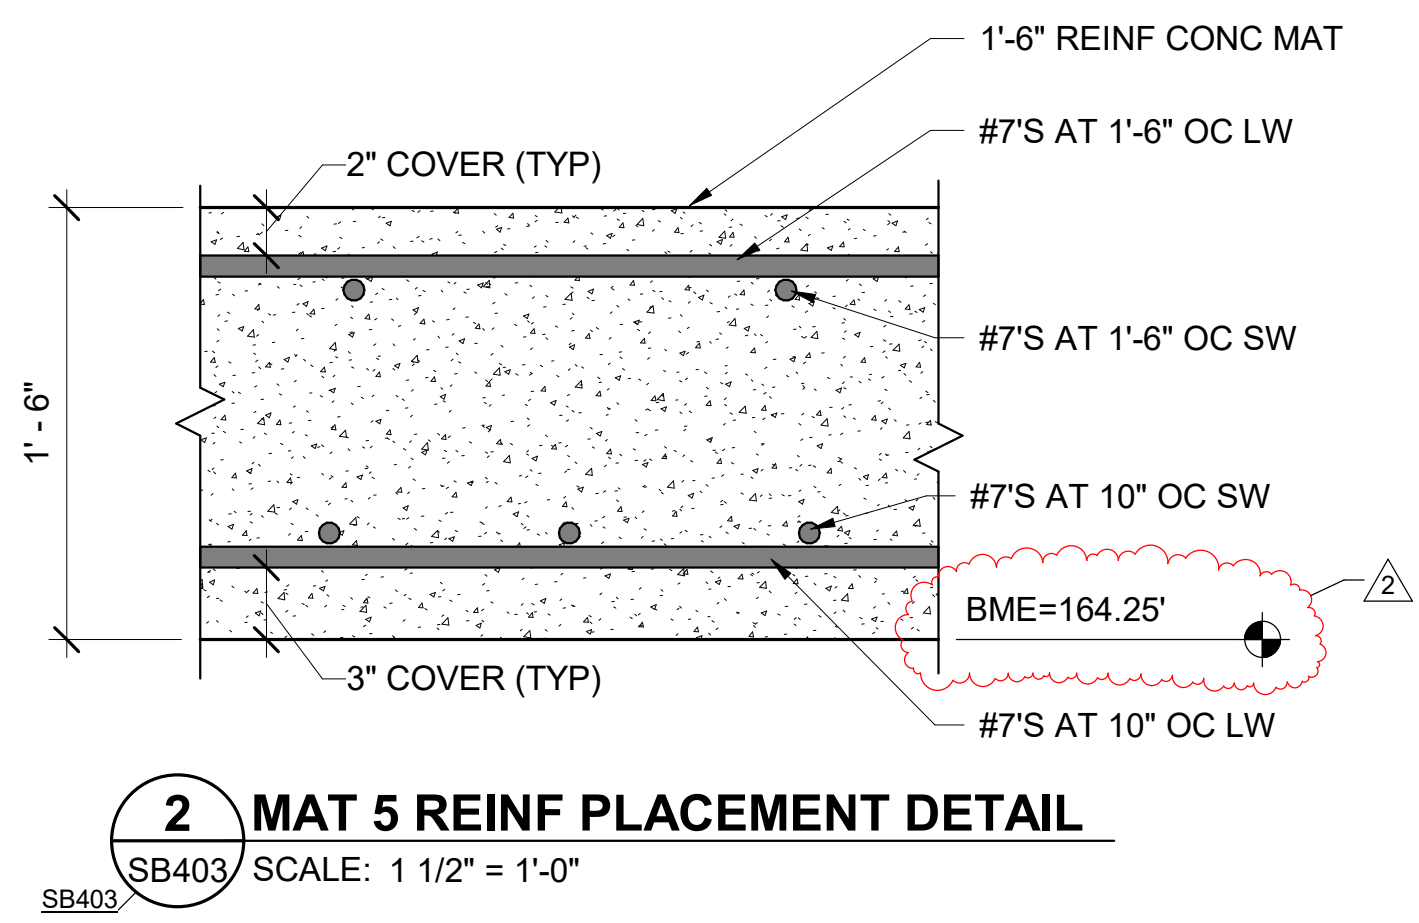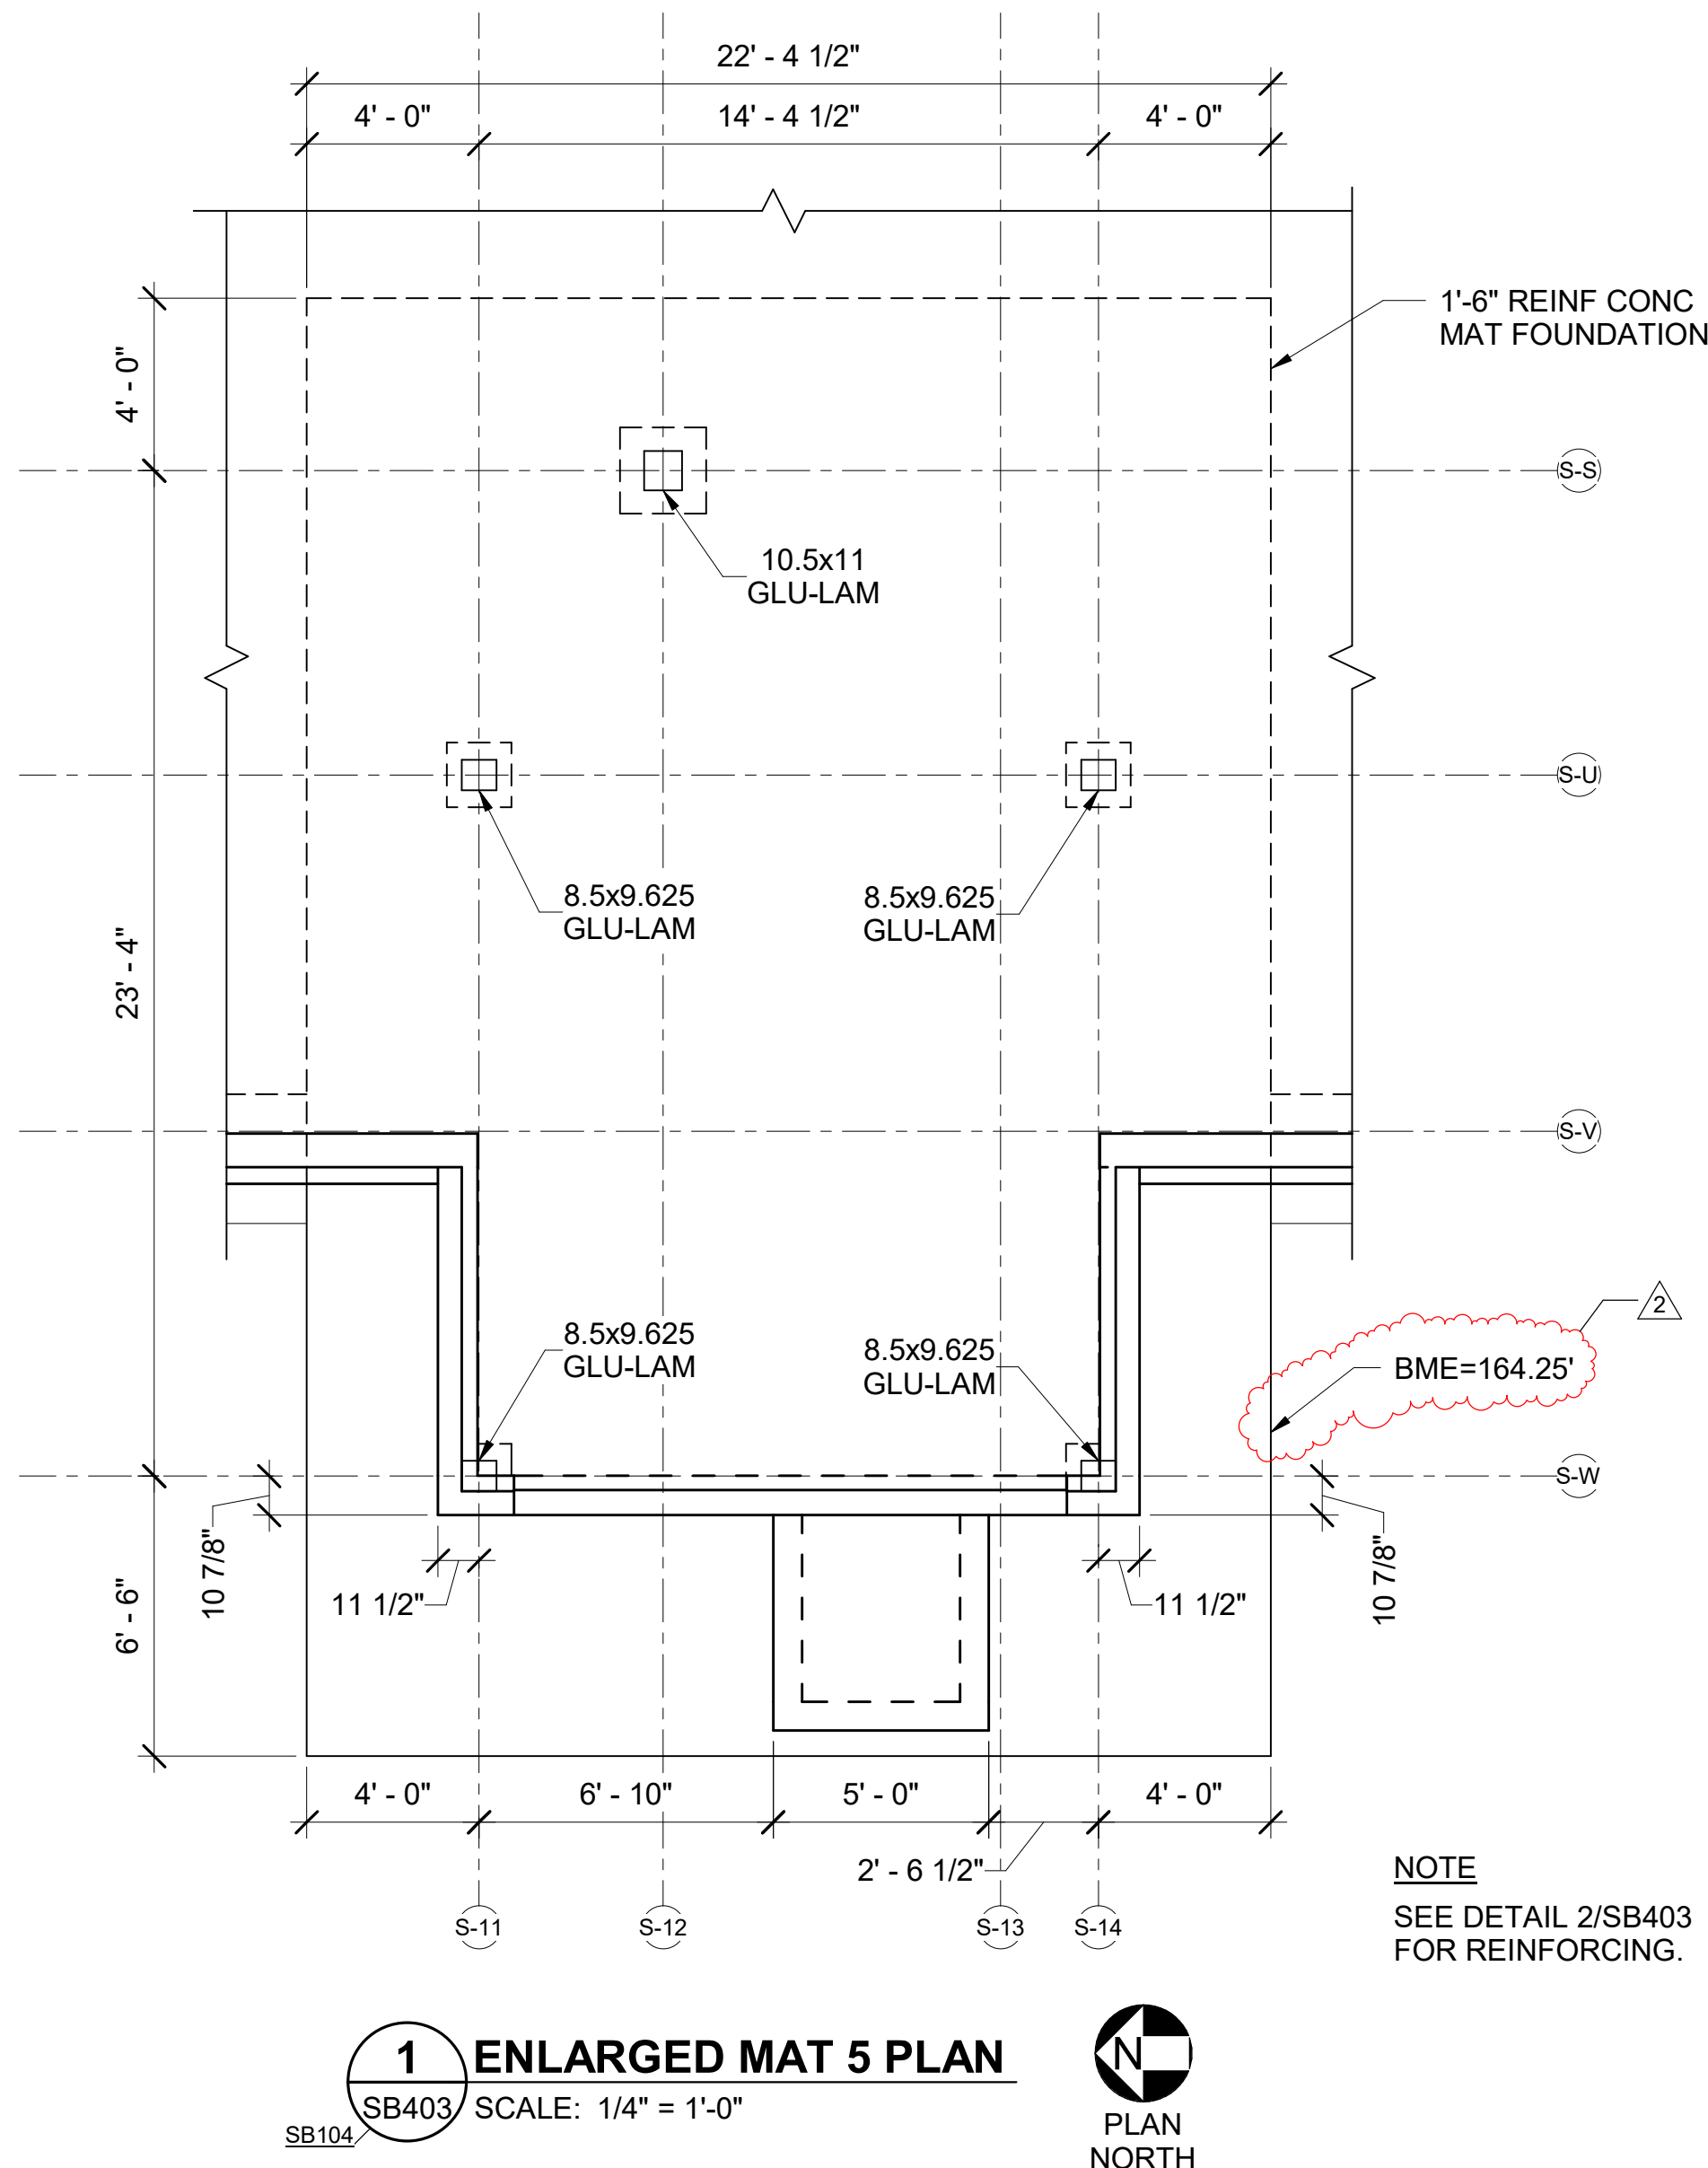

STATE OF MAINE DAVID N. MARTIN No. 9620 Professional Engineer				DEPARTMENT OF INLAND FISHERIES & WILDLIFE			
TITLE NEW OFFICE HEADQUARTERS				LOCATION AUGUSTA, ME			
TITLE THIS DWS ENLARGED MAT FOOTING PLANS 2				DRAWING NO. SB403			
DRAWN BY: MJC				OAK POINT ASSOCIATES			
CHECK BY: DNM				SHEET NO.			
NO.				DATE			
2				03/13/2025			
1				02/13/2025			
ADDENDUM NO. 6				ADDENDUM NO. 1			
DESCRIPTION				BY			
REVISIONS				DATE			
				01/29/2025			
				ARCHITECTURE • ENGINEERING • PLANNING			
				231 Main Street, Biddeford, Maine 04005			
				207.283.9193			
				59 OF 239			

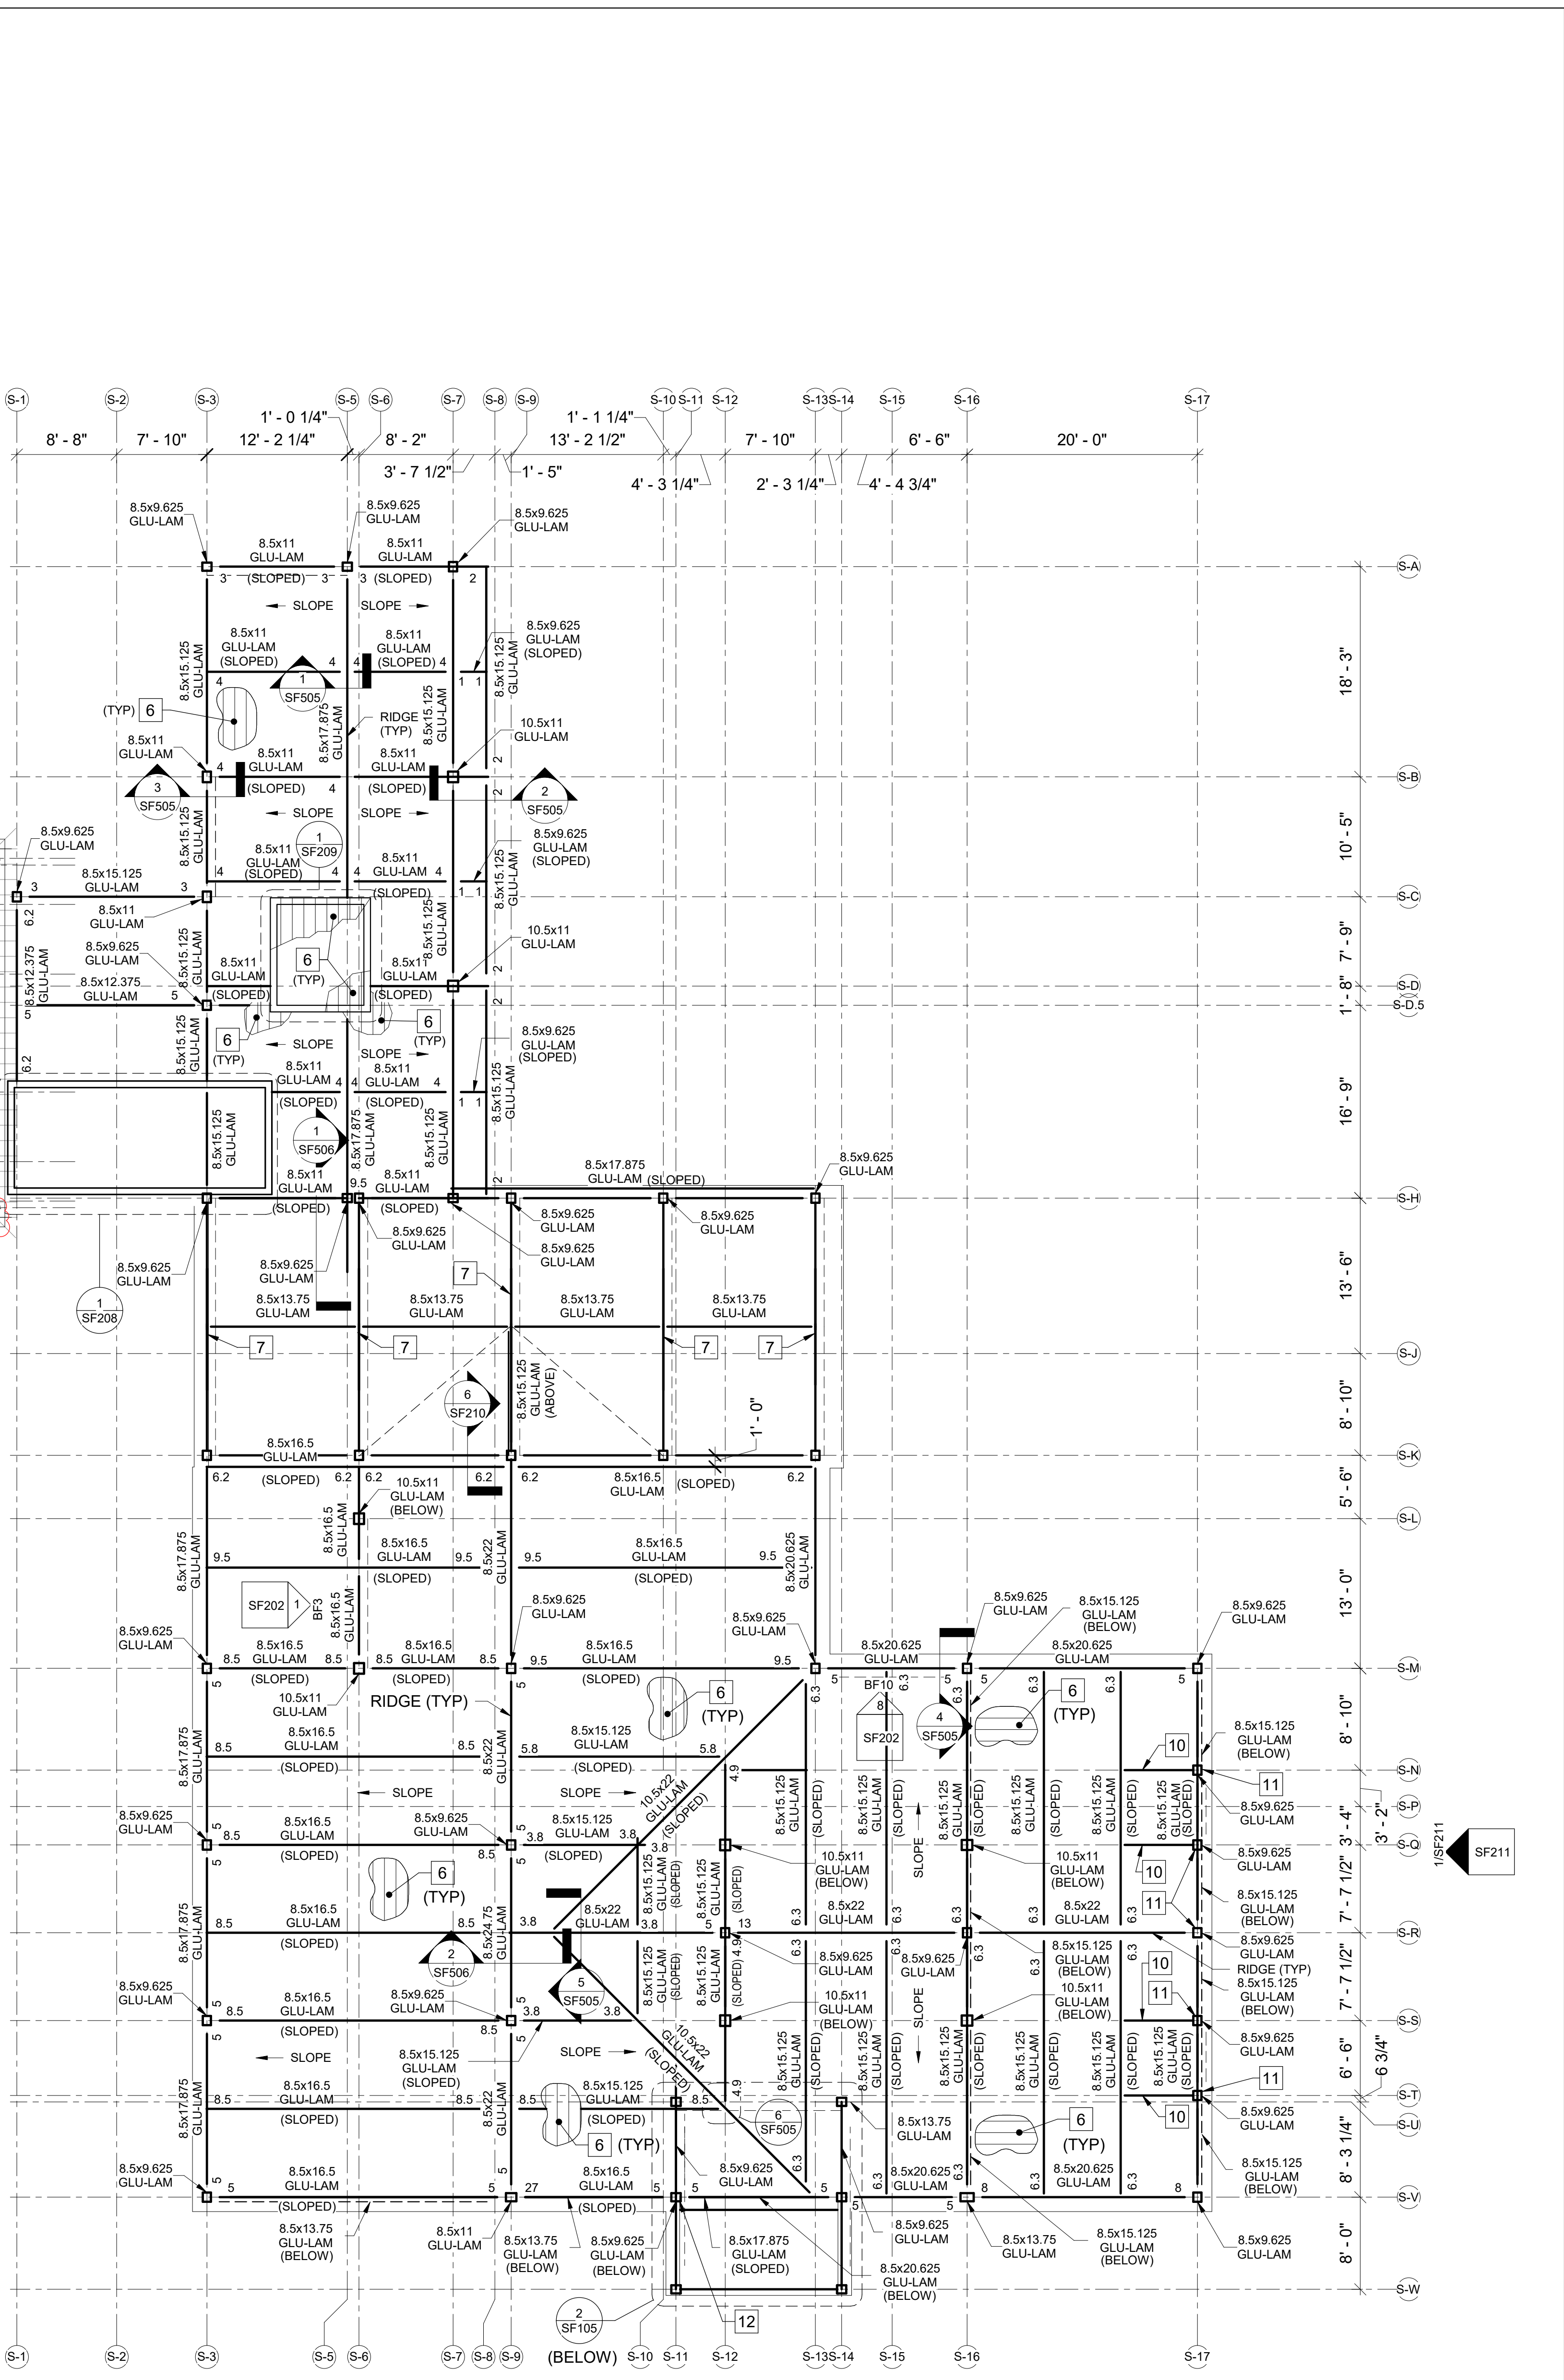

NOTE
TOP OF GLU-LAM ELEVATION = 197.83'
UNLESS NOTED OTHERWISE.

CHECK GRAPHIC SCALE BEFORE USING

GLU-LAM BRACED FRAME CONNECTION FORCES															
CONNECTION NO.	UPPER BRACE FORCES					LOWER BRACE FORCES					BEAM VERTICAL FORCES			BEAM AXIAL FORCES	
	DL	SL	LL	WL	EL	DL	SL	LL	WL	EL	DL	SL	LL	WL	EL
BF3-a	NA	NA	NA	NA	NA	3	4.8	0	17	70	1	1	0	3.9	16
BF3-b	3	4.8	0	17	70	5	4.8	5	19	80	5.8	0	6.2	-	-
BF3-c	5	4.8	5	19	80	NA	NA	NA	NA	NA	NA	NA	NA	NA	NA
BF4-a	NA	NA	NA	NA	NA	5	5.3	0	6.3	17.5	1	0	0	4.1	9.5
BF4-b	5	5.3	0	6.3	17.5	10.1	5.3	4.7	18.6	21.8	1.5	0	0	5	10
BF4-c	10.1	5.3	4.7	18.6	21.8	NA	NA	NA	NA	NA	NA	NA	NA	NA	NA
BF5-a	NA	NA	NA	NA	NA	5	5.3	0	6.3	17.5	1	0	0	4.1	9.5
BF5-b	5	5.3	0	6.3	17.5	10.1	5.3	4.7	18.6	21.8	1.5	0	0	5	10
BF5-c	10.1	5.3	4.7	18.6	21.8	NA	NA	NA	NA	NA	NA	NA	NA	NA	NA
BF6-a	NA	NA	NA	NA	NA	7.5	6.9	0	2.2	14.8	1	1	0	1.3	7.7
BF6-b	7.5	6.9	0	2.2	14.8	4.5	6.9	1	4.8	16	1	0	2	1.8	2
BF6-c	4.5	6.9	1	4.8	16	5	6.9	2	17.1	58.1	2	0	2	14.6	32
BF6-d	5	6.9	2	17.1	58.1	NA	NA	NA	NA	NA	NA	NA	NA	NA	NA
BF7-a	NA	NA	NA	NA	NA	2	2	0	26	81	1	1	0	2.6	8.1
BF7-b	2	2	0	26	8.1	2	2	0	6.3	26	2.4	2.5	1.0	5.1	22.2
BF7-c	2	2	0	6.3	26	2.5	2	2	26	53.4	3.3	0	1.5	14.5	25
BF7-d	2.5	2	2	26	53.4	NA	NA	NA	NA	NA	NA	NA	NA	NA	NA
BF8-a	NA	NA	NA	NA	NA	1	1	0	8.4	39.3	NA	NA	NA	NA	NA
BF8-b	1	1	0	8.4	39.3	NA	NA	NA	NA	NA	1.8	0	2	6	18.5
BF8-c	NA	NA	NA	NA	NA	6.6	1	3	17	50	1.8	0	2	6	18.5
BF8-d	6.6	1	3	17	50	NA	NA	NA	NA	NA	NA	NA	NA	NA	NA
BF9-a	NA	NA	NA	NA	NA										
BF9-b						NA	NA	NA	NA	NA	NA	NA	NA	NA	NA
BF10-a	NA	NA	NA	NA	NA	4.8	4.0	0.0	14	45	1.8	2.0	0.6	5.5	8.0
BF10-b	4.8	4.0	0.0	14	45	18.4	119	10.7	22.3	55	3.8	0.0	3.2	23	32
BF10-c	18.4	119	10.7	22.3	55	NA	NA	NA	NA	NA	NA	NA	NA	NA	NA
BF11-a	NA	NA	NA	NA	NA	2.6	1.8	0.0	3.6	25.4	1	1	0	1	6
BF11-b	2.6	1.8	0.0	3.6	25.4	1.0	1.8	0.6	15.4	32	1	0	2.7	2.2	7
BF11-c	1.0	1.8	0.6	15.4	32	5	1.8	3.5	27	45	2.0	0	18	3	8
BF11-d	5	1.8	3.5	27	45	NA	NA	NA	NA	NA	NA	NA	NA	NA	NA
BF12-a	NA	NA	NA	NA	NA	0.5	0.9	0.0	2.7	14.6	1	14	0	1	6.2
BF12-b	0.5	0.9	0.0	2.7	14.6	1.2	1.1	1	9.7	41	3.8	0	8.8	1.5	4.0
BF12-c	1.2	1.1	1	9.7	41	3.0	1.1	2.4	18	44	2.8	0	2.8	0.8	1.0
BF12-d	3.0	1.1	2.4	18	44	NA	NA	NA	NA	NA	NA	NA	NA	NA	NA

LRFD DESIGN LOAD COMBINATIONS

LC1: 1.2DL+1.6LL+0.5SL
LC2: 1.2DL+1.6SL+0.5WL
LC3: 1.2DL+0.5LL+1.0WL
LC4: 0.9DL+10WL
LC5: (1.2+0.2Sds)DL+0.5LL+0.2SL+1.0EL
LC6: (0.9+0.2Sds)DL+1.0EL
Sds=0.257g

ASD LOAD COMBINATIONS



LC1: 1.0DL+1.0EL
LC2: 1.0DL+0.75LL+0.75SL+0.45WL
LC3: 1.0DL+0.6WL
LC4: (1.0+14Sds)DL+0.75LL+0.53EL
LC5: (0.8+0.14Sds)DL+0.70EL
Sds=0.257g


NOTES

- BRACE FORCES CAN ACT IN COMPRESSION OR TENSION.
- BRACE FORCE IS FACTORED FORCE BASED ON 1.0W AND 1.0EL.
- BEAM VERTICAL REACTIONS ARE SERVICE LEVEL FORCES.
- DESIGN PLATES AT INTERSECTING BRACE MEMBERS FOR BRACE AXIAL FORCE.
- FORCES GIVEN ARE IN KIPS.
- CONNECTIONS MAY BE DESIGNED USING EITHER LRFD OR ASD.
- COLUMN BASE PLATES, ANCHOR RODS, AND COLUMN TO BASE PLATE CONNECTION HAVE BEEN DESIGNED FOR THE BRACE FRAME FORCES.
- DESIGN CONNECTION OF BRACE TO COLUMN BASE PLATES AND INTEGRATE WITH THE DESIGN OF THE COLUMN TO BASE PLATE CONNECTION.

DESIGN CRITERIA


- DESIGN INTENT IS FOR THE USE OF CONCEALED KNIFE PLATE CONNECTIONS.
- EXPOSED STEEL WOULD BE ACCEPTABLE AT THE ENDS OF BRACES SUCH AS BUILT-UP T OR ROLLED SECTION WITH THE STEM CONCEALED IN HTE BRACE AND THE FLANGE EXPOSED.
- SMALLER DIAMETER MECHANICAL FASTENERS, DIAMETER LESS THAN OR EQUAL TO 3/8", ARE PREFERRED. LARGER DIAMETER FASTENERS ARE ACCEPTABLE IF IT IS DETERMINED THAT SMALLER DIAMETER FASTENERS WOULD NOT HAVE SUFFICIENT CAPACITY.
- COUNTERSINK HEADS OF EXPOSED FASTENERS AT ALL CONNECTIONS.
- COMPLY WITH APPENDIX E OF NATIONAL DESIGN SPECIFICATION FOR WOOD CONSTRUCTION FOR NET SECTION TENSION CAPACITY, ROW TEAR OUT CAPACITY, AND GROUP TEAR OUT CAPACITY. NOTIFY STRUCTURAL ENGINEER OF RECORD IF CALCULATIONS INDICATE THAT ANY MEMBER WOULD NOT HAVE SUFFICIENT CAPACITY FOFR THE IMPOSED FORCES.

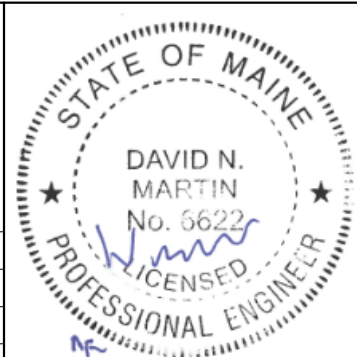						DEPARTMENT OF INLAND FISHERIES & WILDLIFE	
						TITLE NEW OFFICE HEADQUARTERS	
						LOCATION AUGUSTA, ME	
						TITLE THIS DWG. GLU-LAM BRACED FRAME CONNECTION FORCES SCHEDULE	
						 DRAWING NO. SF204	
						SHEET NO.	
						ARCHITECTURE • ENGINEERING • PLANNING	
2 03/13/2025 ADDENDUM NO. 6 DNM				DRAWN BY: MJC		231 Main Street, Biddeford, Maine 04005	
1 02/28/2025 ADDENDUM NO. 3 DNM				CHECK BY: DNM		207.283.9193	
NO. DATE DESCRIPTION BY NO.				DATE 01/29/2025		76 OF 239	

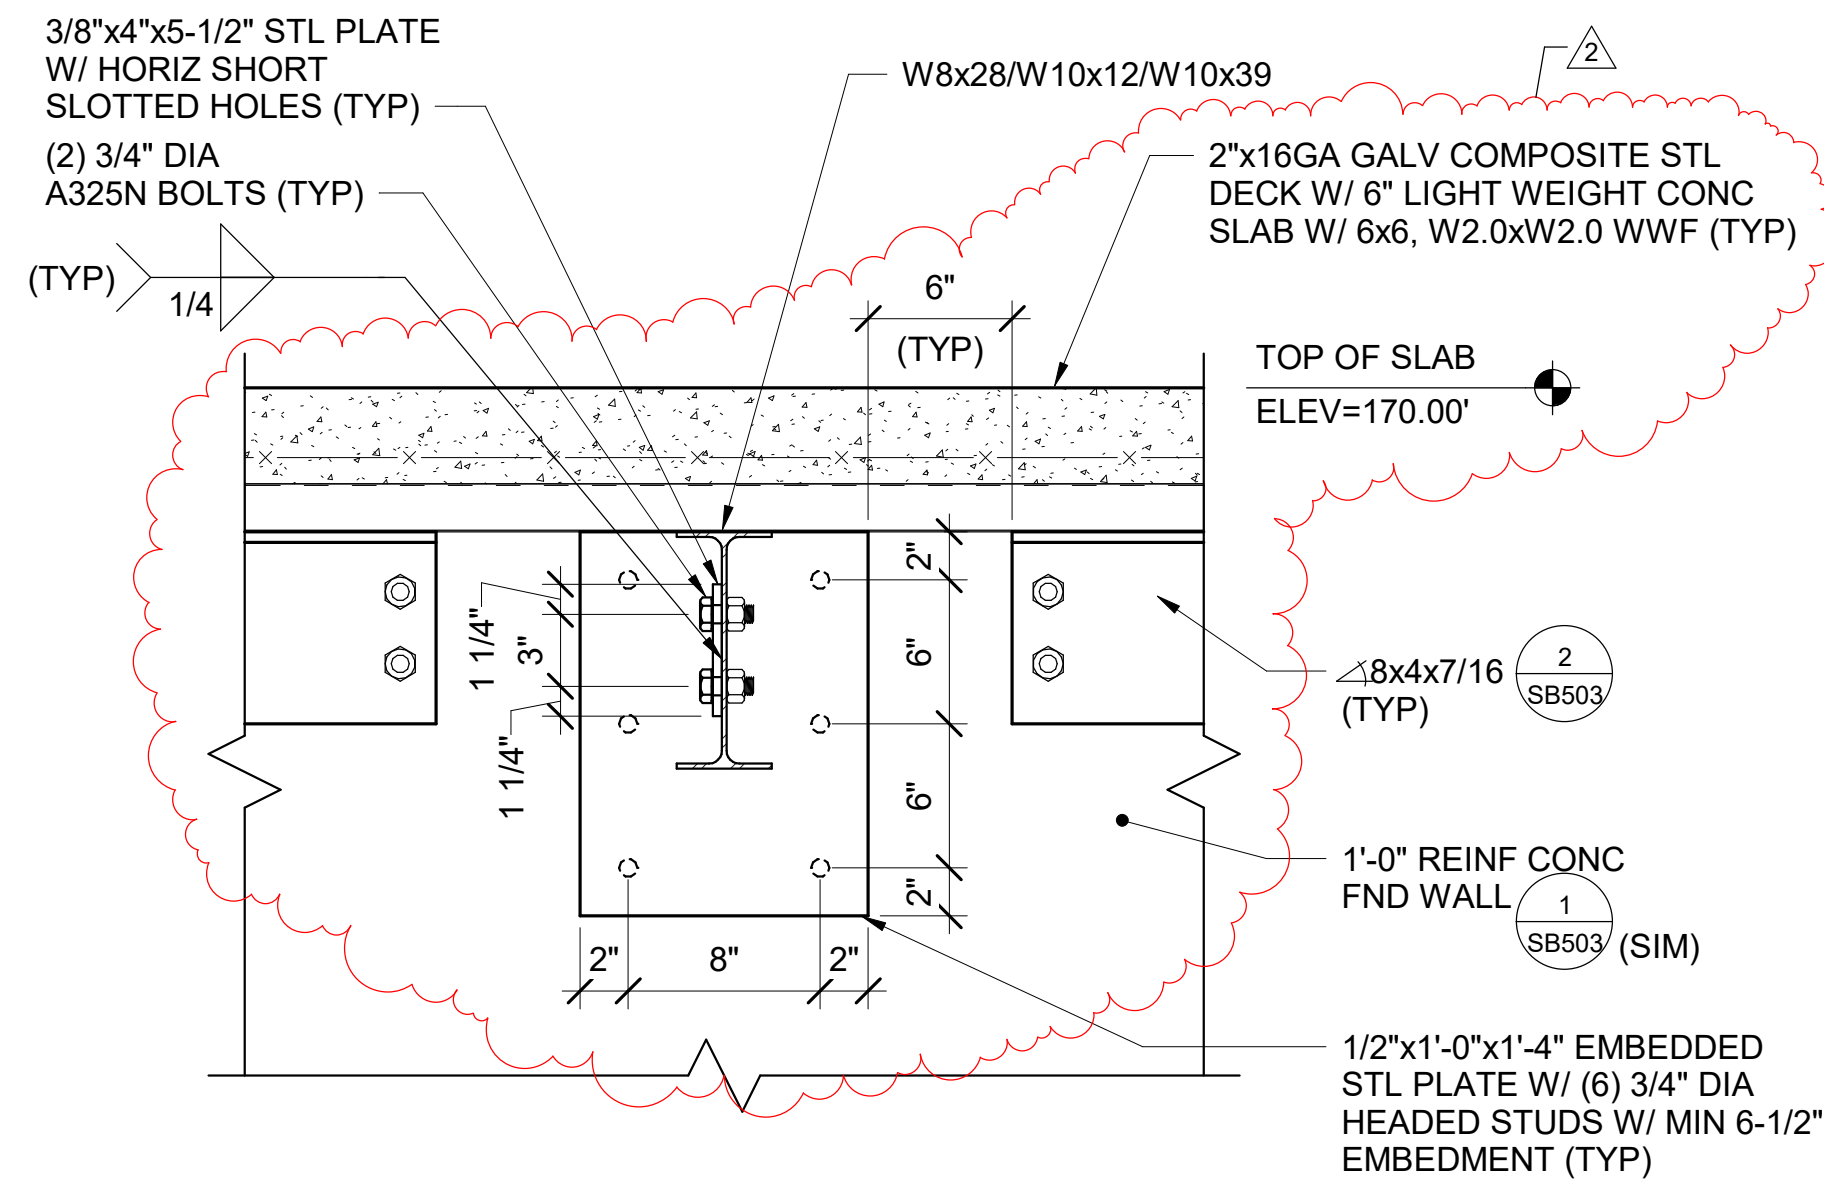


1 W8x28/W10x12/W10x39 EMBEDDED STEEL PLATE DETAIL

SF504/ SCALE: 1 1/2" = 1'-0"

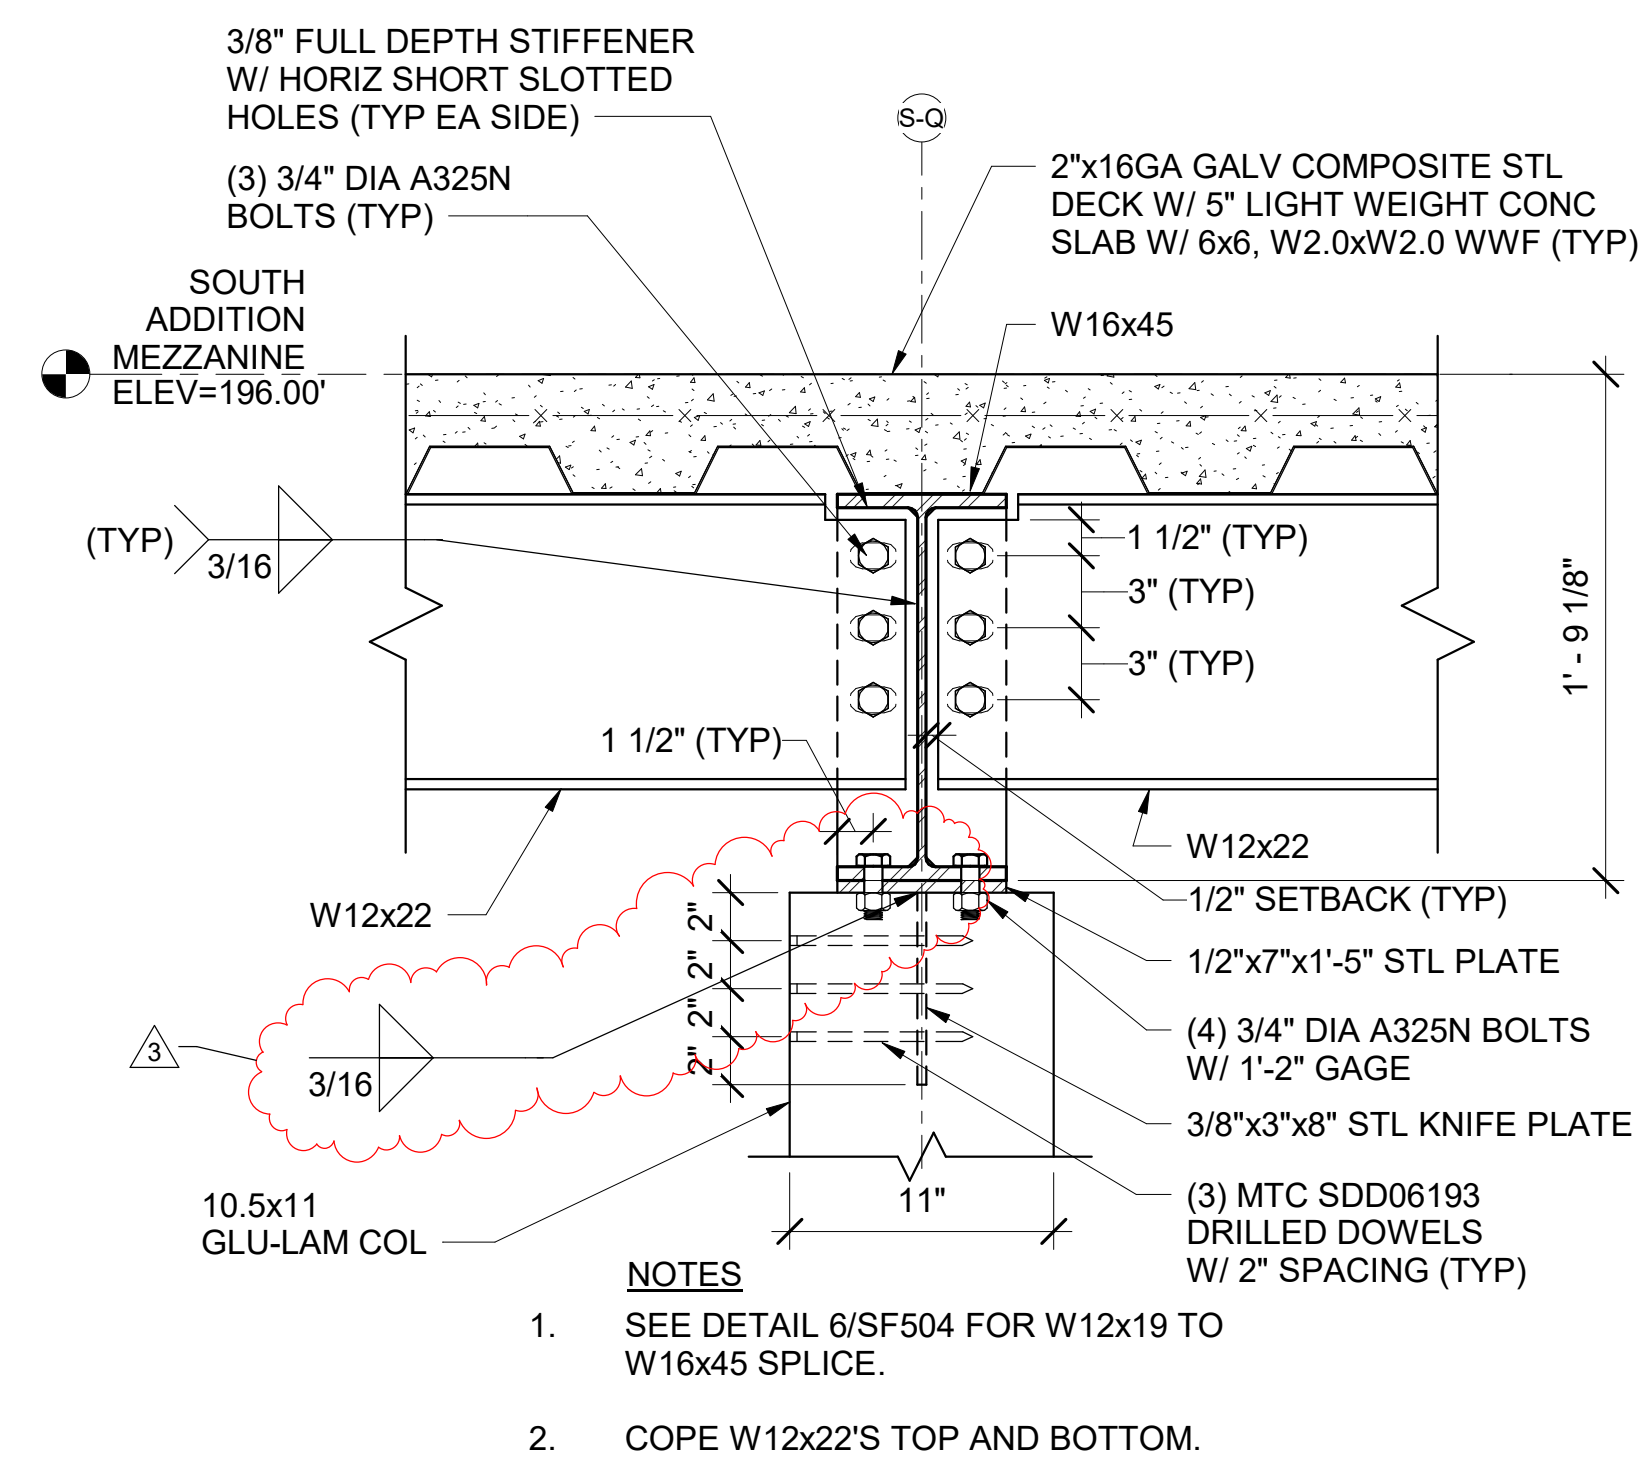


2 W12x35/W14x22 EMBEDDED STEEL PLATE DETAIL

SF504/ SCALE: 1 1/2" = 1'-0"

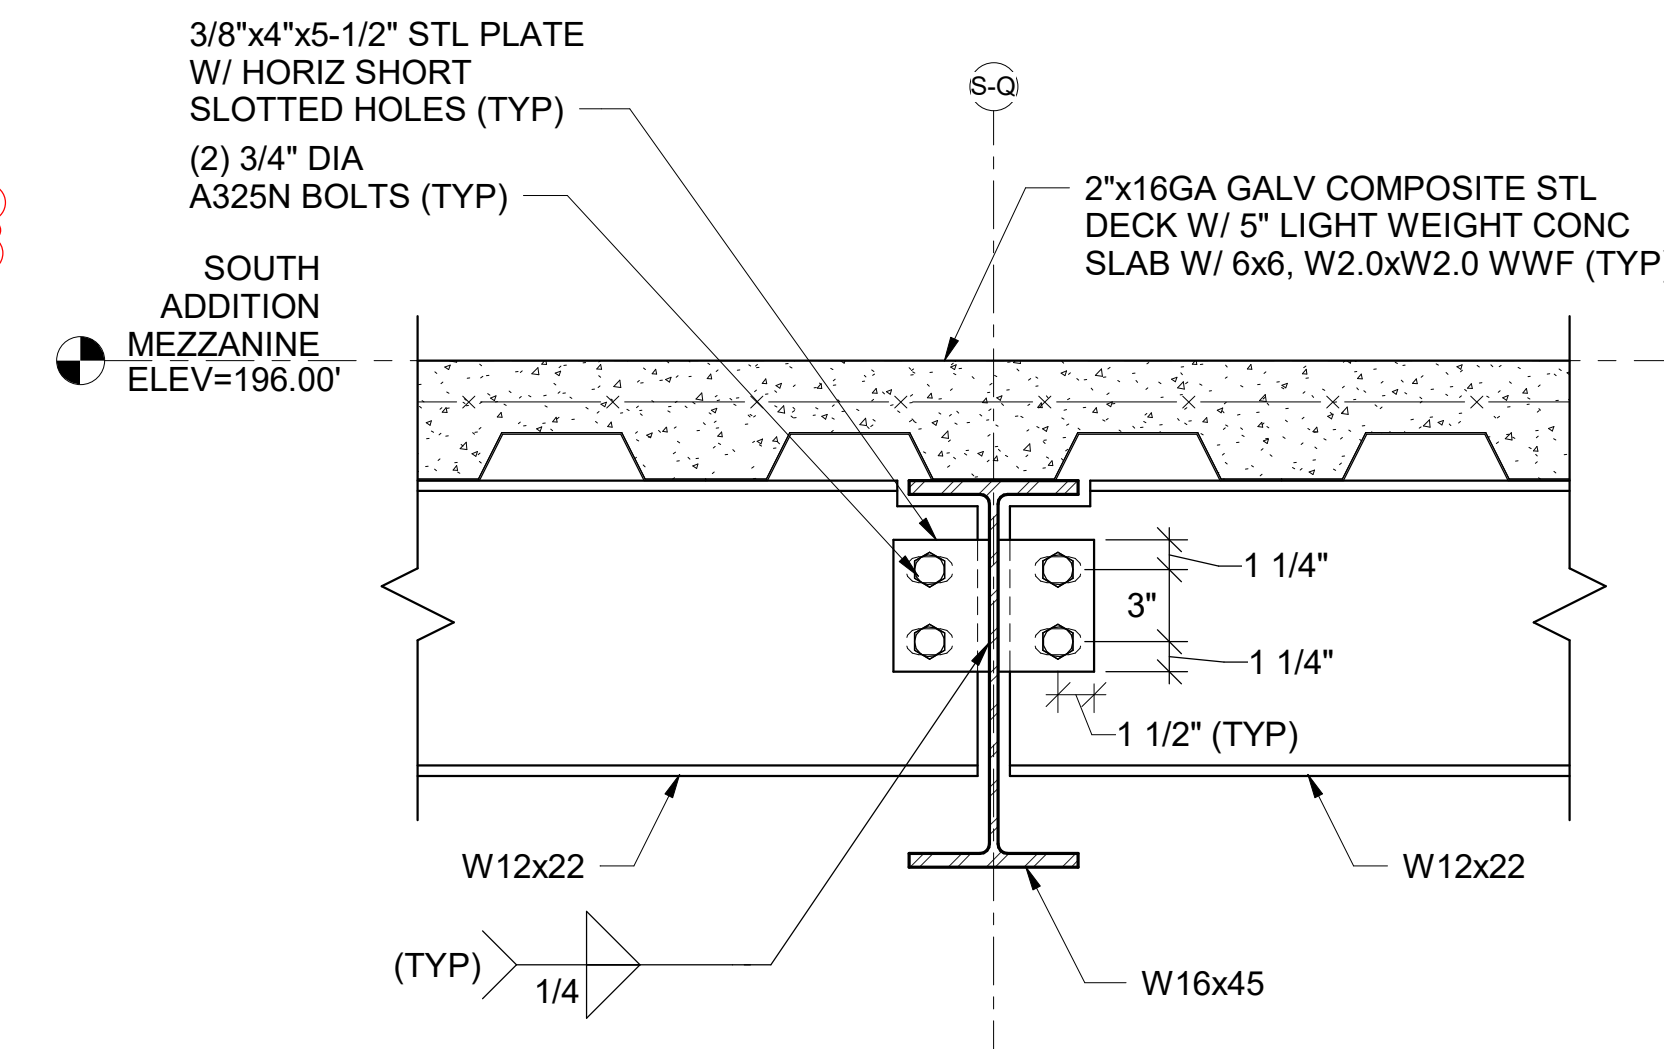


3 W12x22 to W16x45 CONN DETAIL

SF504/ SCALE: 1 1/2" = 1'-0"

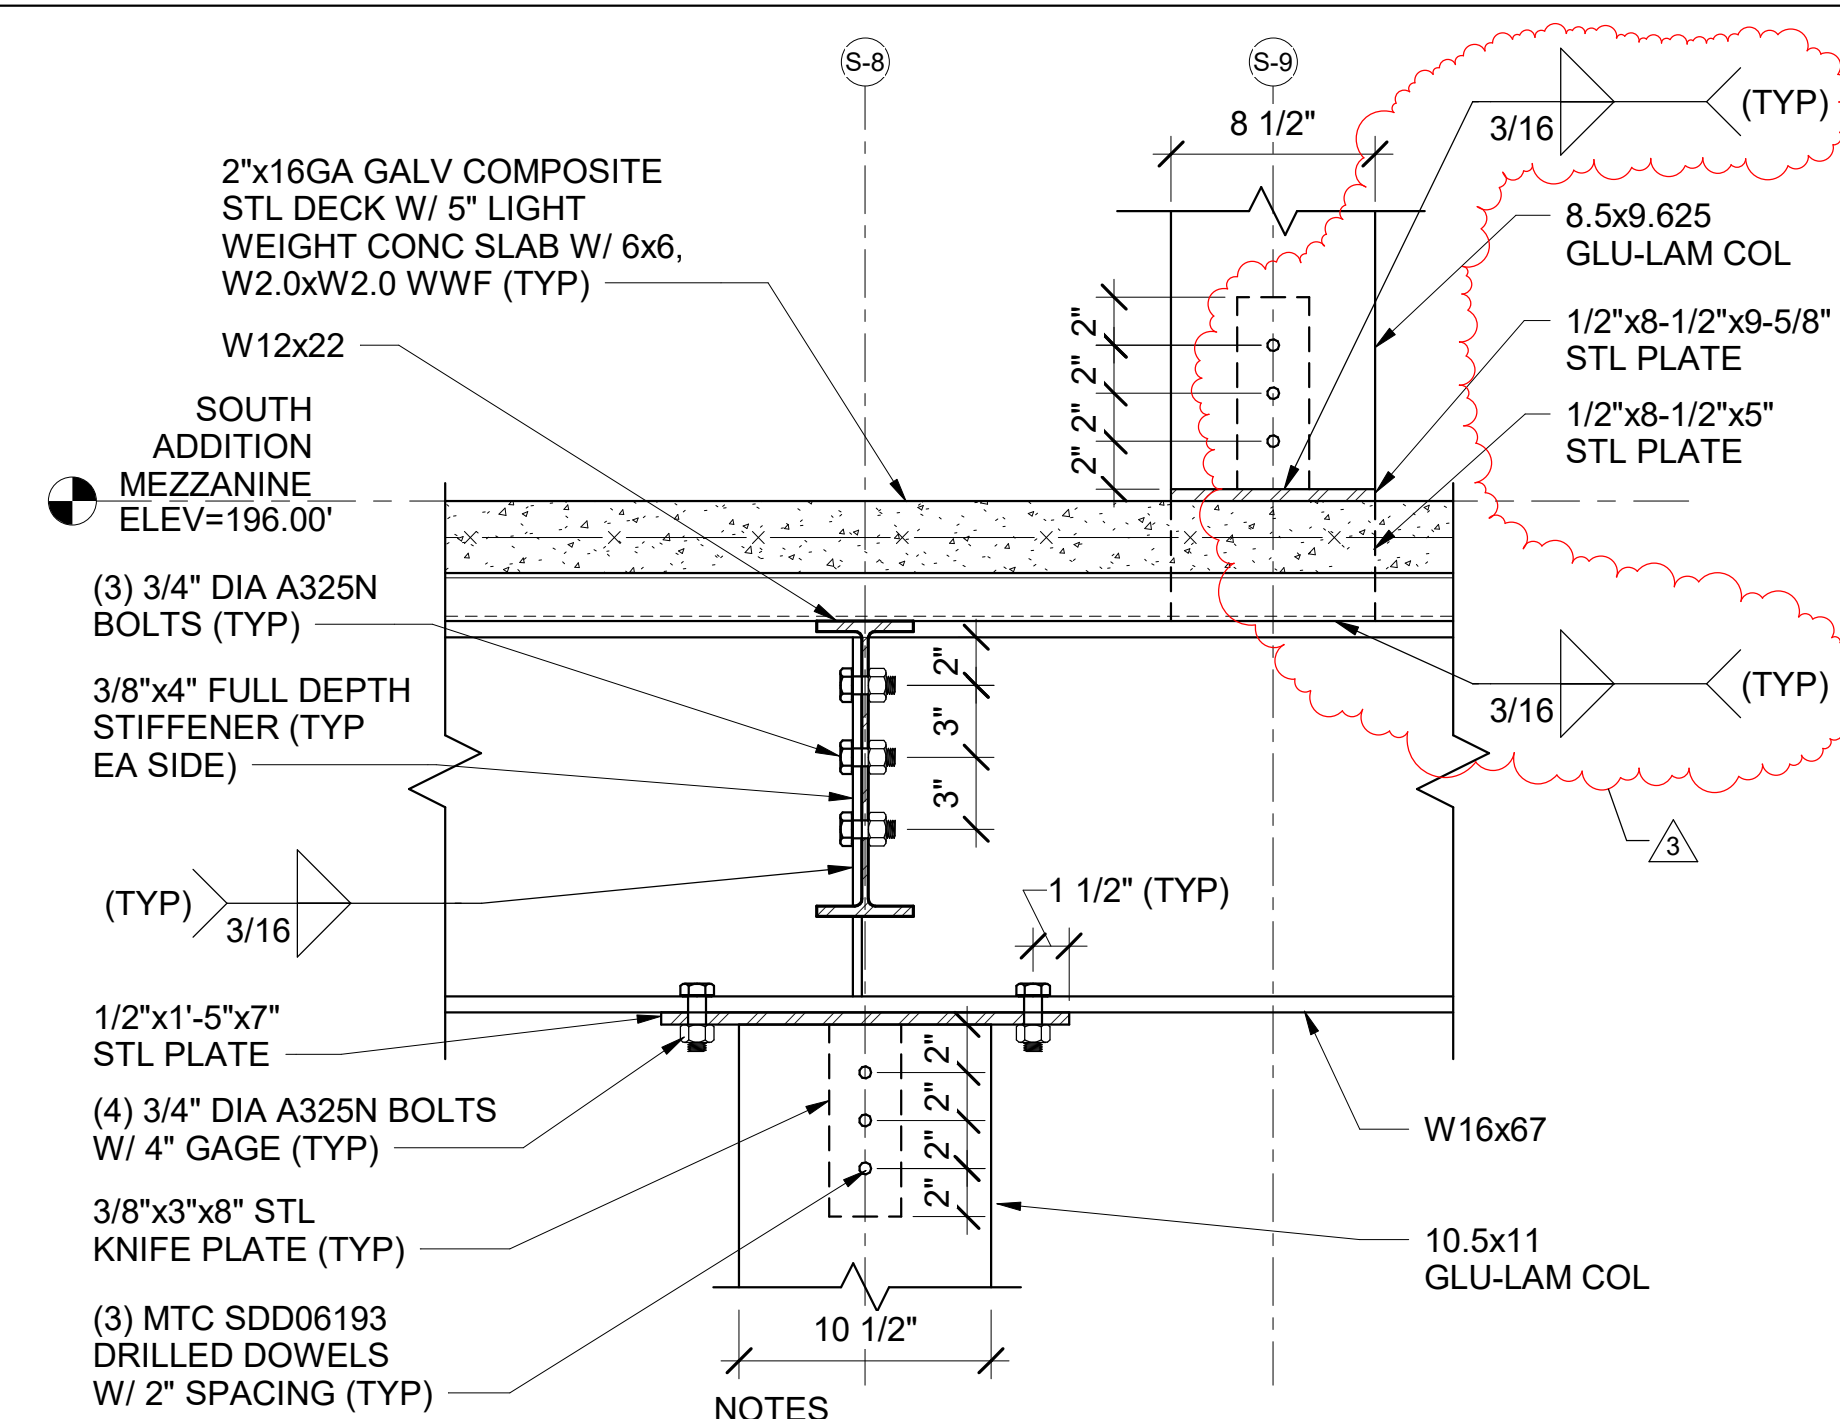


4 W12x22 to W16x67 CONN DETAIL

SF504/ SCALE: 1 1/2" = 1'-0"

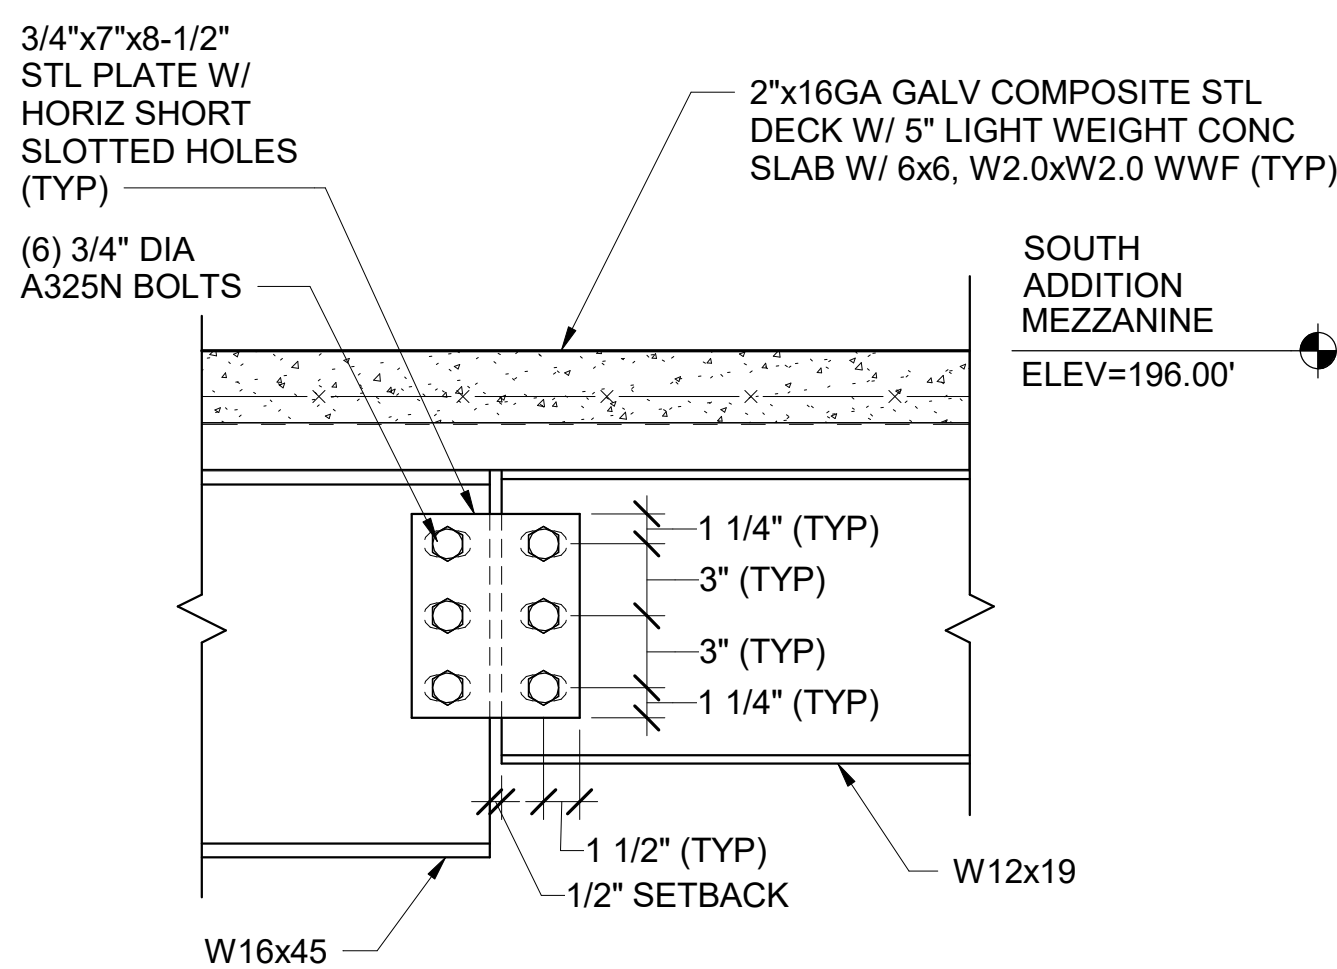


5 W12x22/W16x45 TO GLU-LAM COL CONN DETAIL

SF504/ SCALE: 1 1/2" = 1'-0"

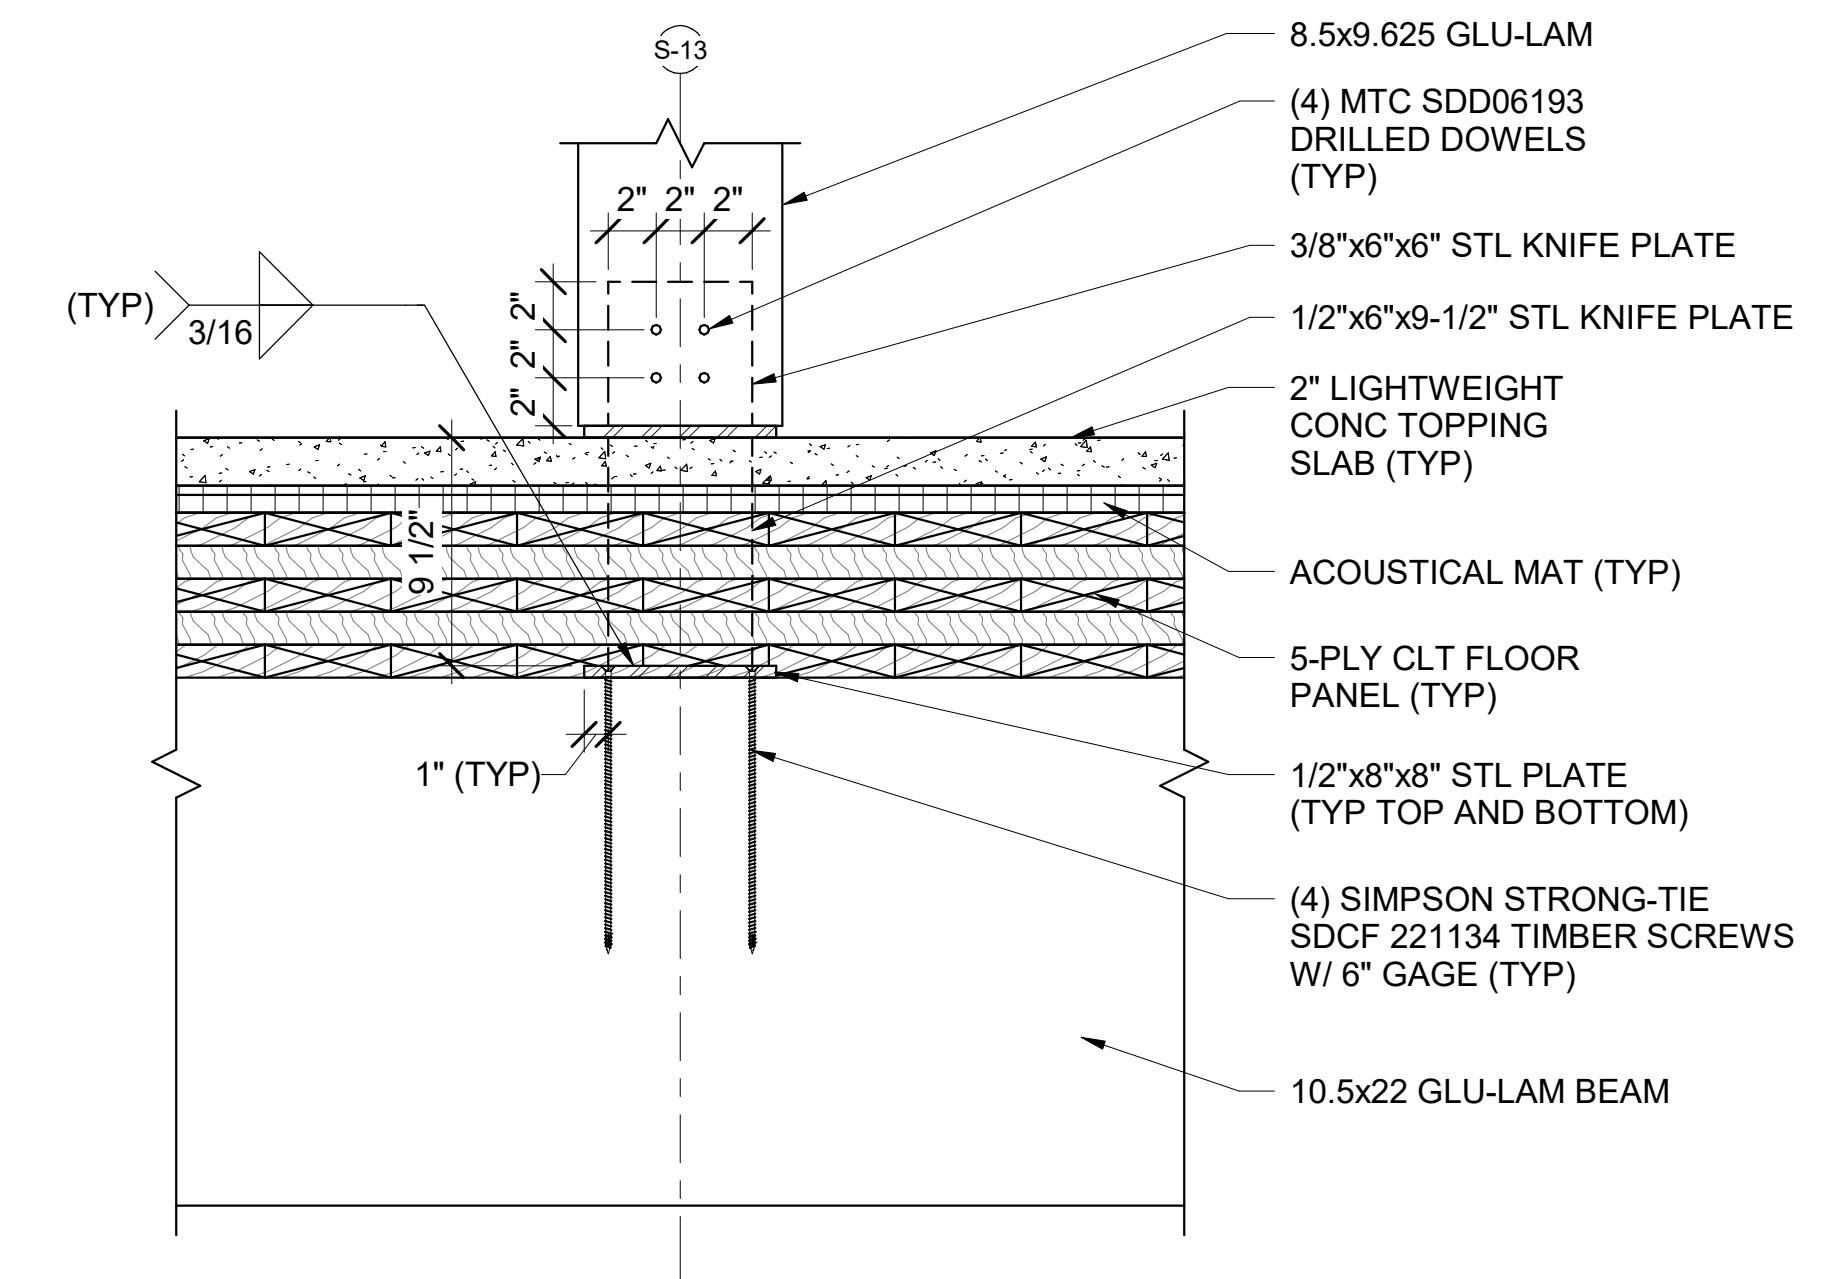


6 W12x19 to W16x45 BEAM SPLICE DETAIL

SF504/ SCALE: 1 1/2" = 1'-0"

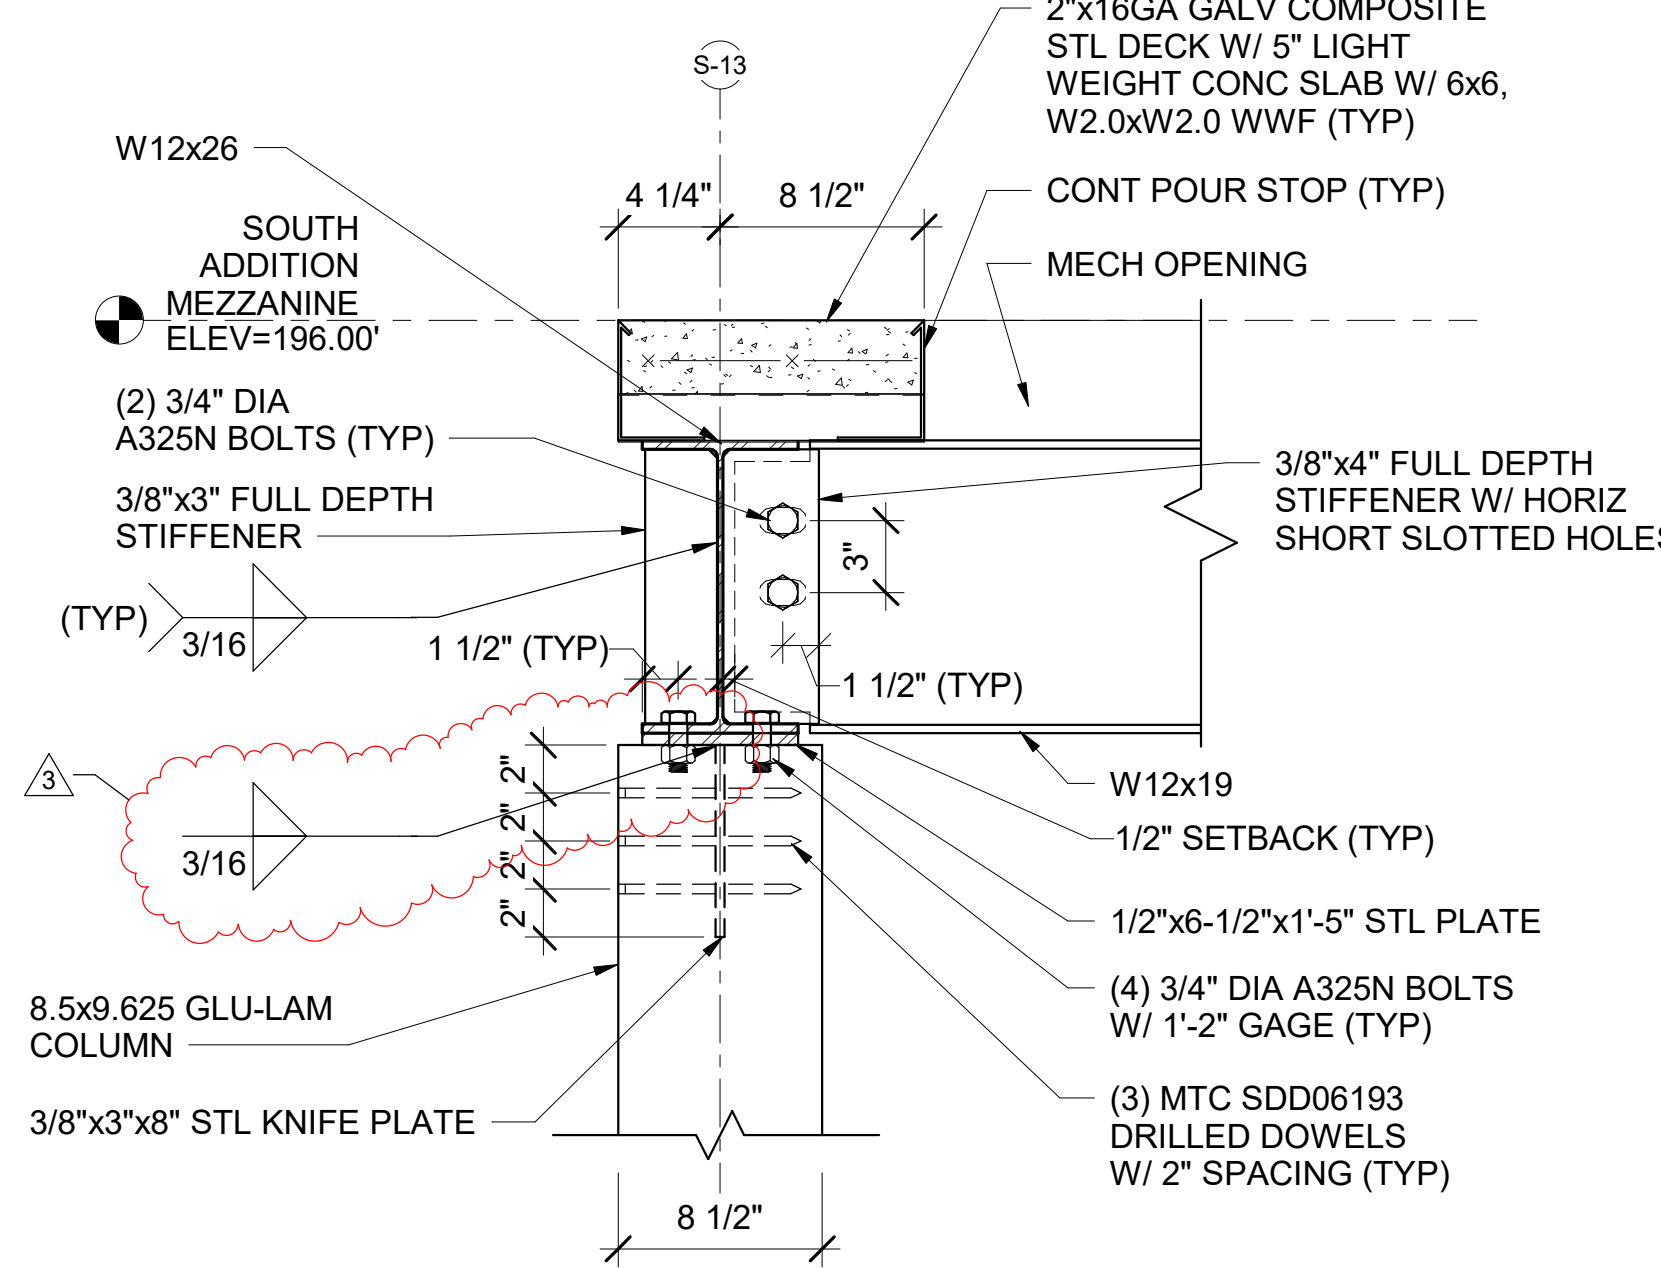


7 W12x19 to W12x26 CONN DETAIL

SF504/ SCALE: 1 1/2" = 1'-0"

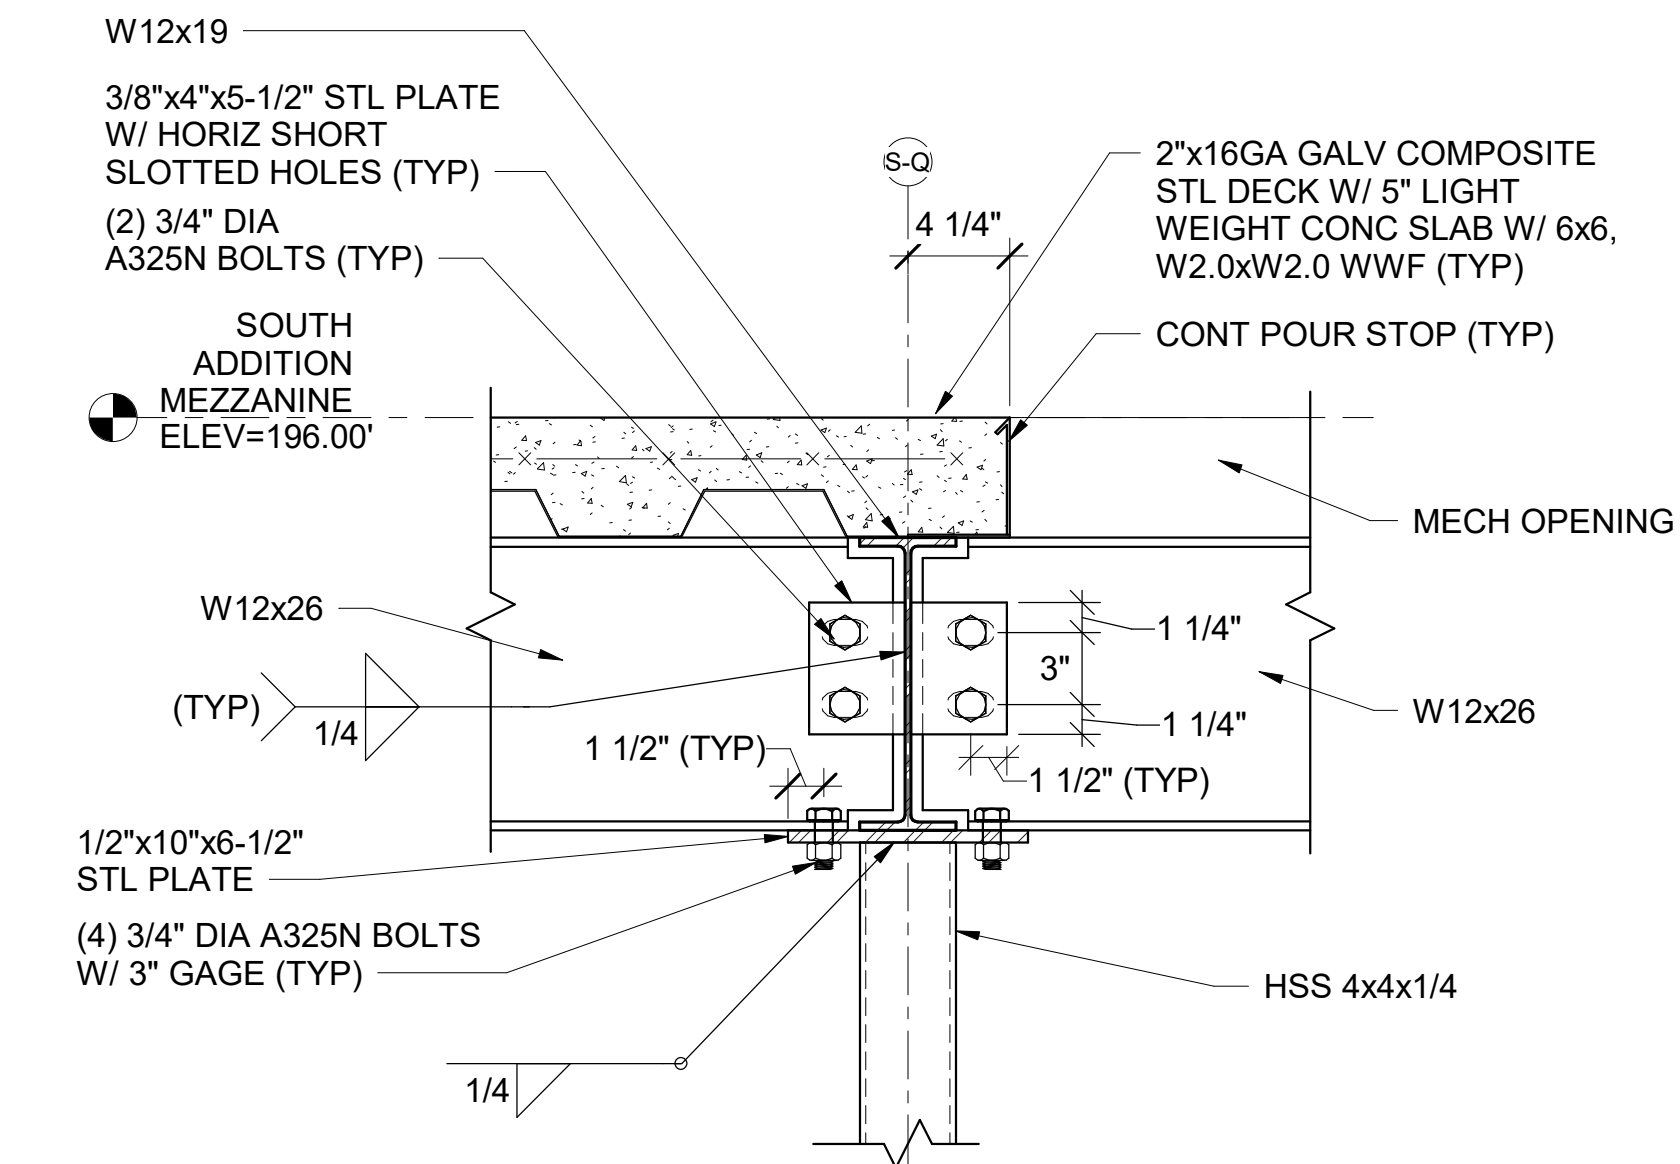

8 W12x26/W12x19 TO HSS 4x4x1/4 COL CONN DETAIL

SF504/ SCALE: 1 1/2" = 1'-0"

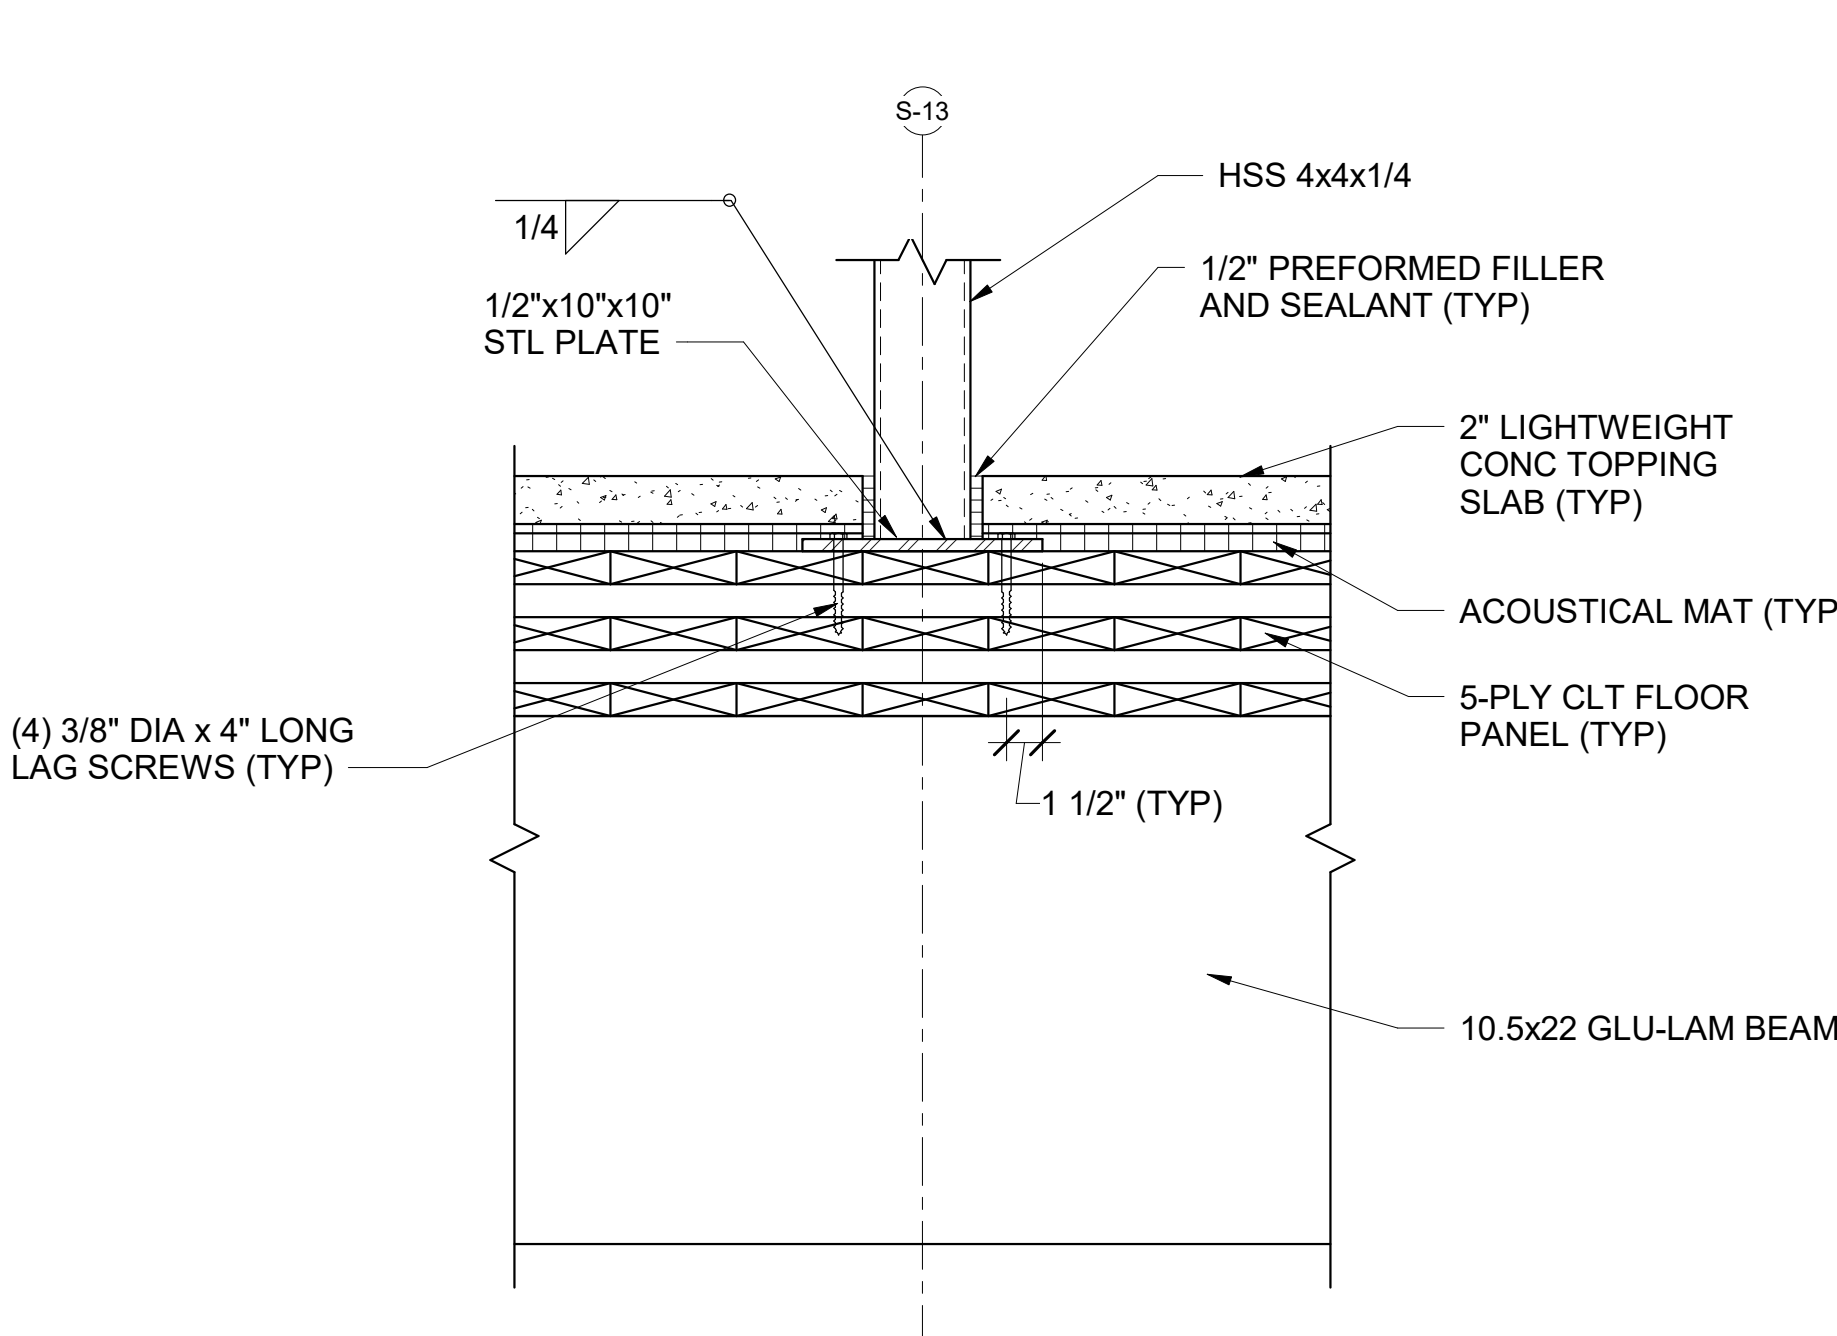


9 8.5x9.625 GLU-LAM TO 10.5x22 GLU-LAM CONN DETAIL

SF504/ SCALE: 1 1/2" = 1'-0"

10 HSS 4x4x1/4 TO 10.5x22 GLU-LAM CONN DETAIL


SF504/ SCALE: 1 1/2" = 1'-0"

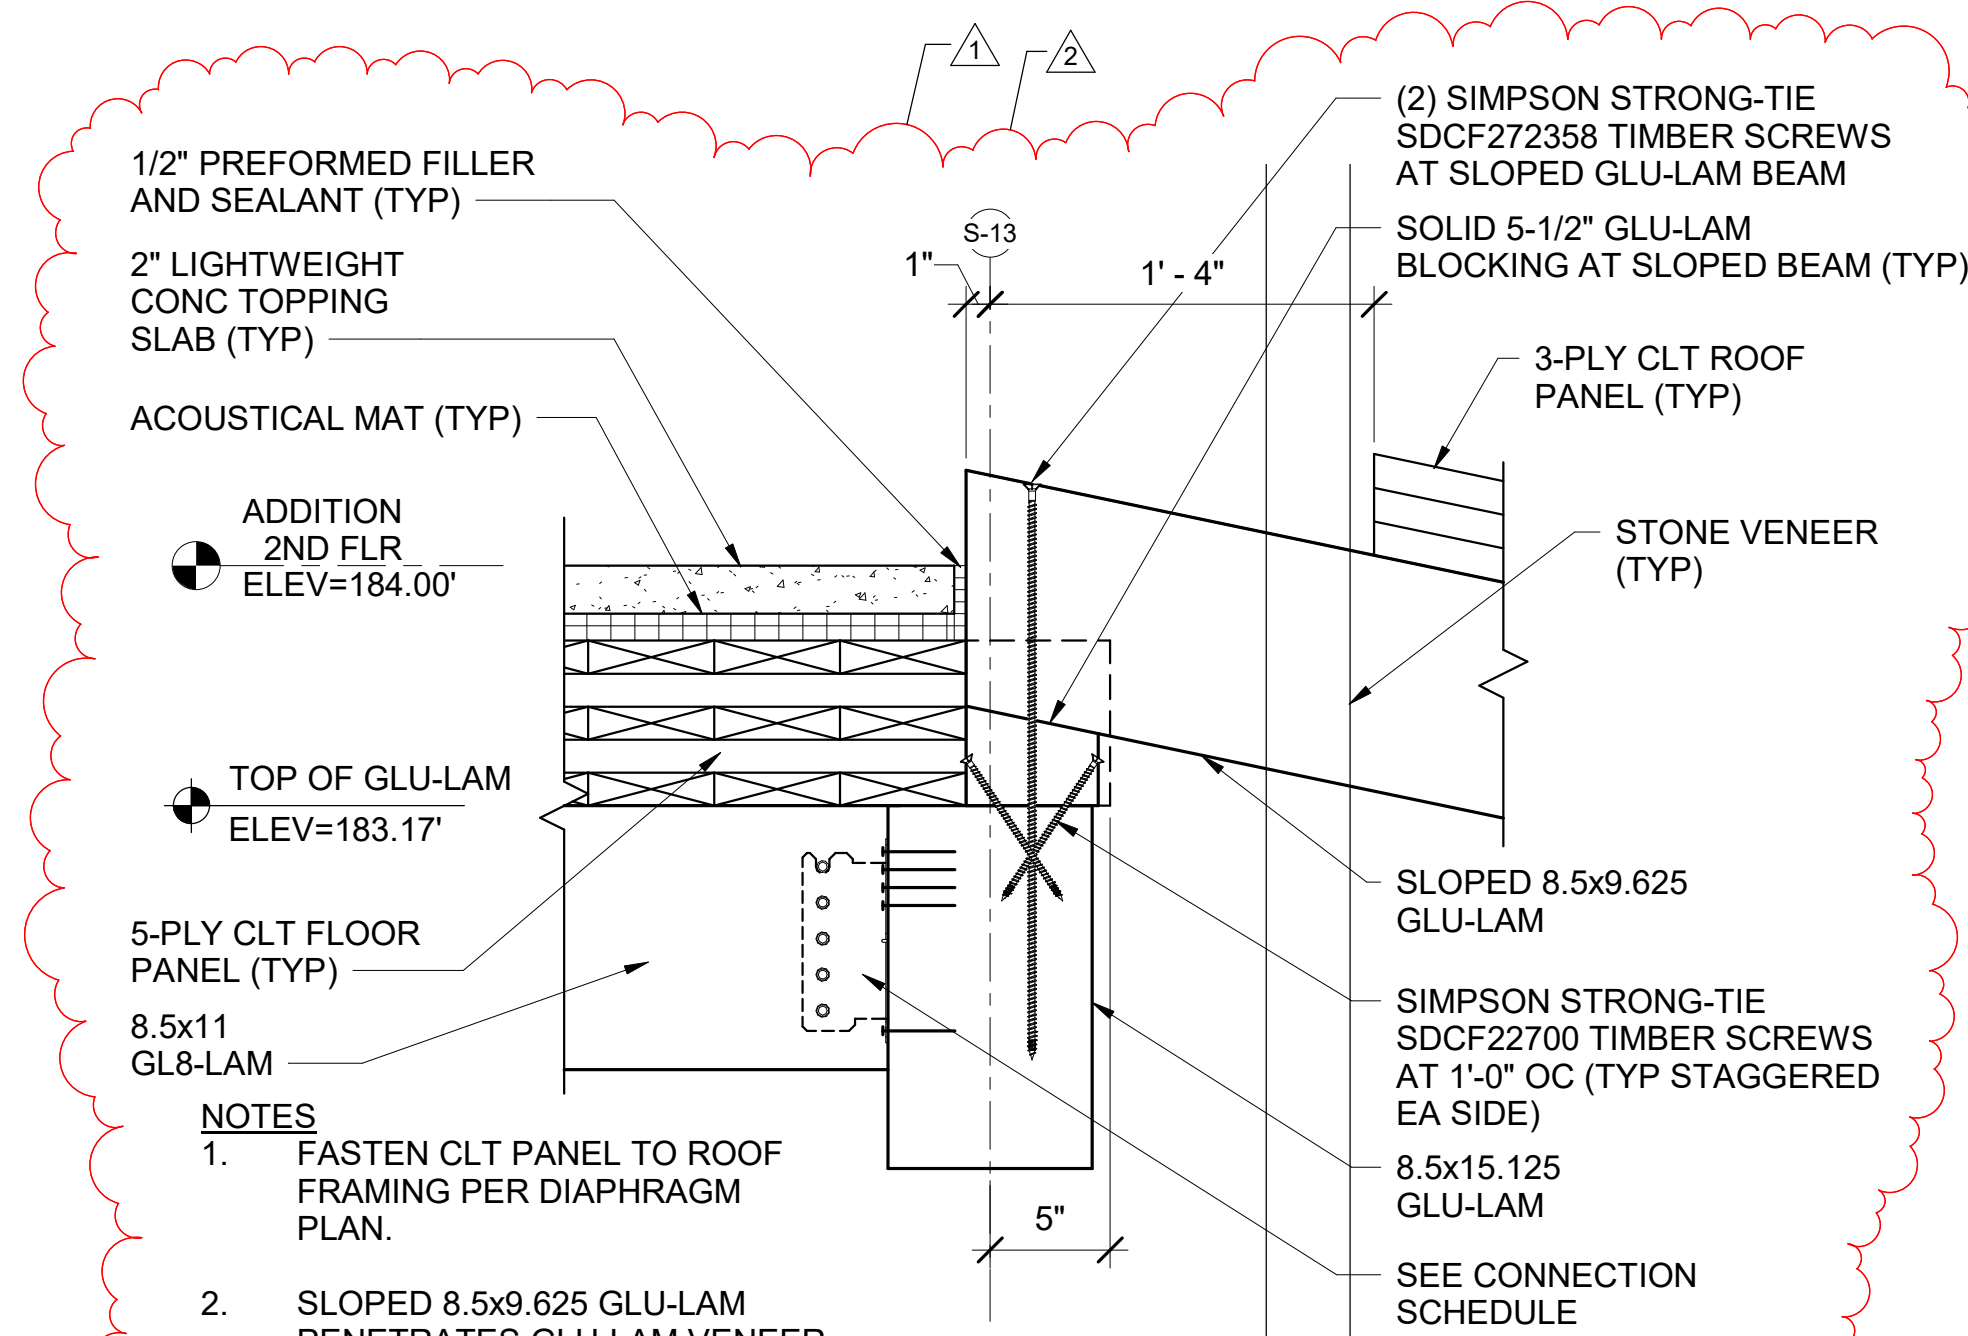

11 GLU-LAM BEAM/CLT ROOF PANEL SUPPORT DETAIL

SF504/ SCALE: 1 1/2" = 1'-0"

GRAPHIC SCALE

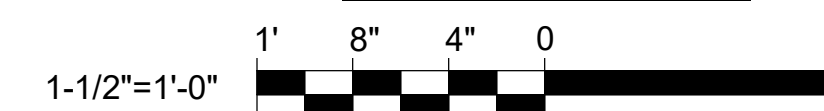


CHECK GRAPHIC SCALE BEFORE USING

<div> <div>STATE OF MAINE</div> <div>DAVID N. MARTIN</div> <div>No. 9620</div> <div>PROFESSIONAL ENGINEER</div> </div>				<div>DEPARTMENT OF INLAND FISHERIES & WILDLIFE</div> <div>NEW OFFICE HEADQUARTERS</div> <div>AUGUSTA, ME</div> <div>STRUCTURAL DETAILS 4</div>
--	--	--	--	--


COLUMN CAP PLATE SCHEDULE				
CAP PLATE TYPE	t	B	L	DIA
CP1	1/4"	4"	4"	-
CP2	1/4"	5"	5"	-

NOTE:
1. FLUSH WELD CAP PLATES UNLESS NOTED OTHERWISE.
2. * - CAP PLATE TO MATCH COLUMN DIMENSIONS.
3. SEE SHEETS SF602 AND SF603 FOR COLUMN SCHEDULES.

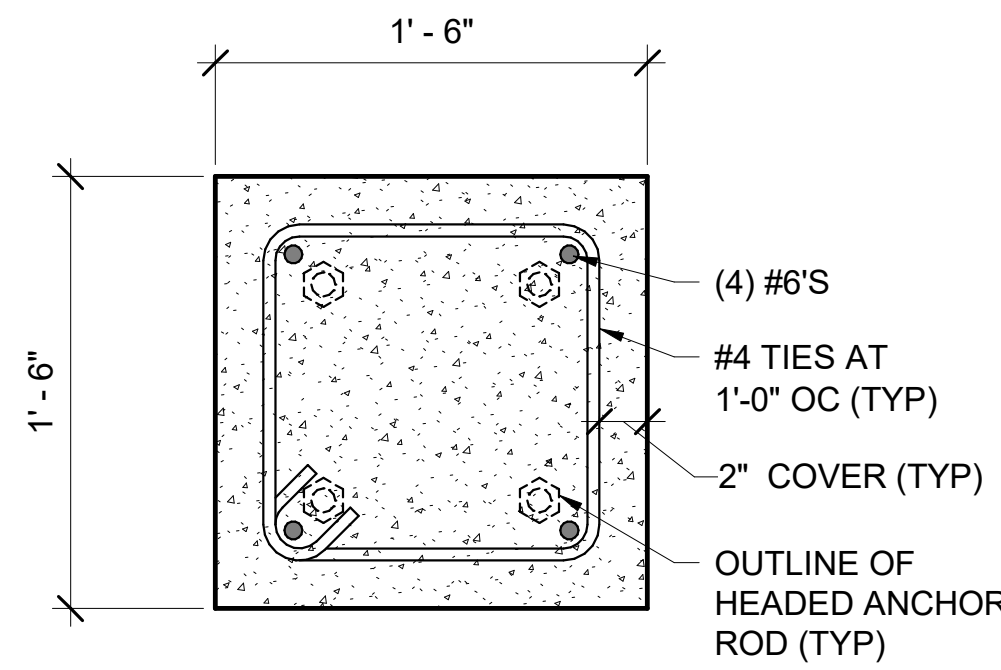


- NOTES**
- PROVIDE (3) #4 TIES WITH 2" SPACING, TYPICAL TOP AND BOTTOM OF VERTICAL REINFORCING STEEL.
 - LOCATE BOTTOM TIES IN COLUMN FOOTING.
 - LOCATE TOP TIE WITHIN 1-1/2" OF TOP OF VERTICAL REINFORCING STEEL.

1 TYP PIER DETAIL A
SF604 SCALE: 1 1/2" = 1'-0"

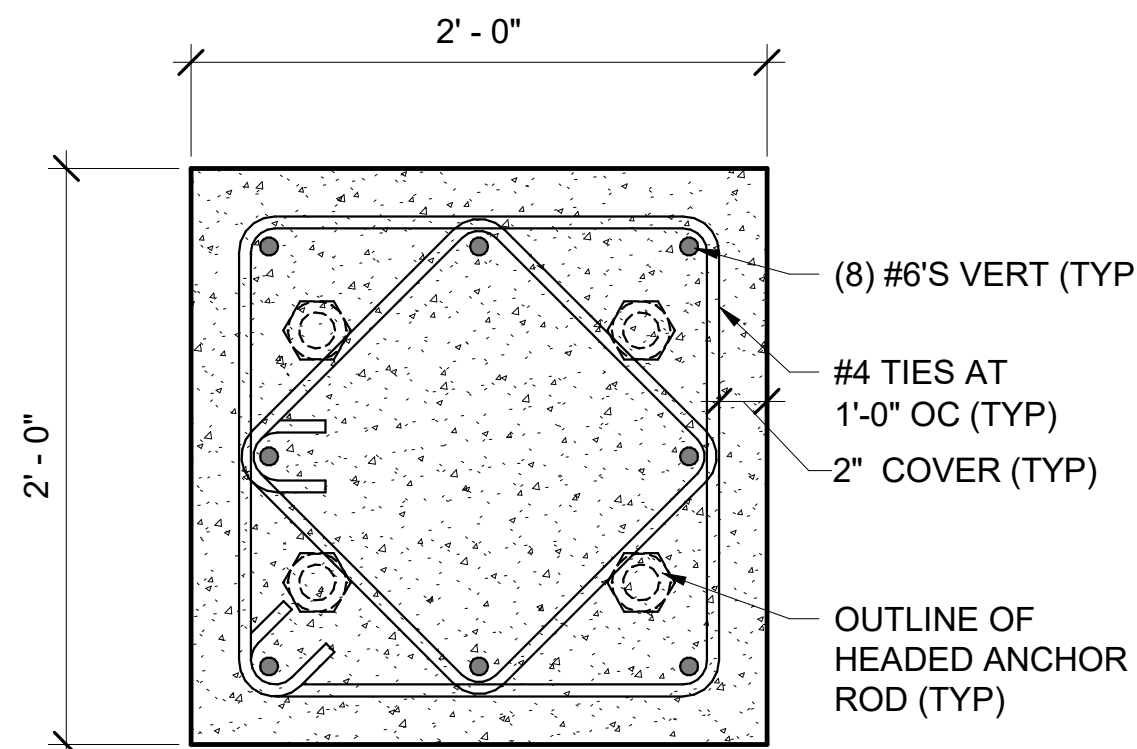


- NOTES**
- PROVIDE 2" SPACING FOR TIES AT TOP AND BOTTOM OF VERTICAL REINFORCING STEEL.
 - LOCATE BOTTOM TIES IN COLUMN FOOTING.
 - LOCATE TOP TIE WITHIN 1-1/2" OF TOP OF VERTICAL REINFORCING STEEL.
 - SEE DETAIL 6/SF604 FOR ADDITIONAL (4) #6 DOWELS AT BRACED FRAMES.

2 TYP PIER DETAIL B
SF604 SCALE: 1 1/2" = 1'-0"

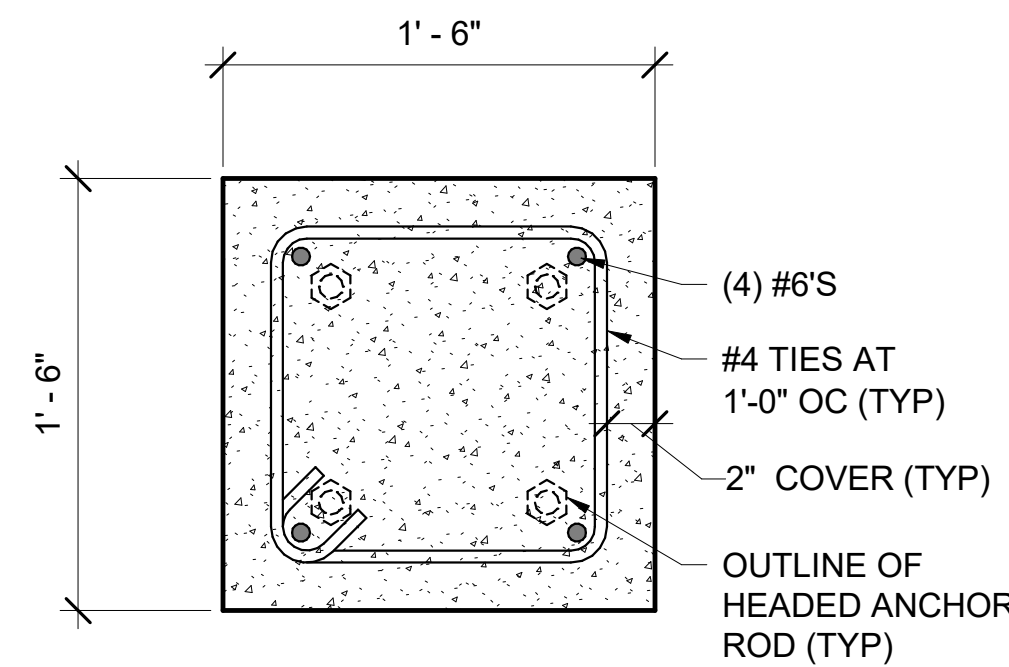


- NOTES**
- PROVIDE (5) #4 TIES WITH 2" SPACING, TYPICAL TOP AND BOTTOM OF VERTICAL REINFORCING STEEL.
 - LOCATE BOTTOM TIES IN COLUMN FOOTING.
 - LOCATE TOP TIE WITHIN 1-1/2" OF TOP OF VERTICAL REINFORCING STEEL.
 - SEE DETAIL 7/SF604 FOR ADDITIONAL (4) #6 DOWELS AT BRACED FRAMES.

3 TYP PIER DETAIL C
SF604 SCALE: 1 1/2" = 1'-0"

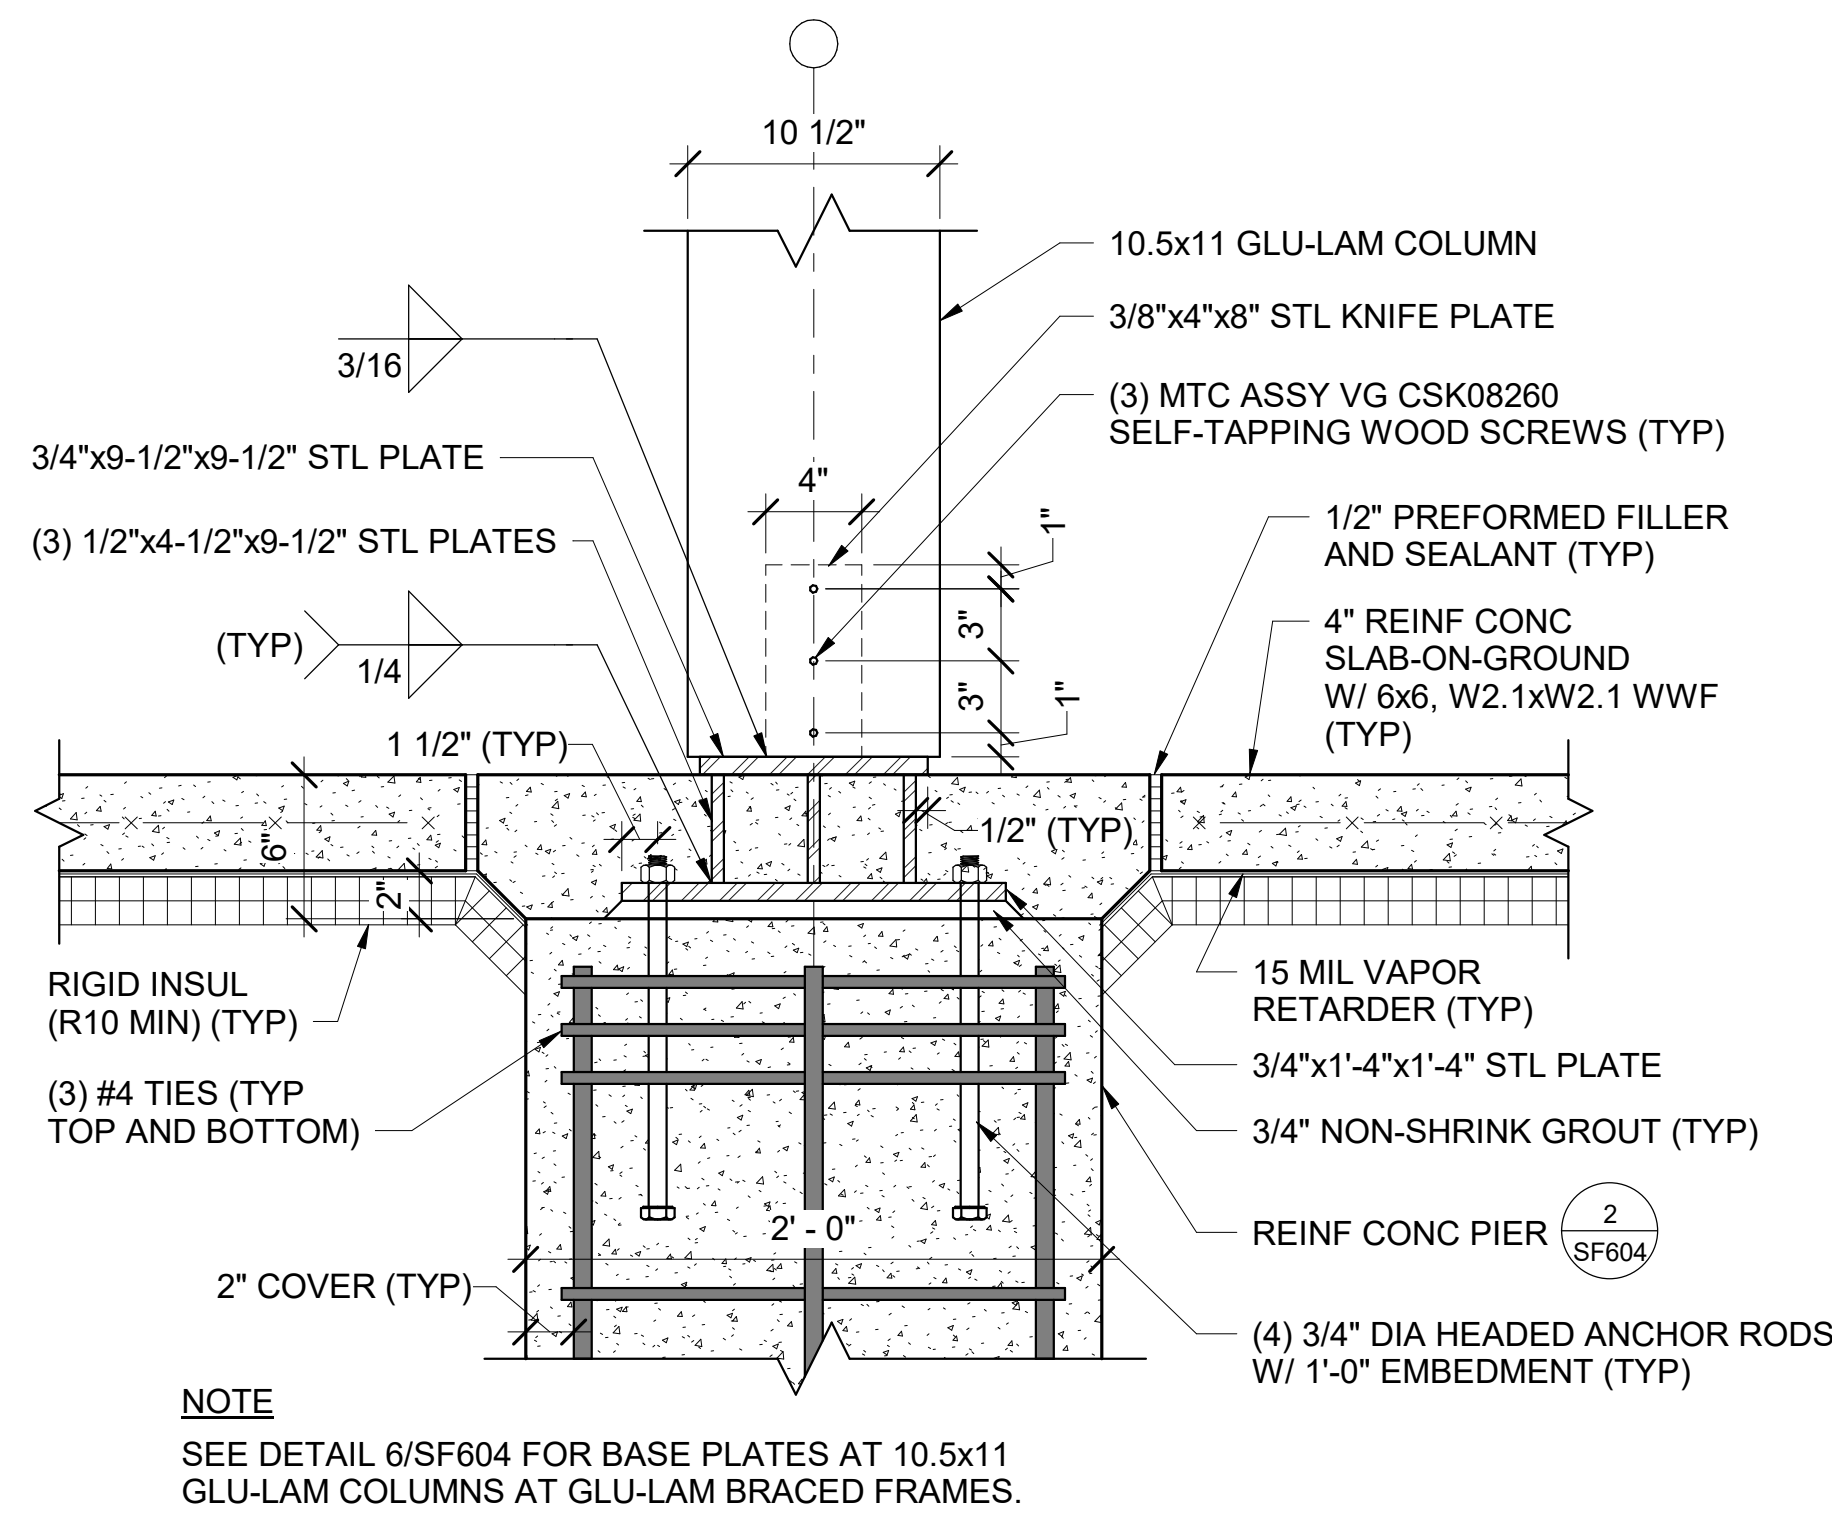


NOTE
SEE DETAIL 6/SF604 FOR BASE PLATES AT 10.5x11 GLU-LAM COLUMNS AT GLU-LAM BRACED FRAMES.

4 10.5x11 GLU-LAM COLUMN BASE PLATE DETAIL
SF604 SCALE: 1 1/2" = 1'-0"

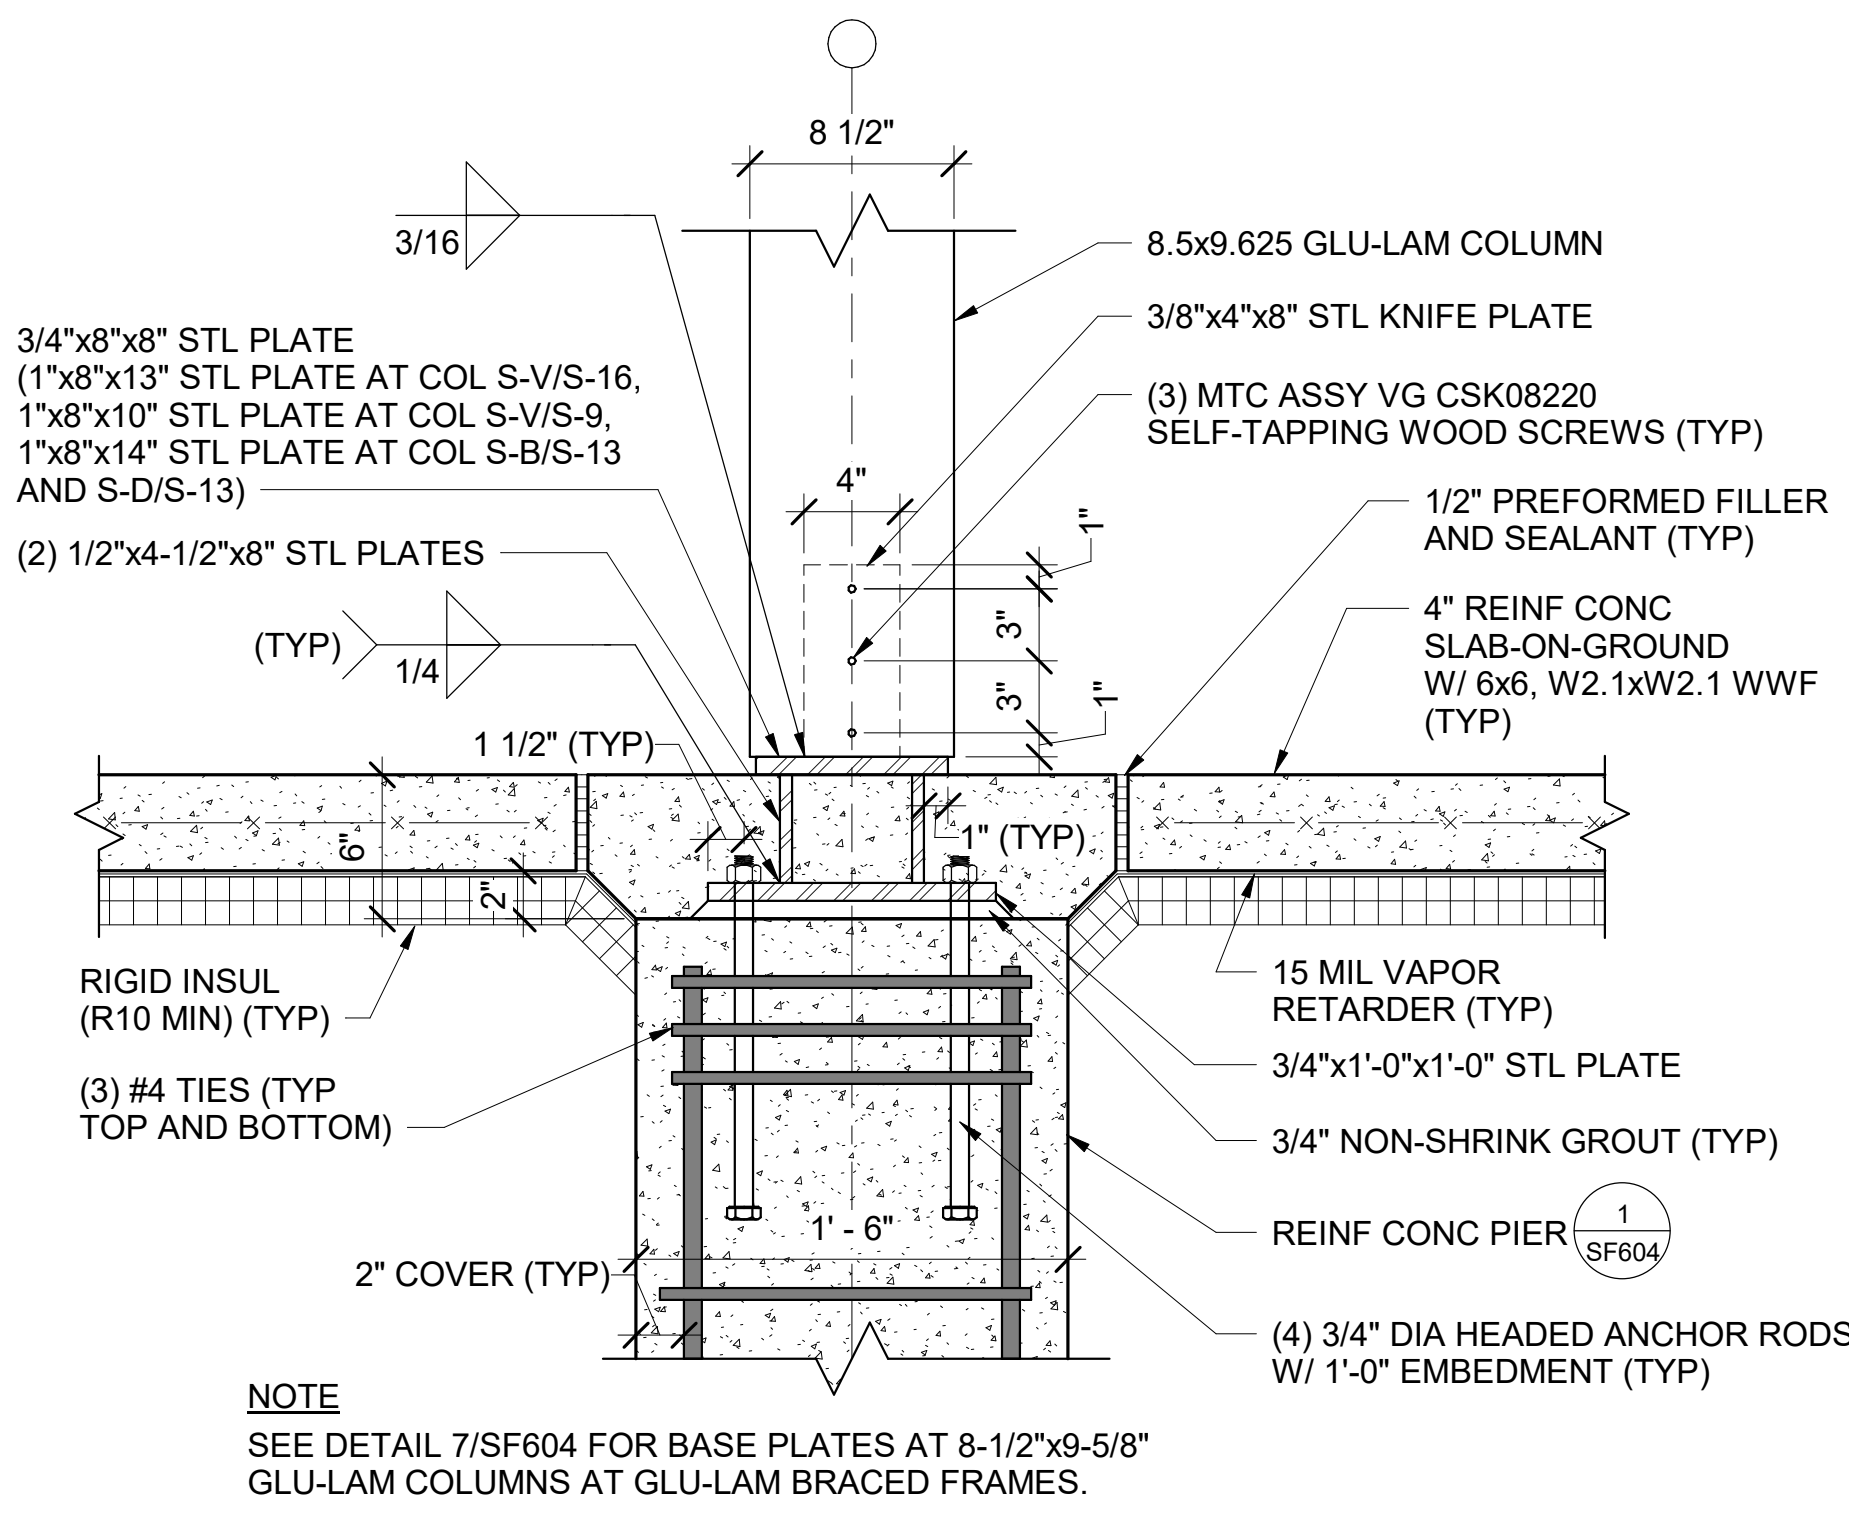


NOTE
SEE DETAIL 7/SF604 FOR BASE PLATES AT 8-1/2"x9-5/8" GLU-LAM COLUMNS AT GLU-LAM BRACED FRAMES.

5 8.5x9.625 GLU-LAM COLUMN BASE PLATE DETAIL
SF604 SCALE: 1 1/2" = 1'-0"

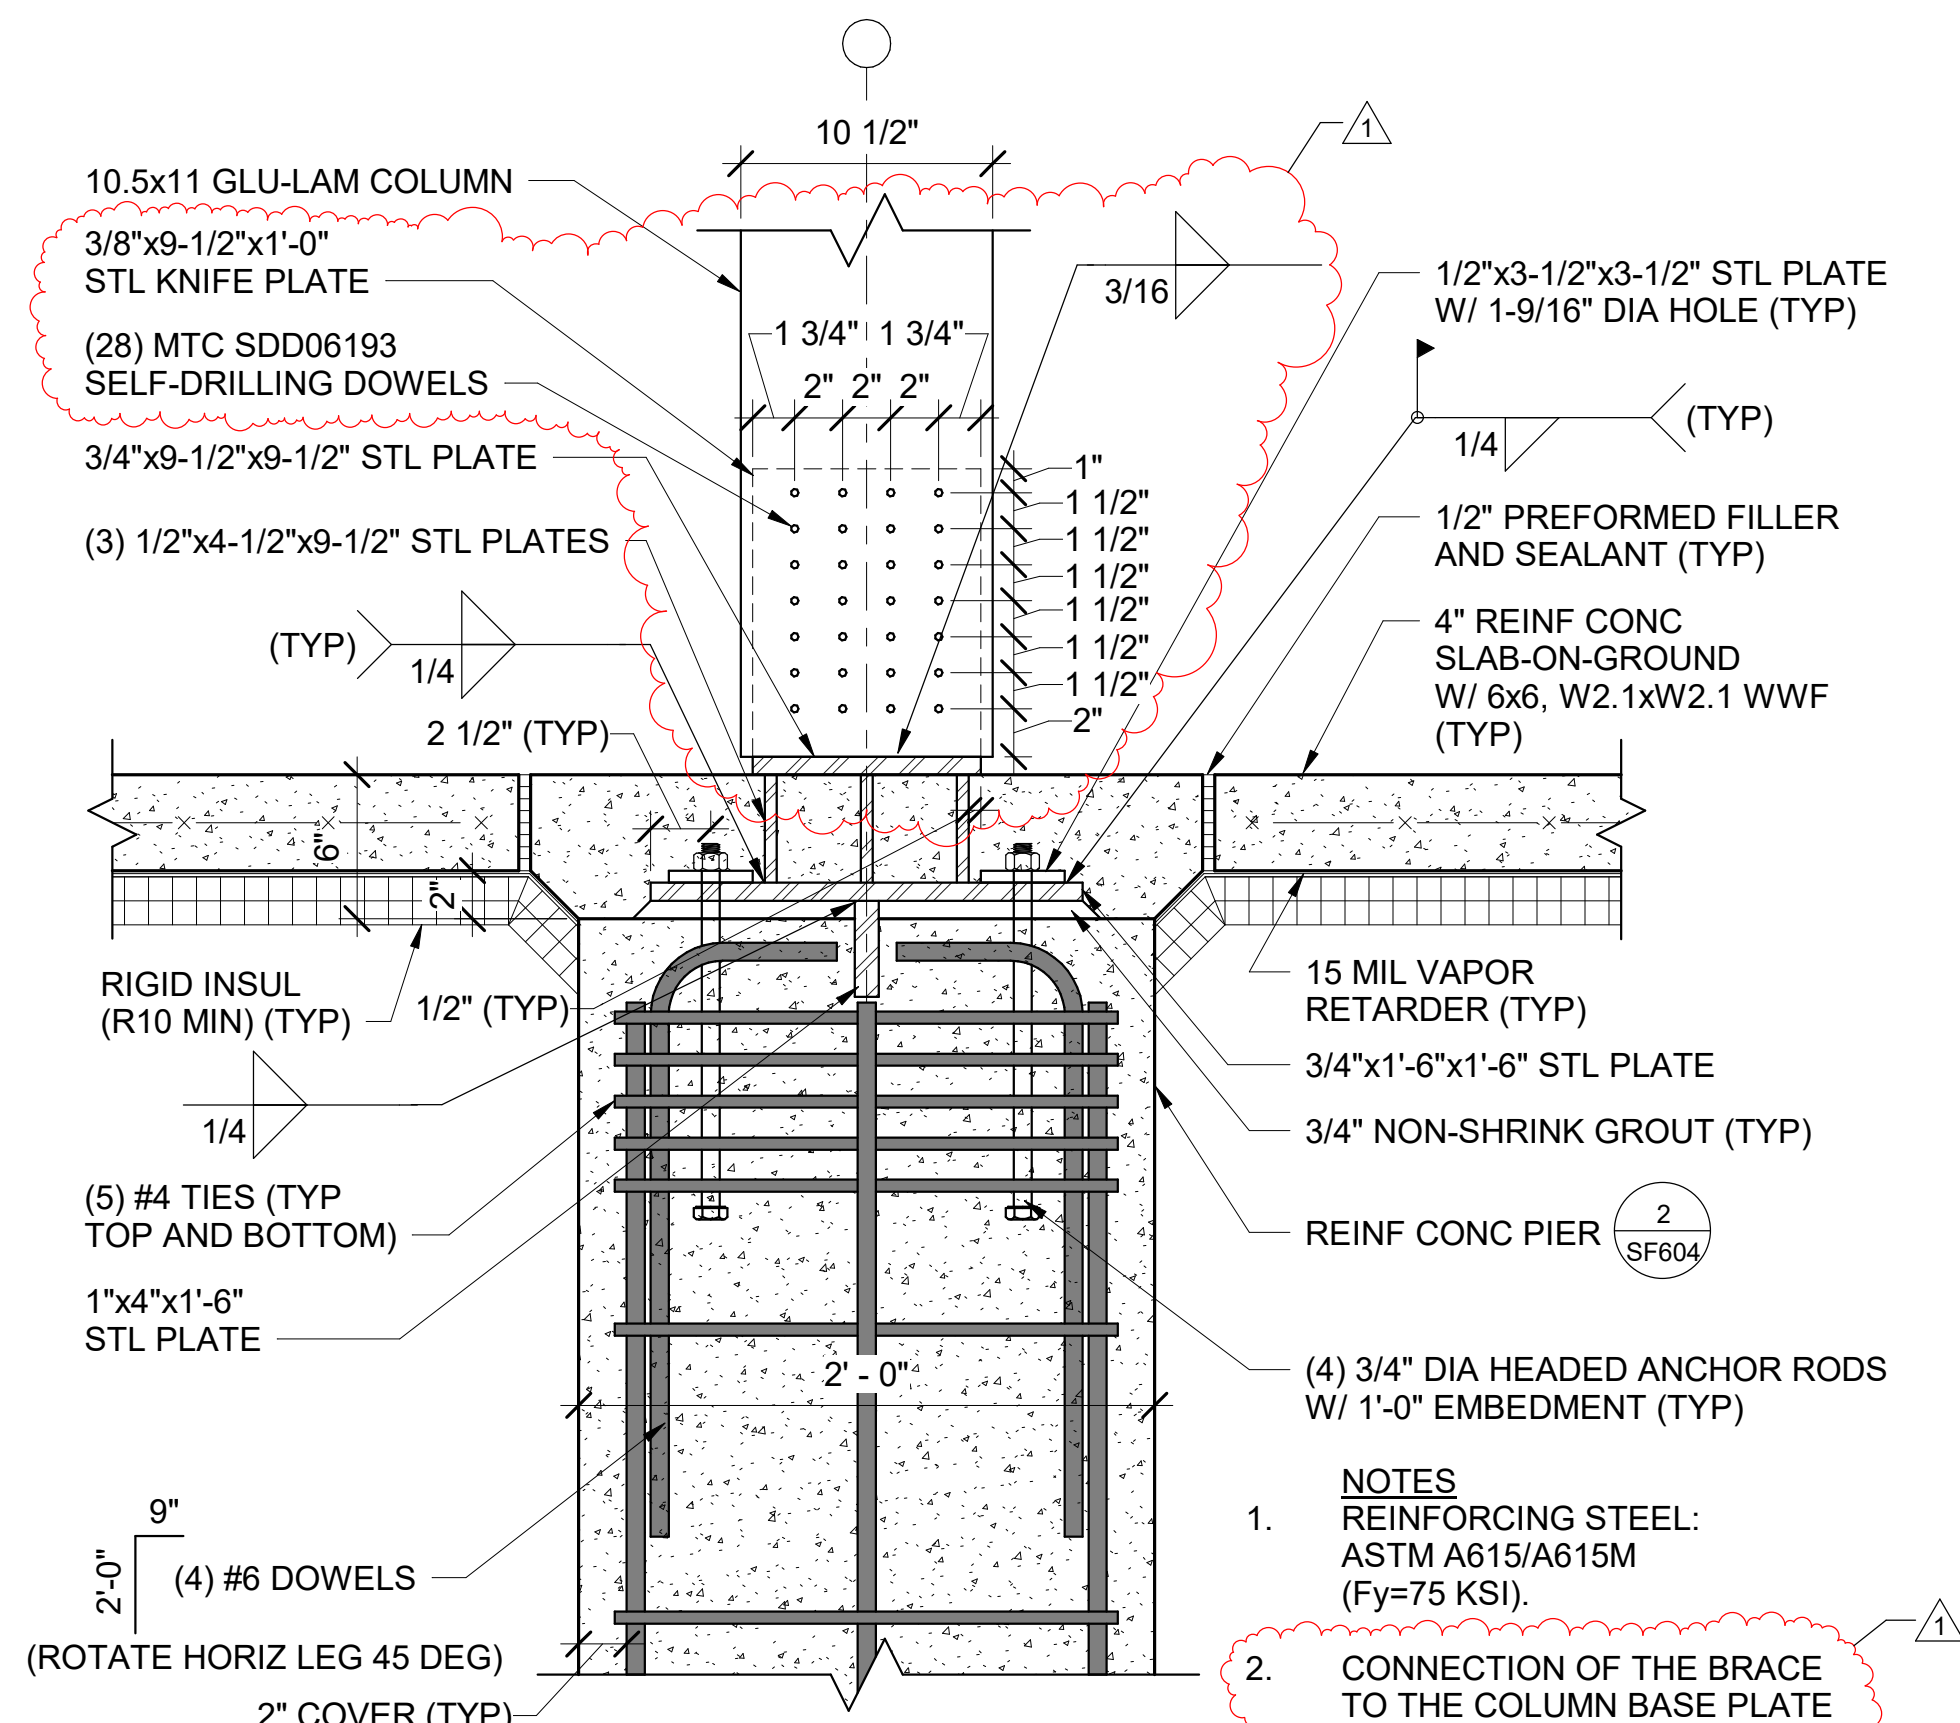


- NOTES**
- REINFORCING STEEL: ASTM A615/A615M (Fy=75 KSI).
 - CONNECTION OF THE BRACE TO THE COLUMN BASE PLATE TO BE PER THE GLU-LAM BRACED FRAME CONNECTION DESIGN. INTEGRATE THE BRACE CONNECTION WITH THE COLUMN TO BASE PLATE CONNECTION.

6 10.5x11 GLU-LAM COLUMN BASE PLATE DETAIL (BRACED FRAME)
SF604 SCALE: 1 1/2" = 1'-0"

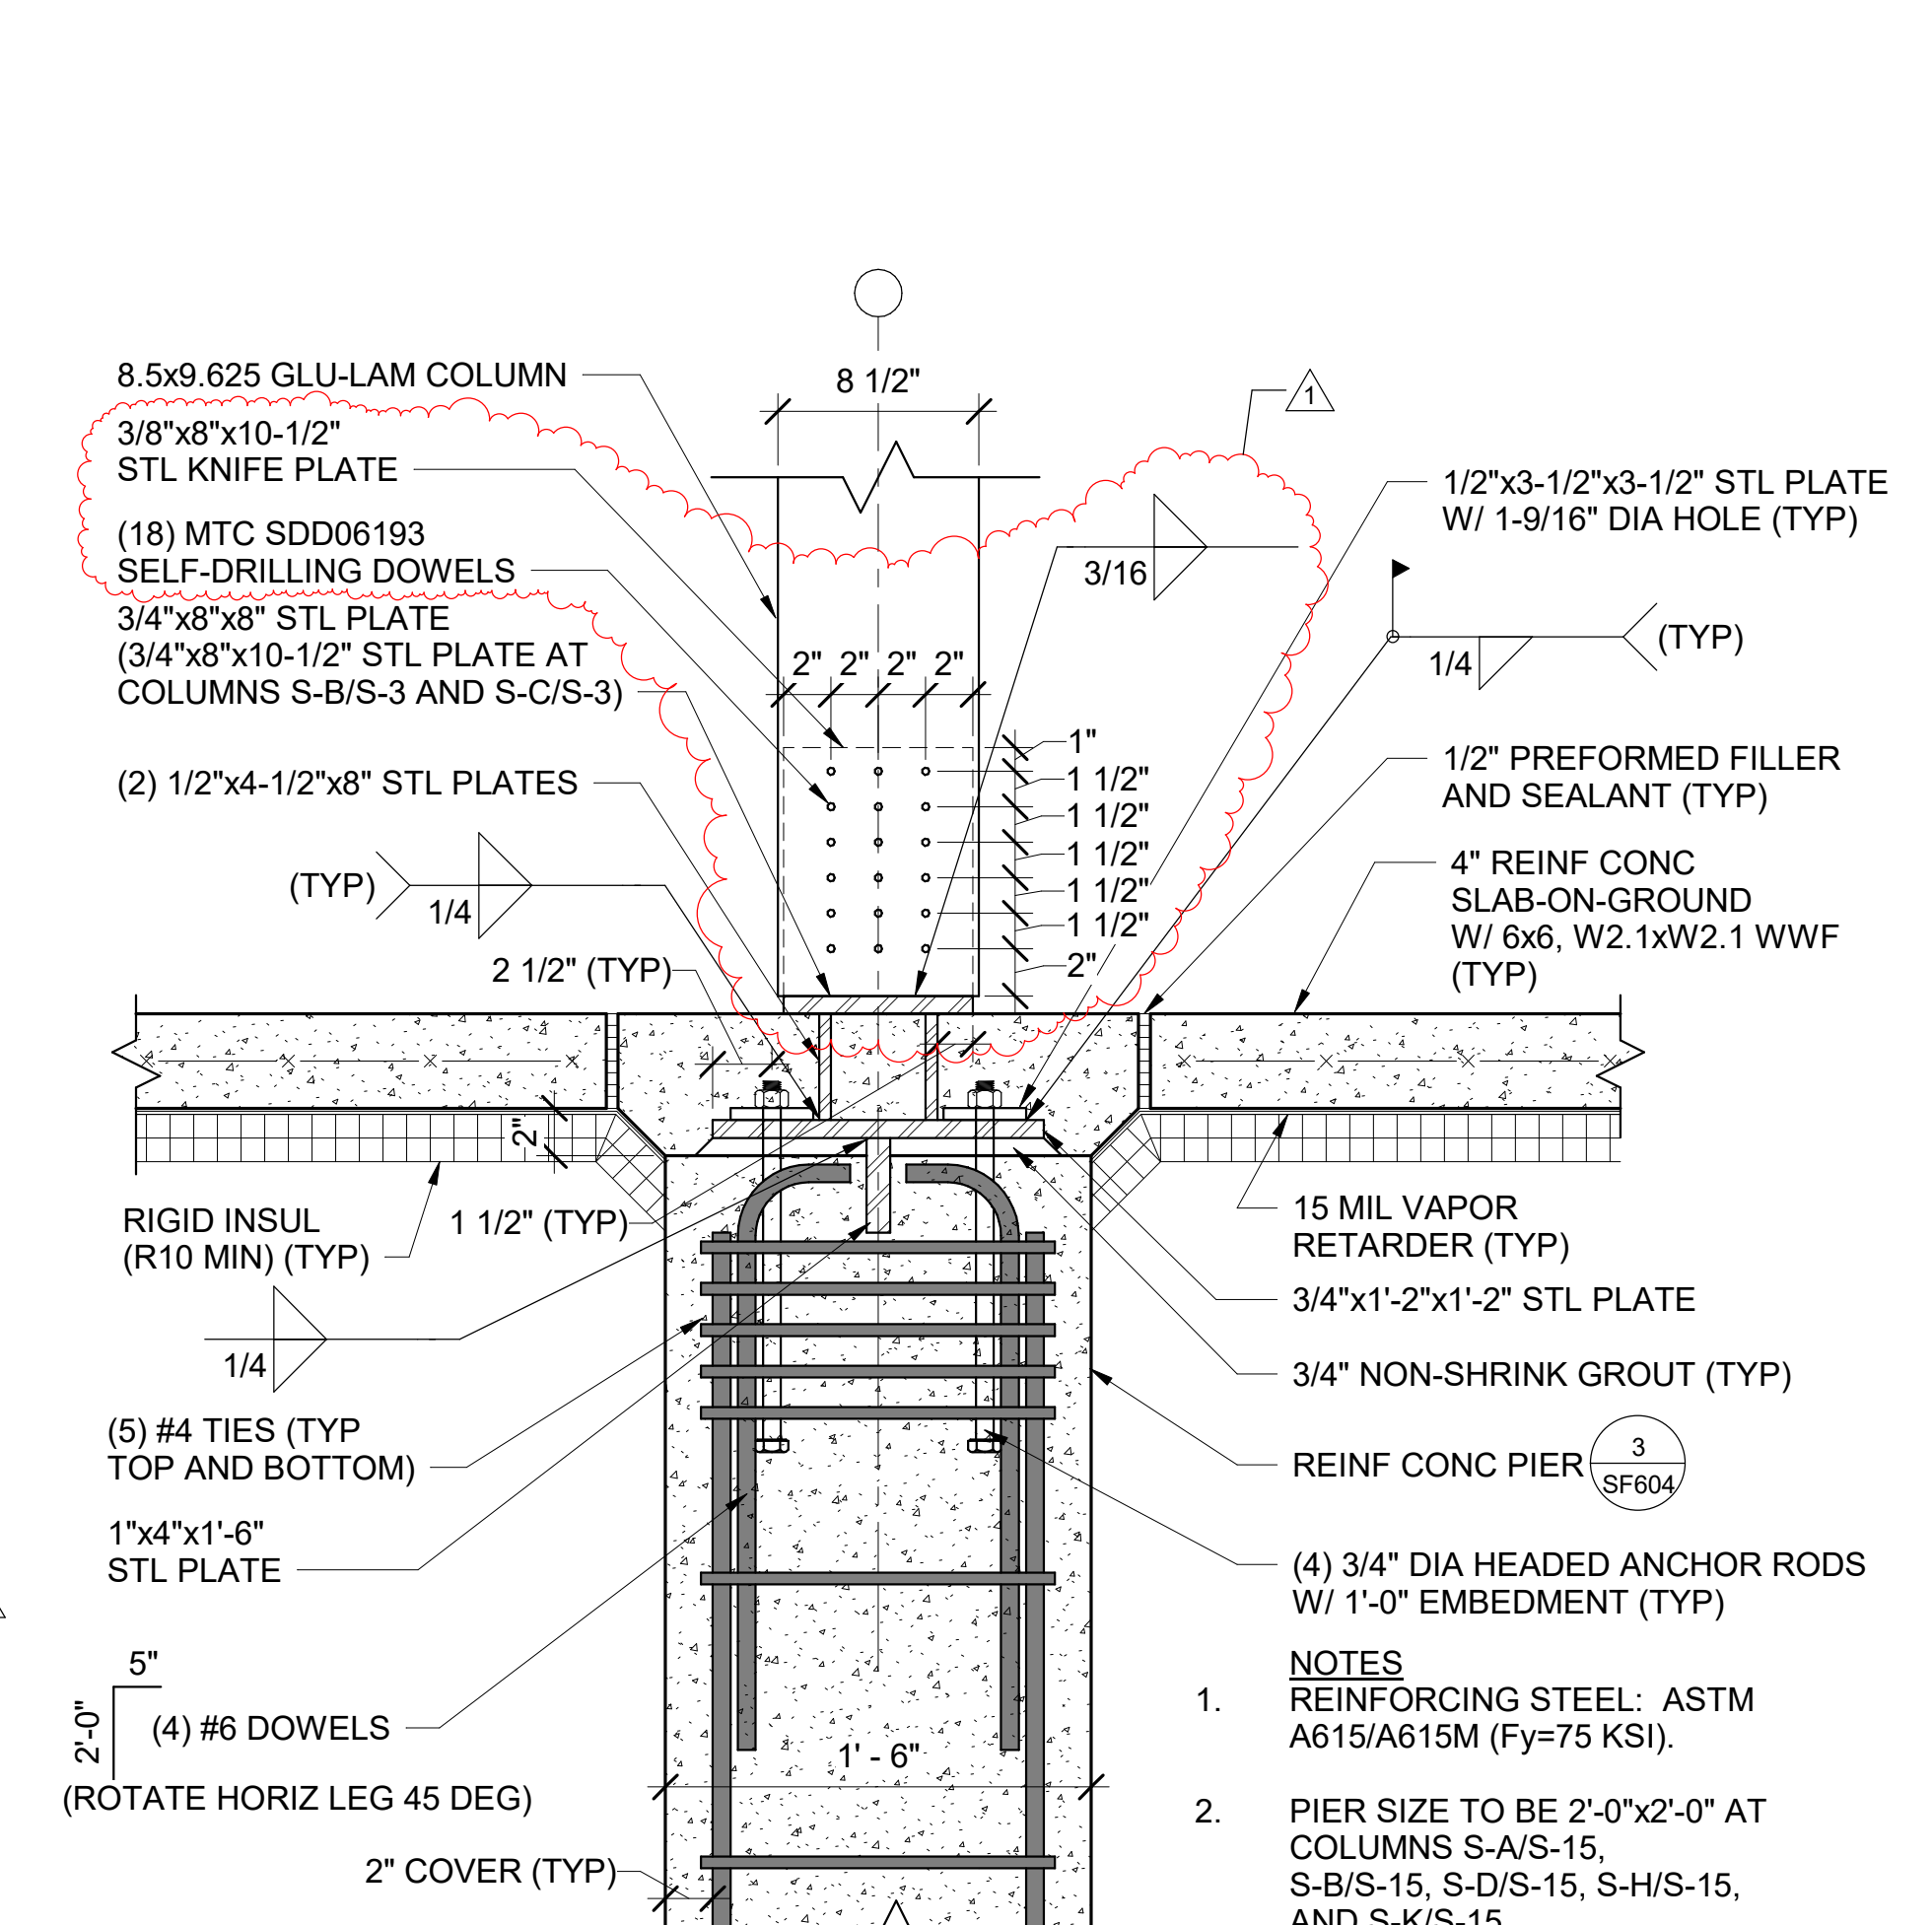


- NOTES**
- REINFORCING STEEL: ASTM A615/A615M (Fy=75 KSI).
 - PIER SIZE TO BE 2'-0" x 2'-0" AT COLUMNS S-A/S-15, S-B/S-15, S-D/S-15, S-H/S-15, AND S-K/S-15.
 - CONNECTION OF THE BRACE TO THE COLUMN BASE PLATE TO BE PER THE GLU-LAM BRACED FRAME CONNECTION DESIGN. INTEGRATE THE BRACE CONNECTION WITH THE COLUMN TO BASE PLATE CONNECTION.

7 8.5x9.625 GLU-LAM COLUMN BASE PLATE DETAIL (BRACED FRAME)
SF604 SCALE: 1 1/2" = 1'-0"

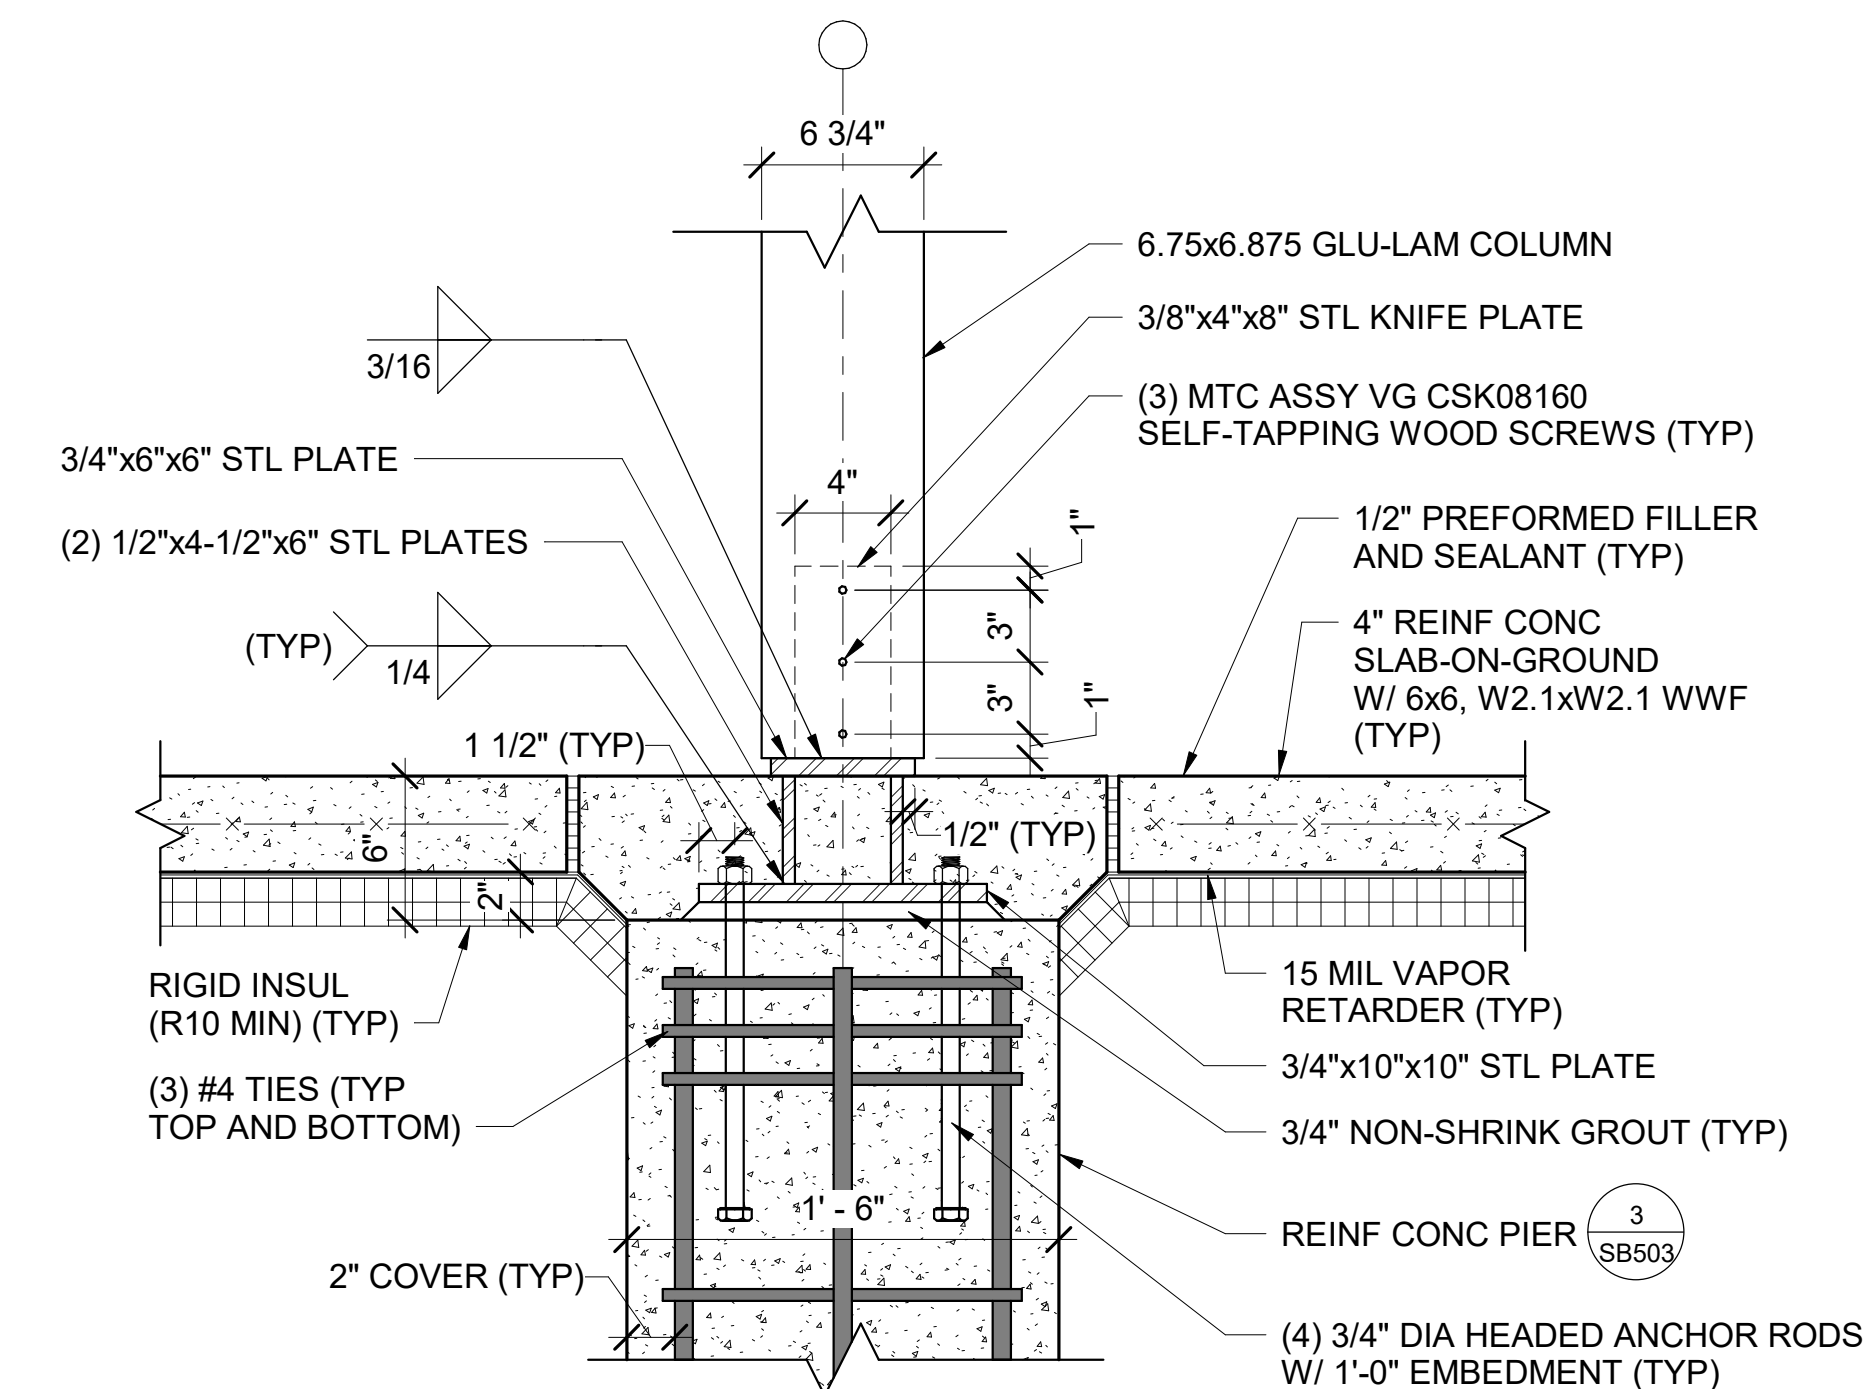


8 6.75x6.875 GLU-LAM COLUMN BASE PLATE DETAIL
SF604 SCALE: 1 1/2" = 1'-0"

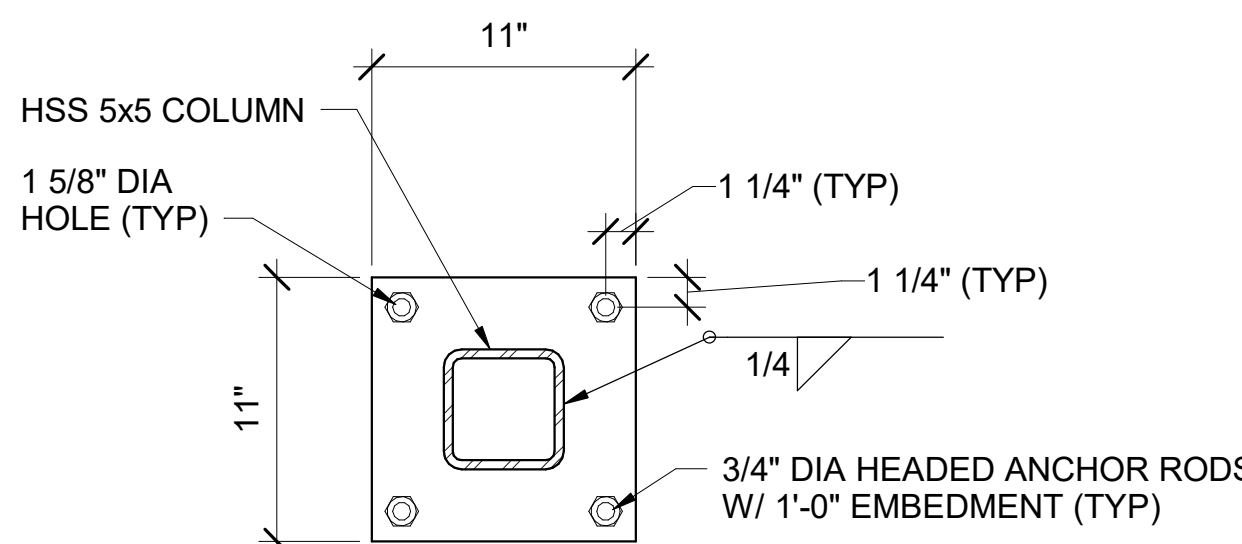


- NOTES**
- USE 1/2" PLATE AT HSS 5x5x1/4 COLUMNS.
 - USE 3/4" PLATE AT HSS 5x5x5/16 COLUMNS.
 - USE 3/4" PLATE AT HSS 5x5x3/8 COLUMNS.
 - PROVIDE 3/4" MAXIMUM NON-SHRINK GROUT UNDER BASE PLATES.

9 TYP HSS COLUMN BASE PLATE DETAIL
SF604 SCALE: 1 1/2" = 1'-0"

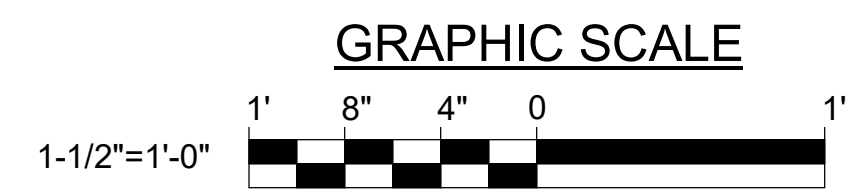

DRAWN BY: MJC		CHECK BY: DNM	
DATE: 01/29/2025		DATE: 01/29/2025	
REVISIONS		NO. DATE DESCRIPTION BY	
1 03/13/2025 ADDENDUM NO. 6		DNM	


STATE OF MAINE DAVID N. MARTIN No. 9622 REGISTERED PROFESSIONAL ENGINEER		DEPARTMENT OF INLAND FISHERIES & WILDLIFE TITLE: NEW OFFICE HEADQUARTERS LOCATION: AUGUSTA, ME TITLE THIS DWG: COLUMN BASE PLATE DETAILS	
OAK POINT ASSOCIATES		DRAWING NO. SF604 SHEET NO. 96 OF 239	

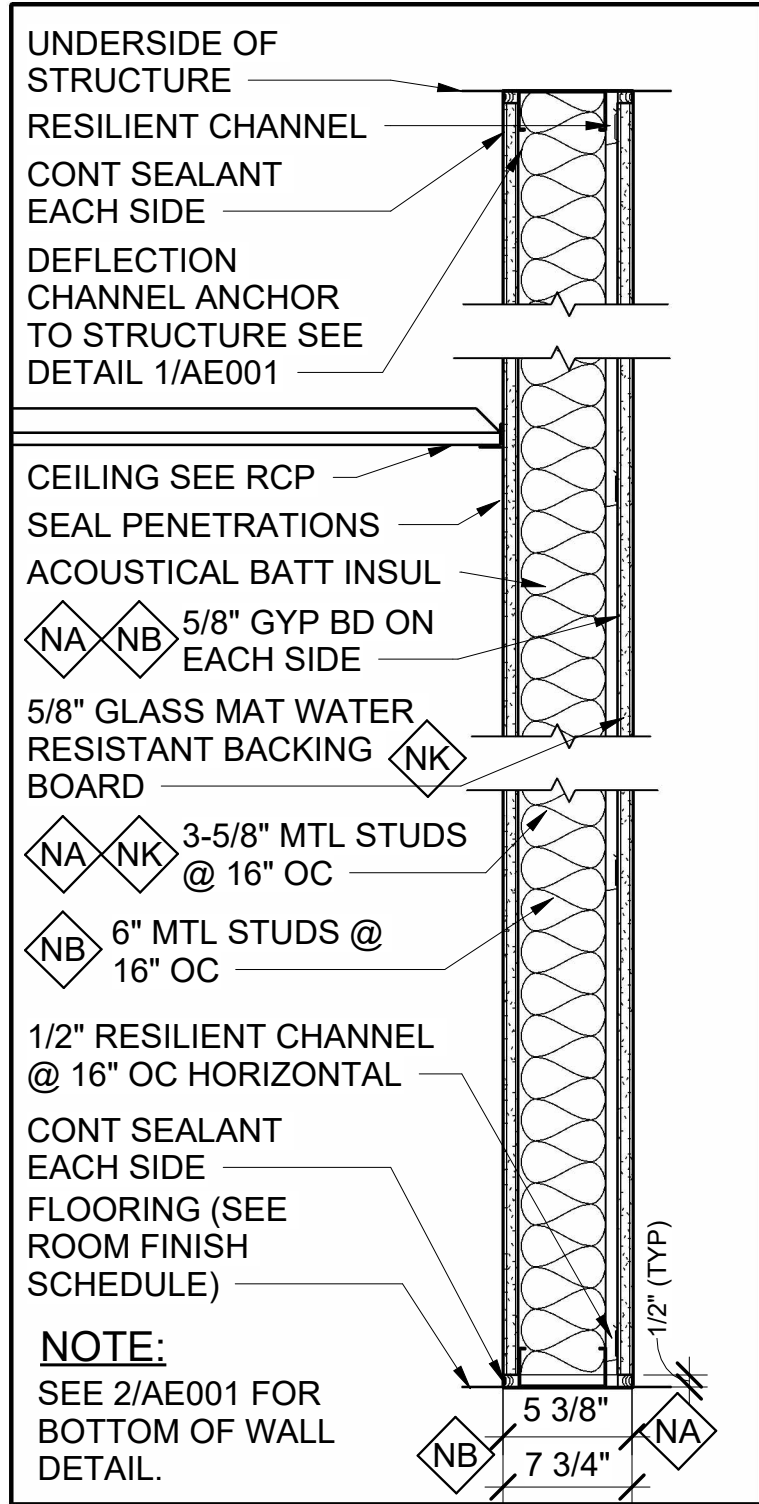

3-5/8" MTL STUD W/ 1/2" RESILIENT CHANNEL FULL HGT


6" MTL STUD W/ 1/2" RESILIENT CHANNEL FULL HGT

3-5/8" MTL STUD W/ 1/2" RESILIENT CHANNEL FULL HGT

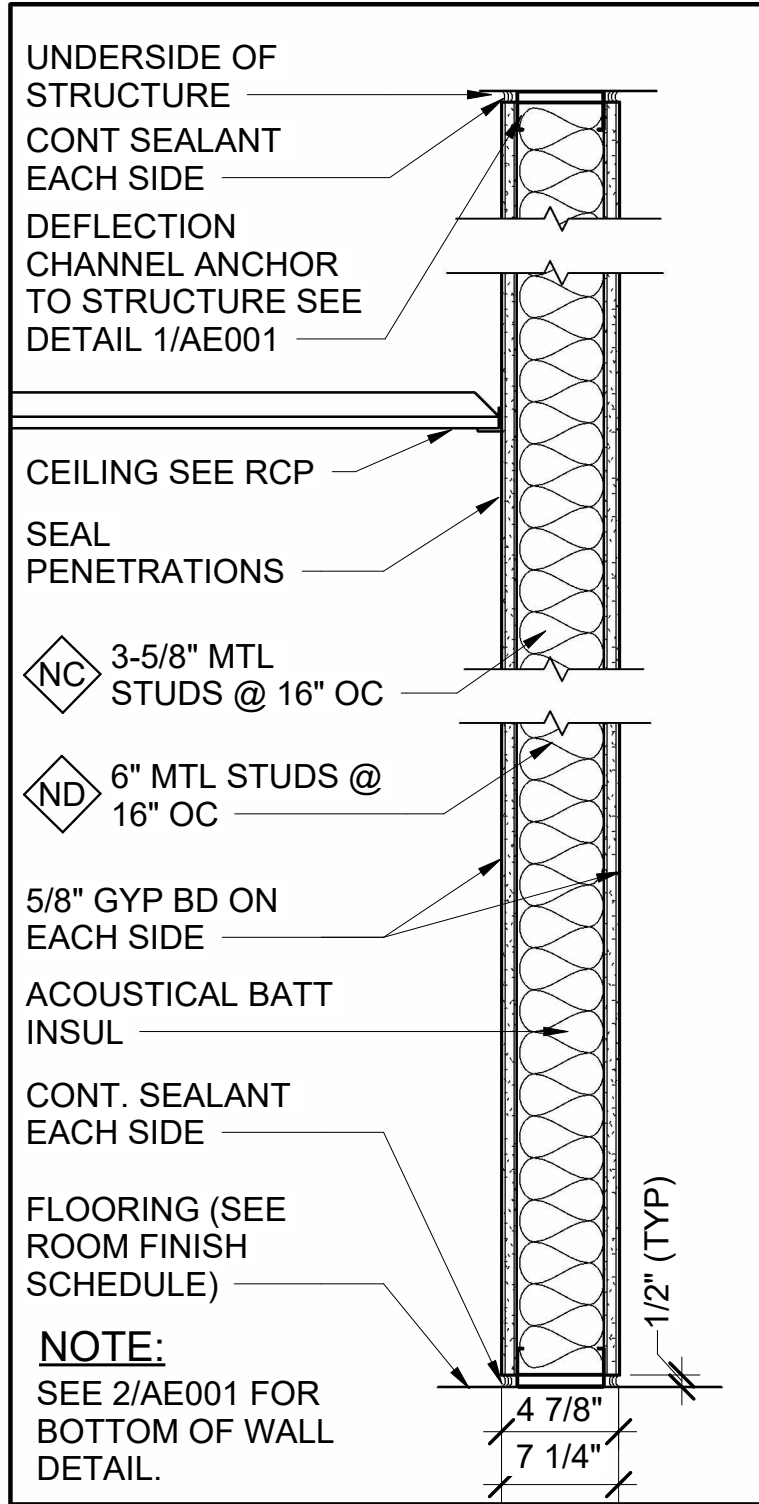


3-5/8" MTL STUD FULL HGT 5/8" GYP BD EACH SIDE


6" MTL STUD FULL HGT

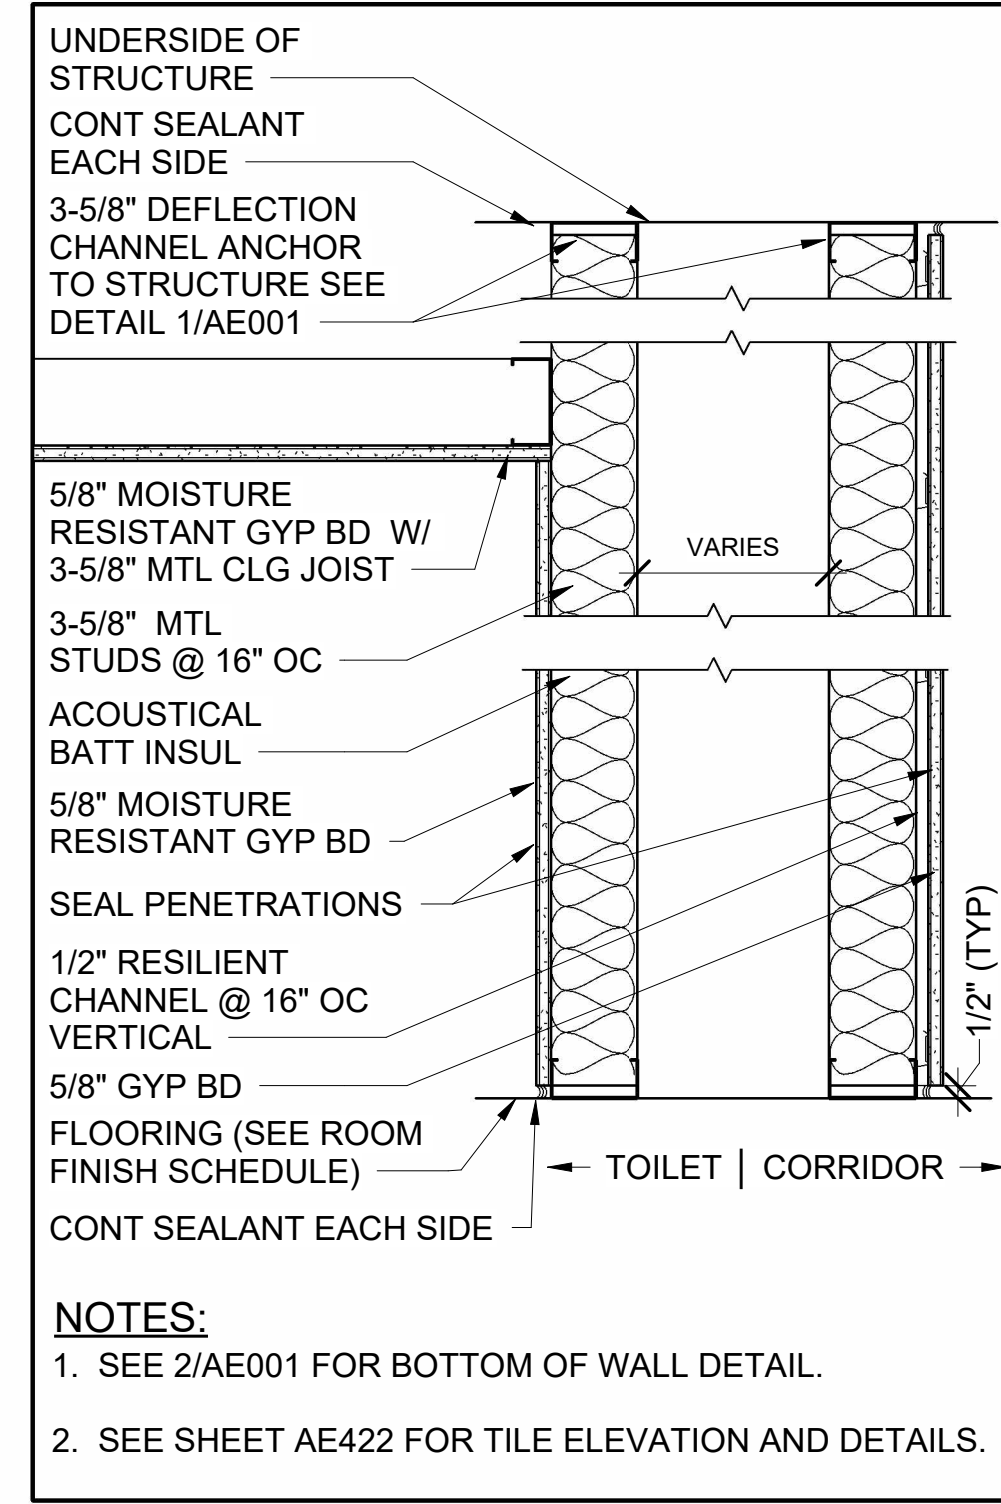


3-5/8" MTL STUD CHASE WALL FULL HEIGHT W/ WALL TILE

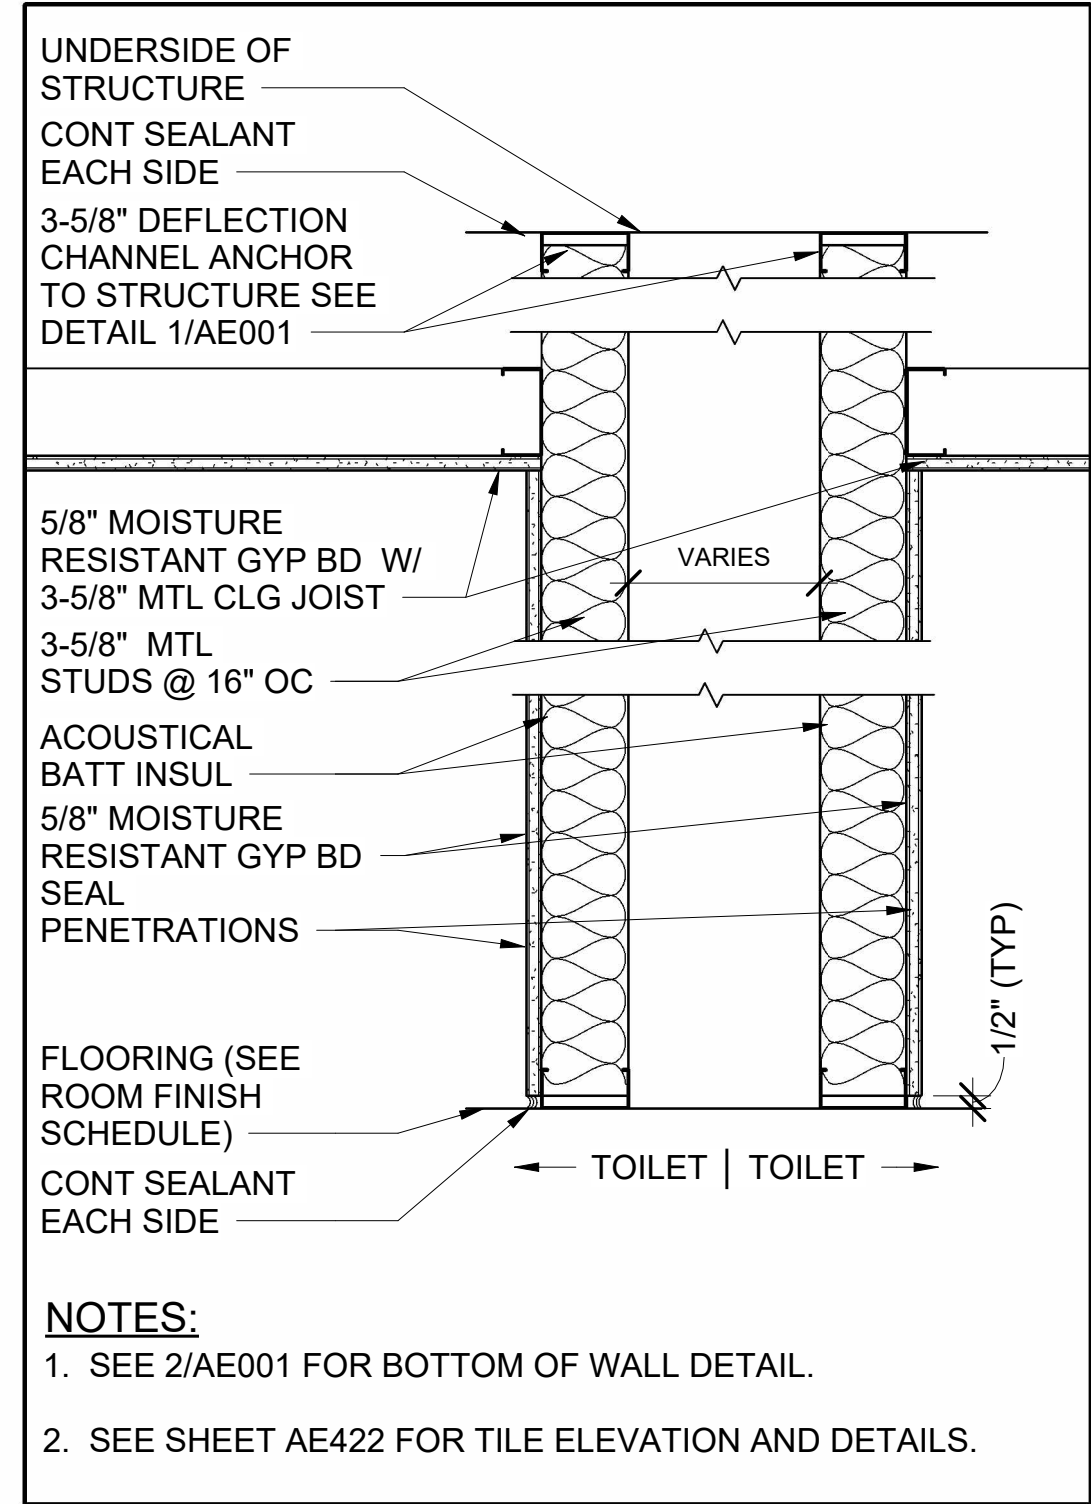

3-5/8" MTL STUD CHASE WALL FULL HEIGHT W/ WALL TILE BOTH SIDES

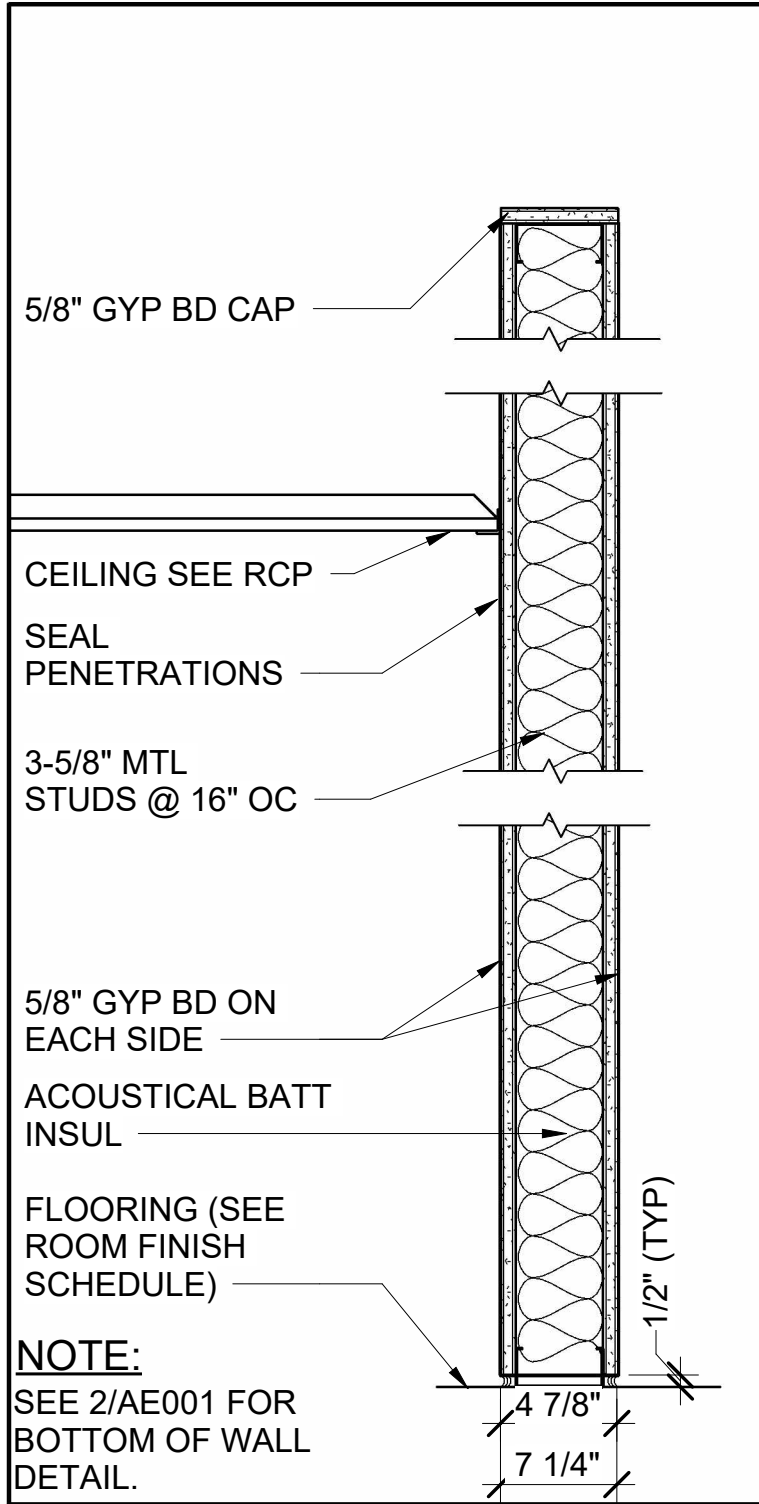


3-5/8" MTL STUD PARTIAL HGT 12'-0" AFF

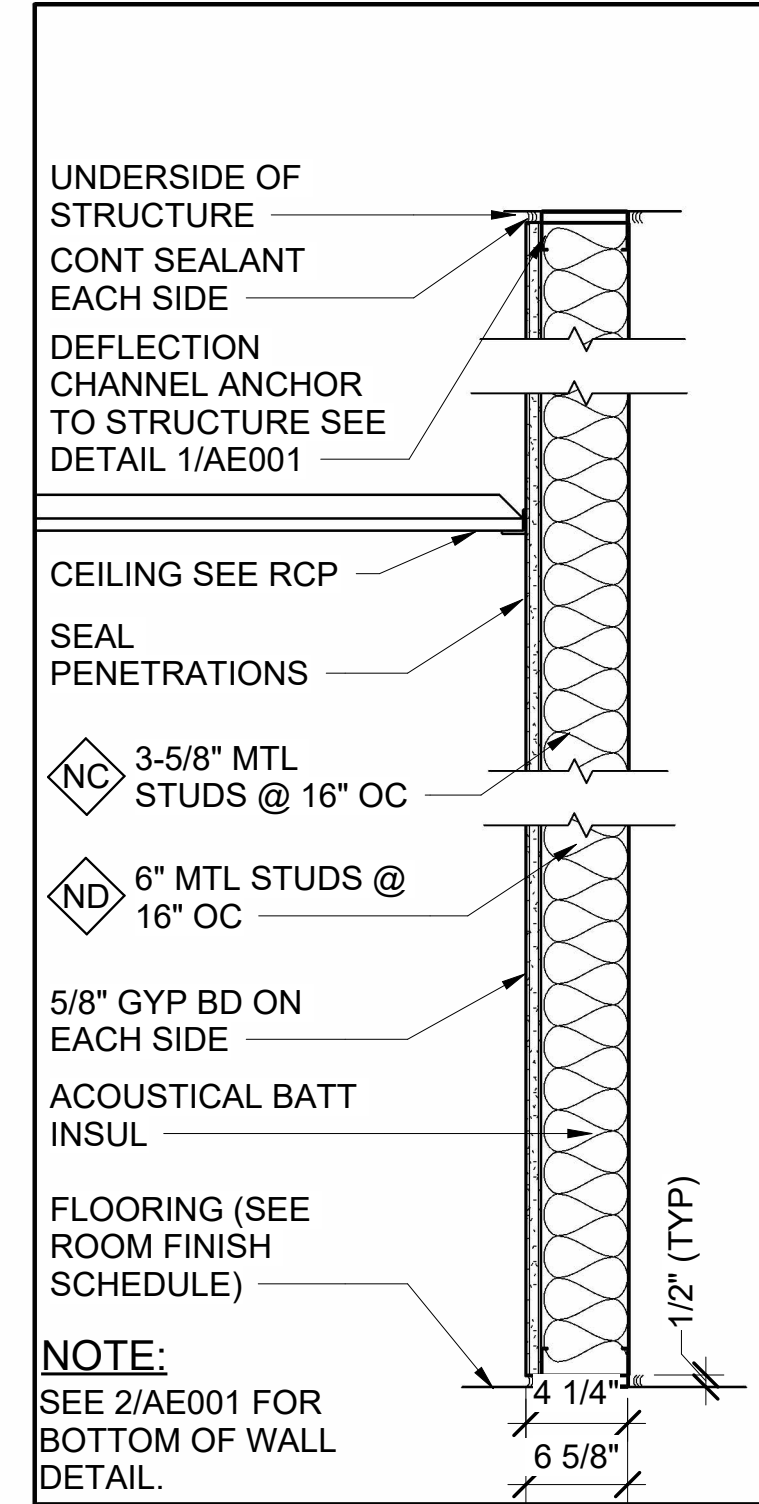


3-5/8" MTL STUD FULL HGT 5/8" GYP BD ONE SIDE


1-5/8" MTL STUD FULL HGT 5/8" GYP BD ONE SIDE

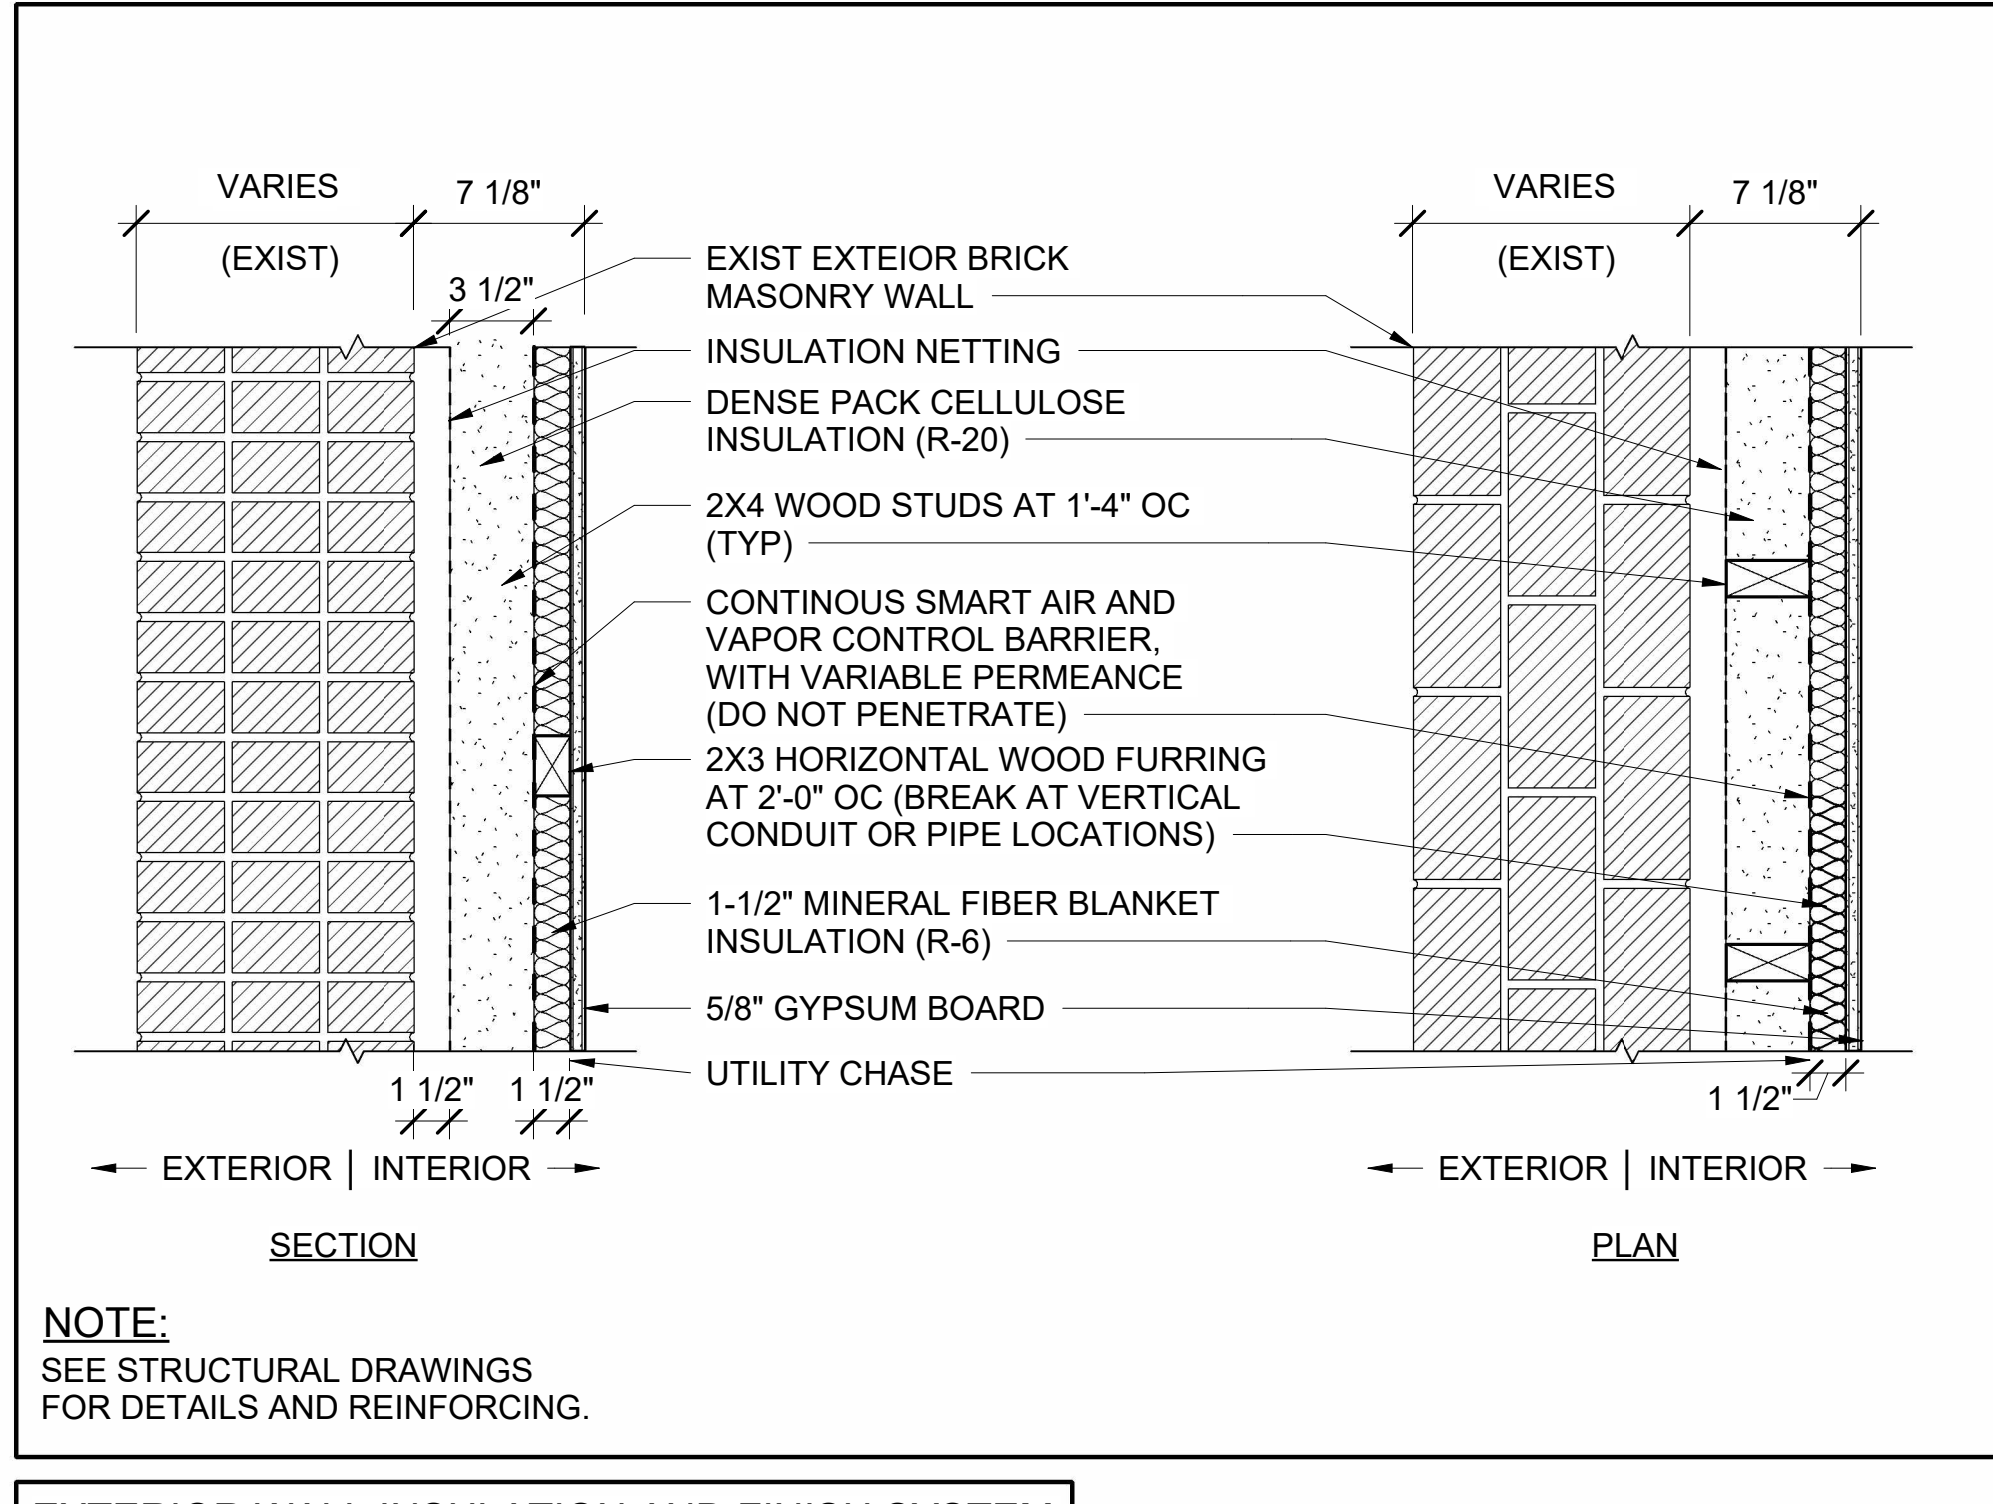


EXTERIOR WALL INSULATION AND FINISH SYSTEM NON-FIRE RATED

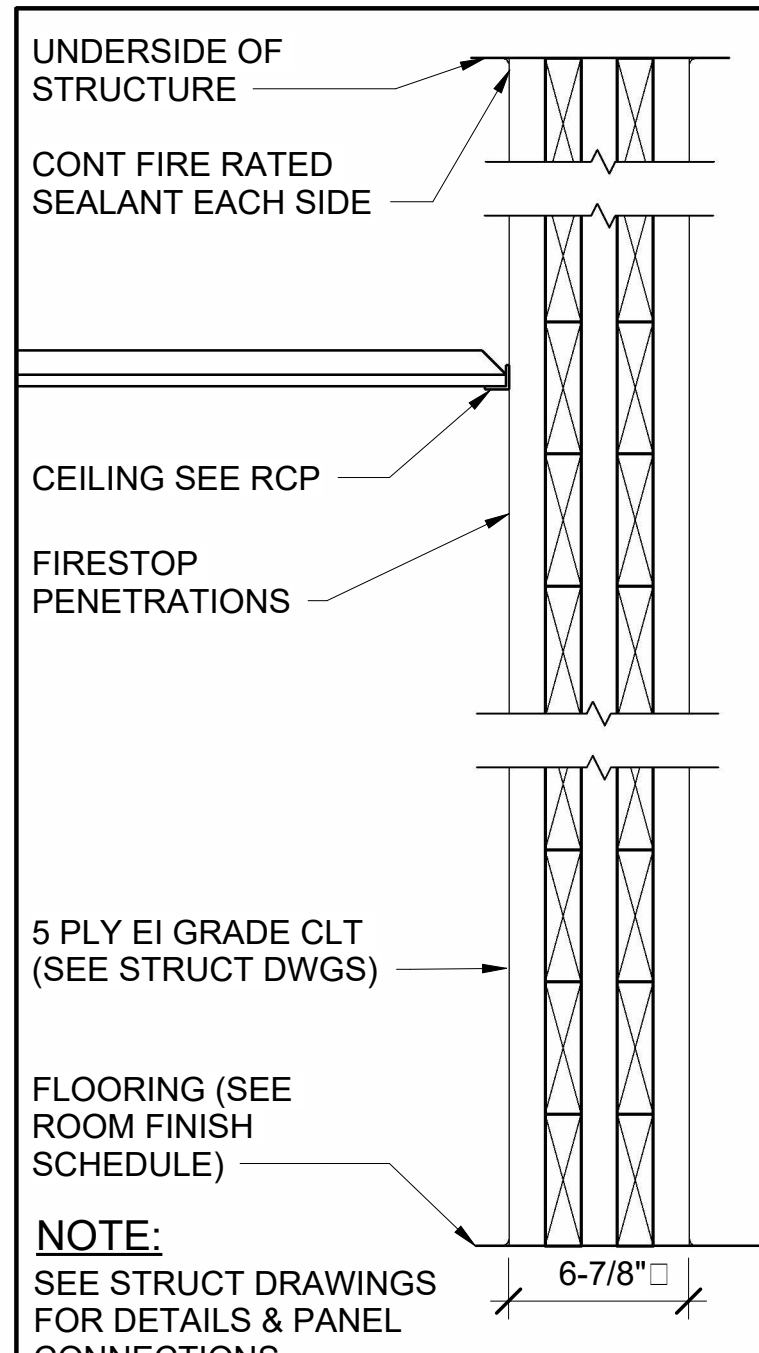

5-PLY CLT 1 HOUR RATED UL (V320)

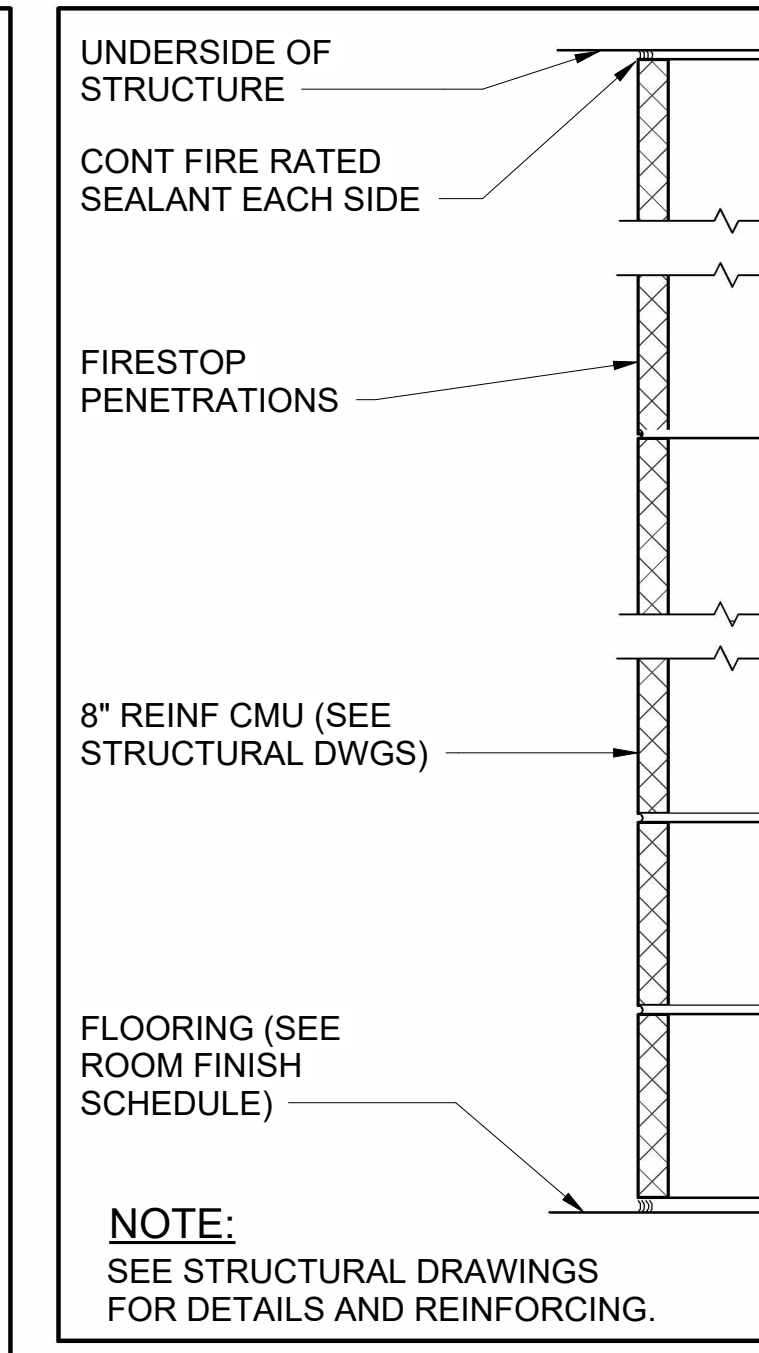


8" REINFORCED CMU 1 HOUR RATED UL U906

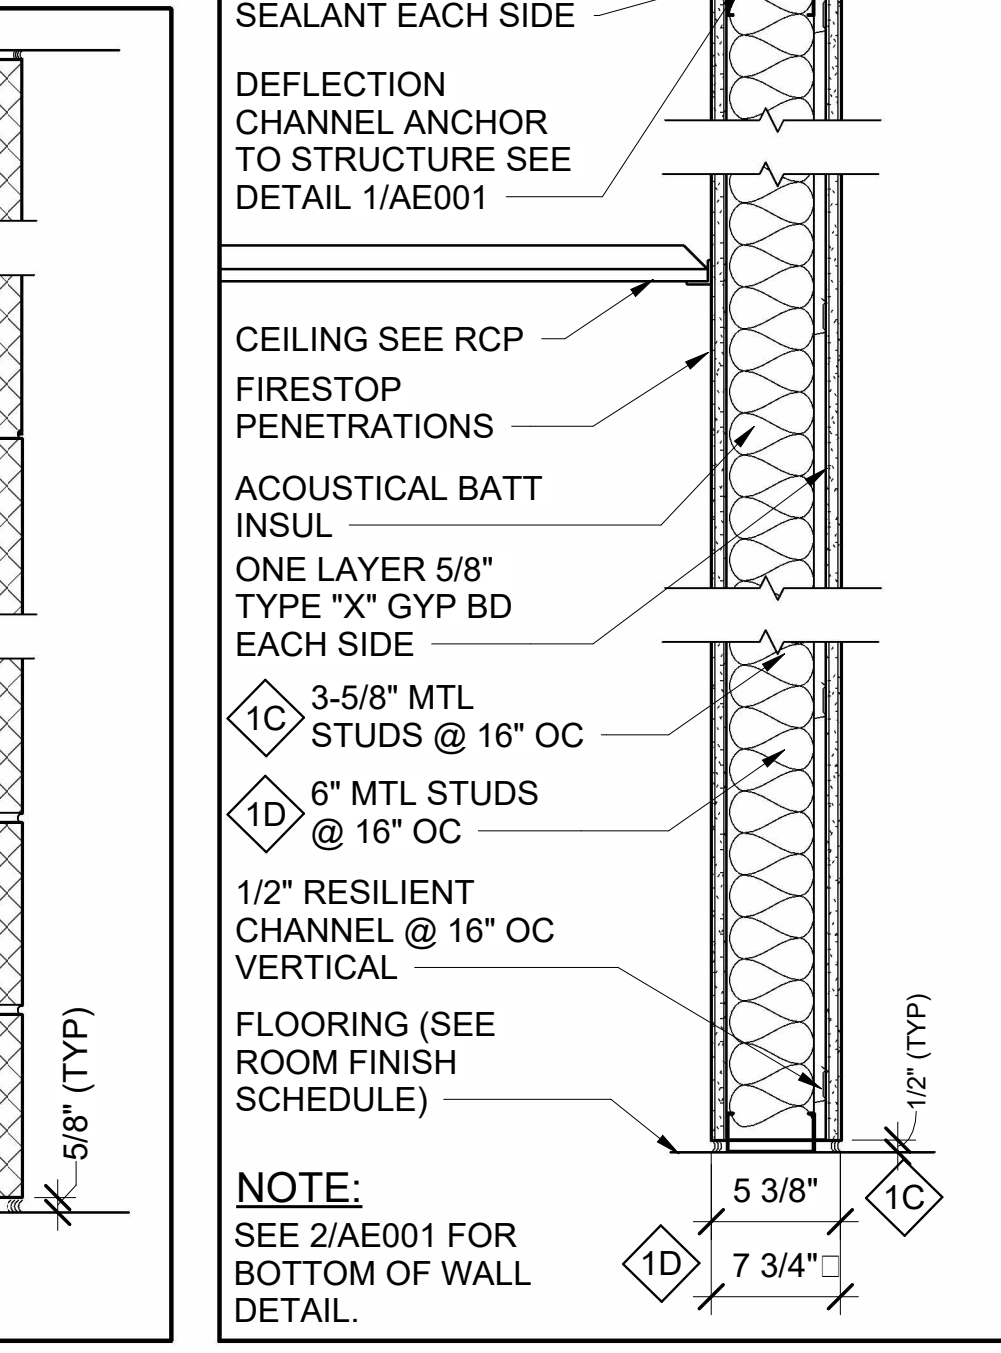


3 5/8" MTL STUD FULL HGT W/ 1/2" RESILIENT CHANNEL FULL HGT, 1 HOUR RATED UL U465


6" MTL STUD FULL HGT W/ 1/2" RESILIENT CHANNEL FULL HGT, 1 HOUR RATED UL U465 (SIM)

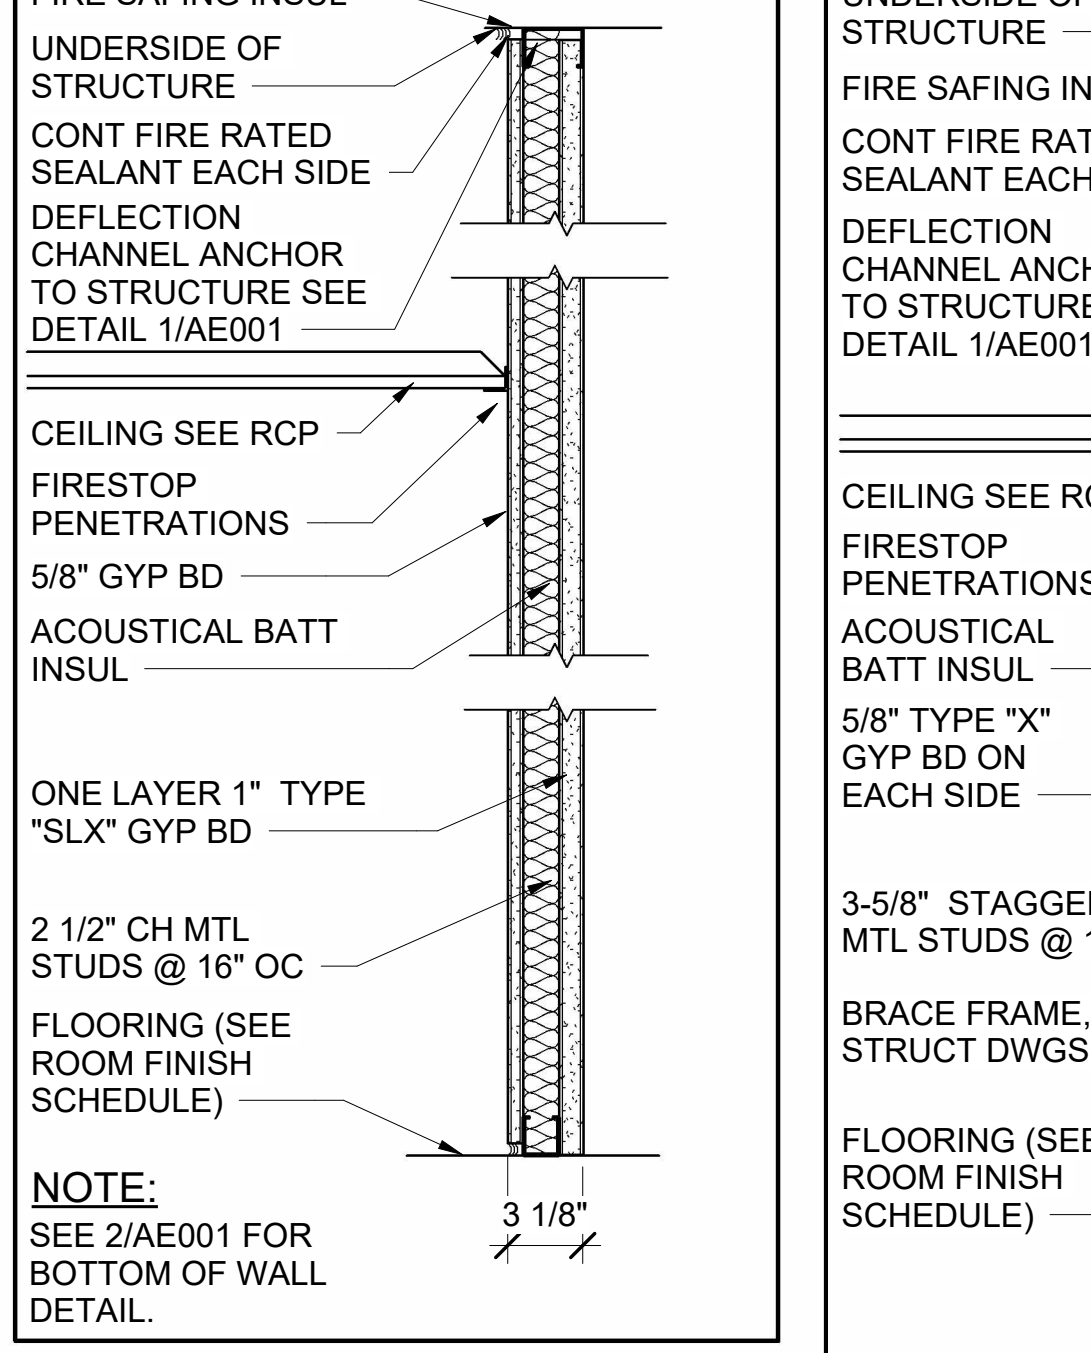


2 1/2" CH MTL STUD W/ 1/2" RESILIENT CHANNEL FULL HGT 1 HOUR RATED UL U415

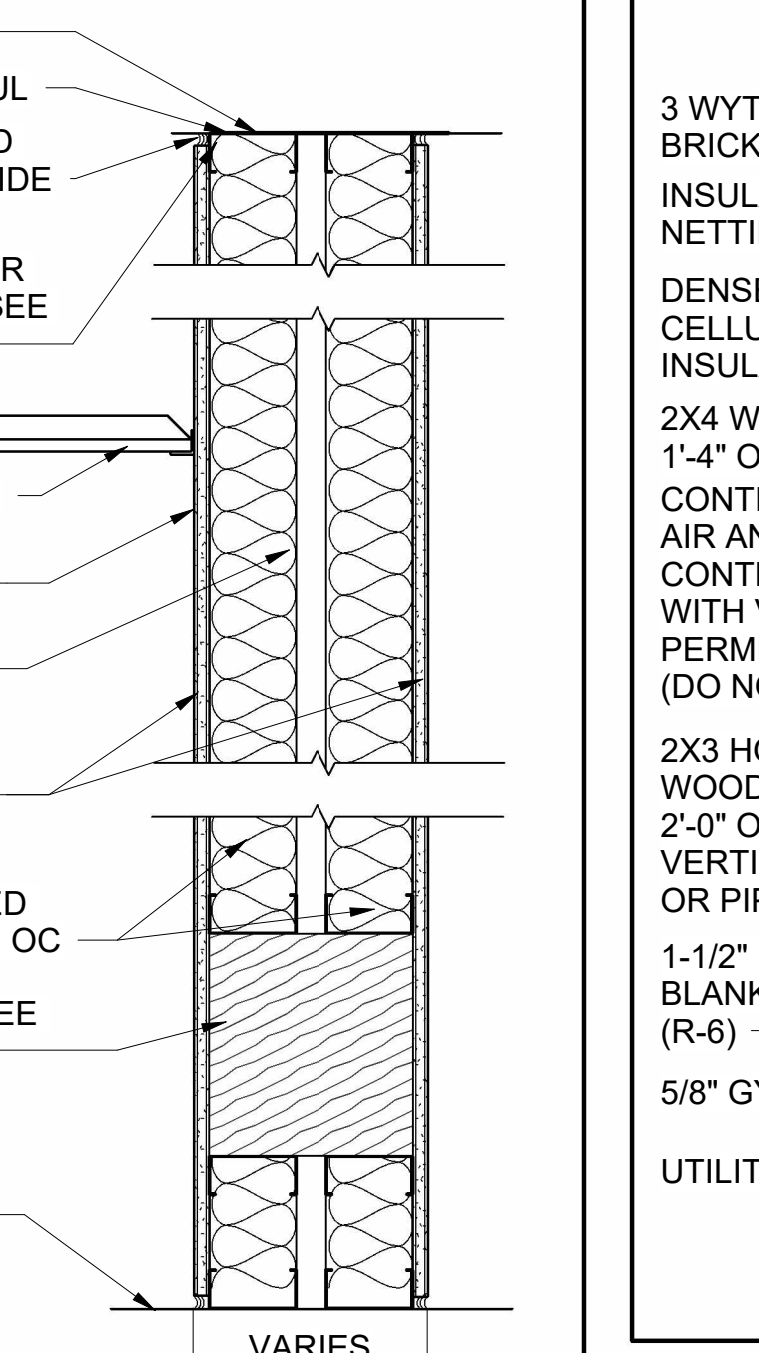


3 5/8" DOUBLE MTL STUD FULL HGT 1 HOUR RATED UL U493

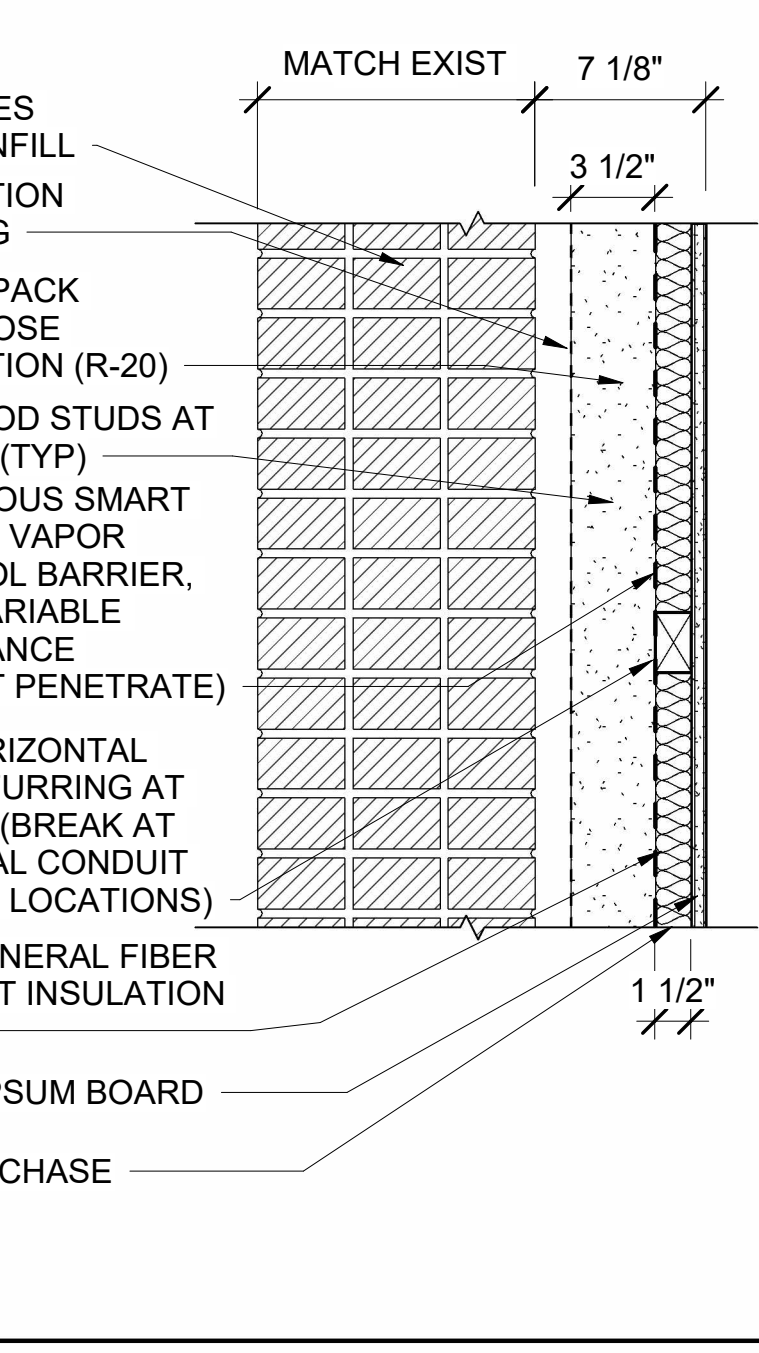


EXISTING EXTERIOR WALL INFILL 2HR FIRE RESISTANCE BASED ON IBC TABLE 722.4.1(1)

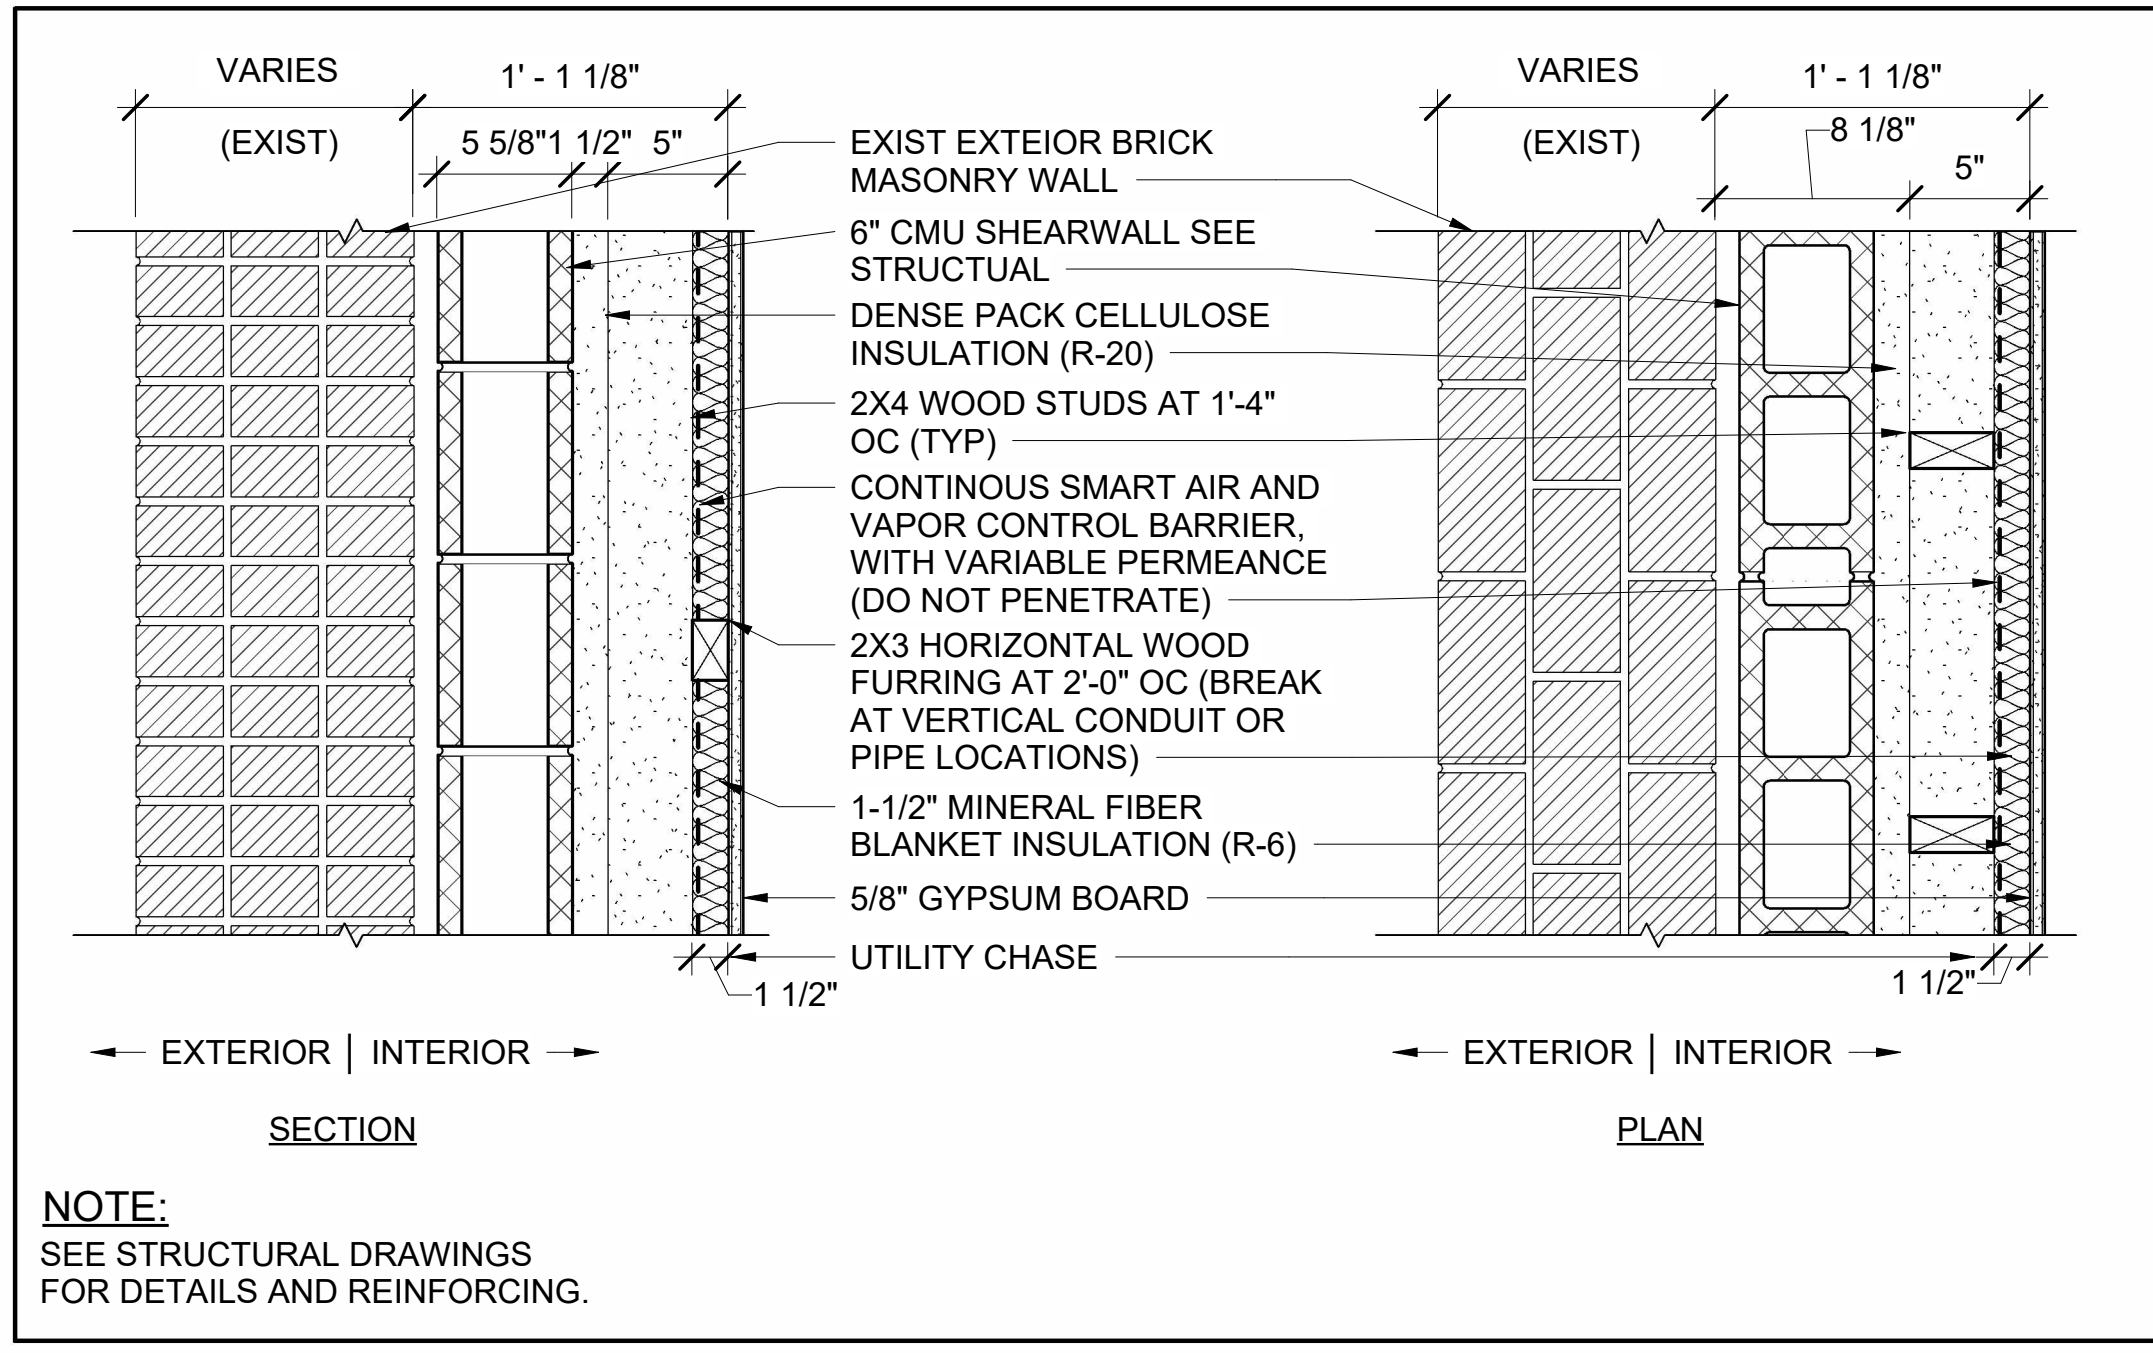


EXTERIOR WALL INSULATION AND FINISH SYSTEM NON-FIRE RATED

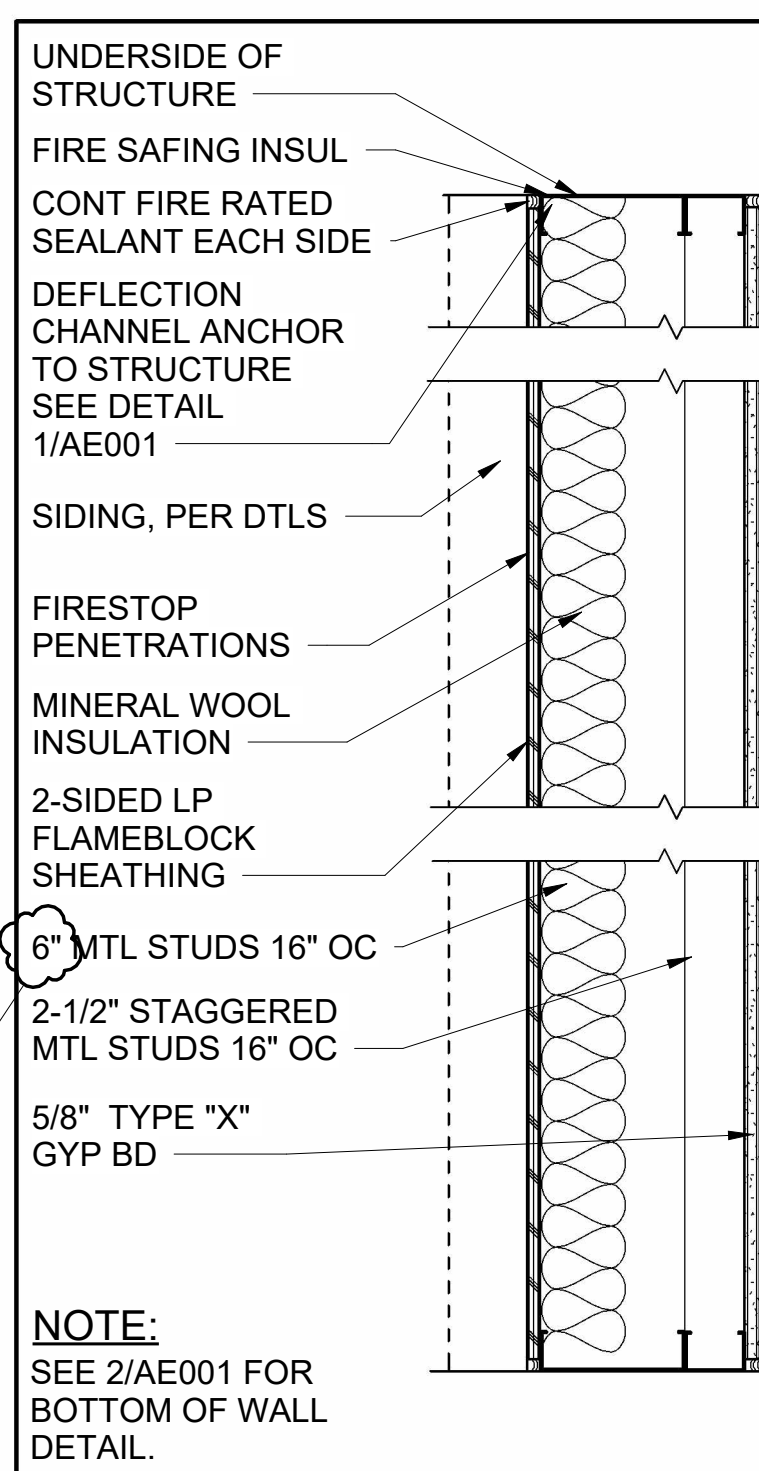


2-1/2" MTL STUD FULL HGT 1 HOUR RATED V337

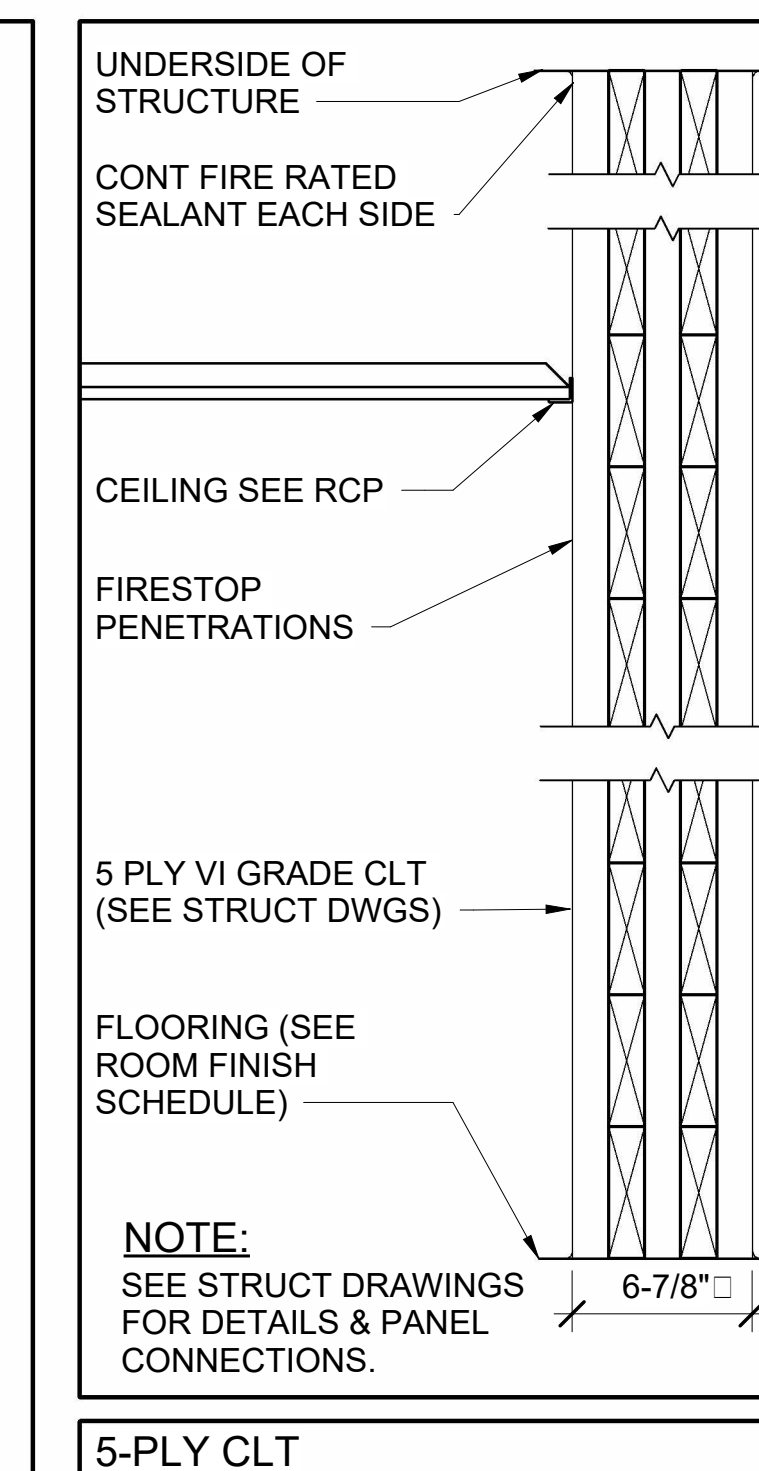


5-PLY CLT 2 HOUR RATED WESTERN FIRE CENTER 1/26/2017

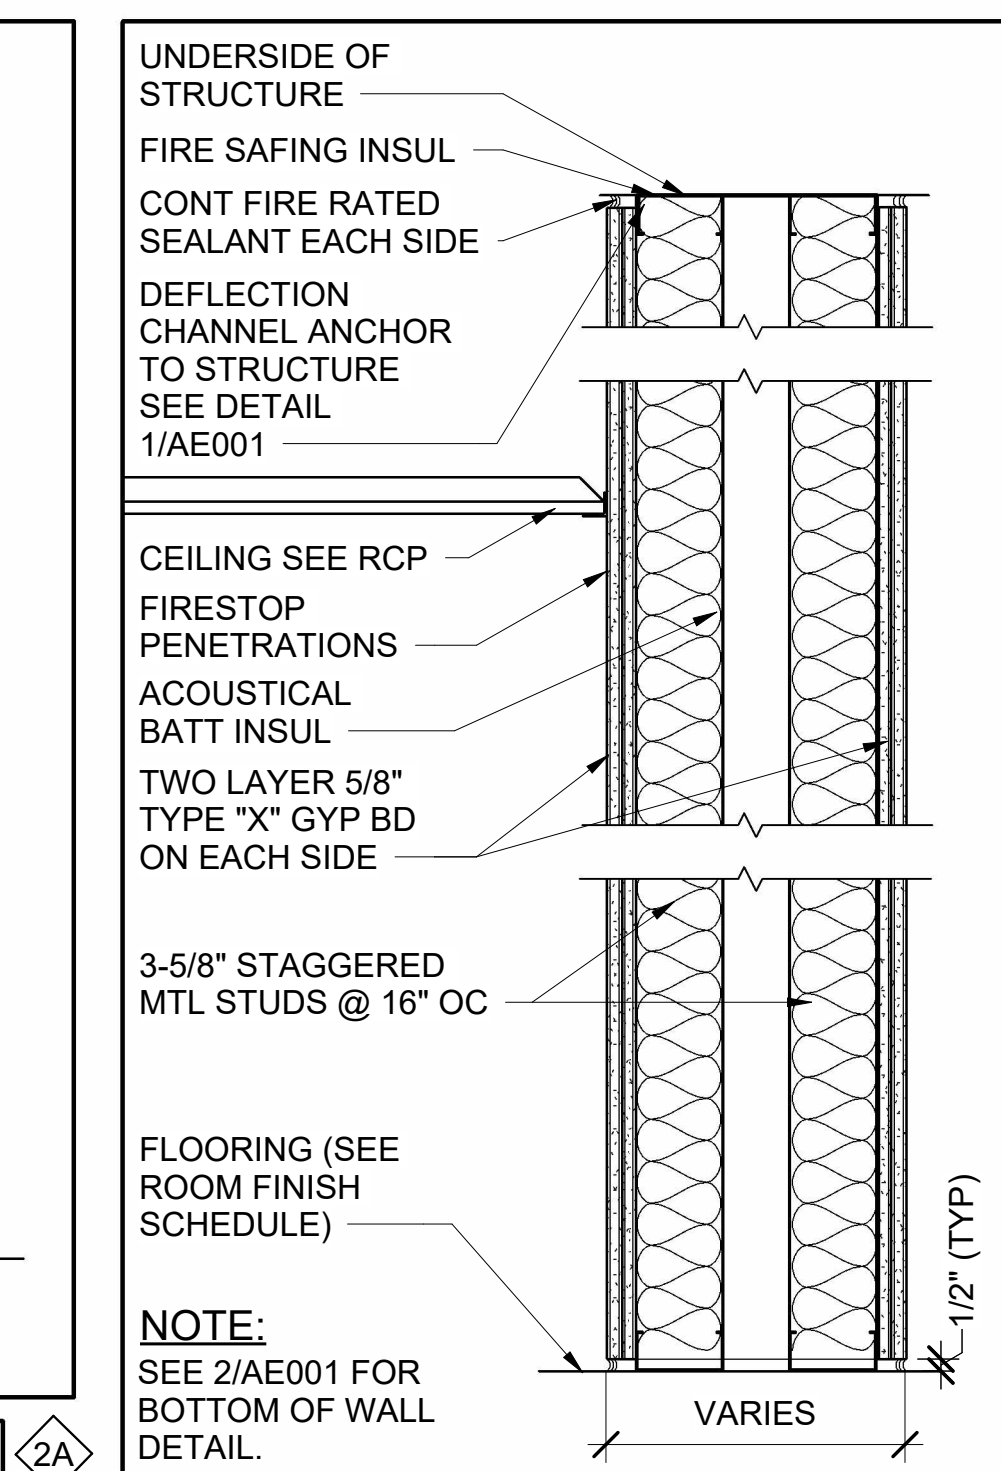


3-5/8" DOUBLE MTL STUD FULL HGT 2 HOUR RATED UL U493

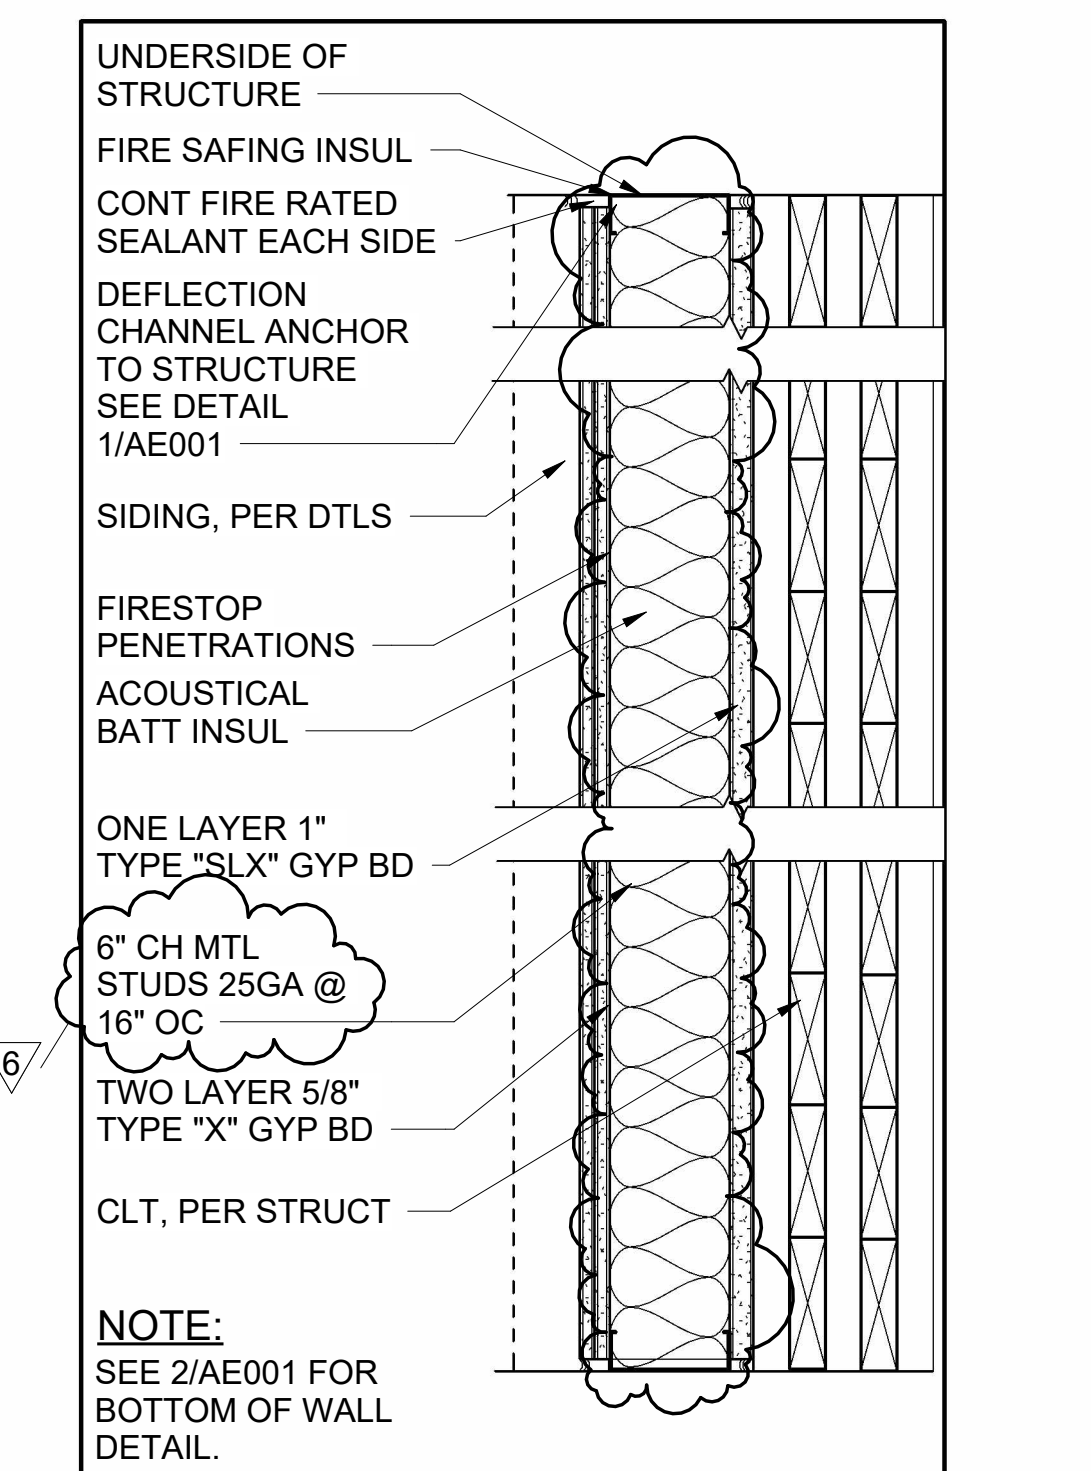

6" CH MTL STUD FULL HGT 2 HOUR RATED UL U415

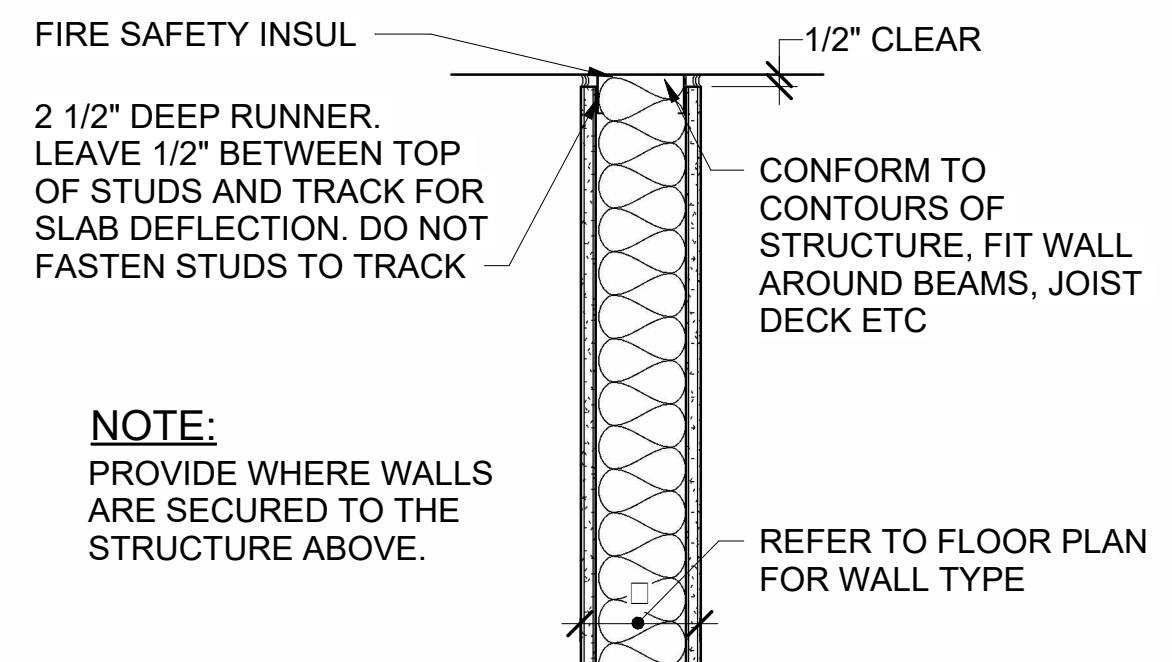


1 DEFLECTION CHANNEL DETAIL (TYP)

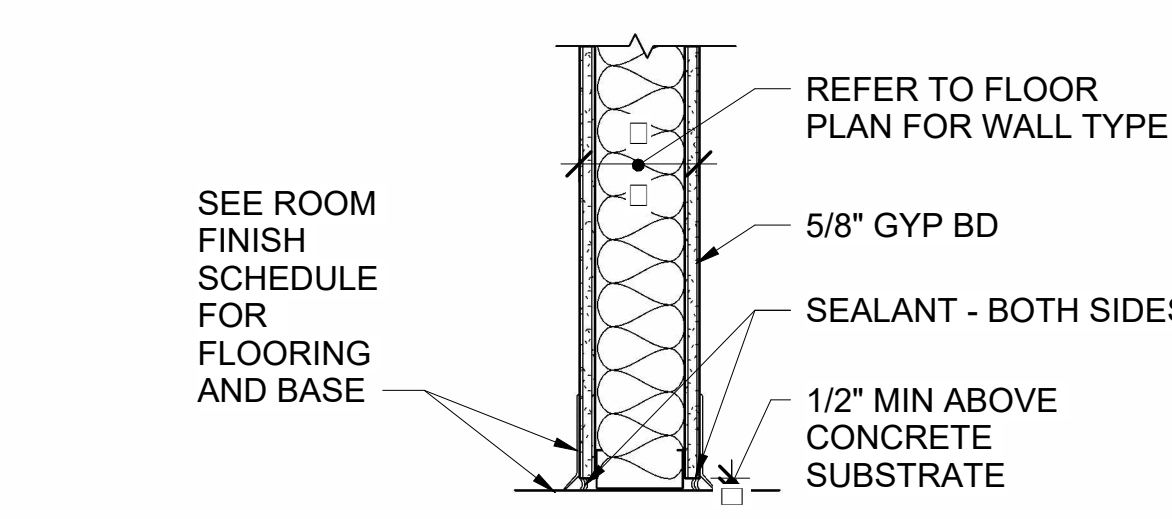

2 GYP BD SILL DETAIL (TYP)


AE001 AE001 SCALE: 1 1/2" = 1'-0"

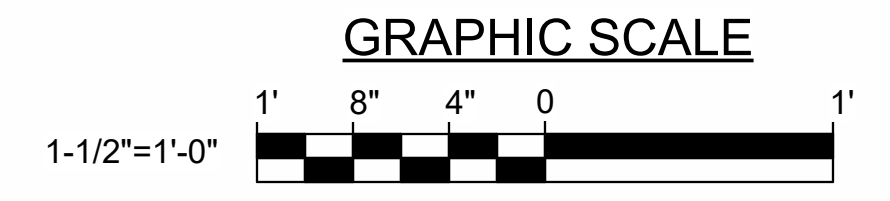

CHECK GRAPHIC SCALE BEFORE USING

- GENERAL NOTES:** (THIS SHEET ONLY)
- PROVIDE 5/8" ABUSE RESISTANT (VERY HIGH IMPACT) GYPSUM BOARD AT ALL EXPOSED CORRIDOR WALLS TO 8'-0" MINIMUM ABOVE FINISH FLOOR AND AS INDICATED.
 - SEE STRUCTURAL DRAWINGS FOR MASONRY WALL REINFORCING.
 - SEE ROOM FINISH SCHEDULES ON AE640 AND AE641 FOR WALL FINISHES.
 - SEE REFLECTED CEILING PLANS FOR ACT AND GYPSUM BOARD CEILING HEIGHTS; AE701- AE704.
 - GYPSUM BOARD WALLS WITH CERAMIC TILE FINISH SHALL HAVE 5/8" MOISTURE RESISTANT GYP BD. COORDINATE CERAMIC TILE WAINSCOTING WITH INTERIOR TOILET ELEVATIONS AND FINISH SCHEDULES.
 - AT FIRE RESISTANT RATED ASSEMBLIES PROVIDE TESTED AND LISTED FIRESTOP SYSTEMS TO MAINTAIN THE INTEGRITY OF THE FIRE RESISTANT RATING. AREAS REQUIRING FIRESTOP SYSTEMS INCLUDE MEMBRANE PENETRATIONS, THROUGH PENETRATIONS, JOINTS BETWEEN ASSEMBLIES AND CONSTRUCTION JOINTS. PROVIDE ENGINEERING JUDGEMENT IF LISTED ASSEMBLY IS UNAVAILABLE.
 - AT SMOKE BARRIERS AND SMOKE PARTITIONS PROVIDE SEALANT TO MAINTAIN THE INTEGRITY OF THE SMOKE RESISTANCE OF THE ASSEMBLY. AREAS REQUIRING SEALANT INCLUDE MEMBRANE PENETRATIONS, THROUGH PENETRATIONS, JOINTS BETWEEN ASSEMBLIES AND CONSTRUCTION JOINTS.
 - WHERE FLOORS INTERSECT EXTERIOR CURTAIN WALLS, PROVIDE A JOINT SYSTEM THAT IS CAPABLE OF LIMITING THE TRANSFER OF SMOKE.
 - REFER TO SHEET AE520 FOR RATED WALL PENETRATION DETAILS.
 - AT NON-RATED WALL ASSEMBLIES SEAL MEMBRANE PENETRATIONS, THROUGH PENETRATIONS, JOINTS BETWEEN ASSEMBLIES AND CONSTRUCTION JOINTS WITH ACOUSTICAL SEALANT.

				DEPARTMENT OF INLAND FISHERIES & WILDLIFE	
TITLE: NEW OFFICE HEADQUARTERS				LOCATION: AUGUSTA, ME	
TITLE THIS DWG: WALL TYPES AND DETAILS				SHEET NO: AE001	
NO. DATE DESCRIPTION BY				CHECK BY: CET	
REVISIONS				DATE: 01/29/2025	
6 03/13/2025 ADDENDUM NO.6				HMG	
1 02/13/2025 ADDENDUM NO.1				HMG	
231 Main Street, Biddeford, Maine 04005				207.283.9192	

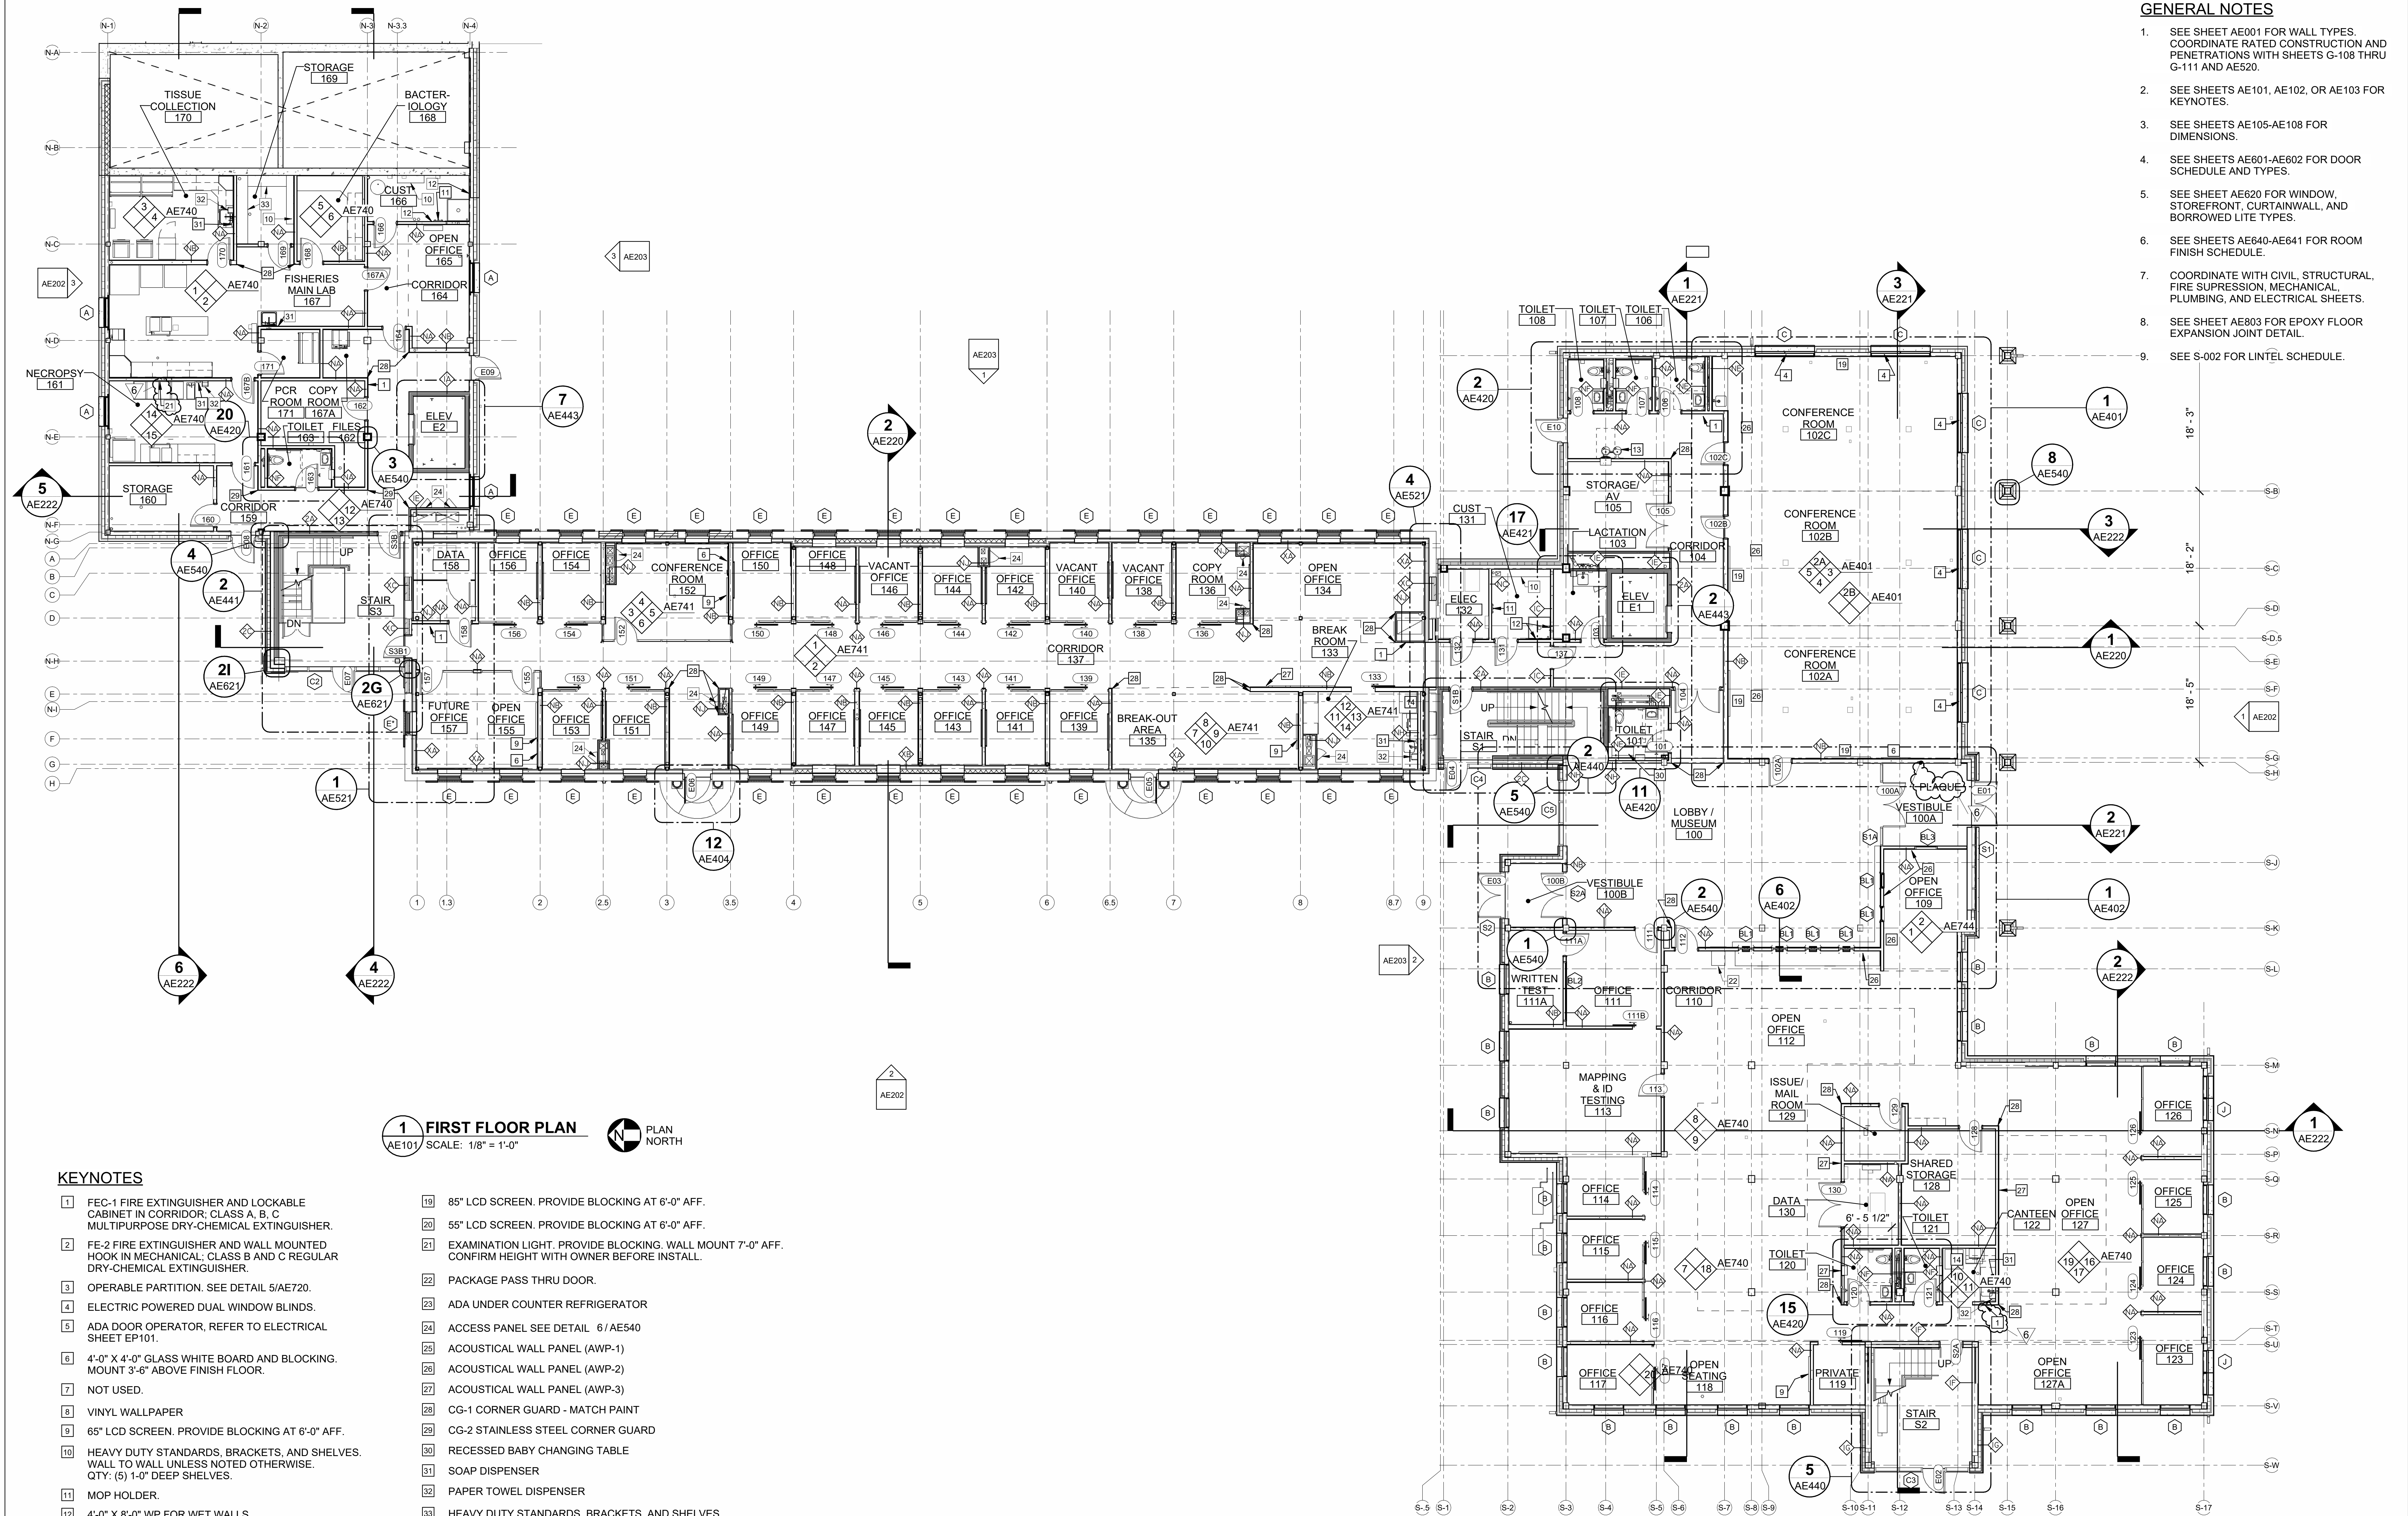


- GENERAL NOTES**
- SEE SHEET AE001 FOR WALL TYPES. COORDINATE RATED CONSTRUCTION AND PENETRATIONS WITH SHEETS G-108 THRU G-111 AND AE520.
 - SEE SHEETS AE101, AE102, OR AE103 FOR KEYNOTES.
 - SEE SHEETS AE105-AE108 FOR DIMENSIONS.
 - SEE SHEETS AE601-AE602 FOR DOOR SCHEDULE AND TYPES.
 - SEE SHEET AE620 FOR WINDOW, STOREFRONT, CURTAINWALL, AND BORROWED LITE TYPES.
 - SEE SHEETS AE640-AE641 FOR ROOM FINISH SCHEDULE.
 - COORDINATE WITH CIVIL, STRUCTURAL, FIRE SUPPRESSION, MECHANICAL, PLUMBING, AND ELECTRICAL SHEETS.
 - SEE SHEET AE803 FOR EPOXY FLOOR EXPANSION JOINT DETAIL.
 - SEE S-002 FOR LINTEL SCHEDULE.

KEYNOTES

- FEC-1 FIRE EXTINGUISHER AND LOCKABLE CABINET IN CORRIDOR; CLASS A, B, C MULTIPURPOSE DRY-CHEMICAL EXTINGUISHER.
- FE-2 FIRE EXTINGUISHER AND WALL MOUNTED HOOK IN MECHANICAL; CLASS B AND C REGULAR DRY-CHEMICAL EXTINGUISHER.
- OPERABLE PARTITION. SEE DETAIL 5/AE720.
- ELECTRIC POWERED DUAL WINDOW BLINDS.
- ADA DOOR OPERATOR, REFER TO ELECTRICAL SHEET EP101.
- 4'-0" X 4'-0" GLASS WHITE BOARD AND BLOCKING. MOUNT 3'-6" ABOVE FINISH FLOOR.
- NOT USED.
- VINYL WALLPAPER
- 65" LCD SCREEN. PROVIDE BLOCKING AT 6'-0" AFF.
- HEAVY DUTY STANDARDS, BRACKETS, AND SHELVES. WALL TO WALL UNLESS NOTED OTHERWISE. QTY: (5) 1'-0" DEEP SHELVES.
- MOP HOLDER.
- 4'-0" X 8'-0" WP FOR WET WALLS.
- WATER FOUNTAIN AND/OR BOTTLE FILLER. COORDINATE WITH PLUMBING SHEETS.
- RESIDENTIAL REFRIGERATOR WITH ADA CONTROLS (NIC).
- COUNTERTOP MICROWAVE (NIC).
- COPIER (NIC).
- FLUSH WALL ACCESS PANEL. BOTTOM 6" AFF.
- WADER HANGER. BASIS OF DESIGN" RED HEAD WADER HANGER.
- 85" LCD SCREEN. PROVIDE BLOCKING AT 6'-0" AFF.
- 55" LCD SCREEN. PROVIDE BLOCKING AT 6'-0" AFF.
- EXAMINATION LIGHT. PROVIDE BLOCKING. WALL MOUNT 7'-0" AFF. CONFIRM HEIGHT WITH OWNER BEFORE INSTALL.
- PACKAGE PASS THRU DOOR.
- ADA UNDER COUNTER REFRIGERATOR
- ACCESS PANEL SEE DETAIL 6/AE540
- ACOUSTICAL WALL PANEL (AWP-1)
- ACOUSTICAL WALL PANEL (AWP-2)
- ACOUSTICAL WALL PANEL (AWP-3)
- CG-1 CORNER GUARD - MATCH PAINT
- CG-2 STAINLESS STEEL CORNER GUARD
- RECESSED BABY CHANGING TABLE
- SOAP DISPENSER
- PAPER TOWEL DISPENSER
- HEAVY DUTY STANDARDS, BRACKETS, AND SHELVES. WALL TO WALL UNLESS NOTED OTHERWISE. QTY: (5) 18" DEEP SHELVES.


1 FIRST FLOOR PLAN
SCALE: 1/8" = 1'-0"
PLAN NORTH

GRAPHIC SCALE

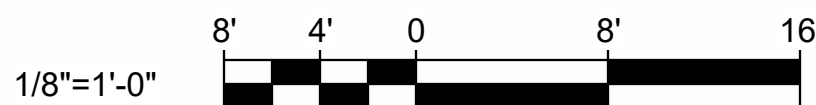

CHECK GRAPHIC SCALE BEFORE USING

--	--	
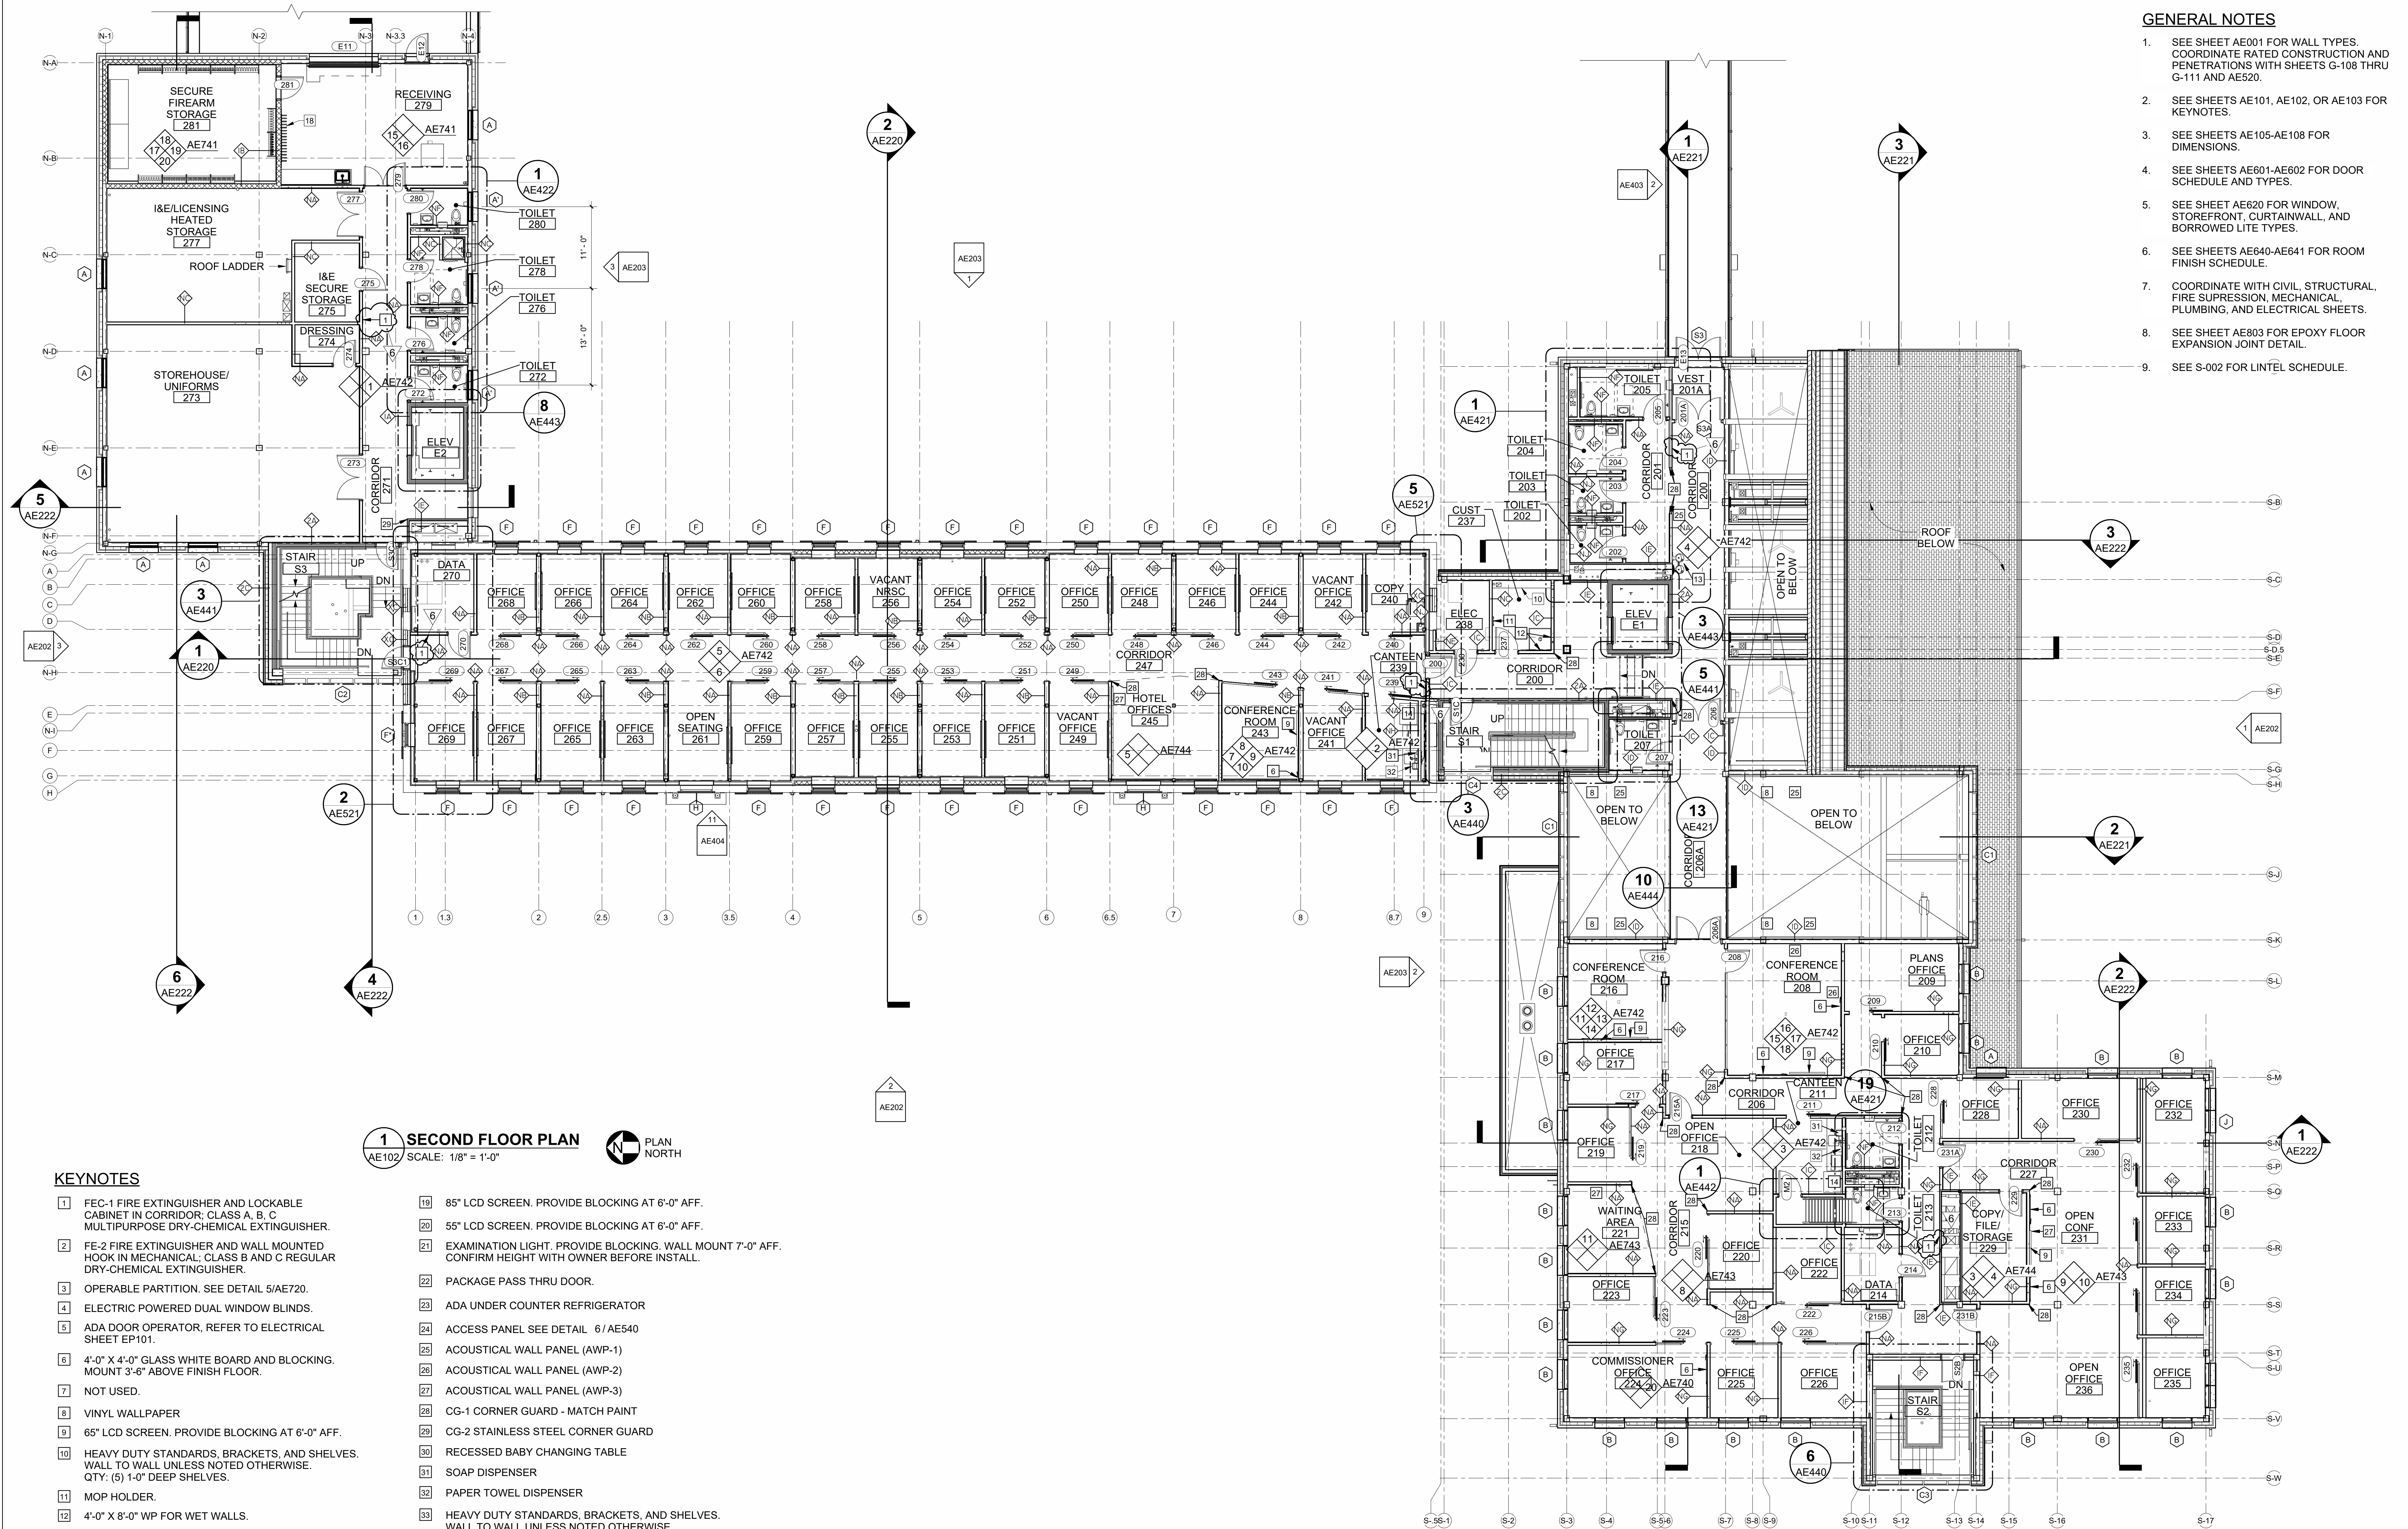

1 SECOND FLOOR PLAN
AE102 SCALE: 1/8" = 1'-0"




KEYNOTES

- 1 FEC-1 FIRE EXTINGUISHER AND LOCKABLE CABINET IN CORRIDOR; CLASS A, B, C MULTIPURPOSE DRY-CHEMICAL EXTINGUISHER.
- 2 FE-2 FIRE EXTINGUISHER AND WALL MOUNTED HOOK IN MECHANICAL; CLASS B AND C REGULAR DRY-CHEMICAL EXTINGUISHER.
- 3 OPERABLE PARTITION. SEE DETAIL 5/AE720.
- 4 ELECTRIC POWERED DUAL WINDOW BLINDS.
- 5 ADA DOOR OPERATOR, REFER TO ELECTRICAL SHEET EP101.
- 6 4'-0" X 4'-0" GLASS WHITE BOARD AND BLOCKING. MOUNT 3'-6" ABOVE FINISH FLOOR.
- 7 NOT USED.
- 8 VINYL WALLPAPER
- 9 65" LCD SCREEN. PROVIDE BLOCKING AT 6'-0" AFF.
- 10 HEAVY DUTY STANDARDS, BRACKETS, AND SHELVES. WALL TO WALL UNLESS NOTED OTHERWISE. QTY: (5) 1'-0" DEEP SHELVES.
- 11 MOP HOLDER.
- 12 4'-0" X 8'-0" WP FOR WET WALLS.
- 13 WATER FOUNTAIN AND/OR BOTTLE FILLER. COORDINATE WITH PLUMBING SHEETS.
- 14 RESIDENTIAL REFRIGERATOR WITH ADA CONTROLS (NIC).
- 15 COUNTERTOP MICROWAVE (NIC).
- 16 COPIER (NIC).
- 17 FLUSH WALL ACCESS PANEL. BOTTOM 6" AFF.
- 18 WADER HANGER. BASIS OF DESIGN" RED HEAD WADER HANGER.
- 19 85" LCD SCREEN. PROVIDE BLOCKING AT 6'-0" AFF.
- 20 55" LCD SCREEN. PROVIDE BLOCKING AT 6'-0" AFF.
- 21 EXAMINATION LIGHT. PROVIDE BLOCKING. WALL MOUNT 7'-0" AFF. CONFIRM HEIGHT WITH OWNER BEFORE INSTALL.
- 22 PACKAGE PASS THRU DOOR.
- 23 ADA UNDER COUNTER REFRIGERATOR
- 24 ACCESS PANEL SEE DETAIL 6/AE540
- 25 ACOUSTICAL WALL PANEL (AWP-1)
- 26 ACOUSTICAL WALL PANEL (AWP-2)
- 27 ACOUSTICAL WALL PANEL (AWP-3)
- 28 CG-1 CORNER GUARD - MATCH PAINT
- 29 CG-2 STAINLESS STEEL CORNER GUARD
- 30 RECESSED BABY CHANGING TABLE
- 31 SOAP DISPENSER
- 32 PAPER TOWEL DISPENSER
- 33 HEAVY DUTY STANDARDS, BRACKETS, AND SHELVES. WALL TO WALL UNLESS NOTED OTHERWISE. QTY: (5) 18" DEEP SHELVES.

GENERAL NOTES

1. SEE SHEET AE001 FOR WALL TYPES. COORDINATE RATED CONSTRUCTION AND PENETRATIONS WITH SHEETS G-108 THRU G-111 AND AE520.
2. SEE SHEETS AE101, AE102, OR AE103 FOR KEYNOTES.
3. SEE SHEETS AE105-AE108 FOR DIMENSIONS.
4. SEE SHEETS AE601-AE602 FOR DOOR SCHEDULE AND TYPES.
5. SEE SHEET AE620 FOR WINDOW, STOREFRONT, CURTAINWALL, AND BORROWED LITE TYPES.
6. SEE SHEETS AE640-AE641 FOR ROOM FINISH SCHEDULE.
7. COORDINATE WITH CIVIL, STRUCTURAL, FIRE SUPPRESSION, MECHANICAL, PLUMBING, AND ELECTRICAL SHEETS.
8. SEE SHEET AE803 FOR EPOXY FLOOR EXPANSION JOINT DETAIL.
9. SEE S-002 FOR LINTEL SCHEDULE.

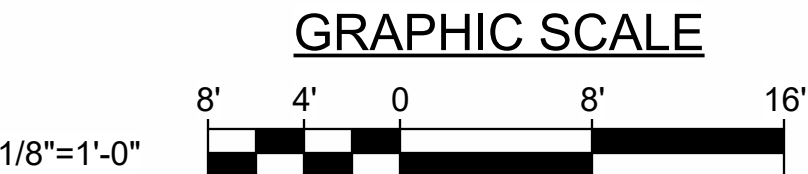

CHECK GRAPHIC SCALE BEFORE USING


		DEPARTMENT OF INLAND FISHERIES & WILDLIFE	
TITLE: NEW OFFICE HEADQUARTERS		LOCATION: AUGUSTA, ME	
TITLE THIS DWG: SECOND FLOOR PLAN		DRAWING NO: AE102	
DATE: 01/29/2025		SHEET NO: 101 OF 239	
REVISIONS		OAK POINT ASSOCIATES	
NO.	DATE	DESCRIPTION	BY
6	03/13/2025	ADDENDUM NO.6	HMG
3	02/27/2025	ADDENDUM NO.3	HMG
1	02/13/2025	ADDENDUM NO.1	HMG

GENERAL NOTES


- SEE SHEET AE001 FOR WALL TYPES. COORDINATE RATED CONSTRUCTION AND PENETRATIONS WITH SHEETS G-108 THRU G-111 AND AE520.
- SEE SHEETS AE101, AE102, OR AE103 FOR KEYNOTES.
- SEE SHEETS AE105-AE108 FOR DIMENSIONS.
- SEE SHEETS AE601-AE602 FOR DOOR SCHEDULE AND TYPES.
- SEE SHEET AE620 FOR WINDOW, STOREFRONT, CURTAINWALL, AND BORROWED LITE TYPES.
- SEE SHEETS AE640-AE641 FOR ROOM FINISH SCHEDULE.
- COORDINATE WITH CIVIL, STRUCTURAL, FIRE SUPPRESSION, MECHANICAL, PLUMBING, AND ELECTRICAL SHEETS.
- SEE SHEET AE803 FOR EPOXY FLOOR EXPANSION JOINT DETAIL.
- SEE S-002 FOR LINTEL SCHEDULE.

KEYNOTES: (THIS SHEET ONLY)


- 1 FOUNDATION WALL INFILL, SEE STRUCTURAL DWG 7/SB503

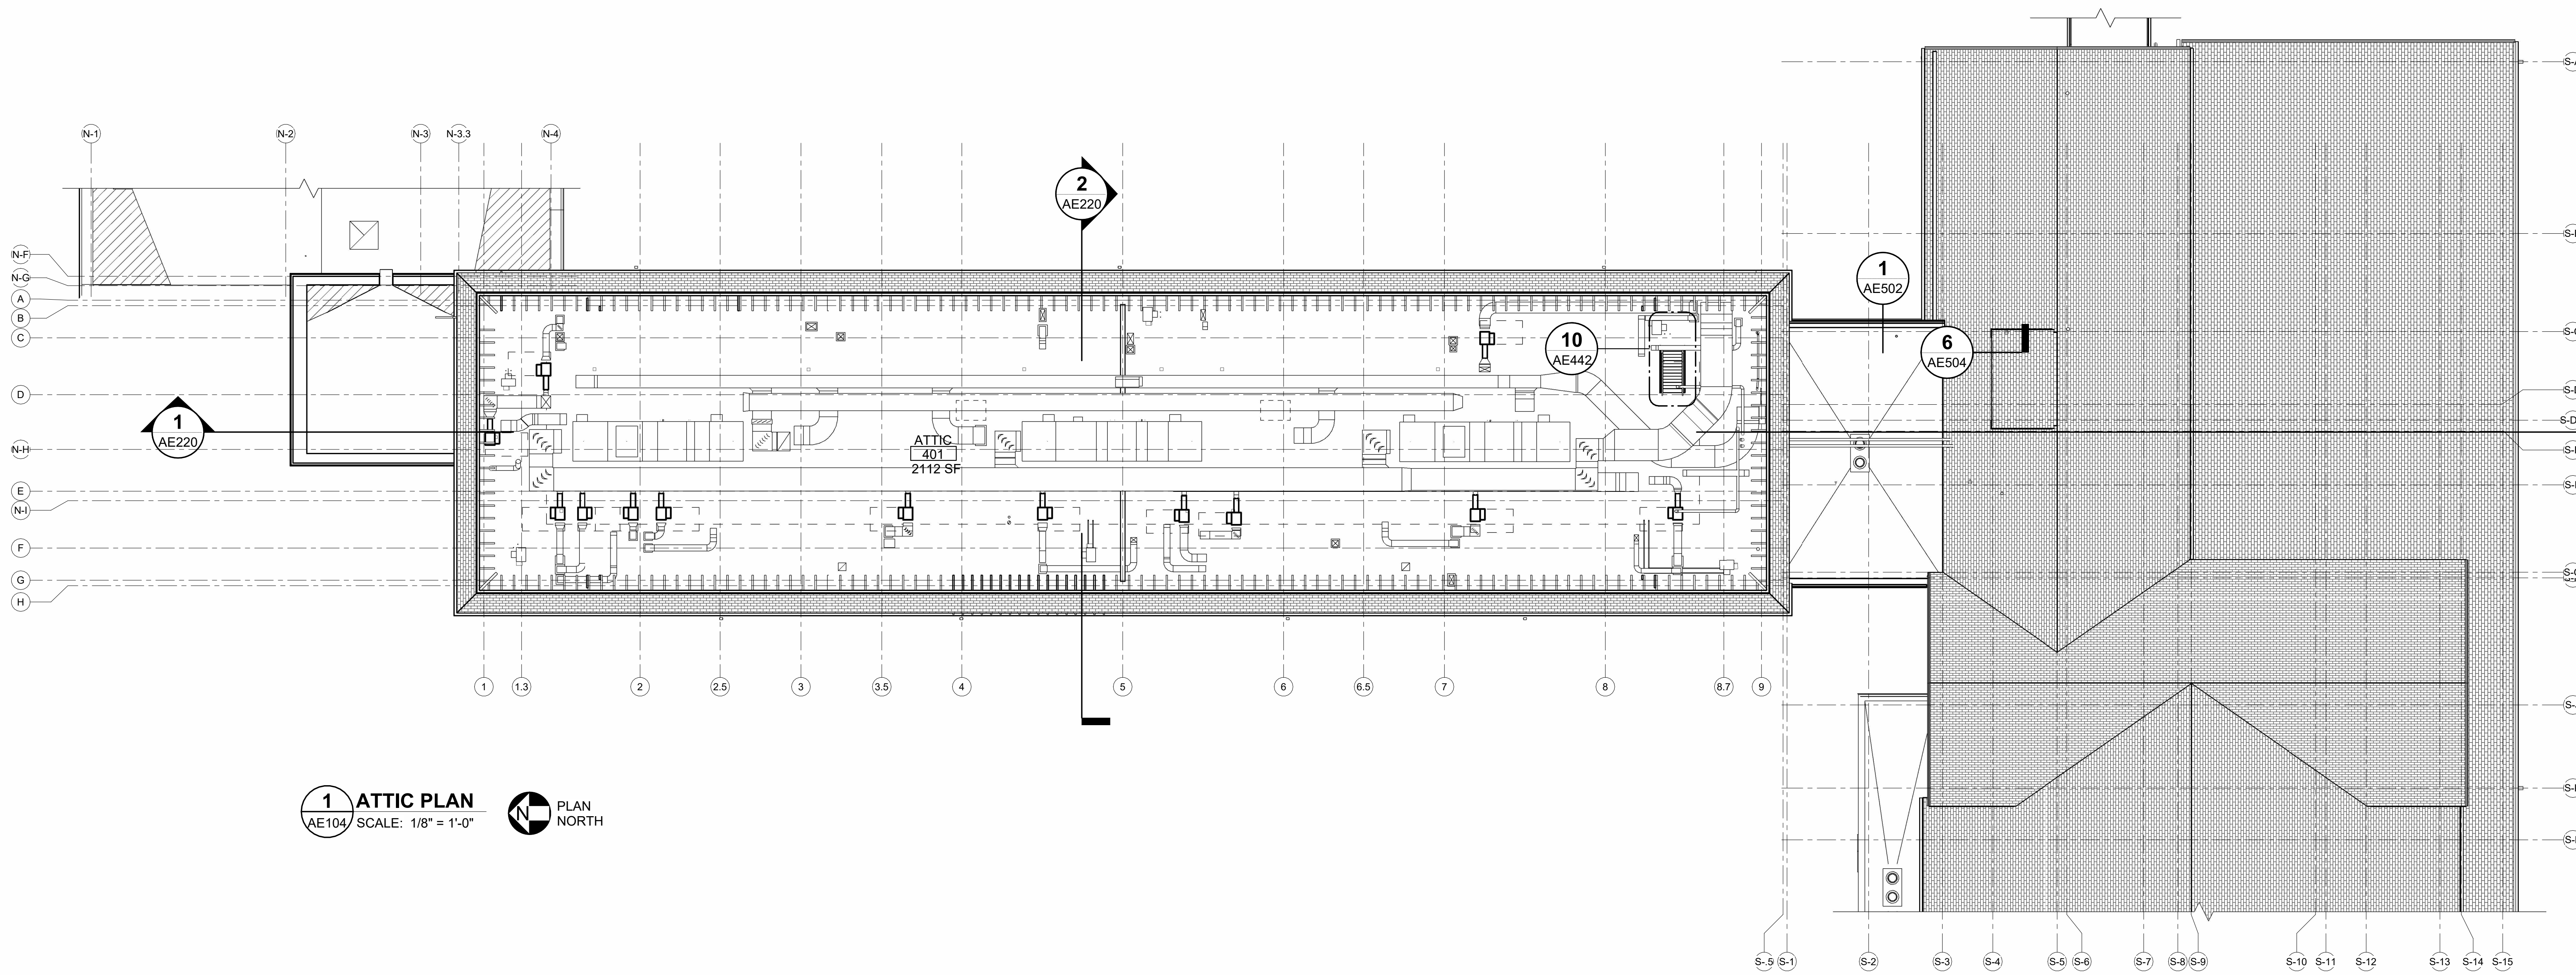

1 ATTIC PLAN
AE104 SCALE: 1/8" = 1'-0" PLAN NORTH

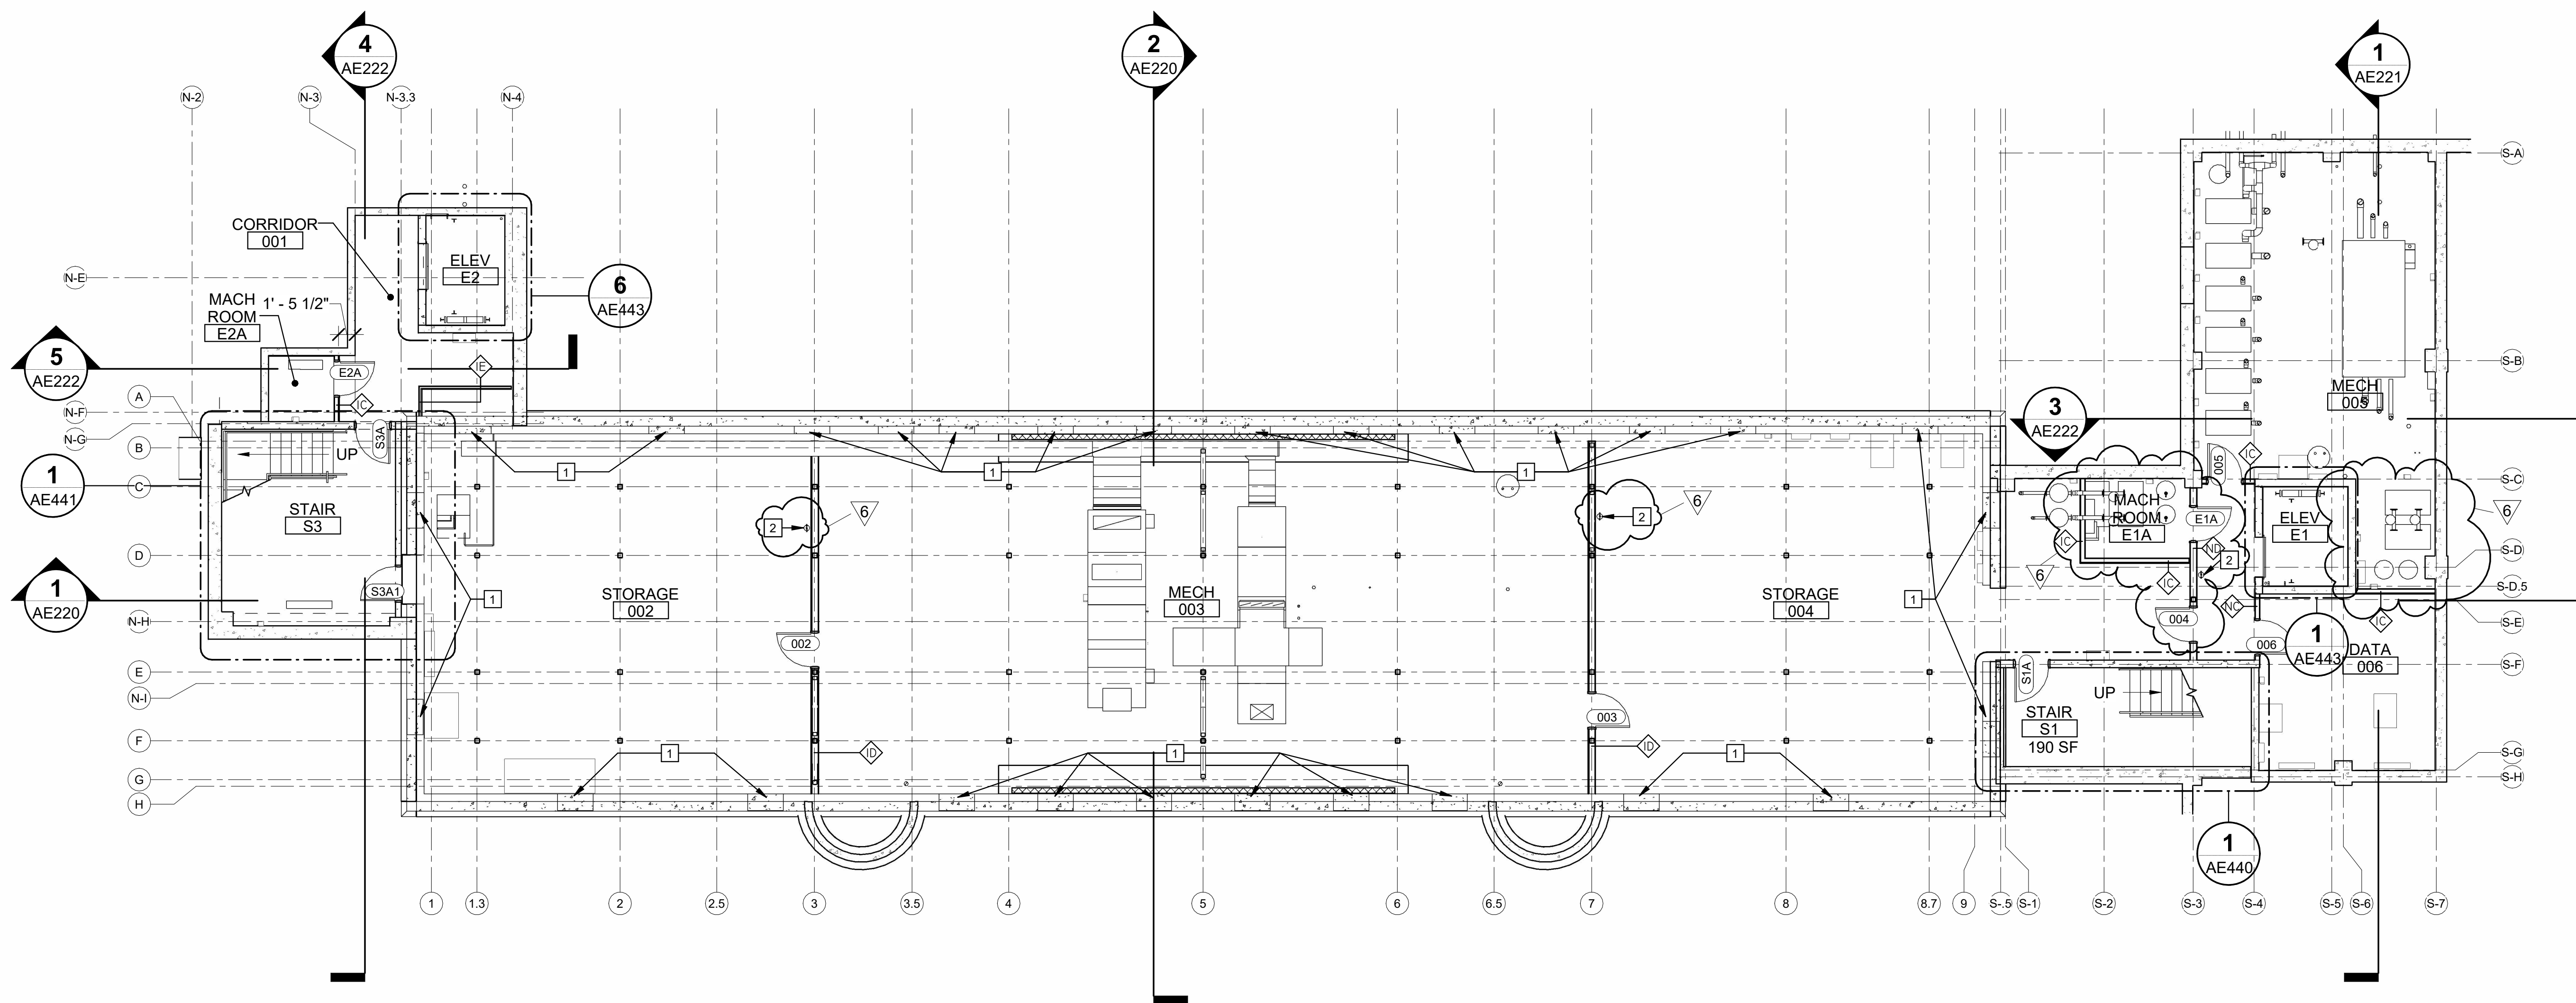

2 BASEMENT PLAN
AE104 SCALE: 1/8" = 1'-0" PLAN NORTH


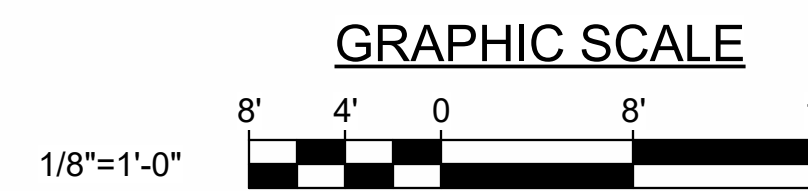







CHECK GRAPHIC SCALE BEFORE USING













				DEPARTMENT OF INLAND FISHERIES & WILDLIFE		
				TITLE NEW OFFICE HEADQUARTERS		
				LOCATION AUGUSTA, ME		
				TITLE THIS DWG. BASEMENT AND ATTIC FLOOR PLANS		
6	03/13/2025	ADDENDUM NO.6	HMG	DRAWN BY: MJD	 DRAWING NO. AE104 SHEET NO. 103 OF 239	
5	03/06/2025	ADDENDUM NO.5	HMG	CHECK BY: CET		
1	02/13/2025	ADDENDUM NO.1	HMG			
NO.	DATE	DESCRIPTION	BY	NO.		
REVISIONS				DATE 01/29/2025		
				231 Main Street, Biddeford, Maine 04005 207-283-6165		

1. SEE SHEETS AE601-AE602 FOR DOOR SCHEDULE AND TYPES.
2. SEE SHEET AE620 FOR WINDOW, STOREFRONT, CURTAINWALL, AND BORROWED LITE TYPES.
3. COORDINATE WITH CIVIL, STRUCTURAL, FIRE SUPPRESSION, MECHANICAL, PLUMBING, AND ELECTRICAL SHEETS.
4. SEE S-002 FOR LINTEL SCHEDULE.

GENERAL MATERIALS KEYNOTES		
TAG	MATERIAL	DESCRIPTION
EF-1	GALVANIZED FASICA	FASCIA AND DECORATIVE TRIM, TO MATCH ORIGINAL
EG-1	GUTTER SYSTEM	COPPER GUTTERS AND DOWNSPOUTS, TO MATCH ORIGINAL
EM-1	BRICK MASONRY	EXISTING BRICK WALLS ARE 3 WYTHES THICK.
F-1	FASCIA TYPE	METAL FASCIA CLIP
G-1	GUTTER SYSTEM	METAL GUTTER SYSTEM AND DOWNSPOUT
M-1	MASONRY STONE VENEER	ARRISCRAFT, SHADOW BUILDING STONE
M-2	MASONRY ACCENT BAND	ARRISCRAFT, BUILDING STONE
M-3	CAST STONE ACCENT BAND	ADVANCED ARCHITECTURAL STONE
R-1	ASPHALT ROOF (CET)	CERTAINTEED, LANDMARK, HUNTER GREEN
R-2	ASPHALT ROOF	CERTAINTEED, LANDMARK, HUNTER GREEN
S-1	DIMENSIONAL LETTER SIGNAGE	CAST ALUMINUM CHARTACTERS, 12" HIGH
W-1	FIBER CEMENT PANEL SIDING	NICHIIHA, VINTAGEWOOD CEMENTITIOUS SIDING, CEDAR

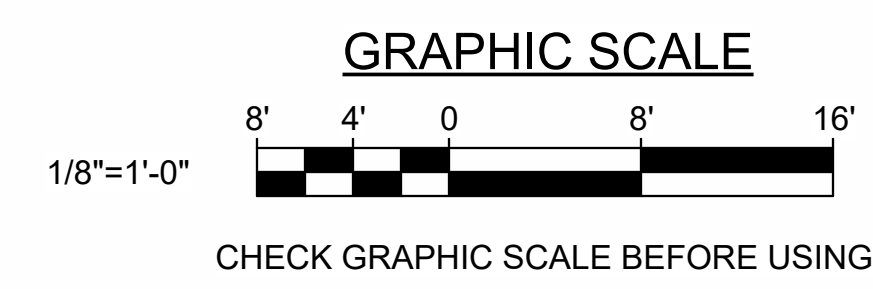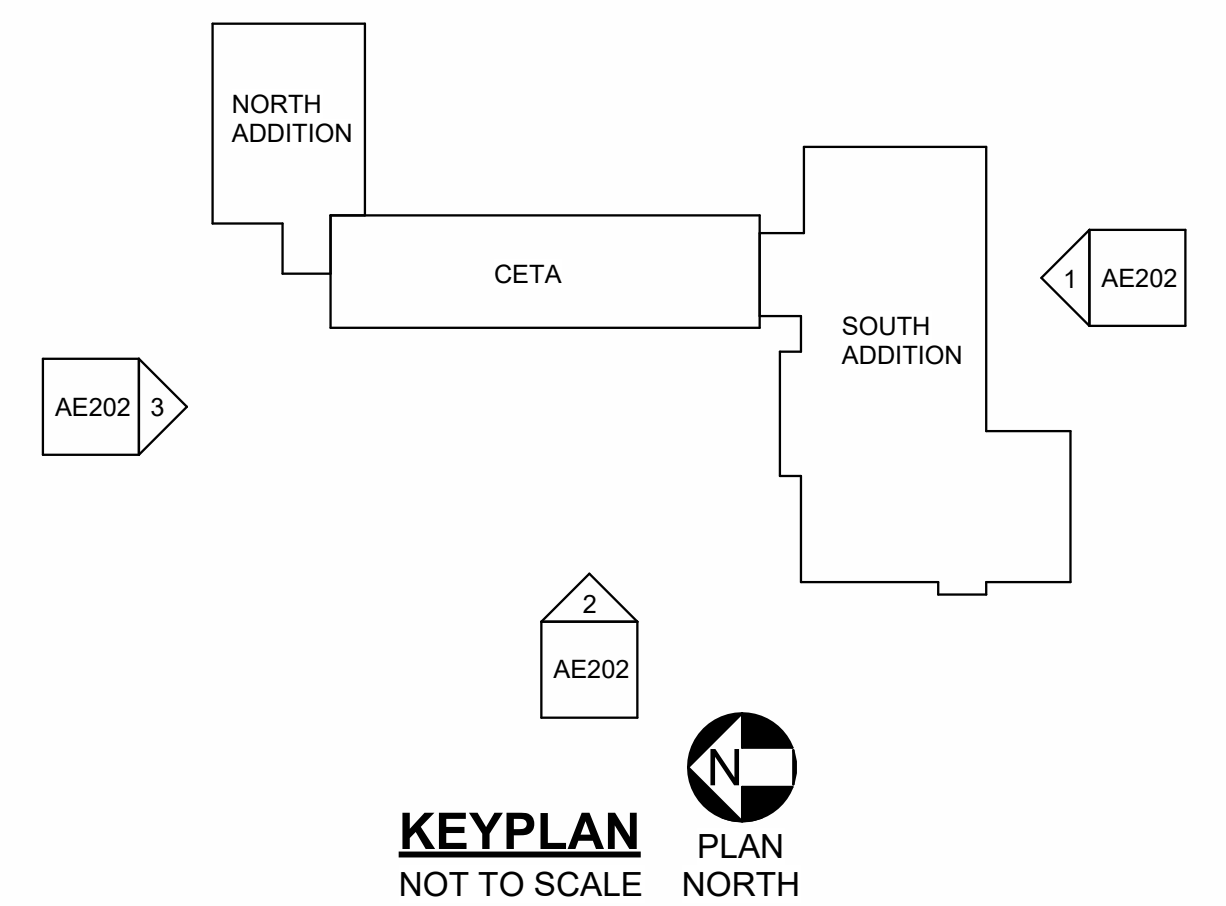[illegible]

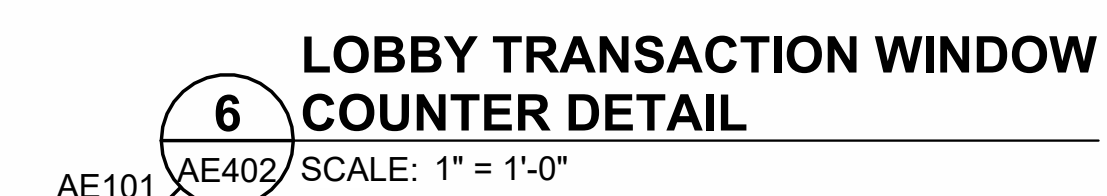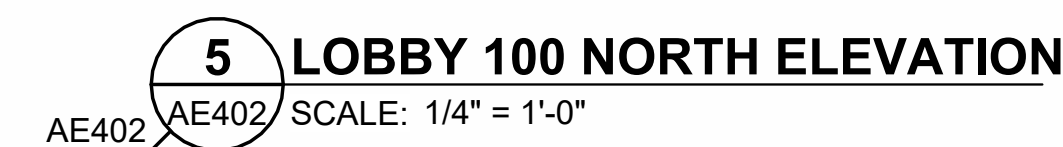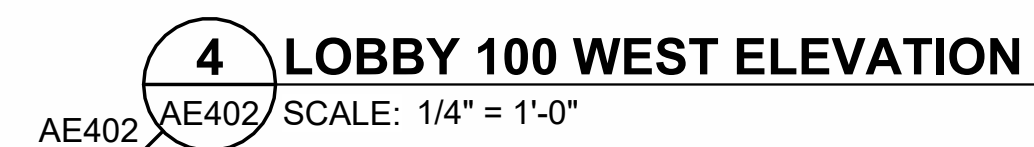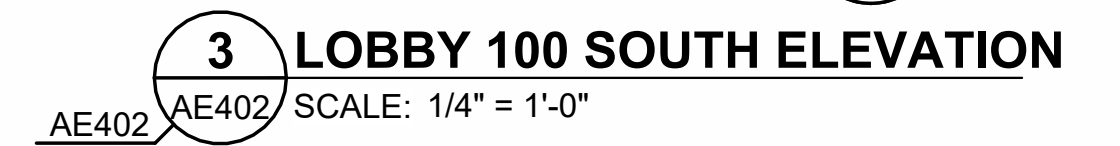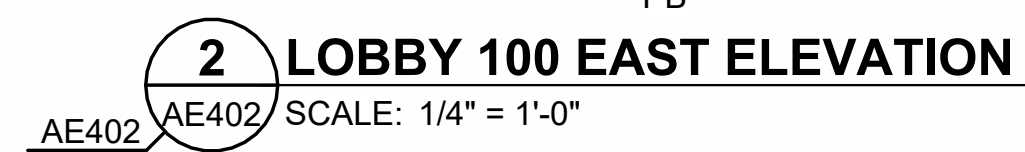[illegible]

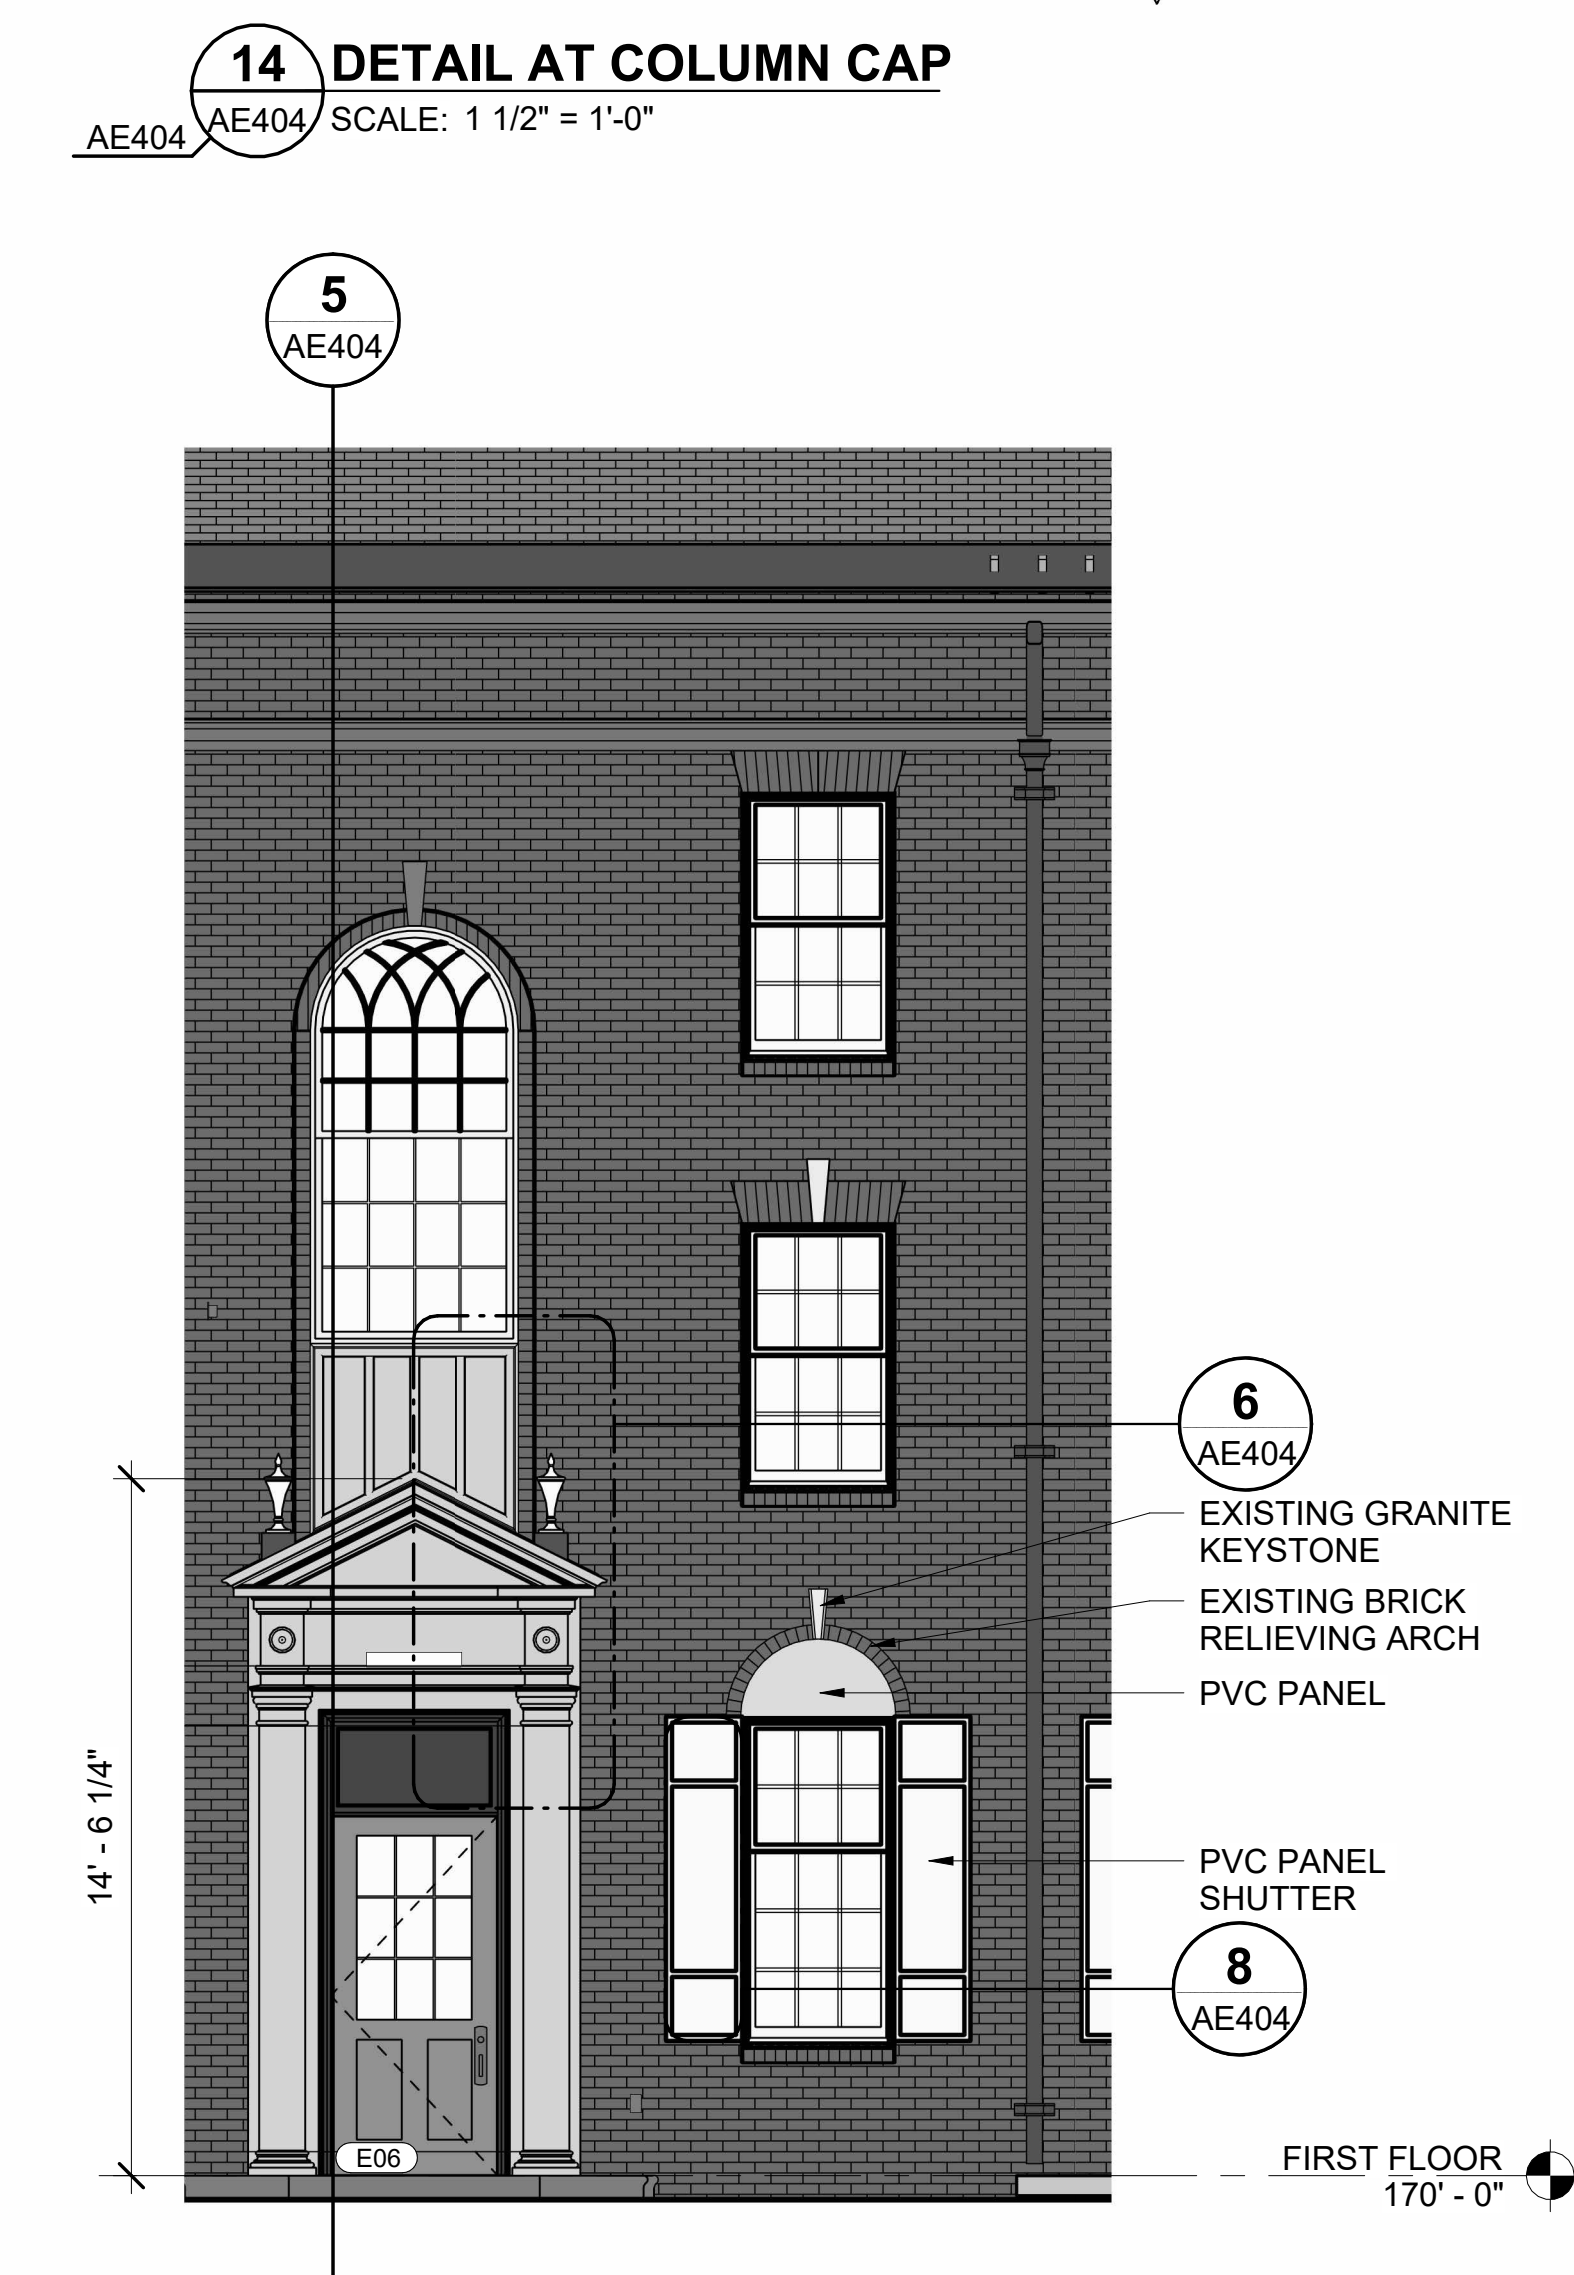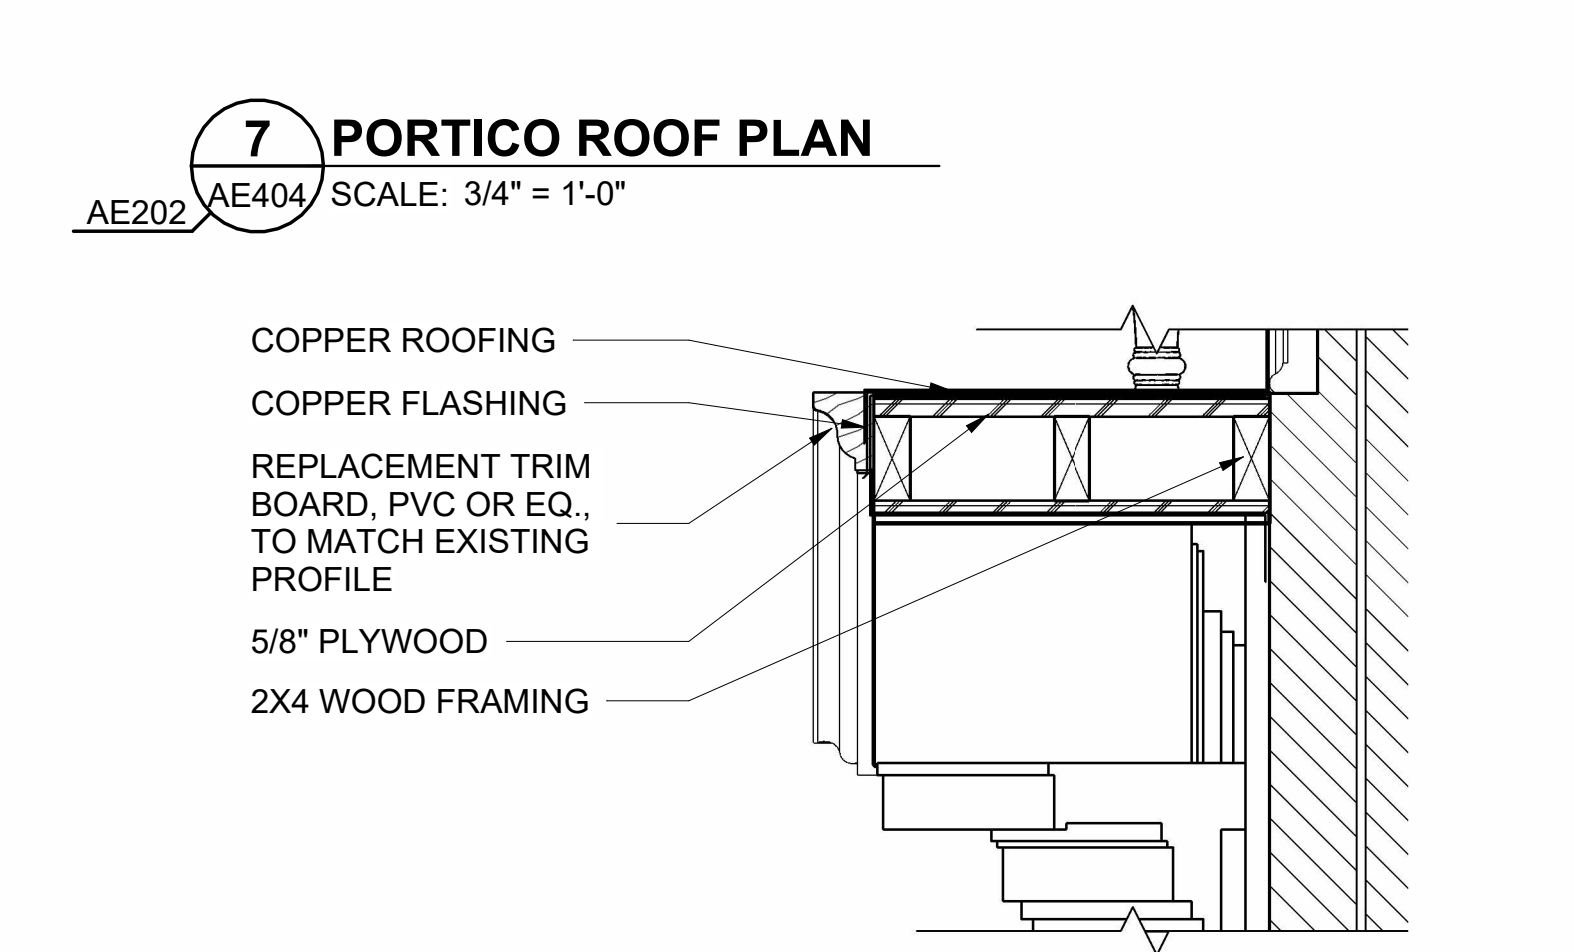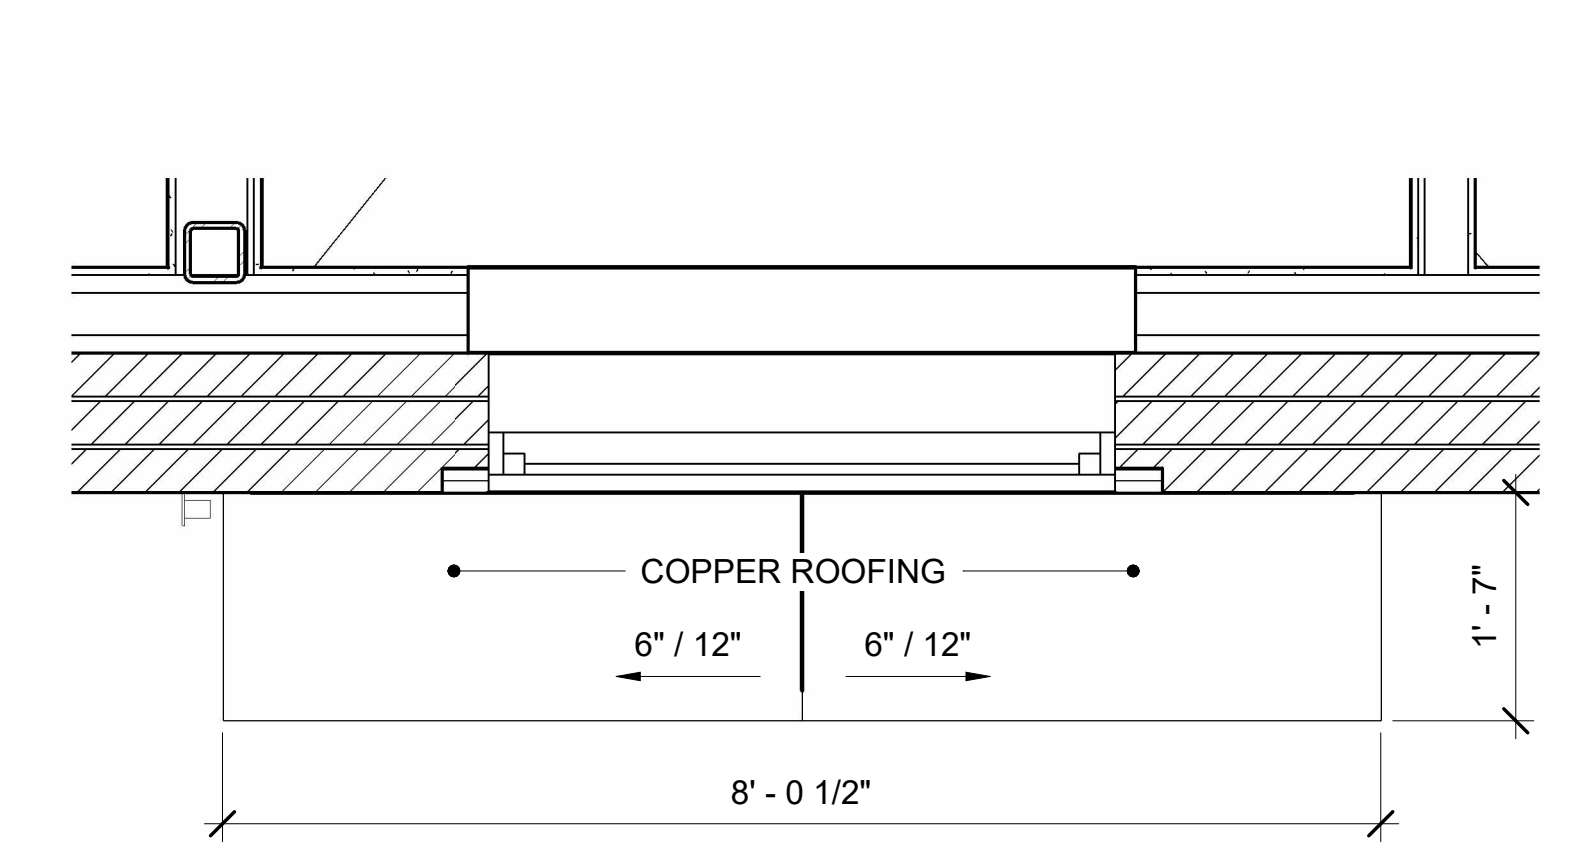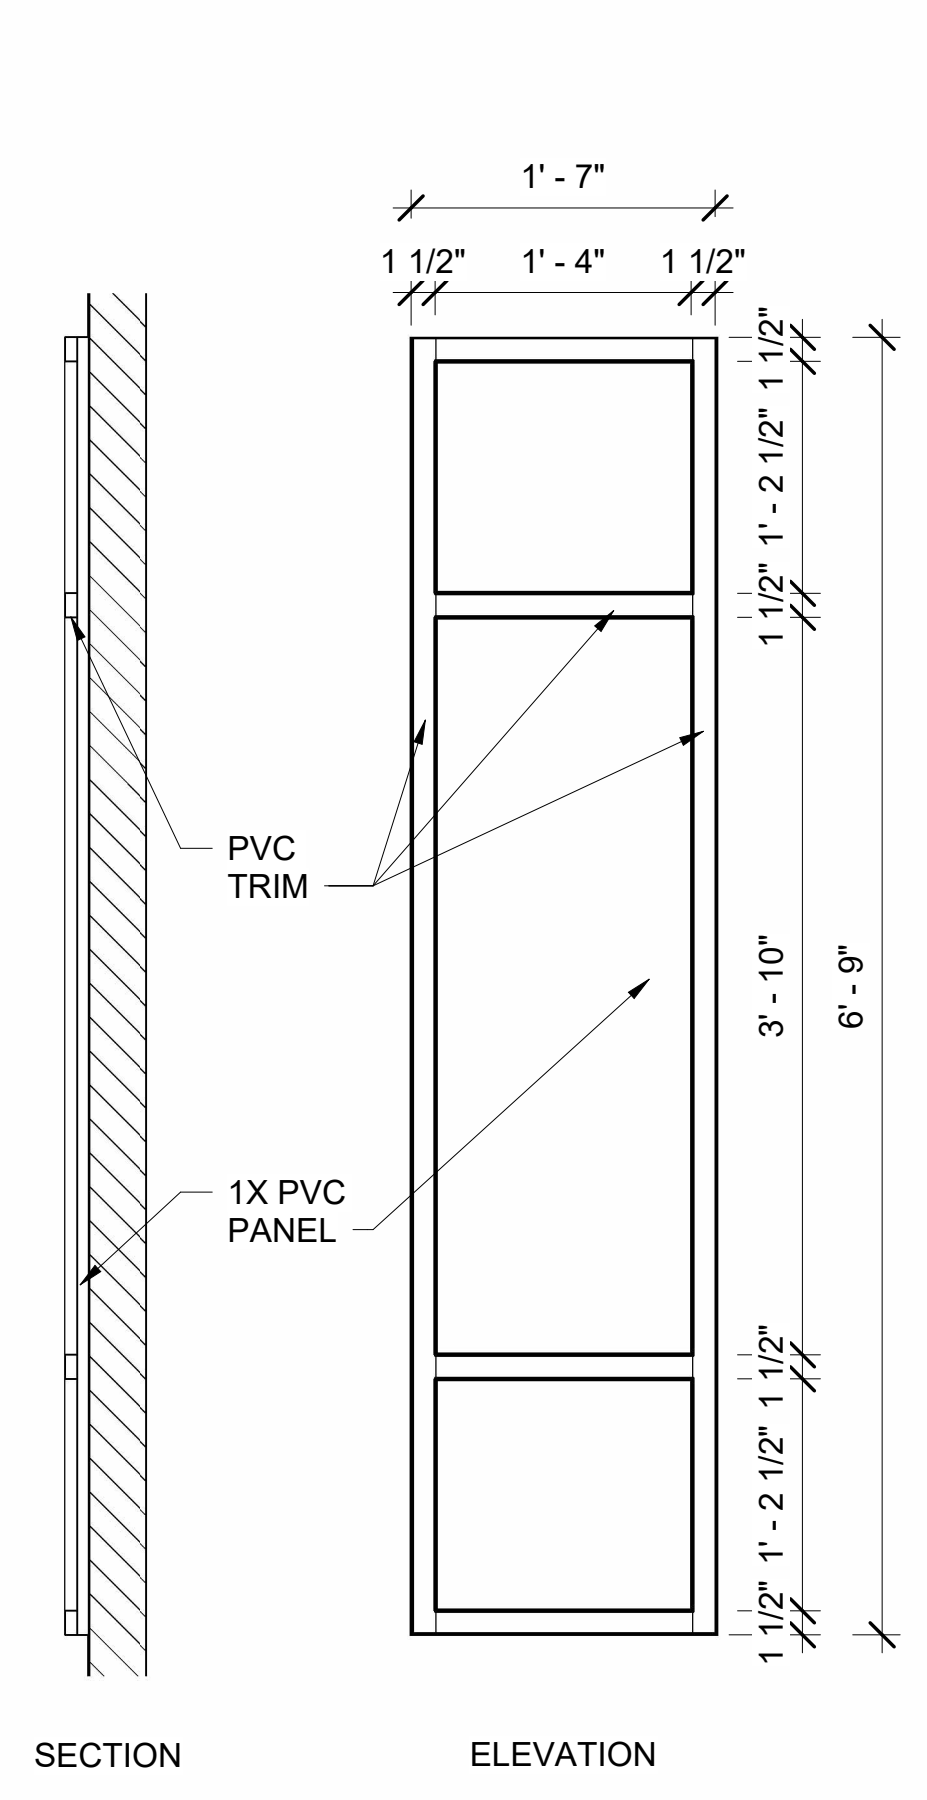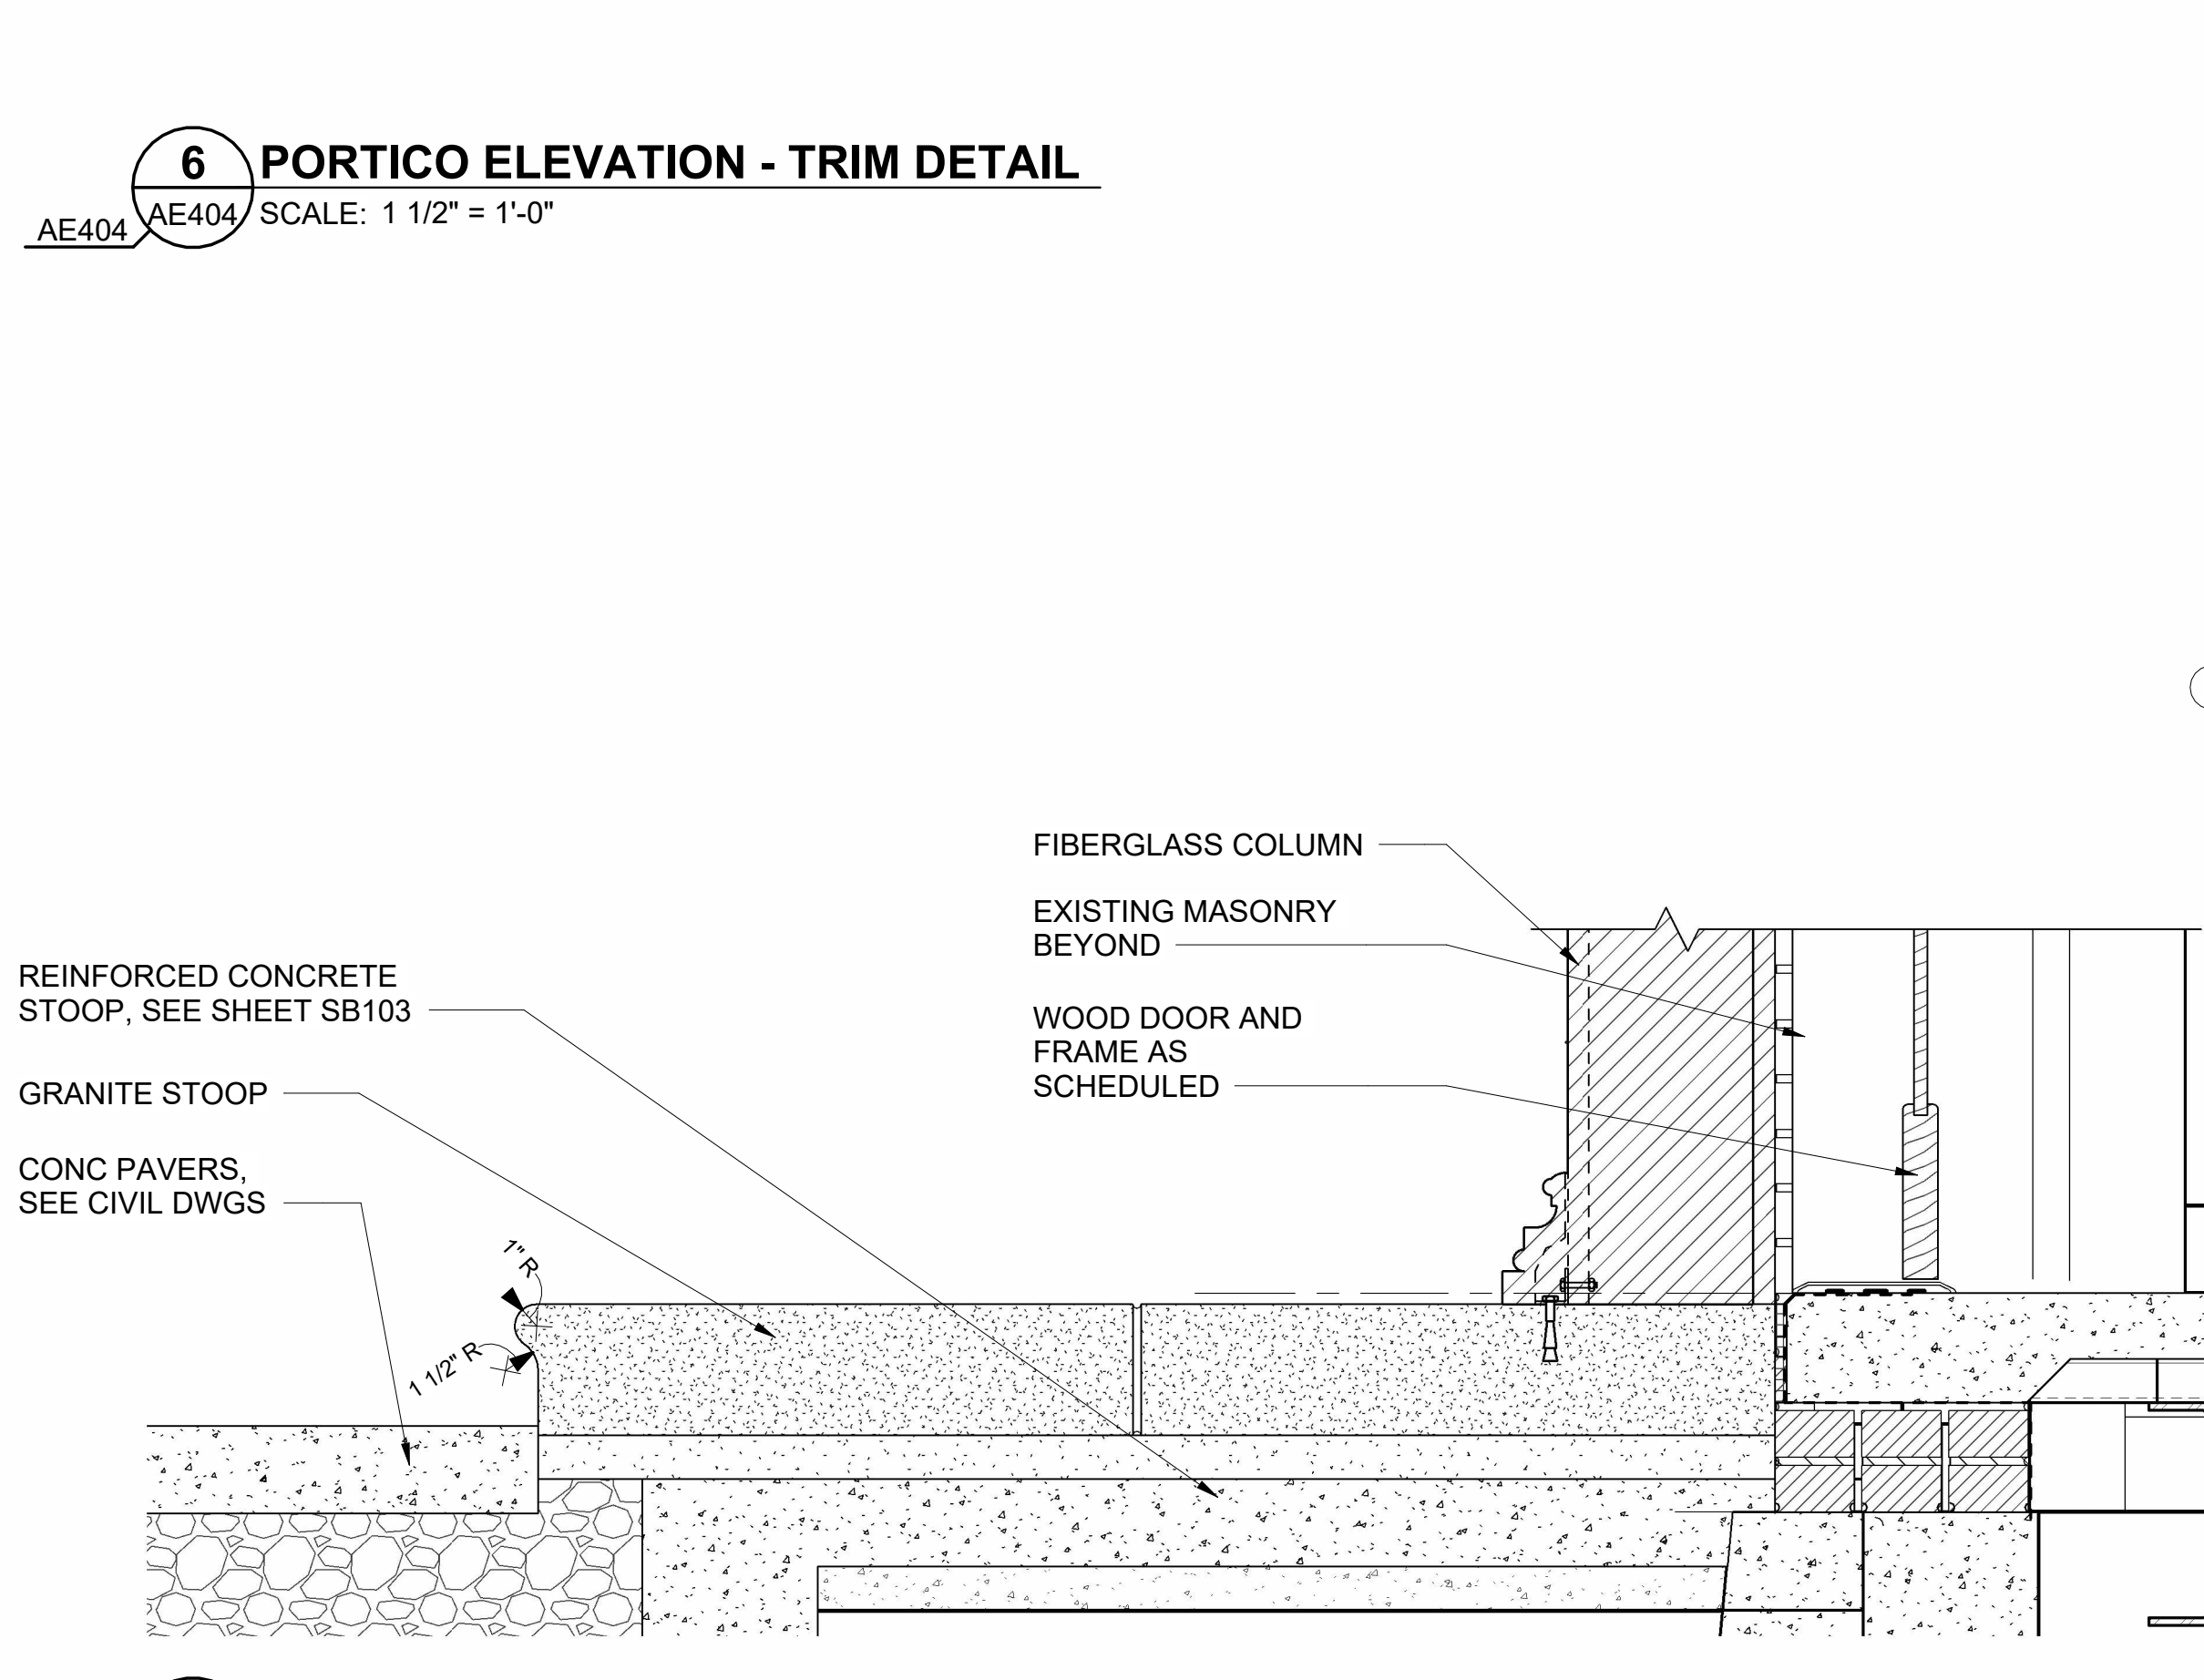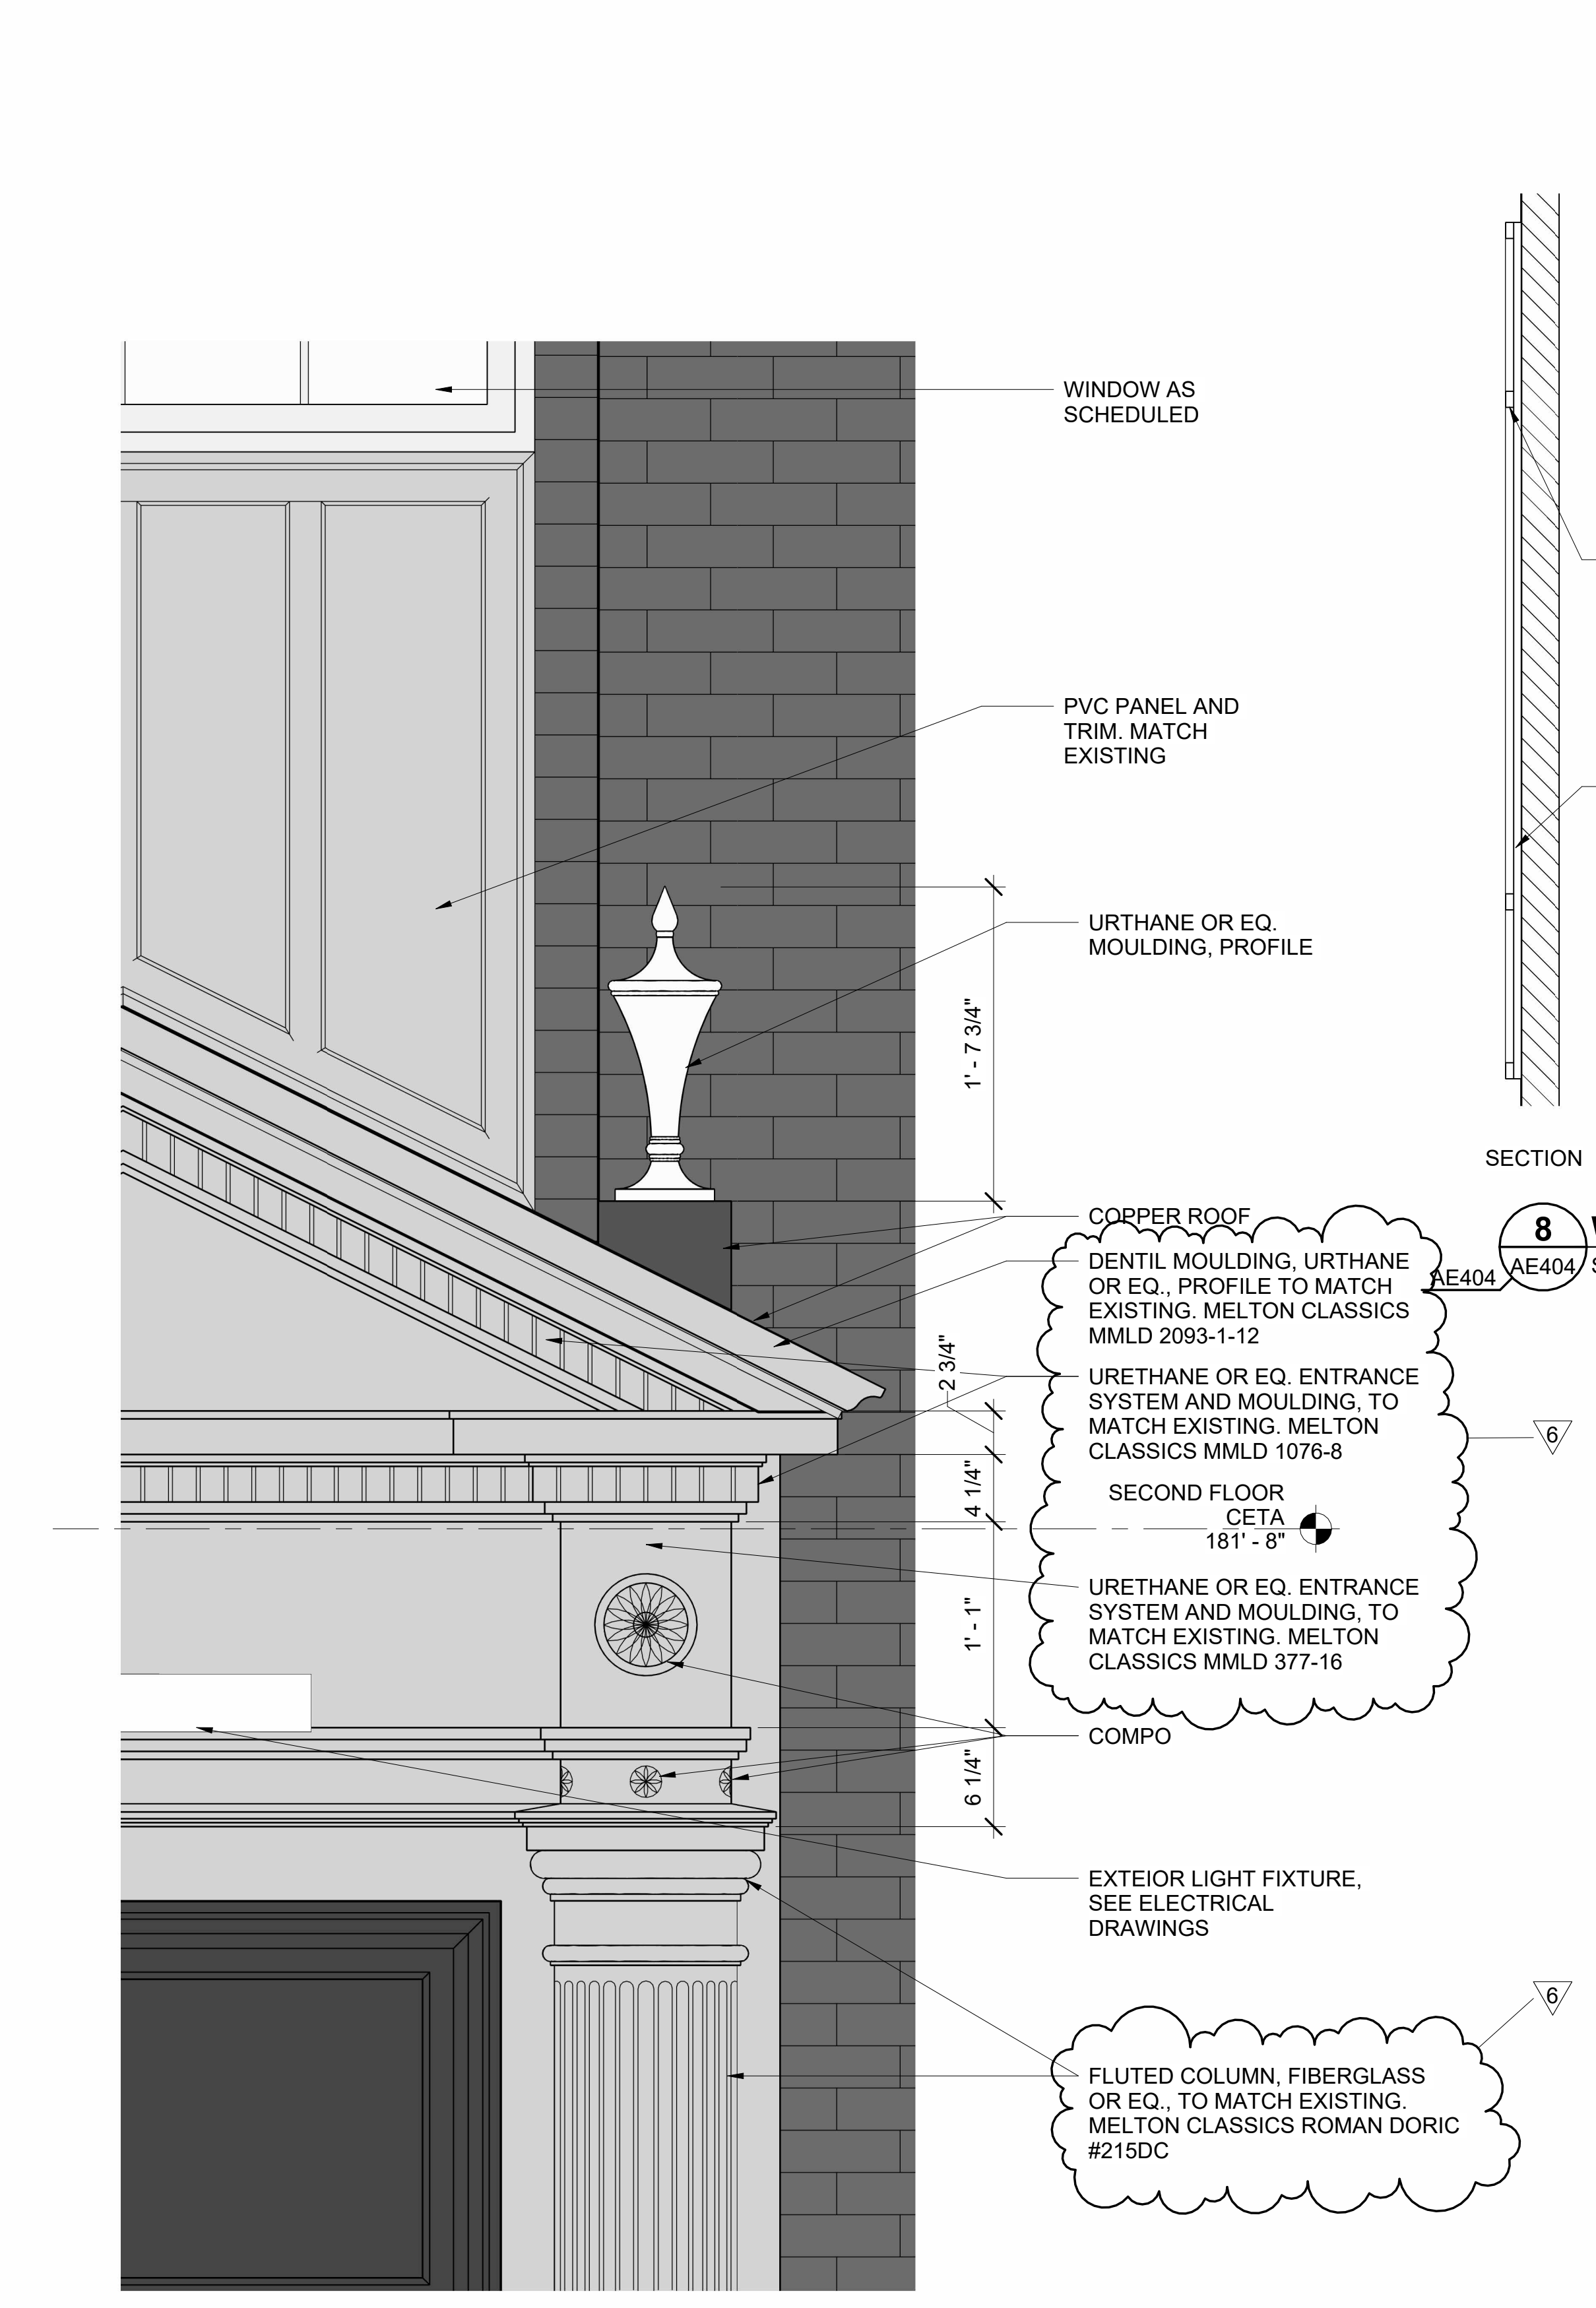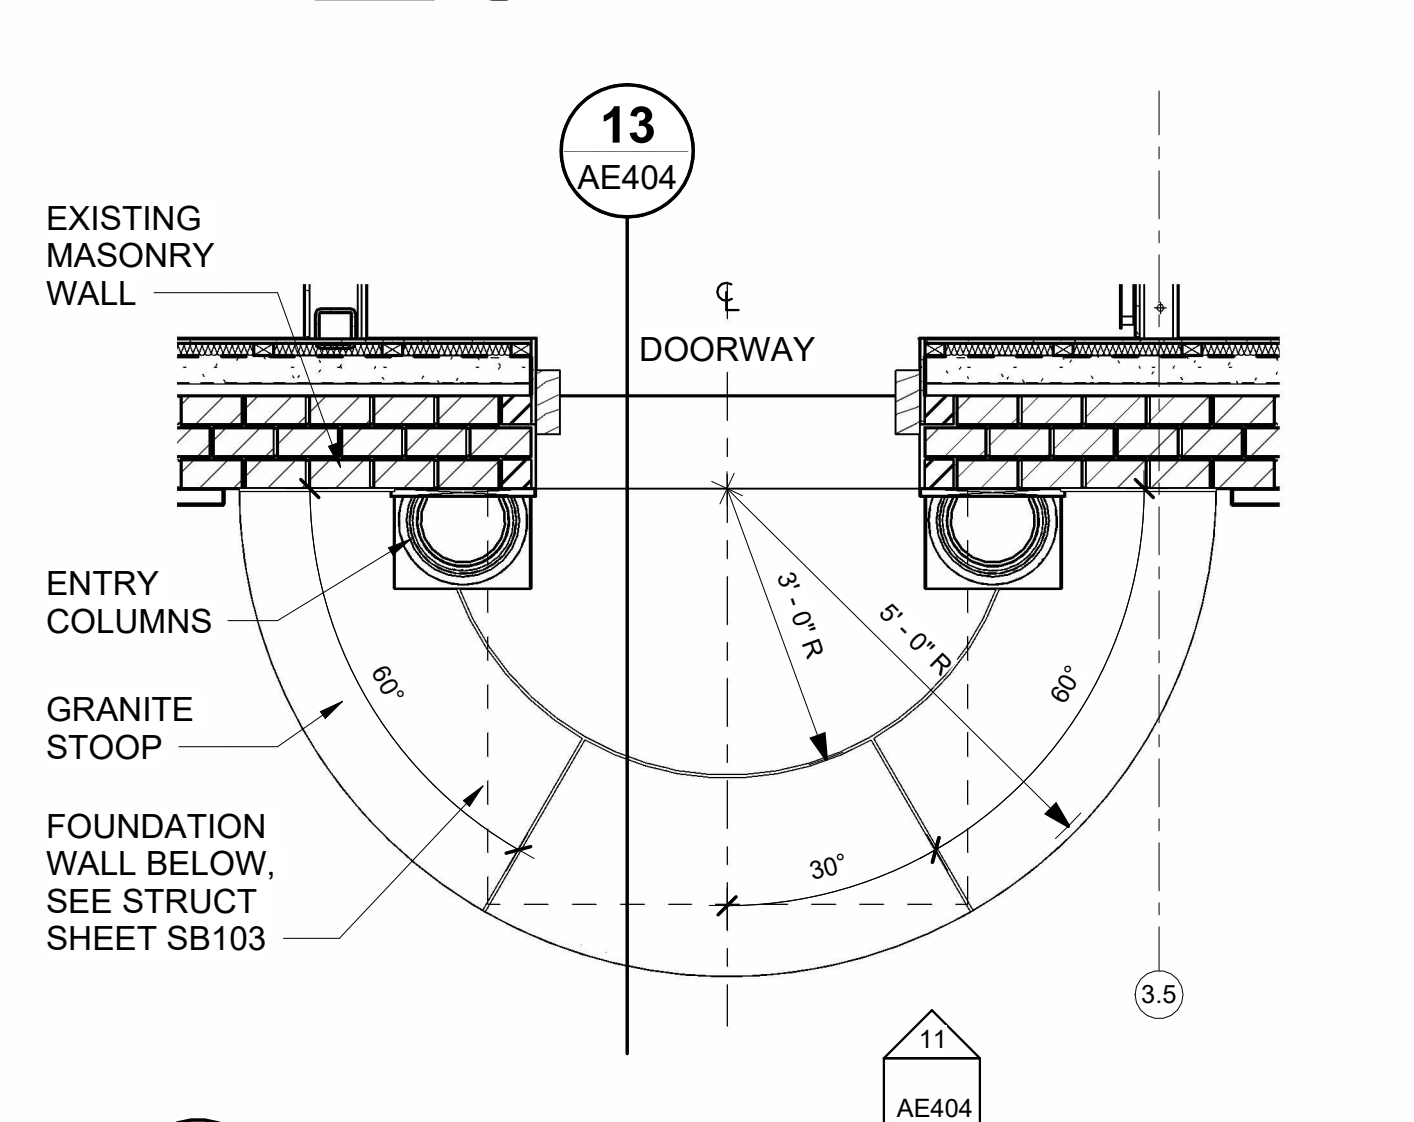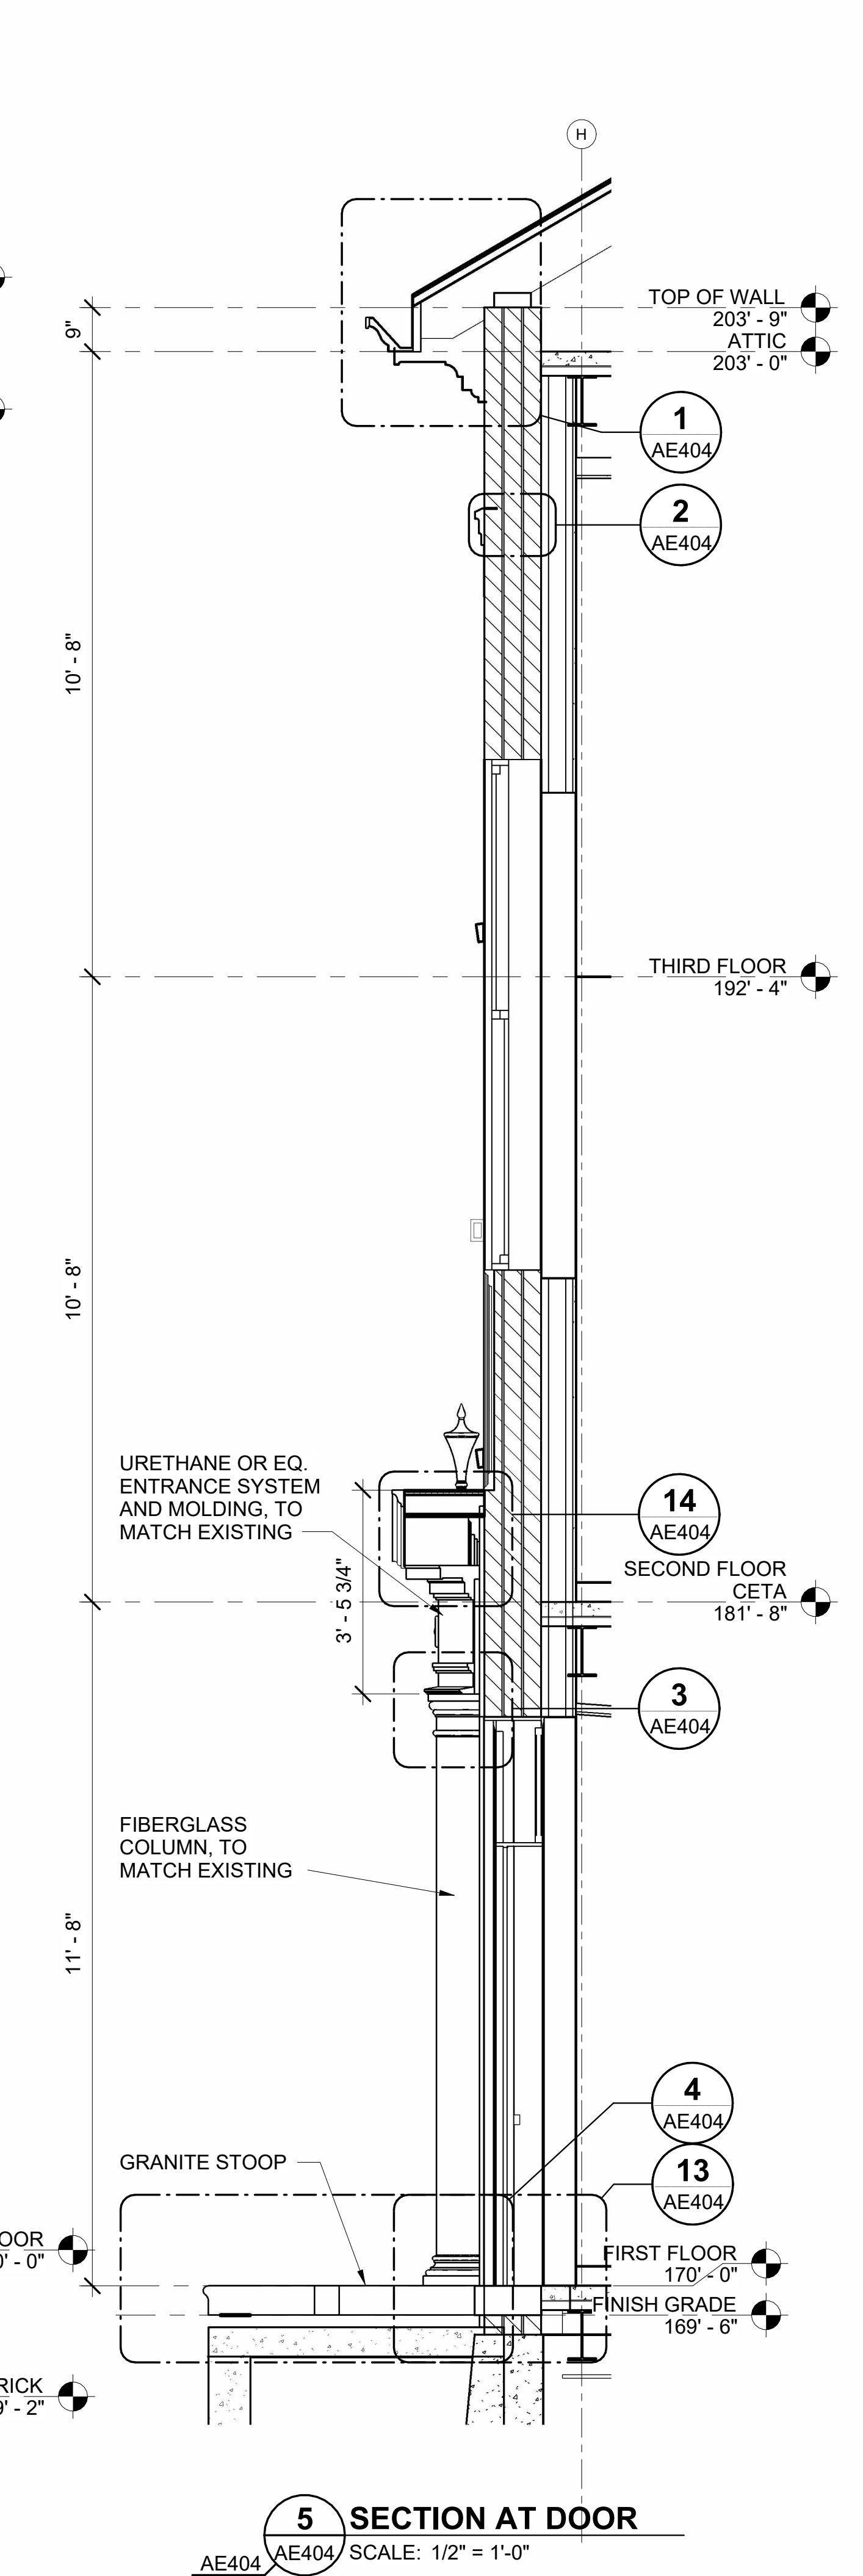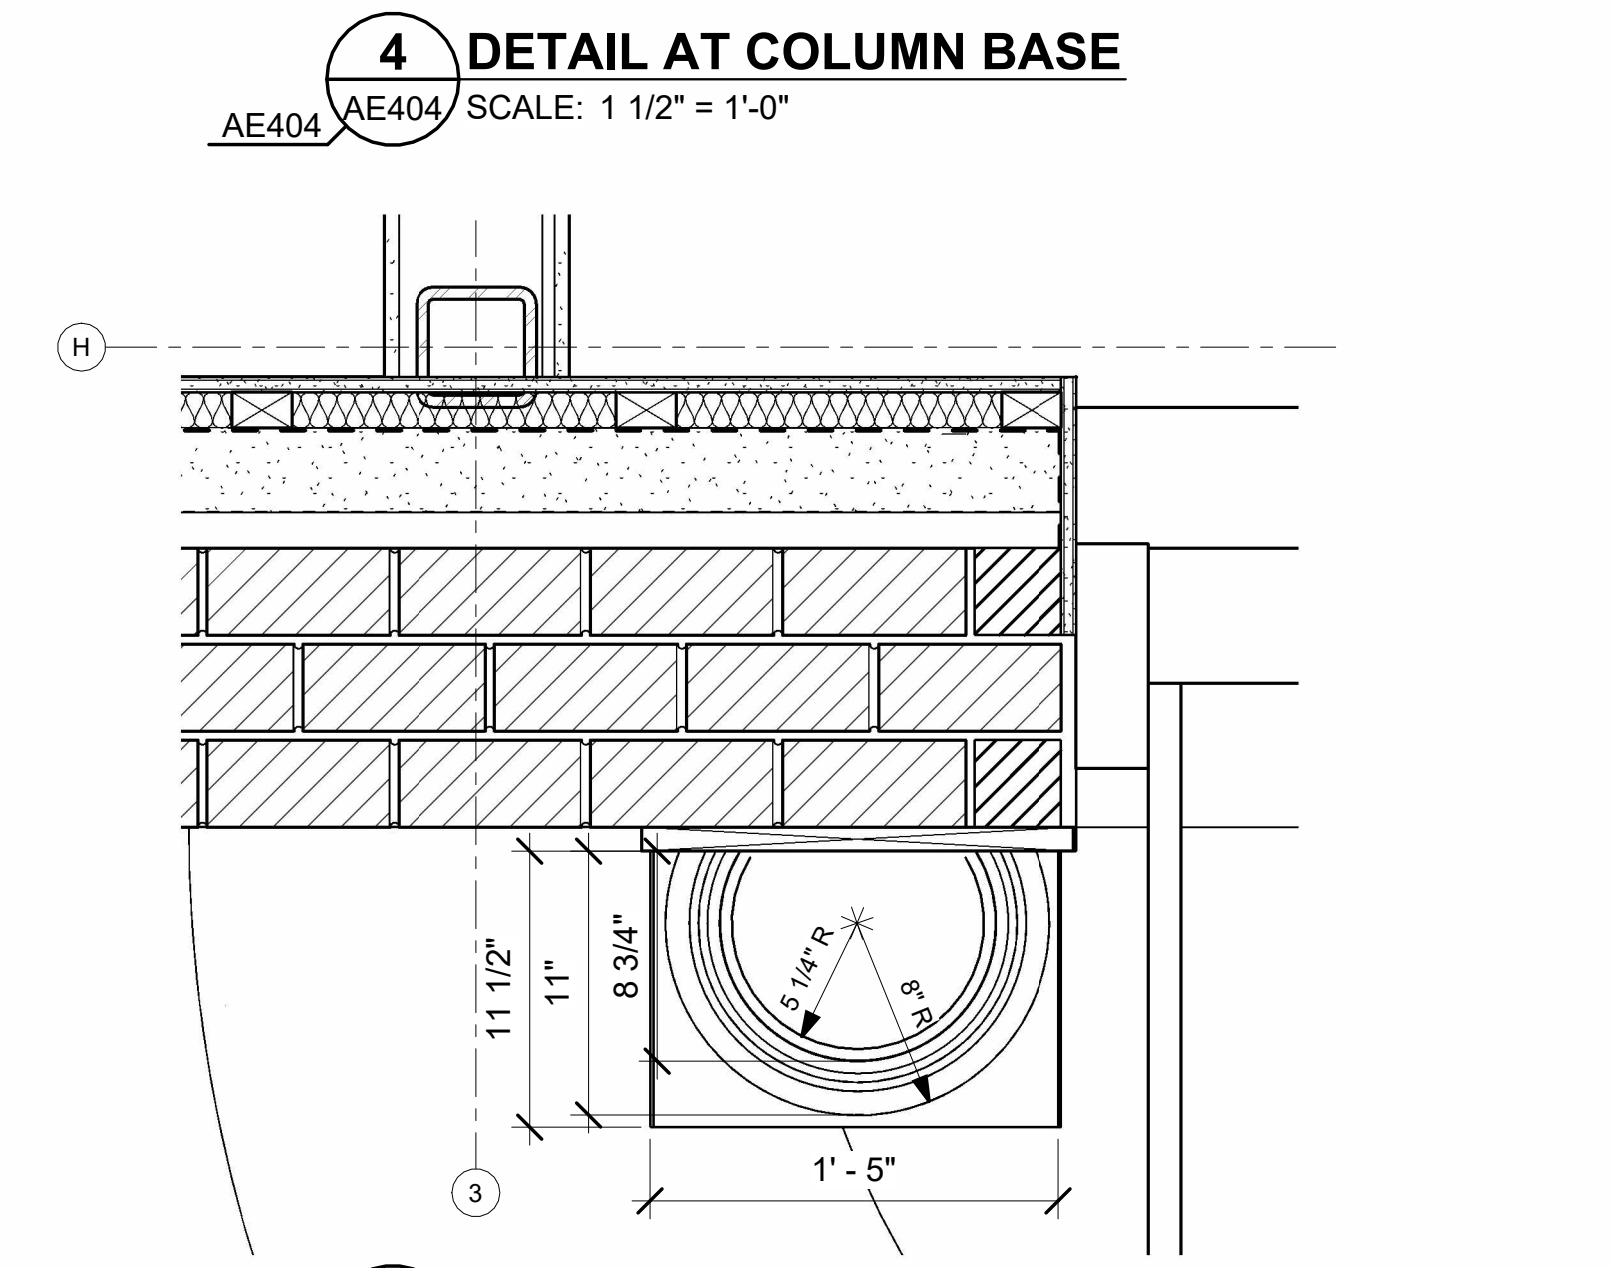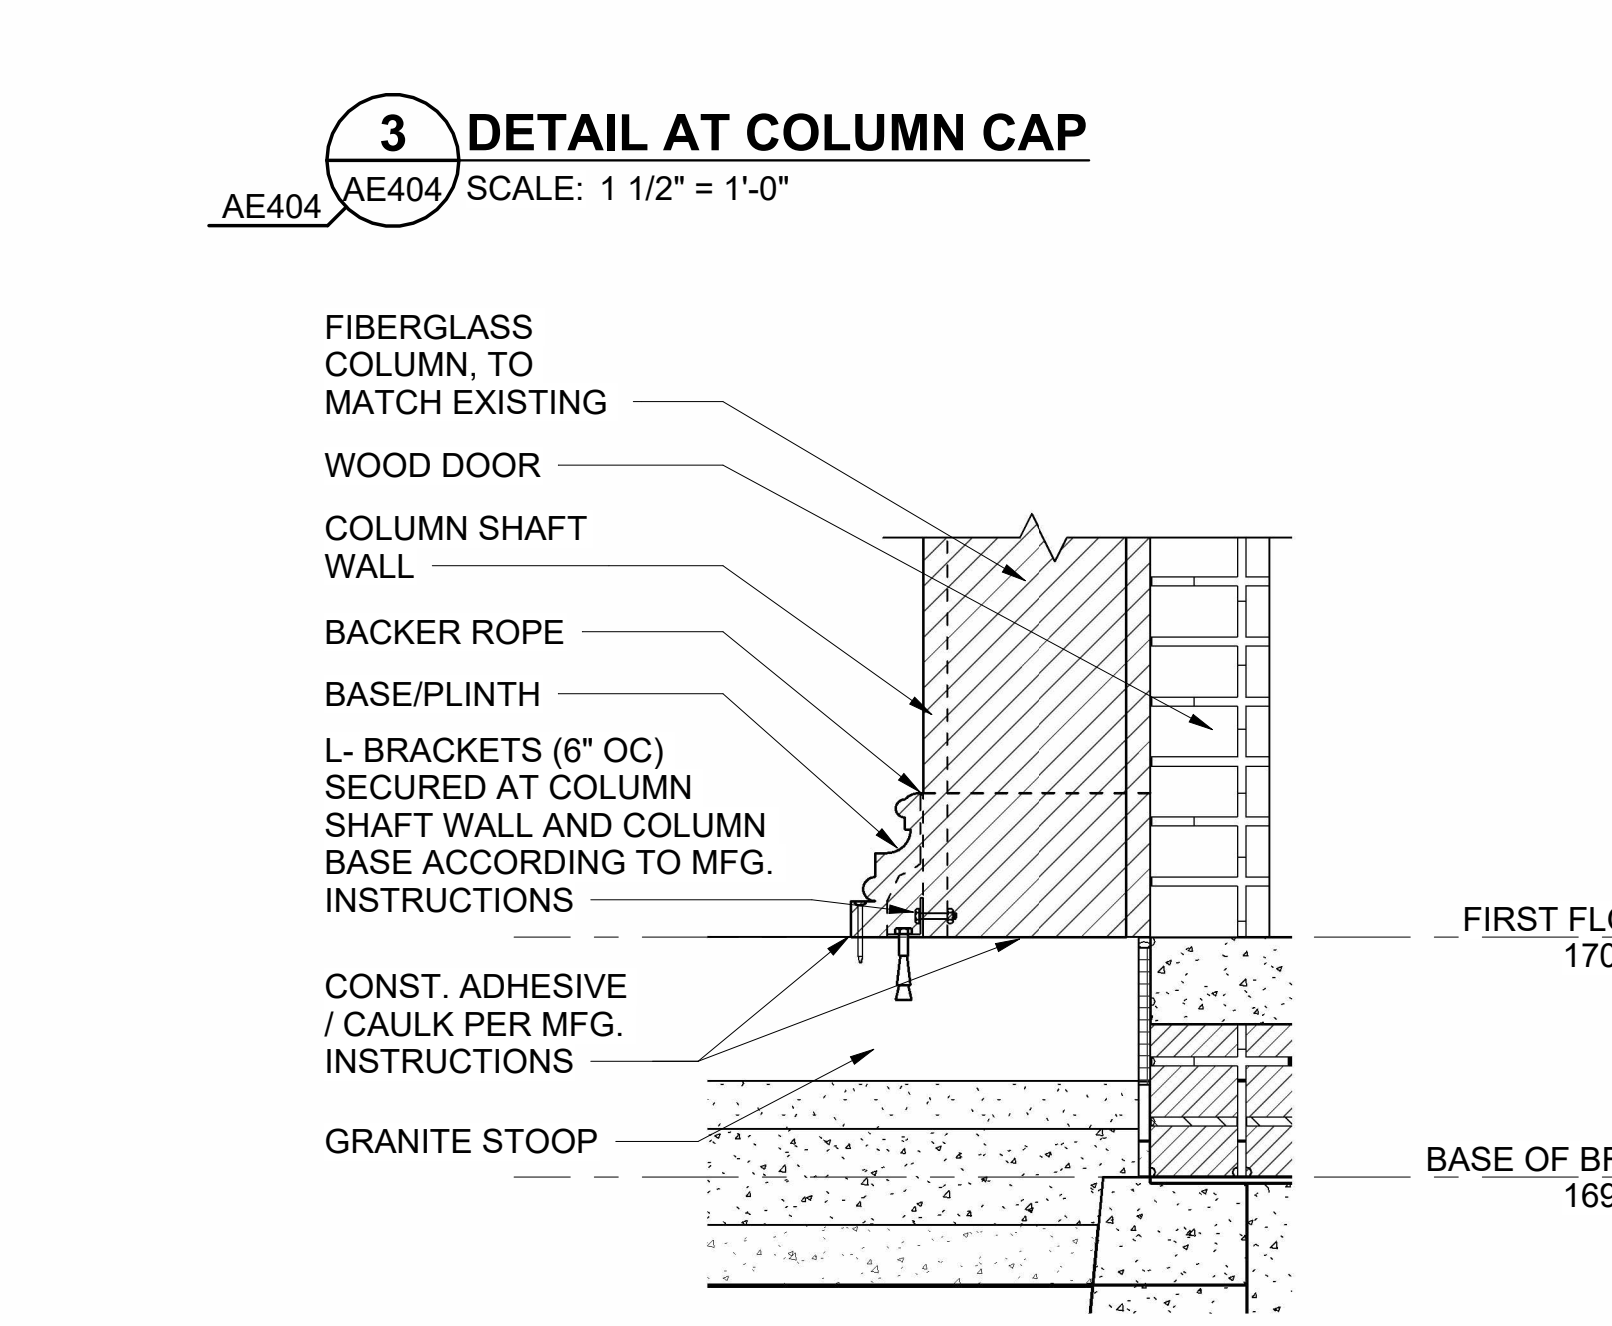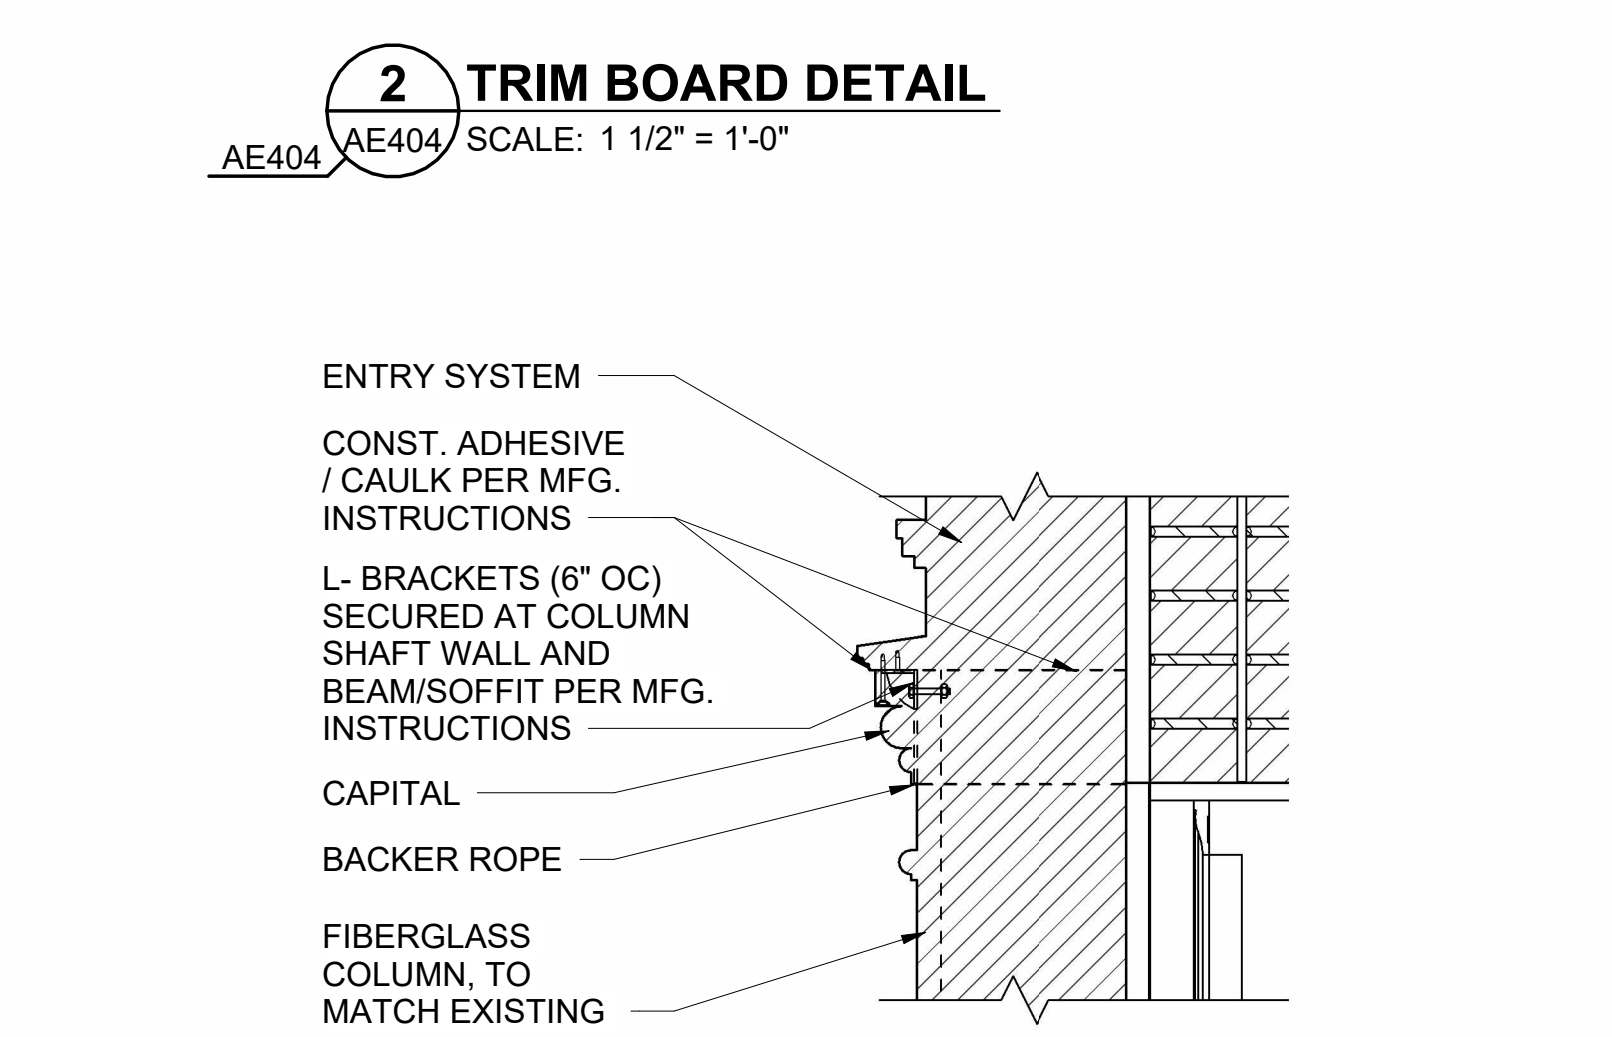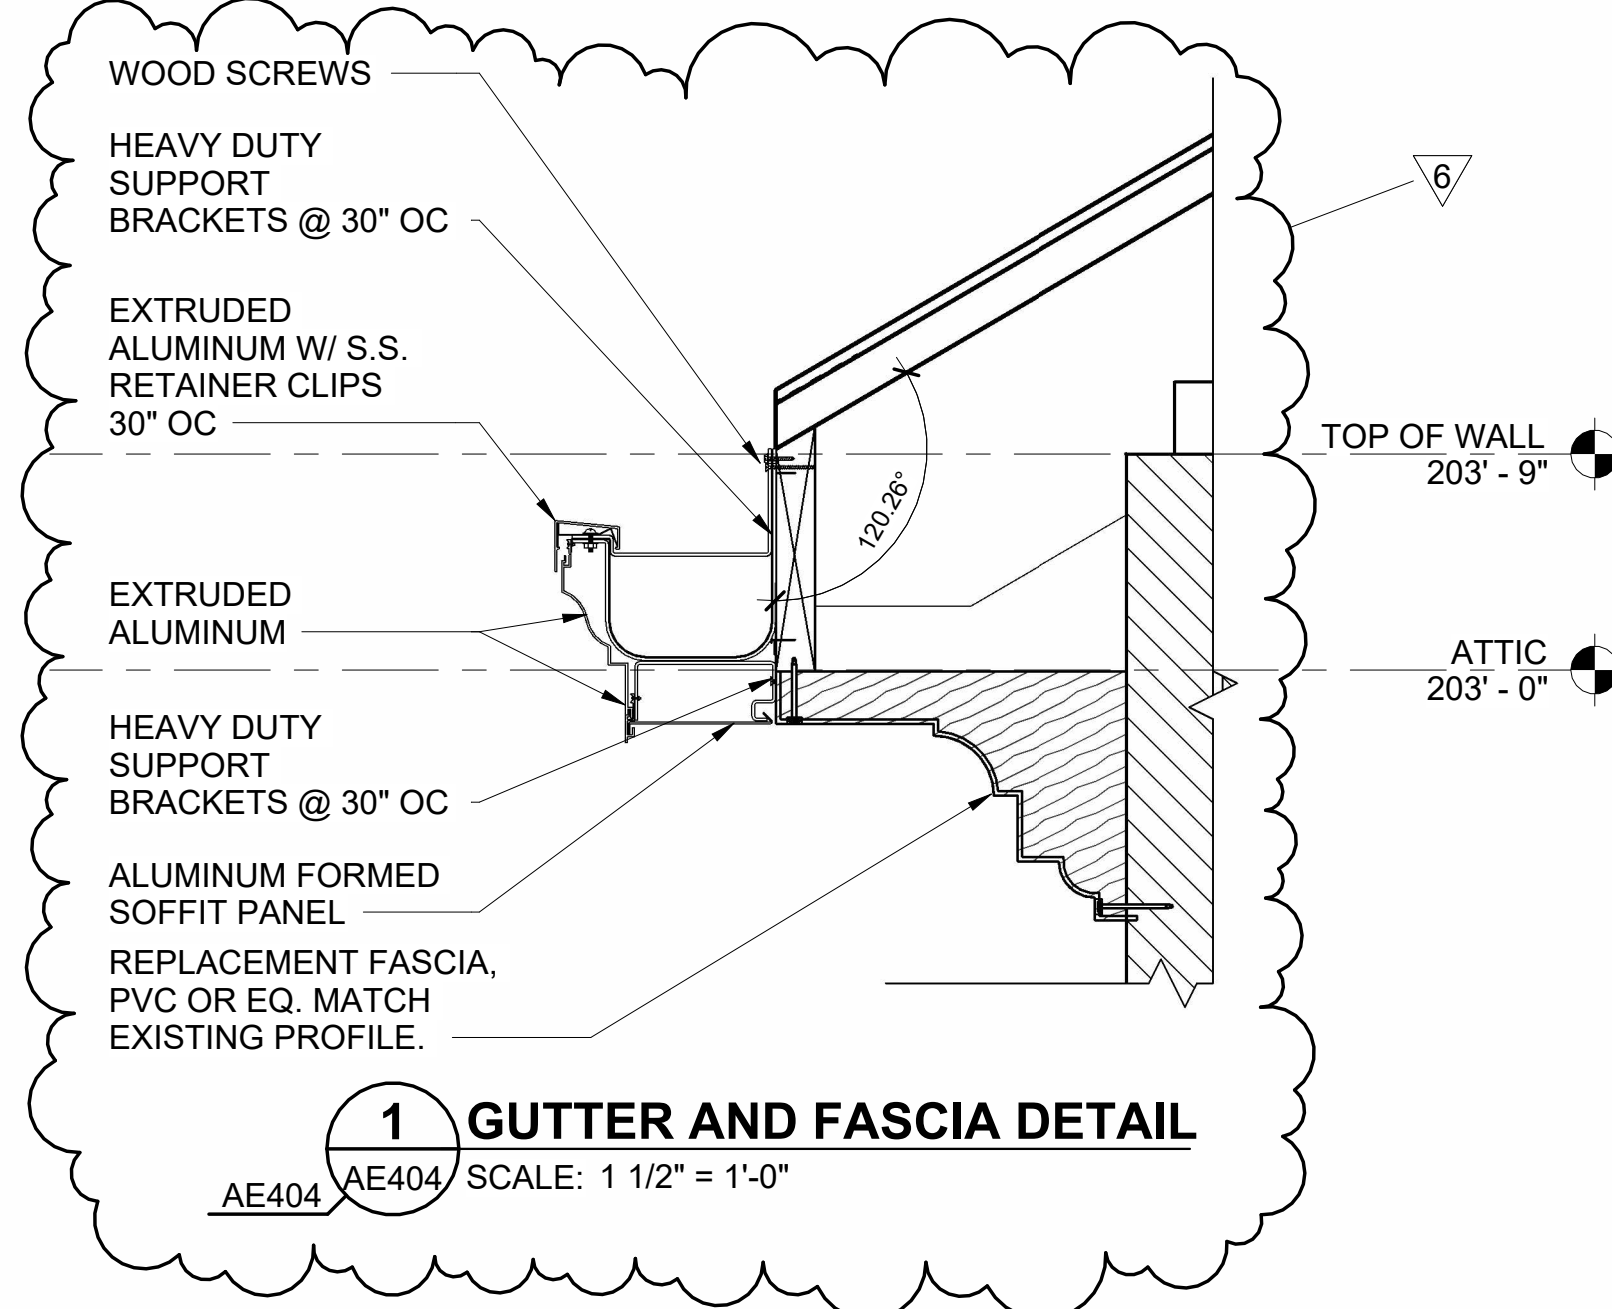

GRAPHIC SCALE

1/4"=1'-0" 1"=1'-0" 1/2"=1'-0"

CHECK GRAPHIC SCALE BEFORE USING

NO.	DATE	DESCRIPTION	BY
6	03/13/2025	ADDENDUM NO.6	HMG

NO.	DATE	DESCRIPTION	BY
1	01/29/2025		CET

DEPARTMENT OF INLAND FISHERIES & WILDLIFE

TITLE: NEW OFFICE HEADQUARTERS

LOCATION: AUGUSTA, ME

TITLE THIS DWG: CETA FACADE RESTORATION ELEVATIONS AND DETAILS

DRAWN BY: MJD


CHECK BY: CET

DATE: 01/29/2025


OAK POINT ASSOCIATES

AE404


121 OF 239

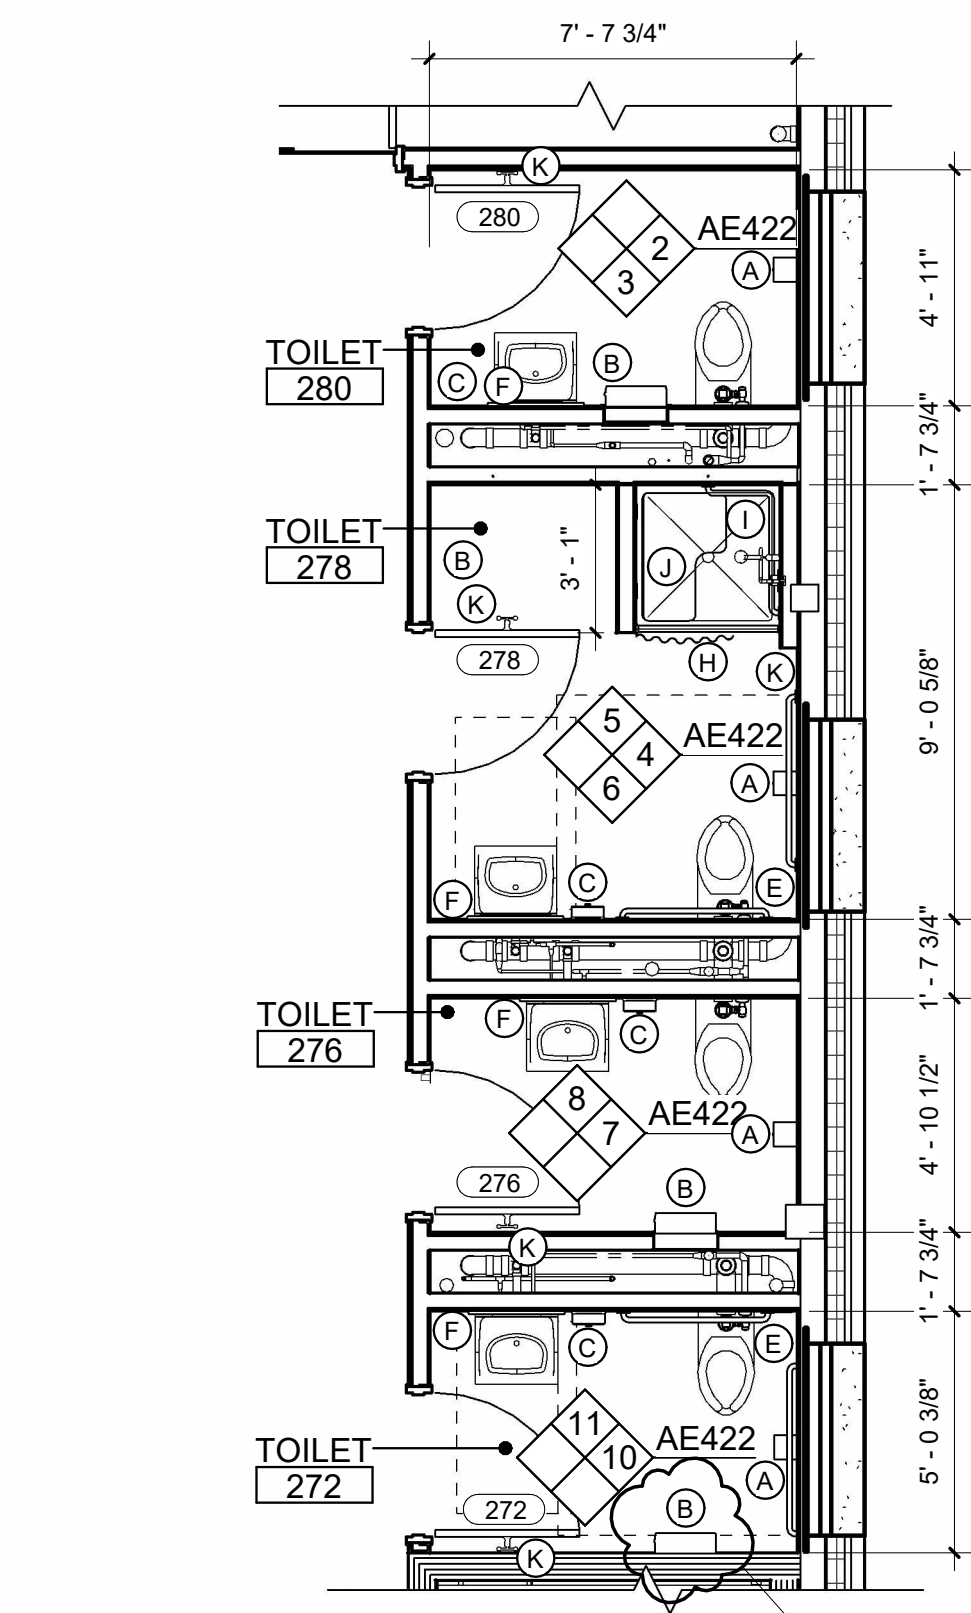


1 RESTROOM 276, 278, & 280 ENLARGED PLAN
AE102 AE422 SCALE: 1/4" = 1'-0"

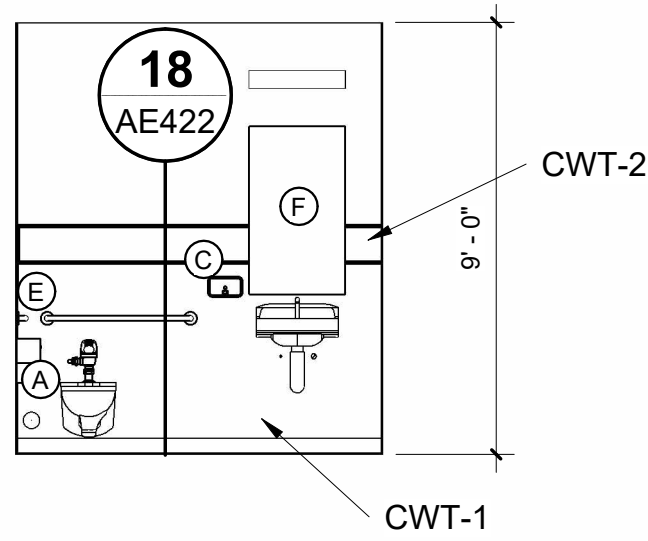


6 RESTROOM 278 WEST ELEVATION
AE422 AE422 SCALE: 1/4" = 1'-0"

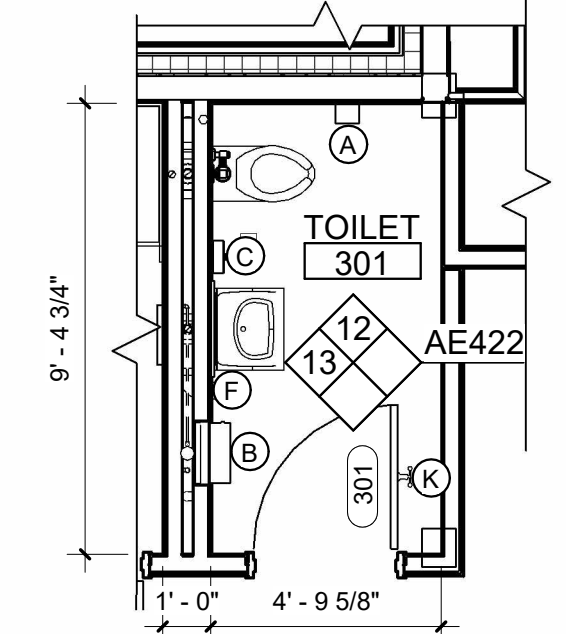


9 RESTROOM 301 ENLARGED PLAN
AE103 AE422 SCALE: 1/4" = 1'-0"

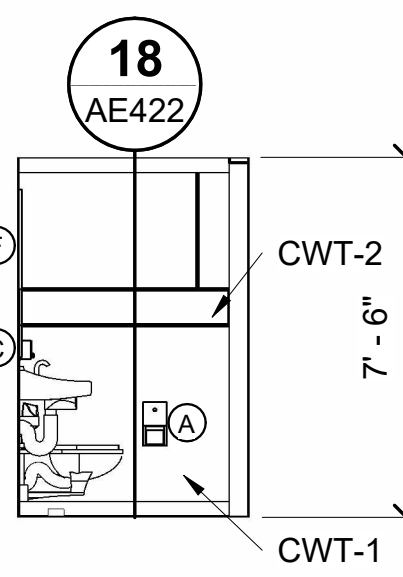


12 RESTROOM 301 EAST ELEVATION
AE422 AE422 SCALE: 1/4" = 1'-0"

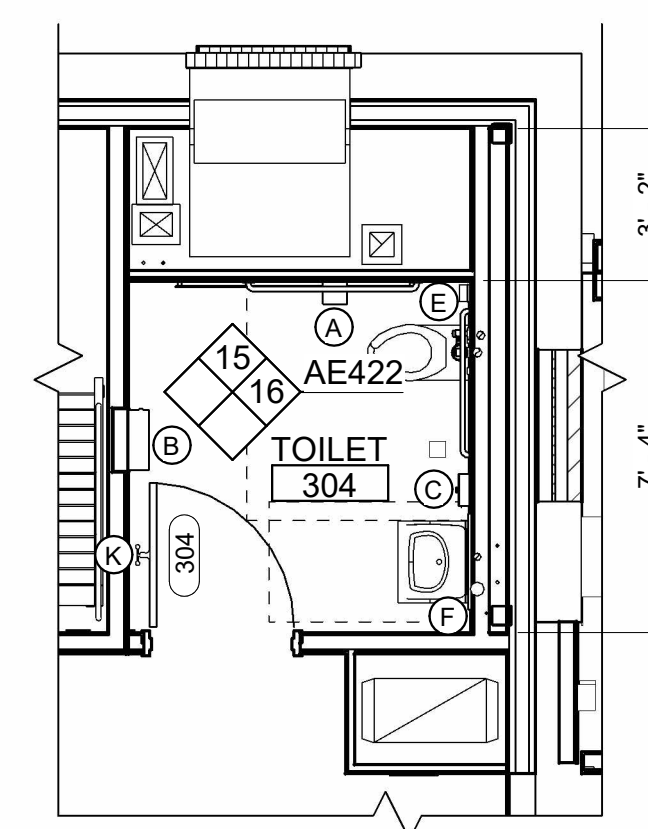


14 RESTROOM 304 ENLARGED PLAN & CORRIDOR 300
AE103 AE422 SCALE: 1/4" = 1'-0"

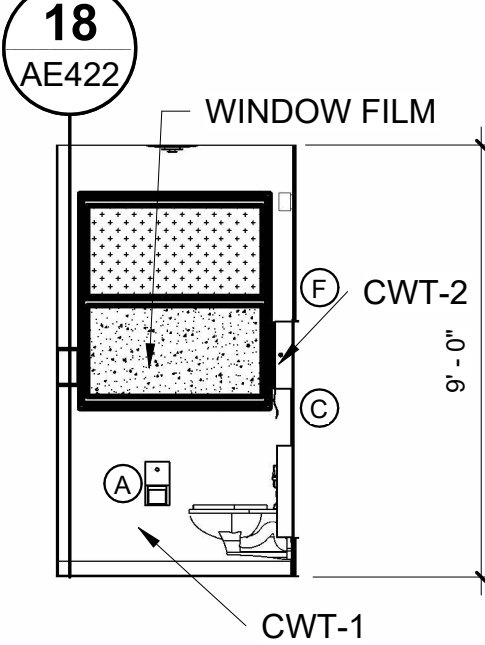


2 RESTROOM 280 SOUTH ELEVATION
AE422 AE422 SCALE: 1/4" = 1'-0"

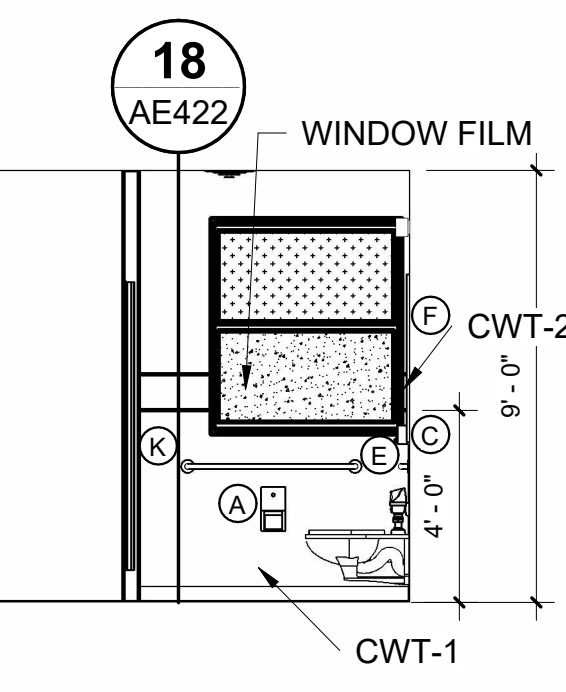


4 RESTROOM 278 SOUTH ELEVATION
AE422 AE422 SCALE: 1/4" = 1'-0"

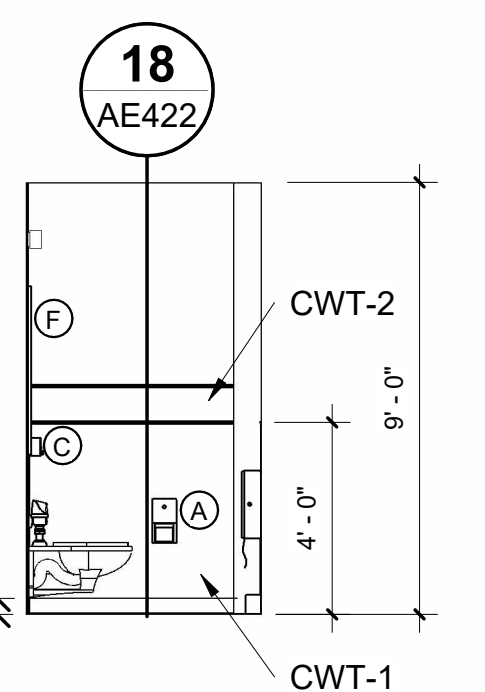


7 RESTROOM 276 SOUTH ELEVATION
AE422 AE422 SCALE: 1/4" = 1'-0"

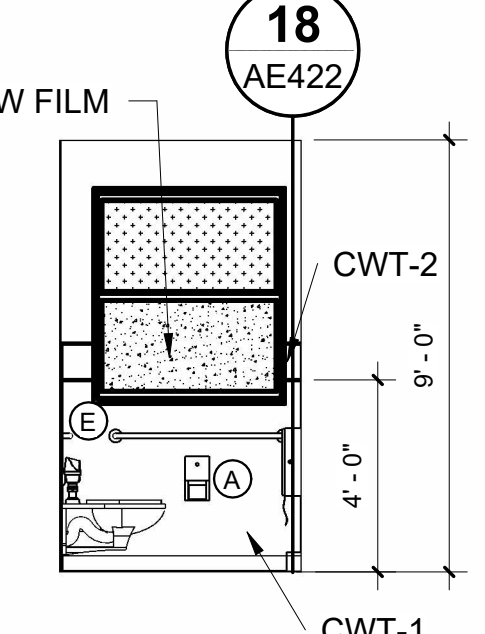


10 RESTROOM 272 SOUTH ELEVATION
AE422 AE422 SCALE: 1/4" = 1'-0"

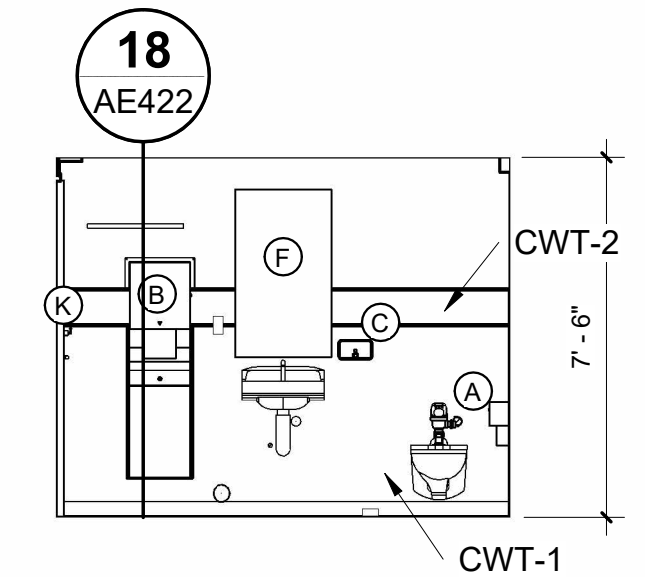


13 RESTROOM 301 NORTH ELEVATION
AE422 AE422 SCALE: 1/4" = 1'-0"

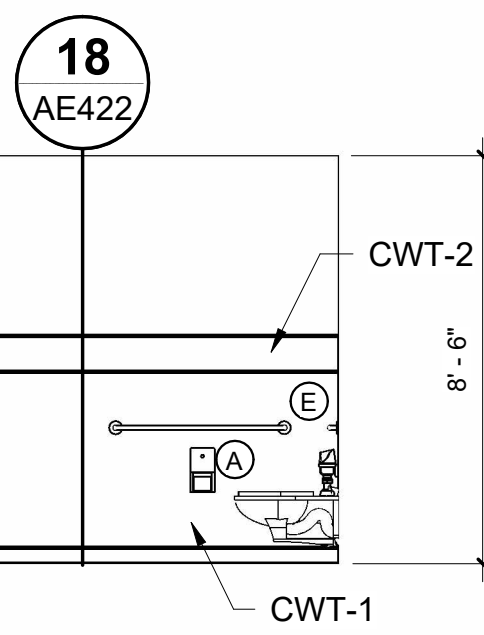


15 RESTROOM 304 EAST ELEVATION
AE422 AE422 SCALE: 1/4" = 1'-0"

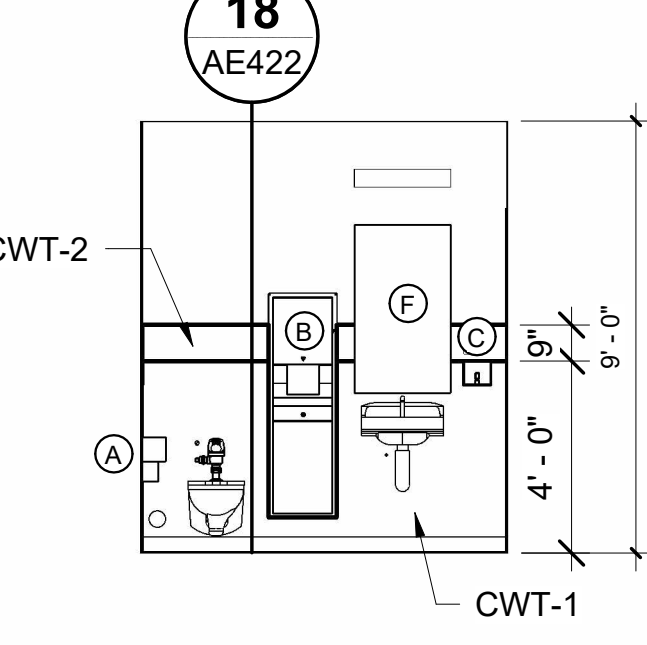


3 RESTROOM 280 WEST ELEVATION
AE422 AE422 SCALE: 1/4" = 1'-0"

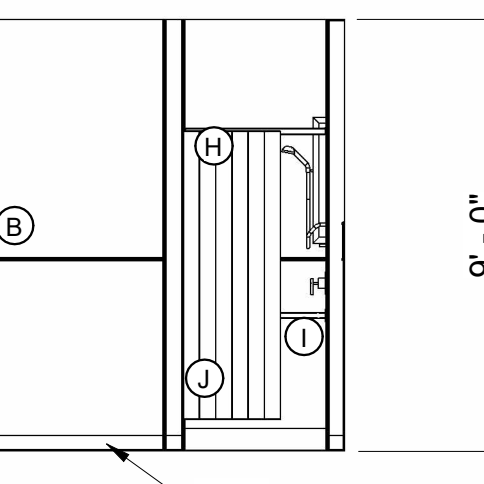


5 RESTROOM 278 EAST ELEVATION
AE422 AE422 SCALE: 1/4" = 1'-0"

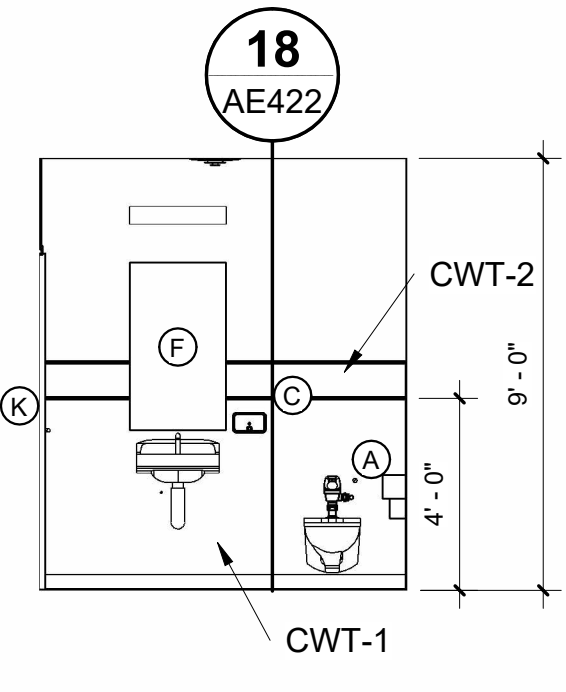

8 RESTROOM 276 EAST ELEVATION
AE422 AE422 SCALE: 1/4" = 1'-0"

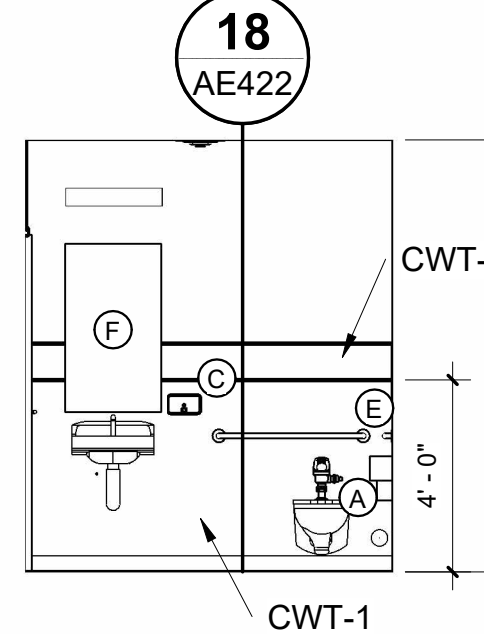


11 RESTROOM 272 EAST ELEVATION
AE422 AE422 SCALE: 1/4" = 1'-0"

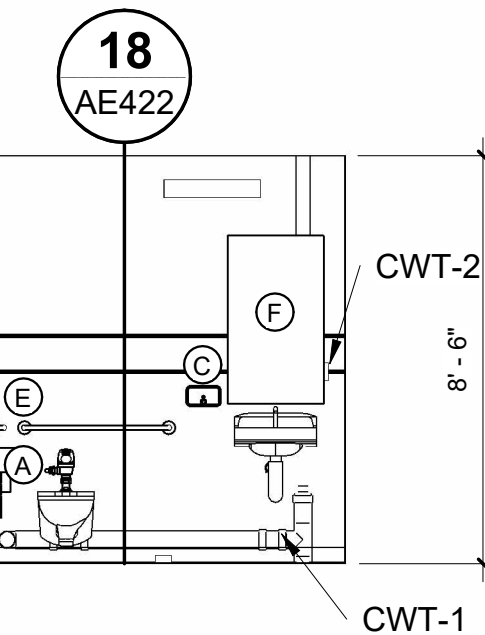


16 RESTROOM 304 SOUTH ELEVATION
AE422 AE422 SCALE: 1/4" = 1'-0"

GENERAL NOTES


1. SEE SHEETS AE101, AE102, OR AE103 FOR KEYNOTES.
2. SEE SHEET AE420 FOR MOUNTING HEIGHTS AND RESTROOM ACCESSORY SCHEDULE.
3. SEE 17/AE422 FOR TILE PATTERN ELEVATION.
4. SEE SHEETS AE601-AE602 FOR DOOR SCHEDULE AND TYPES.
5. SEE SHEETS AE640-AE641 FOR ROOM FINISH SCHEDULE.
6. COORDINATE BLOCKING LOCATIONS W/ ACCESSORY ITEMS.

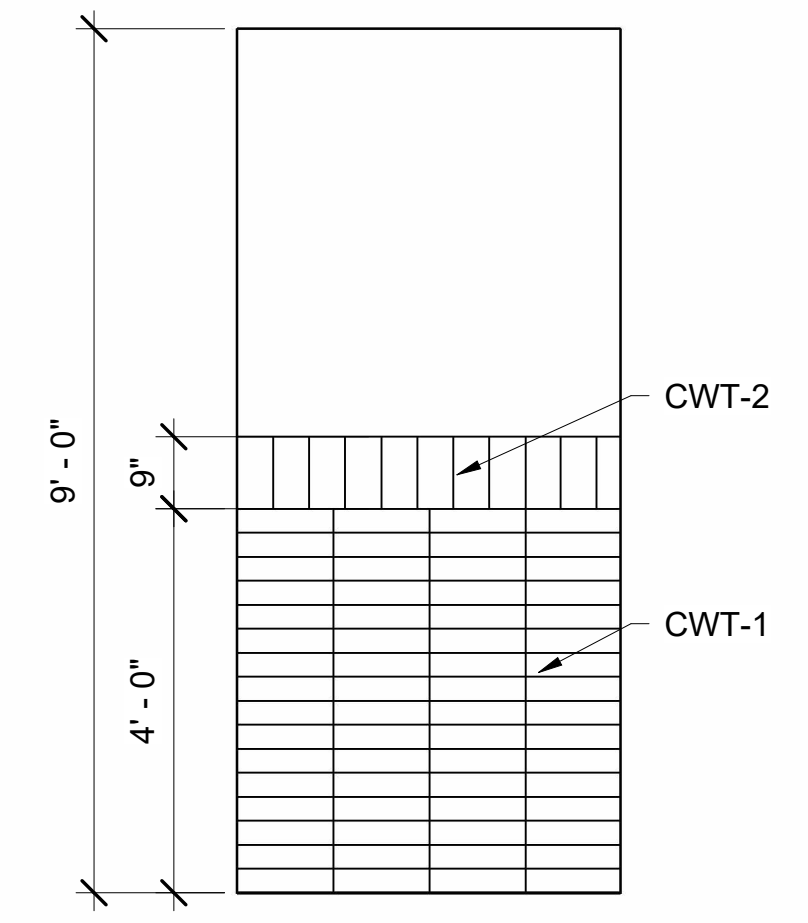


17 TILE PATTERN ELEVATION
AE422 SCALE: 1/2" = 1'-0"

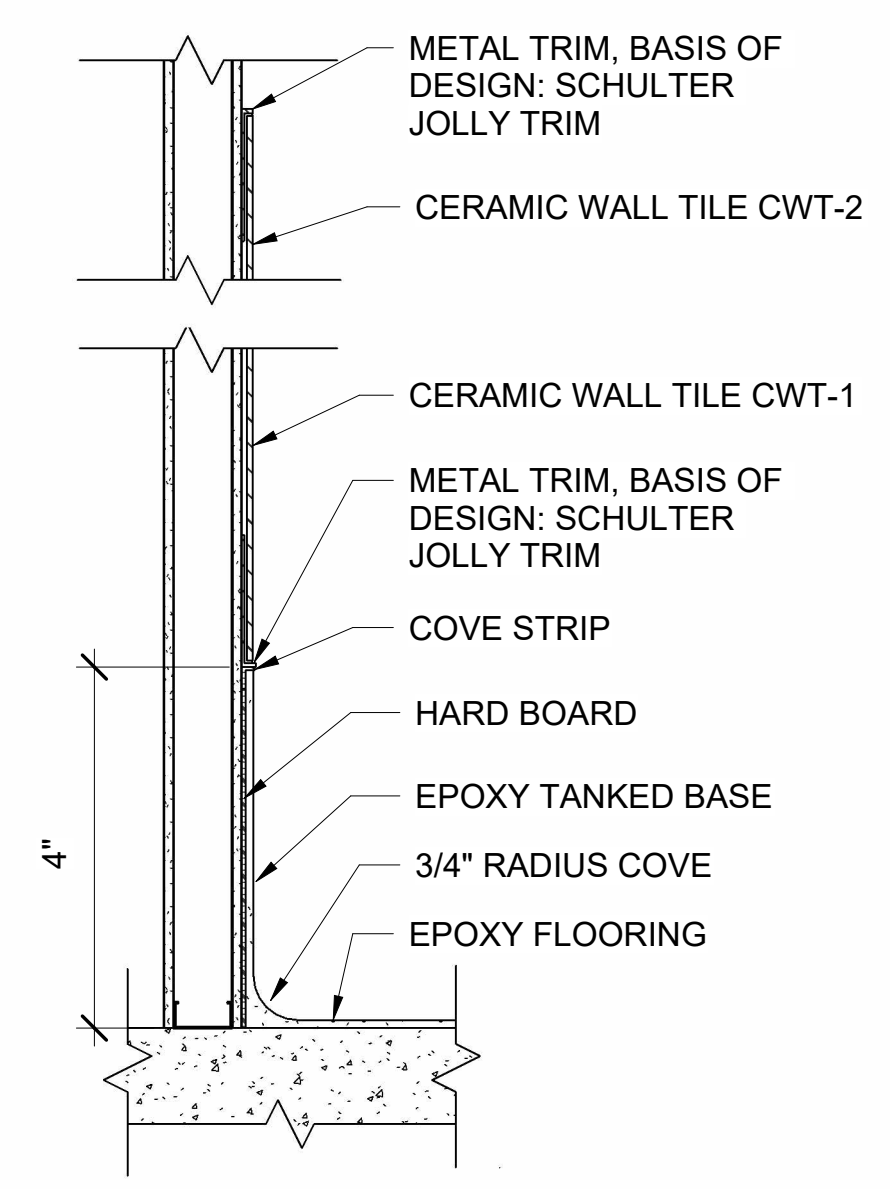


18 EPOXY FLOOR AND WALL TILE DETAIL
AE420 AE422 SCALE: 1" = 1'-0"

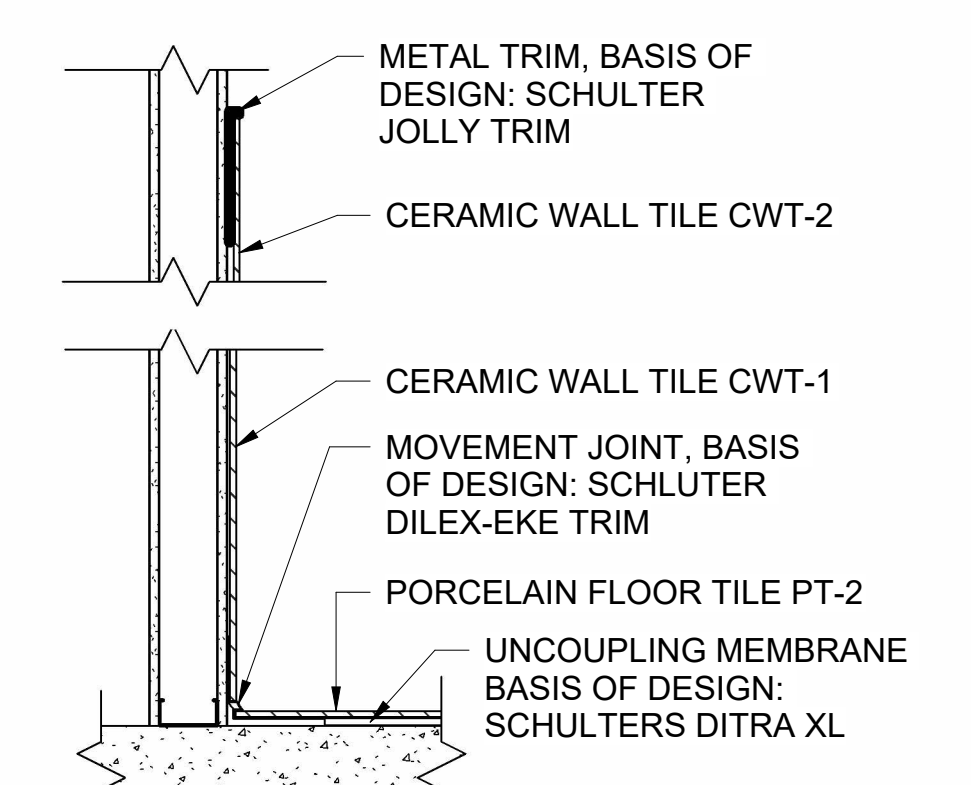


19 PORCELAIN TILE FLOOR AND WALL TILE DETAIL
AE420 AE422 SCALE: 1" = 1'-0"

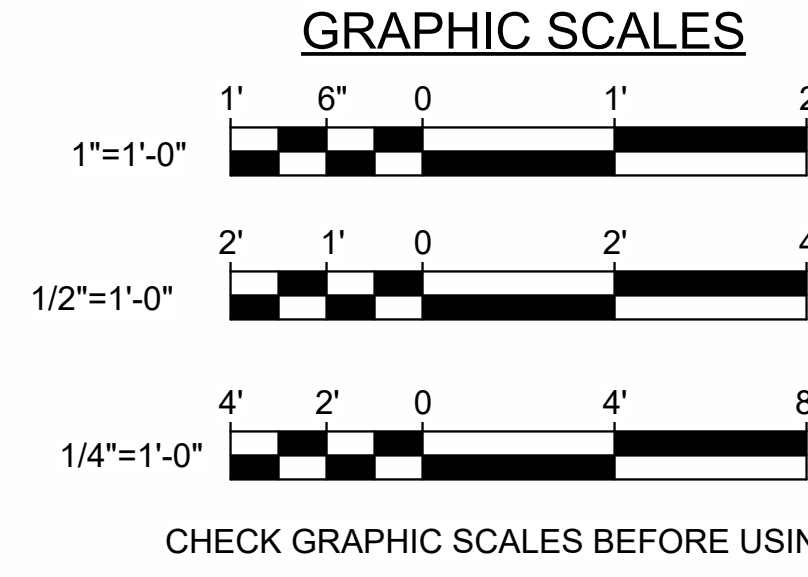


				DEPARTMENT OF INLAND FISHERIES & WILDLIFE			
				TITLE: NEW OFFICE HEADQUARTERS			
				LOCATION: AUGUSTA, ME			
				TITLE THIS DWG: RESTROOM ENLARGED PLAN AND INTERIOR ELEVATION 3			
				OAK POINT ASSOCIATES			
				DRAWN BY: MJD			
				CHECK BY: CET			
				DATE: 01/29/2025			
				231 Main Street, Biddeford, Maine 04005			

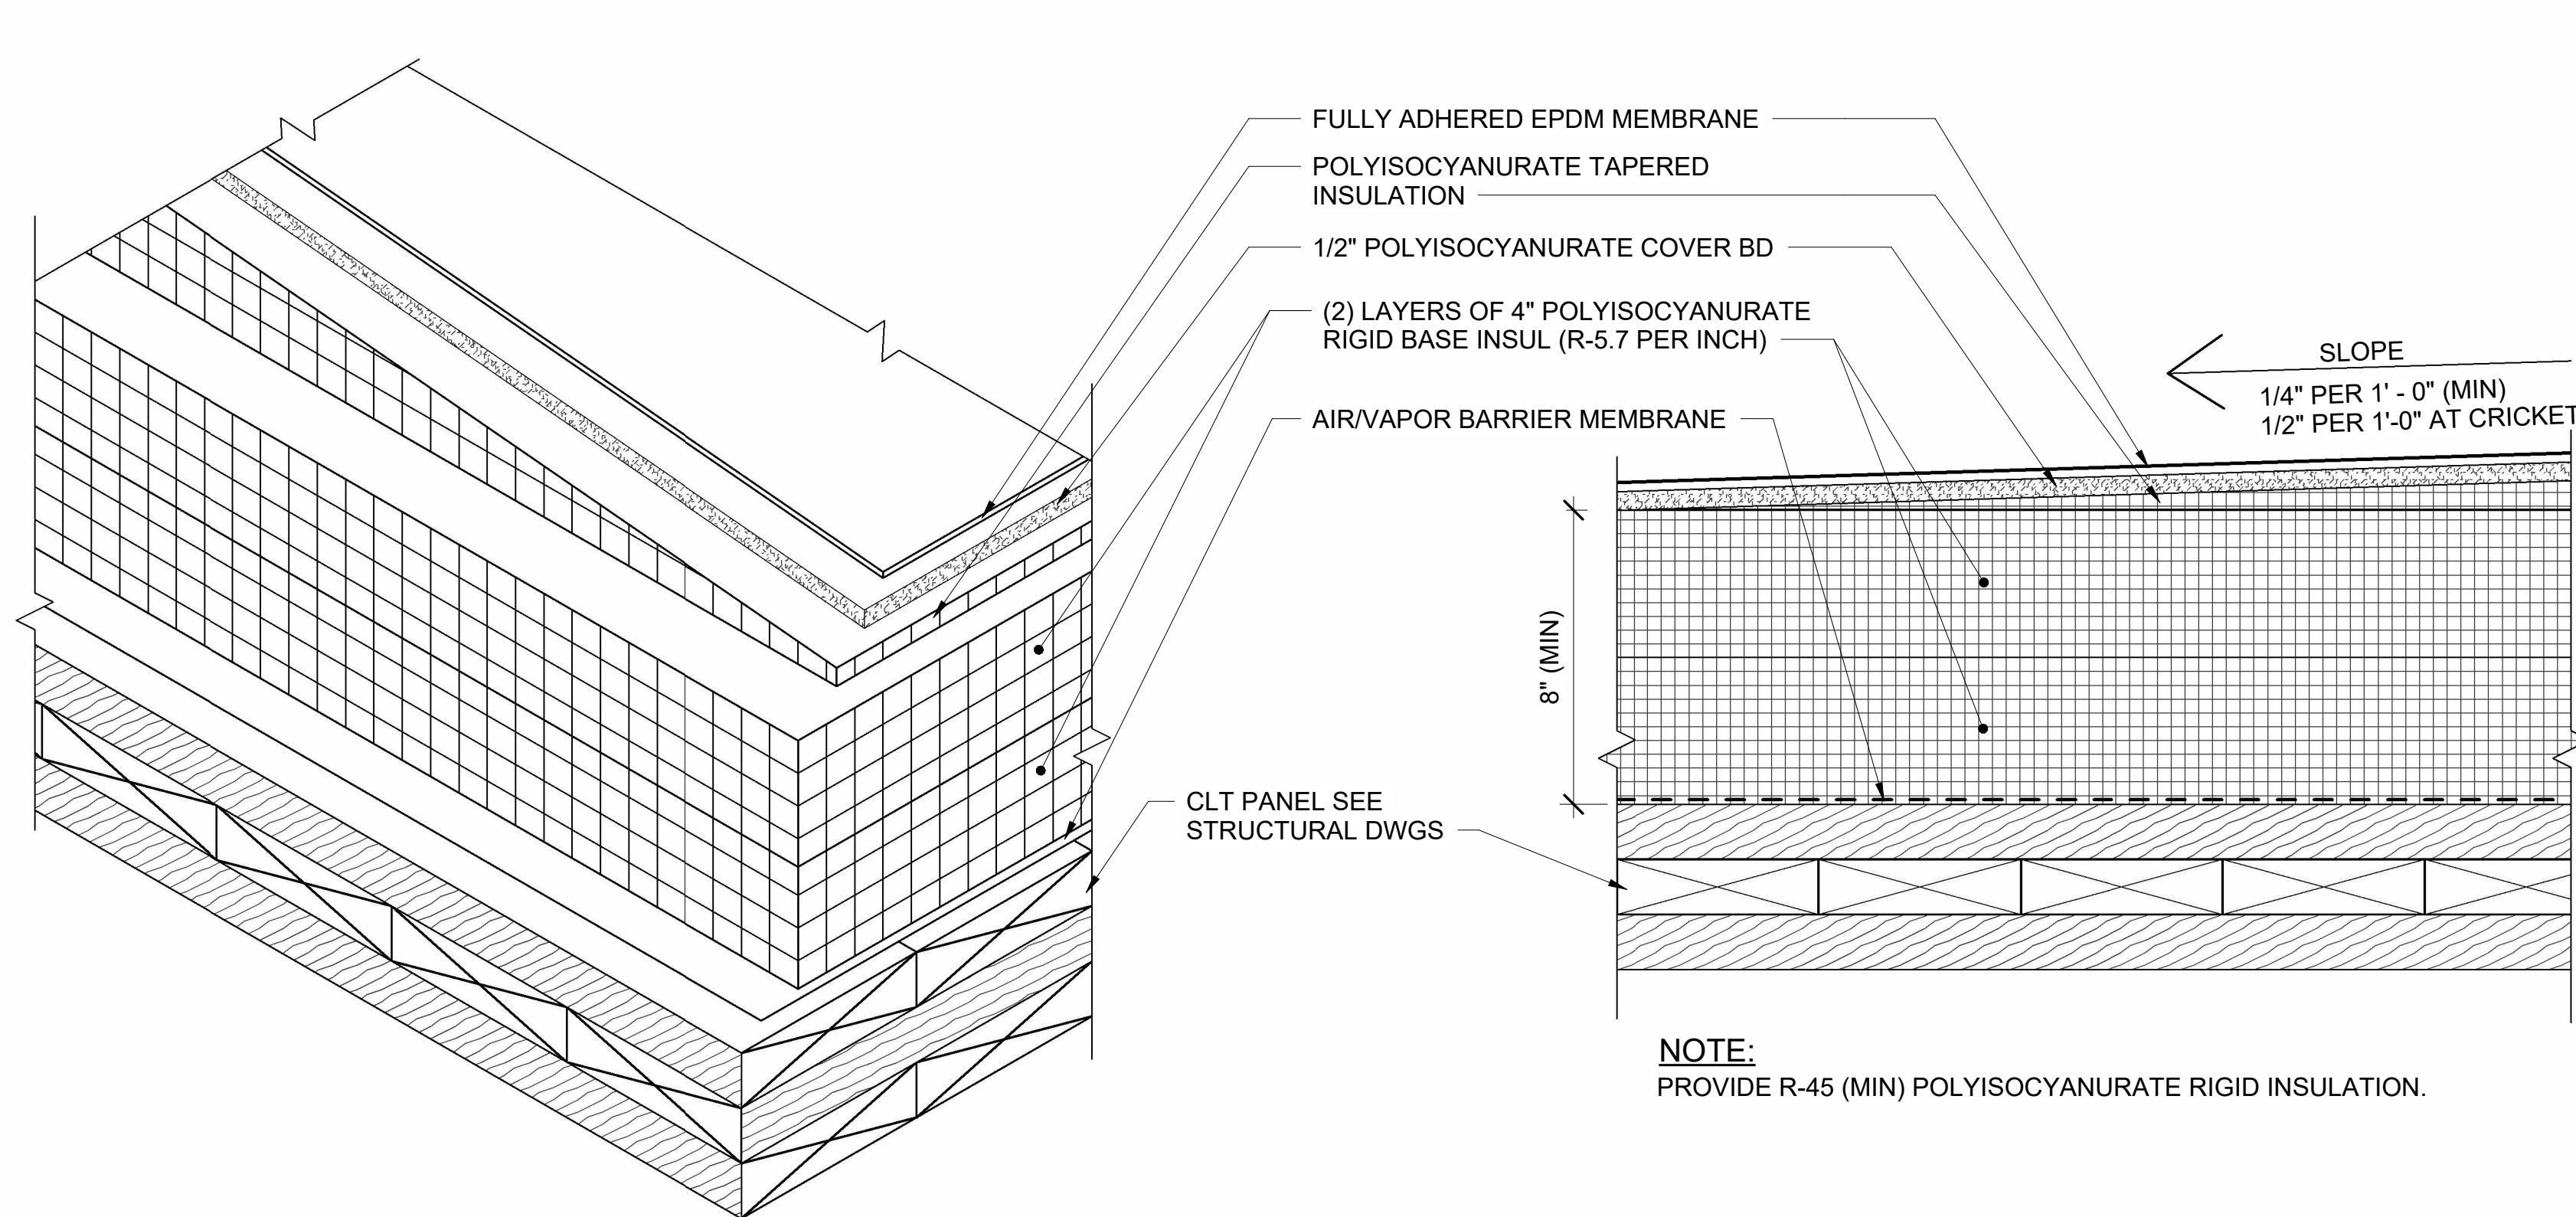


1 EPDM ROOF SYSTEM DETAIL (TYP)
AE120 AE501 SCALE: 3" = 1'-0"

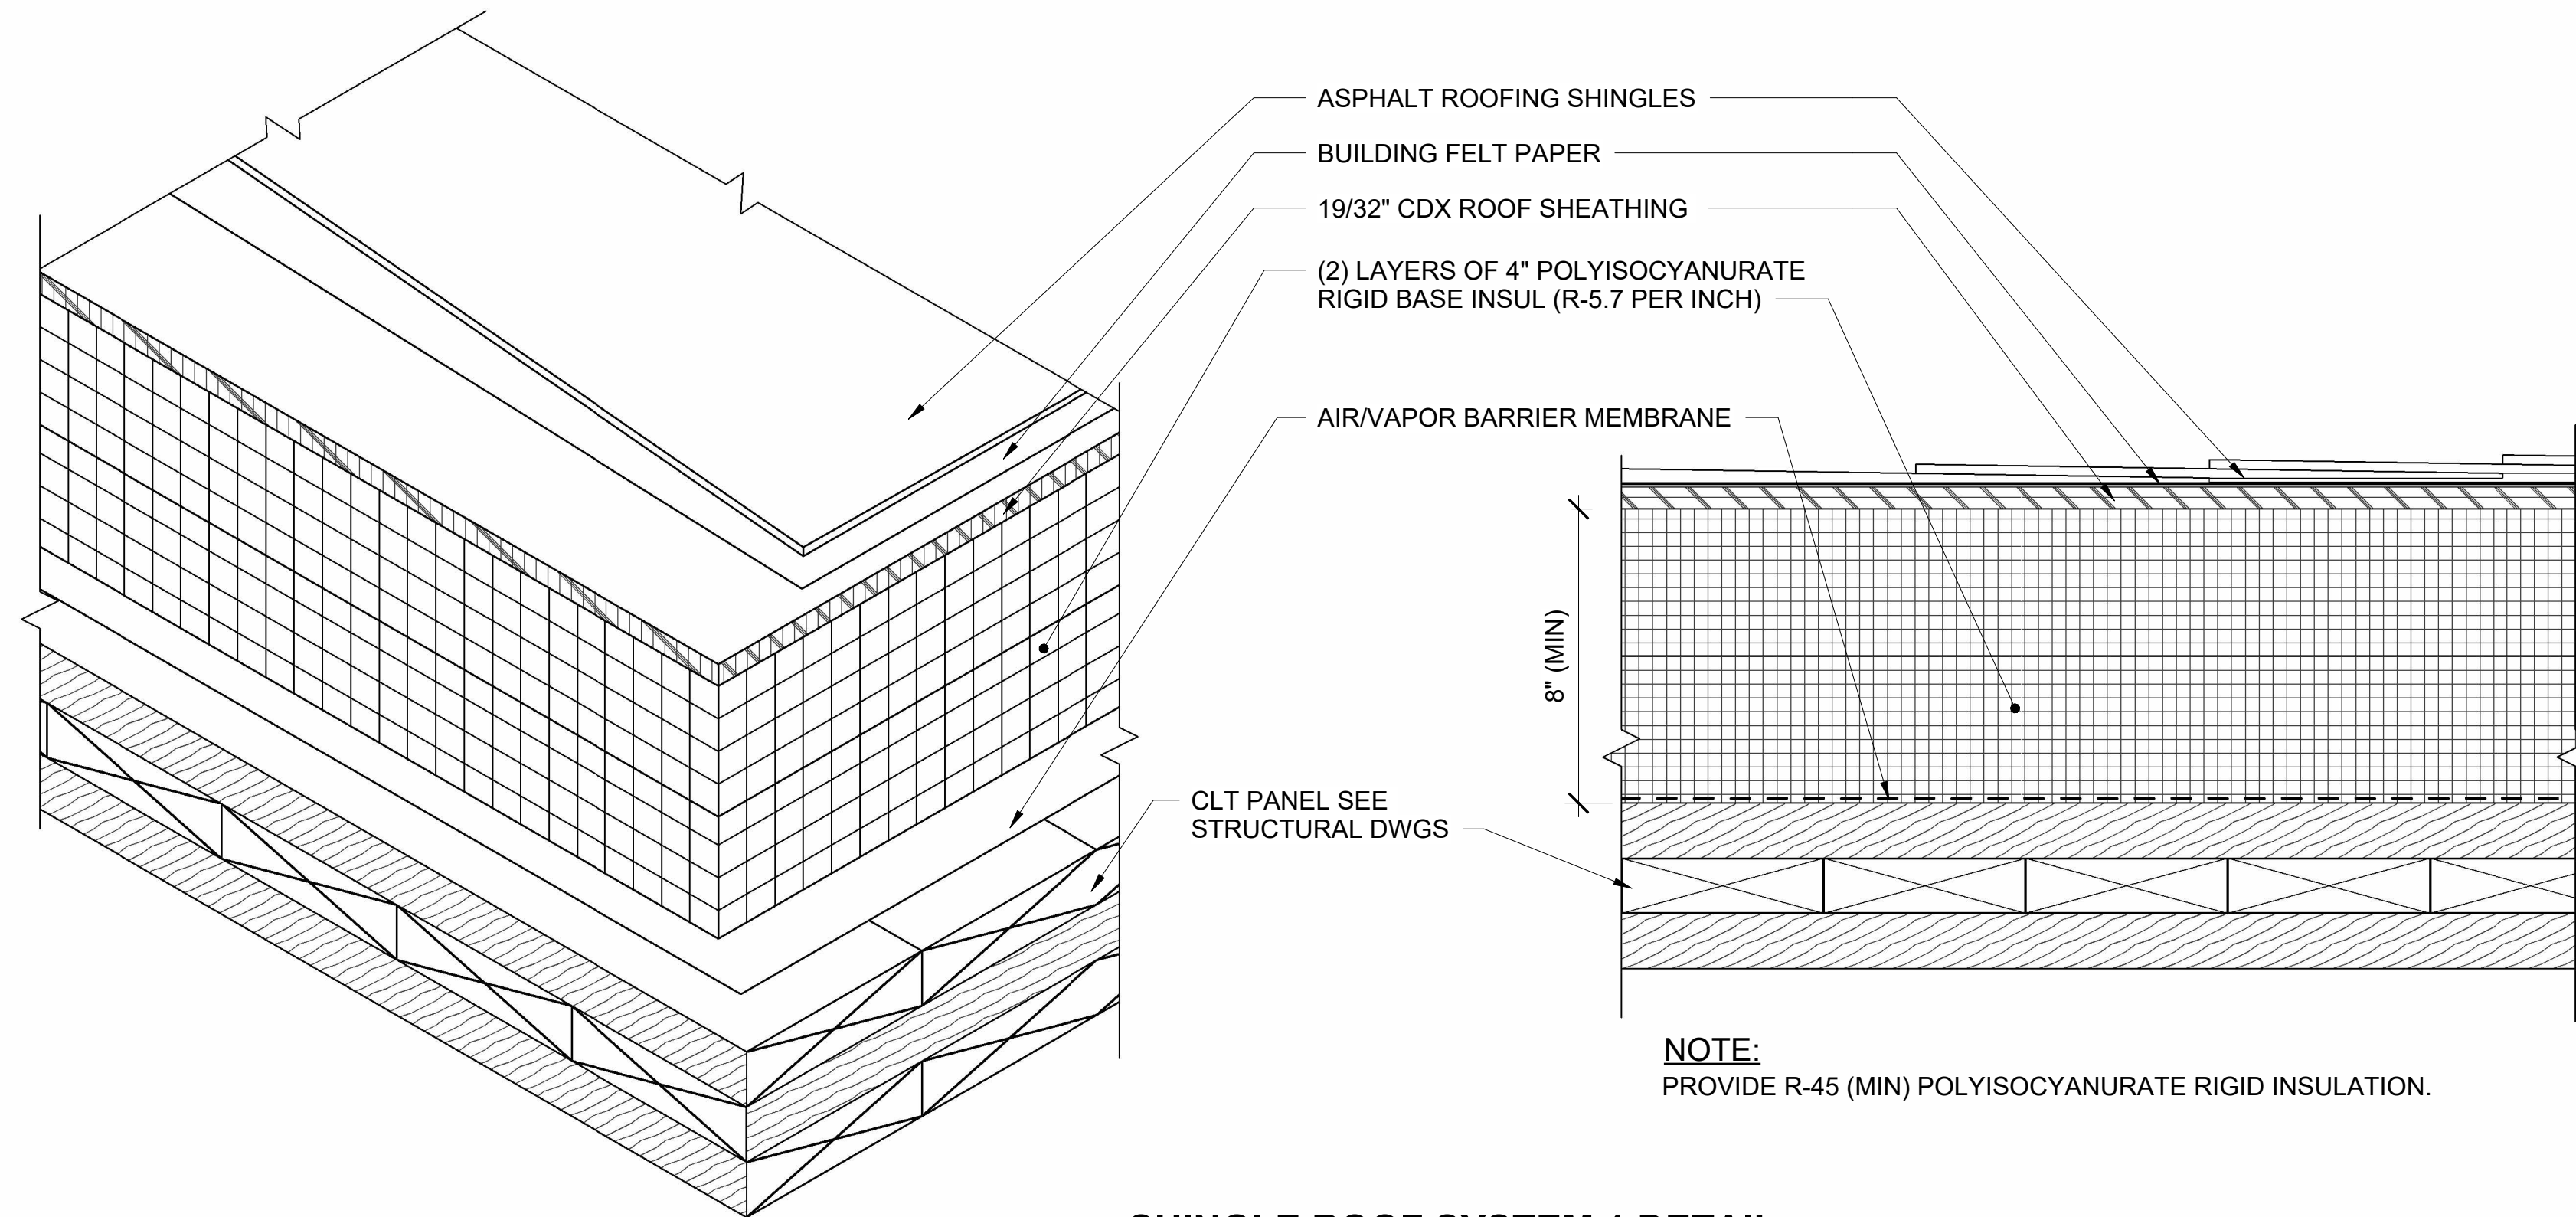


2 SHINGLE ROOF SYSTEM 1 DETAIL (TYP)
AE120 AE501 SCALE: 3" = 1'-0"

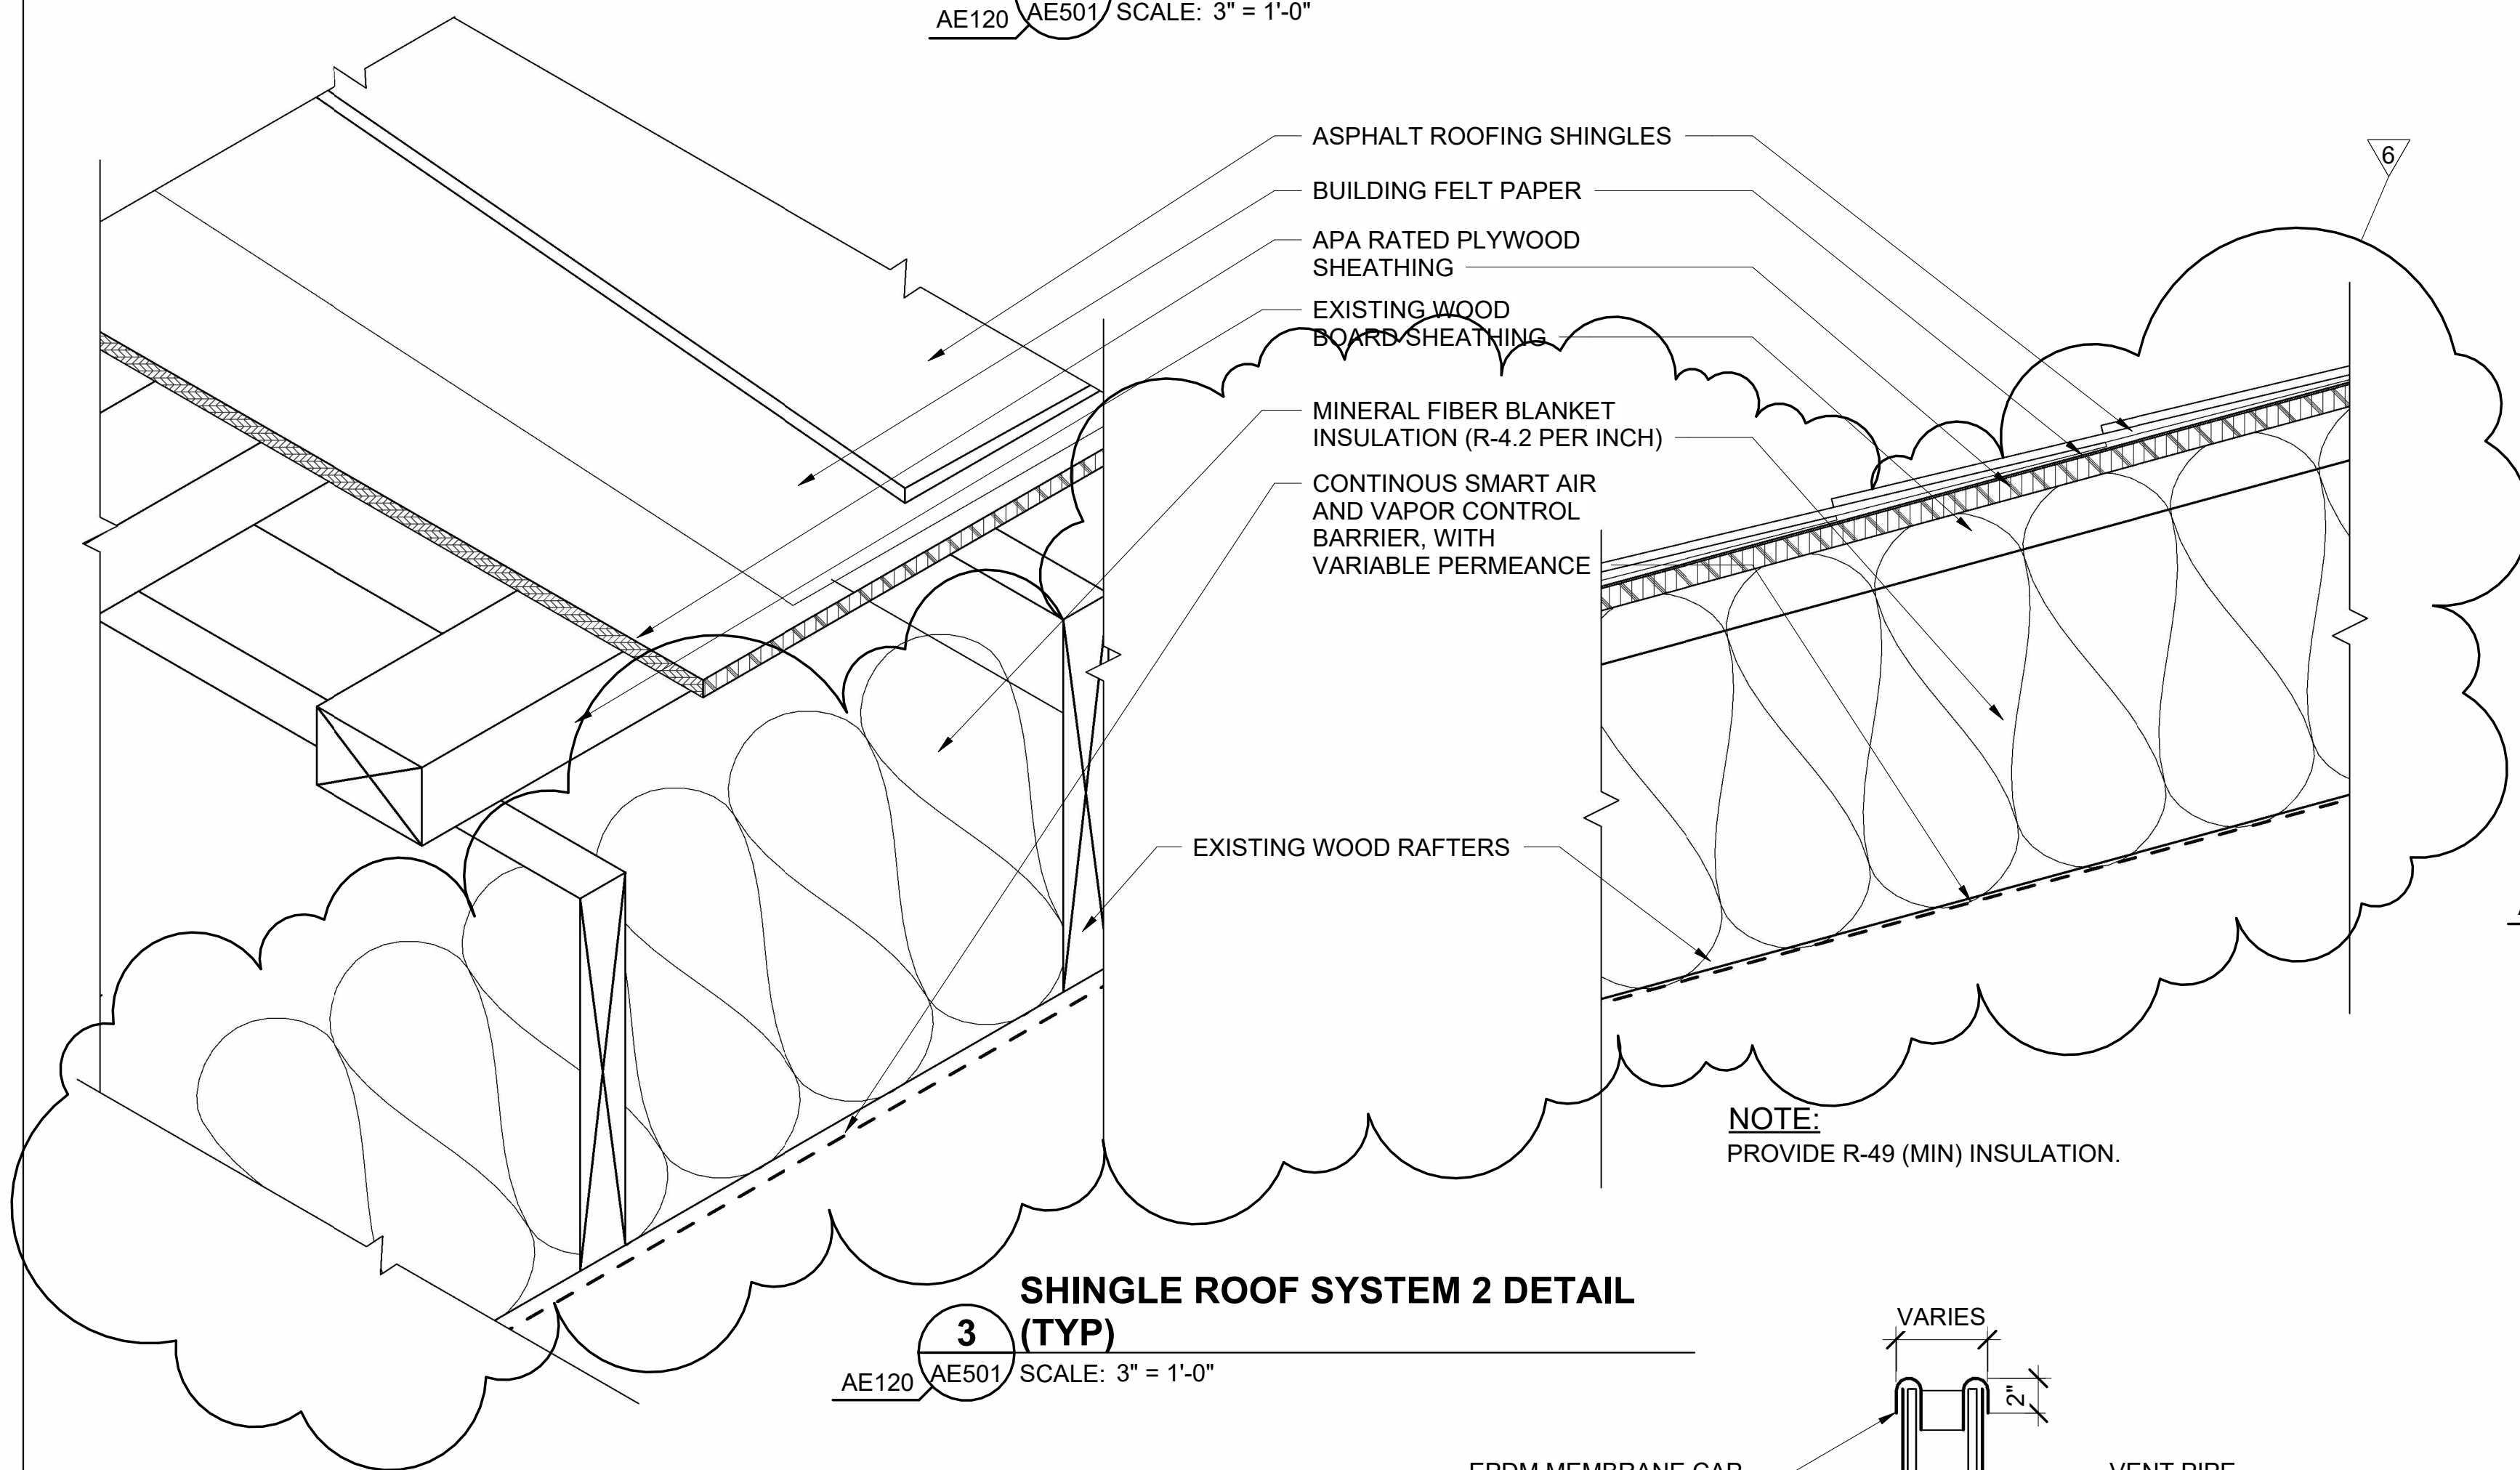


3 SHINGLE ROOF SYSTEM 2 DETAIL (TYP)
AE120 AE501 SCALE: 3" = 1'-0"

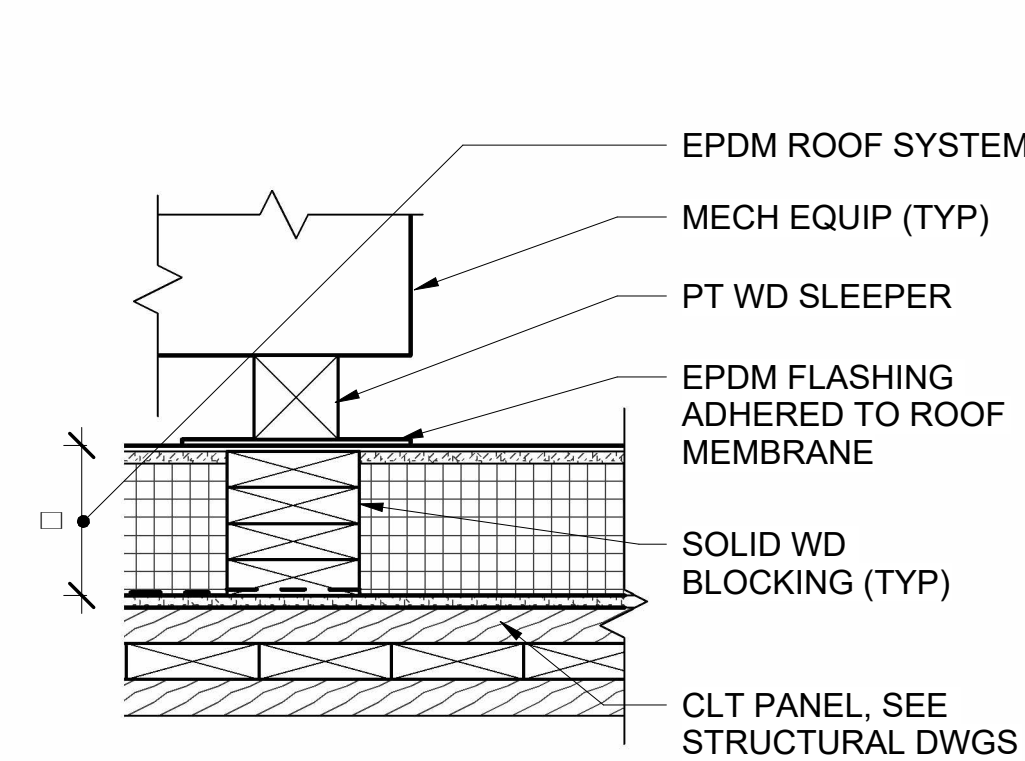


4 ROOF SLEEPER DETAIL (TYP)
AE120 AE501 SCALE: 1 1/2" = 1'-0"

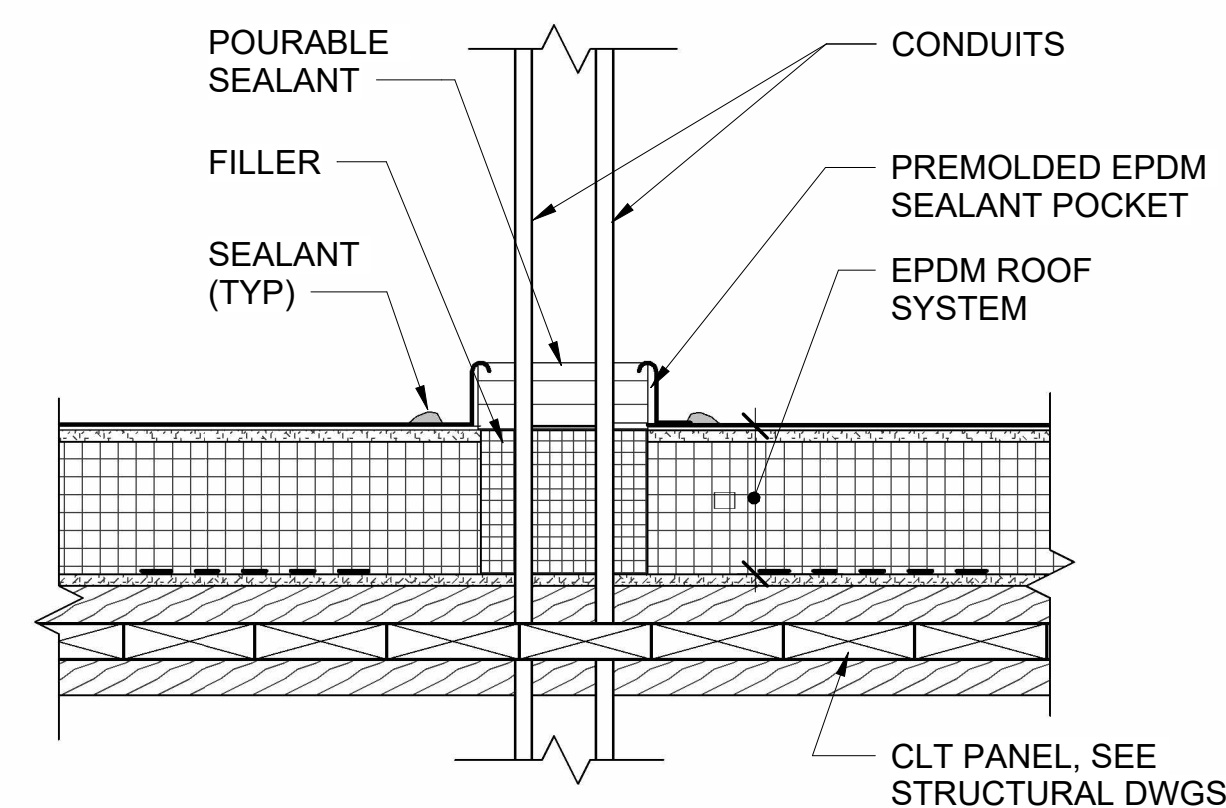


5 PITCH POCKET DETAIL (TYP)
AE501 SCALE: 1 1/2" = 1'-0"

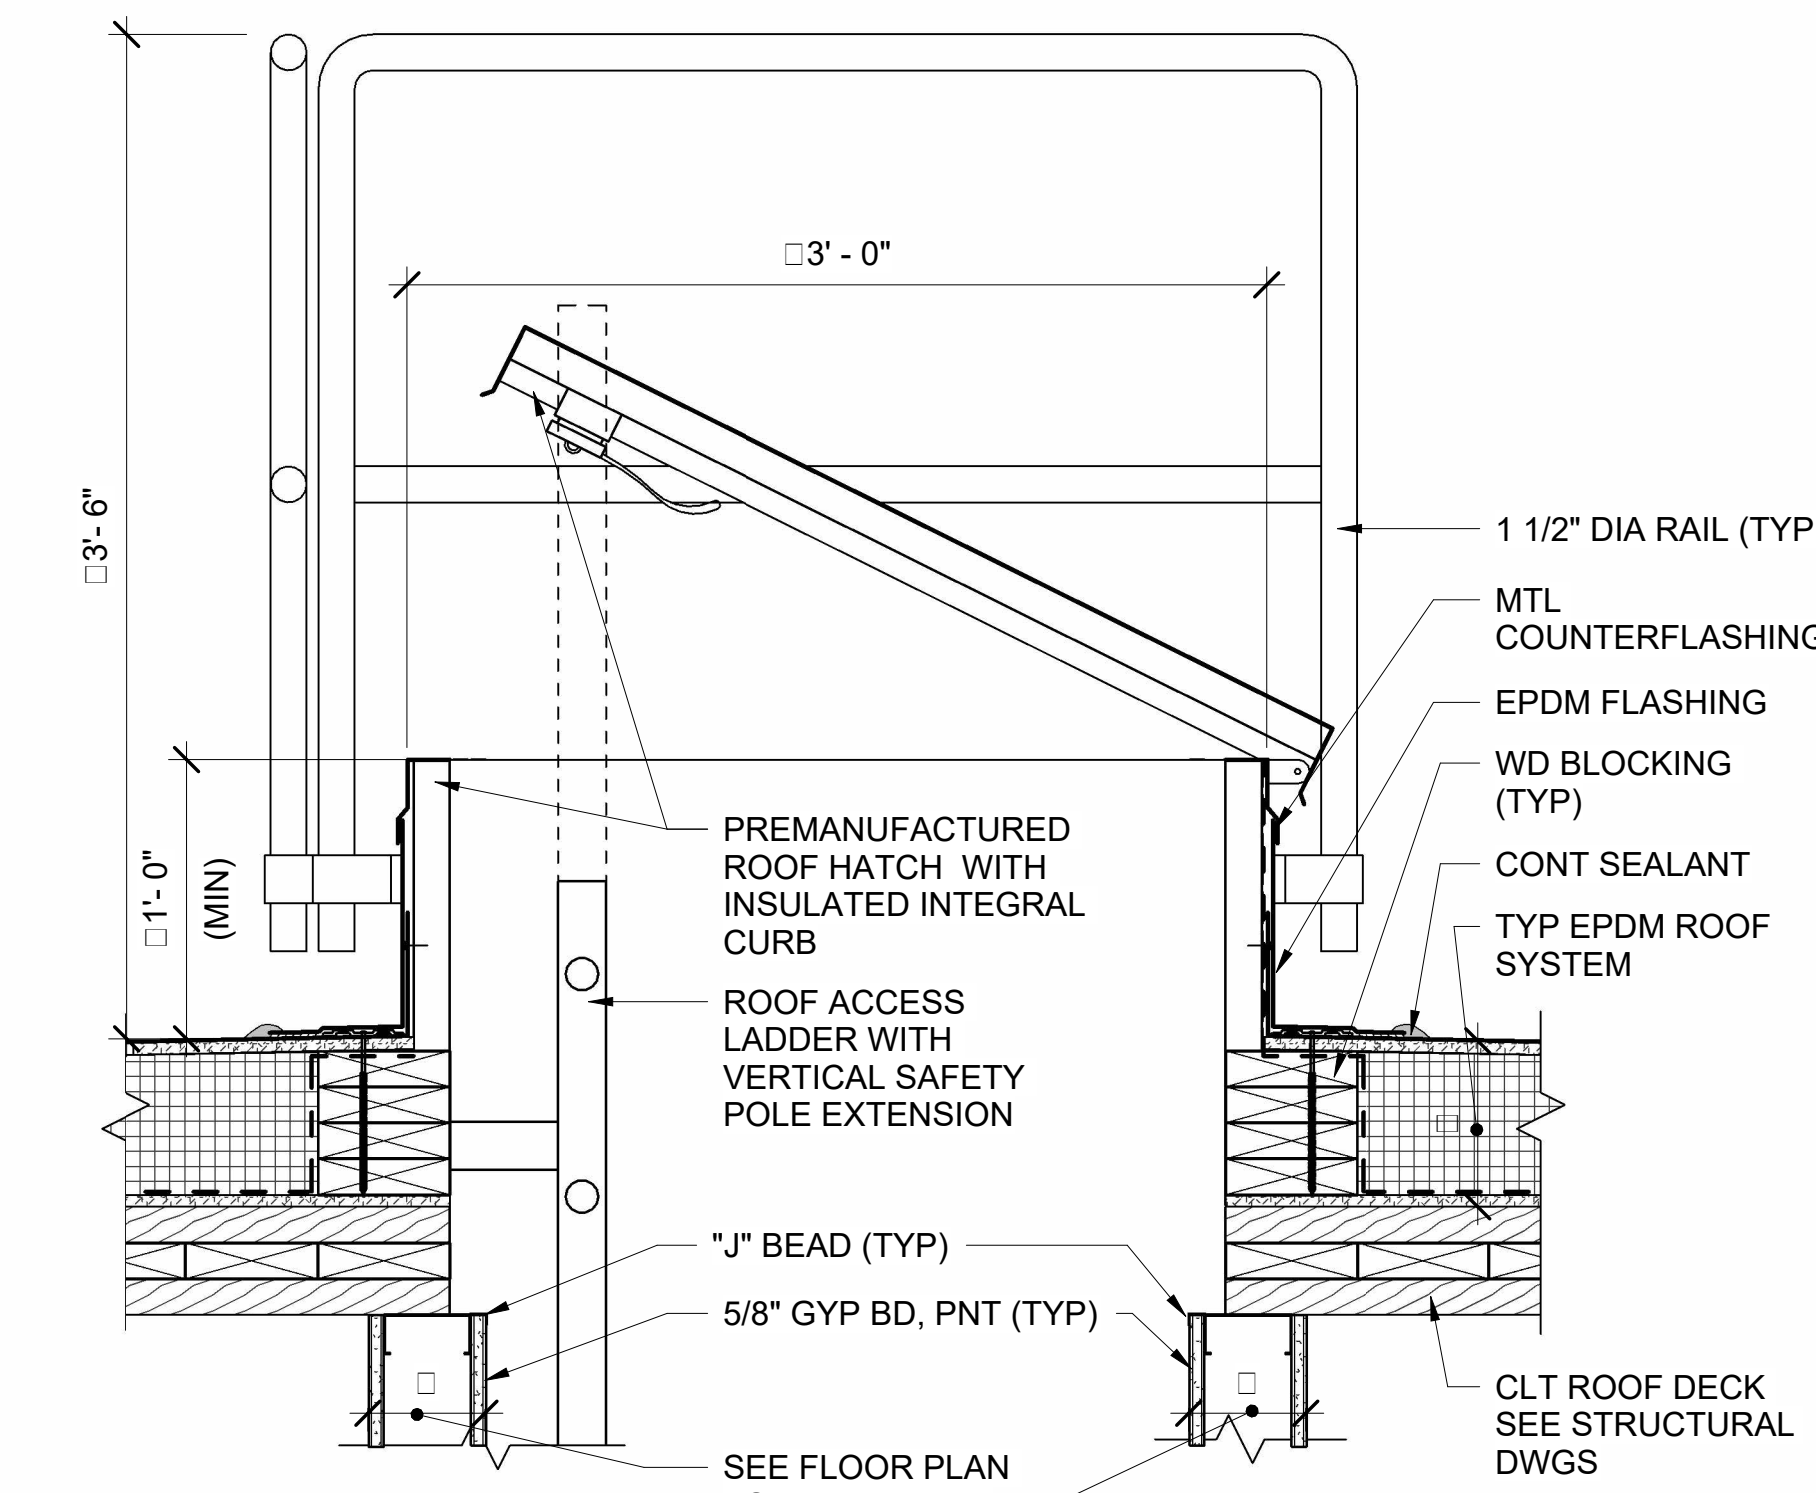


6 ROOF HATCH DETAIL (TYP)
AE120 AE501 SCALE: 1 1/2" = 1'-0"

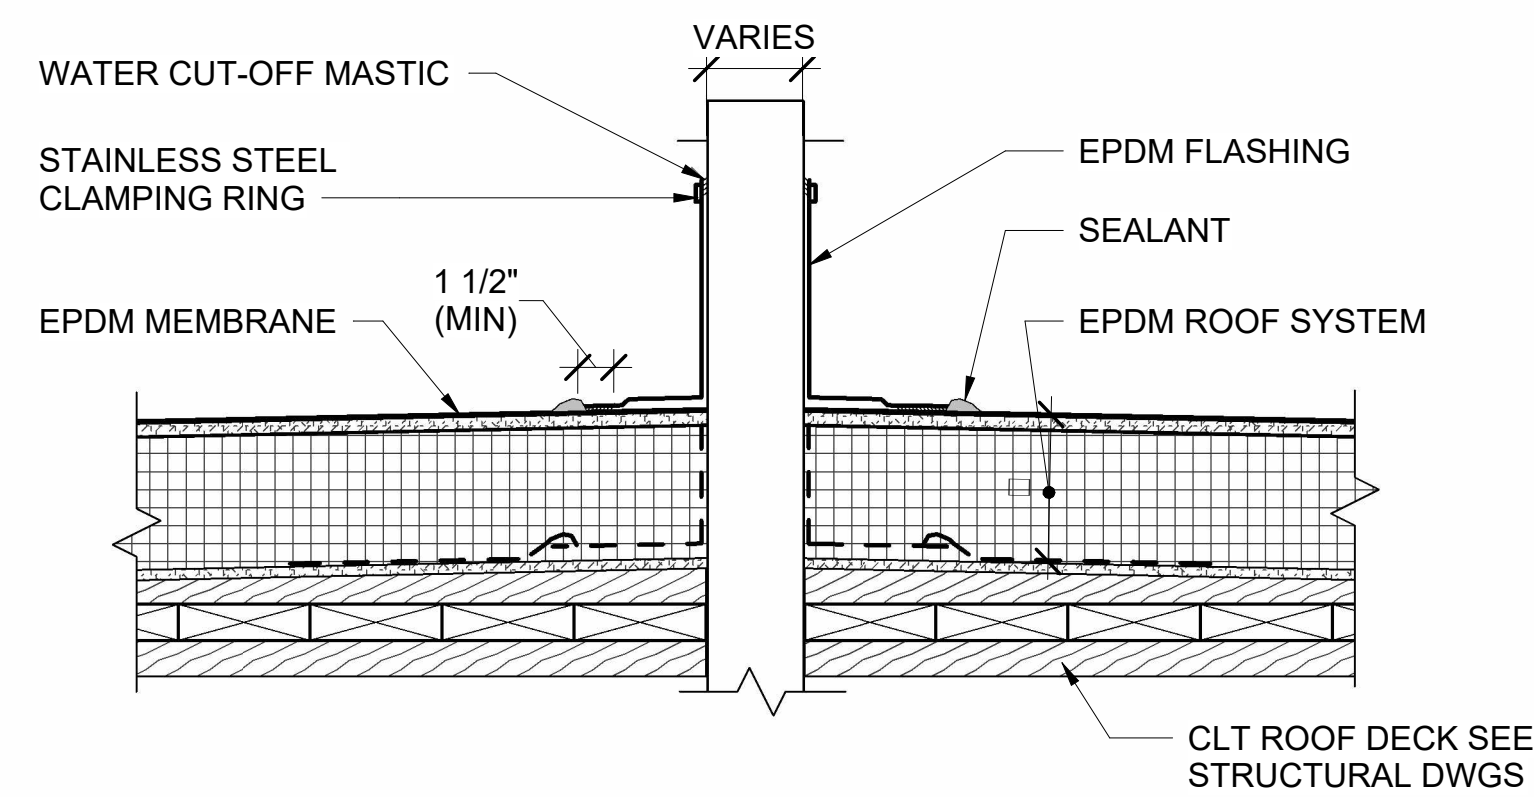


7 PIPE SUPPORT PENETRATION DETAIL (TYP)
AE501 SCALE: 1 1/2" = 1'-0"

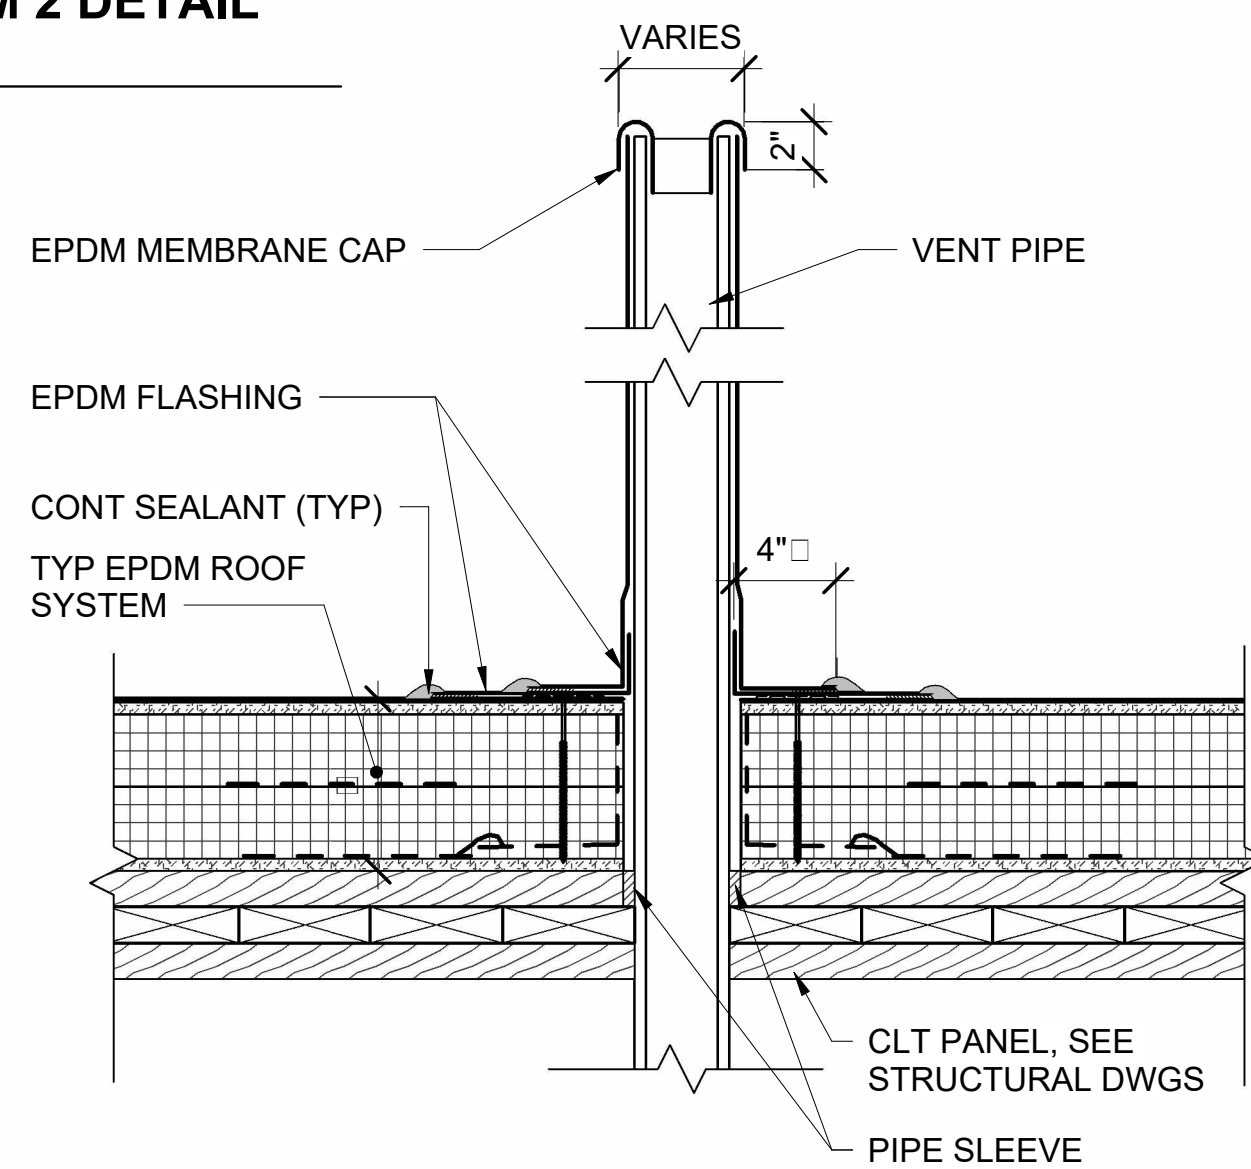


8 VENT PIPE DETAIL (TYP)
AE501 SCALE: 1 1/2" = 1'-0"

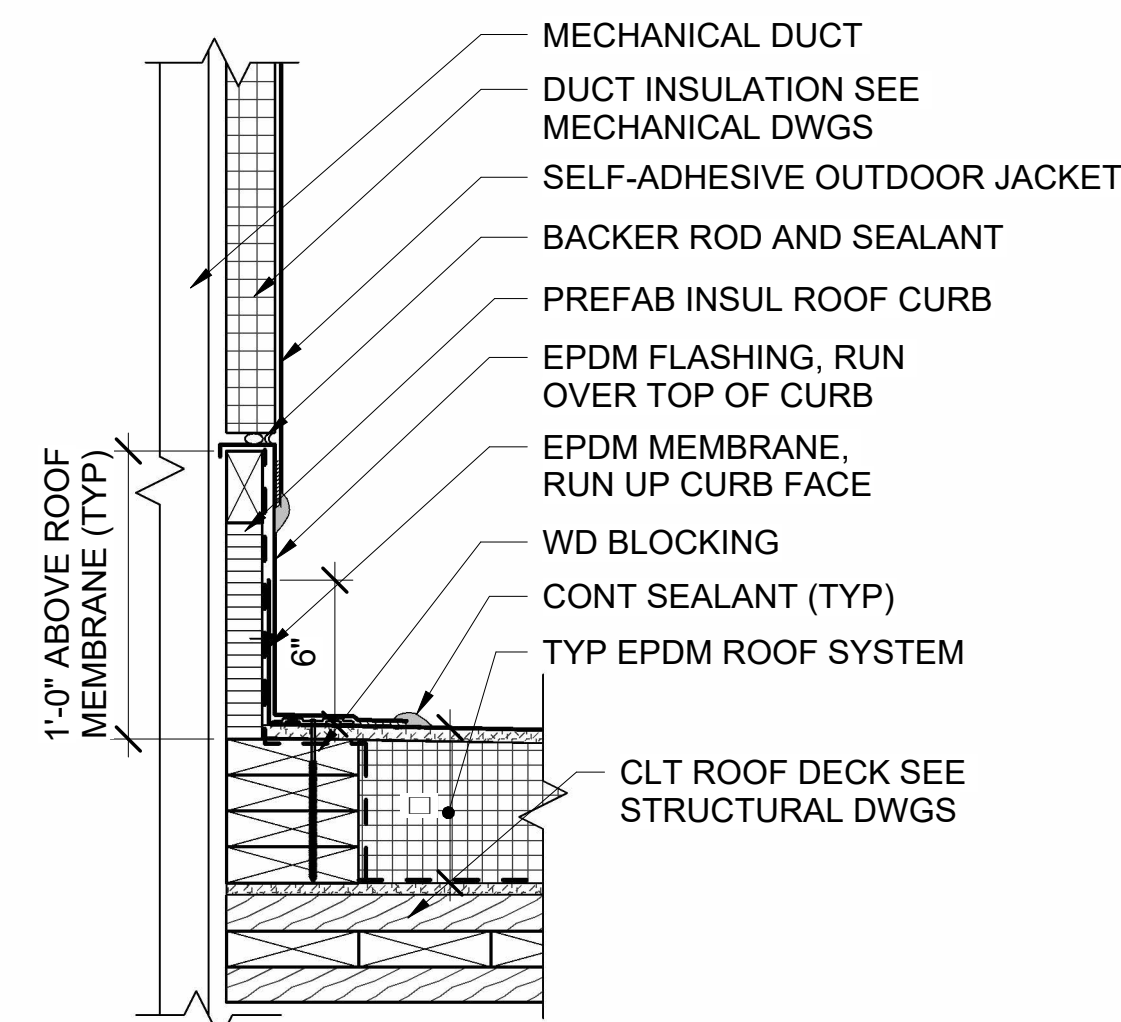


9 DUCT CURB DETAIL (TYP)
AE501 SCALE: 1 1/2" = 1'-0"

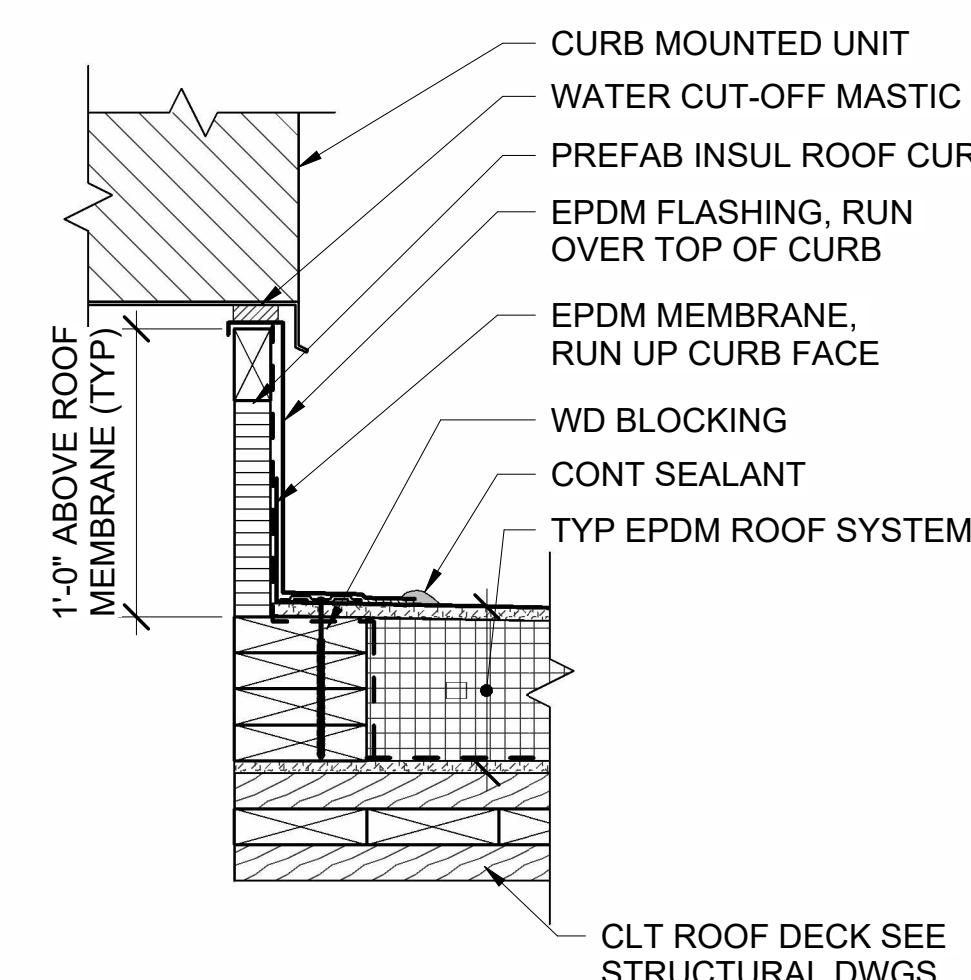

10 EQUIPMENT CURB DETAIL (TYP)
AE120 AE501 SCALE: 1 1/2" = 1'-0"

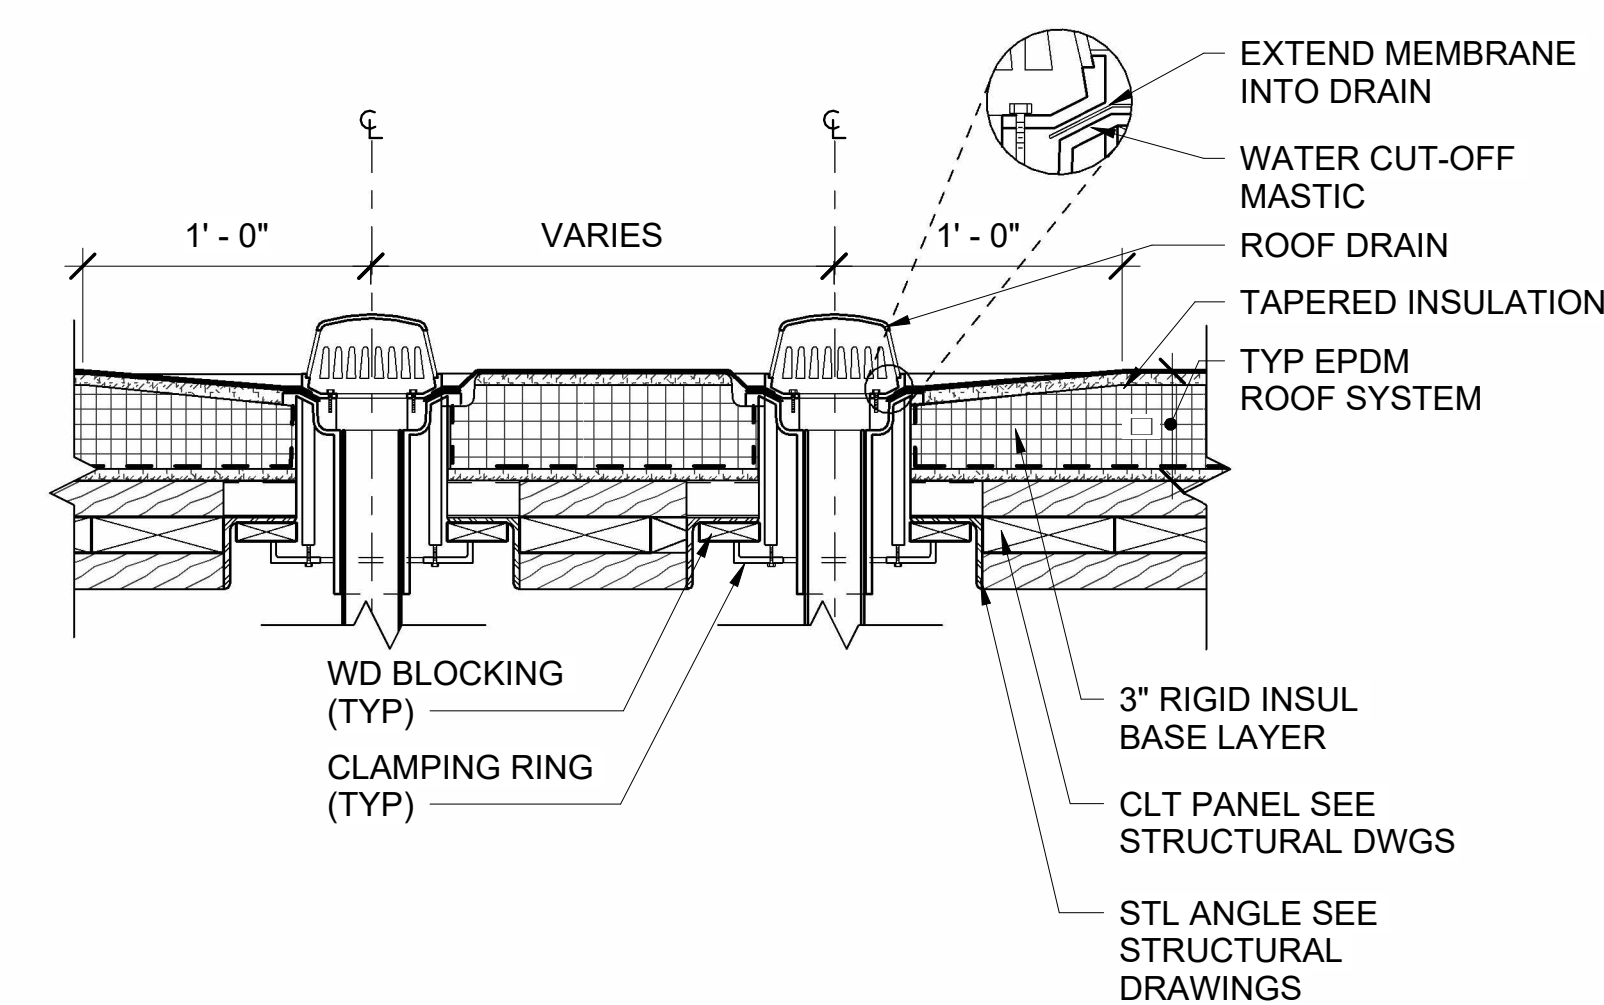


11 DUAL ROOF DRAIN DETAIL 2 (TYP)
AE120 AE501 SCALE: 1 1/2" = 1'-0"

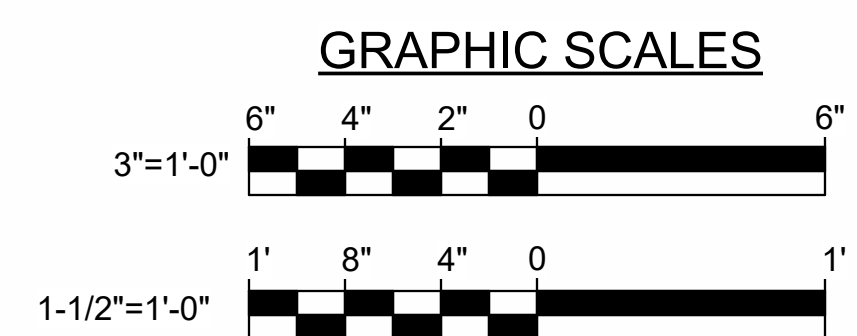


CHECK GRAPHIC SCALE BEFORE USING

DEPARTMENT OF INLAND FISHERIES & WILDLIFE			
TITLE NEW OFFICE HEADQUARTERS			
LOCATION AUGUSTA, ME			
TITLE THIS DWG. ROOF DETAILS 1			
DRAWN BY: MJD			
CHECK BY: CET			
DATE 01/29/2025			
NO. 1			
DESCRIPTION			
REVISIONS			
6 03/13/2025 ADDENDUM NO.6			
1 02/13/2025 ADDENDUM NO.1			
NO. DATE DESCRIPTION			
BY			
DATE 01/29/2025			
DRAWING NO. AE501			
SHEET NO. 130 OF 239			

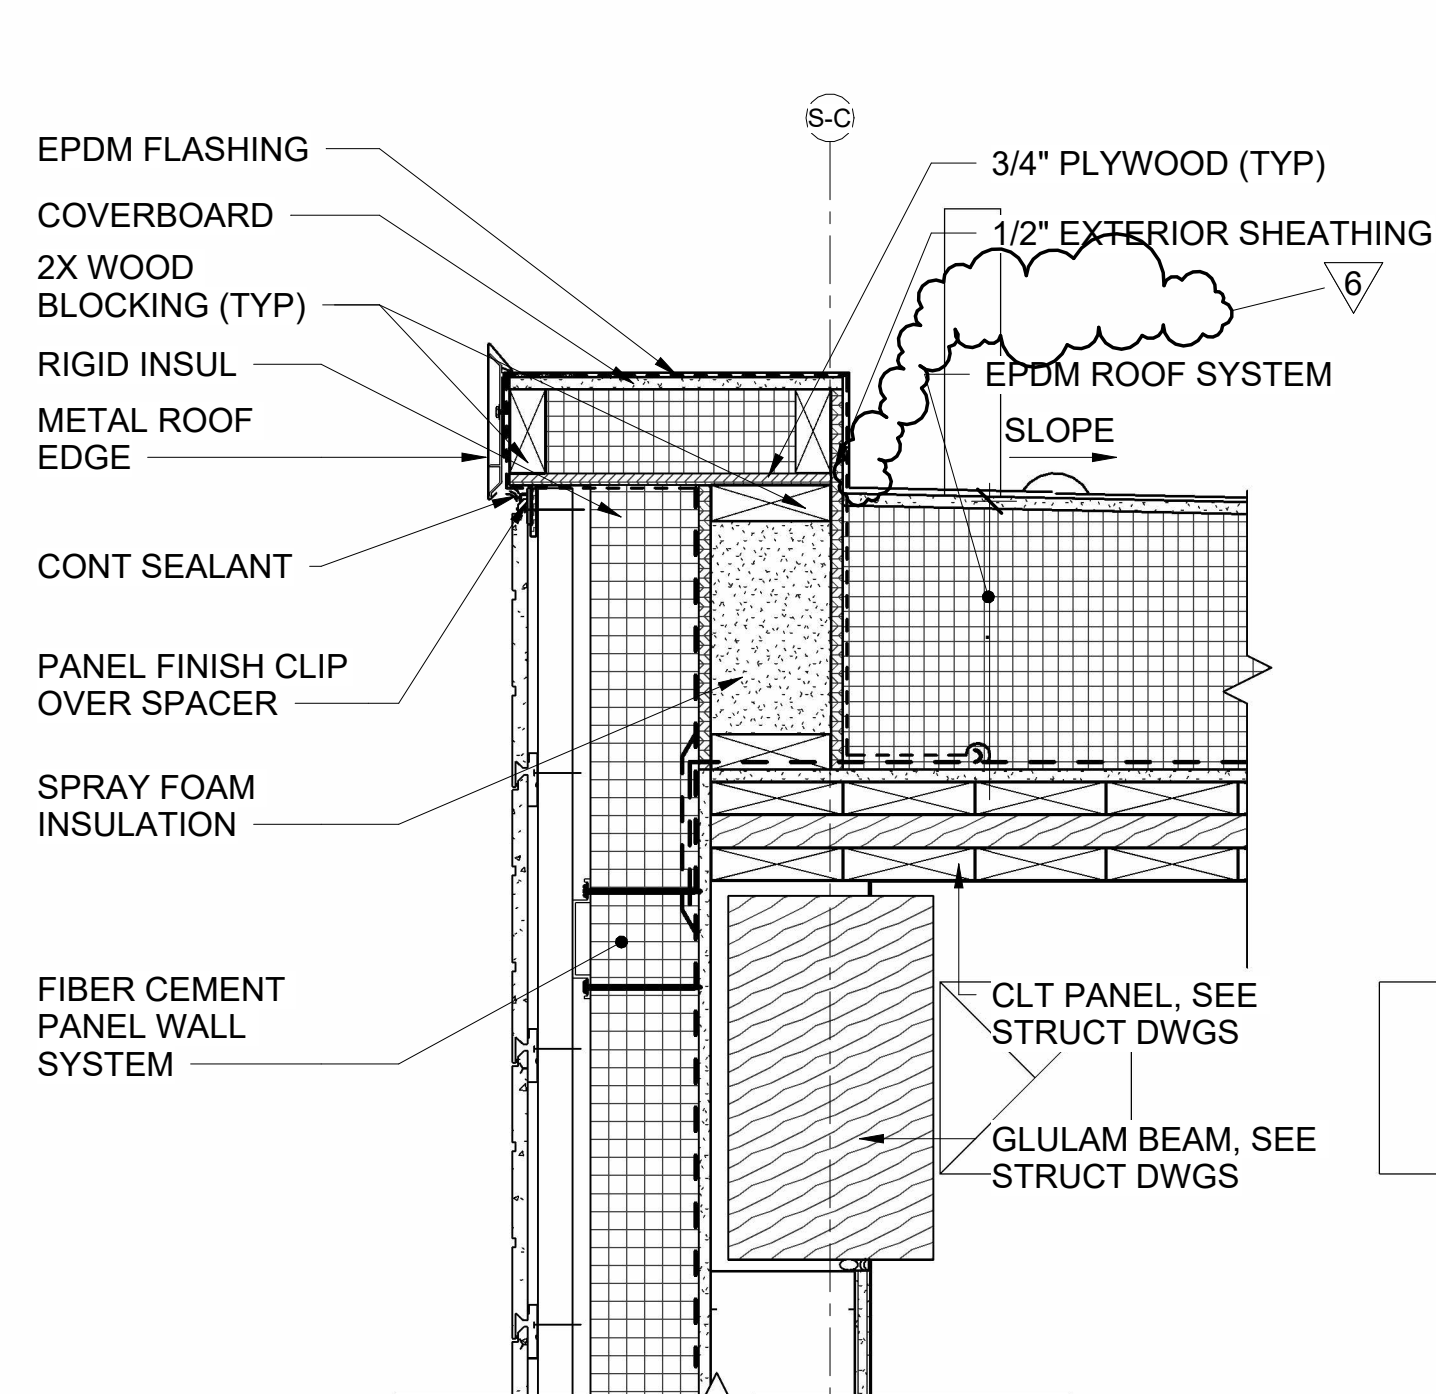


1 ROOF EDGE DETAIL @ FIBER CEMENT BOARD SIDING

AE104 AE502 SCALE: 1 1/2" = 1'-0"

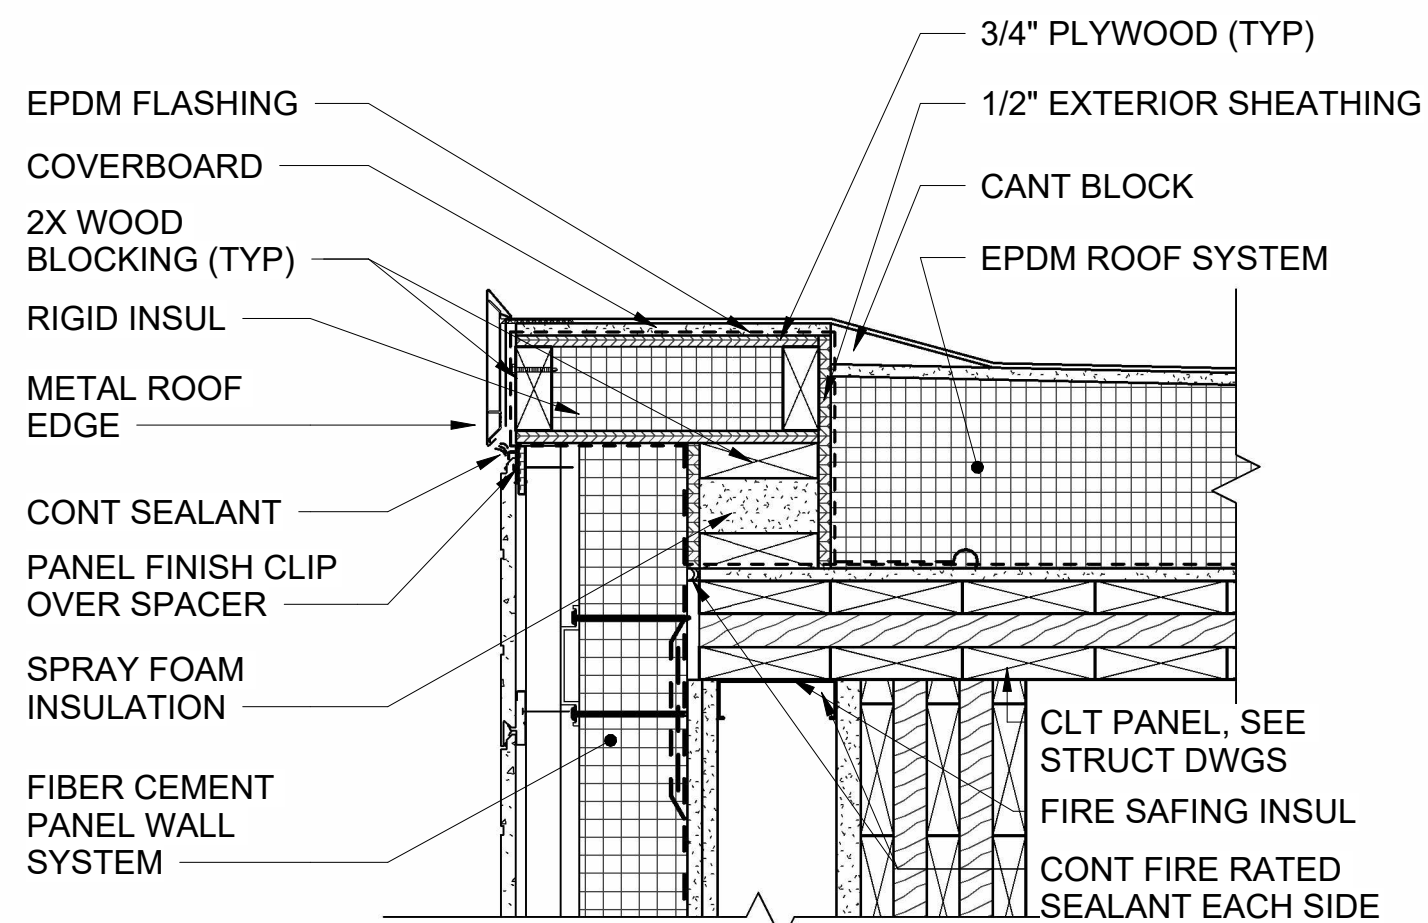


2 ROOF EDGE DETAIL @ FIBER CEMENT BOARD SIDING, 2 HR WALL

AE120 AE502 SCALE: 1 1/2" = 1'-0"

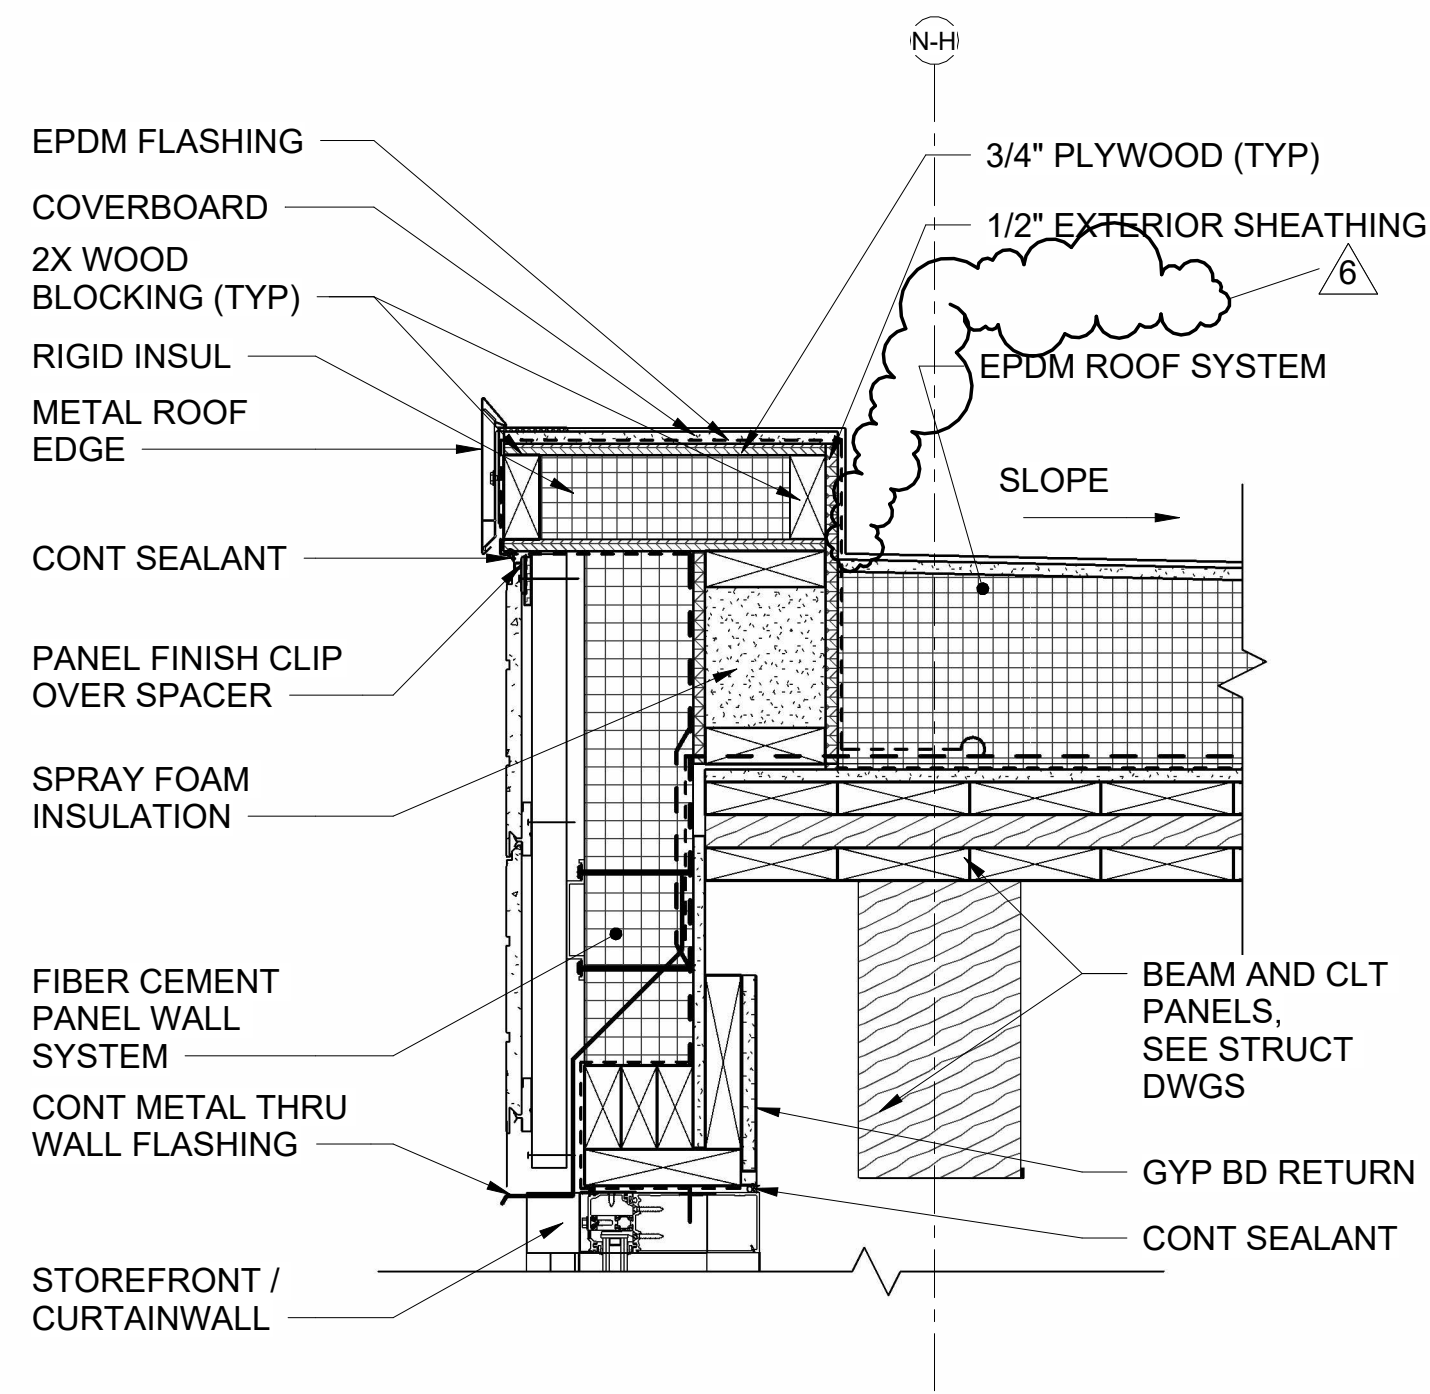


3 ROOF EDGE DETAIL @ CURTAINWALL

AE120 AE502 SCALE: 1 1/2" = 1'-0"

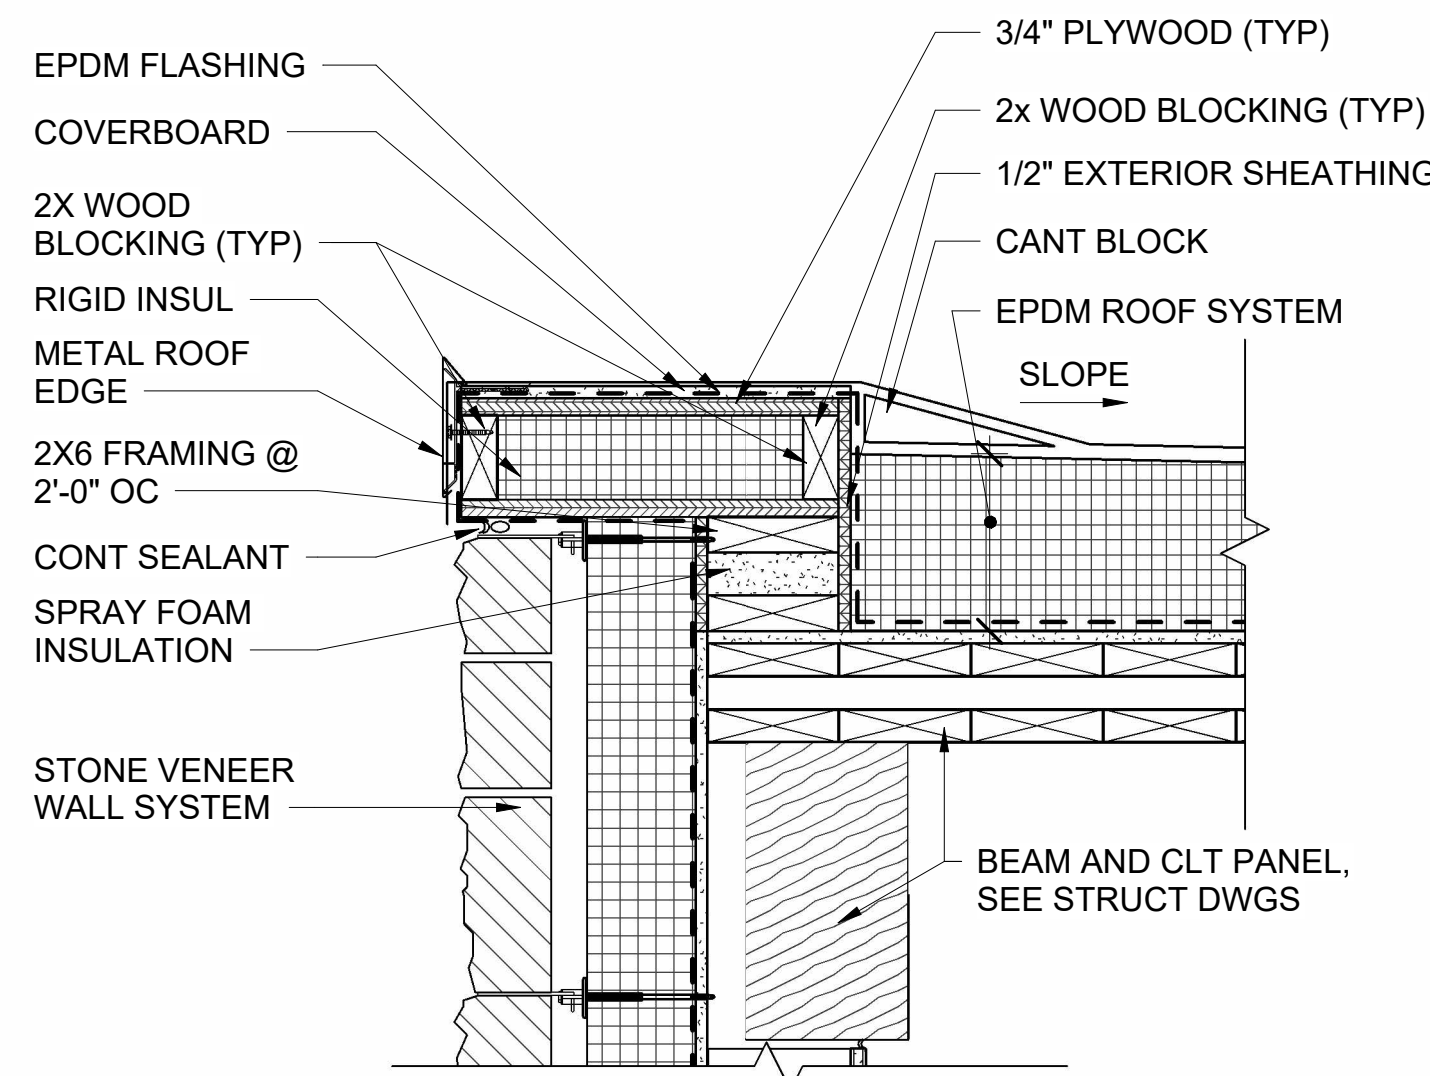


4 ROOF EDGE DETAIL @ STONE VENEER

AE120 AE502 SCALE: 1 1/2" = 1'-0"

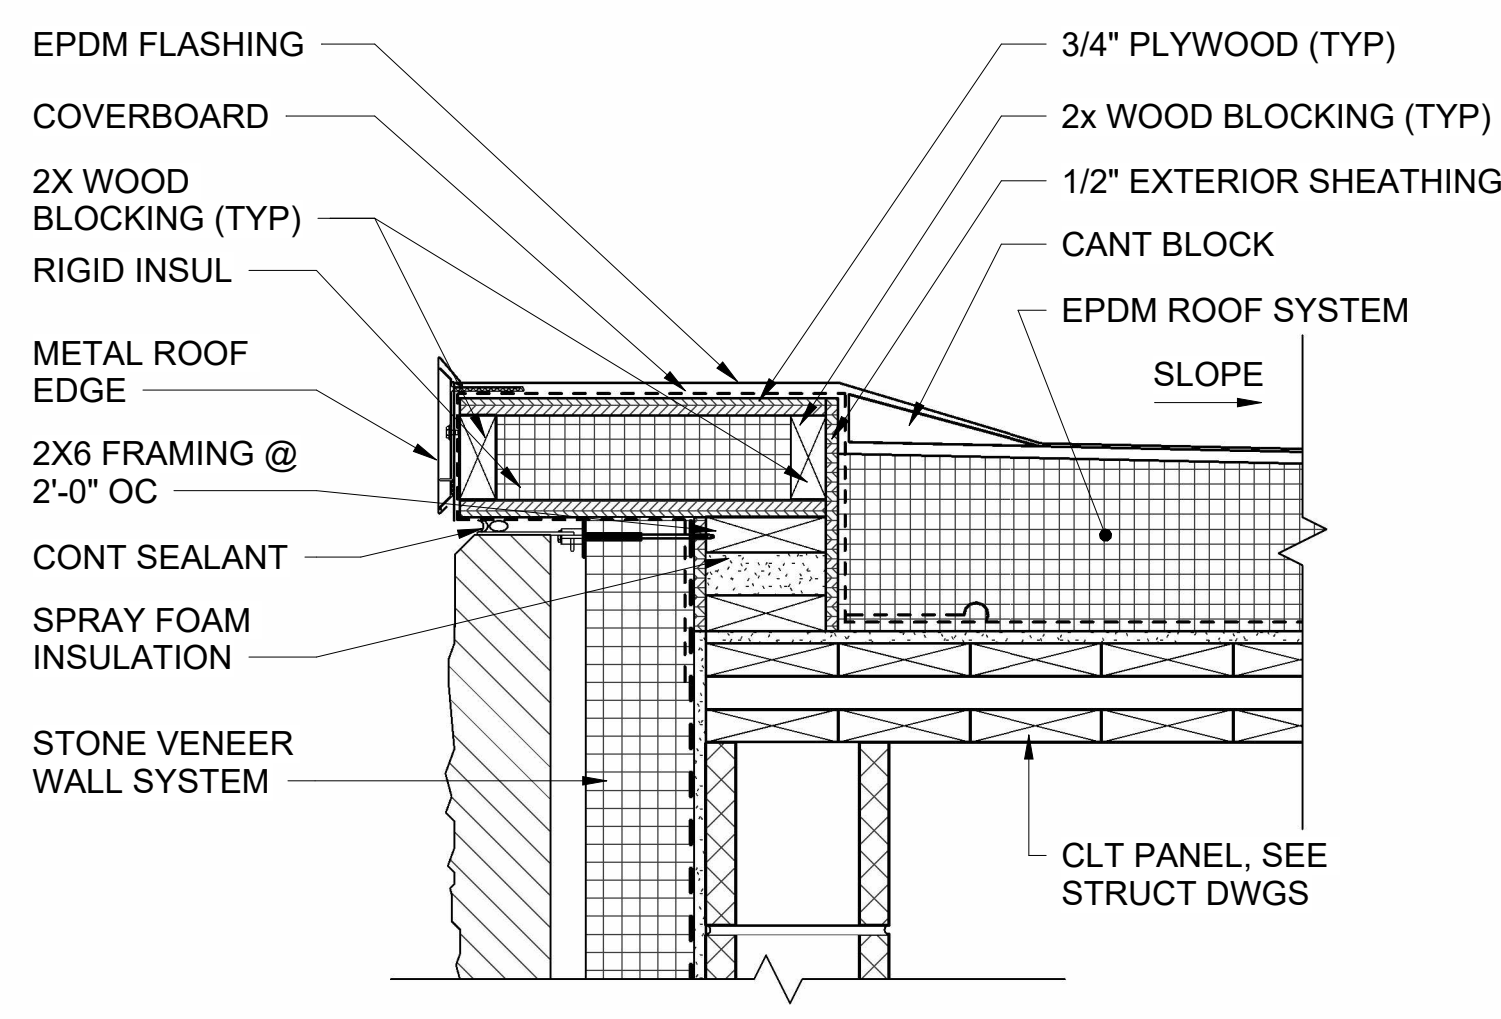


5 ROOF EDGE DETAIL @ STONE VENEER ON CMU WALL

AE120 AE502 SCALE: 1 1/2" = 1'-0"

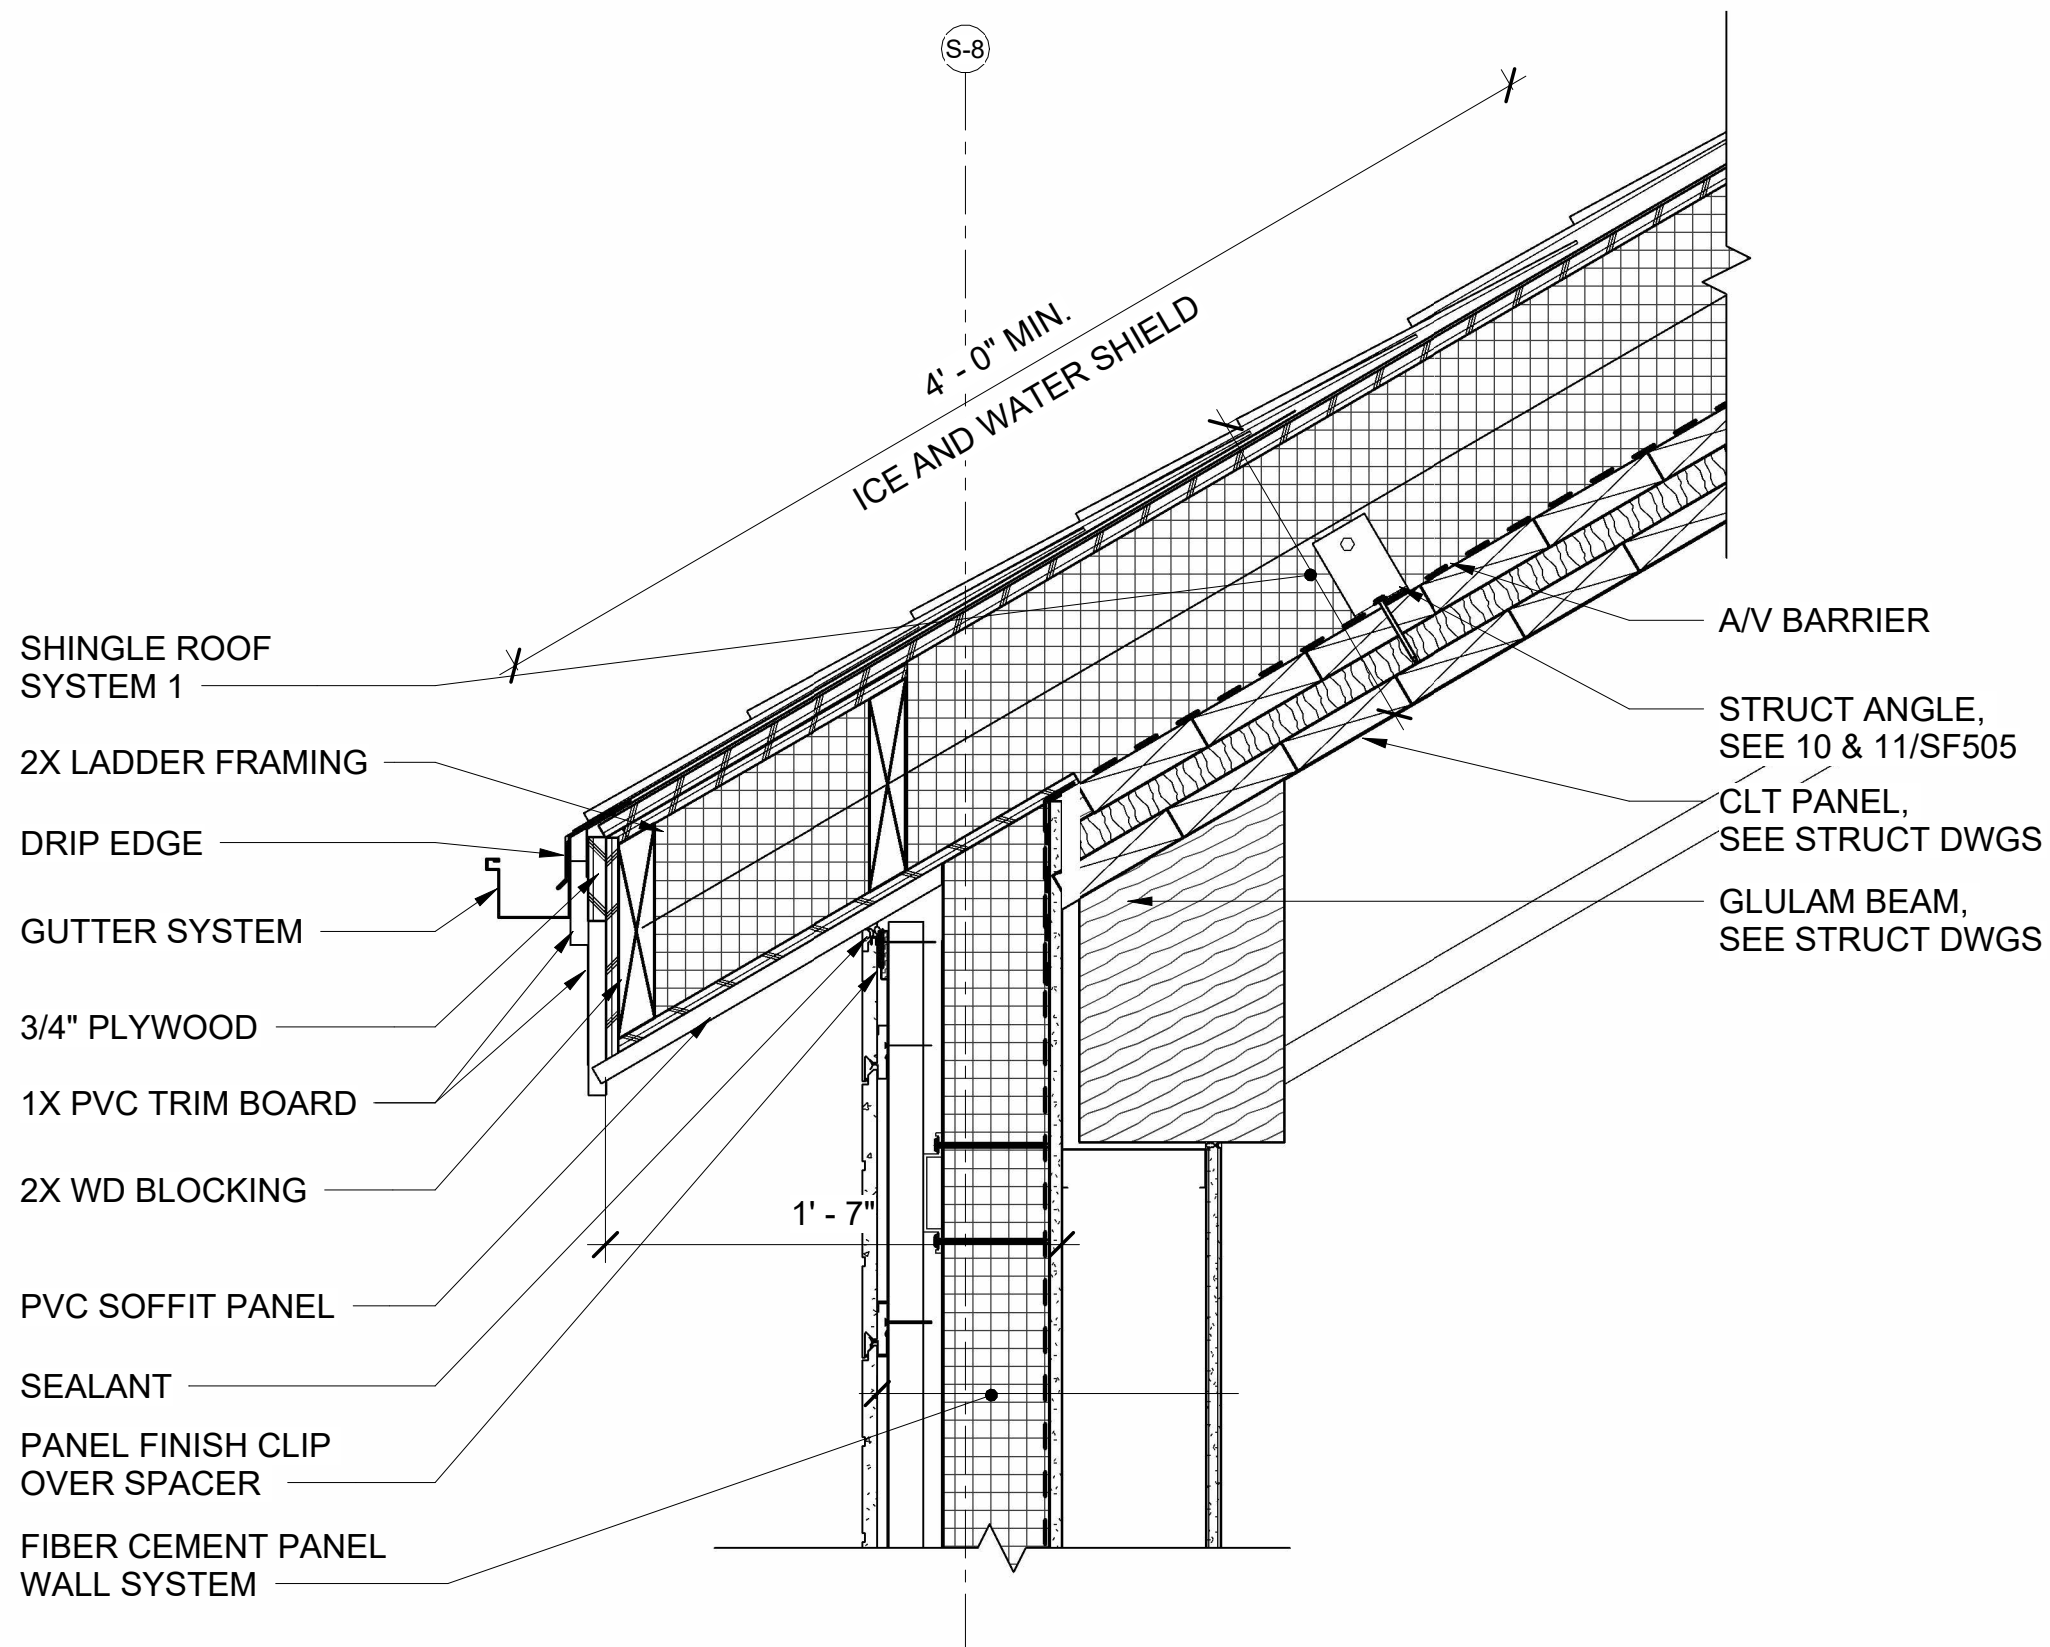


6 EAVE DETAIL @ FIBER CEMENT BOARD SIDING

AE120 AE502 SCALE: 1 1/2" = 1'-0"

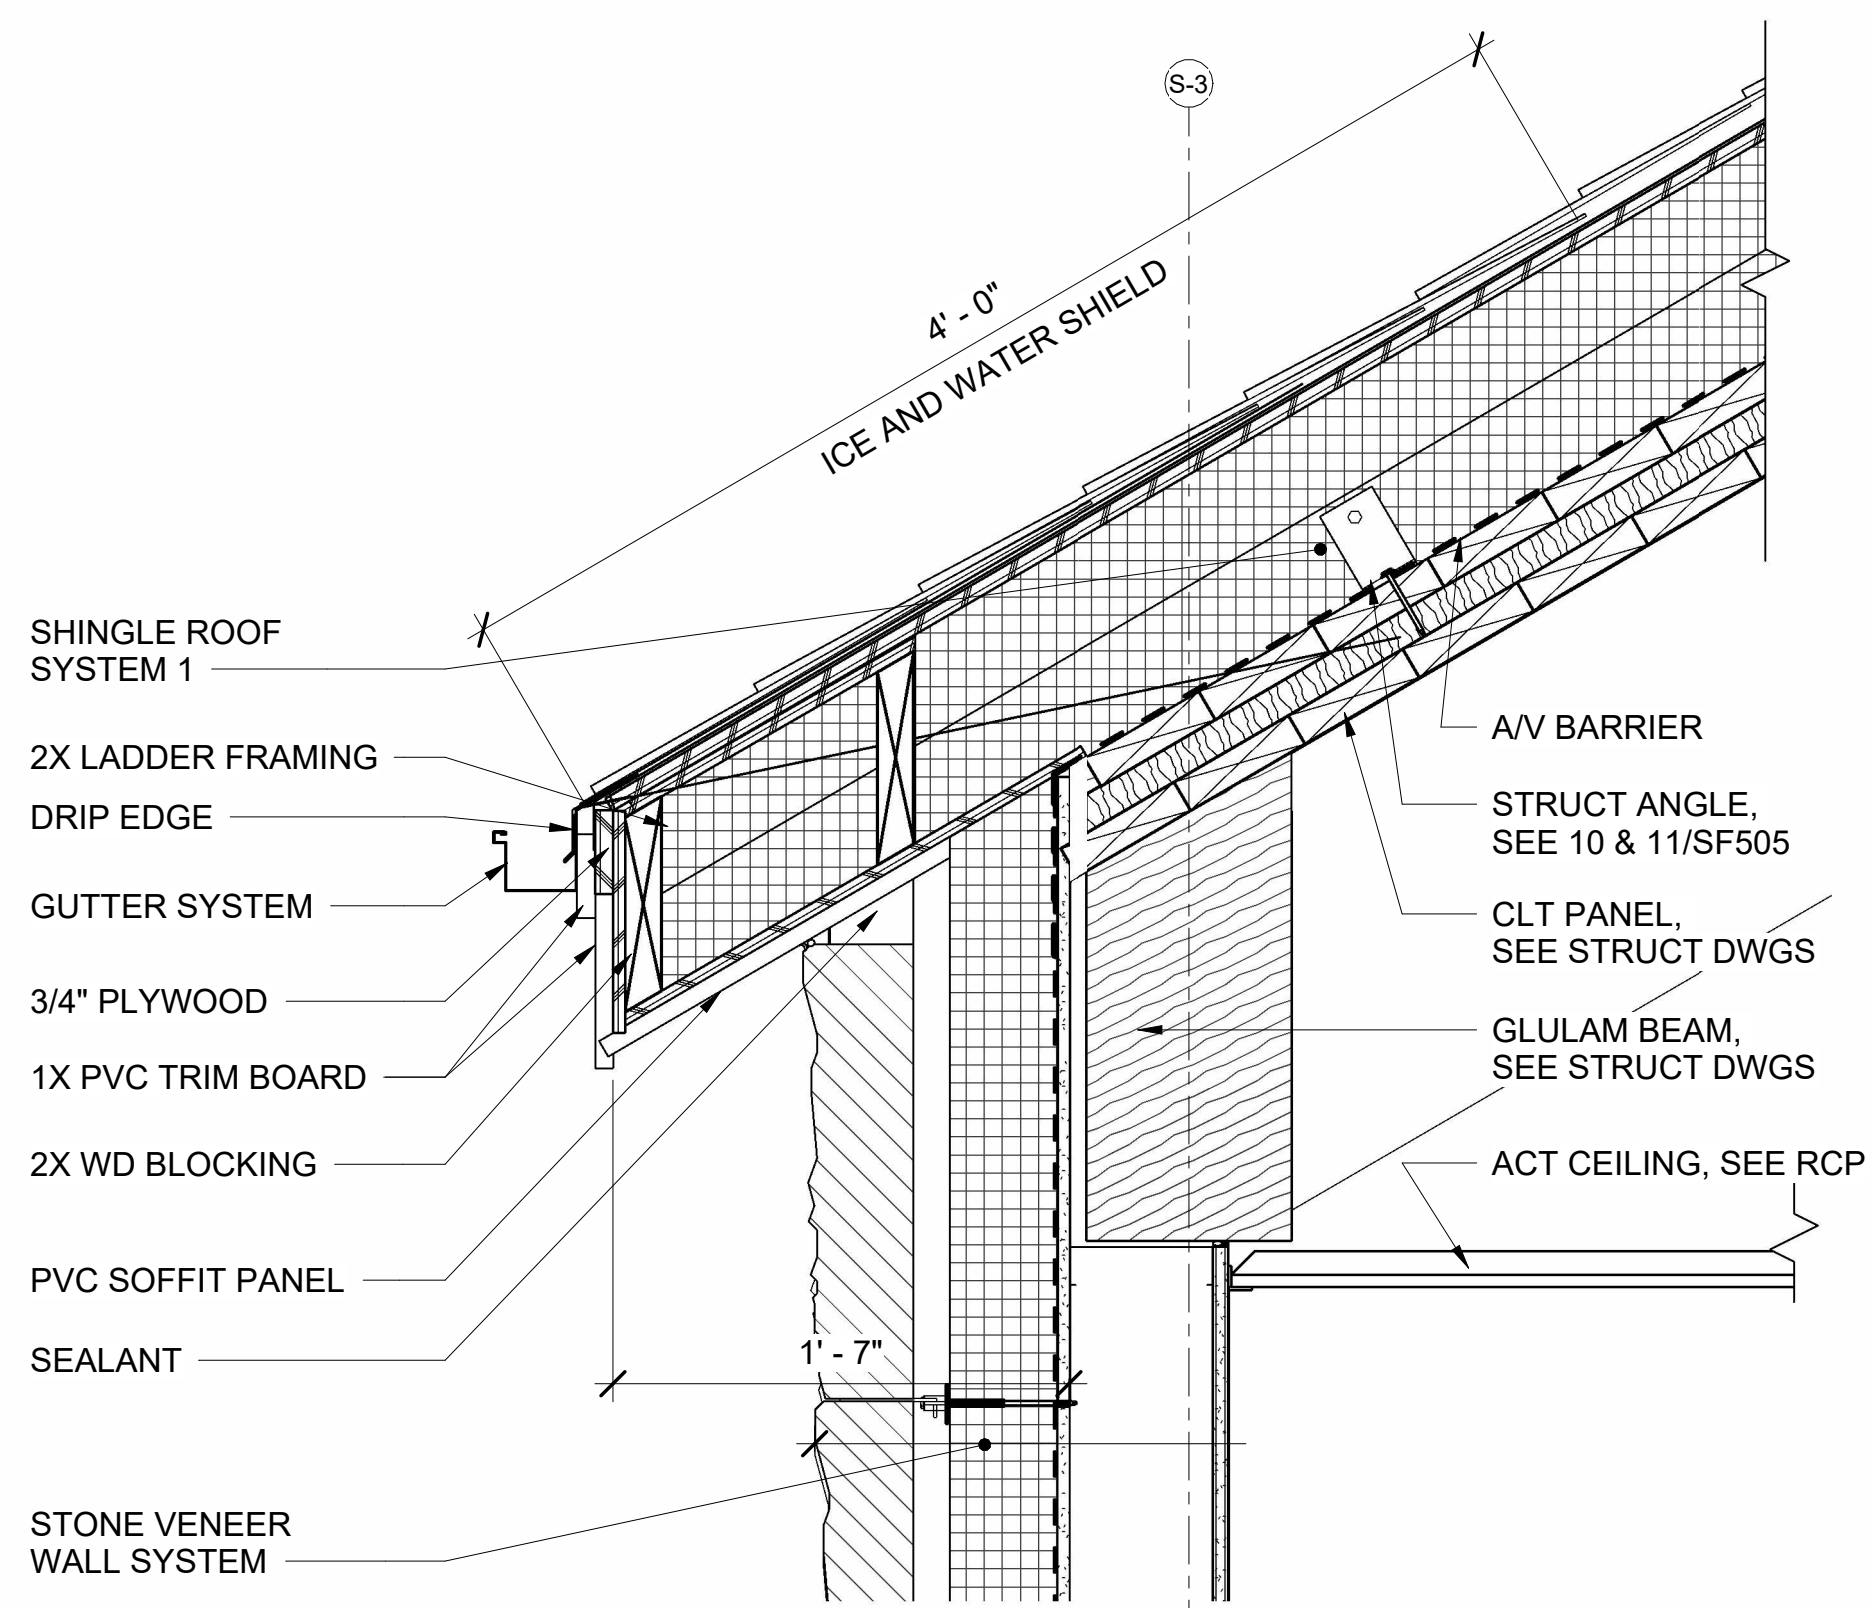


7 EAVE DETAIL @ STONE VENEER

AE120 AE502 SCALE: 1 1/2" = 1'-0"

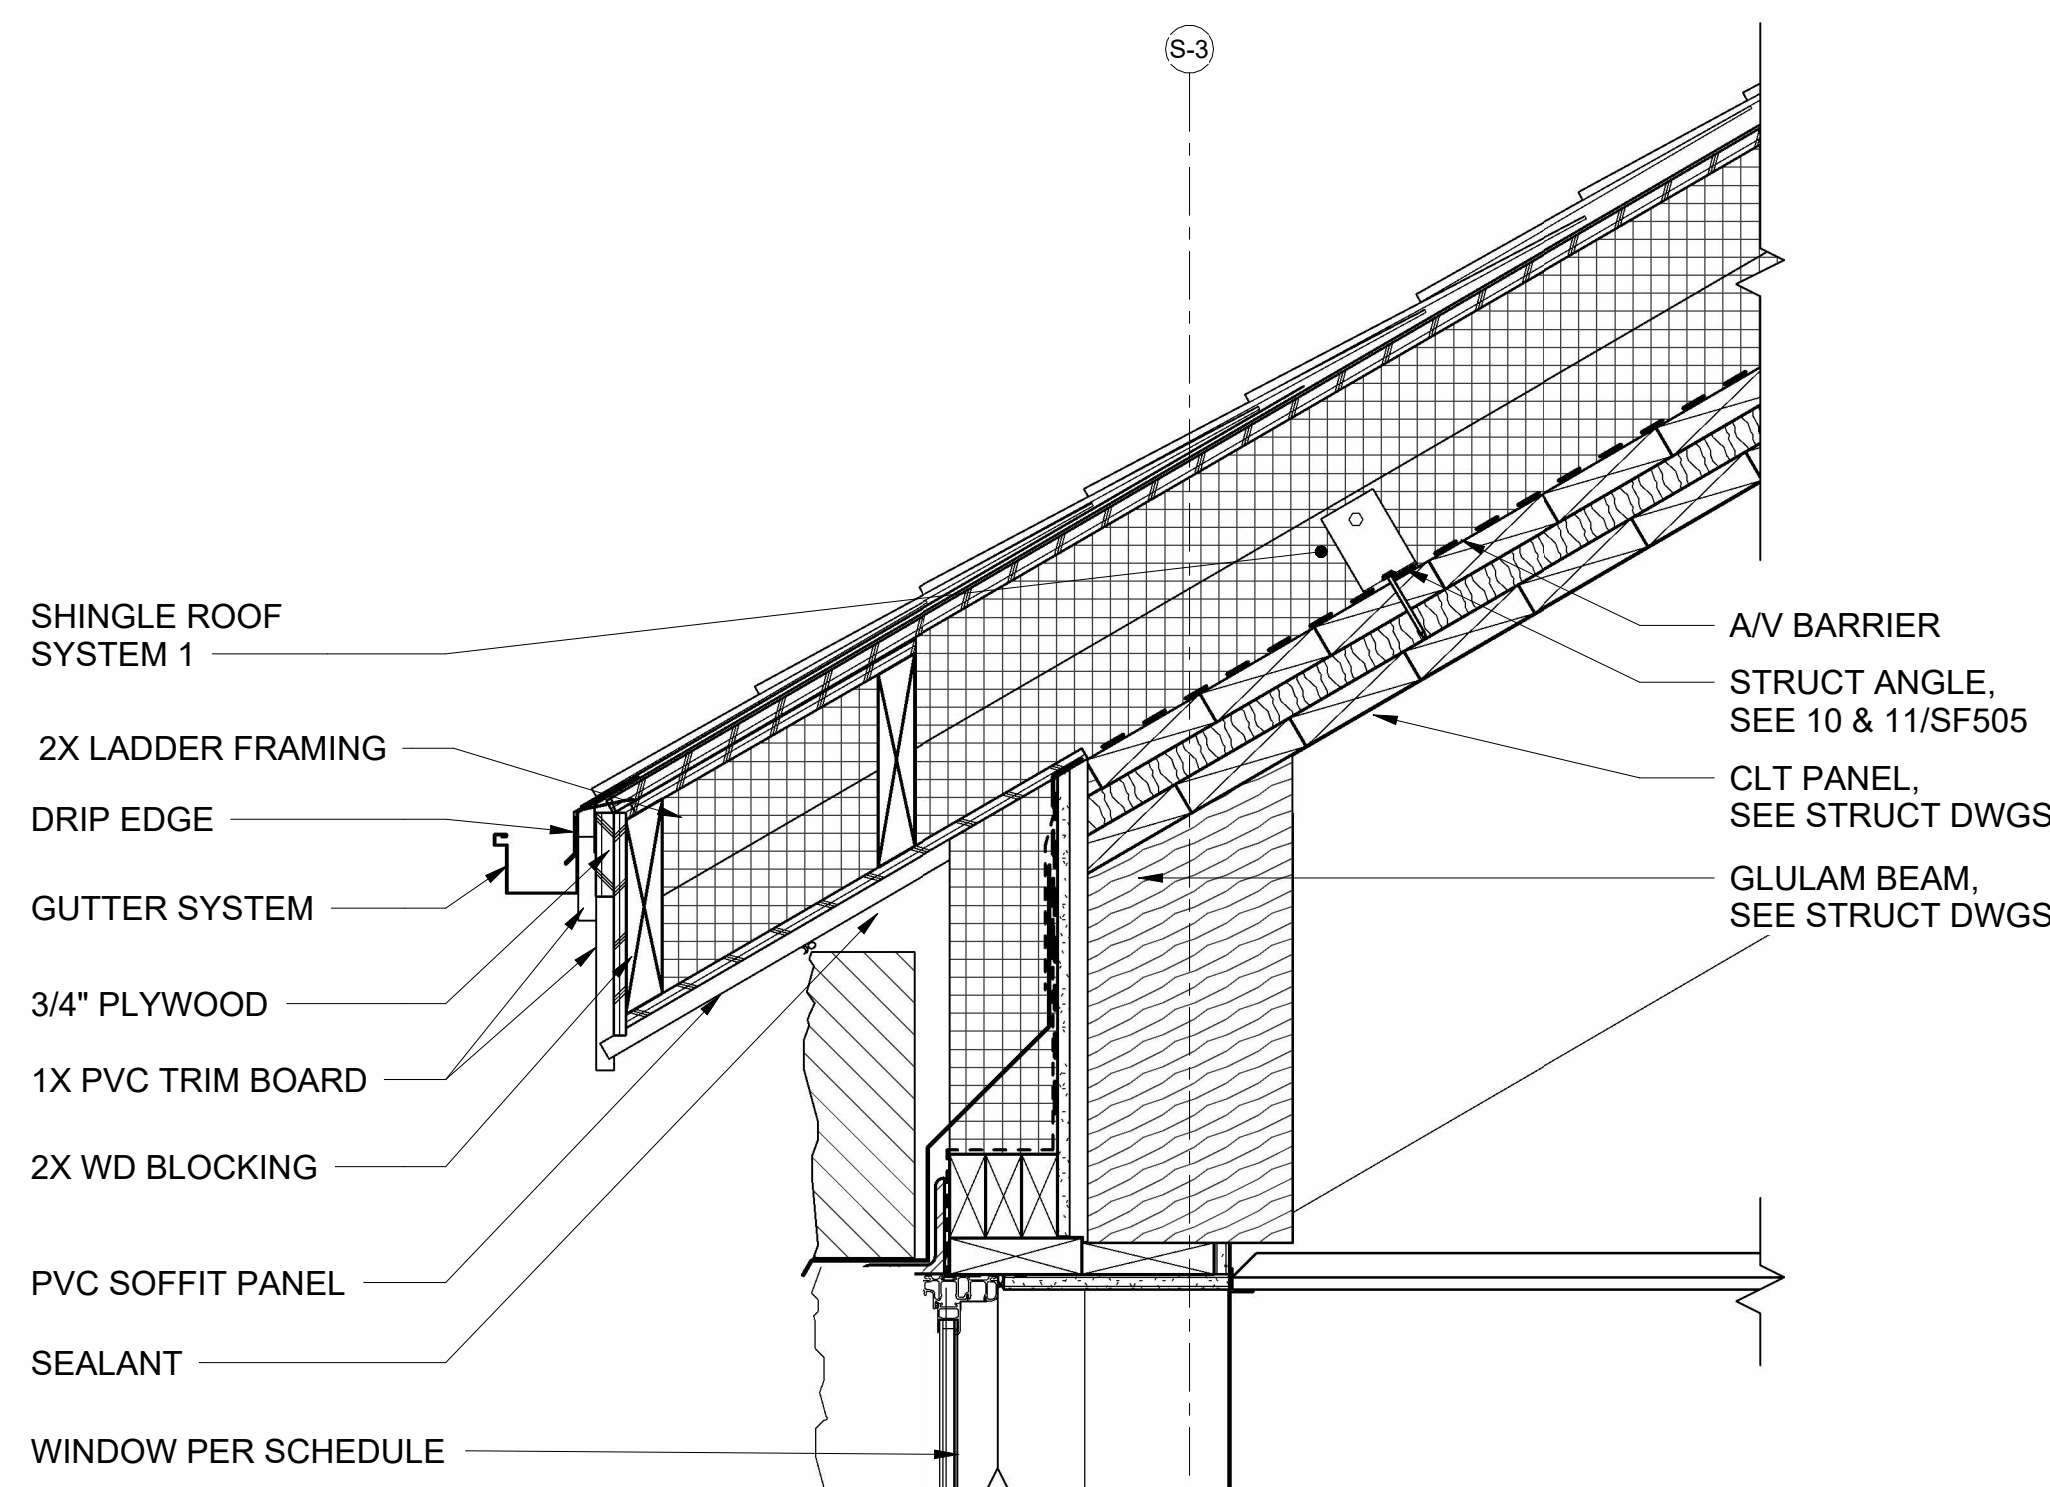


8 EAVE DETAIL @ STONE VENEER @ WINDOW

AE120 AE502 SCALE: 1 1/2" = 1'-0"

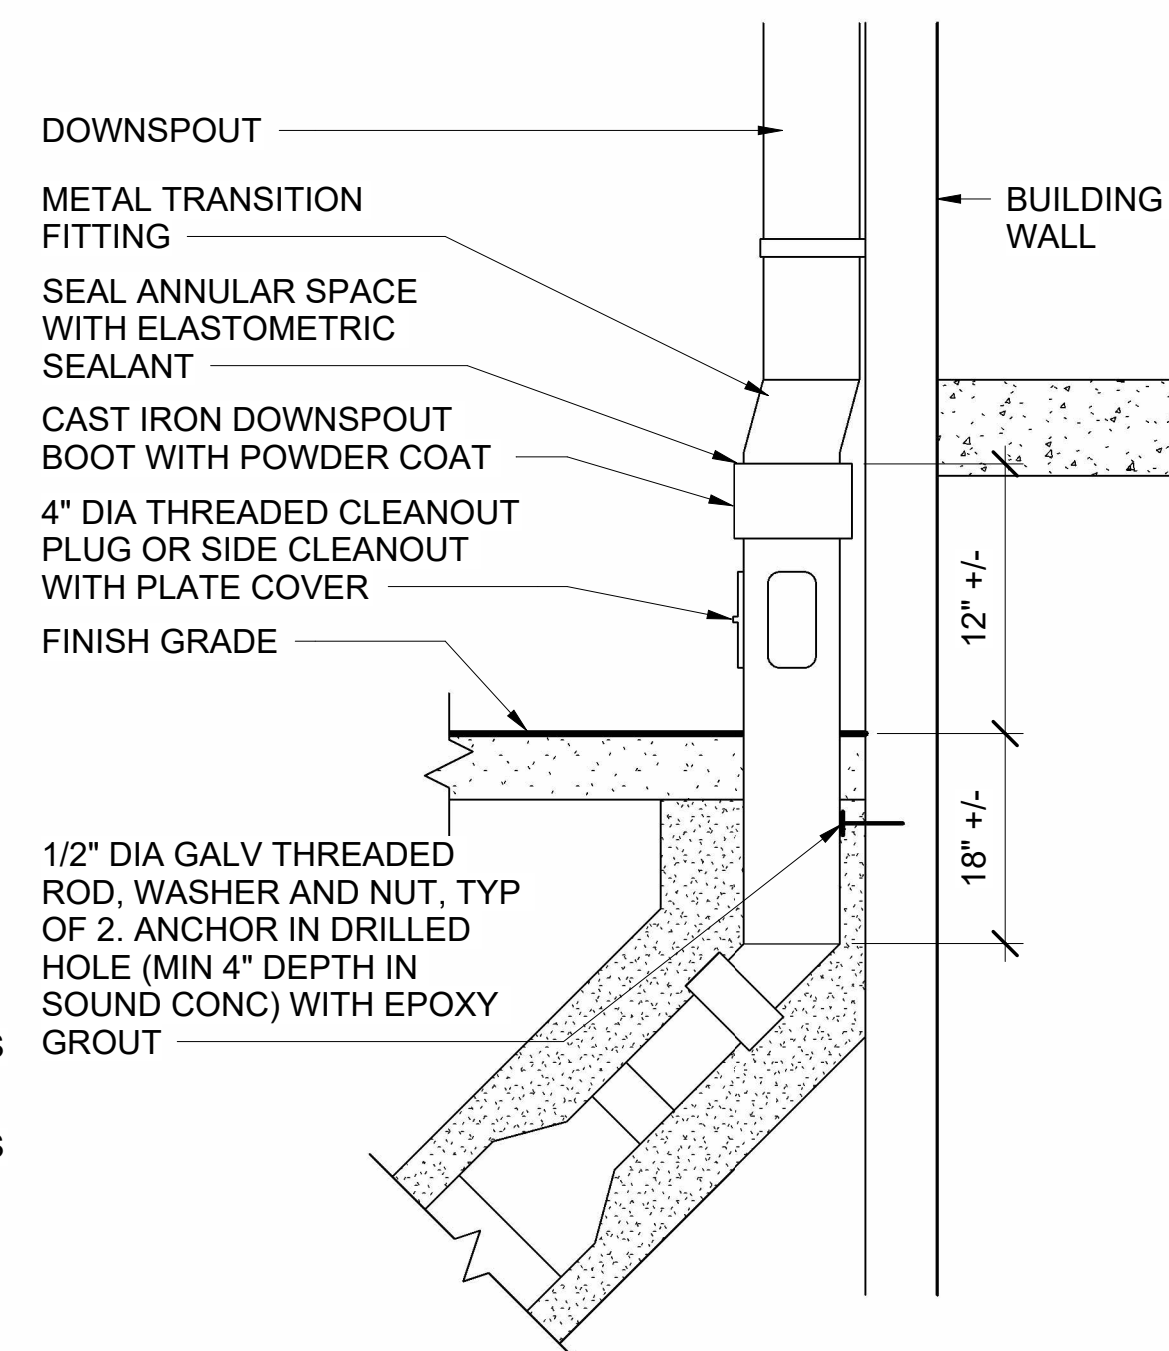


13 DOWNSPOUT BOOT

AE502 SCALE: 1 1/2" = 1'-0"

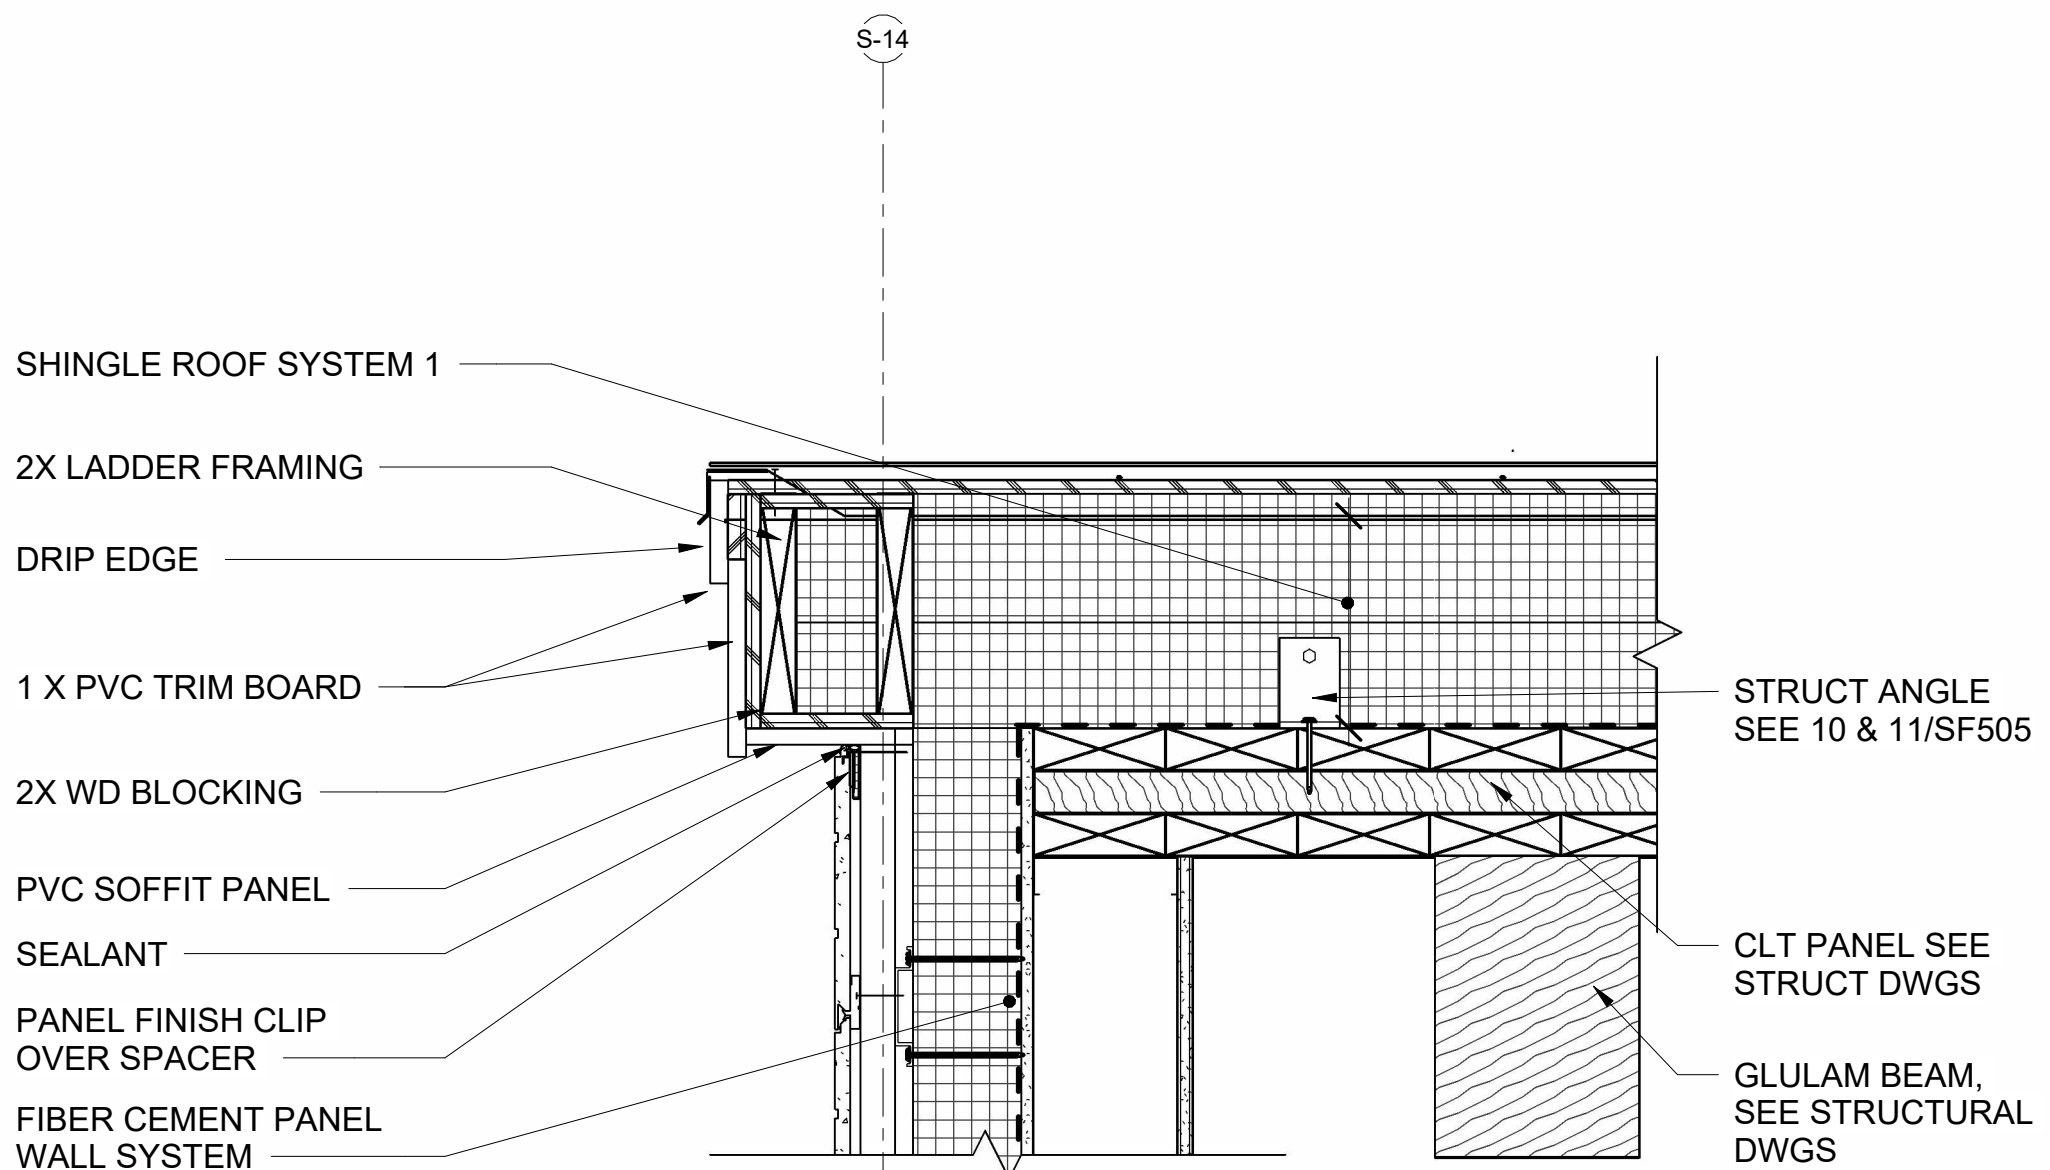


9 RAKE DETAIL @ FIBER CEMENT BOARD SIDING

AE120 AE502 SCALE: 1 1/2" = 1'-0"

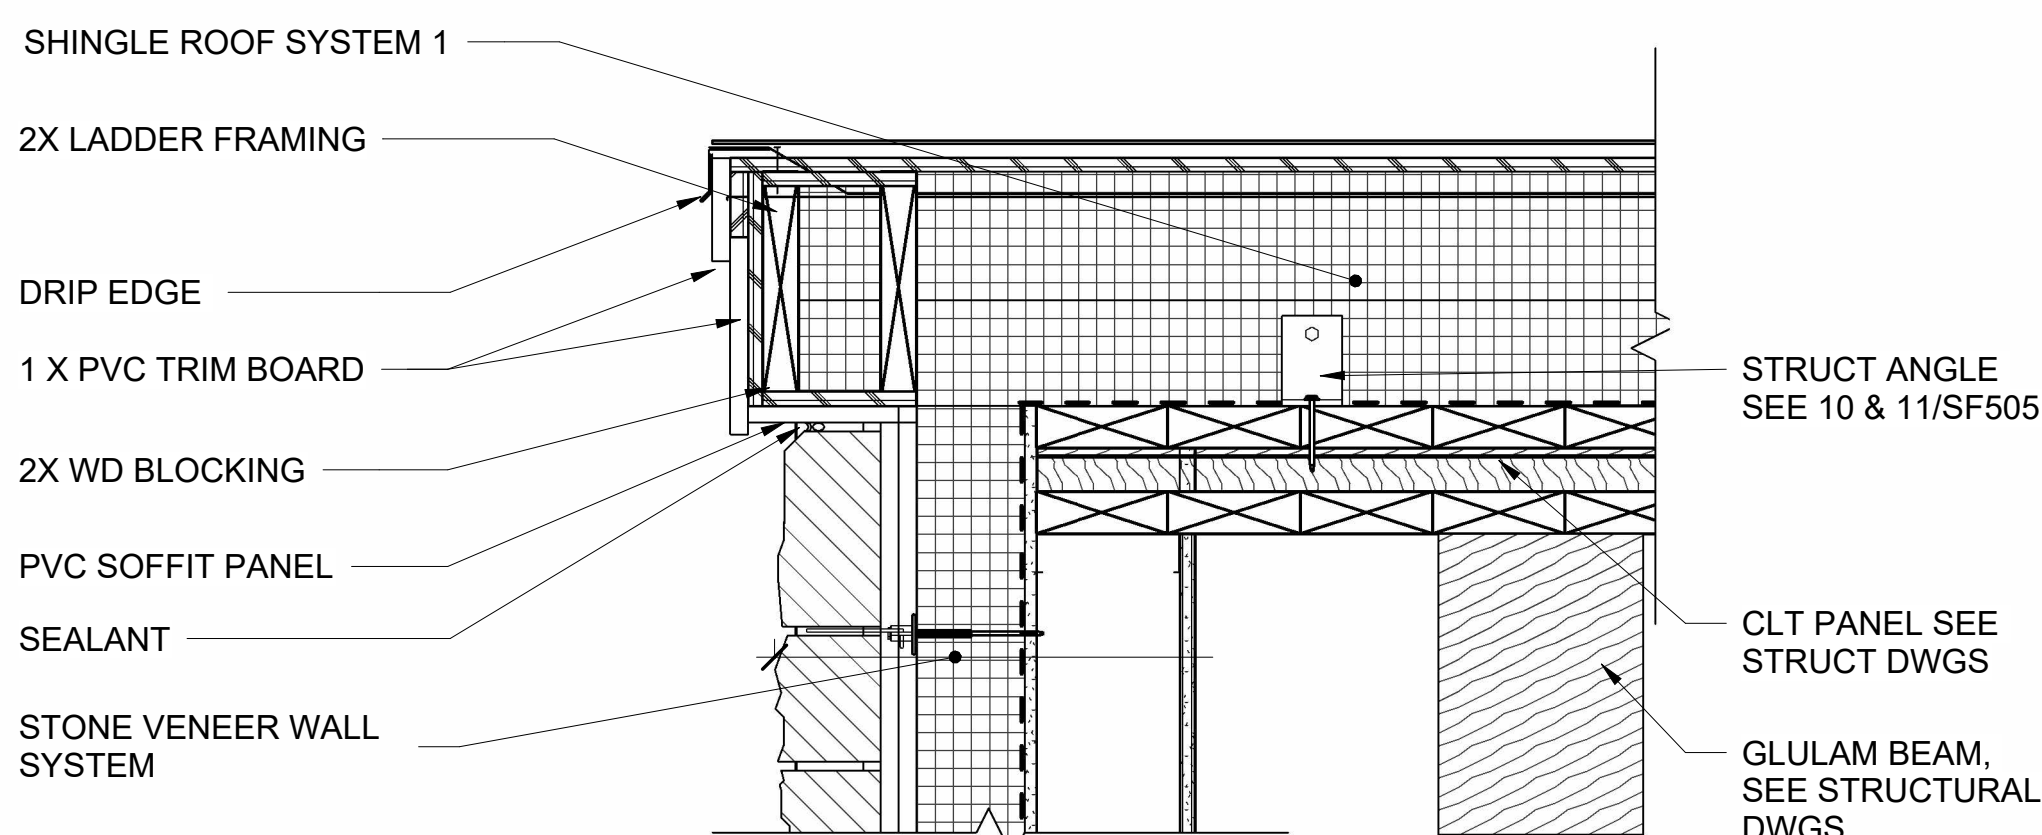


10 RAKE DETAIL @ STONE VENEER

AE120 AE502 SCALE: 1 1/2" = 1'-0"

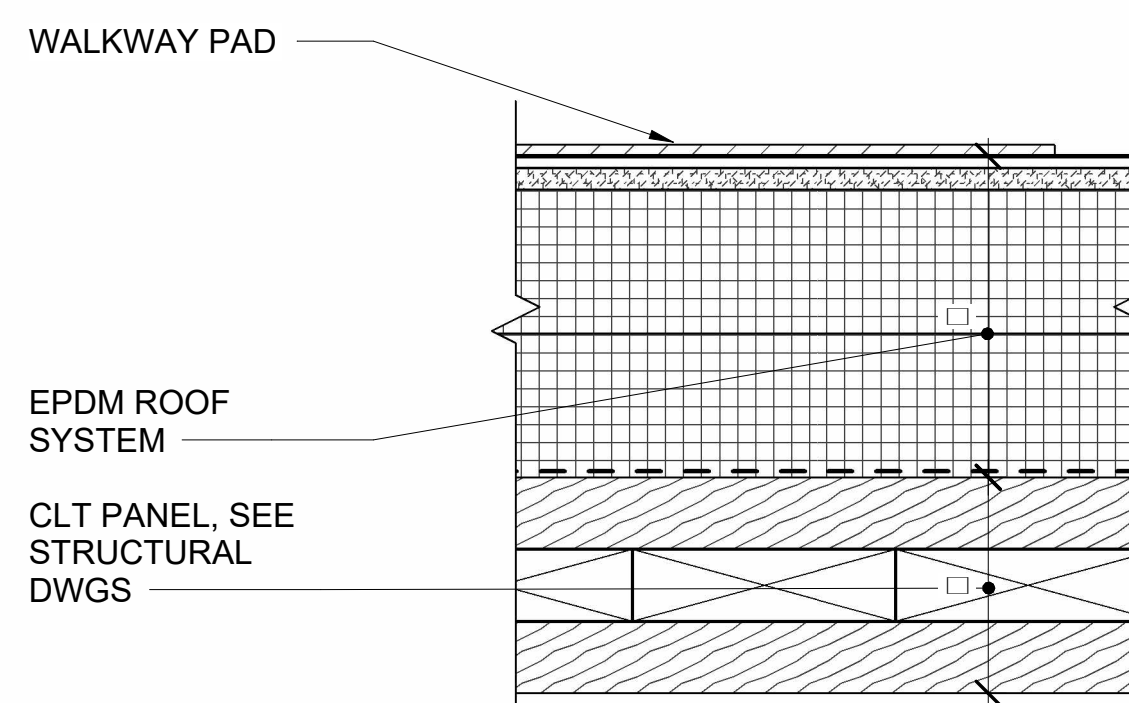

11 WALKWAY PAD DETAIL (TYP)

AE502 SCALE: 3" = 1'-0"

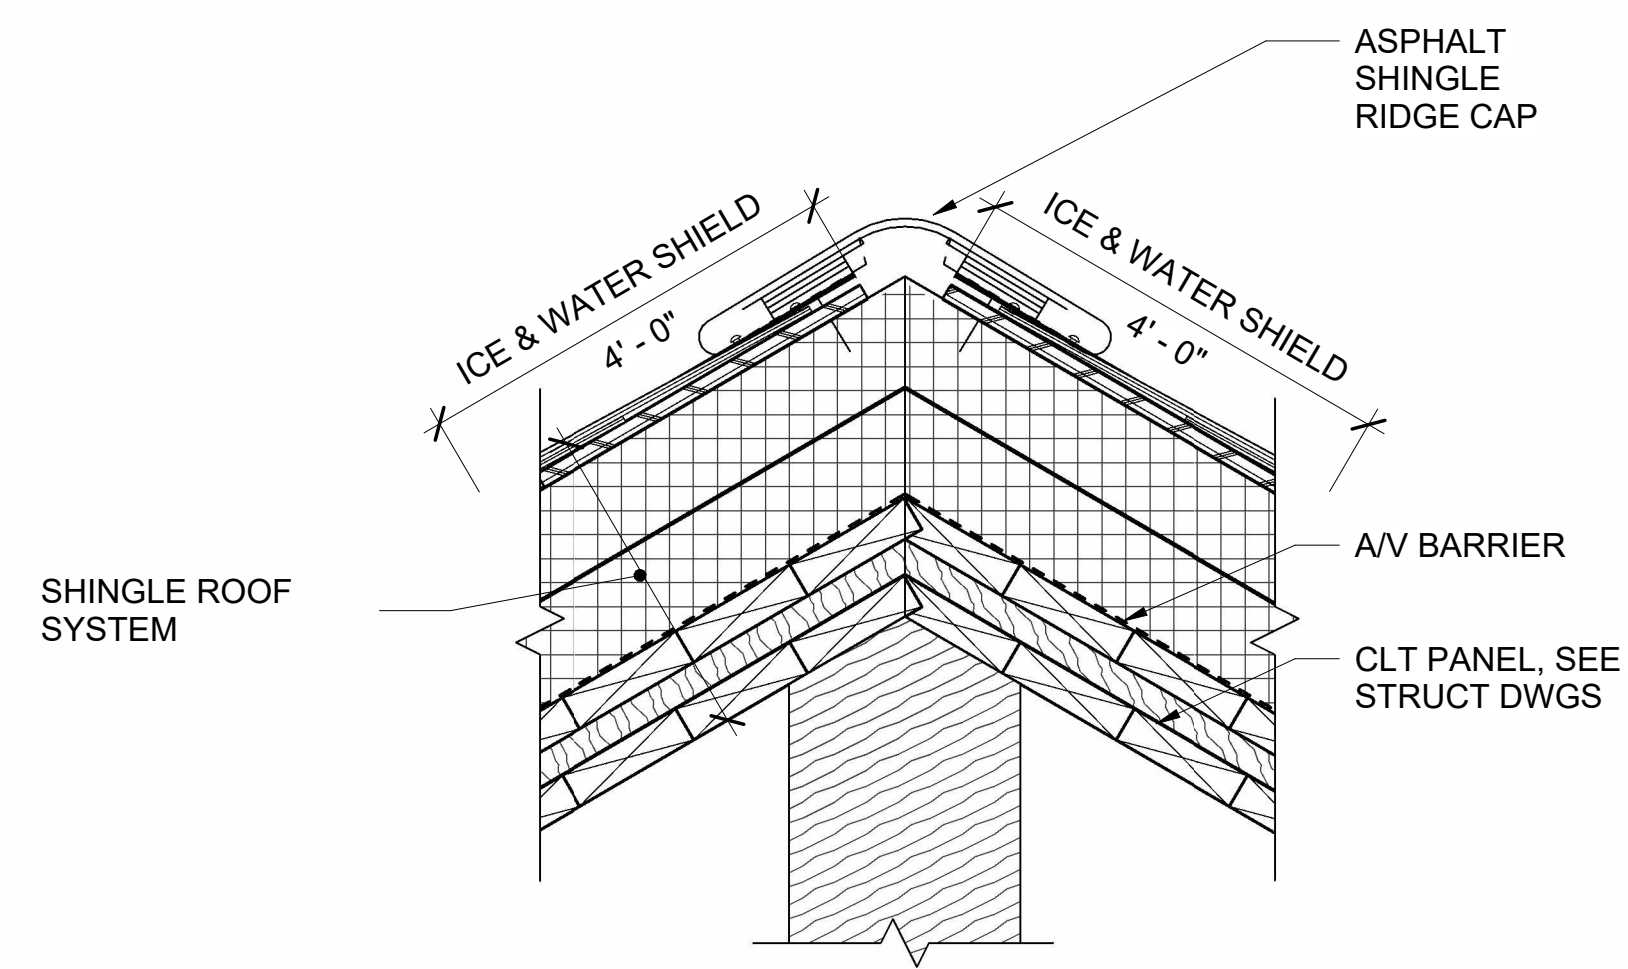


12 RIDGE CAP DETAIL

AE120 AE502 SCALE: 1 1/2" = 1'-0"




CHECK GRAPHIC SCALE BEFORE USING


				DEPARTMENT OF INLAND FISHERIES & WILDLIFE			
TITLE: NEW OFFICE HEADQUARTERS				DRAWING NO. AE502			
LOCATION: AUGUSTA, ME				SHEET NO. 131 OF 239			
TITLE THIS DWG: ROOF DETAILS 2				DATE: 01/29/2025			
NO.	DATE	DESCRIPTION	BY	NO.	DATE	DESCRIPTION	BY
6	03/13/2025	ADDENDUM NO.6	HMG	DRAWN BY:	MJD		
3	02/27/2025	ADDENDUM NO.3	HMG	CHECK BY:	CET		
1	02/13/2025	ADDENDUM NO.1	HMG				

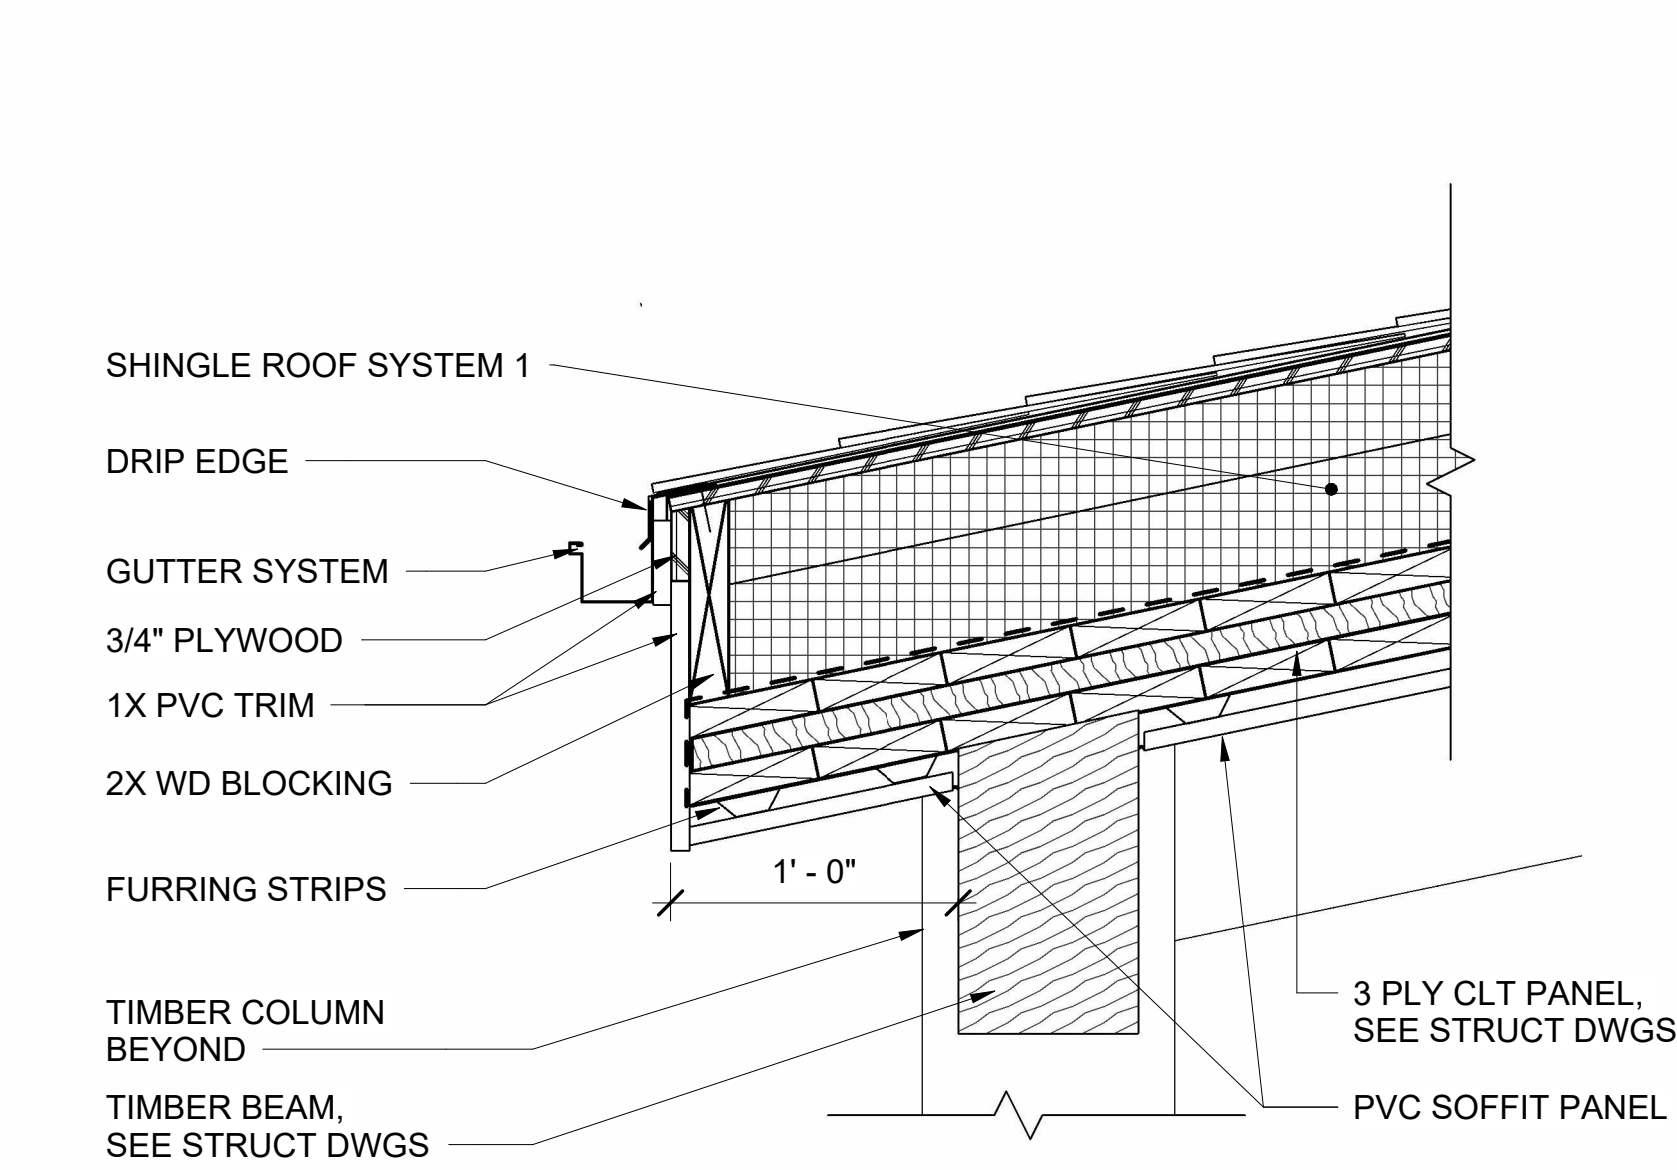


1 EAVE DETAIL @ ROOF OVERHANG, BETWEEN COLUMNS
AE120 AE503 SCALE: 1 1/2" = 1'-0"

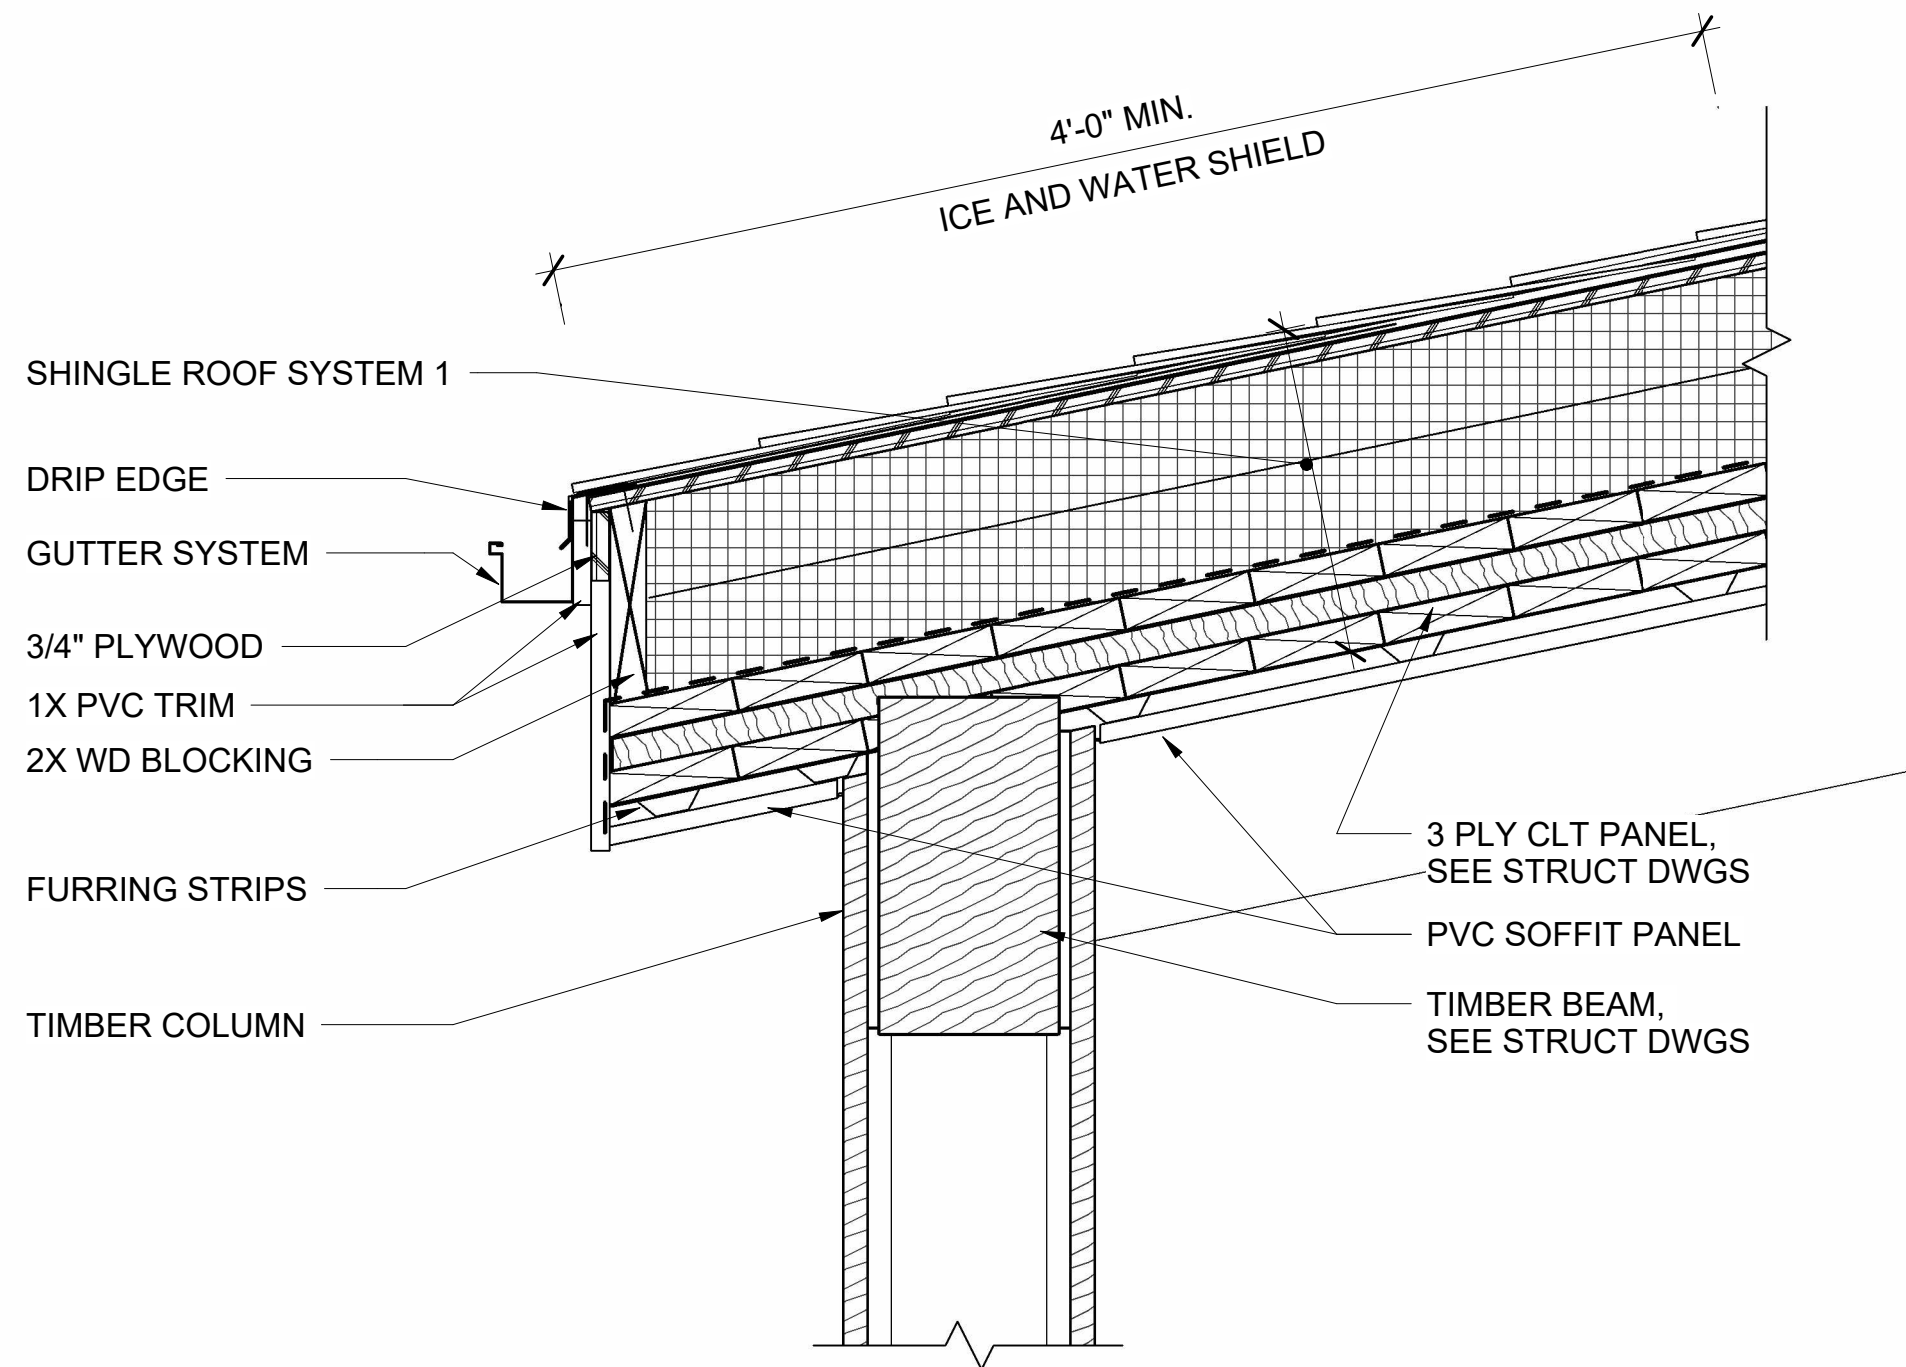


2 EAVE DETAIL @ ROOF OVERHANG
AE120 AE503 SCALE: 1 1/2" = 1'-0"

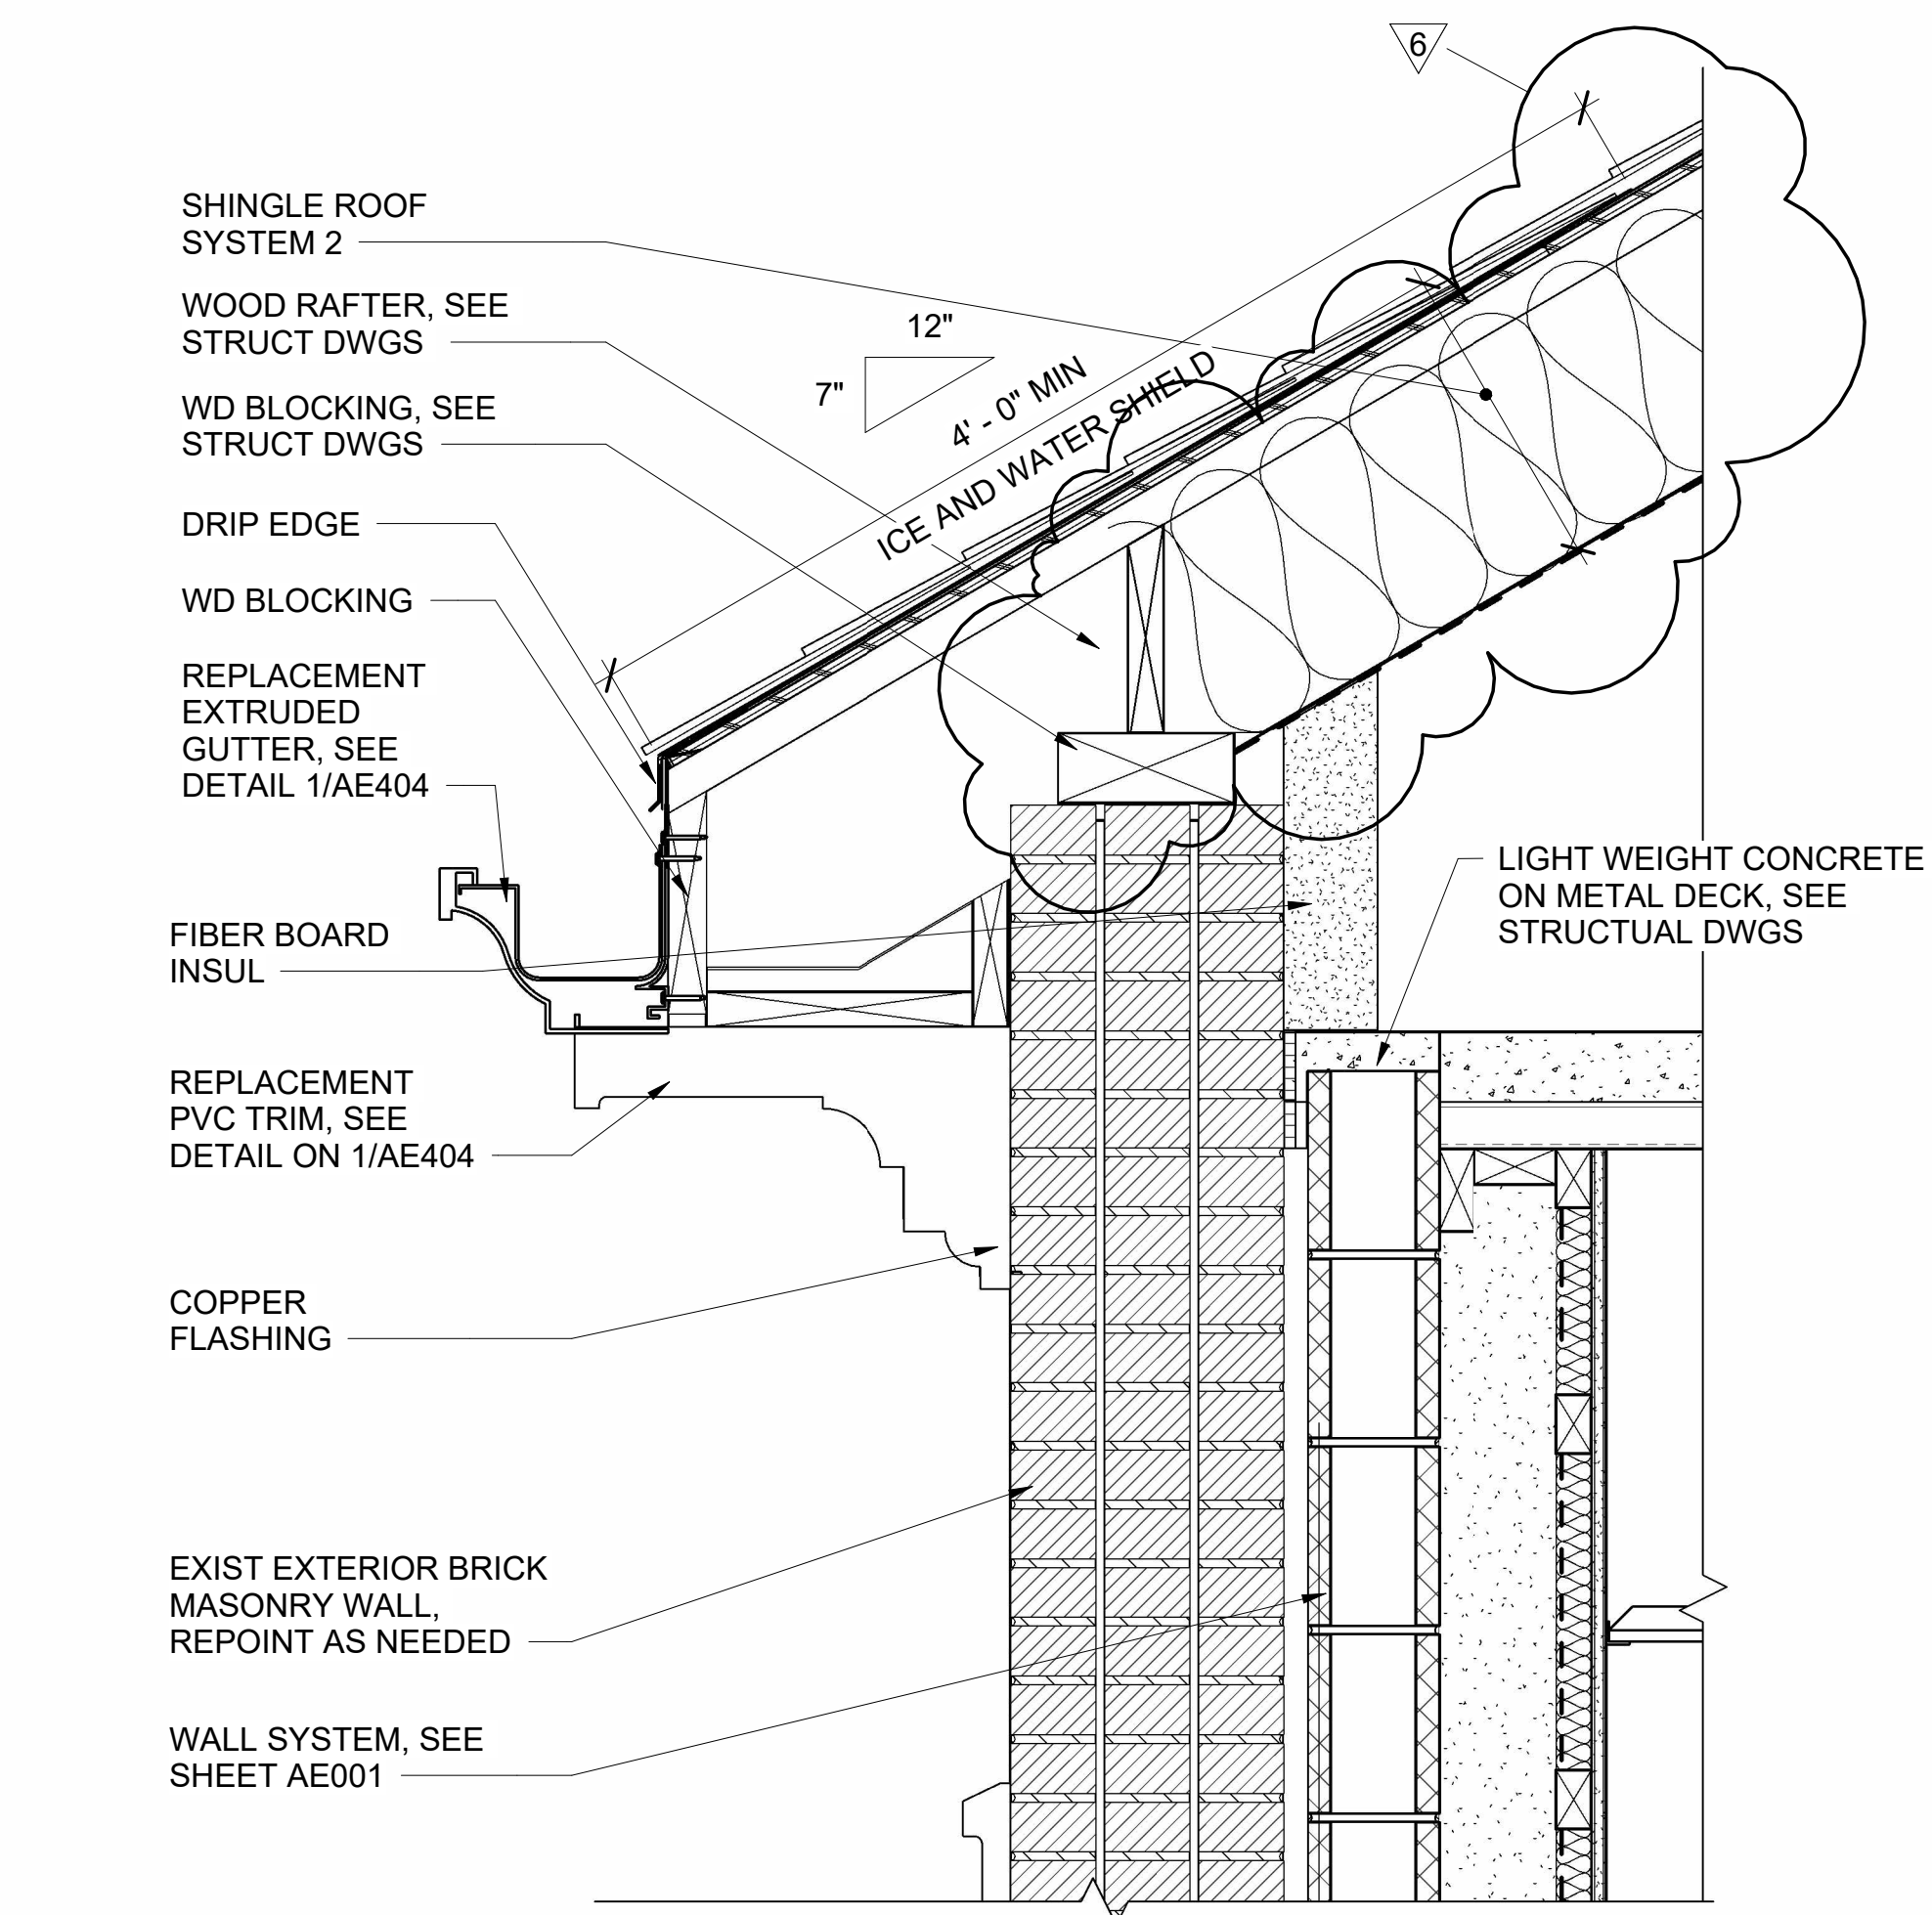


5 EAVE DETAIL @ SHINGE ROOF
AE120 AE503 SCALE: 1 1/2" = 1'-0"

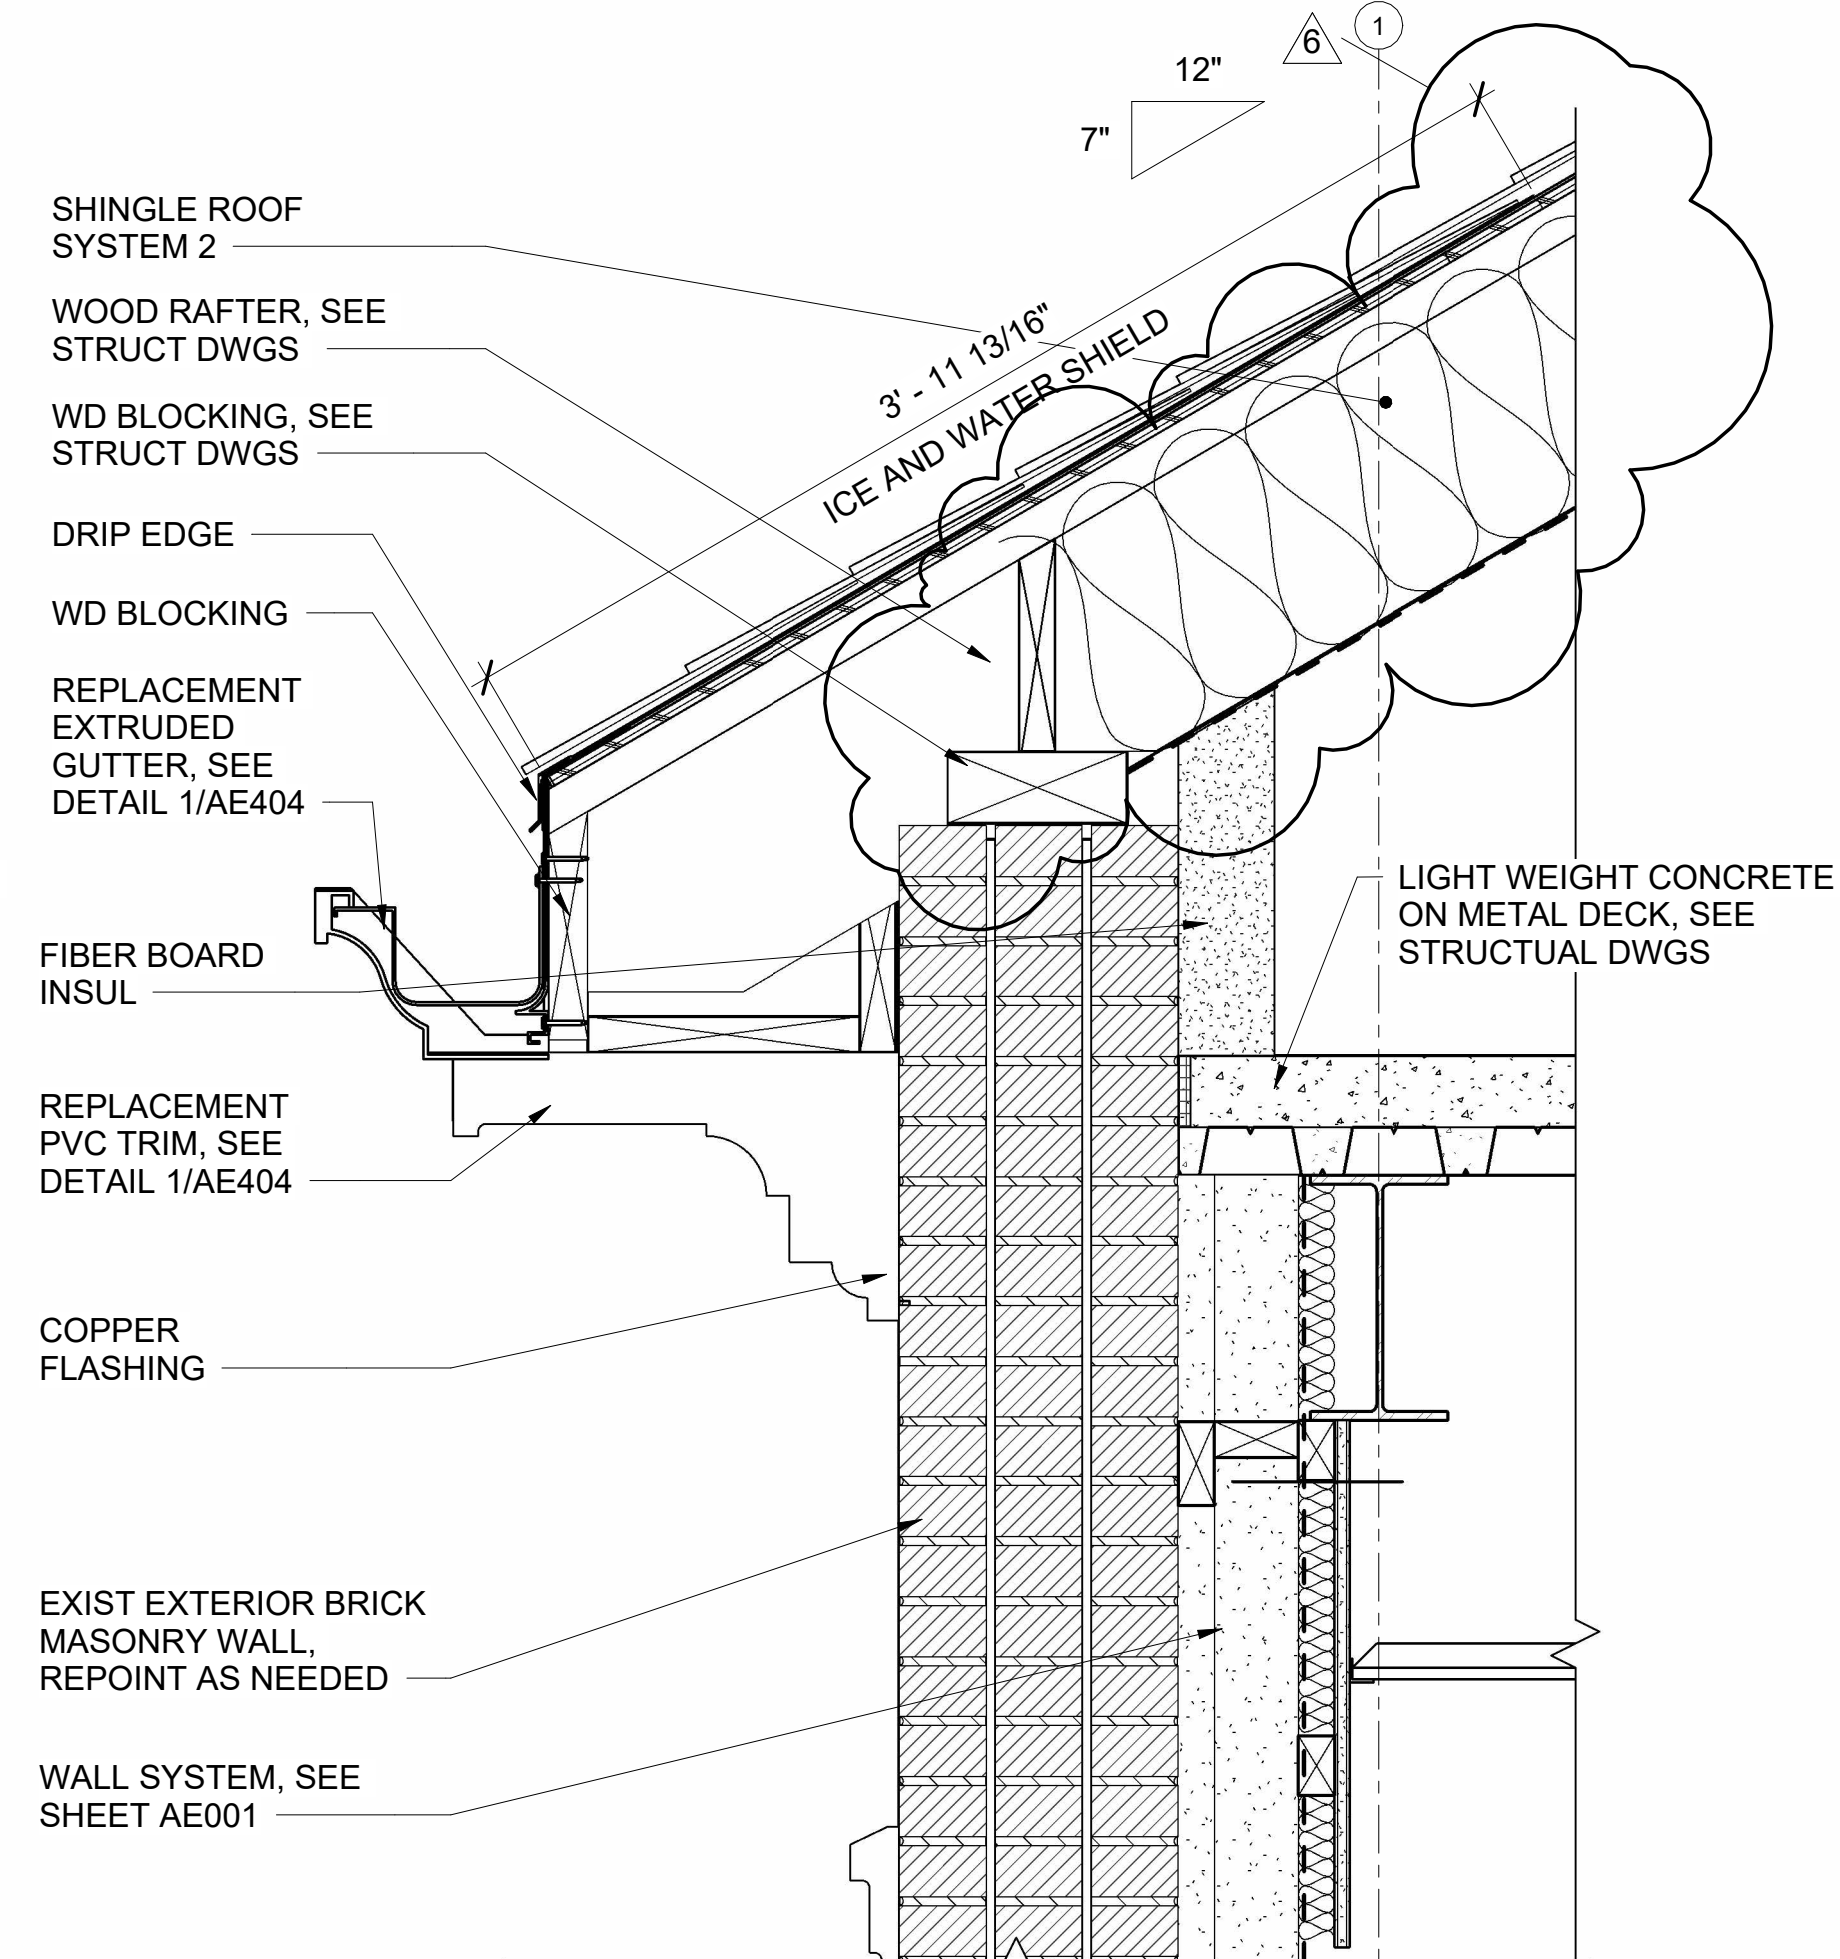


6 EAVE DETAIL @ SHINGE ROOF
AE120 AE503 SCALE: 1 1/2" = 1'-0"

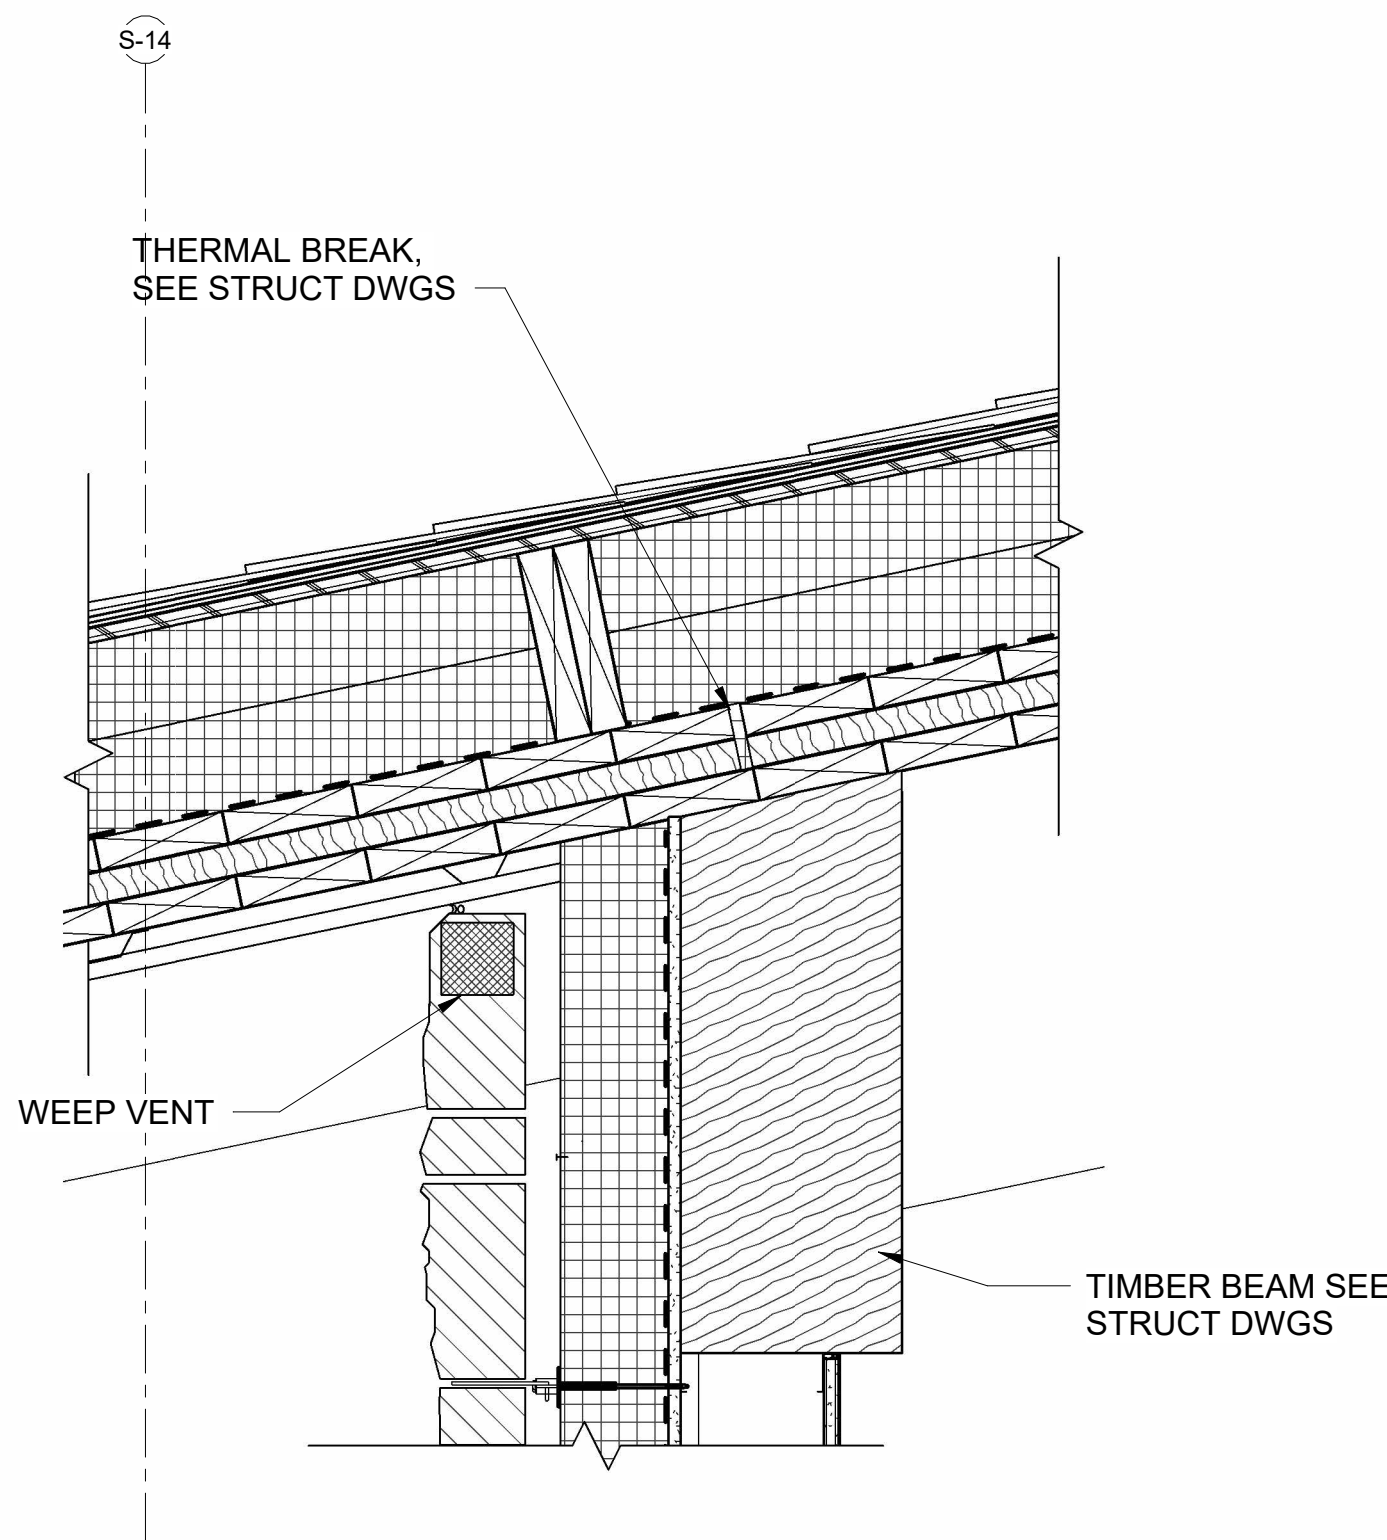



3 ROOF DETAIL
AE120 AE503 SCALE: 1 1/2" = 1'-0"

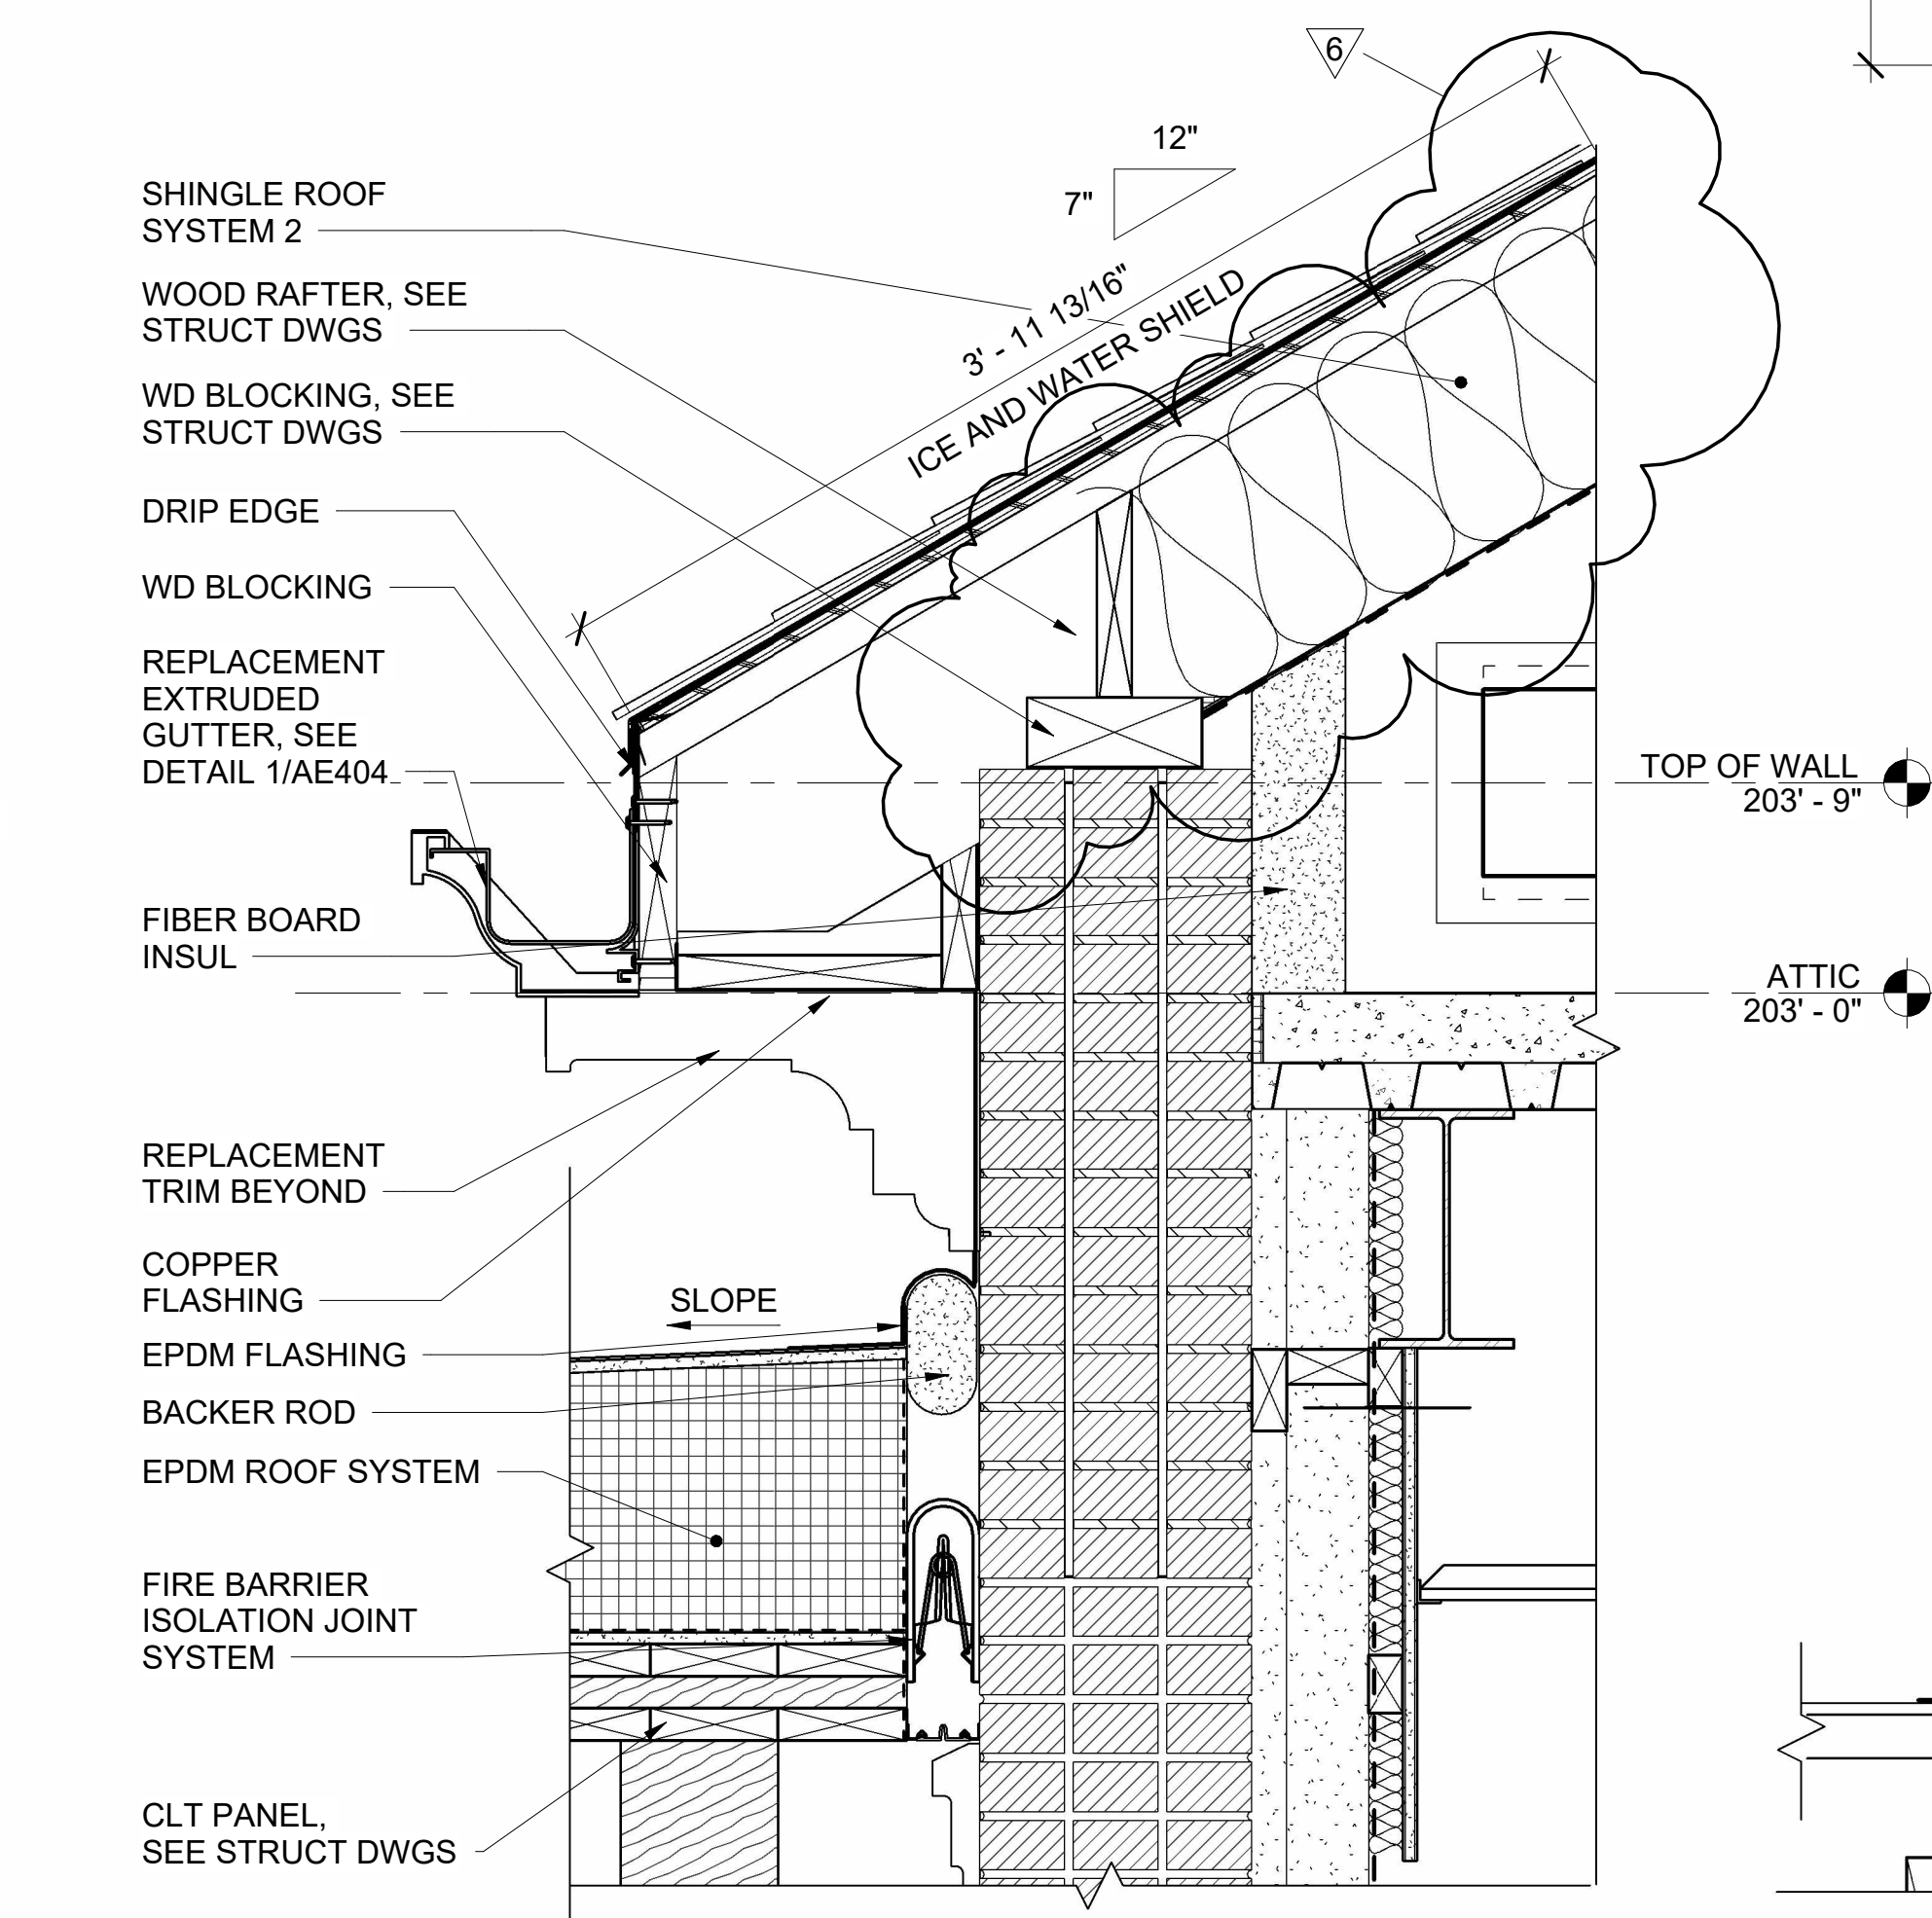


7 ROOF EXPANSION JOINT DETAIL
AE120 AE503 SCALE: 1 1/2" = 1'-0"

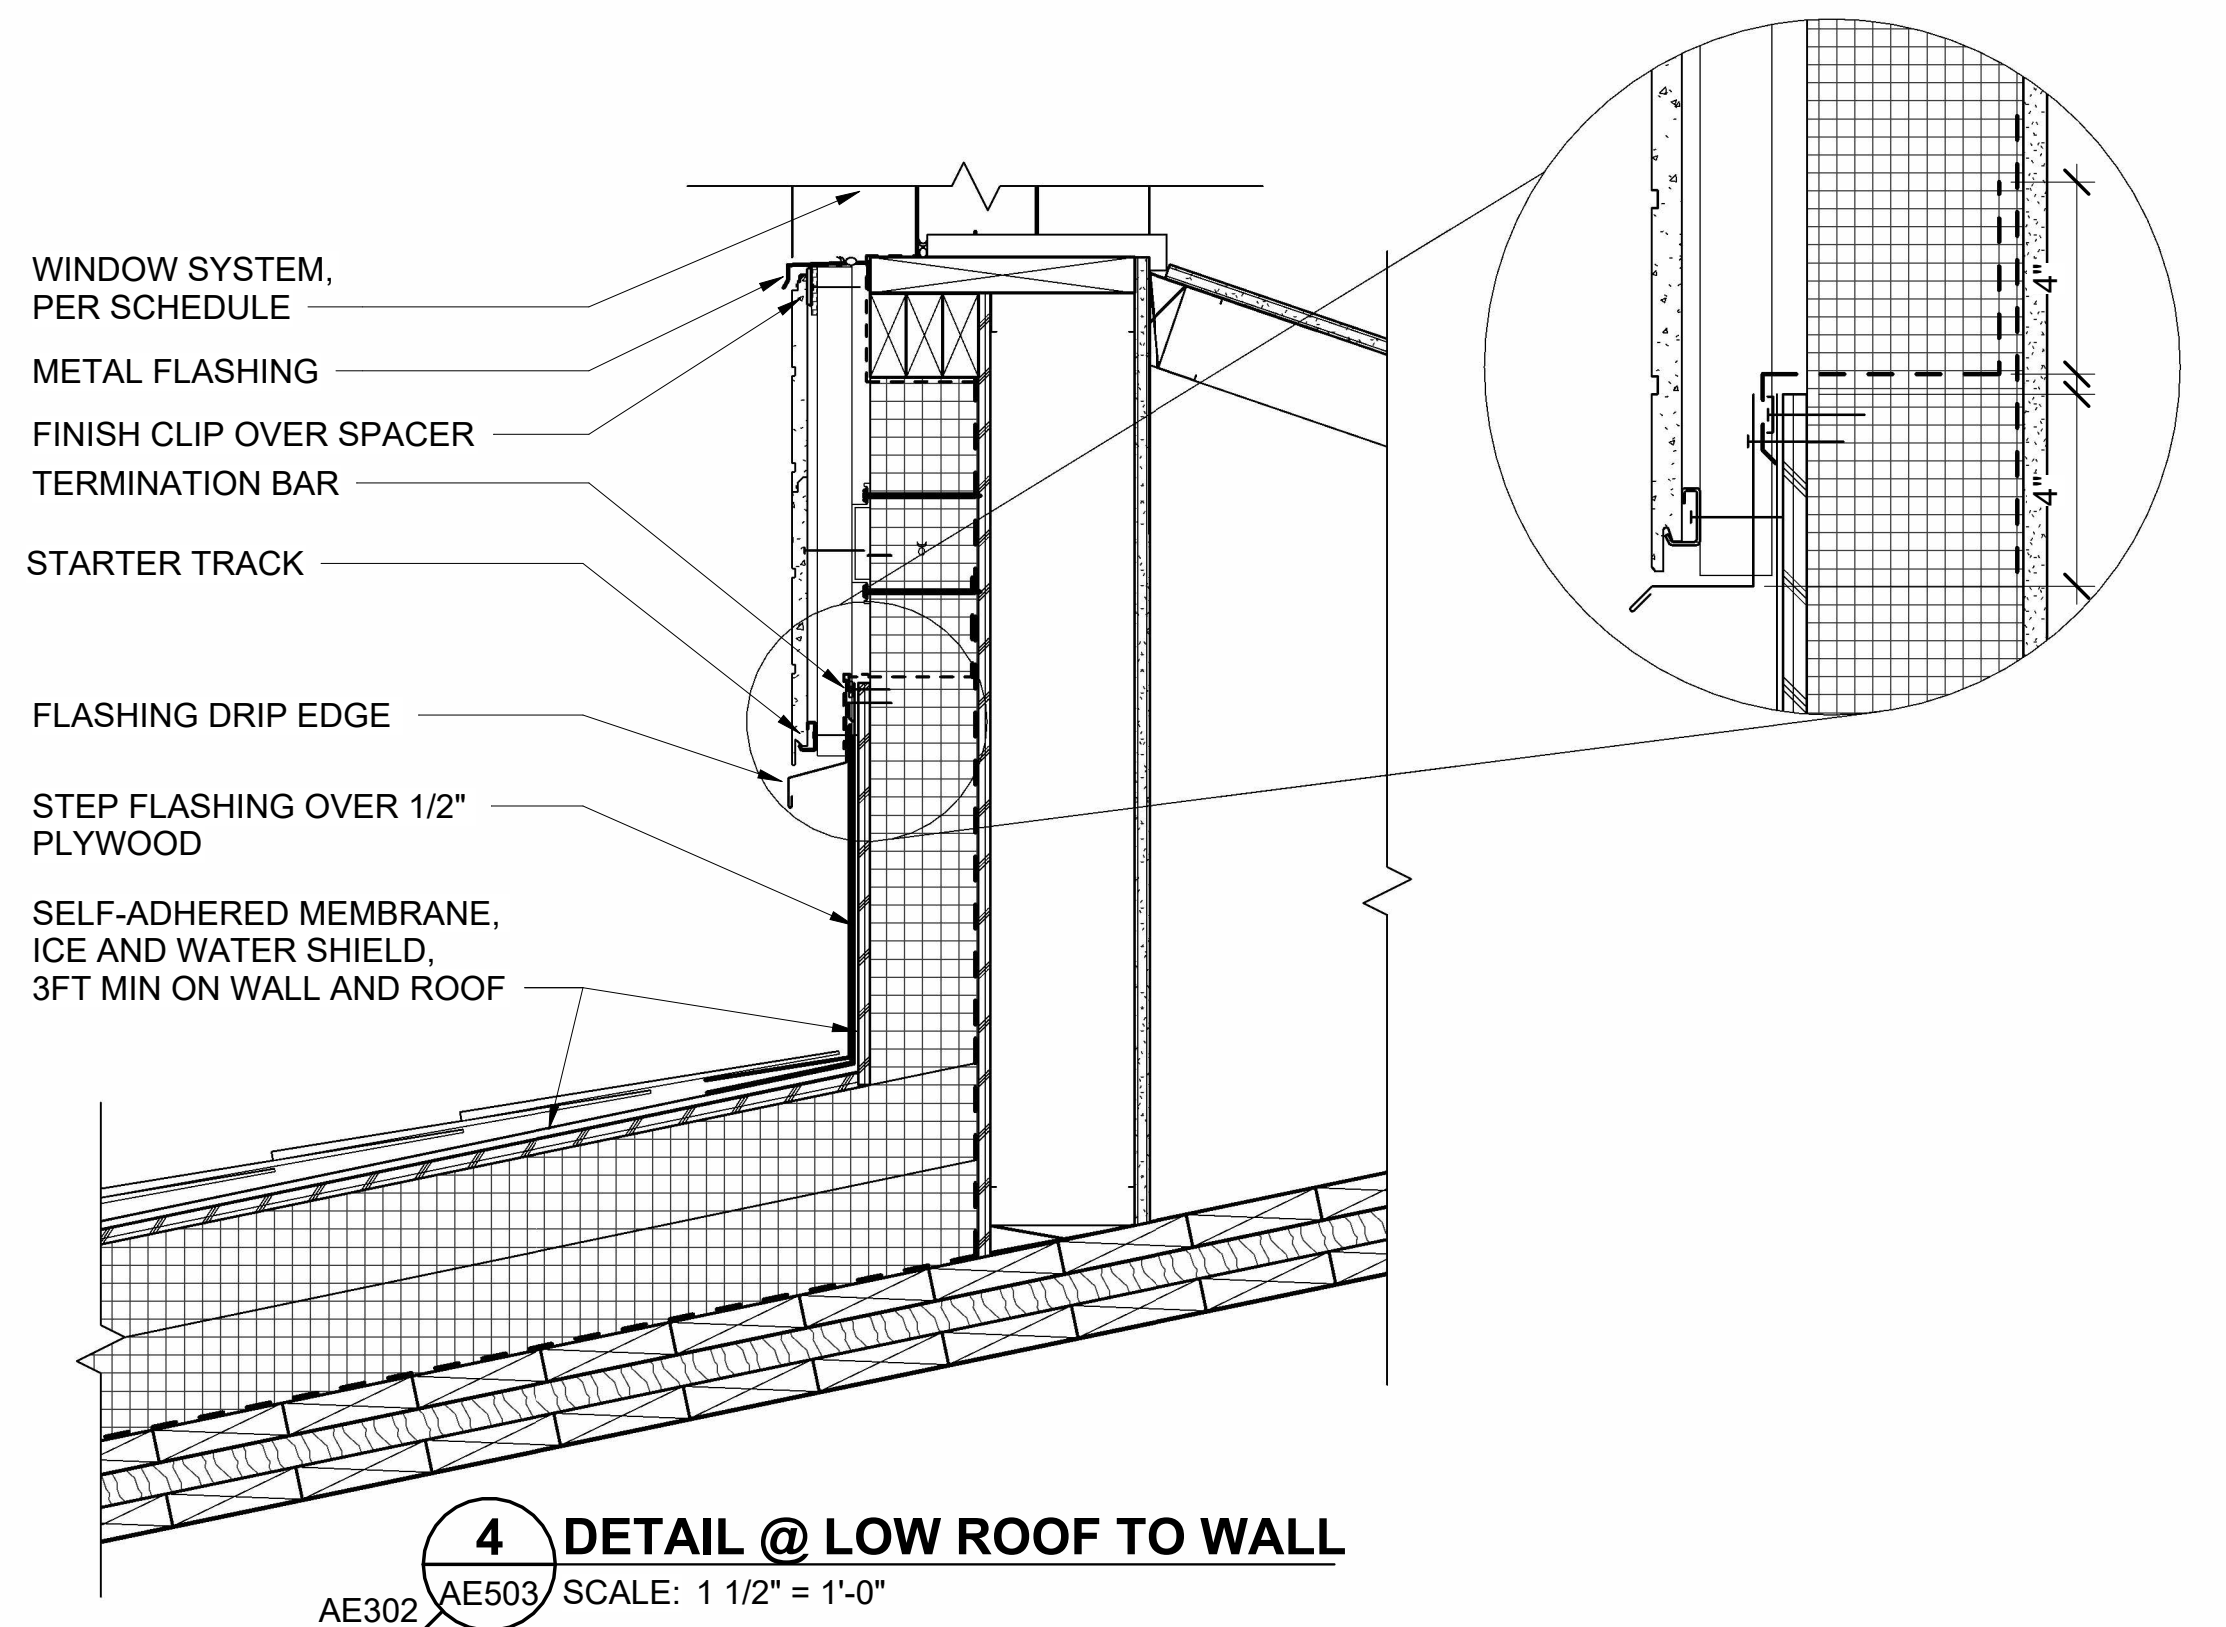

4 DETAIL @ LOW ROOF TO WALL
AE302 AE503 SCALE: 1 1/2" = 1'-0"





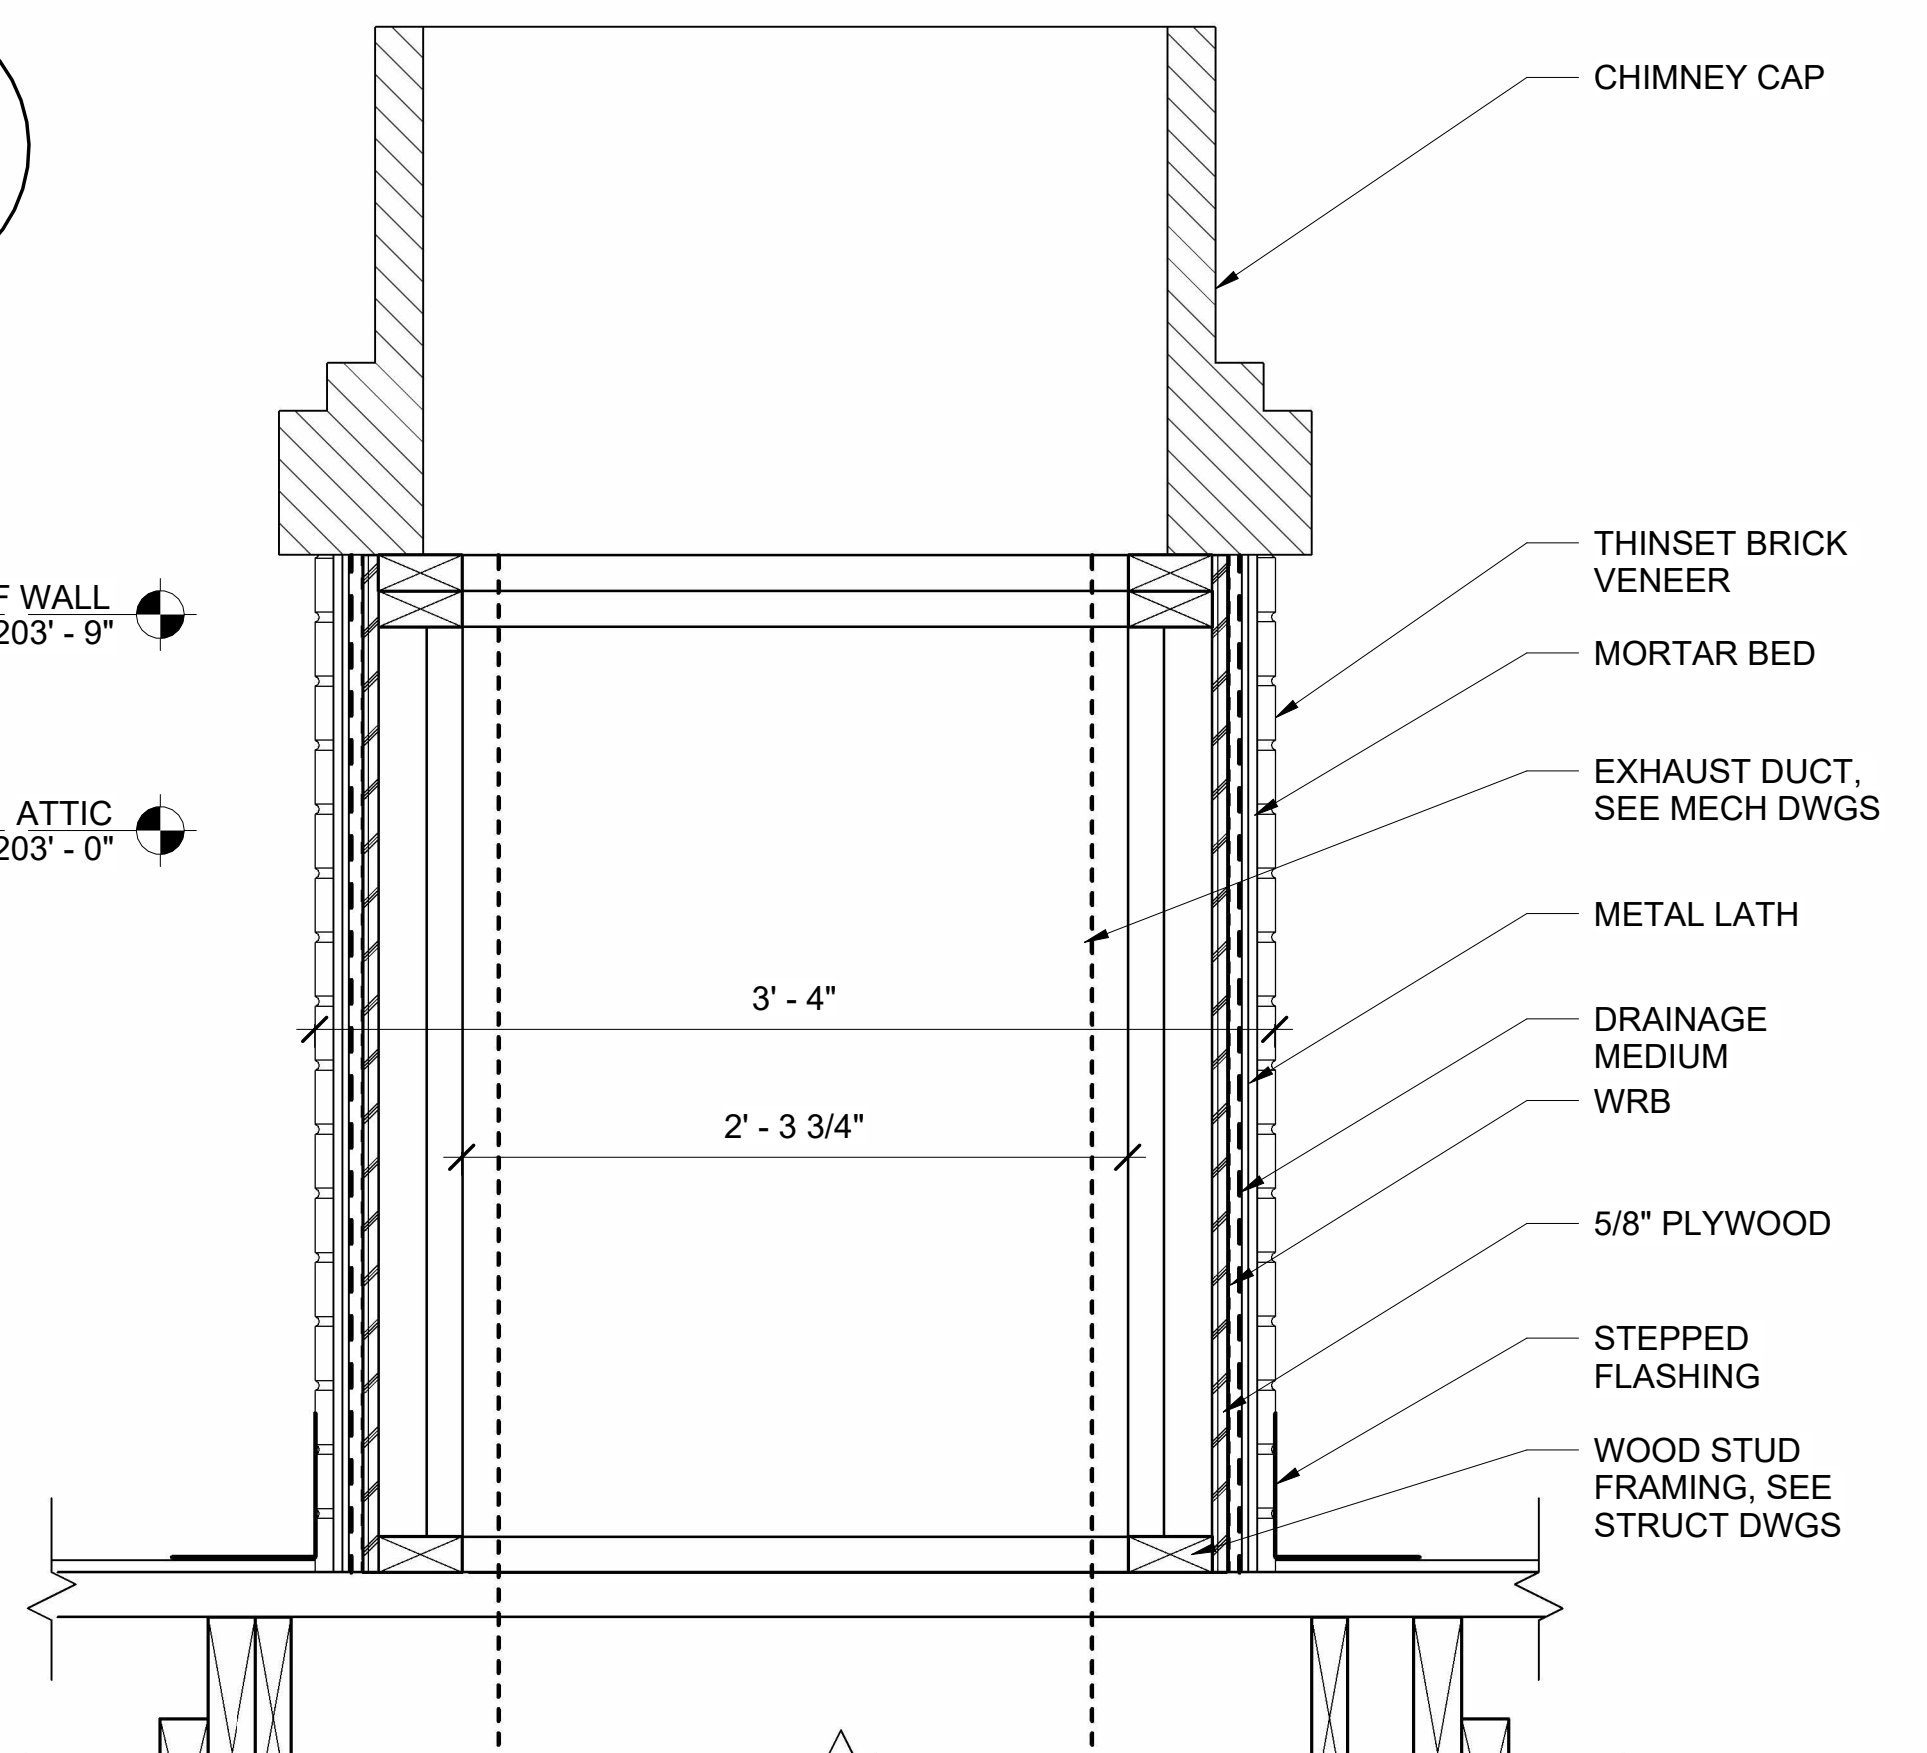
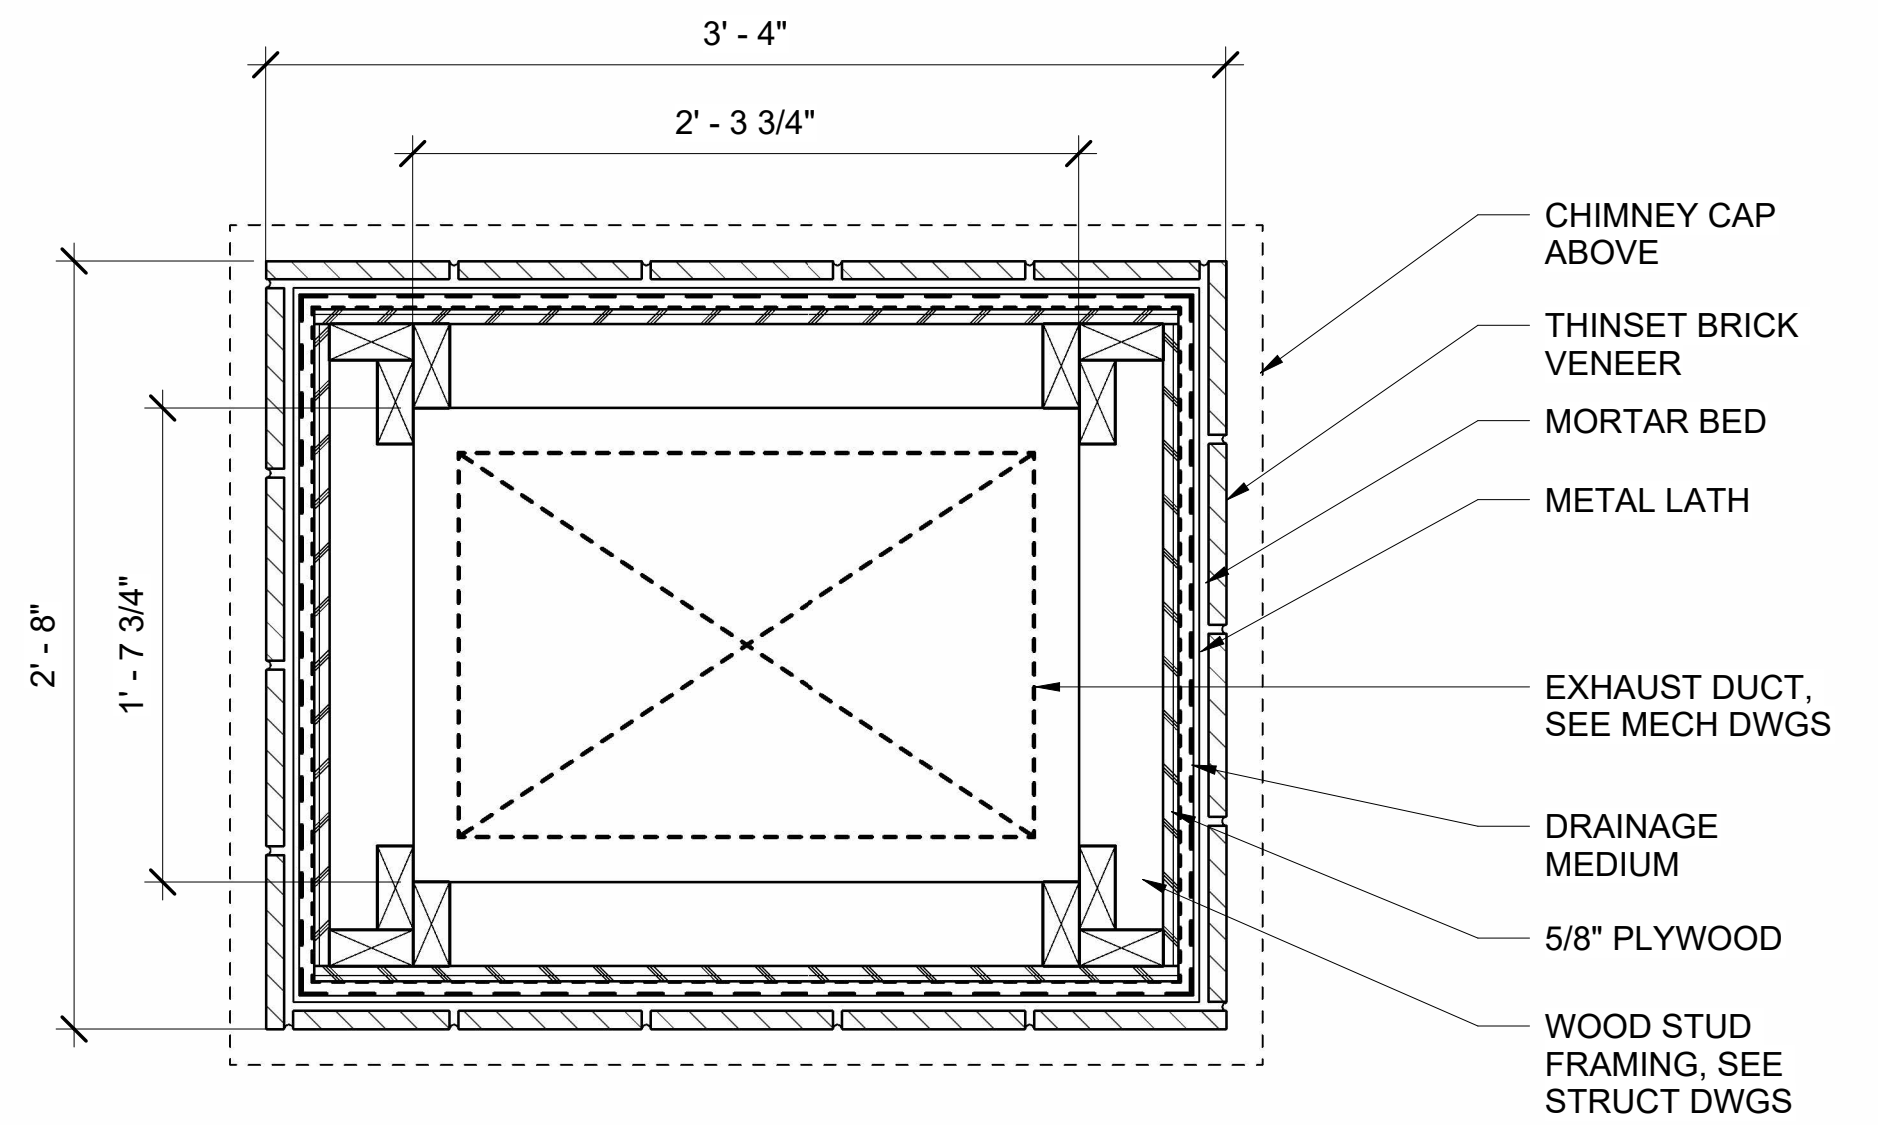


8 DETAIL AT CHIMNEY AT CETA BUILDING
AE120 AE503 SCALE: 1 1/2" = 1'-0"

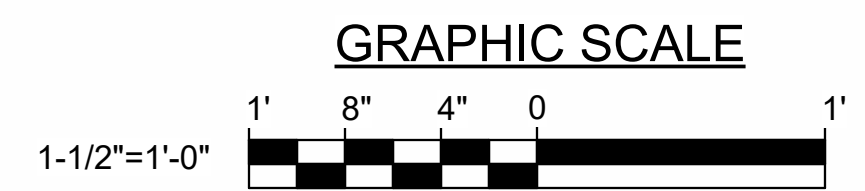

CHECK GRAPHIC SCALE BEFORE USING

DEPARTMENT OF INLAND FISHERIES & WILDLIFE			
NEW OFFICE HEADQUARTERS			
AUGUSTA, ME			
TITLE THIS DWS: ROOF DETAILS 3			
DRAWN BY: MJD		CHECK BY: CET	
NO. 6		DATE 01/29/2025	
DESCRIPTION		REVISIONS	
6 03/13/2025 ADDENDUM NO.6		HMG	
5 03/06/2025 ADDENDUM NO.5		HMG	
NO. 1		DATE 01/29/2025	
DESCRIPTION		REVISIONS	
6 03/13/2025 ADDENDUM NO.6		HMG	
5 03/06/2025 ADDENDUM NO.5		HMG	
NO. 1		DATE 01/29/2025	
DESCRIPTION		REVISIONS	

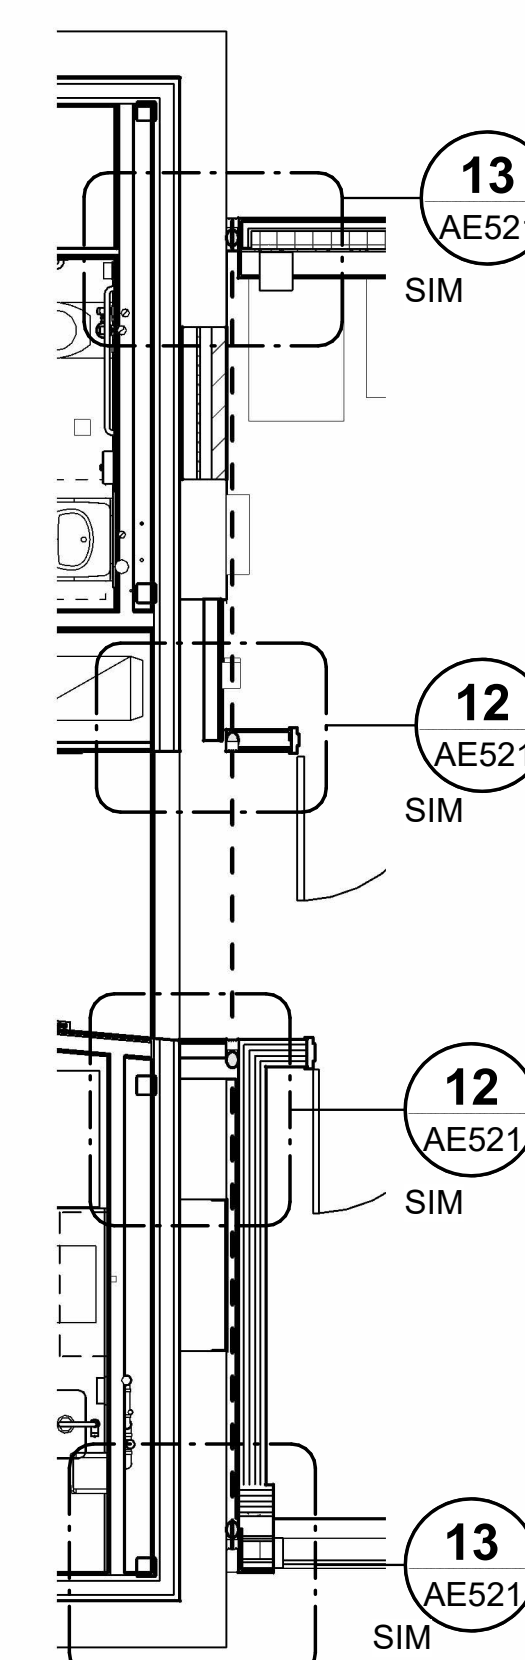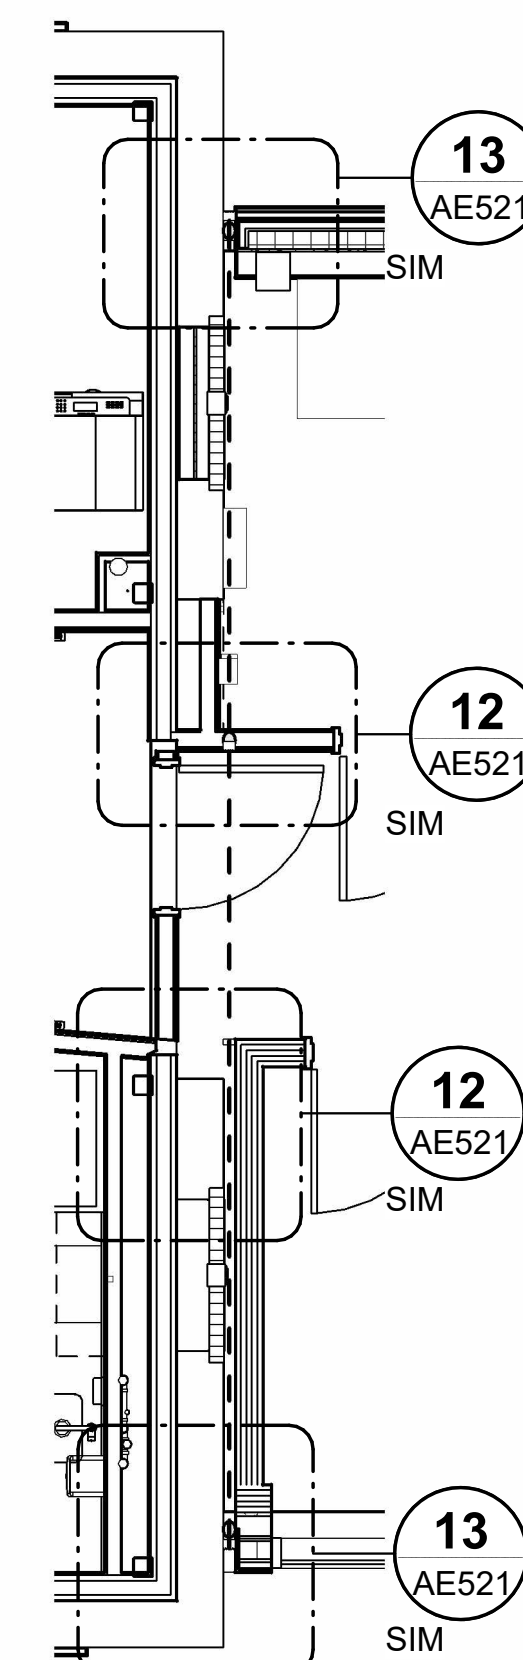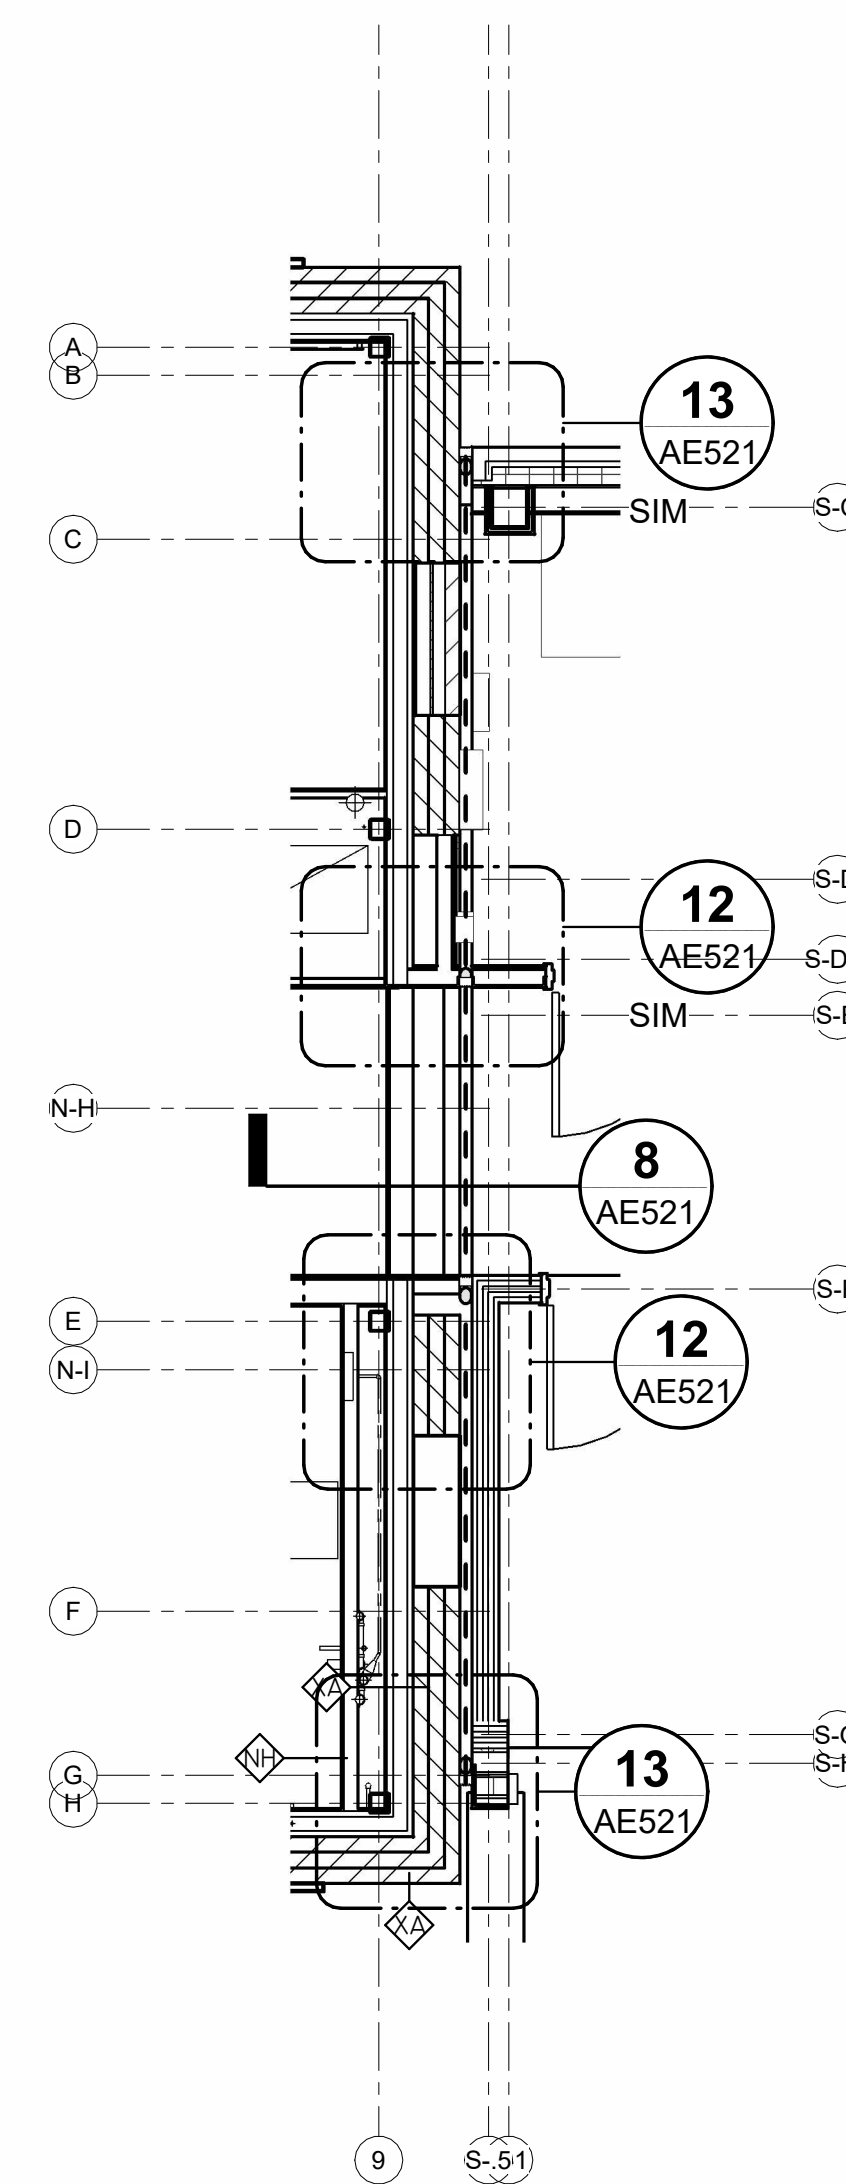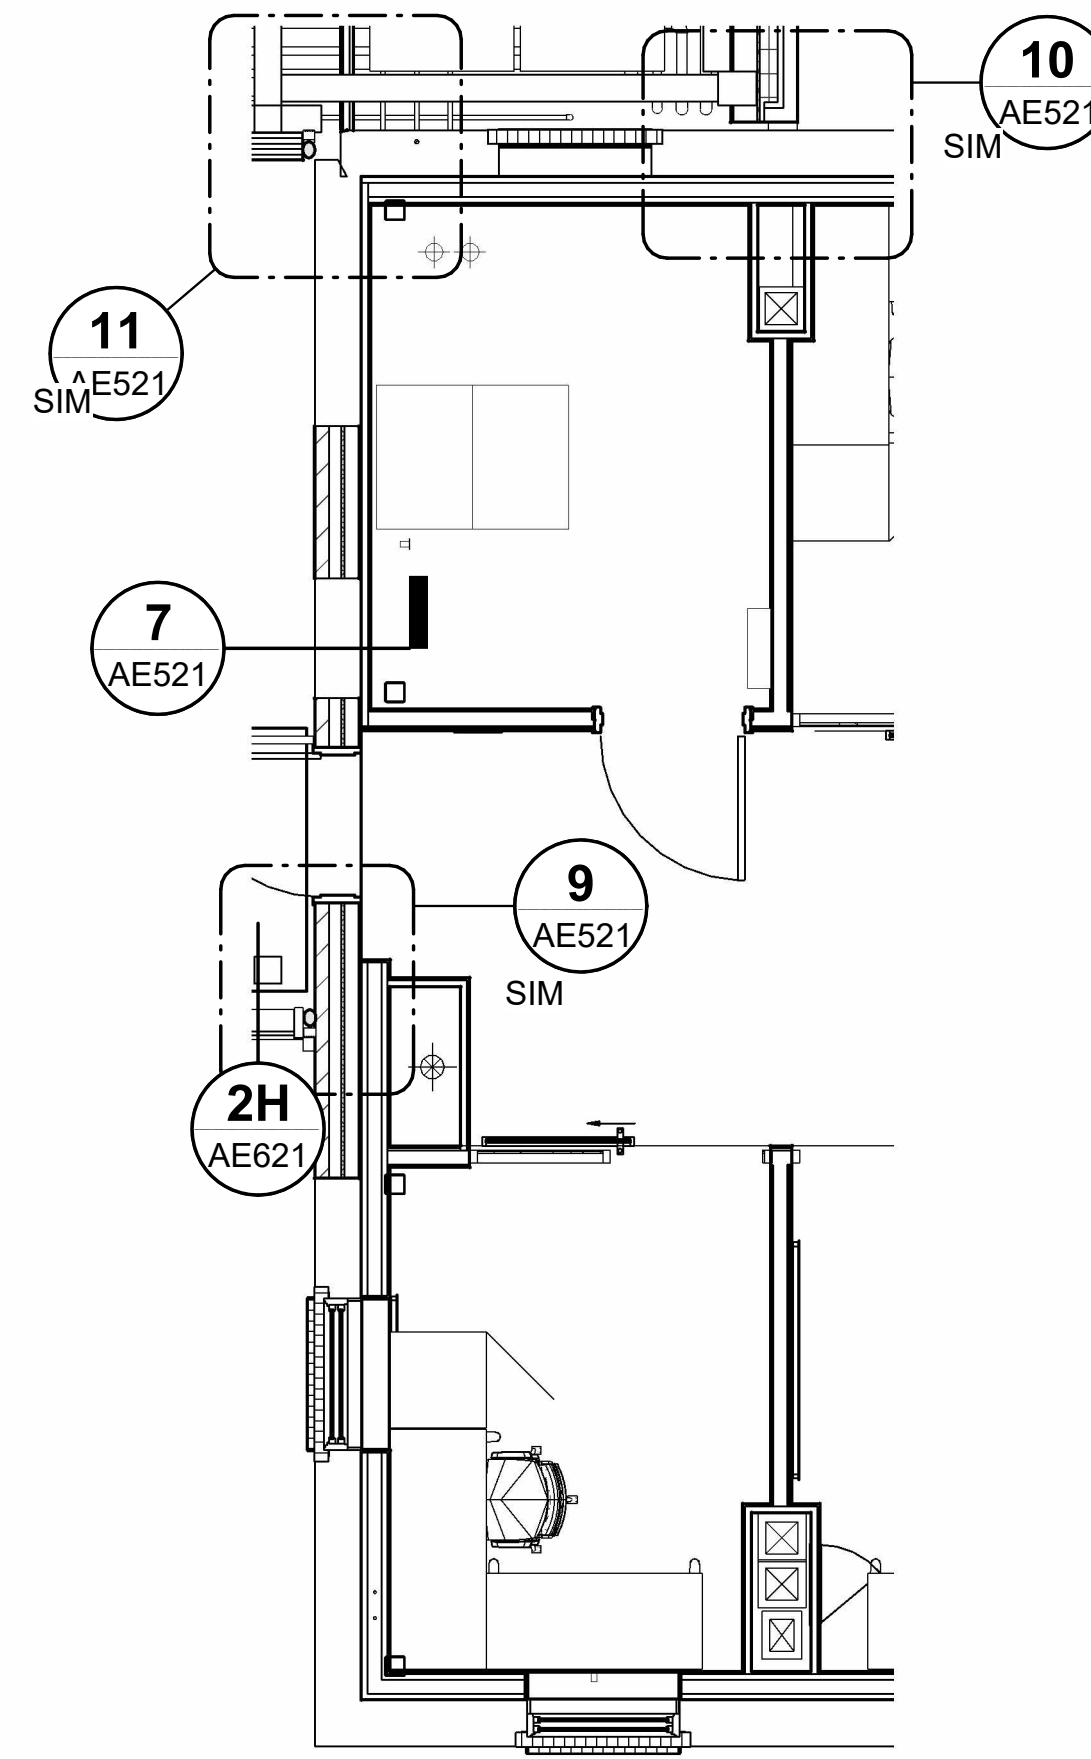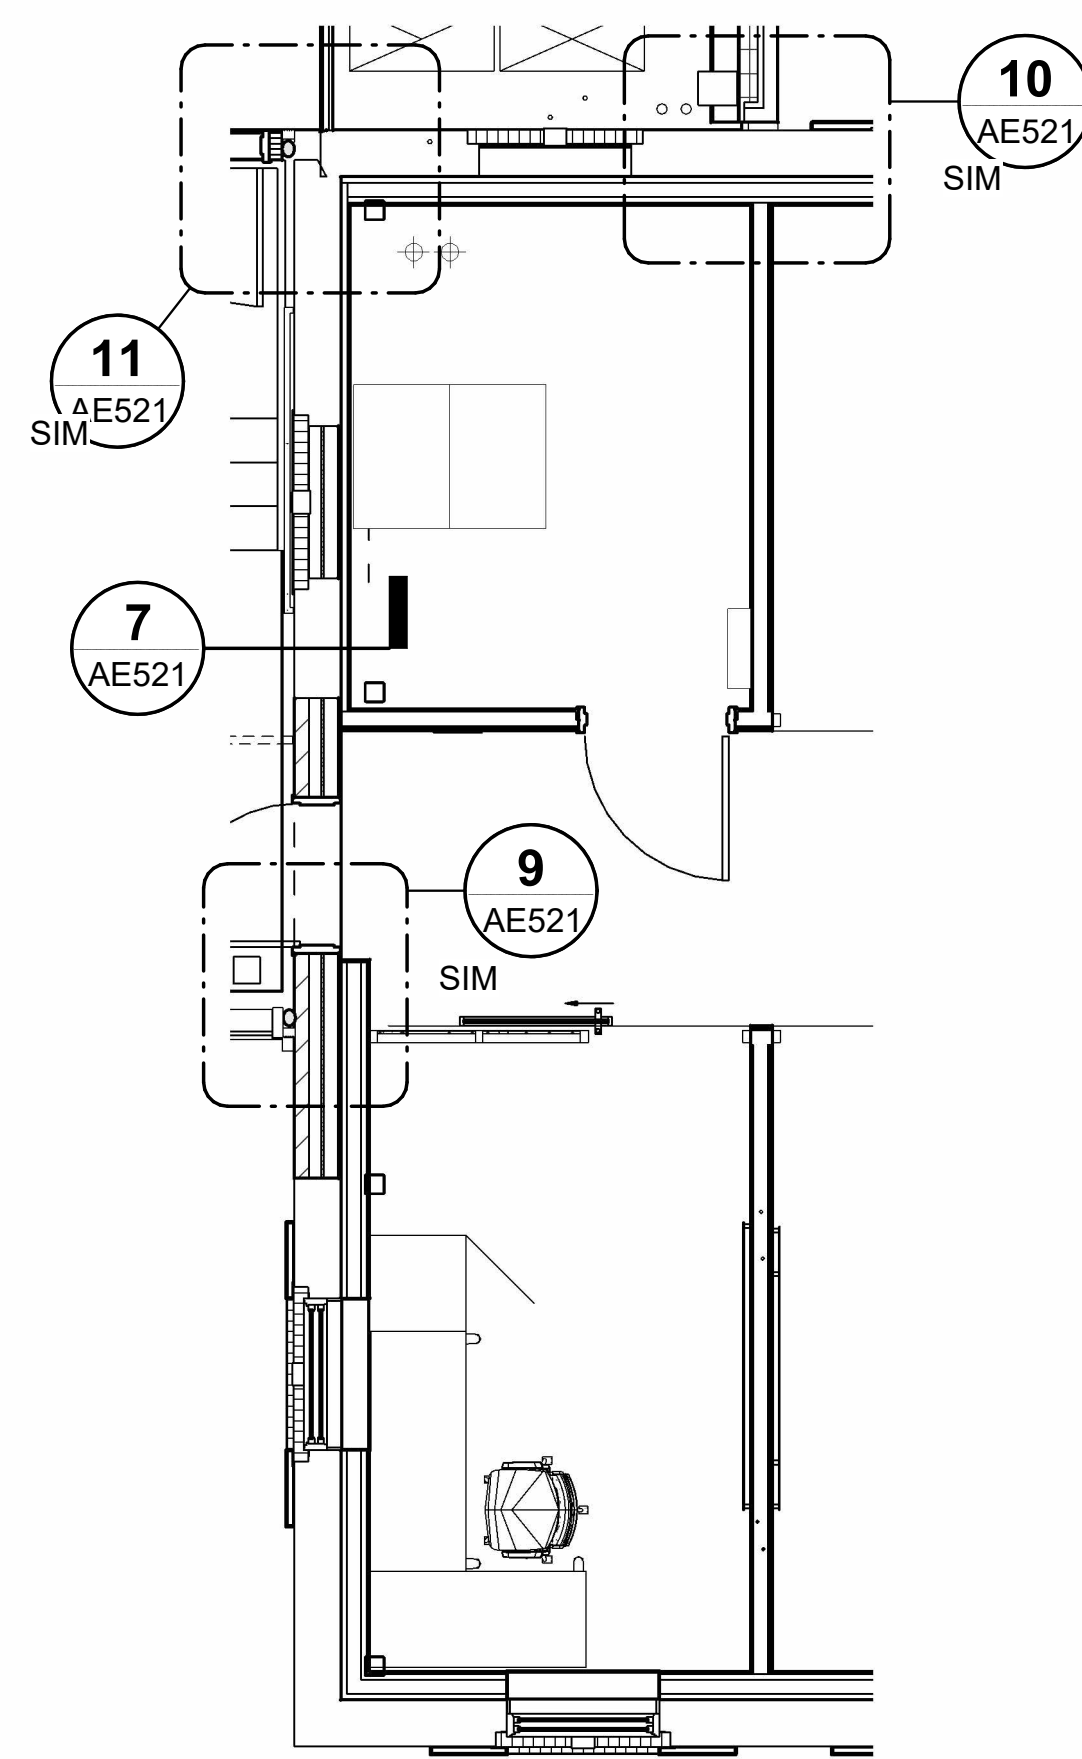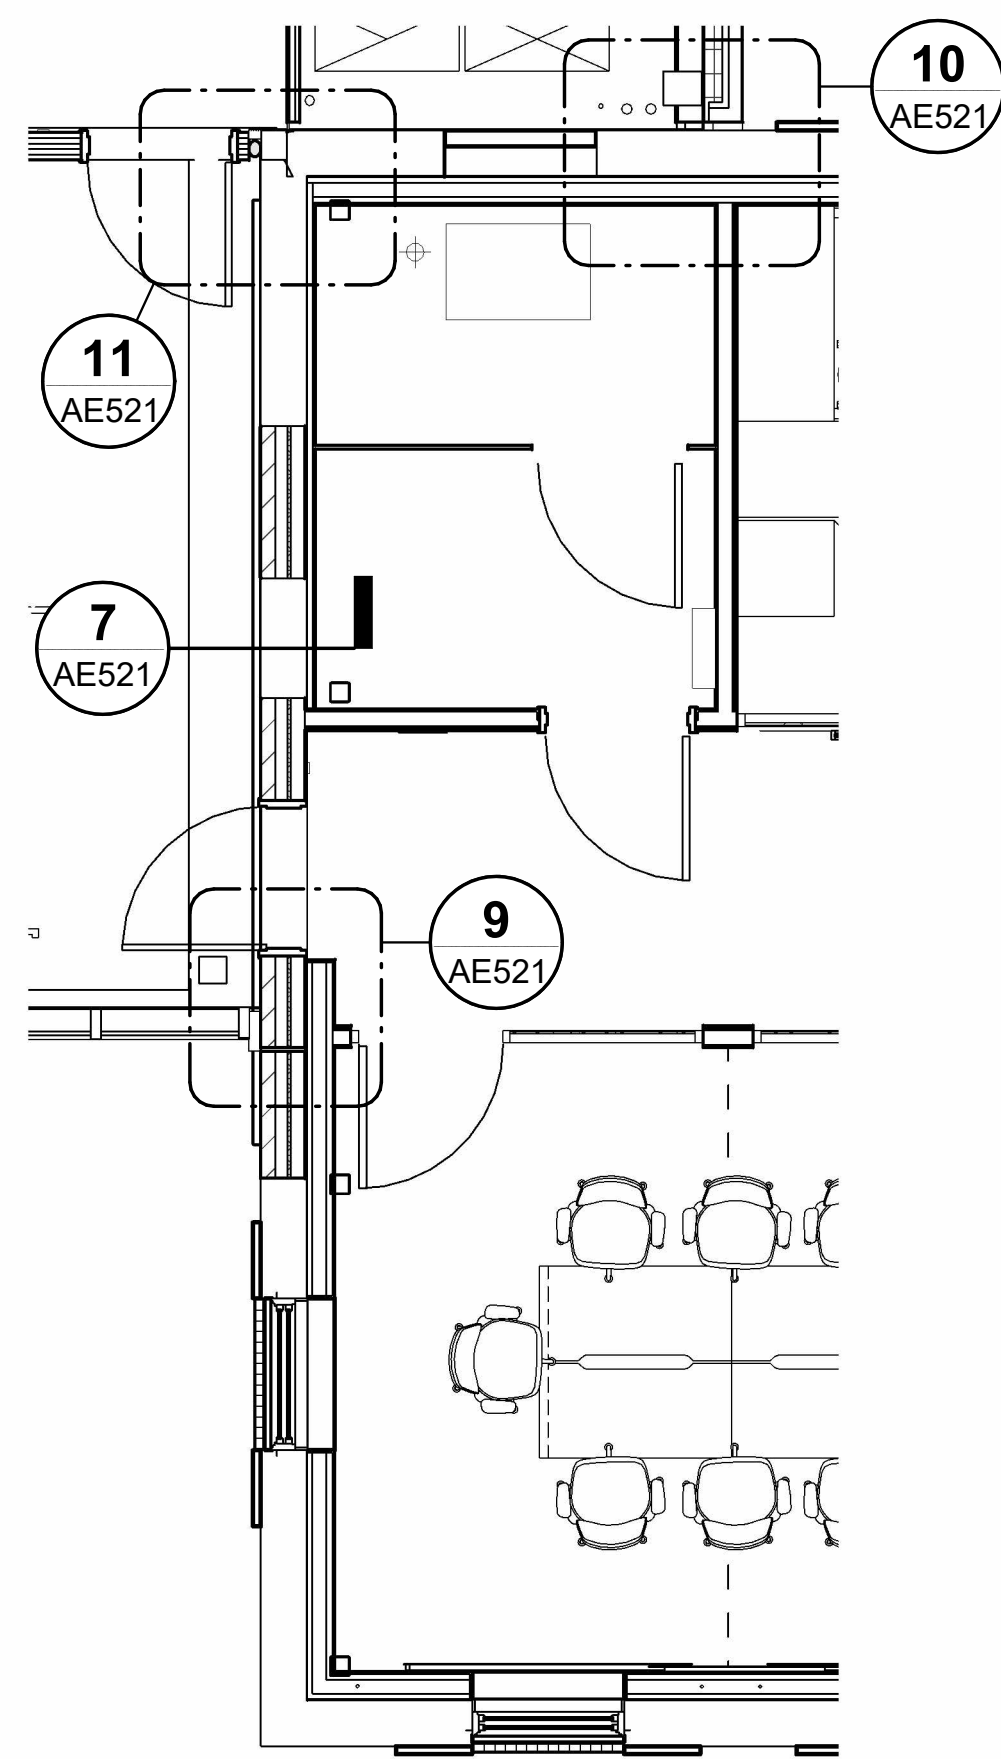

1 ENLARGED FIRST FLOOR PLAN @ EXPANSION JOINT, CETA NORTH
AE101 AE521 SCALE: 1/4" = 1'-0"


2 ENLARGED SECOND FLOOR PLAN @ EXPANSION JOINT, CETA NORTH
AE102 AE521 SCALE: 1/4" = 1'-0"

3 ENLARGED THIRD FLOOR PLAN @ EXPANSION JOINT, CETA NORTH
AE103 AE521 SCALE: 1/4" = 1'-0"

4 ENLARGED FIRST FLOOR PLAN @ EXPANSION JOINT, CETA SOUTH
AE101 AE521 SCALE: 1/4" = 1'-0"


5 ENLARGED SECOND FLOOR PLAN @ EXPANSION JOINT, CETA SOUTH
AE102 AE521 SCALE: 1/4" = 1'-0"

6 ENLARGED THIRD FLOOR PLAN @ EXPANSION JOINT, CETA SOUTH
AE103 AE521 SCALE: 1/4" = 1'-0"

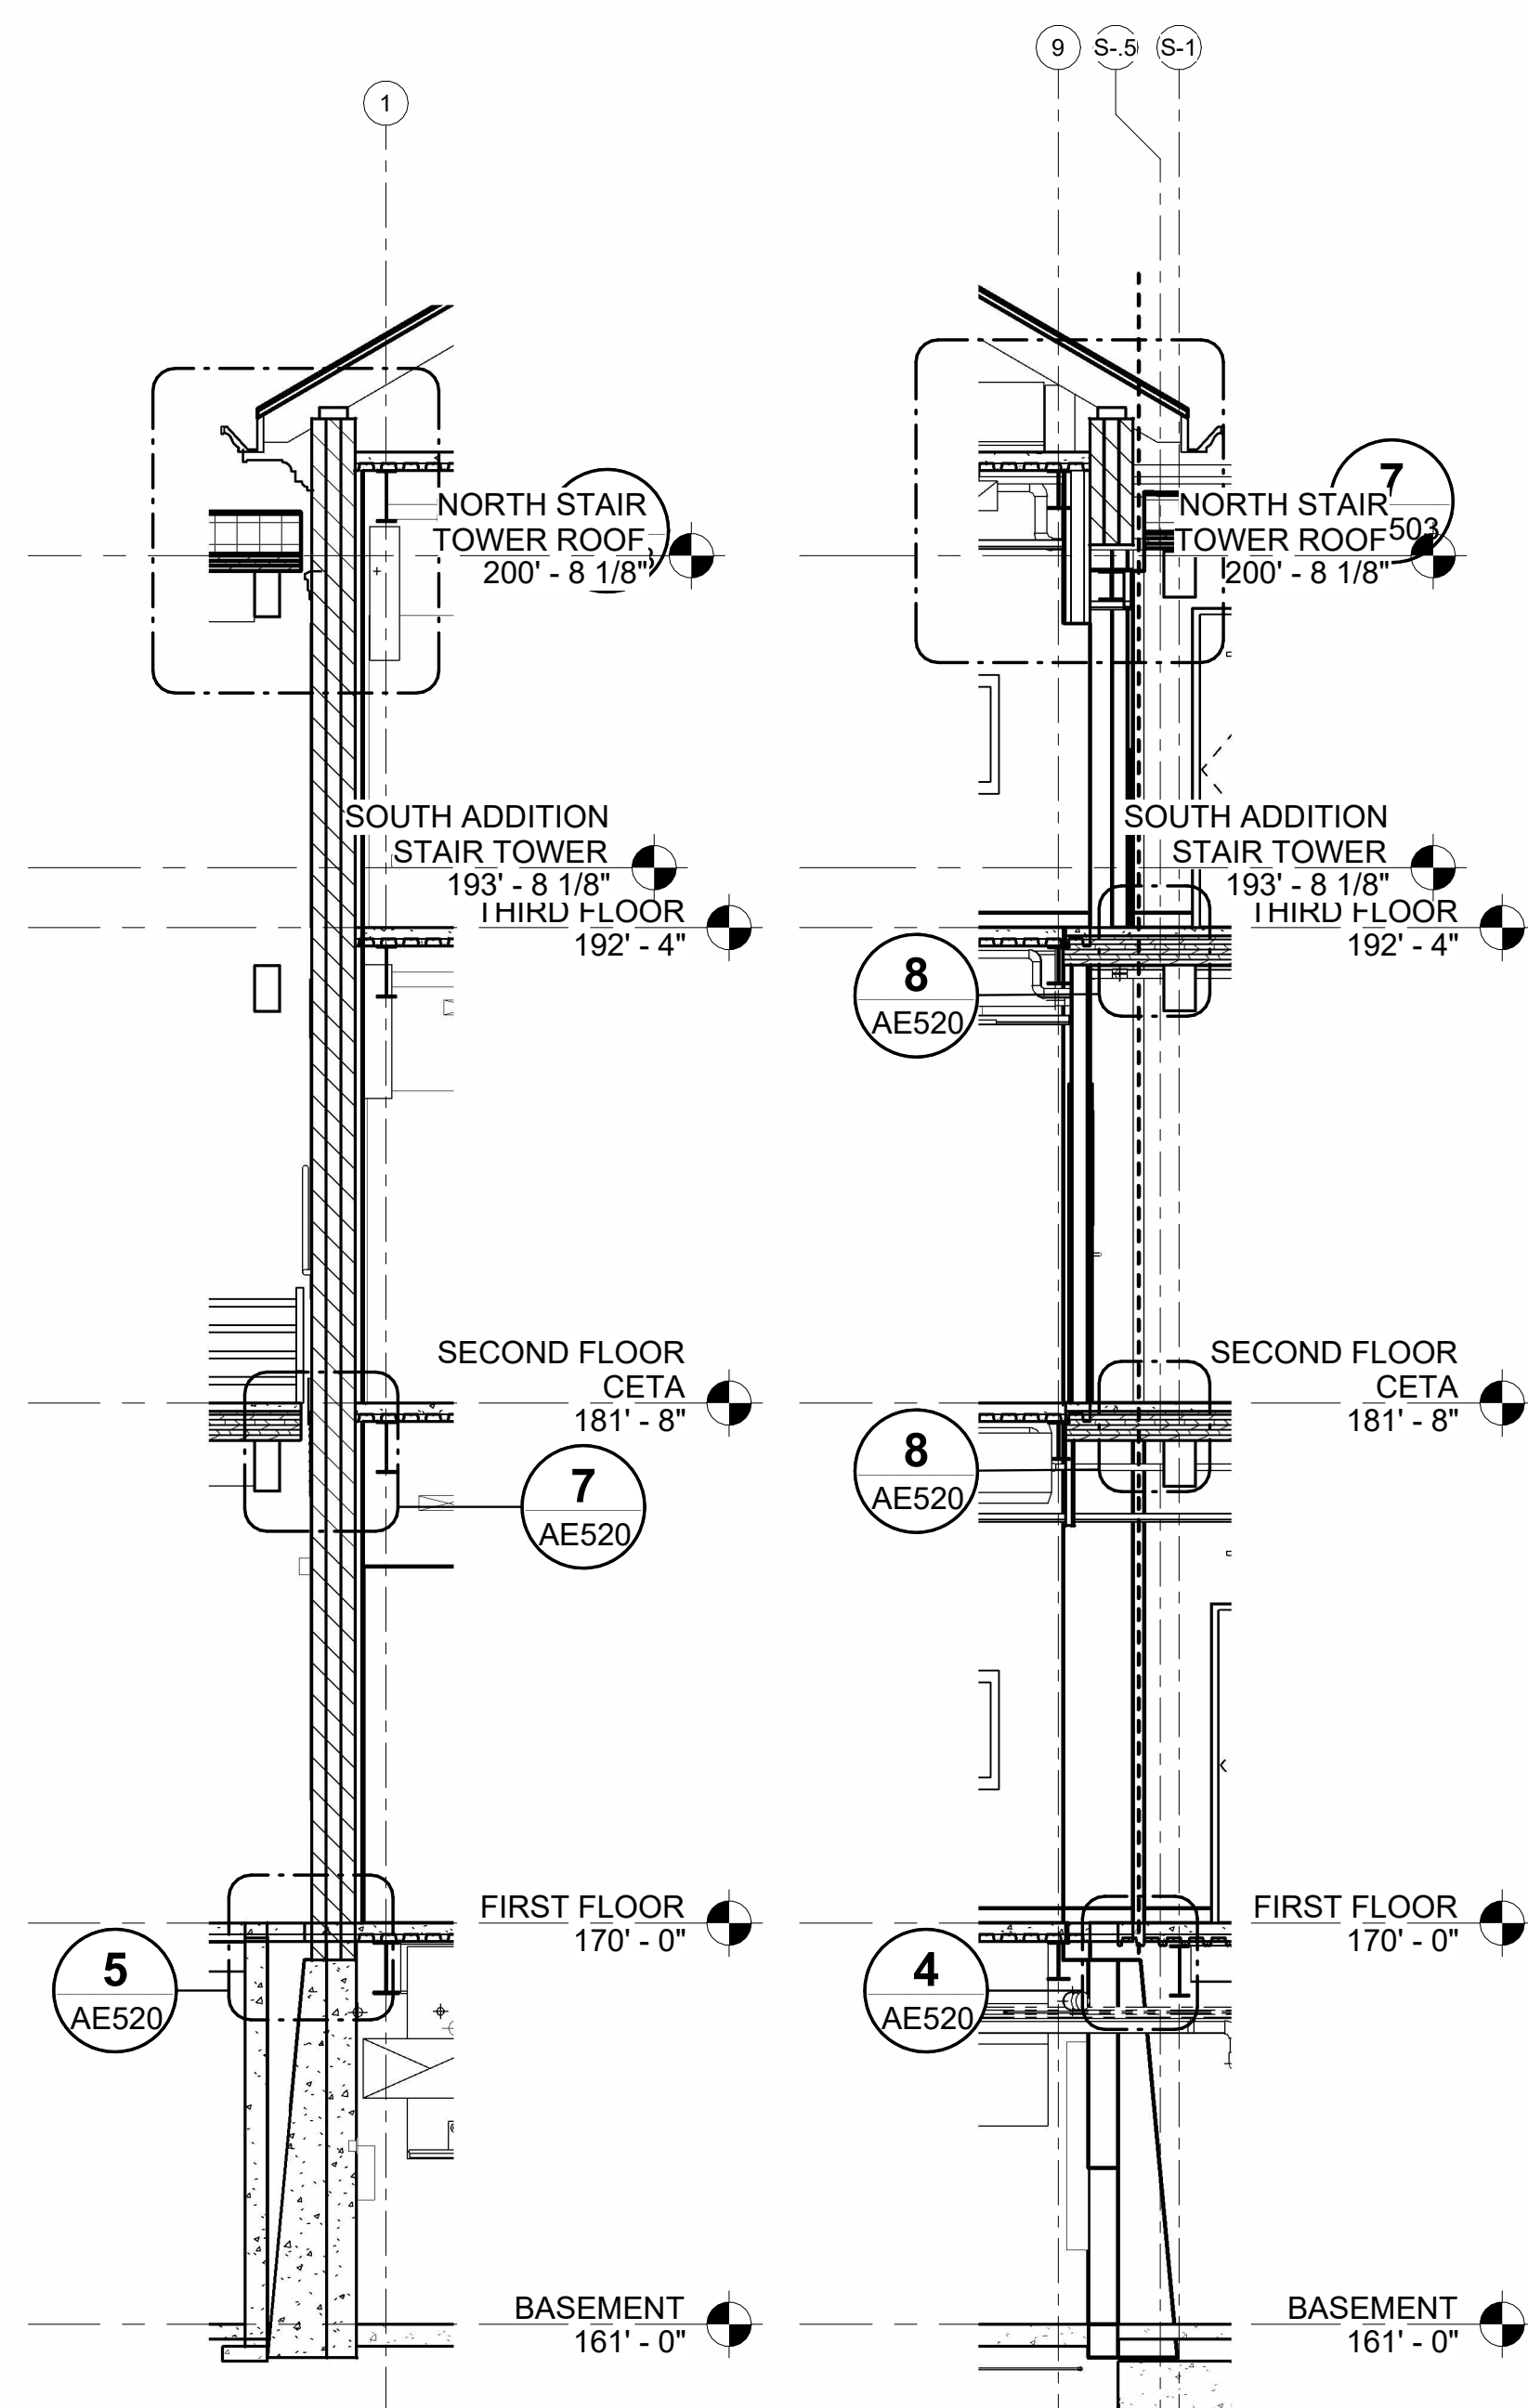


7 WALL SECTION
AE521 AE521 SCALE: 1/4" = 1'-0"

8 WALL SECTION
AE521 AE521 SCALE: 1/4" = 1'-0"

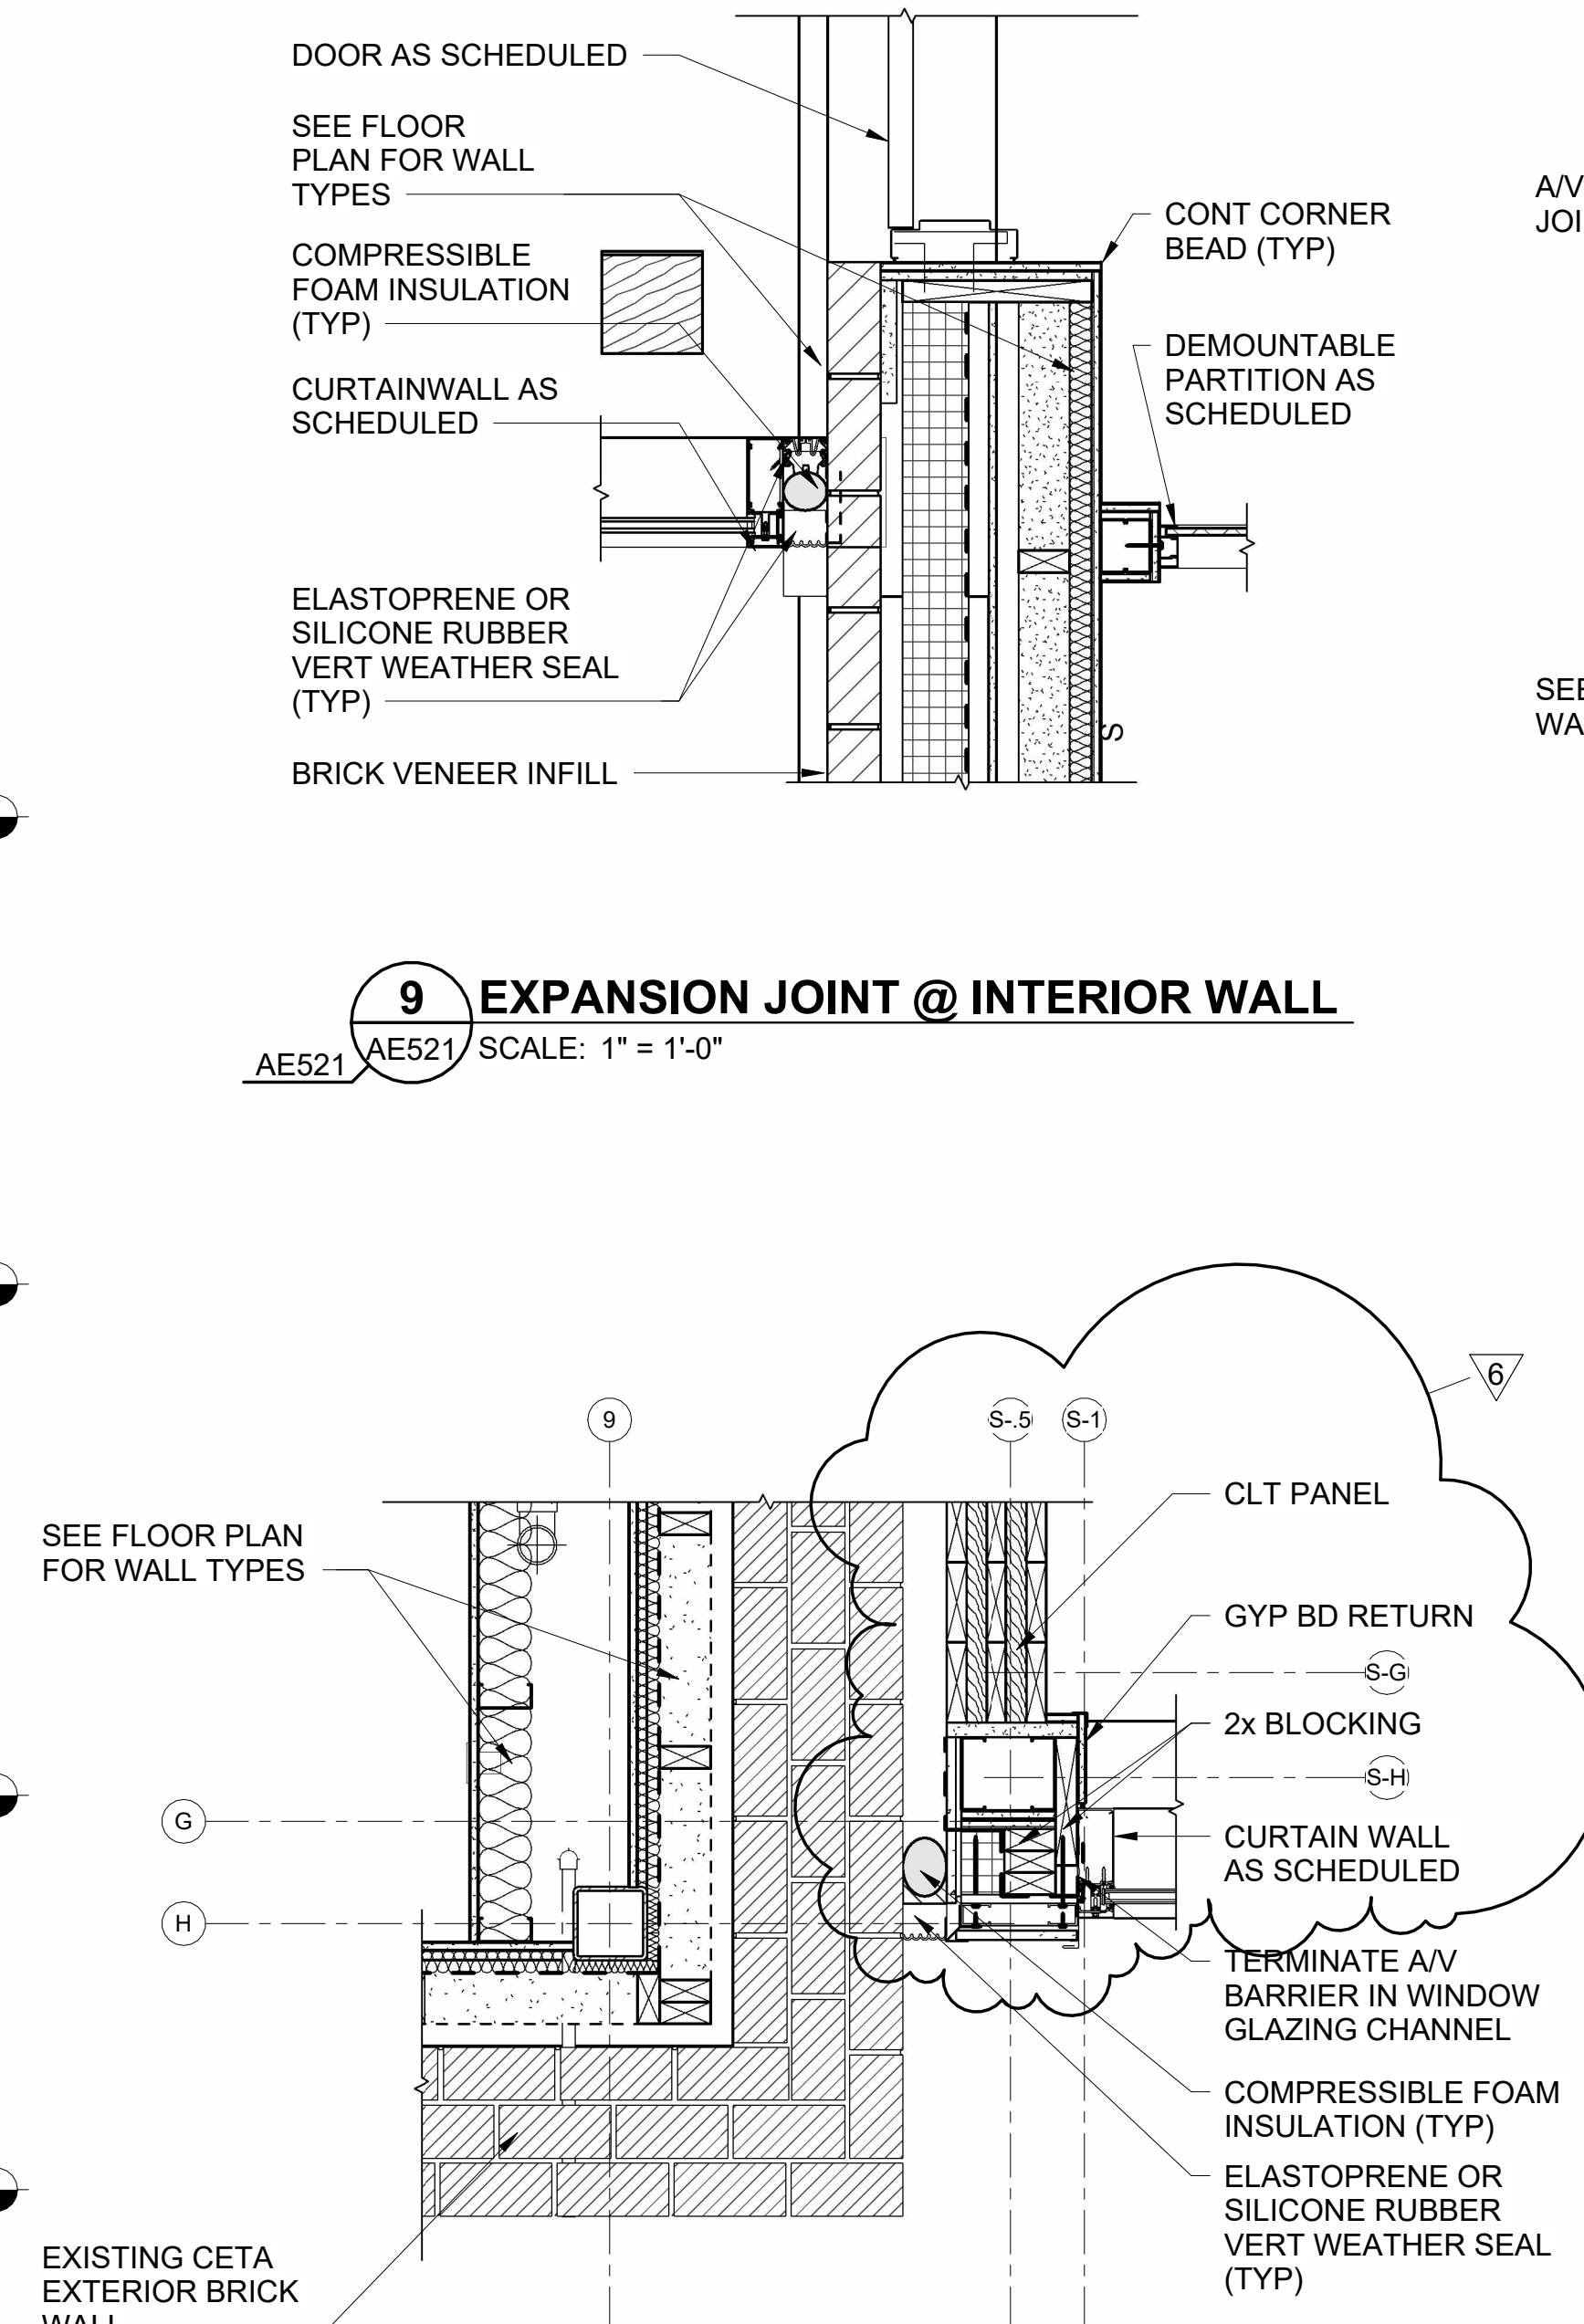


9 EXPANSION JOINT @ INTERIOR WALL
AE521 AE521 SCALE: 1" = 1'-0"


13 EXPANSION JOINT @ EXTERIOR WALL
AE521 AE521 SCALE: 1" = 1'-0"

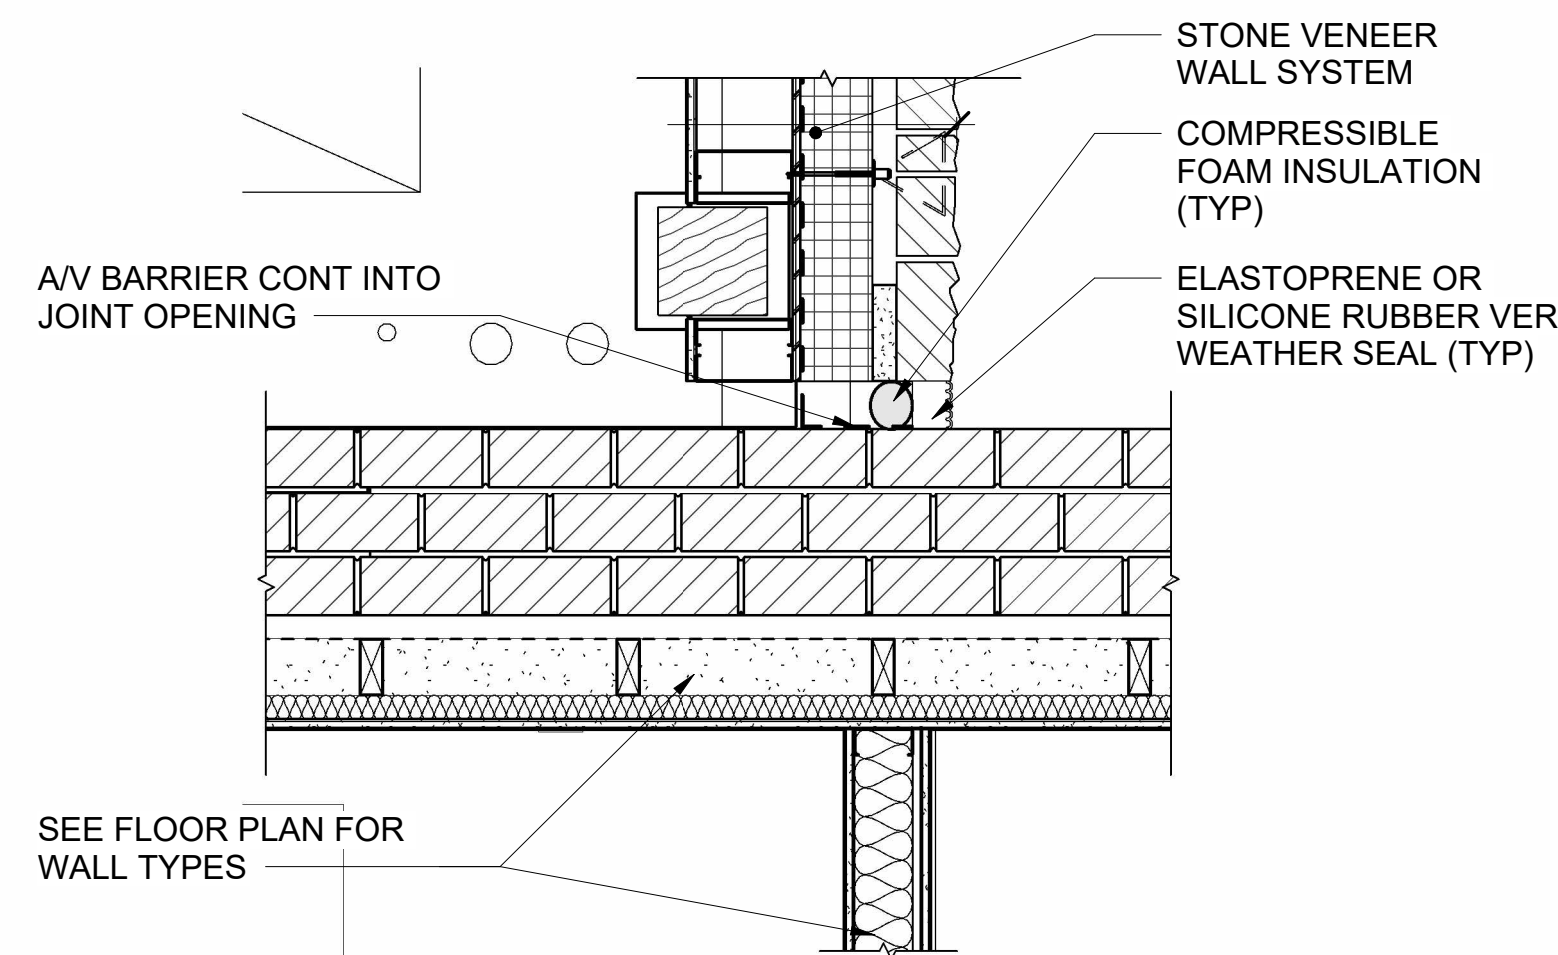


10 EXPANSION JOINT @ EXTERIOR WALL
AE521 AE521 SCALE: 1" = 1'-0"

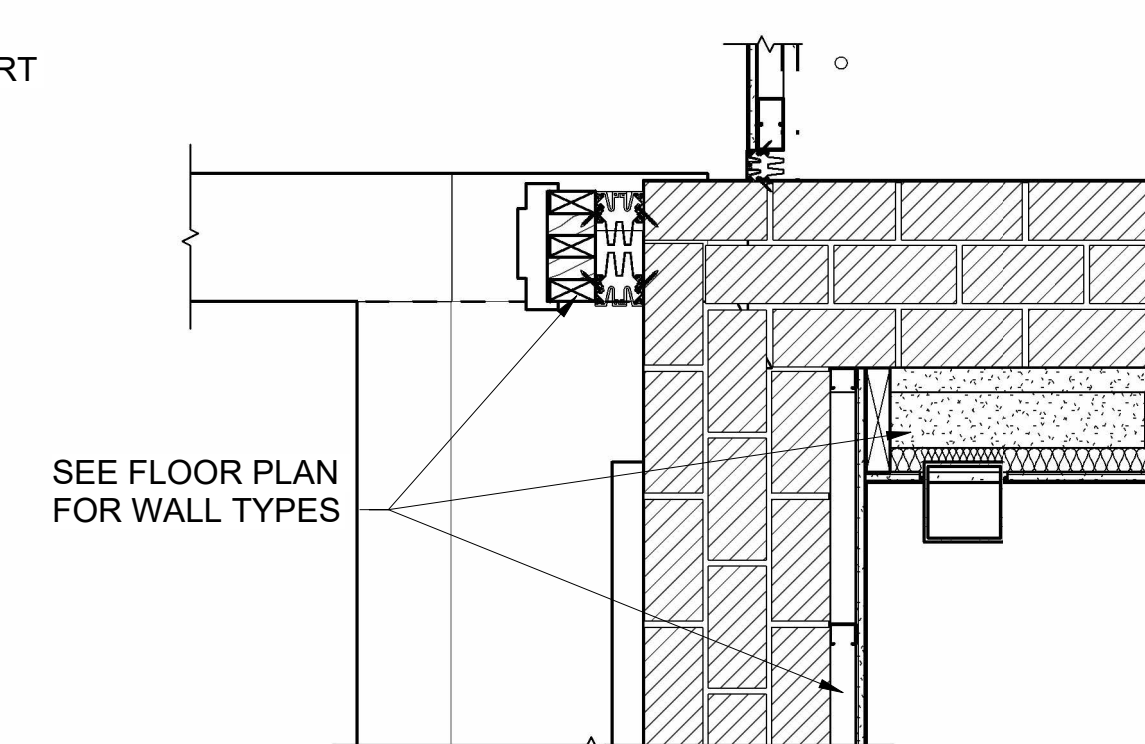


11 EXPANSION JOINT @ INTERIOR WALL
AE521 AE521 SCALE: 1" = 1'-0"

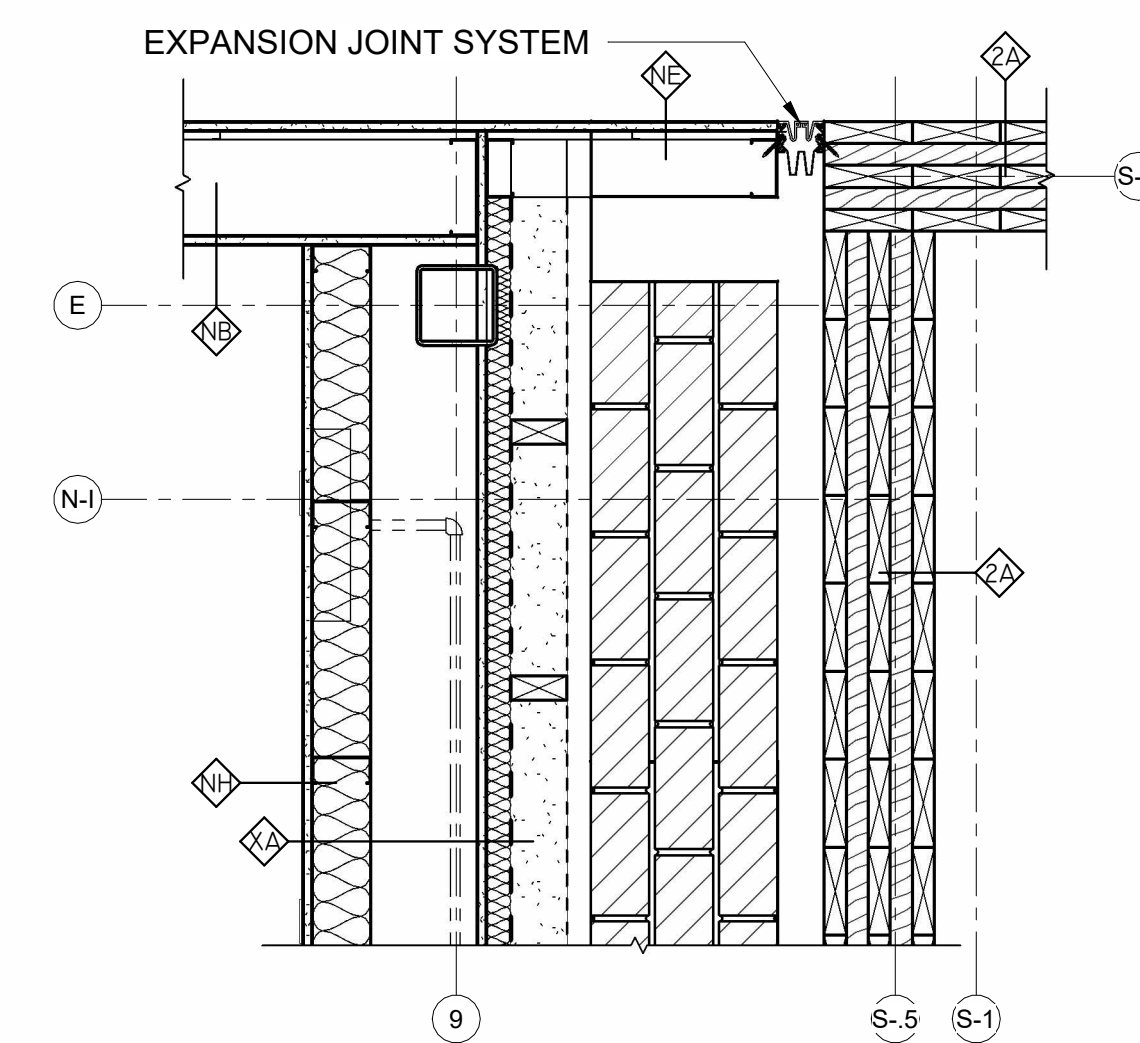

12 EXPANSION JOINT @ INTERIOR WALL
AE521 AE521 SCALE: 1" = 1'-0"

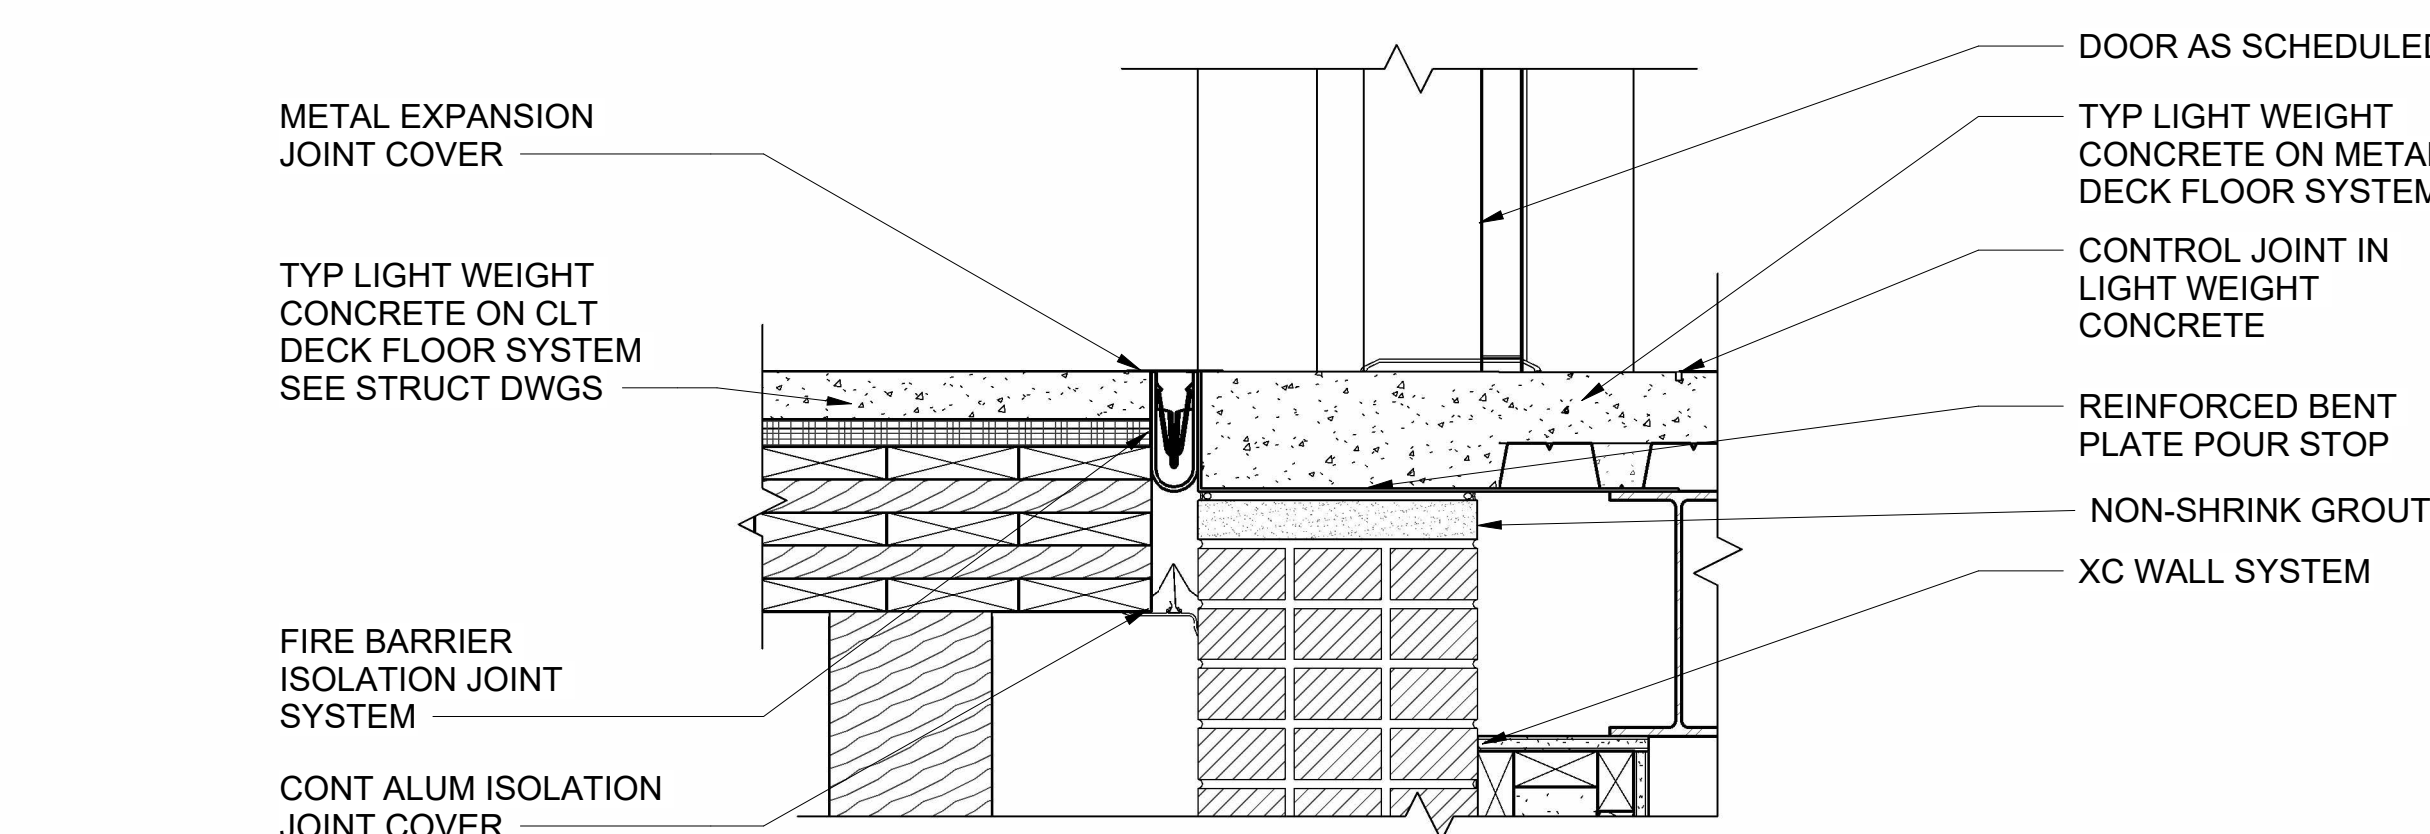

14 SECTION DETAIL AT EXP JOINT
AE301 AE521 SCALE: 1 1/2" = 1'-0"

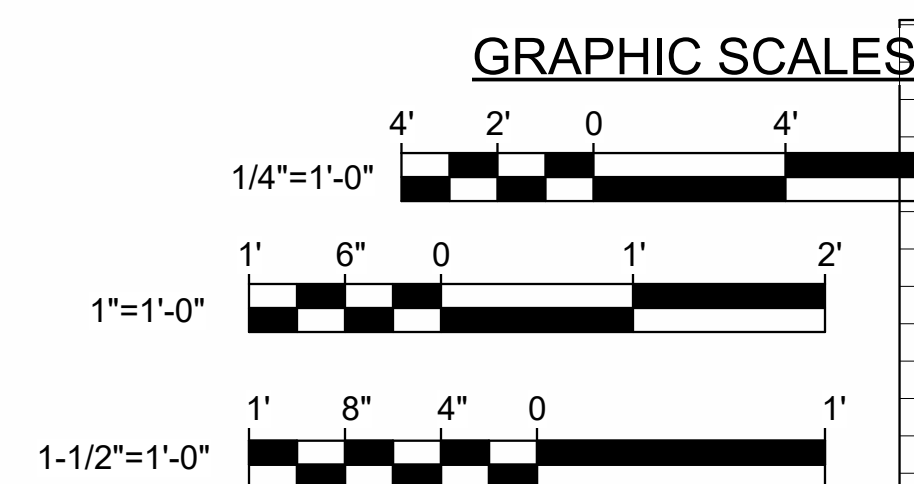

CHECK GRAPHIC SCALES BEFORE USING

NO.	DATE	DESCRIPTION	BY
6	03/13/2025	ADDENDUM NO.6	HMG
1	02/13/2025	ADDENDUM NO.1	HMG

DRAWN BY: MJD	CHECK BY: CET
DATE: 01/29/2025	

DEPARTMENT OF INLAND FISHERIES & WILDLIFE

TITLE: NEW OFFICE HEADQUARTERS

LOCATION: AUGUSTA, ME

TITLE THIS DWG: EXPANSION JOINT ENLARGED PLANS AND DETAILS

OAK POINT ASSOCIATES

DRAWING NO: AE521

SHEET NO: 139 OF 239

DOOR SCHEDULE - NORTH ADDITION																
NO.	DOOR						HARDWARE TYPE	FRAME			DETAILS			FIRE RATING	NOTES	DOOR SHADES
	WIDTH	HEIGHT	THICKNESS	TYPE	MAT	FINISH		TYPE	MAT	FINISH	HEAD	JAMB	SILL			
160	3' - 0"	7' - 0"	1 3/4"	A	HM	PNT	HW-3	2	HM	PNT	1/AE602	6/AE602	11/AE602			
161	3' - 0"	7' - 0"	1 3/4"	B	HM	PNT	HW-7	2	HM	PNT	1/AE602	6/AE602	11/AE602			
162	3' - 0"	7' - 0"	1 3/4"	A	HM	PNT	HW-3	2	HM	PNT	1/AE602	6/AE602	11/AE602			
163	3' - 0"	7' - 0"	1 3/4"	A	HM	PNT	HW-2	2	HM	PNT	1/AE602	6/AE602	11/AE602			
164	3' - 0"	7' - 0"	1 3/4"	B	HM	PNT	HW-7	2	HM	PNT	1/AE602	6/AE602	11/AE602			
166	3' - 0"	7' - 0"	1 3/4"	A	HM	PNT	HW-3	2	HM	PNT	1/AE602	6/AE602	11/AE602			
167A	3' - 0"	7' - 0"	1 3/4"	B	HM	PNT	HW-5B	2	HM	PNT	1/AE602	6/AE602	11/AE602			
167B	3' - 0"	7' - 0"	1 3/4"	B	HM	PNT	HW-7	2	HM	PNT	1/AE602	6/AE602	11/AE602			
168	3' - 0"	7' - 0"	1 3/4"	A	HM	PNT	HW-5A	2	HM	PNT	1/AE602	6/AE602	11/AE602			
169	3' - 0"	7' - 0"	1 3/4"	A	HM	PNT	HW-5A	2	HM	PNT	1/AE602	6/AE602	11/AE602			
170	3' - 0"	7' - 0"	1 3/4"	B	HM	PNT	HW-5A	2	HM	PNT	1/AE602	6/AE602	11/AE602			
171	3' - 0"	7' - 0"	1 3/4"	A	HM	PNT	HW-5A	2	HM	PNT	1/AE602	6/AE602	11/AE602			
272	3' - 0"	7' - 0"	1 3/4"	A	HM	PNT	HW-2	2	HM	PNT	1/AE602	6/AE602	11/AE602			
NO.	DOOR						HARDWARE TYPE	FRAME			DETAILS			FIRE RATING	NOTES	DOOR SHADES	
	WIDTH	HEIGHT	THICKNESS	TYPE	MAT	FINISH		TYPE	MAT	FINISH	HEAD	JAMB	SILL				
002	3' - 0"	7' - 0"	1 3/4"	A	HM	PNT	HW-3	2	HM	PNT	1/AE602	6/AE602	11/AE602	60 MIN			
003	3' - 0"	7' - 0"	1 3/4"	A	HM	PNT	HW-3	2	HM	PNT	1/AE602	6/AE602	11/AE602	60 MIN			
133	3' - 2"	7' - 2"	1 3/4"	G1	ALUM	HPC	HW-6	7	ALUM	HPC					DEMOUNTABLE PARTITION (NB)		
136	3' - 2"	7' - 2"	1 3/4"	G1	ALUM	HPC	HW-4	9	ALUM	HPC	1C/AE630	1D/AE630	1C/AE630		DEMOUNTABLE PARTITION SLIDING DOOR		
138	3' - 2"	7' - 2"	1 3/4"	G1	ALUM	HPC	HW-4	9	ALUM	HPC	1C/AE630	1D/AE630	1C/AE630		DEMOUNTABLE PARTITION SLIDING DOOR		
139	3' - 2"	7' - 2"	1 3/4"	G1	ALUM	HPC	HW-4	9	ALUM	HPC	1C/AE630	1D/AE630	1C/AE630		DEMOUNTABLE PARTITION SLIDING DOOR		
140	3' - 2"	7' - 2"	1 3/4"	G1	ALUM	HPC	HW-4	9	ALUM	HPC	1C/AE630	1D/AE630	1C/AE630		DEMOUNTABLE PARTITION SLIDING DOOR		
152	3' - 0 1/4"	7' - 0 3/8"	1 3/4"	G	ALUM	HPC	HW-6	12	ALUM	HPC	1F/AE630	1G/AE630	1F/AE630		DEMOUNTABLE PARTITION SWINGING DOOR		
153	3' - 2"	7' - 2"	1 3/4"	G1	ALUM	HPC	HW-4	9	ALUM	HPC	1C/AE630	1D/AE630	1C/AE630		DEMOUNTABLE PARTITION SLIDING DOOR		
154	3' - 2"	7' - 2"	1 3/4"	G1	ALUM	HPC	HW-4	9	ALUM	HPC	1C/AE630	1D/AE630	1C/AE630		DEMOUNTABLE PARTITION SLIDING DOOR		
155	3' - 0"	6' - 11 1/2"	1 3/4"	G	ALUM	HPC	HW-5	8	ALUM	HPC	1F/AE630	1G/AE630	1F/AE630		DEMOUNTABLE PARTITION SWINGING DOOR		
156	3' - 2"	7' - 2"	1 3/4"	G1	ALUM	HPC	HW-4	9	ALUM	HPC	1C/AE630	1D/AE630	1C/AE630		DEMOUNTABLE PARTITION SLIDING DOOR		
157	3' - 0"	6' - 11 1/2"	1 3/4"	G	ALUM	HPC	HW-5	8	ALUM	HPC	1F/AE630	1G/AE630	1F/AE630		DEMOUNTABLE PARTITION SWINGING DOOR		
158	3' - 0"	7' - 0"	1 3/4"	A	HM	PNT	HW-3	2	HM	PNT	1/AE602	6/AE602	11/AE602				
200	3' - 0"	7' - 0"	1 3/4"	B	HM	PNT	HW-7	2	HM	PNT	1/AE602	6/AE602	11/AE602	60 MIN			
239	3' - 2"	7' - 2"	1 3/4"	G1	ALUM	HPC	HW-6	9	ALUM	HPC	1C/AE630	1D/AE630	1C/AE630		DEMOUNTABLE PARTITION (NB)		
240	3' - 2"	7' - 2"	1 3/4"	G1	ALUM	HPC	HW-6	9	ALUM	HPC	1C/AE630	1D/AE630	1C/AE630		DEMOUNTABLE PARTITION (NB)		
241	3' - 2"	7' - 2"	1 3/4"	G1	ALUM	HPC	HW-4	9	ALUM	HPC	1C/AE630	1D/AE630	1C/AE630		DEMOUNTABLE PARTITION SLIDING DOOR		
242	3' - 2"	7' - 2"	1 3/4"	G1	ALUM	HPC	HW-4	9	ALUM	HPC	1C/AE630	1D/AE630	1C/AE630		DEMOUNTABLE PARTITION SLIDING DOOR		
243	3' - 2"	7' - 2"	1 3/4"	G1	ALUM	HPC	HW-6	9	ALUM	HPC	1C/AE630	1D/AE630	1C/AE630		DEMOUNTABLE PARTITION SLIDING DOOR		
244	3' - 2"	7' - 2"	1 3/4"	G1	ALUM	HPC	HW-4	9	ALUM	HPC	1C/AE630	1D/AE630	1C/AE630		DEMOUNTABLE PARTITION SLIDING DOOR		
246	3' - 2"	7' - 2"	1 3/4"	G1	ALUM	HPC	HW-4	9	ALUM	HPC	1C/AE630	1D/AE630	1C/AE630		DEMOUNTABLE PARTITION SLIDING DOOR		
270	3' - 0"	7' - 0"	1 3/4"	A	HM	PNT	HW-3	2	HM	PNT	1/AE602	6/AE602	11/AE602				
304	3' - 0"	7' - 0"	1 3/4"	A	HM	PNT	HW-2	2	HM	PNT	1/AE602	6/AE602	11/AE602				
305	3' - 2"	7' - 2"	1 3/4"	G1	ALUM	HPC	HW-6	7	ALUM	HPC					DEMOUNTABLE PARTITION SLIDING DOOR		
306	3' - 2"	7' - 2"	1 3/4"	G1	ALUM	HPC	HW-6	9	ALUM	HPC					DEMOUNTABLE PARTITION SLIDING DOOR		
306A	3' - 0"	7' - 0"	1 3/4"	A	HM	PNT	HW-3	2	HM	PNT	1/AE602	6/AE602	11/AE602	60 MIN			
307	3' - 2"	7' - 2"	1 3/4"	G1	ALUM	HPC	HW-6	7	ALUM	HPC					DEMOUNTABLE PARTITION SLIDING DOOR		
308	3' - 2"	7' - 2"	1 3/4"	G1	ALUM	HPC	HW-4	9	ALUM	HPC	1C/AE630	1D/AE630	1C/AE630		DEMOUNTABLE PARTITION SLIDING DOOR		
309	3' - 0 3/4"	7' - 0"	1 3/4"	G	ALUM	HPC	HW-6A	12	ALUM	HPC	1F/AE630	1G/AE630	1F/AE630		DEMOUNTABLE PARTITION SWINGING DOOR		
312	3' - 2"	7' - 2"	1 3/4"	G1	ALUM	HPC	HW-4	9	ALUM	HPC	1C/AE630	1D/AE630	1C/AE630		DEMOUNTABLE PARTITION SLIDING DOOR		
313	3' - 2"	7' - 2"	1 3/4"	G1	ALUM	HPC	HW-4	9	ALUM	HPC	1C/AE630	1D/AE630	1C/AE630		DEMOUNTABLE PARTITION SLIDING DOOR		
314	3' - 2"	7' - 2"	1 3/4"	G1	ALUM	HPC	HW-4	9	ALUM	HPC	1C/AE630	1D/AE630	1C/AE630		DEMOUNTABLE PARTITION SLIDING DOOR		
315	3' - 2"	7' - 2"	1 3/4"	G1	ALUM	HPC	HW-4	9	ALUM	HPC	1C/AE630	1D/AE630	1C/AE630		DEMOUNTABLE PARTITION SLIDING DOOR		
316	3' - 2"	7' - 2"	1 3/4"	G1	ALUM	HPC	HW-4	9	ALUM	HPC	1C/AE630	1D/AE630	1C/AE630		DEMOUNTABLE PARTITION SLIDING DOOR		
317	3' - 2"	7' - 2"	1 3/4"	G1	ALUM	HPC	HW-4	9	ALUM	HPC	1C/AE630	1D/AE630	1C/AE630		DEMOUNTABLE PARTITION SLIDING DOOR		
318	3' - 2"	7' - 2"	1 3/4"	G1	ALUM	HPC	HW-4	9	ALUM	HPC	1C/AE630	1D/AE630	1C/AE630		DEMOUNTABLE PARTITION SLIDING DOOR		
319	3' - 2"	7' - 2"	1 3/4"	G1	ALUM	HPC	HW-4	9	ALUM	HPC	1C/AE630	1D/AE630	1C/AE630		DEMOUNTABLE PARTITION SLIDING DOOR		
327	3' - 2"	7' - 2"	1 3/4"	G1	ALUM	HPC	HW-4	9	ALUM	HPC	1C/AE630	1D/AE630	1C/AE630		DEMOUNTABLE PARTITION SLIDING DOOR		
328	3' - 2"	7' - 2"	1 3/4"	G1	ALUM	HPC	HW-4	9	ALUM	HPC	1C/AE630	1D/AE630	1C/AE630		DEMOUNTABLE PARTITION SLIDING DOOR		
330	3' - 0"	7' - 0"	1 3/4"	A	HM	PNT	HW-3	2	HM	PNT	1/AE602	6/AE602	11/AE602				

DOOR SCHEDULE - SOUTH ADDITION																	
NO.	DOOR						HARDWARE TYPE	FRAME			DETAILS			FIRE RATING	NOTES	DOOR SHADES	
	WIDTH	HEIGHT	THICKNESS	TYPE	MAT	FINISH		TYPE	MAT	FINISH	HEAD	JAMB	SILL				
004	3'-0"	7'-0"	1 3/4"	A	HM	PNT	HW-3	2	HM	PNT	1/AE602	6/AE602	11/AE602	60 MIN			
005	3'-0"	7'-0"	1 3/4"	A	HM	PNT	HW-3	2	HM	PNT	1/AE602	6/AE602	11/AE602				
006	3'-0"	7'-0"	1 3/4"	A	HM	PNT	HW-3	2	HM	PNT	1/AE602	6/AE602	11/AE602				
100A	6'-0"	7'-0"	1 3/4"	D	ALUM	HPC	EH-1	S1A	ALUM	HPC	3C/AE621	3D/AE621	3F/AE621				
100B	6'-0"	7'-0"	1 3/4"	D	ALUM	HPC	EH-2	S2A	ALUM	HPC	3C/AE621	3D/AE621	3F/AE621				
101	3'-0"	7'-0"	1 3/4"	A	HM	PNT	HW-2	2	HM	PNT	1/AE602	6/AE602	11/AE602				
102A	3'-0"	7'-0"	1 3/4"	B	HM	PNT	HW-5B	2	HM	PNT	1/AE602	6/AE602	11/AE602	60 MIN			
102B	3'-0"	7'-0"	1 3/4"	B	HM	PNT	HW-5B	2	HM	PNT	1/AE602	6/AE602	11/AE602				
102C	3'-0"	7'-0"	1 3/4"	B	HM	PNT	HW-5B	2	HM	PNT	1/AE602	6/AE602	11/AE602				
103	3'-0"	7'-0"	1 3/4"	A	HM	PNT	HW-2	2	HM	PNT	1/AE602	6/AE602	11/AE602				
104	6'-0"	7'-0"	1 3/4"	D	HM	PNT	HW-7A	2	HM	PNT	1/AE602	6/AE602	11/AE602				
105	6'-0"	7'-0"	1 3/4"	A	HM	PNT	HW-3A	4	HM	PNT	1/AE602	6/AE602	11/AE602				
106	3'-0"	7'-0"	1 3/4"	A	HM	PNT	HW-2	2	HM	PNT	1/AE602	6/AE602	11/AE602				
107	3'-0"	7'-0"	1 3/4"	A	HM	PNT	HW-2	2	HM	PNT	1/AE602	6/AE602	11/AE602				
108	3'-0"	7'-0"	1 3/4"	A	HM	PNT	HW-2	2	HM	PNT	1/AE602	6/AE602	11/AE602				
207	3'-0"	7'-0"	1 3/4"	A	HM	PNT	HW-2	2	HM	PNT	1/AE602	6/AE602	11/AE602	60 MIN			
208	3'-0"	7'-0"	1 3/4"	G	ALUM	HPC	HW-6A	12	ALUM	HPC	1F/AE630	1G/AE630	1F/AE630		DEMOUNTABLE PARTITION SWINGING DOOR		
209	3'-2"	7'-2"	1 3/4"	G1	ALUM	HPC	HW-4	9	ALUM	HPC					DEMOUNTABLE PARTITION (NB)		
210	3'-2"	7'-2"	1 3/4"	G1	ALUM	HPC	HW-4	9	ALUM	HPC					DEMOUNTABLE PARTITION (NB)		
211	3'-2"	7'-2"	1 3/4"	G1	ALUM	HPC	HW-4	9	ALUM	HPC					DEMOUNTABLE PARTITION (NB)		
212	3'-0"	7'-0"	1 3/4"	A	HM	PNT	HW-2	2	HM	PNT	1/AE602	6/AE602	11/AE602				
213	3'-0"	7'-0"	1 3/4"	A	HM	PNT	HW-2	2	HM	PNT	1/AE602	6/AE602	11/AE602				
214	3'-0"	7'-0"	1 3/4"	A	HM	PNT	HW-3	2	HM	PNT	1/AE602	6/AE602	11/AE602				
215A	3'-0"	7'-0"	1 3/4"	B	HM	PNT	HW-7	2	HM	PNT	1/AE602	6/AE602	11/AE602				
215B	3'-0"	7'-0"	1 3/4"	B	HM	PNT	HW-7	2	HM	PNT	1/AE602	6/AE602	11/AE602				
216	3'-0"	7'-0"	1 3/4"	B	HM	PNT	HW-8	2	HM	PNT	1/AE602	6/AE602	11/AE602				
217	3'-2"	7'-2"	1 3/4"	G1	ALUM	HPC	HW-4	9	ALUM	HPC	1/AE602	6/AE602	11/AE602		DEMOUNTABLE PARTITION (NB)		
219	3'-2"	7'-2"	1 3/4"	G1	ALUM	HPC	HW-4	9	ALUM	HPC	1C/AE630	1D/AE630	1C/AE630		DEMOUNTABLE PARTITION SLIDING DOOR		
220	3'-2"	7'-2"	1 3/4"	G1	ALUM	HPC	HW-4	9	ALUM	HPC	1C/AE630	1D/AE630	1C/AE630		DEMOUNTABLE PARTITION SLIDING DOOR		
222	3'-2"	7'-2"	1 3/4"	G1	ALUM	HPC	HW-4	9	ALUM	HPC	1C/AE630	1D/AE630	1C/AE630		DEMOUNTABLE PARTITION SLIDING DOOR		
223	3'-2"	7'-2"	1 3/4"	G1	ALUM	HPC	HW-4	9	ALUM	HPC	1C/AE630	1D/AE630	1C/AE630		DEMOUNTABLE PARTITION SLIDING DOOR		
224	3'-2"	7'-2"	1 3/4"	G1	ALUM	HPC	HW-4	8	ALUM	HPC	1C/AE630	1D/AE630	1C/AE630		DEMOUNTABLE PARTITION SLIDING DOOR		
225	3'-2"	7'-2"	1 3/4"	G1	ALUM	HPC	HW-4	9	ALUM	HPC	1C/AE630	1D/AE630	1C/AE630		DEMOUNTABLE PARTITION SLIDING DOOR		
226	3'-2"	7'-2"	1 3/4"	G1	ALUM	HPC	HW-4	9	ALUM	HPC	1C/AE630	1D/AE630	1C/AE630		DEMOUNTABLE PARTITION SLIDING DOOR		
228	3'-2"	7'-2"	1 3/4"	G1	ALUM	HPC	HW-4	9	ALUM	HPC	1C/AE630	1D/AE630	1C/AE630		DEMOUNTABLE PARTITION SLIDING DOOR		
229	3'-0"	7'-0"	1 3/4"	A	HM	PNT	HW-3	2	HM	PNT	1/AE602	6/AE602	11/AE602				
230	3'-2"	7'-2"	1 3/4"	G1	ALUM	HPC	HW-4	9	ALUM	HPC	1C/AE630	1D/AE630	1C/AE630		DEMOUNTABLE PARTITION SLIDING DOOR		
231A	3'-0"	7'-0"	1 3/4"	B	HM	PNT	HW-7	2	HM	PNT	3/AE603	4/AE603	5/AE603				
231B	3'-0"	7'-0"	1 3/4"	B	HM	PNT	HW-7	2	HM	PNT	1/AE602	6/AE602	11/AE602				
232	3'-2"	7'-2"	1 3/4"	G1	ALUM	HPC	HW-4	8	ALUM	HPC	1C/AE630	1D/AE630	1C/AE630		DEMOUNTABLE PARTITION SLIDING DOOR		
233	3'-2"	7'-2"	1 3/4"	G1	ALUM	HPC	HW-4	9	ALUM	HPC	1C/AE630	1D/AE630	1C/AE630		DEMOUNTABLE PARTITION SLIDING DOOR		
234	3'-2"	7'-2"	1 3/4"	G1	ALUM	HPC	HW-4	9	ALUM	HPC	1C/AE630	1D/AE630	1C/AE630		DEMOUNTABLE PARTITION SLIDING DOOR		
235	3'-2"	7'-2"	1 3/4"	G1	ALUM	HPC	HW-4	9	ALUM	HPC	1C/AE630	1D/AE630	1C/AE630		DEMOUNTABLE PARTITION SLIDING DOOR		
237	3'-0"	7'-0"	1 3/4"	A	HM	PNT	HW-3	2	HM	PNT	1/AE602	6/AE602	11/AE602	60 MIN			
238	3'-0"	7'-0"	1 3/4"	A	HM	PNT	HW-3	2	HM	PNT	1/AE602	6/AE602	11/AE602	60 MIN			
301	3'-0"	7'-0"	1 3/4"	A	HM	PNT	HW-2	2	HM	PNT	1/AE602	6/AE602	11/AE602				
302	3'-0"	7'-0"	1 3/4"	A	HM	PNT	HW-3	2	HM	PNT	1/AE602	6/AE602	11/AE602				
303	3'-0"	7'-0"	1 3/4"	A	HM	PNT	HW-3	2	HM	PNT	1/AE602	6/AE602	11/AE602				
E1A	3'-0"	7'-0"	1 3/4"	A	HM	PNT	HW-3	2	HM	PNT	1/AE602	6/AE602	11/AE602	120 MIN			
M1	3'-0"	7'-0"	1 3/4"	A	HM	PNT	HW-1	2	HM	PNT	1/AE602	6/AE602	11/AE602	60 MIN			
M2	3'-0"	7'-0"	1 3/4"	A	HM	PNT	HW-1	2	HM	PNT	1/AE602	6/AE602	11/AE602	60 MIN			

DOOR SCHEDULE NOTES:


1. PROVIDE POWERED DOOR OPENER.
2. INSULATED DOOR(S).
3. PROVIDE (1) ONE PAIR OF ELECTRIC LATCH RETRACTORS FOR USE IN BUILDING SECURITY SYSTEM.

GENERAL NOTES:

1. SEE SHEET AE620 AND ASE621 FOR ALUMINUM CURTAIN WALL AND STOREFRONT FRAME TYPES AND DETAILS REFERENCE.
2. SEE SHEETS G-108 THRU G-111 FOR COORDINATION OF FIRE RATING, SMOKE RATING, SELF-LATCHING, AND SELF-CLOSING REQUIREMENTS.
3. UNDERCUT INTERIOR DOORS 3/4" (MAX ALLOWED BY NFPA 80).
4. PROVIDE DOORS WITH CONSTRUCTION CORES.
5. SEE SHEET AE602 FOR DOOR TYPES.
6. SEE SHEET AE630 FOR DEMOUNTABLE PARTITION FRAME TYPES AND DETAILS.

DOOR SCHEDULE LEGEND:

ALUM = ALUMINUM	NAT = NATURAL FINISH	WD = WOOD
GALV = GALVANIZED	PNT = PAINT	
HM = HOLLOW METAL	SS = STAINLESS STEEL	
GPC = HIGH PERFORMANCE COATING	STN = STAIN	
MFR = MANUFACTURER	STL = STEEL	

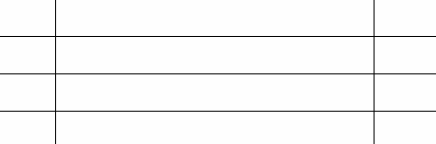						
6	03/13/2025	ADDENDUM NO. 6	HMG			<div style="display: flex; justify-content: space-between;"> <div> <p>DEPARTMENT OF INLAND FISHERIES & WILDLIFE</p> <p>TITLE NEW OFFICE HEADQUARTERS</p> <p>LOCATION AUGUSTA, ME</p> <p>TITLE THIS DWG DOOR SCHEDULE</p> </div> <div style="text-align: right;"> <p>OK POINT ASSOCIATES</p> <p>AE601</p> <p><small>207-293-9193</small></p> </div> </div>
3	02/27/2025	ADDENDUM NO. 3	HMG	DRAWN BY: MJD		
1	02/13/2025	ADDENDUM NO. 1	HMG	CHECKED BY: CET		
NO.	DATE	DESCRIPTION	BY	NO.		
REVISIONS				DATE	01/29/2025	

DOOR SCHEDULE - EXTERIOR/STAIRS																
NO.	DOOR						HARDWARE TYPE	FRAME			DETAILS			FIRE RATING	NOTES	DOOR SHADES
	WIDTH	HEIGHT	THICKNESS	TYPE	MAT	FINISH		TYPE	MAT	FINISH	HEAD	JAMB	SILL			
E01	6' - 0"	7' - 0"	1 3/4"	D	ALUM	HPC	EH-1	S1	ALUM	HPC	3C/AE621	3D/AE621	3F/AE621			
E02	3' - 0"	7' - 0"	1 3/4"	D	ALUM	HPC	EH-3	C3	ALUM	HPC	1C/AE621	1D/AE621	1F/AE621			
E03	6' - 0"	7' - 0"	1 3/4"	D	ALUM	HPC	EH-2	S2	ALUM	HPC	3C/AE621	3D/AE621	3F/AE621			
E04	3' - 0"	7' - 0"	1 3/4"	D	ALUM	HPC	EH-3	C4	ALUM	HPC	1C/AE621	1D/AE621	1F/AE621			
E05	3' - 6"	7' - 6"	1 3/8"	H	WD	STN	EH-4	6	WD	PNT	3/AE603	4/AE603	5/AE603			
E06	3' - 6"	7' - 6"	1 3/8"	H	WD	STN	EH-4	6	WD	PNT	3/AE603	4/AE603	5/AE603			
E07	3' - 0"	7' - 0"	1 3/4"	D	ALUM	HPC	EH-3	C2	ALUM	HPC	1C/AE621	1D/AE621	1F/AE621			
E08	3' - 0"	7' - 0"	1 3/4"	D	ALUM	HPC	EH-3	1	HM	PNT	6/AE603	7/AE603	8/AE603			
E09	3' - 0"	7' - 0"	1 3/4"	D	ALUM	HPC	EH-3	1	HM	PNT	6/AE603	7/AE603	8/AE603			
E10	3' - 0"	7' - 0"	1 3/4"	D	ALUM	HPC	EH-3	1	HM	PNT	6/AE603	7/AE603	8/AE603			
E11	9' - 4"	9' - 0"	2"	J	STL	GALV	EH-5	MFR	ALUM	HPC	1/AE603	2/AE603	1/AE603		OVERHEAD DOOR	
E12	3' - 0"	7' - 0"	1 3/4"	A	HM	PNT	EH-3	1	HM	PNT	6/AE603	7/AE603	8/AE603			
E13	6' - 0"	7' - 0"	1 3/4"	D	ALUM	HPC	EH-2	S3	ALUM	HPC	3C/AE621	3D/AE621	3F/AE621			
S1A	3' - 0"	7' - 0"	1 1/2"	C	WD	NAT	HW-1	2	HM	PNT	3/AE602	8/AE602	11/AE602	120 MIN		
S1B	3' - 0"	7' - 0"	1 1/2"	C	HM	PNT	HW-1	4	HM	PNT	3/AE602	8/AE602	11/AE602	120 MIN		
S1C	3' - 0"	7' - 0"	1 1/2"	C	HM	PNT	HW-1	4	HM	PNT	3/AE602	8/AE602	11/AE602	120 MIN		
S1D	3' - 0"	7' - 0"	1 1/2"	C	HM	PNT	HW-1	4	HM	PNT	3/AE602	8/AE602	11/AE602	120 MIN		
S2A	3' - 0"	7' - 0"	1 1/2"	C	HM	PNT	HW-1	4	HM	PNT	5/AE602	10/AE602	11/AE602	120 MIN		
S2B	3' - 0"	7' - 0"	1 1/2"	C	HM	PNT	HW-1	4	HM	PNT	5/AE602	10/AE602	11/AE602	60 MIN		
S3A	3' - 0"	7' - 0"	1 1/2"	C	HM	PNT	HW-1	4	HM	PNT	4/AE602	9/AE602	11/AE602	120 MIN		
S3A1	3' - 0"	7' - 0"	1 1/2"	C	HM	PNT	HW-1	4	HM	PNT	4/AE602	9/AE602	11/AE602	120 MIN		
S3B	3' - 0"	7' - 0"	1 1/2"	C	HM	PNT	HW-1	4	HM	PNT	3/AE602	8/AE602	11/AE602	120 MIN		
S3B1	3' - 0"	7' - 0"	1 1/2"	C	HM	PNT	HW-1	4	HM	PNT				120 MIN		
S3C	3' - 0"	7' - 0"	1 1/2"	C	HM	PNT	HW-1	4	HM	PNT	3/AE602	8/AE602	11/AE602	120 MIN		
S3C1	3' - 0"	7' - 0"	1 1/2"	C	HM	PNT	HW-1	4	HM	PNT				120 MIN		
S3D	3' - 0"	7' - 0"	1 1/2"	C	HM	PNT	HW-1	4	HM	PNT				120 MIN		

DOOR SCHEDULE NOTES:


- PROVIDE POWERED DOOR OPENER.
- INSULATED DOOR(S).
- PROVIDE (1) ONE PAIR OF ELECTRIC LATCH RETRACTORS FOR USE IN BUILDING SECURITY SYSTEM.

GENERAL NOTES:

- SEE SHEET AE620 AND ASE621 FOR ALUMINUM CURTAIN WALL AND STOREFRONT FRAME TYPES AND DETAILS REFERENCE.
- SEE SHEETS G-108 THRU G-111 FOR COORDINATION OF FIRE RATING, SMOKE RATING, SELF-LATCHING, AND SELF-CLOSING REQUIREMENTS.
- UNDERCUT INTERIOR DOORS 3/4" (MAX ALLOWED BY NFPA 80).
- PROVIDE DOORS WITH CONSTRUCTION CORES.
- SEE SHEET AE602 FOR DOOR TYPES.
- SEE SHEET AE630 FOR DEMOUNTABLE PARTITION FRAME TYPES AND DETAILS.


DOOR SCHEDULE LEGEND:

ALUM = ALUMINUM
GALV = GALVANIZED
HM = HOLLOW METAL
HPC = HIGH PERFORMANCE COATING
MFR = MANUFACTURER
NAT = NATURAL FINISH
PNT = PAINT
SS = STAINLESS STEEL
STN = STAIN
STL = STEEL
WD = WOOD

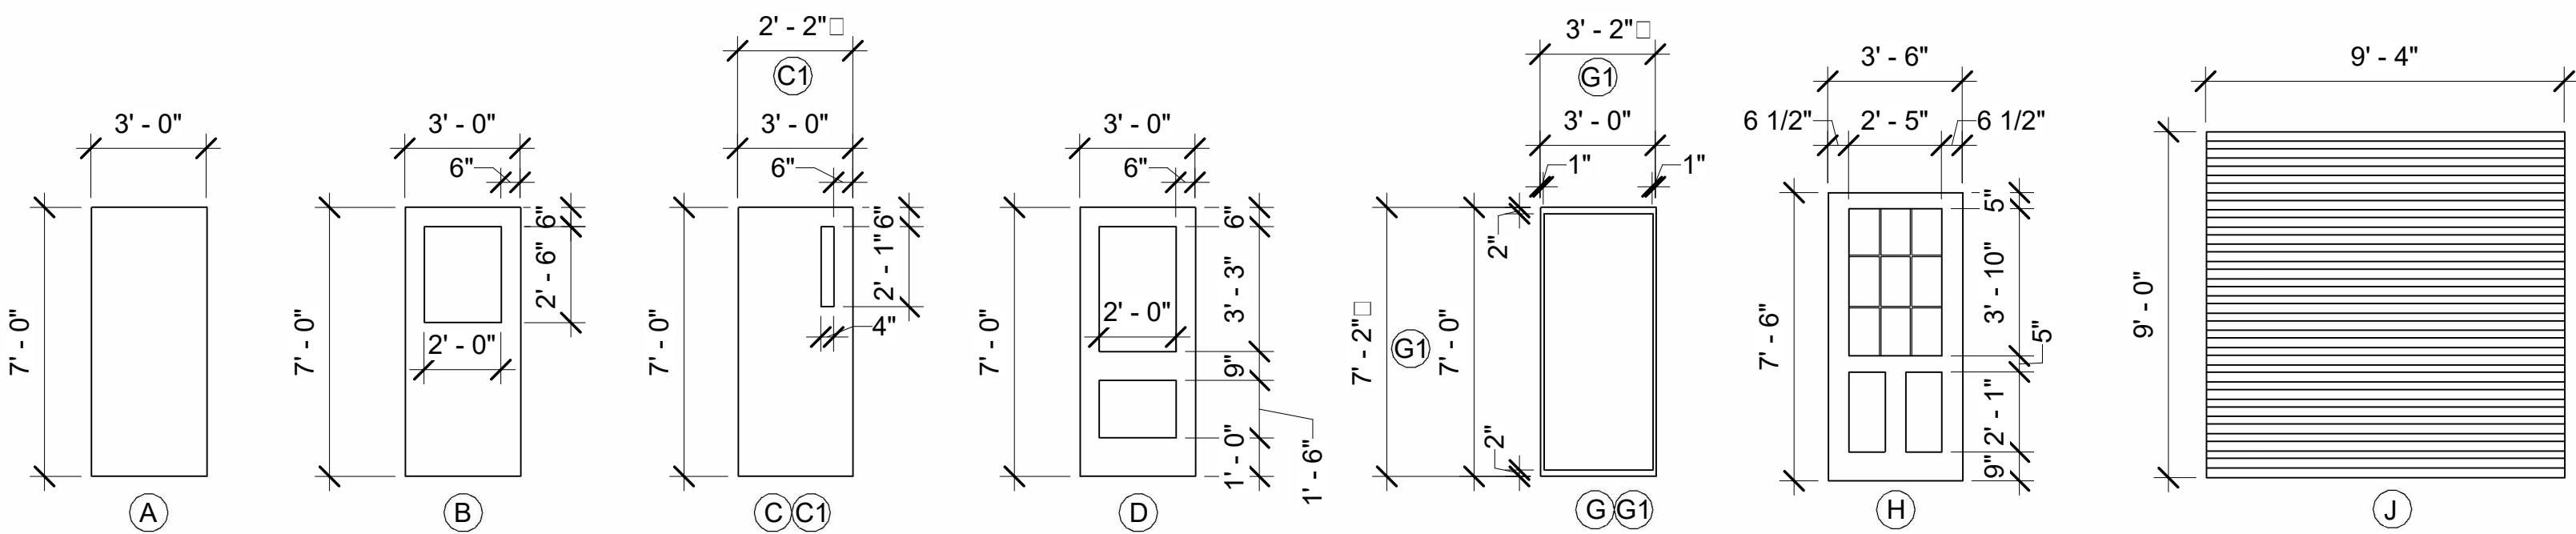



DOOR TYPES

SCALE: 1/4"=1'-0"

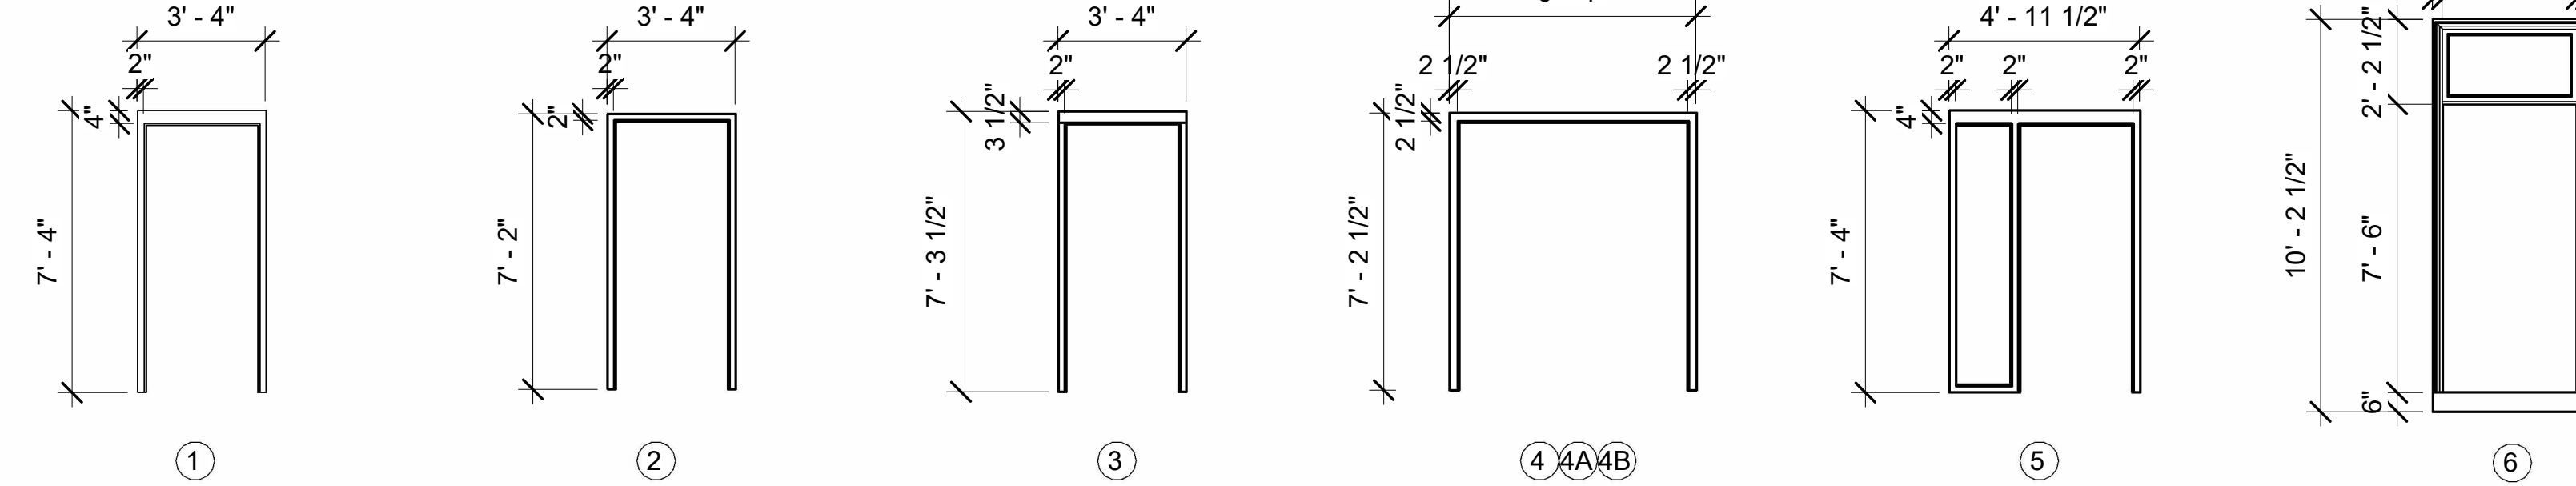

FRAME TYPES

SCALE: 1/4"=1'-0"

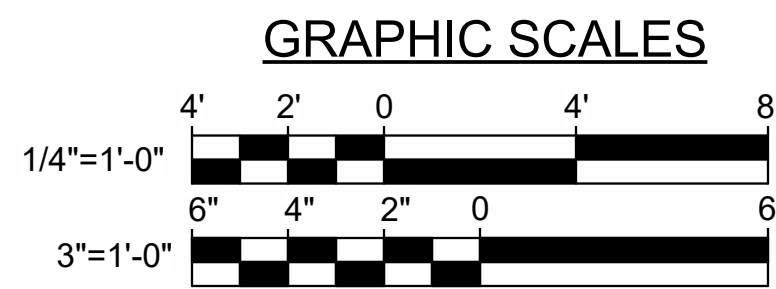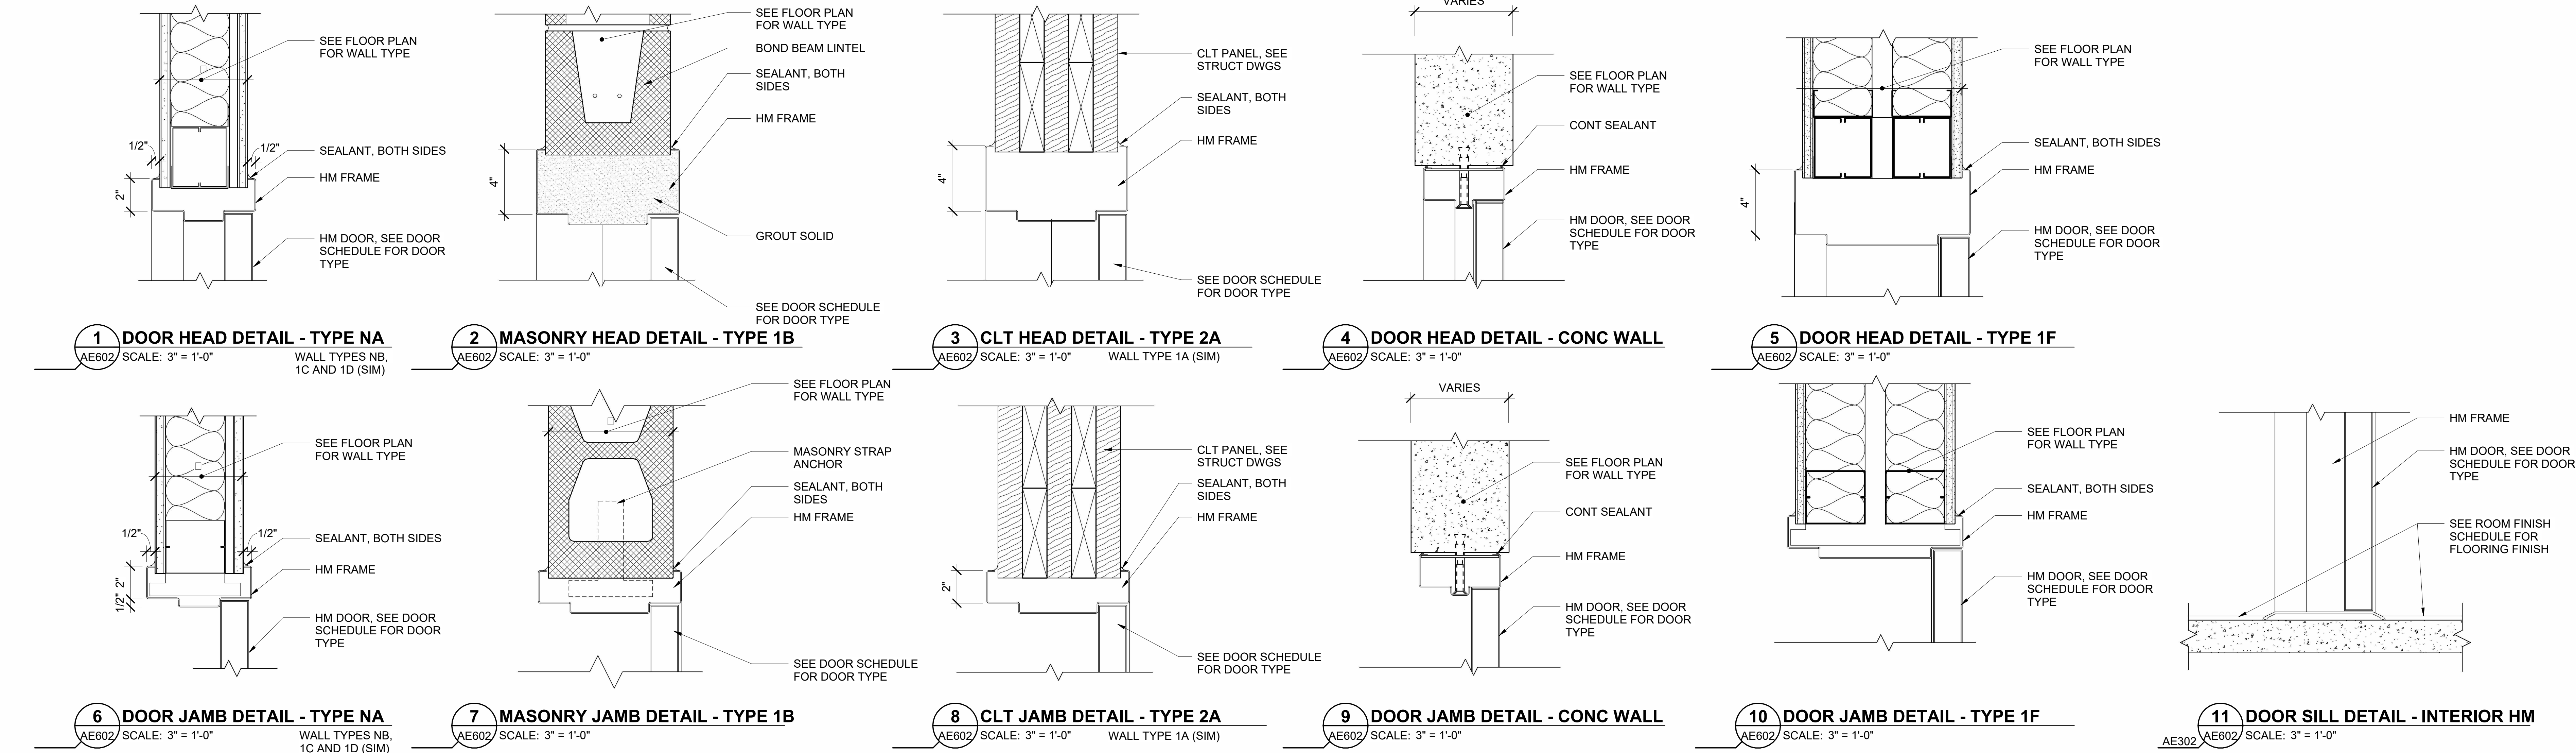

REVISIONS				DATE	DESCRIPTION	BY	NO.
NO.	DATE	DESCRIPTION	BY				
6	03/13/2025	ADDENDUM NO.6	HMG				
3	02/27/2025	ADDENDUM NO.3	HMG				
1	02/13/2025	ADDENDUM NO.1	HMG				
				DATE	01/29/2025		

DEPARTMENT OF INLAND FISHERIES & WILDLIFE

TITLE NEW OFFICE HEADQUARTERS


LOCATION AUGUSTA, ME

TITLE THIS DWG. DOOR FRAME TYPE AND DOOR DETAILS

OAK POINT ASSOCIATES

AE602

144 OF 239

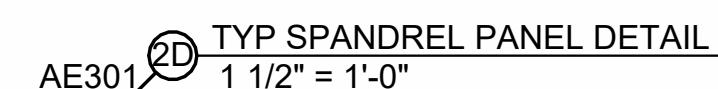

A diagram illustrating the conversion of 1-1/2 inches to 1 foot minus 0 inches. It shows a ruler with markings at 1', 8", 4", 0, and 1'. The text "1-1/2"=1'-0"" is written to the left of the ruler.

CHECK GRAPHIC SCALE BEFORE USING

[illegible]