BATHROOM INTERIORS GENERAL NOTES 1. REFER TO FINISH PLAN AND SCHEDULE FOR ACCENT PAINT AT LOBBY 1. SOLID SURFACE SHOWER INSERT UNIT. SEE DETAIL XXX REFER TO FINISH PLANS FOR FLOOR MATERIAL TRANSITIONS AND FOR FLOOR 1.1 EXISTING FIBERGLASS SHOWER UNIT TO BE REMOVED AND REINSTALLED PATTERN PLANS. 2. SOLID SURFACE SHOWER SURROUND AND FLOOR, SEE DETAIL XXX 3. TILE MEMBRANE USED IN CONJUNCTION WITH FLOOR TILE (FT-1, FT-1), 2.2 ADA UNIT WITH SOLID SURFACE SHOWER AND FLOOR INSTALL; REFER TO SPECIFICATIONS 3. EXISTING TILE TO REMAIN 4. ALTERNATIVE #X- REPLACE WITH COUNTER APRON AND NEW PLAM APRON PROVIDE FLOOR/WALL TRANSITION TRIM BETWEEN FLOOR AND WALL TILE; REFER TO SPECIFICATIONS 5. ALL SALVAGED PLUMBING FIXTURES, MIRRORS, STALL DIVIDERS AND TOILET ACCESSORIES TO BE REINSTALLED AFTER INFILL IS COMPLETE 5. [P*] INDICATES ACCENT WALL COLORS 6. REFER TO RCP FOR ACCENT PAINT COLORS 7. REFER TO FINISH PLANS FOR WALL FINISHES. A500 - EXISTING MIRROR EXISTING COLUMN - NEW TILE[WT-1] — INFILL WALL, - ADA GRAB BARS IN ADA RESTROOM ONLY — ADA GRAB BARS IN ADA RESTROOM ONLY NEW ADA TOILET NEW ADA SINK TEMPERED ——— C4 TYP. RESTROOM- WEST
1/4" = 1'-0"

TYP. RESTROOM- WALL OPPOSITE WET WALL
1/4" = 1'-0" NEW GWB FURRING WALL WITH PAINT. SEE FINISH PLAN — ELECTRONIC KEY BOX, O.F.O.I, PROVIDE POWER, DATA NEW CASEWORK, [PT-4] — — [P] REFER TO FINISH PLAN WALL MOUNTED TV, O.F.O.I EXISTING WINDOWS
TO REMAIN PROVIDE BLOCKING AS REQ'D. A2 A700 A700 [WC-1] 2 | 12-12-23 | Addendum PROVIDE OPEN TO BEYOND POWER/DATA < WB-1 TO BEYOND 6' - 0" TEMPERED TEMPERED PROVIDE WHITEBOARD, INSTALL PER MANUFACTURER'S INSTRUCTIONS. Z-CLIPS. — NEW RADIATOR, SEE MECH. DRAWINGS ----NEW RADIATOR, SEE MECH. DRAWINGS — PROVIDE POWER -EXISTING RADIATOR, SEE MECH. DRAWINGS ----B5 STUDENT LOUNGE- EAST B2 STUDENT LOUNGE- SOUTH
1/4" = 1'-0" PAINT EXISTING STAINED PANELS [PT-4] — - 2" HARDWOOD TRIM, PAINTED SPECIATLY BACK-BOX ON STROFERONT FOR FIRE — WALL MOUNTED TV, O.F.O.I — CENTER ALL WALL 🕨 A500 - NEW WINDOWS INFILL WITH PAINTED HARDWOOD VENEER PLYWOOD PANEL [PT-4] — — PROVIDE POWER/DATA MOUNTED DEVICES ON END CAP ALARM PULL STATION _ ALUM.WINDOW FRAME 11/22/2023 EXISTING WINDOWS ackslash TACKABLE SURFACE $-\!\!\!-\!\!\!\!-$ | [PT-4] NEW HARDWOOD — (4) 1'-5 1/2" X 3 1/2" LINEAR GRILLES, BUTT JOINT FRAMES VENEER PLYWOOD PANEL PAINTED HARDWOOD SHIPLAP CEILING TO FLOOR 8 1/2 3' - 2" 3' - 2" 8" V.I.E. ☐ PAINTED HARDWOOD TRIM A3 LOBBY- WEST
1/4" = 1'-0" SHEET **INTERIOR WALL FINISH NOTES** REFER TO WALL FINISH PLAN FOR INTERIOR FINISHES ALL MATERIALS CALLED OUT ARE NEW REFER TO TYPICAL MOUNTING HEIGHTS AND REQUIRED CLEARANCES ON ALL STOREFRONT GLAZING PANES TO BE TEMPERED GLASS. REFER TO SPEC FOR GLASS TYPES

FINISH GENERAL NOTES

CHA Architecture, P.C. 49 Dartmouth Street Portland, Maine 04101 207.775.1059 . www.chacompanies.com

> COPYRIGHT CHA Architecture Reuse or reproduction of the contents of this document is not permitted without written permission of CHA Architecture, P.0

#3 1 12-5-23 Addendum N Date Descriptio Revision Schedule

NOT FOR


CONSTRUCTION


JOB NO. 076982


ISSUE 100% CONSTRUCTION DOCUMENTS -ISSUED FOR BIDDING


INTERIOR

ELEVATIONS

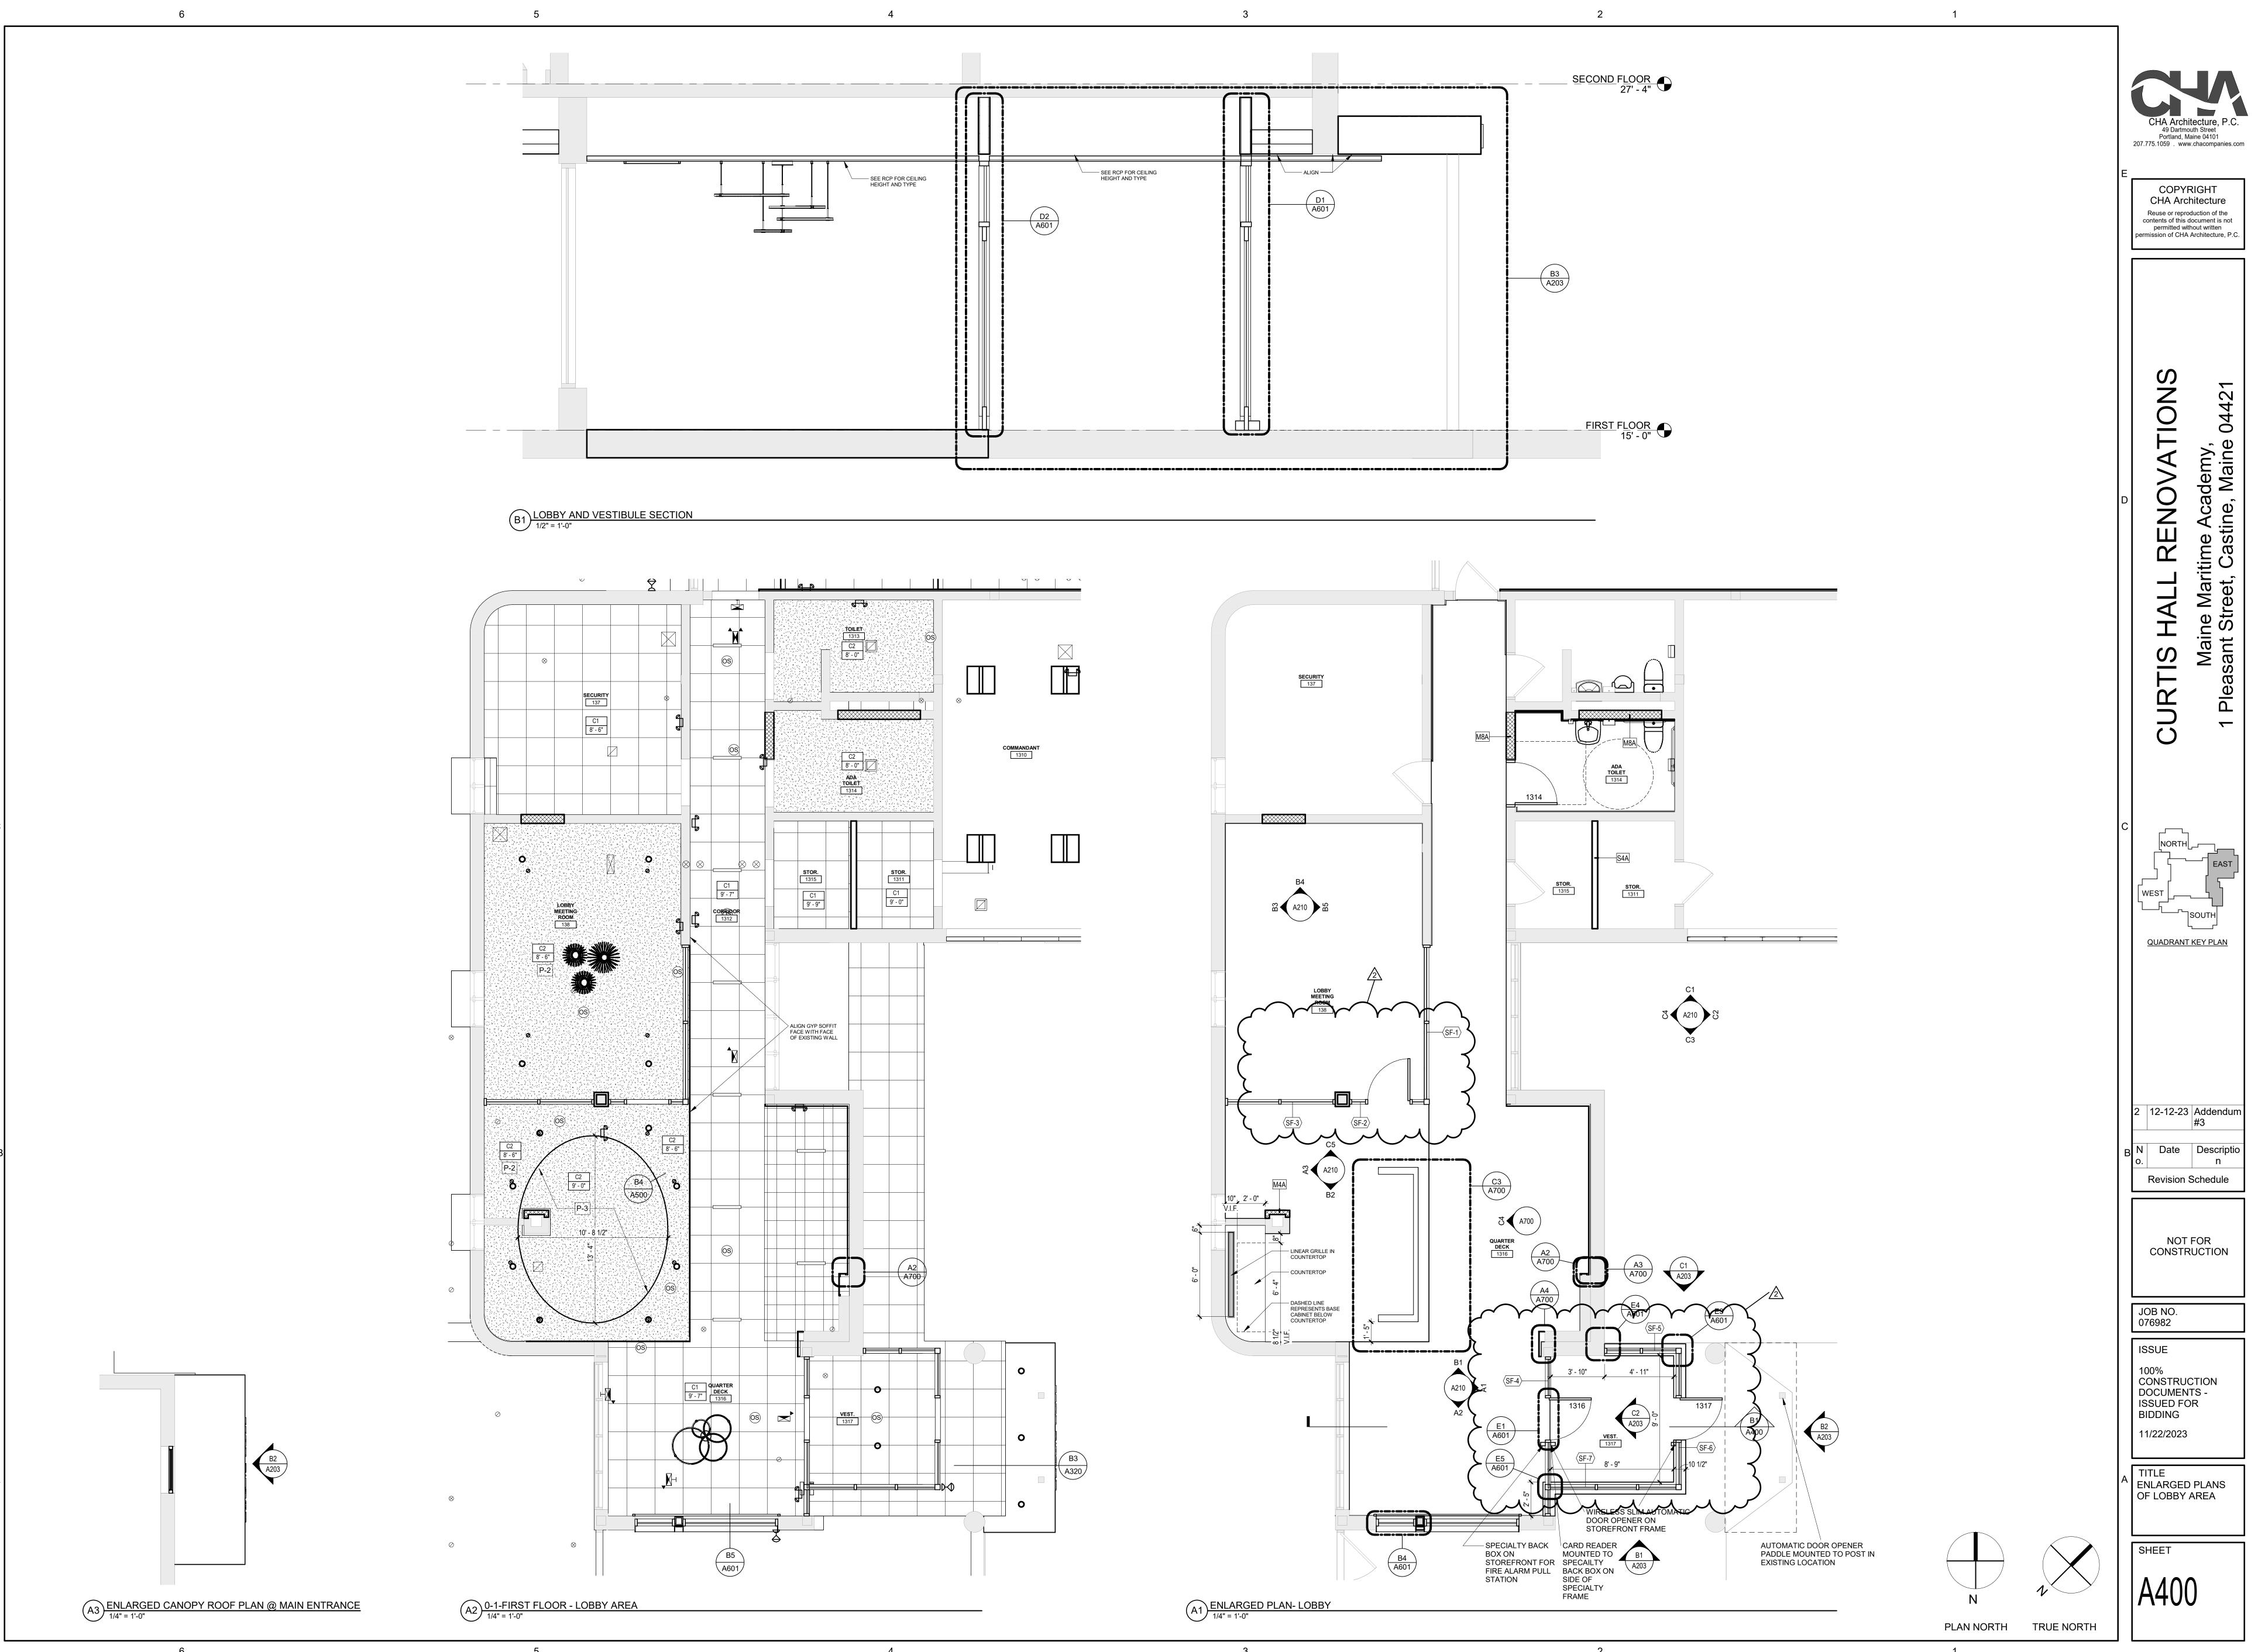

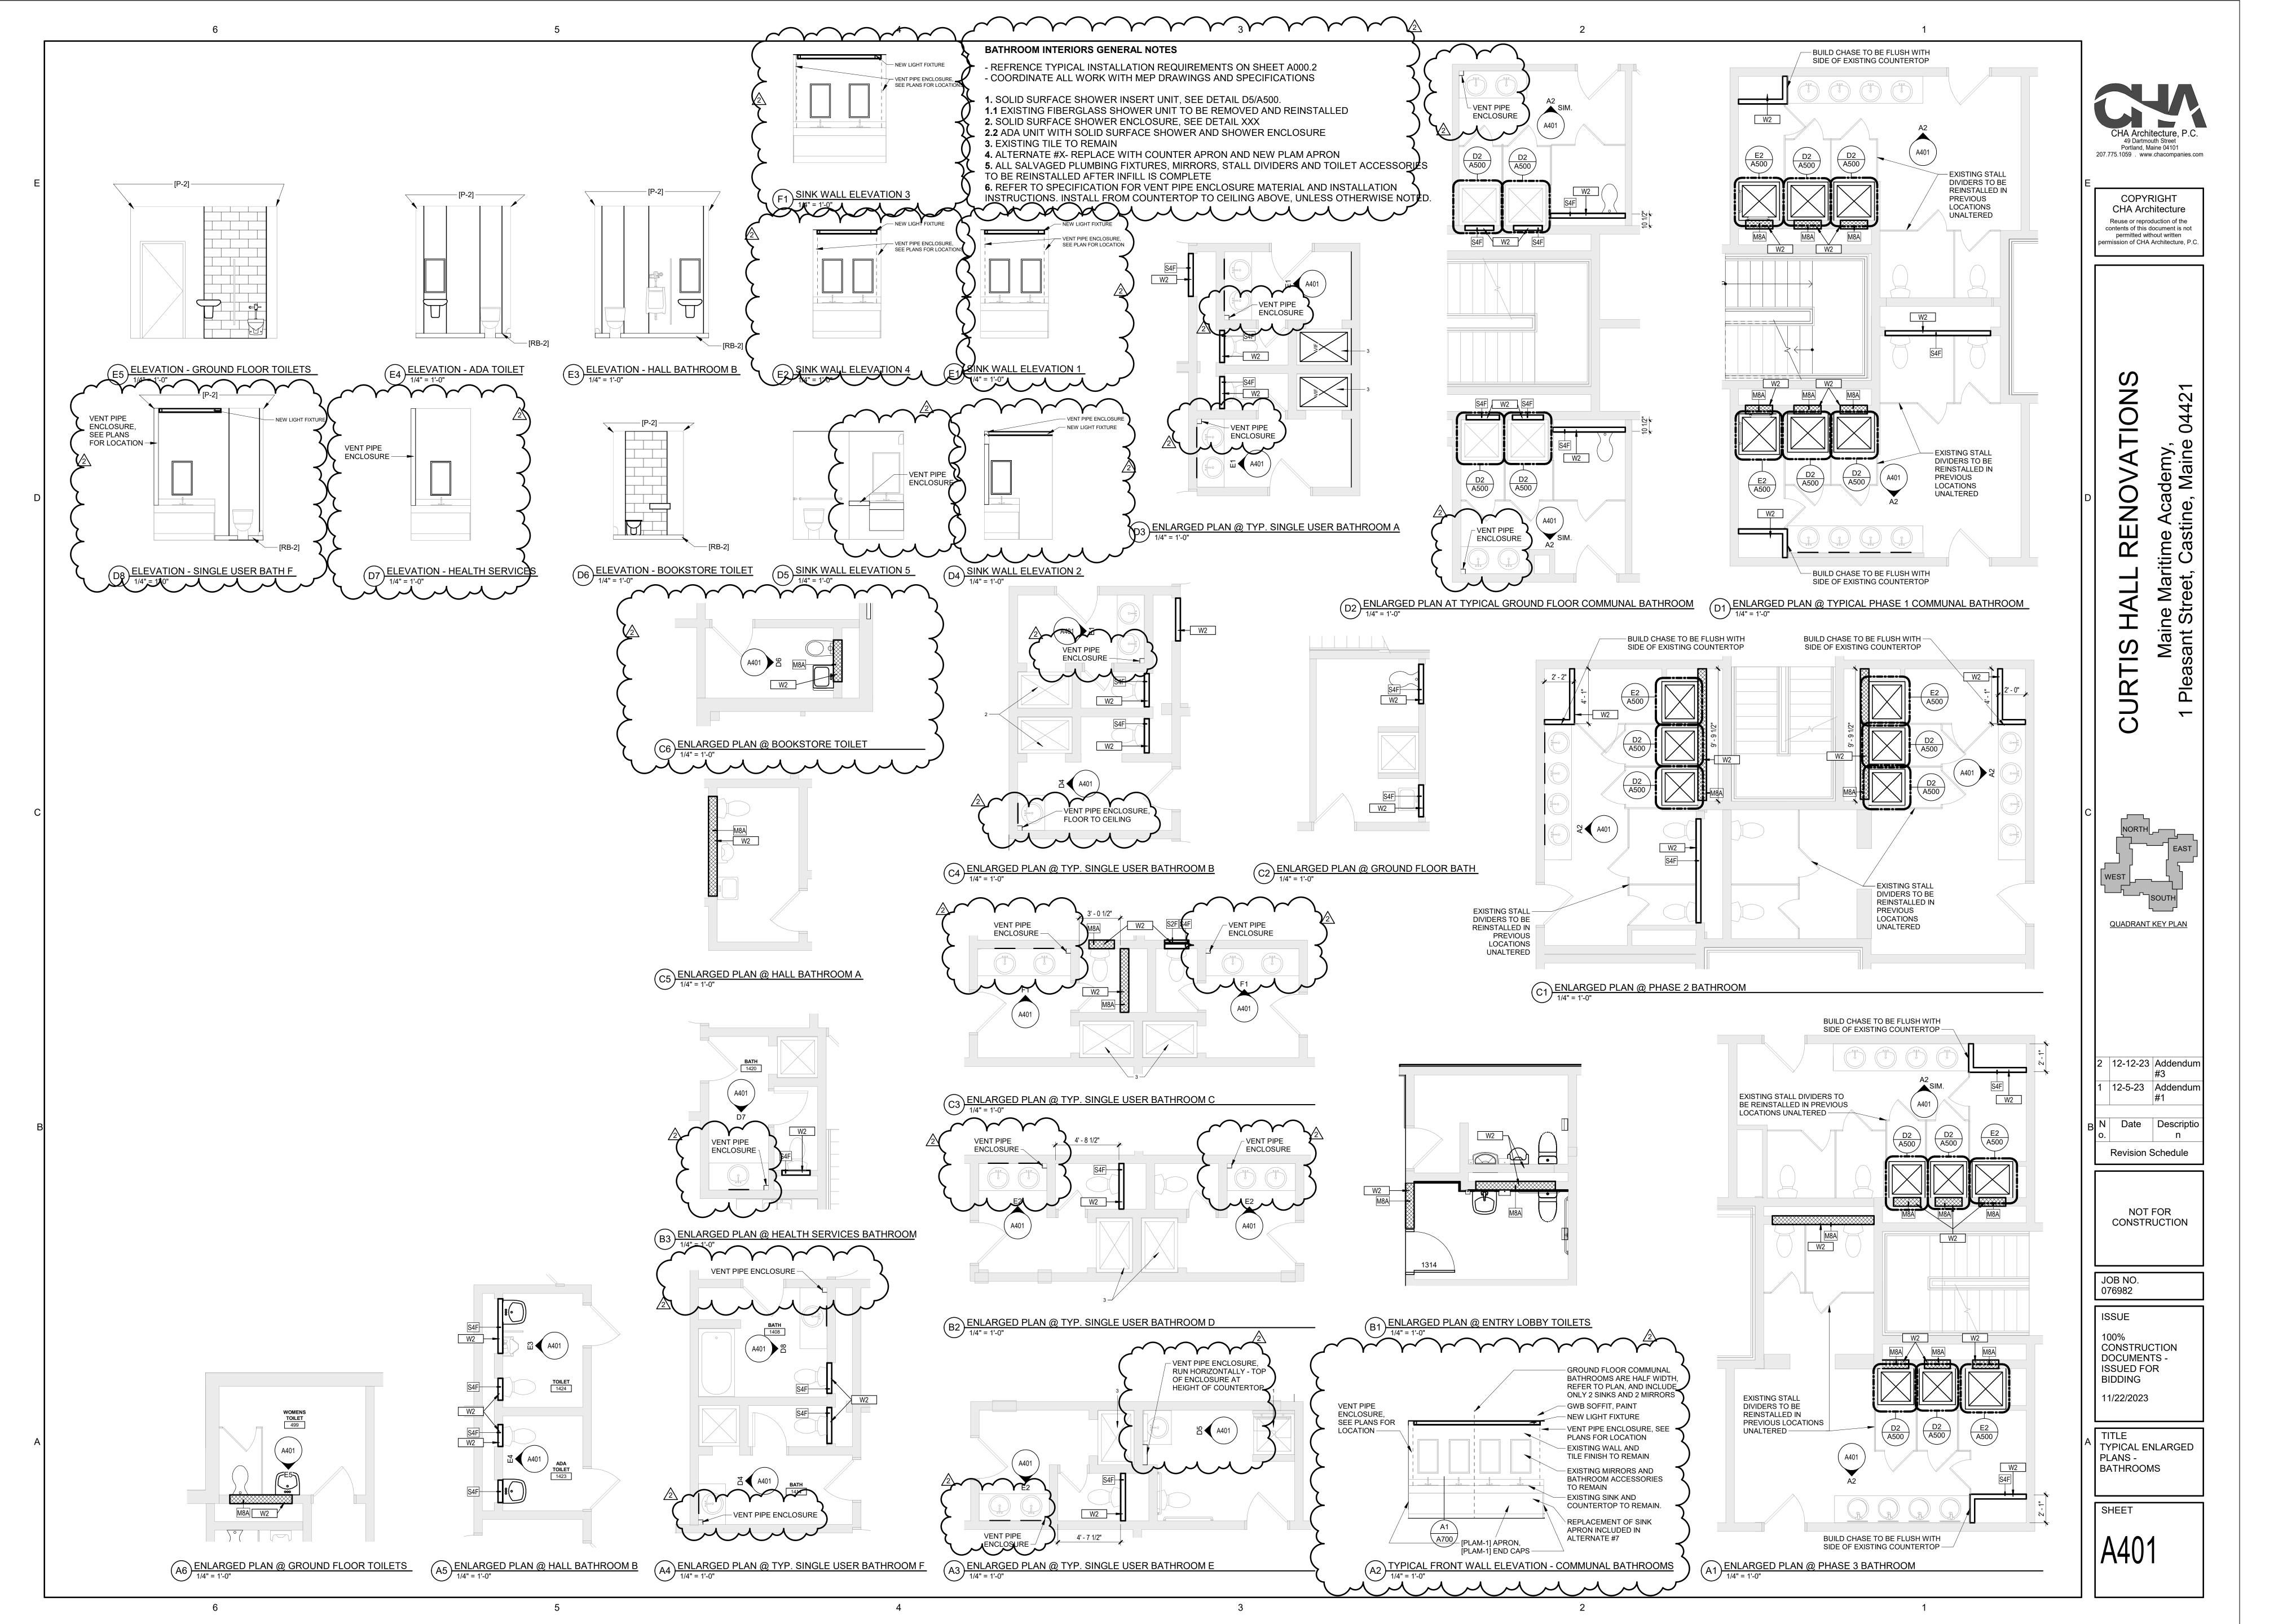

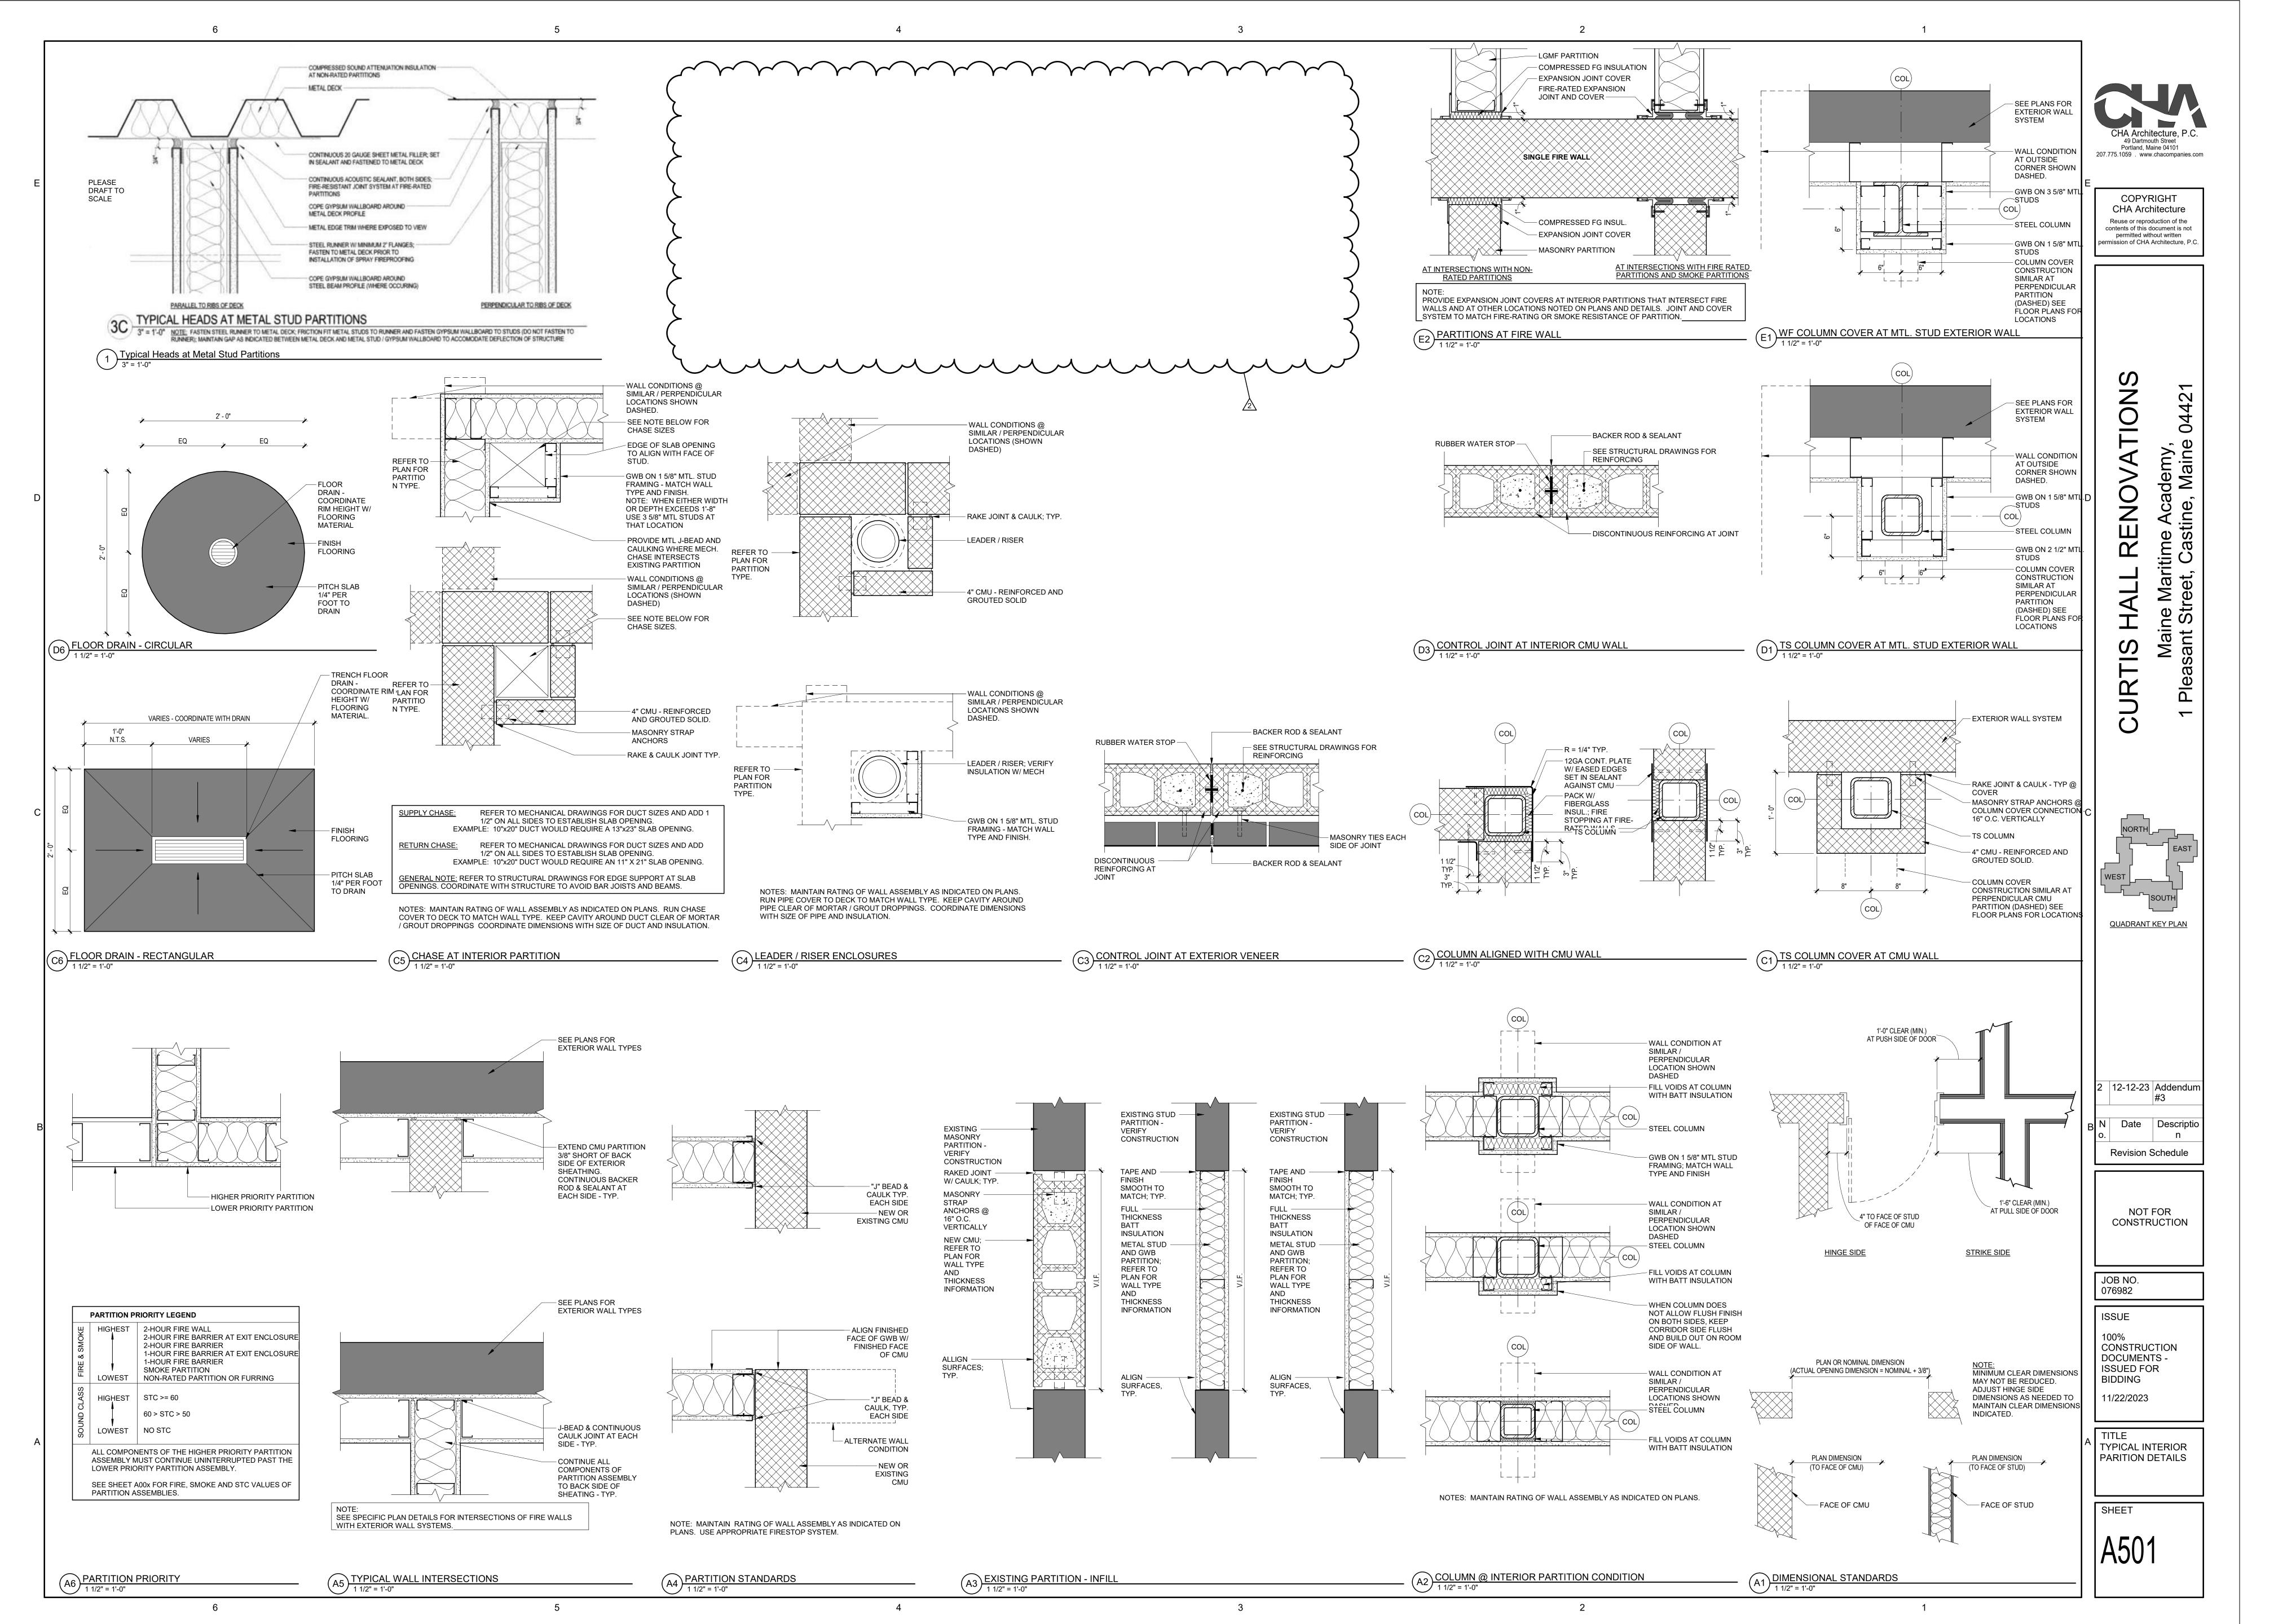

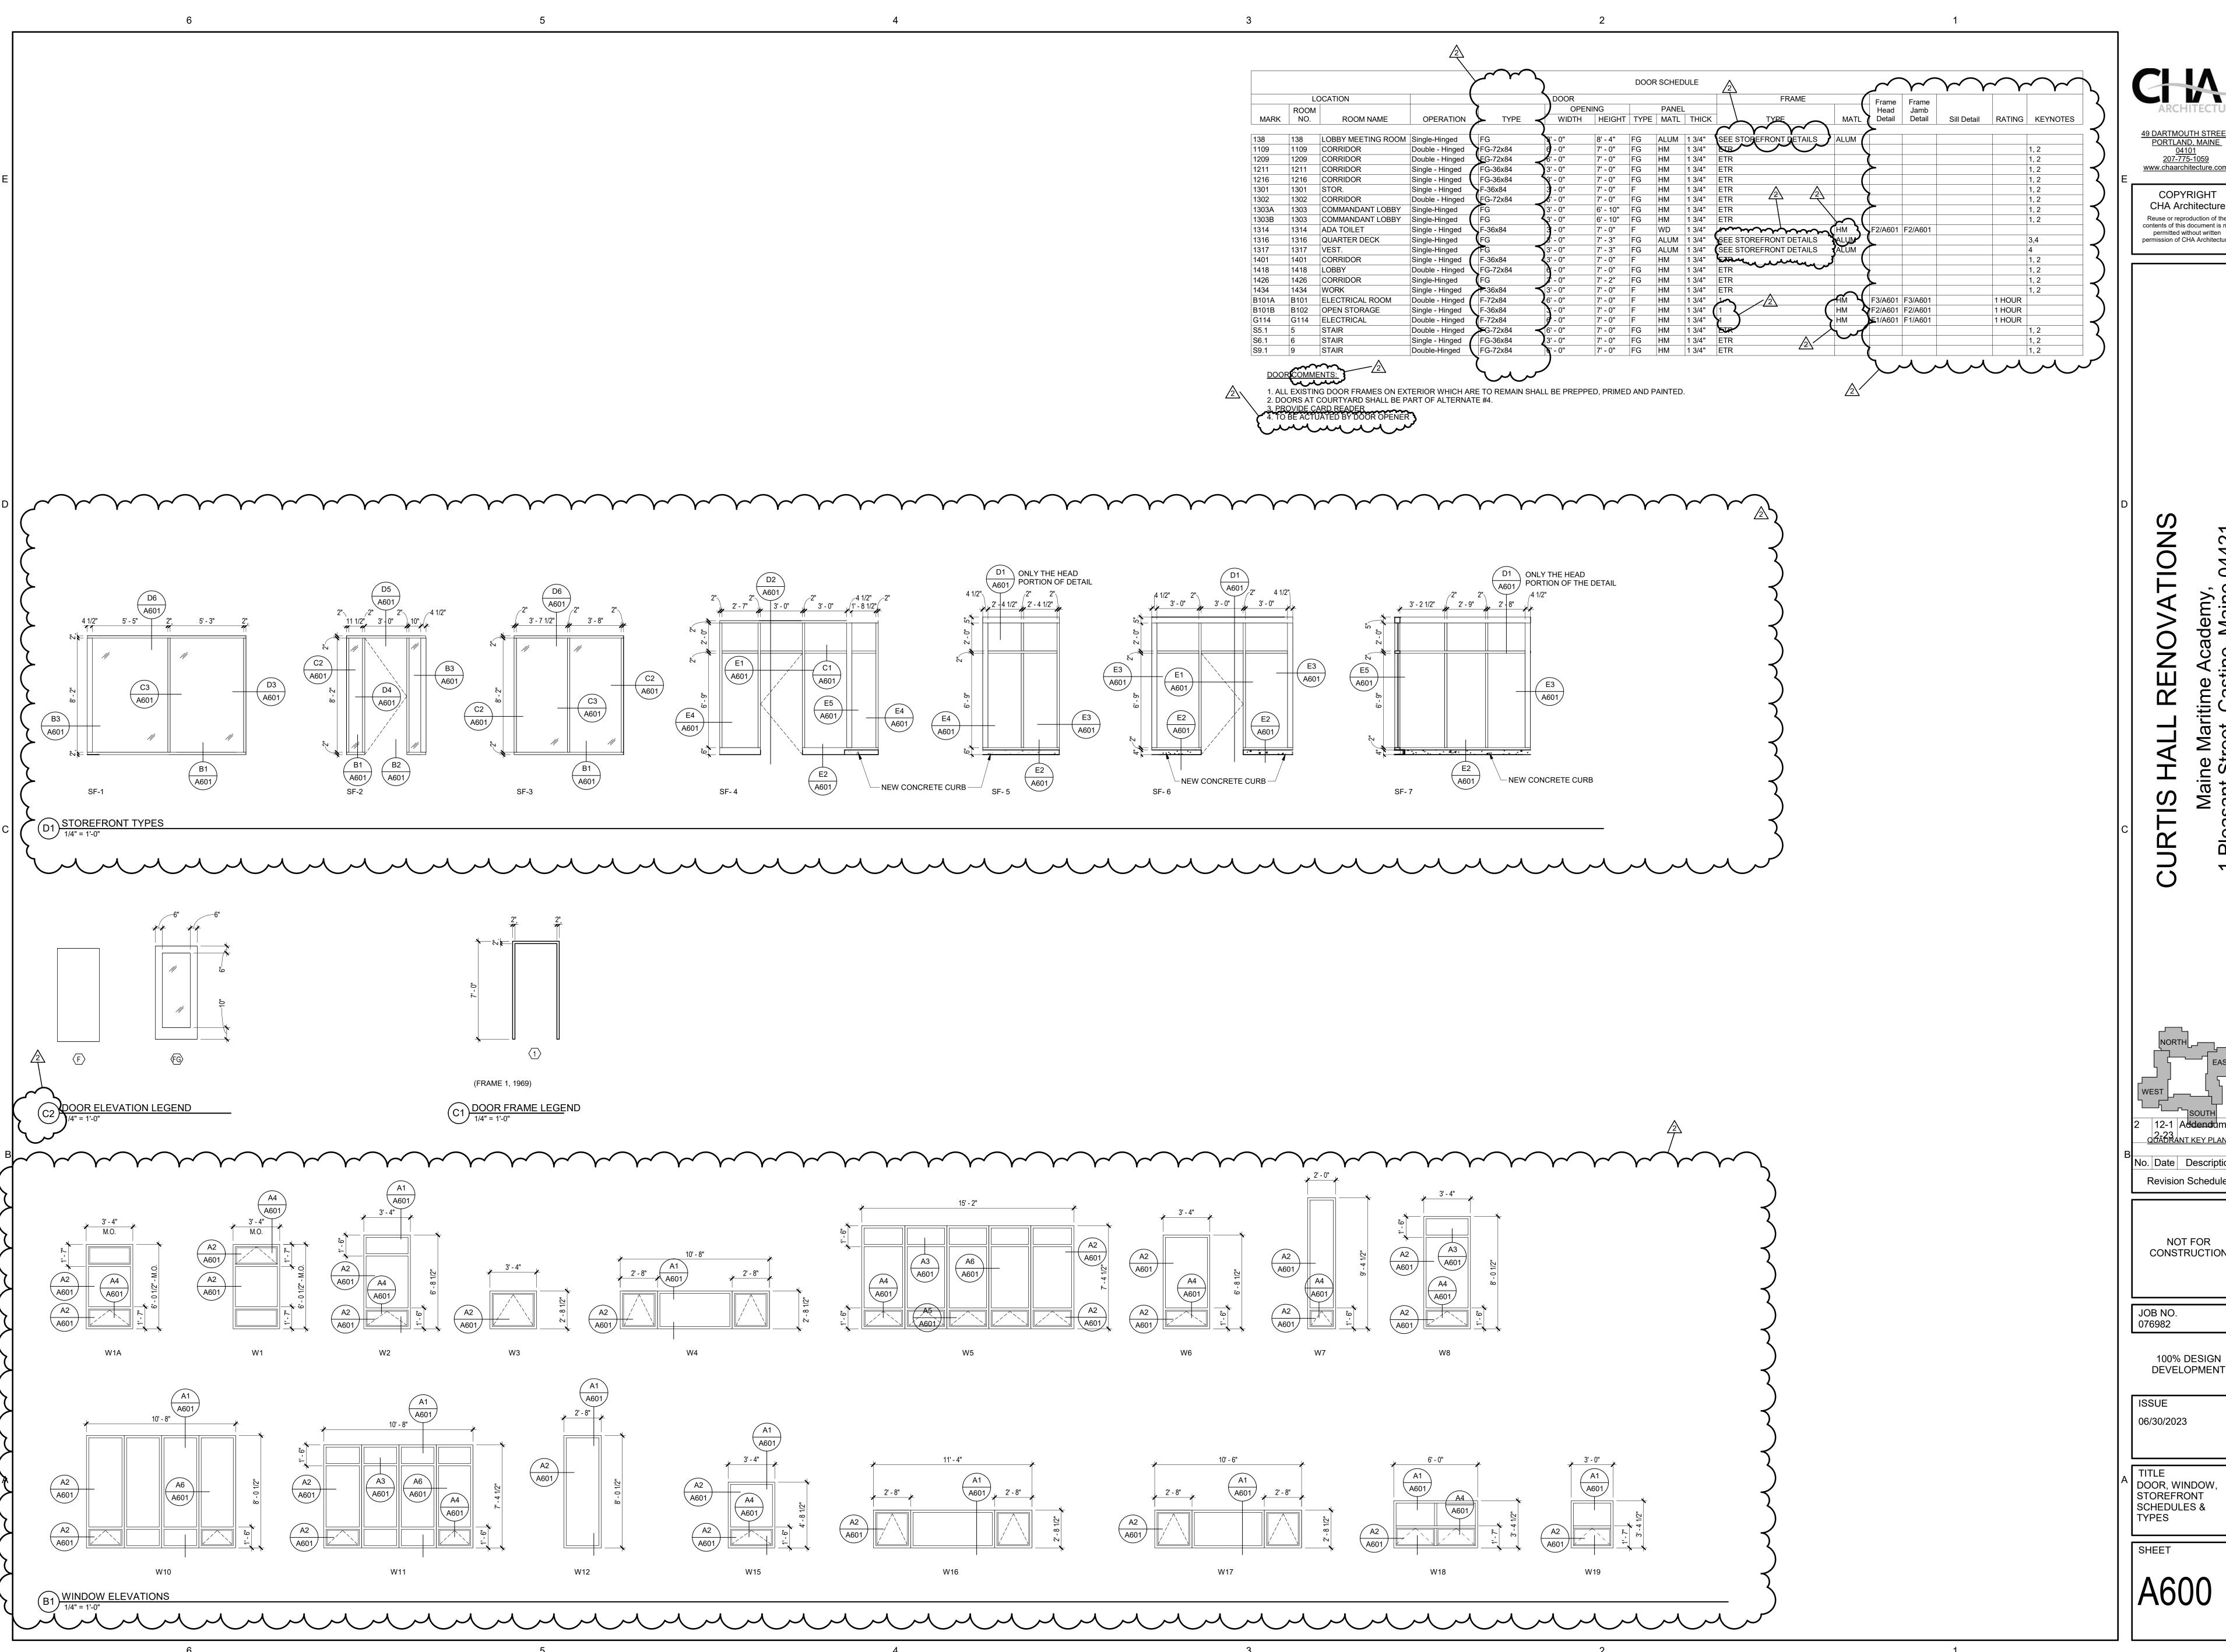

49 DARTMOUTH STREET
PORTLAND, MAINE
04101
207-775-1059 www.chaarchitecture.com

COPYRIGHT CHA Architecture Reuse or reproduction of the contents of this document is not permitted without written permission of CHA Architecture.

0442

2-23 QUADRANT KEY PLAN No. Date Description

> NOT FOR CONSTRUCTION


100% DESIGN DEVELOPMENT

06/30/2023

DOOR, WINDOW, STOREFRONT SCHEDULES &

SHEET

A600

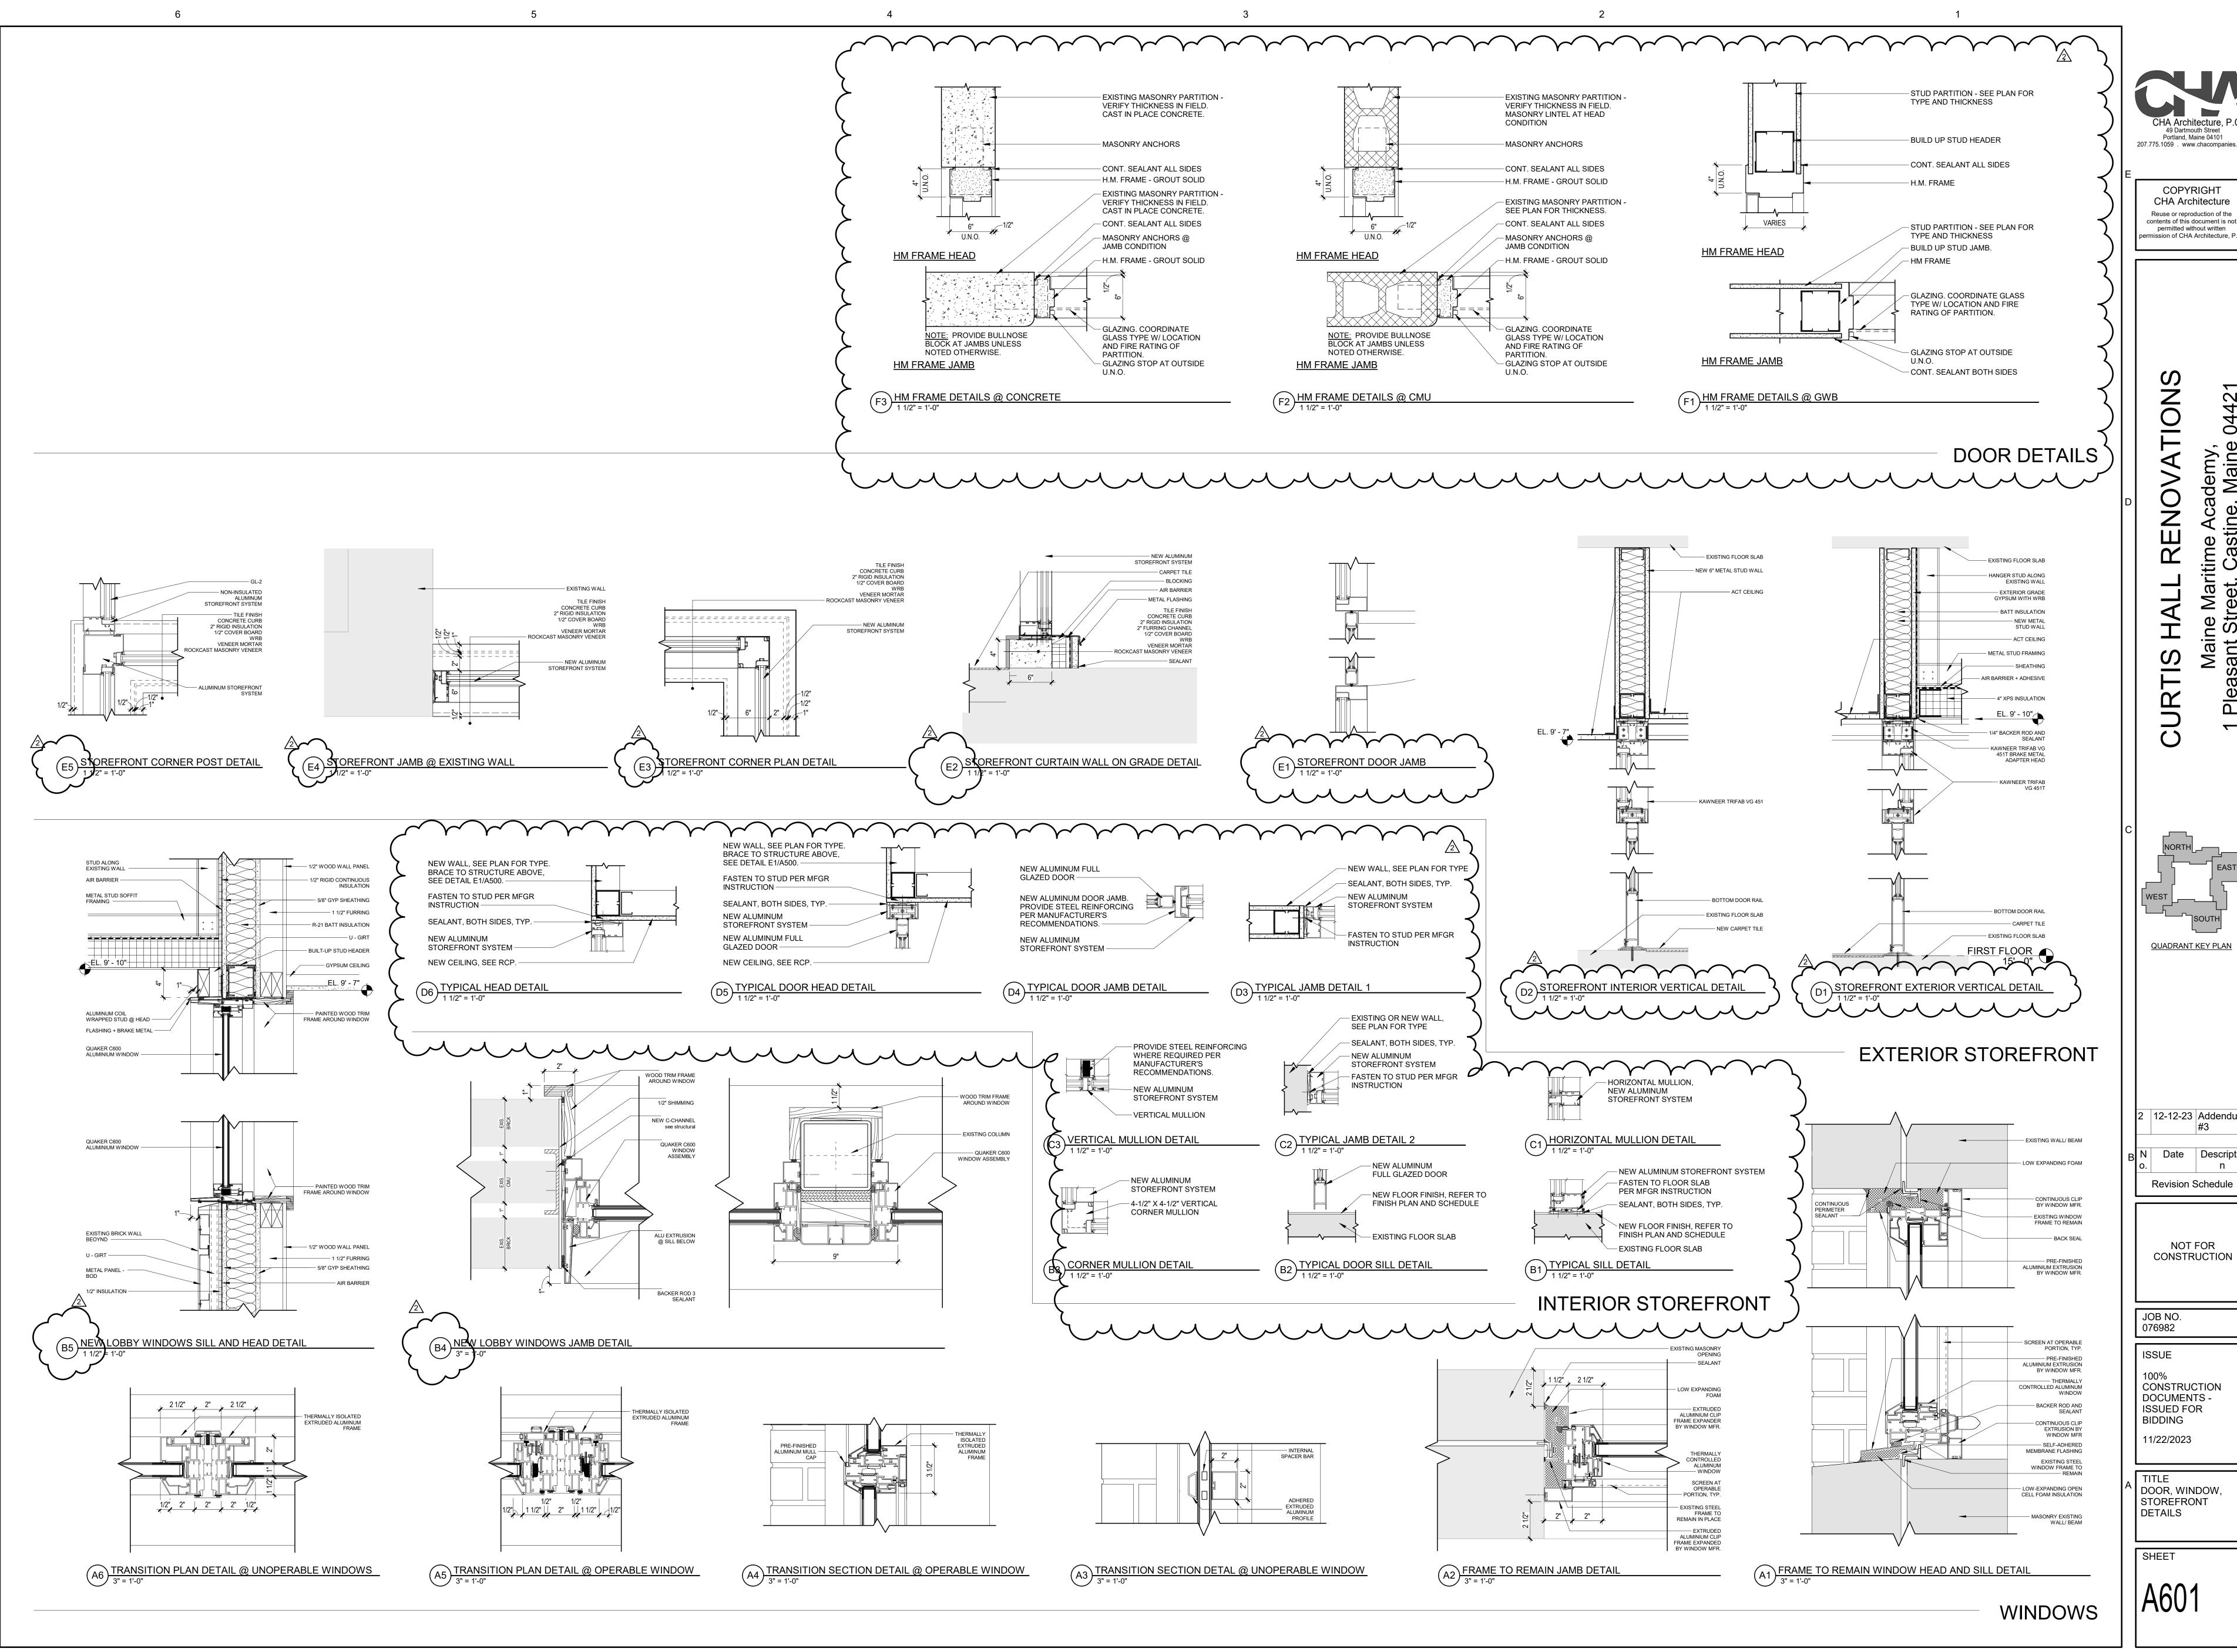

CHA Architecture, P.C. 49 Dartmouth Street Portland, Maine 04101 207.775.1059 . www.chacompanies.com

> **COPYRIGHT** CHA Architecture Reuse or reproduction of the contents of this document is not permitted without written

ermission of CHA Architecture, P.0

04 demy, Maine


QUADRANT KEY PLAN

2 12-12-23 Addendum #3 Date Descriptio

NOT FOR

CONSTRUCTION

CONSTRUCTION

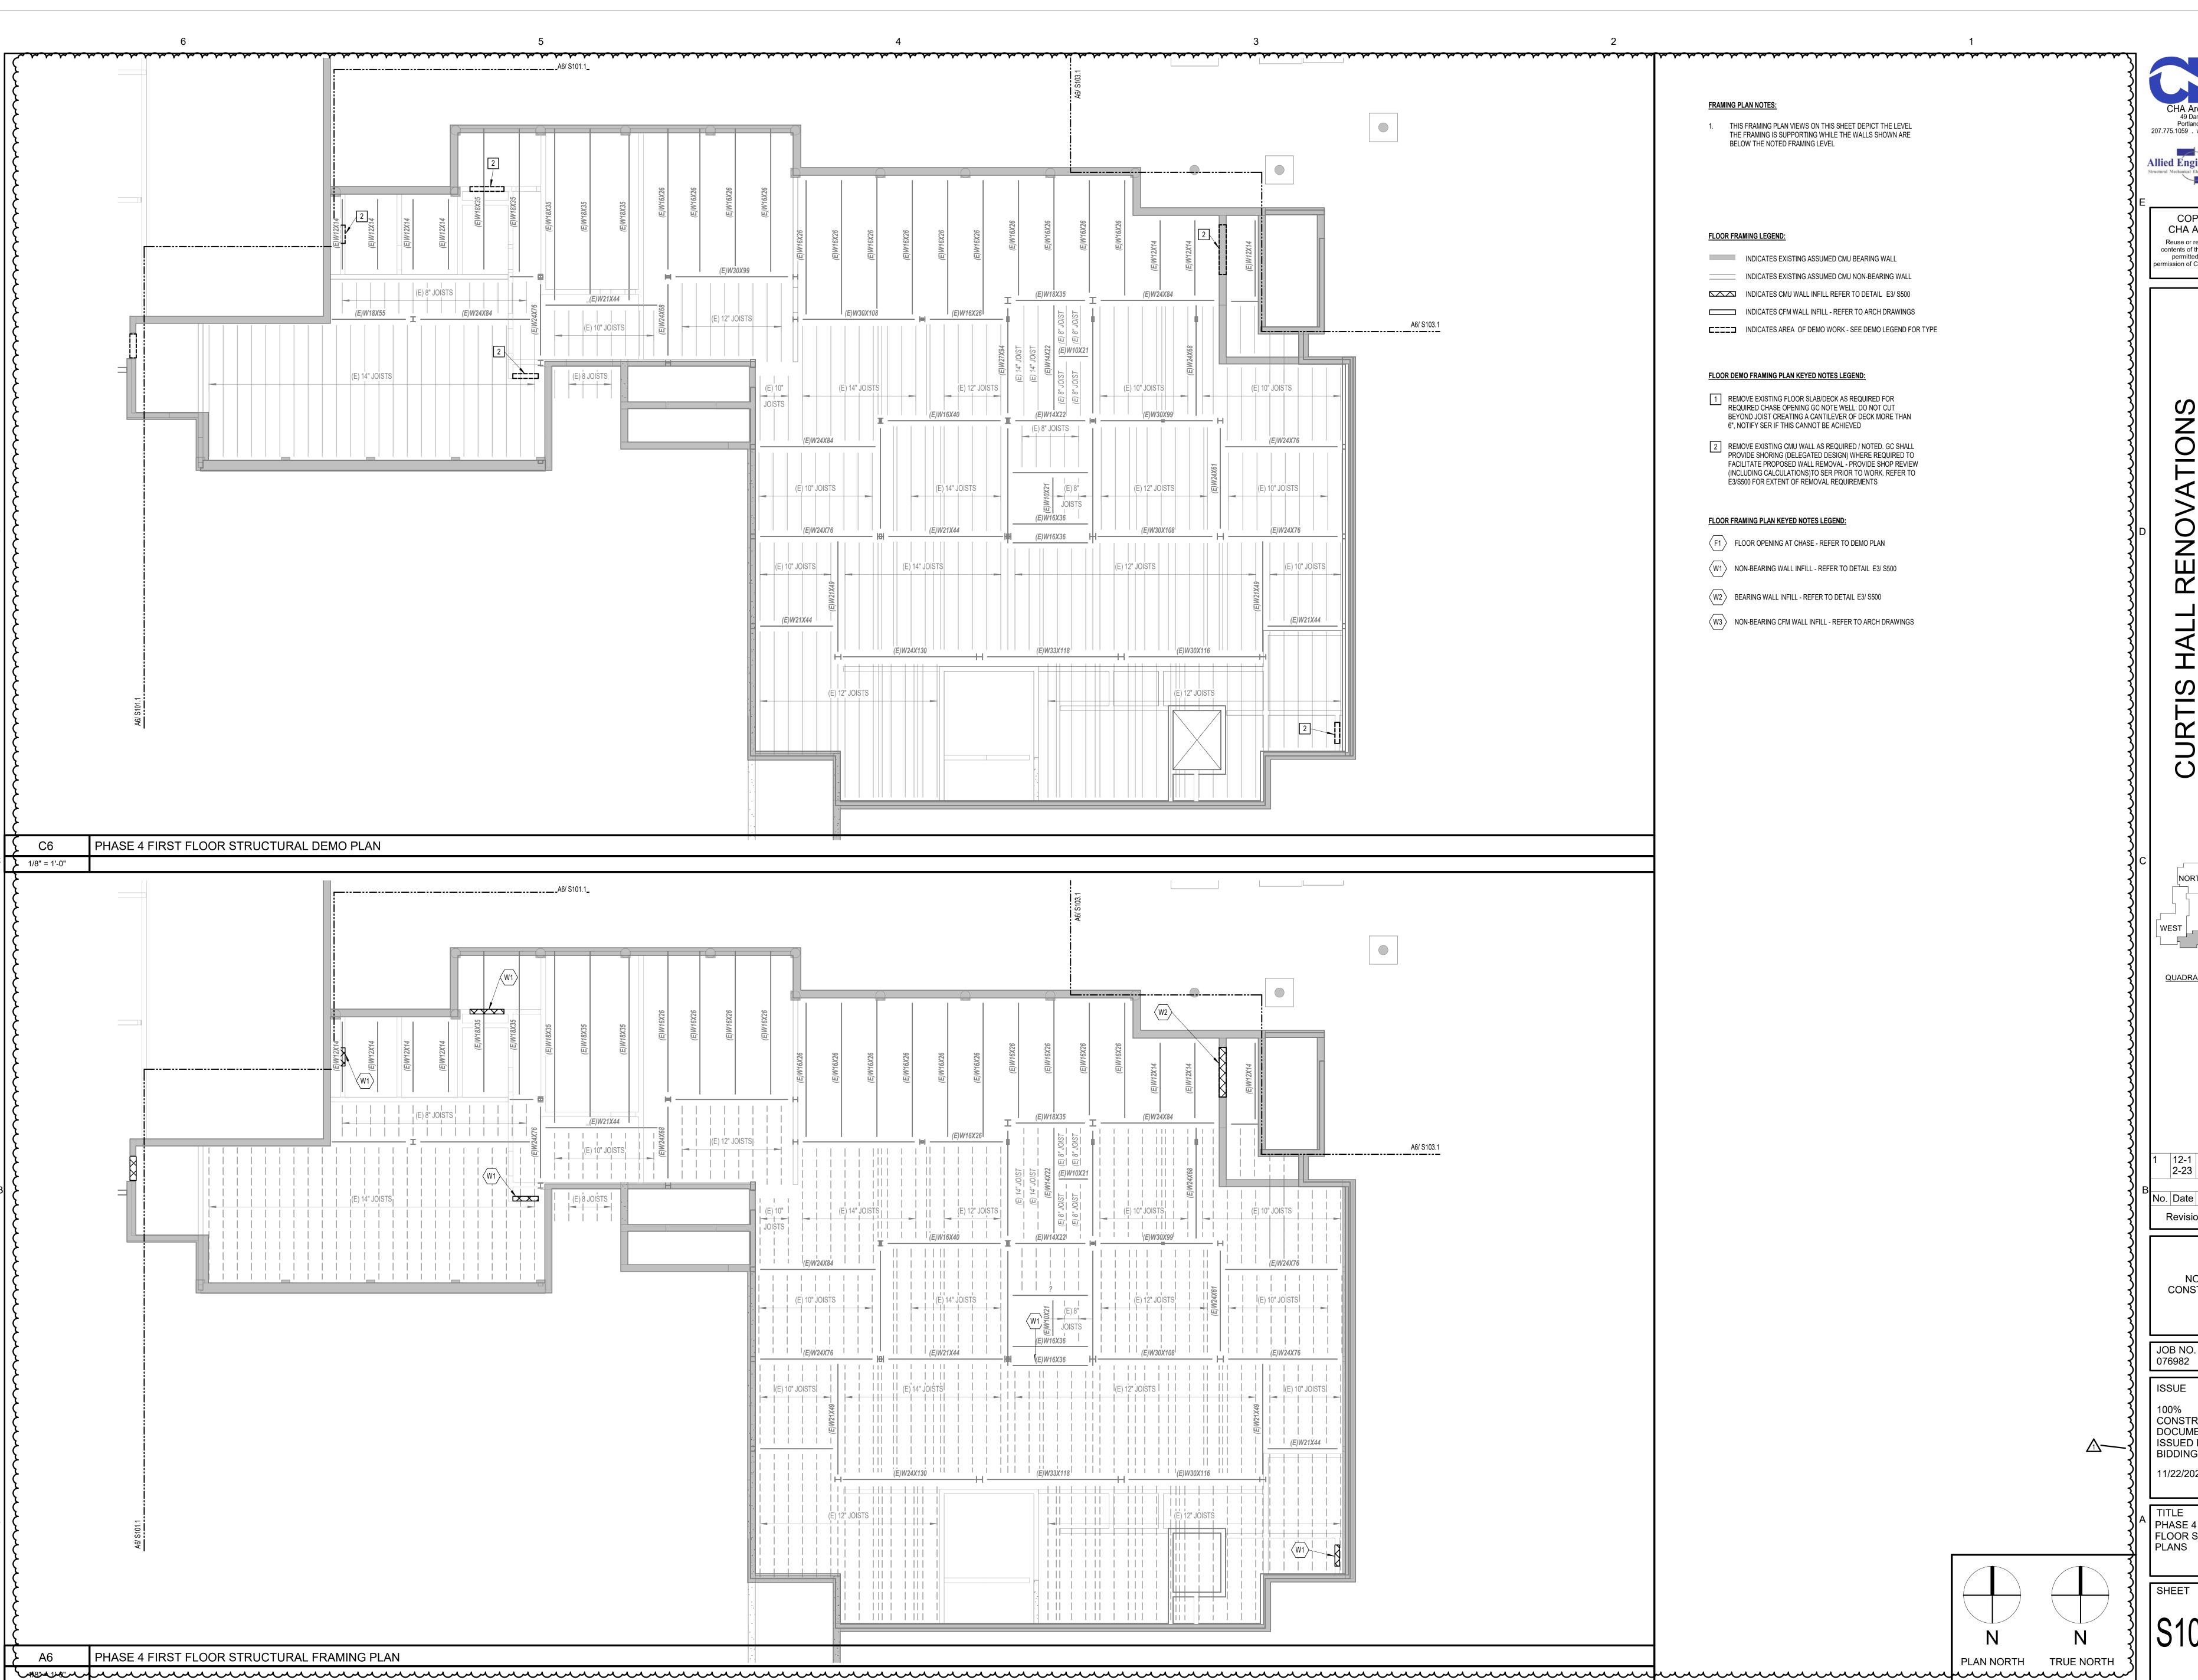

Portland, Maine 04101 207.775.1059 . www.chacompanies.com

Allied Engineering
Structural Mechanical Electrical Plumbing
F: 207.221.2266

COPYRIGHT CHA Architecture Reuse or reproduction of the contents of this document is not permitted without written

permission of CHA Architecture, P.

Z O

QUADRANT KEY PLAN


12-1 | Addendum #3


No. Date Description Revision Schedule


> NOT FOR CONSTRUCTION


CONSTRUCTION DOCUMENTS -ISSUED FOR 11/22/2023


PHASE 4 FIRST FLOOR STRUCTURAL

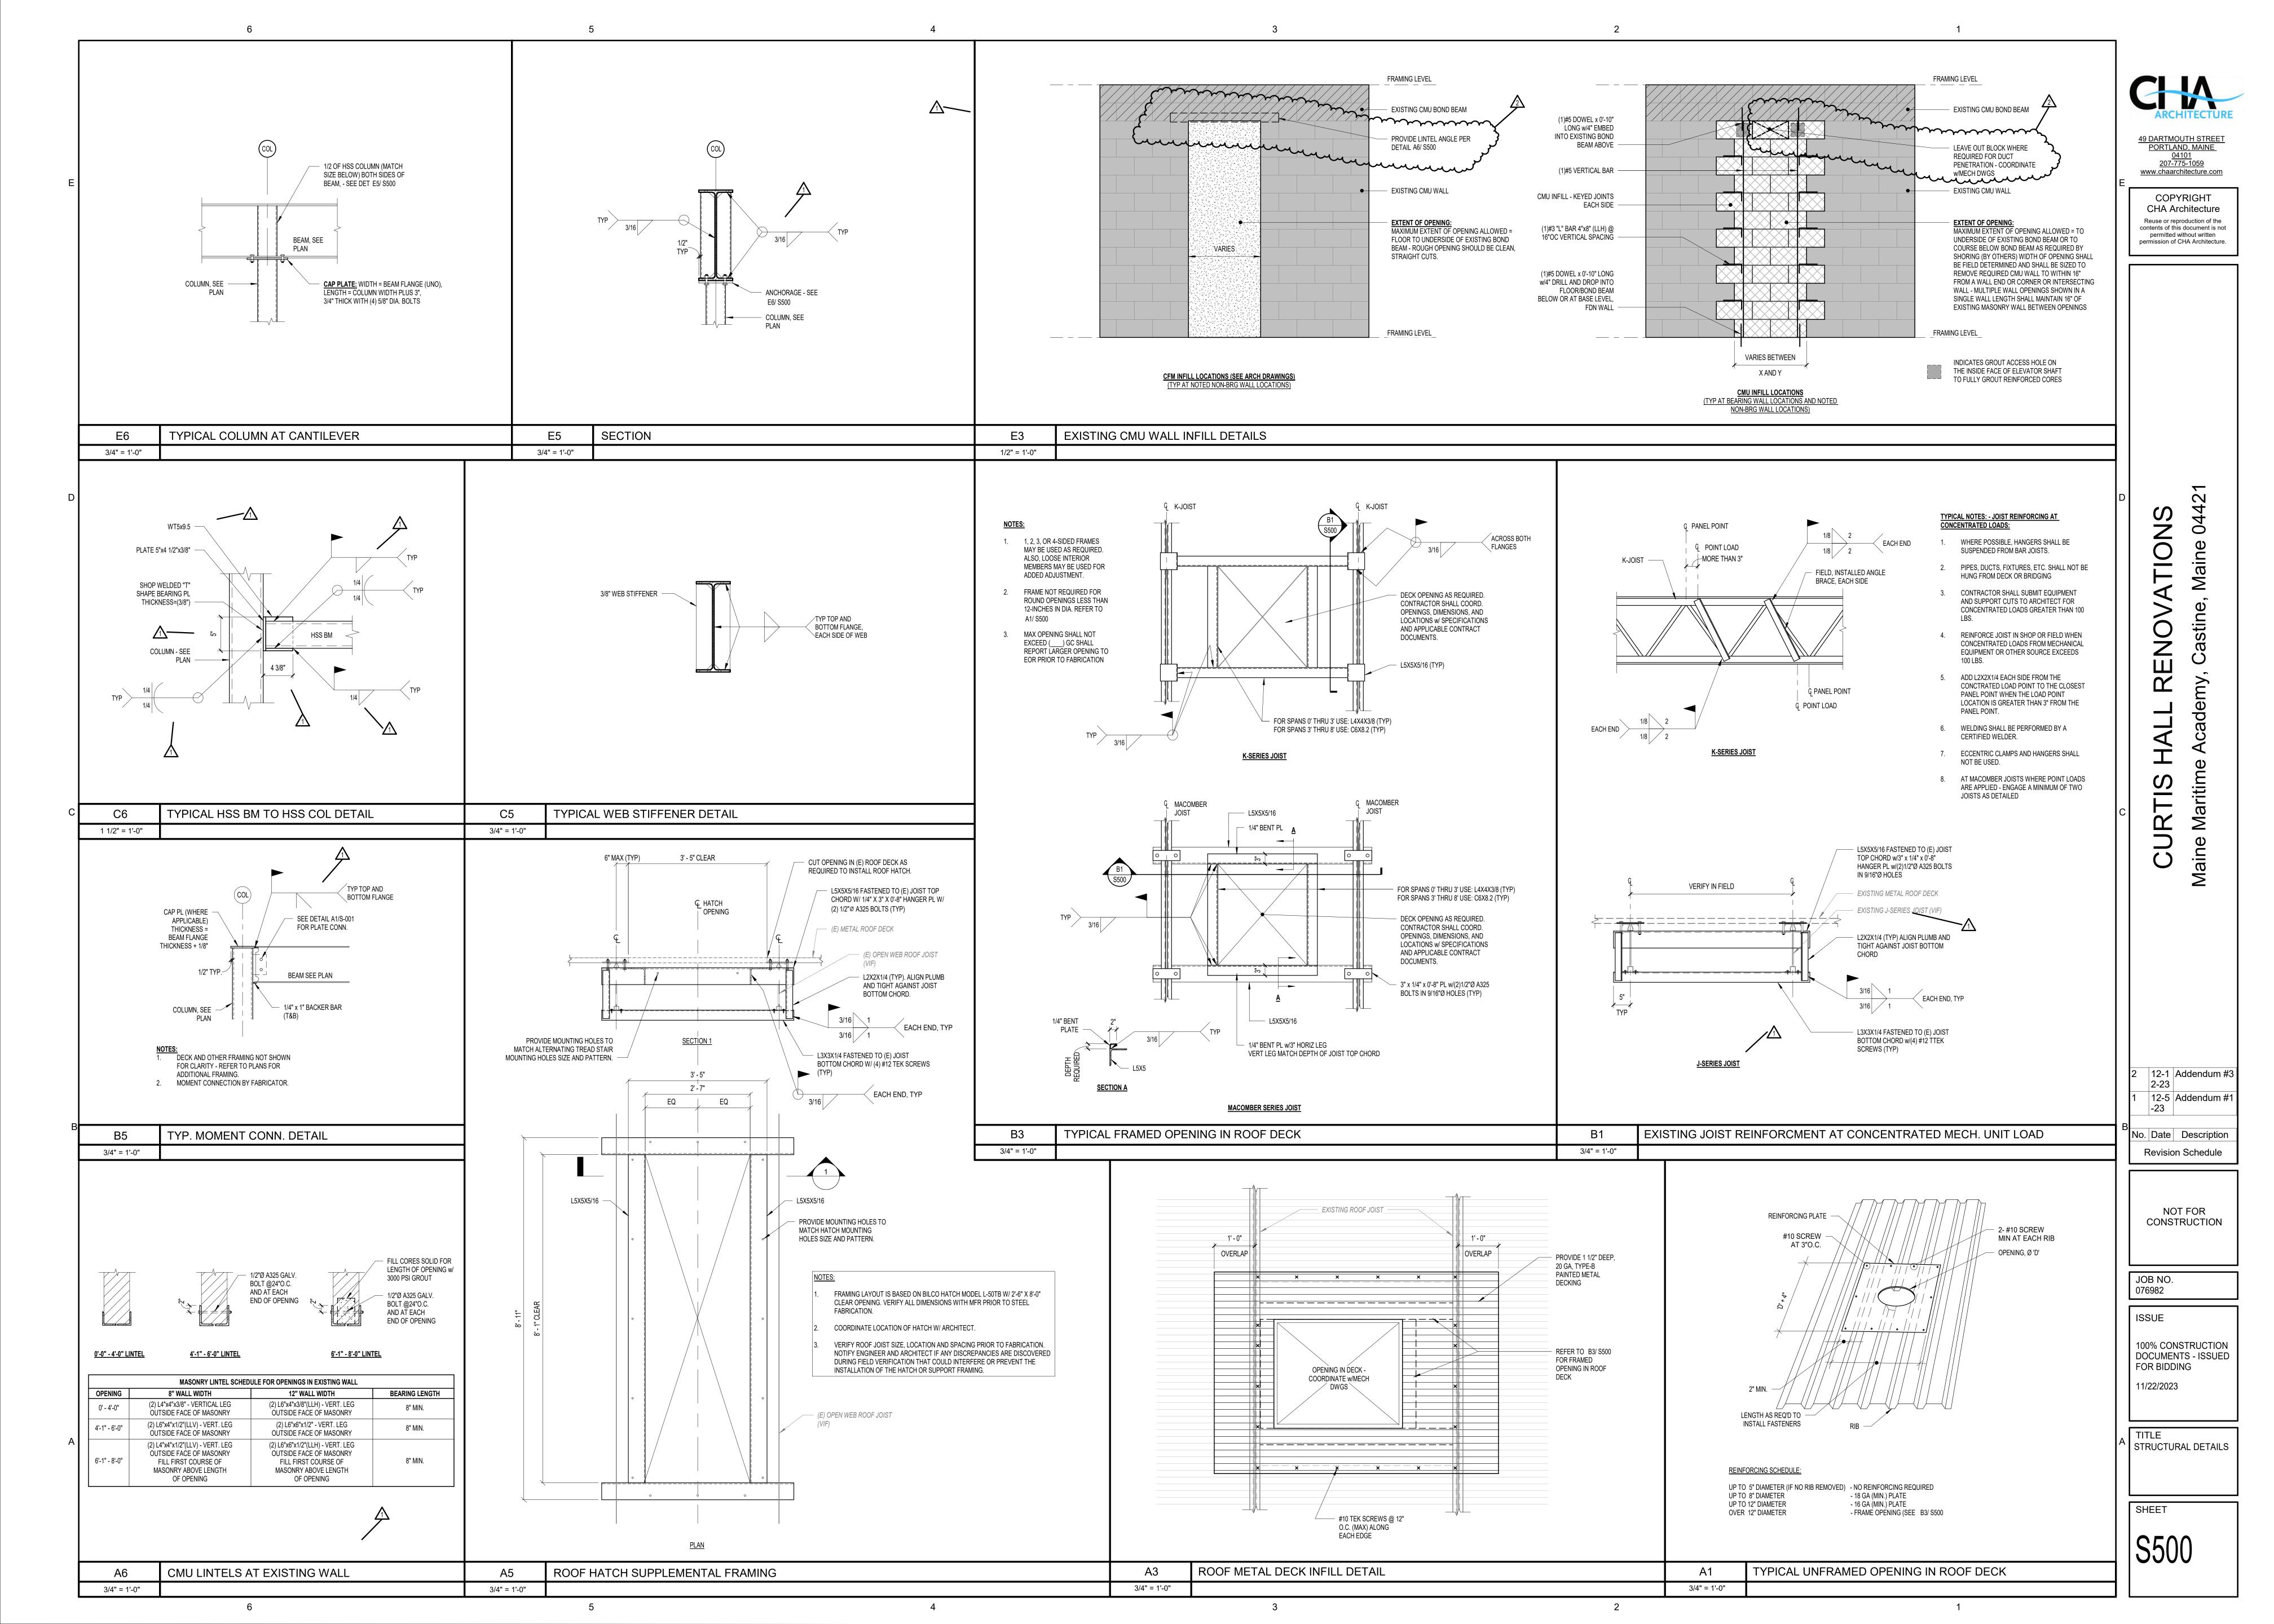


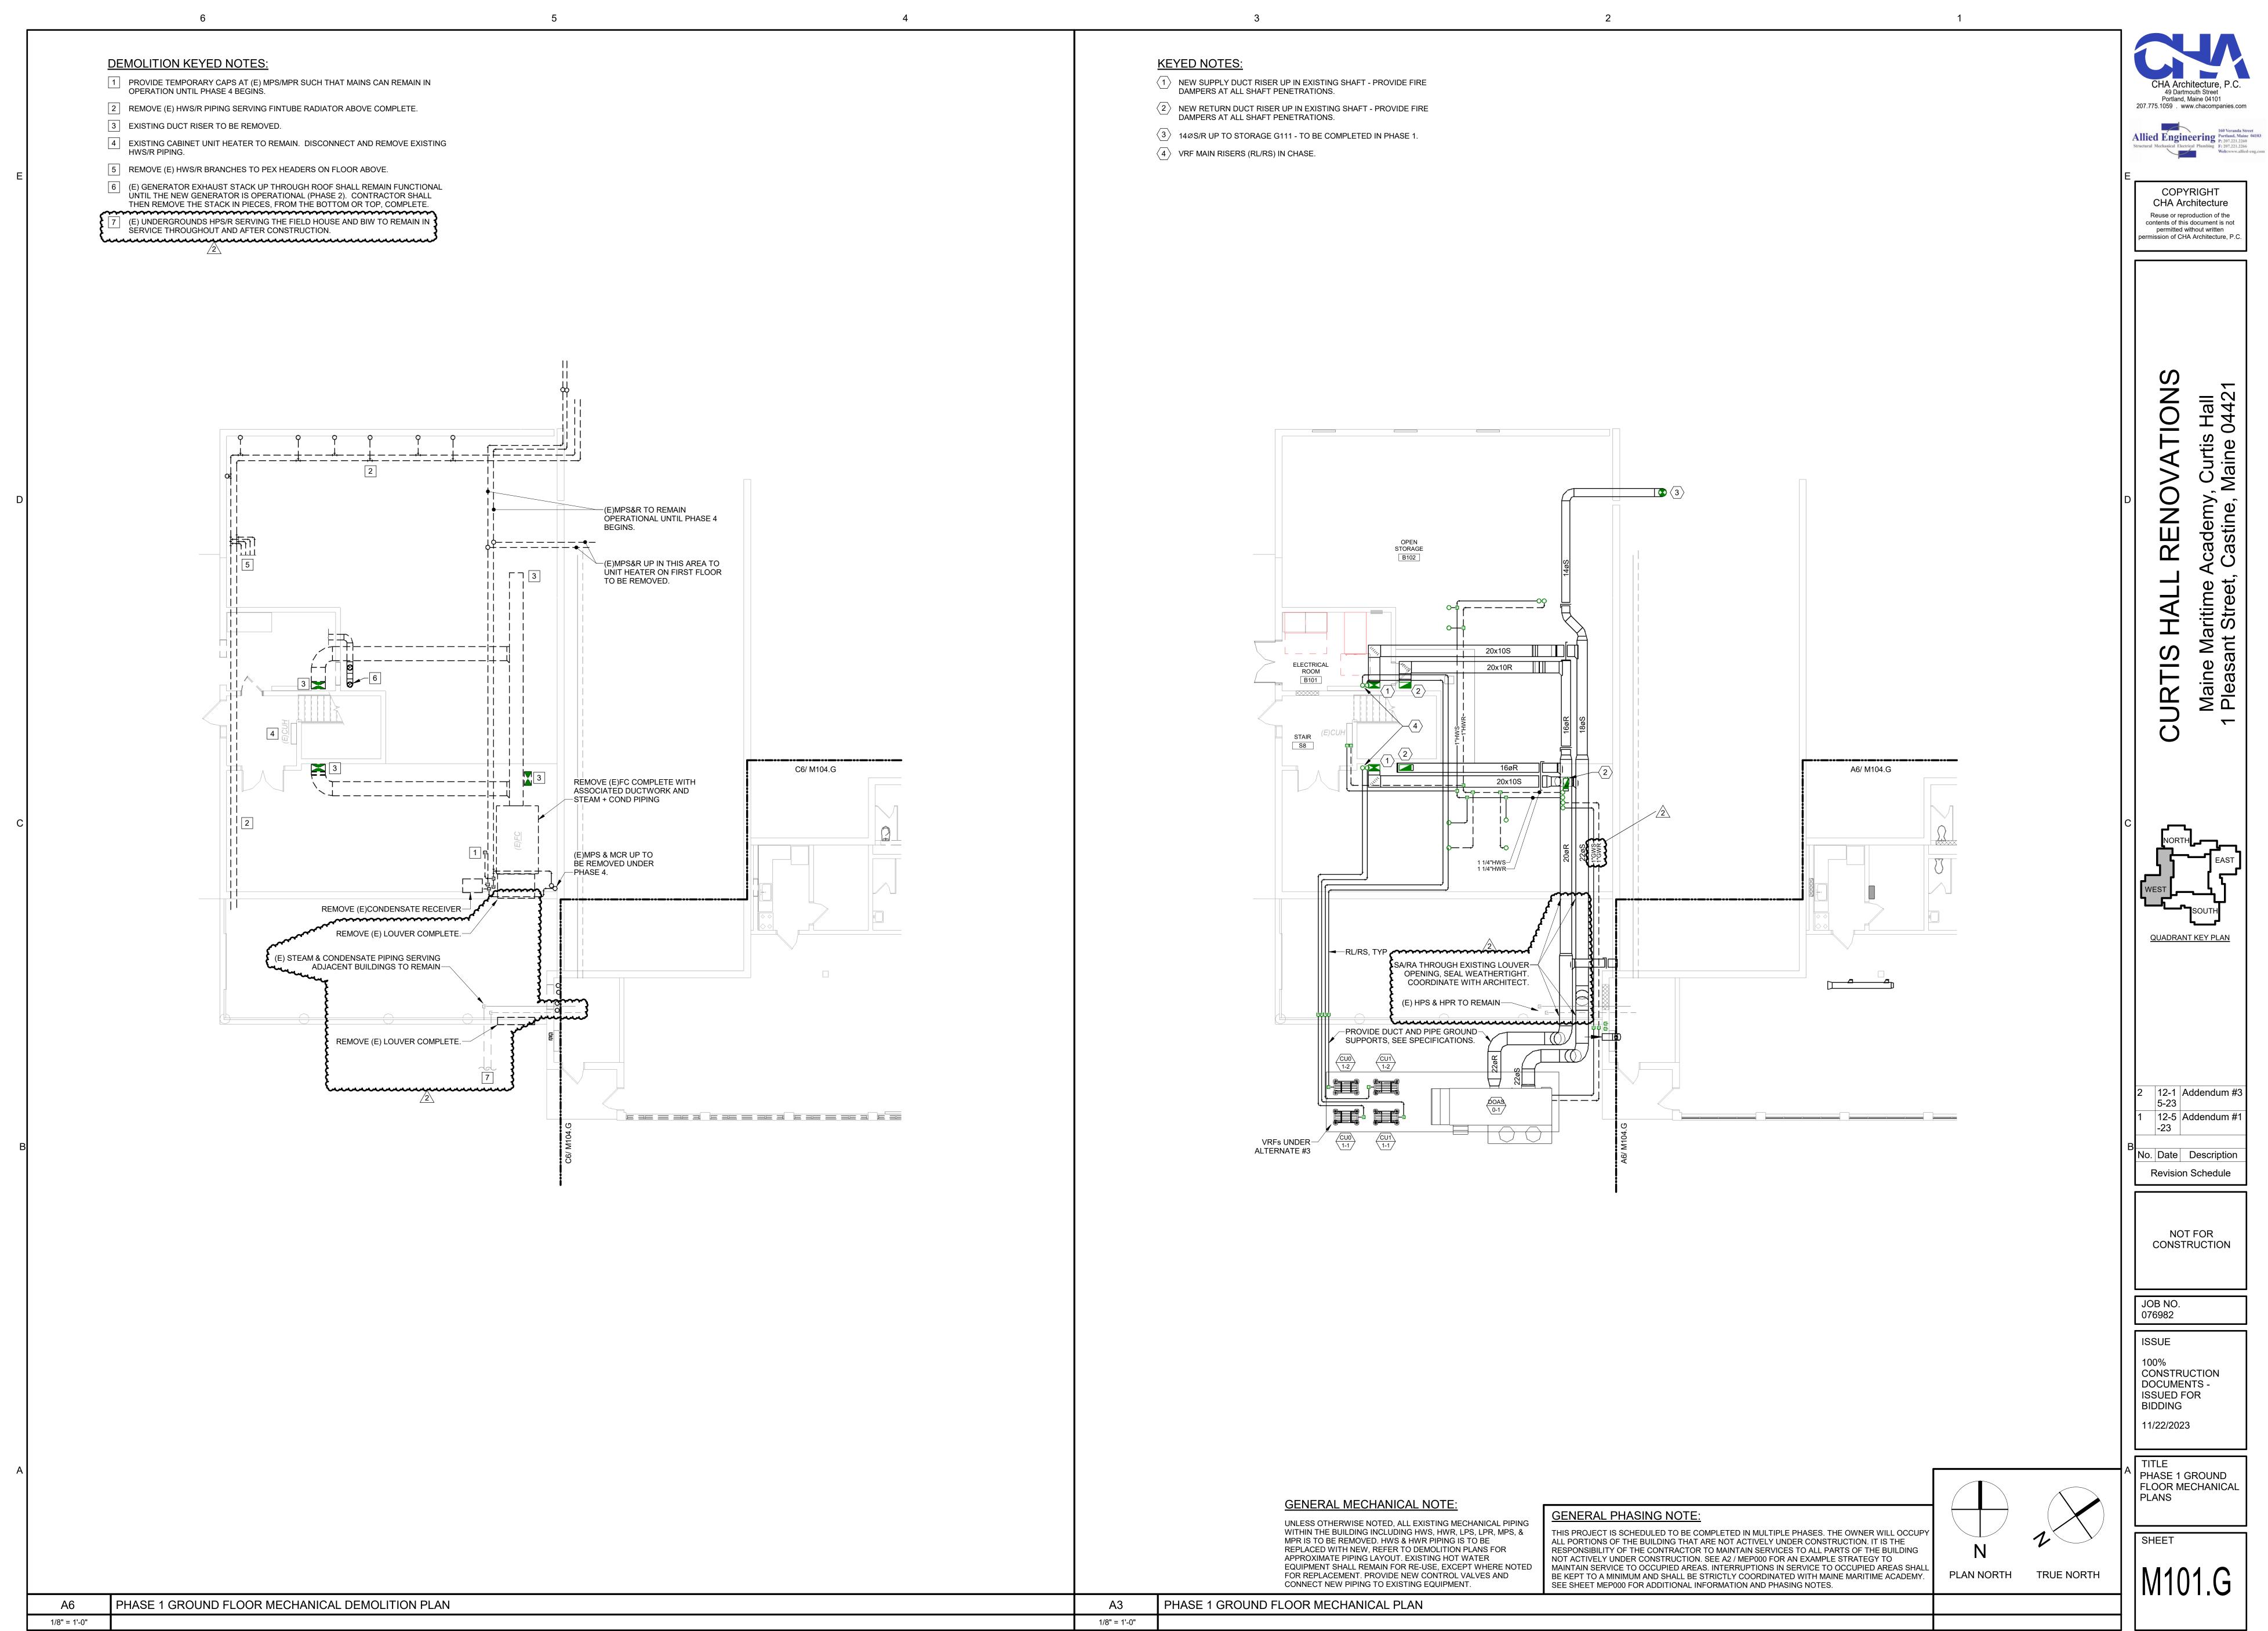

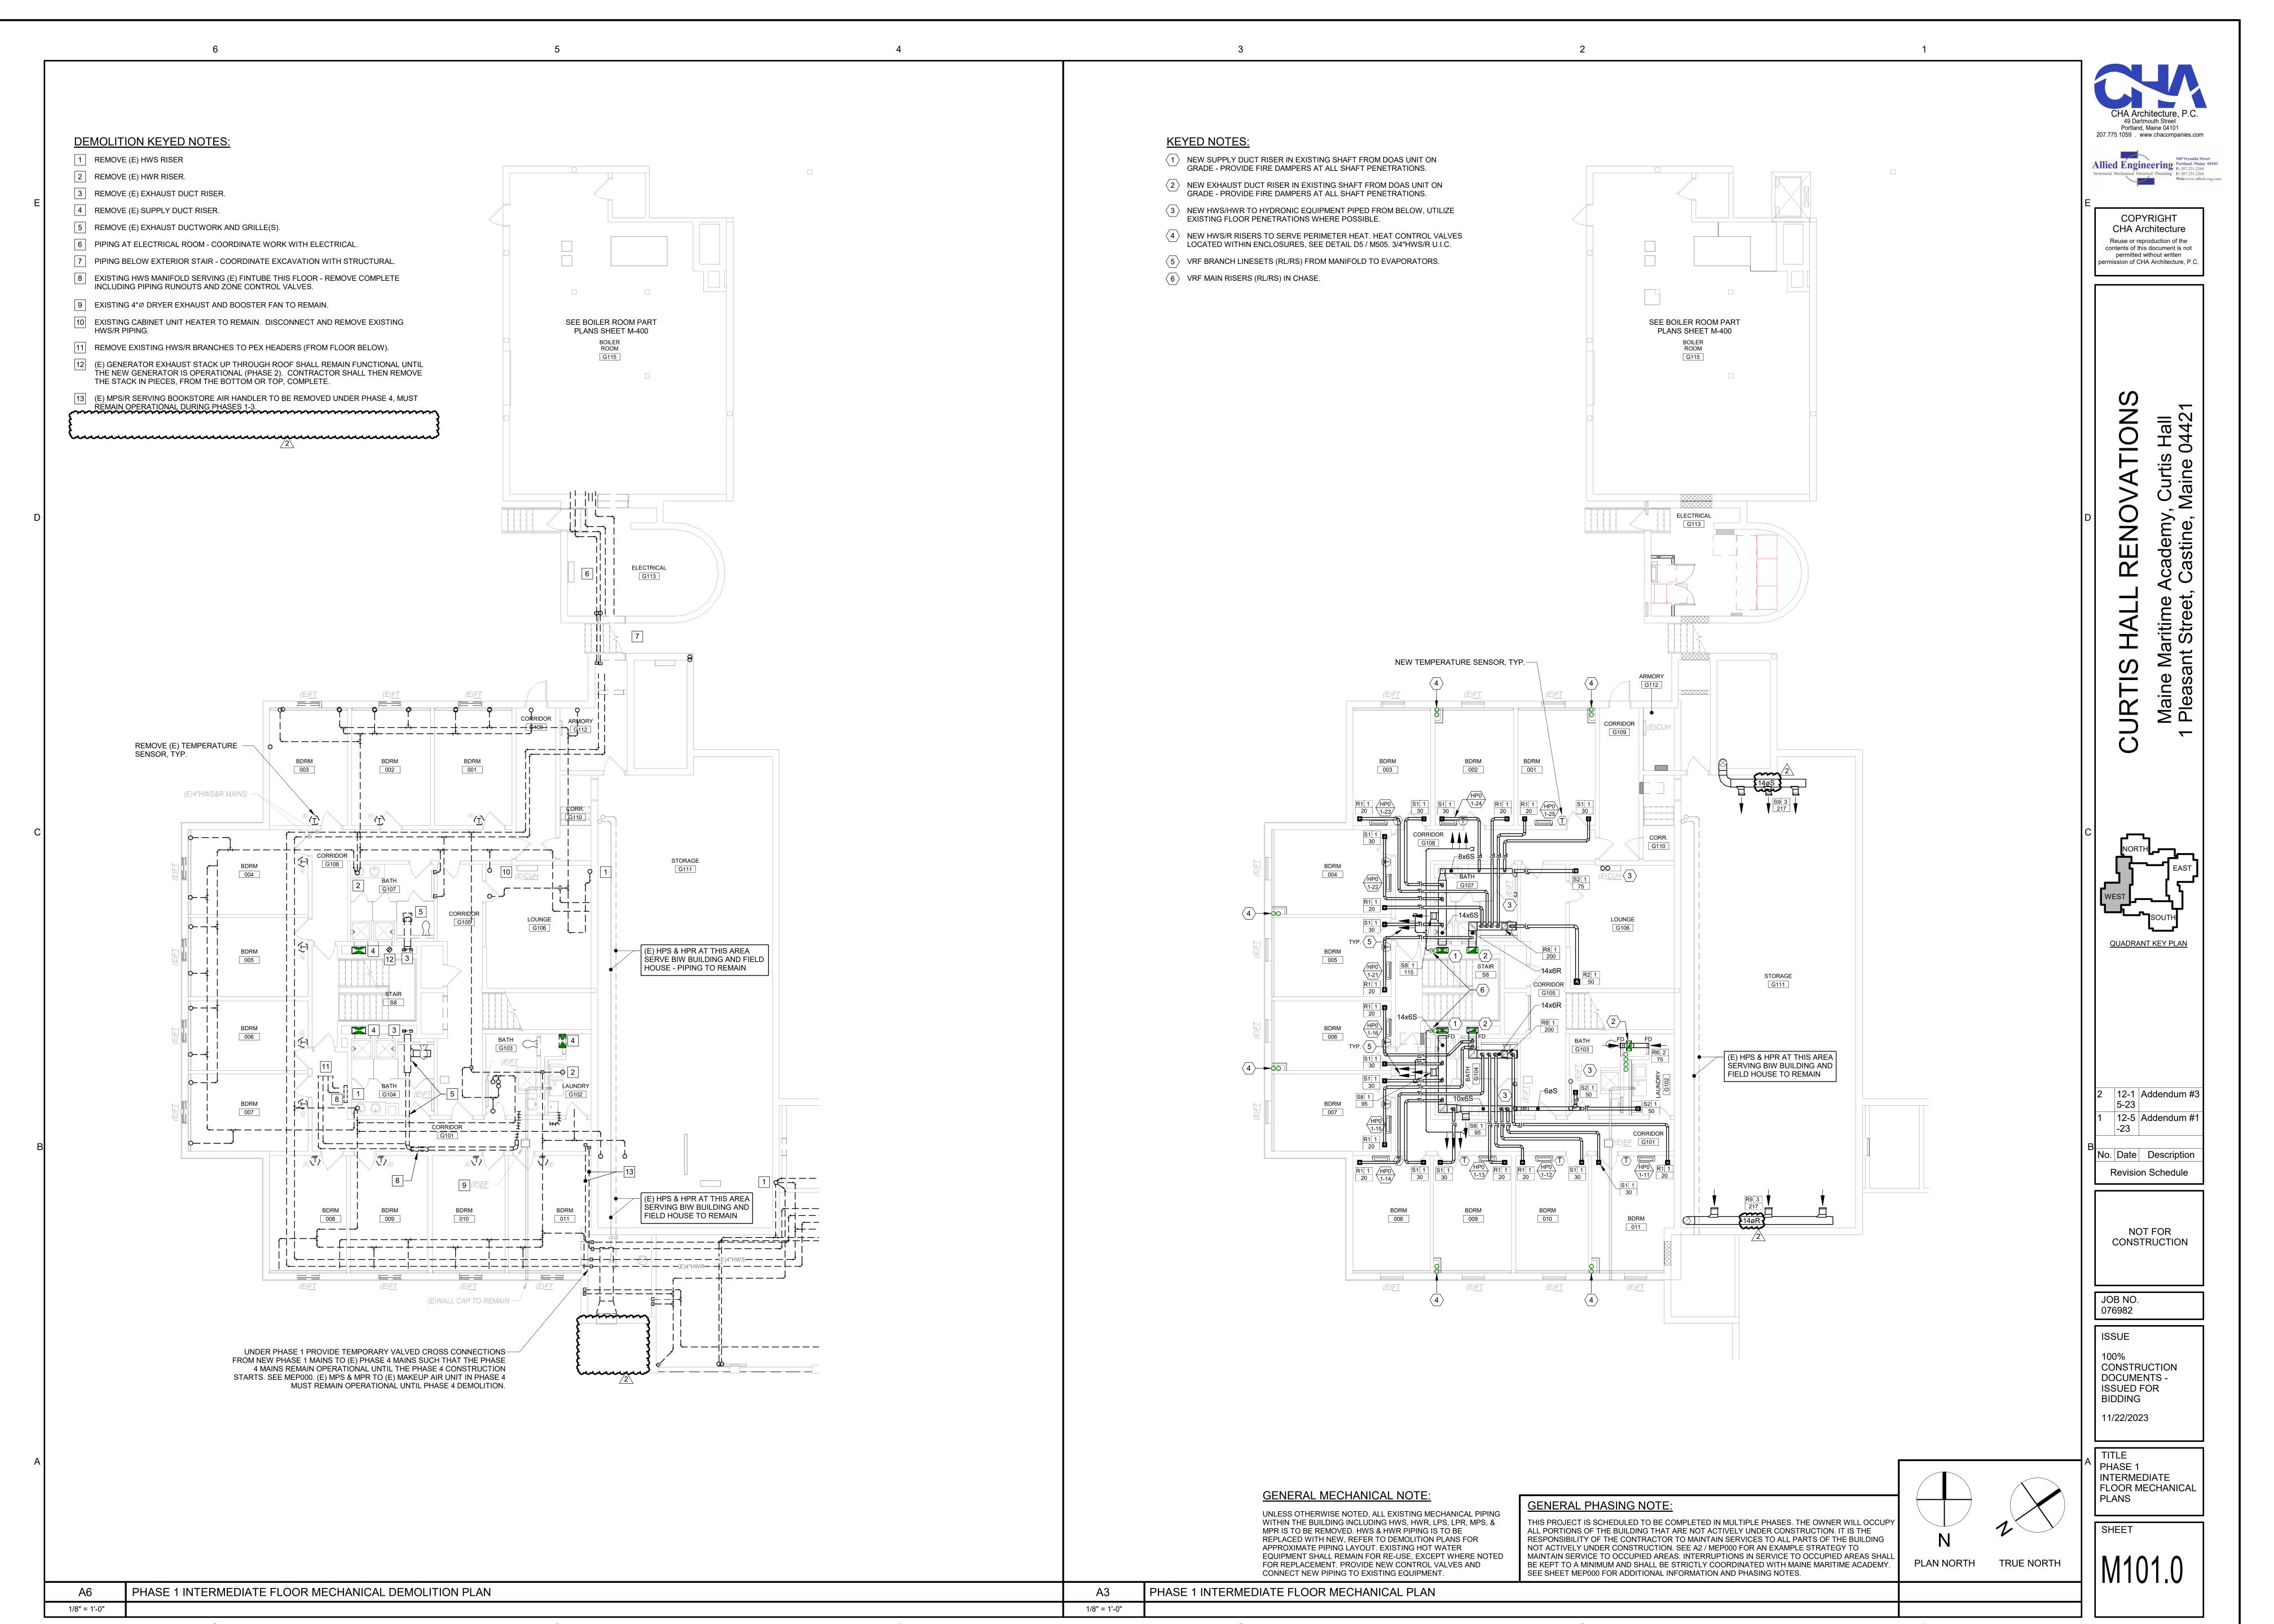

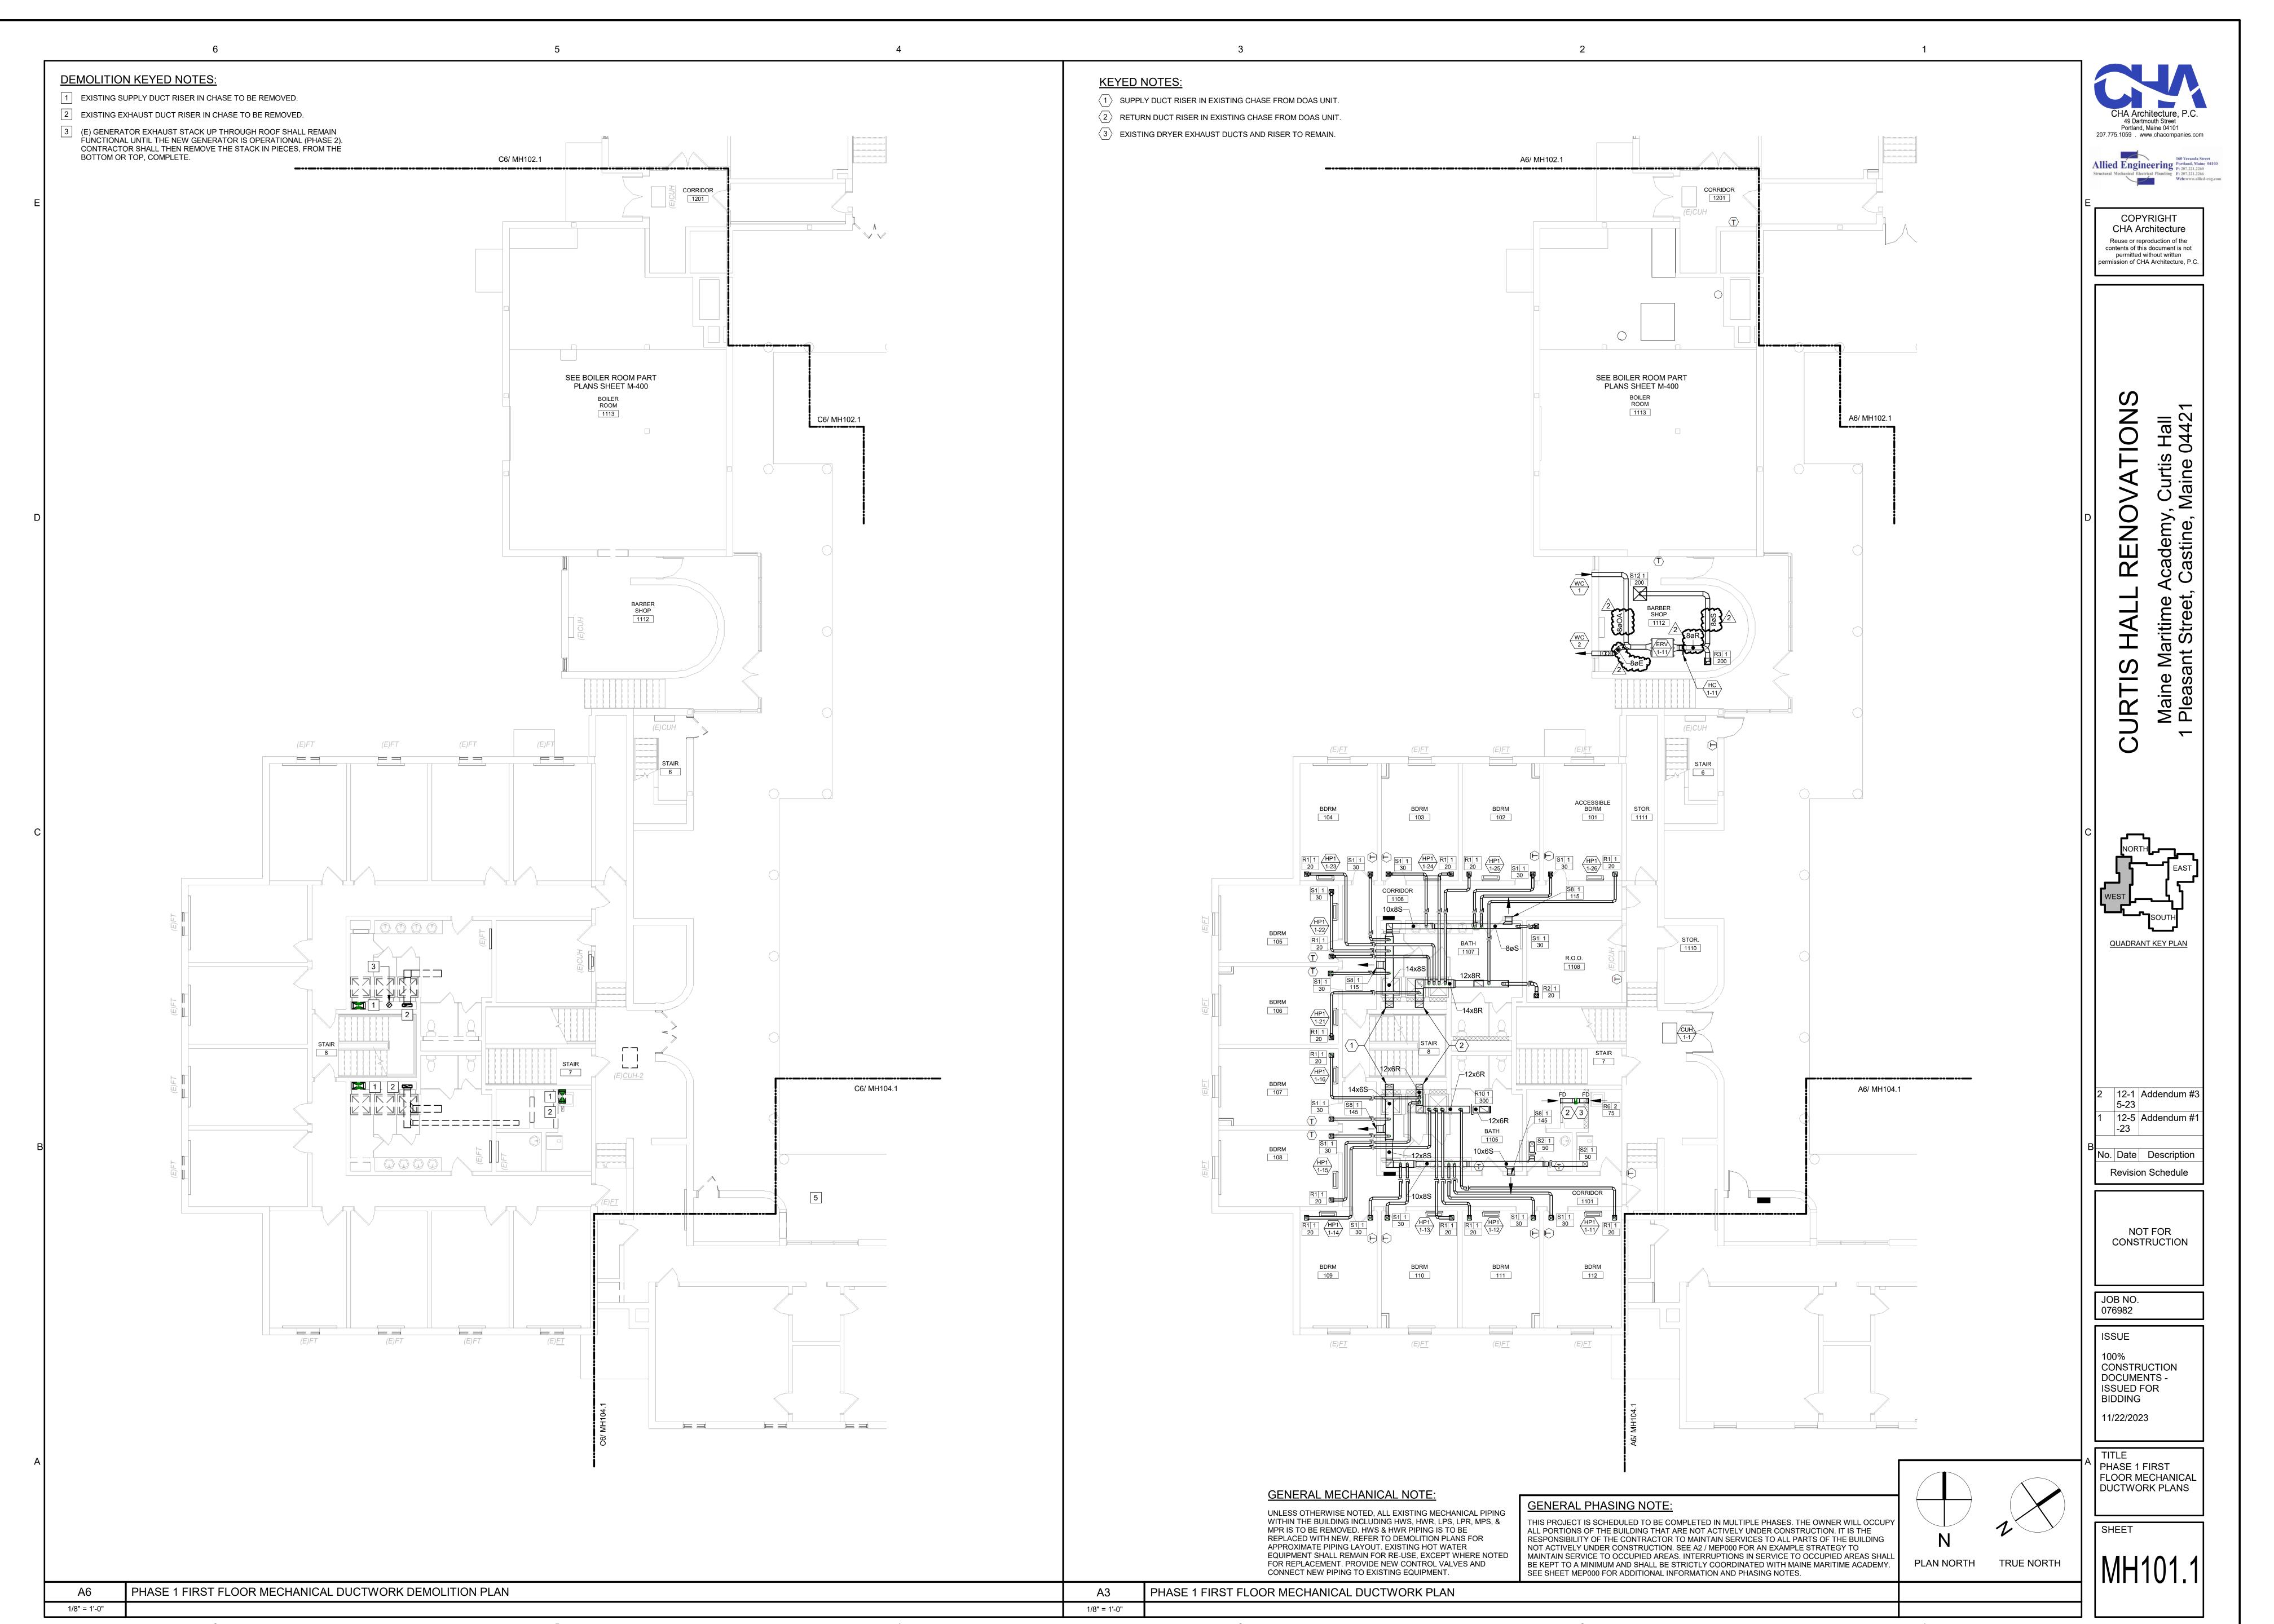

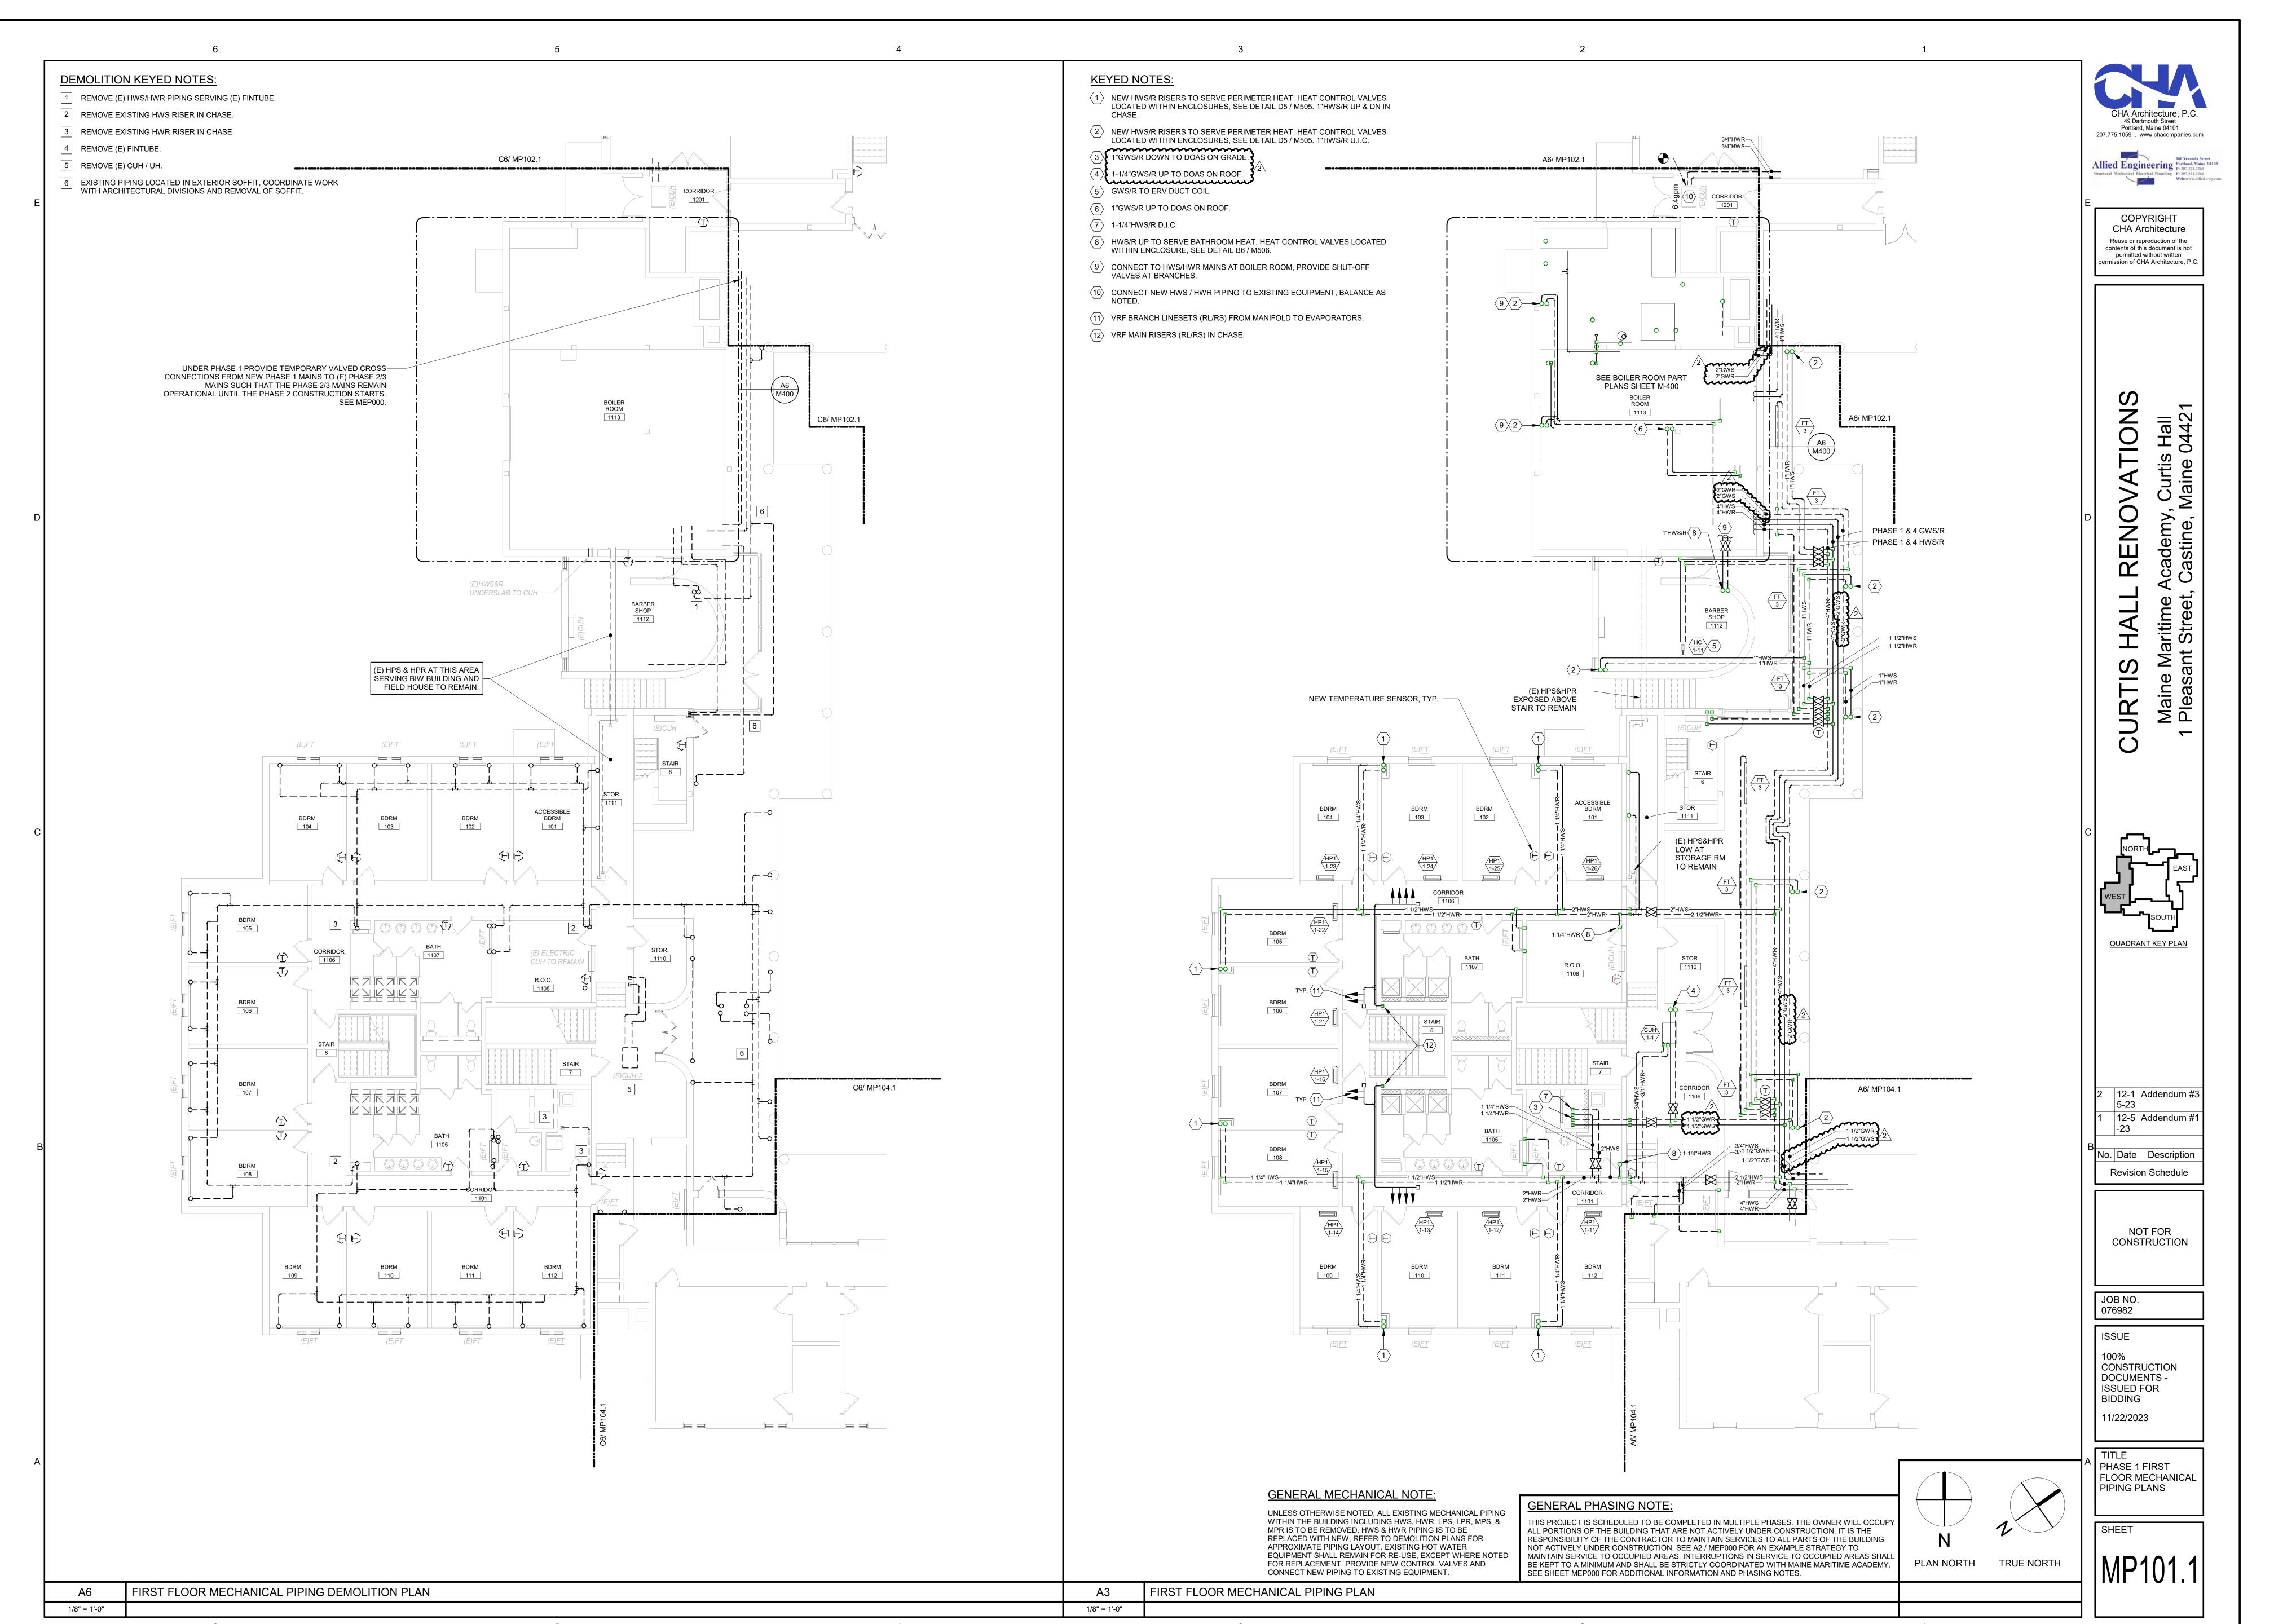

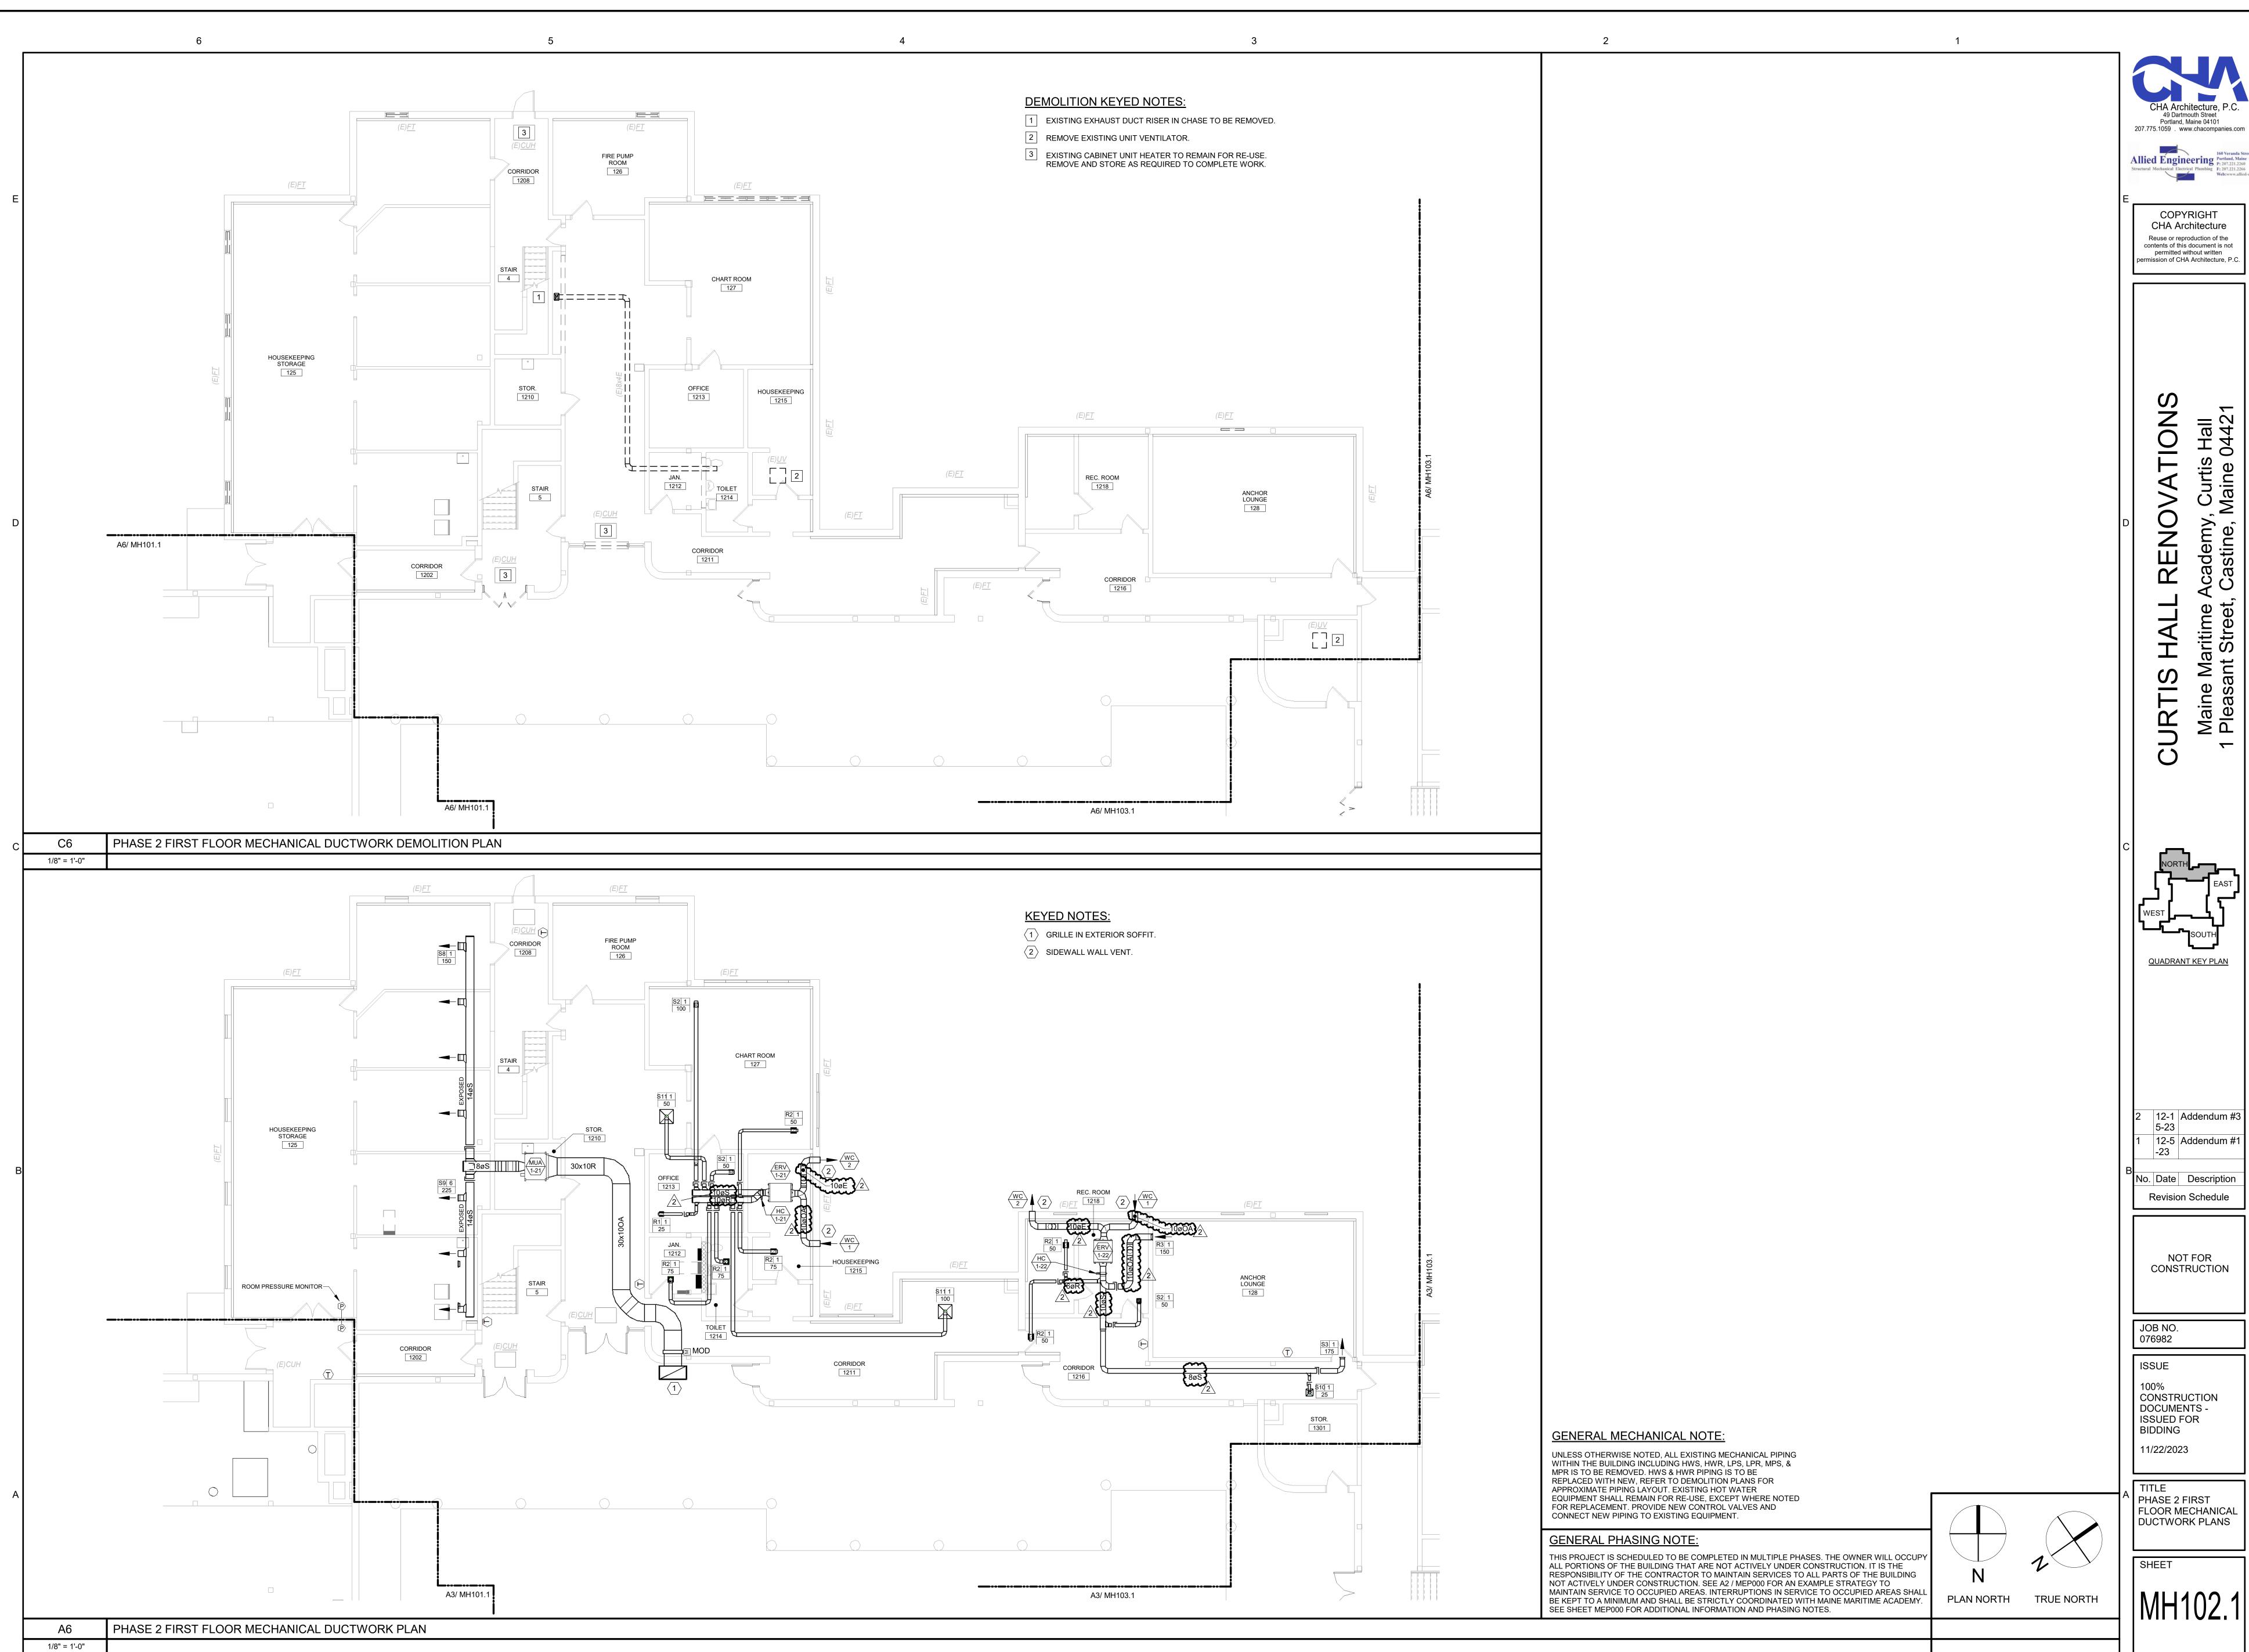


49 Dartmouth Street Portland, Maine 04101 207.775.1059 . www.chacompanies.com

Allied Engineering


Portland, Maine 04103
P; 207,221,2260


F; 207,221,2266
Web:www.allied-eng.com

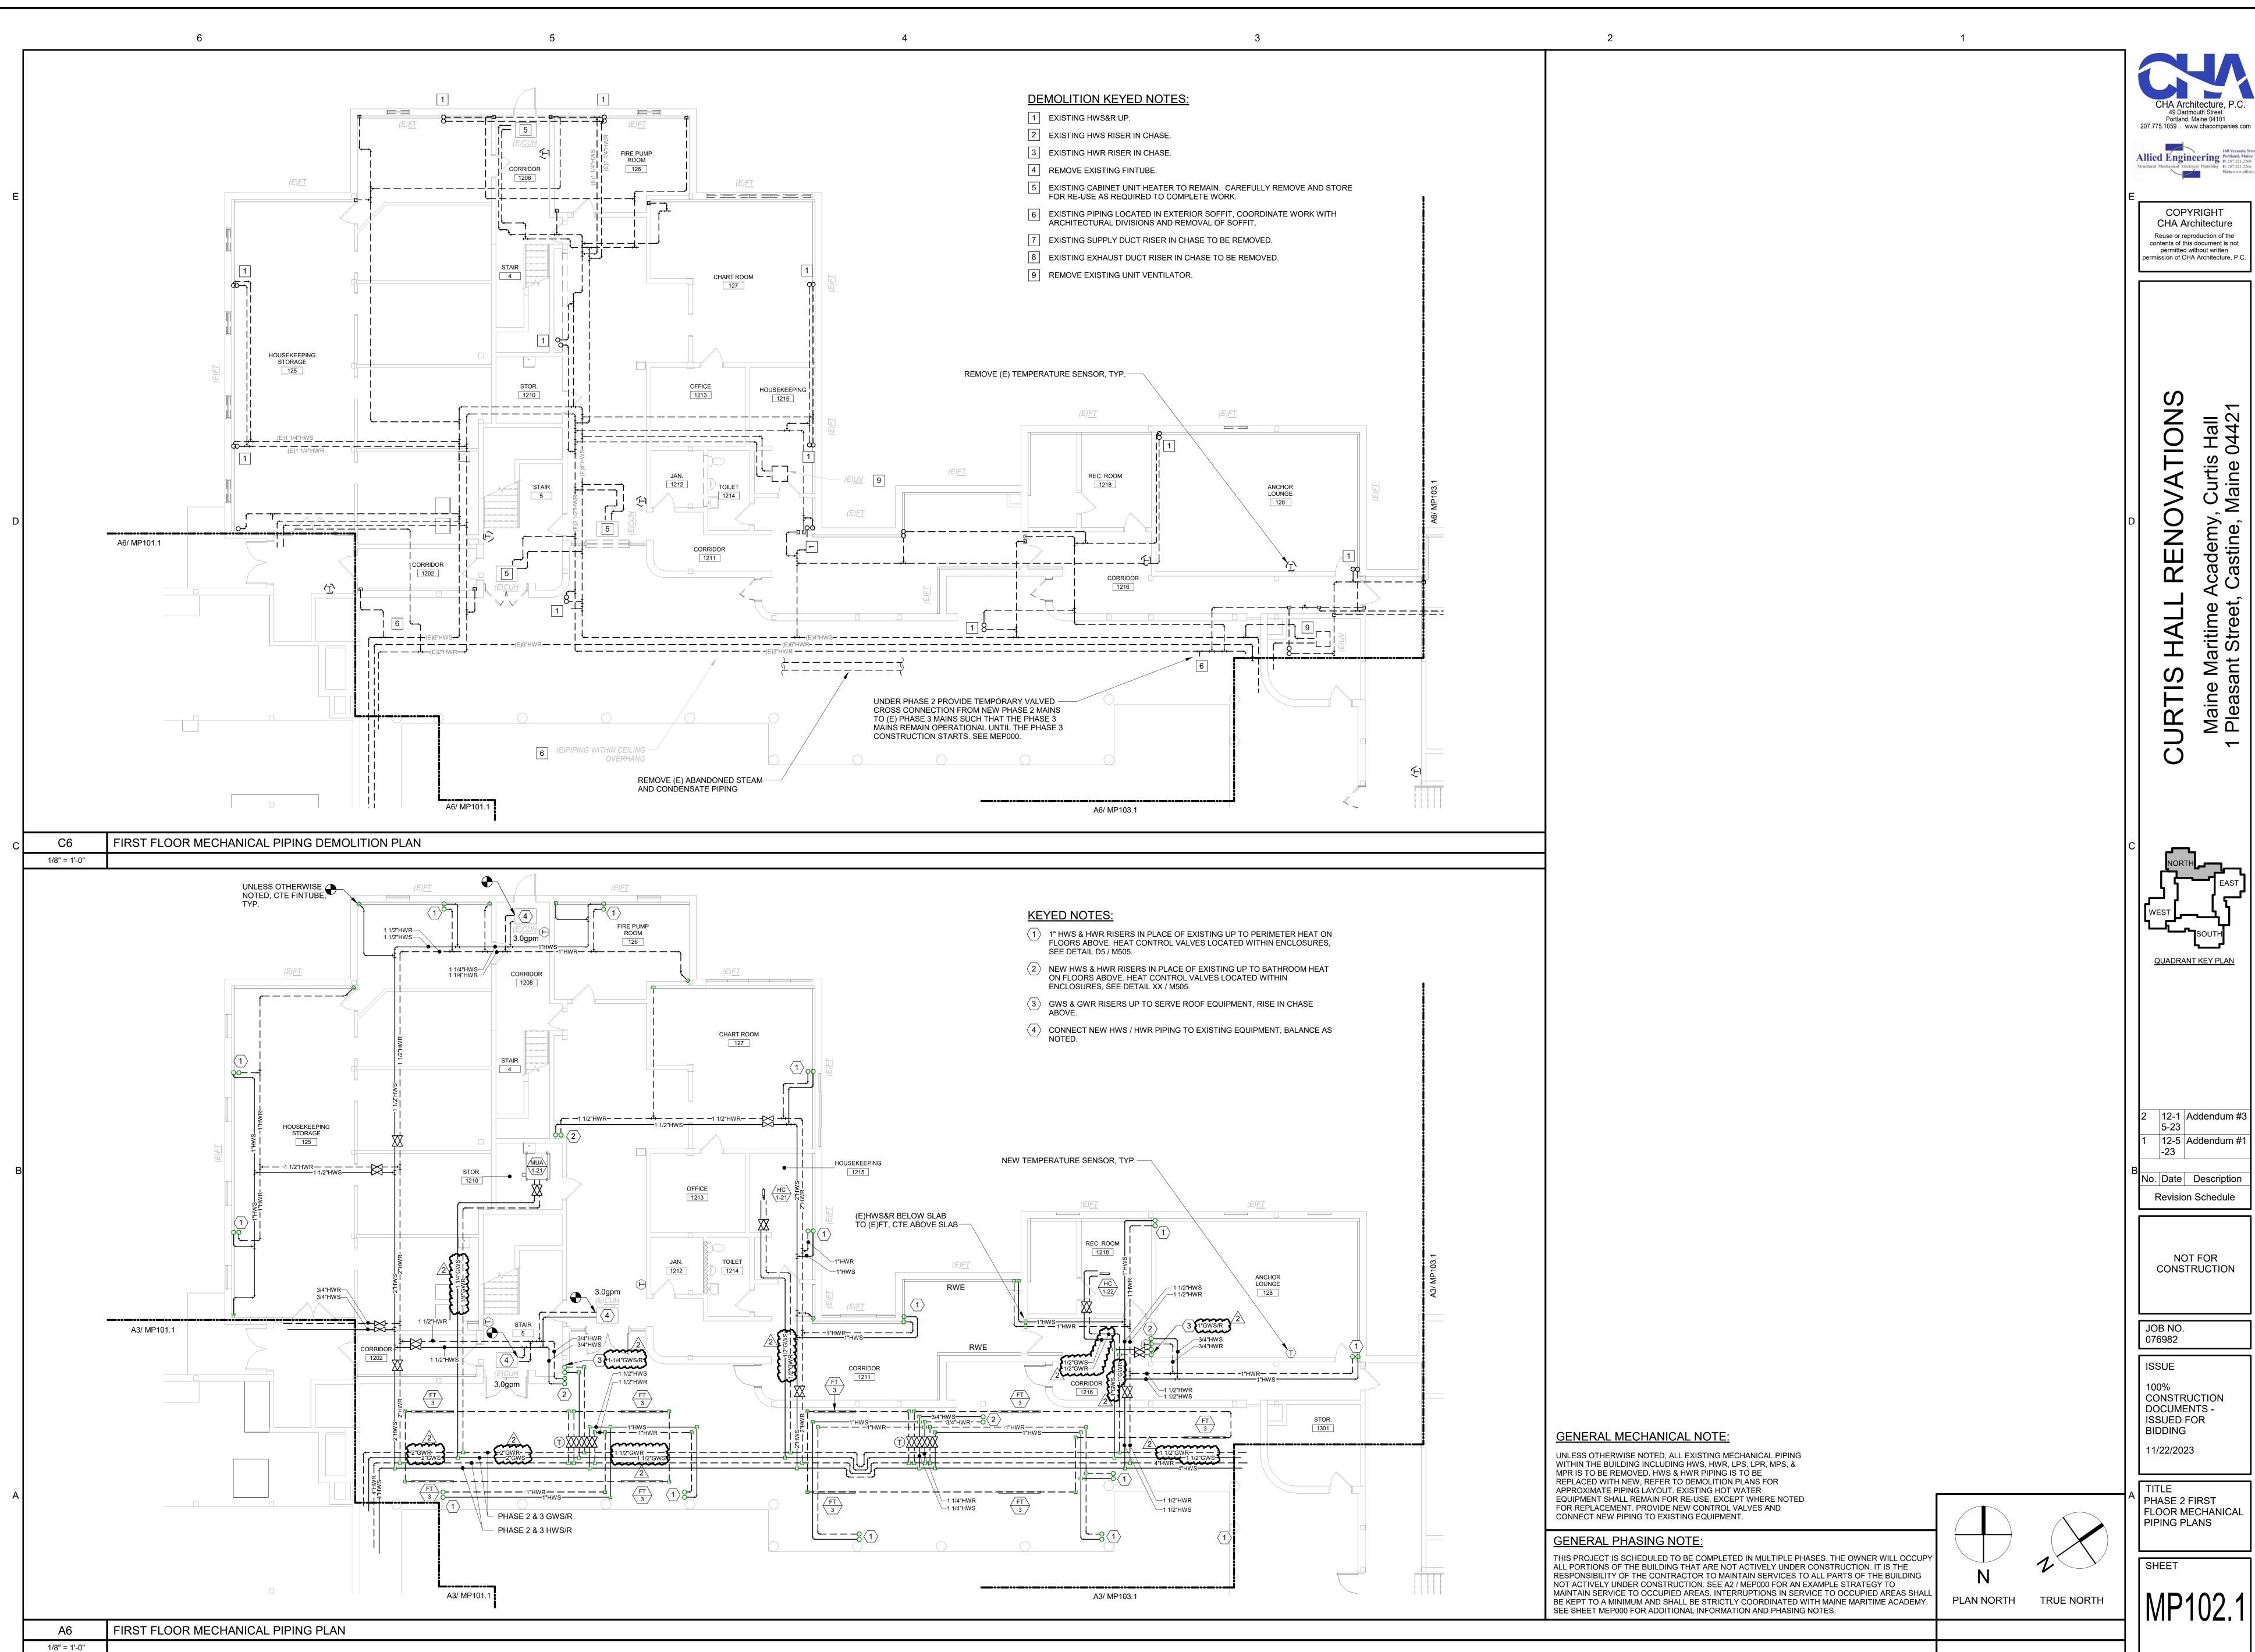


207.775.1059 www.chacompanies.com


Allied Engineering Portland, Maine 04103 Pr. 207.221.2260
Structural Mechanical Electrical Plumbing Fr. 207.221.2266

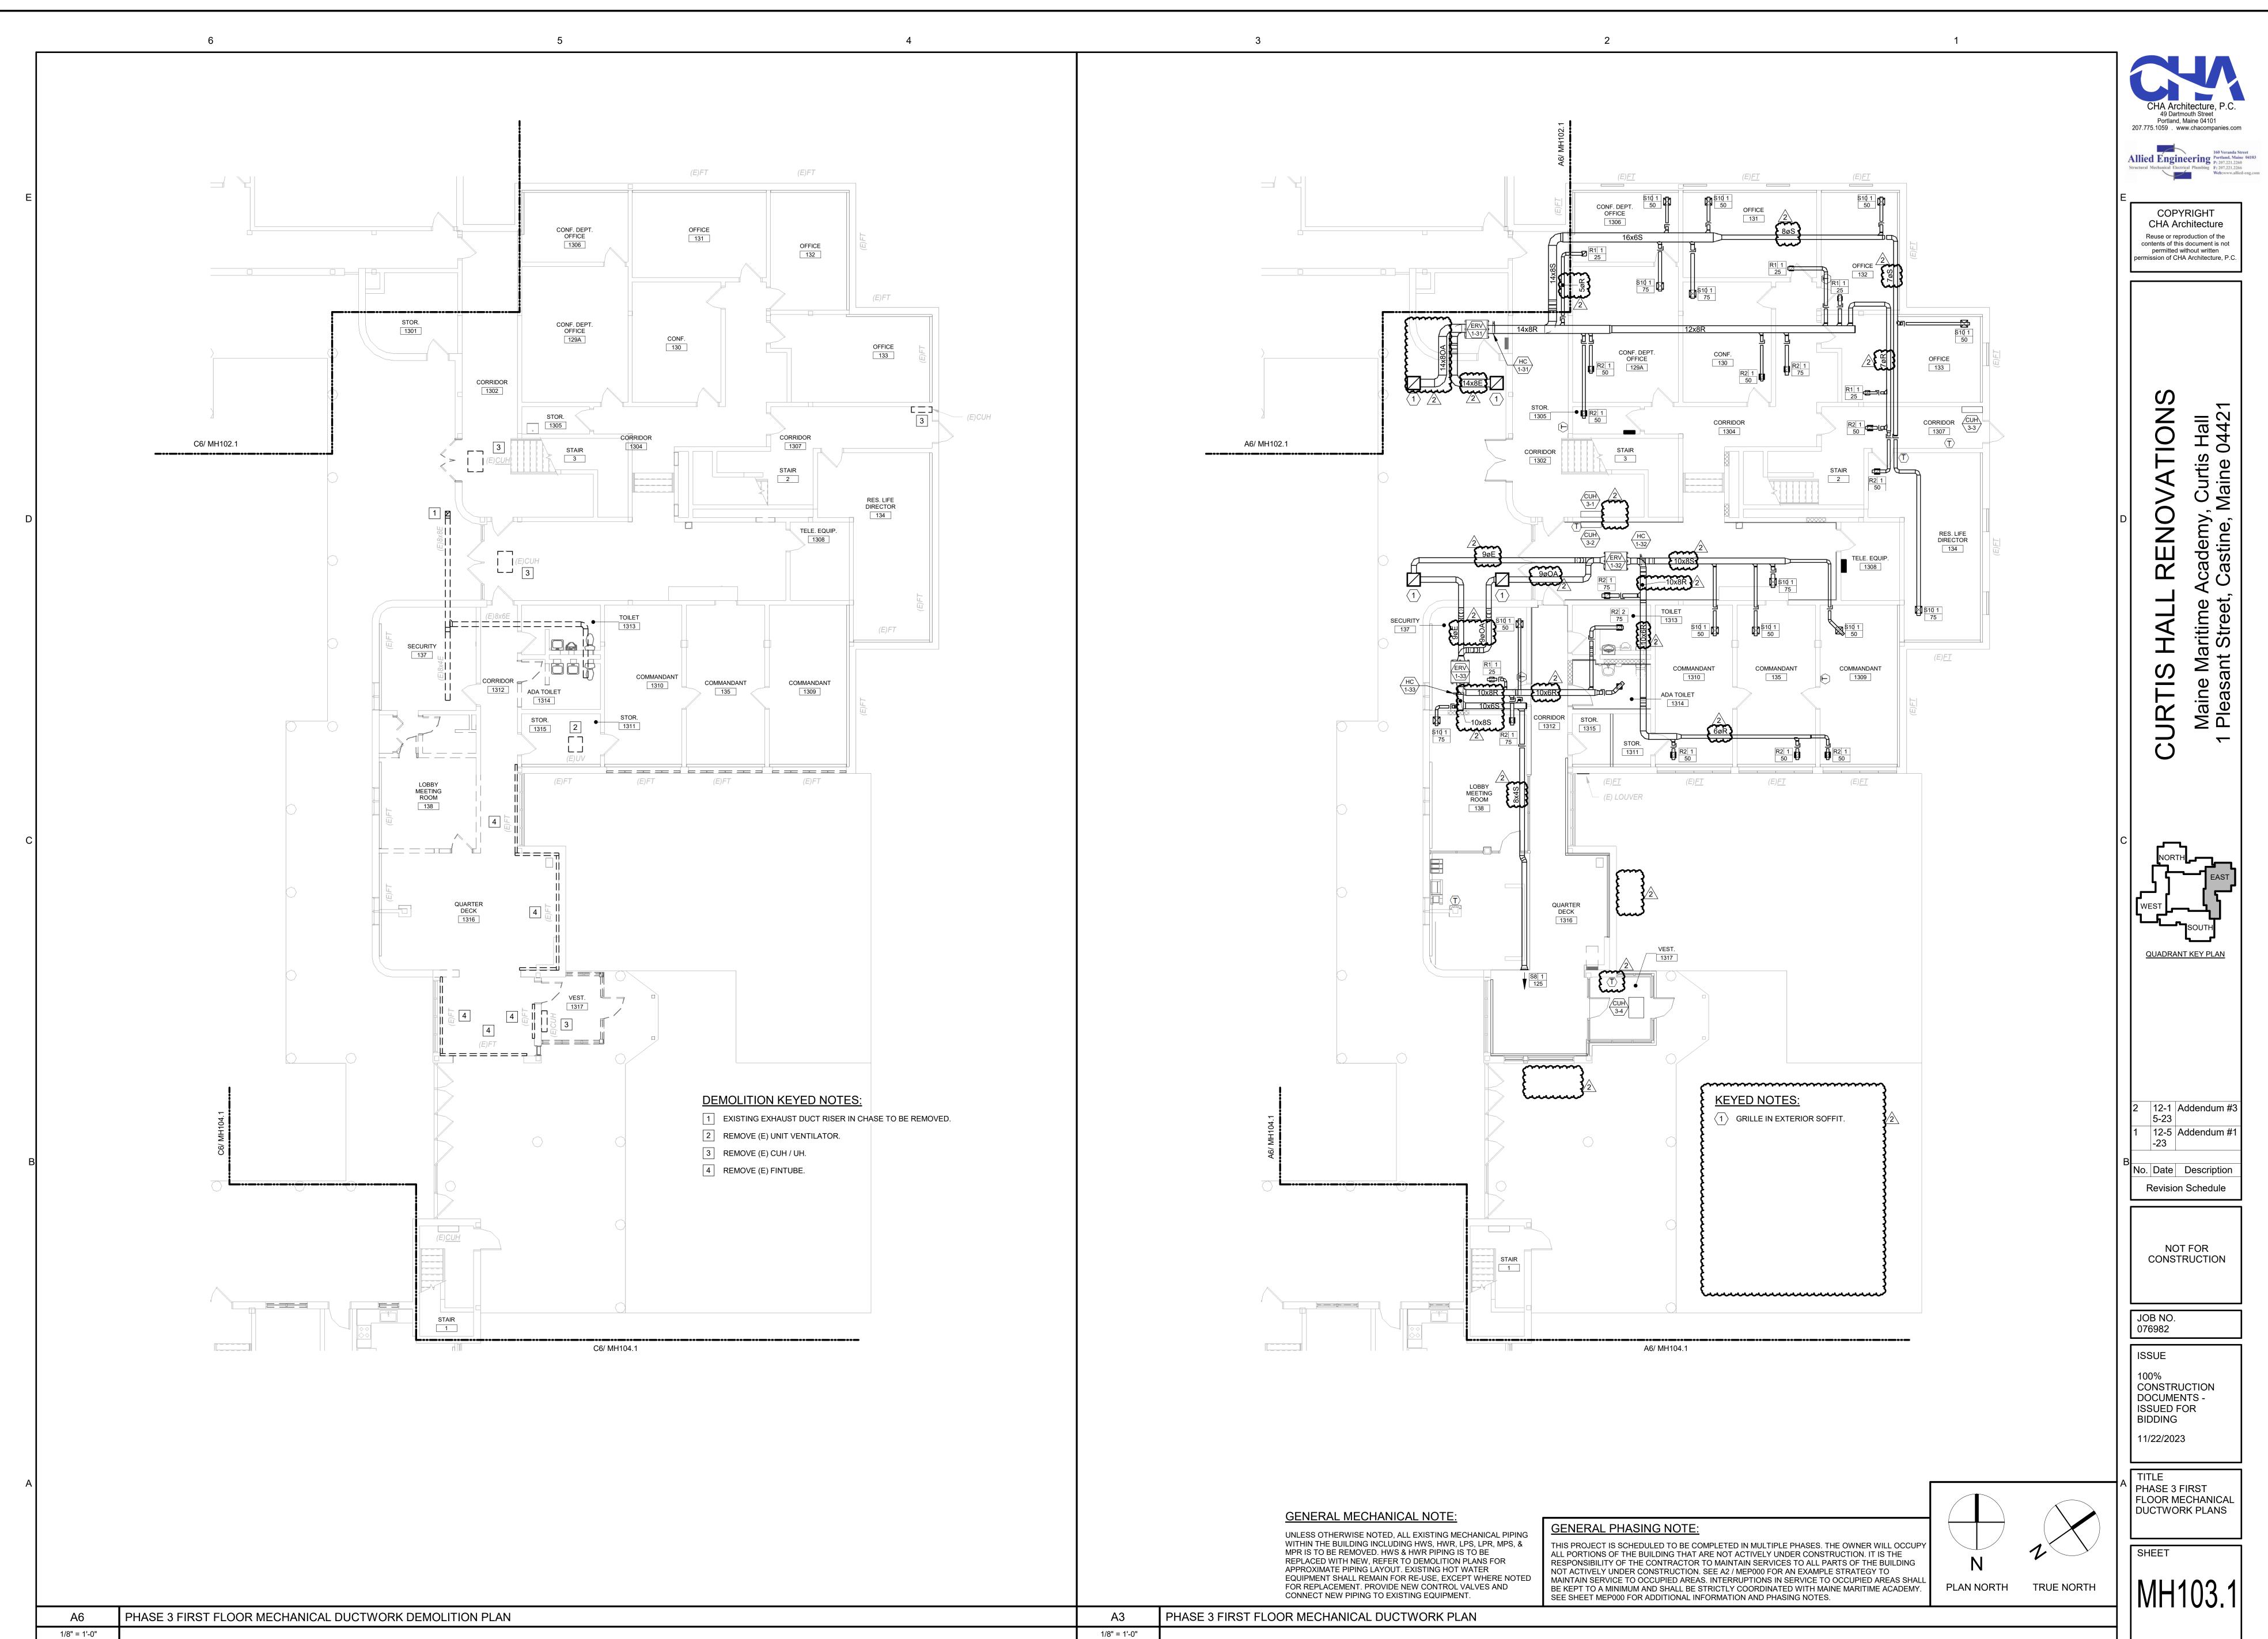

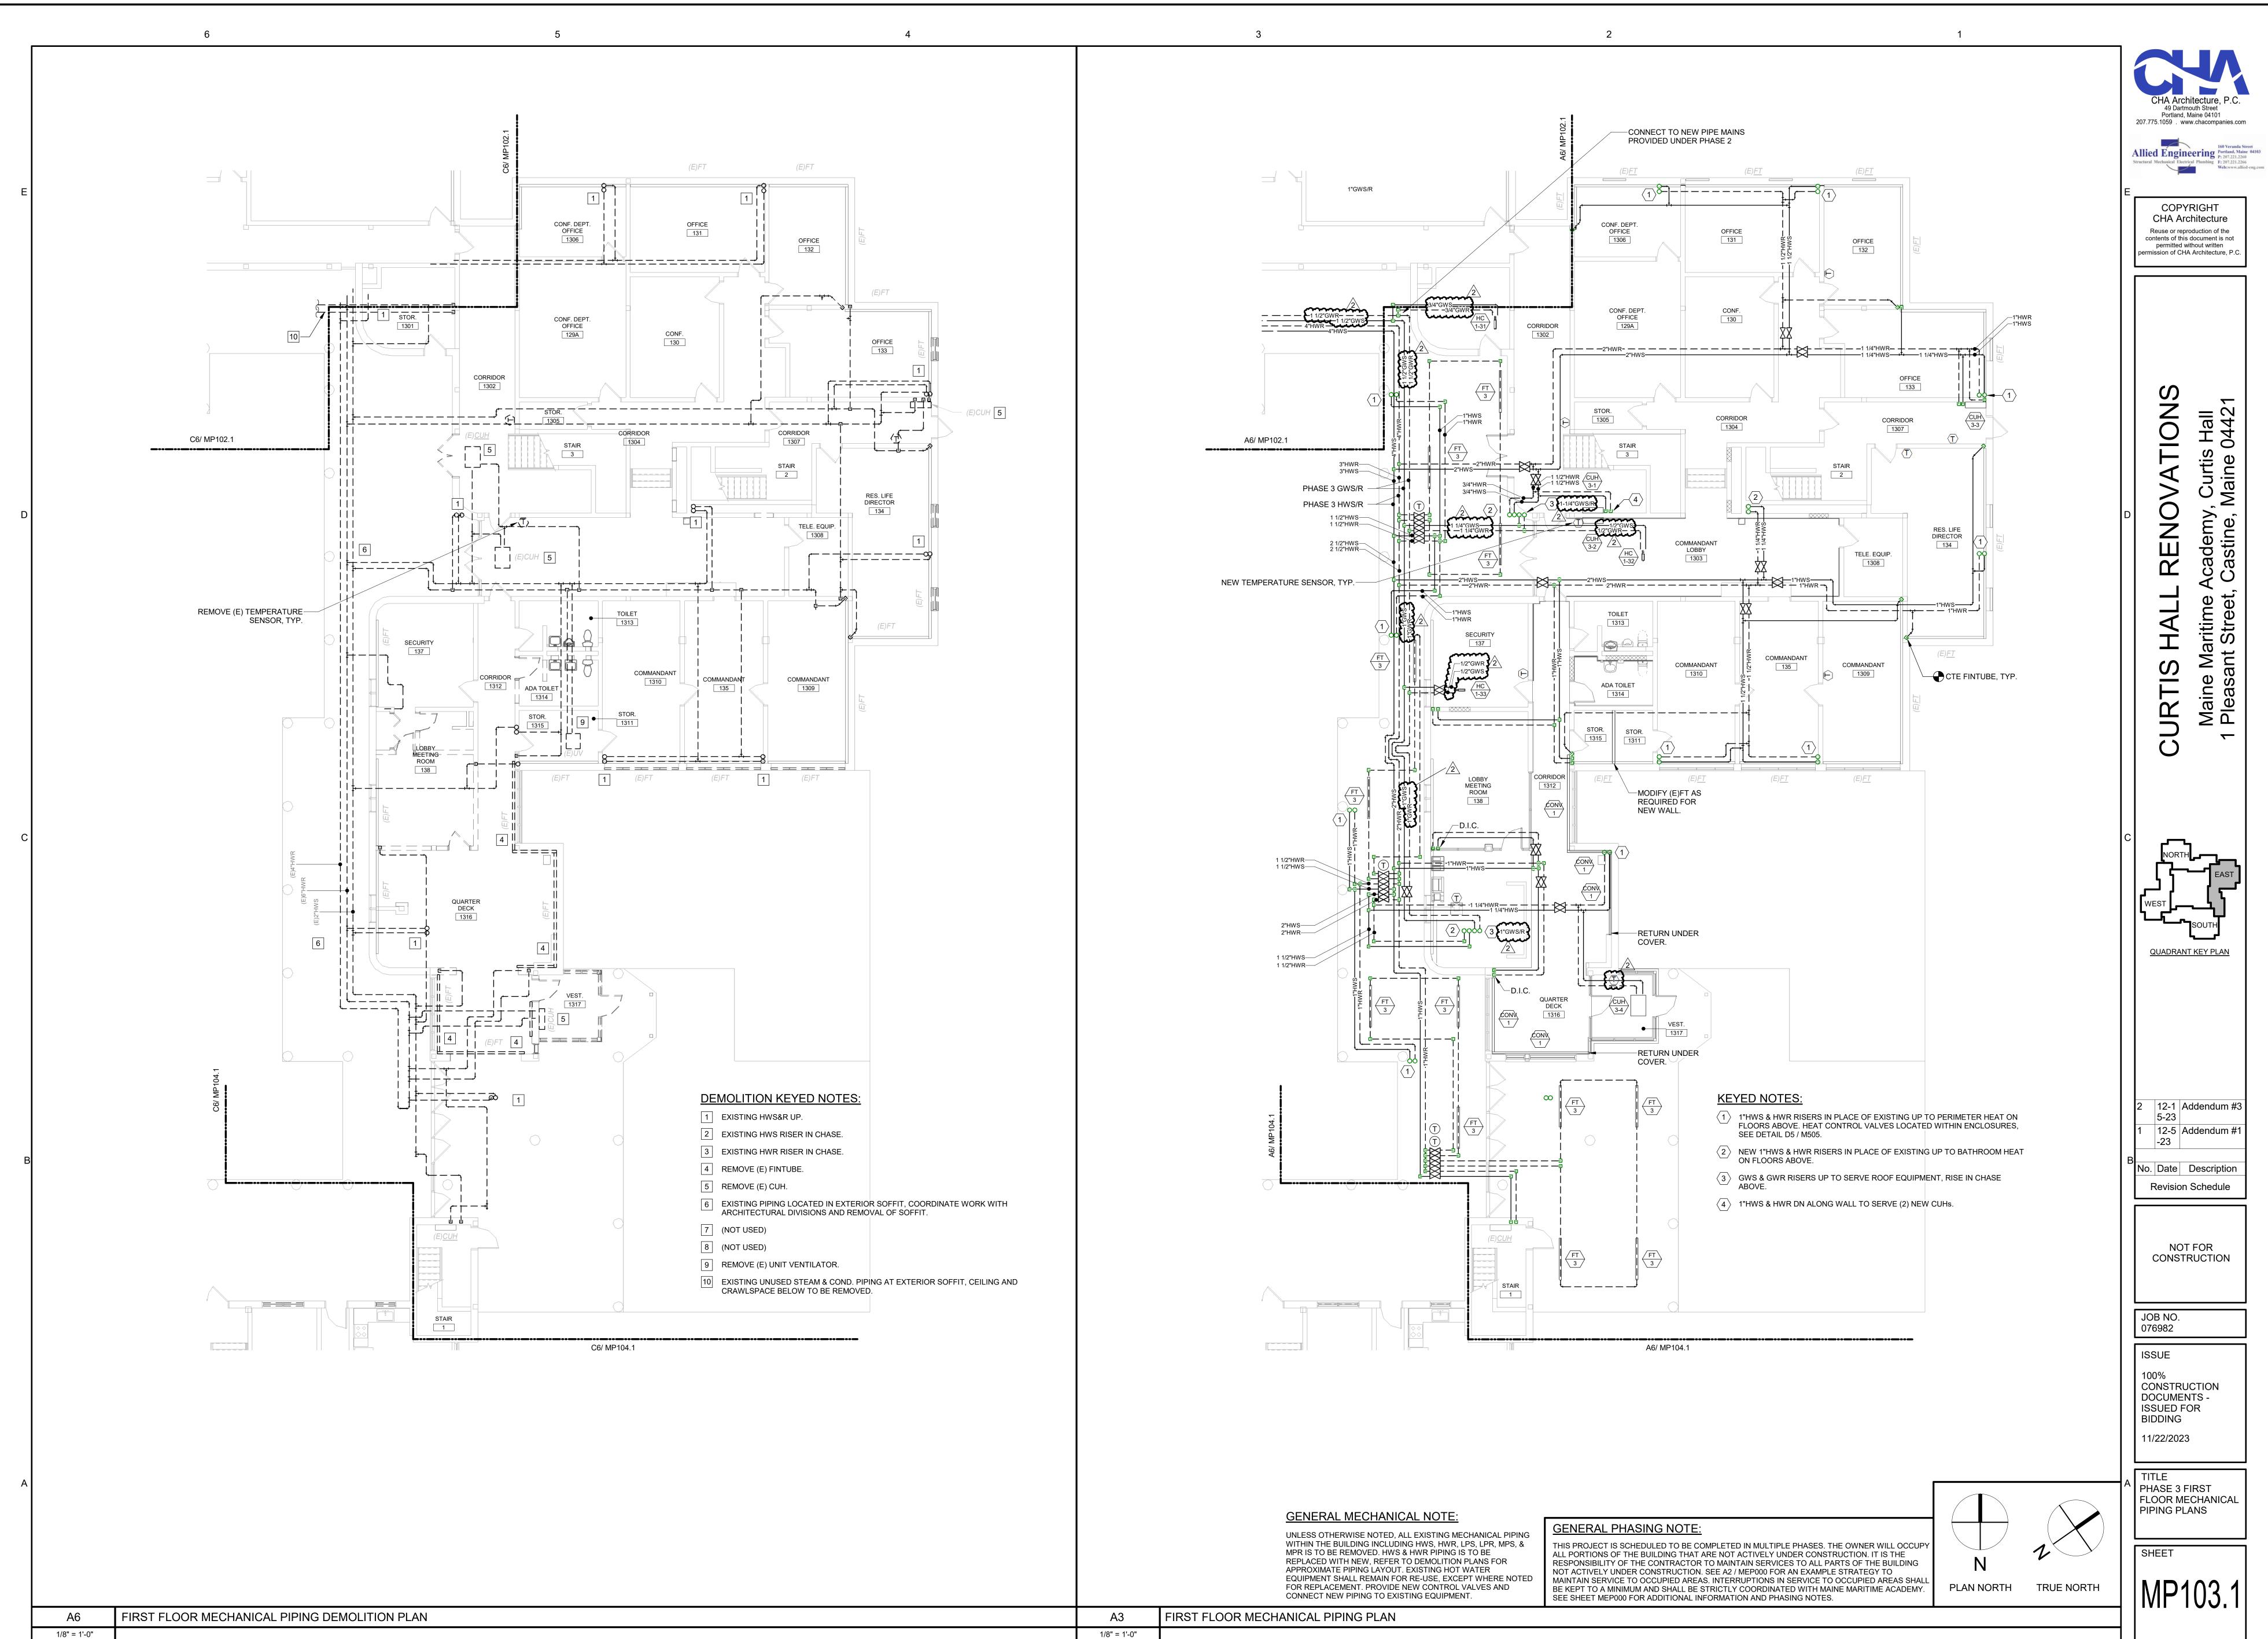


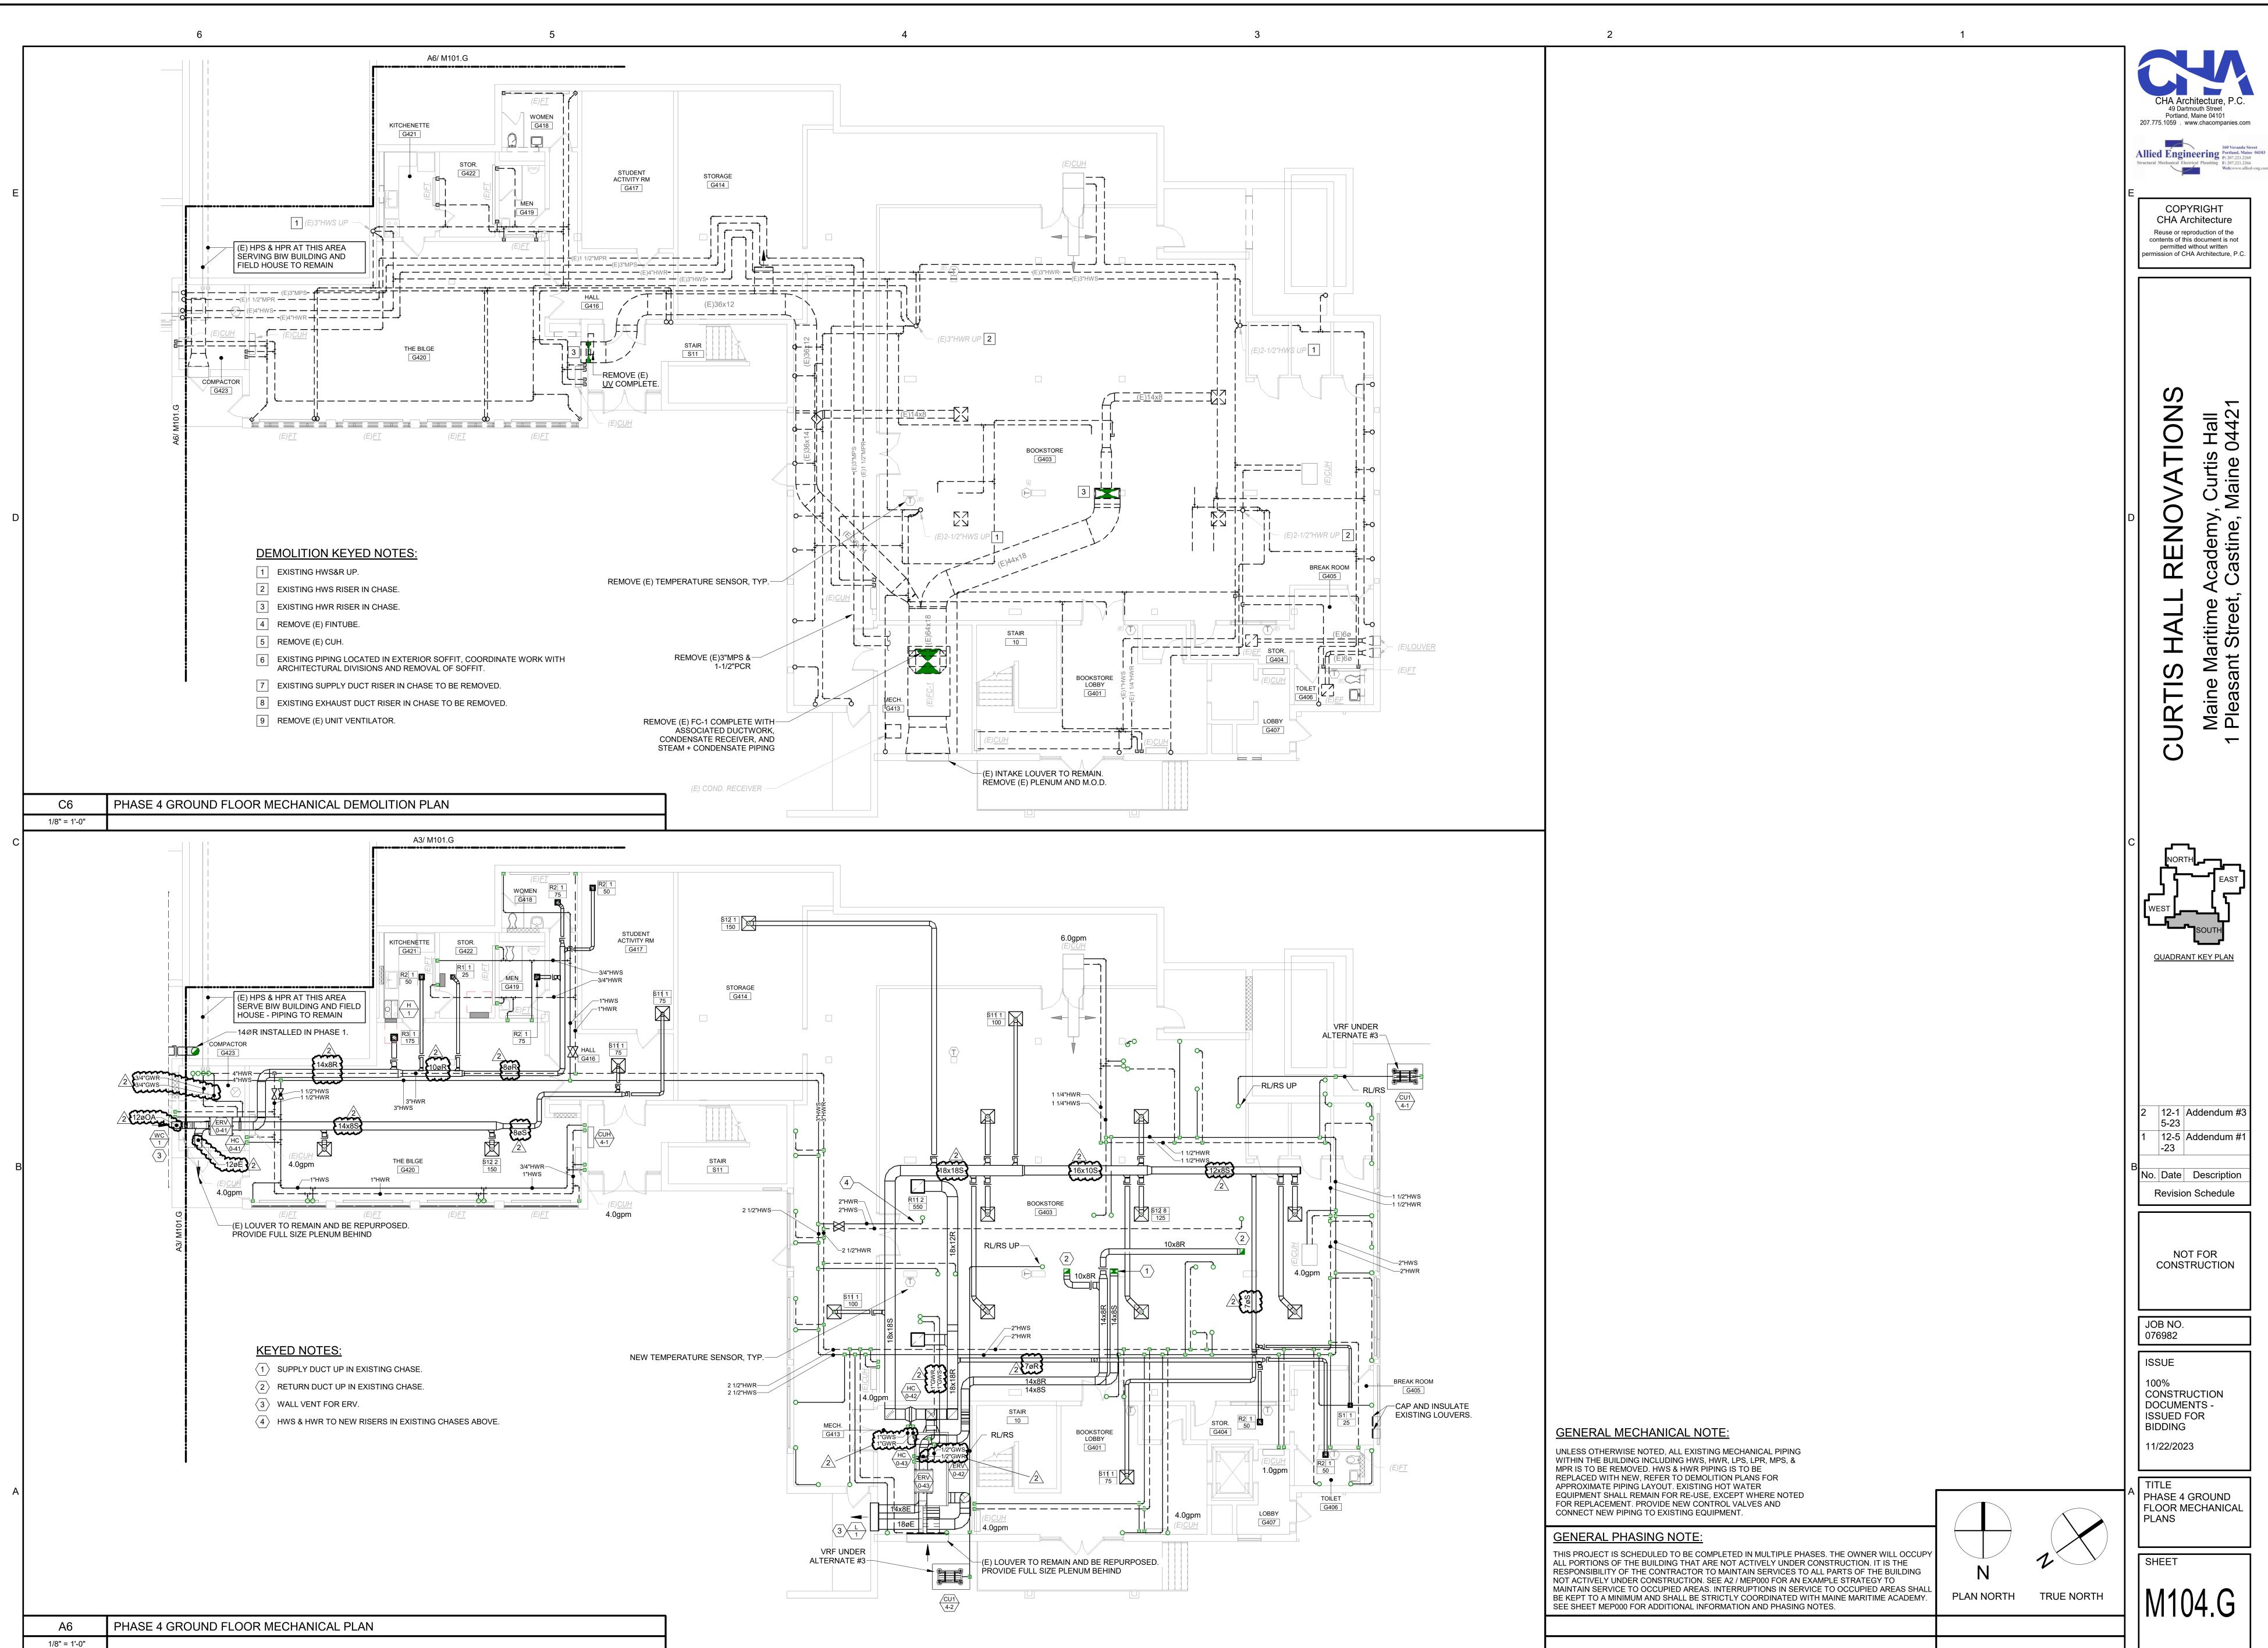



207.775.1059 www.chacompanies.com

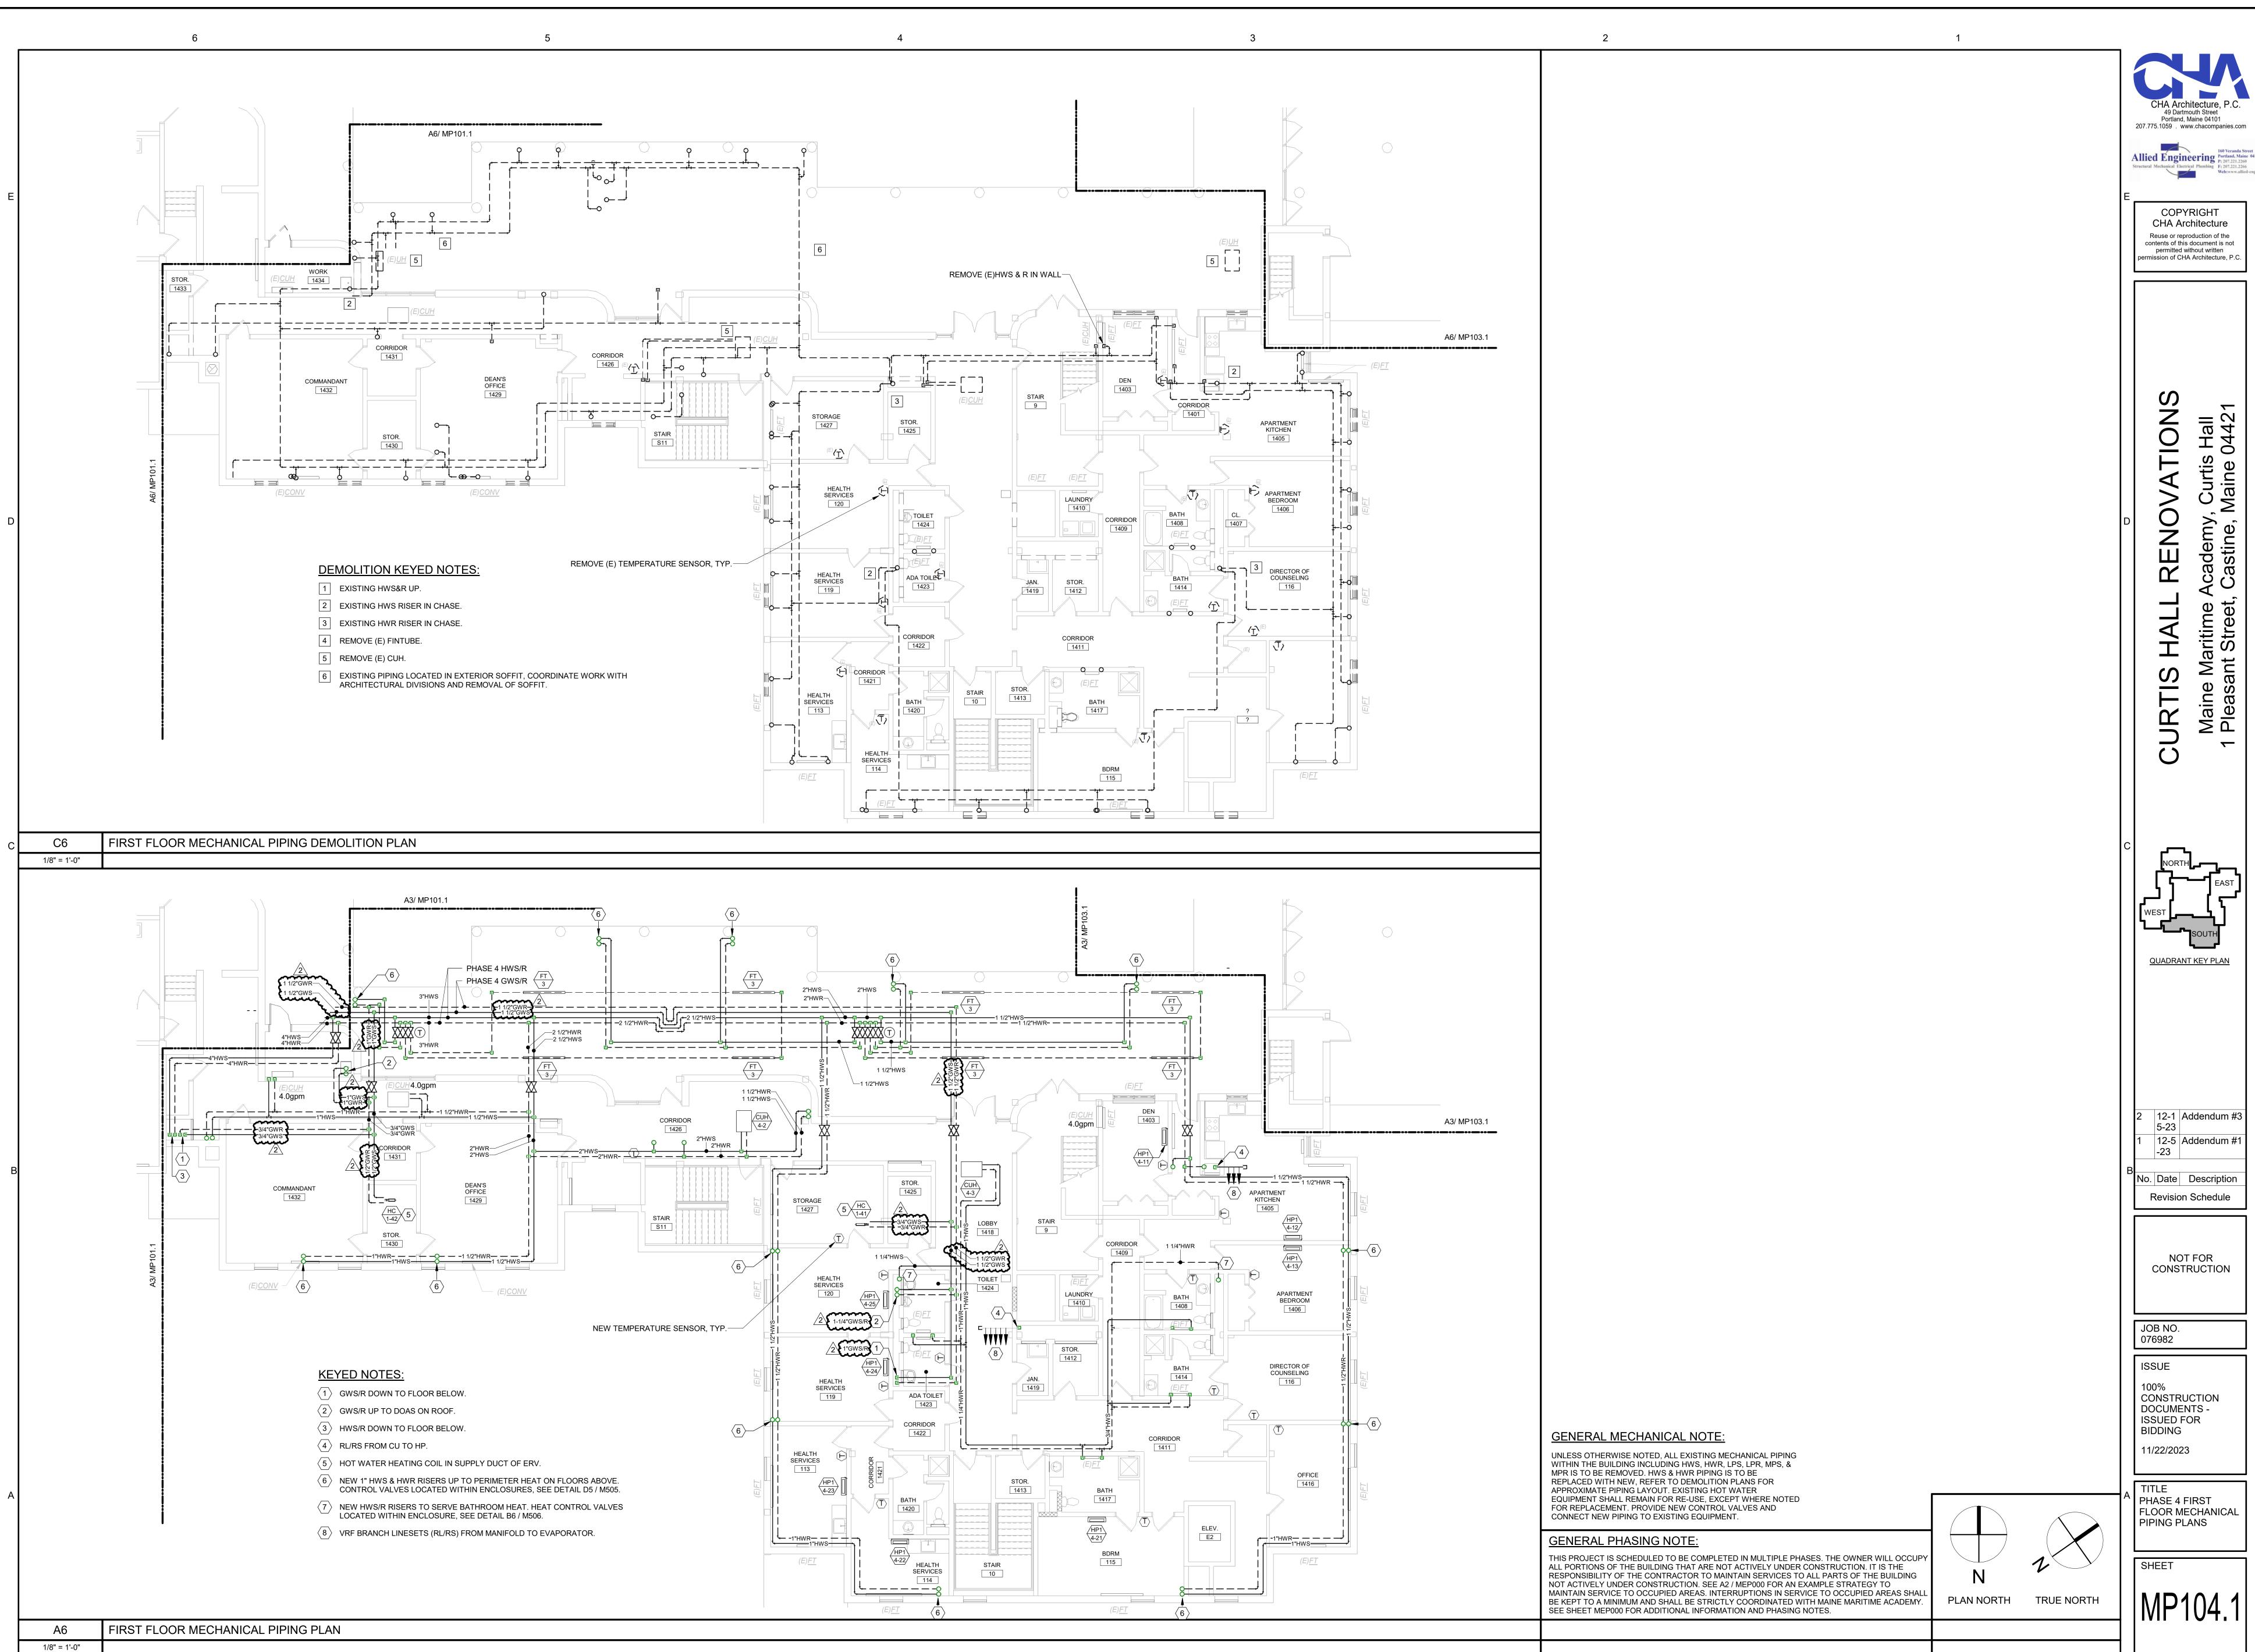


Allied Engineering Portland, Maine 04103
P; 207,221,2266
Structural Mechanical Electrical Plumbing F; 207,221,2266
Web:www.allied-eng.com

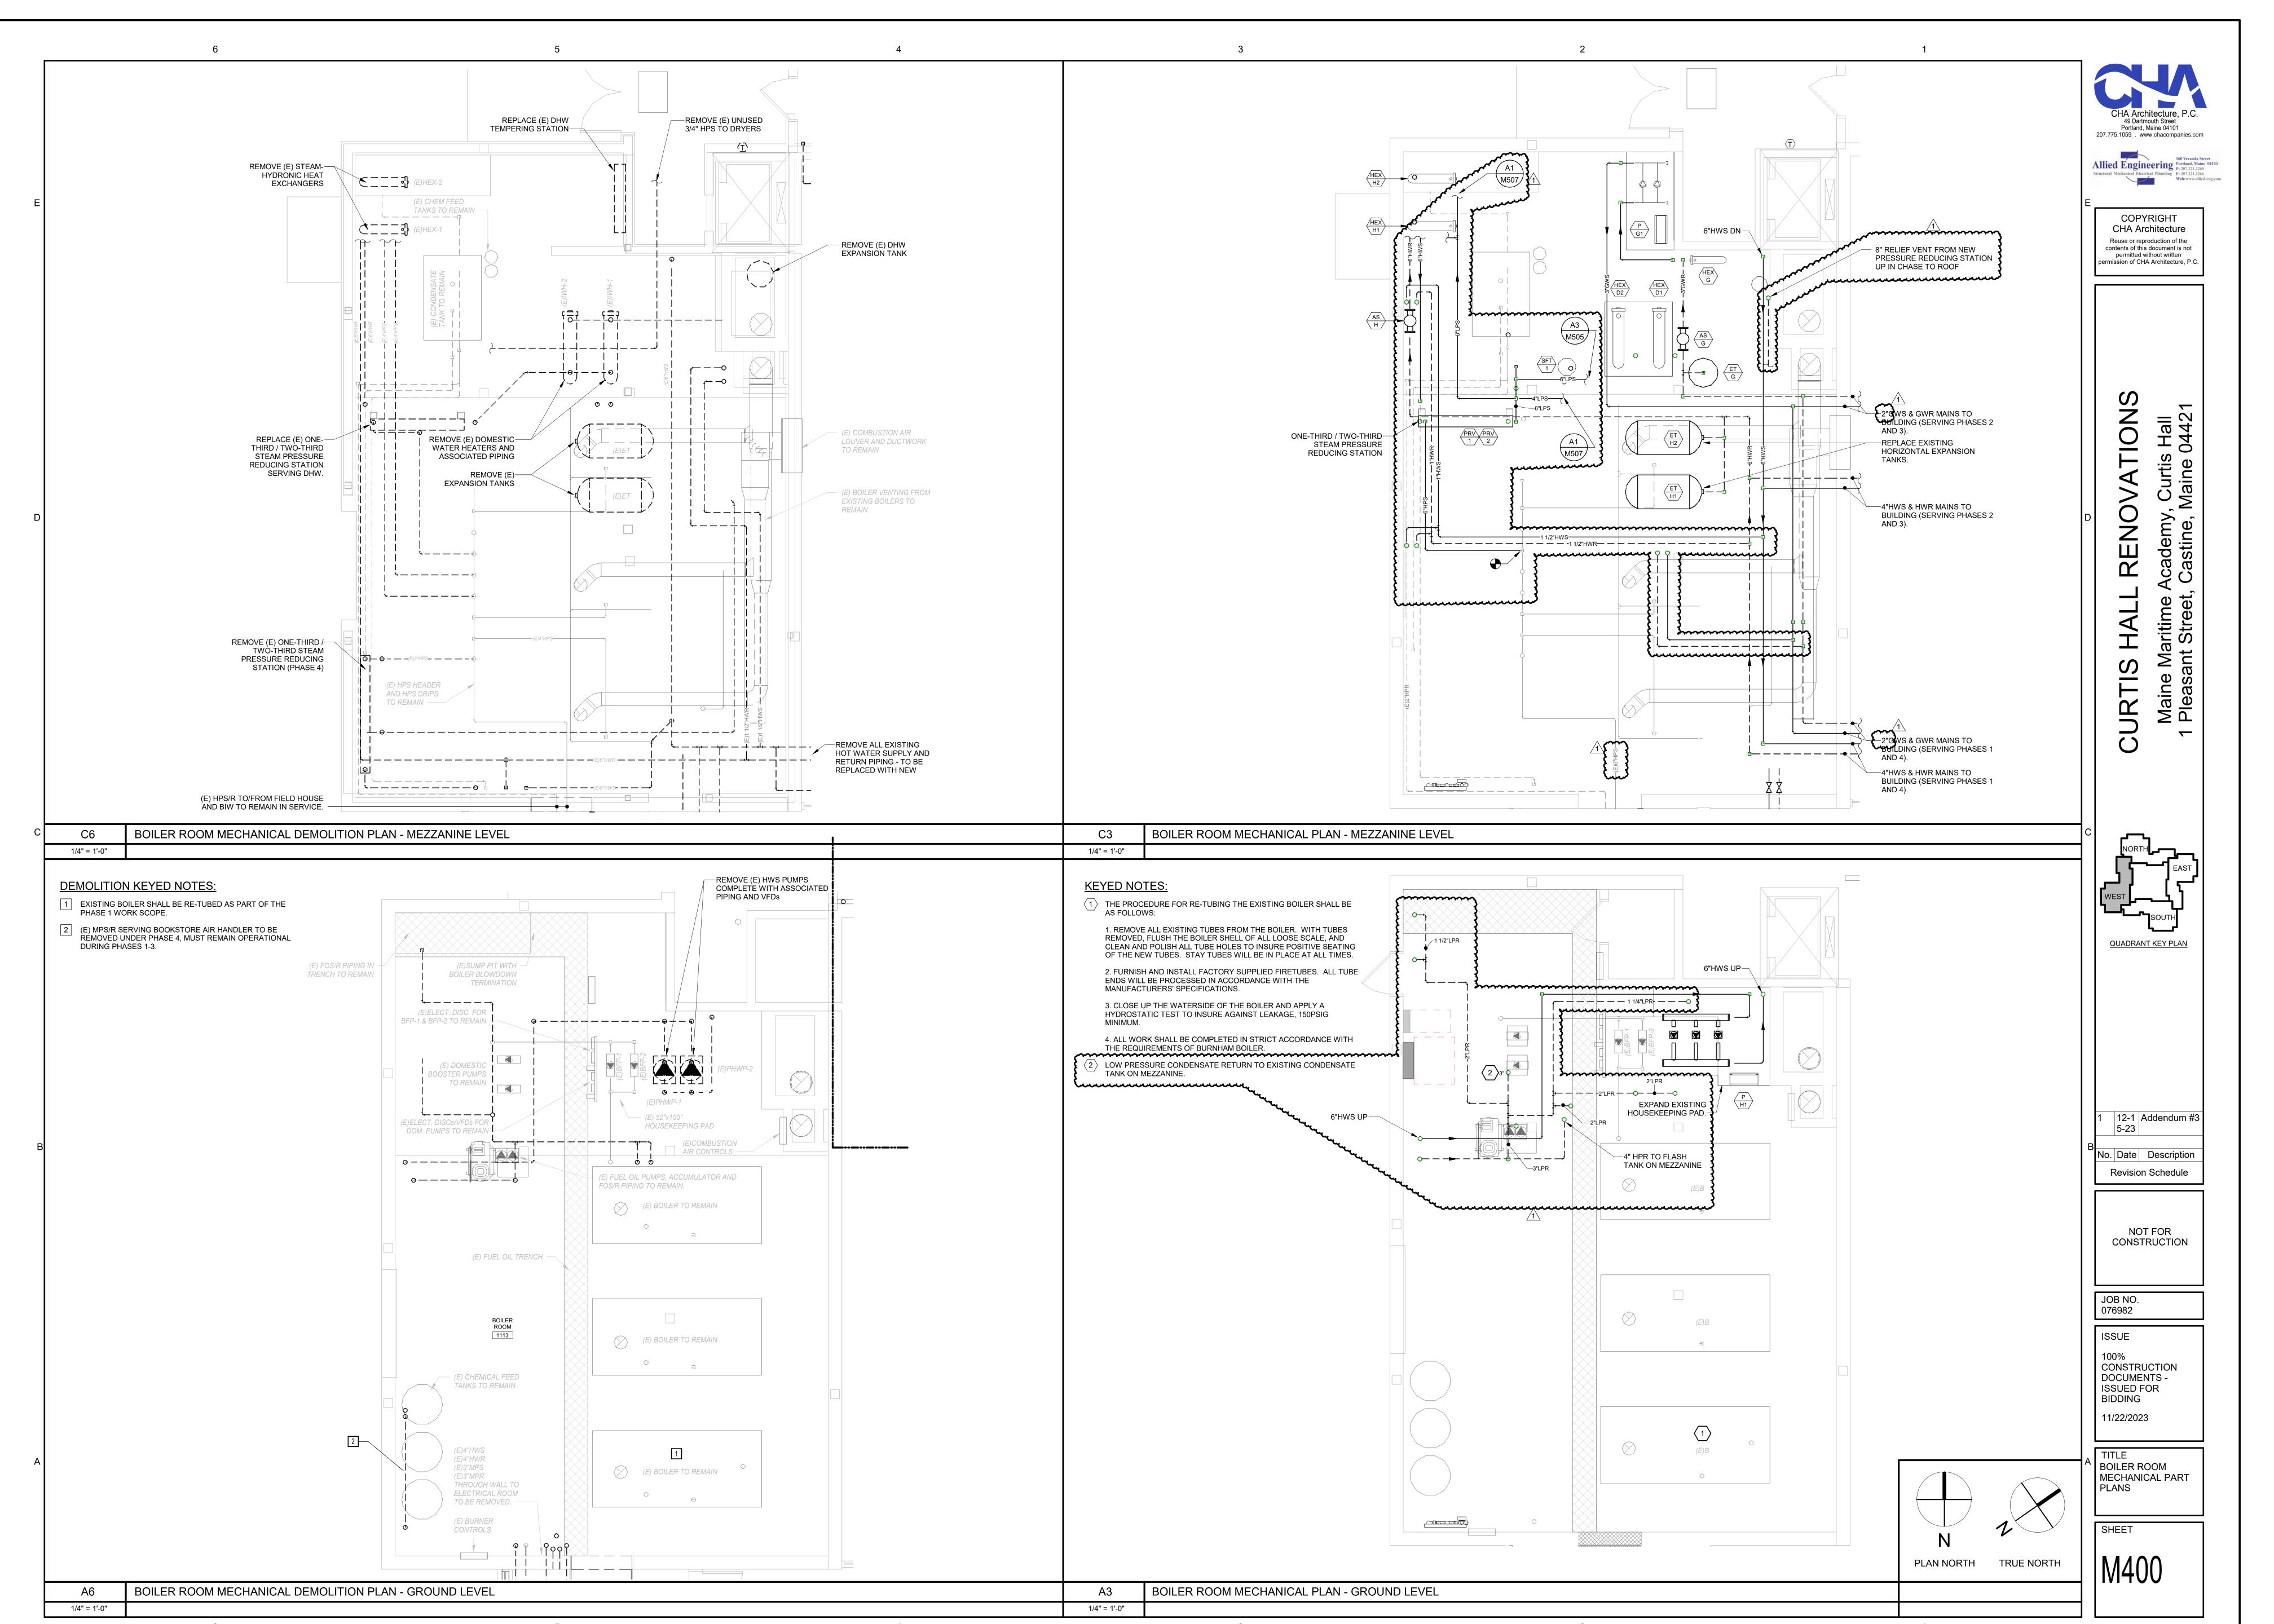

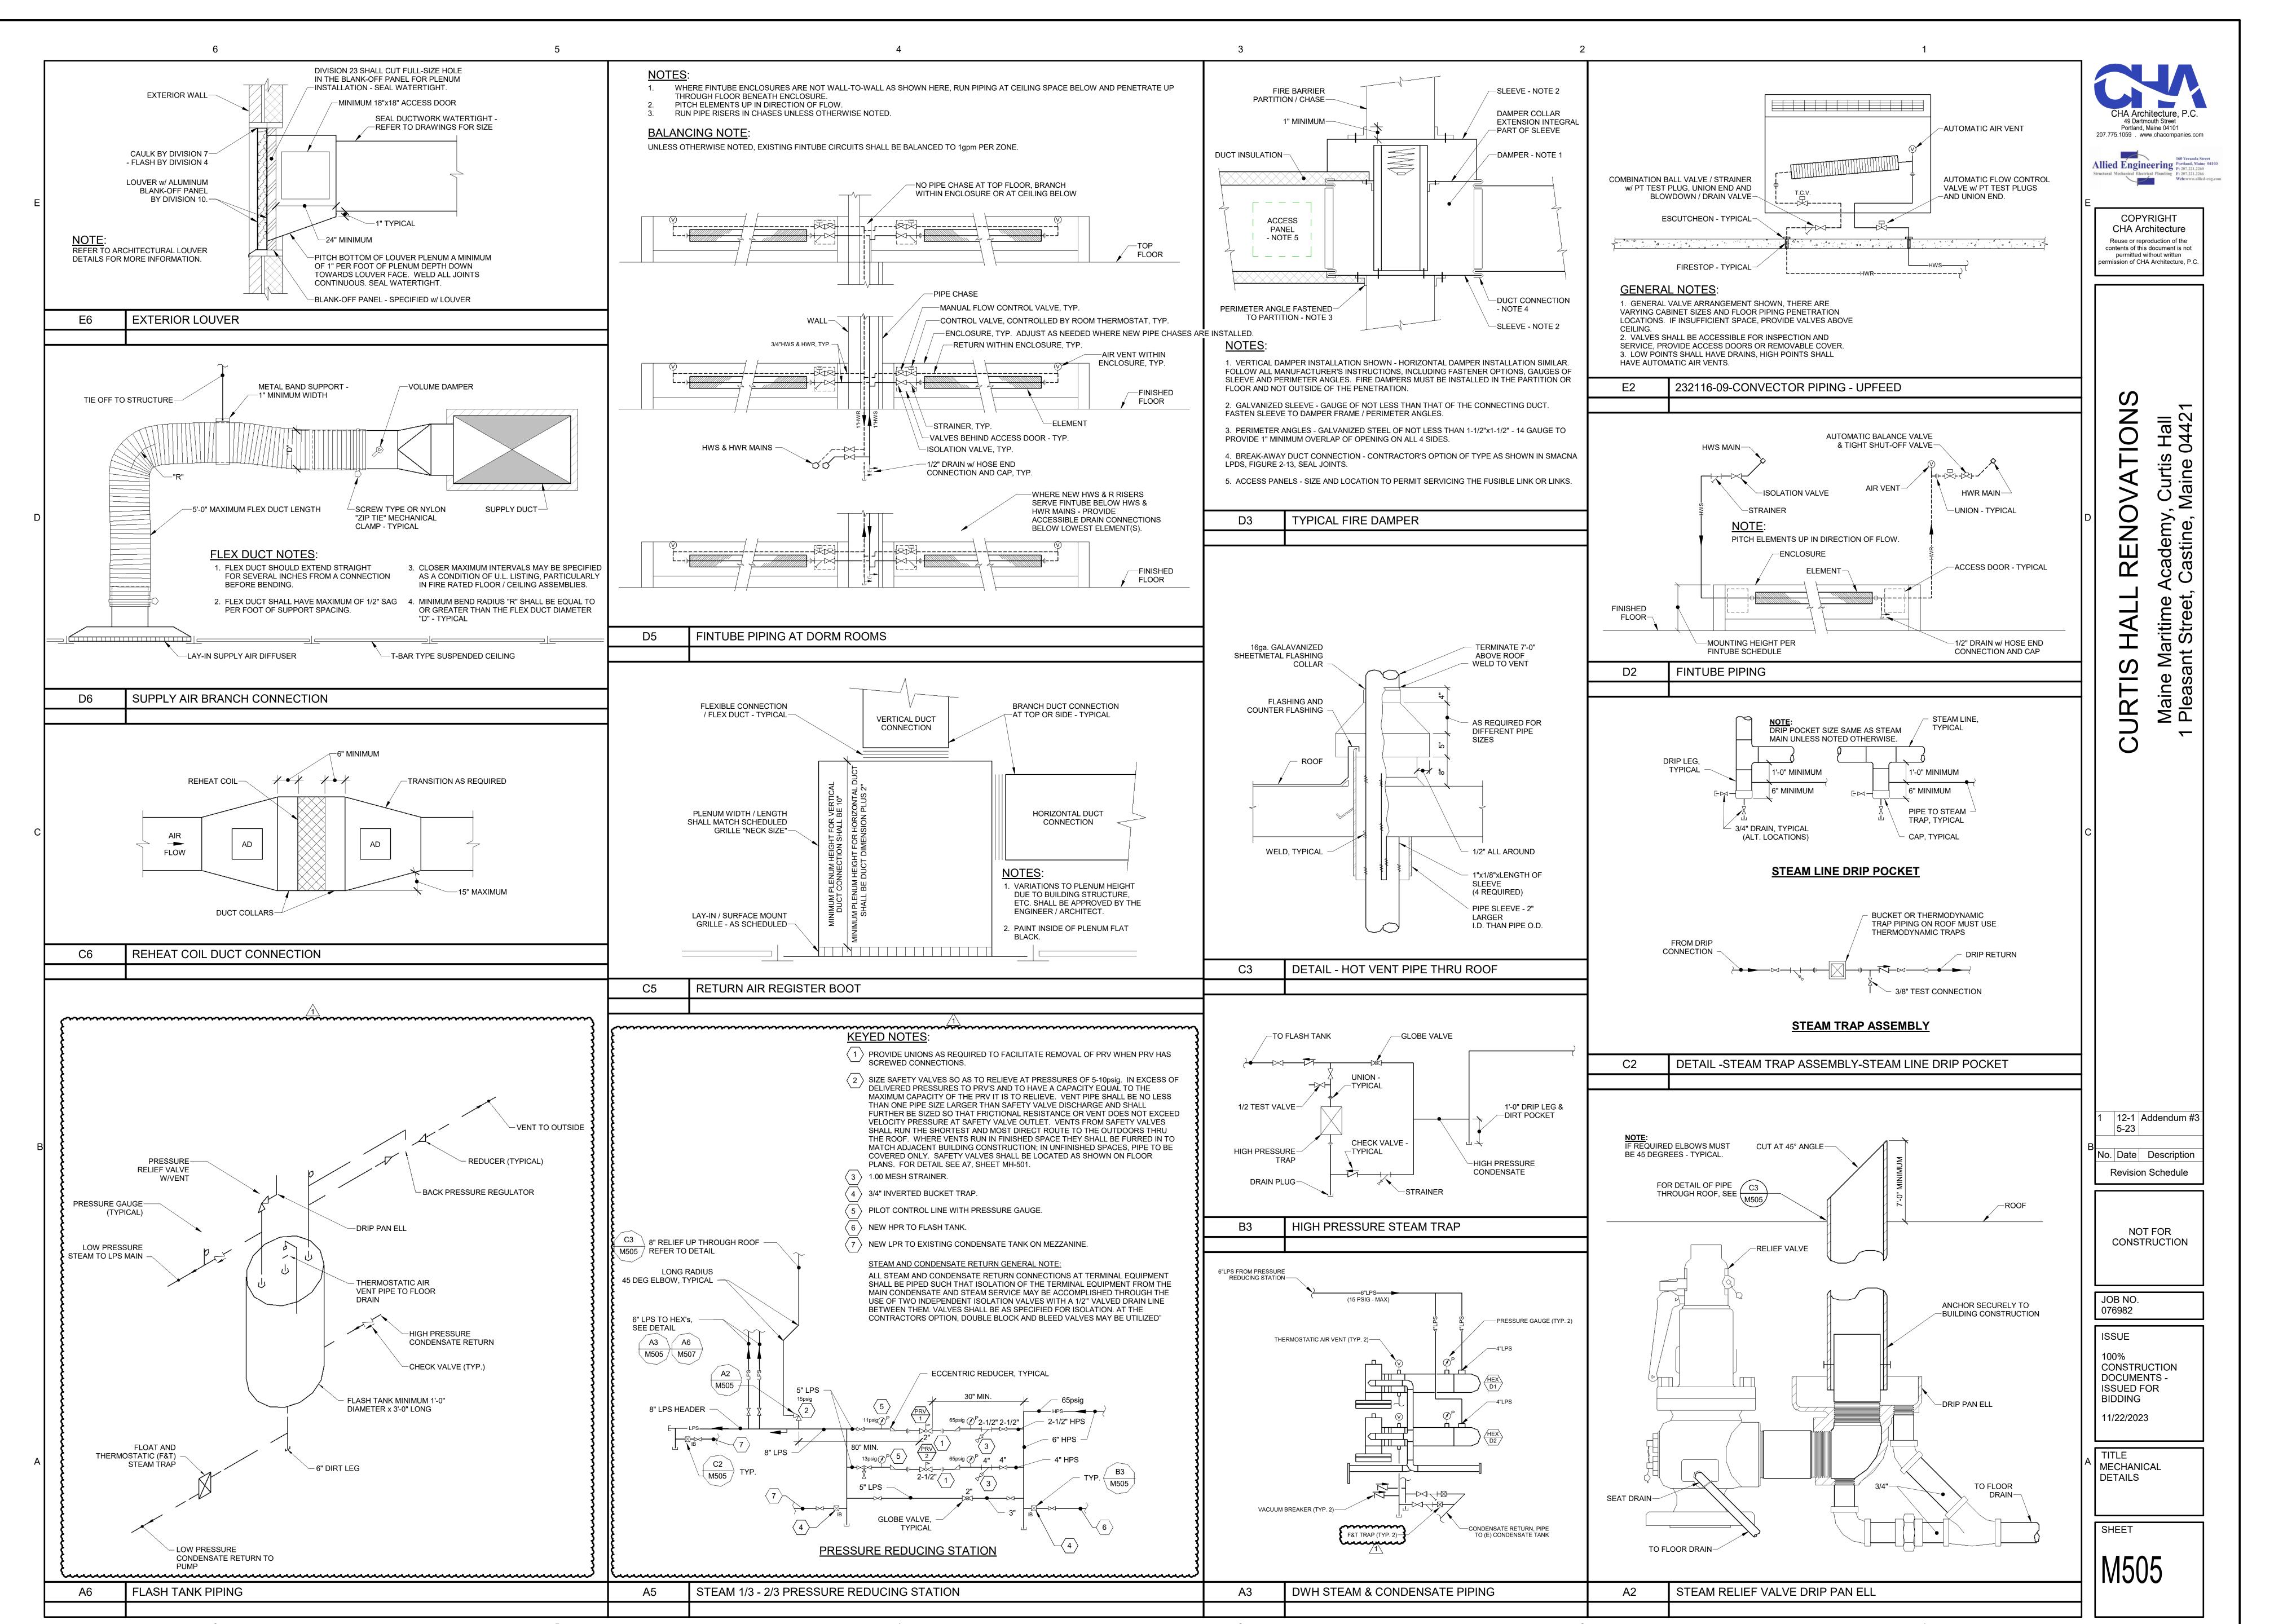

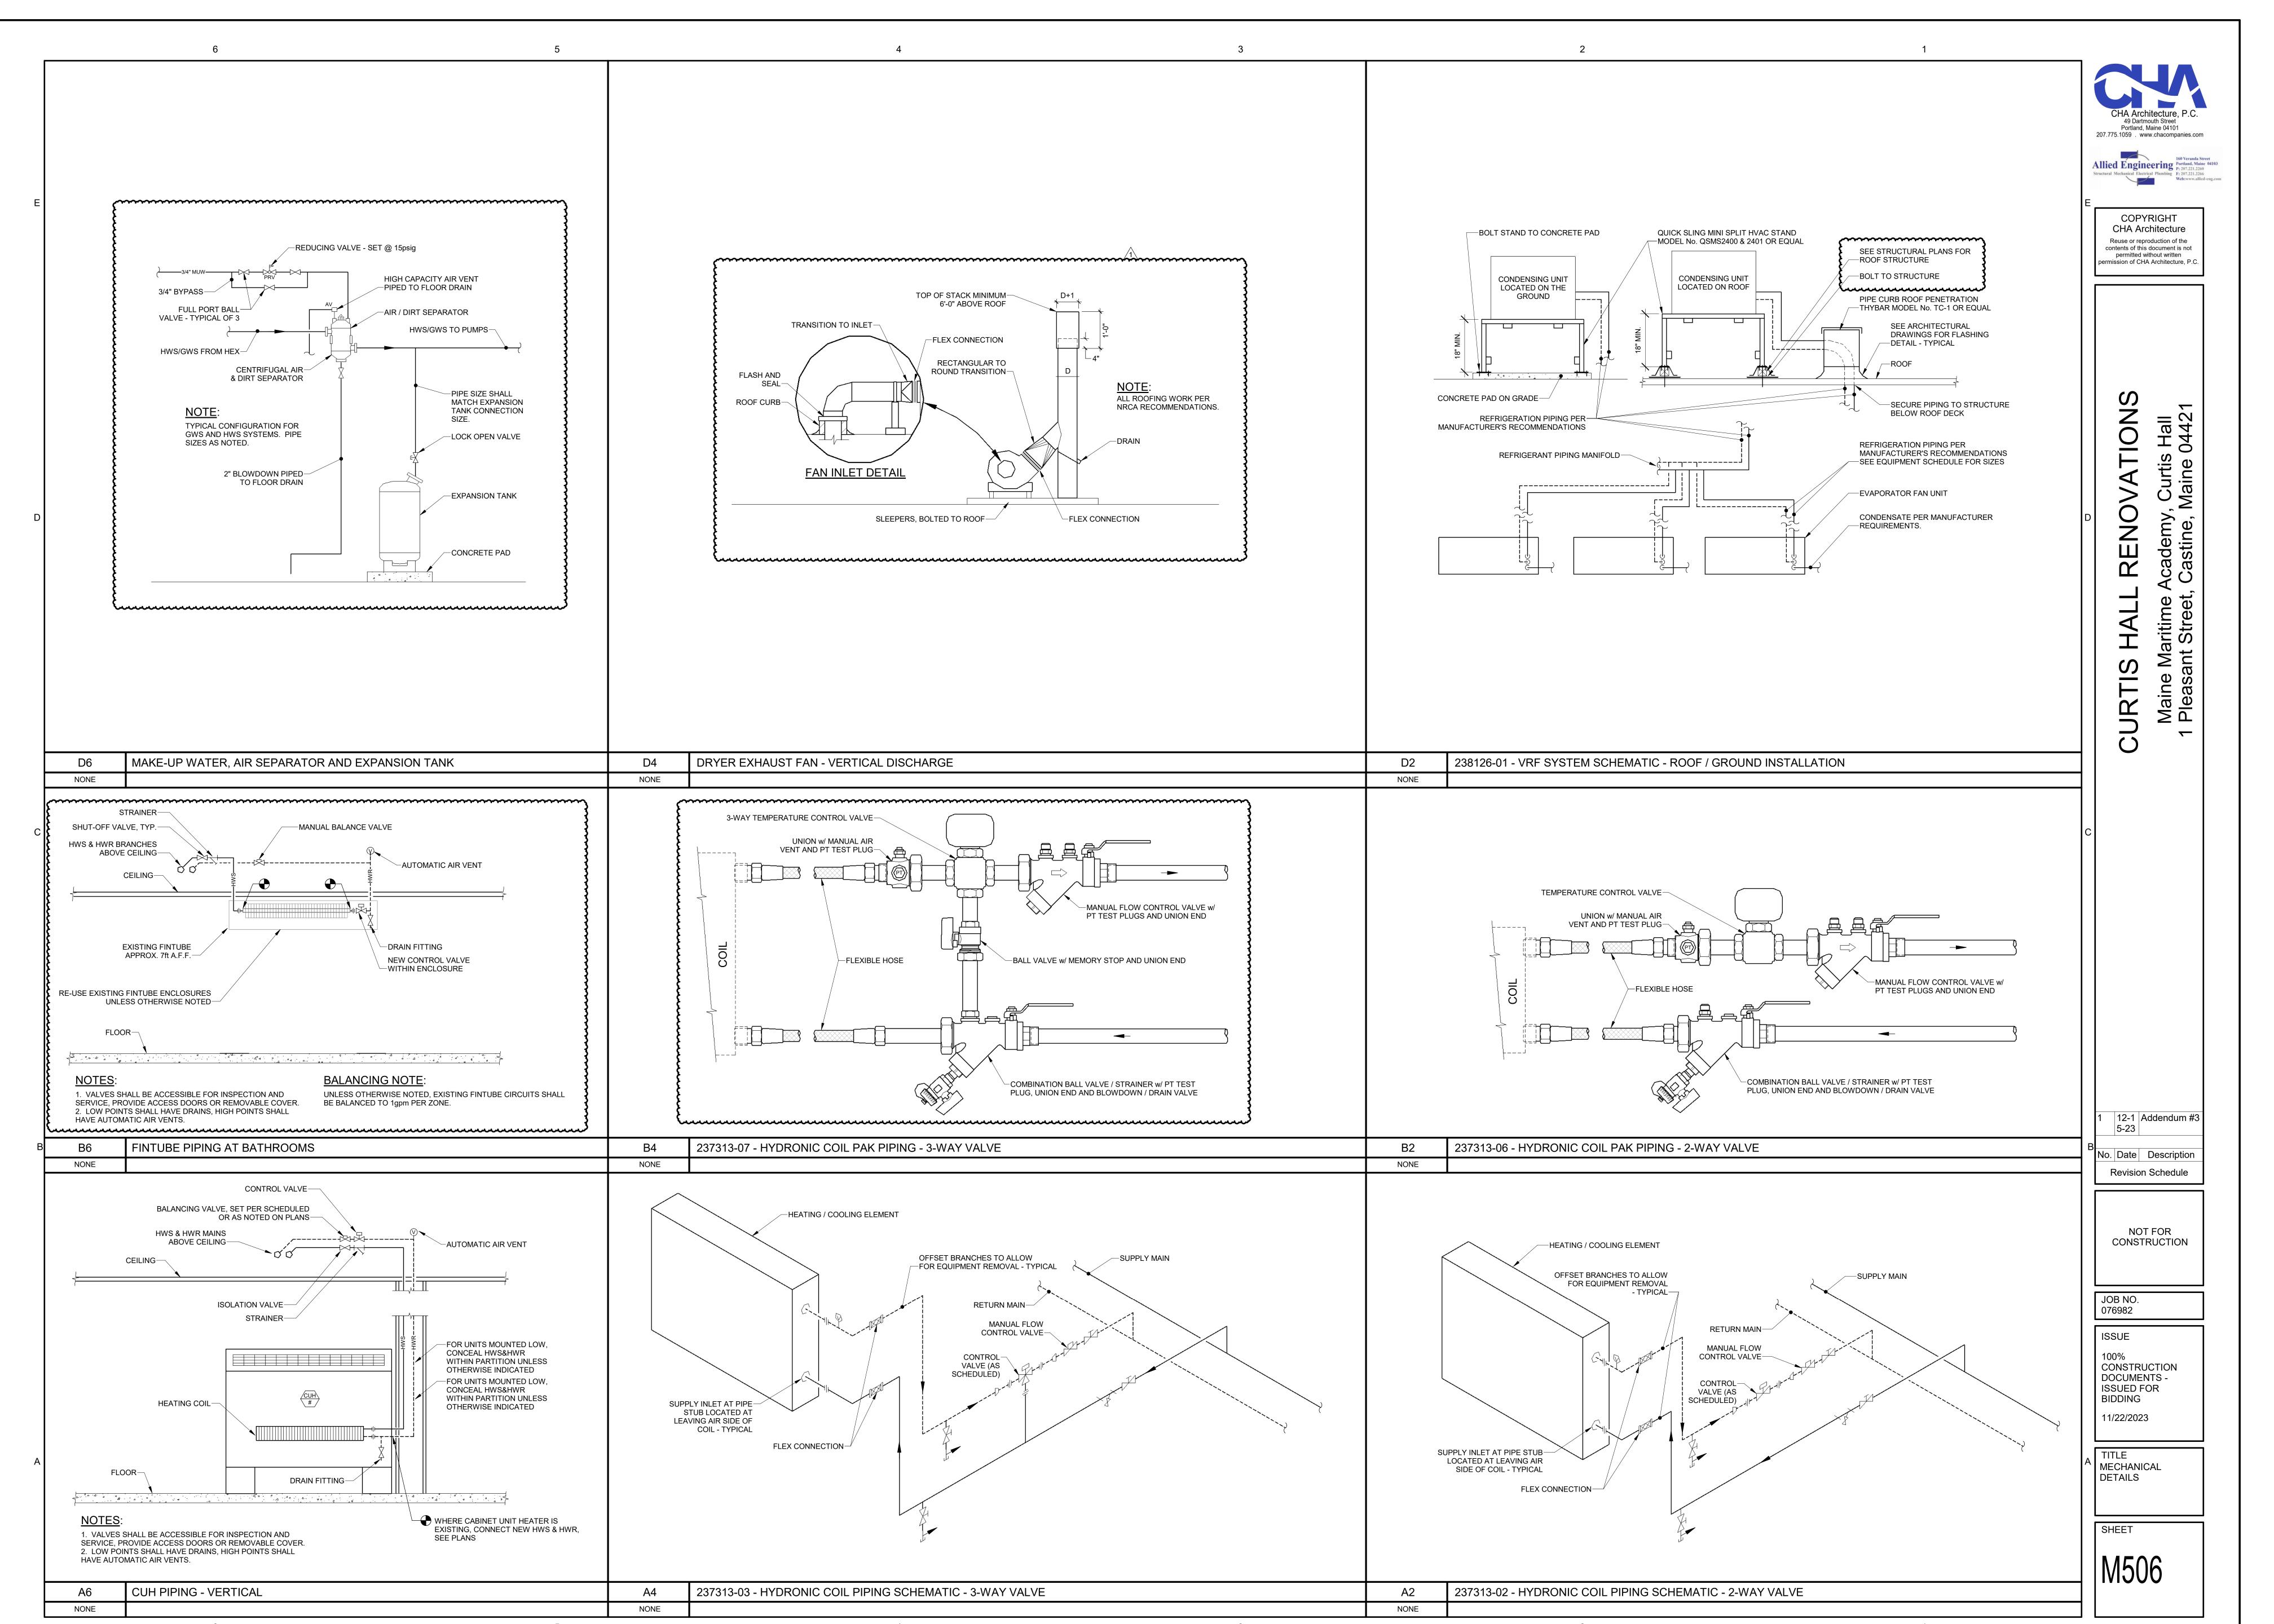

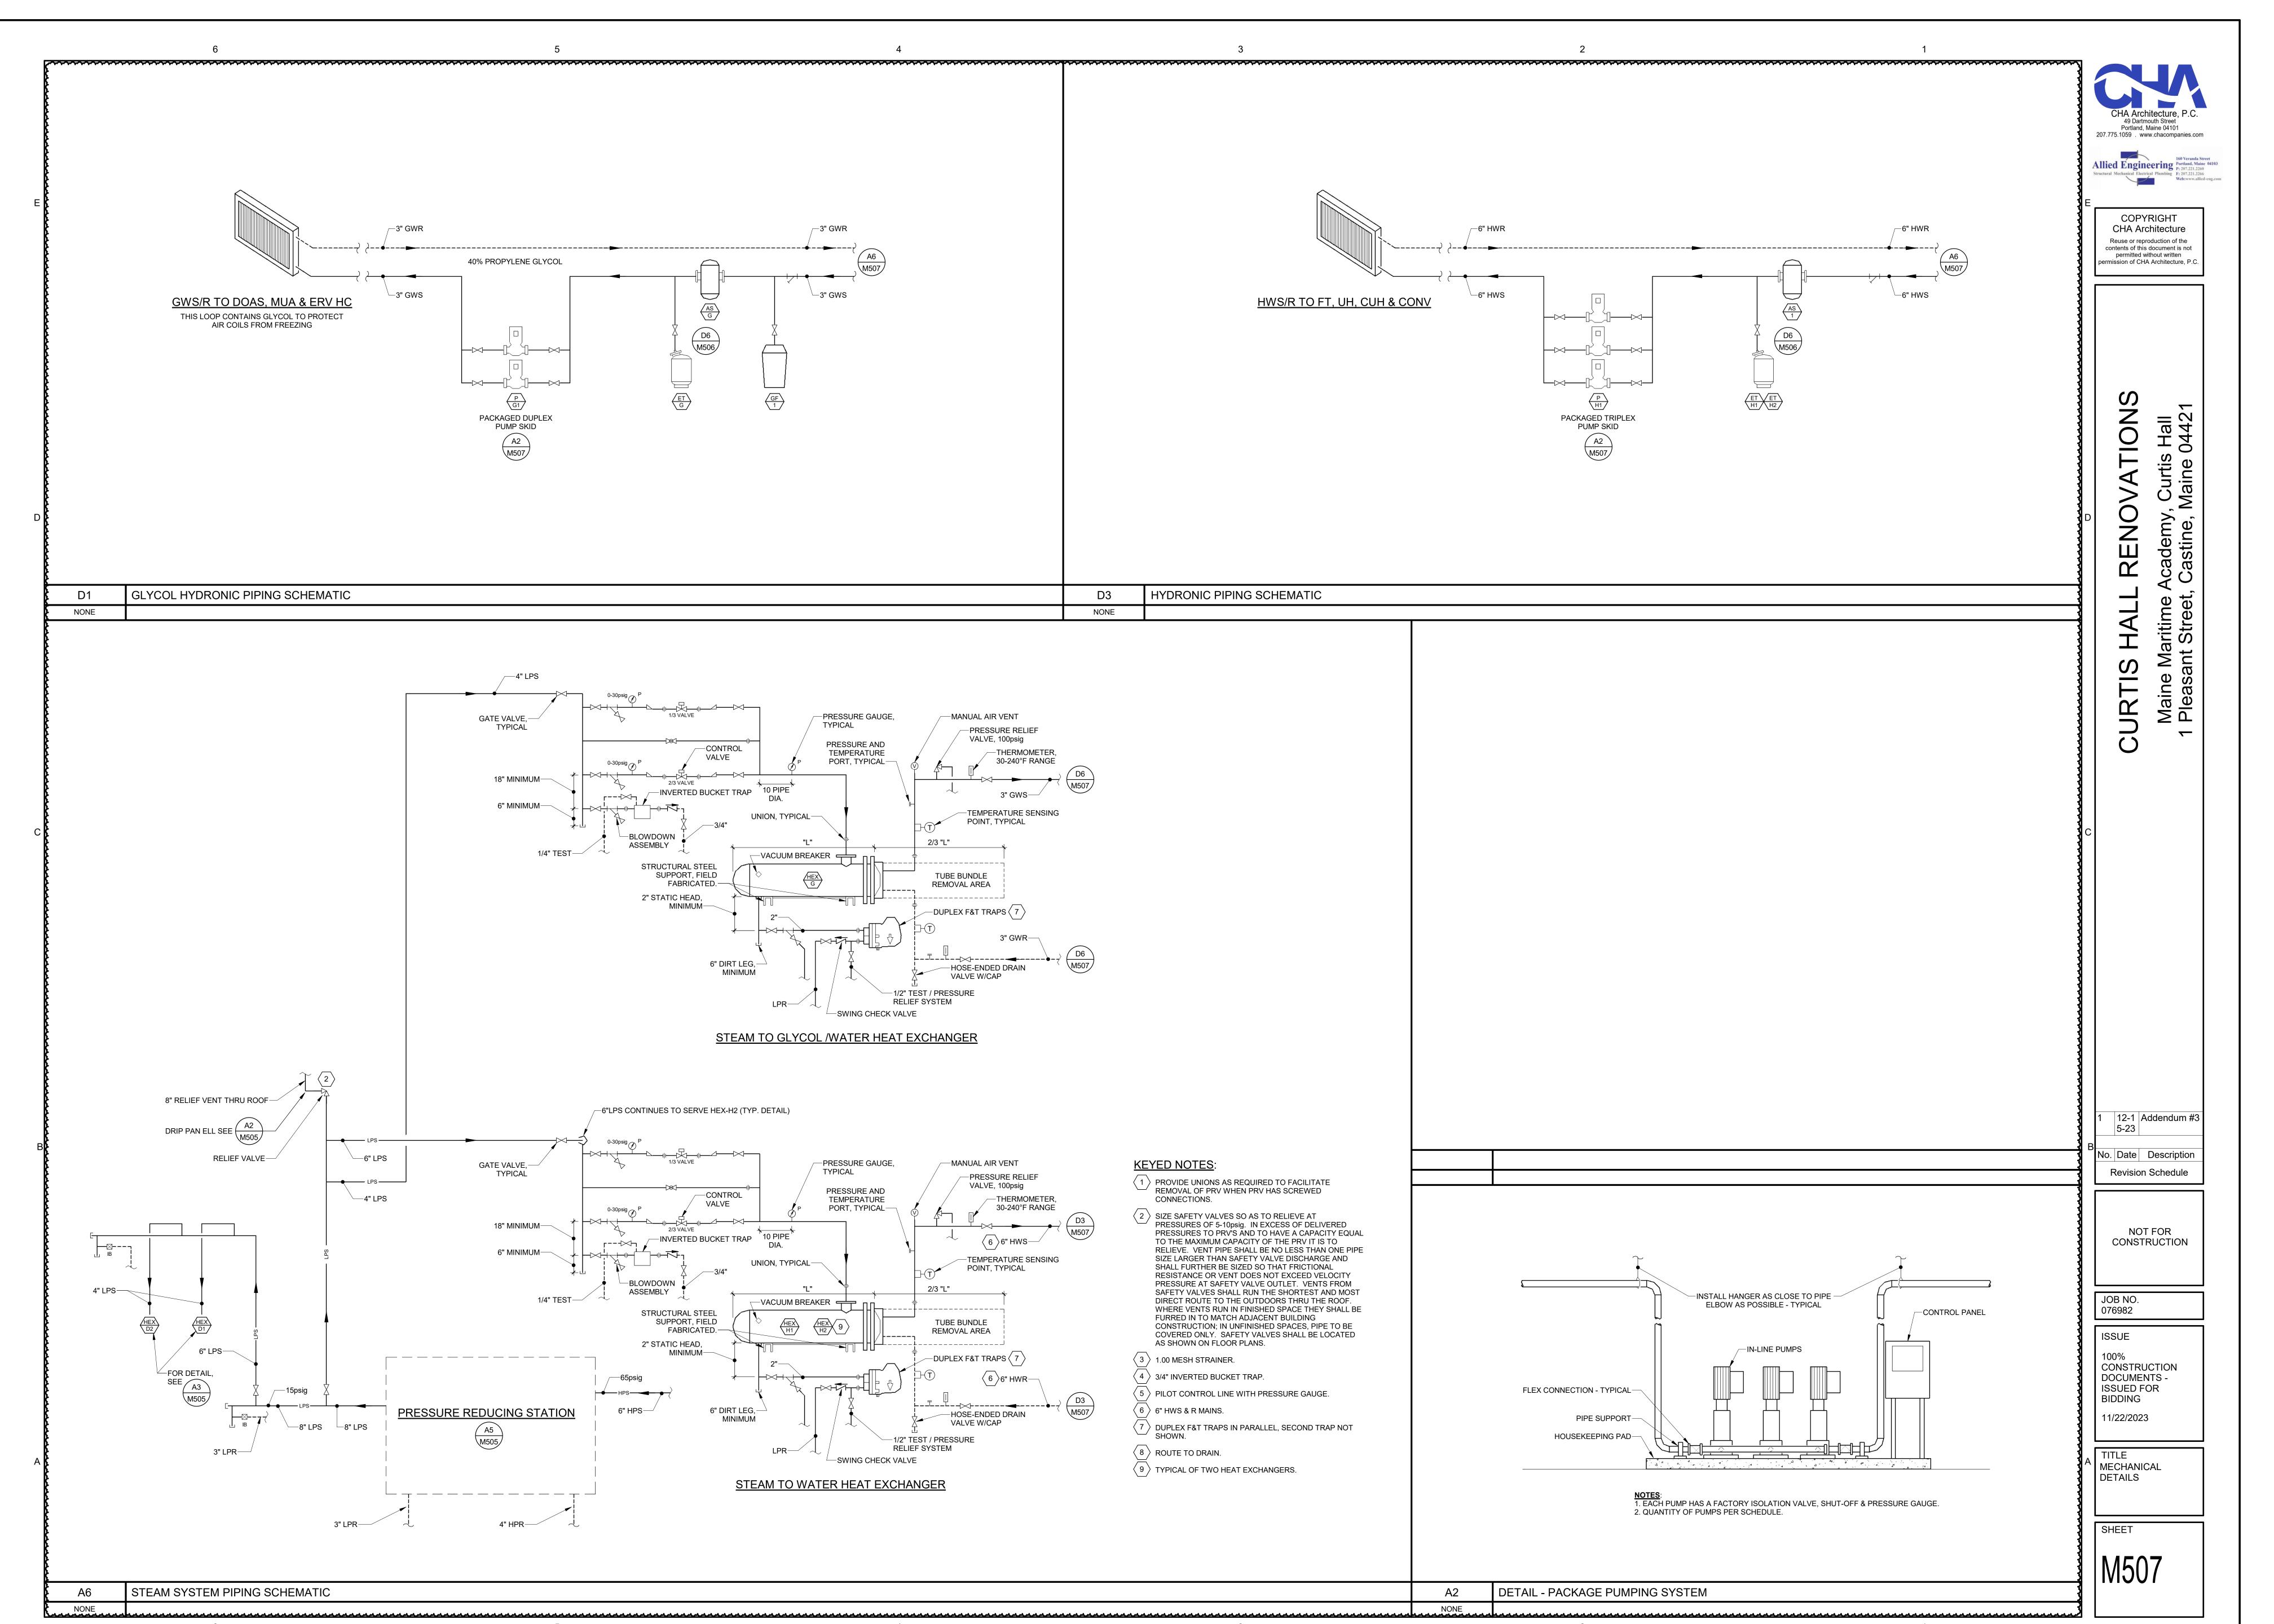

SYSTEM	HWS/R LOOP	GWS/R LOOP	DHW
AIR-DIRT SEPARATOR	AS-H	AS-G	
MANUFACTURER	TACO	TACO	
MODEL	4906AD	49025AD	
TYPE	AIR & DIRT	AIR & DIRT	
FLOW RATE, GPM	648	65	
INLET/OUTLET	6"	2-1/2"	
BLADDER-TYPE EXPANSION TANK	ET-H1 & H2	ET-G	ET-D
MANUFACTURER	TACO	TACO	TACO
MODEL	CA-1100	CA-450	PAX10
SYSTEM HEIGHT, FT	60	60	
STATIC PRESSURE AT TANK, PSI.	26.0	26.0	
PSI REQ'D. AT HIGHEST SYS POINT	5	5	
TANK PRE-CHARGE PRESSURE	31.0	31.0	40.0
TANK DIAMETER	30	20	12"
TANK LENGTH	85.25	77.5	12"
ACCEPTANCE VOLUME	291	119	1.7
WATERLOGGED WEIGHT (LBS.)	3250	1375	63
ASME PRESSURE RATING	125	125	150

R,G, & D ROUND	DUCT RUNOUT SIZE
DUCT SIZE (Ø IN.)	CFM RANGE
4"	0 ≤ CFM ≤ 30
5"	31 ≤ CFM ≤ 60
6"	61 ≤ CFM ≤ 100
7"	101 ≤ CFM ≤ 150
8"	151 ≤ CFM ≤ 215
9"	216 ≤ CFM ≤ 285
10"	286 ≤ CFM ≤ 385
12"	385 ≤ CFM ≤ 620
14"	621 ≤ CFM ≤ 950
16"	951 ≤ CFM ≤ 1330
18"	1331 ≤ CFM ≤ 1810
NOTE: ROUND DUCT RUNOUT SI DOCUMENTS	ZES, UNLESS NOTED OTHERWISE IN

HYDRONIC PIPE SIZE	RUNOUT SCHEDU
PIPE SIZE	MAX GPM
1/2"	1
3/4"	3
1"	6
1-1/4"	11
1-1/2"	18
2"	38
2-1/2"	65
3"	100
4"	230
5"	410
6"	700

			REGISTERS - GRILLES	- DIFFUSI	ERS (RGD)	SCHED	ULE			
TAG	MFR.	MODEL	TYPE	NECK SIZE	FACE SIZE	MAX CFM	MAX TOTAL P.D. (IN.W.C.)	MAX NC LEVEL	BLOW	NOTES
S-1	PRICE	520	STEEL DOUBLE DEFL. SUPPLY	6" X 6"	7.75" X 7.75"	40	0.10"	20	ADJUSTABLE	4"Ø DUCT RUNOUT
S-2	PRICE	520	STEEL DOUBLE DEFL. SUPPLY	6" X 6"	7.75" X 7.75"	130	0.10"	20	ADJUSTABLE	6"Ø DUCT RUNOUT
S-3	PRICE	520	STEEL DOUBLE DEFL. SUPPLY	8" X 6"	9.75" X 7.75"	180	0.10"	20	ADJUSTABLE	8"Ø DUCT RUNOUT
S-4	PRICE	520	STEEL DOUBLE DEFL. SUPPLY	10" X 6"	11.75" X 7.75"	240	0.10"	20	ADJUSTABLE	10"Ø DUCT RUNOUT
S-5	PRICE	520D	STEEL DOUBLE DEFL. SUPPLY W/DAMPER	6" X 6"	7.75" X 7.75"	40	0.10"	20	ADJUSTABLE	
S-6	PRICE	520D	STEEL DOUBLE DEFL. SUPPLY W/DAMPER	6" X 6"	7.75" X 7.75"	130	0.10"	20	ADJUSTABLE	
S-7	PRICE	520D	STEEL DOUBLE DEFL. SUPPLY W/DAMPER	8" X 6"	9.75" X 7.75"	180	0.10"	20	ADJUSTABLE	
S-8	PRICE	520D	STEEL DOUBLE DEFL. SUPPLY W/DAMPER	12" X 4"	13.75" X 5.75"	180	0.10"	20	ADJUSTABLE	
S-9	PRICE	520D	STEEL DOUBLE DEFL. SUPPLY W/DAMPER	10" X 6"	11.75" X 7.75"	240	0.10"	20	ADJUSTABLE	
S-10	PRICE	SCDA	SQ. CEILING SUPPLY DIFFUSER, ADJUSTABLE, 3-CONE	6" DIA	12" X12"	100	0.06"	18	4-WAY	
5-11	PRICE	SCDA	SQ. CEILING SUPPLY DIFFUSER, ADJUSTABLE, 4-CONE	6" DIA	24" X 24"	100	0.06"	16	4-WAY	
-12	PRICE	SCDA	SQ. CEILING SUPPLY DIFFUSER, ADJUSTABLE, 4-CONE	8" DIA	24" X 24"	240	0.07"	17	4-WAY	
₹-1	PRICE	530	STEEL RETURN, 3/4" SPACING, 45 DEG VANES	6" X 6"	7.75" X 7.75"	40	0.05"	20		4"Ø DUCT RUNOUT
R-2	PRICE	530	STEEL RETURN, 3/4" SPACING, 45 DEG VANES	8" X 8"	9.75" X 9.75"	130	0.05"	20		6"Ø DUCT RUNOUT
R-3	PRICE	530	STEEL RETURN, 3/4" SPACING, 45 DEG VANES	10" X 10"	11.75" X 11.75"	220	0.05"	20		8"Ø DUCT RUNOUT
R-4	PRICE	530	STEEL RETURN, 3/4" SPACING, 45 DEG VANES	12" X 12"	13.75" X 13.75"	360	0.05"	20		10"Ø DUCT RUNOUT
₹-5	PRICE	530D	STEEL RETURN, 3/4" SPACING, 45 DEG VANES, W/DAMPER	6" X 6"	7.75" X 7.75"	40	0.05"	20		
₹-6	PRICE	530D	STEEL RETURN, 3/4" SPACING, 45 DEG VANES, W/DAMPER	8" X 8"	9.75" X 9.75"	130	0.05"	20		
R-7	PRICE	530D	STEEL RETURN, 3/4" SPACING, 45 DEG VANES, W/DAMPER	16" X 4"	17.75" X 5.75"	150	0.05"	20		
₹-8	PRICE	530D	STEEL RETURN, 3/4" SPACING, 45 DEG VANES, W/DAMPER	10" X 10"	11.75" X 11.75"	220	0.05"	20		
₹-9	PRICE	530D	STEEL RETURN, 3/4" SPACING, 45 DEG VANES, W/DAMPER	12" X 8"	13.75" X 9.75"	240	0.05"	20		
R-10	PRICE	530D	STEEL RETURN, 3/4" SPACING, 45 DEG VANES, W/DAMPER	16" X 10"	17.75" X 11.75"	360	0.05"	20		
R-11	PRICE	530	STEEL RETURN, 3/4" SPACING, 45 DEG VANES	22" X 22"	23.75" X 23.75"	1,000	0.05"	20		

							SIEAWIP	KESSUKE K	EDUCING VALV	ES 1/3 / 2/3						
TAG	SERVES	LOCATION	MFR	MODEL	VALVE SIZE	CONTROL	MAX INLET PRESSURE	OUTLET PRESSURE	SAFETY RELIEF VALVE SET PRESSURE	CAPACITY (LBS/HR)	MIN. CV	NOISE LEVEL	SAFETY RELIEF VALVE MANUF/MODEL	RELIEF PIPE THRU ROOF	SAFETY RELIEF VALVE SIZE	NOTES
PRV-1 C	CURTIS HALL	BOILER ROOM	ARMSTRONG	GP-2000	2"	EXTERNALLY PILOTED	65 PSIG	13 PSIG	25 PSIG	3,400	24.95	81 dBa	KUNKLE SAFETY VALVE /	8"	4" x 6"	1
PRV-2	CURTIS HALL	BOILER ROOM	ARMSTRONG	GP-2000	2 1/2"	EXTERNALLY PILOTED	65 PSIG	13 PSIG	25 PSIG	6,800	54.17	80 dBa	6252 KPM	0	4 x 0	1

						FLASH TA	NK SCHE	DULE							
UNIT NO.	LOCATION	MANUFACTURER	MODEL	CONDENSATE (LBS/HR)	INITITAL PRESSURE	FLASH PRESSURE	% FLASH	ASME RATING	HEIGHT	DIAMETER	FLASH OUTLET(FLG)	COND INLET (FLG)	LPR OUTLET		GAUGE CONN
SFT-1	BOILER ROOM	CEMLINE	V40FST	13,200	65 PSIG	15 PSIG	6.7%	150 PSIG	48"	16"	6"	6"	2"	2"	1/2"

				CONVEC	TOR SCI	HEDULE	=				
TAG	MFR.	TYPE	STYLE	LENGTH (IN.)	HEIGHT (IN.)	DEPTH (IN.)	EWT (F)	LWT (F)	BTUH / FT	GPM / FT	MAX WPD (FT.)
CONV-1	RUNTAL	RF-4	NOTE 1	SEE DWGS	11.5"	1.6"	180	160	844	0.1	1.0
NOTES:											
1. EXPOSE	D, WALL HU	JNG									

					VARIABL	E REFRIGER	RANT FI	LOW (VF	RF) - OL	ITDOOF	R UNIT PEI	RFOR	MANO	CE SCH	IEDUL	E				
	NIONAINIAI	NOMINA	AL BTUH	CORREC	TED BTUH	MAXIMUM	COOLI	NG EFF.	HEATIN	IG EFF.	ELECT	ΓRICAL	REQU	IREMEN	ITS	DII	MENSIO	NS S	TRANE MODEL	MEIOLIT
CU SIZE	NOMINAL TONNAGE	COOLING	HEATING	COOLING TOTAL	HEATING MINIMUM	CONNECTED CAPACITY	EER	SEER	COP	HSPF	V / PH / HZ	MCA	RFS	МОСР	DISC. BY	H (IN)	W (IN)	D (IN)	TRANE MODEL NUMBER	WEIGHT (LB)
Α	3	36,000	36,000	33,300	34,250	130%	13.80	20.65	3.85	12.10	208/1/60	36	40	40	DIV 26	52-11/16	41-11/32	13	NTXMSH36A142AA	278
В	4	48,000	54,000	43,450	40,000	130%	12.20	19.75	3.65	11.50	208/1/60	36	40	40	DIV 26	52-11/16	41-11/32	13	NTXMSH36A142AA	278
С	2	22,000	25,000	21,500	20,950	100%	19.00	19.00	0.00	10.00	208/1/60	31	40	40	DIV 26	41-9/32	37-13/32	13	NTXMPH24A132AA	189
D																				
NOTES:																				

1. Nominal cooling capacities are based on indoor coil EAT of 80/67°F (DB/WB), outdoor of 95°F (DB)

2. Nominal heating capacities are based on indoor coil EAT of 70°F (DB), outdoor of 43°F (WB)

3. Efficiency values for EER, IEER, COP are based on AHRI 1230 test method for mixture of ducted & non-ducted indoor units. 4. Provide added field charge in addition to factory charge as needed based upon final as-built piping layout.5. Outdoor design conditions: 86F Summer, -11F Winter.

6. CU size here are assigned to spaces on VRF Outdoor Unit Size Schedule.

7. All units shall be low-temp heating (H2i Hyper-Heat) units.

8. CU size C shall be a Multi-Zone unit w/ three individual refrigerant pipe circuits.

		ABLE REFRIGERANT FLO	\	_		CAPACITY	CORRECTE	$D \subset V$
TAG	UNIT LOCATION	AREAS SERVED	CU SIZE	QTY HP ON SYSTEM	COOLING	HEATING	COOLING TOTAL	HE MIN
CU0 1-1	GRADE	INT FLR - PH 1 - DORMS	Α	6	36,000	36,000	33,300	3
CU0 1-2	GRADE	INT FLR - PH 1 - DORMS	Α	5	36,000	36,000	33,300	3
CU1 1-1	GRADE	1st FLR - PH 1 - DORMS	Α	6	36,000	36,000	33,300	3
CU1 1-2	GRADE	1st FLR - PH 1 - DORMS	Α	6	36,000	36,000	33,300	3
CU1 4-1	GRADE	1st FLR - PH 4 - APARTMENT	С	3	22,000	25,000	21,500	2
CU1 4-2	GRADE	1st FLR - PH 4 - HEALTH SERVICES	Α	5	36,000	36,000	33,300	3
		SYSTEMS LISTED AB	OVE TH	S LINE ARE	BID ALTERNA	TE #3	I	
CU2 1-1	ROOF	2nd FLR - PH 1 - DORMS	В	8	48,000	54,000	43,450	4
CU2 1-2	ROOF	2nd FLR - PH 1 - DORMS	В	8	48,000	54,000	43,450	4
CU2 1-3	ROOF	2nd FLR - PH 1 - DORMS	В	8	48,000	54,000	43,450	4
CU2 2-1	ROOF	2nd FLR - PH 2 - DORMS	В	8	48,000	54,000	43,450	4
CU2 2-2	ROOF	2nd FLR - PH 2 - DORMS	В	8	48,000	54,000	43,450	4
CU2 2-3	ROOF	2nd FLR - PH 2 - DORMS	В	8	48,000	54,000	43,450	4
CU2 3-1	ROOF	2nd FLR - PH 3 - DORMS	В	8	48,000	54,000	43,450	4
CU2 3-2	ROOF	2nd FLR - PH 3 - DORMS	В	8	48,000	54,000	43,450	4
CU2 3-3	ROOF	2nd FLR - PH 3 - DORMS	В	8	48,000	54,000	43,450	4
CU2 4-1	ROOF	2nd FLR - PH 4 - DORMS	Α	6	36,000	36,000	33,300	3
CU2 4-2	ROOF	2nd FLR - PH 4 - DORMS	В	8	48,000	54,000	43,450	4
CU2 4-3	ROOF	2nd FLR - PH 4 - DORMS	В	8	48,000	54,000	43,450	4
						·	·	
CU3 1-1	ROOF	3rd FLR - PH 1 - DORMS	В	8	48,000	54,000	43,450	4
CU3 1-2	ROOF	3rd FLR - PH 1 - DORMS	В	8	48,000	54,000	43,450	4
CU3 1-3	ROOF	3rd FLR - PH 1 - DORMS	В	8	48,000	54,000	43,450	4
CU3 2-1	ROOF	3rd FLR - PH 2 - DORMS	В	8	48,000	54,000	43,450	4
CU3 2-2	ROOF	3rd FLR - PH 2 - DORMS	В	8	48,000	54,000	43,450	4
CU3 2-3	ROOF	3rd FLR - PH 2 - DORMS	В	8	48,000	54,000	43,450	4
CU3 3-1	ROOF	3rd FLR - PH 3 - DORMS	В	8	48,000	54,000	43,450	4
CU3 3-2	ROOF	3rd FLR - PH 3 - DORMS	В	8	48,000	54,000	43,450	4
CU3 3-3	ROOF	3rd FLR - PH 3 - DORMS	В	8	48,000	54,000	43,450	4
CU3 4-1	ROOF	3rd FLR - PH 4 - DORMS	Α	6	36,000	36,000	33,300	3
CU4 4-3	ROOF	4th FLR - PH 4 - DORMS	В	8	48,000	54,000	43,450	4

NOTES:
1. CU size assigned here, see VRF Outdoor Unit Performance Schedule for CU performan

GENERAL	TAG	MUA-1-21
	SERVES	LAUNDRY MUA, PHASE 2
	LOCATION	FIRST FLOOR (1)
	TYPE	BLOWER COIL UNIT
	MFR	TRANE
	MODEL	BCHE054
FILTER SECTION	FILTERS (OA)	MERV 8
SUPPLY AIR FAN	TYPE	ODP, BI
	AIRFLOW (cfm)	1,500
	ESP, in.wc.	1.0
	MOTOR TYPE	ECM - VARIABLE SPEED
	FAN HP	(1) 1HP
OVERALL DIMENSIONS	LENGTH	35.8"
	WIDTH	46.0"
	HEIGHT	18.0"
	OPERATING WEIGHT, lbs.	210
HEATING COIL	HYDRONIC COIL TAG	INTEGRAL TO UNIT
	EAT, deg-F.	-10
	LAT, deg-F.	75
	TMBTUH	137.7
	MIN COIL AREA, sf.	3.7
	MAX AIR PD. in. wc.	0.1
	COIL FACE VELOCITY	406
	FLUID	40% P.G.
	EWT (F)	180
	LWT (F)	150
	FLOW RATE (GPM)	9.2
	WPD (FTHD)	3.0
ELECTRICAL DATA	V-PH-HZ	208-3-60
	UNIT MCA	5.8
	MOPD / MOCP	15
	SMOKE DETECTORS	NONE
NOTES:		

CHA Architecture, P.C.
49 Dartmouth Street
Portland, Maine 04101
207.775.1059 . www.chacompanies.com

Allied Engineering

Structural Mechanical Electrical Plumbing

F: 207.221.2266

Web:www.allied-eng.com

COPYRIGHT CHA Architecture Reuse or reproduction of the contents of this document is not permitted without written permission of CHA Architecture, P.C.


RENOV,


No. Date Description


ISSUE 100% CONSTRUCTION DOCUMENTS -ISSUED FOR BIDDING 11/22/2023


A MECHANICAL SCHEDULES


SHEET

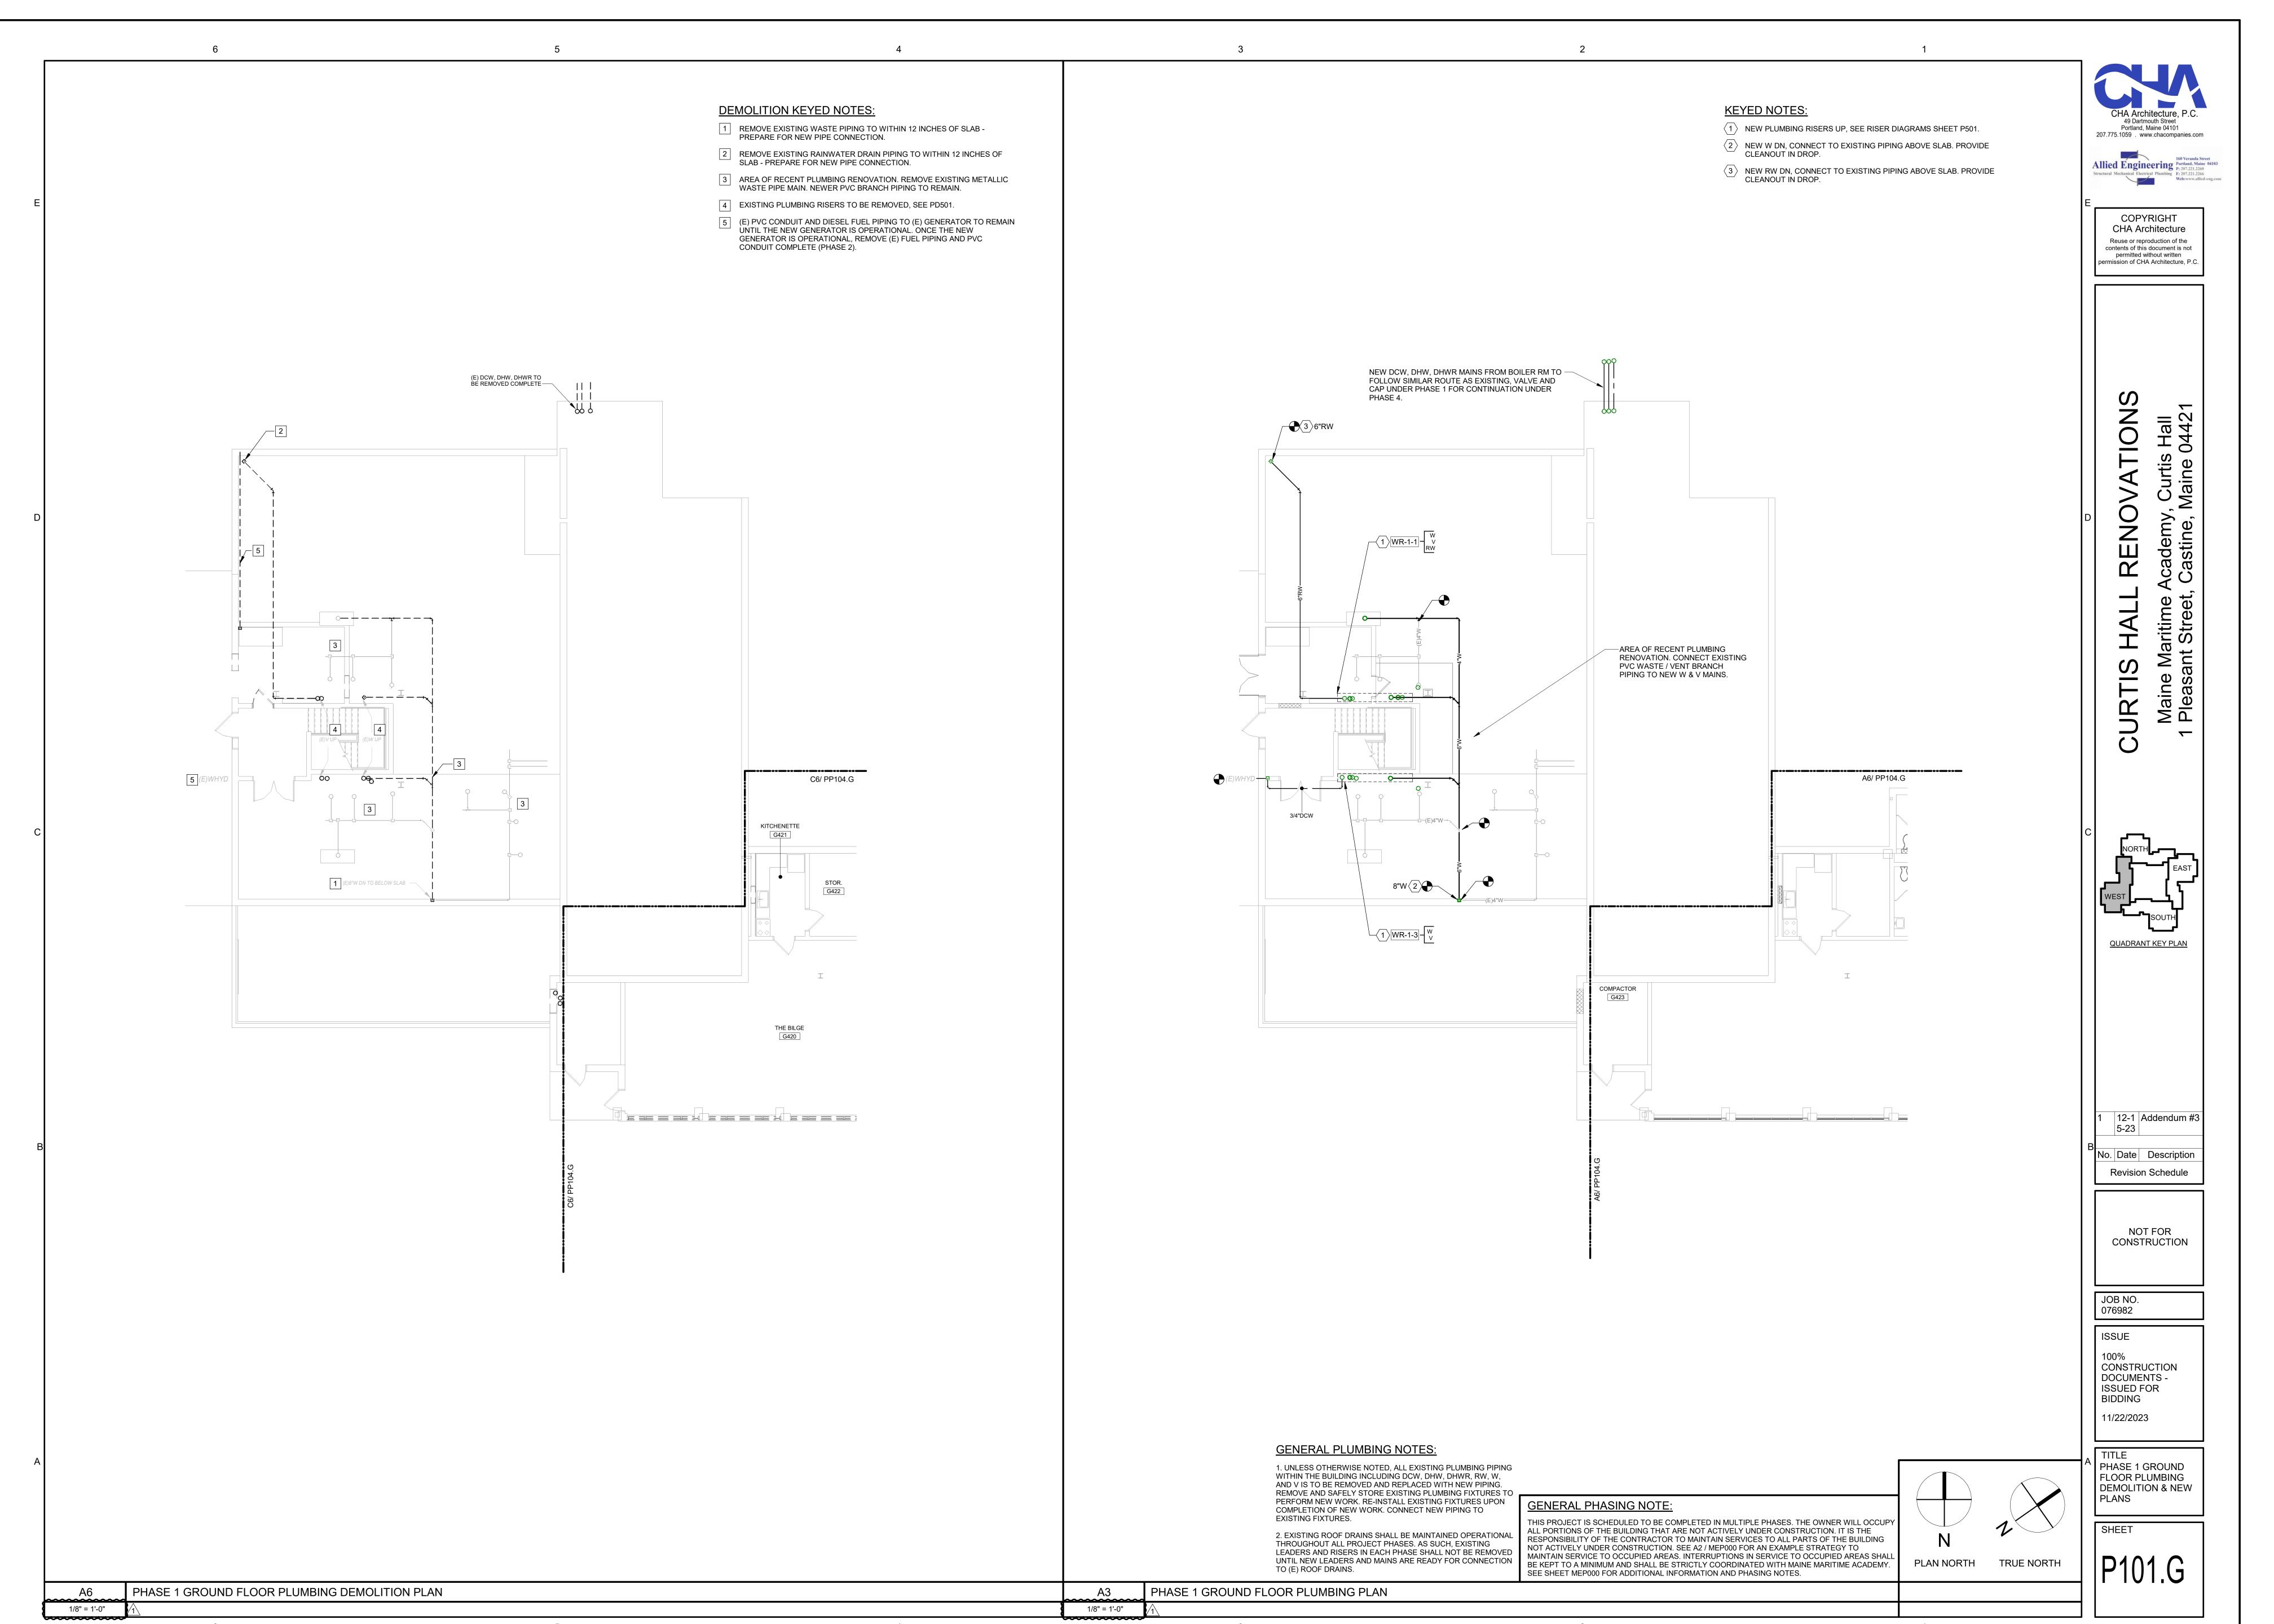


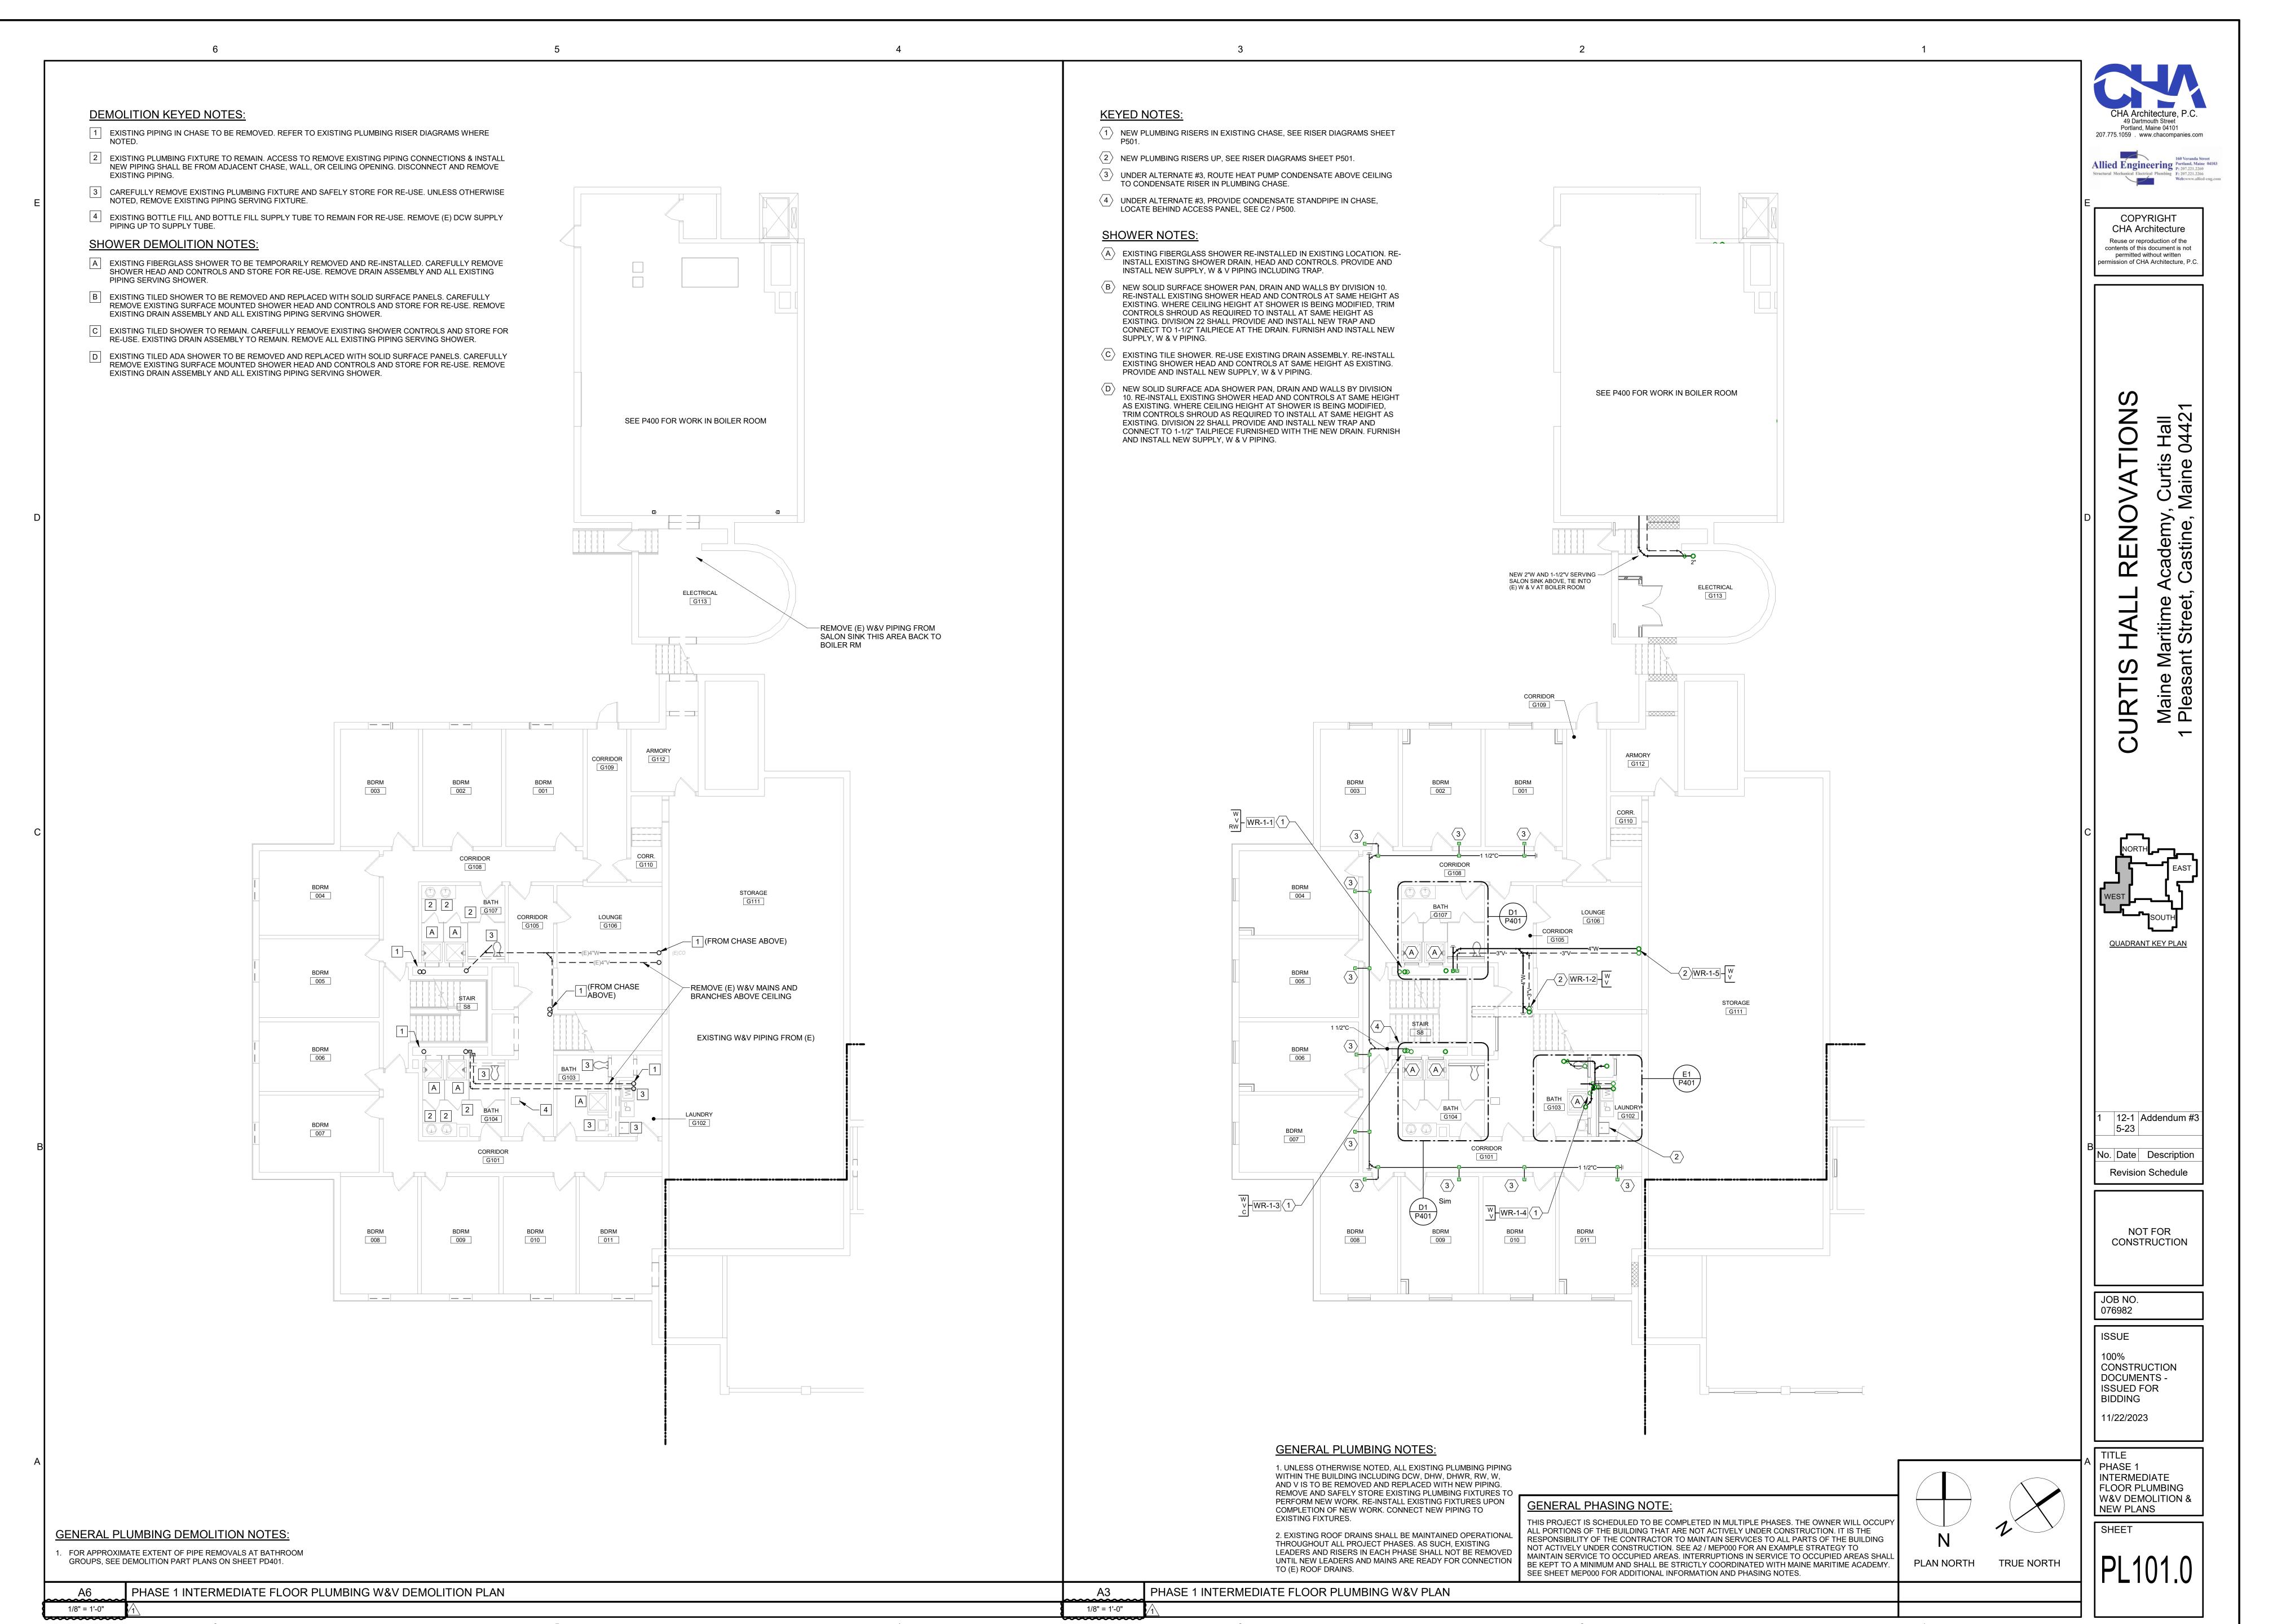


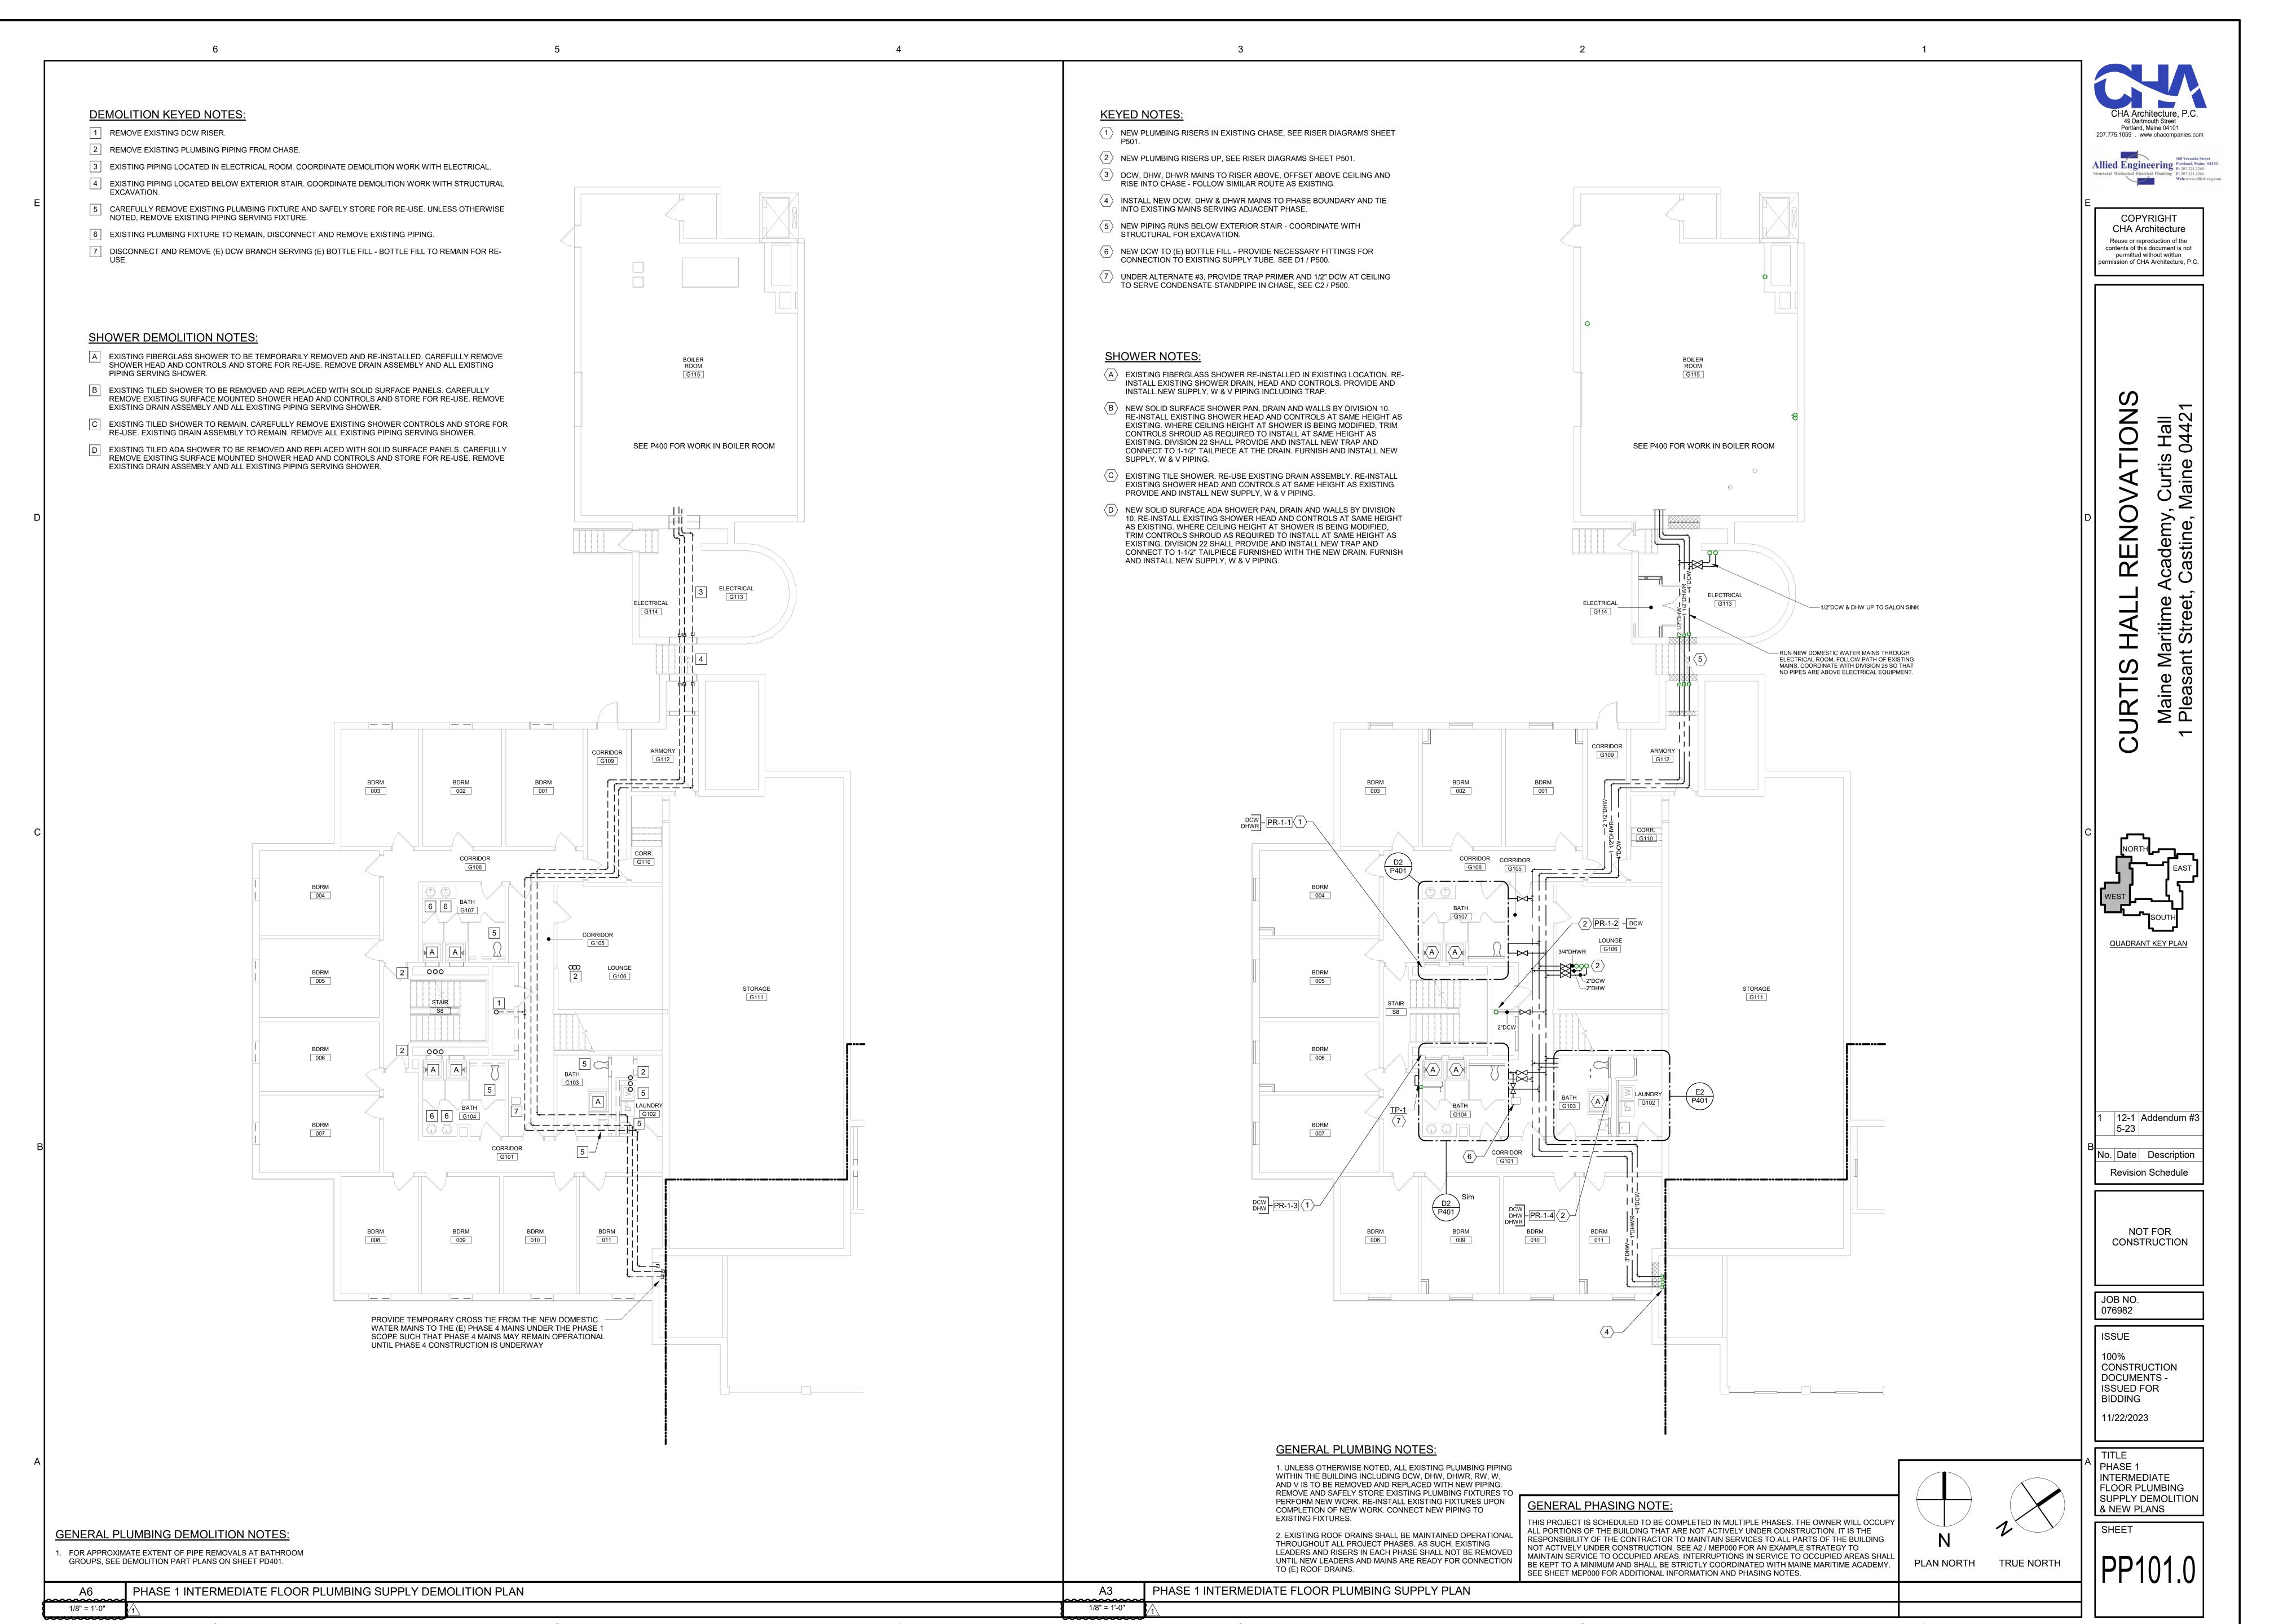


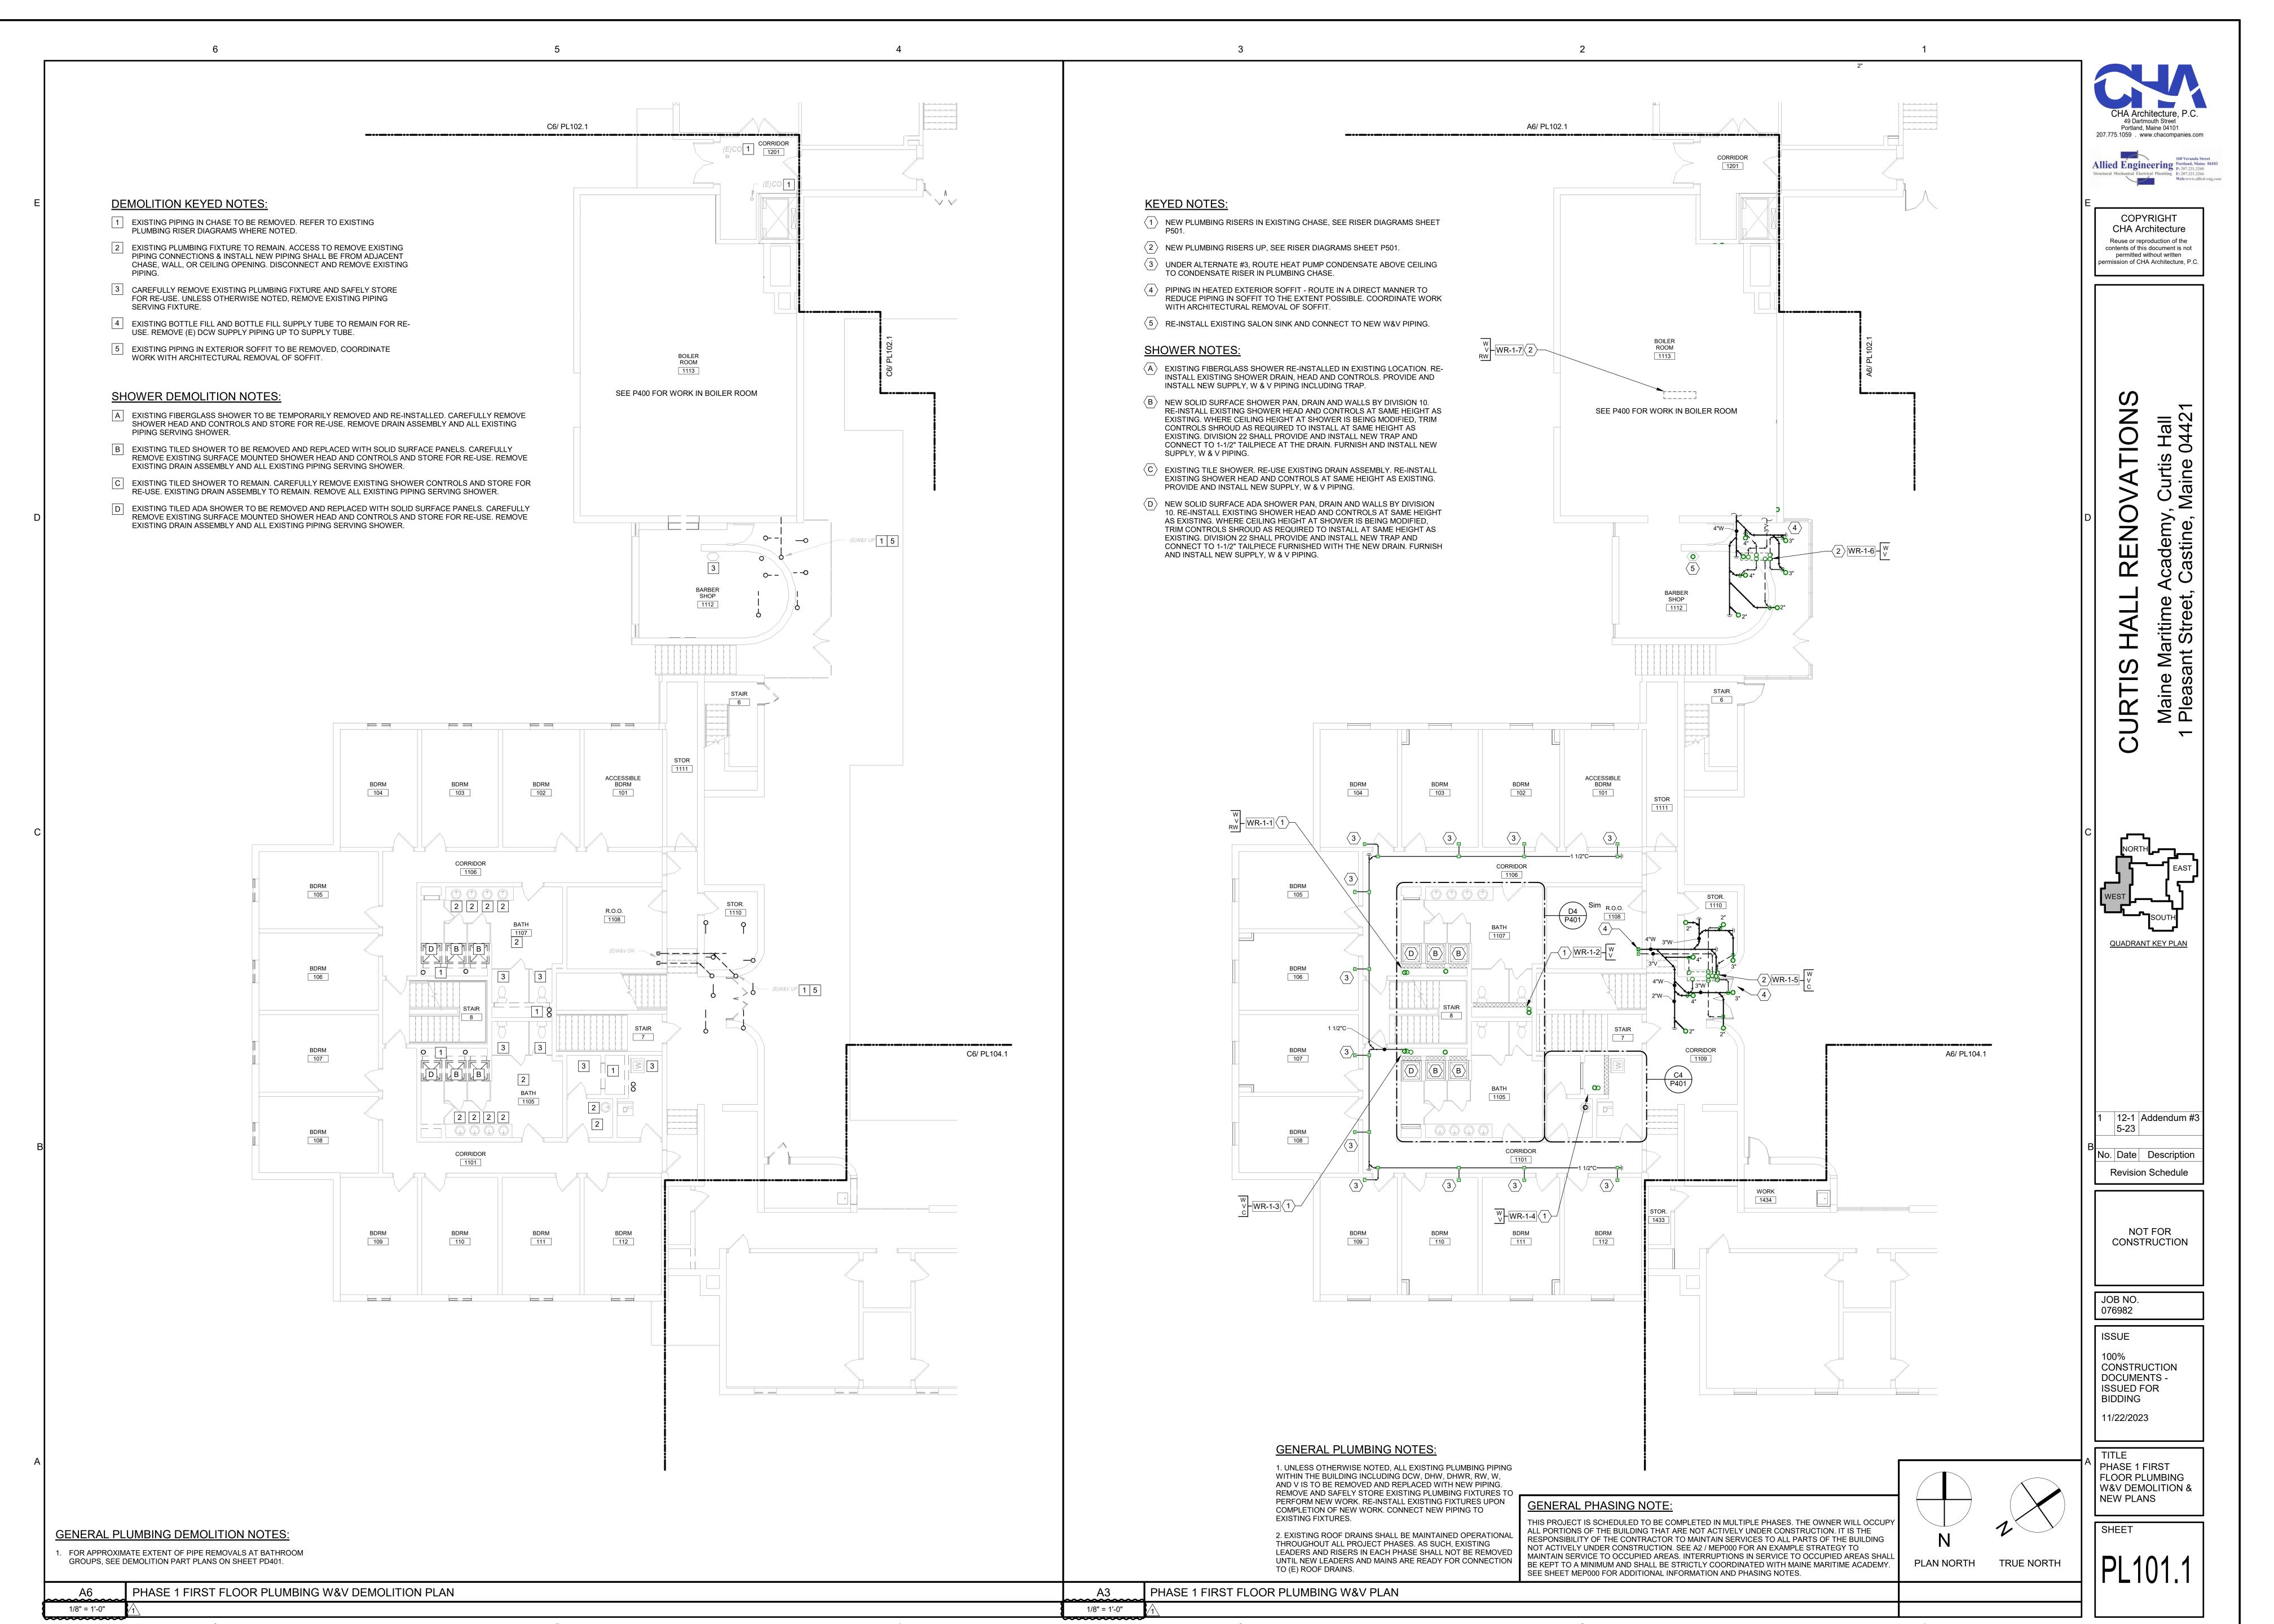

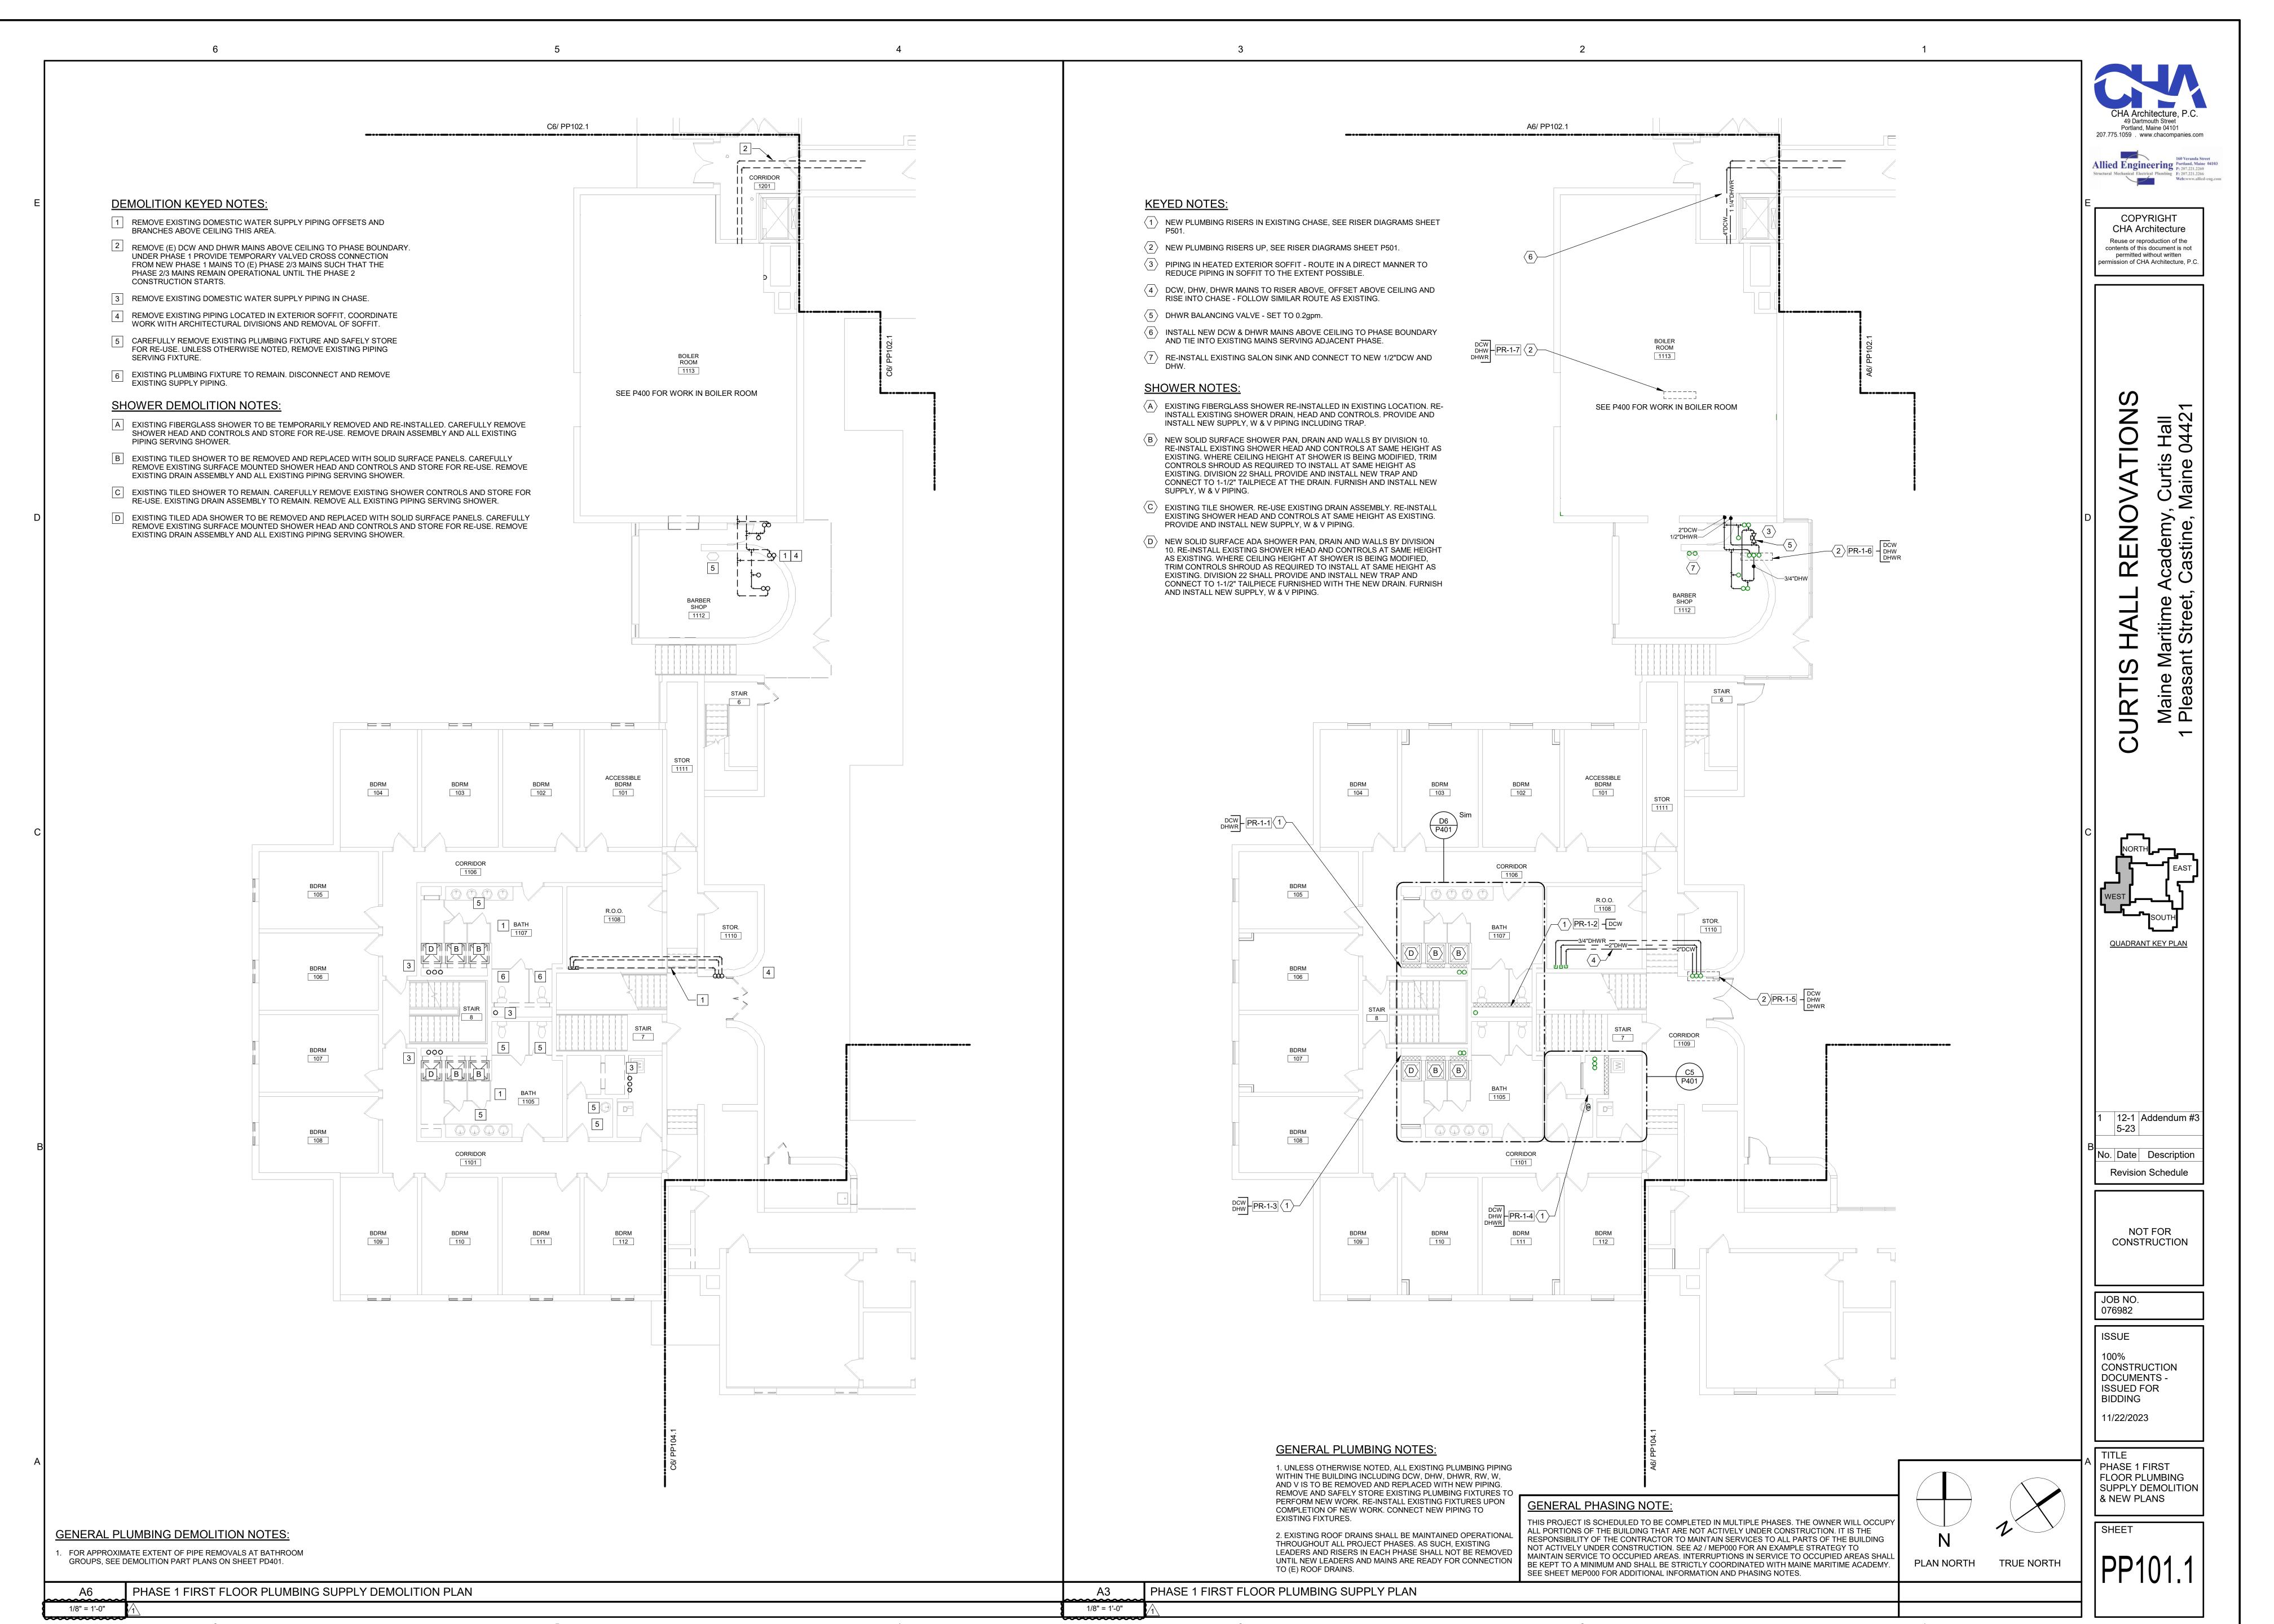


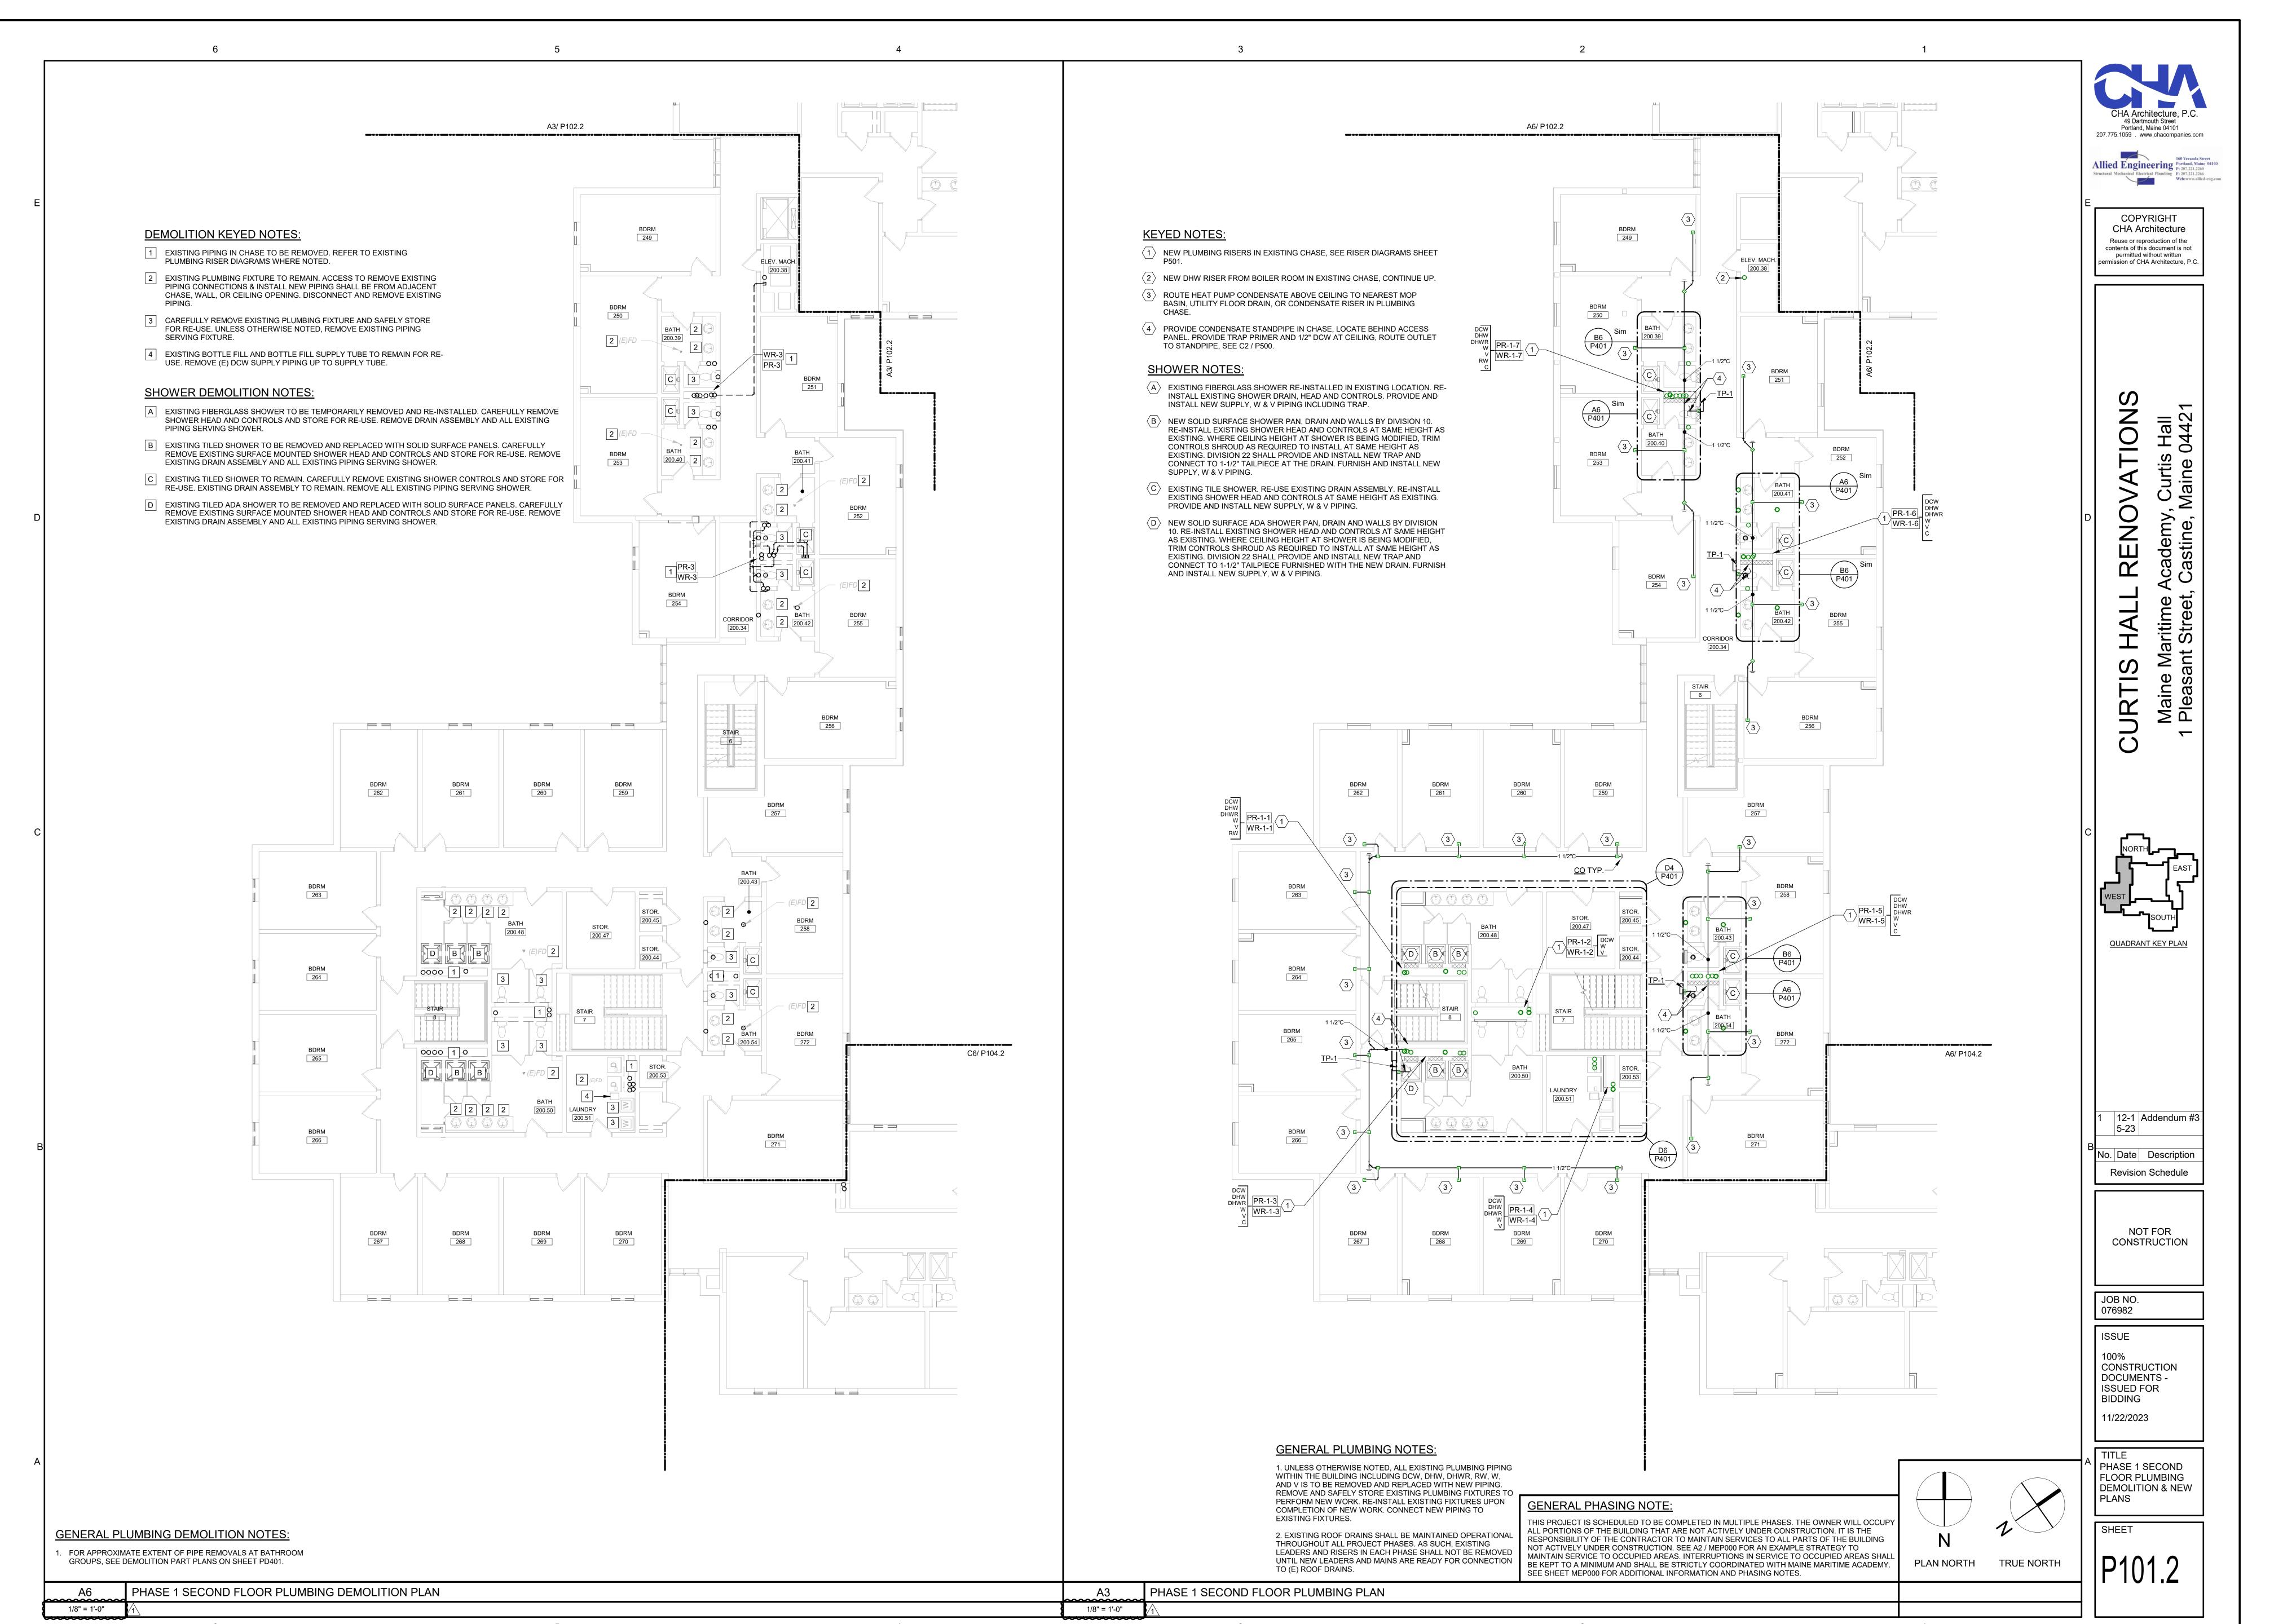


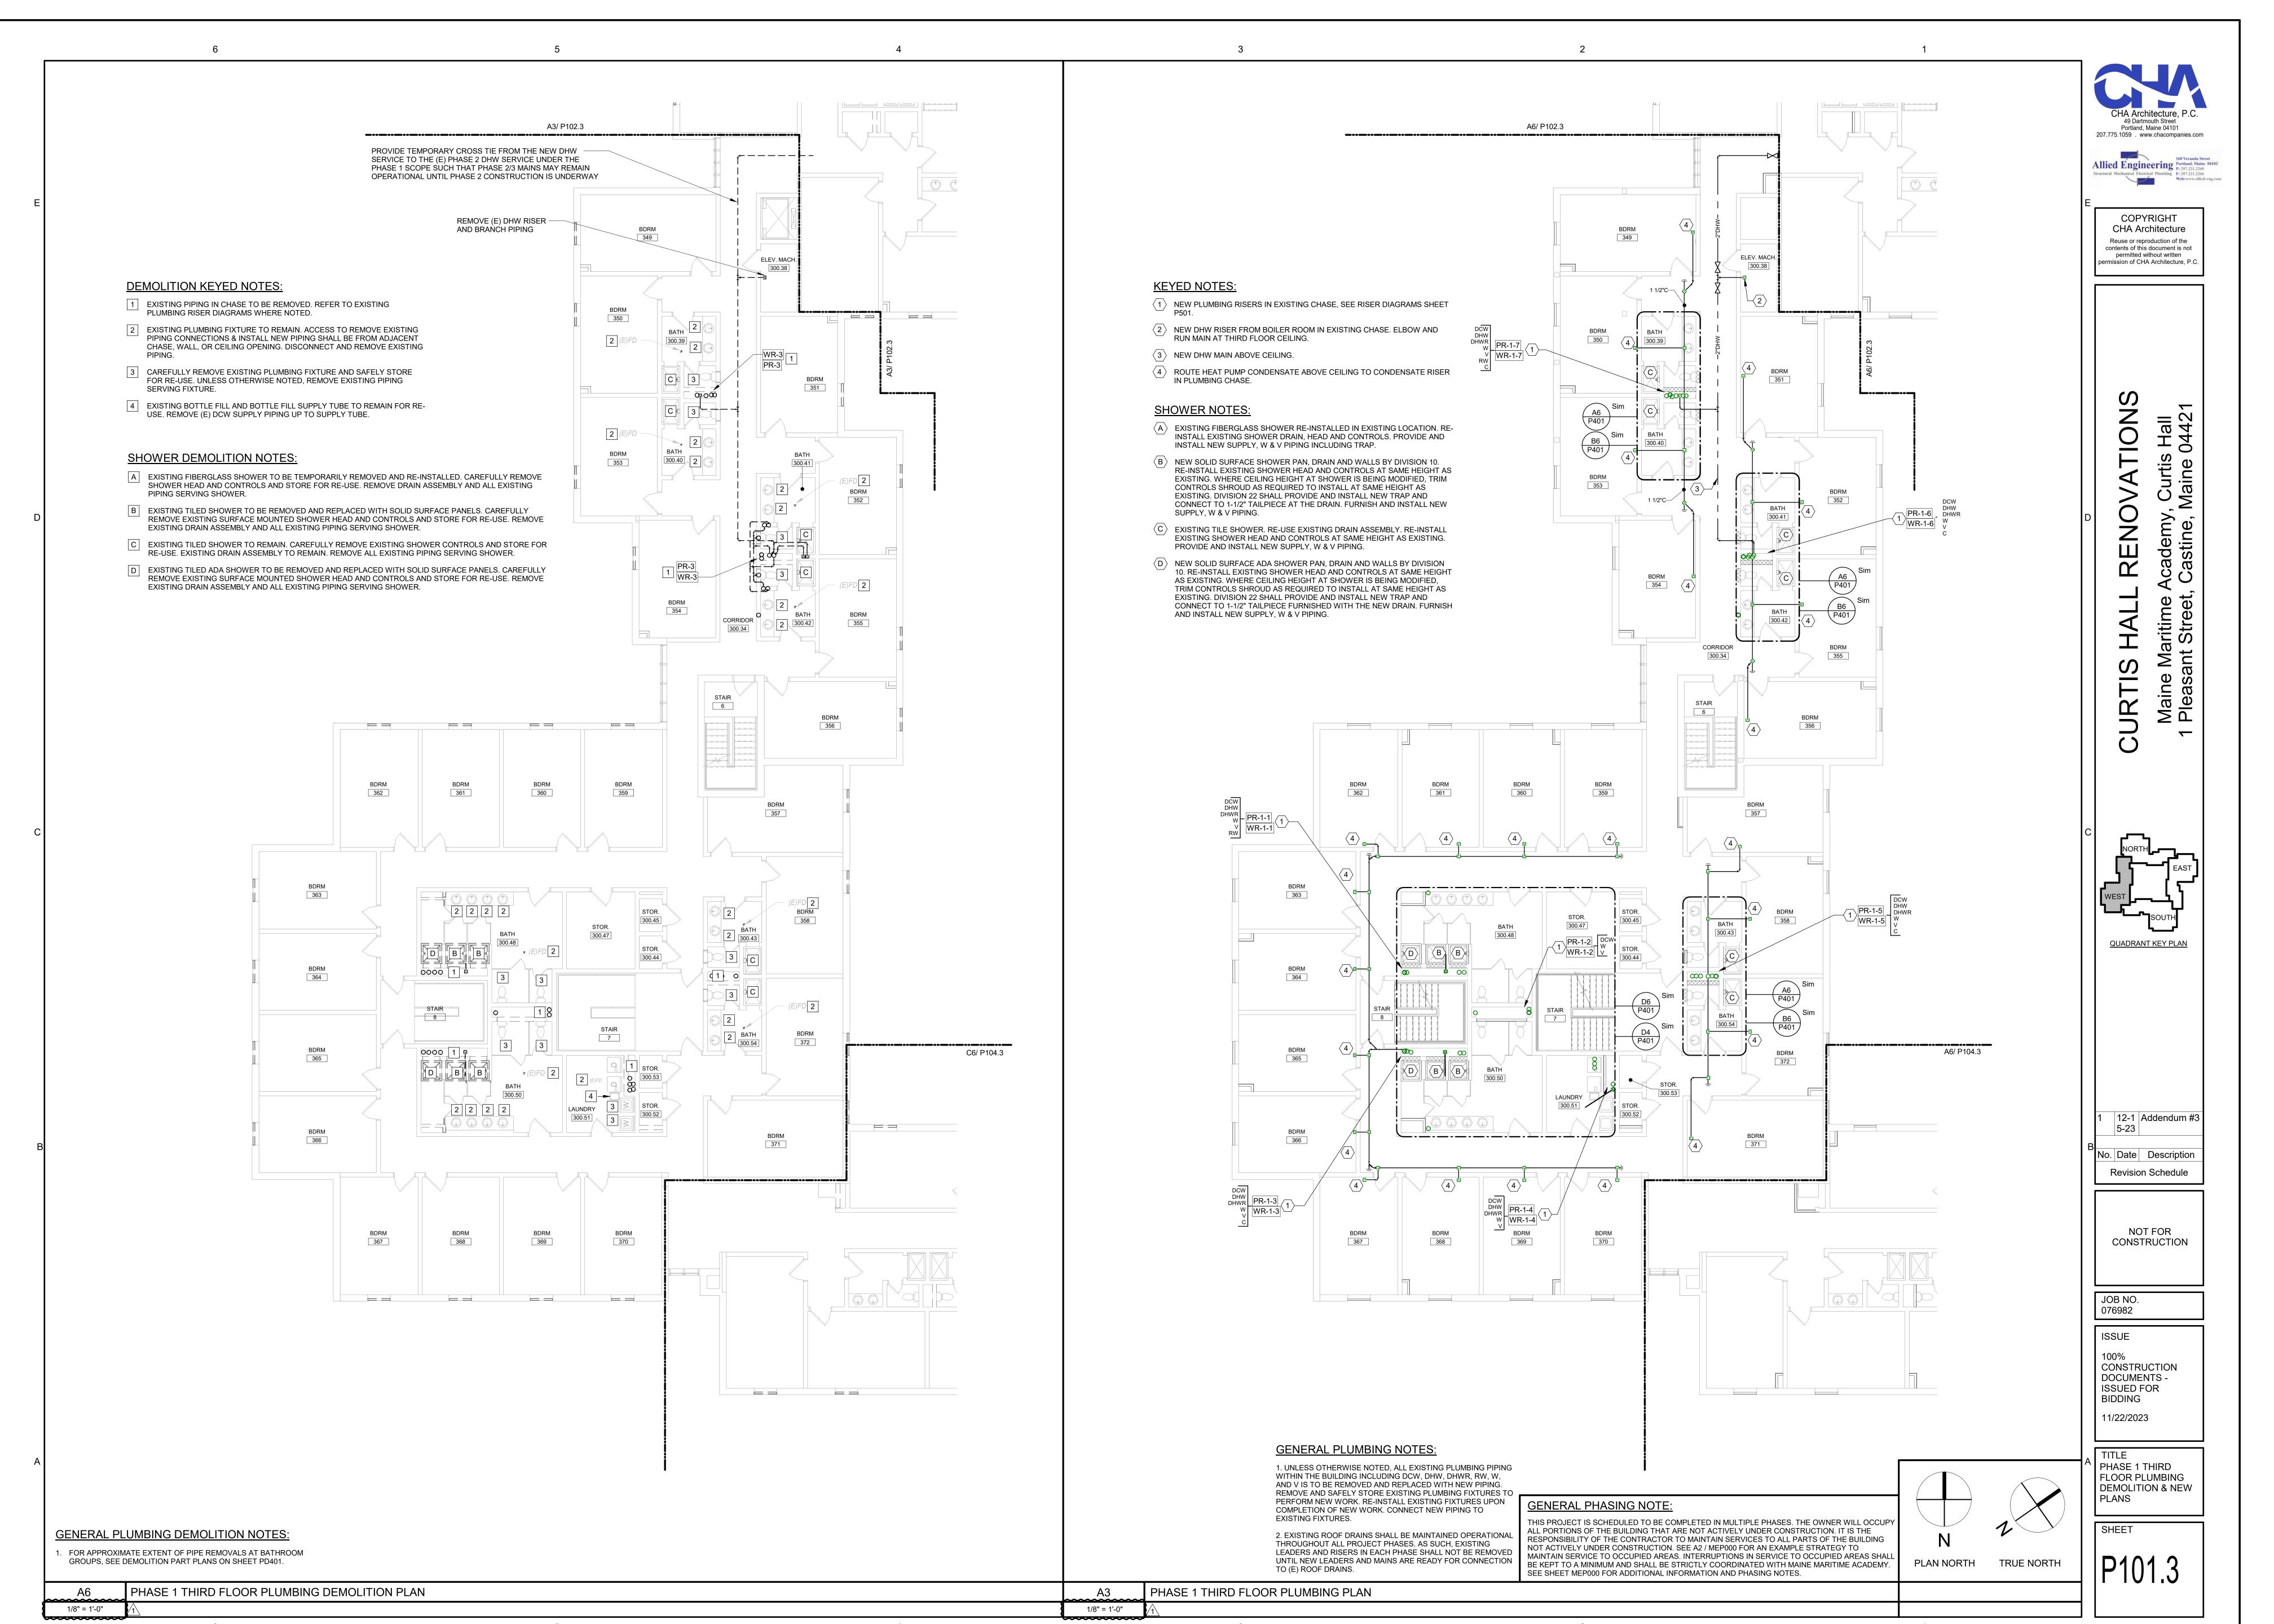


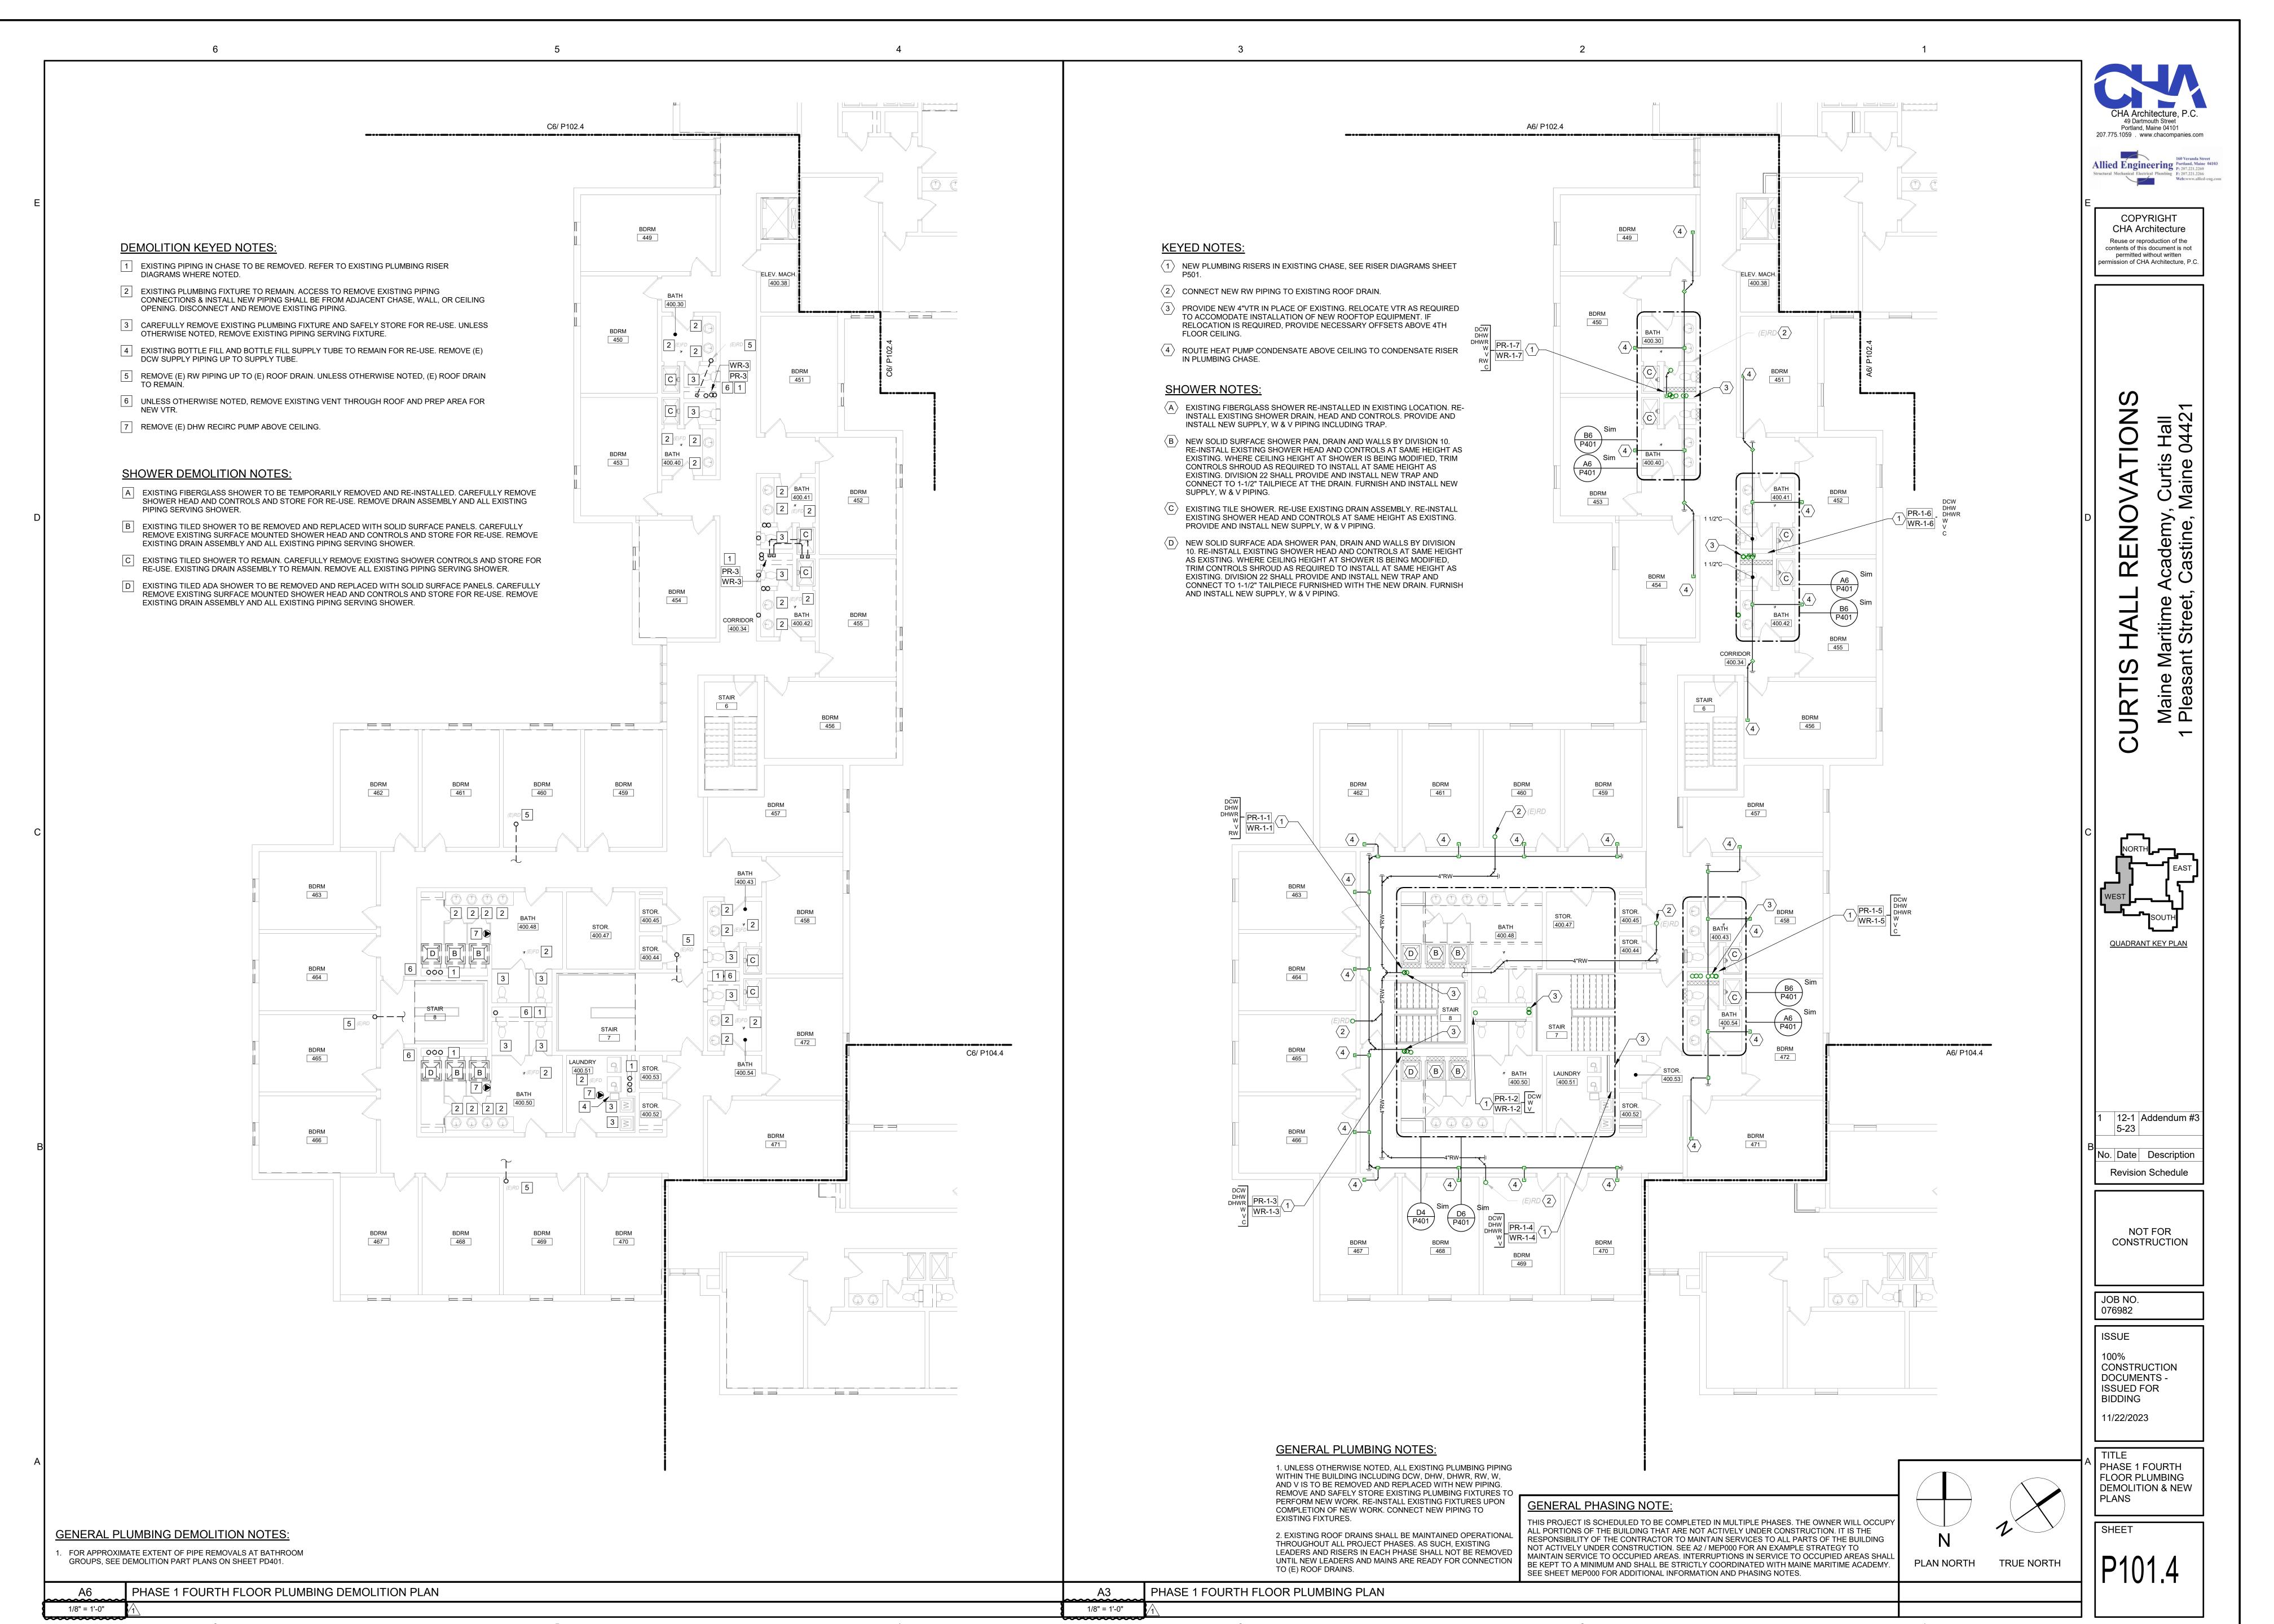



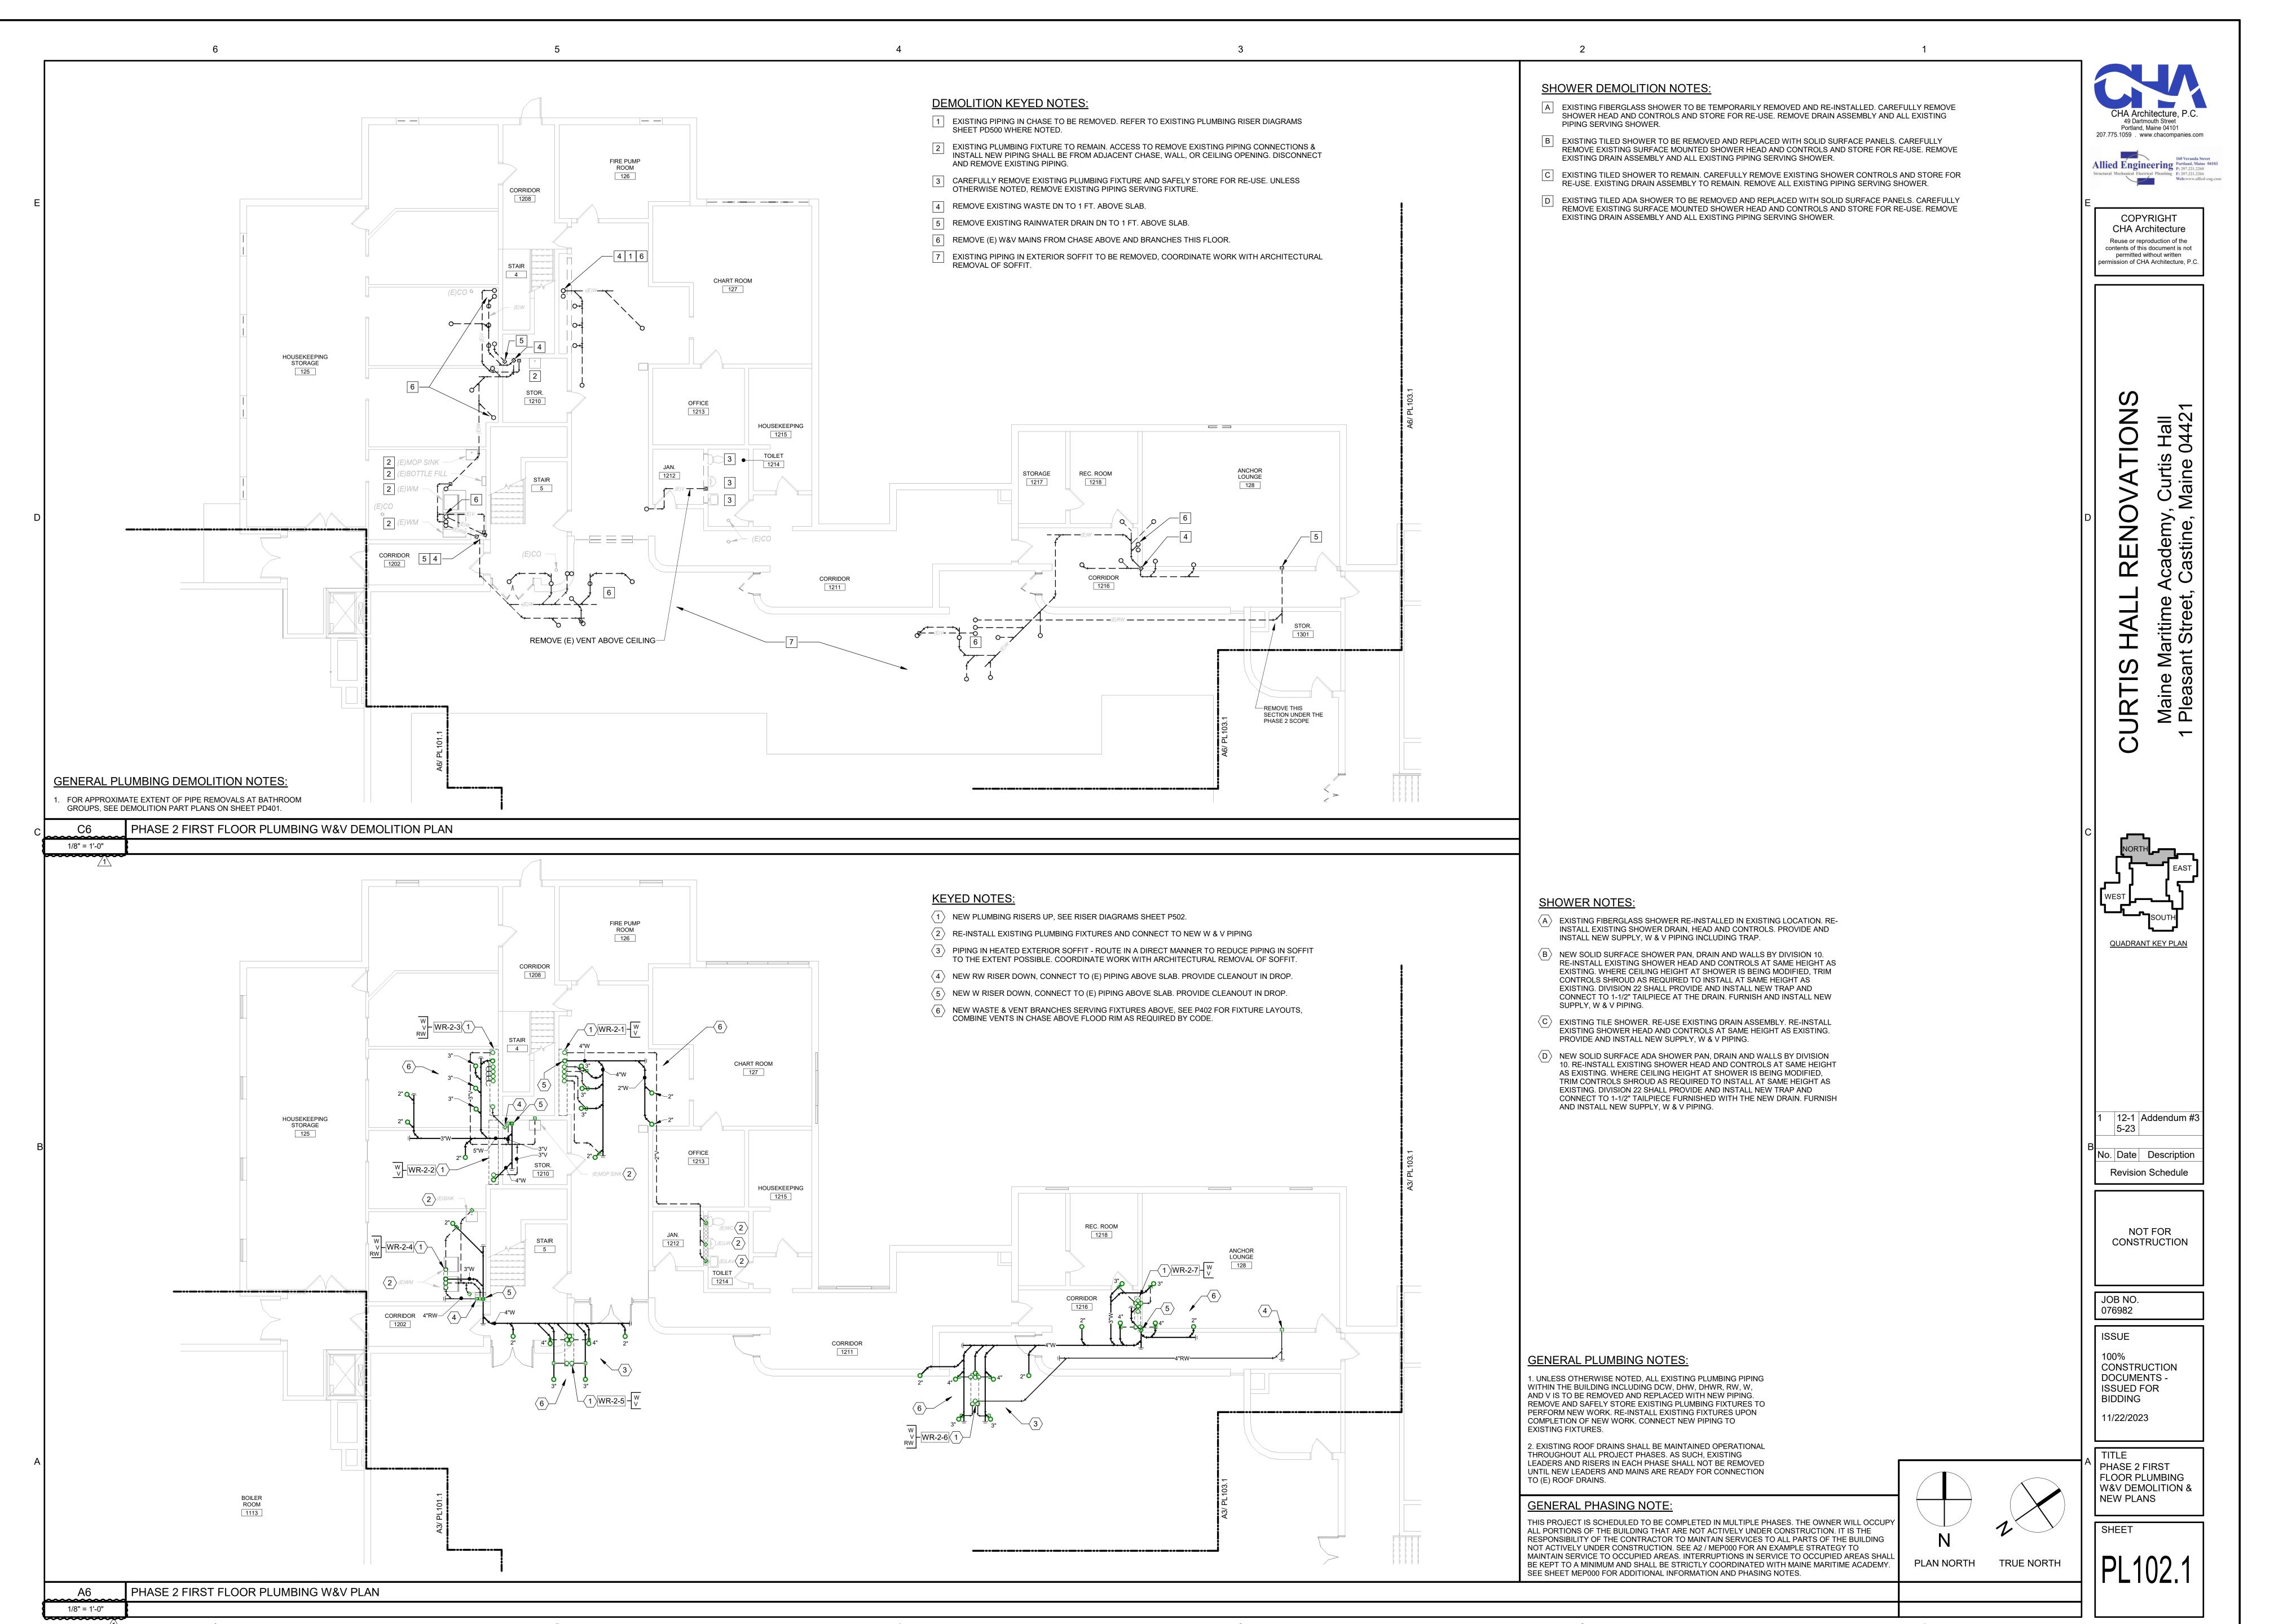

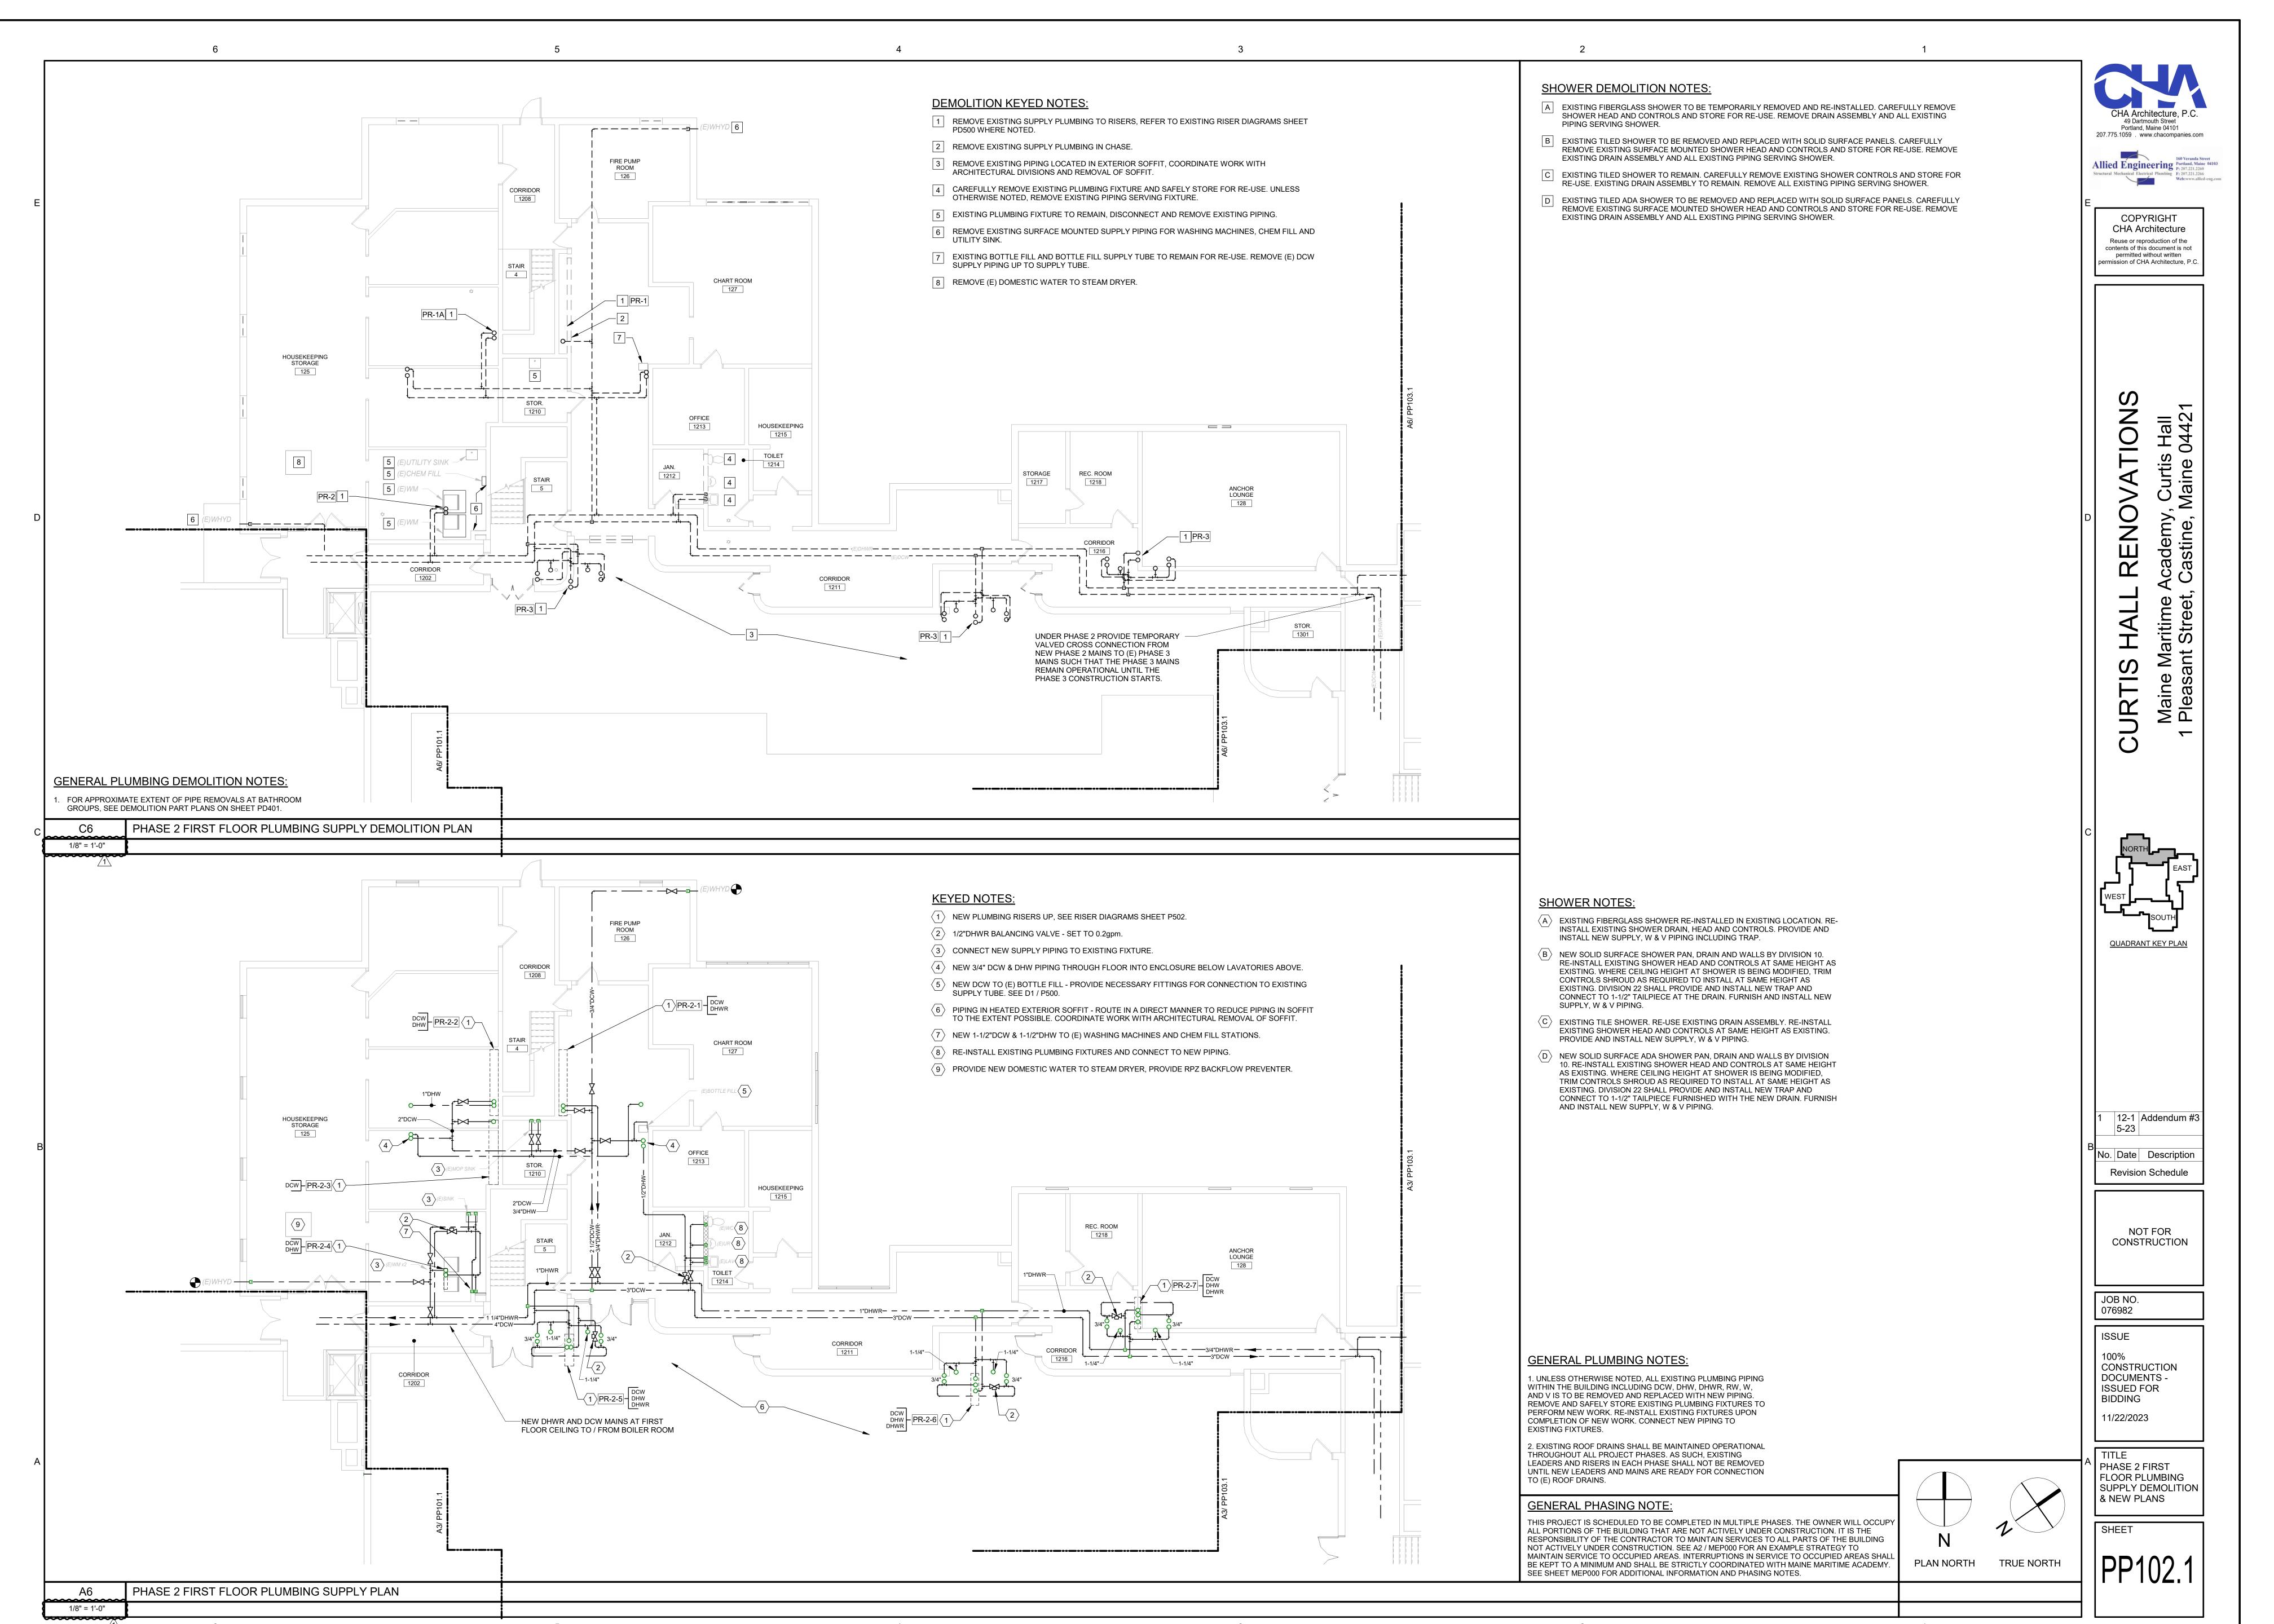

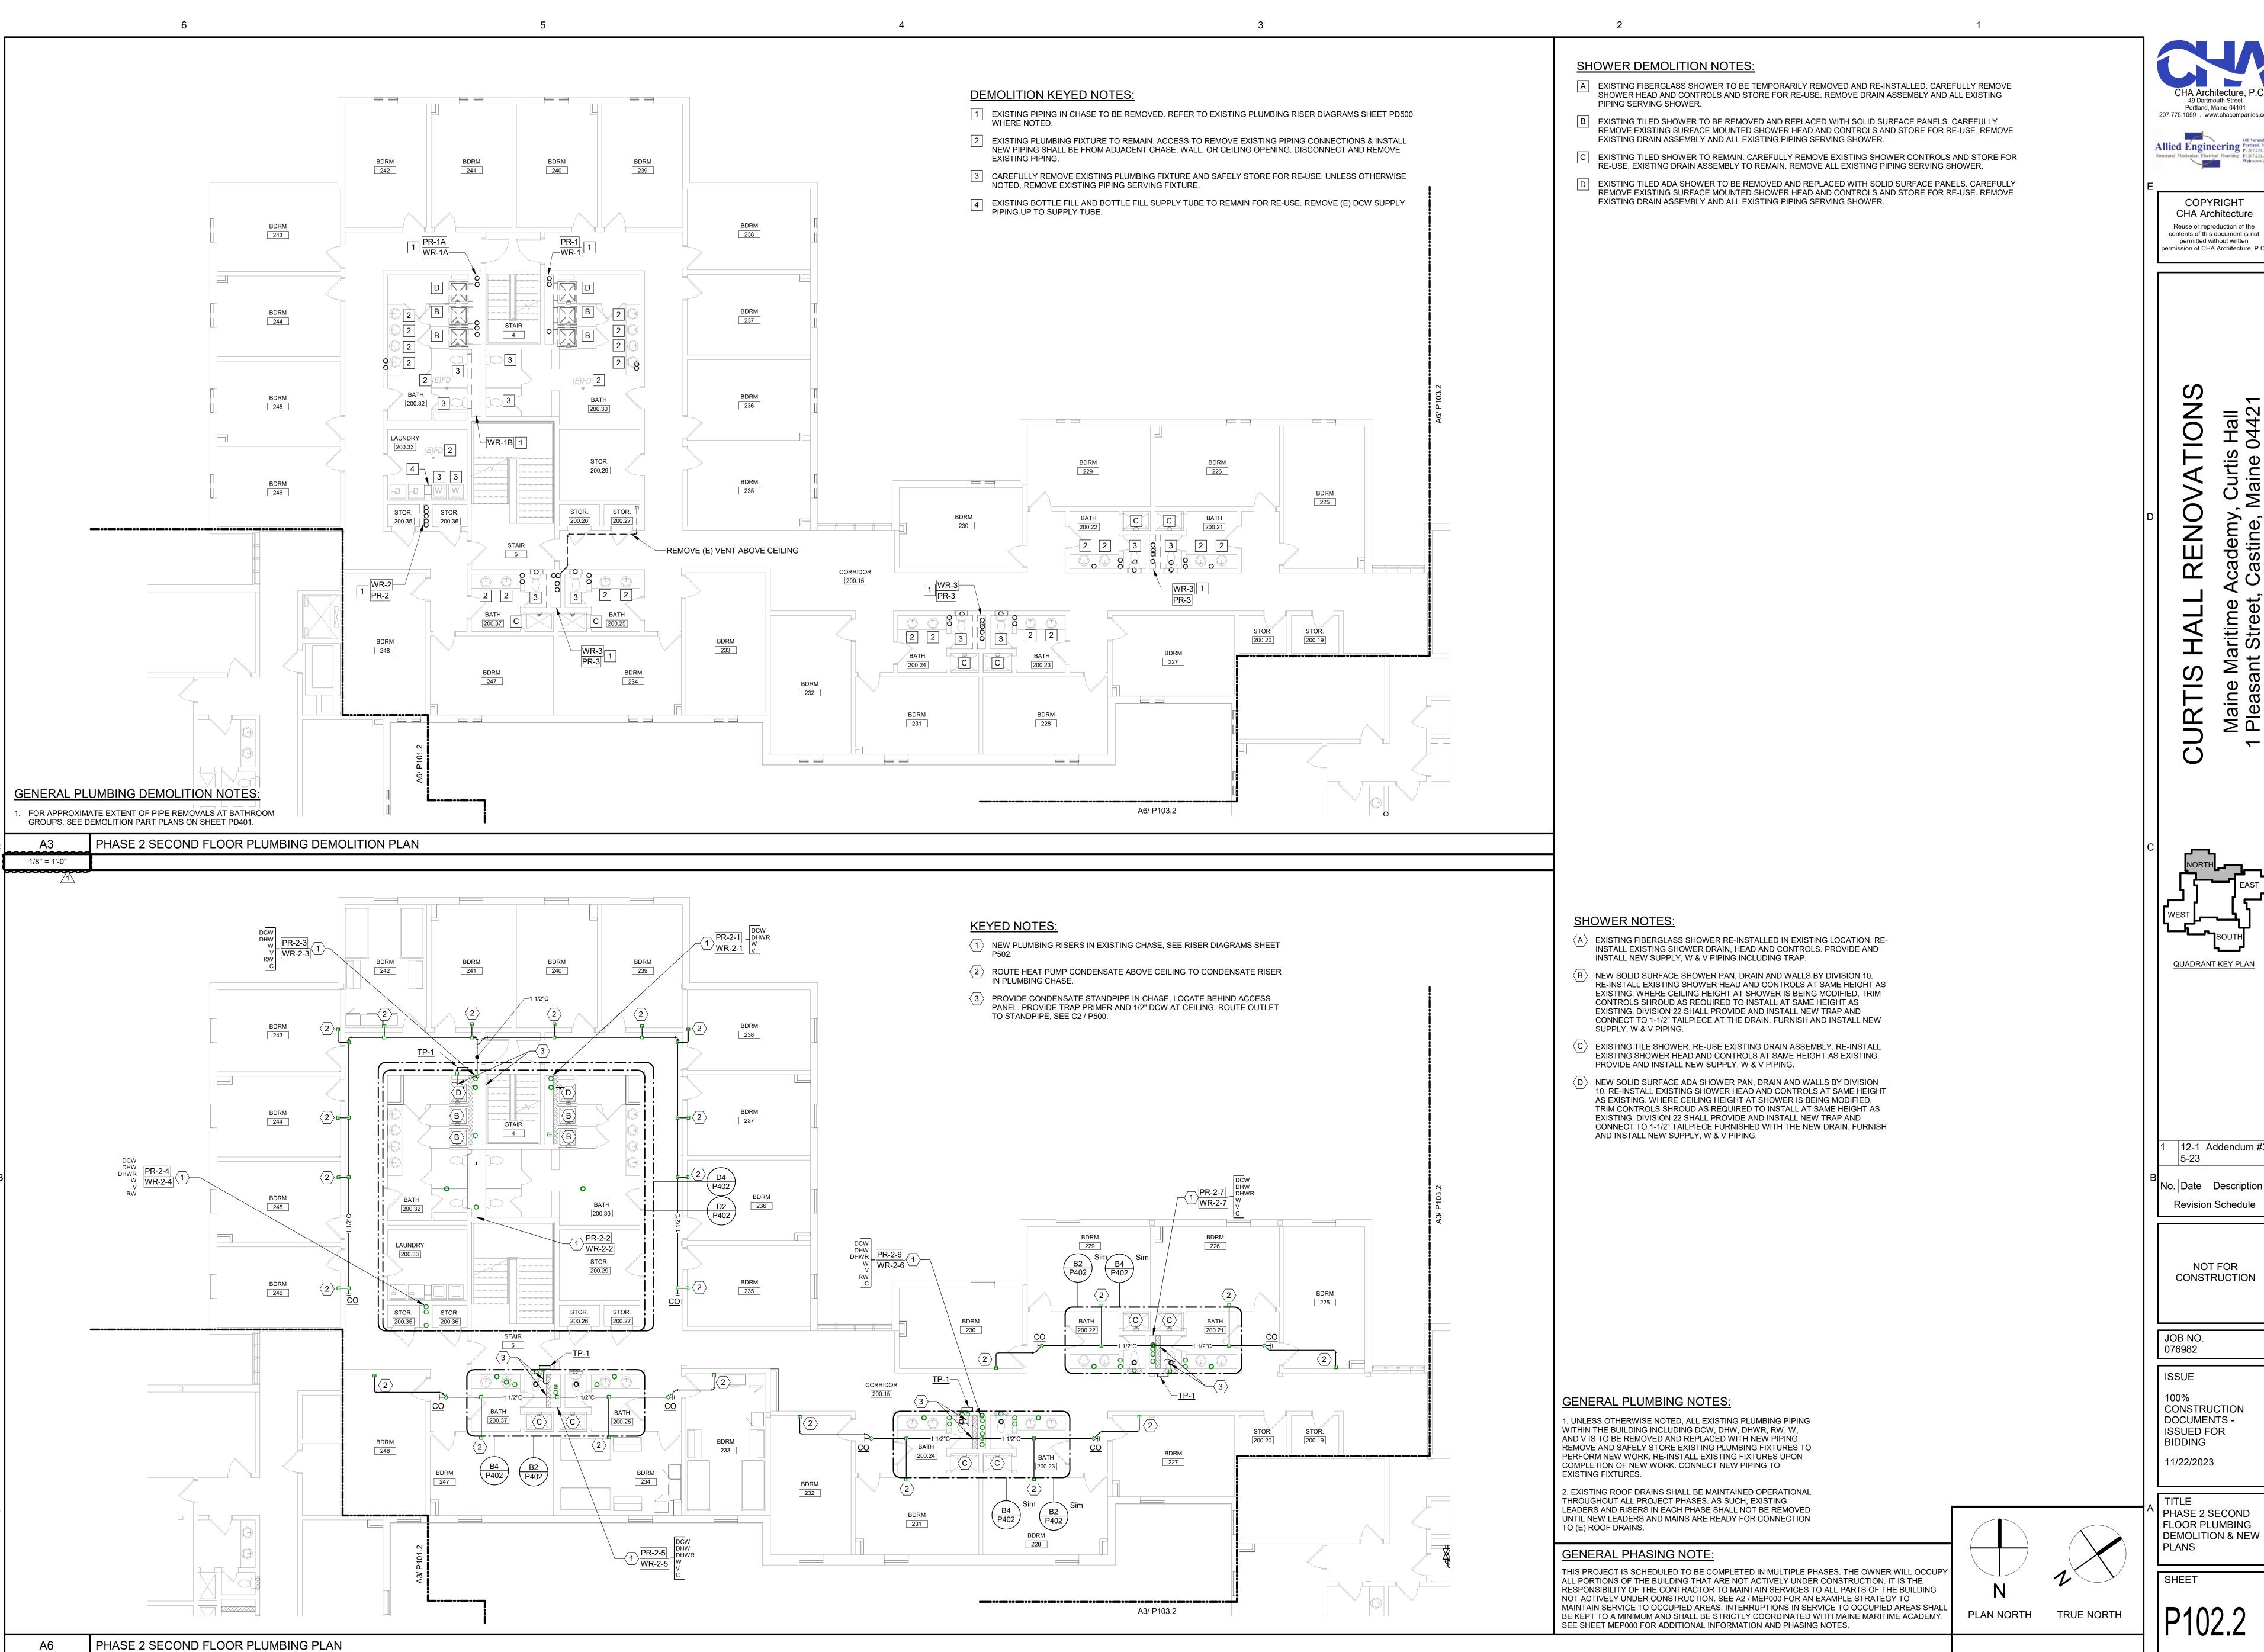

Portland, Maine 04101 207.775.1059 . www.chacompanies.com

Allied Engineering Portland, Maine 04103
Pr. 207.221.2260
Structural Mechanical Electrical Plumbing F: 207.221.2266

COPYRIGHT CHA Architecture Reuse or reproduction of the contents of this document is not permitted without written permission of CHA Architecture, P.


12-1 Addendum #3

Revision Schedule

NOT FOR CONSTRUCTION

CONSTRUCTION

PHASE 2 SECOND FLOOR PLUMBING DEMOLITION & NEW

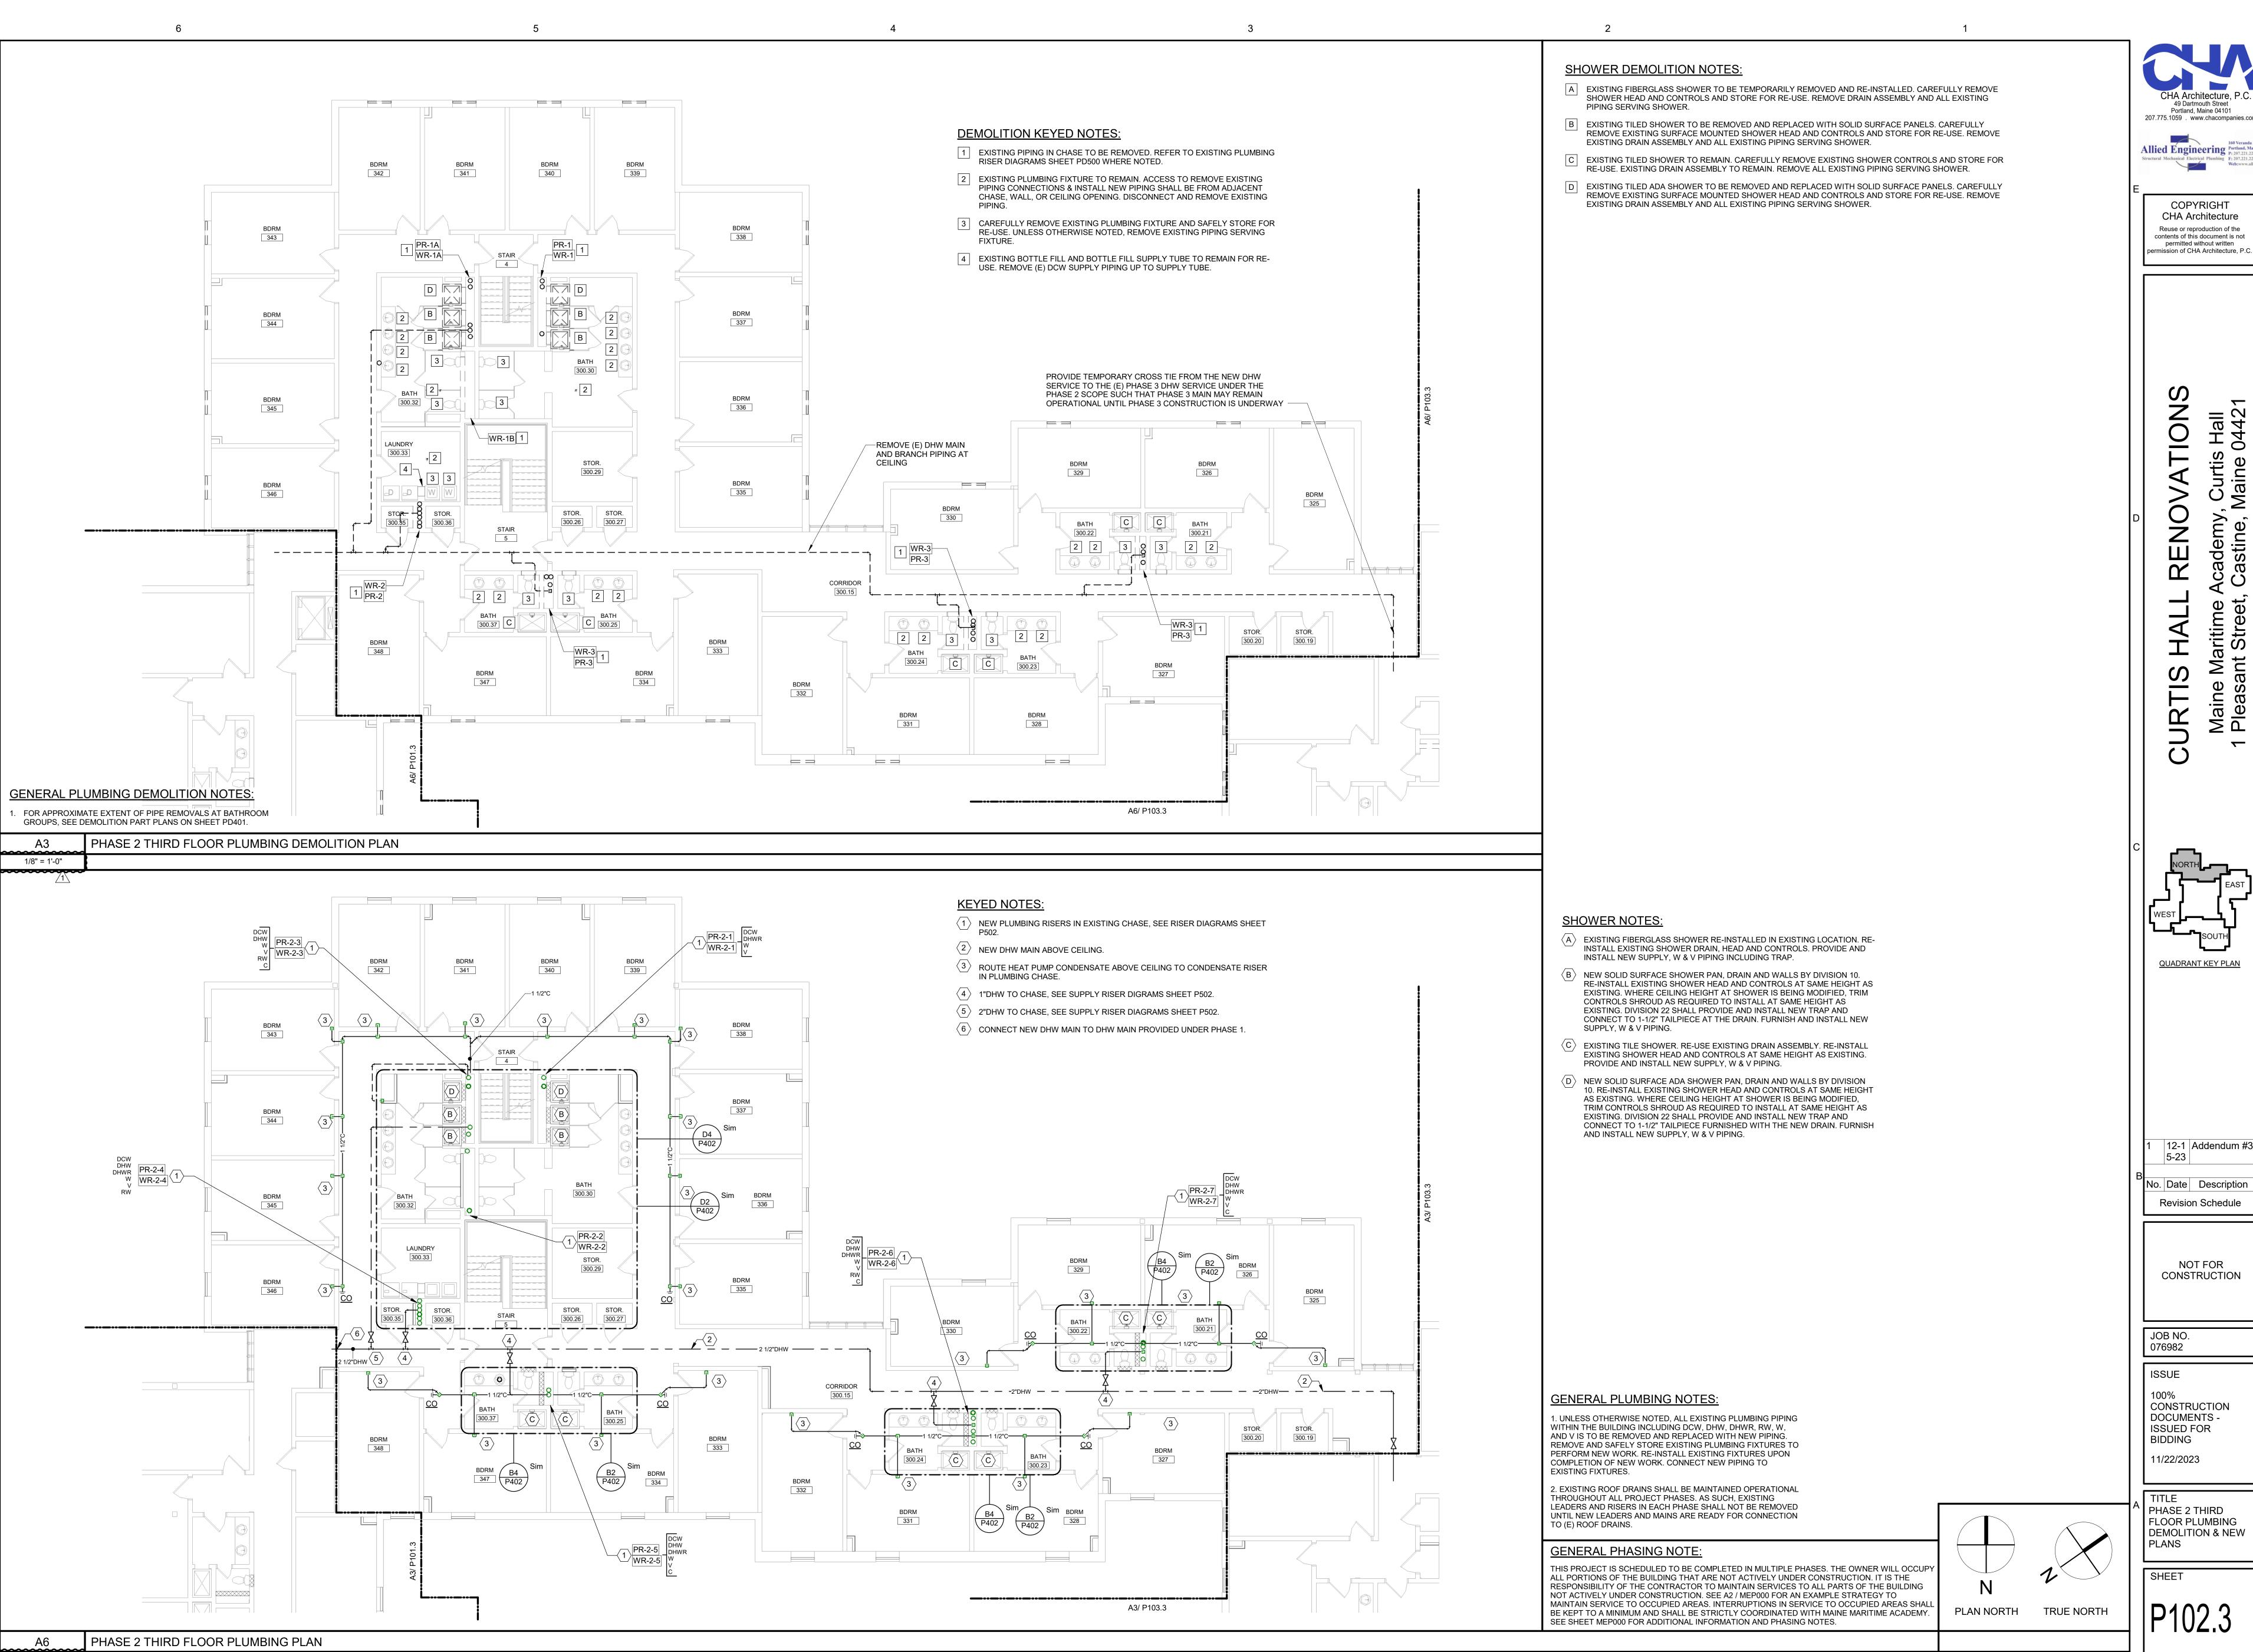

Portland, Maine 04101 207.775.1059 www.chacompanies.com


Allied Engineering Portland, Maine 04103 P: 207.221.2260 Structural Mechanical Electrical Plumbing F: 207.221.2266

COPYRIGHT **CHA Architecture** Reuse or reproduction of the contents of this document is not permitted without written permission of CHA Architecture, P.

QUADRANT KEY PLAN

CONSTRUCTION

PHASE 2 THIRD FLOOR PLUMBING DEMOLITION & NEW

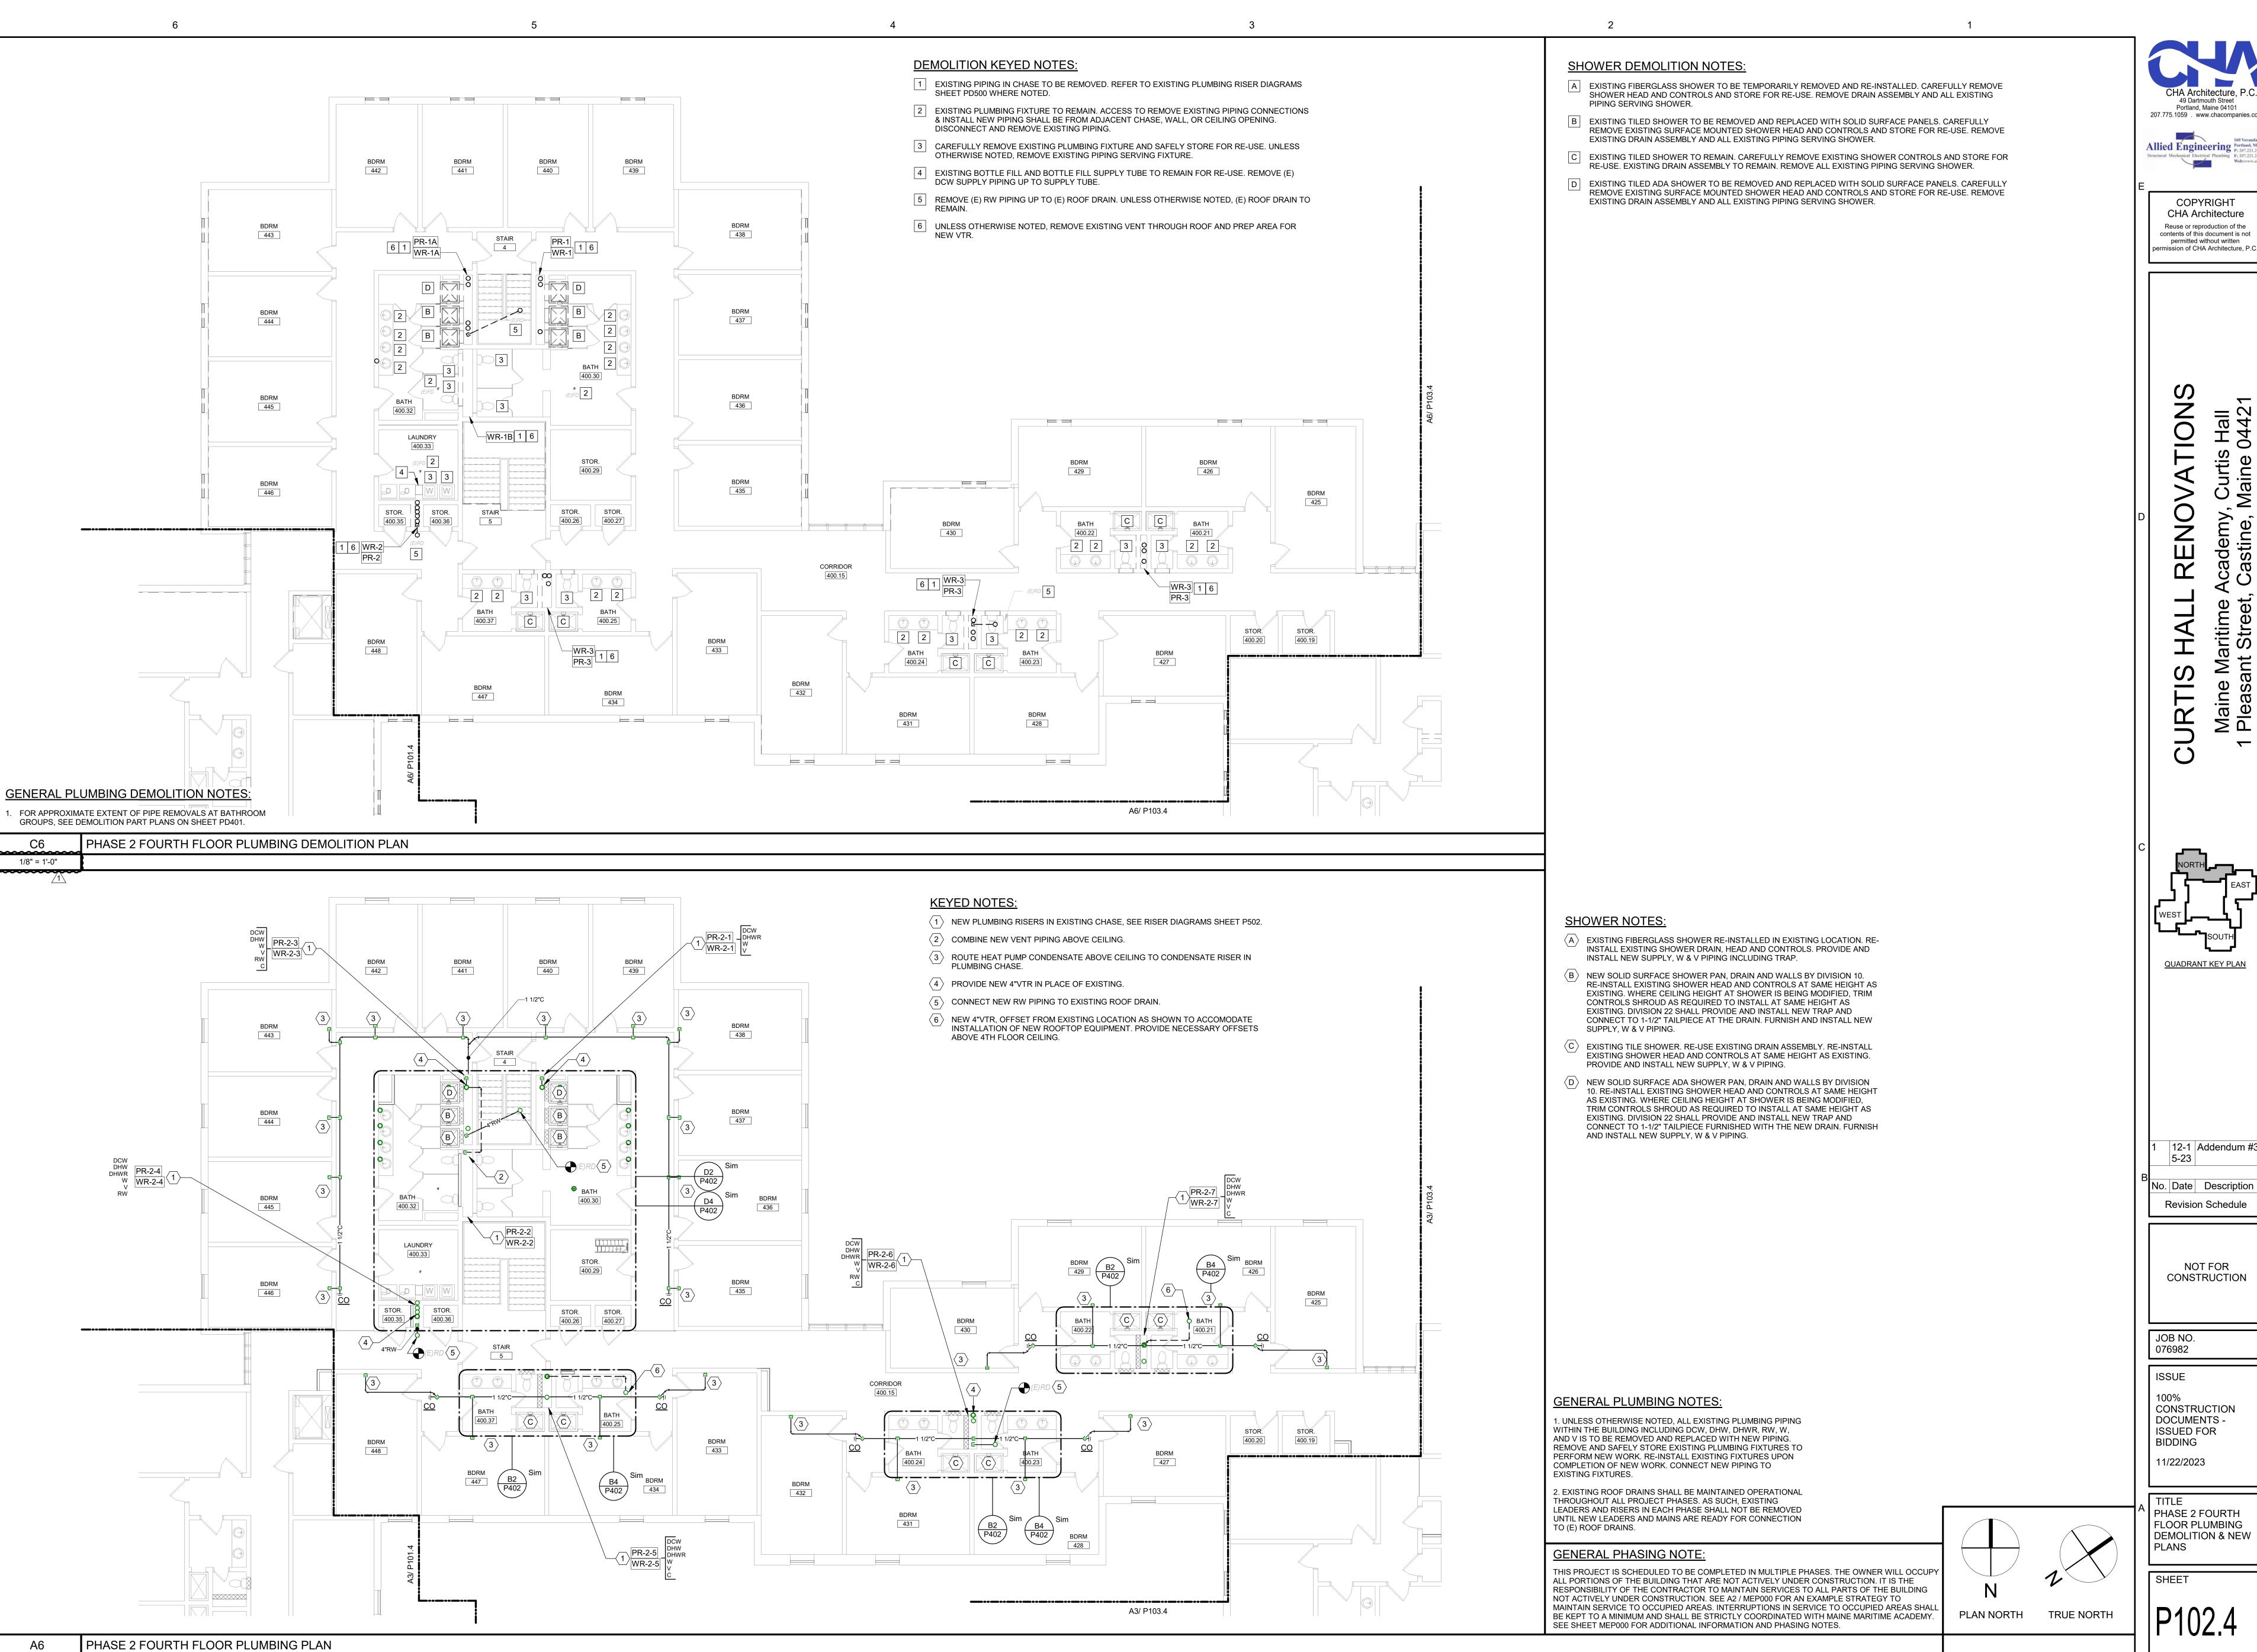

Portland, Maine 04101 207.775.1059 . www.chacompanies.com

Allied Engineering Portland, Maine 04103
Pr. 207.221.2260
Structural Mechanical Electrical Plumbing F: 207.221.2266
Web:www.allied-eng.com

COPYRIGHT CHA Architecture Reuse or reproduction of the contents of this document is not permitted without written permission of CHA Architecture, P.


12-1 | Addendum #3

Revision Schedule

CONSTRUCTION

CONSTRUCTION

PHASE 2 FOURTH FLOOR PLUMBING DEMOLITION & NEW

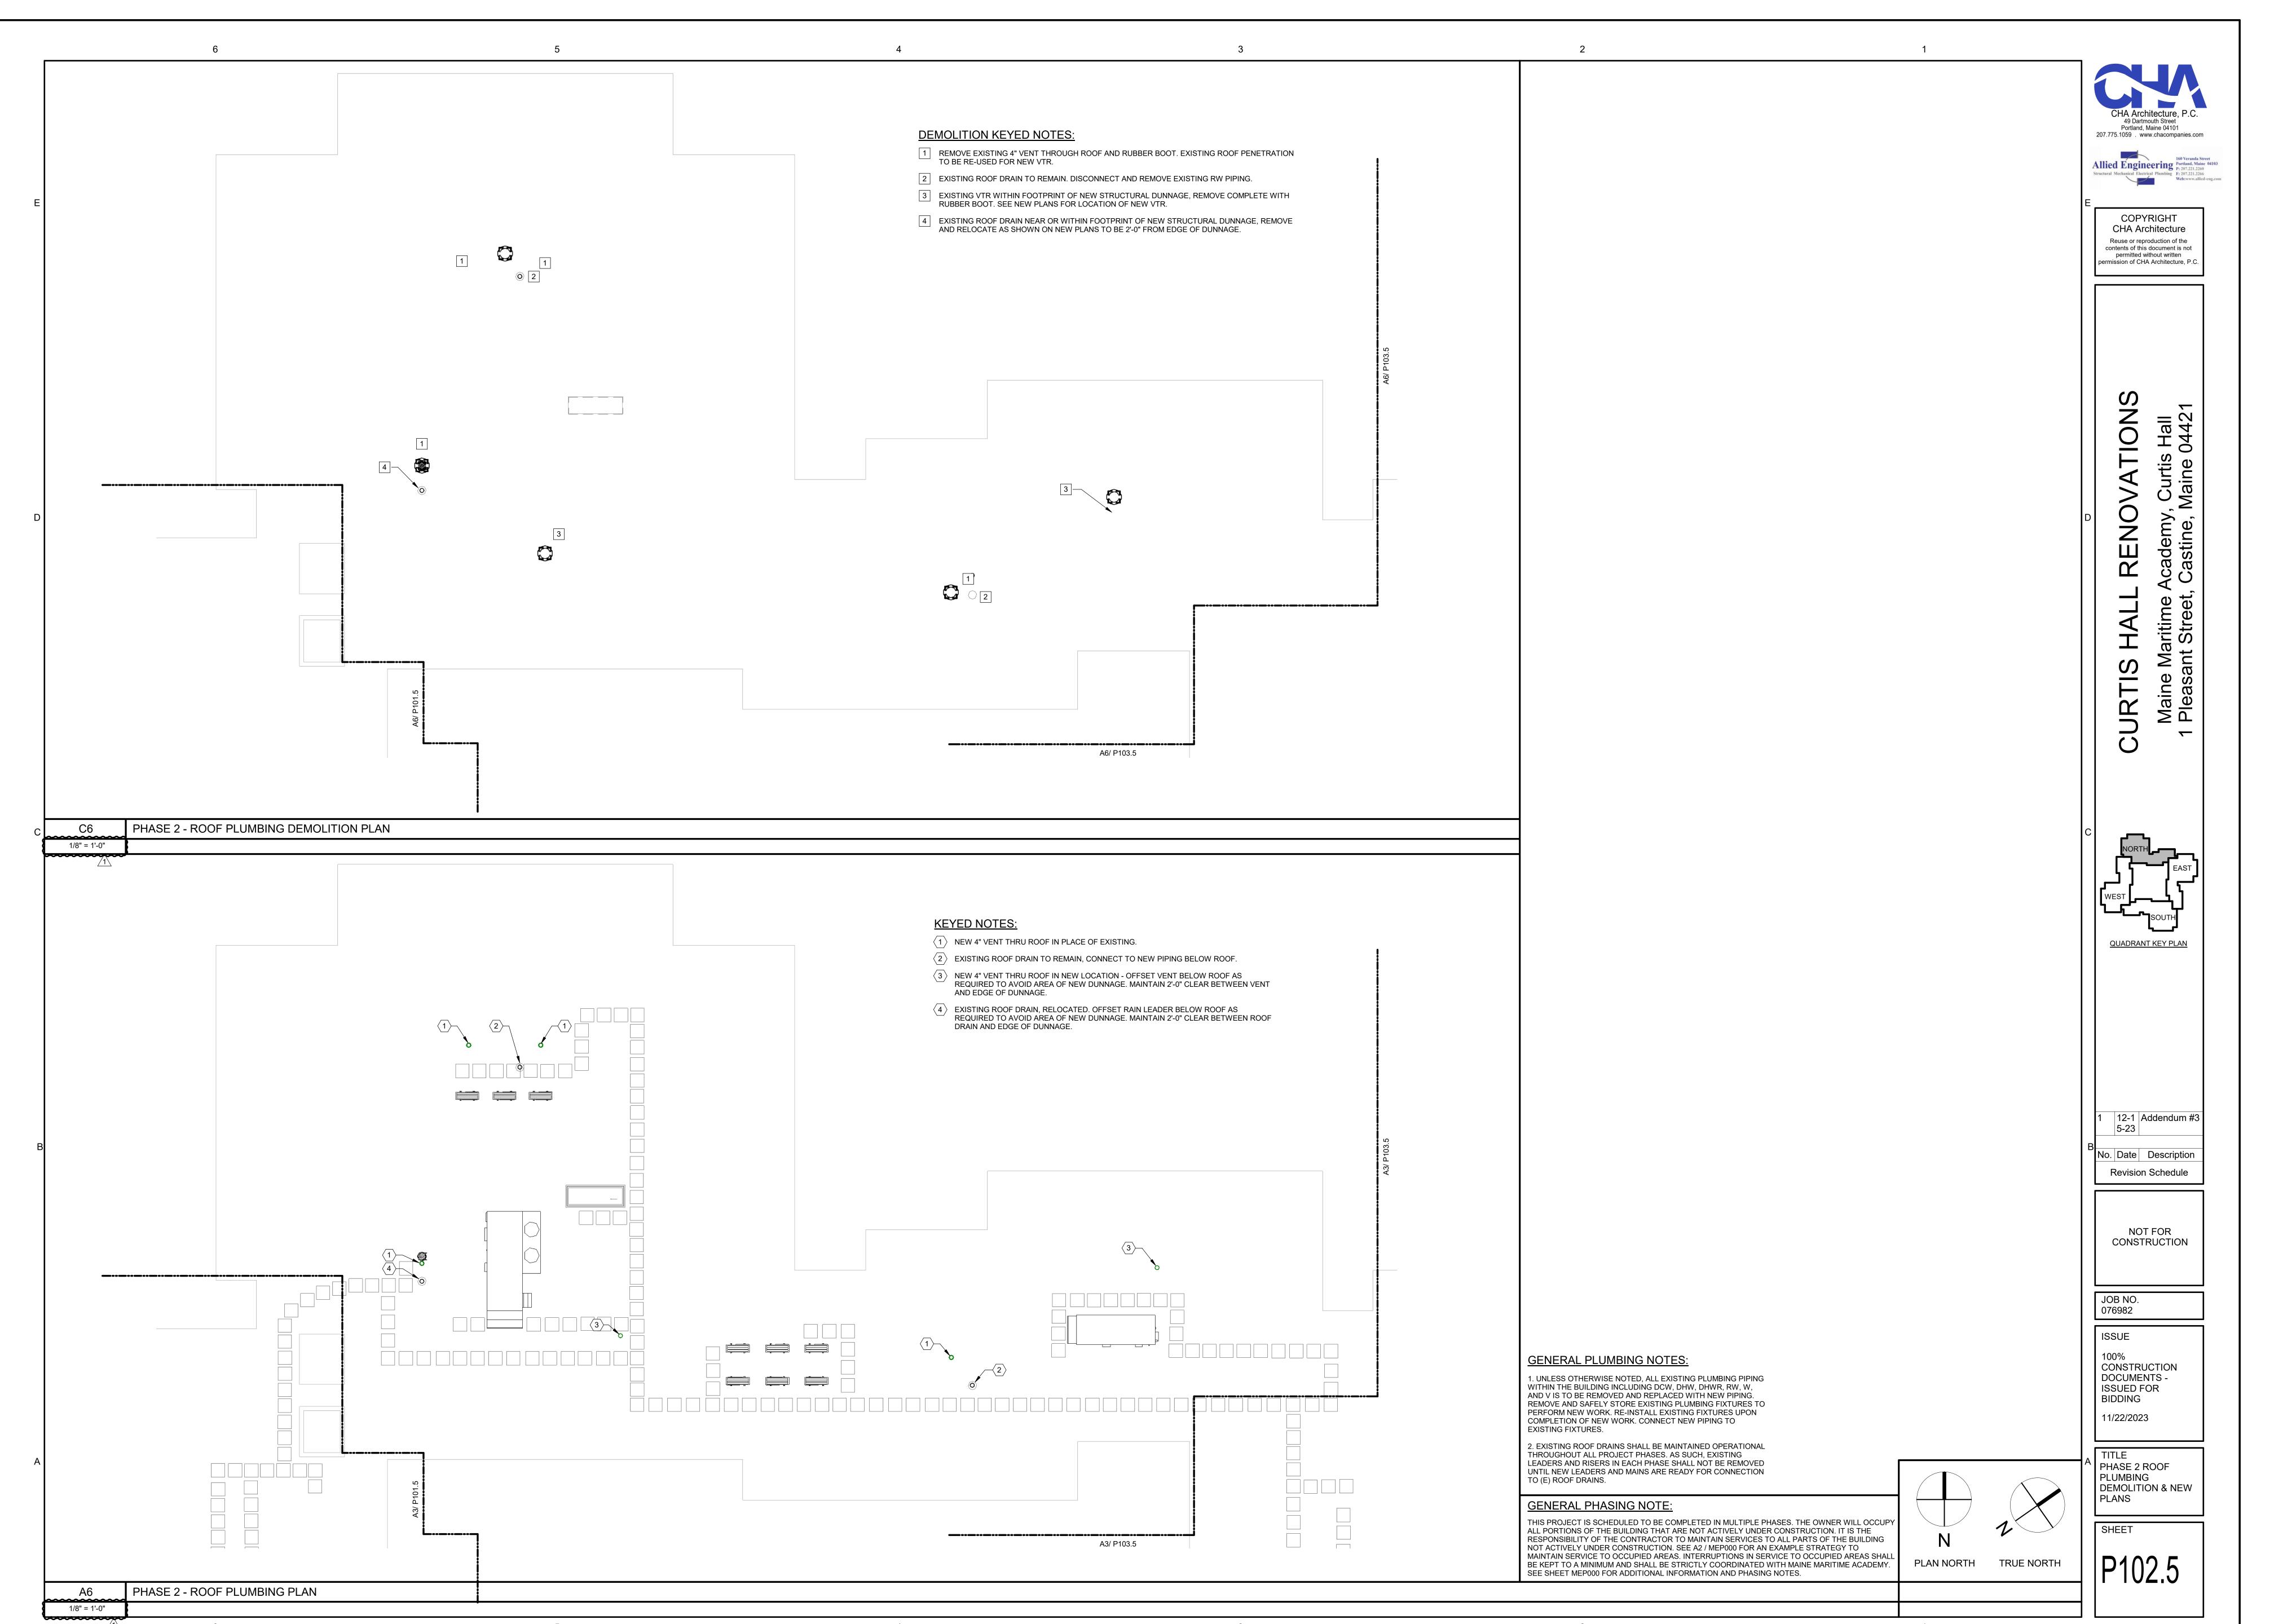



1/8" = 1'-0"

49 Dartmouth Street ['] Portland, Maine 04101 207.775.1059 . www.chacompanies.com

Allied Engineering
Structural Mechanical Electrical Plumbing
F: 207.221.2266
Web:www.allied-eng.com

COPYRIGHT CHA Architecture Reuse or reproduction of the contents of this document is not permitted without written ermission of CHA Architecture, P.

QUADRANT KEY PLAN


12-1 | Addendum #3

No. Date Description Revision Schedule

> NOT FOR CONSTRUCTION

CONSTRUCTION DOCUMENTS -ISSUED FOR

PHASE 3 FIRST FLOOR PLUMBING W&V DEMOLITION &

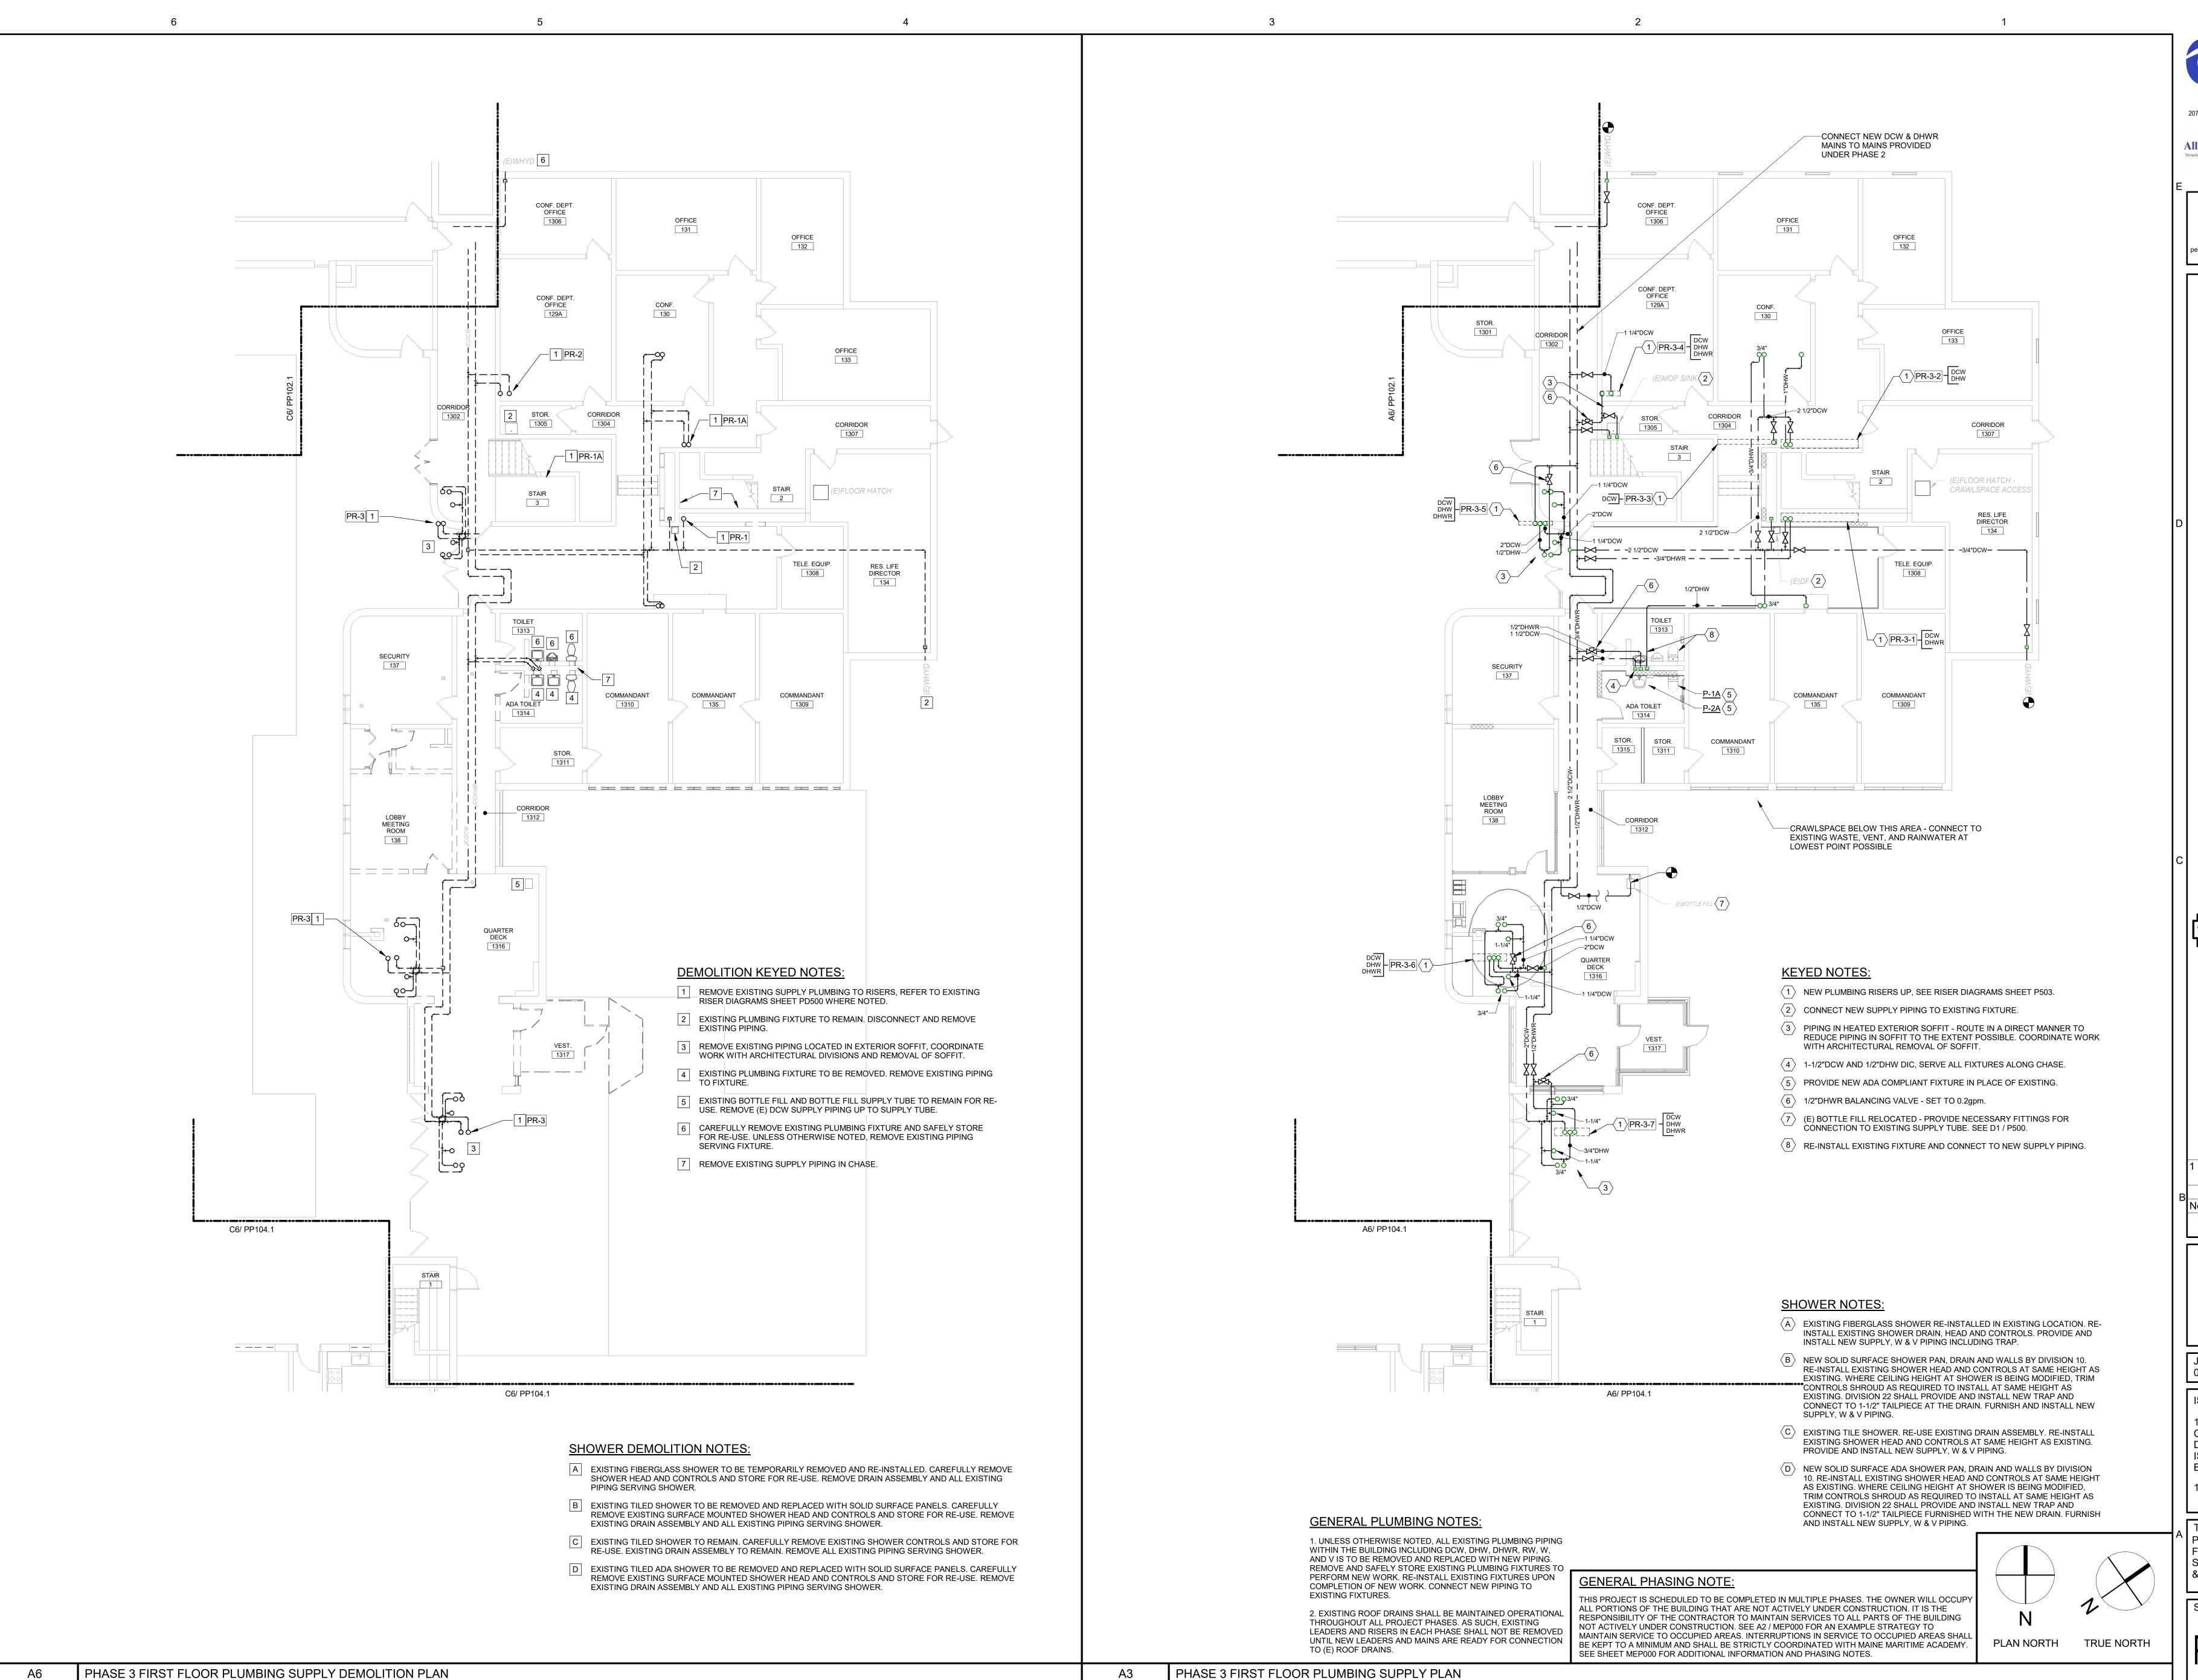


49 Dartmouth Street Portland, Maine 04101 207.775.1059 . www.chacompanies.com

Allied Engineering Portland, Maine 04103
P; 207,221,2266
Structural Mechanical Electrical Plumbing F; 207,221,2266
Web:www.allied-eng.com

COPYRIGHT CHA Architecture Reuse or reproduction of the permitted without written permission of CHA Architecture, P.

contents of this document is not

RENO

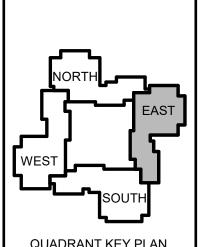

QUADRANT KEY PLAN

12-1 | Addendum #3 5-23

No. Date Description

Revision Schedule


NOT FOR CONSTRUCTION

JOB NO. 076982

ISSUE CONSTRUCTION DOCUMENTS -ISSUED FOR BIDDING 11/22/2023

PHASE 3 FIRST FLOOR PLUMBING SUPPLY DEMOLITION & NEW PLANS

SHEET

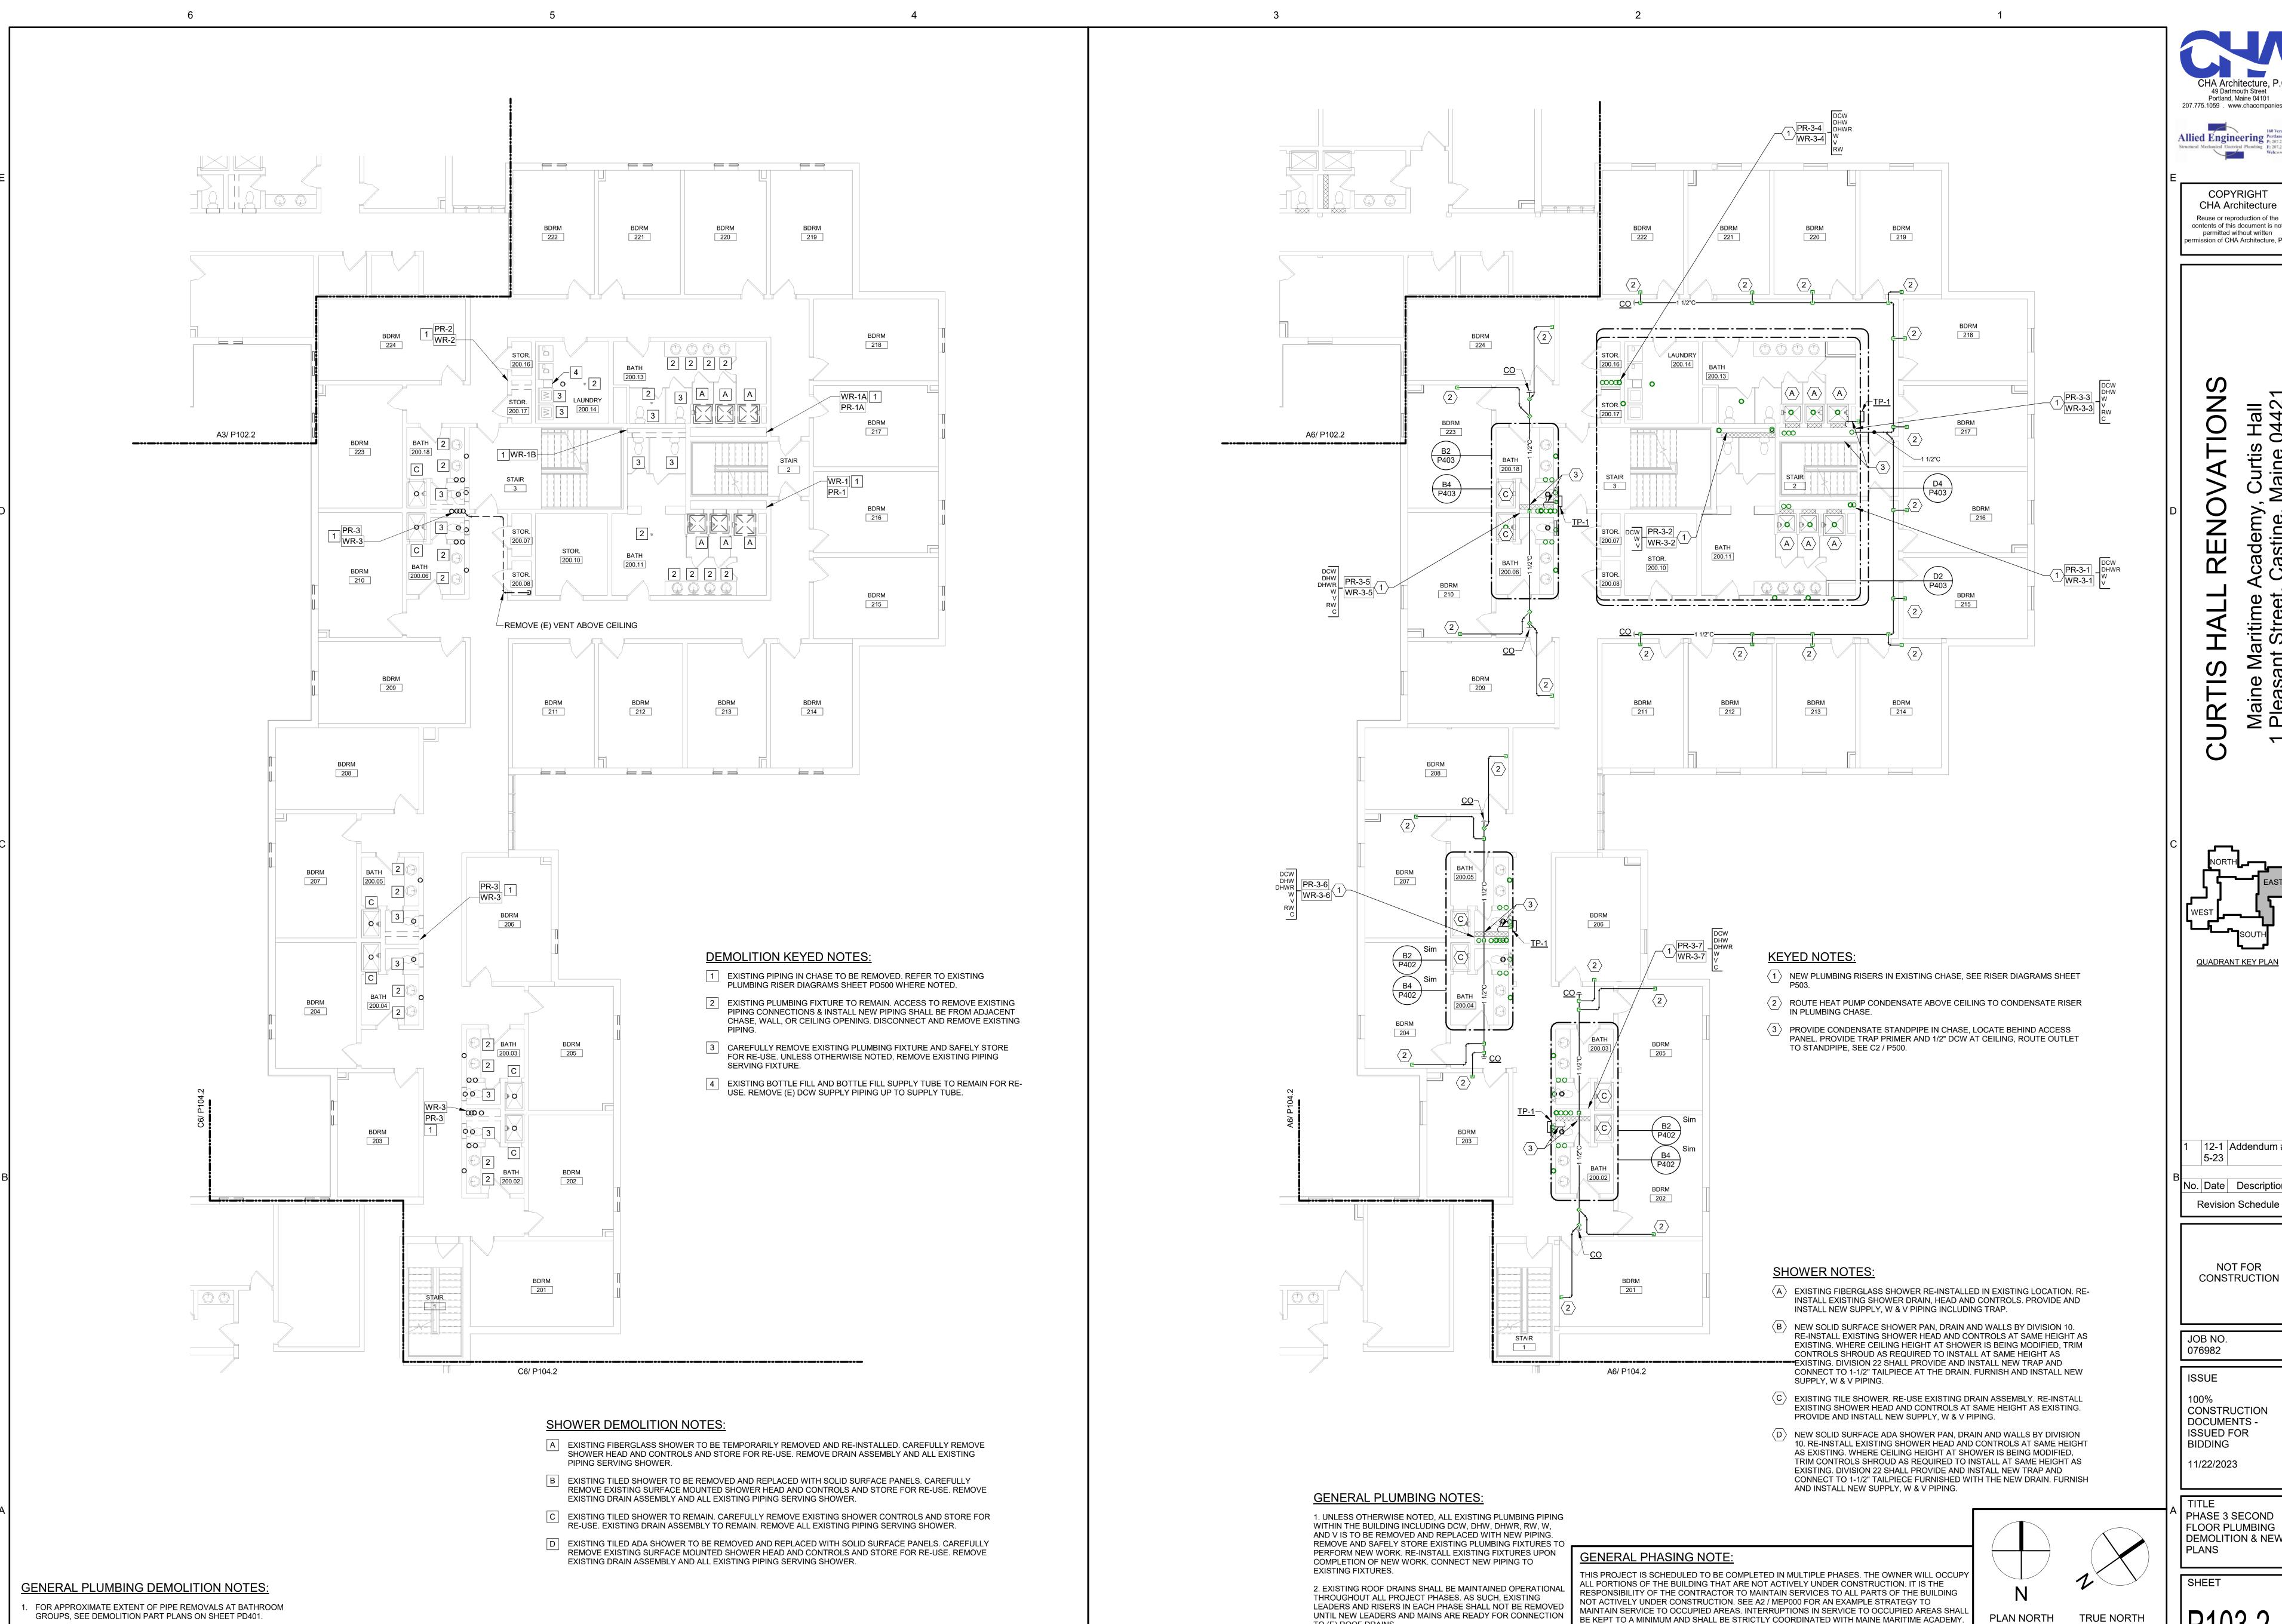

PHASE 3 SECOND FLOOR PLUMBING DEMOLITION PLAN

1/8" = 1'-0"

TO (E) ROOF DRAINS.

PHASE 3 SECOND FLOOR PLUMBING PLAN

A3

1/8" = 1'-0"

SEE SHEET MEP000 FOR ADDITIONAL INFORMATION AND PHASING NOTES.


49 Dartmouth Street 'Portland, Maine 04101 207.775.1059 www.chacompanies.com

Allied Engineering
Structural Mechanical Electrical Plumbing
Structural Mechanical Electrical Plumbing
160 Veranda Street
Portland, Maine 04103
P: 207.221.2260
F: 207.221.2266
Web:www.allied-eng.com

COPYRIGHT CHA Architecture Reuse or reproduction of the contents of this document is not

permitted without written permission of CHA Architecture, P.

astine,

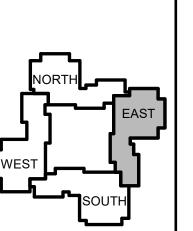

QUADRANT KEY PLAN


12-1 | Addendum #3

No. Date Description

NOT FOR CONSTRUCTION

CONSTRUCTION DOCUMENTS -ISSUED FOR

PHASE 3 SECOND FLOOR PLUMBING DEMOLITION & NEW

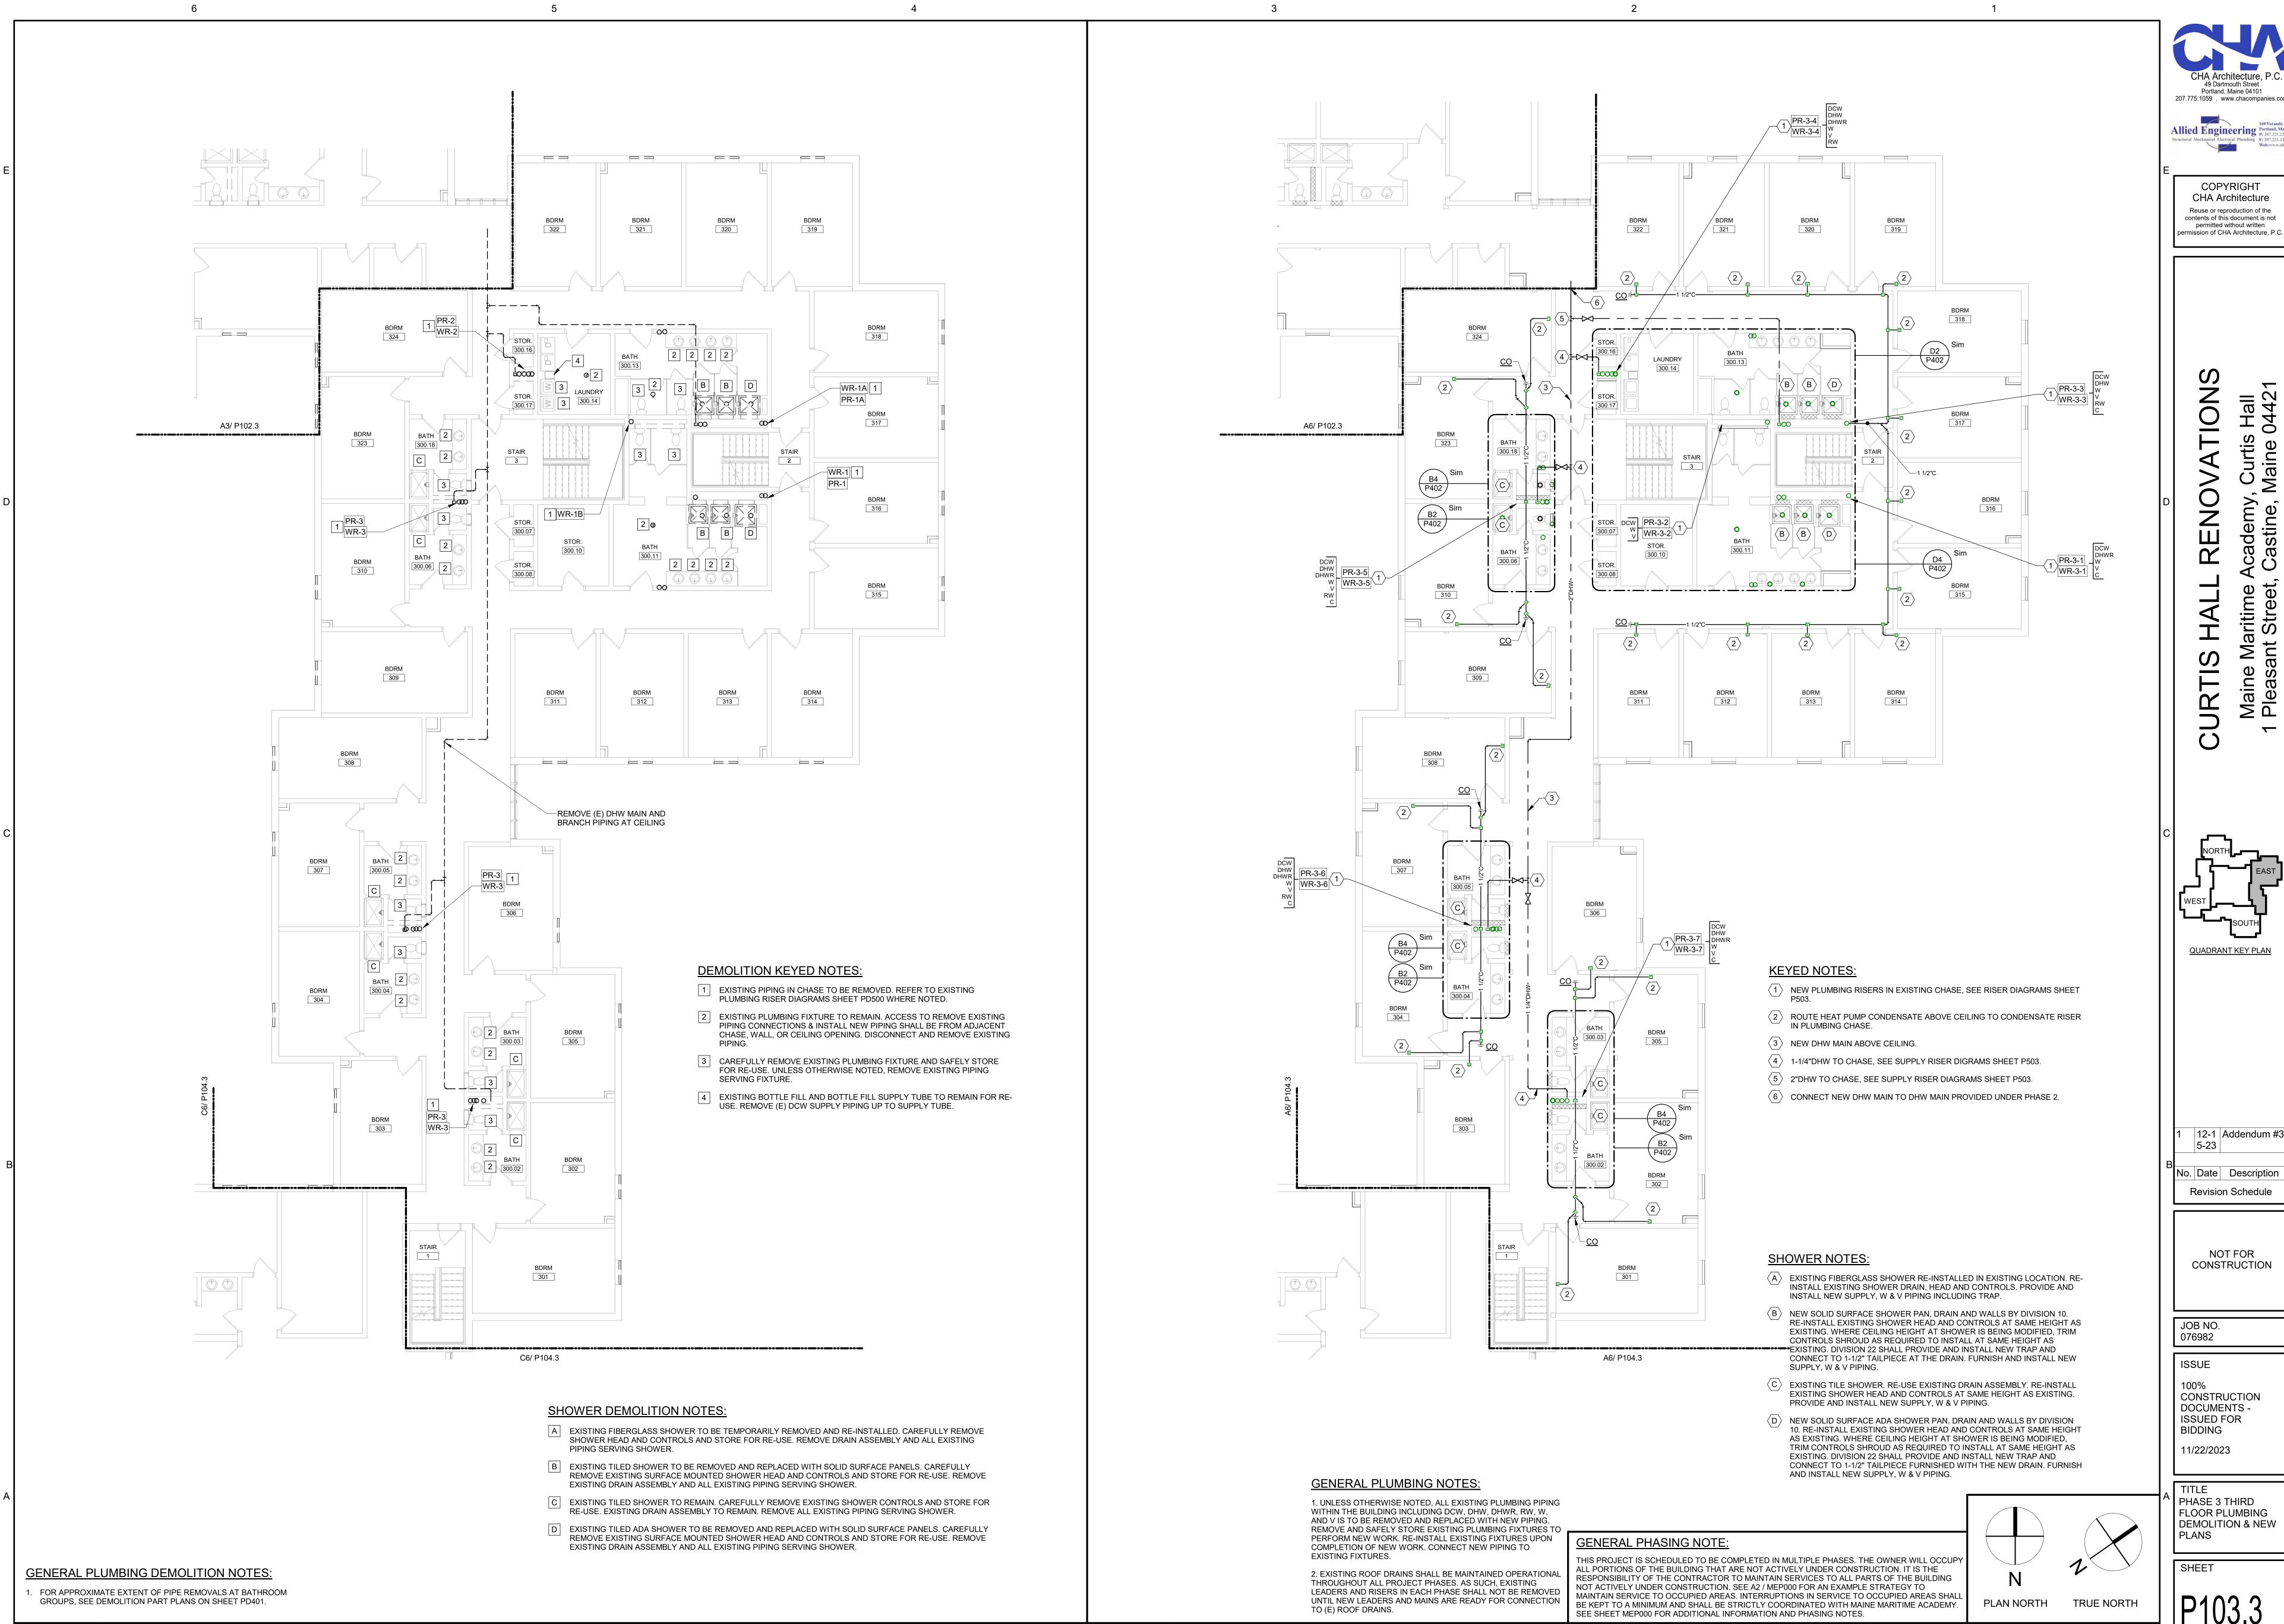

PHASE 3 THIRD FLOOR PLUMBING DEMOLITION PLAN

1/8" = 1'-0"

PHASE 3 THIRD FLOOR PLUMBING PLAN

А3

1/8" = 1'-0"

49 Dartmouth Street 'Portland, Maine 04101 207.775.1059 www.chacompanies.com

Allied Engineering
Structural Mechanical Electrical Plumbing
Structural Mechanical Electrical Plumbing
160 Veranda Street
Portland, Maine 04103
P: 207.221.2260
F: 207.221.2266
Web:www.allied-eng.com

COPYRIGHT CHA Architecture Reuse or reproduction of the contents of this document is not permitted without written permission of CHA Architecture, P.


astine,

QUADRANT KEY PLAN

CONSTRUCTION

CONSTRUCTION

PHASE 3 THIRD FLOOR PLUMBING DEMOLITION & NEW

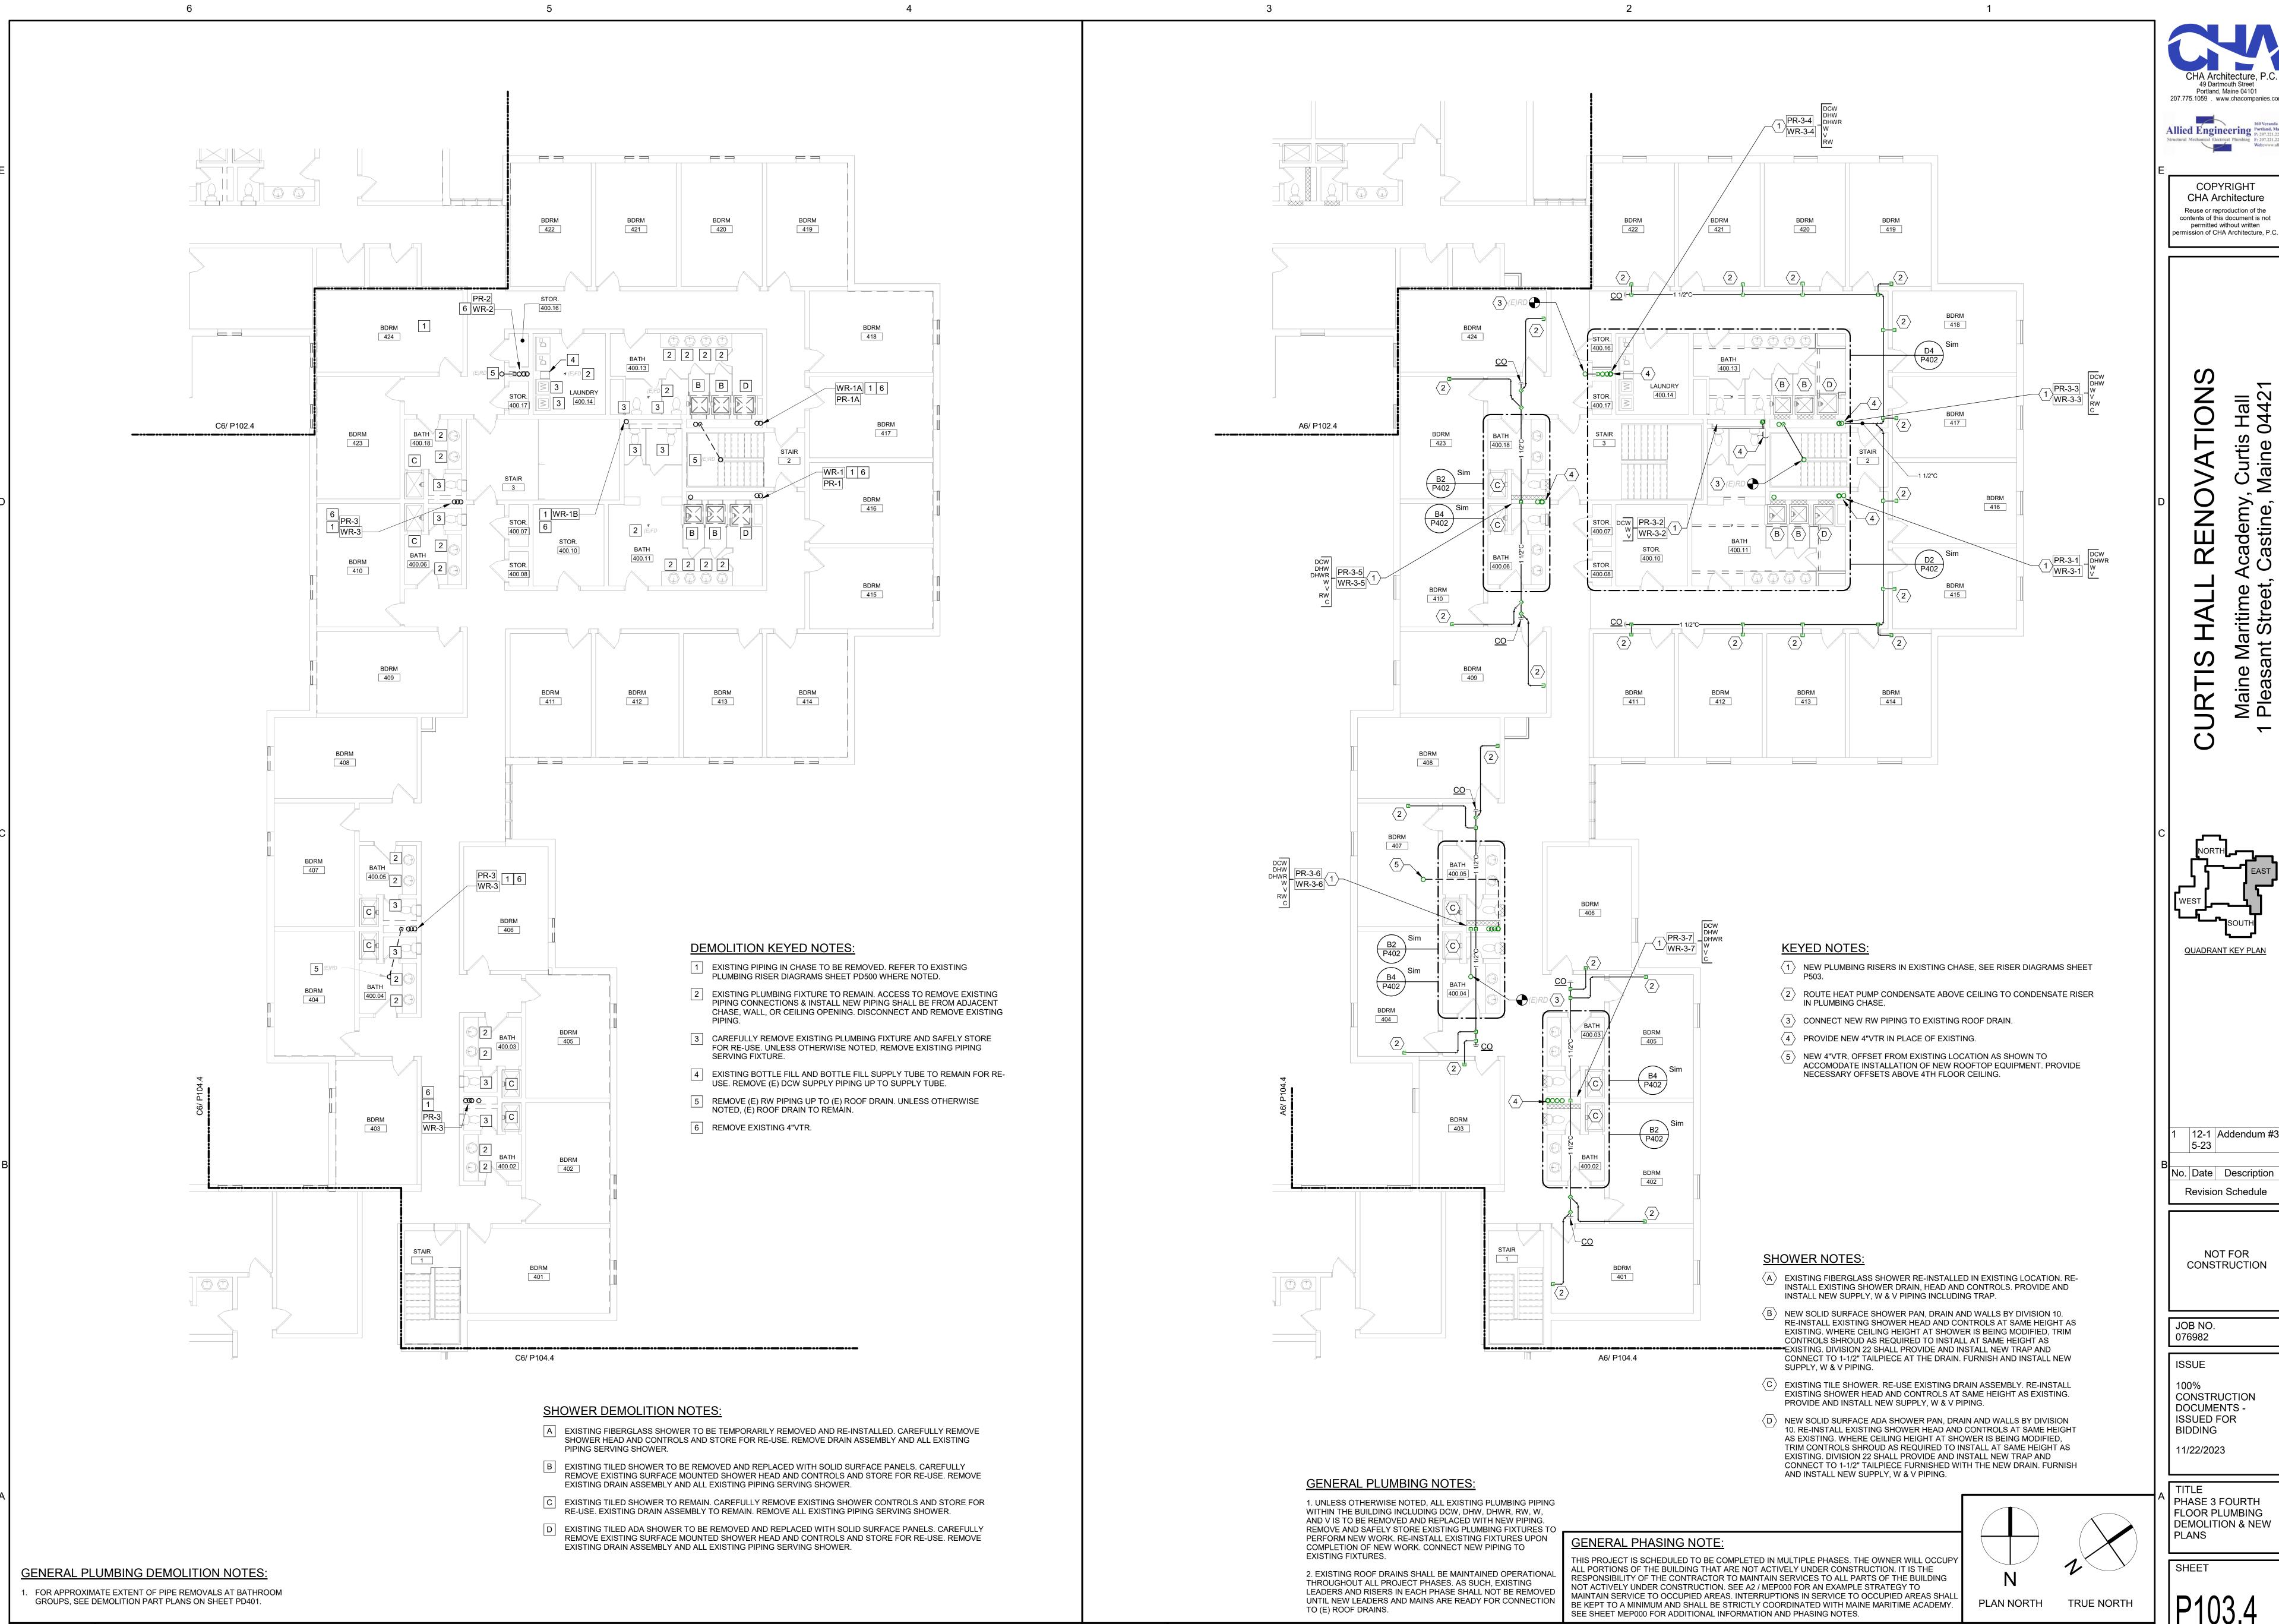

PHASE 3 FOURTH FLOOR PLUMBING PLAN

A3

1/8" = 1'-0"

PHASE 3 FOURTH FLOOR PLUMBING DEMOLITION PLAN

1/8" = 1'-0"

49 Dartmouth Street 'Portland, Maine 04101 207.775.1059 www.chacompanies.com

Allied Engineering
Structural Mechanical Electrical Plumbing
Structural Mechanical Electrical Plumbing
160 Veranda Street
Portland, Maine 04103
P: 207.221.2260
F: 207.221.2266
Web:www.allied-eng.com

