

REF. NO.	DRAWING NO.	REFERENCE DRAWING TITLE	CODE	DATE	REV.	REVISION	BY	CKD	APPVD	JOB	CODE	DATE	REV.	REVISION	BY	CKD	APPVD	JOB
6	-	-	-	-	-	-	-	-	-	-	-	-	-	-	-	-	-	-
5	-	-	-	-	-	-	-	-	-	-	-	-	-	-	-	-	-	-
4	-	-	-	-	-	-	-	-	-	-	-	-	-	-	-	-	-	-
3	-	-	-	-	-	-	-	-	-	-	-	-	-	-	-	-	-	-
2	-	-	-	-	-	-	-	-	-	-	-	-	-	-	-	-	-	-
1	-	-	P	7/23/08	-	SUBMITTED TO MEDEP	CE	MLC	-	-	-	-	-	-	-	-	-	-

**SME**  
Sevee & Maher Engineers, Inc.  
4 Blanchard Road P.O. Box 85A  
Cumberland Center, ME 04021  
JOB NO. 08035.05

DRN	MSB	7/08
CHKD	GHC	7/08
APPVD	-	-
ISSUE CODE		
P	Preliminary	
B	Bids	
C	Construction	
ASB	As Built	
SCALE	NONE	

KATAHDIN PAPER COMPANY LLC.  
EAST MILLINOCKET, MAINE



CAD FILE:

**EAST OPERATION**  
DOLBY III LANDFILL  
CELL 16 CONSTRUCTION  
SECTIONS & DETAILS

JOB NO. \_\_\_\_\_  
FILE NO. \_\_\_\_\_  
LOC. NO. \_\_\_\_\_

**C-300**  
SHEET 1 OF 1

P:\GIS\CAD\CELL 16\REF\DWG\08035.05.dwg 7/23/08 2:18:52 PM mlskdp

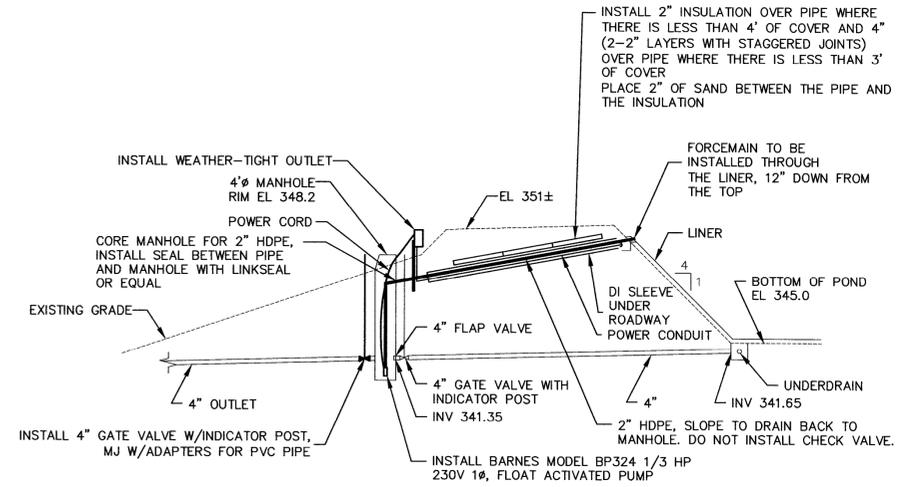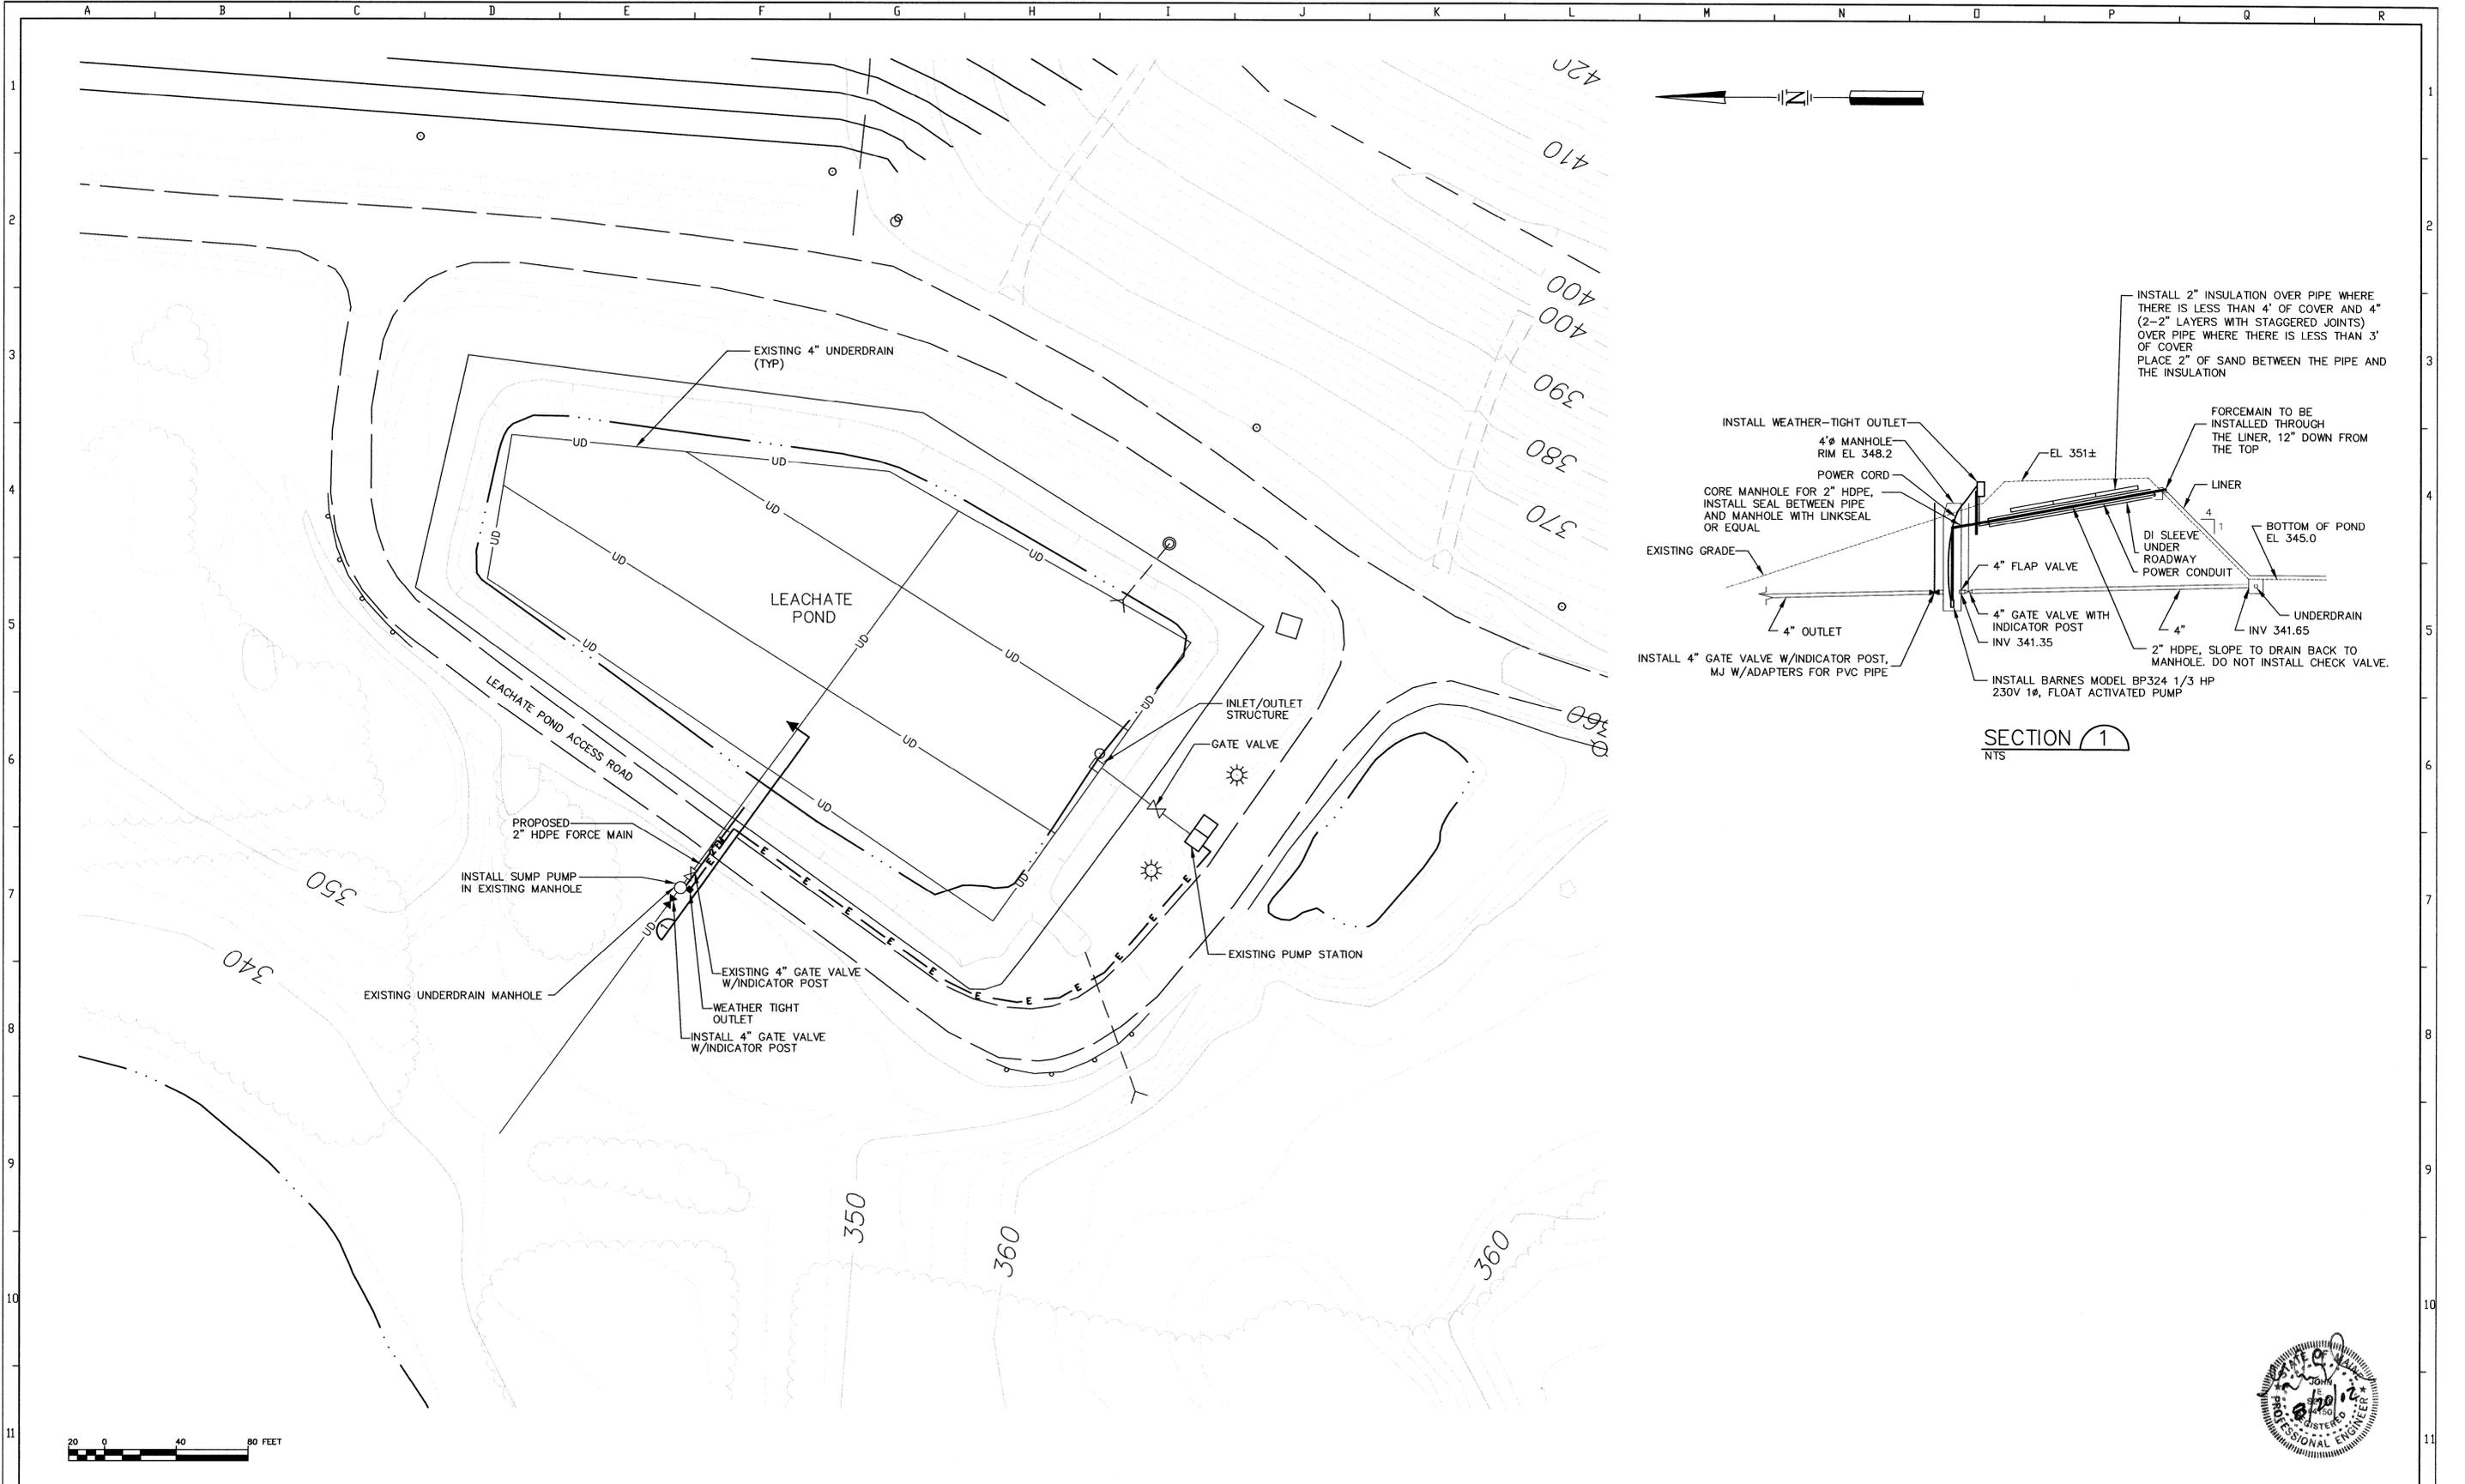

NO.	REVISION	DATE	BY	CHKD	APPVD	JOB	CODE	DATE	REVISION	BY	CHKD	APPVD	JOB
6	-	-	-	-	-	-	-	-	-	-	-	-	-
5	-	-	-	-	-	-	-	-	-	-	-	-	-
4	-	-	-	-	-	-	-	-	-	-	-	-	-
3	-	-	-	-	-	-	-	-	-	-	-	-	-
2	-	-	-	-	-	-	-	-	-	-	-	-	-
1	-	8/13/02	-	-	-	-	-	-	-	-	-	-	-

**SME**  
**Sevee & Maher Engineers, Inc.**  
 4 Blanchard Road P.O. Box 85A  
 Cumberland Center, ME 04021

DRN	DRD	7/27/02
CHKD	GHC	7/27/02
APPVD		
ISSUE CODE		
P	- Preliminary	
B	- Bids	
C	- Construction	
ASB	- As Built	
SCALE	NONE	



CAD FILE: AS9548.DWG

<b>EAST OPERATION</b>	
DOLBY III LANDFILL LEACHATE POND REPIPING OF UNDERDRAIN DISCHARGE	
JOB NO.	YB-26109
FILE NO.	
LDC. NO.	

G:\GPR\031\ACAD\AS9548\YB-26109.dwg Mon Aug 19 14:29:07 2002 DRD

# KATAHDIN PAPER COMPANY LLC. EAST MILLINOCKET, MAINE DOLBY III LANDFILL LEACHATE POND REDEVELOPMENT

SHT NO	TITLE	DWG NO
1	COVER SHEET	YB-26187
2	SYMBOLS & ABBREVIATIONS	YB-26188
3	SITE LOCATION PLAN	YB-26189
4	EXISTING CONDITIONS PLAN	YB-26190
5	BASE GRADING AND UNDERDRAIN PLAN	YB-26191
6	LEAK DETECTION PLAN	YB-26192
7	SECTIONS & DETAILS (SHEET 1 OF 3)	YB-26193
8	SECTIONS & DETAILS (SHEET 2 OF 3)	YB-26193
9	SECTIONS & DETAILS (SHEET 3 OF 3)	YB-26193

*SME*

*Sevee & Maher Engineers, Inc.*  
Waste Management and Hydrogeologic Consultants  
Cumberland Center, Maine



REF. NO.	DRAWING NO.	REFERENCE DRAWING TITLE	CODE	DATE	REV.	REVISION	BY	CKD	APPVD	JOB	CODE	DATE	REV.	REVISION	BY	CKD	APPVD	JOB
6	-			-	-													
5	-			-	-													
4	-			11/26/07	ASB	RECORD DRAWING												
3	-			10/31/06	B	ISSUED FOR BID		GHC										
2	-			5/17/06	P	REVISED PER MEDEP COMMENTS		GHC										
1	-			12/9/05	P	SUBMITTED TO MEDEP		GHC										

DRN	DRD	11/05
CHKD	GHC	11/05
APPVD		-
ISSUE CODE		
P - Preliminary		
B - Bids		
C - Construction		
ASB - As Built		
SCALE		
NONE		

KATAHDIN PAPER COMPANY LLC.  
EAST MILLINOCKET, MAINE

CAD FILE: LPOND-COVER.DWG

EAST OPERATION

DOLBY III LANDFILL  
LEACHATE POND REDEVELOPMENT  
COVER SHEET

JOB NO. 00000  
FILE NO. 0-000-0000  
LOC. NO.

YB-26187


C:\KATAHDIN\KATAHDIN LEACHATE POND REDEVELOPMENT\COVER.DWG: 11/29/2007 10:37:09 PM, 100x800

# SYMBOLS

EXISTING	PROPOSED	EXISTING	PROPOSED	EXISTING	PROPOSED
	NORTH ARROW (TRUE)		DRAINAGE COURSE (WITH DIRECTION)		UNDERGROUND GAS MAIN
	NORTH ARROW (MAGNETIC)		EDGE OF WATER		UNDERGROUND TELEPHONE LINE
	NORTH ARROW (PLAN NORTH)		WATER ELEVATION (GROUND OR SURFACE)		UNDERGROUND ELECTRICAL LINE
	CONTOUR LINES		FENCE LINE (WOOD)		OVERHEAD ELECTRICAL LINE
	SPOT ELEVATION (INVERT ELEVATION)		FENCE LINE (WIRE)		OVERHEAD TELEPHONE LINE
	EXISTING GROUND		STONE WALL		SANITARY SEWER
	SURVEY BASELINE WITH TRIANGULATION OR INTERSECTION PT.		RETAINING WALL		FORCE MAIN
	PROPERTY LINE OR R.O.W.		GUARD RAIL		WATER MAIN
	PROPERTY LINE W/ BEARING AND DISTANCE		BUILDING AND STRUCTURES		STORM DRAIN
	CONSTRUCTION BASELINE		SLOPE RATIO (HORIZONTAL TO VERTICAL)		UNDERDRAIN
	BOUNDARY LINE (State, County, Municipality)		SLOPES (WITH SLOPE RATIO)		PERIMETER DRAIN
	SURVEY MONUMENT		EDGE OF ROAD		LEACHATE TRANSPORT
	SURVEY CONTROL		CUT OR FILL LINE		LEACHATE COLLECTION
	PROPERTY PIN, DRILL HOLE, PK, OR STAKE		BITUMINOUS PAVEMENT		LEAK DETECTION
	WOODS OR BRUSH LINE		CONCRETE		GAS COLLECTION
	INDIVIDUAL TREE		TEST BORING, MONITORING WELL, OR PIEZOMETER AND NUMBER		REDUCER
	MAPPED WETLAND		TEST PIT AND NUMBER		MECHANICAL CAP OR PLUG
	GAS VENT		SURFACE WATER SAMPLE LOCATION		COUPLING
	GAS VENT (CAPPED)		GAS EXTRACTION WELL		BEND
	CLEAN OUT STRUCTURE		MANHOLE		TEE
	CULVERT		CATCH BASIN		PIPE TO BE ABANDONED
	RAILROAD		WATER OR GAS VALVE		RISER PIPE & INLET GRATE
	SLOPE INCLINOMETER		HYDRANT		STORM GRATE
	VIBRATING WIRE SETTLEMENT CELL		AIR RELEASE VALVE		DRAINAGE INLET STRUCTURE
	VERTICAL/HORIZONTAL DISPLACEMENT MONUMENT		SURGE RELEASE VALVE		UNDERDRAIN SUMP
	VERTICAL DISPLACEMENT MONUMENT		UTILITY POLE		SILTATION FENCE
	LIQUID SETTLEMENT GAGE		LIGHT POLE		CLEARING OR CONSTRUCTION LIMIT LINE

ACOMP	ASPHALT COATED CMP	D	DEGREE OF CURVE	HDPE	HIGH DENSITY POLYETHYLENE	PERF	PERFORATED
ACP	ASBESTOS CEMENT PIPE	DBL	DOUBLE	HORIZ	HORIZONTAL	PP	POWER POLE
AC	ACRE	DEG OR °	DEGREE	HP	HORSEPOWER	PSI	POUNDS PER SQUARE INCH
AGG	AGGREGATE	DEPT	DEPTH	HYD	HYDRANT	PVC	POLYVINYL CHLORIDE
ALUM	ALUMINUM	DI	DUCTILE IRON	ID	INSIDE DIAMETER	PVMT	PAVEMENT
APPROX	APPROXIMATE	DI OR Ø	DIAMETER	IN OR "	INCHES	QTY	QUANTITY
ARMH	AIR RELEASE MANHOLE	DIST	DISTANCE	INV	INVERT	RCP	REINFORCED CONCRETE PIPE
ASB	ASBESTOS	DN	DOWN	INV EL	INVERT ELEVATION	ROW	RIGHT OF WAY
ASP	ASPHALT	DR	DRAIN	LF	LEACHATE COLLECTION	RAD	RADIUS
AUTO	AUTOMATIC	DWG	DRAWING	LD	LEAK DETECTION	REQD	REQUIRED
AUX	AUXILIARY	EA	EACH	LOC	LOCATION	RT	ROUTE
AVE	AVENUE	EG	EXISTING GROUND OR GRADE	LT	LEACHATE TRANSPORT	S	SLOPE
AZ	AZIMUTH	ELEC	ELECTRIC	MH	MANHOLE	SCH	SCHEDULE
		EL	ELEVATION	MJ	MECHANICAL JOINT	SF	SQUARE FEET
BCCMP	BITUMINOUS COATED CMP	ELB	ELBOW	MATL	MATERIAL	SHT	SHEET
BM	BENCH MARK	EOP	EDGE OF PAVEMENT	MAX	MAXIMUM	SHH	SANITARY MANHOLE
BIT	BITUMINOUS	EQUIP	EQUIPMENT	MFR	MANUFACTURE	ST	STREET
BLDG	BUILDING	EST	ESTIMATED	MISC	MISCELLANEOUS	STA	STATION
BOT	BOTTOM	EXC	EXCAVATE	MON	MONUMENT	SY	SQUARE YARD
BRG	BEARING	EXIST	EXISTING	NITC	NOT IN THIS CONTRACT	TAN	TANGENT
BV	BALL VALVE	FG	FINISH GRADE	NTS	NOT TO SCALE	TDH	TOTAL DYNAMIC HEAD
CB	CATCH BASIN	FBRGL	FIBERGLASS	NOR	NOW OR FORMERLY	TEMP	TEMPORARY
CEN	CENTER	FLX	FLEXIBLE	NO OR #	NUMBER	TYP	TYPICAL
CEM LIN	CEMENT LINED	FLR	FLANGE	OC	ON CENTER	UD	UNDERDRAIN
CMP	CORRUGATED METAL PIPE	FLX	FLEXIBLE	OD	OUTSIDE DIAMETER	V	VOLTS
CO	CLEAN OUT	FTG	FOOTING	PC	POINT OF CURVE	VA	VALVE ANCHORING TEE
COF	CUBIC FEET	GA	GALLON	PD	PERIMETER DRAIN	VERT	VERTICAL
CFS	CUBIC FEET PER SECOND	GALV	GALVANIZED	PI	POINT OF INTERSECTION	WG	WATER GATE
CI	CAST IRON	GPD	GALLONS PER DAY	PIV	POST INDICATOR VALVE	W/O	WITHOUT
CL	CLASS	GPM	GALLONS PER MINUTE	PT	POINT OF TANGENT	YD	YARD
CLC	CONCRETE						
CONC	CONCRETE CONSTRUCTION						
CONTR	CONTRACTOR						
CS	CURE STOP						
CTR	CENTER						
CU	COPPER						
CY	CUBIC YARD						

## VIEW MARKERS & IDENTIFICATION

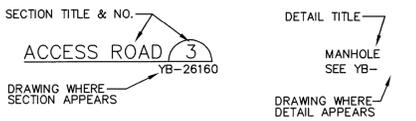

### GENERAL NOTES:

THE DOLBY LANDFILL IS AN ACTIVE FACILITY THAT RECEIVES WASTE ON A DAILY BASIS. IT WILL BE THE RESPONSIBILITY OF THE CONTRACTOR TO COORDINATE WITH THE OWNER WITH REGARDS TO USE OF PREMISES, INCLUDING HAUL ROUTES AND VEHICULAR ACCESS. THE CONTRACTOR SHALL COORDINATE ALL CONSTRUCTION ACTIVITIES SO AS NOT TO INTERFERE WITH ACTIVE LANDFILLING OPERATIONS. THE CONTRACTOR SHALL OBEY ALL TRAFFIC, NOISE, AND DUST CONTROL POLICIES OF THE DOLBY LANDFILL.

THE CONTRACTOR SHALL COMPLY FULLY WITH CONDITIONS OF THE MAINE DEPARTMENT OF ENVIRONMENTAL PROTECTION, (MEDEP), NRPA PERMIT BY RULE CONDITIONS, MEDEP CONSTRUCTION GENERAL PERMIT, AND MEDEP "MAINE EROSION AND SEDIMENT CONTROL HANDBOOK FOR CONSTRUCTION: BEST MANAGEMENT PRACTICES", AS APPLICABLE, AND SHALL TAKE EVERY PRECAUTION TO INSURE THAT NO SILTATION OF STORMWATER DRAINAGE COURSES OCCURS AS A RESULT OF SOIL DISTURBANCE ASSOCIATED WITH THE CONTRACT SCOPE OF WORK.

THE CONTRACTOR SHALL BE RESPONSIBLE FOR PROVIDING COMPLETE PROTECTION OF THE PROJECT DURING CONSTRUCTION FROM ANY ACTS OF NATURE OR MAN, SUCH AS, BUT NOT LIMITED TO, FLOODS, WIND DAMAGE, EARTHEN SLIDES, AND SLOPE FAILURES. DAMAGE TO THE PROJECT CAUSED BY SUCH ACTS WILL NOT BE SUFFICIENT CAUSE TO INCREASE CONTRACTOR COSTS TO THE OWNER.

THE CONTRACTOR SHALL PROTECT EXISTING ON-SITE STRUCTURES FROM DAMAGE DURING CONSTRUCTION, INCLUDING: MONITORING WELLS, POWER LINES, SURVEY POINTS, AND EXISTING LEACHATE COLLECTION AND TRANSPORT FACILITIES AND SYSTEMS, ETC. THE CONTRACTOR SHALL BE RESPONSIBLE FOR ALL REPAIRS REQUIRED TO CORRECT DAMAGE MADE TO EXISTING ON-SITE STRUCTURES DESCRIBED ABOVE RESULTING FROM ANY CONSTRUCTION ACTIVITY.

THE CONTRACTOR AND ITS SUBCONTRACTORS MUST COMPLY WITH ALL APPLICABLE SAFETY PROCEDURES AND REQUIREMENTS UNDER THE OCCUPATIONAL SAFETY AND HEALTH ACT (OSHA) AND REGULATIONS ISSUED THEREUNDER AND STATE LABOR (SAFETY) DEPARTMENT AND MILL RULES, PROCEDURES, AND REGULATIONS REGARDING SAFETY.

CONTOURS SHOWN ON PLANS MAY NOT REPRESENT EXISTING CONDITIONS OF THE SITE. CONTRACTOR SHALL FIELD VERIFY CONDITIONS PRIOR TO CONSTRUCTION.

### MATERIAL SPECIFICATIONS: (SEE TECHNICAL SPECIFICATIONS FOR MORE INFORMATION)

SCREENED TILL: SHALL BE EARTH, SUITABLE FOR EMBANKMENT CONSTRUCTION. SCREENED TILL SHALL BE GLACIAL TILL FREE OF FROZEN MATERIALS, PERISHABLE RUBBISH, PEAT, ORGANIC MATTER, LARGE ROCK FRAGMENTS, OR OTHER UNSUITABLE MATERIAL AND SHALL BE SCREENED TO LESS THAN 1" IN DIAMETER WITH GREATER THAN 20 PERCENT FINES. THE FINAL SURFACE OF THE SCREENED TILL SHALL BE FREE FROM PROTRUDING ROCKS GREATER THAN 1-INCH IN DIAMETER.

COMMON BORROW - MDOT SPECIFICATION 703.18

CLAY - THE CLAY FOR POND LINER BASE SHALL BE SILTY CLAY SOIL FREE OF ORGANIC MATTER, DEBRIS, AND ROCK FRAGMENTS LARGER THAN 1 INCH IN DIAMETER. CLAY SHALL MEET A GRADATION AND HYDRAULIC CONDUCTIVITY REQUIREMENT AS FOLLOWS:

a. SIEVE DESIGNATION	PERCENT BY WEIGHT	
	PASSING	RETAINED
#10	100	0
#40	90-100	0
#200	75-100	0

b. REMOILED HYDRAULIC CONDUCTIVITY (ASTM D 5084-90) MAXIMUM ≤ 1X10-7 cm/sec

c. LIQUID LIMIT: > 20  
PLASTICITY INDEX: 8 ≤ P.I. < 30

STONE BEDDING - THE STONE BEDDING MATERIAL SHALL BE 3/4 INCH SCREENED OR CRUSHED STONE, FREE OF ORGANIC MATTER, SILT OR CLAY LUMPS, OR DELETERIOUS MATERIAL.

3/4" STONE - THE PIPE BEDDING MATERIAL SHALL BE 3/4 INCH SCREENED OR CRUSHED STONE, FREE OF ORGANIC MATTER, SILT OR CLAY LUMPS, OR DELETERIOUS MATERIAL.

COMPACTION - DIKE EMBANKMENT SOIL SHALL BE COMPACTED TO A DENSITY OF 90 PERCENT OF ITS MAXIMUM DRY DENSITY AS DETERMINED BY ASTM D 698 (STANDARD PROCTOR)

- 2" SOLID SDR 11 PVC LEAK DETECTION FORCE MAIN
- 4" PERFORATED SDR 15.5 HDPE PIPE
- 6" SOLID AND PERFORATED SDR 17 HDPE PIPE
- 12" SOLID SDR 17 HDPE PIPE
- 24" SOLID SDR 17 HDPE PIPE

SEED AND FERTILIZER: AREAS DISTURBED BY CONSTRUCTION AND THE OUTBOARD SLOPES OF THE DIKE SHALL BE FERTILIZED AND SEEDED.

### MATERIAL:

AGRICULTURAL GROUND LIMESTONE: 25 LBS PER UNIT (1,000 SF)

FERTILIZER: GRANULAR FERTILIZER 18.5, 18.5, 18.5 (N,P,K) 10 LBS PER UNIT


SEED:	TALL FESCUE	59%
	RED FESCUE	25%
	RED TOP	5%
	LADINO CLOVER	8%
	ANNUAL RYEGRASS	0%

THIS SEED MIXTURE SHALL BE APPLIED AT A RATE OF 3 LBS PER UNIT

MULCH - THE MULCH APPLICATION RATE SHALL BE 2 TONS PER ACRE

INSTALLATION - MDOT 618.05 AND MDOT 618.06

RECOMMENDED TIME OF SEEDING IS FROM APRIL 15 TO SEPTEMBER 15.

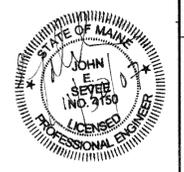

REF. NO.	DRAWING NO.	REFERENCE DRAWING TITLE	CODE	DATE	REV.	REVISION	BY	CHKD	APPVD	JOB	CODE	DATE	REV.	REVISION	BY	CHKD	APPVD	JOB
6	-	-	-	-	-	-	-	-	-	-	-	-	-	-	-	-	-	-
5	-	-	-	-	-	-	-	-	-	-	-	-	-	-	-	-	-	-
4	-	-	-	11/26/07	ASB	RECORD DRAWING												
3	-	-	-	10/31/06	B	ISSUED FOR BID	GHC											
2	-	-	-	5/17/06	P	REVISED PER MEDEP COMMENTS	GHC											
1	-	-	-	12/9/05	P	SUBMITTED TO MEDEP	GHC											

**SME**  
**Sevee & Maher Engineers, Inc.**  
Waste Management and Hydrogeologic Consultants  
Cumberland Center, Maine

JOB NO. 05043.01

DRN	DRD	11/05
CHKD	GHC	11/05
APPVD	-	-
ISSUE CODE		
P - Preliminary		
B - Bids		
C - Construction		
ASB - As Built		
SCALE NONE		


**KATAHDIN PAPER COMPANY LLC.**  
**EAST MILLINOCKET, MAINE**

CAD FILE: SYMSHT.DWG

**EAST OPERATION**

**DOLBY III LANDFILL**  
**LEACHATE POND REDEVELOPMENT**  
**SYMBOLS & ABBREVIATIONS**

JOB NO. 00000  
FILE NO. 0-000-0000  
LOC. NO. **YB-26188**

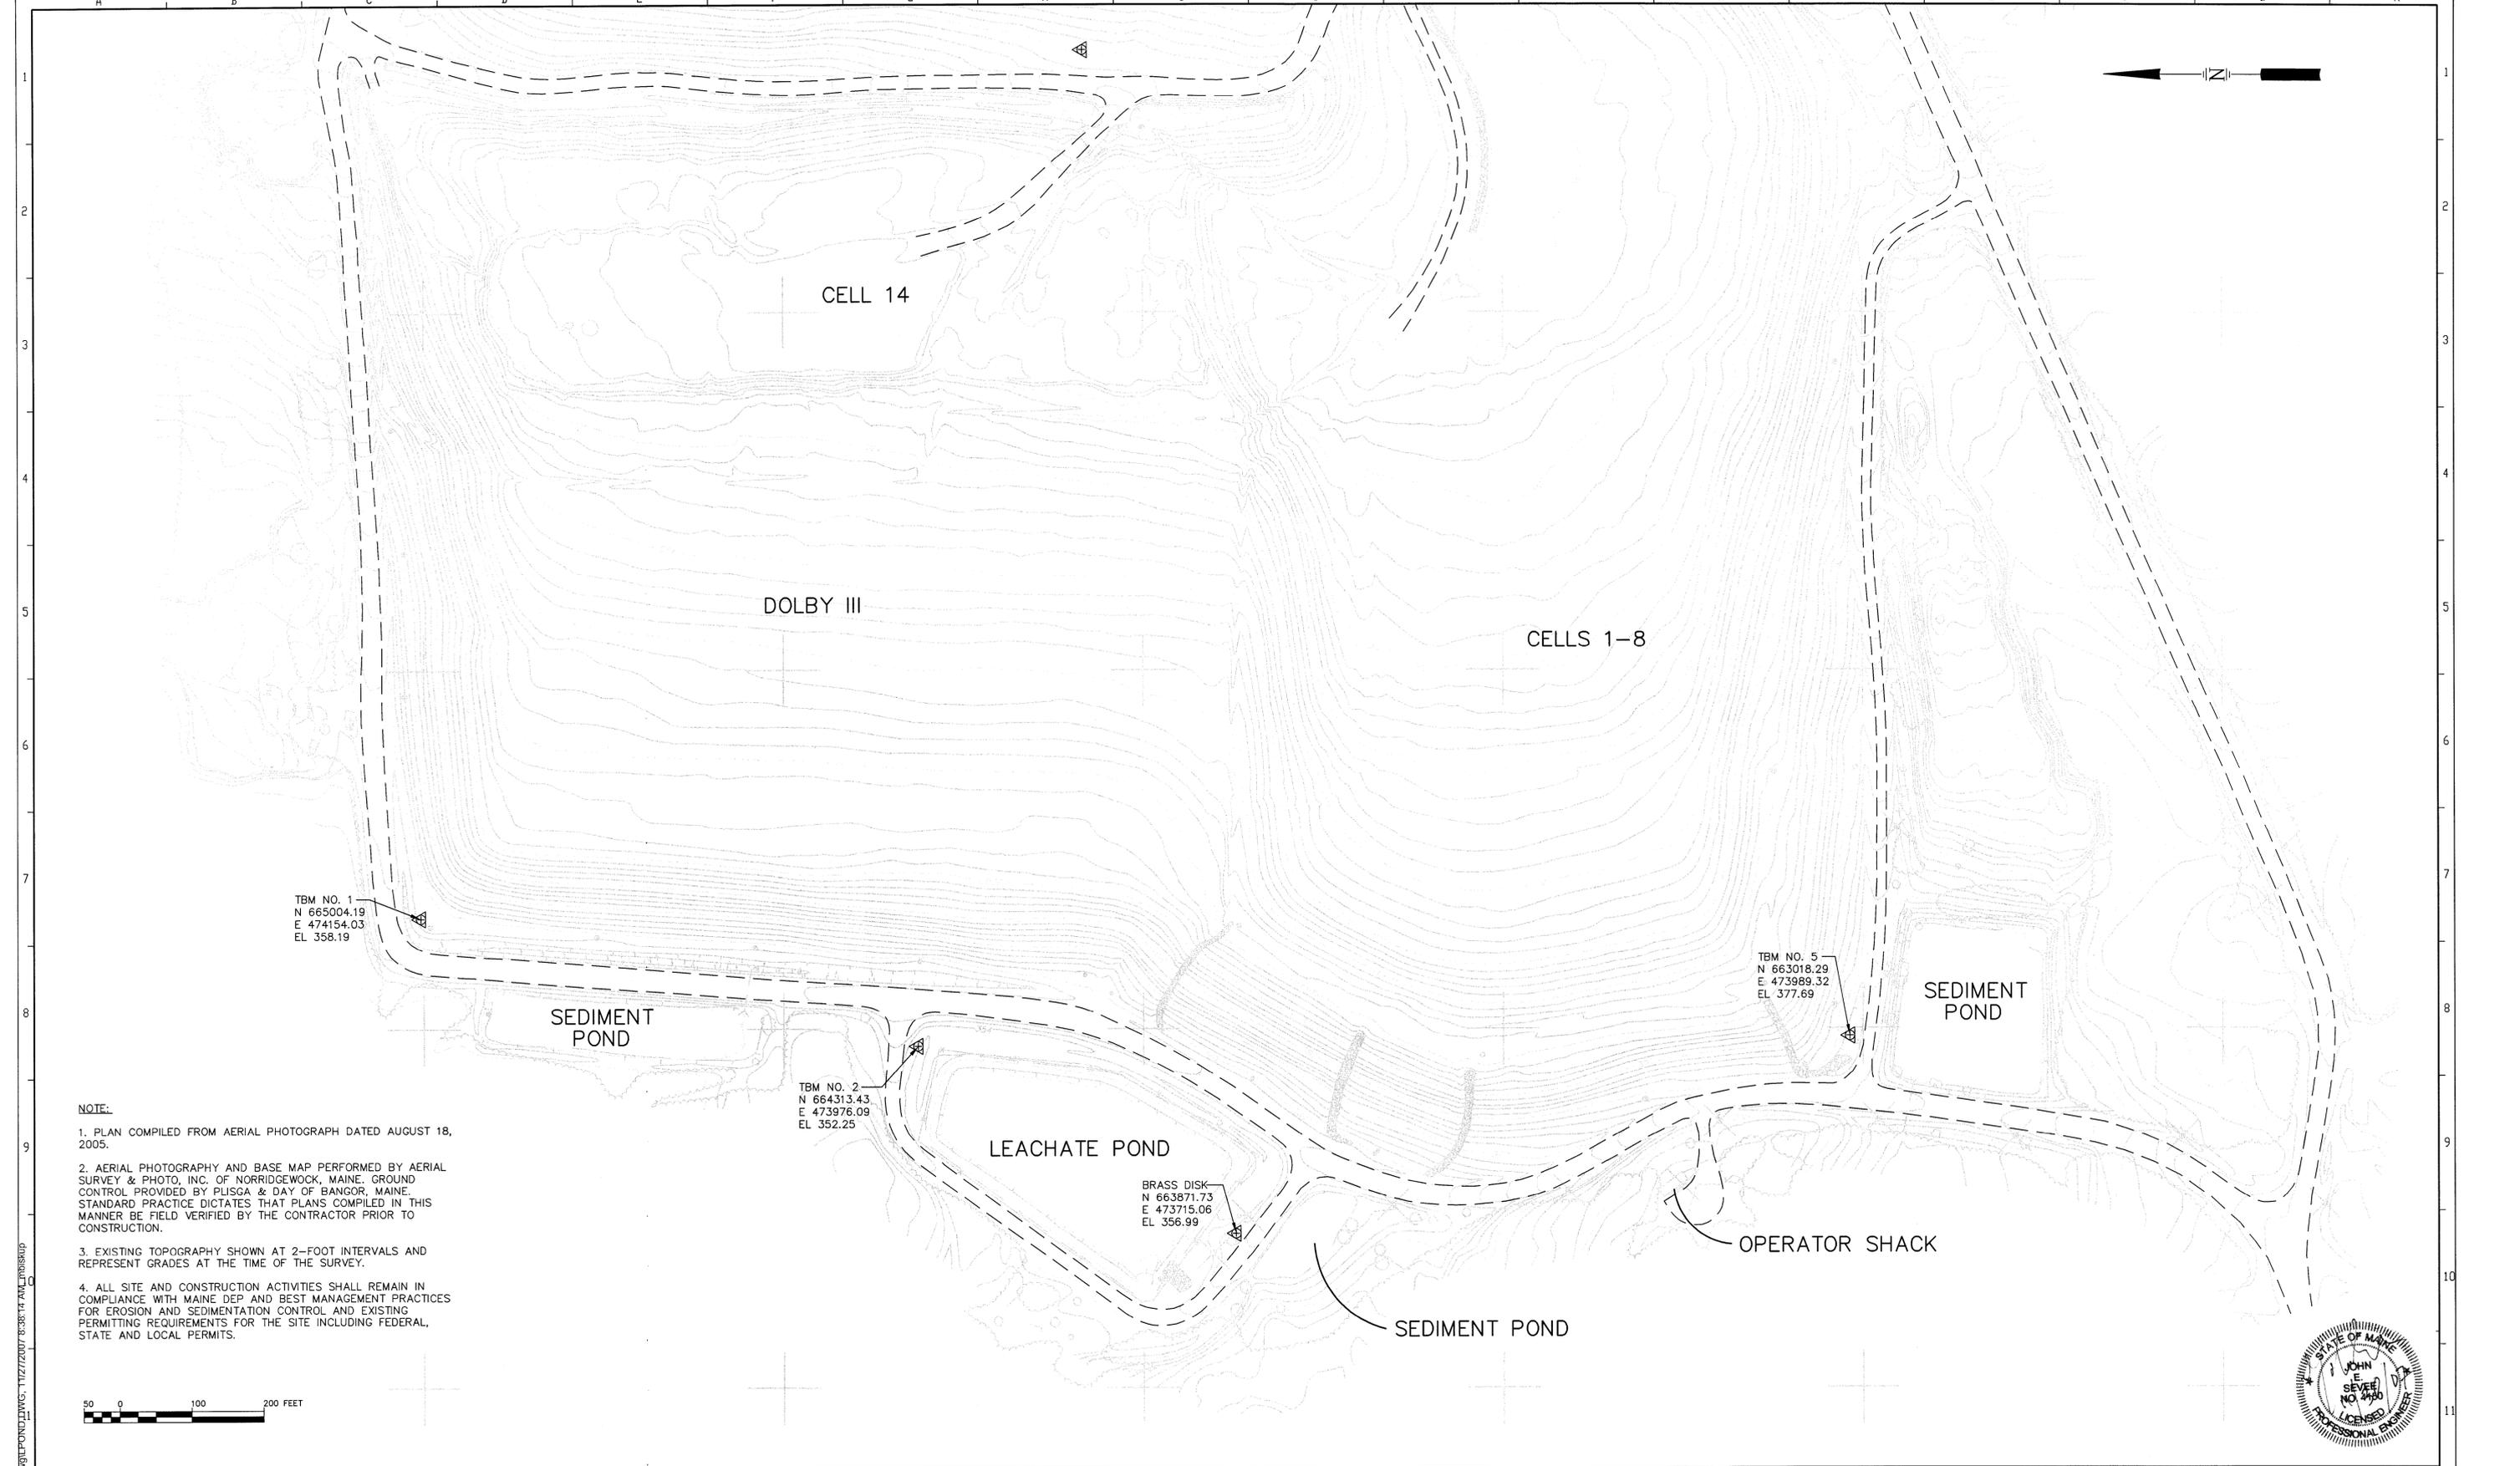

**NOTE:**


1. PLAN COMPILED FROM AERIAL PHOTOGRAPH DATED AUGUST 18, 2005.
2. AERIAL PHOTOGRAPHY AND BASE MAP PERFORMED BY AERIAL SURVEY & PHOTO, INC. OF NORRIDGEWOOD, MAINE. GROUND CONTROL PROVIDED BY PLISGA & DAY OF BANGOR, MAINE. STANDARD PRACTICE DICTATES THAT PLANS COMPILED IN THIS MANNER BE FIELD VERIFIED BY THE CONTRACTOR PRIOR TO CONSTRUCTION.
3. EXISTING TOPOGRAPHY SHOWN AT 2-FOOT INTERVALS AND REPRESENT GRADES AT THE TIME OF THE SURVEY.
4. ALL SITE AND CONSTRUCTION ACTIVITIES SHALL REMAIN IN COMPLIANCE WITH MAINE DEP AND BEST MANAGEMENT PRACTICES FOR EROSION AND SEDIMENTATION CONTROL AND EXISTING PERMITTING REQUIREMENTS FOR THE SITE INCLUDING FEDERAL, STATE AND LOCAL PERMITS.

TBM NO. 1  
N 665004.19  
E 474154.03  
EL 358.19

TBM NO. 2  
N 664313.43  
E 473976.09  
EL 352.25

BRASS DISK  
N 663871.73  
E 473715.06  
EL 356.99

TBM NO. 5  
N 663018.29  
E 473989.32  
EL 377.69

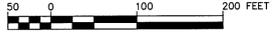


REF. NO.	DRAWING NO.	REFERENCE DRAWING TITLE	CODE	DATE	REV.	REVISION	BY	CKD	APPVD	JOB	CODE	DATE	REV.	REVISION	BY	CKD	APPVD	JOB
6	-		-	-														
5	-		-	-														
4	-		11/26/07	ASE		RECORD DRAWING												
3	-		10/31/06	B		ISSUED FOR BID		GHC										
2	-		5/17/06	P		REVISED PER MEDEP COMMENTS		GHC										
1	-		12/9/05	P		SUBMITTED TO MEDEP		GHC										

**SME**  
*Sevee & Maher Engineers, Inc.*  
Waste Management and Hydrogeologic Consultants  
Cumberland Center, Maine  
JOB NO. 05043.01


DRN	DRD	11/05
CHKD	GHC	11/05
APPVD	-	-
ISSUE CODE		
P	- Preliminary	
B	- Bids	
C	- Construction	
ASB	- As Built	
SCALE AS NOTED		

KATAHDIN PAPER COMPANY LLC.  
EAST MILLINOCKET, MAINE  
CAD FILE: LPOND.DWG

**EAST OPERATION**  
**DOLBY III LANDFILL**  
**LEACHATE POND REDEVELOPMENT**  
**SITE LOCATION PLAN**  
JOB NO. 00000  
FILE NO. 0-000-0000  
LDC. NO. **YB-26189**

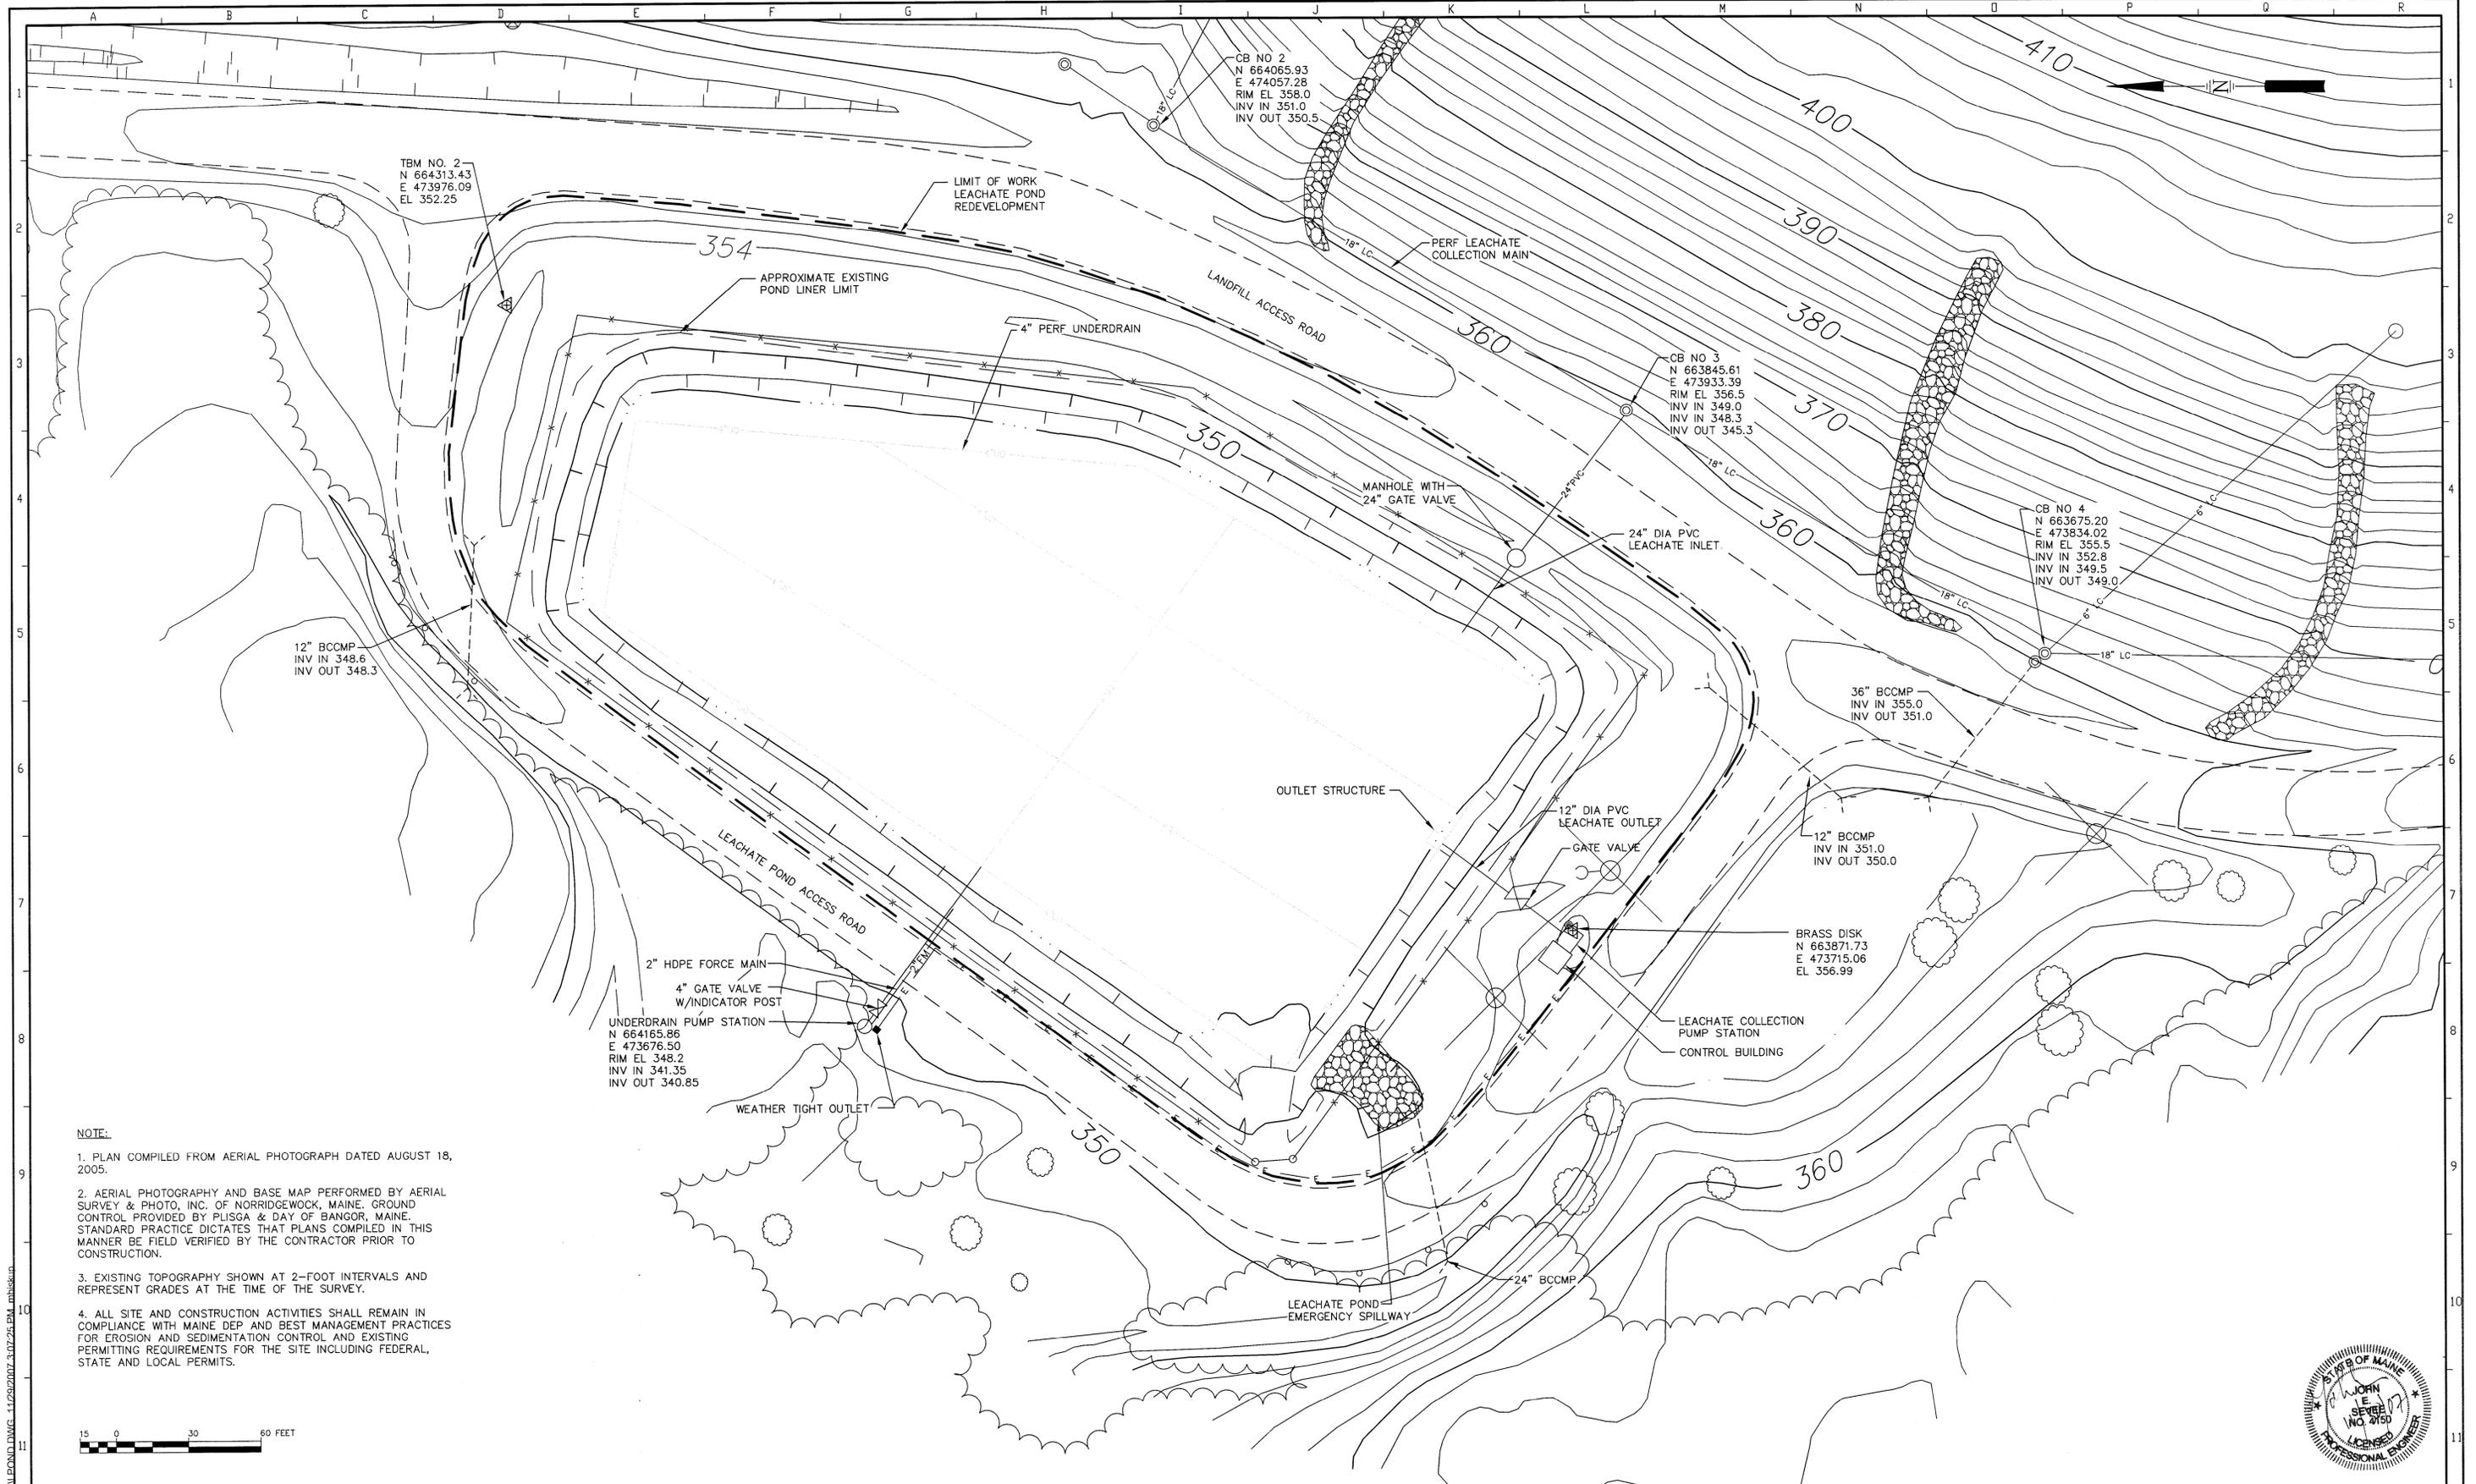

- NOTE:**
1. PLAN COMPILED FROM AERIAL PHOTOGRAPH DATED AUGUST 18, 2005.
  2. AERIAL PHOTOGRAPHY AND BASE MAP PERFORMED BY AERIAL SURVEY & PHOTO, INC. OF NORRIDGEWOOD, MAINE. GROUND CONTROL PROVIDED BY PLISGA & DAY OF BANGOR, MAINE. STANDARD PRACTICE DICTATES THAT PLANS COMPILED IN THIS MANNER BE FIELD VERIFIED BY THE CONTRACTOR PRIOR TO CONSTRUCTION.
  3. EXISTING TOPOGRAPHY SHOWN AT 2-FOOT INTERVALS AND REPRESENT GRADES AT THE TIME OF THE SURVEY.
  4. ALL SITE AND CONSTRUCTION ACTIVITIES SHALL REMAIN IN COMPLIANCE WITH MAINE DEP AND BEST MANAGEMENT PRACTICES FOR EROSION AND SEDIMENTATION CONTROL AND EXISTING PERMITTING REQUIREMENTS FOR THE SITE INCLUDING FEDERAL, STATE AND LOCAL PERMITS.

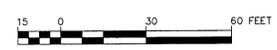

REV. NO.	DRAWING NO.	REFERENCE DRAWING TITLE	CODE	DATE	REV.	REVISION	BY	CHKD	APPVD	JOB	CODE	DATE	REV.	REVISION	BY	CHKD	APPVD	JOB
6	-	-	-	-	-	-	-	-	-	-	-	-	-	-	-	-	-	-
5	-	-	-	-	-	-	-	-	-	-	-	-	-	-	-	-	-	-
4	-	-	-	11/26/07	ASE	RECORD DRAWING												
3	-	-	-	10/31/06	B	ISSUED FOR BID												
2	-	-	-	5/17/06	P	REVISED PER MEDEP COMMENTS												
1	-	-	-	12/9/05	P	SUBMITTED TO MEDEP												

**SME**
  
*Sevee & Maher Engineers, Inc.*
  
 Waste Management and Hydrogeologic Consultants
   
 Cumberland Center, Maine

JOB NO. 05043.01

DRN MBISK 11/05  
 CHKD GHC 11/05  
 APPVD - -  
 ISSUE CODE  
 P - Preliminary  
 B - Bids  
 C - Construction  
 ASB - As Built  
 SCALE AS NOTED

**KATAHDIN PAPER COMPANY LLC.**  
 EAST MILLINOCKET, MAINE


CAD FILE: LPOND.DWG

**EAST OPERATION**  
 DOLBY III LANDFILL  
 LEACHATE POND REDEVELOPMENT  
 EXISTING CONDITIONS PLAN


JOB NO. 000000  
 FILE NO. 0-000-0000  
 LDC. NO.

**YB-26190**



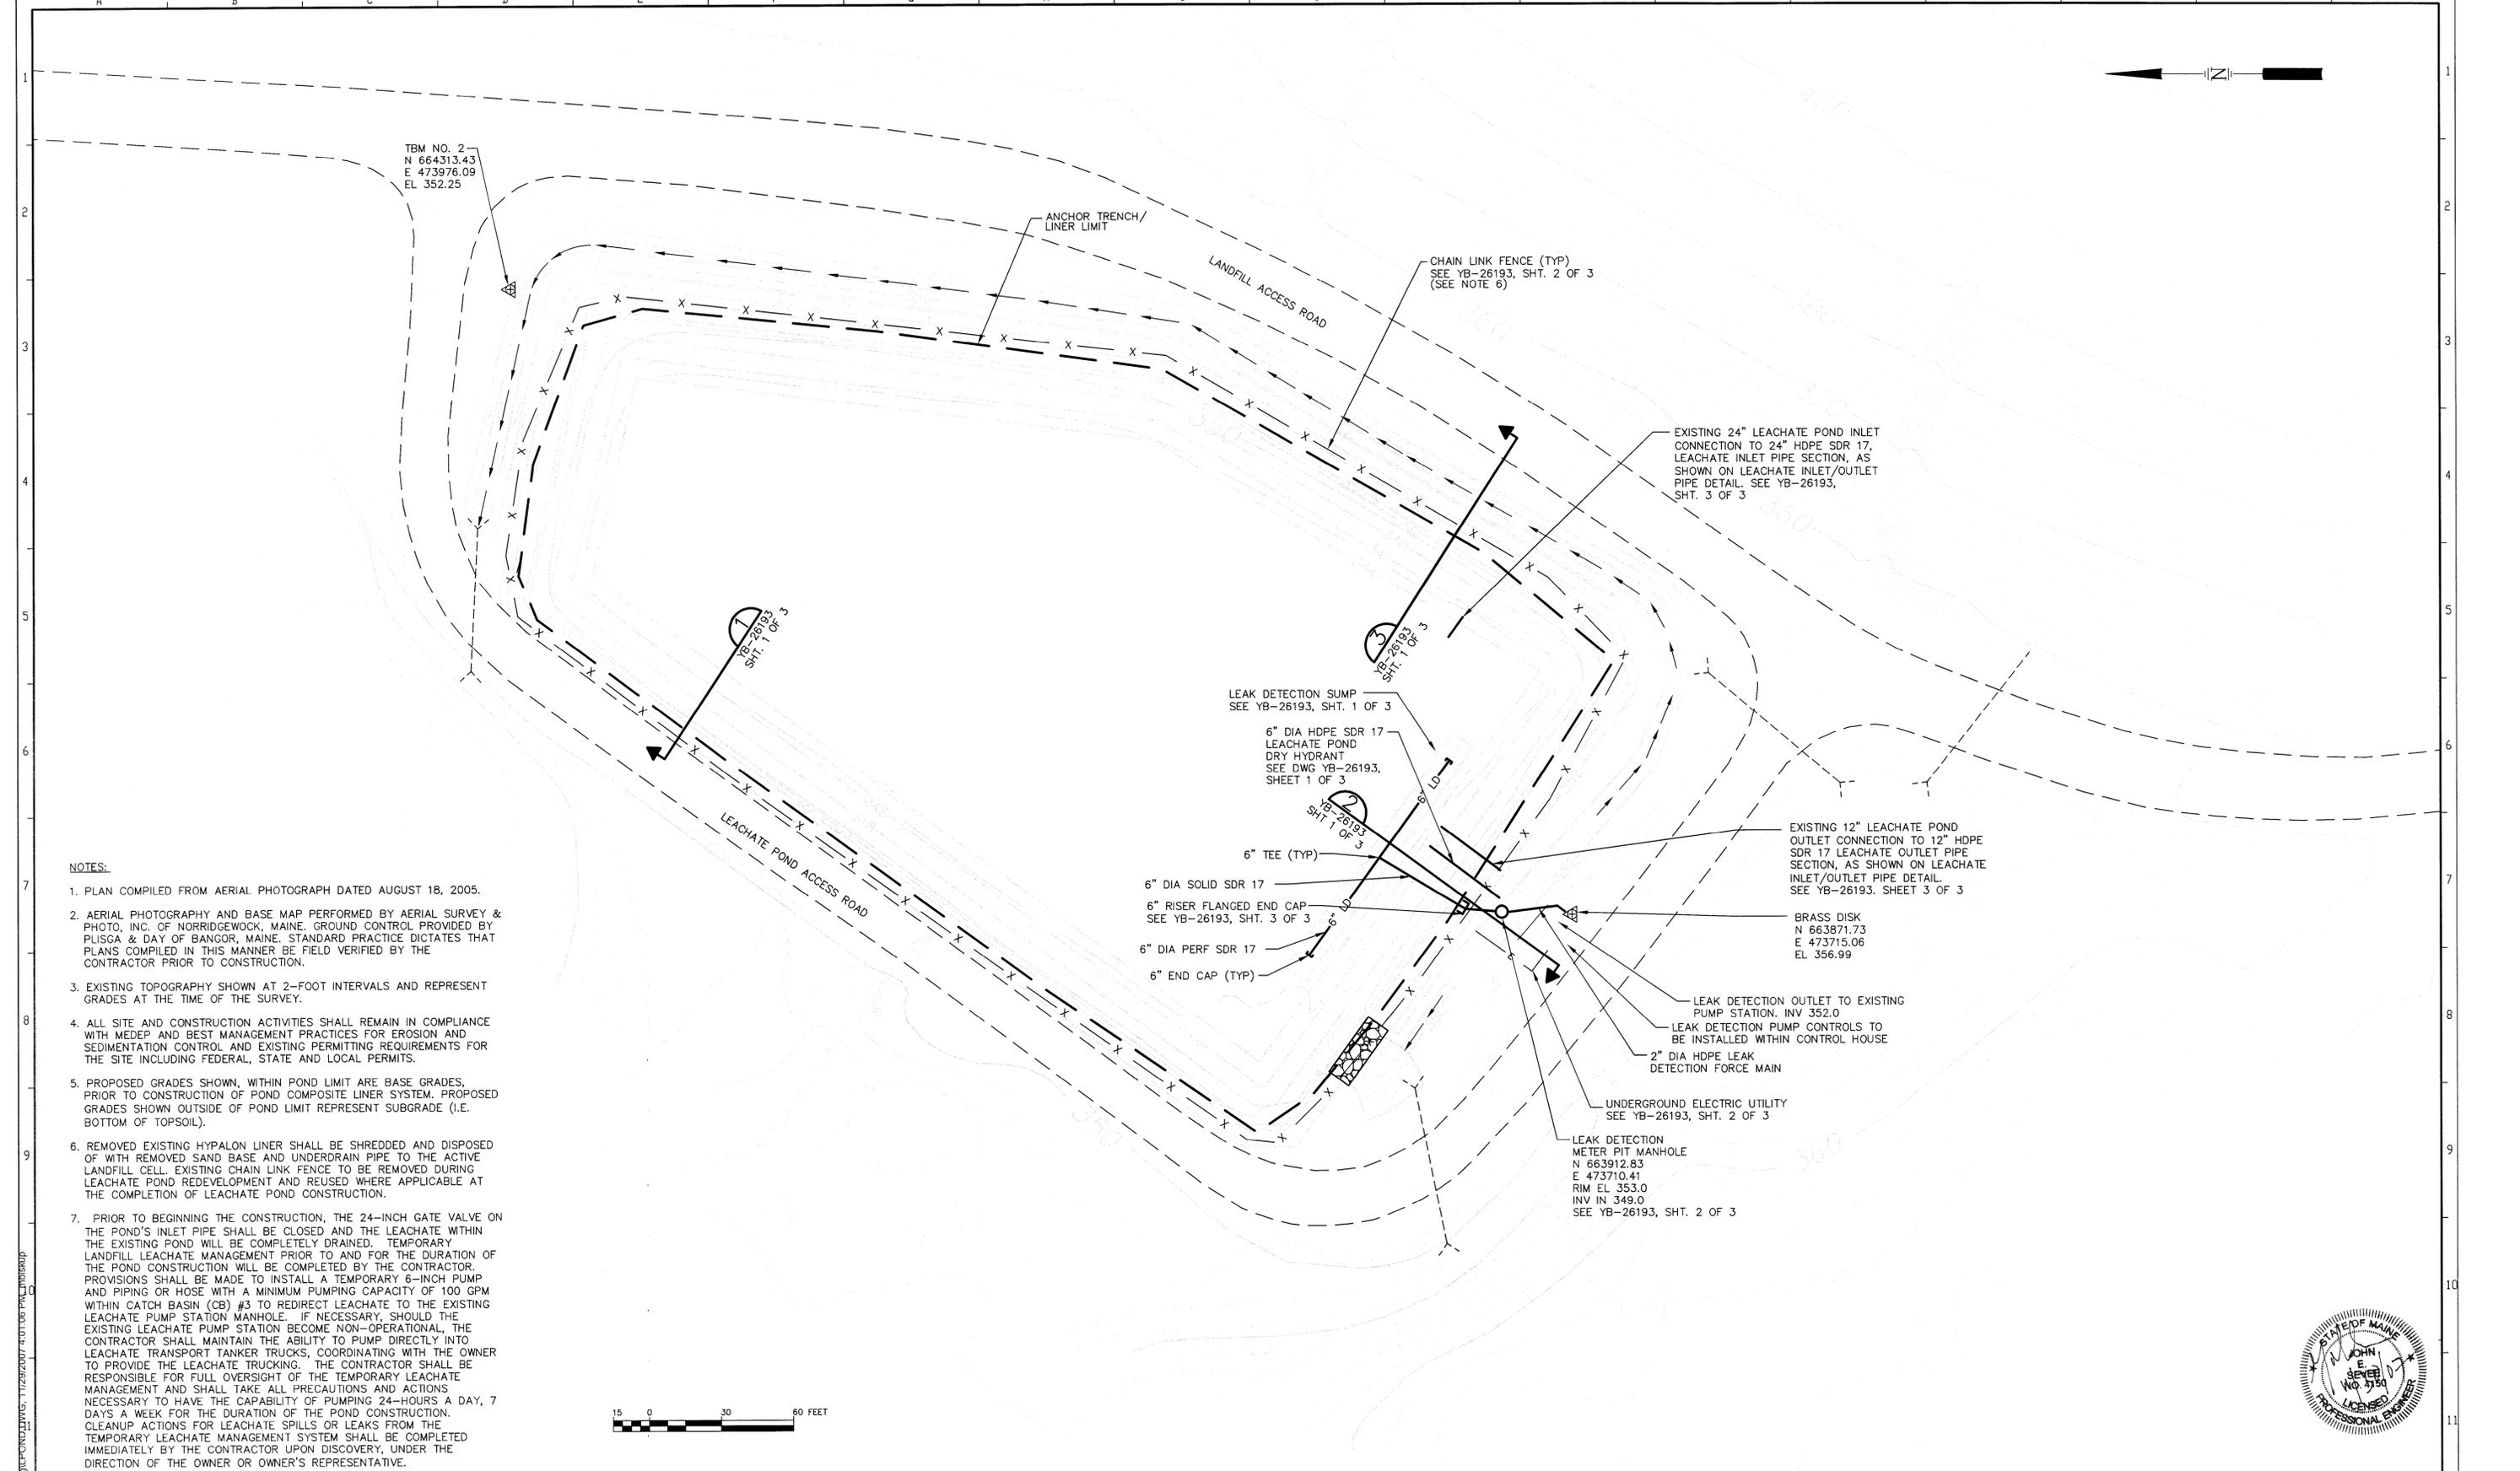

- NOTES:**
1. PLAN COMPILED FROM AERIAL PHOTOGRAPH DATED AUGUST 18, 2005.
  2. AERIAL PHOTOGRAPHY AND BASE MAP PERFORMED BY AERIAL SURVEY & PHOTO, INC. OF NORRIDGEWOCK, MAINE. GROUND CONTROL PROVIDED BY PLISGA & DAY OF BANGOR, MAINE. STANDARD PRACTICE DICTATES THAT PLANS COMPILED IN THIS MANNER BE FIELD VERIFIED BY THE CONTRACTOR PRIOR TO CONSTRUCTION.
  3. EXISTING TOPOGRAPHY SHOWN AT 2-FOOT INTERVALS AND REPRESENT GRADES AT THE TIME OF THE SURVEY.
  4. ALL SITE AND CONSTRUCTION ACTIVITIES SHALL REMAIN IN COMPLIANCE WITH MEDEP AND BEST MANAGEMENT PRACTICES FOR EROSION AND SEDIMENTATION CONTROL AND EXISTING PERMITTING REQUIREMENTS FOR THE SITE INCLUDING FEDERAL, STATE AND LOCAL PERMITS.
  5. PROPOSED GRADES SHOWN, WITHIN POND LIMIT ARE BASE GRADES. PRIOR TO CONSTRUCTION OF POND COMPOSITE LINER SYSTEM, PROPOSED GRADES SHOWN OUTSIDE OF POND LIMIT REPRESENT SUBGRADE (I.E. BOTTOM OF TOPSOIL).
  6. REMOVED EXISTING HYPALON LINER SHALL BE SHREDDED AND DISPOSED OF WITH REMOVED SAND BASE AND UNDERDRAIN PIPE TO THE ACTIVE LANDFILL CELL. EXISTING CHAIN LINK FENCE TO BE REMOVED DURING LEACHATE POND REDEVELOPMENT AND REUSED WHERE APPLICABLE AT THE COMPLETION OF LEACHATE POND CONSTRUCTION.
  7. PRIOR TO BEGINNING THE CONSTRUCTION, THE 24-INCH GATE VALVE ON THE POND'S INLET PIPE SHALL BE CLOSED AND THE LEACHATE WITHIN THE EXISTING POND WILL BE COMPLETELY DRAINED. TEMPORARY LANDFILL LEACHATE MANAGEMENT PRIOR TO AND FOR THE DURATION OF THE POND CONSTRUCTION WILL BE COMPLETED BY THE CONTRACTOR. PROVISIONS SHALL BE MADE TO INSTALL A TEMPORARY 6-INCH PUMP AND PIPING OR HOSE WITH A MINIMUM PUMPING CAPACITY OF 100 GPM WITHIN CATCH BASIN (CB) #3 TO REDIRECT LEACHATE TO THE EXISTING LEACHATE PUMP STATION MANHOLE. IF NECESSARY, SHOULD THE EXISTING LEACHATE PUMP STATION BECOME NON-OPERATIONAL, THE CONTRACTOR SHALL MAINTAIN THE ABILITY TO PUMP DIRECTLY INTO LEACHATE TRANSPORT TANKER TRUCKS, COORDINATING WITH THE OWNER TO PROVIDE THE LEACHATE TRUCKING. THE CONTRACTOR SHALL BE RESPONSIBLE FOR FULL OVERSIGHT OF THE TEMPORARY LEACHATE MANAGEMENT AND SHALL TAKE ALL PRECAUTIONS AND ACTIONS NECESSARY TO HAVE THE CAPABILITY OF PUMPING 24-HOURS A DAY, 7 DAYS A WEEK FOR THE DURATION OF THE POND CONSTRUCTION. CLEANUP ACTIONS FOR LEACHATE SPILLS OR LEAKS FROM THE TEMPORARY LEACHATE MANAGEMENT SYSTEM SHALL BE COMPLETED IMMEDIATELY BY THE CONTRACTOR UPON DISCOVERY, UNDER THE DIRECTION OF THE OWNER OR OWNER'S REPRESENTATIVE.

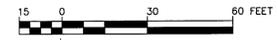

REF. NO.	DRAWING NO.	REFERENCE DRAWING TITLE	CODE	DATE	REV.	REVISION	BY	CKD	APPVD	JOB	CODE	DATE	REV.	REVISION
6	-		-	-	-									
5	-		-	-	-									
4	-		11/26/07	ASB		RECORD DRAWING								
3	-		10/31/06	B		ISSUED FOR BID		GHC						
2	-		5/17/06	P		REVISED PER MEDEP COMMENTS		GHC						
1	-		12/9/05	P		SUBMITTED TO MEDEP		GHC						

**SME**  
**Sevee & Maher Engineers, Inc.**  
 Waste Management and Hydrogeologic Consultants  
 Cumberland Center, Maine



JOB NO. 05043.01

DRN	MBISK	11/05
CHKD	GHC	11/05
APPVD	-	-
ISSUE CODE		
P	Preliminary	
B	Bids	
C	Construction	
ASB	As Built	
SCALE	AS NOTED	

**KATAHDIN PAPER COMPANY LLC.**  
 EAST MILLINOCKET, MAINE

CAD FILE: LPOND.DWG

EAST OPERATION	
DOLBY III LANDFILL LEACHATE POND REDEVELOPMENT LEAK DETECTION PLAN	
JOB NO. 00000	YB-26192
FILE NO. 0-000-0000	
LOC. NO.	

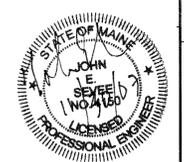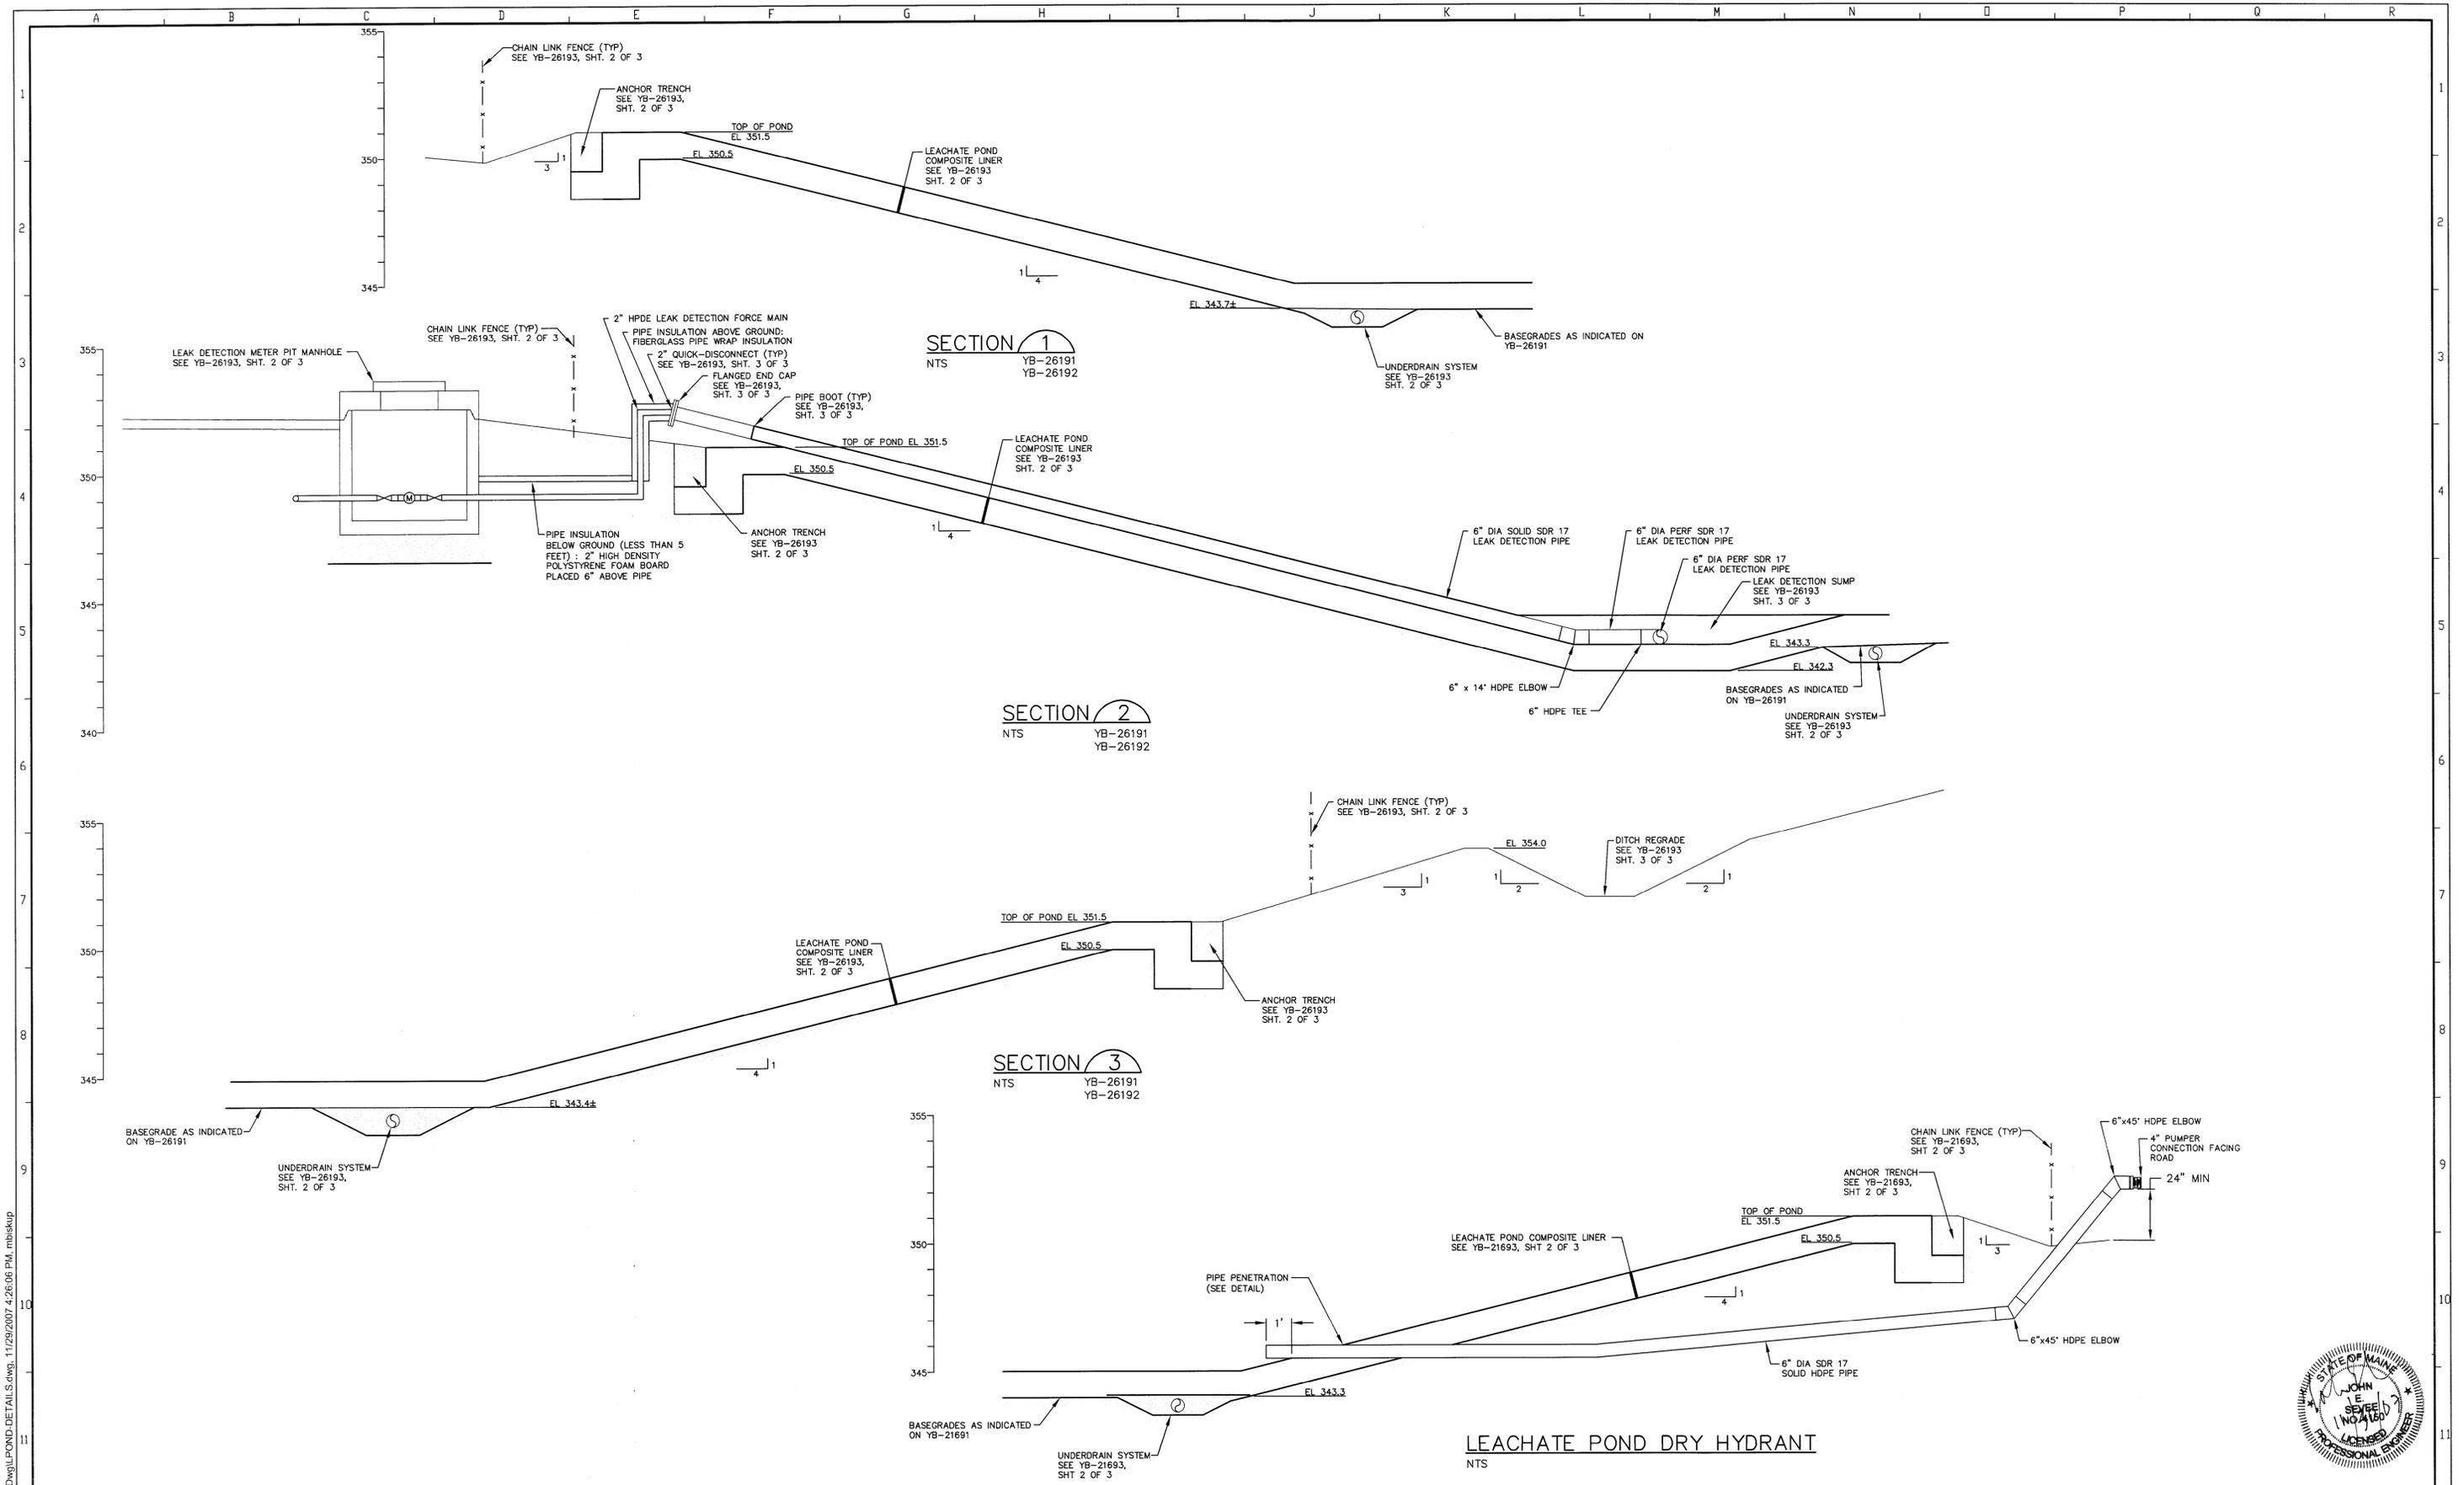

REF. NO.	DRAWING NO.	REFERENCE DRAWING TITLE	CODE	DATE	REV.	REVISION	BY	CHKD	APPVD	JOB	CODE	DATE	REV.	REVISION	BY	CHKD	APPVD	JOB
6	-																	
5	-																	
4	-			11/26/07	ASB	RECORD DRAWING												
3	-			10/31/06	B	ISSUED FOR BID												
2	-			5/17/06	P	REVISED PER MEDEP COMMENTS												
1	-			12/9/05	P	SUBMITTED TO MEDEP												

**SME**  
*Sevee & Maher Engineers, Inc.*  
 Waste Management and Hydrogeologic Consultants  
 Cumberland Center, Maine  
 JOB NO. 05043.01

DRN	DRD	11/05
CHKD	GHC	11/05
APPVD	-	-
ISSUE CODE		
P	Preliminary	
B	Bids	
C	Construction	
ASB	As Built	
SCALE	AS NOTED	


KATAHDIN PAPER COMPANY LLC.  
 EAST MILLINOCKET, MAINE

CAD FILE: YB-26193 BO


EAST OPERATION  
 DOLBY III LANDFILL  
 LEACHATE POND REDEVELOPMENT  
 SECTIONS AND DETAILS  
 (SHEET 1 OF 3)

JOB NO. 00000  
 FILE NO. 0-000-0000  
 LDC. NO. YB-26193


G:\kpc\Do\CAD\Leachate Pond\Rec\DWG\LPOD\DETAILS.dwg, 11/29/2007 4:26:06 PM, mbiskup

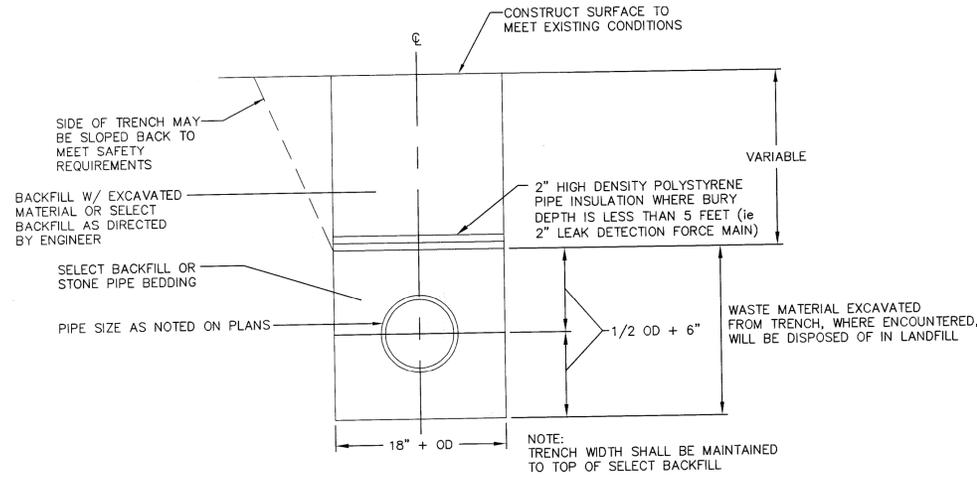


**PIPE TRENCH**  
NTS

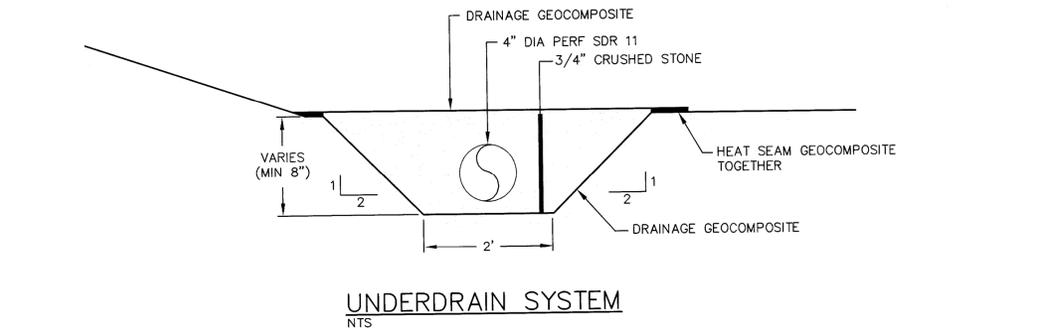


**UNDERDRAIN SYSTEM**  
NTS

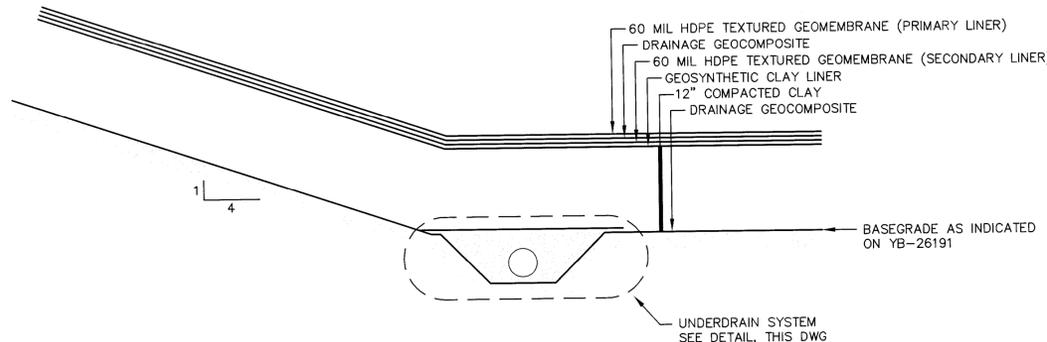

**LEACHATE POND COMPOSITE LINER (BASE & SIDESLOPE)**  
NTS

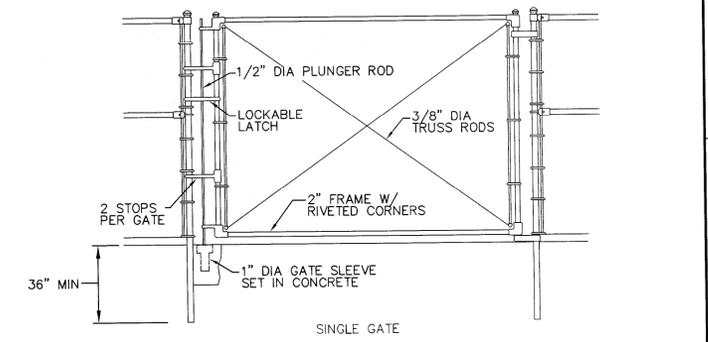


SINGLE GATE

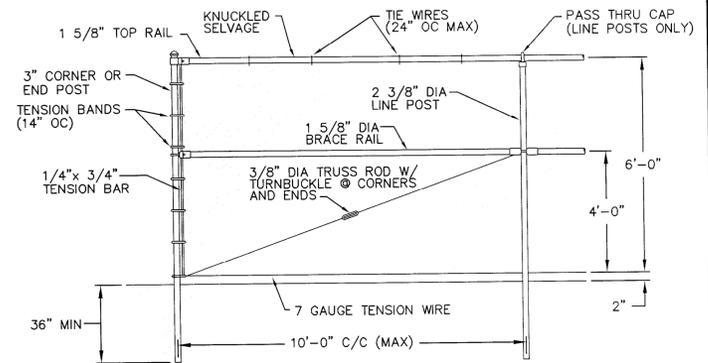


FENCE


**TYPICAL CHAIN LINK FENCE**  
NTS

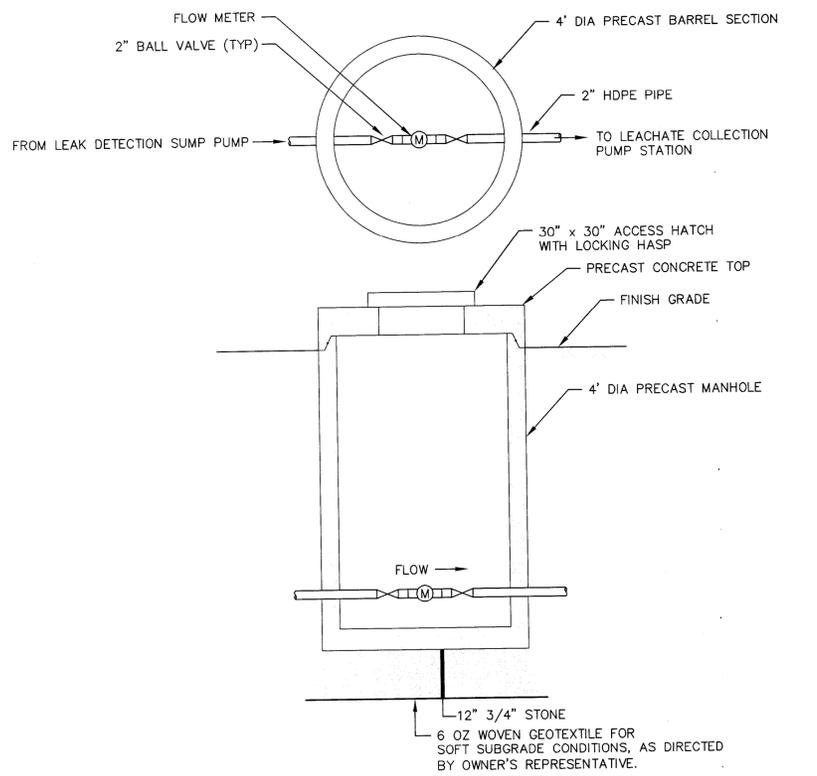


**METER PIT**  
NTS

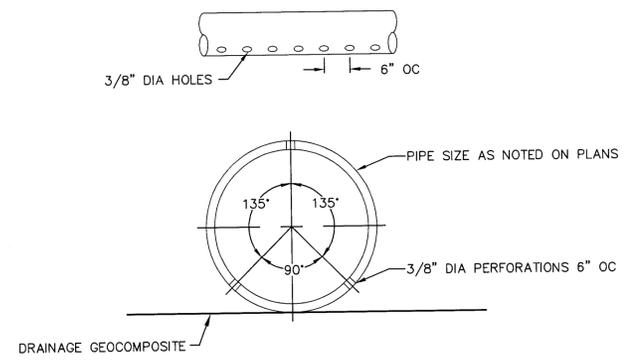

**PERFORATED PIPE**  
NTS

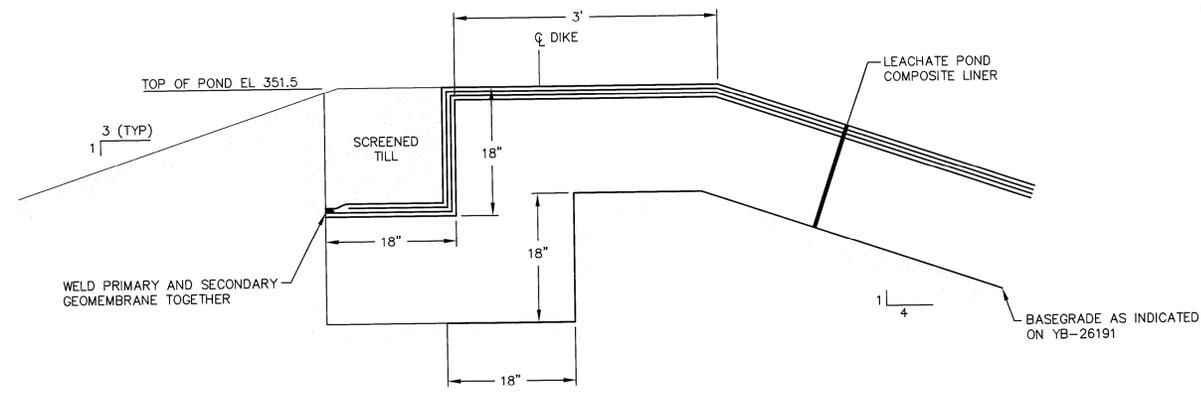


**ANCHOR TRENCH**  
NTS

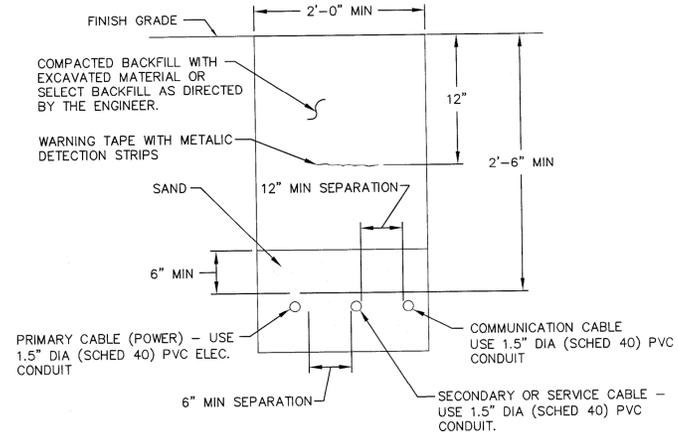

**UNDERGROUND ELECTRIC UTILITY**  
NTS

REV	NO.	DRAWING NO.	REFERENCE DRAWING TITLE	CODE	DATE	REV.	REVISION	BY	CKD	APPVD	JOB	CODE	DATE	REV.	REVISION	BY	CKD	APPVD	JOB
6	-	-	-	-	-	-	-	-	-	-	-	-	-	-	-	-	-	-	-
5	-	-	-	-	-	-	-	-	-	-	-	-	-	-	-	-	-	-	-
4	-	-	-	-	-	-	-	-	-	-	-	-	-	-	-	-	-	-	-
3	-	-	11/26/07	ASB	RECORD DRAWING	-	-	-	-	-	-	-	-	-	-	-	-	-	-
2	-	-	10/31/06	B	ISSUED FOR BID	-	-	-	GHC	-	-	-	-	-	-	-	-	-	-
1	-	-	5/17/06	P	REVISED PER MEDEP COMMENTS	-	-	-	GHC	-	-	-	-	-	-	-	-	-	-
1	-	-	12/9/05	P	SUBMITTED TO MEDEP	-	-	-	GHC	-	-	-	-	-	-	-	-	-	-

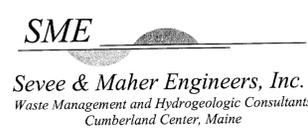

JOB NO. 05043.01

DRN	DRD	11/05
CHKD	GHC	11/05
APPVD	-	-
ISSUE CODE		
P - Preliminary		
B - Bids		
C - Construction		
ASB - As Built		
SCALE AS NOTED		






**KATAHDIN PAPER COMPANY LLC.**  
EAST MILLINOCKET, MAINE

CAD FILE: YB-26193 B1


**EAST OPERATION**  
DOLBY III LANDFILL  
LEACHATE POND REDEVELOPMENT  
SECTIONS AND DETAILS  
(SHEET 2 OF 3)

JOB NO. 00000  
FILE NO. 0-000-0000  
LOC. NO. \_\_\_\_\_  
**YB-26193**




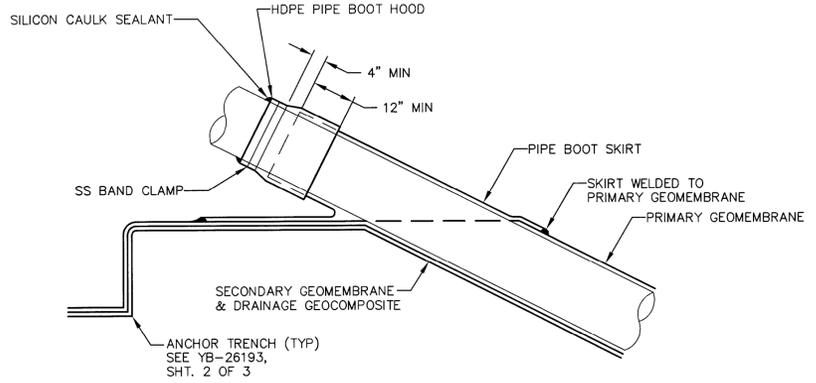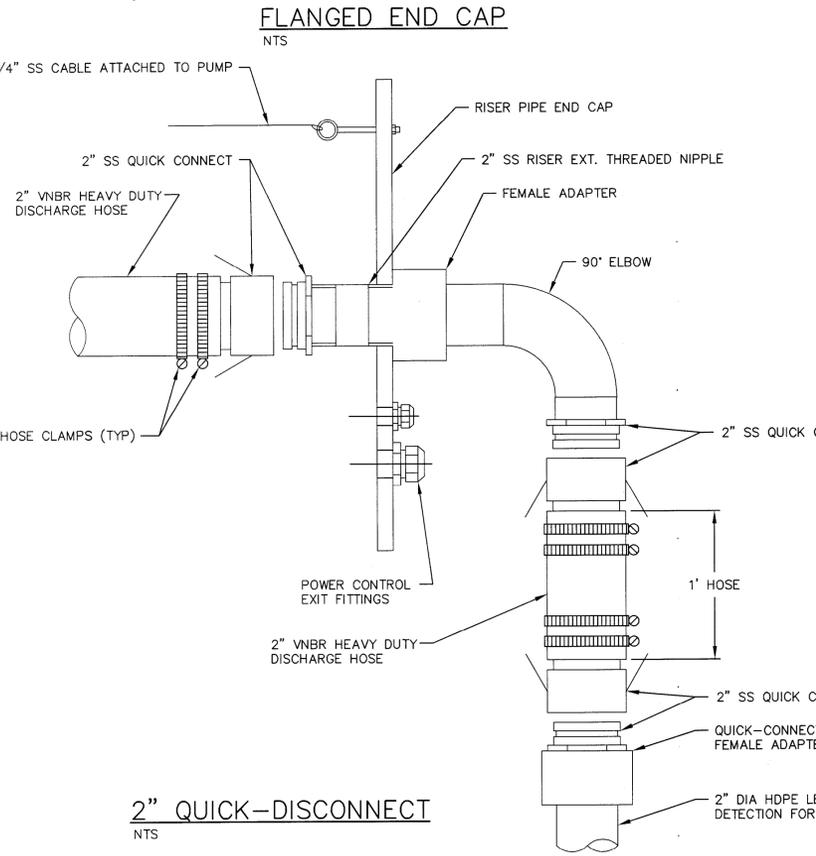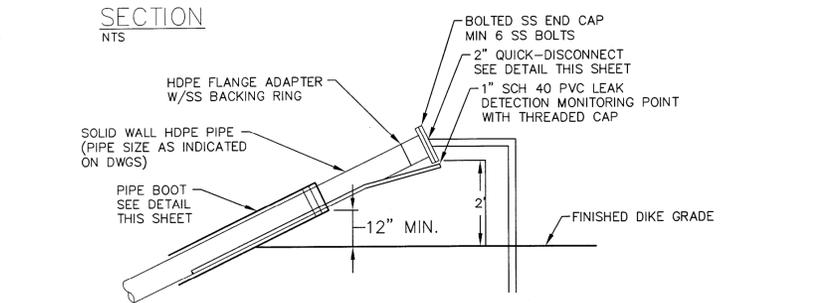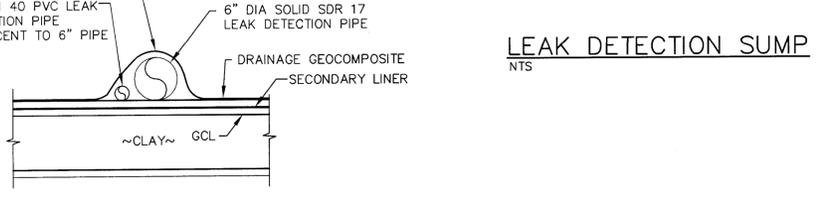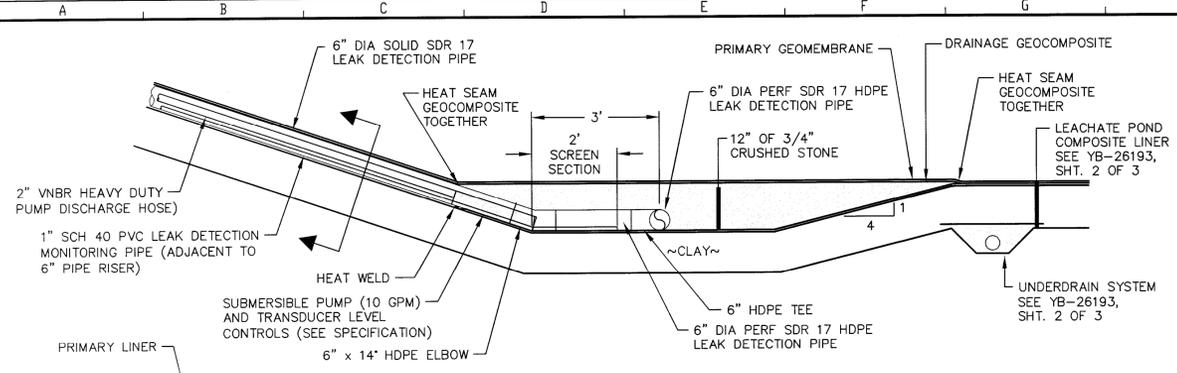


**LEAK DETECTION PUMP CONDUIT PIPE BOOT**  
NTS

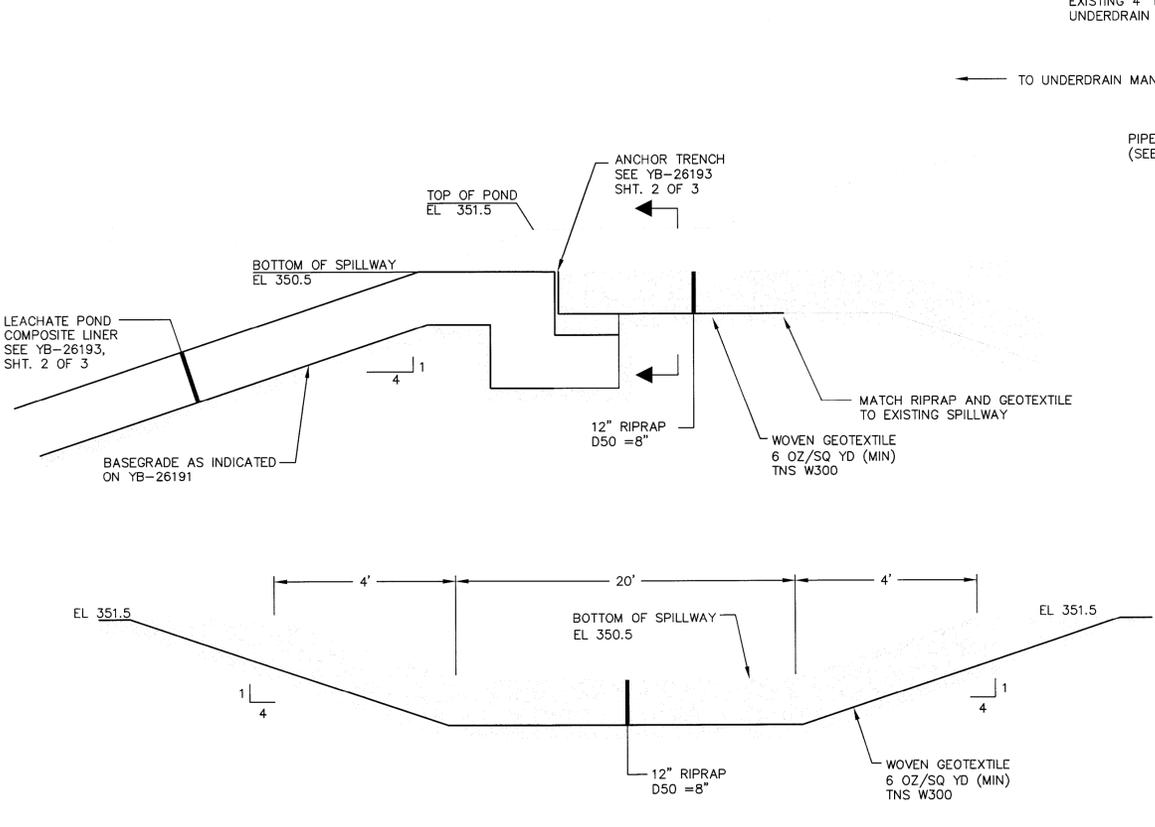


**SECTION LEACHATE POND EMERGENCY SPILLWAY**  
NTS

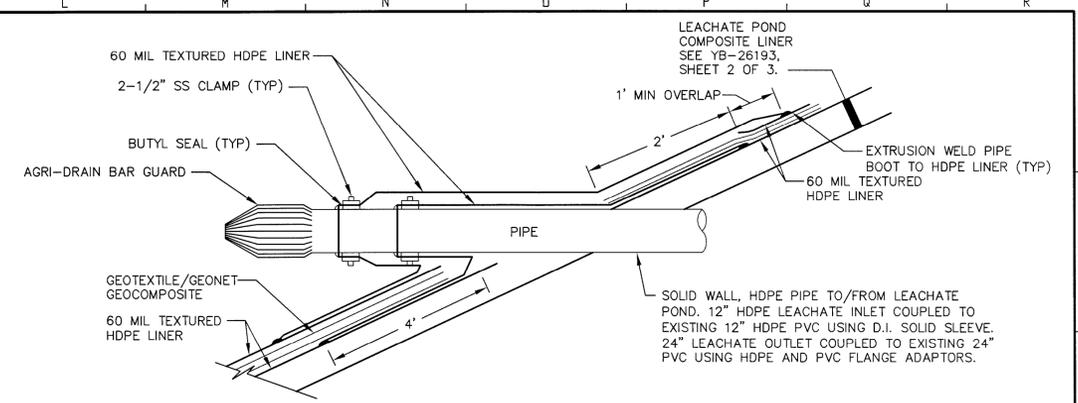

**LEACHATE INLET/OUTLET PIPE**  
NTS

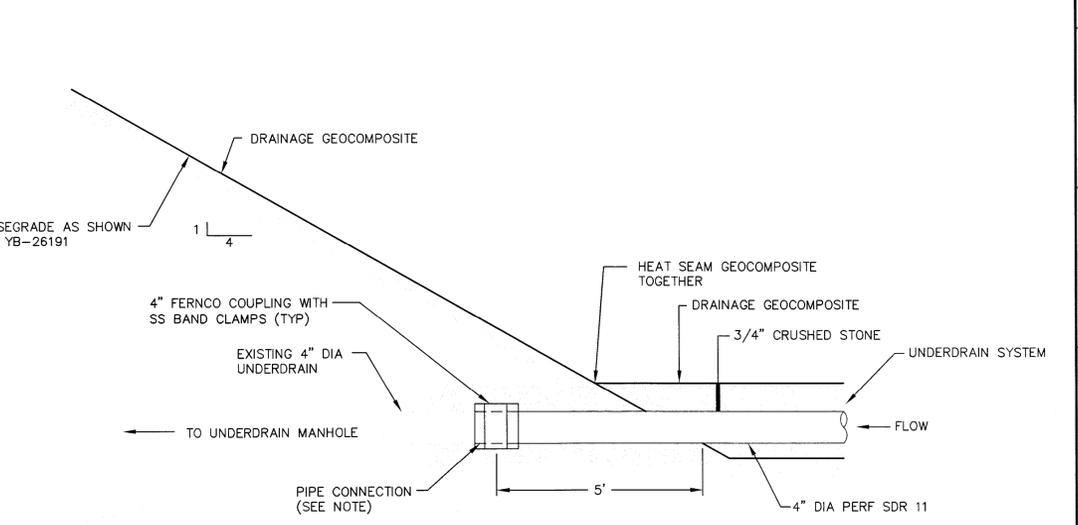

**CONNECTION TO EXISTING 4\"/>NTS**

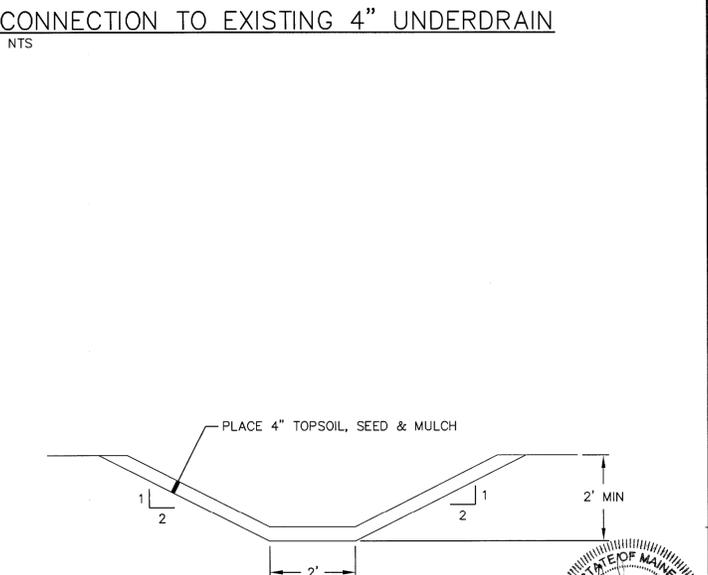

**DITCH REGRADE**  
NTS


REF. NO.	DRAWING NO.	REFERENCE DRAWING TITLE	CODE	DATE	REV.	REVISION	BY	CHKD	APPVD	JOB	CODE	DATE	REV.	REVISION	BY	CHKD	APPVD	JOB
6	-	-	-	-	-	-	-	-	-	-	-	-	-	-	-	-	-	-
5	-	-	-	-	-	-	-	-	-	-	-	-	-	-	-	-	-	-
4	-	-	-	-	-	-	-	-	-	-	-	-	-	-	-	-	-	-
3	-	-	11/26/07	ASB	-	RECORD DRAWING												
2	-	-	10/31/06	B	-	ISSUED FOR BID		GHC										
1	-	-	5/17/06	P	-	REVISED PER MEDEP COMMENTS		GHC										
1	-	-	12/9/05	P	-	SUBMITTED TO MEDEP		GHC										

**SME**  
Sevee & Maher Engineers, Inc.  
Waste Management and Hydrogeologic Consultants  
Cumberland Center, Maine  
JOB NO. 05043.01

DRN	DRD	11/05
CHKD	GHC	11/05
APPVD	-	-
ISSUE CODE		
P	-	Preliminary
B	-	Bids
C	-	Construction
ASB	-	As Built
SCALE	-	AS NOTED

**KATAHDIN PAPER COMPANY LLC.**  
EAST MILLINOCKET, MAINE  
CAD FILE: YB-26193 B2


**EAST OPERATION**  
DOLBY III LANDFILL  
LEACHATE POND REDEVELOPMENT  
SECTIONS AND DETAILS  
(SHEET 3 OF 3)  
JOB NO. 00000  
FILE NO. 0-000-0000  
LOC. NO. **YB-26193**

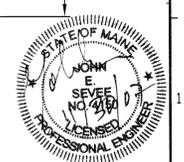

# MAINE BUREAU OF GENERAL SERVICES DOLBY LANDFILL COVER UPGRADE - PHASE 1 EAST MILLINOCKET, MAINE

TITLE	DWG NO
COVER SHEET	C-000
SYMBOLS & ABBREVIATIONS	C-100
PHASED CLOSURE PLAN	C-101
EXISTING CONDITIONS PLAN	C-102
SITE BASE GRADING PLAN (NOT INCLUDED)	C-103
SITE PLAN	C-104
GAS COLLECTION PIPING PLAN	C-105
UNDERDRAIN PIPING PLAN	C-106
SECTIONS AND DETAILS	C-300
SECTIONS AND DETAILS	C-301
SECTIONS AND DETAILS	C-302
SECTIONS AND DETAILS	C-303
LAYOUT POINT TABLES (NOT INCLUDED)	C-304
SEDIMENT POND #3 RESTORATION PLAN AND DETAILS	C-305
SECTIONS AND DETAILS	C-306

LOCATION MAP

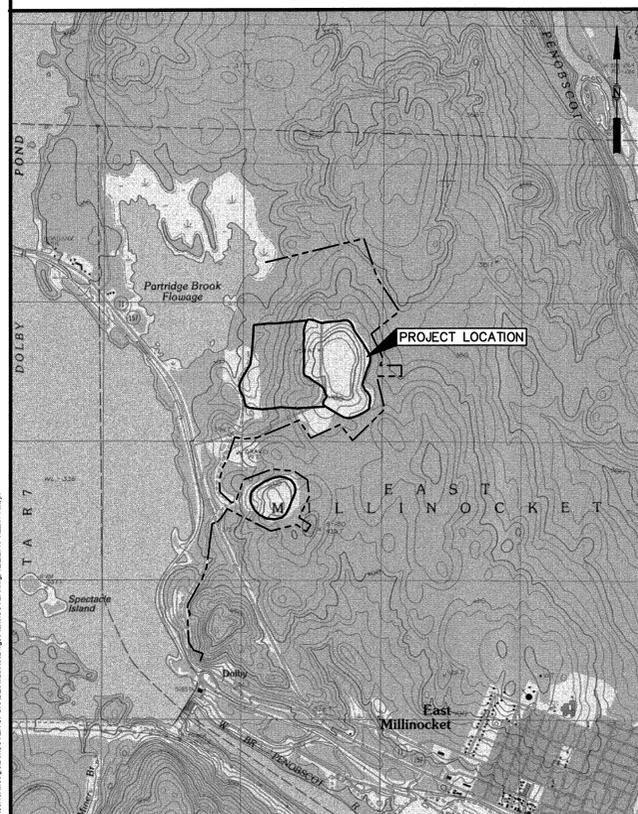

**SME**

Sevee & Maher Engineers, Inc.


ENVIRONMENTAL • CIVIL • GEOTECHNICAL • WATER • COMPLIANCE

4 Blanchard Road, PO Box 85A, Cumberland Center, Maine 04021  
Phone 207.829.5016 • Fax 207.829.5692 • www.smemaine.com



**RECORD DRAWINGS**




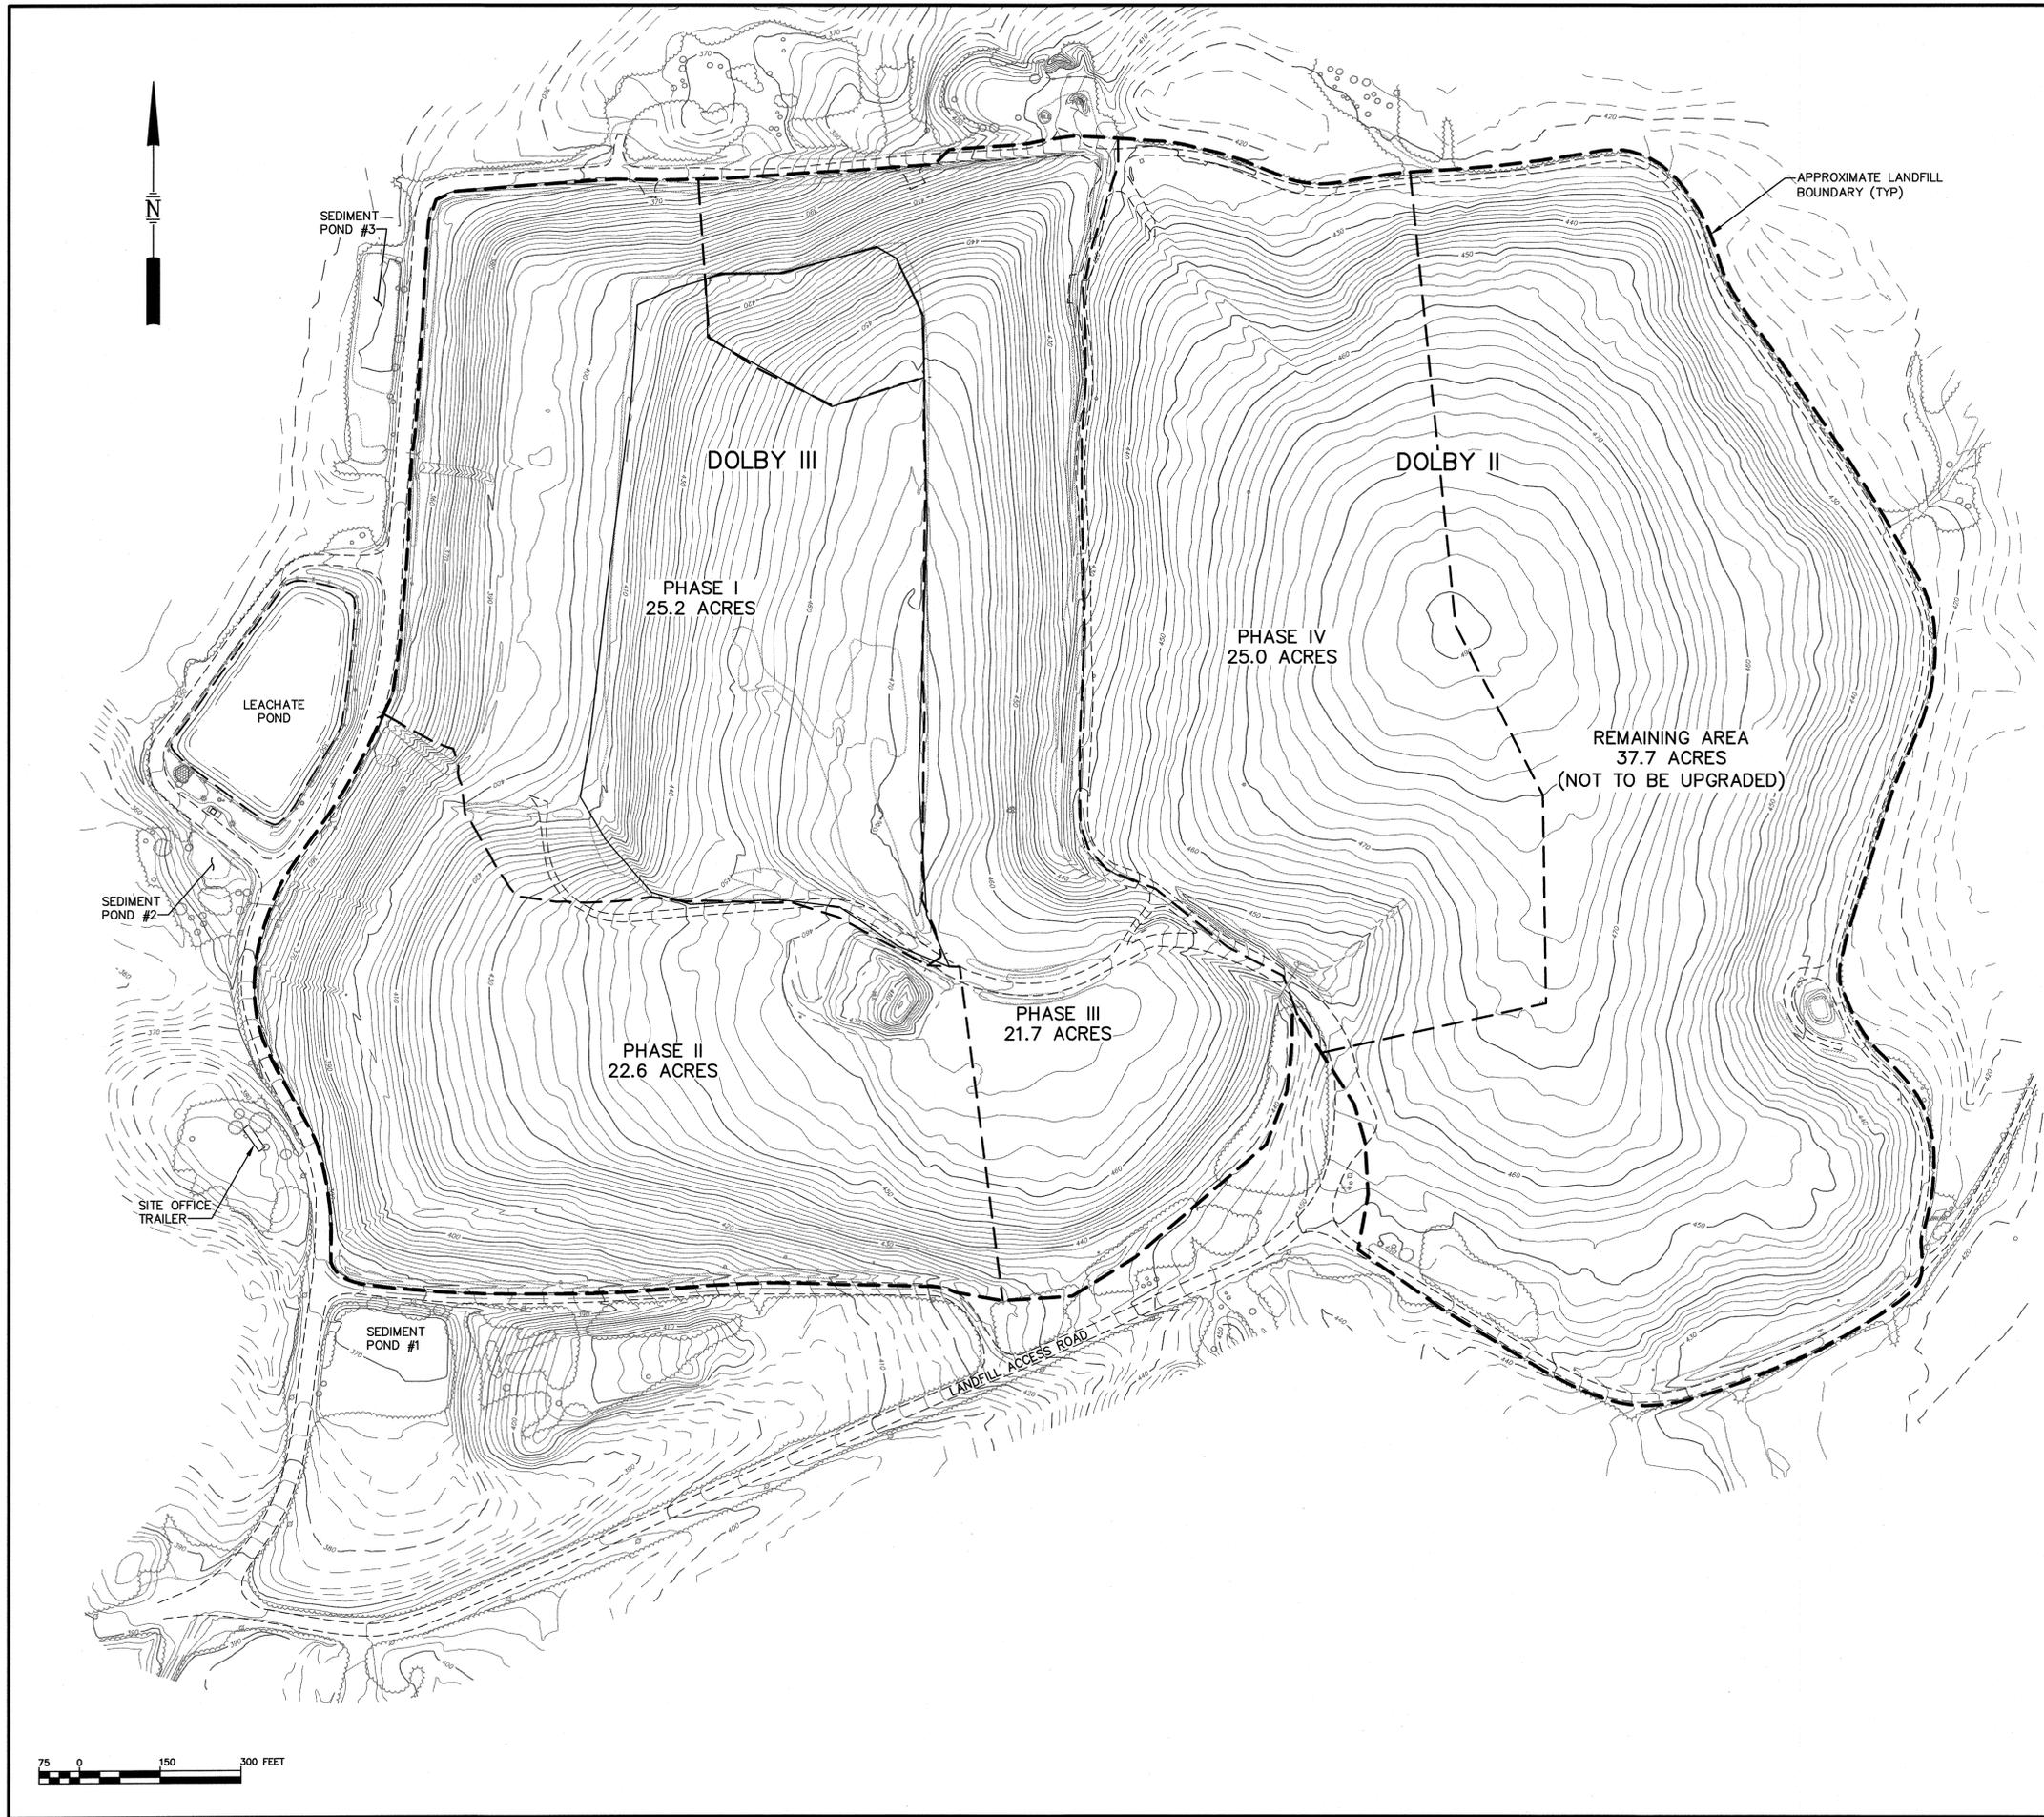

**NOTES**

1. BASE MAP PREPARED BY AERIAL SURVEY & PHOTO, NORRIDGEWOCK, MAINE. PHOTO DATE 10/15/2015. HORIZONTAL DATUM MAINE STATE COORDINATE SYSTEM EAST ZONE, NAD 83. GROUND CONTROL BY PLISGA & DAY, BANGOR, MAINE. VERTICAL DATUM: NAVD 1929. STANDARD PRACTICE DICTATES THAT PLANS COMPILED IN THIS MANNER SHOULD BE FIELD VERIFIED BY THE CONTRACTOR PRIOR TO CONSTRUCTION.
2. ADDITIONAL DITCH TOPOGRAPHY ALONG TOE OF LANDFILL BY SEVEE & MAHER ENGINEERS, INC., CUMBERLAND, MAINE, DATED 10/7/2015
3. PHASED CLOSURE AREAS ARE APPROXIMATE AND ARE SUBJECT TO CHANGE.
4. ALL SITE AND CONSTRUCTION ACTIVITIES SHALL BE IN COMPLIANCE WITH MEDEP BEST MANAGEMENT PRACTICES AND EXISTING FEDERAL, STATE, AND LOCAL PERMITS AND PERMITTING REQUIREMENTS FOR THE SITE.

REV.	BY	DATE	STATUS
	M/MT	11/2016	RECORD DRAWING
	PCM	6/2016	ISSUED FOR CONSTRUCTION
	PCM	4/2016	ISSUED FOR BID

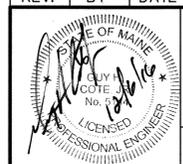


MAINE BUREAU OF GENERAL SERVICES  
 DOLBY LANDFILL COVER UPGRADE – PHASE 1  
 EAST MILLINOCKET, MAINE

**PHASED CLOSURE PLAN**

**SME**  
 Sevee & Maher Engineers, Inc.  
 ENVIRONMENTAL • CIVIL • GEOTECHNICAL • WATER • COMPLIANCE  
 4 Blanchard Road, PO Box 85A, Cumberland Center, Maine 04021  
 Phone 207.829.5016 • Fax 207.829.5692 • www.smemaine.com

DESIGN BY: PCM  
 DRAWN BY: SJM  
 DATE: 4/2016  
 CHECKED BY: *[Signature]*  
 LMN: PHASED  
 CTB: SME-STD



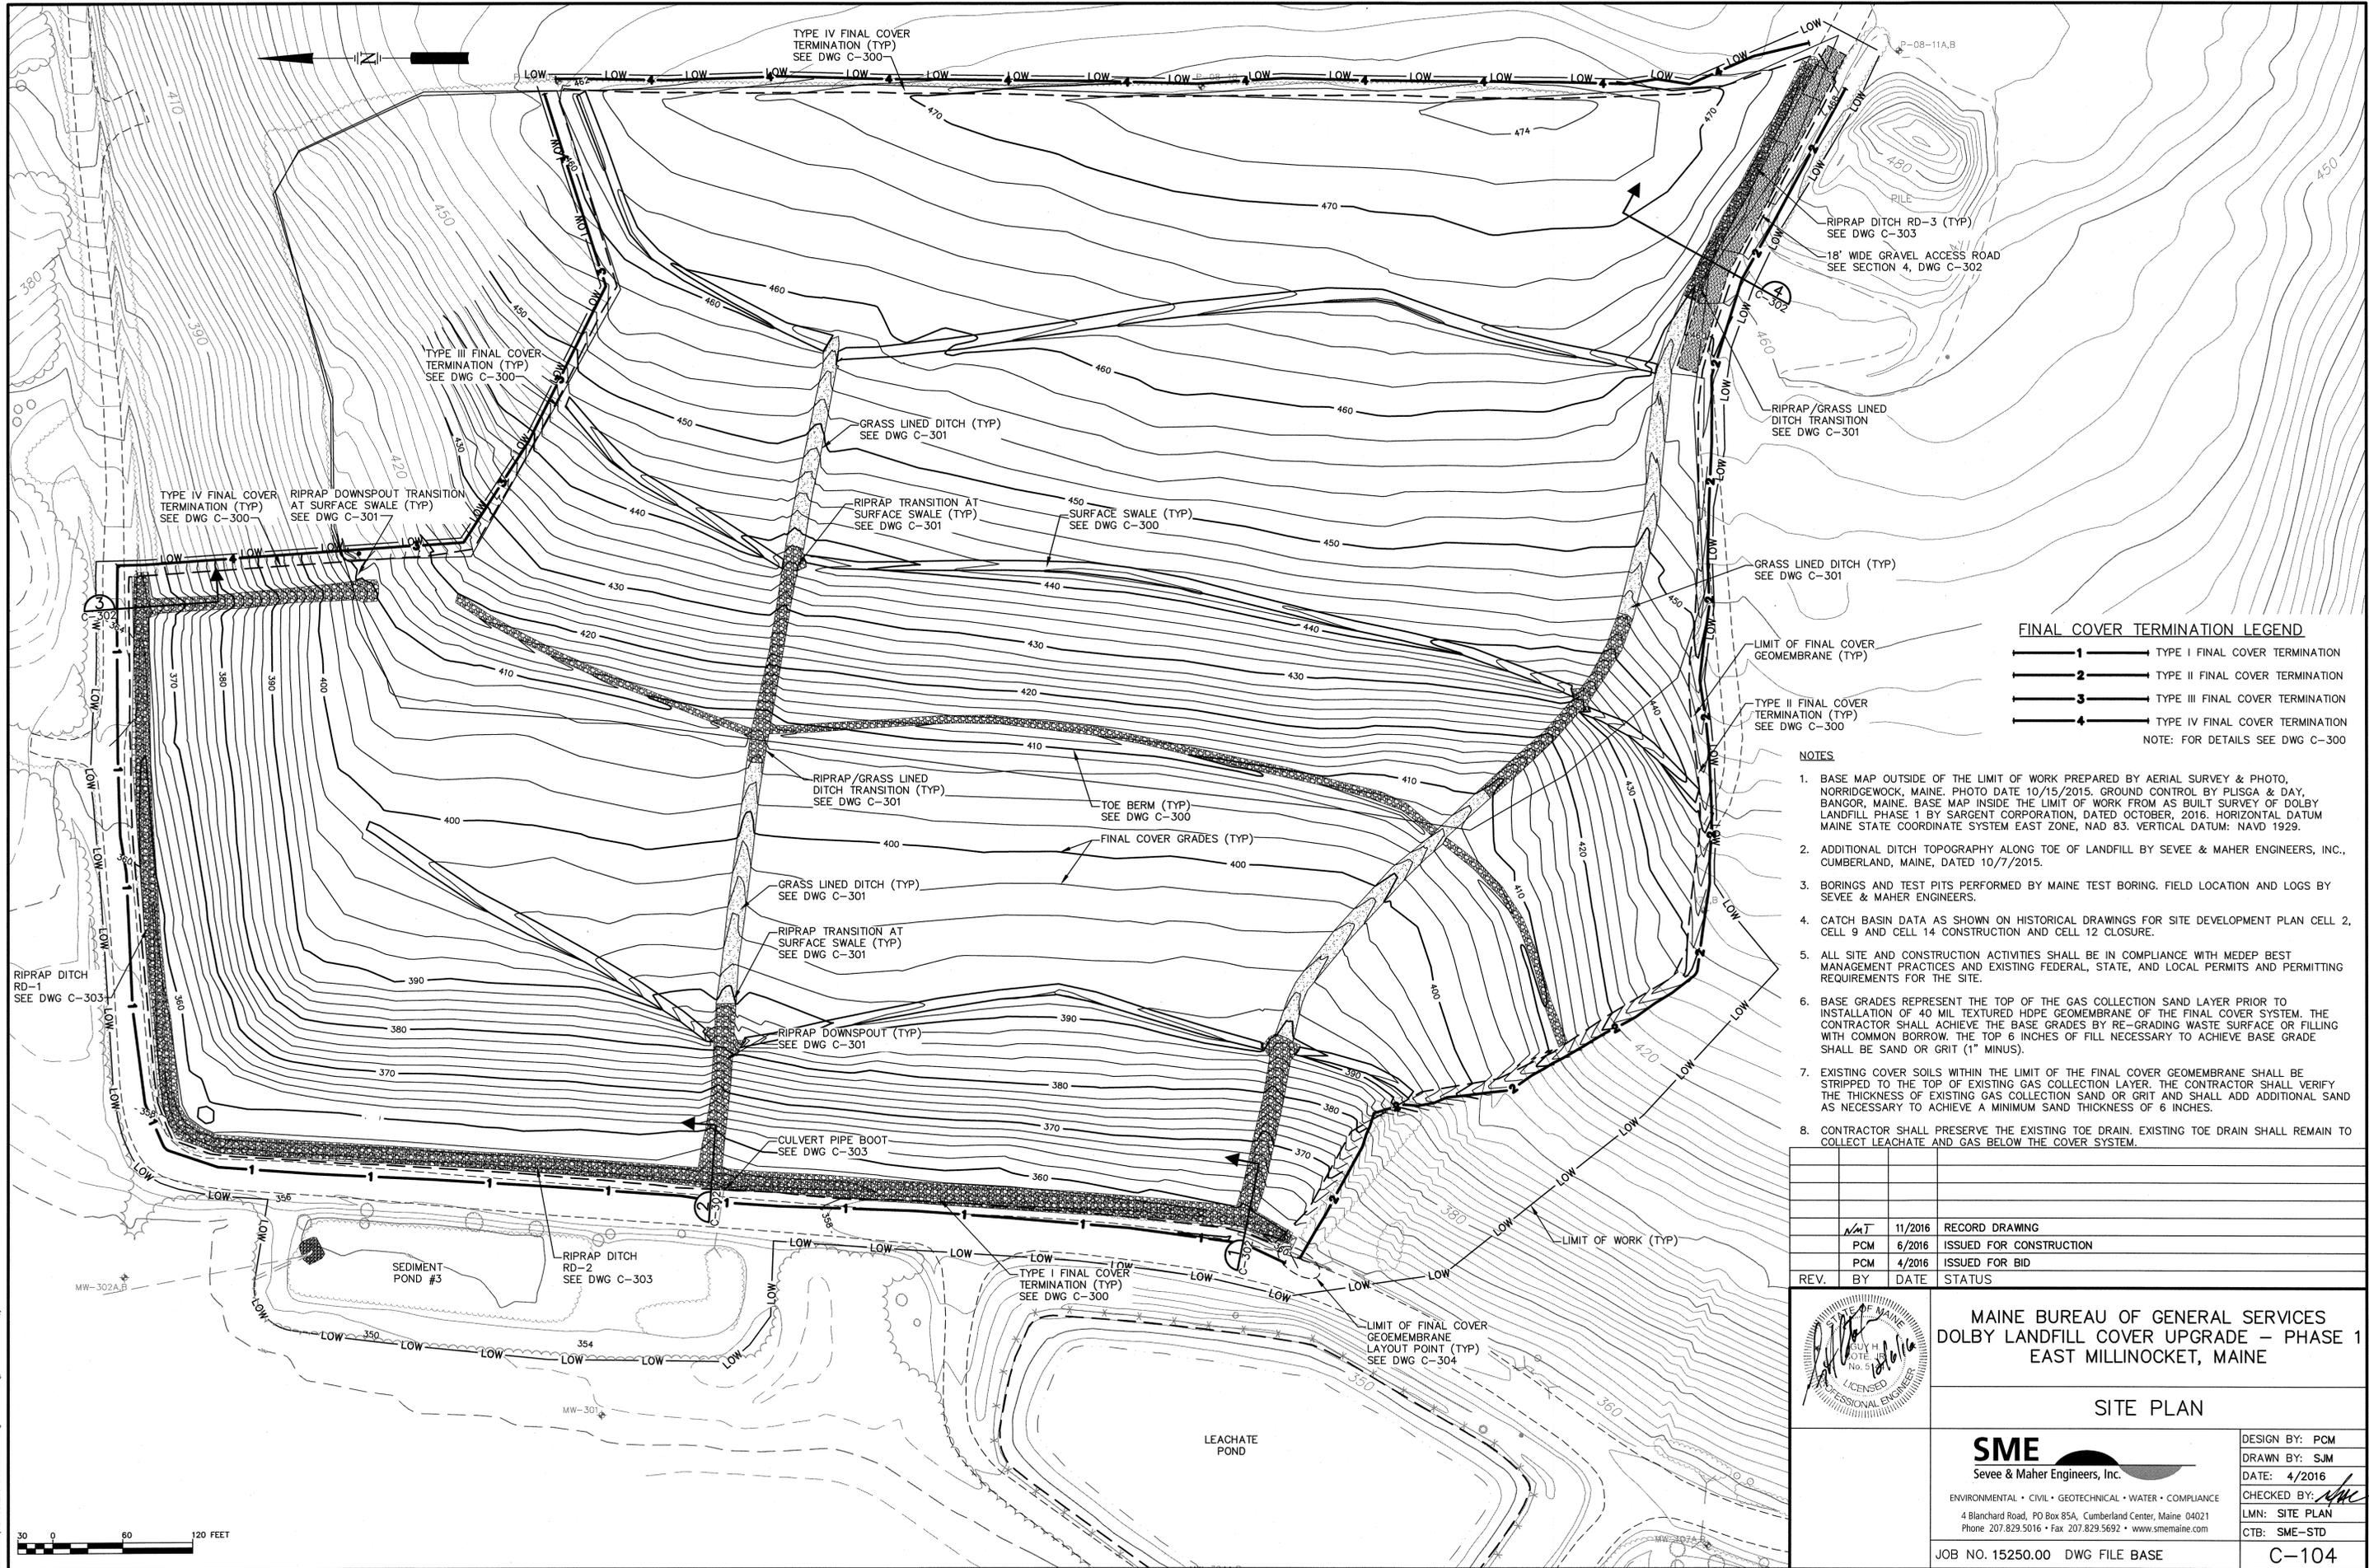

- FINAL COVER TERMINATION LEGEND**
- 1 TYPE I FINAL COVER TERMINATION
  - 2 TYPE II FINAL COVER TERMINATION
  - 3 TYPE III FINAL COVER TERMINATION
  - 4 TYPE IV FINAL COVER TERMINATION
- NOTE: FOR DETAILS SEE DWG C-300

- NOTES**
- BASE MAP OUTSIDE OF THE LIMIT OF WORK PREPARED BY AERIAL SURVEY & PHOTO, NORRIDGEWOCK, MAINE. PHOTO DATE 10/15/2015. GROUND CONTROL BY PLUSGA & DAY, BANGOR, MAINE. BASE MAP INSIDE THE LIMIT OF WORK FROM AS BUILT SURVEY OF DOLBY LANDFILL PHASE 1 BY SARGENT CORPORATION, DATED OCTOBER, 2016. HORIZONTAL DATUM MAINE STATE COORDINATE SYSTEM EAST ZONE, NAD 83. VERTICAL DATUM: NAVD 1929.
  - ADDITIONAL DITCH TOPOGRAPHY ALONG TOE OF LANDFILL BY SEVEE & MAHER ENGINEERS, INC., CUMBERLAND, MAINE, DATED 10/7/2015.
  - BORINGS AND TEST PITS PERFORMED BY MAINE TEST BORING. FIELD LOCATION AND LOGS BY SEVEE & MAHER ENGINEERS.
  - CATCH BASIN DATA AS SHOWN ON HISTORICAL DRAWINGS FOR SITE DEVELOPMENT PLAN CELL 2, CELL 9 AND CELL 14 CONSTRUCTION AND CELL 12 CLOSURE.
  - ALL SITE AND CONSTRUCTION ACTIVITIES SHALL BE IN COMPLIANCE WITH MEDEP BEST MANAGEMENT PRACTICES AND EXISTING FEDERAL, STATE, AND LOCAL PERMITS AND PERMITTING REQUIREMENTS FOR THE SITE.
  - BASE GRADES REPRESENT THE TOP OF THE GAS COLLECTION SAND LAYER PRIOR TO INSTALLATION OF 40 MIL TEXTURED HDPE GEOMEMBRANE OF THE FINAL COVER SYSTEM. THE CONTRACTOR SHALL ACHIEVE THE BASE GRADES BY RE-GRADING WASTE SURFACE OR FILLING WITH COMMON BORROW. THE TOP 6 INCHES OF FILL NECESSARY TO ACHIEVE BASE GRADE SHALL BE SAND OR GRIT (1" MINUS).
  - EXISTING COVER SOILS WITHIN THE LIMIT OF THE FINAL COVER GEOMEMBRANE SHALL BE STRIPPED TO THE TOP OF EXISTING GAS COLLECTION LAYER. THE CONTRACTOR SHALL VERIFY THE THICKNESS OF EXISTING GAS COLLECTION SAND OR GRIT AND SHALL ADD ADDITIONAL SAND AS NECESSARY TO ACHIEVE A MINIMUM SAND THICKNESS OF 6 INCHES.
  - CONTRACTOR SHALL PRESERVE THE EXISTING TOE DRAIN. EXISTING TOE DRAIN SHALL REMAIN TO COLLECT LEACHATE AND GAS BELOW THE COVER SYSTEM.

REV.	BY	DATE	STATUS
	NMT	11/2016	RECORD DRAWING
	PCM	6/2016	ISSUED FOR CONSTRUCTION
	PCM	4/2016	ISSUED FOR BID

**MAINE BUREAU OF GENERAL SERVICES**  
**DOLBY LANDFILL COVER UPGRADE - PHASE 1**  
**EAST MILLINOCKET, MAINE**

**SITE PLAN**

DESIGN BY: PCM  
 DRAWN BY: SJM  
 DATE: 4/2016  
 CHECKED BY: *[Signature]*  
 LMN: SITE PLAN  
 CTB: SME-STD

**SME**  
 Sevee & Maher Engineers, Inc.

ENVIRONMENTAL • CIVIL • GEOTECHNICAL • WATER • COMPLIANCE  
 4 Blanchard Road, PO Box 85A, Cumberland Center, Maine 04021  
 Phone 207.829.5016 • Fax 207.829.5692 • www.smemaine.com


JOB NO. 15250.00 DWG FILE BASE

C-104

M:\Projects\15250\15250-00\DWG\15250-00-100.dwg, 11/20/2016 8:40:03 AM, J1




PHASE III  
ACRES = 22

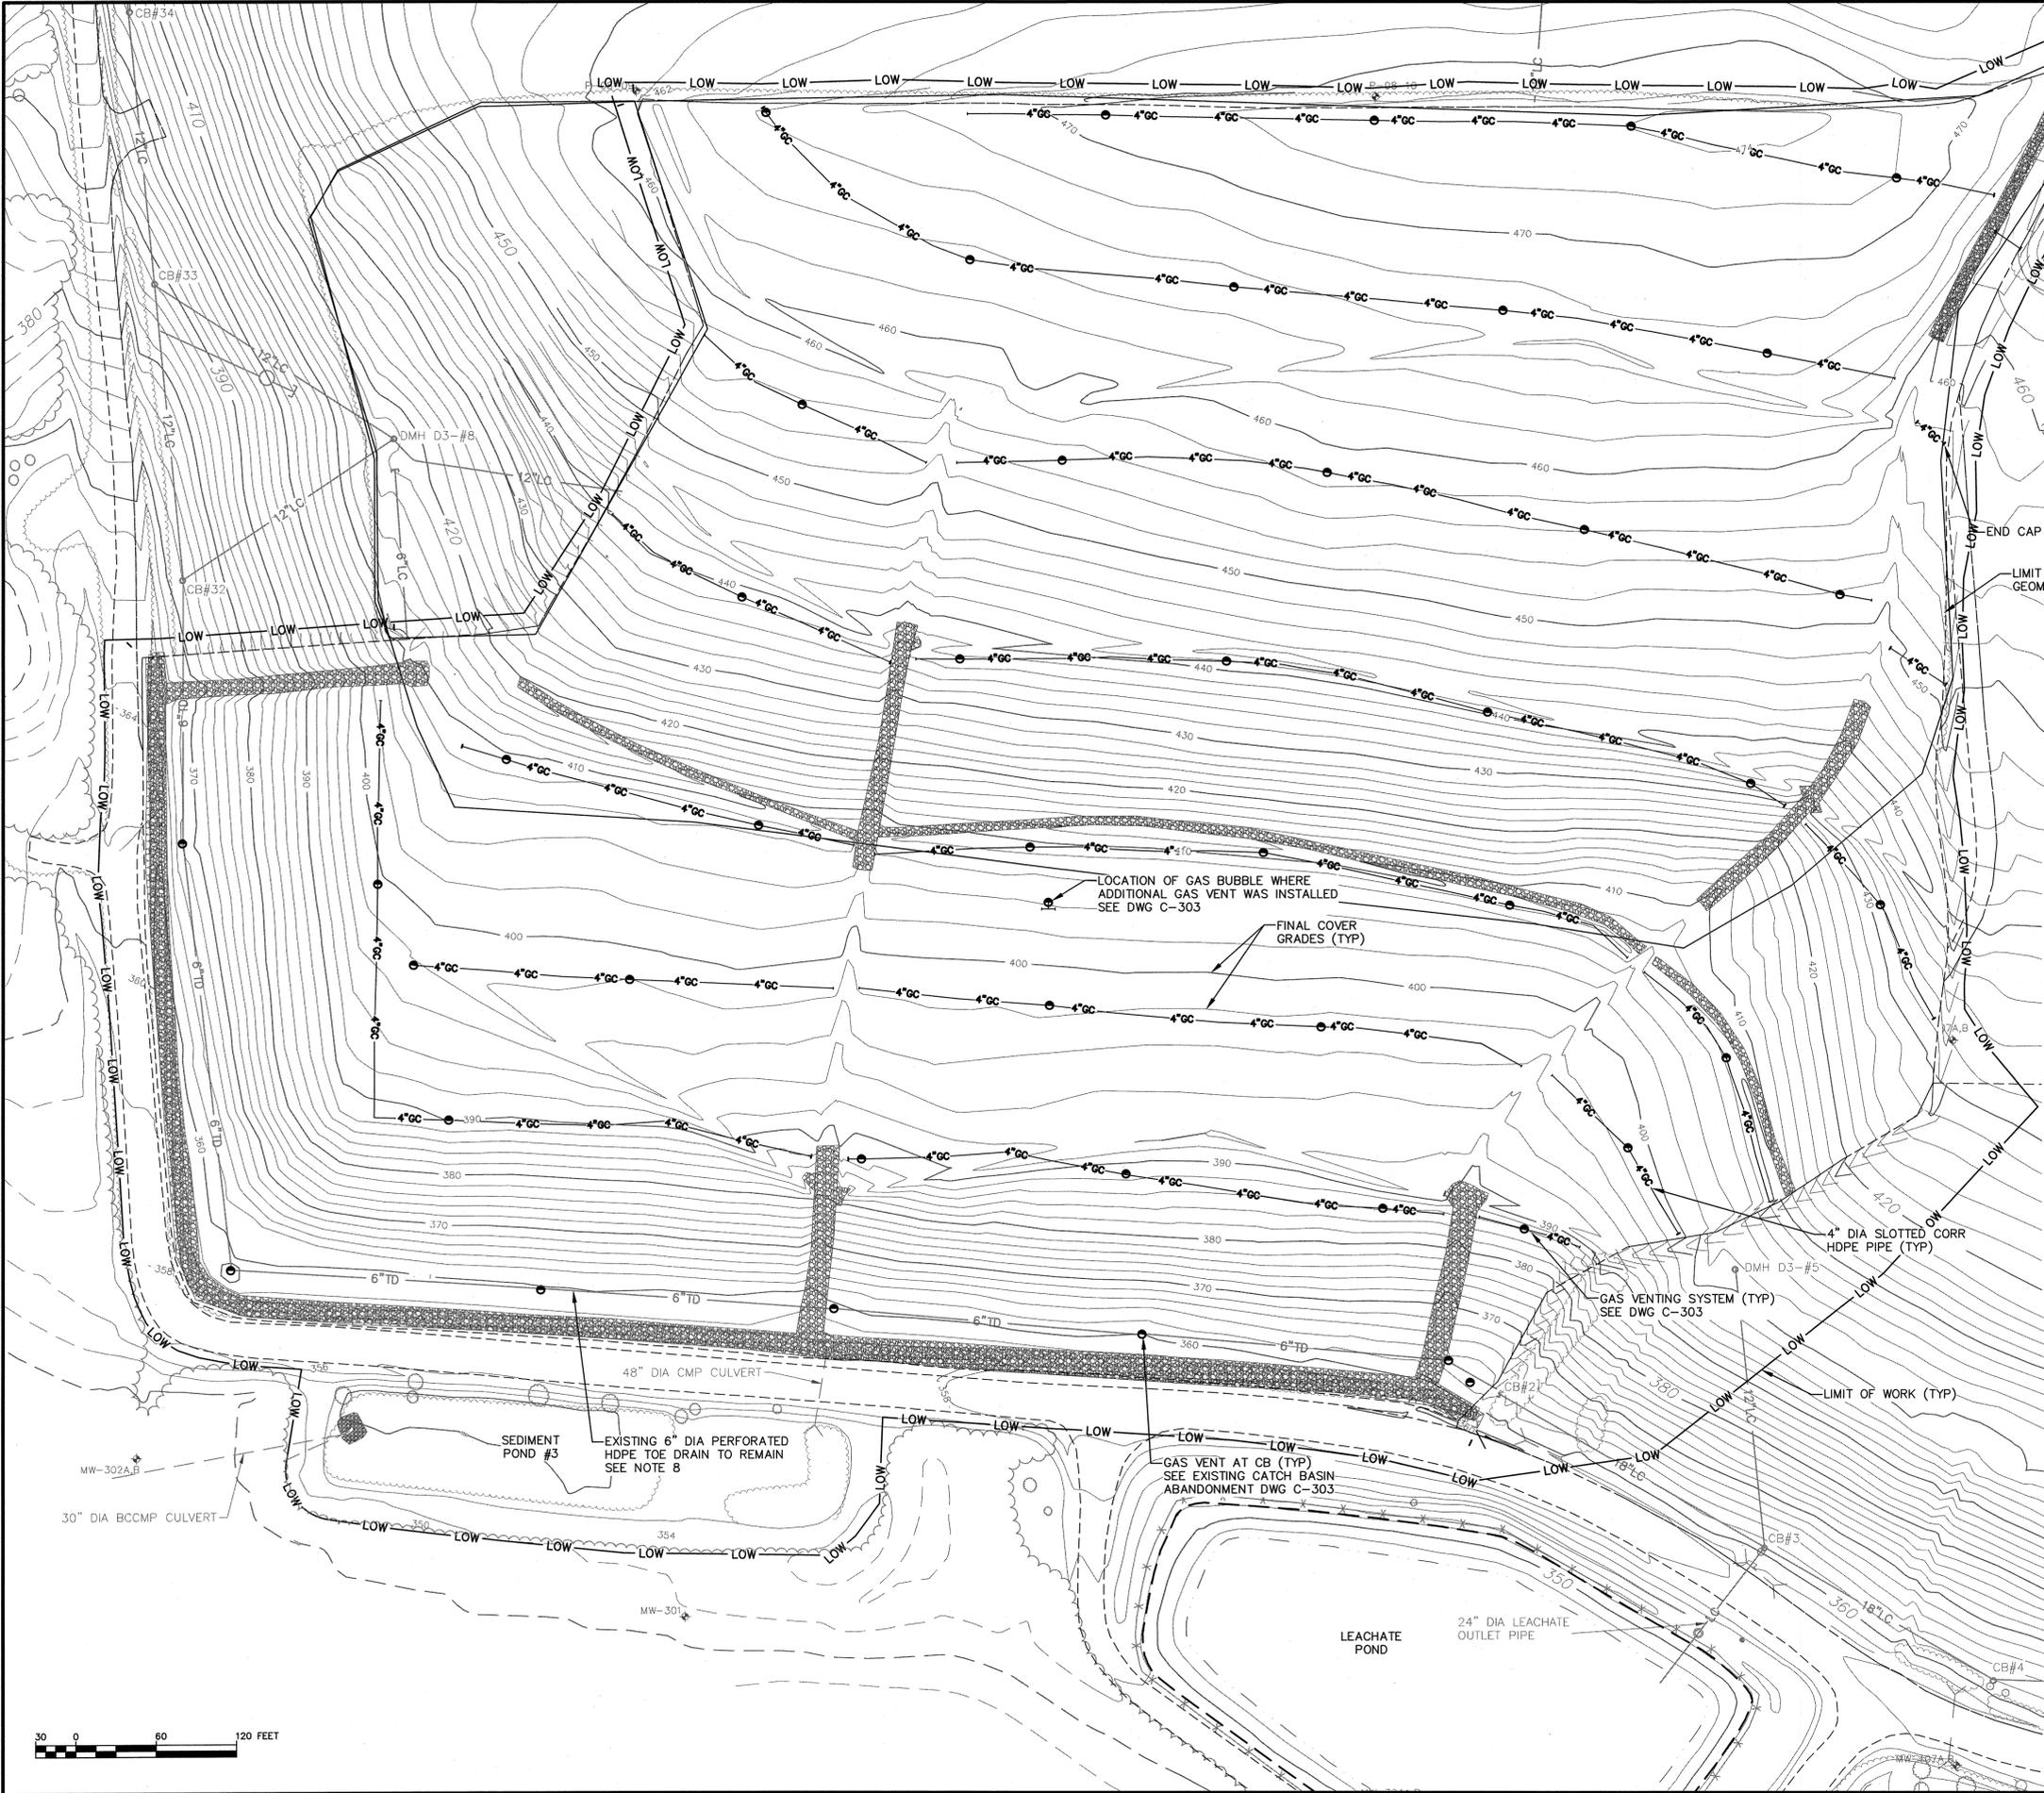

**NOTES**

1. BASE MAP OUTSIDE OF THE LIMIT OF WORK PREPARED BY AERIAL SURVEY & PHOTO, NORRIDGEWOCK, MAINE. PHOTO DATE 10/15/2015. GROUND CONTROL BY PLISGA & DAY, BANGOR, MAINE. BASE MAP INSIDE THE LIMIT OF WORK FROM AS BUILT SURVEY OF DOLBY LANDFILL PHASE 1 BY SARGENT CORPORATION, DATED OCTOBER, 2016. HORIZONTAL DATUM MAINE STATE COORDINATE SYSTEM EAST ZONE, NAD 83. VERTICAL DATUM: NAVD 1929.
2. ADDITIONAL DITCH TOPOGRAPHY ALONG TOE OF LANDFILL BY SEVEE & MAHER ENGINEERS, INC., CUMBERLAND, MAINE, DATED 10/7/2015.
3. BORINGS AND TEST PITS PERFORMED BY MAINE TEST BORING. FIELD LOCATION AND LOGS BY SEVEE & MAHER ENGINEERS.
4. CATCH BASIN DATA AS SHOWN ON HISTORICAL DRAWINGS FOR SITE DEVELOPMENT PLAN CELL 2, CELL 9 AND CELL 14 CONSTRUCTION AND CELL 12 CLOSURE.
5. ALL SITE AND CONSTRUCTION ACTIVITIES SHALL BE IN COMPLIANCE WITH MEDEP BEST MANAGEMENT PRACTICES AND EXISTING FEDERAL, STATE, AND LOCAL PERMITS AND PERMITTING REQUIREMENTS FOR THE SITE.
6. BASE GRADES REPRESENT THE TOP OF THE GAS COLLECTION SAND LAYER PRIOR TO INSTALLATION OF 40 MIL TEXTURED HDPE GEOMEMBRANE OF THE FINAL COVER SYSTEM. THE CONTRACTOR SHALL ACHIEVE THE BASE GRADES BY RE-GRADING WASTE SURFACE OR FILLING WITH COMMON BORROW. THE TOP 6 INCHES OF FILL NECESSARY TO ACHIEVE BASE GRADE SHALL BE SAND OR GRIT (1" MINUS).
7. EXISTING COVER SOILS WITHIN THE LIMIT OF THE FINAL COVER GEOMEMBRANE SHALL BE STRIPPED TO THE TOP OF EXISTING GAS COLLECTION LAYER. THE CONTRACTOR SHALL VERIFY THE THICKNESS OF EXISTING GAS COLLECTION SAND OR GRIT AND SHALL ADD ADDITIONAL SAND AS NECESSARY TO ACHIEVE A MINIMUM SAND THICKNESS OF 6 INCHES.
8. CONTRACTOR SHALL PRESERVE THE EXISTING TOE DRAIN. EXISTING TOE DRAIN SHALL REMAIN TO COLLECT LEACHATE AND GAS BELOW THE COVER SYSTEM.

REV.	BY	DATE	STATUS
		11/2016	RECORD DRAWING
	PCM	6/2016	ISSUED FOR CONSTRUCTION
	PCM	4/2016	ISSUED FOR BID

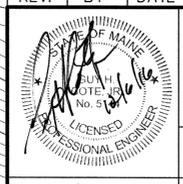

MAINE BUREAU OF GENERAL SERVICES  
DOLBY LANDFILL COVER UPGRADE - PHASE 1  
EAST MILLINOCKET, MAINE

**GAS COLLECTION PIPING PLAN**

**SME**  
Sevee & Maher Engineers, Inc.  
ENVIRONMENTAL • CIVIL • GEOTECHNICAL • WATER • COMPLIANCE  
4 Blanchard Road, PO Box 85A, Cumberland Center, Maine 04021  
Phone 207.829.5016 • Fax 207.829.5692 • www.smemaine.com

DESIGN BY: PCM  
DRAWN BY: SJM  
DATE: 4/2016  
CHECKED BY: [Signature]  
LMN: GC-PIPING  
CTB: SME-STD

JOB NO. 15250.00 DWG FILE BASE C-105















# MAINE BUREAU OF GENERAL SERVICES

## DOLBY LANDFILL COVER UPGRADE

### PHASES 2 AND 3

## EAST MILLINOCKET, MAINE

## BGS PROJECT 3345

TITLE	DWG NO
COVER SHEET	
SYMBOLS & ABBREVIATIONS	C-100
PHASED CLOSURE PLAN	C-101
EXISTING CONDITIONS PLAN	C-102
SITE BASE GRADING PLAN - PHASE 2	C-103
SITE BASE GRADING PLAN - PHASE 3	C-104
SITE PLAN - PHASE 2	C-105
SITE PLAN - PHASE 3	C-106
GAS COLLECTION AND FINGER DRAIN PIPING PLAN - PHASE 2	C-107
GAS COLLECTION AND FINGER DRAIN PIPING PLAN - PHASE 3	C-108
UNDERDRAIN PIPING PLAN - PHASE 2	C-109
UNDERDRAIN PIPING PLAN - PHASE 3	C-110
SECTIONS AND DETAILS	C-300
SECTIONS AND DETAILS	C-301
SECTIONS AND DETAILS	C-302
SECTIONS AND DETAILS	C-303

LOCATION MAP



ENVIRONMENTAL • CIVIL • GEOTECHNICAL • WATER • COMPLIANCE


4 Blanchard Road, PO Box 85A, Cumberland, Maine 04021  
 Phone 207.829.5016 • Fax 207.829.5692 • smemaine.com

**RECORD DRAWINGS**







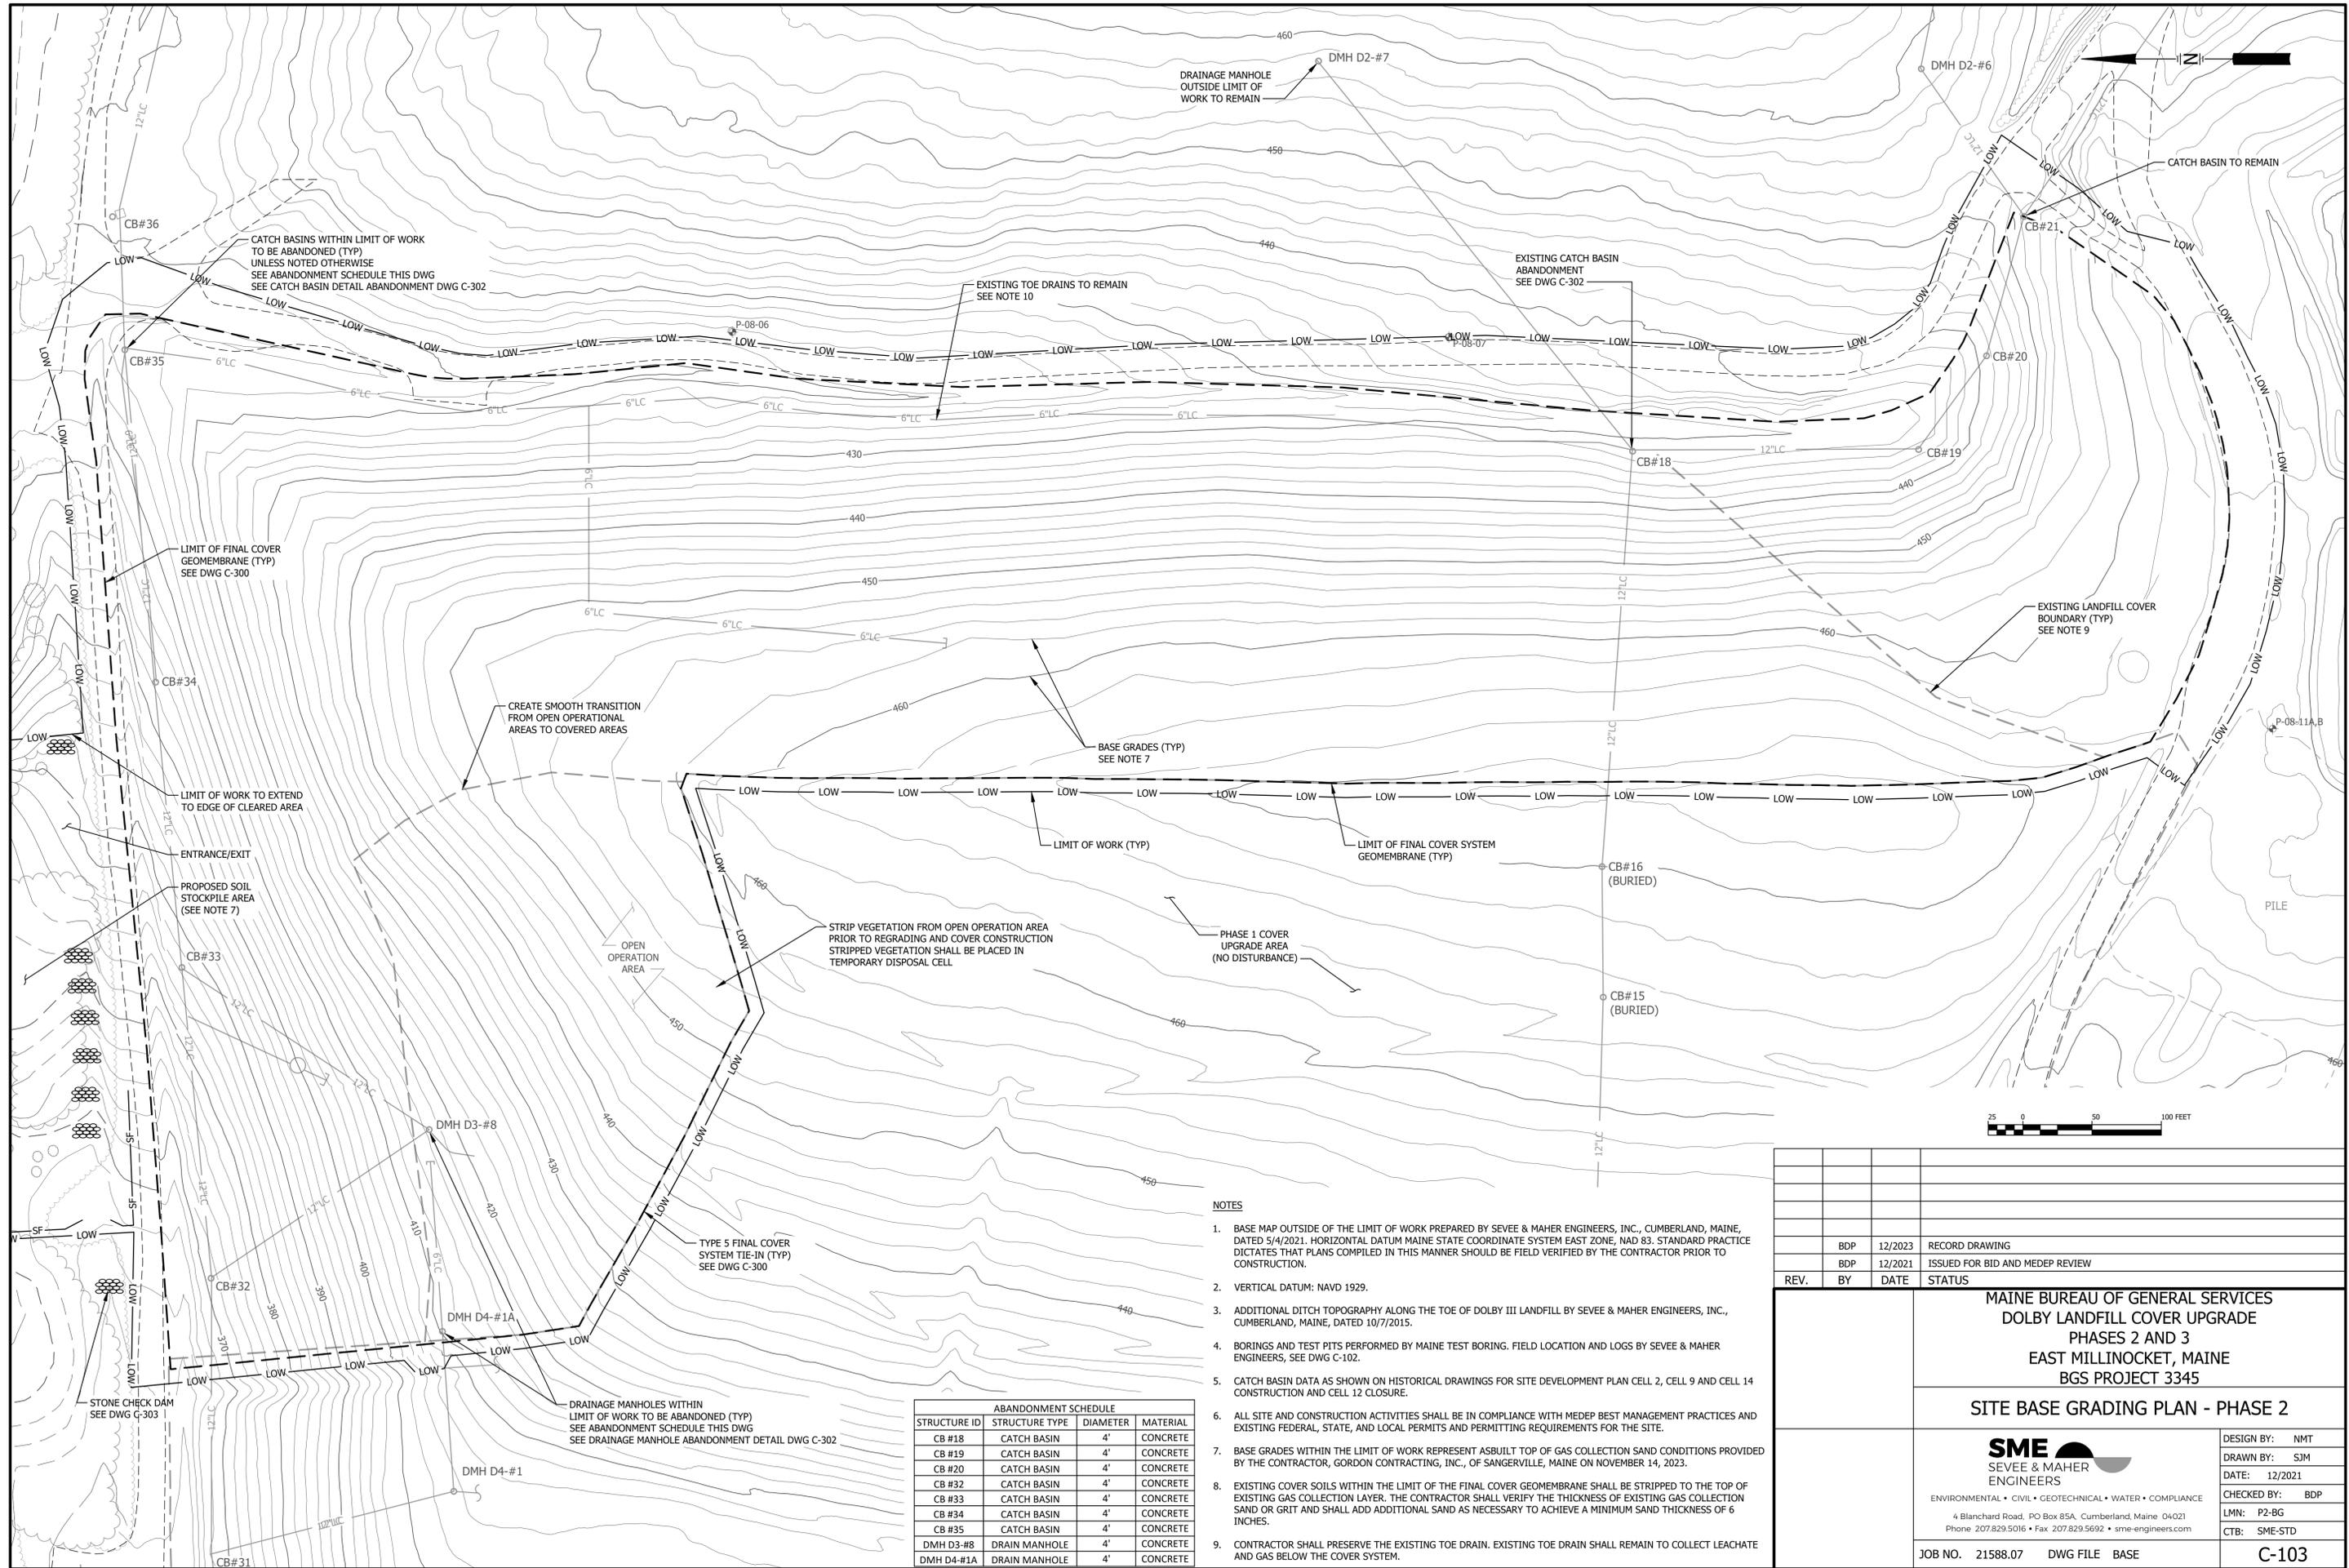

CATCH BASINS WITHIN LIMIT OF WORK TO BE ABANDONED (TYP) UNLESS NOTED OTHERWISE SEE ABANDONMENT SCHEDULE THIS DWG SEE CATCH BASIN DETAIL ABANDONMENT DWG C-302

LIMIT OF FINAL COVER GEOMEMBRANE (TYP) SEE DWG C-300

LIMIT OF WORK TO EXTEND TO EDGE OF CLEARED AREA

ENTRANCE/EXIT

PROPOSED SOIL STOCKPILE AREA (SEE NOTE 7)

STONE CHECK DAM SEE DWG C-303

CREATE SMOOTH TRANSITION FROM OPEN OPERATIONAL AREAS TO COVERED AREAS

EXISTING TOE DRAINS TO REMAIN SEE NOTE 10

EXISTING CATCH BASIN ABANDONMENT SEE DWG C-302

EXISTING LANDFILL COVER BOUNDARY (TYP) SEE NOTE 9

BASE GRADES (TYP) SEE NOTE 7

LIMIT OF WORK (TYP)

LIMIT OF FINAL COVER SYSTEM GEOMEMBRANE (TYP)

STRIP VEGETATION FROM OPEN OPERATION AREA PRIOR TO REGRADING AND COVER CONSTRUCTION STRIPPED VEGETATION SHALL BE PLACED IN TEMPORARY DISPOSAL CELL

PHASE 1 COVER UPGRADE AREA (NO DISTURBANCE)

TYPE 5 FINAL COVER SYSTEM TIE-IN (TYP) SEE DWG C-300

DRAINAGE MANHOLES WITHIN LIMIT OF WORK TO BE ABANDONED (TYP) SEE ABANDONMENT SCHEDULE THIS DWG SEE DRAINAGE MANHOLE ABANDONMENT DETAIL DWG C-302

**NOTES**

1. BASE MAP OUTSIDE OF THE LIMIT OF WORK PREPARED BY SEVEE & MAHER ENGINEERS, INC., CUMBERLAND, MAINE, DATED 5/4/2021. HORIZONTAL DATUM MAINE STATE COORDINATE SYSTEM EAST ZONE, NAD 83. STANDARD PRACTICE DICTATES THAT PLANS COMPILED IN THIS MANNER SHOULD BE FIELD VERIFIED BY THE CONTRACTOR PRIOR TO CONSTRUCTION.
2. VERTICAL DATUM: NAVD 1929.
3. ADDITIONAL DITCH TOPOGRAPHY ALONG THE TOE OF DOLBY III LANDFILL BY SEVEE & MAHER ENGINEERS, INC., CUMBERLAND, MAINE, DATED 10/7/2015.
4. BORINGS AND TEST PITS PERFORMED BY MAINE TEST BORING. FIELD LOCATION AND LOGS BY SEVEE & MAHER ENGINEERS, SEE DWG C-102.
5. CATCH BASIN DATA AS SHOWN ON HISTORICAL DRAWINGS FOR SITE DEVELOPMENT PLAN CELL 2, CELL 9 AND CELL 14 CONSTRUCTION AND CELL 12 CLOSURE.
6. ALL SITE AND CONSTRUCTION ACTIVITIES SHALL BE IN COMPLIANCE WITH MEDEP BEST MANAGEMENT PRACTICES AND EXISTING FEDERAL, STATE, AND LOCAL PERMITS AND PERMITTING REQUIREMENTS FOR THE SITE.
7. BASE GRADES WITHIN THE LIMIT OF WORK REPRESENT ASBUILT TOP OF GAS COLLECTION SAND CONDITIONS PROVIDED BY THE CONTRACTOR, GORDON CONTRACTING, INC., OF SANGERVILLE, MAINE ON NOVEMBER 14, 2023.
8. EXISTING COVER SOILS WITHIN THE LIMIT OF THE FINAL COVER GEOMEMBRANE SHALL BE STRIPPED TO THE TOP OF EXISTING GAS COLLECTION LAYER. THE CONTRACTOR SHALL VERIFY THE THICKNESS OF EXISTING GAS COLLECTION SAND OR GRIT AND SHALL ADD ADDITIONAL SAND AS NECESSARY TO ACHIEVE A MINIMUM SAND THICKNESS OF 6 INCHES.
9. CONTRACTOR SHALL PRESERVE THE EXISTING TOE DRAIN. EXISTING TOE DRAIN SHALL REMAIN TO COLLECT LEACHATE AND GAS BELOW THE COVER SYSTEM.

ABANDONMENT SCHEDULE			
STRUCTURE ID	STRUCTURE TYPE	DIAMETER	MATERIAL
CB #18	CATCH BASIN	4'	CONCRETE
CB #19	CATCH BASIN	4'	CONCRETE
CB #20	CATCH BASIN	4'	CONCRETE
CB #32	CATCH BASIN	4'	CONCRETE
CB #33	CATCH BASIN	4'	CONCRETE
CB #34	CATCH BASIN	4'	CONCRETE
CB #35	CATCH BASIN	4'	CONCRETE
DMH D3-#8	DRAIN MANHOLE	4'	CONCRETE
DMH D4-#1A	DRAIN MANHOLE	4'	CONCRETE

REV.	BY	DATE	STATUS
	BDP	12/2023	RECORD DRAWING
	BDP	12/2021	ISSUED FOR BID AND MEDEP REVIEW

MAINE BUREAU OF GENERAL SERVICES  
 DOLBY LANDFILL COVER UPGRADE  
 PHASES 2 AND 3  
 EAST MILLINOCKET, MAINE  
 BGS PROJECT 3345



**SITE BASE GRADING PLAN - PHASE 2**

**SME**  
 SEVEE & MAHER  
 ENGINEERS  
 ENVIRONMENTAL • CIVIL • GEOTECHNICAL • WATER • COMPLIANCE  
 4 Blanchard Road, PO Box 85A, Cumberland, Maine 04021  
 Phone 207.829.5016 • Fax 207.829.5692 • sme-engineers.com

DESIGN BY: NMT  
 DRAWN BY: SJM  
 DATE: 12/2021  
 CHECKED BY: BDP  
 LMN: P2-BG  
 CTB: SME-STD

JOB NO. 21588.07 DWG FILE BASE **C-103**



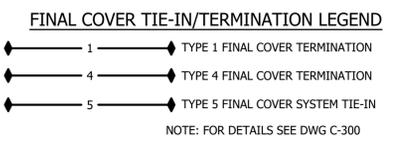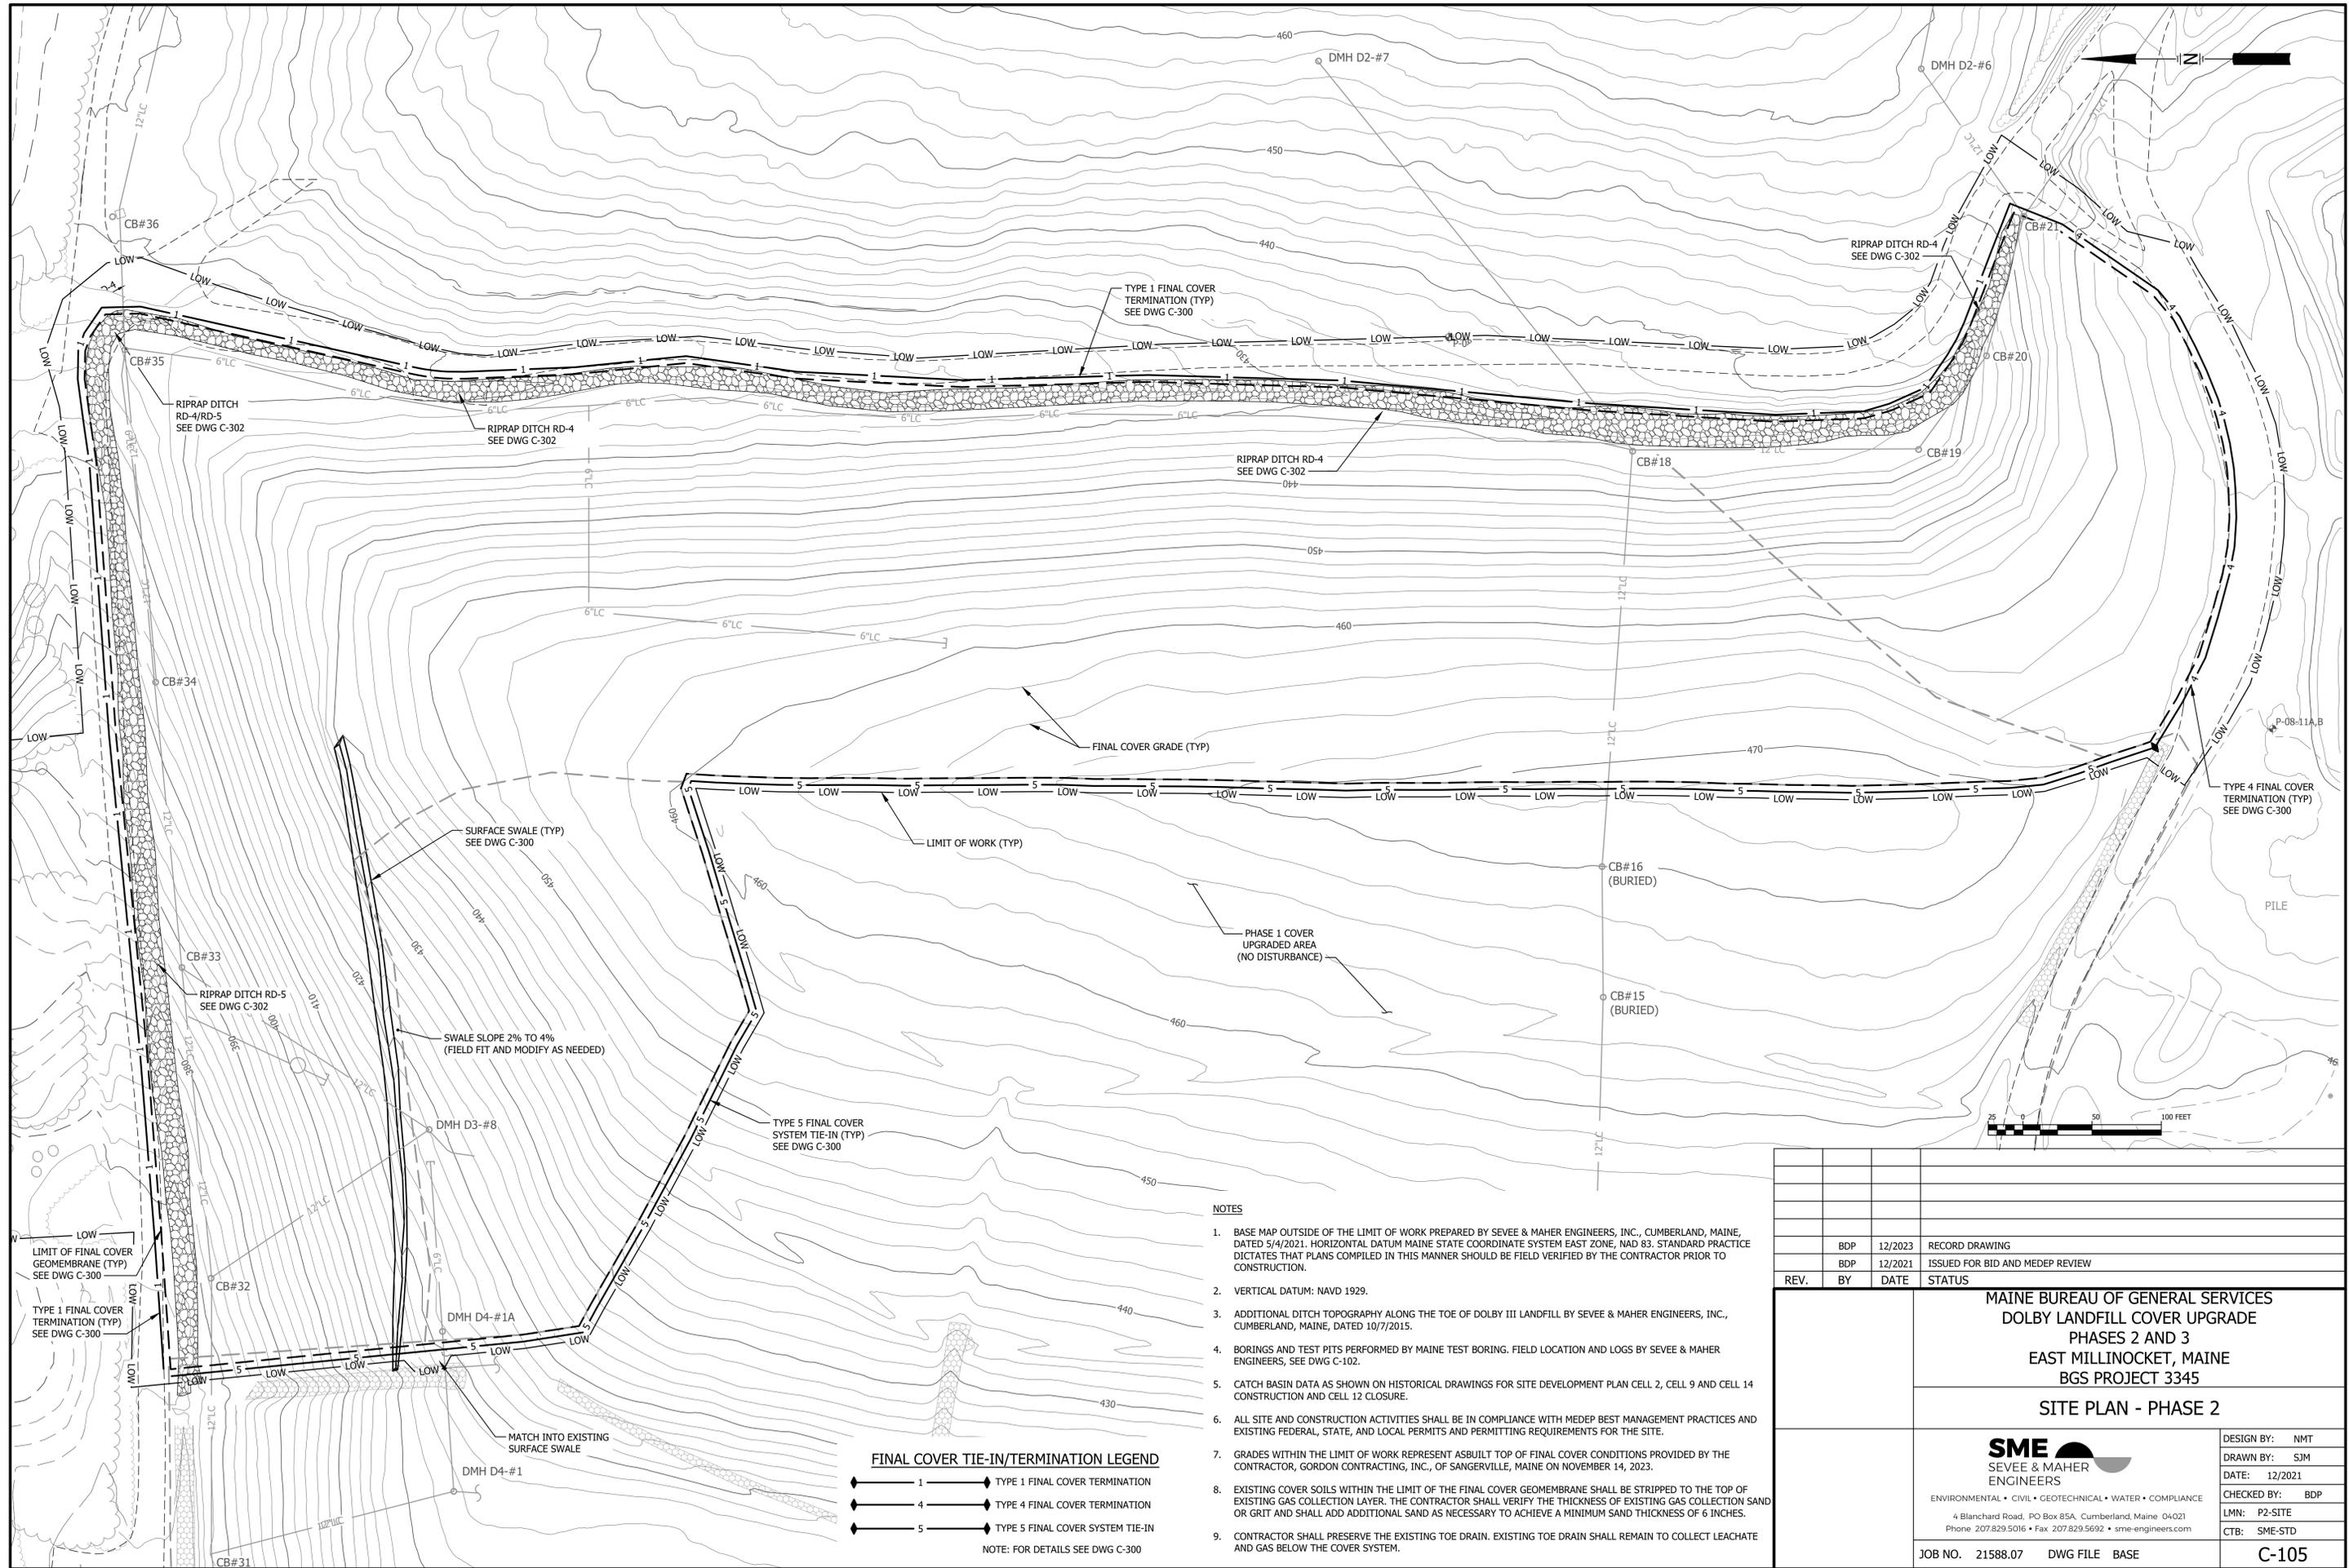

**NOTES**

- BASE MAP OUTSIDE OF THE LIMIT OF WORK PREPARED BY SEVEE & MAHER ENGINEERS, INC., CUMBERLAND, MAINE, DATED 5/4/2021. HORIZONTAL DATUM MAINE STATE COORDINATE SYSTEM EAST ZONE, NAD 83. STANDARD PRACTICE DICTATES THAT PLANS COMPILED IN THIS MANNER SHOULD BE FIELD VERIFIED BY THE CONTRACTOR PRIOR TO CONSTRUCTION.
- VERTICAL DATUM: NAVD 1929.
- ADDITIONAL DITCH TOPOGRAPHY ALONG THE TOE OF DOLBY III LANDFILL BY SEVEE & MAHER ENGINEERS, INC., CUMBERLAND, MAINE, DATED 10/7/2015.
- BORINGS AND TEST PITS PERFORMED BY MAINE TEST BORING. FIELD LOCATION AND LOGS BY SEVEE & MAHER ENGINEERS, SEE DWG C-102.
- CATCH BASIN DATA AS SHOWN ON HISTORICAL DRAWINGS FOR SITE DEVELOPMENT PLAN CELL 2, CELL 9 AND CELL 14 CONSTRUCTION AND CELL 12 CLOSURE.
- ALL SITE AND CONSTRUCTION ACTIVITIES SHALL BE IN COMPLIANCE WITH MEDEP BEST MANAGEMENT PRACTICES AND EXISTING FEDERAL, STATE, AND LOCAL PERMITS AND PERMITTING REQUIREMENTS FOR THE SITE.
- GRADES WITHIN THE LIMIT OF WORK REPRESENT AS BUILT TOP OF FINAL COVER CONDITIONS PROVIDED BY THE CONTRACTOR, GORDON CONTRACTING, INC., OF SANGERVILLE, MAINE ON NOVEMBER 14, 2023.
- EXISTING COVER SOILS WITHIN THE LIMIT OF THE FINAL COVER GEOMEMBRANE SHALL BE STRIPPED TO THE TOP OF EXISTING GAS COLLECTION LAYER. THE CONTRACTOR SHALL VERIFY THE THICKNESS OF EXISTING GAS COLLECTION SAND OR GRIT AND SHALL ADD ADDITIONAL SAND AS NECESSARY TO ACHIEVE A MINIMUM SAND THICKNESS OF 6 INCHES.
- CONTRACTOR SHALL PRESERVE THE EXISTING TOE DRAIN. EXISTING TOE DRAIN SHALL REMAIN TO COLLECT LEACHATE AND GAS BELOW THE COVER SYSTEM.


REV.	BY	DATE	STATUS
	BDP	12/2023	RECORD DRAWING
	BDP	12/2021	ISSUED FOR BID AND MEDEP REVIEW

<b>MAINE BUREAU OF GENERAL SERVICES</b> <b>DOLBY LANDFILL COVER UPGRADE</b> <b>PHASES 2 AND 3</b> <b>EAST MILLINOCKET, MAINE</b> <b>BGS PROJECT 3345</b> <b>SITE PLAN - PHASE 2</b>	
 <b>SEVEE &amp; MAHER ENGINEERS</b> <small>ENVIRONMENTAL • CIVIL • GEOTECHNICAL • WATER • COMPLIANCE</small> <small>4 Blanchard Road, PO Box 85A, Cumberland, Maine 04021</small> <small>Phone 207.829.5016 • Fax 207.829.5692 • sme-engineers.com</small>	DESIGN BY: NMT DRAWN BY: SJM DATE: 12/2021 CHECKED BY: BDP LMN: P2-SITE CTB: SME-STD
JOB NO. 21588.07    DWG FILE BASE	<b>C-105</b>

N:\work\2023\21588.07\PHASE2\DWG\C-105.dwg, C:\E:\202303\21588.07.dwg



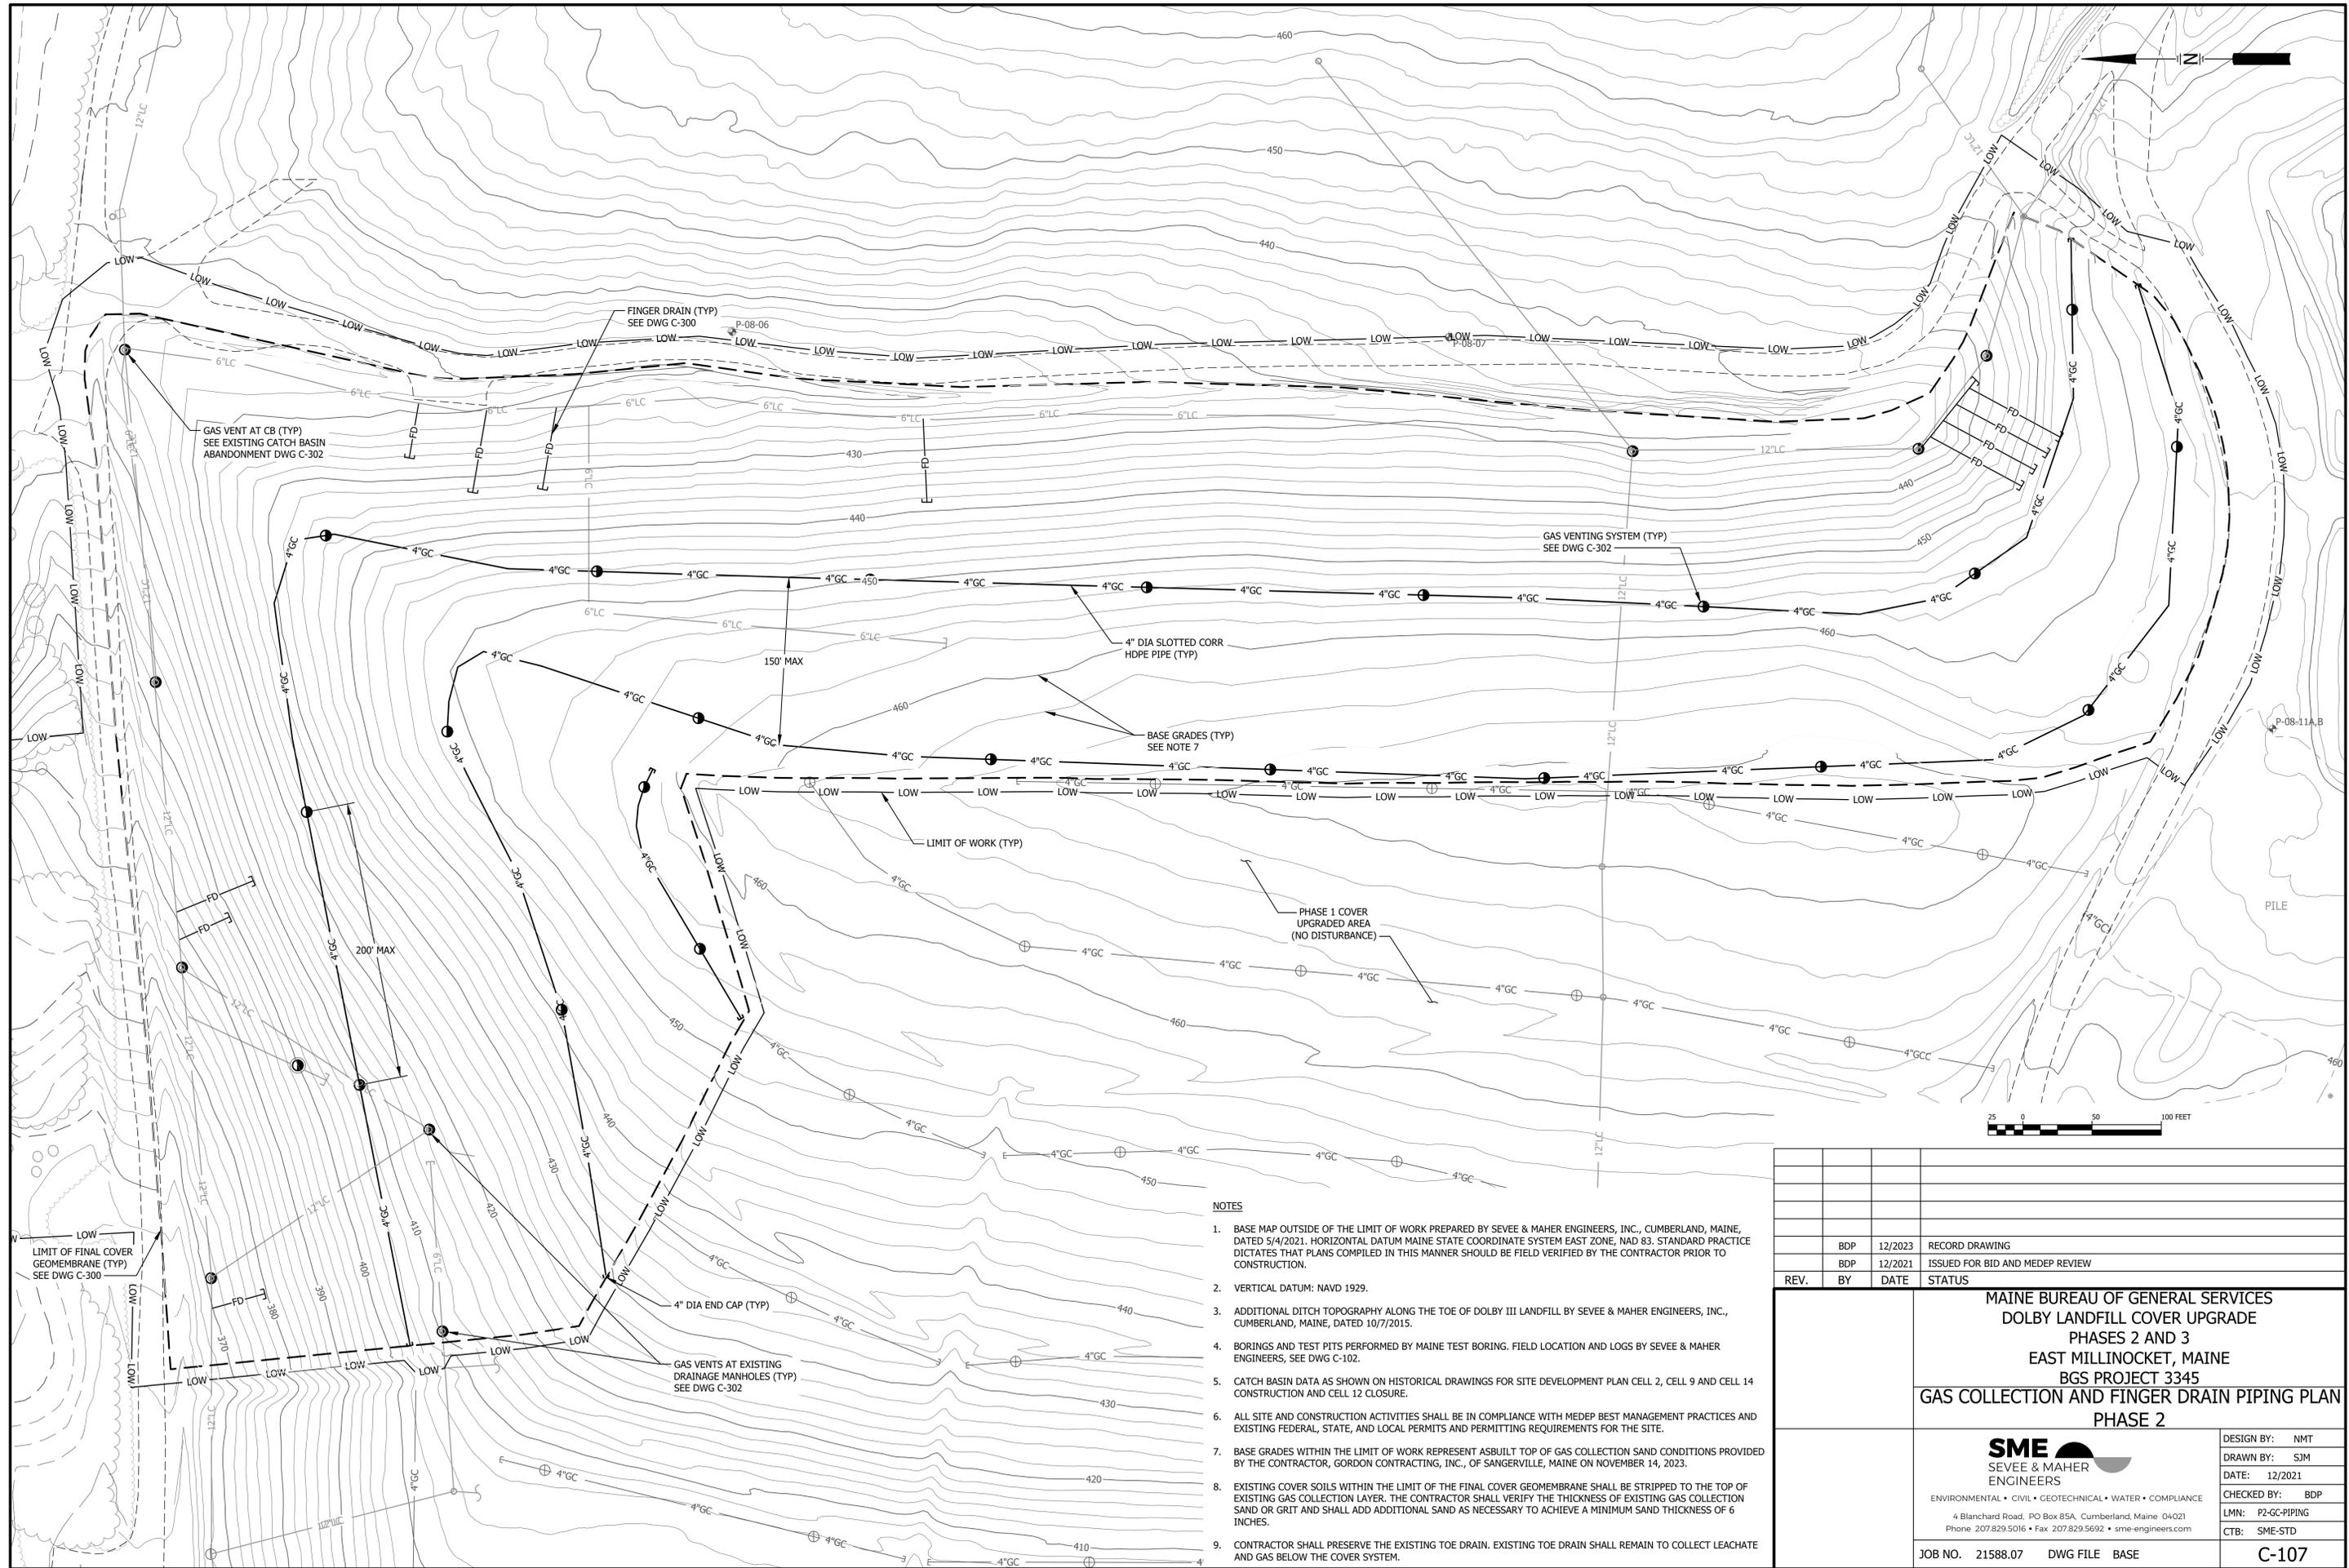

- NOTES**
1. BASE MAP OUTSIDE OF THE LIMIT OF WORK PREPARED BY SEVEE & MAHER ENGINEERS, INC., CUMBERLAND, MAINE, DATED 5/4/2021. HORIZONTAL DATUM MAINE STATE COORDINATE SYSTEM EAST ZONE, NAD 83. STANDARD PRACTICE DICTATES THAT PLANS COMPILED IN THIS MANNER SHOULD BE FIELD VERIFIED BY THE CONTRACTOR PRIOR TO CONSTRUCTION.
  2. VERTICAL DATUM: NAVD 1929.
  3. ADDITIONAL DITCH TOPOGRAPHY ALONG THE TOE OF DOLBY III LANDFILL BY SEVEE & MAHER ENGINEERS, INC., CUMBERLAND, MAINE, DATED 10/7/2015.
  4. BORINGS AND TEST PITS PERFORMED BY MAINE TEST BORING. FIELD LOCATION AND LOGS BY SEVEE & MAHER ENGINEERS, SEE DWG C-102.
  5. CATCH BASIN DATA AS SHOWN ON HISTORICAL DRAWINGS FOR SITE DEVELOPMENT PLAN CELL 2, CELL 9 AND CELL 14 CONSTRUCTION AND CELL 12 CLOSURE.
  6. ALL SITE AND CONSTRUCTION ACTIVITIES SHALL BE IN COMPLIANCE WITH MEDEP BEST MANAGEMENT PRACTICES AND EXISTING FEDERAL, STATE, AND LOCAL PERMITS AND PERMITTING REQUIREMENTS FOR THE SITE.
  7. BASE GRADES WITHIN THE LIMIT OF WORK REPRESENT ASBUILT TOP OF GAS COLLECTION SAND CONDITIONS PROVIDED BY THE CONTRACTOR, GORDON CONTRACTING, INC., OF SANGERVILLE, MAINE ON NOVEMBER 14, 2023.
  8. EXISTING COVER SOILS WITHIN THE LIMIT OF THE FINAL COVER GEOMEMBRANE SHALL BE STRIPPED TO THE TOP OF EXISTING GAS COLLECTION LAYER. THE CONTRACTOR SHALL VERIFY THE THICKNESS OF EXISTING GAS COLLECTION SAND OR GRIT AND SHALL ADD ADDITIONAL SAND AS NECESSARY TO ACHIEVE A MINIMUM SAND THICKNESS OF 6 INCHES.
  9. CONTRACTOR SHALL PRESERVE THE EXISTING TOE DRAIN. EXISTING TOE DRAIN SHALL REMAIN TO COLLECT LEACHATE AND GAS BELOW THE COVER SYSTEM.

BDP	12/2023	RECORD DRAWING	
BDP	12/2021	ISSUED FOR BID AND MEDEP REVIEW	
REV.	BY	DATE	STATUS


**MAINE BUREAU OF GENERAL SERVICES**  
**DOLBY LANDFILL COVER UPGRADE**  
**PHASES 2 AND 3**  
**EAST MILLINOCKET, MAINE**  
**BGS PROJECT 3345**  
**GAS COLLECTION AND FINGER DRAIN PIPING PLAN**  
**PHASE 2**

DESIGN BY:	NMT
DRAWN BY:	SJM
DATE:	12/2021
CHECKED BY:	BDP
LMN:	P2-GC-PIPING
CTB:	SME-STD

**SME SEVEE & MAHER ENGINEERS**  
 ENVIRONMENTAL • CIVIL • GEOTECHNICAL • WATER • COMPLIANCE  
 4 Blanchard Road, PO Box 85A, Cumberland, Maine 04021  
 Phone 207.829.5016 • Fax 207.829.5692 • sme-engineers.com

JOB NO. 21588.07    DWG FILE BASE    **C-107**

N:\work\4100\GIS\DWG\PHASE2\PHASE2\_PIPING.dwg, C:\01\_12122023\_121231.PN

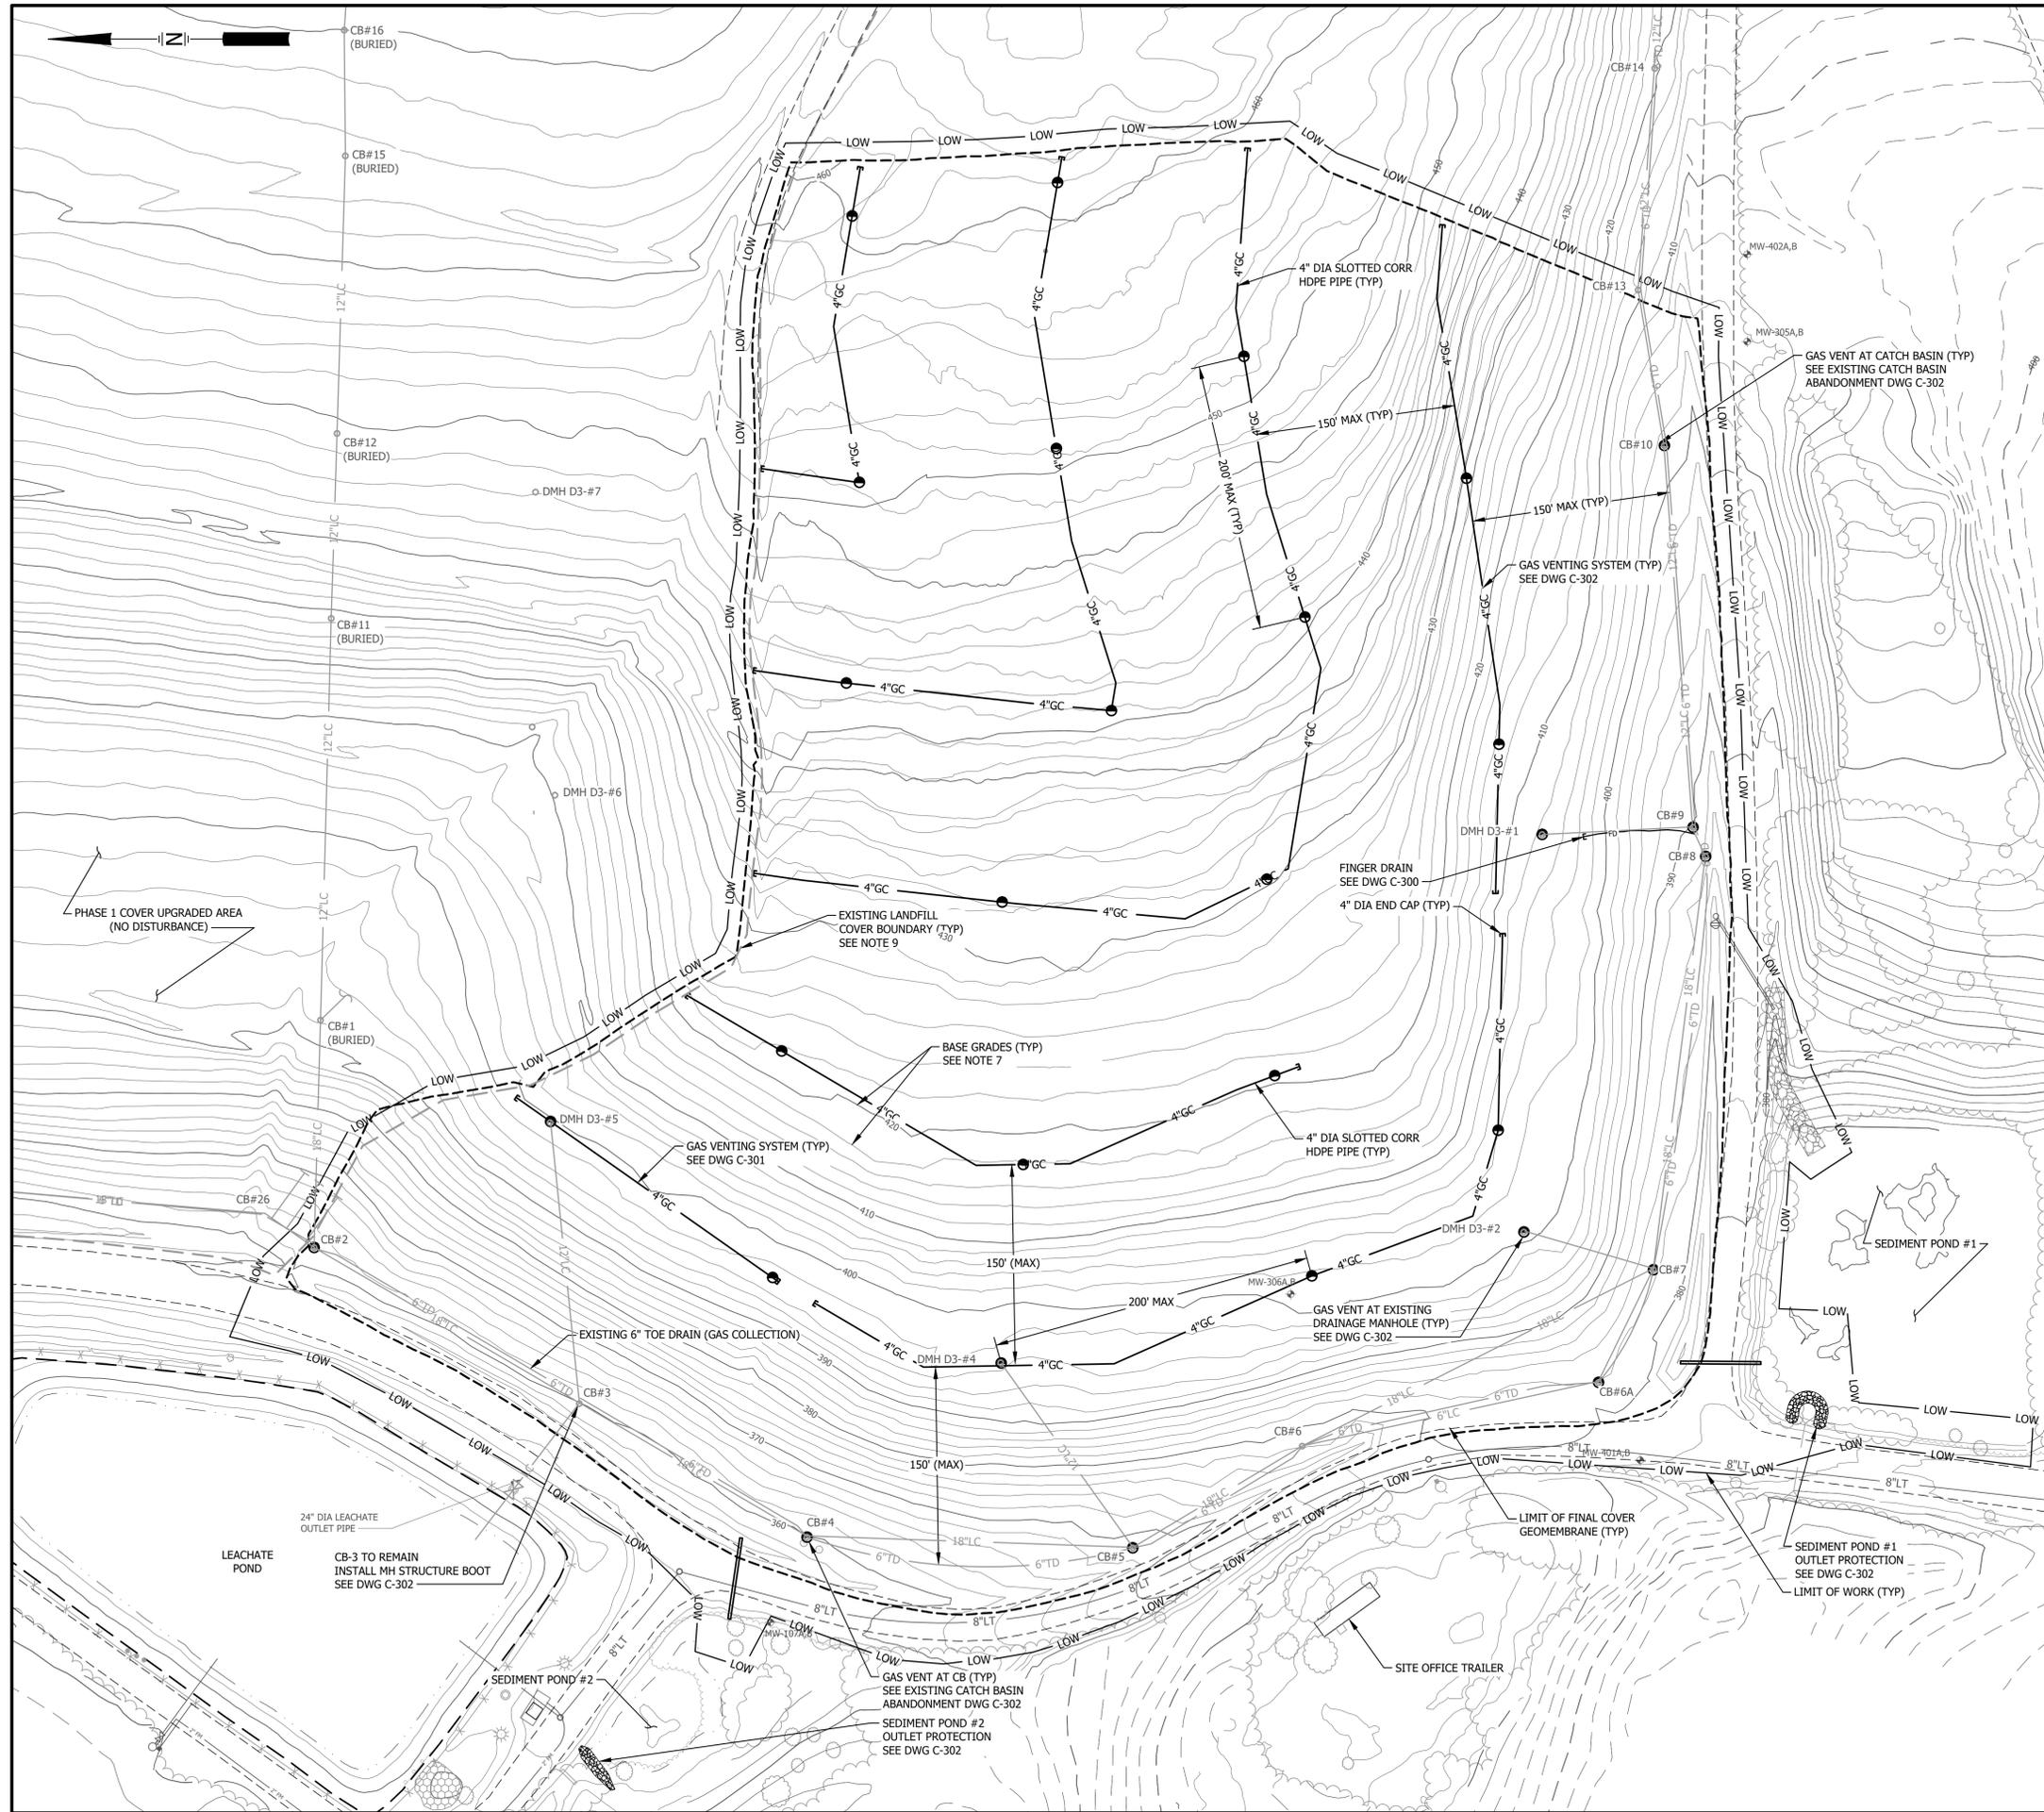

- NOTES**
1. BASE MAP OUTSIDE OF THE LIMIT OF WORK PREPARED BY SEVEE & MAHER ENGINEERS, INC., CUMBERLAND, MAINE, DATED 5/4/2021. HORIZONTAL DATUM MAINE STATE COORDINATE SYSTEM EAST ZONE, NAD 83. STANDARD PRACTICE DICTATES THAT PLANS COMPILED IN THIS MANNER SHOULD BE FIELD VERIFIED BY THE CONTRACTOR PRIOR TO CONSTRUCTION.
  2. VERTICAL DATUM: NAVD 1929.
  3. ADDITIONAL DITCH TOPOGRAPHY ALONG THE TOE OF DOLBY III LANDFILL BY SEVEE & MAHER ENGINEERS, INC., CUMBERLAND, MAINE, DATED 10/7/2015.
  4. BORINGS AND TEST PITS PERFORMED BY MAINE TEST BORING. FIELD LOCATION AND LOGS BY SEVEE & MAHER ENGINEERS, SEE DWG C-102.
  5. CATCH BASIN DATA AS SHOWN ON HISTORICAL DRAWINGS FOR SITE DEVELOPMENT PLAN CELL 2, CELL 9 AND CELL 14 CONSTRUCTION AND CELL 12 CLOSURE.
  6. ALL SITE AND CONSTRUCTION ACTIVITIES SHALL BE IN COMPLIANCE WITH MEDEP BEST MANAGEMENT PRACTICES AND EXISTING FEDERAL, STATE, AND LOCAL PERMITS AND PERMITTING REQUIREMENTS FOR THE SITE.
  7. BASE GRADES WITHIN THE LIMIT OF WORK REPRESENT ASBUILT TOP OF GAS COLLECTION SAND CONDITIONS PROVIDED BY THE CONTRACTOR, GORDON CONTRACTING, INC., OF SANGERVILLE, MAINE ON NOVEMBER 14, 2023.
  8. EXISTING COVER SOILS WITHIN THE LIMIT OF THE FINAL COVER GEOMEMBRANE SHALL BE STRIPPED TO THE TOP OF EXISTING GAS COLLECTION LAYER. THE CONTRACTOR SHALL VERIFY THE THICKNESS OF EXISTING GAS COLLECTION SAND OR GRIT AND SHALL ADD ADDITIONAL SAND AS NECESSARY TO ACHIEVE A MINIMUM SAND THICKNESS OF 6 INCHES.
  9. CONTRACTOR SHALL PRESERVE THE EXISTING TOE DRAIN. EXISTING TOE DRAIN SHALL REMAIN TO COLLECT LEACHATE AND GAS BELOW THE COVER SYSTEM.




REV.	BY	DATE	STATUS
BDP	12/2023		RECORD DRAWING
BDP	12/2021		ADDENDUM #1
BDP	12/2021		ISSUED FOR BID AND MEDEP REVIEW

**MAINE BUREAU OF GENERAL SERVICES  
DOLBY LANDFILL COVER UPGRADE  
PHASES 2 AND 3  
EAST MILLINOCKET, MAINE  
BGS PROJECT 3345  
GAS COLLECTION AND FINGER DRAIN PIPING PLAN  
PHASE 3**

 <small>ENVIRONMENTAL • CIVIL • GEOTECHNICAL • WATER • COMPLIANCE</small> <small>4 Blanchard Road, PO Box 85A, Cumberland, Maine 04021</small> <small>Phone 207.829.5016 • Fax 207.829.5692 • sme-engineers.com</small>	DESIGN BY: BDP
	DRAWN BY: SJM
	DATE: 12/2021
	CHECKED BY: BDP
LMN: P3-GC/PIPING	
CTB: SME-STD	
JOB NO. 21588.07 DWG FILE BASE	
<b>C-108</b>	

\\sme\work\2023\21588.07\PHASE3\DWG\C-108.dwg, C:\08\_122023\21588.07.dwg

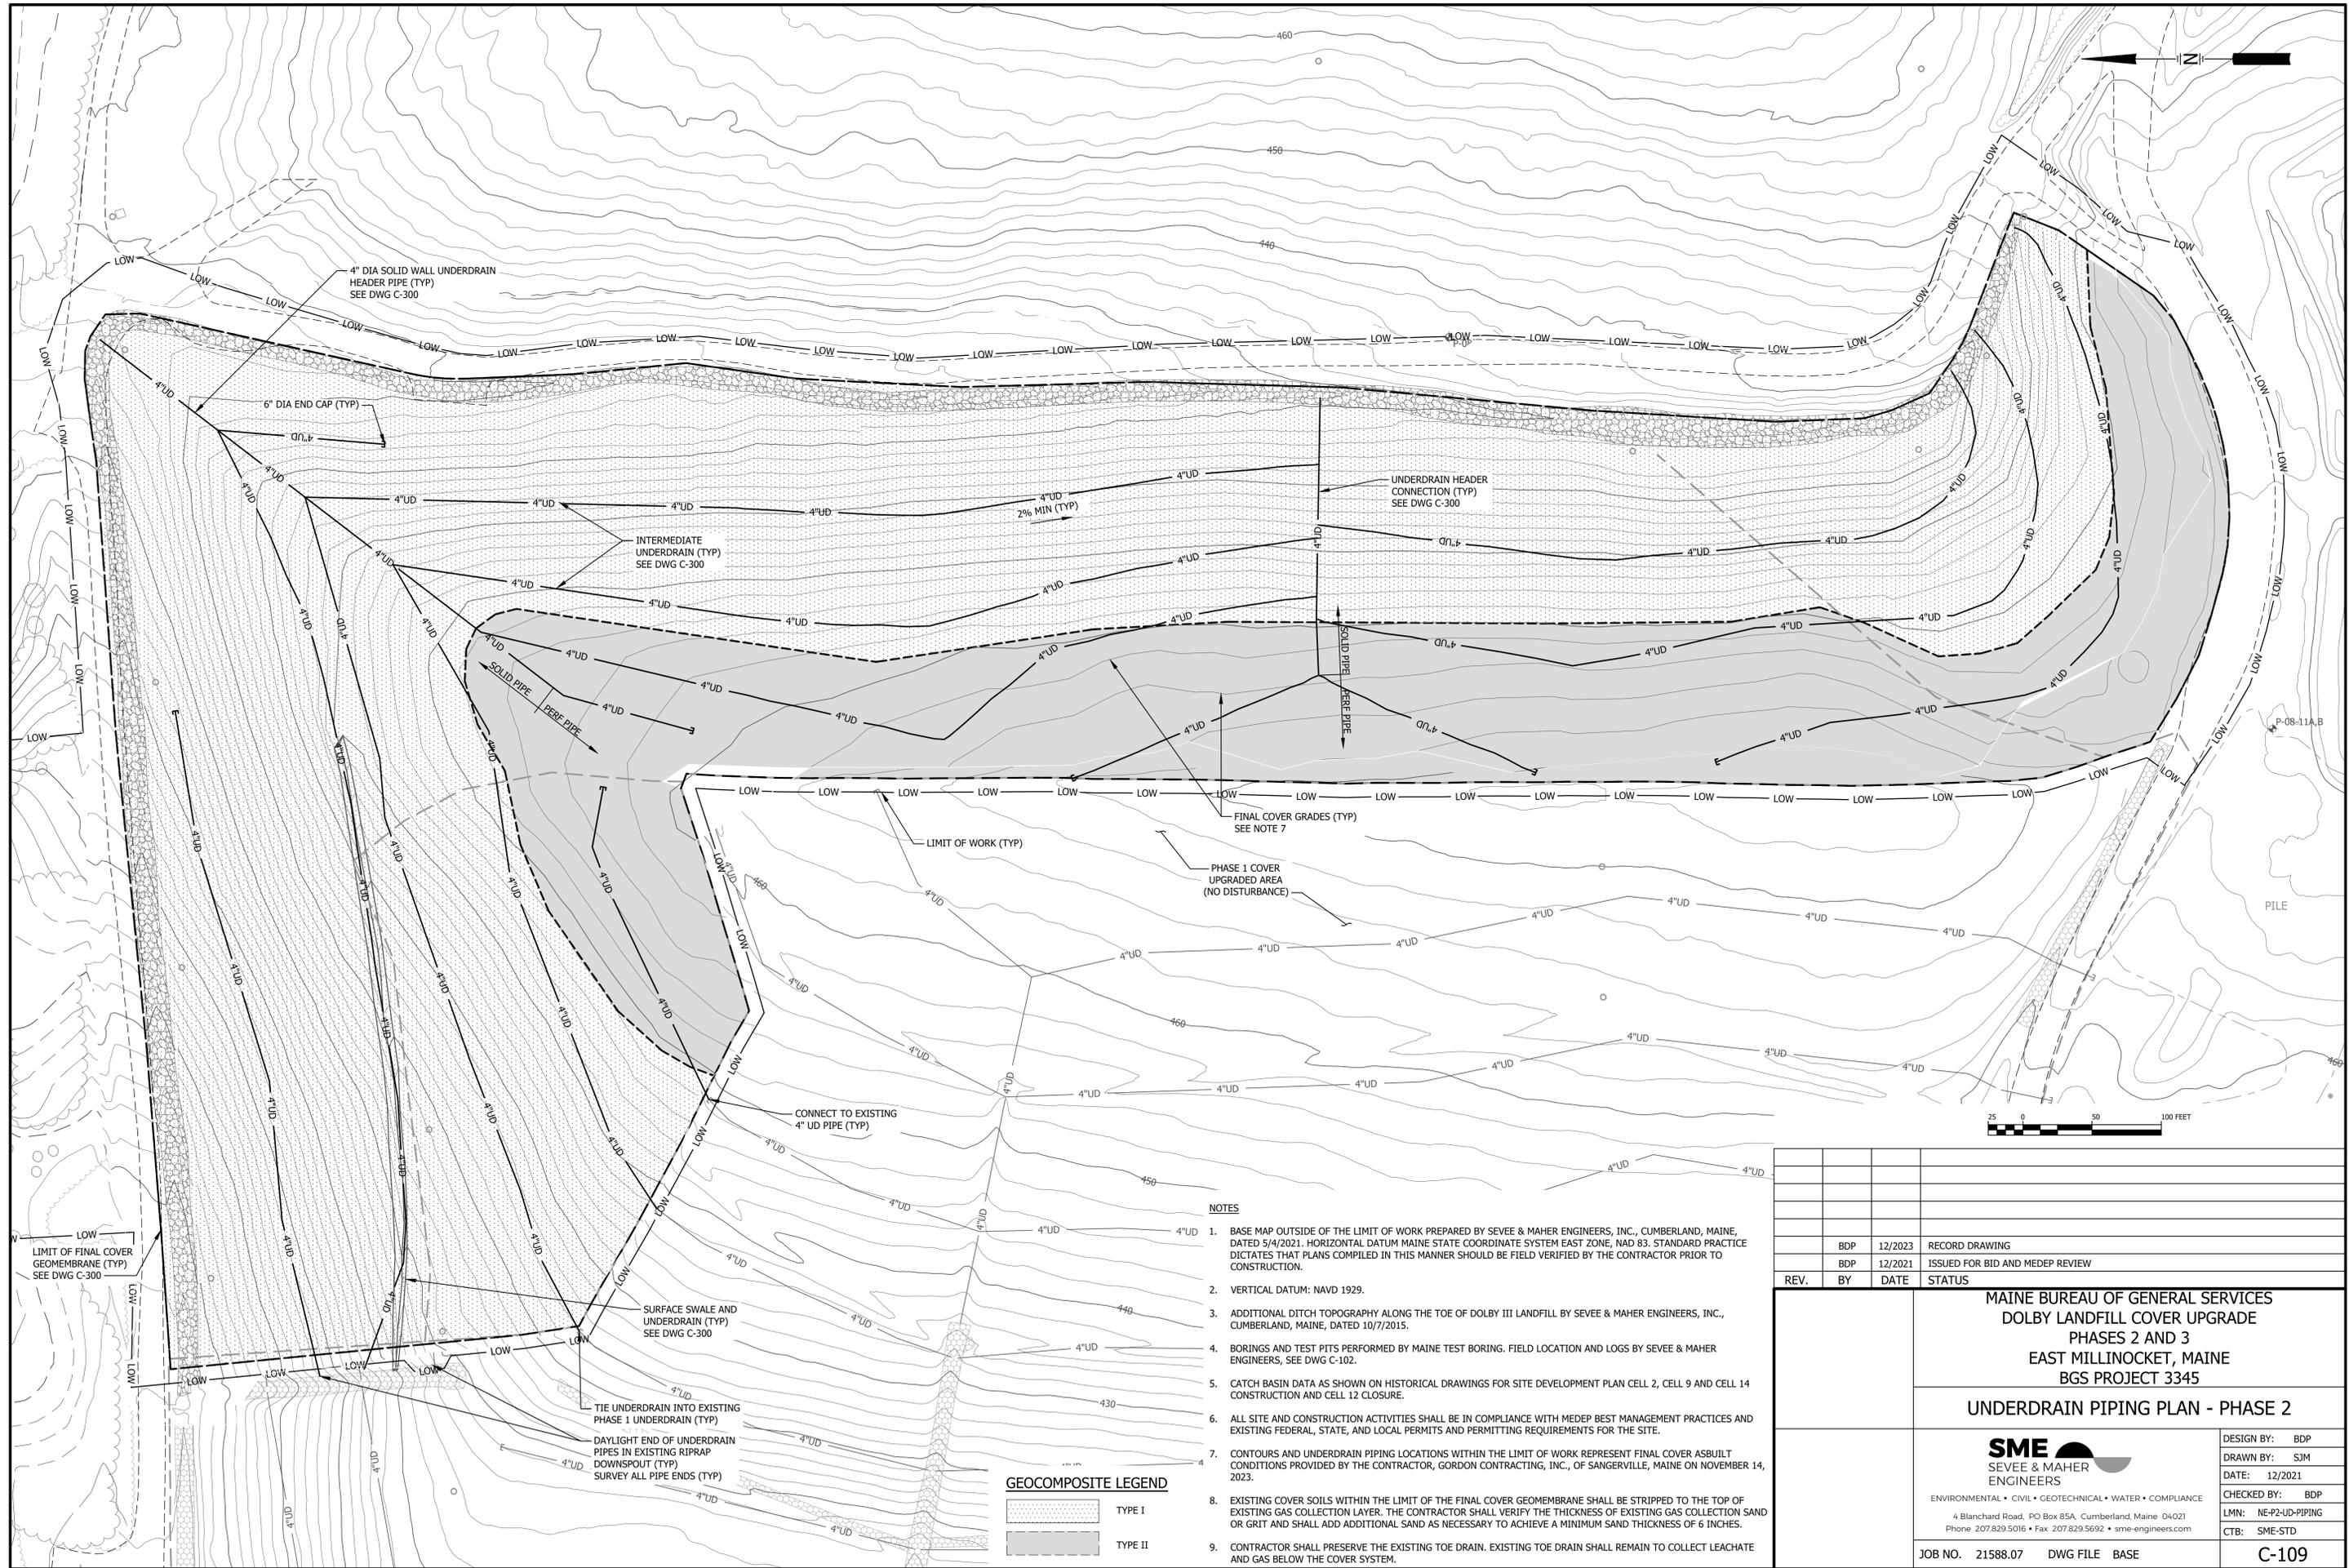

**GEOCOMPOSITE LEGEND**

	TYPE I
	TYPE II

**NOTES**

1. BASE MAP OUTSIDE OF THE LIMIT OF WORK PREPARED BY SEVEE & MAHER ENGINEERS, INC., CUMBERLAND, MAINE, DATED 5/4/2021. HORIZONTAL DATUM MAINE STATE COORDINATE SYSTEM EAST ZONE, NAD 83. STANDARD PRACTICE DICTATES THAT PLANS COMPILED IN THIS MANNER SHOULD BE FIELD VERIFIED BY THE CONTRACTOR PRIOR TO CONSTRUCTION.
2. VERTICAL DATUM: NAVD 1929.
3. ADDITIONAL DITCH TOPOGRAPHY ALONG THE TOE OF DOLBY III LANDFILL BY SEVEE & MAHER ENGINEERS, INC., CUMBERLAND, MAINE, DATED 10/7/2015.
4. BORINGS AND TEST PITS PERFORMED BY MAINE TEST BORING. FIELD LOCATION AND LOGS BY SEVEE & MAHER ENGINEERS, SEE DWG C-102.
5. CATCH BASIN DATA AS SHOWN ON HISTORICAL DRAWINGS FOR SITE DEVELOPMENT PLAN CELL 2, CELL 9 AND CELL 14 CONSTRUCTION AND CELL 12 CLOSURE.
6. ALL SITE AND CONSTRUCTION ACTIVITIES SHALL BE IN COMPLIANCE WITH MEDEP BEST MANAGEMENT PRACTICES AND EXISTING FEDERAL, STATE, AND LOCAL PERMITS AND PERMITTING REQUIREMENTS FOR THE SITE.
7. CONTOURS AND UNDERDRAIN PIPING LOCATIONS WITHIN THE LIMIT OF WORK REPRESENT FINAL COVER ASBUILT CONDITIONS PROVIDED BY THE CONTRACTOR, GORDON CONTRACTING, INC., OF SANGERVILLE, MAINE ON NOVEMBER 14, 2023.
8. EXISTING COVER SOILS WITHIN THE LIMIT OF THE FINAL COVER GEOMEMBRANE SHALL BE STRIPPED TO THE TOP OF EXISTING GAS COLLECTION LAYER. THE CONTRACTOR SHALL VERIFY THE THICKNESS OF EXISTING GAS COLLECTION SAND OR GRIT AND SHALL ADD ADDITIONAL SAND AS NECESSARY TO ACHIEVE A MINIMUM SAND THICKNESS OF 6 INCHES.
9. CONTRACTOR SHALL PRESERVE THE EXISTING TOE DRAIN. EXISTING TOE DRAIN SHALL REMAIN TO COLLECT LEACHATE AND GAS BELOW THE COVER SYSTEM.

REV.	BY	DATE	STATUS
	BDP	12/2023	RECORD DRAWING
	BDP	12/2021	ISSUED FOR BID AND MEDEP REVIEW

MAINE BUREAU OF GENERAL SERVICES  
 DOLBY LANDFILL COVER UPGRADE  
 PHASES 2 AND 3  
 EAST MILLINOCKET, MAINE  
 BGS PROJECT 3345

**UNDERDRAIN PIPING PLAN - PHASE 2**

**SME**  
 SEVEE & MAHER  
 ENGINEERS  
 ENVIRONMENTAL • CIVIL • GEOTECHNICAL • WATER • COMPLIANCE  
 4 Blanchard Road, PO Box 85A, Cumberland, Maine 04021  
 Phone 207.829.5016 • Fax 207.829.5692 • sme-engineers.com

DESIGN BY: BDP  
 DRAWN BY: SJM  
 DATE: 12/2021  
 CHECKED BY: BDP  
 LMN: NE-P2-UD-PIPING  
 CTB: SME-STD



JOB NO. 21588.07 DWG FILE BASE **C-109**



**NOTES**

1. BASE MAP OUTSIDE OF THE LIMIT OF WORK PREPARED BY SEVEE & MAHER ENGINEERS, INC., CUMBERLAND, MAINE, DATED 5/4/2021. HORIZONTAL DATUM MAINE STATE COORDINATE SYSTEM EAST ZONE, NAD 83. STANDARD PRACTICE DICTATES THAT PLANS COMPILED IN THIS MANNER SHOULD BE FIELD VERIFIED BY THE CONTRACTOR PRIOR TO CONSTRUCTION.
2. VERTICAL DATUM: NAVD 1929.
3. ADDITIONAL DITCH TOPOGRAPHY ALONG THE TOE OF DOLBY III LANDFILL BY SEVEE & MAHER ENGINEERS, INC., CUMBERLAND, MAINE, DATED 10/7/2015.
4. BORINGS AND TEST PITS PERFORMED BY MAINE TEST BORING. FIELD LOCATION AND LOGS BY SEVEE & MAHER ENGINEERS, SEE DWG C-102.
5. CATCH BASIN DATA AS SHOWN ON HISTORICAL DRAWINGS FOR SITE DEVELOPMENT PLAN CELL 2, CELL 9 AND CELL 14 CONSTRUCTION AND CELL 12 CLOSURE.
6. ALL SITE AND CONSTRUCTION ACTIVITIES SHALL BE IN COMPLIANCE WITH MEDEP BEST MANAGEMENT PRACTICES AND EXISTING FEDERAL, STATE, AND LOCAL PERMITS AND PERMITTING REQUIREMENTS FOR THE SITE.
7. CONTOURS AND UNDERDRAIN PIPING LOCATIONS WITHIN THE LIMIT OF WORK REPRESENT FINAL COVER ASBUILT CONDITIONS PROVIDED BY THE CONTRACTOR, GORDON CONTRACTING, INC., OF SANGERVILLE, MAINE ON NOVEMBER 14, 2023.
8. EXISTING COVER SOILS WITHIN THE LIMIT OF THE FINAL COVER GEOMEMBRANE SHALL BE STRIPPED TO THE TOP OF EXISTING GAS COLLECTION LAYER. THE CONTRACTOR SHALL VERIFY THE THICKNESS OF EXISTING GAS COLLECTION SAND OR GRIT AND SHALL ADD ADDITIONAL SAND AS NECESSARY TO ACHIEVE A MINIMUM SAND THICKNESS OF 6 INCHES.
9. CONTRACTOR SHALL PRESERVE THE EXISTING TOE DRAIN. EXISTING TOE DRAIN SHALL REMAIN TO COLLECT LEACHATE AND GAS BELOW THE COVER SYSTEM.


**GEOCOMPOSITE LEGEND**

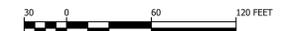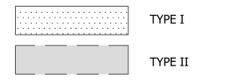


REV.	BY	DATE	STATUS
BDP		12/2023	RECORD DRAWING
BDP		12/2021	ADDENDUM #1
BDP		12/2021	ISSUED FOR BID AND MEDEP REVIEW

<b>MAINE BUREAU OF GENERAL SERVICES</b> <b>DOLBY LANDFILL COVER UPGRADE</b> <b>PHASES 2 AND 3</b> <b>EAST MILLINOCKET, MAINE</b> <b>BGS PROJECT 3345</b>	
<b>UNDERDRAIN PIPING PLAN - PHASE 3</b>	
 <small>ENVIRONMENTAL • CIVIL • GEOTECHNICAL • WATER • COMPLIANCE</small> <small>4 Blanchard Road, PO Box 85A, Cumberland, Maine 04021</small> <small>Phone 207.829.5016 • Fax 207.829.5692 • sme-engineers.com</small>	DESIGN BY: BDP DRAWN BY: SJM DATE: 12/2021 CHECKED BY: BDP LMN: P3-UDPIPING CTB: SME-STD
JOB NO. 21588.07    DWG FILE BASE	<b>C-110</b>


N:\work\401025\F01\0401025\F01\Phase 3\UnderdrainPipingPhase3.dwg, C:\10\_122023\1041025.dwg

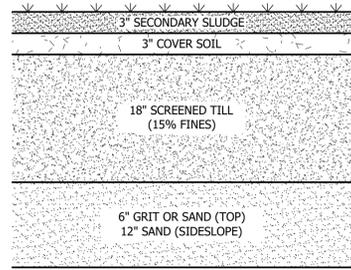


**DOLBY III - EXISTING COVER 1**  
NTS

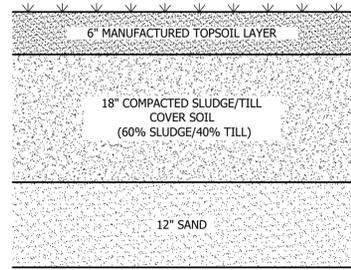


**DOLBY III - EXISTING COVER 2**  
NTS

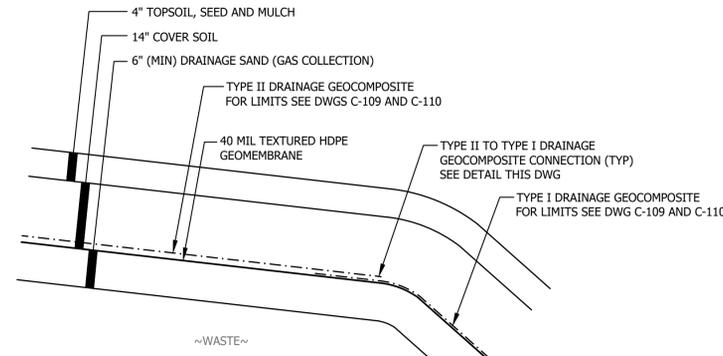


**FINAL COVER SYSTEM**  
NTS

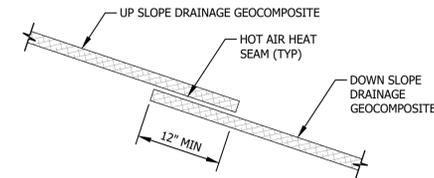


**TYPE II TO TYPE I DRAINAGE GEOCOMPOSITE CONNECTION**  
NTS

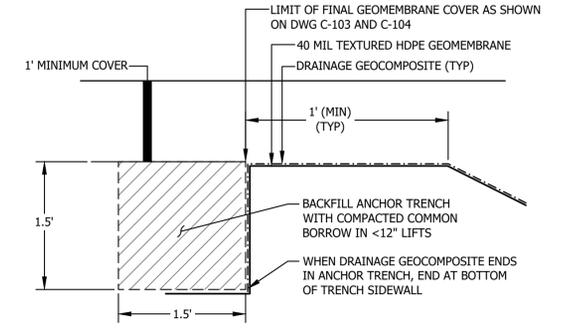


**ANCHOR TRENCH**  
NTS

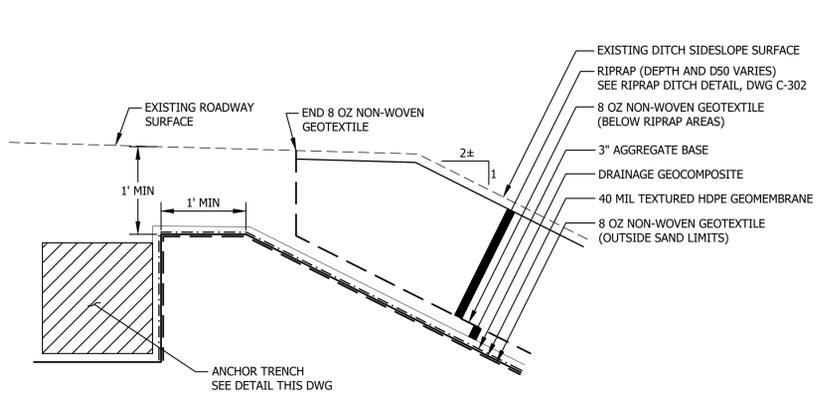


**TYPE 1 FINAL COVER TERMINATION**  
NTS

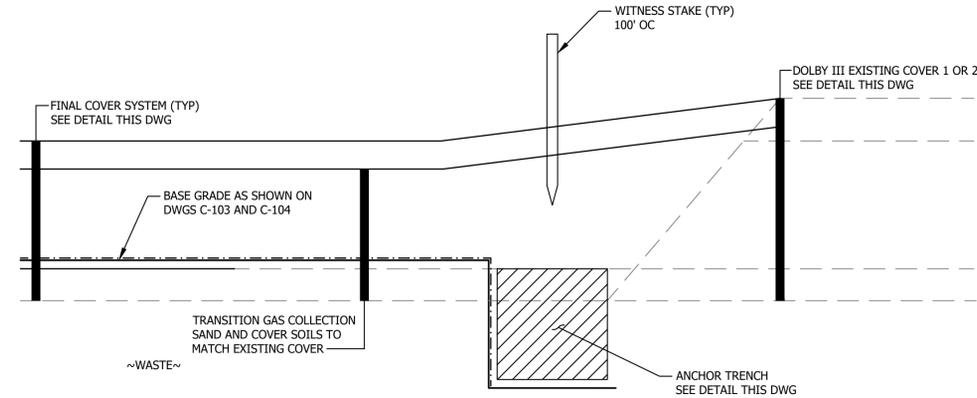


**TYPE 4 FINAL COVER TERMINATION**  
NTS

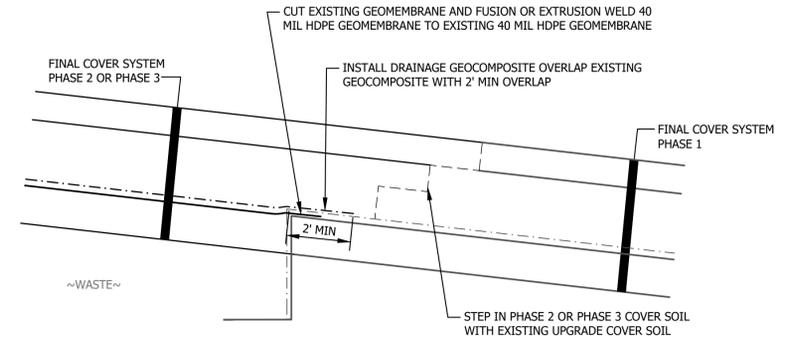


**TYPE 5 FINAL COVER SYSTEM TIE-IN**  
NTS

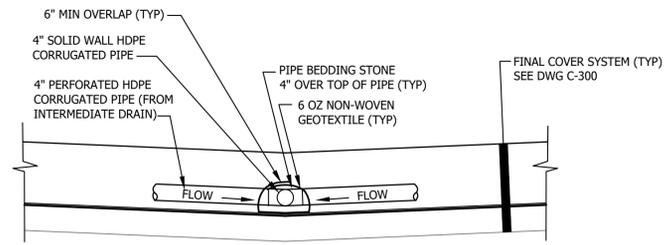


**UNDERDRAIN HEADER PIPE**  
NTS

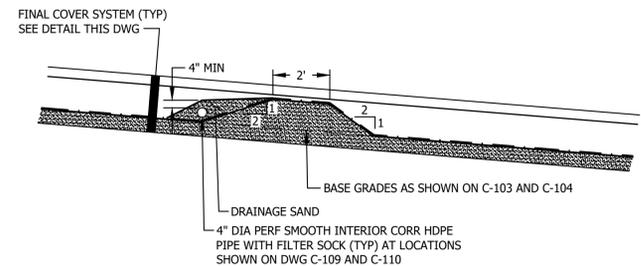


**INTERMEDIATE UNDERDRAIN**  
NTS

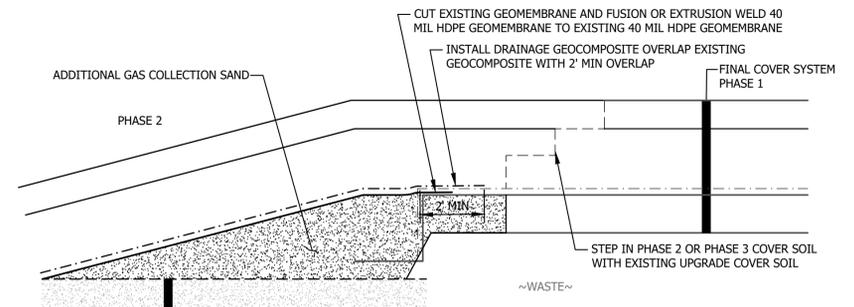

**TYPE 5 FINAL COVER SYSTEM GAS COLLECTION SAND TIE-IN**  
NTS

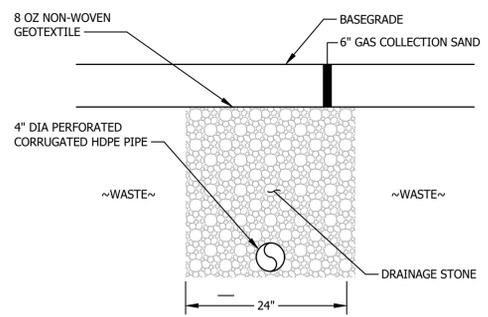

**FINGER DRAIN**  
NTS

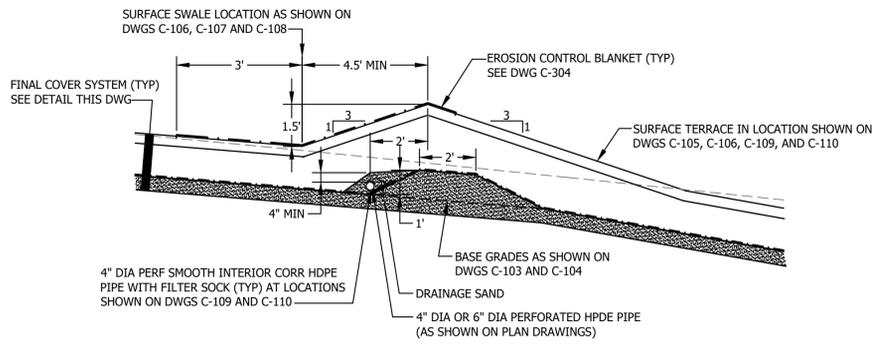

**SURFACE SWALE AND UNDERDRAIN**  
NTS

REV.	BY	DATE	STATUS
BDP	12/2023	RECORD DRAWING	
BDP	12/2021	ISSUED FOR BID AND MEDEP REVIEW	


**MAINE BUREAU OF GENERAL SERVICES  
DOLBY LANDFILL COVER UPGRADE  
PHASES 2 AND 3  
EAST MILLINOCKET, MAINE  
BGS PROJECT 3345**

**SECTIONS AND DETAILS**


 <b>SME SEVEE &amp; MAHER ENGINEERS</b> <small>ENVIRONMENTAL • CIVIL • GEOTECHNICAL • WATER • COMPLIANCE</small> <small>4 Blanchard Road, PO Box 85A, Cumberland, Maine 04021</small> <small>Phone 207.829.5016 • Fax 207.829.5692 • sme-engineers.com</small>	DESIGN BY: NMT DRAWN BY: SJM DATE: 12/2021 CHECKED BY: BDP LMN: NONE CTB: SME-STD
JOB NO. 21588.07    DWG FILE DETAILS	<b>C-300</b>




CB	"A"	"B"	"C"	"D"
CB-2c	356.0	352.0	352.5	18"
CB-1i	382.5	380.0	380.5	18"

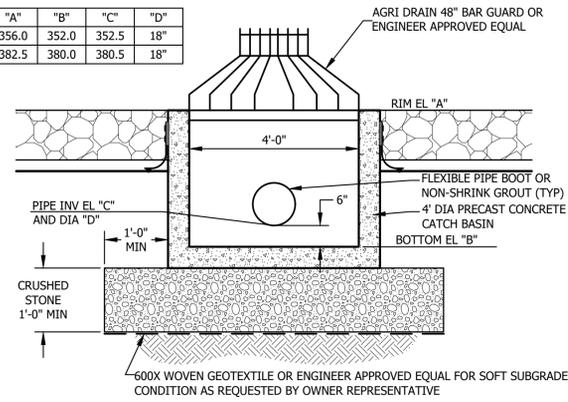


**CATCH BASIN**  
NTS

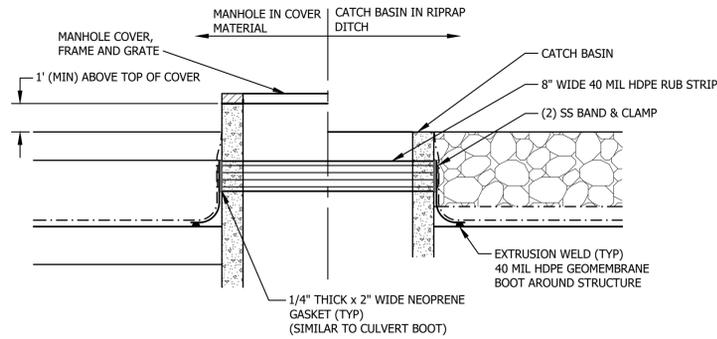


**MH/CB STRUCTURE BOOT**  
NTS

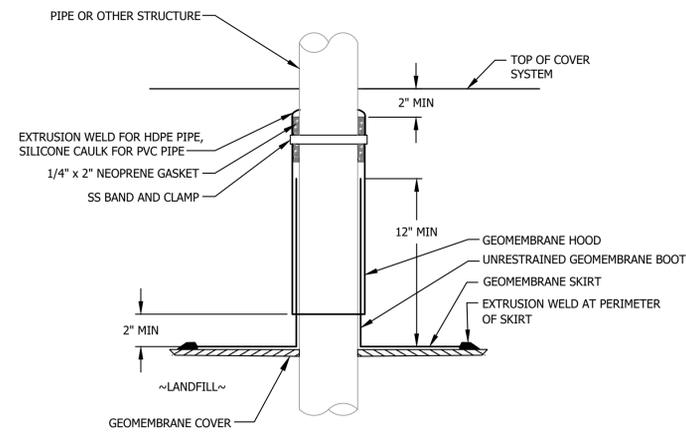



**PIPE BOOT**  
NTS

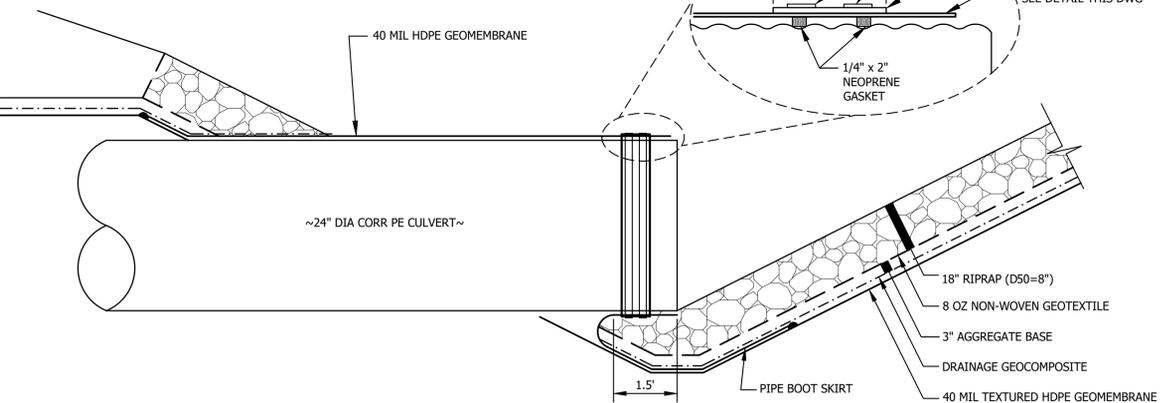


**CULVERT PIPE BOOT**  
NTS

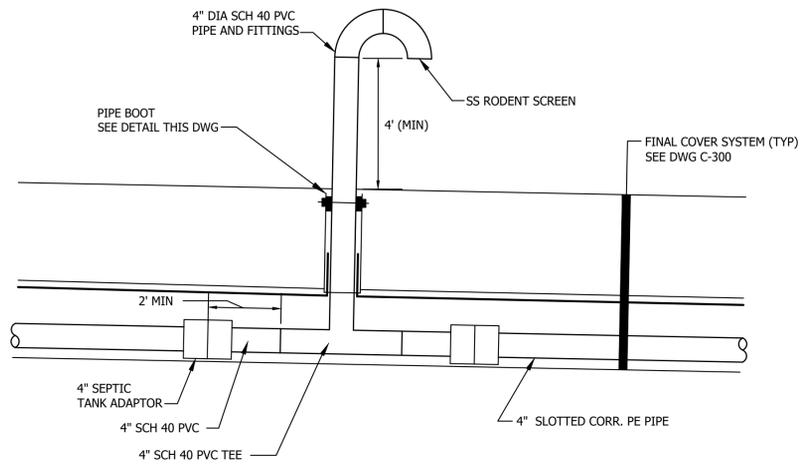

**GAS VENTING SYSTEM**  
NTS

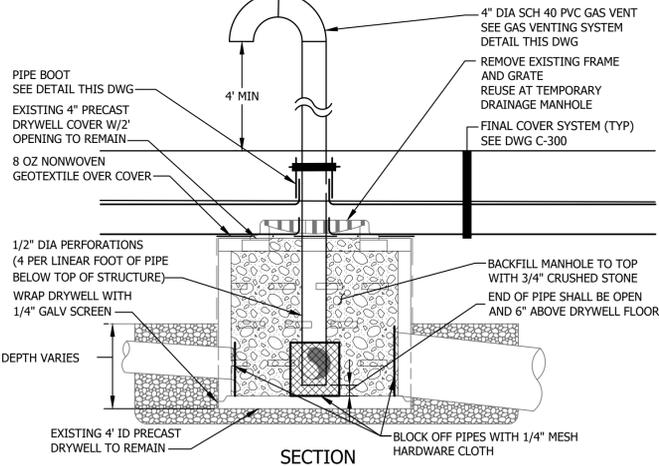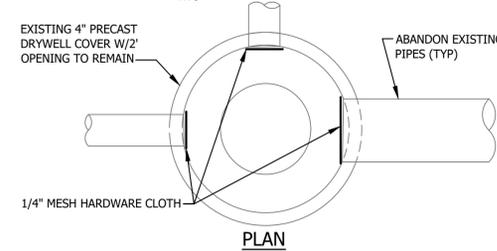


**SECTION DRAINAGE MANHOLE ABANDONMENT**  
NTS

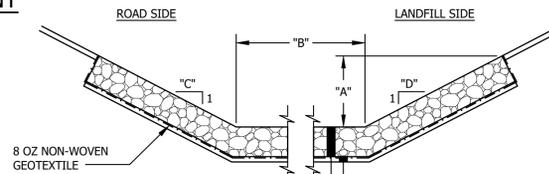


DITCH	"A" (FT)	"B" (FT)	"C"	"D"	"E"	"F"
RD-4	2	2	2	3	14"	6"
RD-5	1.5	4	2	3	27"	12"
RD-6	1.5	2'	2	3	18"	8"
RD-7	1.5	0	2	3	14"	6"
RD-8	1.5	2'	2	3	14"	6"
RD-9	1.5	2'	3	3	14"	6"
RD-11i	1.5	2'	3	3	18"	8"
RD-112	1.5	4'	3	3	18"	8"

**RIPRAP DITCH**  
NTS

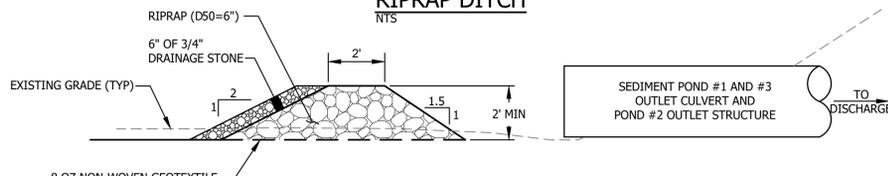

**POND OUTLET PROTECTION**  
NTS

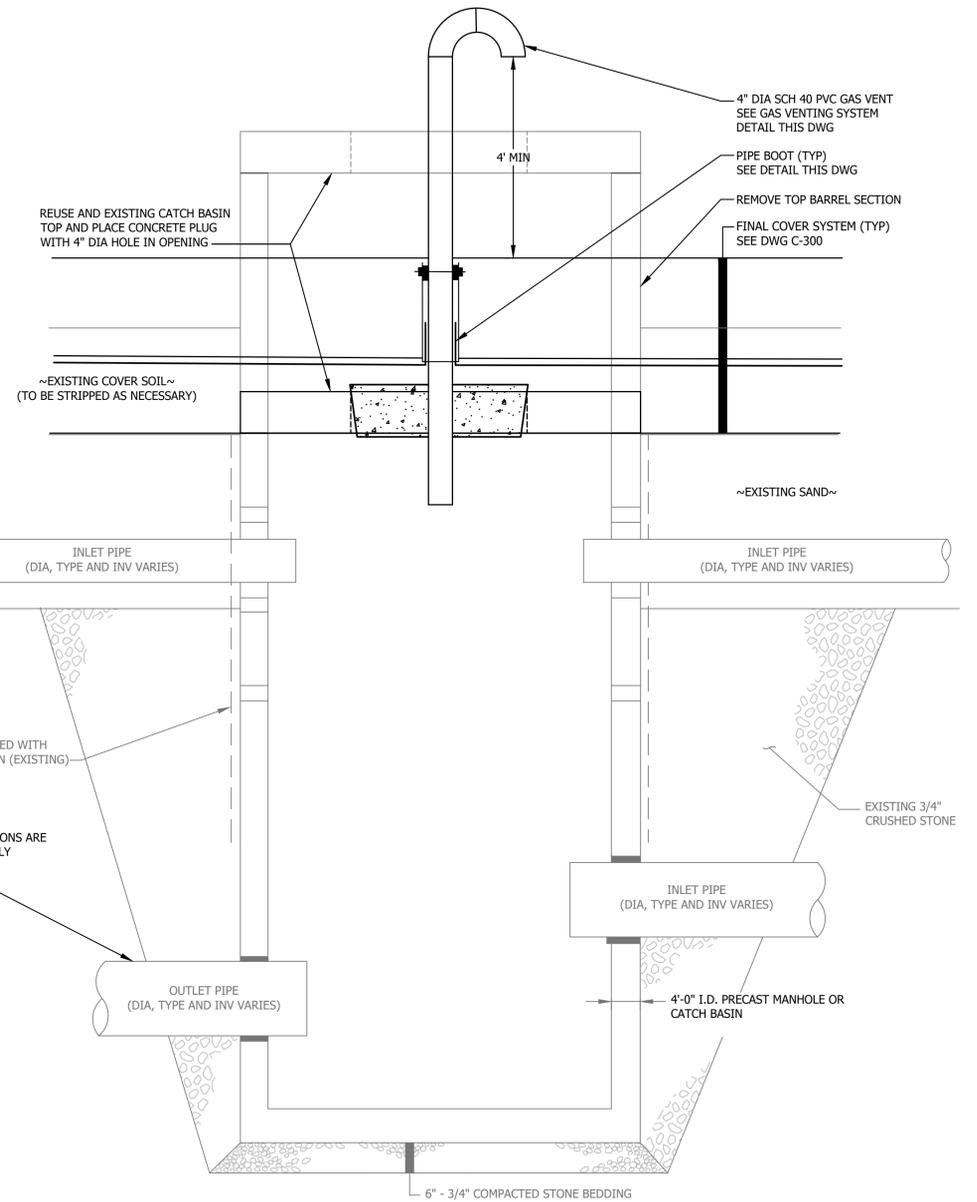

**EXISTING CATCH BASIN ABANDONMENT**  
NTS

NOTE: CONTRACTOR SHALL FIELD VERIFY PIPE LOCATIONS AND OTHER EXISTING CONDITIONS PRIOR TO ABANDONMENT.

REV.	BY	DATE	STATUS
BDP	12/2023	RECORD DRAWING	
BDP	12/2021	ISSUED FOR BID AND MEDEP REVIEW	






MAINE BUREAU OF GENERAL SERVICES  
DOLBY LANDFILL COVER UPGRADE  
PHASES 2 AND 3  
EAST MILLINOCKET, MAINE  
BGS PROJECT 3345

**SECTIONS AND DETAILS**

**SME SEVEE & MAHER ENGINEERS**  
ENVIRONMENTAL • CIVIL • GEOTECHNICAL • WATER • COMPLIANCE  
4 Blanchard Road, PO Box 85A, Cumberland, Maine 04021  
Phone 207.829.5016 • Fax 207.829.5692 • sme-engineers.com

DESIGN BY: NMT  
DRAWN BY: SJM  
DATE: 12/2021  
CHECKED BY: BDP  
LMN: NONE  
CTB: SME-STD

JOB NO. 21588.07 DWG FILE DETAILS **C-302**

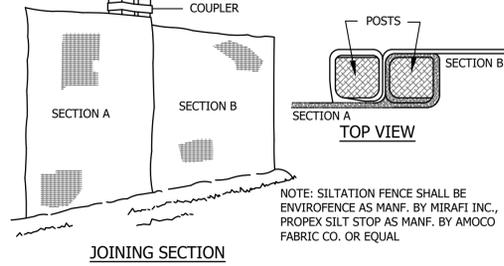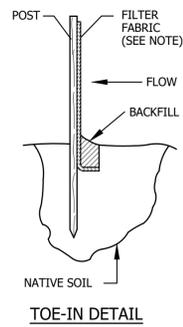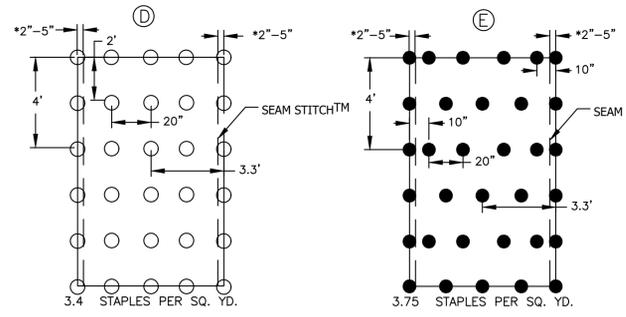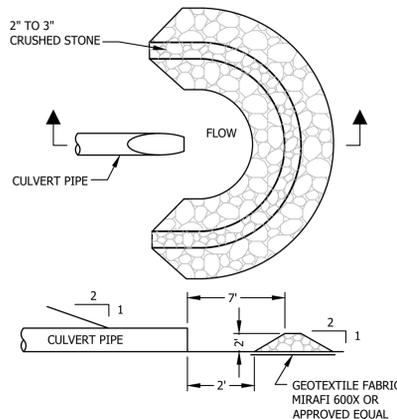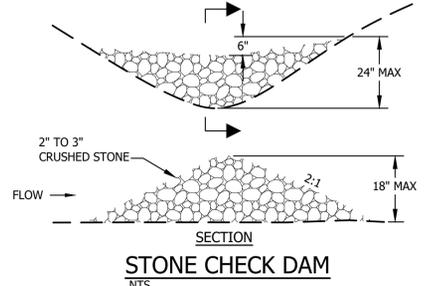

NOTE: SILTATION FENCE SHALL BE ENVIROFENCE AS MANF. BY MIRAFI INC., PROPEX SILT STOP AS MANF. BY AMOCO FABRIC CO. OR EQUAL

TEMPORARY AND PERMANENT EROSION AND SEDIMENTATION CONTROL

- A. GENERAL**
- All soil erosion and sediment control will be done in accordance with the Maine Erosion and Sediment Control Best Management Practices, Maine Department of Environmental Protection, October 2016, and as currently revised.
  - The contractor will be responsible for the repair/replacement/maintenance of all erosion control measures until all disturbed areas are stabilized. Contractor shall be responsible for plan preparation, documentation and inspection in accordance with Maine Construction General Permit obtained for this project.
  - Disturbed areas will be permanently stabilized within 7 days of final grading. Disturbed areas not to be worked upon within 14 days of disturbance, shall be temporarily stabilized within 7 days of the disturbance.
  - In all areas, removal of trees, bushes and other vegetation, as well as disturbance of topsoil will be kept to a minimum while allowing proper site operations.
  - Any suitable topsoil will be stripped and stockpiled for reuse in final grading. Topsoil will be stockpiled in a manner such that natural drainage is not obstructed and no off-site sediment damage will result. If a stockpile is necessary, the side slopes of the topsoil stockpile will not exceed 2:1. Silt fence will be installed around the perimeter of all topsoil stockpiles. Topsoil stockpiles will be surrounded with siltation fencing and will be temporarily seeded with arrostok rye, annual or perennial ryegrass, within 7 days of formation, or temporarily mulched if seeding cannot be done within the recommended seeding dates. Recommended seeding dates and application rates are as follows:  
 Arrostok Rye: Recommended Seeding Dates: 9/10 - 11/1 Application Rate: 112 lbs/acre  
 Perennial Ryegrass: Recommended Seeding Dates: 4/1 - 9/10 Application Rate: 85 lbs/acre  
 Mulch: o Hay or Straw Application Rate: 2 - 3 tons/acre. Anchor with tack or 300 lbs/acre fiber mulch  
 o Wood Fiber Cellulose (Lj to Augus) Application Rate: 4,000 lbs/acre. Anchoring not required

- B. TEMPORARY MEASURES**
- Silt Fence**
    - Silt fence will be installed prior to and downgradient of all construction activity where soil disturbance may result in erosion.
    - The height of a silt fence will not exceed 36 inches.
    - The filter fabric will be purchased in a continuous roll cut to the length of the barrier to avoid the use of joints. When joints are necessary, filter cloth will be spliced together only at a support post, with a minimum 6-inch overlap, and securely sealed.
    - Posts will be spaced a maximum of 10 feet apart at the barrier location and driven securely into the ground (minimum of 12 inches). When extra strength fabric is used without the wire support fence, post spacing will not exceed 6 feet.
    - A trench will be excavated approximately 4 inches wide and 4 inches deep along the line of posts and upgradient from the barrier.
    - The standard strength of filter fabric will be stapled or wired to the fence, and 8 inches of the fabric will be extended into the trench. The fabric will not extend more than 36 inches above the original ground surface. Filter fabric will not be stapled to existing trees.
    - When extra strength filter fabric and closer post spacing are used, the wire mesh support fence may be eliminated. In such a case, the filter fabric will be stapled or wired directly to the posts with all other provisions of item (f) applying.
    - The trench will be backfilled and the soil compacted over the filter fabric.
    - Silt fences will be removed when they have served their useful purpose, but not before the upgradient areas have been permanently stabilized.
    - Silt fences will be inspected immediately after each rainfall and at least daily during prolonged rainfall. They will be inspected if there are any signs of erosion or sedimentation below them. Any required repairs will be made immediately. If there are signs of undercutting at the center or the edges, or impounding of large volumes of water behind them, they will be replaced with a temporary crushed stone check dam.
    - Should the fabric on a silt fence decompose or become ineffective prior to the end of the expected usable life, and the barrier still be necessary, the fabric will be replaced promptly.
    - Sediment deposits should be removed after each storm event if significant buildup has occurred or if deposits exceed 15 inches in depth.
  - Stone Check Dams**
    - Stone check dams should be constructed of 2 to 3-inch stone. The stone should be placed according to the configuration shown on the drawing. Hand or mechanical placement will be necessary to achieve complete coverage of the ditch or swale and to ensure that the center of the dam is lower than the edges.
    - Check dams should be installed as the swale is being constructed.
    - Sediment will be removed from behind the check dams when it has accumulated to one half of the original height of the dam.
    - Check dams will be removed when the grass has matured sufficiently to protect the ditch or swale. The area beneath the check dams will be seeded and mulched immediately after they are removed.
    - Regular inspections will be made to ensure that the center of the dam is lower than the edges. Erosion caused by high flows around the edges of the dam will be corrected. If evidence of siltation in the water is apparent downstream from the check dam, the check dam will be inspected and adjusted. Check dams will be checked for sediment accumulation after each significant rainfall.
  - Wood Waste Compost/Bark Filter Berms**
    - The filter berm shall consist of an approved wood waste compost/bark mulch mix or recycled composted bark flume grit and fragmented wood generated from water-flume log handling systems or small shredding of stumpage (6 inches long x 1 1/2" dia.). The mixture needs to be a well-graded blend of organic and mineral substance. The composition is usually manufactured on or off site and by blending it with a well graded sand and gravel. The objective is a light, heavy, non-erodible mixture that is not composed of one uniform material, i.e. just bark mulch will not suffice. Comparable composted mixes can be used upon approval of the Department of Environmental Protection, Bureau of Land and Water Quality.
    - The mix shall conform to the following standards:  
 \* Moisture Content 30 - 60%  
 \* PH 5.0-8.0  
 \* Screen Size - 100% less than 6-inch max; 70% less than 0.75 inch.  
 \* No less than 80% organic material (dry weight) by loss of ignition.  
 \* No stones larger than 4 inch diameter.  
 \* Silts, clays or sugar sands are not acceptable in the mix.
    - Installation and Size of Berm: The dimensions of the berm are more a function of the strength of the material than the flows (forces) it will encounter. At a minimum the berm shall be 4 feet wide and 18 inches high. The berm shall be placed on, uncompacted along a relatively level contour. Wherever possible the existing surface must be scoured and the mixture keyed in like any other sediment control measure.
    - Maintenance: All deficiencies shall be immediately corrected with additional material placed on top of the berm to reach the desired height. When the berm is decomposed, clogged with sediment, eroded, or becomes ineffective, it shall be replaced.
    - Clean up and Retrieval: At the end of the job, an erosion control berm shall be removed or spread out so that the native earth can be seen below.

- B. TEMPORARY MEASURES (Cont)**
- Erosion Control Mats**
    - During the growing season (April 1 to September 10) use mats indicated on drawings on channel bottoms and steep slopes >3H:1V.
    - During the fall and winter (September 11 to March 31) use heavy grade mats as recommended by the engineer on all channel bottoms and slopes >4H:1V.
    - Install mats in accordance with the manufacturer's recommendations.
  - Erosion Control Measures**
    - The smallest practical area of land shall be exposed to construction at any one time.
    - The temporary erosion control measures shall be maintained until the permanent erosion control measures are present.
    - All areas disturbed by construction shall have available loam placed before seeding (or an acceptable alternative).
    - After construction is terminated, all temporary erosion control measures shall be removed and accumulated sediment disposed of in a secure location.
    - Mulch shall be mowings of acceptable herbaceous growth, free from noxious weeds or woody stems, and shall be dry.

- C. Permanent Measures**
- Riprapped Ditches, Aprons and Plunge Pools
    - Construct riprapped ditches, aprons and plunge pools in accordance with the details shown on the Drawings.
    - Stone for riprap will consist of sub-angular field stone or rough unshewn quarry stone. The stone will be hard and of such quality that it will not disintegrate on exposure to water or weathering, be chemically stable and suitable in all other respects for the purpose intended. The bulk specific gravity (saturated surface-dry basis) of the individual stones will be at least 2.5.
    - The riprap should be placed so that it produces a dense well-graded mass of stone with a minimum of voids. The desired distribution of stones throughout the mass may be obtained by selective loading at the quarry, controlled dumping of successive loads during final placing, or by combination of these methods. The riprap should be placed to its full thickness on one operation. The riprap should not be placed in layers. The riprap should not be placed by dumping into chutes or similar methods which are likely to cause segregation of the various stone sizes. Care should be taken not to dislodge the underlying material when placing the stones.
    - The finished slope should be free of pockets of small stone or clusters of large stones. Hand placing may be necessary to achieve the required grades and a good distribution of stone sizes. Final thickness of the riprap blanket should be within plus or minus 1/4 of the specified thickness.
    - Riprap will be inspected periodically to determine if high flows have caused scour beneath the riprap or dislodged any of the stone. If repairs are needed, they should be accomplished immediately.
  - Topsoil, Seed, Mulch**
    - Topsoil: Use stockpiled materials spread to the depths shown on the plans, if available. Approved topsoil substitutes may be used (refer to Section C-2-2 of Best Management Practices Handbook, see Note 2).
    - Seeding should be completed by September 15 of each year. Areas not seeded or which do not obtain satisfactory growth by October 1, will be seeded with Arrostok Rye or mulched at rates previously specified herein. After November 1, or the first killing frost, disturbed areas should be treated as indicated in C below.

Seed	SEEDING SPECIFICATIONS	
	Permanent Seeding (180 lbs/acre)	Temporary Seeding (120 lbs/acre)
Red Fescue	50% by weight	Winter Rye
Red Top	2% by weight	100% by weight
Winter Cover	5% by weight	
Annual Ryegrass	25% by weight	
Birdsfoot Trefoil	3% by weight	
Kentucky Bluegrass	15% by weight	

Fertilizer: Apply 2 pounds per unit (87 lbs/acre) of nitrogen, phosphoric acid, and potash, or 413 lbs/acre of 19-19-19 fertilizer.

Lim: Apply liquid limestone at a rate of 3 tons per acre (138 lbs/1,000 sq ft).

Mulch: Mulch with weed-free hay or straw at 3.0 tons per acre with tack or 260 lbs/acre fiber mulch.


(c) If permanent vegetated stabilization cannot be established due to the season of the year, all exposed and disturbed areas not to undergo further disturbance are to have dormant seeding applied and be temporarily mulched to protect the site. The following methods may be used to perform a dormant seeding:

- Prepare the seedbed, add the required amounts of lime and fertilizer, then mulch and anchor. After the first killing frost and before snow fall, broadcast or hydroseed the selected seed mixture. Double the regular seeding rates for this type seeding.
- When soil conditions permit, between the first killing frost and before snow fall, prepare the seedbed, lime and fertilize, apply the selected seed mixture, and mulch and anchor. Double the regular seeding rates for this type of seeding.

Dormant seedings need to be anchored extremely well on slopes, ditch bases and areas of concentrated flows.

Dormant seeding requires inspection and reseeded as needed in the spring. All areas where cover is inadequate must be immediately reseeded and mulched as soon as possible.

(3) Erosion Control Mats  
 (a) Install mats as indicated on drawings and in accordance with manufacturers' recommendations.

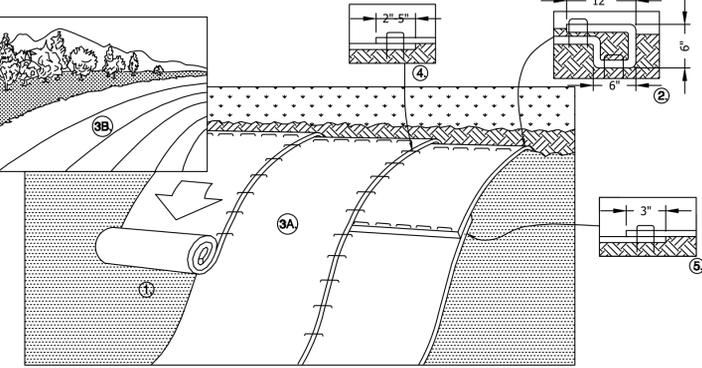


- PREPARE BEFORE INSTALLING ROLLED EROSION CONTROL PRODUCTS (RECP'S). INCLUDING ANY NECESSARY APPLICATION OF LIME, FERTILIZER AND SEED.
- BEGIN AT THE TOP OF THE SLOPE BY ANCHORING THE RECP'S IN A 6" DEEP X 6" WIDE TRENCH WITH APPROXIMATELY 12" OF RECP'S EXTENDED BEYOND THE UP-SLOPE PORTION OF THE TRENCH. ANCHOR THE RECP'S WITH A ROW OF STAPLES/STAKES APPROXIMATELY 12" APART IN THE BOTTOM OF THE TRENCH. BACKFILL AND COMPACT THE TRENCH AFTER STAPLING. APPLY SEED TO COMPACTED SOIL AND FOLD REMAINING 12" PORTION OF RECP'S BACK OVER SEED AND COMPACTED SOIL. SECURE RECP'S OVER COMPACTED SOIL WITH A ROW OF STAPLES/STAKES SPACED APPROXIMATELY 12" APART ACROSS THE WIDTH OF THE RECP'S.
- ROLL THE RECP'S (A.) DOWN OR (B.) HORIZONTALLY ACROSS THE SLOPE. RECP'S WILL UNROLL WITH APPROPRIATE SIDE AGAINST THE SOIL SURFACE. ALL RECP'S MUST BE SECURELY FASTENED TO SOIL SURFACE BY PLACING STAPLES IN APPROPRIATE LOCATIONS AS SHOWN IN THE STAPLE PATTERN GUIDE. WHEN USING THE DOT SYSTEM™, STAPLES SHOULD BE PLACED THROUGH EACH OF THE COLORED DOTS CORRESPONDING TO THE APPROPRIATE STAPLE PATTERN.
- THE EDGES OF PARALLEL RECP'S MUST BE STAPLED WITH APPROXIMATELY 2"-5" OVERLAP DEPENDING ON RECP'S TYPE.
- CONSECUTIVE RECP'S SPICED DOWN THE SLOPE MUST BE PLACED END OVER END (SHINGLE STYLE) WITH AN APPROXIMATE 3" OVERLAP. STAPLE THROUGH OVERLAPPED AREA, APPROXIMATELY 12" APART ACROSS ENTIRE RECP'S WIDTH.

\*IN LOOSE SOIL CONDITIONS, THE USE OF STAPLE OR STAKE LENGTHS GREATER THAN 6" MAY BE NECESSARY TO PROPERLY SECURE THE RECP'S.

- PREPARE BEFORE INSTALLING ROLLED EROSION CONTROL PRODUCTS (RECP'S). INCLUDING ANY NECESSARY APPLICATION OF LIME, FERTILIZER AND SEED.
- BEGIN AT THE TOP OF THE SLOPE BY ANCHORING THE RECP'S IN A 6" DEEP X 6" WIDE TRENCH WITH APPROXIMATELY 12" OF RECP'S EXTENDED BEYOND THE UP-SLOPE PORTION OF THE TRENCH. ANCHOR THE RECP'S WITH A ROW OF STAPLES/STAKES APPROXIMATELY 12" APART IN THE BOTTOM OF THE TRENCH. BACKFILL AND COMPACT THE TRENCH AFTER STAPLING. APPLY SEED TO COMPACTED SOIL AND FOLD REMAINING 12" PORTION OF RECP'S BACK OVER SEED AND COMPACTED SOIL. SECURE RECP'S OVER COMPACTED SOIL WITH A ROW OF STAPLES/STAKES SPACED APPROXIMATELY 12" APART ACROSS THE WIDTH OF THE RECP'S.
- ROLL CENTER RECP'S IN THE DIRECTION OF WATER FLOW IN BOTTOM OF CHANNEL. RECP'S WILL UNROLL WITH APPROPRIATE SIDE AGAINST THE SOIL SURFACE. ALL RECP'S MUST BE SECURELY FASTENED TO SOIL SURFACE BY PLACING STAPLES IN APPROPRIATE LOCATIONS AS SHOWN IN THE STAPLE PATTERN GUIDE. WHEN USING THE DOT SYSTEM™, STAPLES SHOULD BE PLACED THROUGH EACH OF THE COLORED DOTS CORRESPONDING TO THE APPROPRIATE STAPLE PATTERN.
- PLACE CONSECUTIVE RECP'S END OVER END (SHINGLE STYLE) WITH A 4" TO 6" OVERLAP. USE A DOUBLE ROW OF STAPLES STAGGERED 4" APART AND 4" ON CENTER TO SECURE RECP'S.
- FULL LENGTH EDGE OF RECP'S AT OF SIDE SLOPES MUST BE ANCHORED WITH A ROW OF STAPLES APPROXIMATELY 12" APART IN A 6" DEEP X 6" WIDE TRENCH. BACKFILL AND COMPACT THE TRENCH AFTER STAPLING.
- ADJACENT RECP'S MUST BE OVERLAPPED APPROXIMATELY 2" TO 5" (DEPENDING ON RECP'S TYPE) AND STAPLED.
- IN HIGH FLOW CHANNEL APPLICATIONS, A STAPLE CHECK SLOT IS RECOMMENDED AT 30 TO 40 FOOT INTERVALS. USE A DOUBLE ROW OF STAPLES STAGGERED 4" APART AND 4" ON CENTER OVER ENTIRE WIDTH OF THE CHANNEL.
- THE TERMINAL END OF THE RECP'S MUST BE ANCHORED WITH A ROW OF STAPLES APPROXIMATELY 12" APART IN A 6" DEEP X 6" WIDE TRENCH. BACKFILL AND COMPACT THE TRENCH AFTER STAPLING.

\*IN LOOSE SOIL CONDITIONS, THE USE OF STAPLE OR STAKE LENGTHS GREATER THAN 6" MAY BE NECESSARY TO PROPERLY SECURE THE RECP'S.

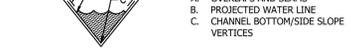

NOTE: \* HORIZONTAL STAPLE SPACING SHOULD BE ALTERED IF NECESSARY TO ALLOW STAPLES TO SECURE THE CRITICAL POINTS ALONG THE CHANNEL SURFACE.

CHANNEL INSTALLATION NTS

REV.	BY	DATE	STATUS
	BDP	12/2023	RECORD DRAWING
	BDP	12/2021	ISSUED FOR BID AND MEDEP REVIEW

**MAINE BUREAU OF GENERAL SERVICES**  
**DOLBY LANDFILL COVER UPGRADE**  
**PHASES 2 AND 3**  
**EAST MILLINOCKET, MAINE**  
**BGS PROJECT 3345**

**SECTIONS AND DETAILS**

ENVIRONMENTAL • CIVIL • GEOTECHNICAL • WATER • COMPLIANCE  
 4 Blanchard Road, PO Box 85A, Cumberland, Maine 04021  
 Phone 207.829.5016 • Fax 207.829.5692 • sme-engineers.com

DESIGN BY: NMT  
 DRAWN BY: SJM  
 DATE: 12/2021  
 CHECKED BY: BDP  
 LMN: NONE  
 CTB: SME-STD

JOB NO. 21588.07 DWG FILE DETAILS **C-303**

# MAINE DEPARTMENT OF ADMINISTRATIVE AND FINANCIAL SERVICES

## DOLBY LANDFILL COVER UPGRADE


### PHASE 4

## EAST MILLINOCKET, MAINE

### BGS PROJECT 3754

TITLE	DWG NO
COVER SHEET	
SYMBOLS & ABBREVIATIONS	C-100
PHASED CLOSURE PLAN	C-101
EXISTING CONDITIONS PLAN	C-102
TEMPORARY CELL WASTE MIXING PLAN	C-103
SITE BASE GRADING PLAN	C-104
GAS COLLECTION PIPING PLAN	C-105
UNDERDRAIN PIPING PLAN	C-106
SITE PLAN	C-107
SECTIONS AND DETAILS	C-300
SECTIONS AND DETAILS	C-301
SECTIONS AND DETAILS	C-302
SECTIONS AND DETAILS	C-303
SECTIONS AND DETAILS	C-304

LOCATION MAP

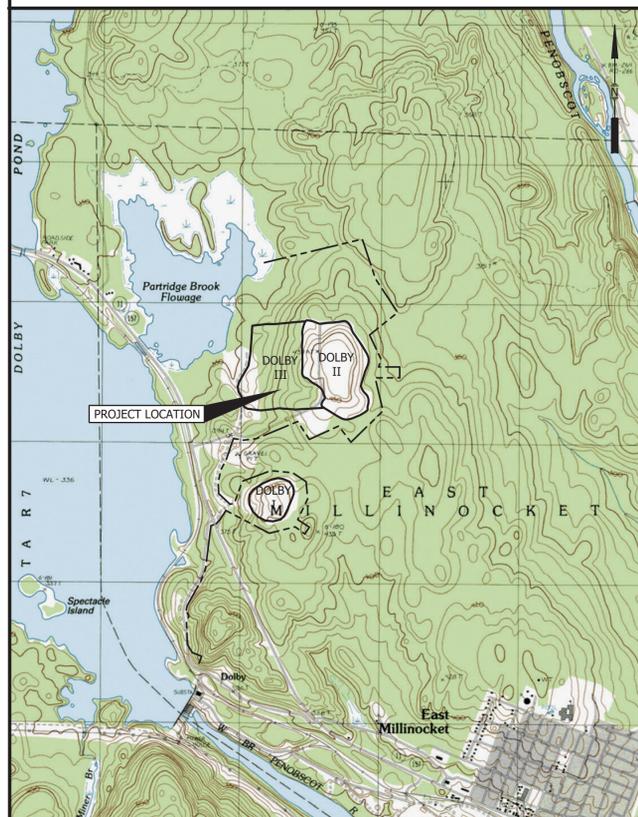

ENVIRONMENTAL • CIVIL • GEOTECHNICAL • WATER • COMPLIANCE


4 Blanchard Road, PO Box 85A, Cumberland, Maine 04021  
 Phone 207.829.5016 • Fax 207.829.5692 • smemaine.com



**RECORD DRAWINGS**





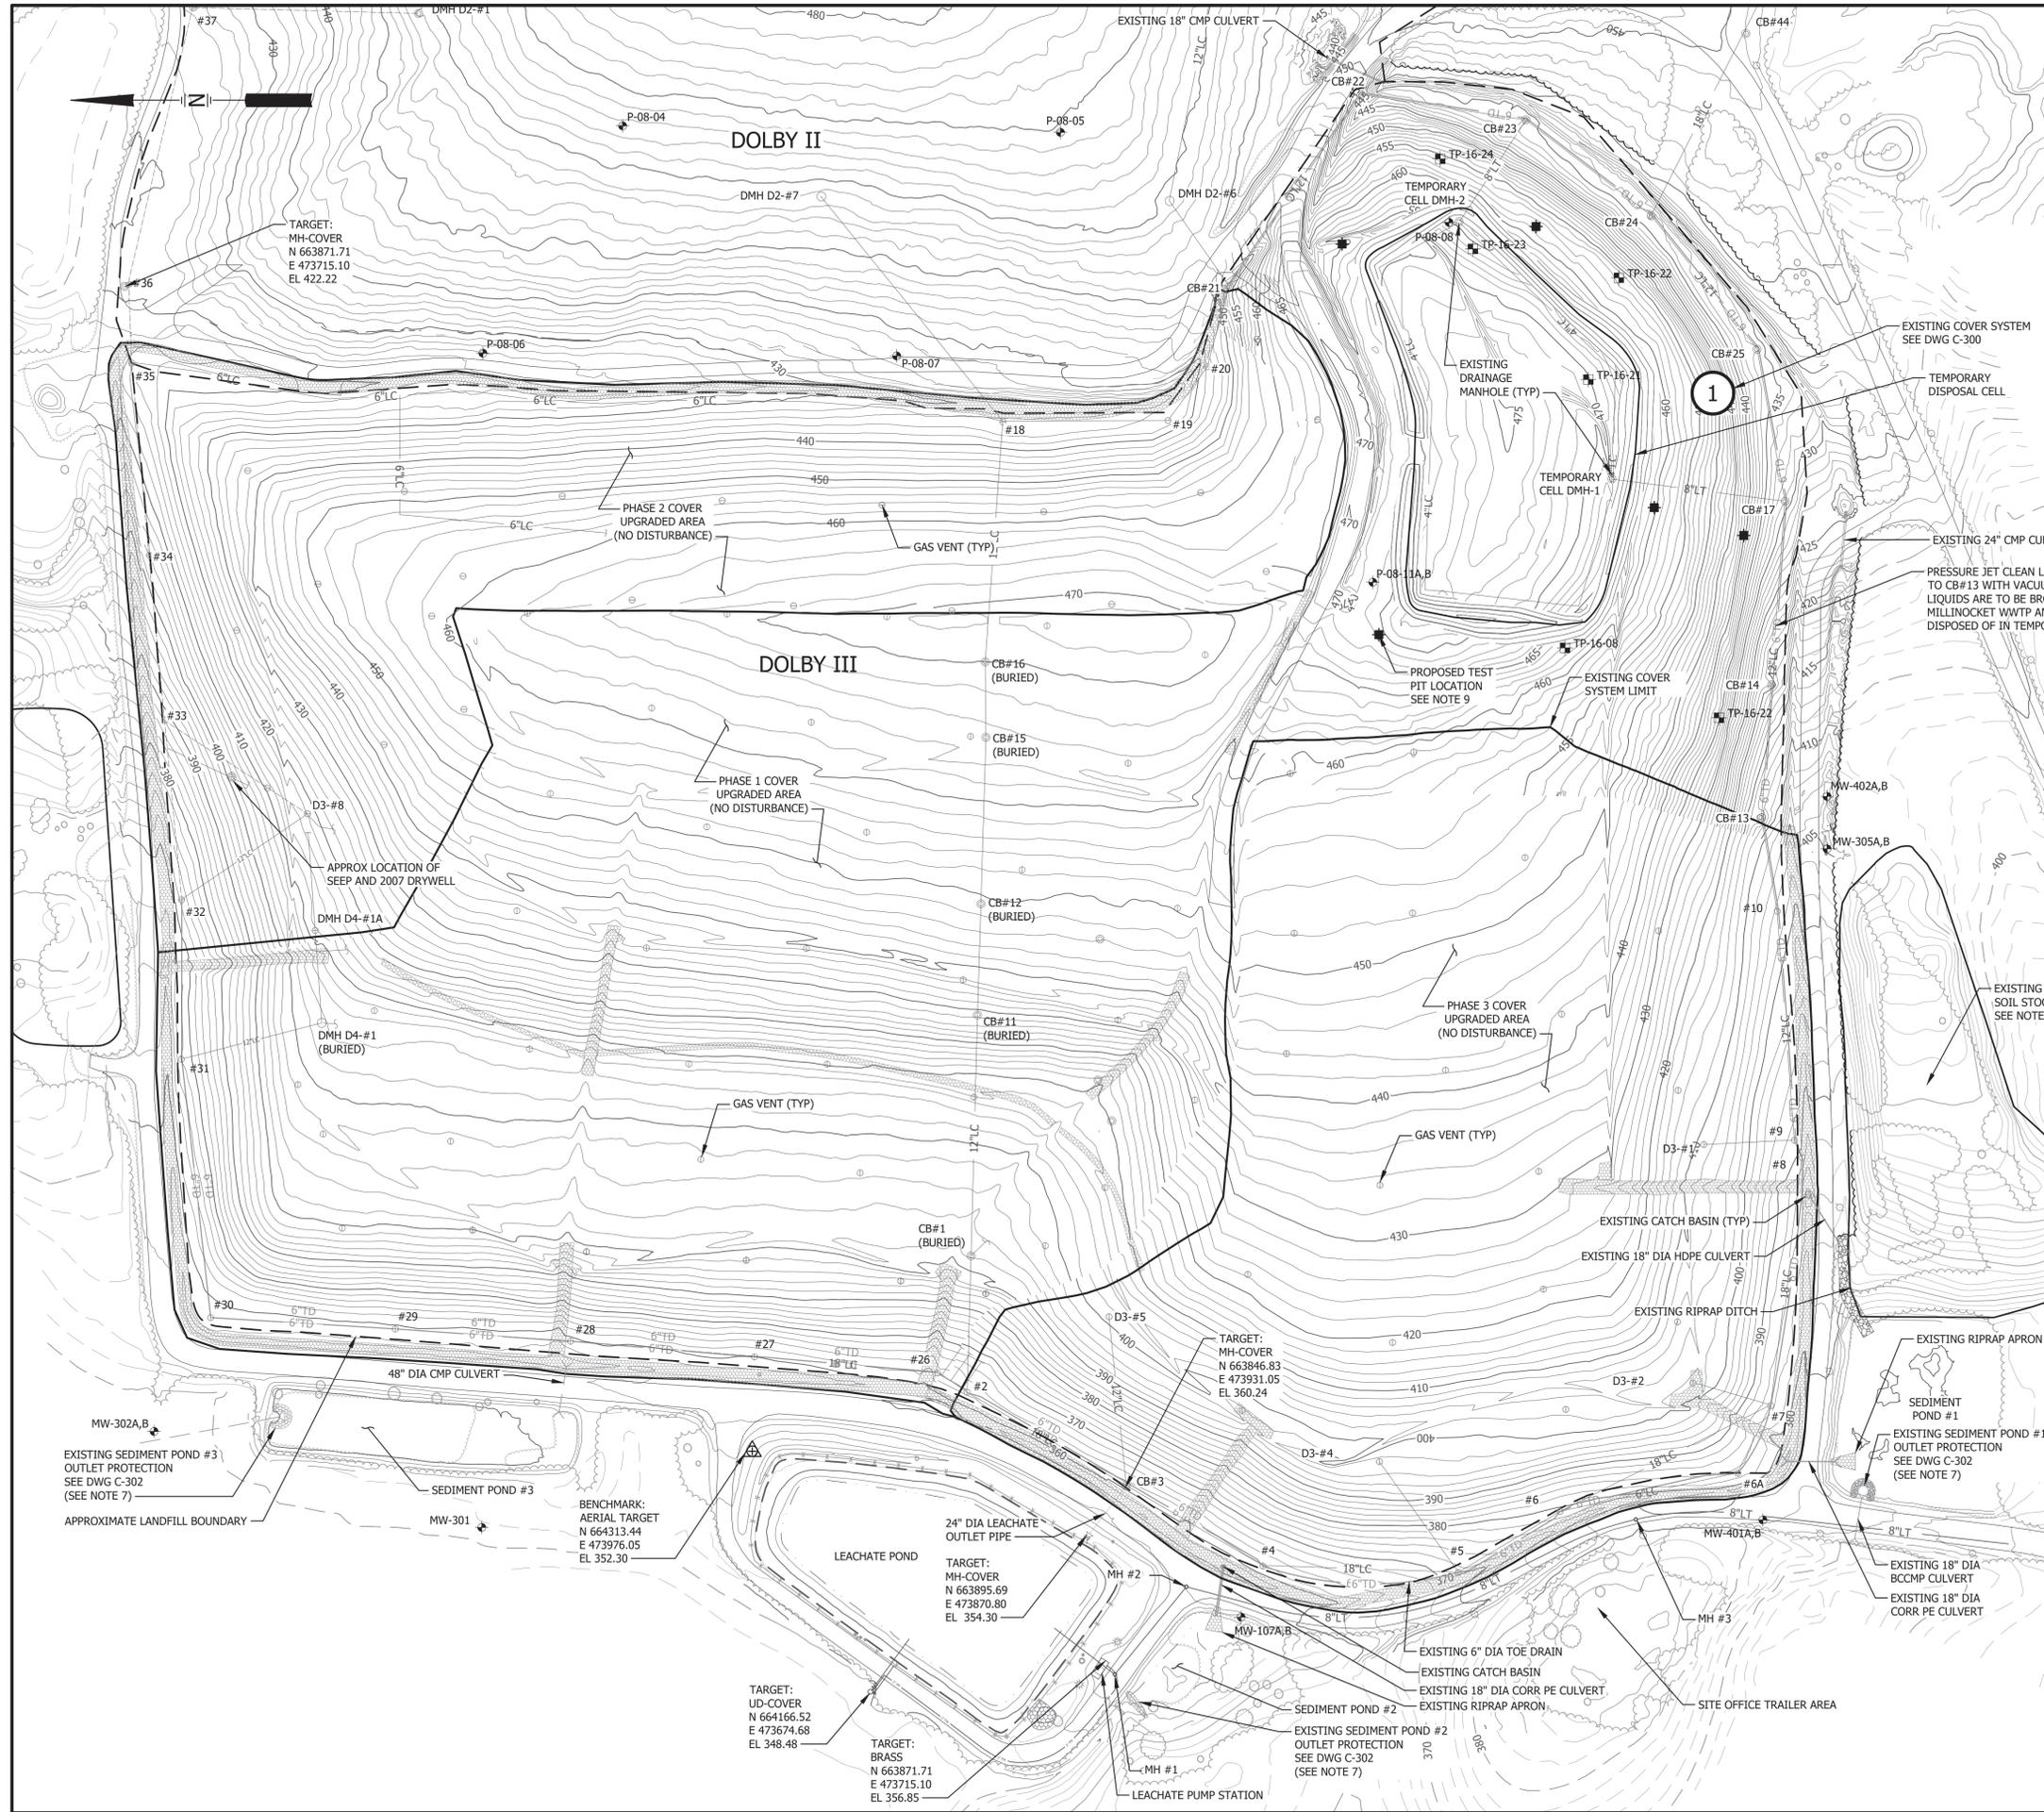

- NOTES**
1. BASE MAP PREPARED BY AERIAL SURVEY & PHOTO OF NORRIDGEWOCK, MAINE. PHOTO DATE 10/15/2015. HORIZONTAL DATUM HORIZONTAL DATUM MAINE STATE COORDINATE SYSTEM EAST ZONE, NAD 83. STANDARD PRACTICE DICTATES THAT PLANS COMPILED IN THIS MANNER SHOULD BE FIELD VERIFIED BY THE CONTRACTOR PRIOR TO CONSTRUCTION.
  2. TOPOGRAPHY WITHIN LANDFILL LIMITS AND OUTSIDE PHASE 2, 3, AND 4 COVER UPGRADE AREAS FROM AERIAL SURVEY PERFORMED BY SEVEE AND MAHER ENGINEERS DATED 5/4/2021. TOPOGRAPHY WITHIN PHASE 2 AND 3 COVER UPGRADE AREAS PROVIDED BY GORDON CONTRACTING, INC., OF SANGERVILLE, MAINE ON NOVEMBER 14, 2023. TOPOGRAPHY WITHIN PHASE 4 CONSTRUCTION LIMITS PROVIDED BY SARGENT CORPORATION ON NOVEMBER 5, 2024.
  3. VERTICAL DATUM: NAVD 1929.
  4. BORINGS PERFORMED BY MAINE TEST BORING. TEST PITS, FIELD LOCATIONS, AND LOGS BY SEVEE & MAHER ENGINEERS.
  5. CATCH BASIN DATA AS SHOWN ON HISTORICAL DRAWINGS FOR SITE DEVELOPMENT PLAN CELL 2, CELL 9 AND CELL 14 CONSTRUCTION AND CELL 12 CLOSURE.
  6. ALL SITE AND CONSTRUCTION ACTIVITIES (INCLUDING SOIL STOCKPILE AREAS) SHALL BE IN COMPLIANCE WITH MEDEP BEST MANAGEMENT PRACTICES AND EXISTING FEDERAL, STATE, AND LOCAL PERMITS AND PERMITTING REQUIREMENTS FOR THE SITE.
  7. SEDIMENT POND OUTLET PROTECTIONS SHOULD BE REMOVED ONCE CONSTRUCTION ACTIVITIES ARE CONCLUDED AND SITE HAS ACHIEVED SUITABLE GRASS GROWTH AS DETERMINED BY THE ENGINEER.
  8. EXISTING COVER SOIL STOCKPILE SHOULD BE CLEARED, STUMPED, AND GRUBBED PRIOR TO USE. EROSION CONTROL MEASURES SHOULD BE INSTALLED AND DISTURBED AREAS SHALL BE STABILIZED AT COMPLETION OF WORK PER MEDEP BEST MANAGEMENT PRACTICES.
  9. TEST PITS SHOULD BE PERFORMED WITHIN TWO WEEKS OF SITE MOBILIZATION. CONDUCT TEST PITS TO LOCATE EXISTING GAS COLLECTION SAND AND REPORT LOCATION AND ELEVATION TO ENGINEER.

PHASE 4 CATCH BASIN SCHEDULE		
CB ID	INV IN	INV OUT
CB#13	405.6 (12")	405.4 (12")
CB#14	411.6 (12")	411.40 (12")
CB#17	426.00 (8") 425.05 (12")	425.01 (12")
CB#21	448.9 (6") 449.1(6") 436.9(12") 445.4(12")	445.5 (12")
CB#22	435.3 (6") 437.0 (6")	433.9 (12")
CB#23	435.5 (6") 435.0 (8") 434.8 (6")	433.9 (12")
CB#24	432.8 (6") 434.4 (6") 433.0 (18")	432.3 (12")
CB#25	429.3 (6") 430.1 (6")	427.8 (12")
TEMPORARY CELL DMH-1	462.2 (4") 459.3 (4")	457.37 (8")
TEMPORARY CELL DMH-2	458.8 (4") 458.8 (4")	457.04 (8")



REV.	BY	DATE	STATUS
	BDP	1/2025	RECORD DRAWING
	BDP	2/2024	ISSUED FOR BID AND MEDEP REVIEW

**MAINE BUREAU OF GENERAL SERVICES**  
**DOLBY LANDFILL COVER UPGRADE**  
**PHASE 4**  
**EAST MILLINOCKET, MAINE**  
**BGS PROJECT 3754**

**EXISTING CONDITIONS PLAN**

**SEVEE & MAHER ENGINEERS**  
ENVIRONMENTAL • CIVIL • GEOTECHNICAL • WATER • COMPLIANCE  
 4 Blanchard Road, PO Box 85A, Cumberland, Maine 04021  
 Phone 207.829.5016 • Fax 207.829.5692 • sme-engineers.com


DESIGN BY: TJM  
 DRAWN BY: BWB  
 DATE: 1/2025  
 CHECKED BY: NMT  
 LMN: EXCON  
 CTB: SME-STD.CTB

JOB NO. 231265.00 DWG FILE BASE

**C-102**

H:\Projects\2025\231265\DWG\PHASE 4\EXISTING CONDITIONS PLAN.dwg, 01.11.2025, 13:17:41, baw



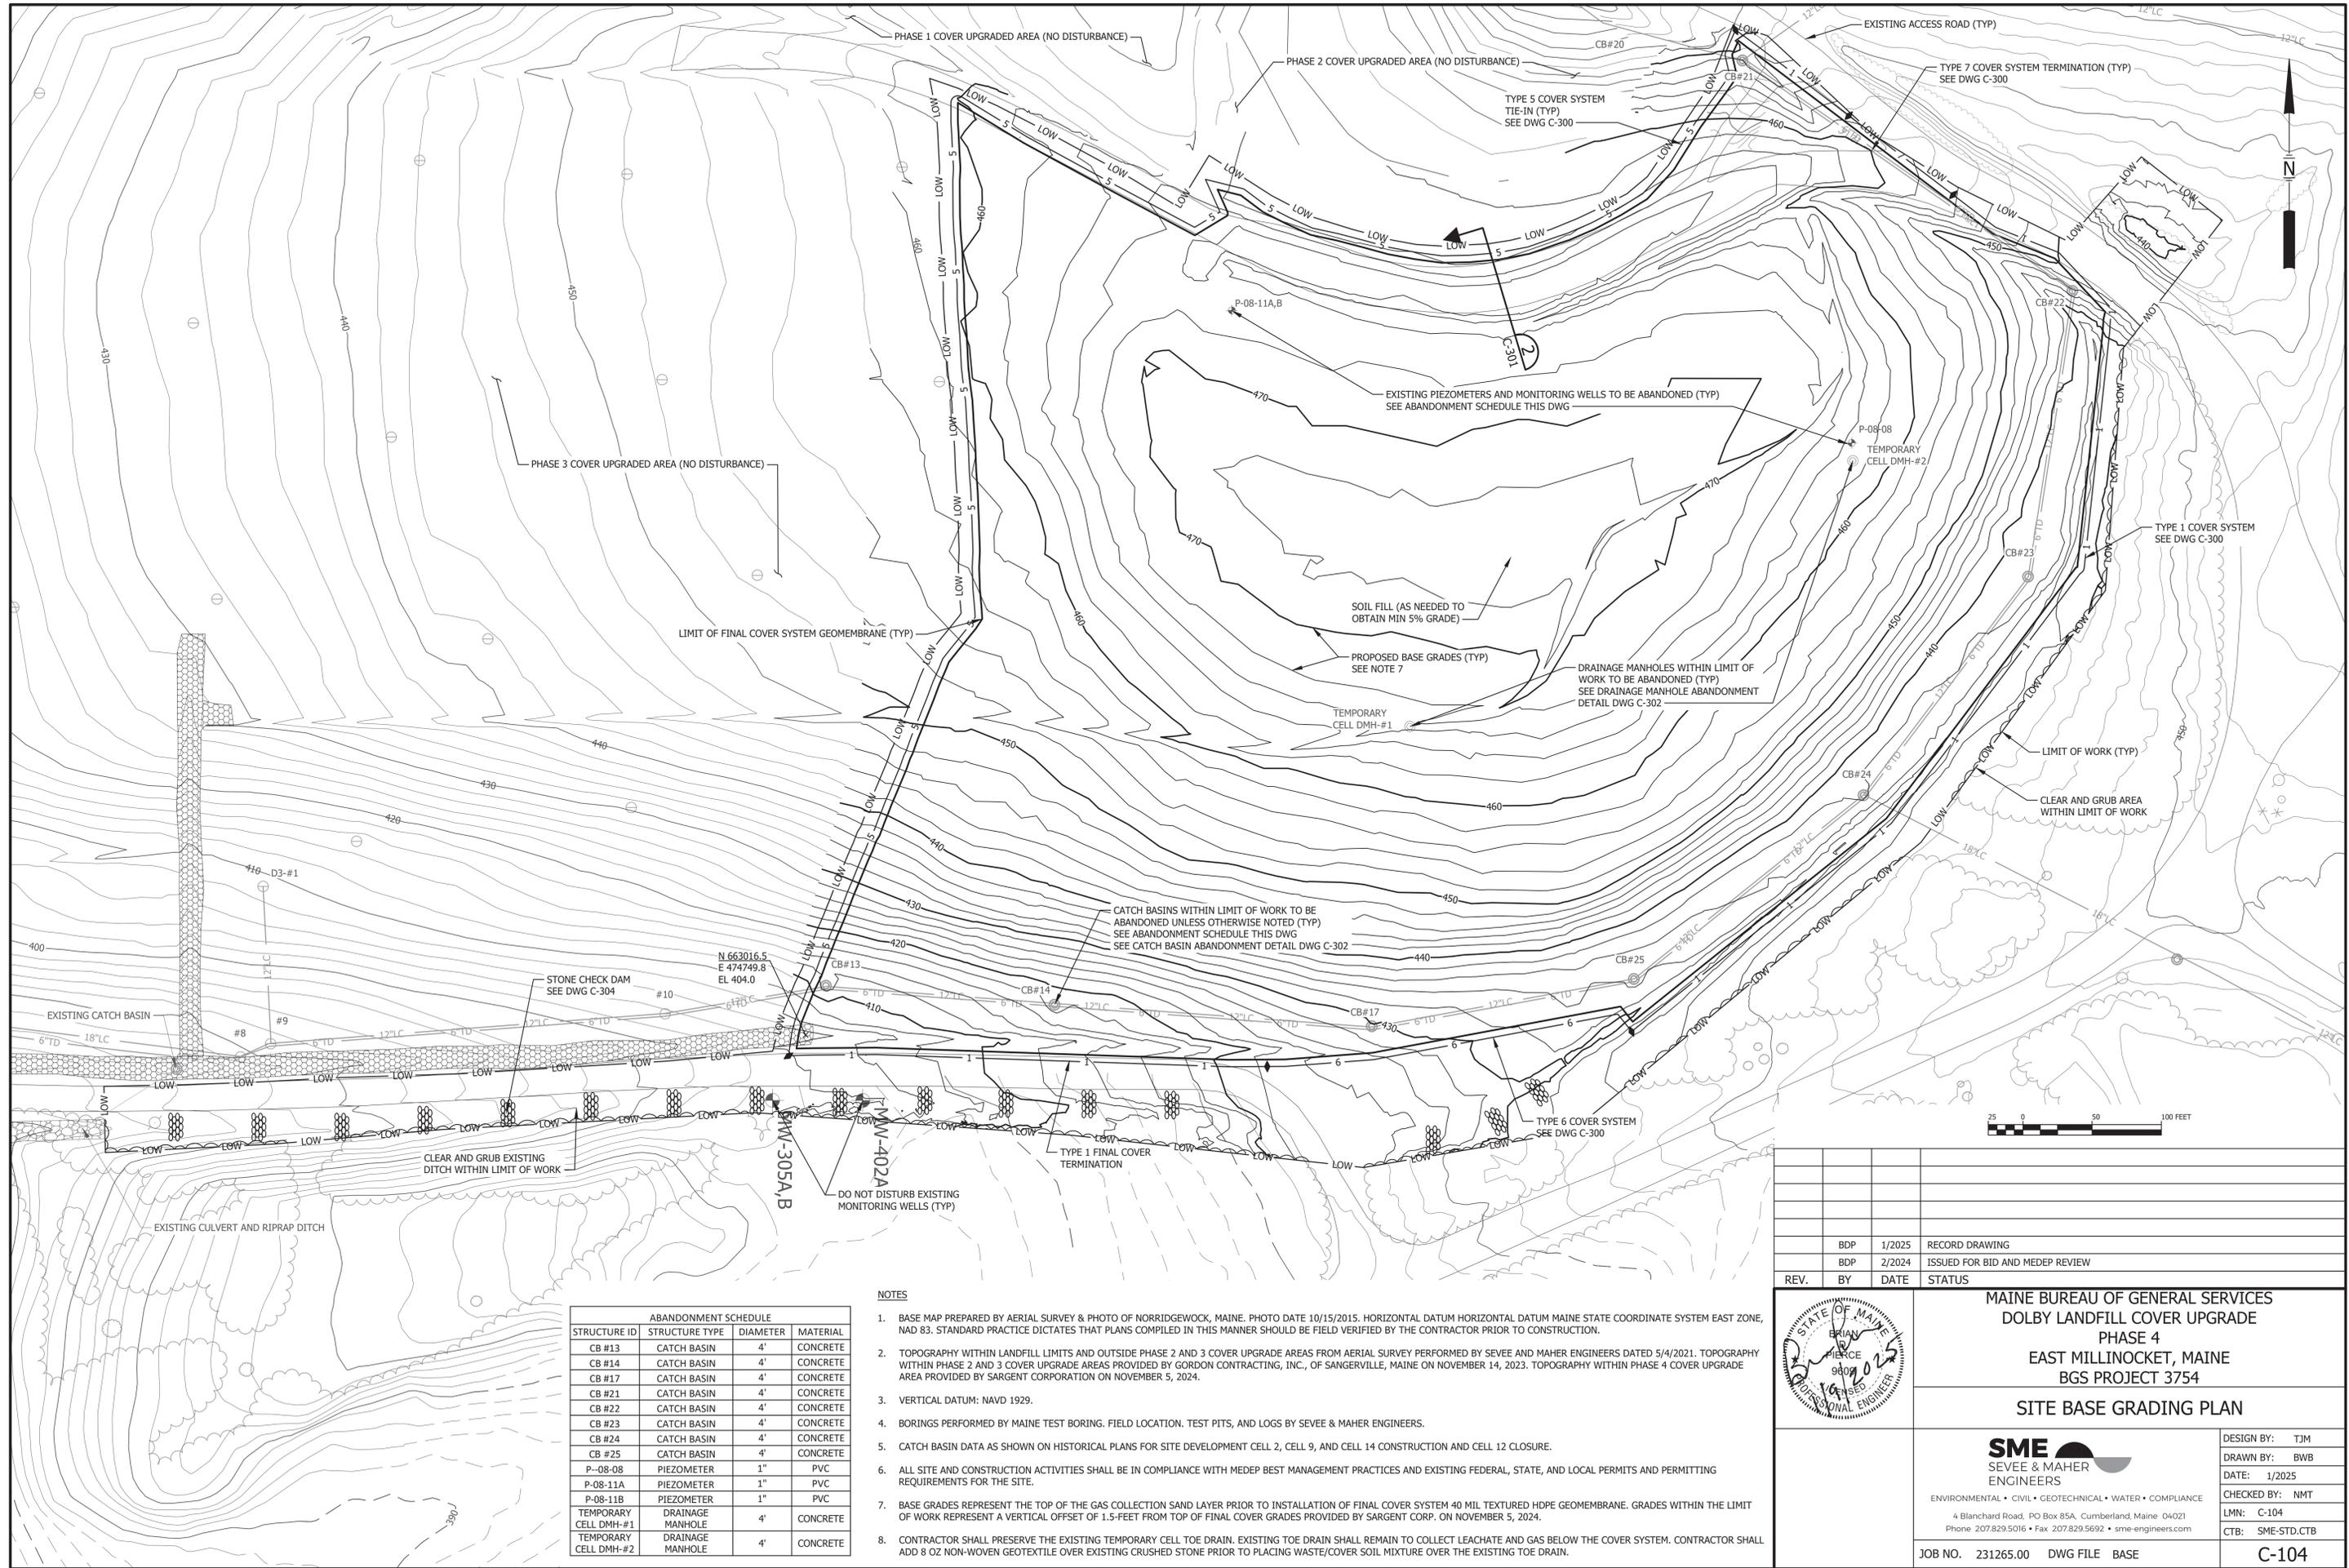


**NOTES**

- BASE MAP PREPARED BY AERIAL SURVEY & PHOTO OF NORRIDGEWOCK, MAINE. PHOTO DATE 10/15/2015. HORIZONTAL DATUM HORIZONTAL DATUM MAINE STATE COORDINATE SYSTEM EAST ZONE, NAD 83. STANDARD PRACTICE DICTATES THAT PLANS COMPILED IN THIS MANNER SHOULD BE FIELD VERIFIED BY THE CONTRACTOR PRIOR TO CONSTRUCTION.
- TOPOGRAPHY WITHIN LANDFILL LIMITS AND OUTSIDE PHASE 2 AND 3 COVER UPGRADE AREAS FROM AERIAL SURVEY PERFORMED BY SEVEE & MAHER ENGINEERS DATED 5/4/2021. TOPOGRAPHY WITHIN PHASE 2 AND 3 COVER UPGRADE AREAS PROVIDED BY GORDON CONTRACTING, INC., OF SANGERVILLE, MAINE ON NOVEMBER 14, 2023. TOPOGRAPHY WITHIN PHASE 4 COVER UPGRADE AREA PROVIDED BY SARGENT CORPORATION ON NOVEMBER 5, 2024.
- VERTICAL DATUM: NAVD 1929.
- BORINGS PERFORMED BY MAINE TEST BORING. FIELD LOCATION. TEST PITS, AND LOGS BY SEVEE & MAHER ENGINEERS.
- CATCH BASIN DATA AS SHOWN ON HISTORICAL PLANS FOR SITE DEVELOPMENT CELL 2, CELL 9, AND CELL 14 CONSTRUCTION AND CELL 12 CLOSURE.
- ALL SITE AND CONSTRUCTION ACTIVITIES SHALL BE IN COMPLIANCE WITH MEDEP BEST MANAGEMENT PRACTICES AND EXISTING FEDERAL, STATE, AND LOCAL PERMITS AND PERMITTING REQUIREMENTS FOR THE SITE.
- BASE GRADES REPRESENT THE TOP OF THE GAS COLLECTION SAND LAYER PRIOR TO INSTALLATION OF FINAL COVER SYSTEM 40 MIL TEXTURED HDPE GEOMEMBRANE. GRADES WITHIN THE LIMIT OF WORK REPRESENT A VERTICAL OFFSET OF 1.5-FEET FROM TOP OF FINAL COVER GRADES PROVIDED BY SARGENT CORP. ON NOVEMBER 5, 2024.
- CONTRACTOR SHALL PRESERVE THE EXISTING TEMPORARY CELL TOE DRAIN. EXISTING TOE DRAIN SHALL REMAIN TO COLLECT LEACHATE AND GAS BELOW THE COVER SYSTEM. CONTRACTOR SHALL ADD 8 OZ NON-WOVEN GEOTEXTILE OVER EXISTING CRUSHED STONE PRIOR TO PLACING WASTE/COVER SOIL MIXTURE OVER THE EXISTING TOE DRAIN.

ABANDONMENT SCHEDULE			
STRUCTURE ID	STRUCTURE TYPE	DIAMETER	MATERIAL
CB #13	CATCH BASIN	4'	CONCRETE
CB #14	CATCH BASIN	4'	CONCRETE
CB #17	CATCH BASIN	4'	CONCRETE
CB #21	CATCH BASIN	4'	CONCRETE
CB #22	CATCH BASIN	4'	CONCRETE
CB #23	CATCH BASIN	4'	CONCRETE
CB #24	CATCH BASIN	4'	CONCRETE
CB #25	CATCH BASIN	4'	CONCRETE
P-08-08	PIEZOMETER	1"	PVC
P-08-11A	PIEZOMETER	1"	PVC
P-08-11B	PIEZOMETER	1"	PVC
TEMPORARY CELL DMH-#1	DRAINAGE MANHOLE	4'	CONCRETE
TEMPORARY CELL DMH-#2	DRAINAGE MANHOLE	4'	CONCRETE

BDP	1/2025	RECORD DRAWING	
BDP	2/2024	ISSUED FOR BID AND MEDEP REVIEW	
REV.	BY	DATE	STATUS
<b>MAINE BUREAU OF GENERAL SERVICES</b> <b>DOLBY LANDFILL COVER UPGRADE</b> <b>PHASE 4</b> <b>EAST MILLINOCKET, MAINE</b> <b>BGS PROJECT 3754</b> <b>SITE BASE GRADING PLAN</b>			
		DESIGN BY: TJM DRAWN BY: BWB DATE: 1/2025 CHECKED BY: NMT LMN: C-104 CTB: SME-STD.CTB	
		ENVIRONMENTAL • CIVIL • GEOTECHNICAL • WATER • COMPLIANCE 4 Blanchard Road, PO Box 85A, Cumberland, Maine 04021 Phone 207.829.5016 • Fax 207.829.5692 • sme-engineers.com	
JOB NO. 231265.00		DWG FILE BASE	
		<b>C-104</b>	


H:\m\2025\231265\DWG\PHASE 4\LANDFILL COVER UPGRADE\PHASE 4\BASE GRADING PLAN.dwg, 01/15/2025 10:17:44 AM

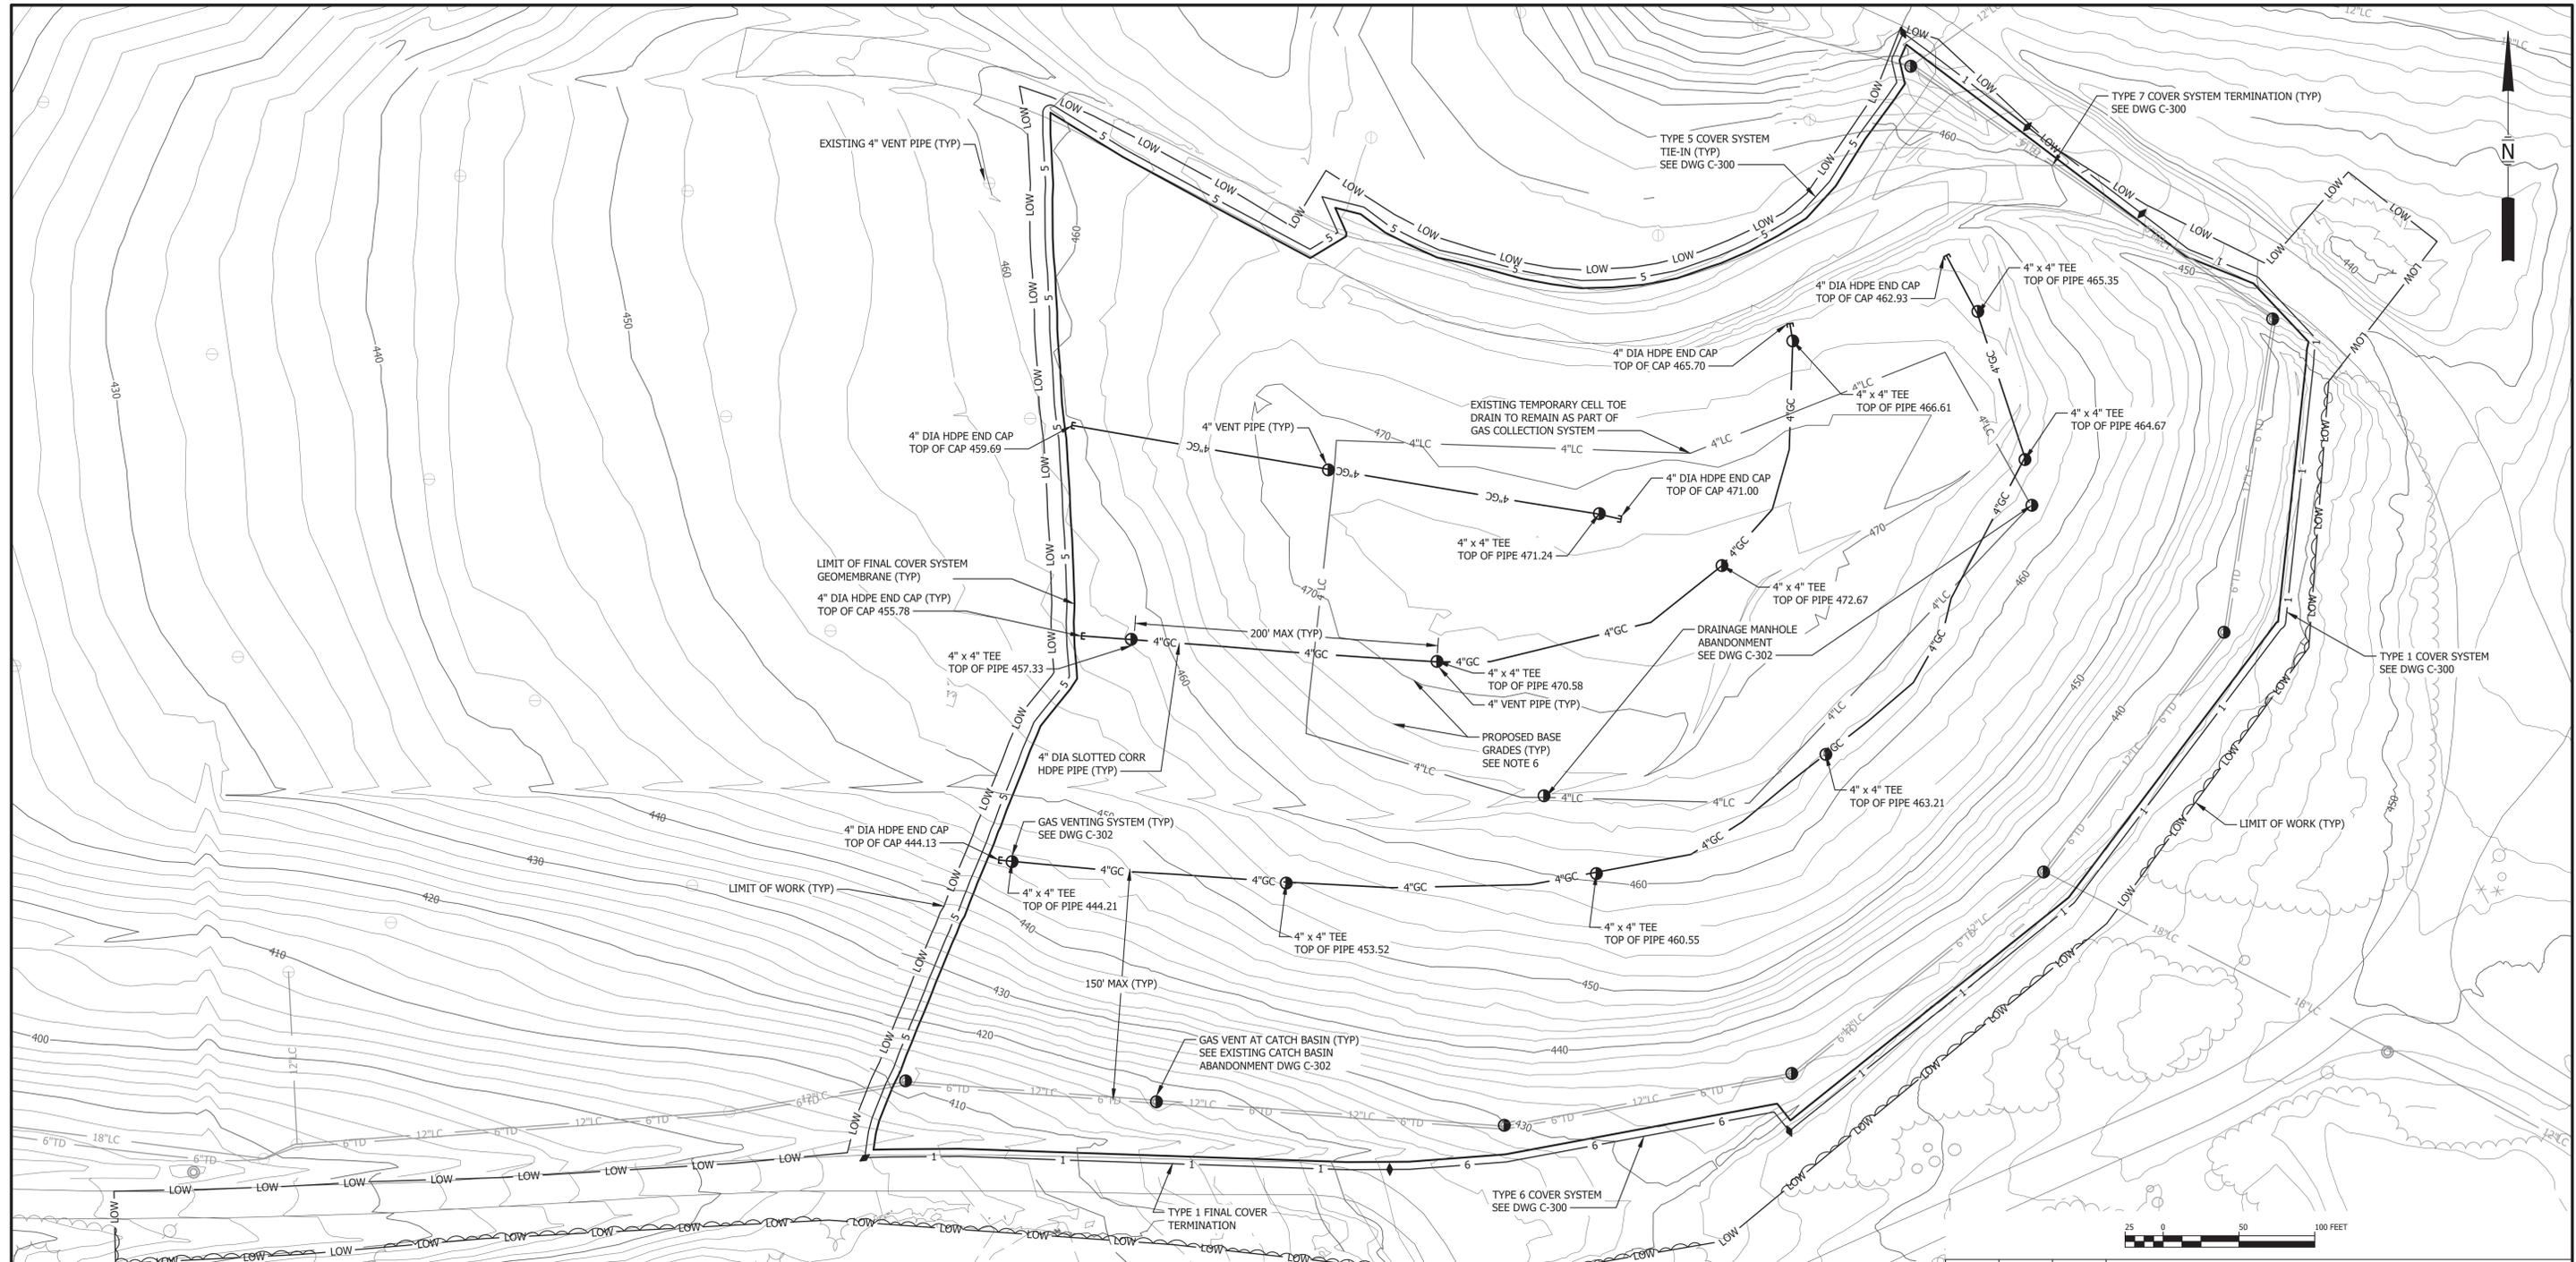

**NOTES**

1. BASE MAP PREPARED BY AERIAL SURVEY & PHOTO OF NORRIDGEWOCK, MAINE. PHOTO DATE 10/15/2015. HORIZONTAL DATUM HORIZONTAL DATUM MAINE STATE COORDINATE SYSTEM EAST ZONE, NAD 83. STANDARD PRACTICE DICTATES THAT PLANS COMPILED IN THIS MANNER SHOULD BE FIELD VERIFIED BY THE CONTRACTOR PRIOR TO CONSTRUCTION.
2. TOPOGRAPHY WITHIN LANDFILL LIMITS AND OUTSIDE PHASE 2 AND 3 COVER UPGRADE AREAS FROM AERIAL SURVEY PERFORMED BY SEVEE & MAHER ENGINEERS DATED 5/4/2021. TOPOGRAPHY WITHIN PHASE 2 AND 3 COVER UPGRADE AREAS PROVIDED BY GORDON CONTRACTING, INC., OF SANGERVILLE, MAINE ON NOVEMBER 14, 2023.
3. VERTICAL DATUM: NAVD 1929.
4. BORINGS PERFORMED BY MAINE TEST BORING. FIELD LOCATION, TEST PITS, AND LOGS BY SEVEE & MAHER ENGINEERS.
5. ALL SITE AND CONSTRUCTION ACTIVITIES SHALL BE IN COMPLIANCE WITH MEDEP BEST MANAGEMENT PRACTICES AND EXISTING FEDERAL, STATE, AND LOCAL PERMITS AND PERMITTING REQUIREMENTS FOR THE SITE.
6. BASE GRADES REPRESENT THE TOP OF THE GAS COLLECTION SAND LAYER PRIOR TO INSTALLATION OF FINAL COVER SYSTEM 40 MIL TEXTURED HDPE GEOMEMBRANE. GRADES WITHIN THE LIMIT OF WORK REPRESENT A VERTICAL OFFSET OF 1.5- FEET FROM TOP OF FINAL COVER GRADES PROVIDED BY SARGENT CORP. ON NOVEMBER 5, 2024
7. CONTRACTOR SHALL PRESERVE THE EXISTING TEMPORARY CELL TOE DRAIN. EXISTING TOE DRAIN SHALL REMAIN TO COLLECT LEACHATE AND GAS BELOW THE COVER SYSTEM. CONTRACTOR SHALL ADD 8 OZ NON-WOVEN GEOTEXTILE OVER EXISTING CRUSHED STONE PRIOR TO PLACING WASTE/COVER SOIL MIXTURE OVER THE EXISTING TOE DRAIN.

BDP	1/2025	RECORD DRAWING
BDP	2/2024	ISSUED FOR BID AND MEDEP REVIEW
REV.	BY	DATE
		STATUS

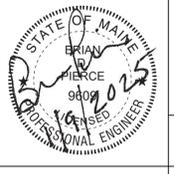

**MAINE BUREAU OF GENERAL SERVICES**  
**DOLBY LANDFILL COVER UPGRADE**  
**PHASE 4**  
**EAST MILLINOCKET, MAINE**  
**BGS PROJECT 3754**

**GAS COLLECTION PIPING PLAN**

DESIGN BY: TJM  
 DRAWN BY: BWB  
 DATE: 1/2025  
 CHECKED BY: NMT  
 LMN: C-105  
 CTB: SME-STD.CTB

**SME**  
**SEVEE & MAHER**  
**ENGINEERS**


ENVIRONMENTAL • CIVIL • GEOTECHNICAL • WATER • COMPLIANCE  
 4 Blanchard Road, PO Box 85A, Cumberland, Maine 04021  
 Phone 207.829.5016 • Fax 207.829.5692 • sme-engineers.com

JOB NO. 231265.00

DWG FILE BASE

**C-105**

H:\work\2025\231265\Phase 4\landfill\gas\piping\dwg\G-105\_192025\_121524.dwg

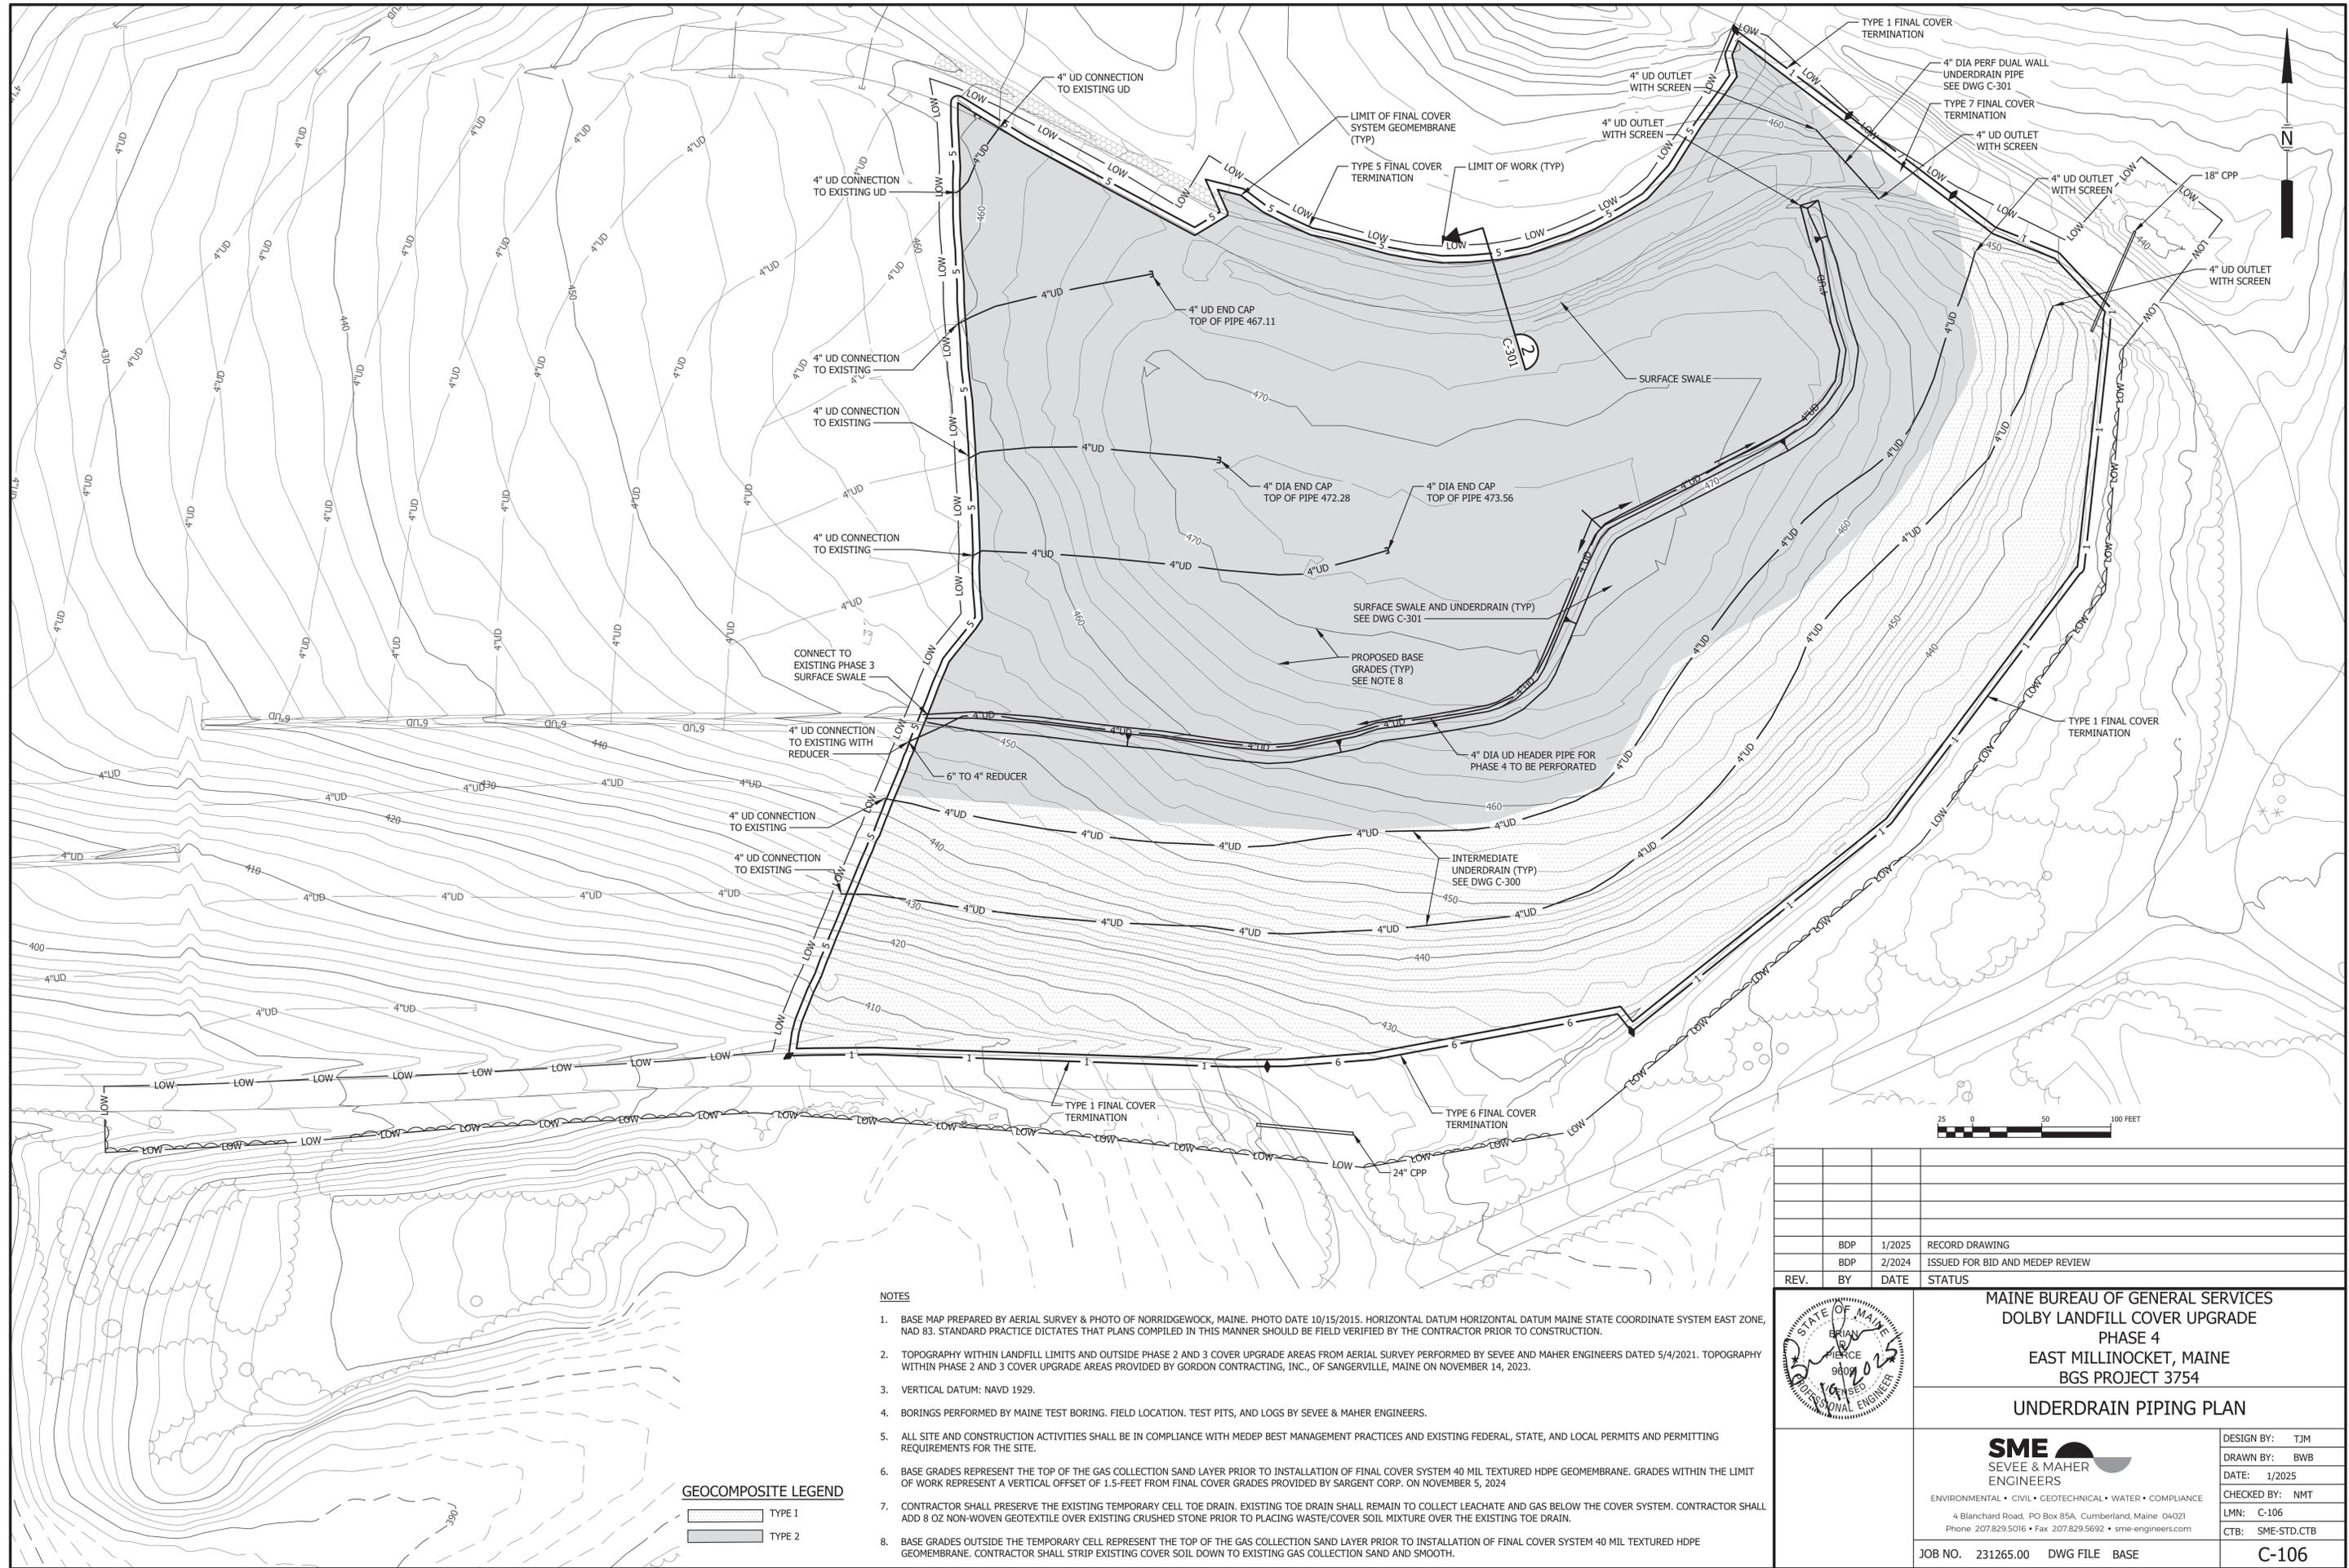

**NOTES**

1. BASE MAP PREPARED BY AERIAL SURVEY & PHOTO OF NORRIDGEWOCK, MAINE. PHOTO DATE 10/15/2015. HORIZONTAL DATUM HORIZONTAL DATUM MAINE STATE COORDINATE SYSTEM EAST ZONE, NAD 83. STANDARD PRACTICE DICTATES THAT PLANS COMPILED IN THIS MANNER SHOULD BE FIELD VERIFIED BY THE CONTRACTOR PRIOR TO CONSTRUCTION.
2. TOPOGRAPHY WITHIN LANDFILL LIMITS AND OUTSIDE PHASE 2 AND 3 COVER UPGRADE AREAS FROM AERIAL SURVEY PERFORMED BY SEVEE & MAHER ENGINEERS DATED 5/4/2021. TOPOGRAPHY WITHIN PHASE 2 AND 3 COVER UPGRADE AREAS PROVIDED BY GORDON CONTRACTING, INC., OF SANGERVILLE, MAINE ON NOVEMBER 14, 2023.
3. VERTICAL DATUM: NAVD 1929.
4. BORINGS PERFORMED BY MAINE TEST BORING. FIELD LOCATION, TEST PITS, AND LOGS BY SEVEE & MAHER ENGINEERS.
5. ALL SITE AND CONSTRUCTION ACTIVITIES SHALL BE IN COMPLIANCE WITH MEDEP BEST MANAGEMENT PRACTICES AND EXISTING FEDERAL, STATE, AND LOCAL PERMITS AND PERMITTING REQUIREMENTS FOR THE SITE.
6. BASE GRADES REPRESENT THE TOP OF THE GAS COLLECTION SAND LAYER PRIOR TO INSTALLATION OF FINAL COVER SYSTEM 40 MIL TEXTURED HDPE GEOMEMBRANE. GRADES WITHIN THE LIMIT OF WORK REPRESENT A VERTICAL OFFSET OF 1.5- FEET FROM FINAL COVER GRADES PROVIDED BY SARGENT CORP. ON NOVEMBER 5, 2024
7. CONTRACTOR SHALL PRESERVE THE EXISTING TEMPORARY CELL TOE DRAIN. EXISTING TOE DRAIN SHALL REMAIN TO COLLECT LEACHATE AND GAS BELOW THE COVER SYSTEM. CONTRACTOR SHALL ADD 8 OZ NON-WOVEN GEOTEXTILE OVER EXISTING CRUSHED STONE PRIOR TO PLACING WASTE/COVER SOIL MIXTURE OVER THE EXISTING TOE DRAIN.
8. BASE GRADES OUTSIDE THE TEMPORARY CELL REPRESENT THE TOP OF THE GAS COLLECTION SAND LAYER PRIOR TO INSTALLATION OF FINAL COVER SYSTEM 40 MIL TEXTURED HDPE GEOMEMBRANE. CONTRACTOR SHALL STRIP EXISTING COVER SOIL DOWN TO EXISTING GAS COLLECTION SAND AND SMOOTH.

**GEOCOMPOSITE LEGEND**

- TYPE 1
- TYPE 2

BDP	1/2025	RECORD DRAWING	
BDP	2/2024	ISSUED FOR BID AND MEDEP REVIEW	
REV.	BY	DATE	STATUS

**MAINE BUREAU OF GENERAL SERVICES**  
**DOLBY LANDFILL COVER UPGRADE**  
**PHASE 4**  
**EAST MILLINOCKET, MAINE**  
**BGS PROJECT 3754**

**UNDERDRAIN PIPING PLAN**

**SME**  
**SEVEE & MAHER**  
**ENGINEERS**

ENVIRONMENTAL • CIVIL • GEOTECHNICAL • WATER • COMPLIANCE  
 4 Blanchard Road, PO Box 85A, Cumberland, Maine 04021  
 Phone 207.829.5016 • Fax 207.829.5692 • sme-engineers.com


DESIGN BY: TJM  
 DRAWN BY: BWB  
 DATE: 1/2025  
 CHECKED BY: NMT  
 LMN: C-106  
 CTB: SME-STD.CTB

JOB NO. 231265.00

DWG FILE BASE

**C-106**

H:\work\2025\231265\Phase 4\UnderdrainPiping.dwg, 01.08.19.2025 13:54:24, 14

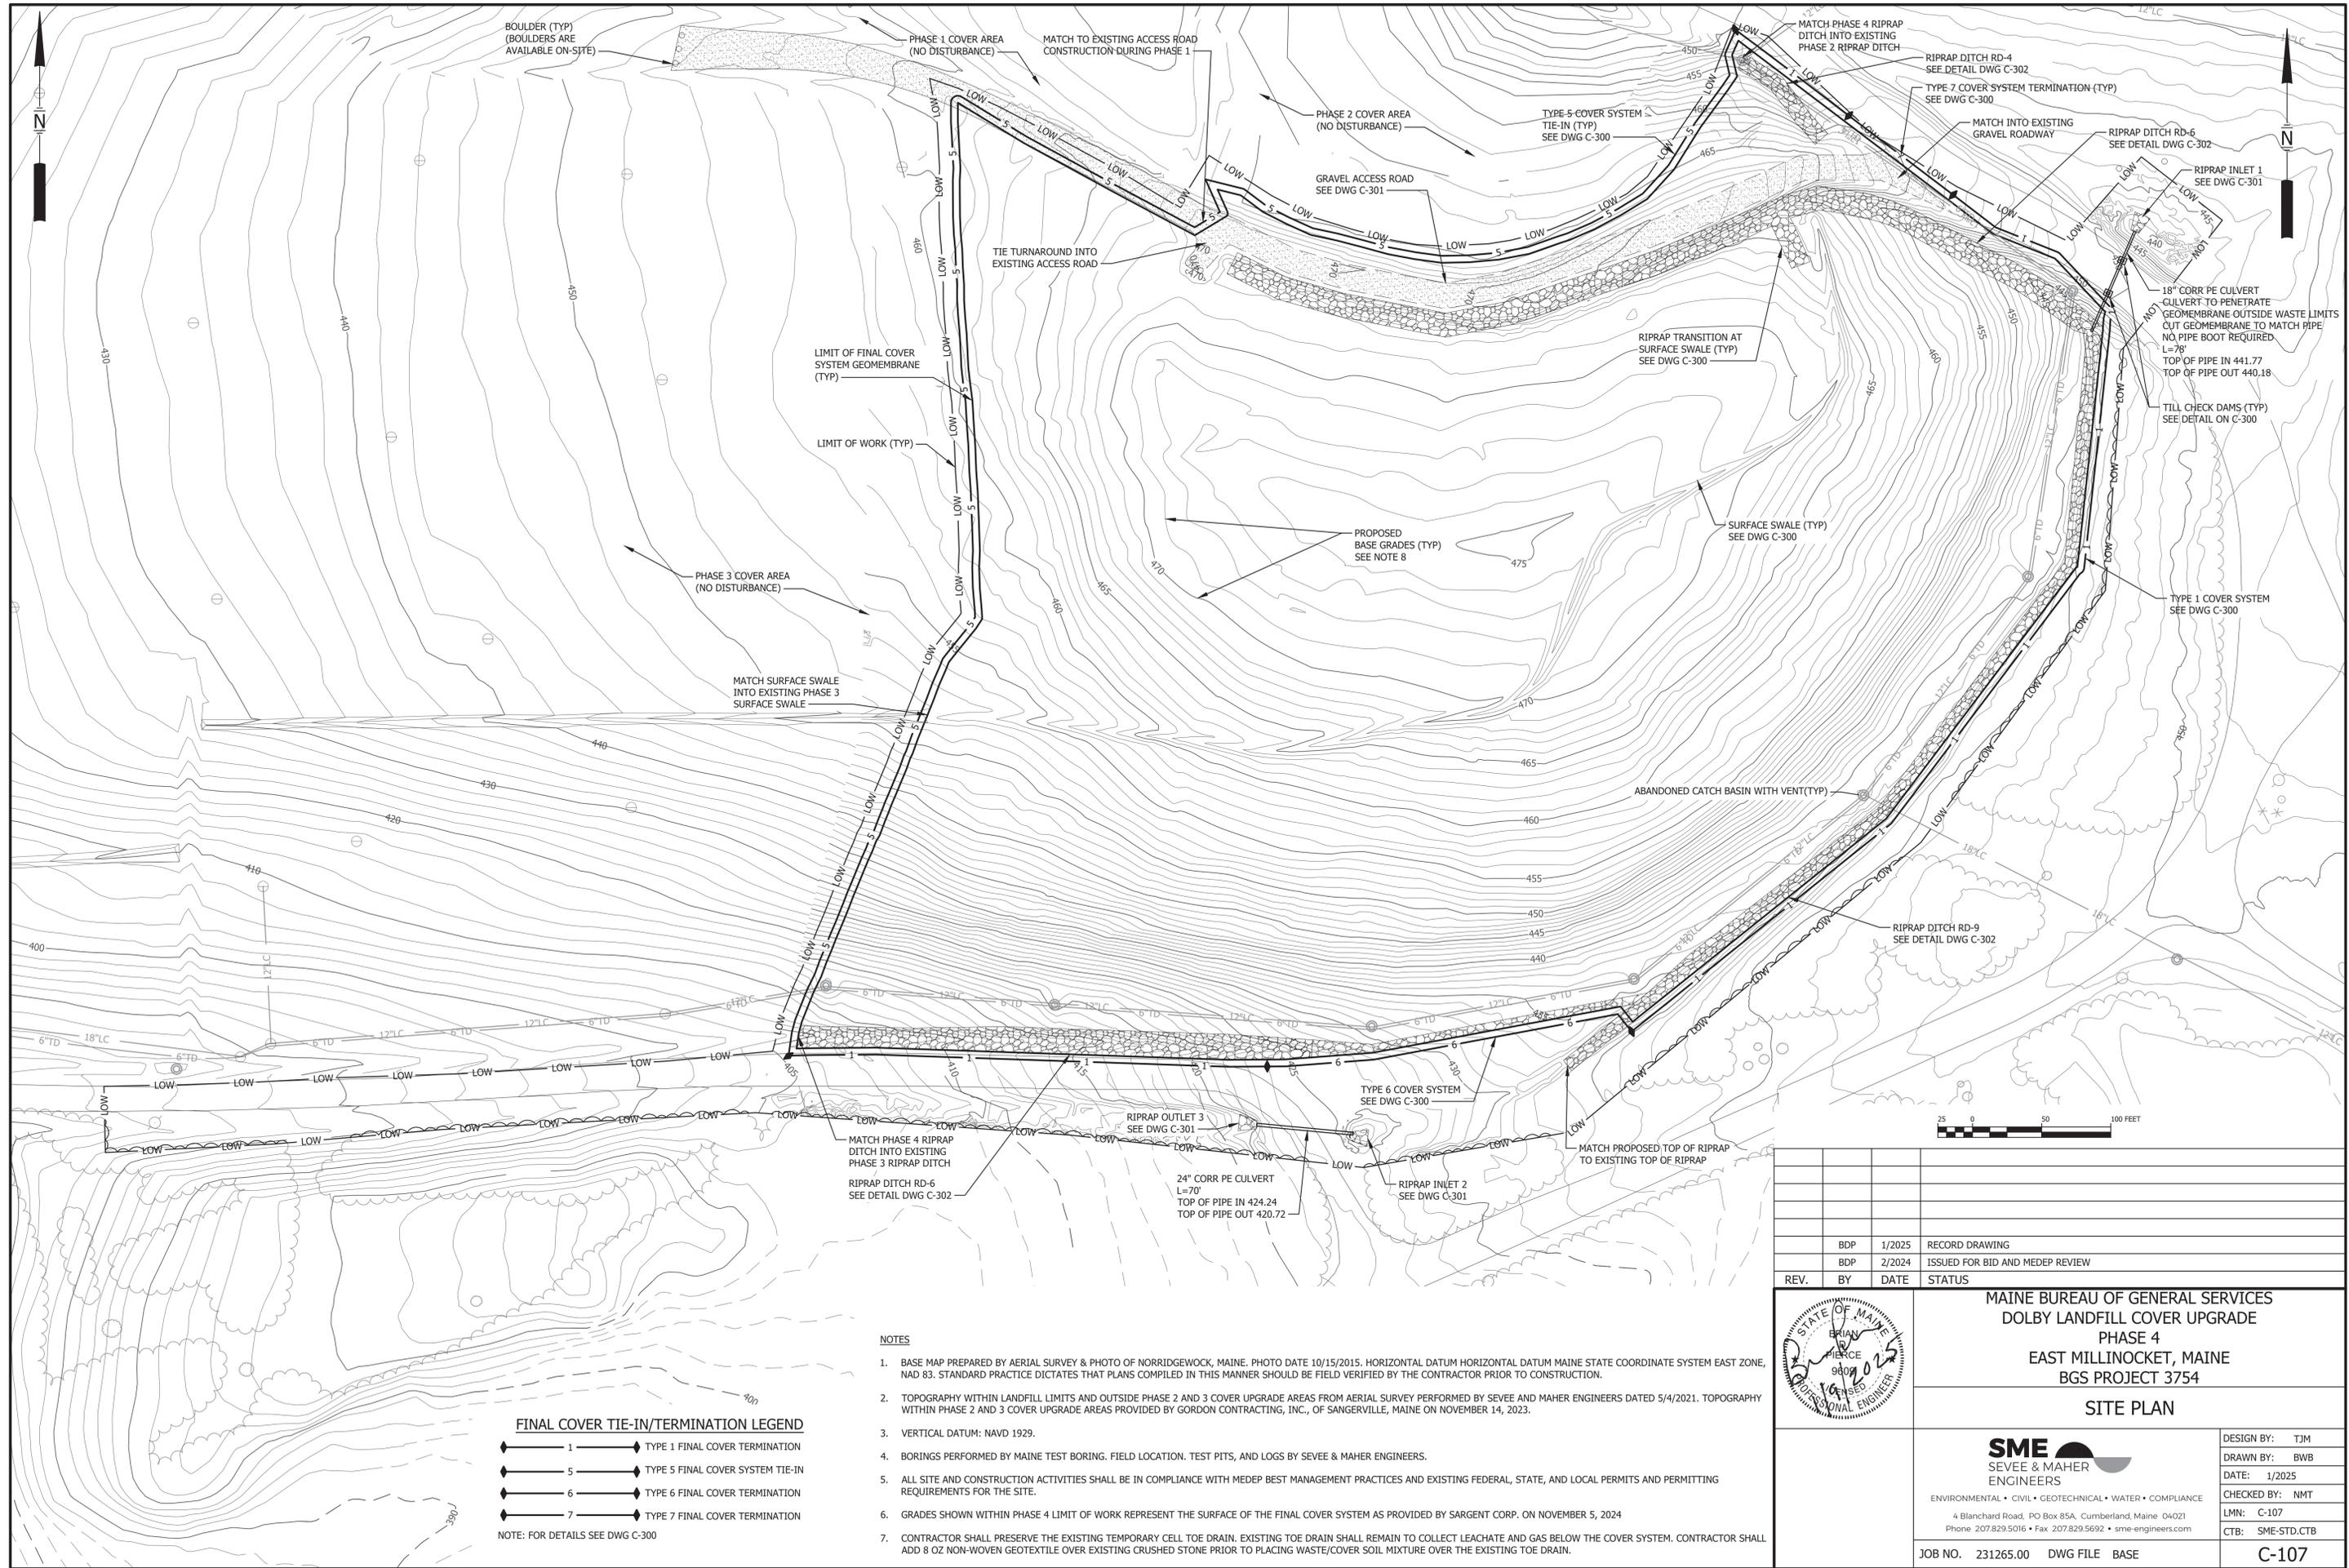

**FINAL COVER TIE-IN/TERMINATION LEGEND**

1	TYPE 1 FINAL COVER TERMINATION
5	TYPE 5 FINAL COVER SYSTEM TIE-IN
6	TYPE 6 FINAL COVER TERMINATION
7	TYPE 7 FINAL COVER TERMINATION

NOTE: FOR DETAILS SEE DWG C-300

**NOTES**

- BASE MAP PREPARED BY AERIAL SURVEY & PHOTO OF NORRIDGEWOCK, MAINE. PHOTO DATE 10/15/2015. HORIZONTAL DATUM HORIZONTAL DATUM MAINE STATE COORDINATE SYSTEM EAST ZONE, NAD 83. STANDARD PRACTICE DICTATES THAT PLANS COMPILED IN THIS MANNER SHOULD BE FIELD VERIFIED BY THE CONTRACTOR PRIOR TO CONSTRUCTION.
- TOPOGRAPHY WITHIN LANDFILL LIMITS AND OUTSIDE PHASE 2 AND 3 COVER UPGRADE AREAS FROM AERIAL SURVEY PERFORMED BY SEVEE AND MAHER ENGINEERS DATED 5/4/2021. TOPOGRAPHY WITHIN PHASE 2 AND 3 COVER UPGRADE AREAS PROVIDED BY GORDON CONTRACTING, INC., OF SANGERVILLE, MAINE ON NOVEMBER 14, 2023.
- VERTICAL DATUM: NAVD 1929.
- BORINGS PERFORMED BY MAINE TEST BORING. FIELD LOCATION, TEST PITS, AND LOGS BY SEVEE & MAHER ENGINEERS.
- ALL SITE AND CONSTRUCTION ACTIVITIES SHALL BE IN COMPLIANCE WITH MEDEP BEST MANAGEMENT PRACTICES AND EXISTING FEDERAL, STATE, AND LOCAL PERMITS AND PERMITTING REQUIREMENTS FOR THE SITE.
- GRADES SHOWN WITHIN PHASE 4 LIMIT OF WORK REPRESENT THE SURFACE OF THE FINAL COVER SYSTEM AS PROVIDED BY SARGENT CORP. ON NOVEMBER 5, 2024
- CONTRACTOR SHALL PRESERVE THE EXISTING TEMPORARY CELL TOE DRAIN. EXISTING TOE DRAIN SHALL REMAIN TO COLLECT LEACHATE AND GAS BELOW THE COVER SYSTEM. CONTRACTOR SHALL ADD 8 OZ NON-WOVEN GEOTEXTILE OVER EXISTING CRUSHED STONE PRIOR TO PLACING WASTE/COVER SOIL MIXTURE OVER THE EXISTING TOE DRAIN.

BDP	1/2025	RECORD DRAWING
BDP	2/2024	ISSUED FOR BID AND MEDEP REVIEW
REV.	BY	DATE
		STATUS

MAINE BUREAU OF GENERAL SERVICES  
DOLBY LANDFILL COVER UPGRADE  
PHASE 4  
EAST MILLINOCKET, MAINE  
BGS PROJECT 3754


**SITE PLAN**

**SME**  
SEVEE & MAHER  
ENGINEERS  
ENVIRONMENTAL • CIVIL • GEOTECHNICAL • WATER • COMPLIANCE  
4 Blanchard Road, PO Box 85A, Cumberland, Maine 04021  
Phone 207.829.5016 • Fax 207.829.5692 • sme-engineers.com


DESIGN BY: TJM  
DRAWN BY: BWB  
DATE: 1/2025  
CHECKED BY: NMT  
LMN: C-107  
CTB: SME-STD.CTB

JOB NO. 231265.00 DWG FILE BASE **C-107**


H:\work\2025\231265\DWG\Phase 4\landfill\cover\upgrade\c-107\_192025\_112025.dwg  
 1/20/25 11:20:25 AM

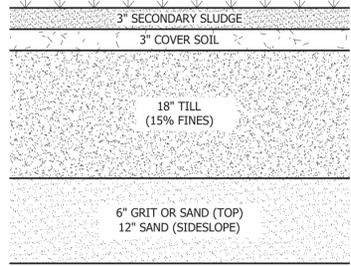


**DOLBY III - EXISTING COVER 1**  
NTS

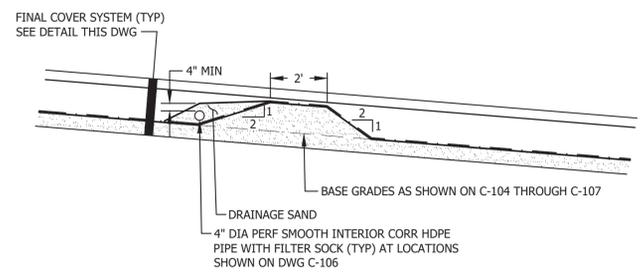

**INTERMEDIATE UNDERDRAIN**  
NTS

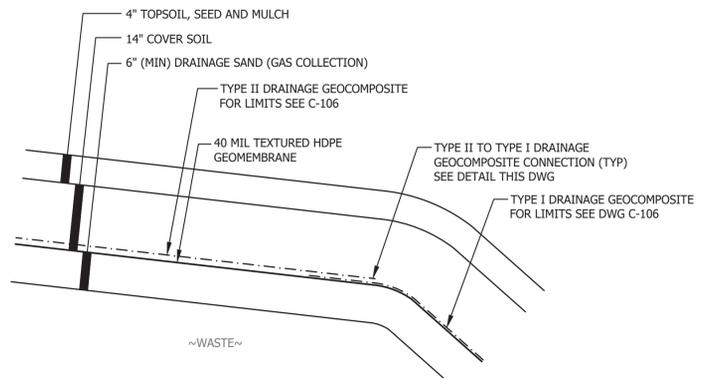


**FINAL COVER SYSTEM**  
NTS

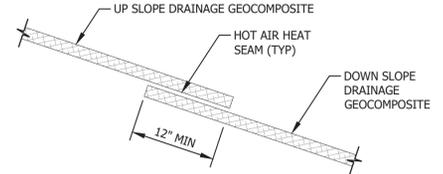


NOTE:  
CONTRACTOR SHALL MAKE CONNECTION AT LOCATIONS SHOWN ON THE DRAWINGS.


**TYPE II TO TYPE I DRAINAGE GEOCOMPOSITE CONNECTION**  
NTS

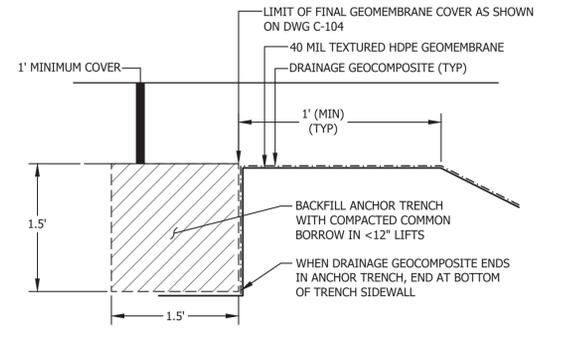


**ANCHOR TRENCH**  
NTS

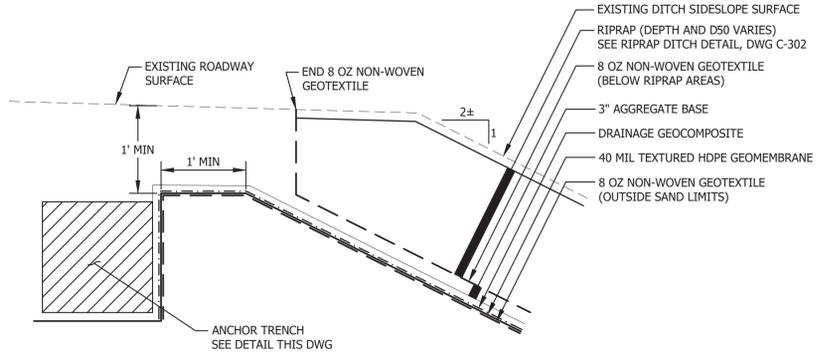


**TYPE 1 FINAL COVER TERMINATION**  
NTS

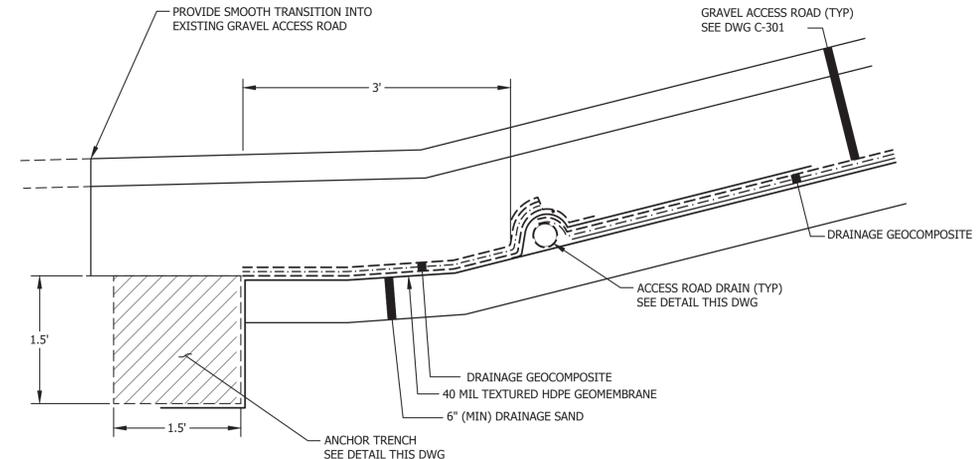


**TYPE 7 FINAL COVER TERMINATION**  
NTS

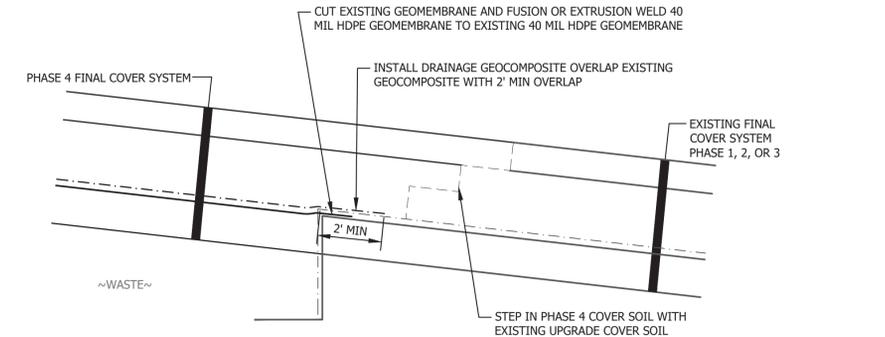


**TYPE 5 FINAL COVER TIE-IN**  
NTS

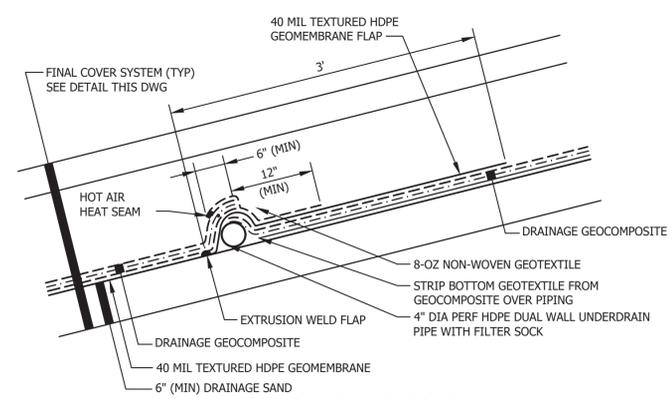


**ACCESS ROAD DRAIN**  
NTS

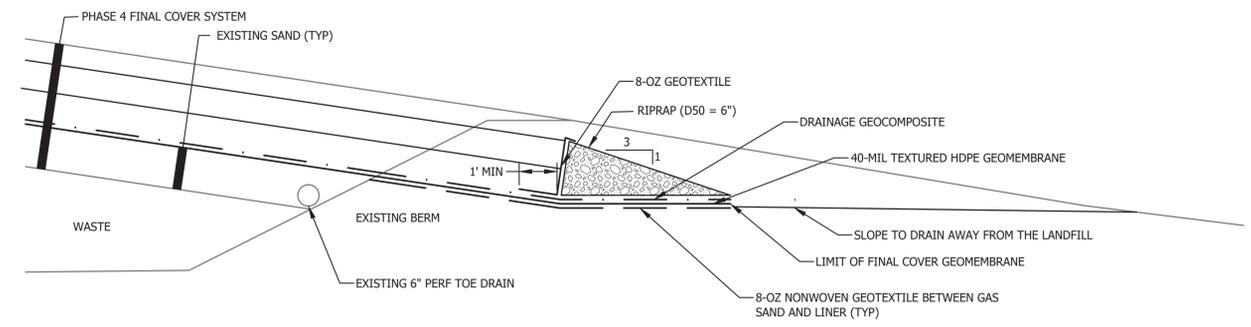

**TYPE 6 FINAL COVER TERMINATION**  
NTS

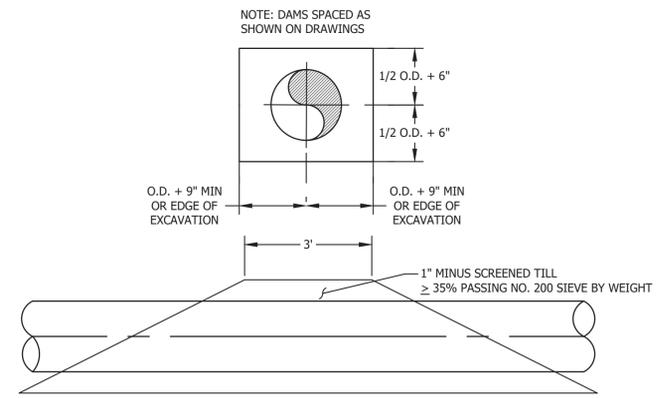

**TILL DAM**  
NTS

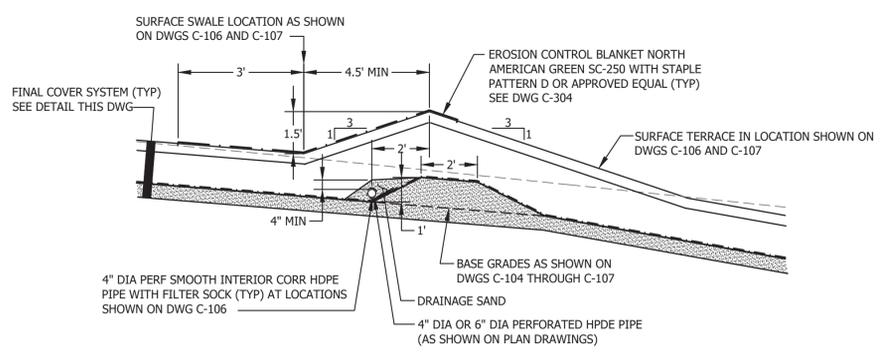

**SURFACE SWALE AND UNDERDRAIN**  
NTS

BDP	1/2025	RECORD DRAWING	
BDP	2/2024	ISSUED FOR BID AND MEDEP REVIEW	
REV.	BY	DATE	STATUS


MAINE BUREAU OF GENERAL SERVICES  
DOLBY LANDFILL COVER UPGRADE  
PHASE 4  
EAST MILLINOCKET, MAINE  
BGS PROJECT 3754

**SECTIONS AND DETAILS**


**SME SEVEE & MAHER ENGINEERS**  
ENVIRONMENTAL • CIVIL • GEOTECHNICAL • WATER • COMPLIANCE  
4 Blanchard Road, PO Box 85A, Cumberland, Maine 04021  
Phone 207.829.5016 • Fax 207.829.5692 • sme-engineers.com

DESIGN BY: TJM  
DRAWN BY: BWB  
DATE: 11/2024  
CHECKED BY: BDP  
LMN: NONE  
CTB: SME-STD


JOB NO. 231265.00 DWG FILE DETAILS **C-300**

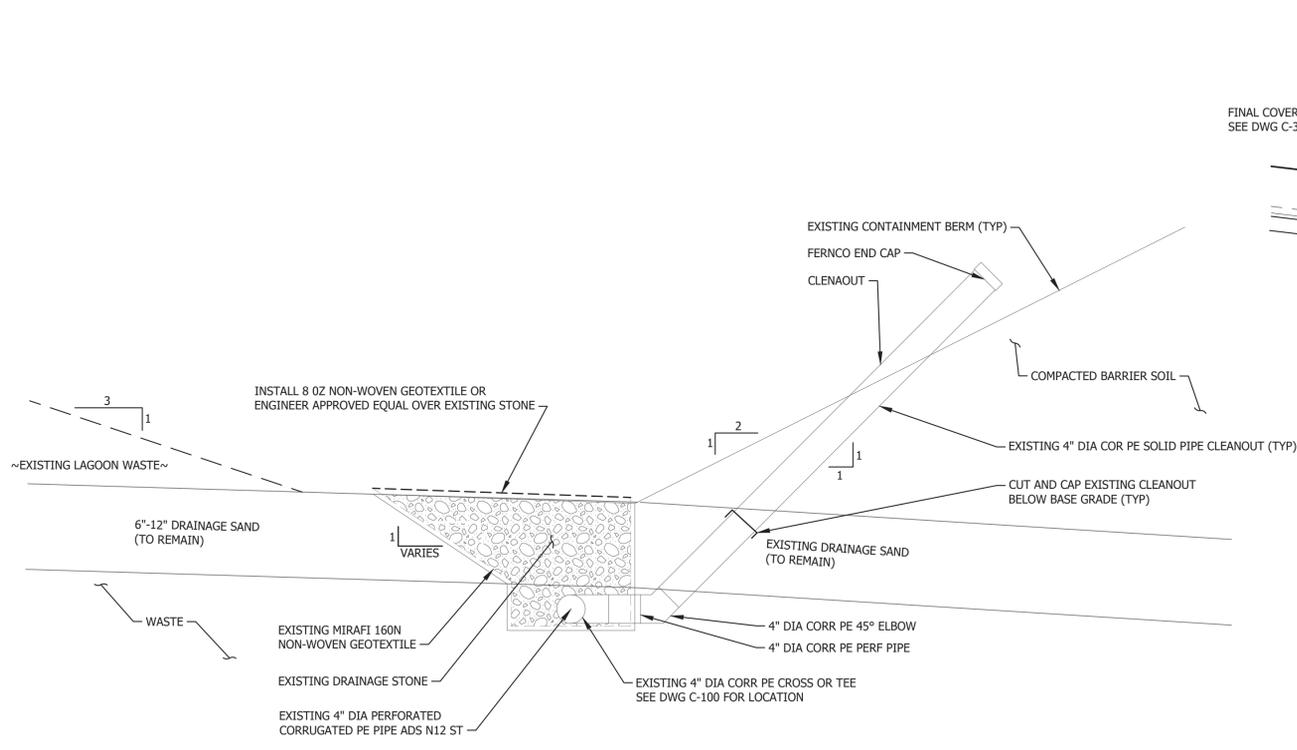


**EXISTING TEMPORARY CELL LEACHATE COLLECTION TOE DRAIN AND CLEANOUT**  
NTS

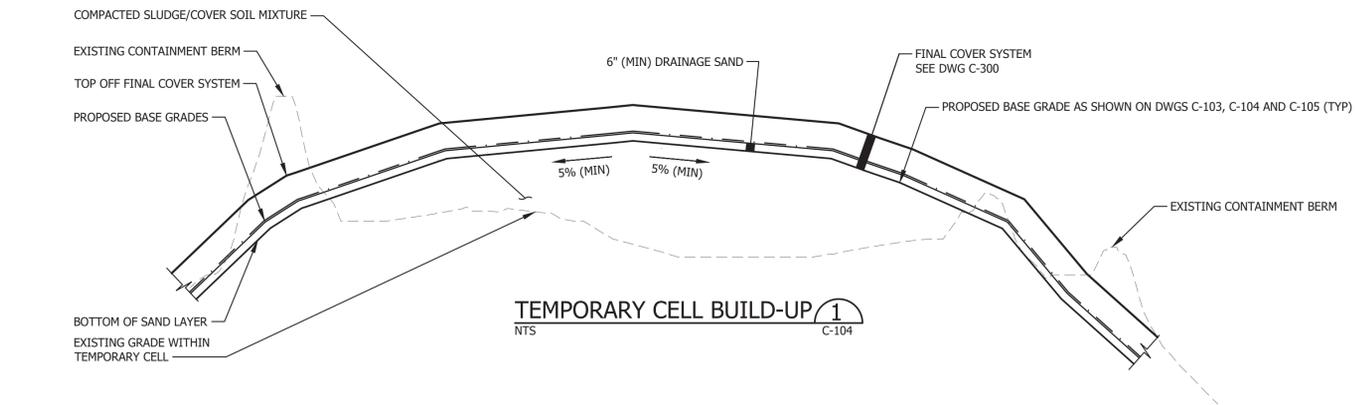


**TEMPORARY CELL BUILD-UP 1**  
NTS C-104

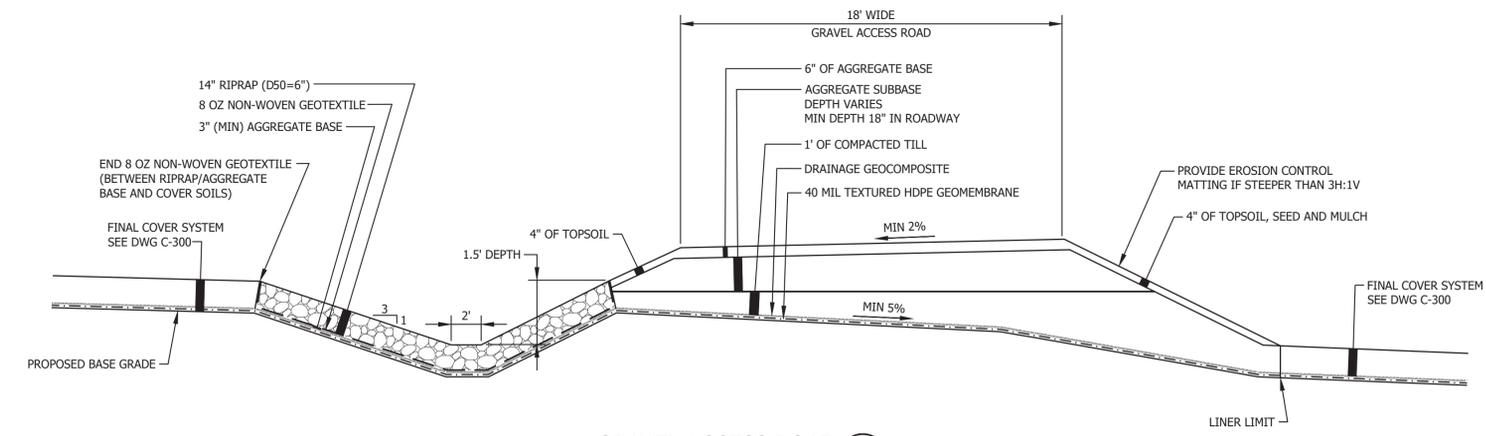

**GRAVEL ACCESS ROAD 2**  
NTS C-105, C-106, AND C-107

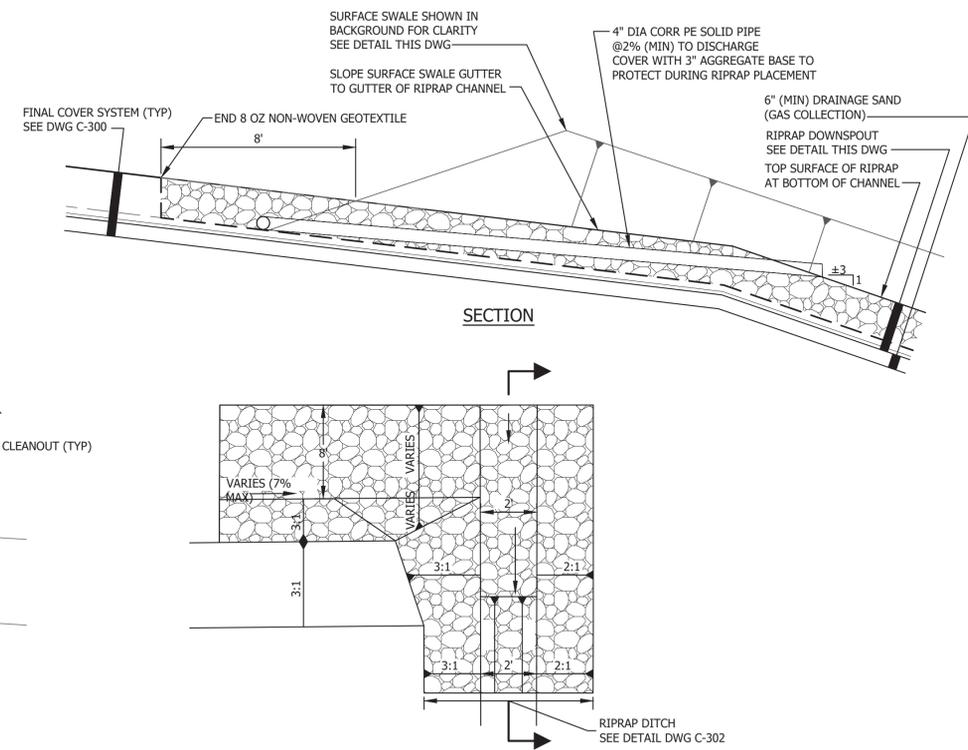


**SECTION**

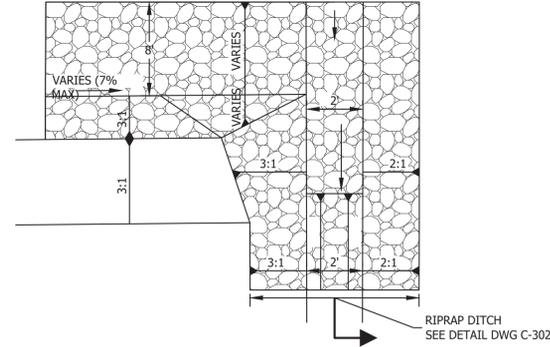

**PLAN VIEW**

**RIPRAP TRANSITION AT SURFACE SWALE**  
NTS

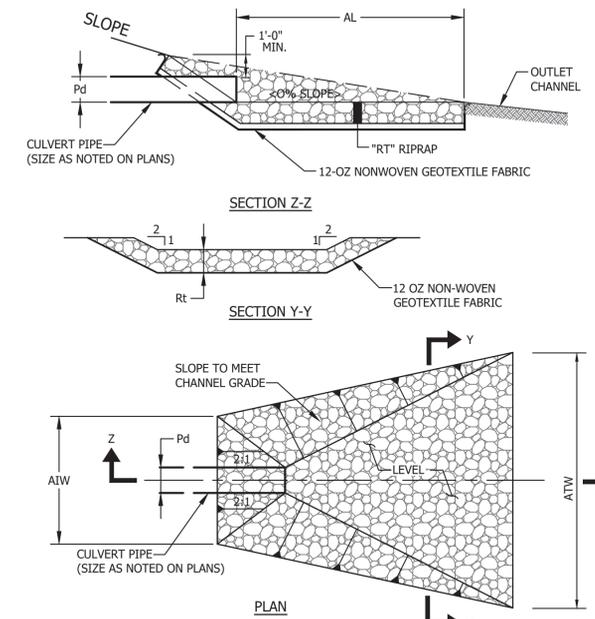

**SECTION Z-Z**






**SECTION Y-Y**

**PLAN**

INLET/OUTLET NO.	PIPE DIA. Pd (IN)	D50	THICK RT (IN)	LENGTH AL (FT)	INITIAL WIDTH AIW (FT)	TERMINAL WIDTH ATW (FT)
1	18	6	18	13	6	12
2	24	6	18	13	6	12
3	24	6	18	13	6	12


**RIPRAP APRON AT PIPE INLET/OUTLET**  
NTS

BDP	1/2025	RECORD DRAWING	
BDP	2/2024	ISSUED FOR BID AND MEDEP REVIEW	
REV.	BY	DATE	STATUS
<b>MAINE BUREAU OF GENERAL SERVICES</b> <b>DOLBY LANDFILL COVER UPGRADE</b> <b>PHASE 4</b> <b>EAST MILLINOCKET, MAINE</b> <b>BGS PROJECT 3754</b>			
<b>SECTIONS AND DETAILS</b>			
		DESIGN BY: TJM DRAWN BY: BWB DATE: 11/2024 CHECKED BY: BDP LMN: NONE CTB: SME-STD	
ENVIRONMENTAL • CIVIL • GEOTECHNICAL • WATER • COMPLIANCE 4 Blanchard Road, PO Box 85A, Cumberland, Maine 04021 Phone 207.829.5016 • Fax 207.829.5692 • sme-engineers.com		JOB NO. 231265.00 DWG FILE DETAILS	
			<b>C-301</b>

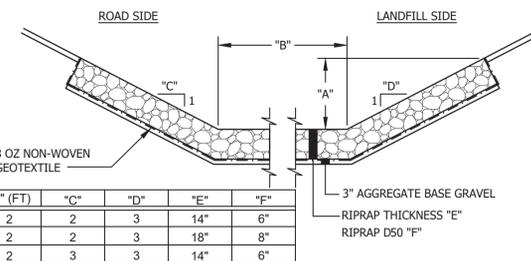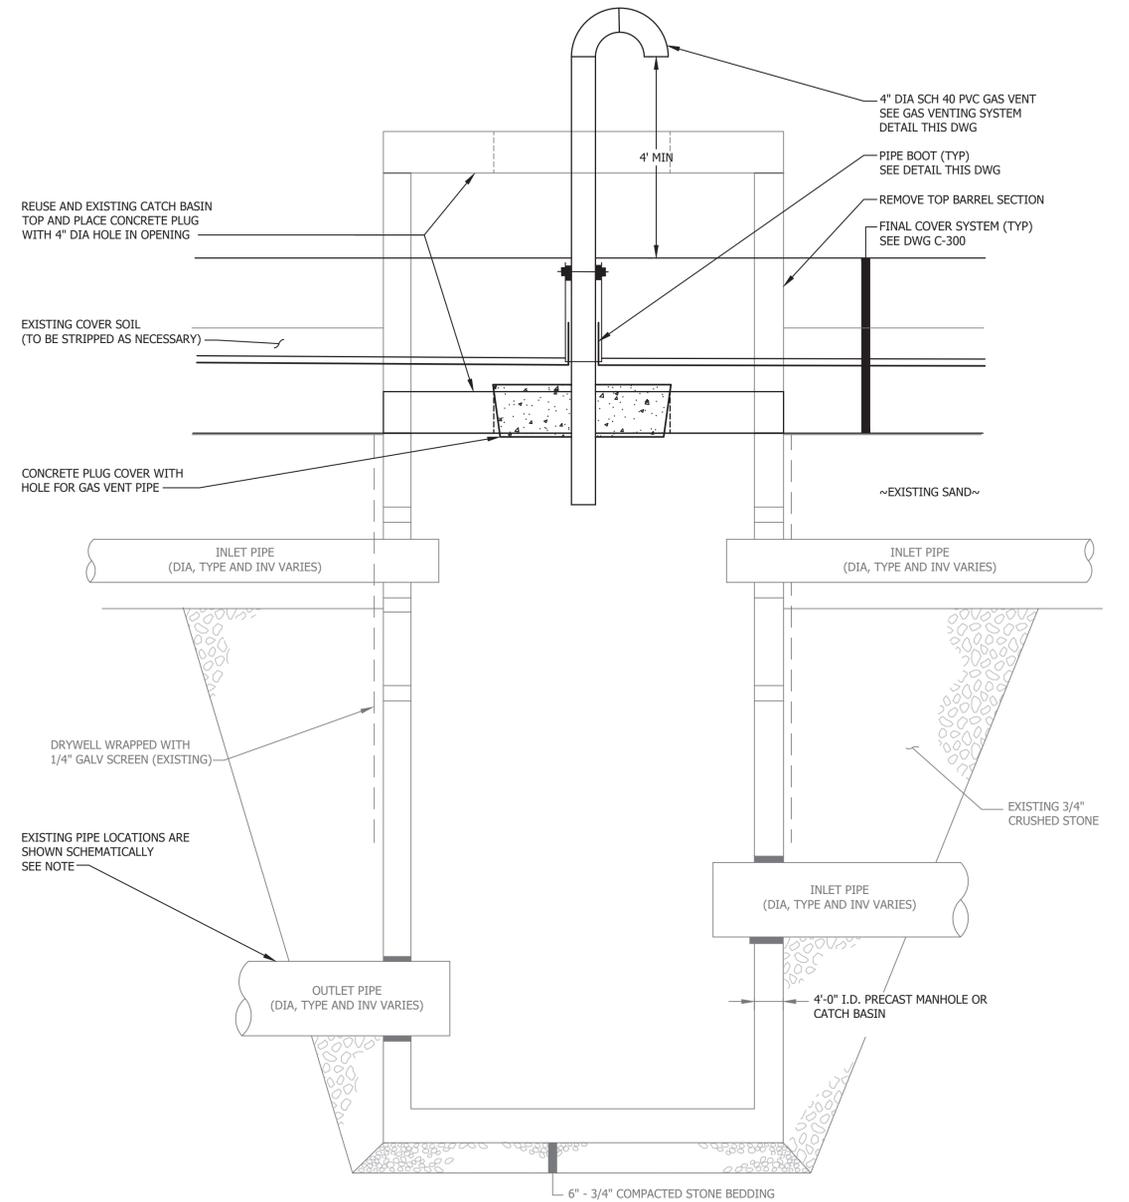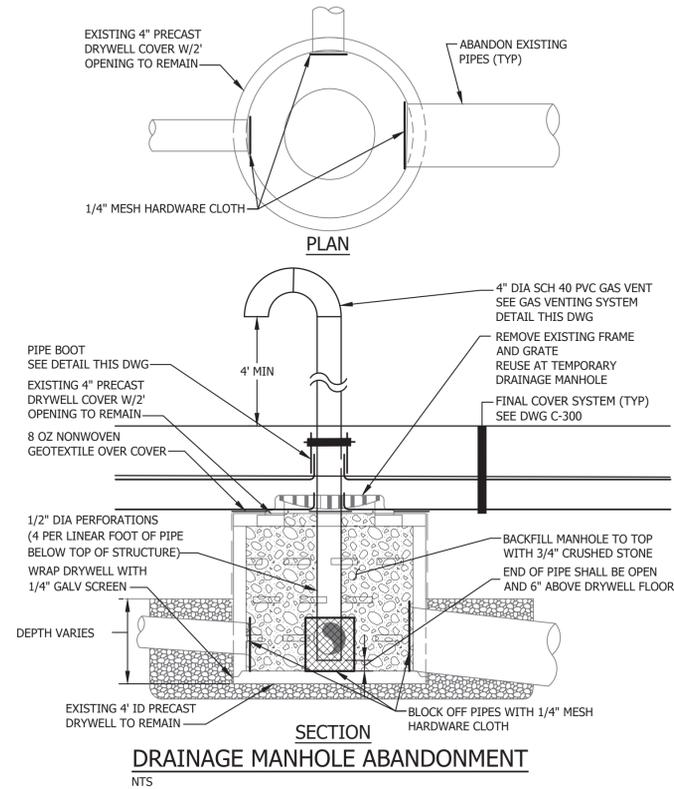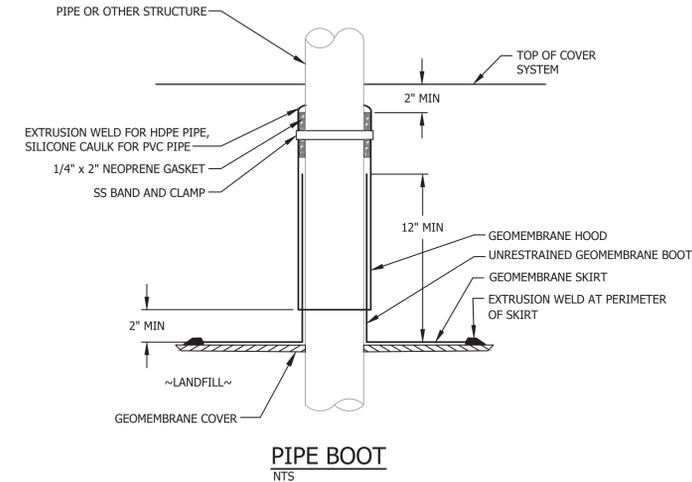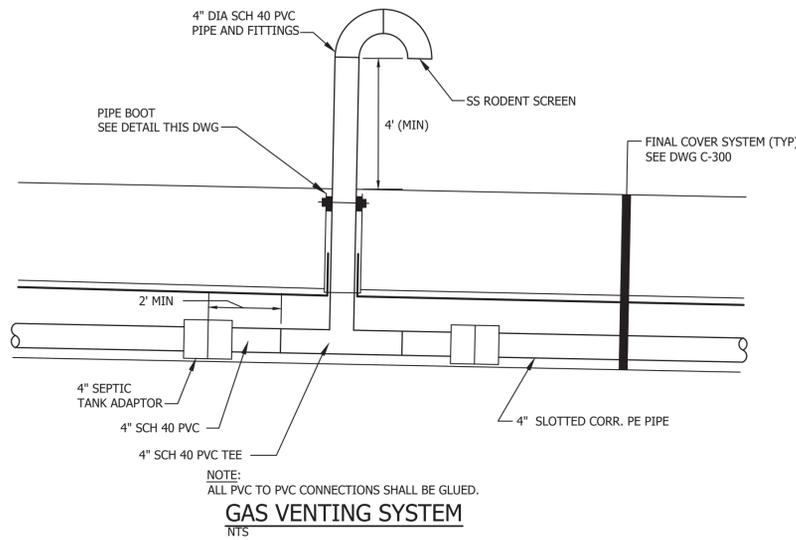


DITCH	"A" (FT)	"B" (FT)	"C"	"D"	"E"	"F"
RD-4	2	2	2	3	14"	6"
RD-6	1.5	2	2	3	18"	8"
RD-9	1.5	2	3	3	14"	6"

BDP	1/2025	RECORD DRAWING	
BDP	2/2024	ISSUED FOR BID AND MEDEP REVIEW	
REV.	BY	DATE	STATUS
<b>MAINE BUREAU OF GENERAL SERVICES</b> <b>DOLBY LANDFILL COVER UPGRADE</b> <b>PHASE 4</b> <b>EAST MILLINOCKET, MAINE</b> <b>BGS PROJECT 3754</b>			
<b>SECTIONS AND DETAILS</b>			
		DESIGN BY: TJM DRAWN BY: BWB DATE: 11/2024 CHECKED BY: BDP LMN: NONE CTB: SME-STD	
<b>SME</b> <b>SEVEE &amp; MAHER</b> <b>ENGINEERS</b> ENVIRONMENTAL • CIVIL • GEOTECHNICAL • WATER • COMPLIANCE 4 Blanchard Road, PO Box 85A, Cumberland, Maine 04021 Phone 207.829.5016 • Fax 207.829.5692 • sme-engineers.com		JOB NO. 231265.00 DWG FILE DETAILS <b>C-302</b>	


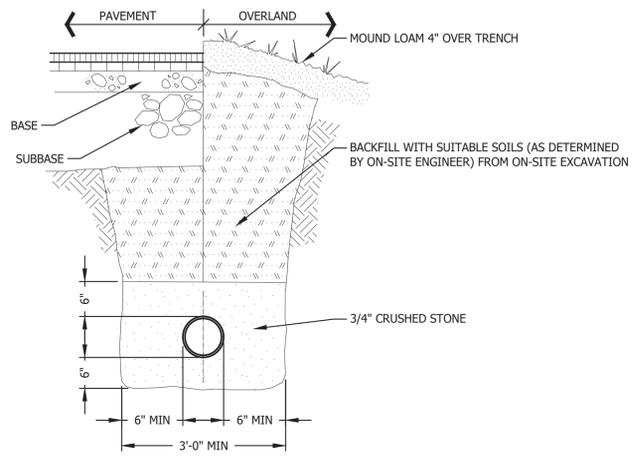


**TYPICAL TRENCH SECTION**  
NTS

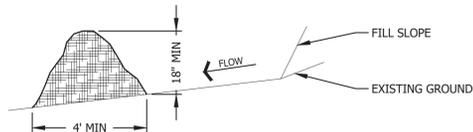


**EROSION CONTROL MIX SEDIMENT BARRIER**  
NTS

- NOTES:**
- EROSION CONTROL MIX CAN BE MANUFACTURED ON OR OFF THE SITE. IT MUST CONSIST PRIMARILY OF ORGANIC MATERIAL SEPARATED AT THE POINT OF GENERATION, AND MAY INCLUDE: SHREDDED BARK, STUMP GRINDINGS, COMPOSTED BARK, OR FLUME GRIT AND FRAGMENTED WOOD GENERATED FROM WATER-FLUME LOG HANDLING SYSTEMS, WOOD CHIPS, GROUND CONSTRUCTION DEBRIS, REPROCESSED WOOD PRODUCTS OR BARK CHIPS WILL NOT BE ACCEPTABLE AS THE ORGANIC COMPONENT OF THE MIX. EROSION CONTROL MIX SHALL CONTAIN A WELL-GRADED MIXTURE OF PARTICLE SIZES AND MAY CONTAIN ROCKS LESS THAN 4" IN DIAMETER. EROSION CONTROL MIX MUST BE FREE OF REFUSE, PHYSICAL CONTAMINANTS, AND MATERIAL TOXIC TO PLANT GROWTH.  
 THE MIX COMPOSITION SHALL MEET THE FOLLOWING STANDARDS:  
 A. ORGANIC MATERIAL, BETWEEN 20% - 100% (DRY WEIGHT BASIS)  
 B. PARTICLE SIZE: BY WEIGHT, 100% PASSING #4 SCREEN, 70-85% PASSING 0.75" SCREEN  
 C. THE ORGANIC PORTION NEEDS TO BE FIBROUS AND ELONGATED.  
 D. LARGE PORTIONS OF SILTS, CLAYS OR FINE SANDS ARE NOT ACCEPTABLE IN THE MIX.  
 E. SOLUBLE SALTS CONTENT SHALL BE LESS THAN 4.0 MMHOS/CM.  
 F. PH: 5.0 - 8.0
  - ON SLOPES LESS THAN 5% OR AT THE BOTTOM OF SLOPES 2:1 OR LESS UP TO 20 FEET LONG, THE BARRIER MUST CONFORM TO THE ABOVE DIMENSIONS. ON THE LONGER OR STEEPER SLOPES, THE BARRIER SHOULD BE WIDER TO ACCOMMODATE THE ADDITIONAL FLOW.
  - THE BARRIER MUST BE PLACED ALONG A RELATIVELY LEVEL ELEVATION. IT MAY BE NECESSARY TO CUT TALL GRASSES OR WOODY VEGETATION TO AVOID CREATING VOIDS AND BRIDGES THAT WOULD ENABLE FINES TO WASH UNDER THE BARRIER THROUGH THE GRASS BLADES OR PLANT STEMS.
  - LOCATIONS WHERE OTHER BMP'S SHOULD BE USED:  
 A. AT LOW POINTS OF CONCENTRATED FLOW  
 B. BELOW CULVERT OUTLET APRONS  
 C. WHERE A PREVIOUS STAND-ALONE EROSION CONTROL MIX APPLICATION HAS FAILED  
 D. AT THE BOTTOM OF STEEP PERIMETER SLOPES THAT ARE MORE THAN 50 FEET FROM TOP TO BOTTOM (LARGE UPGRADE WATERSHED)  
 E. AROUND CATCH BASINS AND CLOSED STORM DRAIN SYSTEMS
  - THE EROSION CONTROL MIX BARRIERS SHOULD BE INSPECTED REGULARLY AND AFTER EACH LARGE RAINFALL. REPAIR ALL DAMAGED SECTIONS OF BERM IMMEDIATELY BY REPLACING OR ADDING ADDITIONAL MATERIAL PLACED ON THE BERM TO THE DESIRED HEIGHT AND WIDTH.
  - IT MAY BE NECESSARY TO REINFORCE THE BARRIER WITH SILT FENCE OR STONE CHECK DAMS IF THERE ARE SIGNS OF UNDERCUTTING OR THE IMPOUNDMENT OF LARGE VOLUMES OF WATER.
  - SEDIMENT DEPOSITS SHOULD BE REMOVED WHEN THEY REACH APPROXIMATELY ONE-HALF THE HEIGHT OF THE BARRIER.
  - REPLACE SECTIONS OF BERM THAT DECOMPOSE, BECOME CLOGGED WITH SEDIMENT OR OTHERWISE BECOME INEFFECTIVE. THE BARRIER SHOULD BE RESHAPED AS NEEDED.
  - EROSION CONTROL MIX BARRIERS CAN BE LEFT IN PLACE AFTER CONSTRUCTION. ANY SEDIMENT DEPOSITS REMAINING IN PLACE AFTER BARRIER IS NO LONGER REQUIRED SHOULD BE SPREAD TO CONFORM TO THE EXISTING GRADE AND BE SEEDED AND MULCHED.
  - IF TEMPORARY BERMS ARE USED AS SILT BARRIERS, THEY ARE PROHIBITED AT THE BASE OF SLOPES STEEPER THAN 8% OR WHERE THERE IS FLOWING WATER WITHOUT THE SUPPORT OF ADDITIONAL MEASURES SUCH AS SILT FENCE.

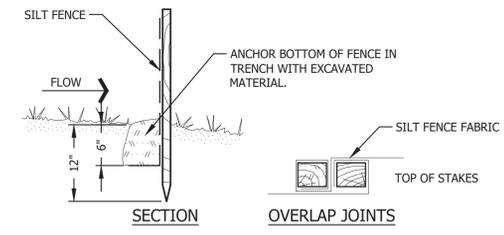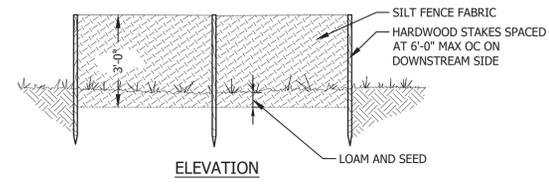

**SILT FENCE**  
NOTE:  
CONTRACTORS OPTION TO USE SEDIMENT BARRIER OR SILT FENCE FOR SLOPE PROTECTION.

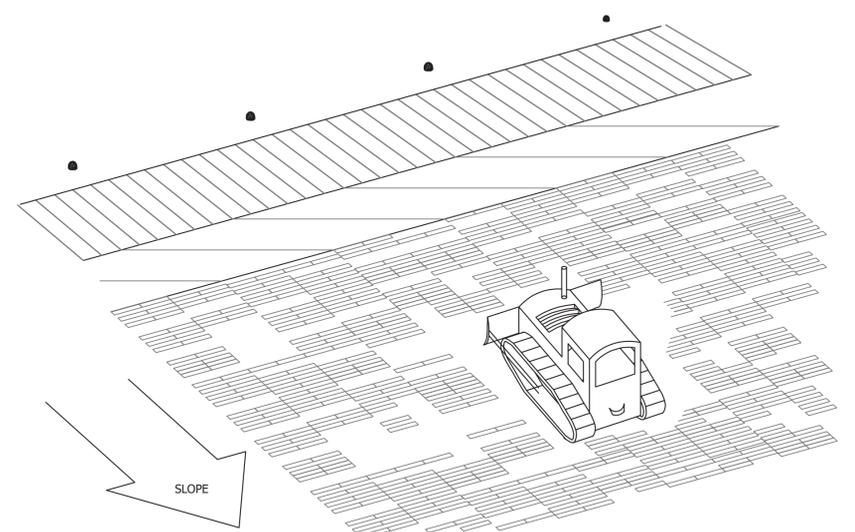


- NOTES:**
- SLOPE TRACKING SHALL BE PERFORMED BY CONTRACTOR ON ALL FINISHED AREAS TO BE SEEDED.
  - TRACKING SHALL BE PERFORMED BY RUNNING LOW GROUND PRESSURE TRACKED MACHINERY UP AND DOWN SLOPES LEAVING TREAD MARKS PARALLEL TO THE CONTOUR.

**SLOPE TRACKING**  
NTS

**SURFACE DRAINAGE SEDIMENT CONTROL**  
NTS

BDP	1/2025	RECORD DRAWING	
BDP	2/2024	ISSUED FOR BID AND MEDEP REVIEW	
REV.	BY	DATE	STATUS
<b>MAINE BUREAU OF GENERAL SERVICES</b> <b>DOLBY LANDFILL COVER UPGRADE</b> <b>PHASE 4</b> <b>EAST MILLINOCKET, MAINE</b> <b>BGS PROJECT 3754</b>			
<b>SECTIONS AND DETAILS</b>			
			DESIGN BY: TJM DRAWN BY: BWB DATE: 11/2024 CHECKED BY: BDP LMN: NONE CTB: SME-STD
<b>SME</b> <b>SEVEE &amp; MAHER</b> <b>ENGINEERS</b> ENVIRONMENTAL • CIVIL • GEOTECHNICAL • WATER • COMPLIANCE 4 Blanchard Road, PO Box 85A, Cumberland, Maine 04021 Phone 207.829.5016 • Fax 207.829.5692 • sme-engineers.com			JOB NO. 231265.00 DWG FILE DETAILS <b>C-303</b>

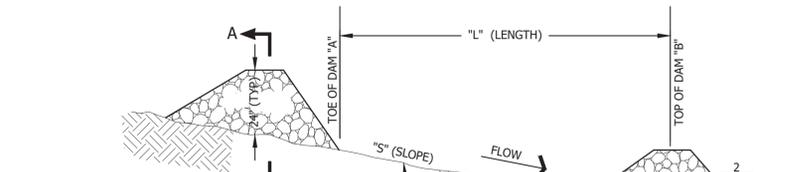


"S" (SLOPE) FT/FT	"L" (LENGTH) FT
0.020	100
0.030	66
0.040	50
0.050	40
0.080	25
0.100	20
0.120	17
0.150	13


L = THE DISTANCE SUCH THAT POINTS A AND B ARE OF EQUAL ELEVATION

**NOTES:**


- WHILE THIS PRACTICE IS NOT INTENDED TO BE USED PRIMARILY FOR SEDIMENT TRAPPING, SOME SEDIMENT WILL ACCUMULATE BEHIND DAMS. SEDIMENT SHOULD BE REMOVED FROM BEHIND DAMS WHEN IT HAS ACCUMULATED TO ONE HALF THE ORIGINAL HEIGHT OF THE DAM.
- STONE: 1"-6" WELL GRADED CRUSHED STONE

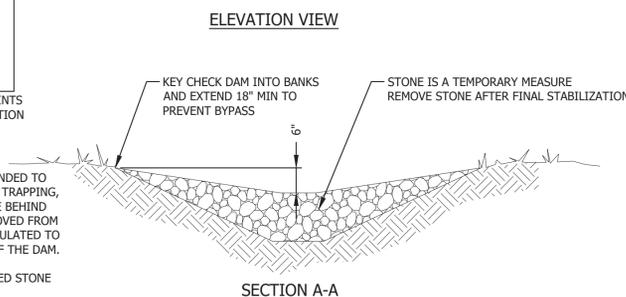

**STONE CHECK DAM**  
NTS

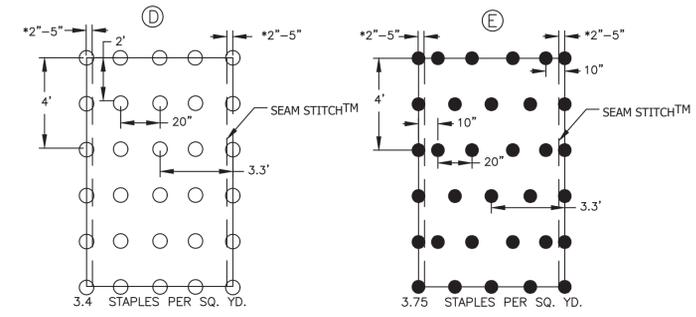


**ECB STAPLE PATTERN GUIDE**  
NTS

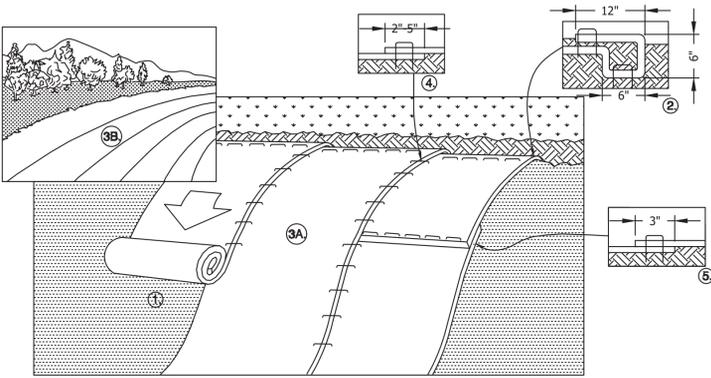


- PREPARE BEFORE INSTALLING ROLLED EROSION CONTROL PRODUCTS (RECP'S). INCLUDING ANY NECESSARY APPLICATION OF LIME, FERTILIZER AND SEED.
- BEGIN AT THE TOP OF THE SLOPE BY ANCHORING THE RECP'S IN A 6" DEEP X 6" WIDE TRENCH WITH APPROXIMATELY 12" OF RECP'S EXTENDED BEYOND THE UP-SLOPE PORTION OF THE TRENCH. ANCHOR THE RECP'S WITH A ROW OF STAPLES/STAKES APPROXIMATELY 12" APART IN THE BOTTOM OF THE TRENCH. BACKFILL AND COMPACT THE TRENCH AFTER STAPLING. APPLY SEED TO COMPACTED SOIL AND FOLD REMAINING 12" PORTION OF RECP'S BACK OVER SEED AND COMPACTED SOIL. SECURE RECP'S OVER COMPACTED SOIL WITH A ROW OF STAPLES/STAKES SPACED APPROXIMATELY 12" APART ACROSS THE WIDTH OF THE RECP'S.
- ROLL THE RECP'S (A.) DOWN OR (B.) HORIZONTALLY ACROSS THE SLOPE. RECP'S WILL UNROLL WITH APPROPRIATE SIDE AGAINST THE SOIL SURFACE. ALL RECP'S MUST BE SECURELY FASTENED TO SOIL SURFACE BY PLACING STAPLES IN APPROPRIATE LOCATIONS AS SHOWN IN THE STAPLE PATTERN GUIDE. WHEN USING THE DOT SYSTEM™, STAPLES SHOULD BE PLACED THROUGH EACH OF THE COLORED DOTS CORRESPONDING TO THE APPROPRIATE STAPLE PATTERN.
- THE EDGES OF PARALLEL RECP'S MUST BE STAPLED WITH APPROXIMATELY 2"-5" OVERLAP DEPENDING ON RECP'S TYPE.
- CONSECUTIVE RECP'S SPICED DOWN THE SLOPE MUST BE PLACED END OVER END (SHINGLE STYLE) WITH AN APPROXIMATE 3" OVERLAP. STAPLE THROUGH OVERLAPPED AREA, APPROXIMATELY 12" APART ACROSS ENTIRE RECP'S WIDTH.

\*IN LOOSE SOIL CONDITIONS, THE USE OF STAPLE OR STAKE LENGTHS GREATER THAN 6" MAY BE NECESSARY TO PROPERLY SECURE THE RECP'S.

**SLOPE INSTALLATION**  
NTS

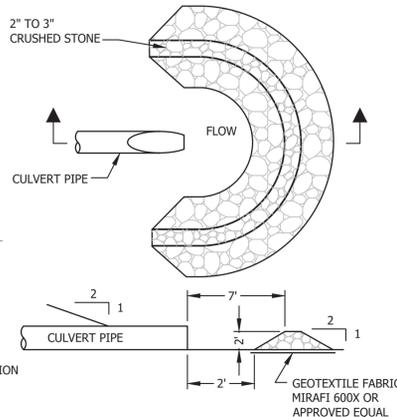


**RIPRAP CULVERT INLET PROTECTION (TEMPORARY)**  
NTS

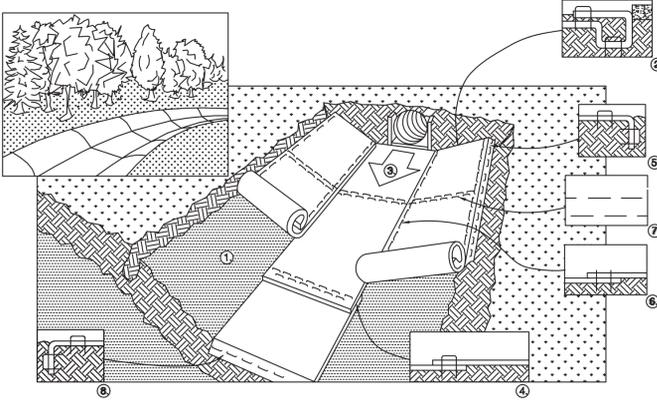

- PREPARE BEFORE INSTALLING ROLLED EROSION CONTROL PRODUCTS (RECP'S). INCLUDING ANY NECESSARY APPLICATION OF LIME, FERTILIZER AND SEED.
- BEGIN AT THE TOP OF THE SLOPE BY ANCHORING THE RECP'S IN A 6" DEEP X 6" WIDE TRENCH WITH APPROXIMATELY 12" OF RECP'S EXTENDED BEYOND THE UP-SLOPE PORTION OF THE TRENCH. ANCHOR THE RECP'S WITH A ROW OF STAPLES/STAKES APPROXIMATELY 12" APART IN THE BOTTOM OF THE TRENCH. BACKFILL AND COMPACT THE TRENCH AFTER STAPLING. APPLY SEED TO COMPACTED SOIL AND FOLD REMAINING 12" PORTION OF RECP'S BACK OVER SEED AND COMPACTED SOIL. SECURE RECP'S OVER COMPACTED SOIL WITH A ROW OF STAPLES/STAKES SPACED APPROXIMATELY 12" APART ACROSS THE WIDTH OF THE RECP'S.
- ROLL CENTER RECP'S IN THE DIRECTION OF WATER FLOW IN BOTTOM OF CHANNEL. RECP'S WILL UNROLL WITH APPROPRIATE SIDE AGAINST THE SOIL SURFACE. ALL RECP'S MUST BE SECURELY FASTENED TO SOIL SURFACE BY PLACING STAPLES IN APPROPRIATE LOCATIONS AS SHOWN IN THE STAPLE PATTERN GUIDE. WHEN USING THE DOT SYSTEM™, STAPLES SHOULD BE PLACED THROUGH EACH OF THE COLORED DOTS CORRESPONDING TO THE APPROPRIATE STAPLE PATTERN.
- PLACE CONSECUTIVE RECP'S END OVER END (SHINGLE STYLE) WITH A 4" TO 6" OVERLAP. USE A DOUBLE ROW OF STAPLES STAGGERED 4" APART AND 4" ON CENTER TO SECURE RECP'S.
- FULL LENGTH EDGE OF RECP'S AT SIDE SLOPES MUST BE ANCHORED WITH A ROW OF STAPLES APPROXIMATELY 12" APART IN A 6" DEEP X 6" WIDE TRENCH. BACKFILL AND COMPACT THE TRENCH AFTER STAPLING.
- ADJACENT RECP'S MUST BE OVERLAPPED APPROXIMATELY 2" TO 5" (DEPENDING ON RECP'S TYPE) AND STAPLED.
- IN HIGH FLOW CHANNEL APPLICATIONS, A STAPLE CHECK SLOT IS RECOMMENDED AT 30 TO 40 FOOT INTERVALS. USE A DOUBLE ROW OF STAPLES STAGGERED 4" APART AND 4" ON CENTER OVER ENTIRE WIDTH OF THE CHANNEL.
- THE TERMINAL END OF THE RECP'S MUST BE ANCHORED WITH A ROW OF STAPLES APPROXIMATELY 12" APART IN A 6" DEEP X 6" WIDE TRENCH. BACKFILL AND COMPACT THE TRENCH AFTER STAPLING.

\*IN LOOSE SOIL CONDITIONS, THE USE OF STAPLE OR STAKE LENGTHS GREATER THAN 6" MAY BE NECESSARY TO PROPERLY SECURE THE RECP'S.

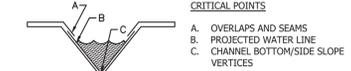

**CHANNEL INSTALLATION**  
NTS

**TEMPORARY AND PERMANENT EROSION AND SEDIMENTATION CONTROL**

- A. GENERAL**
- All soil erosion and sediment control will be done in accordance with the Maine Erosion and Sediment Control Best Management Practices, Maine Department of Environmental Protection, October 2016, and as currently revised.
  - The contractor will be responsible for the repair/replacement/maintenance of all erosion control measures until all disturbed areas are stabilized. Contractor shall be responsible for plan preparation, documentation and inspection.
  - Disturbed areas will be permanently stabilized within 7 days of final grading. Disturbed areas not to be worked upon within 14 days of disturbance, shall be temporarily stabilized within 7 days of the disturbance.
  - In all areas, removal of trees, bushes and other vegetation, as well as disturbance of topsoil will be kept to a minimum while allowing proper site operations.
  - Any suitable topsoil or cover soil will be stripped and stockpiled for reuse in final grading. Soil will be stockpiled in a manner such that natural drainage is not obstructed and no off-site sediment damage will result. If a stockpile is necessary, the side slopes of the stockpile will not exceed 2:1. Silt fence will be installed around the perimeter of all stockpiles. Stockpiles will be surrounded with siltation fencing and will be temporarily seeded with arrostook rye, annual or perennial ryegrass, within 7 days of formation, or temporarily mulched if seeding cannot be done within the recommended seeding dates. Recommended seeding dates and application rates are as follows:  
Arrostook Rye: Recommended Seeding Dates: 4/15 - 8/15  
Application Rate: 112 lbs/acre  
Perennial Ryegrass: Recommended Seeding Dates: 4/15 - 8/15  
Application Rate: 85 lbs/acre  
Mulch: o Hay or Straw  
Application Rate: 2 - 3 tons/acre.  
Anchor with tack or 300 lbs/acre fiber mulch  
o Wood Fiber Cellulose (4/15 - 7/15) Temporary mulch only  
Application Rate: 4,000 lbs/acre.  
Anchoring not required

- B. TEMPORARY MEASURES**
- Silt Fence**
    - Silt fence will be installed prior to and downgradient of all construction activity where soil disturbance may result in erosion.
    - The height of a silt fence will not exceed 36 inches.
    - The filter fabric will be purchased in a continuous roll cut to the length of the barrier to avoid the use of joints. When joints are necessary, filter cloth will be spliced together only at a support post, with a minimum 6-inch overlap, and securely sealed.
    - Posts will be spaced a maximum of 10 feet apart at the barrier location and driven securely into the ground (minimum of 12 inches). When extra strength fabric is used without the wire support fence, post spacing will not exceed 6 feet.
    - A trench will be excavated approximately 6 inches wide and 6 inches deep along the line of posts and upgradient from the barrier.
    - The standard strength of filter fabric will be stapled or wired to the fence, and 8 inches of the fabric will be extended into the trench. The fabric will not extend more than 36 inches above the original ground surface. Filter fabric will not be stapled to existing trees.
    - When extra strength filter fabric and closer post spacing are used, the wire mesh support fence may be eliminated. In such a case, the filter fabric will be stapled or wired directly to the posts with all other provisions of item (f) applying.
    - The trench will be backfilled and the soil compacted over the filter fabric.
  - Stone Check Dams**
    - Silt fences will be removed when they have served their useful purpose, but not before the upgradient areas have been permanently stabilized.
    - Silt fences will be inspected immediately after each rainfall and at least daily during prolonged rainfall. They will be inspected if there are any signs of erosion or sedimentation below them. Any required repairs will be made immediately. If there are signs of undercutting at the center or the edges, or impounding of large volumes of water behind them, they will be replaced with a temporary crushed stone check dam.
    - Should the fabric on a silt fence decompose or become ineffective prior to the end of the expected useful life, and the barrier still be necessary, the fabric will be replaced promptly.
    - Sediment deposits should be removed after each storm event if significant buildup has occurred or if deposits exceed half the height of the fence.

- Erosion control mix and sediment berm**
  - The filter berm shall consist of an approved wood waste compost/bark mulch mix or recycled composted bark flume grit and fragmented wood generated from water-flume log handling systems or small shredding of stumpage (6 inches long x 1/2" dia.). The mixture needs to be a well-graded blend of organic and mineral substance. The composition is usually manufactured on or off site and by blending it with a well graded sand and gravel. The objective is a light, heavy, non-erodible mixture that is not composed of one uniform material, i.e. just bark mulch will not suffice. Comparable composted mixes can be used upon approval of the Department of Environmental Protection, Bureau of Land and Water Quality.
  - The mix shall conform to standards shown on the detail:
  - Installation and Size of Berm: The dimensions of the berm are more a function of the strength of the material than the flows (forces) it will encounter. At a minimum the berm shall be 4 feet wide and 18 inches high. The berm shall be placed, uncompacted along a relatively level contour. Wherever possible the existing surface must be scoured and the mixture keyed in like any other sediment control measure.
  - Maintenance: All deficiencies shall be immediately corrected with additional material place on top of the berm to reach the desired height. When the berm is decomposed, clogged with sediment, eroded, or becomes ineffective, it shall be replaced.
  - Clean up and Retrieval: At the end of the job, an erosion control berm shall be removed or spread out so that the native earth can be seen below.

- C. Permanent Measures**
- Riprapped Ditches, Aprons and Plunge Pools
    - Construct riprapped ditches, aprons and plunge pools in accordance with the details shown on the Drawings.
    - Stone for riprap will consist of sub-angular field stone or rough unheun quarry stone. The stone will be hard and of such quality that it will not disintegrate on exposure to water or weathering, be chemically stable and suitable in all other respects for the purpose intended. The bulk specific gravity (saturated surface-dry basis) of the individual stones will be at least 2.5.
    - The riprap should be placed so that it produces a dense well-graded mass of stone with a minimum of voids. The desired distribution of stones throughout the mass may be obtained by selective loading at the quarry, controlled dumping of successive loads during final placing, or by combination of these methods. The riprap should be placed to its full thickness on one operation. The riprap should not be placed in layers. The riprap should not be placed by dumping into chutes or similar methods which are likely to cause segregation of the various stone sizes. Care should be taken not to dislodge the underlying material when placing the stones.

- D. MAINTENANCE PLAN**
- Routine Maintenance Inspection shall be performed annually by a qualified person during wet weather to ensure that the facility performs as intended. Inspection priorities shall include checking erosion controls for accumulation of sediments.
  - Grassed Areas
    - Lime according to a soil test or at a minimum of every five years using a rate of 2 tons per acre (100 pounds per 1,000 sq ft)
    - Topdress with fertilizer in the early spring (before May 15) one year after planting with a balanced fertilizer, applying 50 pounds of nitrogen/acre (500 pounds of 10-20-20 per acre). Thereafter, fertilize according to a soil test or broadcast biennially, 300 pounds of 10-10-10 or equivalent per acre (7.5 pounds per 1,000 sq ft).
- E. INSPECTIONS**
- Inspections will be undertaken by qualified personnel to ensure that temporary and permanent erosion and sedimentation controls are properly installed and correctly functioning, and that additional erosion control measures are installed if needed. Such inspections will occur weekly and before and after each significant rainfall event (1 inch or more within a 24 hour period) during construction until permanent erosion control measures have been properly installed and the site is stabilized.
  - A log (report) must be kept summarizing the scope of the inspection, name(s) and qualifications of the personnel making the inspection, the date(s) of the inspection, and the major observations relating to the operation of erosion and sedimentation controls and pollution prevention measures. Major observations must include: BMP's that need to be maintained; location(s) of BMP's that failed to operate as designed or proved inadequate for a particular location; and location(s) of where additional BMP's area needed that did not exist at the time of inspection. Follow-up to correct deficiencies or enhance controls must also be indicated in the log and dated, including what action was taken and when.
- F. HOUSEKEEPING**
- Spill prevention. Controls must be used to prevent pollutants from being discharged from materials on site, including storage practices to minimize exposure of the materials to stormwater, and appropriate spill prevention, containment, and response planning and implementation.
  - Groundwater protection. During construction, liquid petroleum products and other hazardous materials with the potential to contaminate groundwater may not be stored or handled in areas of the site draining to an infiltration area. An "infiltration area" is any area of the site that by design or as a result of soils, topography and other relevant factors accumulates runoff that infiltrates into the soil. Dikes, berms, sumps, and other forms of secondary containment that prevent discharge to groundwater may be used to isolate portions of the site for the purposes of storage and handling of these materials.
  - Fugitive sediment and dust. Actions must be taken to ensure that activities do not result in noticeable erosion of soils or fugitive dust emissions during or after construction. Oil may not be used for dust control.
  - Debris and other materials. Litter, construction debris, and chemicals exposed to stormwater must be prevented from becoming a pollutant source.
  - Trench or foundation de-watering. Trench de-watering is the removal of water from trenches, foundations, coffer dams, ponds, and other areas within the construction area that retain water after excavation. In most cases the collected water is heavily silted and hinders correct and safe construction practices. The collected water must be removed from the ponded area, either through gravity or pumping, and must be spread through natural wooded buffers or removed to areas that are specifically designed to collect the maximum amount of sediment possible, like a cofferdam sedimentation basin. Avoid allowing the water to flow over disturbed areas of the site. Equivalent measures may be taken if approved by the department.
  - Non-stormwater discharges. Identify and prevent contamination by non-stormwater discharges.
  - Additional requirements. Additional requirements may be applied on a site-specific basis.

Seed	Permanent Seeding (180 lbs/acre)	Temporary Seeding (112 lbs/acre)
Red Fescue	50% by weight	Winter Rye
Red Top	2% by weight	100% by weight
White Clover	5% by weight	
Annual Ryegrass	25% by weight	
Birdsfoot Trefoil	3% by weight	
Kentucky Bluegrass	15% by weight	

Fertilizer: Apply 2 pounds per unit (87 lbs/acre) of nitrogen, phosphoric acid, and potash, or 413 lbs/acre of 19-19-19 fertilizer.

Lime: Apply liquid limestone at a rate of 3 tons per acre (138 lbs/1,000 sq ft).

Mulch: Mulch with weed-free hay or straw at 2-3 tons per acre with engineer approved tack or fiber mulch to completely cover hay/straw mulch.

(c) If permanent vegetated stabilization cannot be established due to the season of the year, all exposed and disturbed areas not to undergo further disturbance are to have dormant seeding applied and be temporarily mulched to protect the site. The following methods may be used to perform a dormant seeding:

- Prepare the seedbed, add the required amounts of lime and fertilizer, then mulch and anchor. After the first killing frost and before snow fall, broadcast or hydroseed the selected seed mixture. Double the regular seeding rates for this type seeding.
  - When soil conditions permit, between the first killing frost and before snow fall, prepare the seedbed, lime and fertilize, apply the selected seed mixture, and mulch and anchor. Double the regular seeding rates for this type of seeding.
- Dormant seedings need to be anchored extremely well on slopes, ditch bases and areas of concentrated flows.
- Dormant seeding requires inspection and reseeded as needed in the spring. All areas where cover is inadequate must be immediately reseeded and mulched as soon as possible.

(3) Erosion Control Mats  
(a) Install mats as indicated on drawings and in accordance with manufacturers' recommendations.

REV.	BY	DATE	STATUS
	BDP	1/2025	RECORD DRAWING
	BDP	2/2024	ISSUED FOR BID AND MEDEF REVIEW


**MAINE BUREAU OF GENERAL SERVICES**  
**DOLBY LANDFILL COVER UPGRADE**  
**PHASE 4**  
**EAST MILLINOCKET, MAINE**  
**BGS PROJECT 3754**

**SECTIONS AND DETAILS**

**SME SEVEE & MAHER ENGINEERS**  
ENVIRONMENTAL • CIVIL • GEOTECHNICAL • WATER • COMPLIANCE  
4 Blanchard Road, PO Box 85A, Cumberland, Maine 04021  
Phone 207.829.5016 • Fax 207.829.5692 • sme-engineers.com

DESIGN BY: TJM  
DRAWN BY: BWB  
DATE: 11/2024  
CHECKED BY: BDP  
LMN: NONE  
CTB: SME-STD

JOB NO. 231265.00 DWG FILE DETAILS **C-304**

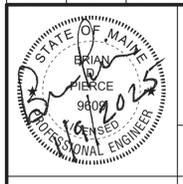

### GENERAL NOTES

#### 1. UTILITIES AND AGENCIES

BANGOR AND AROOSTOOK RAILROAD  
 MAINE DEPARTMENT OF TRANSPORTATION - DIVISION OFFICE, BANGOR, MAINE  
 BANGOR HYDRO-ELECTRIC CO. - ROUTE 2, LINCOLN, MAINE  
 NYNEX  
 DIG SAFE

#### 2. NOTES

-REFER TO DRAWING YB-22974 FOR MANHOLE AND STRUCTURE SCHEDULE  
 -PAVEMENT AND BASES REMOVED BY THE PIPELINE CONSTRUCTION SHALL BE REPLACED TO THE SAME THICKNESS OF THE ADJACENT LAYERS.  
 -ALL AREAS DISTURBED BY THE PIPELINE CONSTRUCTION AND NOT RESURFACED SHALL BE COVERED WITH "WO (2)" INCHES OF LOAM, GRADED, SEEDED, AND MULCHED.  
 -THRUST RESTRAINT REQUIRED ON ALL FORCE MAIN BENDS GREATER THAN 22.5'. SEE DETAIL YB-22977

### LEGEND

	EXISTING	PROPOSED
STRUCTURES		
MANHOLE		
CONTOUR		
WETLAND EDGE		
LEACHATE LINE		
SURVEY BASELINE		
TREE LINE		
OVERHEAD TELEPHONE		
UTILITY POLE		
TEST PIT		
WETLAND SETBACK BUFFER		
RAILROAD		
FILL OR CUT AREA (PROFILE)		

### DATUM

HORIZONTAL DATUM FROM STATION 0+00 TO STATION 167+00 IS BASED ON MAINE STATE GRID (EAST ZONE) 1927 NORTH AMERICAN DATUM.  
 VERTICAL DATUM FROM STATION 0+00 TO STATION 167+00 IS BASED ON NGVD83

#### HORIZONTAL AND VERTICAL CONTROL

SQUAW BAY CONTROL POINT #1 - BRASS DISK IN TOP OF CONCRETE MANHOLE ON WESTERLY SIDE OF LEACHATE POND.  
 COORDINATES: NORTH 66463.732  
 EAST 473626.762  
 ELEVATION: 348.58  
 IDENTIFICATION: "MON #1"

SQUAW BAY CONTROL POINT #2 - BRASS DISK IN TOP OF CONCRETE PUMP STATION ON SOUTHERLY SIDE OF LEACHATE POND.  
 COORDINATES: NORTH 662871.733  
 EAST 473743.028  
 ELEVATION: 356.99  
 IDENTIFICATION: "MON #2"

SQUAW BAY CONTROL POINT #3 - BRASS DISK IN TOP OF CONCRETE CHIMNEY ON NORTHWEST CORNER OF FIBER RECYCLE BUILDING.  
 COORDINATES: NORTH 653349.302  
 EAST 473333.704  
 ELEVATION: 319.24  
 IDENTIFICATION: CONTROL MON 7034

VERTICAL DATUM CONVERSION FACTOR  
 TO CONVERT NGVD (29) TO "WELL DATUM, 400 1.59".  
 TO CONVERT WELL DATUM TO NGVD (29) SUBTRACT 1.59".

TEMPORARY BENCHMARKS (TBM)  
 TBM, PL-13 - TOP OF WALLER - ELEV. 308.56 - STA. 31+00, 45'.  
 TBM, SOUT PD - TOP OF SPRING STONE - ELEV. 309.70 - STA. 61+35, 50'.  
 TBM, GREENWOOD BLDG - FIRST MARK ON BLDG ELEV. 307.41 - STA. 167+00, 105'.



NO.	DATE	DESCRIPTION	BY	CHK	APP'D
C	3/96	RECORD DRAWING	MSB	PBT	
C	6/95	ISSUED FOR CONSTRUCTION	BAK	PBT	22846
B	4/95	ISSUED FOR BIDS	MSB	PBT	22846
P	4/25	PRELIMINARY CONSTRUCTION ISSUE	MSB	JRK	22846

**SQUAW BAY CORP**  
 CONSULTING ENGINEERS

PO. BOX 164 CUMBERLAND CENTER, MAINE 04112

DRN	JRK	9/94
CHK	PBT	10/94
CHK		
CORR		
APP'D		
ISSUE CHECK		
P - Plan	B - Bids	
W - W/TG	C - Const.	
COL	N.T.S.	



**EAST OPERATION**  
 LEACHATE PIPELINE PROJECT  
 DOLBY LANDFILL TO THE EAST OPERATION  
 STA. 0+00 TO STA. 167+00  
 8" FORCE MAIN  
 INDEX, SYMBOLS, AND GENERAL NOTES

JOB NO. 22846  
 ENG. REG. NO. 22846  
 FILE NO. 2-092-4783

**YB-22960**  
 SHEET 1 OF 1

### INDEX


LEACHATE PIPELINE PROJECT  
 DOLBY LANDFILL TO THE EAST OPERATION

#### DRAWING NUMBER


#### DRAWING TITLE

YB-22960	INDEX, SYMBOLS, AND GENERAL NOTES
YB-22961	PLAN / PROFILE 8" FORCE MAIN - STA. 0+80 TO STA. 12+50
YB-22962	PLAN / PROFILE 8" FORCE MAIN - STA. 12+50 TO STA. 25+00
YB-22963	PLAN / PROFILE 8" FORCE MAIN - STA. 25+00 TO STA. 37+50
YB-22964	PLAN / PROFILE 8" FORCE MAIN - STA. 37+50 TO STA. 50+00
YB-22965	PLAN / PROFILE 8" FORCE MAIN - STA. 50+00 TO STA. 62+50
YB-22966	PLAN / PROFILE 10" AND 12" GRAVITY TRANSITION - STA. 62+50 TO STA. 75+00
YB-22967	PLAN / PROFILE 10" GRAVITY SECTION STA. 75+00 TO STA. 87+50
YB-22968	PLAN / PROFILE 10" GRAVITY SECTION STA. 87+50 TO STA. 100+00
YB-22969	PLAN / PROFILE 10" GRAVITY SECTION STA. 100+00 TO STA. 112+50
YB-22970	PLAN / PROFILE 10" GRAVITY SECTION STA. 112+50 TO STA. 125+00
YB-22971	PLAN / PROFILE 10" GRAVITY SECTION STA. 125+00 TO STA. 137+50
YB-22972	PLAN / PROFILE 10" GRAVITY SECTION STA. 137+50 TO STA. 150+00
YB-22973	PLAN / PROFILE 10" GRAVITY SECTION STA. 150+00 TO STA. 162+50
YB-22974	PLAN / PROFILE 10" GRAVITY SECTION STA. 162+50 TO STA. 167+00
YB-22975 (1 OF 2)	MANHOLES AND STRUCTURES - MISCELLANEOUS DETAILS
YB-22975 (2 OF 2)	MANHOLES AND STRUCTURES - MISCELLANEOUS DETAILS
YB-22976	EXISTING PUMP STATION MODIFICATIONS - PLANS AND DETAILS
YB-22977	EROSION CONTROL AND MISCELLANEOUS DETAILS

D:\94-229\ACAD\DWG\THU 07-20-94 07:56:05 1995

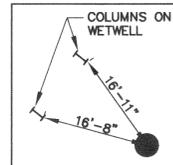

TIES TO MH @ STA. 0+95

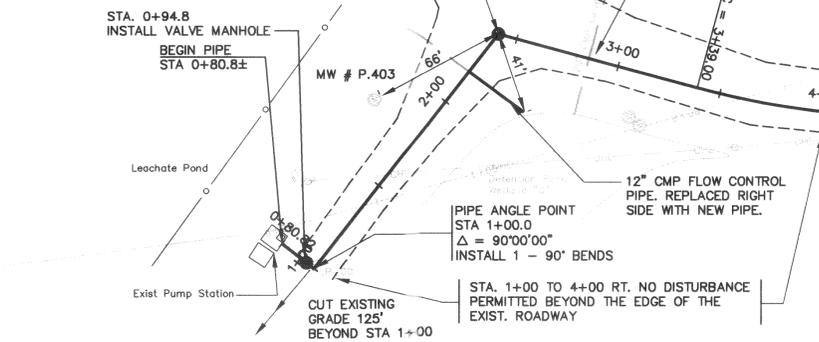

**CURVE #1**  
 $\Delta = 41^{\circ}25'40''$   
 $R = 400.00'$   
 $T = 151.26'$   
 $L = 289.2'$


**CURVE #2**  
 $\Delta = 33^{\circ}02'44''$   
 $R = 400.00'$   
 $T = 118.66'$   
 $L = 230.7'$

**INSTALL SILTATION FENCE**

STA.	TO STA.	LOCATION
1+50	4+00	RT. 10' OFF EDGE OF ROAD
9+50	12+50	RT. 10' OFF EDGE OF ROAD

**INSTALL EROSION CONTROL BLANKET**

STA.	TO STA.	LOCATION
10+00	12+50	RT. ON ANY DISTURBED ROADWAY SLOPES
24+50	25+00	RT. ON ANY DISTURBED ROADWAY SLOPES

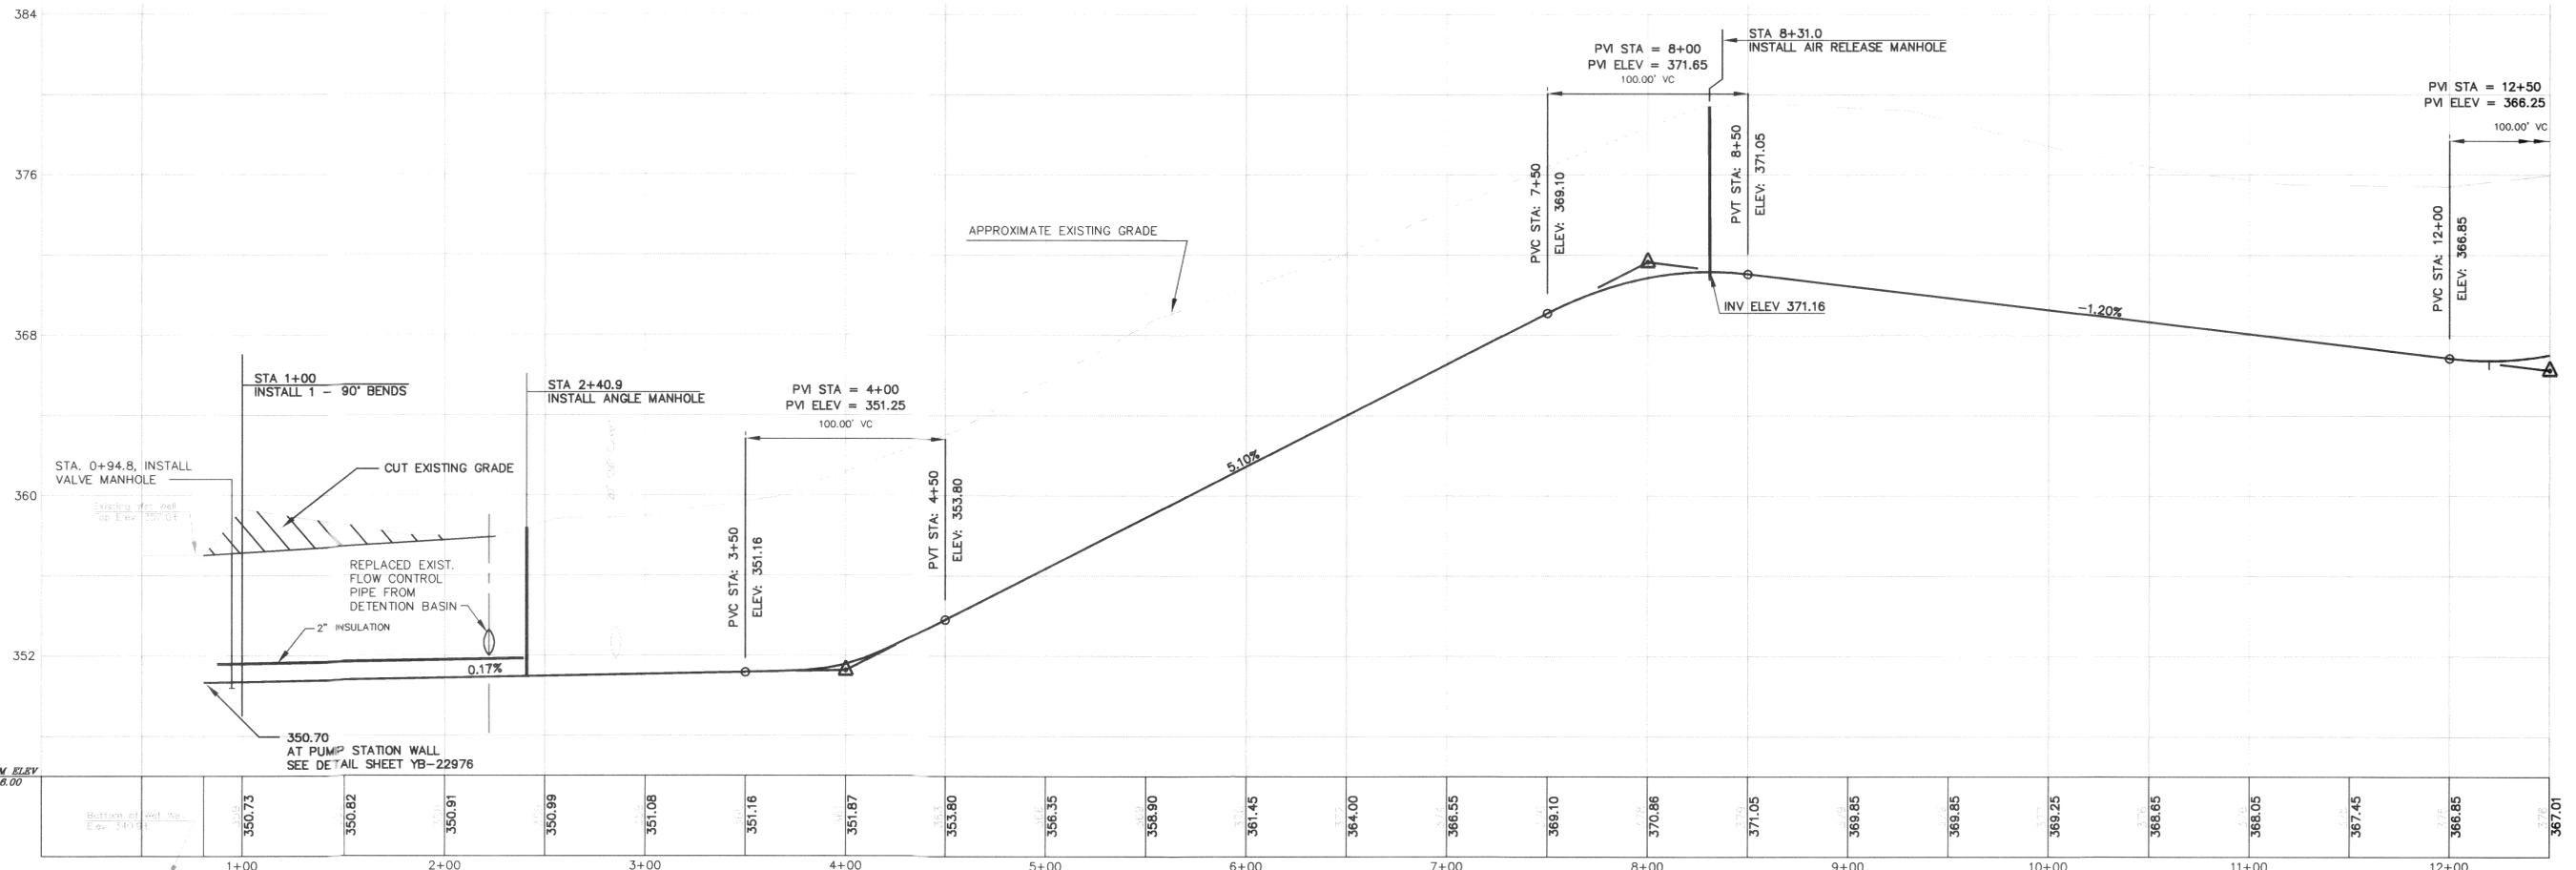

NO.	DATE	DESCRIPTION	BY	CHK	APP'D
YB-14801		DOLBY 3 LANDFILL, INTERPRETIVE GEOLOGIC PROFILES			
YB-14800		DOLBY 3 LANDFILL, PHREATIC SURFACE MAP			
YB-14799	C	3/96 RECORD DRAWING	MSB	PBT	
YB-14797	C	6/95 ISSUED FOR CONSTRUCTION	BAK	PBT	
YB-14796-A	B	4/95 ISSUED FOR BIDS	MSB	PBT	
YB-14795	P	4/95 PRELIMINARY CONSTRUCTION ISSUE	RMC	PBT	
SB-14888	P	12/94 SUBMITTED W/ PERMIT APPLICATION	JRK	PBT	

**SQUAW BAY CORP**  
**CONSULTING ENGINEERS**

P.O. BOX 86A CUMBERLAND CENTER, MAINE 04021


DRN	JRK	9/94
CHK	PBT	10/94
CHK		
CORR		
APPVD		
ISSUE CODE		
P - Prelim	B - Bids	
M - M.I.T.O.	C - Const.	
Scale: 1"=40'H; 1"=4'V		

**EAST OPERATION**  
**LEACHATE PIPELINE PROJECT**  
 DOLBY LANDFILL TO THE EAST OPERATION  
 STA. 0+80.8 TO STA. 12+50  
 8" FORCE MAIN  
 PLAN & PROFILE



JOB NO. 22846  
 ENG. REQ. NO.  
 FILE NO. 2-092-4783

**YB-22961**  
 SHEET 1 OF 1



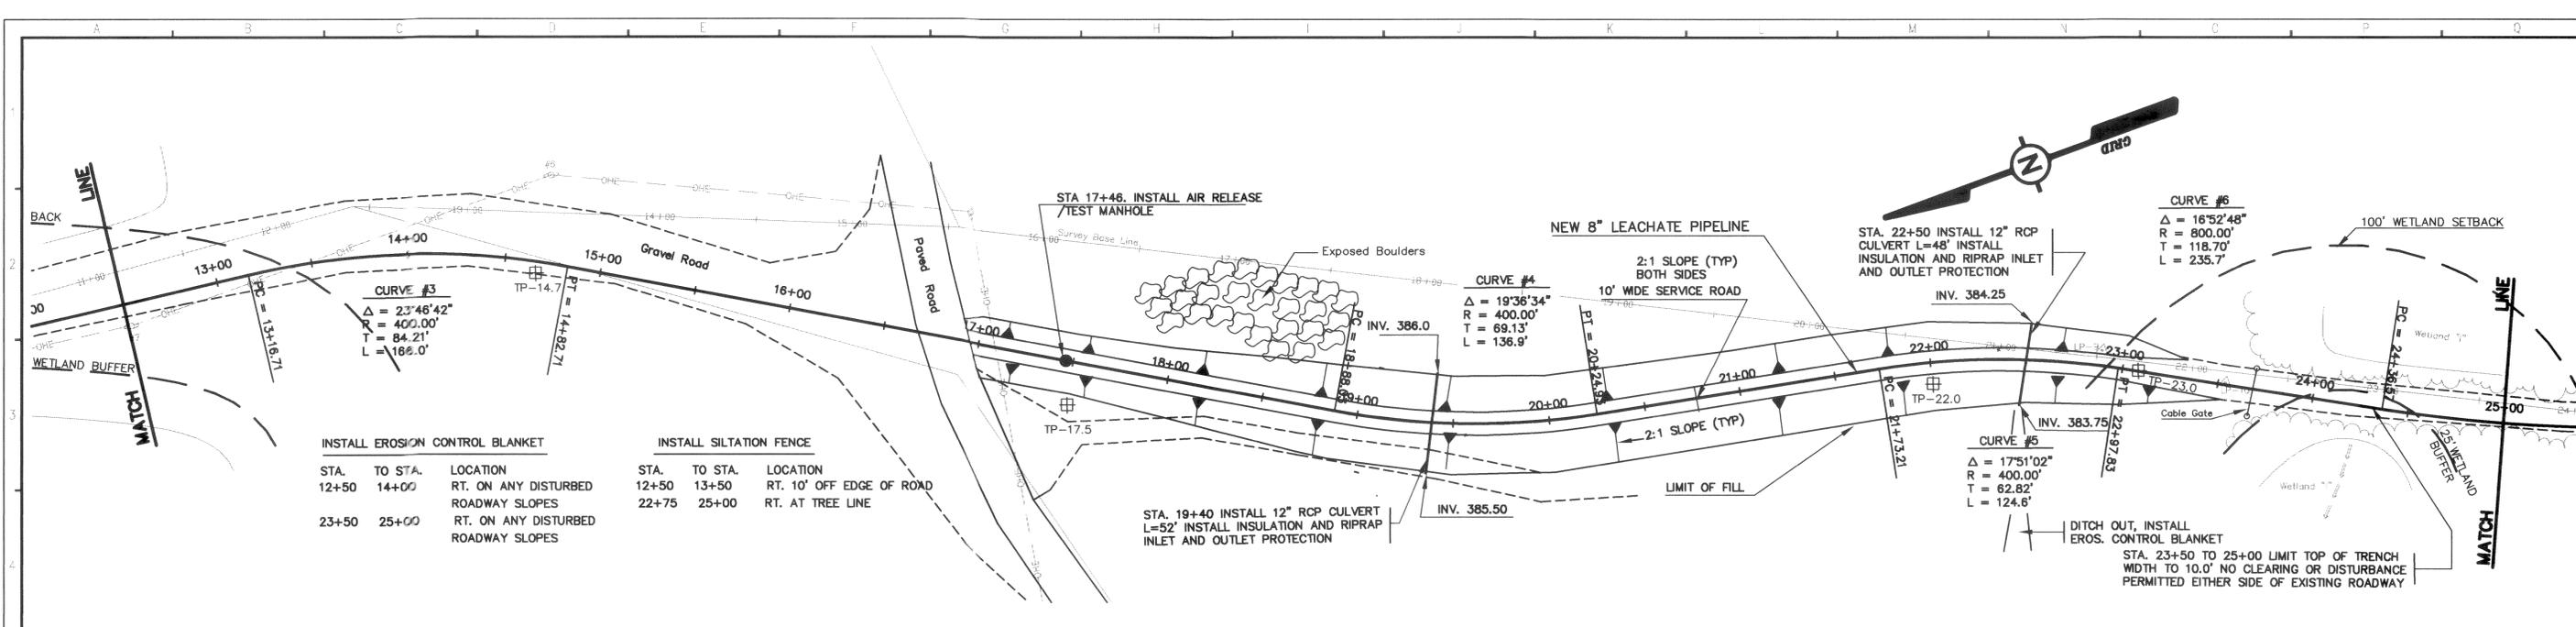

INSTALL EROSION CONTROL BLANKET			INSTALL SILTATION FENCE		
STA.	TO STA.	LOCATION	STA.	TO STA.	LOCATION
12+50	14+00	RT. ON ANY DISTURBED ROADWAY SLOPES	12+50	13+50	RT. 10' OFF EDGE OF ROAD
23+50	25+00	RT. ON ANY DISTURBED ROADWAY SLOPES	22+75	25+00	RT. AT TREE LINE

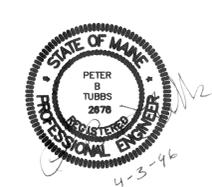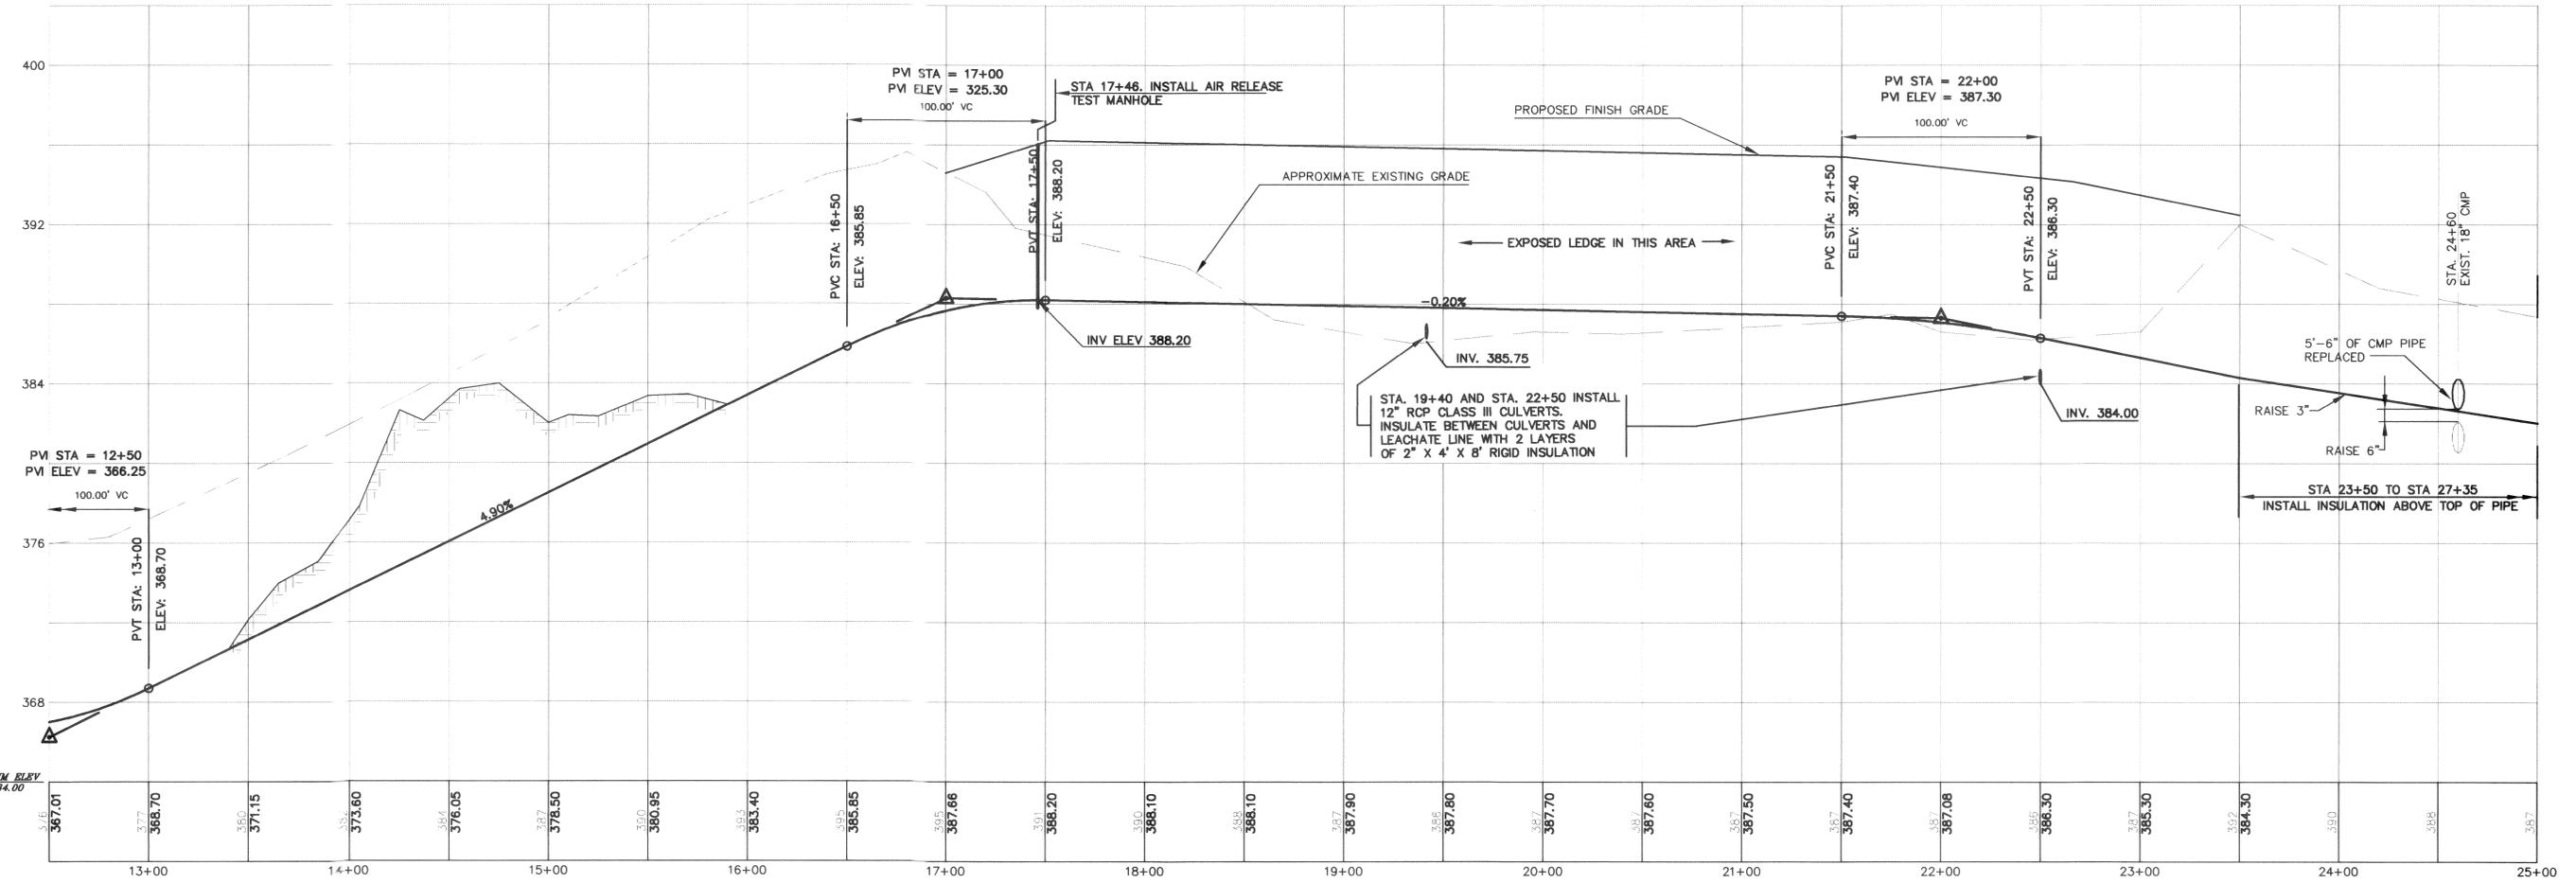

DRAWING NO.	REFERENCE DRAWING TITLE	CODE	NO.	DATE	REVISION	BY	CHK	APP'D	JOB No.
		C	3/96		RECORD DRAWING	MSB	PBT		
		C	6/95		ISSUED FOR CONSTRUCTION	BAK	PBT		
		B	4/95		ISSUED FOR BIDS	RMC	PBT		
		P	4/95		PRELIMINARY CONSTRUCTION ISSUE	RMC	PBT		
		P			SUBMITTED W/ PERMIT APPLICATION	JRK	PBT		

**SQUAW BAY CORP**  
CONSULTING ENGINEERS



P.O. BOX 86A CUMBERLAND CENTER, MAINE 04021

DRN	JRK	9/94
CHK	PBT	10/94
CHK		
CORR		
APPVD		
ISSUE CODE		
P	- Prelim	B - Bids
M	- Mt. T.O.	C - Const.
SCALE 1"=40'H; 1"=4'V		



**EAST OPERATION**  
LEACHATE PIPELINE PROJECT  
DOLBY LANDFILL TO THE EAST OPERATION  
STA. 12+50 TO STA. 25+00  
8" FORCE MAIN  
PLAN & PROFILE

JOB NO. 22846  
ENG. REG. NO. YB-22962  
FILE NO. 2-092-4783  
SHEET 1 OF 1

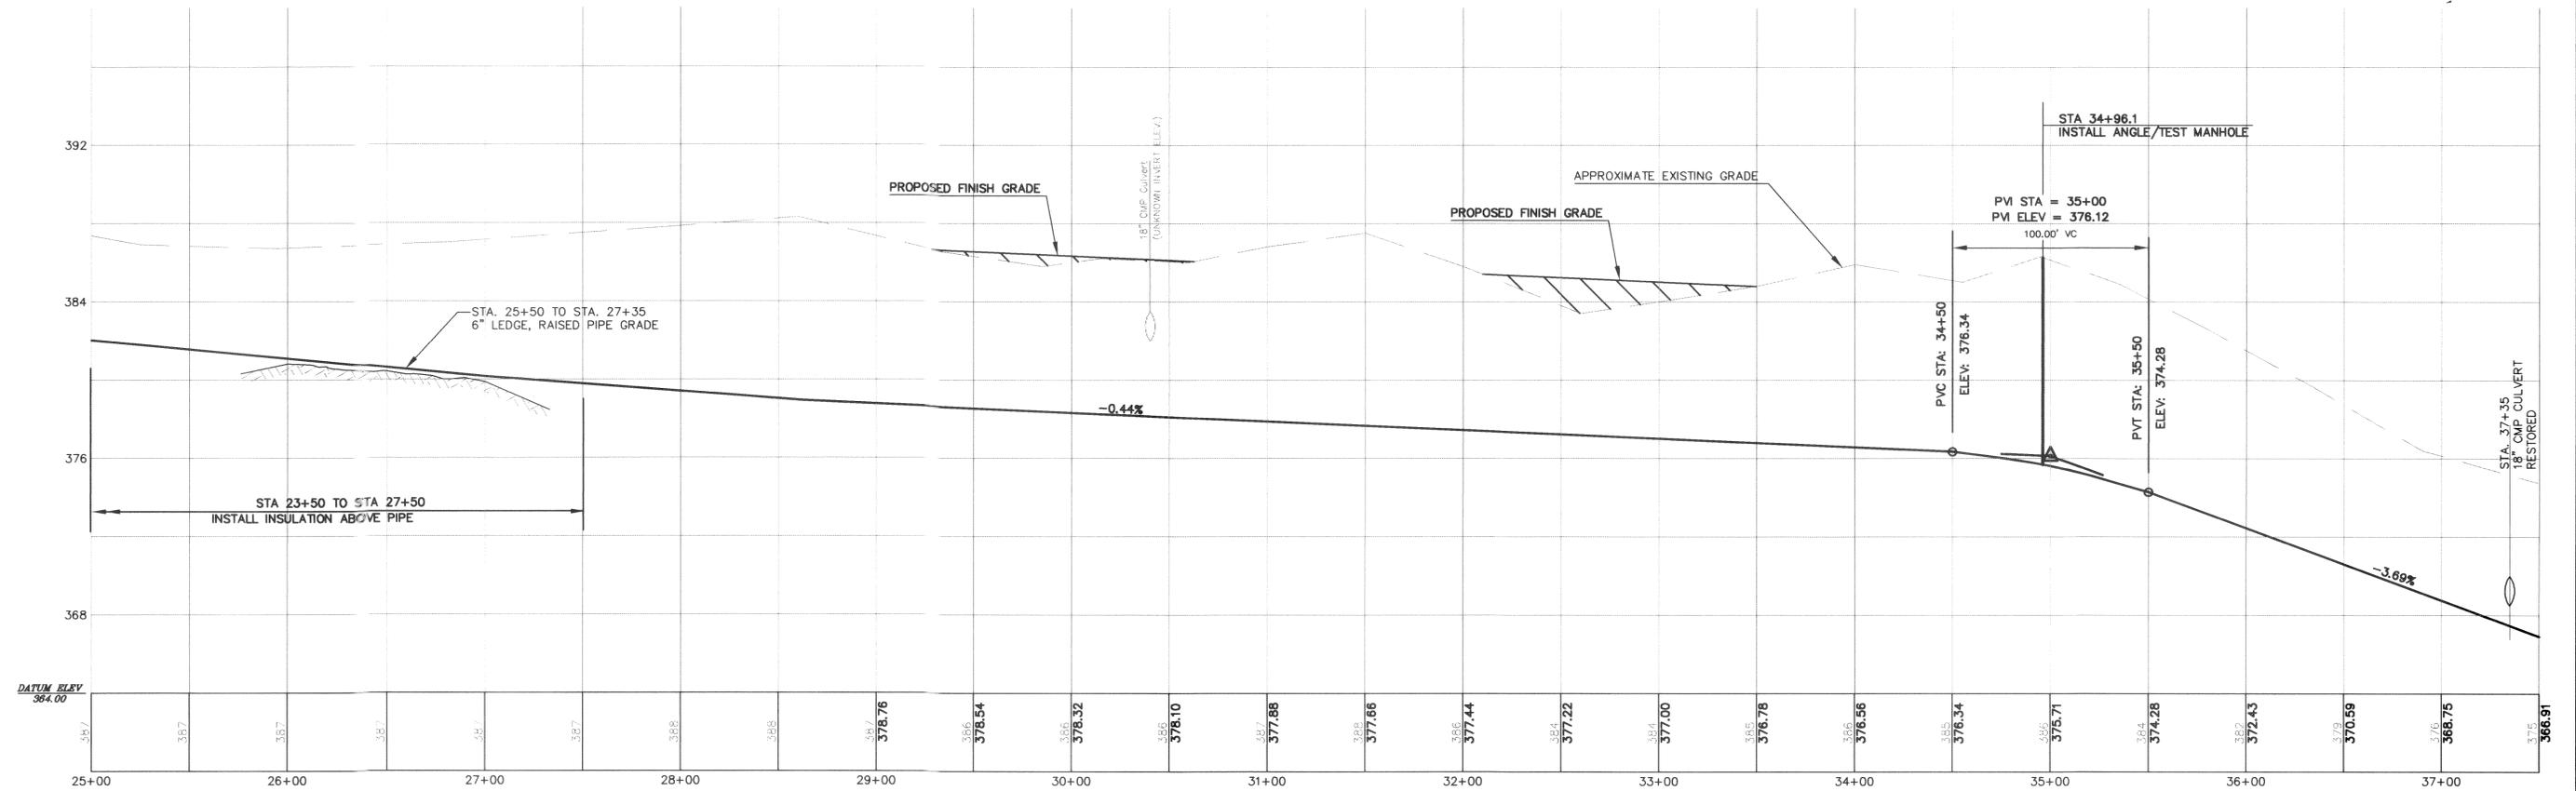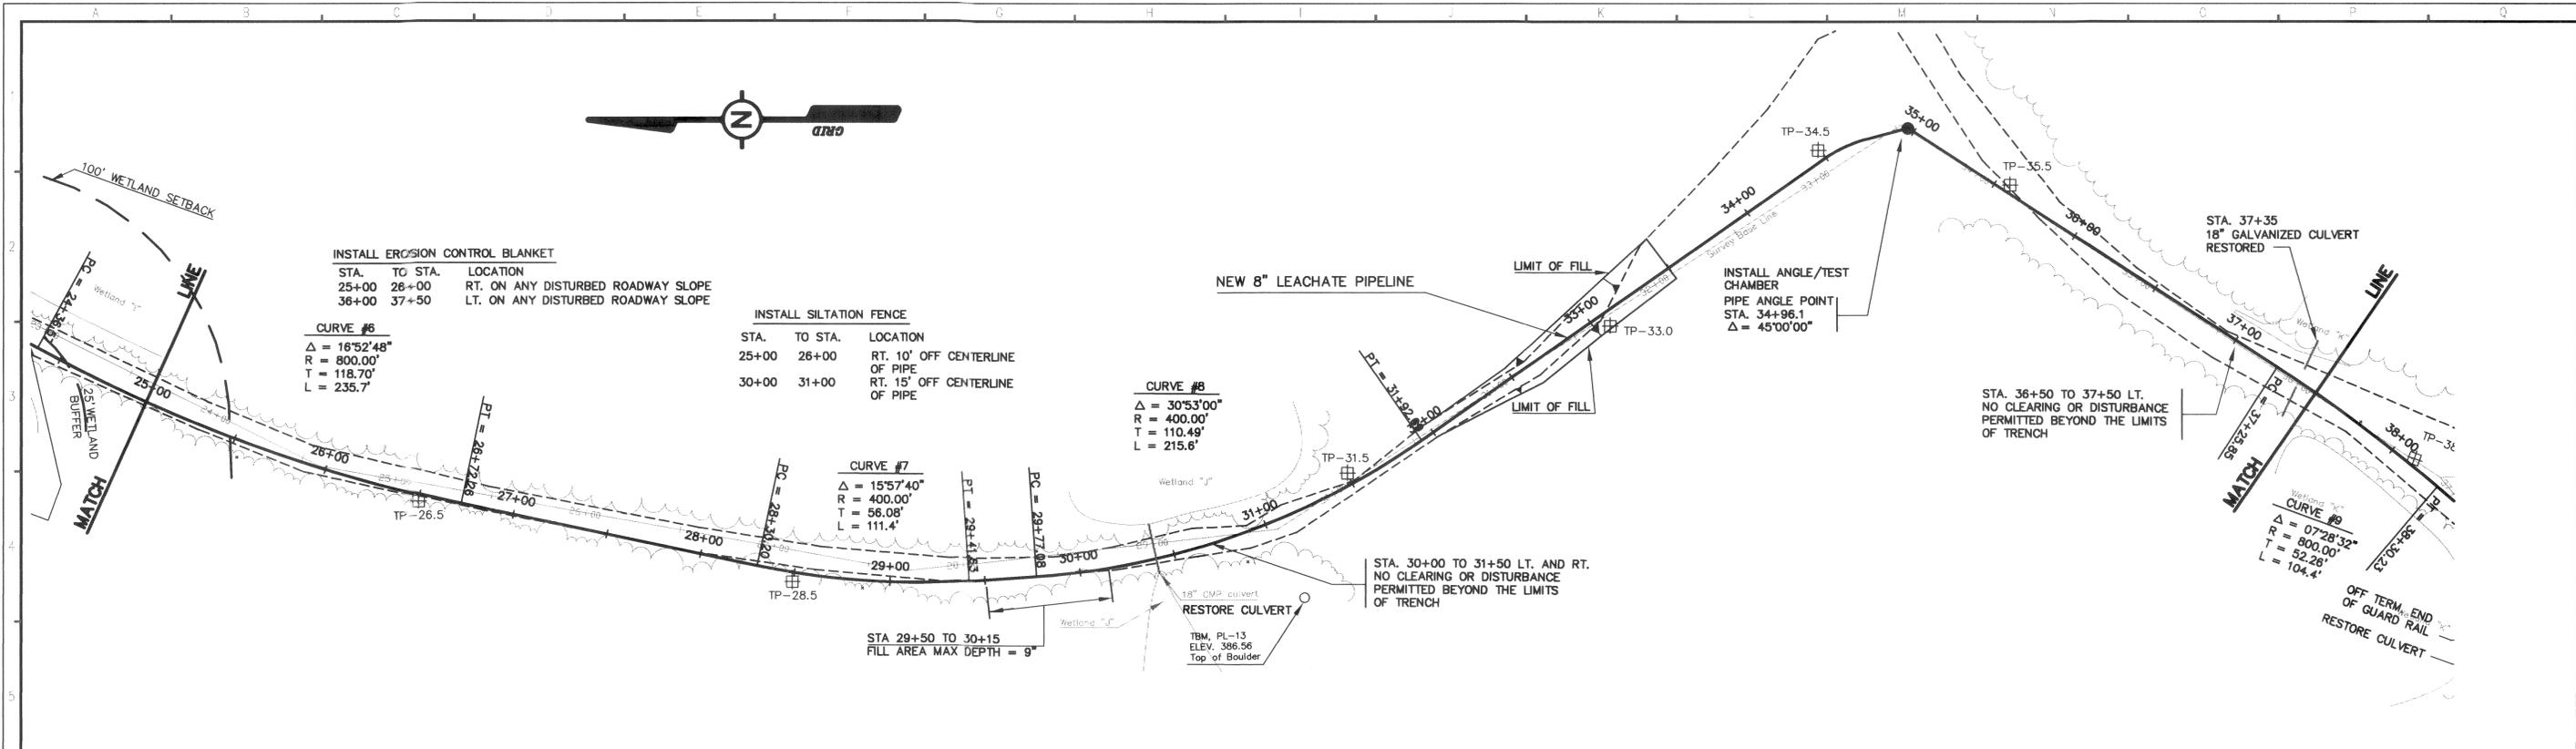


DRAWING NO.	REFERENCE DRAWING TITLE	CODE	NO.	DATE	REVISION	BY	CHK	APP'D	JOB NO.
		C	3/96		RECORD DRAWING	MSB	PBT		
		C	6/95		ISSUED FOR CONSTRUCTION	BAK	PBT		
		B	4/95		ISSUED FOR BIDS	RMC	PBT		
		P	4/95		PRELIMINARY CONSTRUCTION ISSUE	RMC	PBT		
		P			SUBMITTED W/ PERMIT APPLICATION	JRK	PBT		


DRN	JRK	9/94
CHK	PBT	10/94
CHK		
CORR		
APPVD		
ISSUE CODE		
P	- Prelim	B - Bids
M	- Mt. I.O.	C - Const.
SCALE 1"=40'H; 1"=4'V		

EAST OPERATION	
LEACHATE PIPELINE PROJECT	
DOLBY LANDFILL TO THE EAST OPERATION	
STA. 25+00 TO STA. 37+50	
8" FORCE MAIN	
PLAN & PROFILE	
JOB NO.	22846
ENG. REQ. NO.	
FILE NO.	2-092-4783
YB-22963	
SHEET 1 OF 1	



D:\94-227\ACAD\94227R12 Thu Mar 28 14:10:42 1996

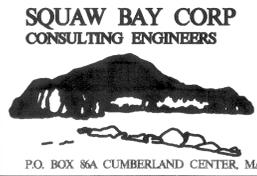

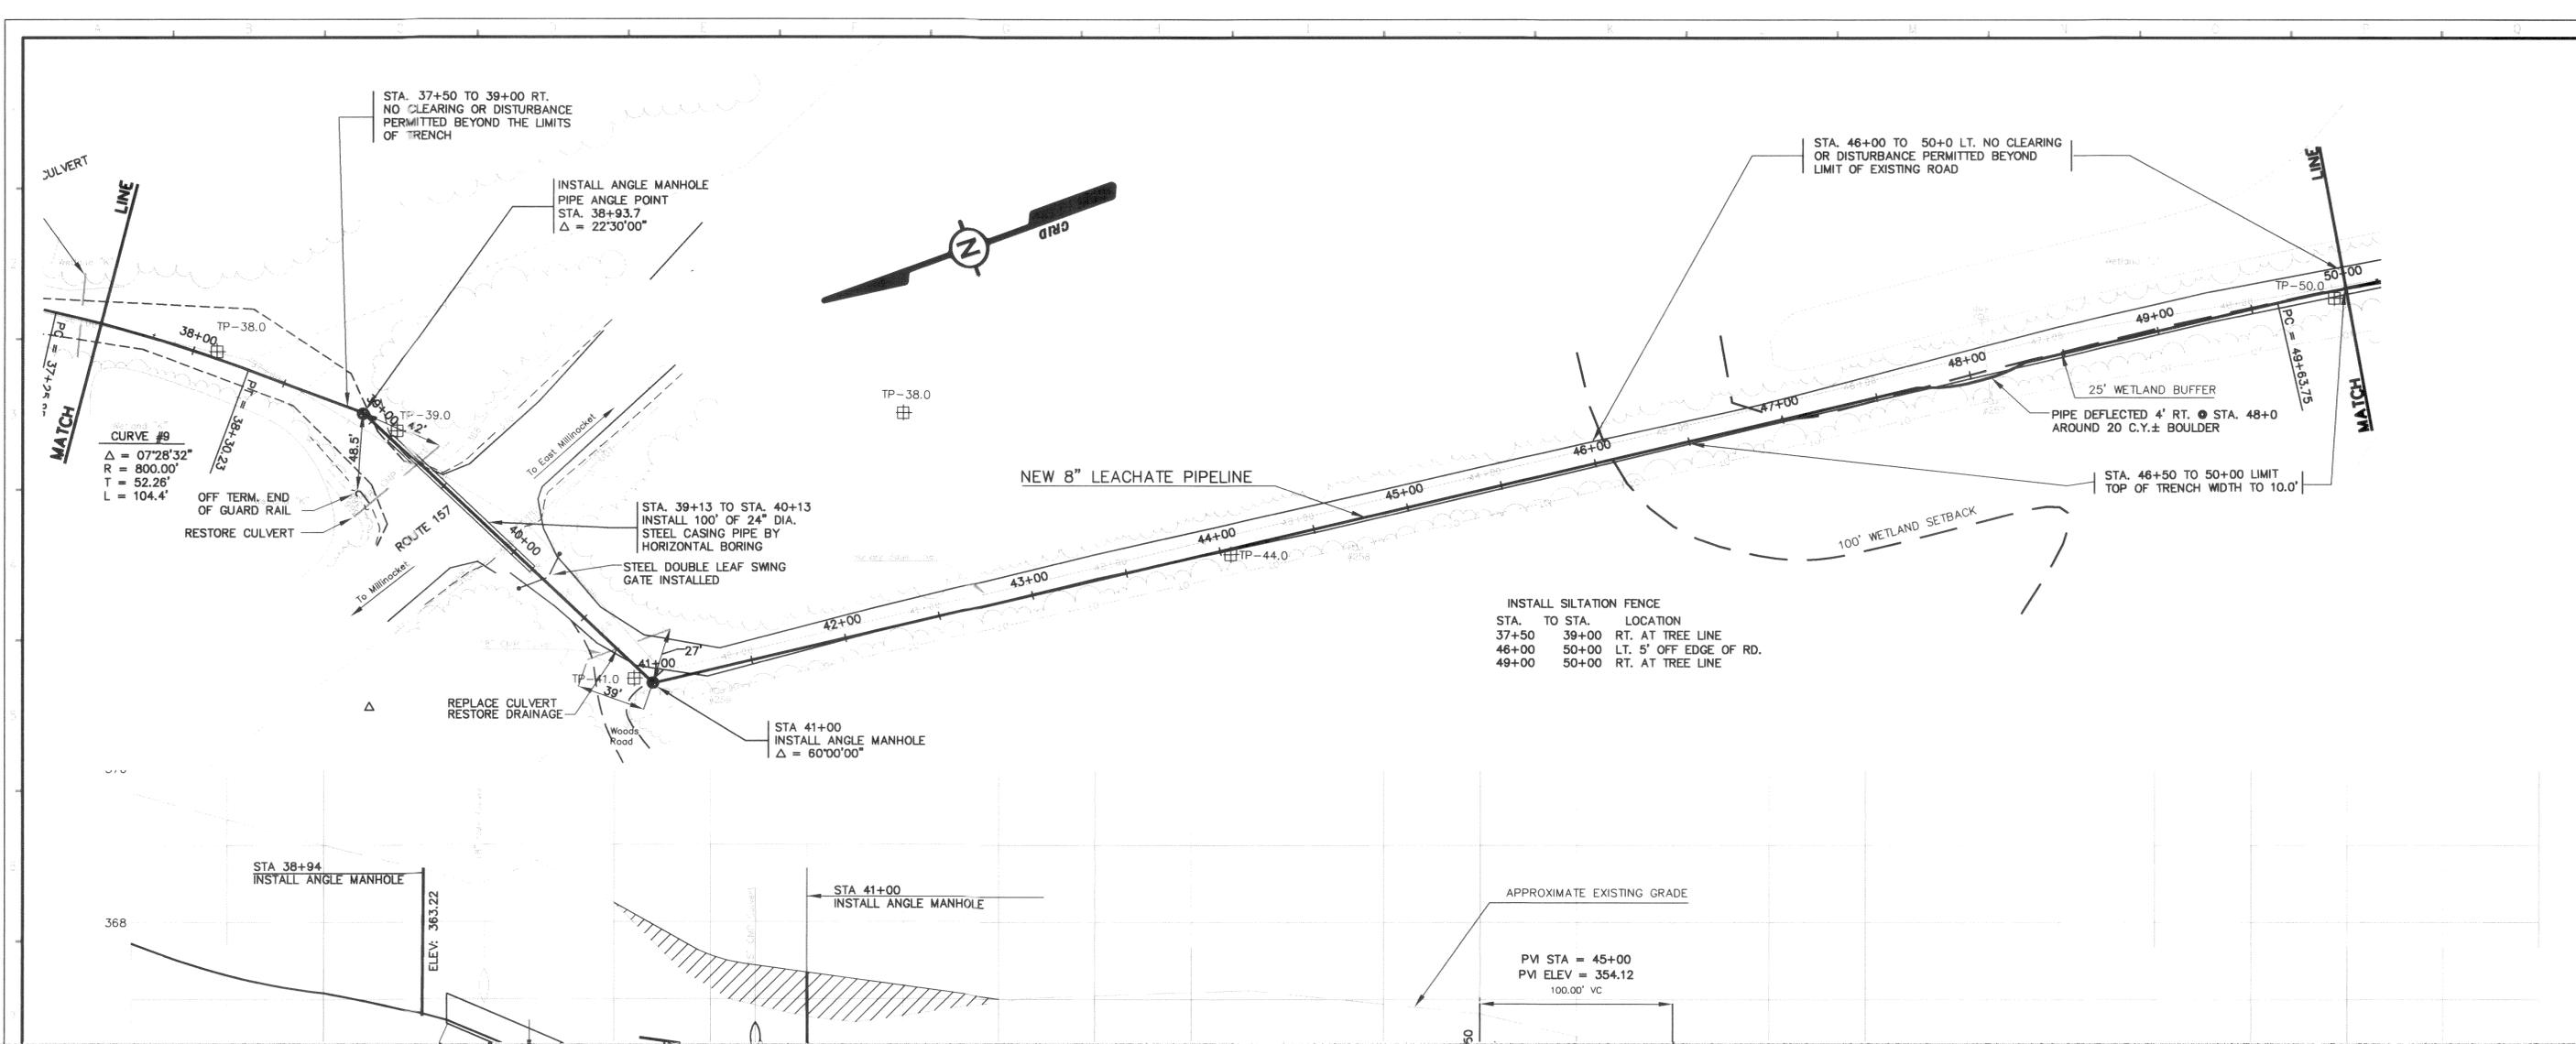CURVE #9  
 $\Delta = 07^{\circ}28'32''$   
 $R = 800.00'$   
 $T = 52.26'$   
 $L = 104.4'$

INSTALL SILTATION FENCE  
 STA. TO STA. LOCATION  
 37+50 39+00 RT. AT TREE LINE  
 46+00 50+00 LT. 5' OFF EDGE OF RD.  
 49+00 50+00 RT. AT TREE LINE

STA 38+94  
 INSTALL ANGLE MANHOLE




STA 41+00  
 INSTALL ANGLE MANHOLE

APPROXIMATE EXISTING GRADE


PVI STA = 45+00  
 PVI ELEV = 354.12  
 100.00' VC





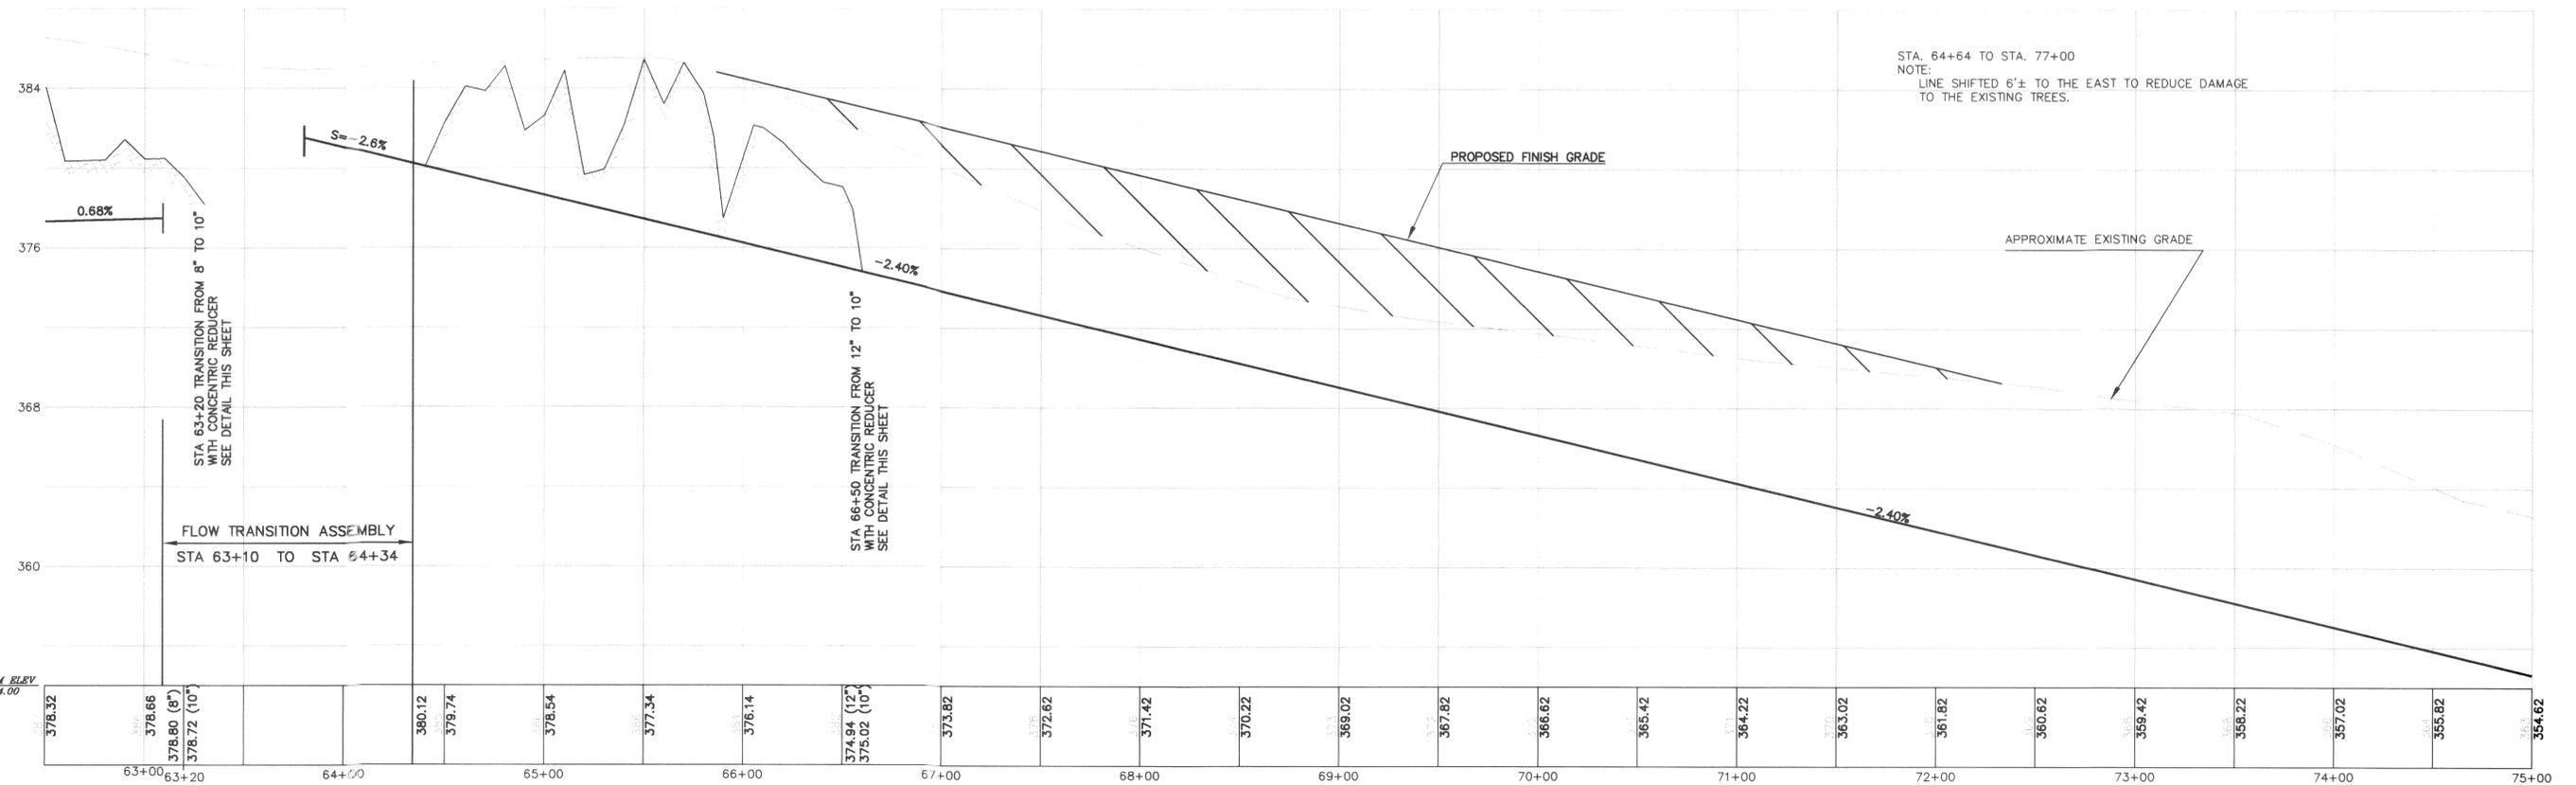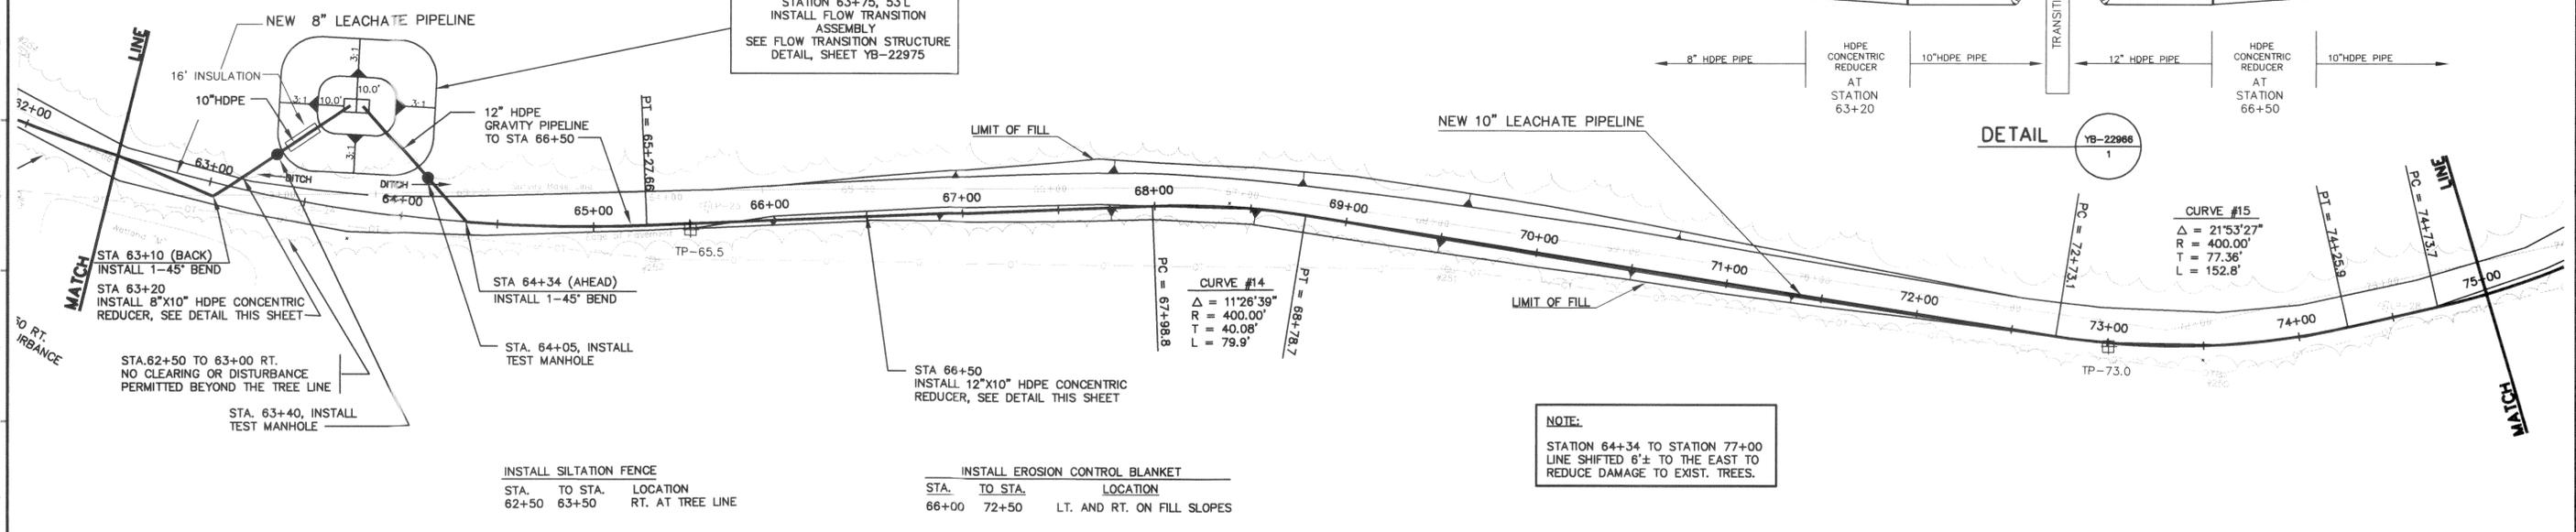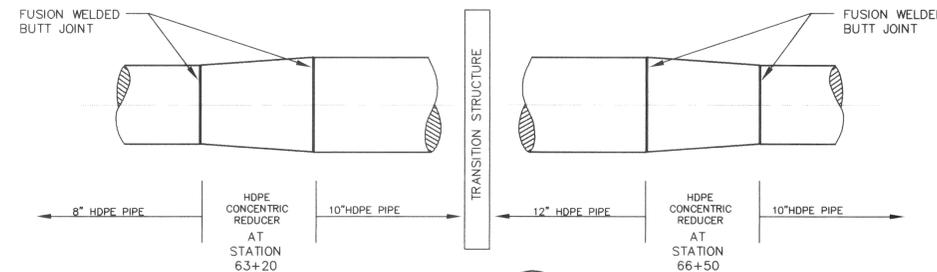

STATION	ELEVATION
63+00	378.32
63+20	378.66
63+20 (9")	378.80
63+20 (10")	378.72
64+00	380.12
64+00	379.74
65+00	378.54
66+00	377.34
66+00	378.14
67+00	374.94 (12")
67+00	375.02 (10")
67+00	373.82
68+00	372.62
68+00	371.42
69+00	370.22
69+00	369.02
70+00	367.82
70+00	366.62
71+00	365.42
71+00	364.22
72+00	363.02
72+00	361.82
73+00	360.62
73+00	359.42
74+00	358.22
74+00	357.02
75+00	355.82
75+00	354.62

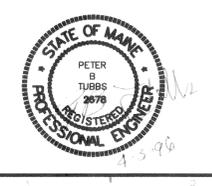

NO.	DATE	REVISION	BY	CHKD	APPD
C	3/96	RECORD DRAWING	MSB	PBT	
C	6/95	ISSUED FOR CONSTRUCTION	BAK	PBT	
B	4/95	ISSUED FOR BIDS	RMC	PBT	
P	4/95	PRELIMINARY CONSTRUCTION ISSUE	RMC	PBT	
P		SUBMITTED W/ PERMIT APPLICATION	JRK	PBT	

**SQUAW BAY CORP**  
CONSULTING ENGINEERS

P.O. BOX 86A CUMBERLAND CENTER, MAINE 04021

DRN	JRK	9/94
CHK	PBT	10/94
CHK		
CORR		
APPVD		
ISSUE CODE		
P	- Prelim	B - Bids
M	- Mtl T.O.	C - Const.
SCALE 1"=40'H; 1"=4'V		


**EAST OPERATION**  
**LEACHATE PIPELINE PROJECT**  
DOLBY LANDFILL TO THE EAST OPERATION  
STA. 62+50 TO STA. 75+00  
8" FORCE MAIN/12" & 10" GRAVITY TRANSITION  
PLAN & PROFILE

JOB NO. 22846  
ENG. REG. NO.  
FILE NO. 2-092-4783

**YB-22966**  
SHEET 1 OF 1






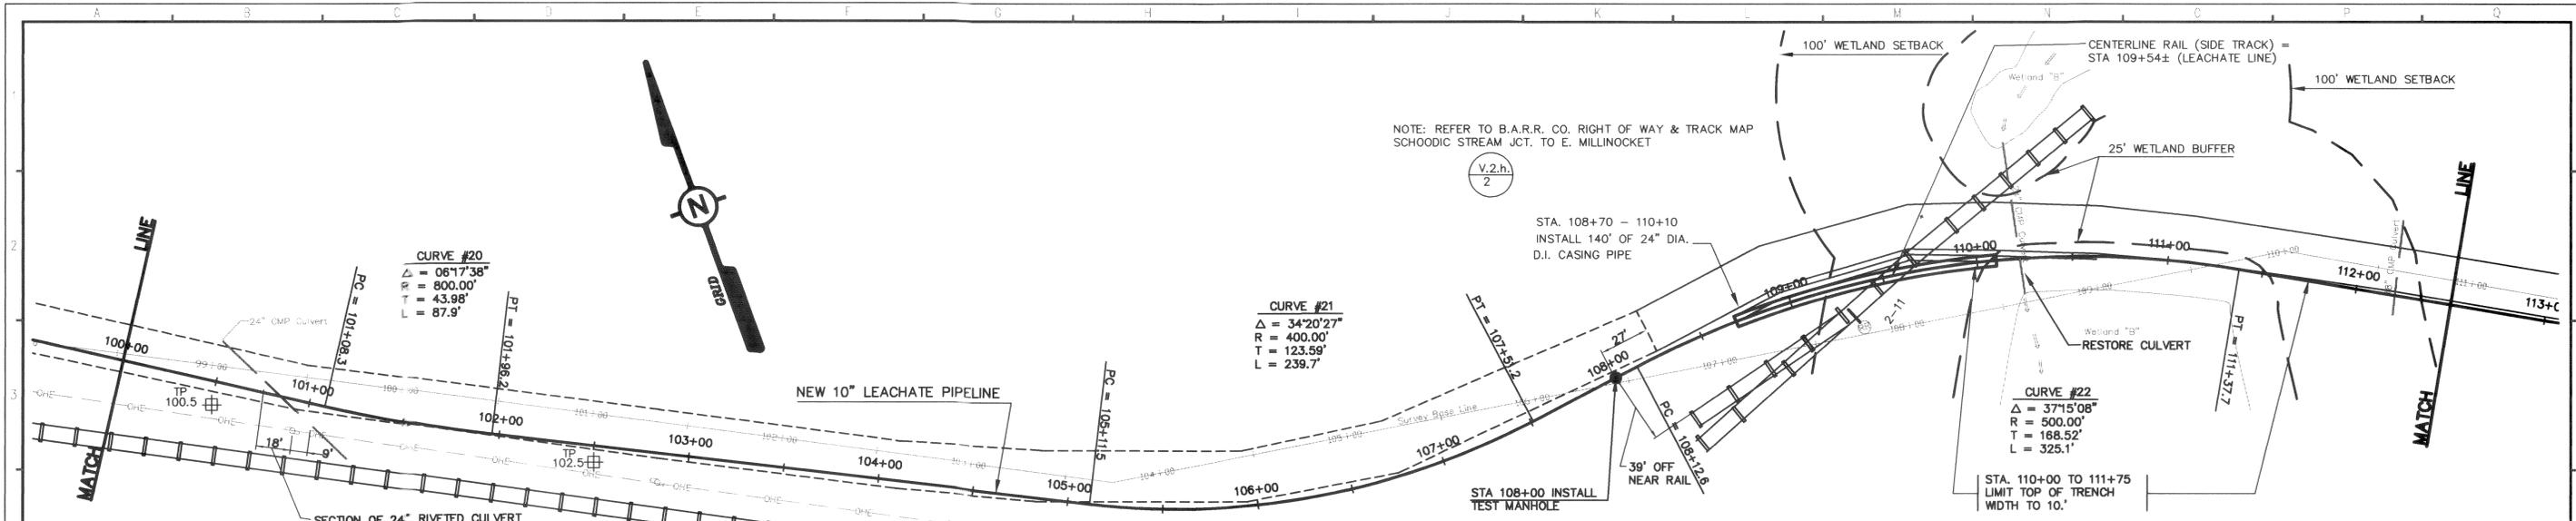

INSTALL EROSION CONTROL BLANKET  
 STA. TO STA. LOCATION  
 (MULCHED ONLY) 108+50 / R.R. / RT. ON ANY DISTURBED SLOPE / R.R. 112+50 RT. ON ANY DISTURBED SLOPE

INSTALL SILTATION FENCE  
 STA. TO STA. LOCATION  
 108+50 R.R. RT. 10' OFF EDGE OF TRENCH  
 R.R. 112+50 RT. 10' OFF EDGE OF TRENCH

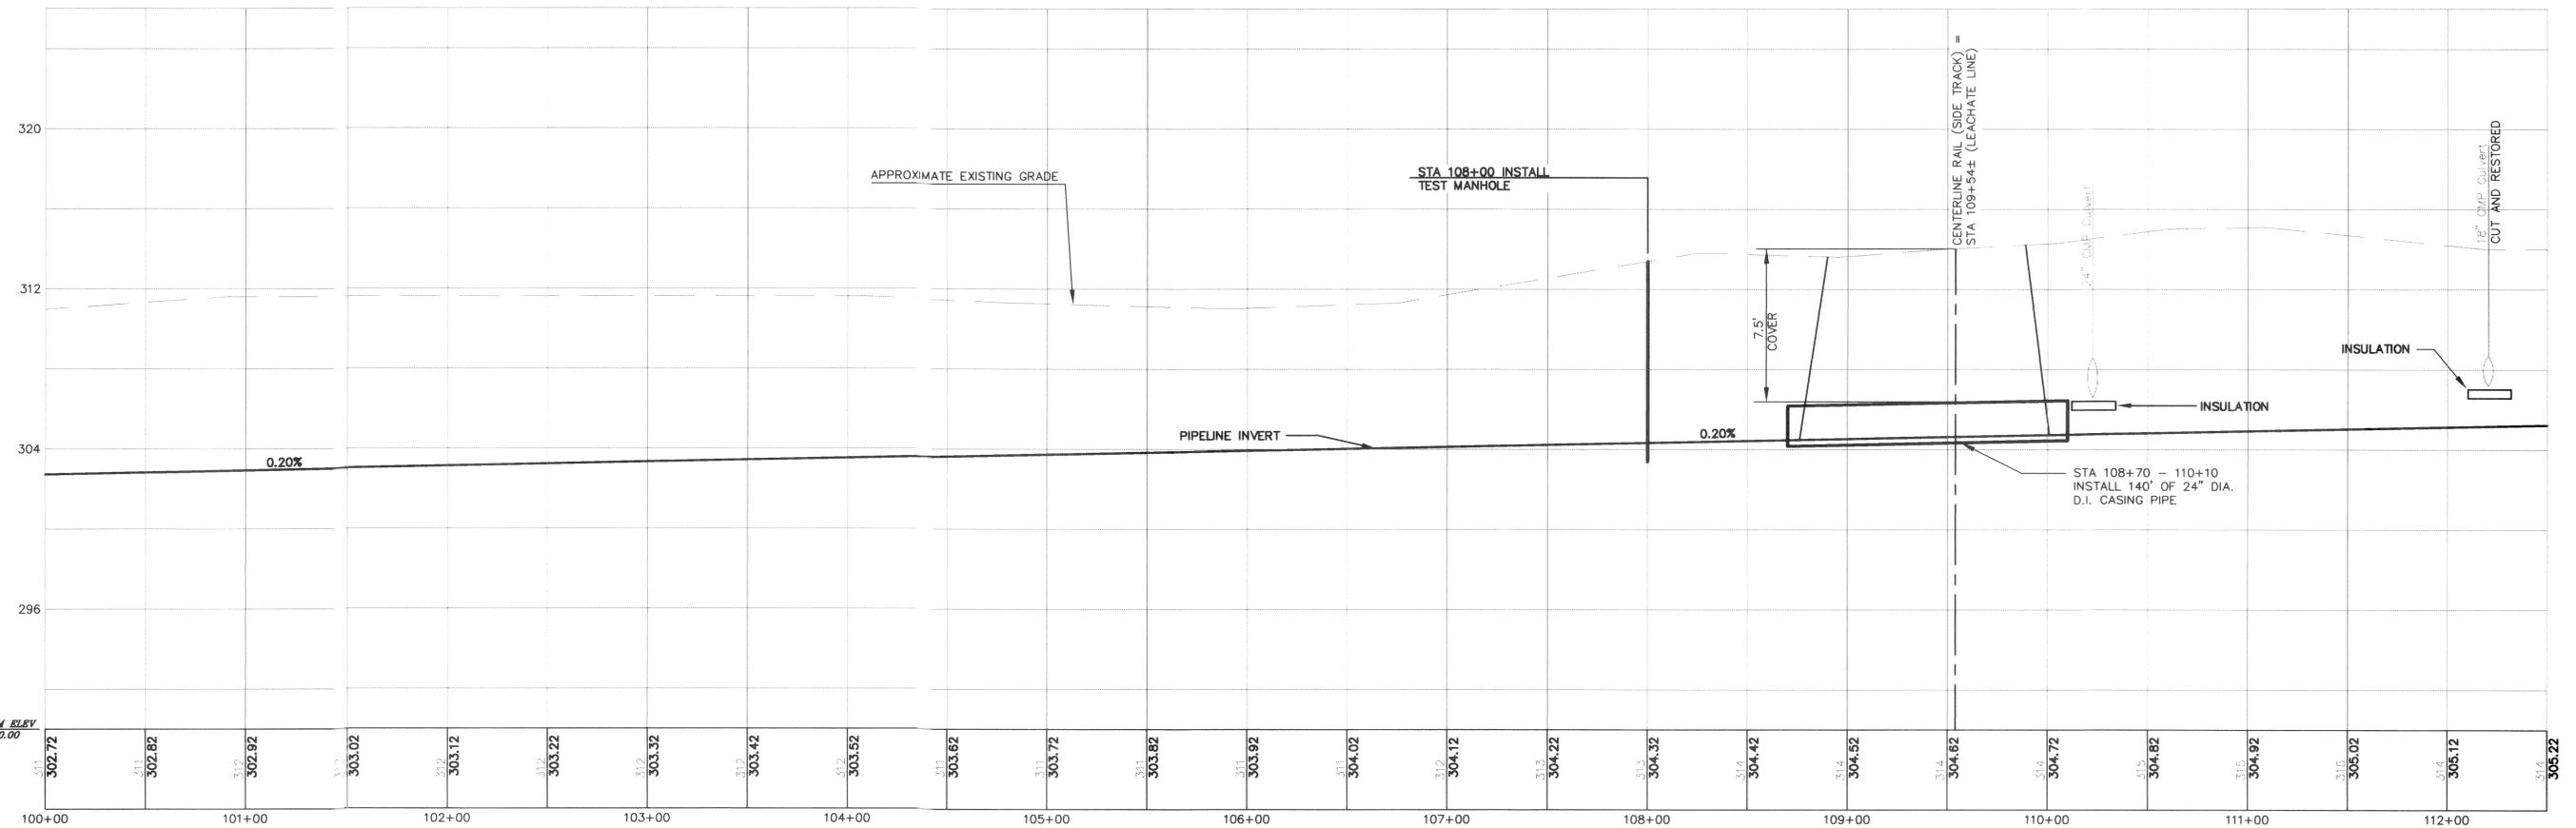

DRAWING NO.	REFERENCE DRAWING TITLE	CODE	NO.	DATE	REVISION	BY	CHK	APPD	JOB NO.
V2h-2	B.A.R.R. Co. RIGHT OF WAY & TRACK MAP, SCHOODIC STREAM JCT. TO E. MILLINOCKET	P			SUBMITTED W/ PERMIT APPLICATION	JRK	PBT		

**SQUAW BAY CORP**  
 CONSULTING ENGINEERS

P.O. BOX 86A CUMBERLAND CENTER, MAINE 04021



DRN	JRK	9/94
CHK	PBT	10/94
CHK		
CORR		
APPVD		
ISSUE CODE		
P - Prelim	B - Bids	
M - Mtl T.O.	C - Const.	
SCALE 1"=40'H; 1"=4'V		

**EAST OPERATION**  
 LEACHATE PIPELINE PROJECT  
 DOLBY LANDFILL TO THE EAST OPERATION  
 STA. 100+00 TO STA. 112+50  
 10" GRAVITY SECTION  
 PLAN & PROFILE

JOB NO. 22846  
 ENG. REQ. NO.  
 FILE NO. 2-092-4783

**YB-22969**  
 SHEET 1 OF 1

D:\94-227\ACAD\94227R12 Thu Mar 28 14:55:52 1996

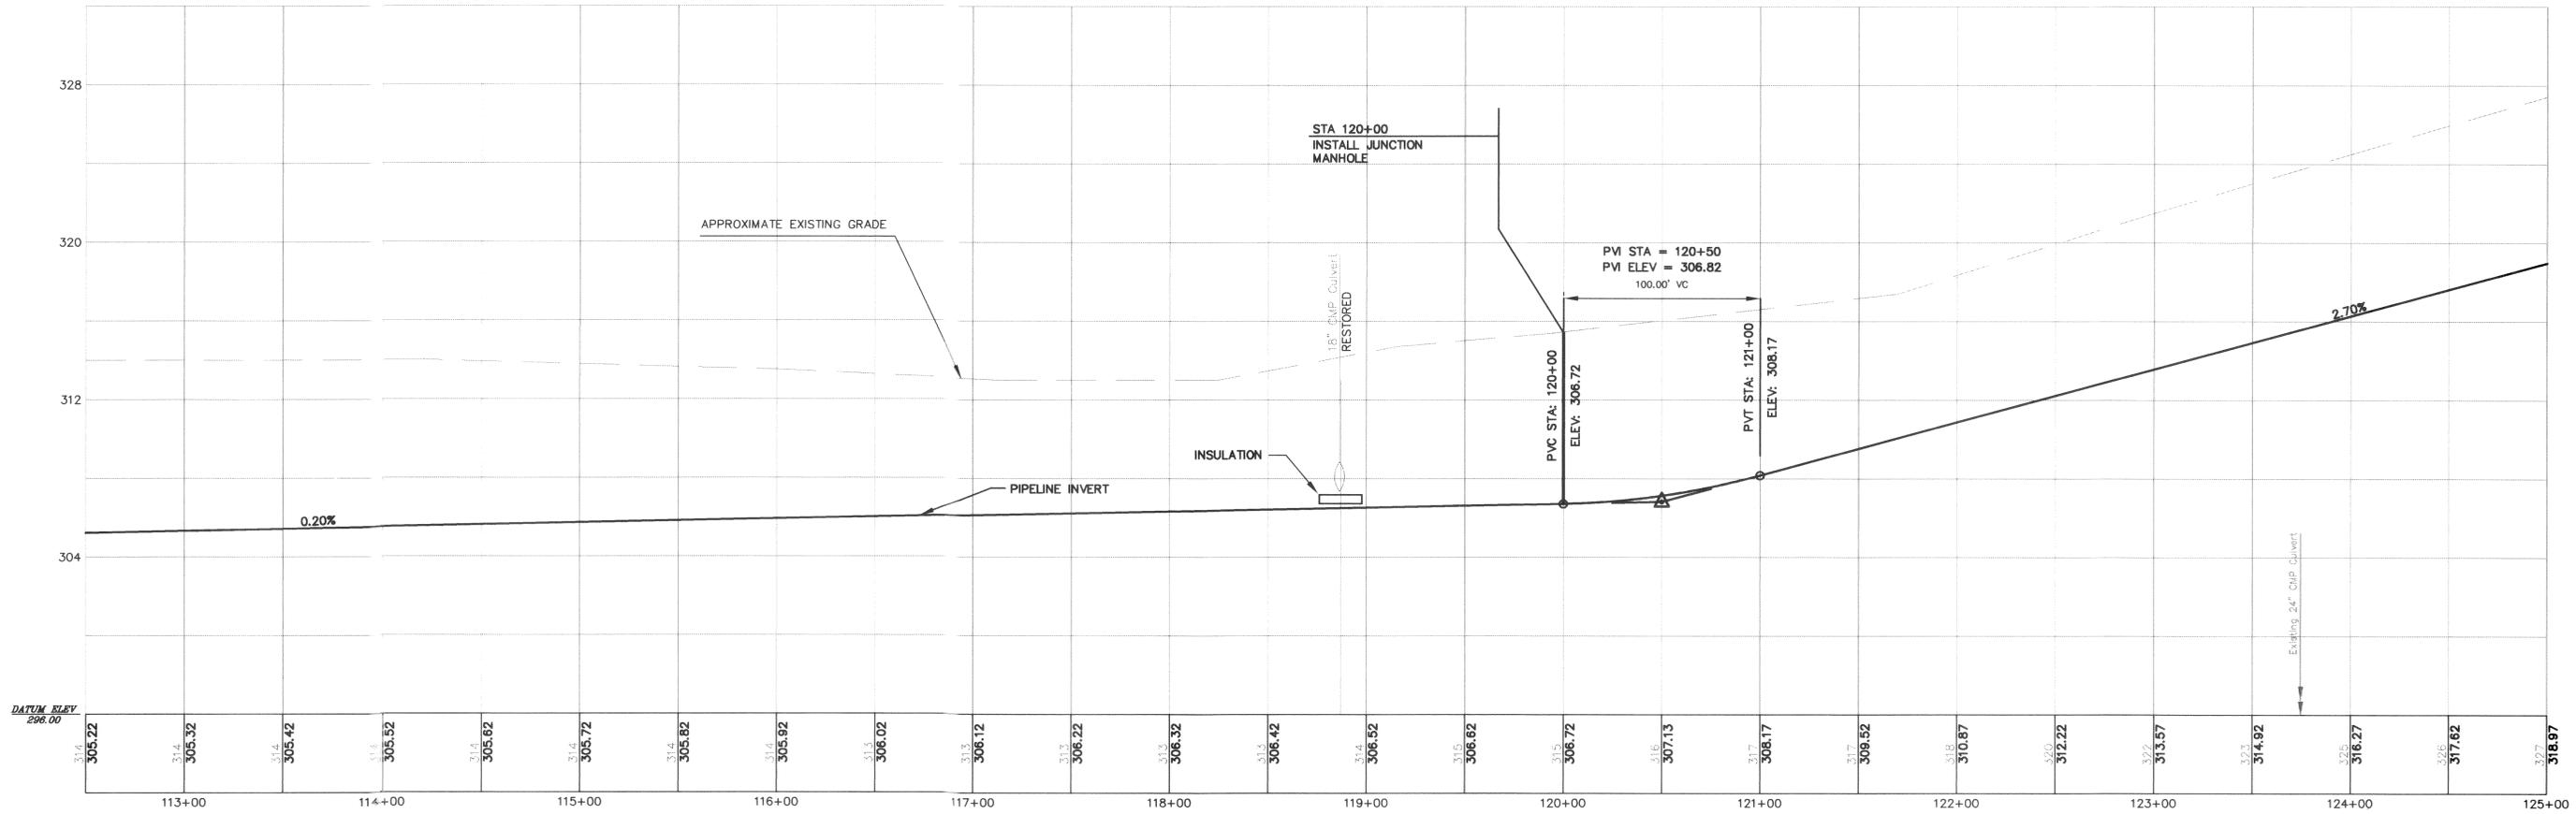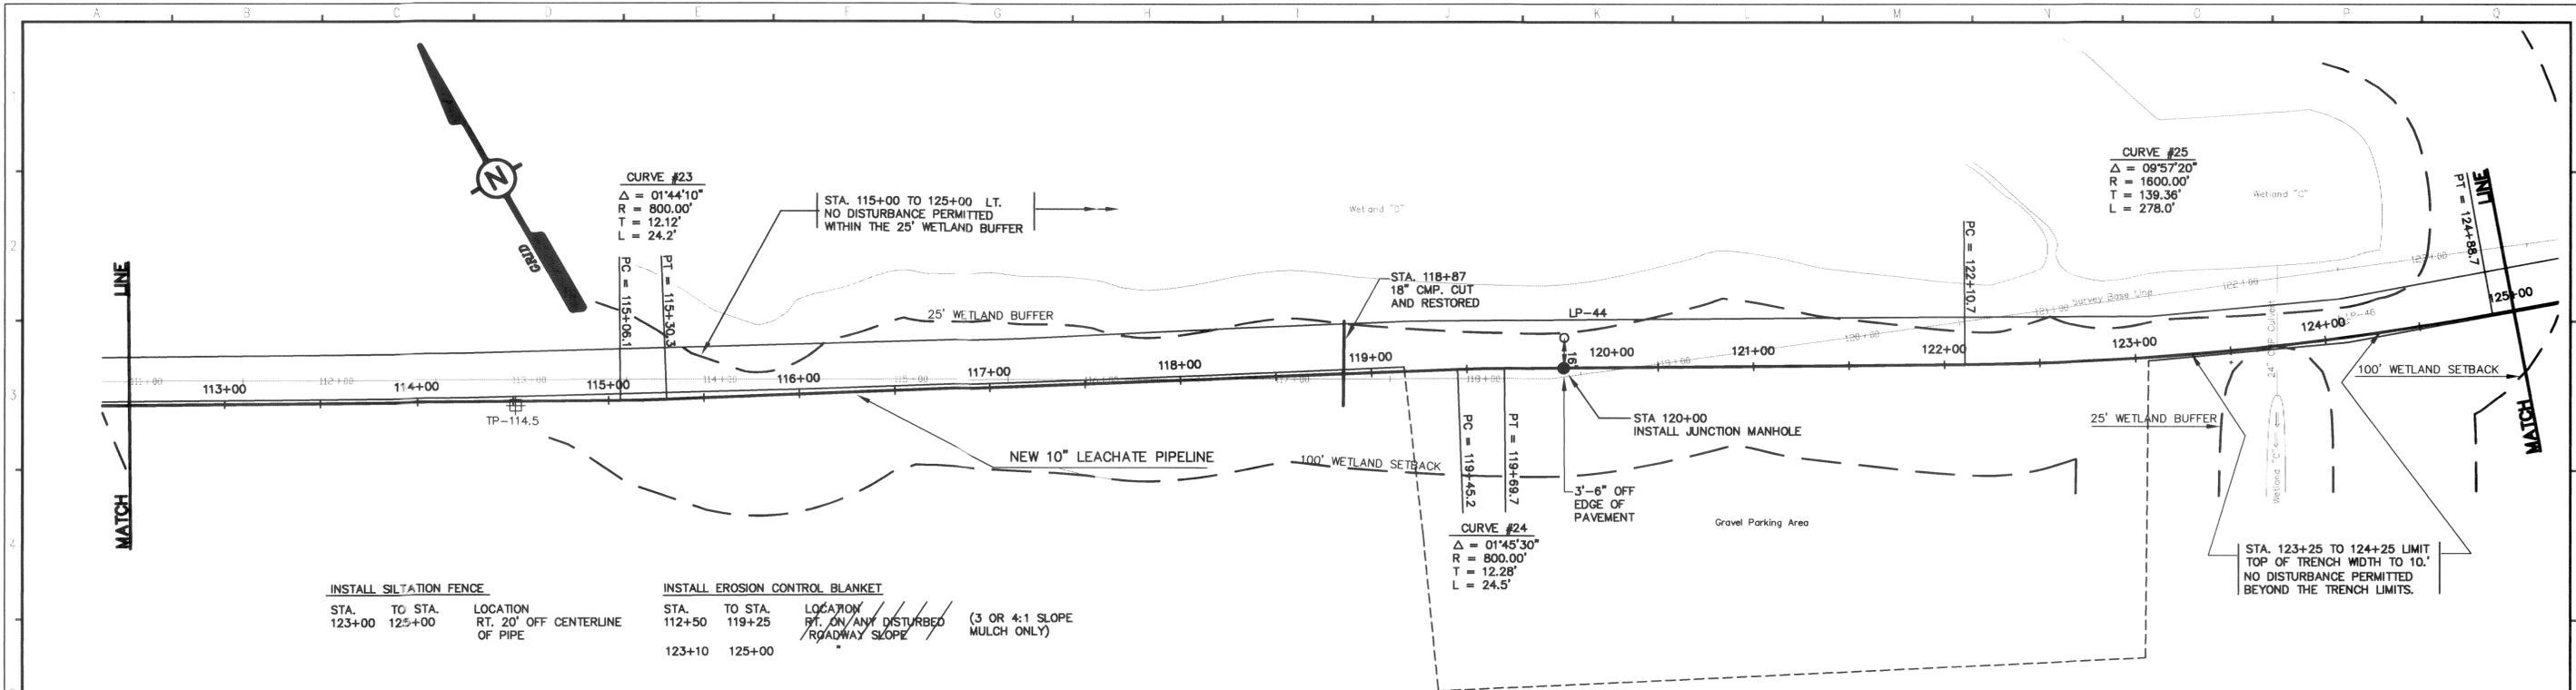

D:\94-227\ACAD\94227R12 Thu Mar 28 15:00:43 1996



DRAWING NO.	REFERENCE DRAWING TITLE	CODE	NO.	DATE	REVISION	BY	CHK	APP'D	JOB NO.
		C	3/96		RECORD DRAWING	MSB	PBT		
		C	6/95		ISSUED FOR CONSTRUCTION	BAK	PBT		
		B	4/95		ISSUED FOR BIDS	RMC	PBT		
		P	4/95		PRELIMINARY CONSTRUCTION ISSUE	RMC	PBT		
		P			SUBMITTED W/ PERMIT APPLICATION	JRK	PBT		

**SQUAW BAY CORP**  
 CONSULTING ENGINEERS

P.O. BOX 86A CUMBERLAND CENTER, MAINE 04021


DRN	JRK	9/94
CHK	PBT	10/94
CHK		
CORR		
APPVD		
ISSUE CODE		
P	- Prelim	B - Bids
M	- Mt. T.O.	C - Const.
SCALE 1"=40'H; 1"=4'V		

**BOWATER**  
 Great Northern Paper

**EAST OPERATION**  
 LEACHATE PIPELINE PROJECT  
 DOLBY LANDFILL TO THE EAST OPERATION  
 STA. 112+50 TO STA. 125+00  
 10" GRAVITY SECTION  
 PLAN & PROFILE

JOB NO. 22846  
 ENG. REQ. NO.  
 FILE NO. 2-092-4783

**YB-22970**  
 SHEET 1 OF 1

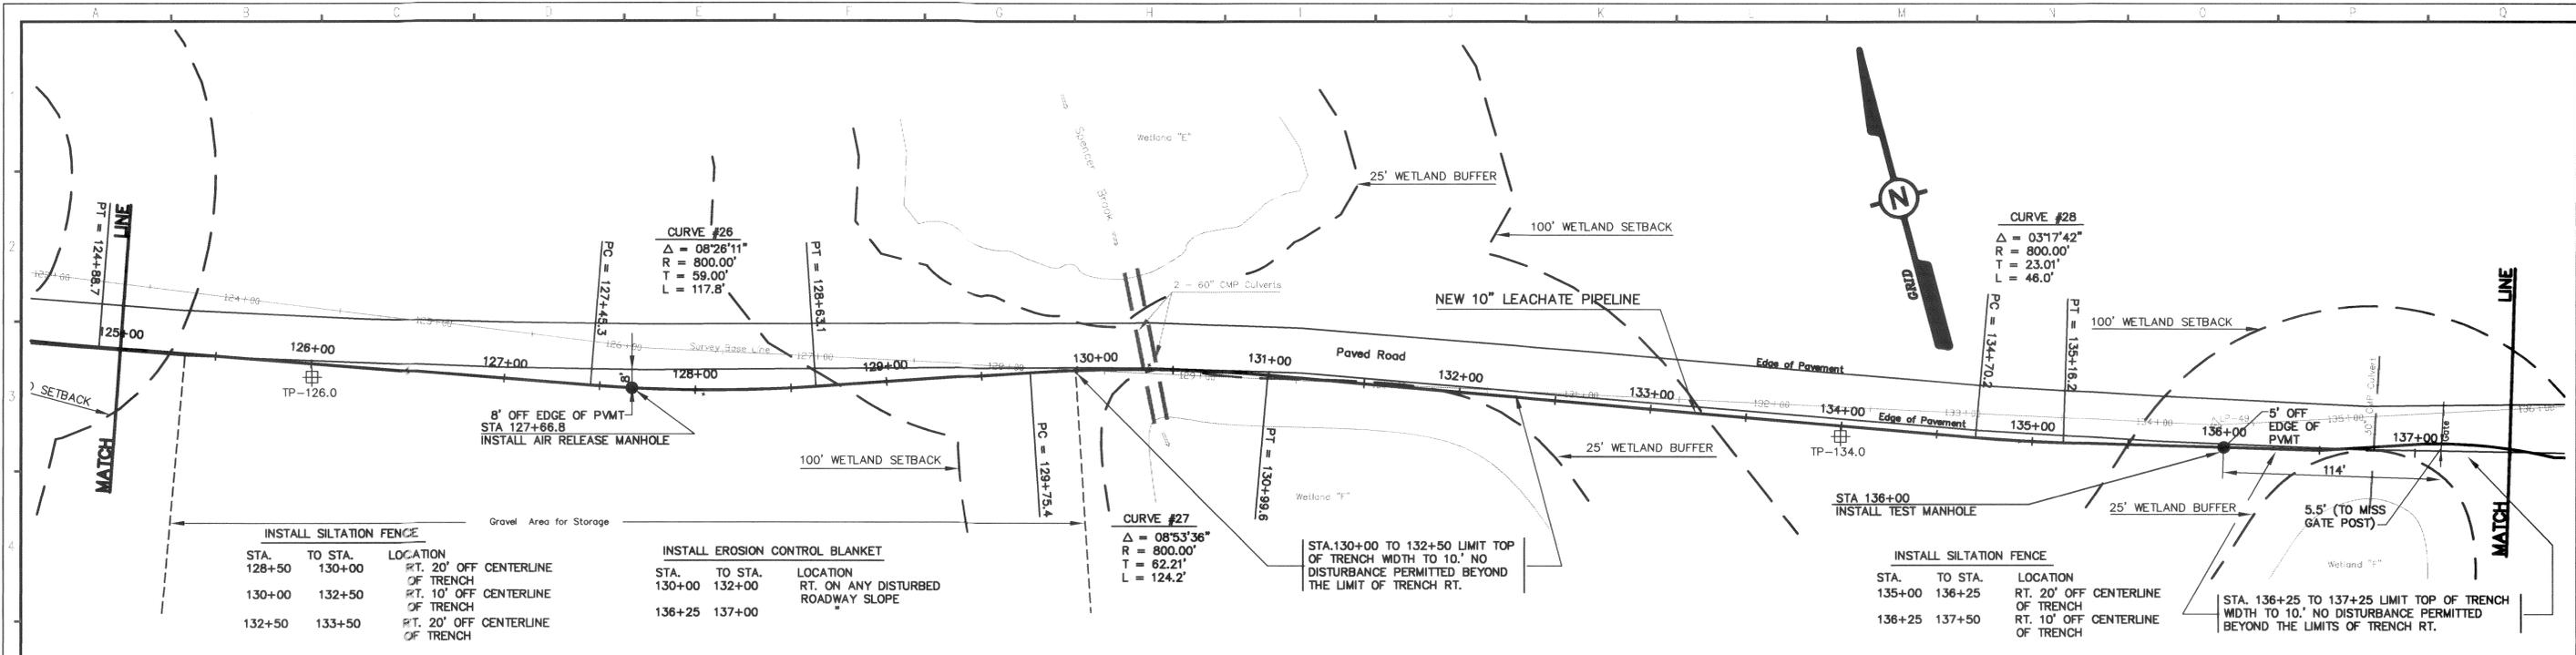

INSTALL SILTATION FENCE

STA.	TO STA.	LOCATION
128+50	130+00	RT. 20' OFF CENTERLINE OF TRENCH
130+00	132+50	RT. 10' OFF CENTERLINE OF TRENCH
132+50	133+50	RT. 20' OFF CENTERLINE OF TRENCH


INSTALL EROSION CONTROL BLANKET

STA.	TO STA.	LOCATION
130+00	132+00	RT. ON ANY DISTURBED ROADWAY SLOPE
136+25	137+00	

INSTALL SILTATION FENCE

STA.	TO STA.	LOCATION
135+00	136+25	RT. 20' OFF CENTERLINE OF TRENCH
136+25	137+50	RT. 10' OFF CENTERLINE OF TRENCH

STA. 136+25 TO 137+25 LIMIT TOP OF TRENCH WIDTH TO 10'. NO DISTURBANCE PERMITTED BEYOND THE LIMITS OF TRENCH RT.

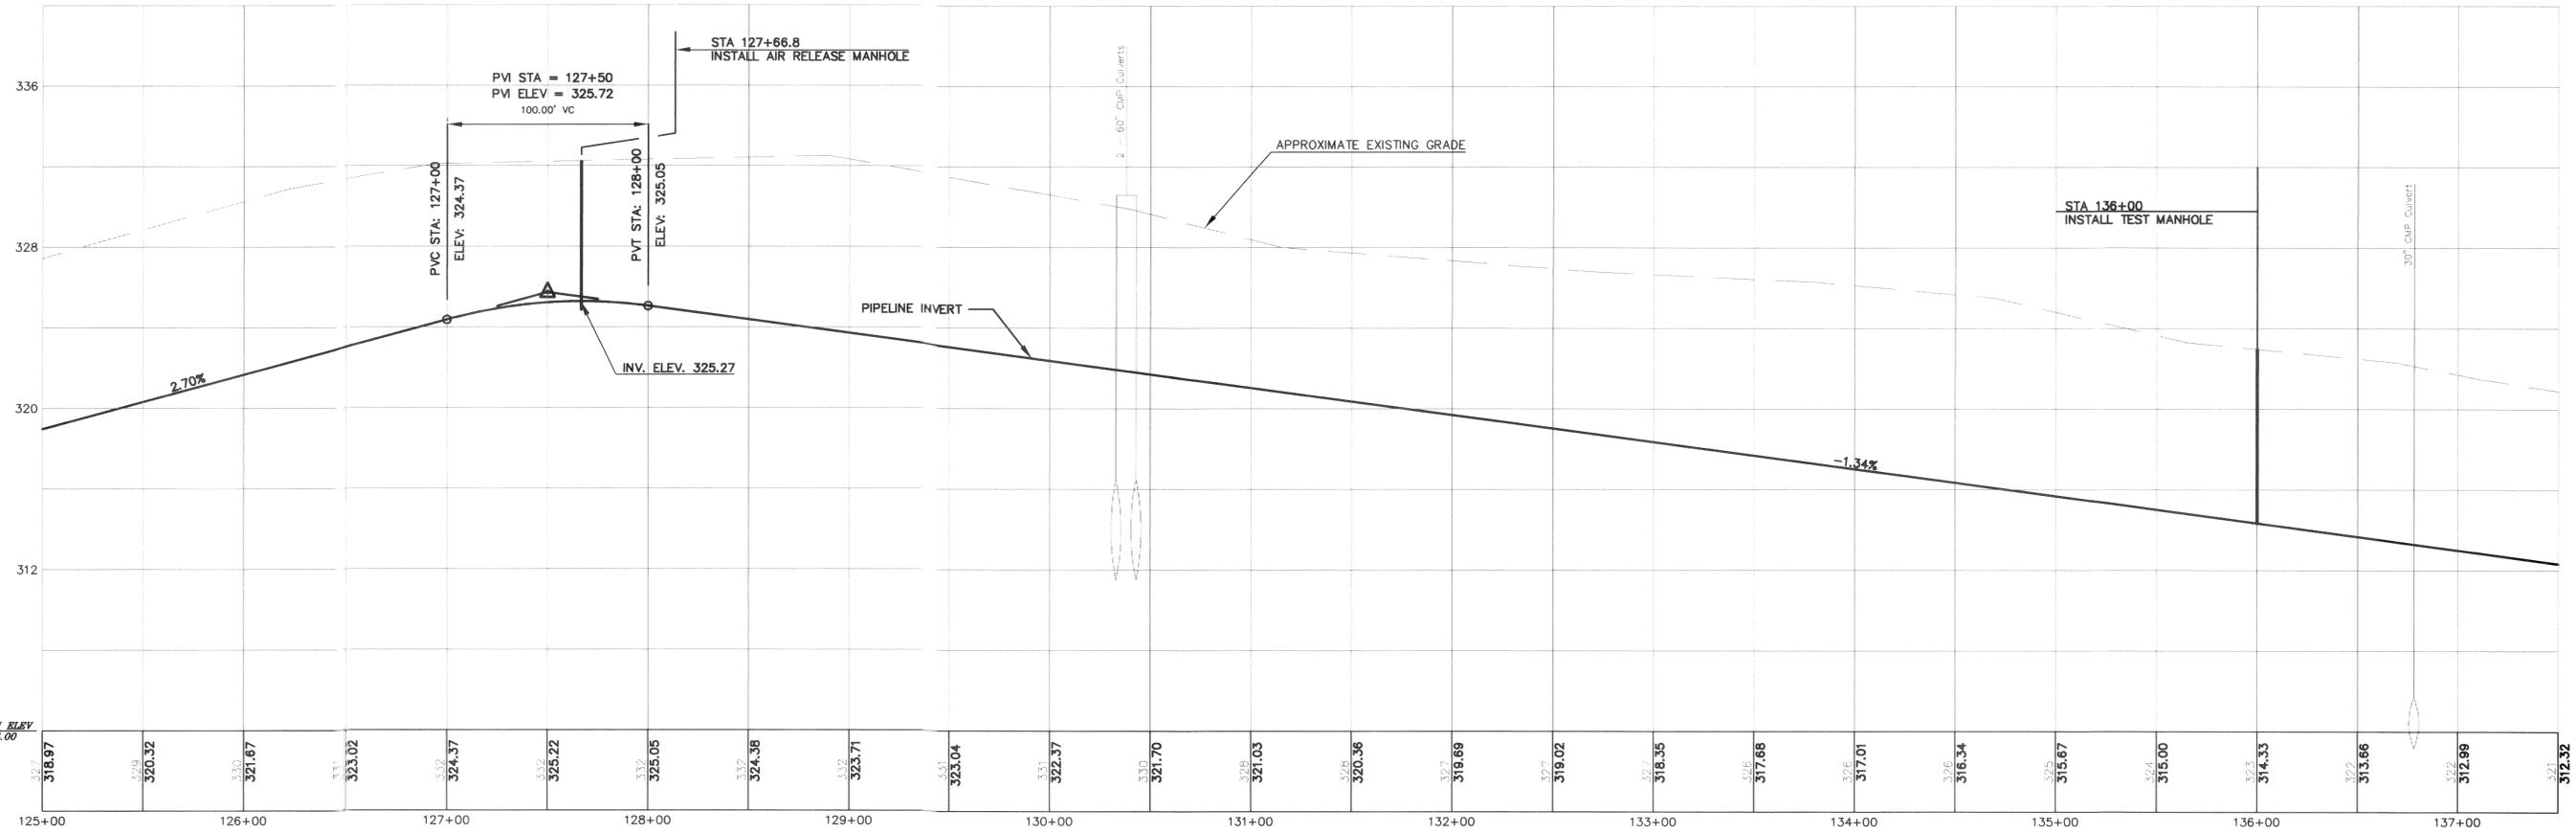

STATION	ELEVATION
125+00	318.97
126+00	320.32
127+00	321.67
128+00	323.02
129+00	324.37
130+00	325.72
131+00	327.07
132+00	328.42
133+00	329.77
134+00	331.12
135+00	332.47
136+00	333.82
137+00	335.17

D:\94-227\ACAD\94227R12 Thu Mar 26 15:04:11 1996



DRAWING NO.	REFERENCE DRAWING TITLE	CODE	NO.	DATE	REVISION	BY	CHK	APPVD	JOB NO.
		C	3/96		RECORD DRAWING	MSB	PBT		
		C	6/95		ISSUED FOR CONSTRUCTION	BAK	PBT		
		B	4/95		ISSUED FOR BIDS	RMC	PBT		
		P	4/95		PRELIMINARY CONSTRUCTION ISSUE	RMC	PBT		
		P			SUBMITTED W/ PERMIT APPLICATION	JRK	PBT		

**SQUAW BAY CORP**  
CONSULTING ENGINEERS


P.O. BOX 86A CUMBERLAND CENTER, MAINE 04021

DRN	JRK	9/94
CHK	PBT	10/94
CHK		
CORR		
APPVD		
ISSUE CODE		
P	- Prelim	B - Bids
M	- Mt. T.O.	C - Const.
SCALE 1"=40'H; 1"=4'V		



**EAST OPERATION**  
LEACHATE PIPELINE PROJECT  
DOLBY LANDFILL TO THE EAST OPERATION  
STA. 125+00 TO STA. 137+50  
10' GRAVITY SECTION  
PLAN & PROFILE

JOB NO. 22846  
ENG. REG. NO. YB-22971  
FILE NO. 2-092-4783  
SHEET 1 OF 1

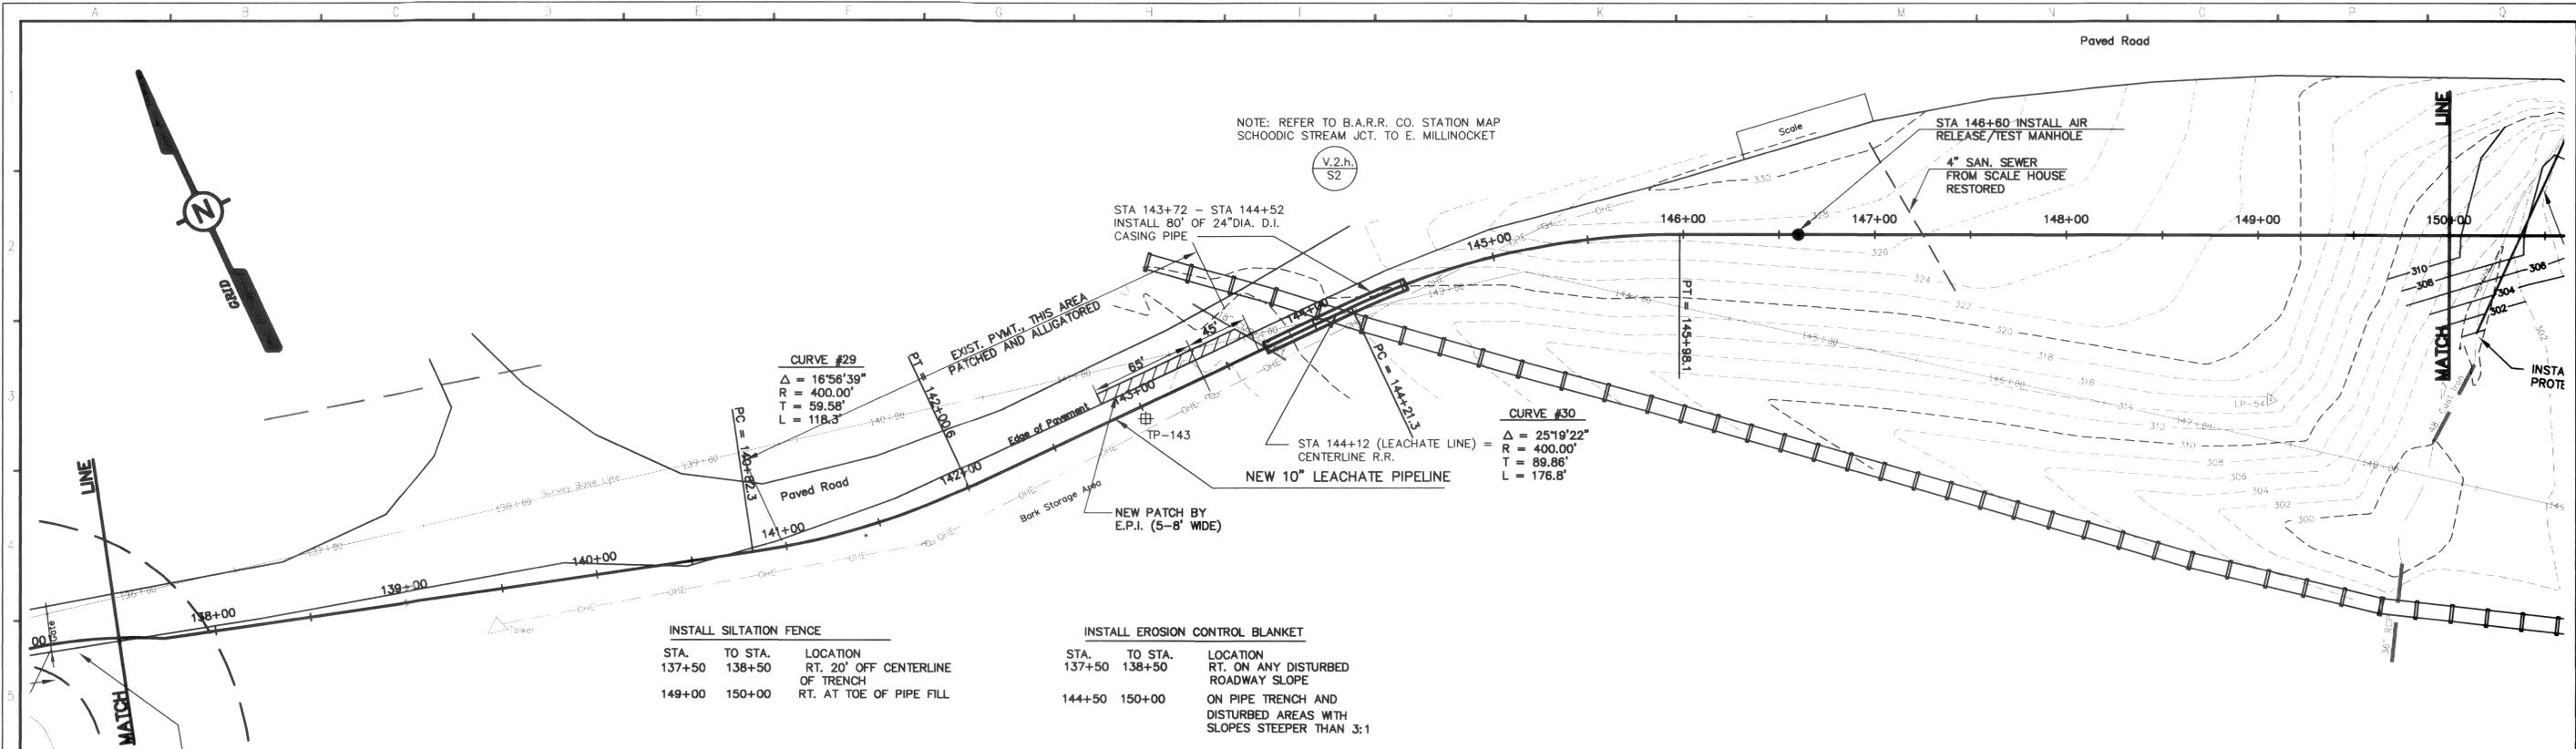


**INSTALL SILTATION FENCE**

STA.	TO STA.	LOCATION
137+50	138+50	RT. 20' OFF CENTERLINE OF TRENCH
149+00	150+00	RT. AT TOE OF PIPE FILL

**INSTALL EROSION CONTROL BLANKET**

STA.	TO STA.	LOCATION
137+50	138+50	RT. ON ANY DISTURBED ROADWAY SLOPE
144+50	150+00	ON PIPE TRENCH AND DISTURBED AREAS WITH SLOPES STEEPER THAN 3:1

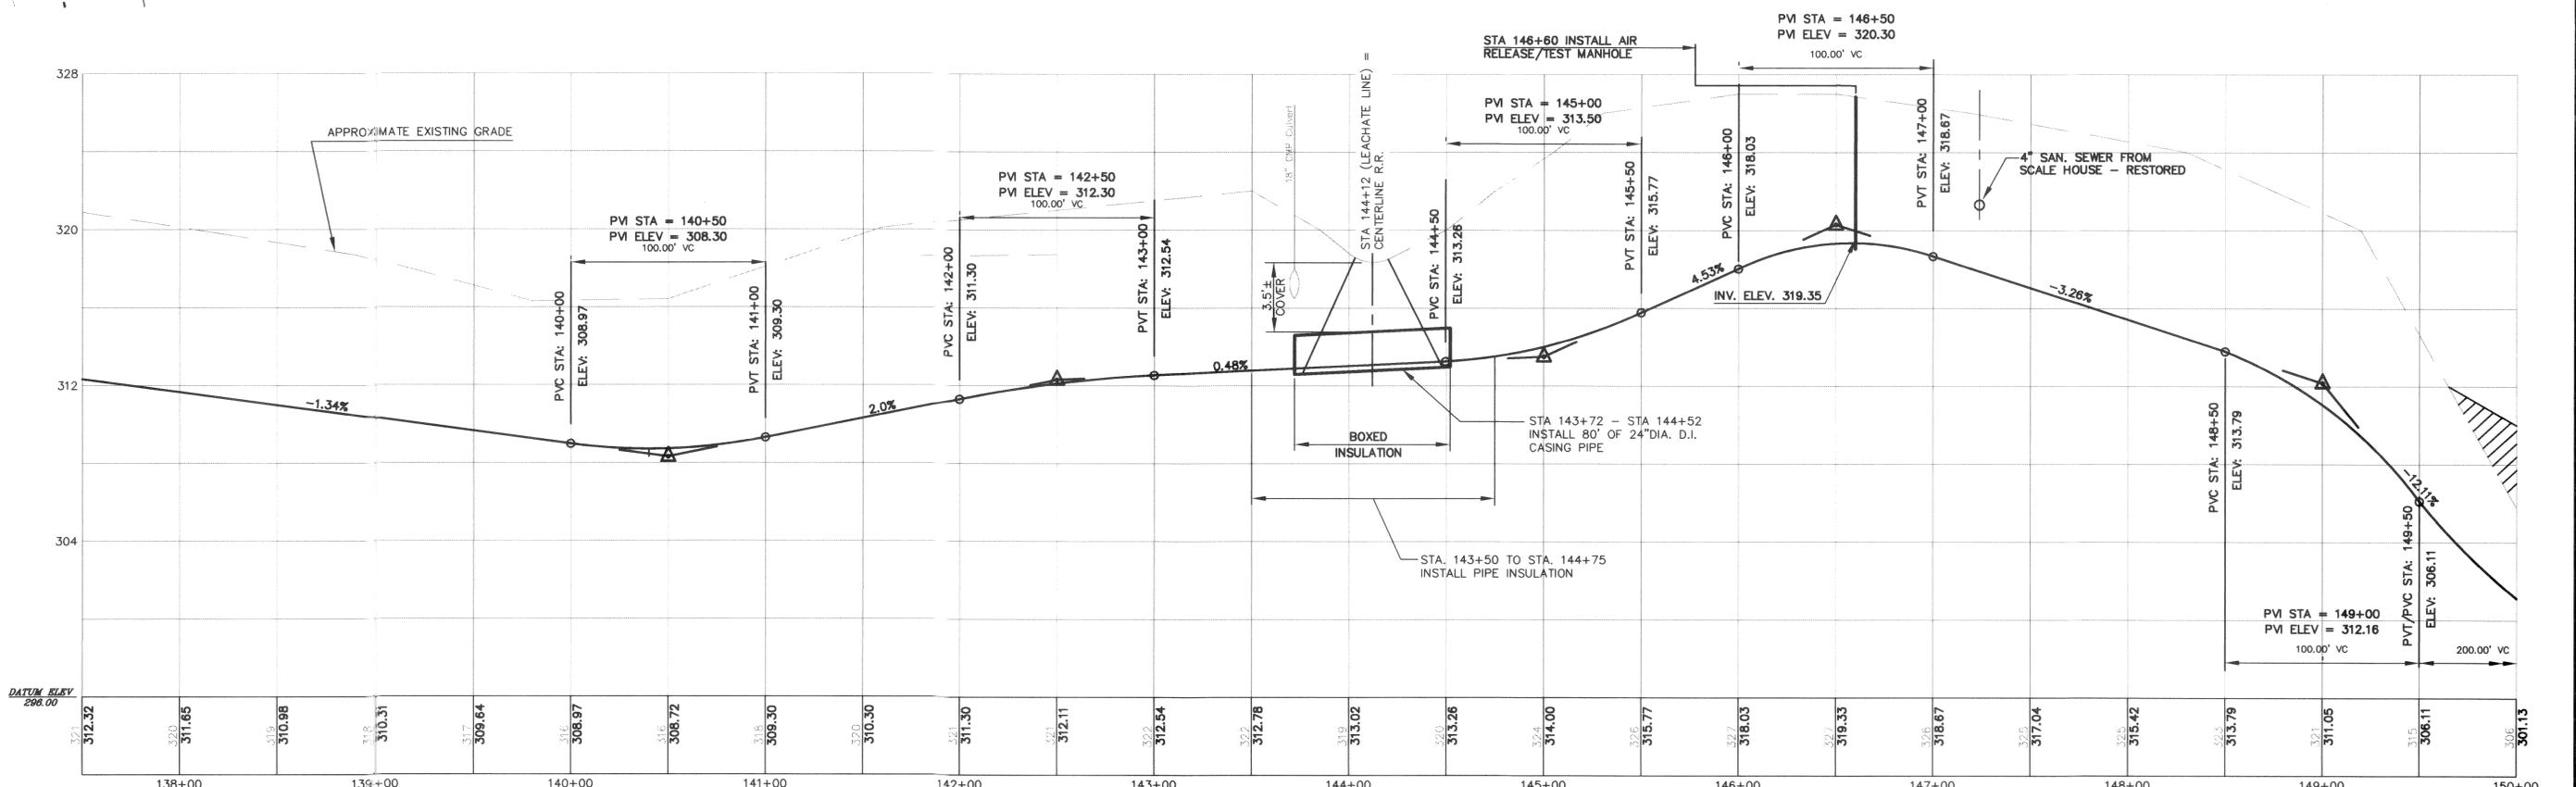

STA.	ELEV.																										
137+00	312.32	138+00	311.65	139+00	310.98	140+00	310.31	141+00	309.64	142+00	311.30	143+00	312.54	144+00	313.28	145+00	314.00	146+00	315.77	147+00	318.67	148+00	313.79	149+00	311.05	150+00	306.11



DRAWING NO.	REFERENCE DRAWING TITLE	CODE	NO.	DATE	REVISION	BY	CHKD	APPVD	JOB NO.
V2h-S2	B.A.R.R. Co. STATION MAP SCHOODIC STREAM JCT. TO E. MILLINOCKET								

**SQUAW BAY CORP**  
CONSULTING ENGINEERS

P.O. BOX 86A CUMBERLAND CENTER, MAINE 04021

DRN	JRK	9/94
CHK	PBT	10/94
CHK		
CORR		
APPVD		




**EAST OPERATION**  
LEACHATE PIPELINE PROJECT  
DOLBY LANDFILL TO THE EAST OPERATION  
STA. 137+50 TO STA. 150+00  
10' GRAVITY SECTION  
PLAN & PROFILE

JOB NO. 22846  
ENG. REG. NO.  
FILE NO. 2-092-4783


**YB-22972**  
SHEET 1 OF 1

D:\94-227\ACAD\94227R12 Thu Mar 26 15:25:33 1996

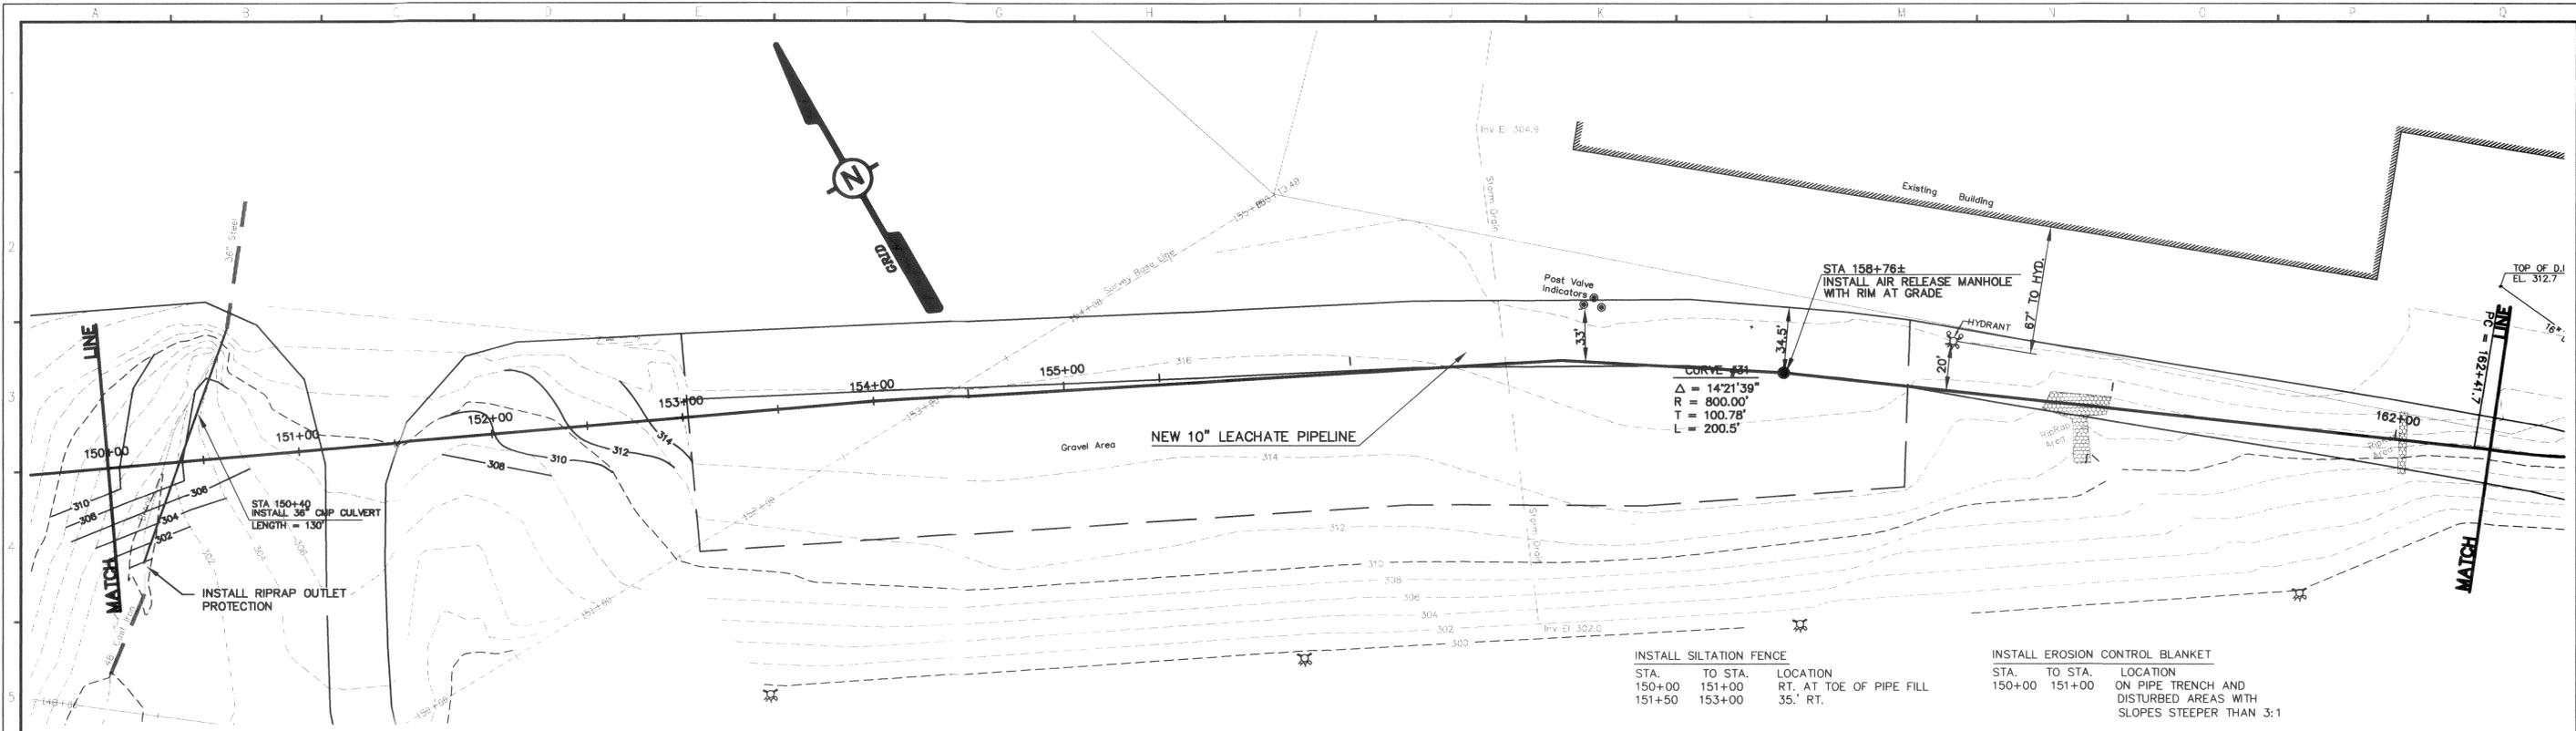

INSTALL SILTATION FENCE  
 STA. TO STA. LOCATION  
 150+00 151+00 RT. AT TOE OF PIPE FILL  
 151+50 153+00 35.' RT.

INSTALL EROSION CONTROL BLANKET  
 STA. TO STA. LOCATION  
 150+00 151+00 ON PIPE TRENCH AND  
 DISTURBED AREAS WITH  
 SLOPES STEEPER THAN 3:1

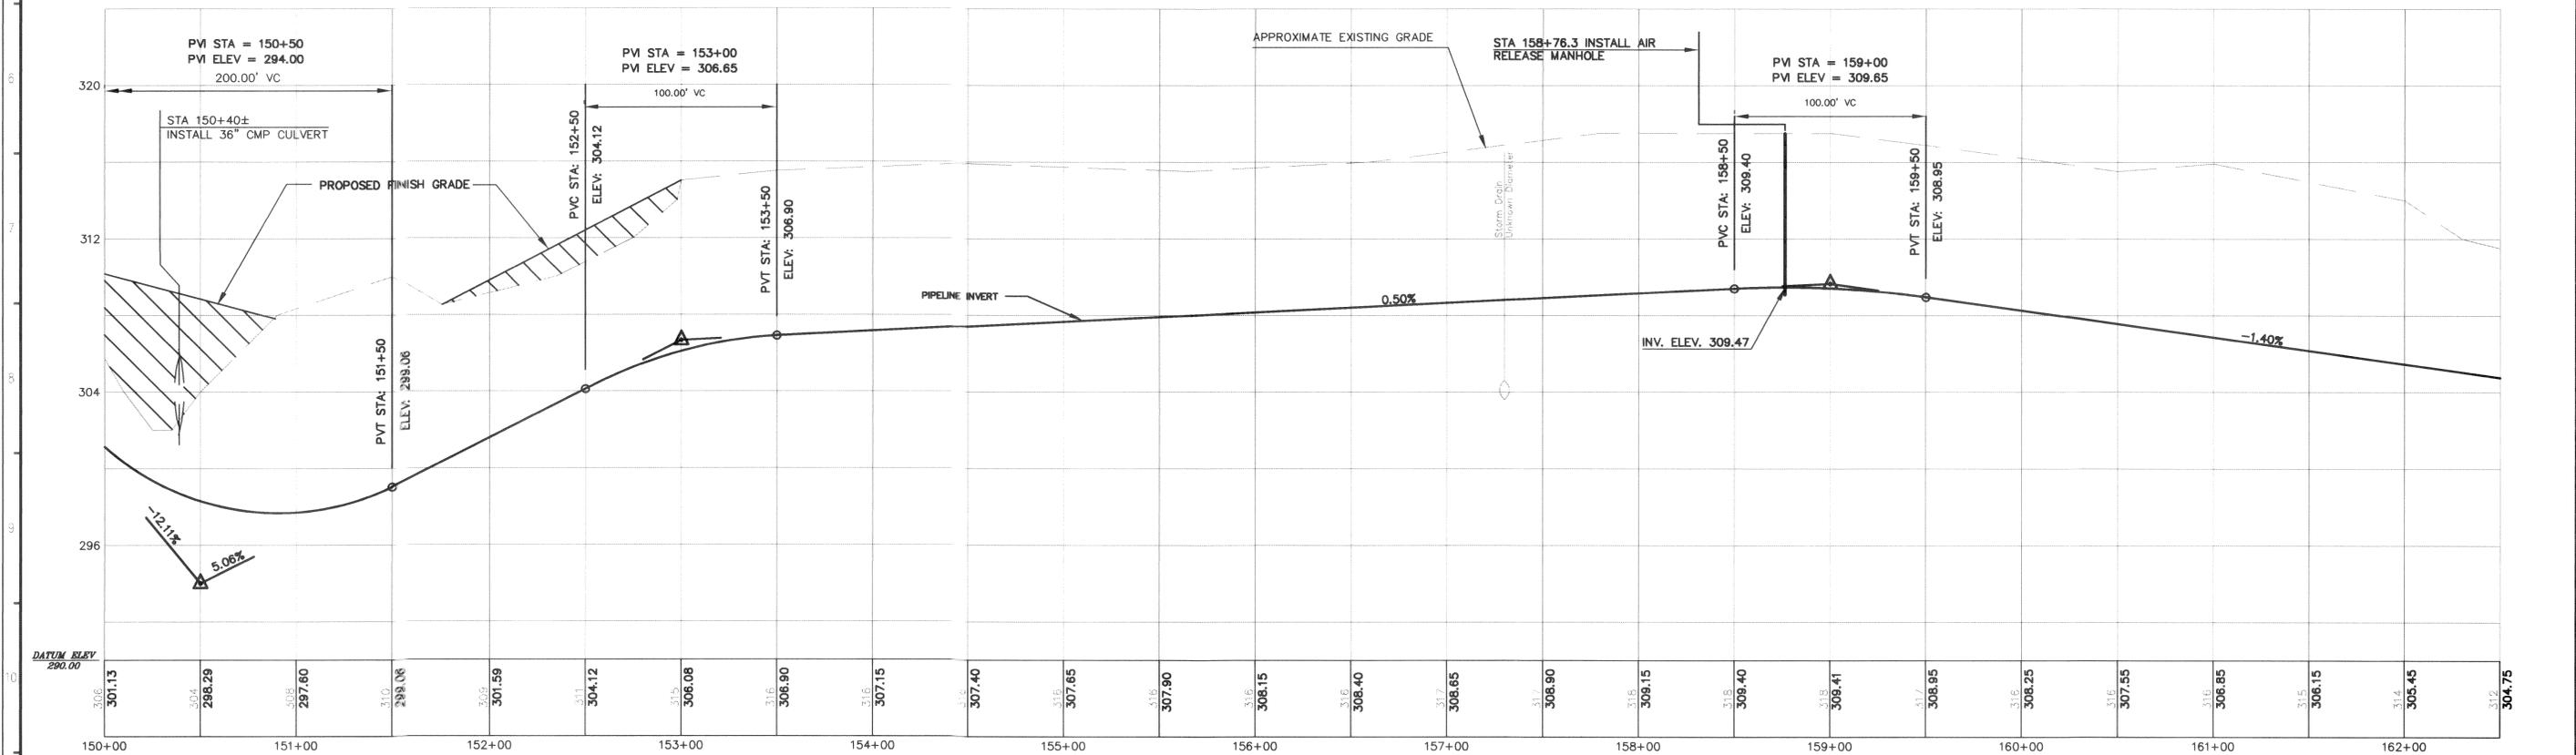

DRAWING NO.	REFERENCE DRAWING TITLE	CODE	NO.	DATE	REVISION	BY	CHK	APPVD	JOB NO.
YB-20978	RECYCLE FIBER PLANT - UNDERGROUND UTILITIES SHEETS 1-6	C	3/96		RECORD DRAWING	MSB	PBT		
		C	6/95		ISSUED FOR CONSTRUCTION	BAK	PBT		
		B	4/95		ISSUED FOR BIDS	MSB	PBT		
		P	4/95		PRELIMINARY CONSTRUCTION ISSUE	RMC	PBT		
		P			SUBMITTED W/ PERMIT APPLICATION	JRK	PBT		

**SQUAW BAY CORP**  
 CONSULTING ENGINEERS

P.O. BOX 86A CUMBERLAND CENTER, MAINE 04021

DRN	JRK	9/94
CHK	PBT	10/94
CHK		
CORR		
APPVD		
ISSUE CODE		
P - Prelim	B - Bids	
M - Mt T.O.	C - Const.	
SCALE 1"=40'H; 1"=4'V		



**EAST OPERATION**  
 LEACHATE PIPELINE PROJECT  
 DOLBY LANDFILL TO THE EAST OPERATION  
 STA. 150+00 TO STA. 162+50  
 10' GRAVITY SECTION  
 PLAN & PROFILE

YB-22973  
 SHEET 1 OF 1



ENG. REQ. NO. 22846  
 FILE NO. 2-092-4783

D:\94-227\ACAD\94227R12 Thu Mar 28 15:34:14 1996



**MANHOLE AND STRUCTURE SCHEDULE**

STATION	TYPE	SIZE	DESCRIPTION
0+95	CIRCULAR	8' DIA.	GATE AND CHECK VALVE
2+41	CIRCULAR	6' DIA.	ANGLE
8+31	CIRCULAR	6' DIA.	AIR RELEASE
17+46	CIRCULAR	8' DIA.	AIR RELEASE / TEST
34+96	CIRCULAR	8' DIA.	ANGLE / TEST
38+94	CIRCULAR	4' DIA.	ANGLE
41+00	CIRCULAR	4' DIA.	ANGLE
51+50	CIRCULAR	8' DIA.	TEST
63+40	CIRCULAR	8' DIA.	TEST
63+75, 53' LT.	RECTANGULAR	6' X 12'	FLOW TRANSITION STRUCTURE
64+05	CIRCULAR	8' DIA.	TEST
78+35	CIRCULAR	4' DIA.	ANGLE
85+30	CIRCULAR	8' DIA.	TEST
91+50	CIRCULAR	4' DIA.	AIR RELEASE
108+00	CIRCULAR	8' DIA.	TEST
127+67	CIRCULAR	6' DIA.	AIR RELEASE
136+00	CIRCULAR	8' DIA.	TEST
120+00	CIRCULAR	4' DIA.	JUNCTION
146+60	CIRCULAR	8' DIA.	AIR RELEASE / TEST
158+76	CIRCULAR	6' DIA.	AIR RELEASE
166+85	CIRCULAR	8' DIA.	VALVE

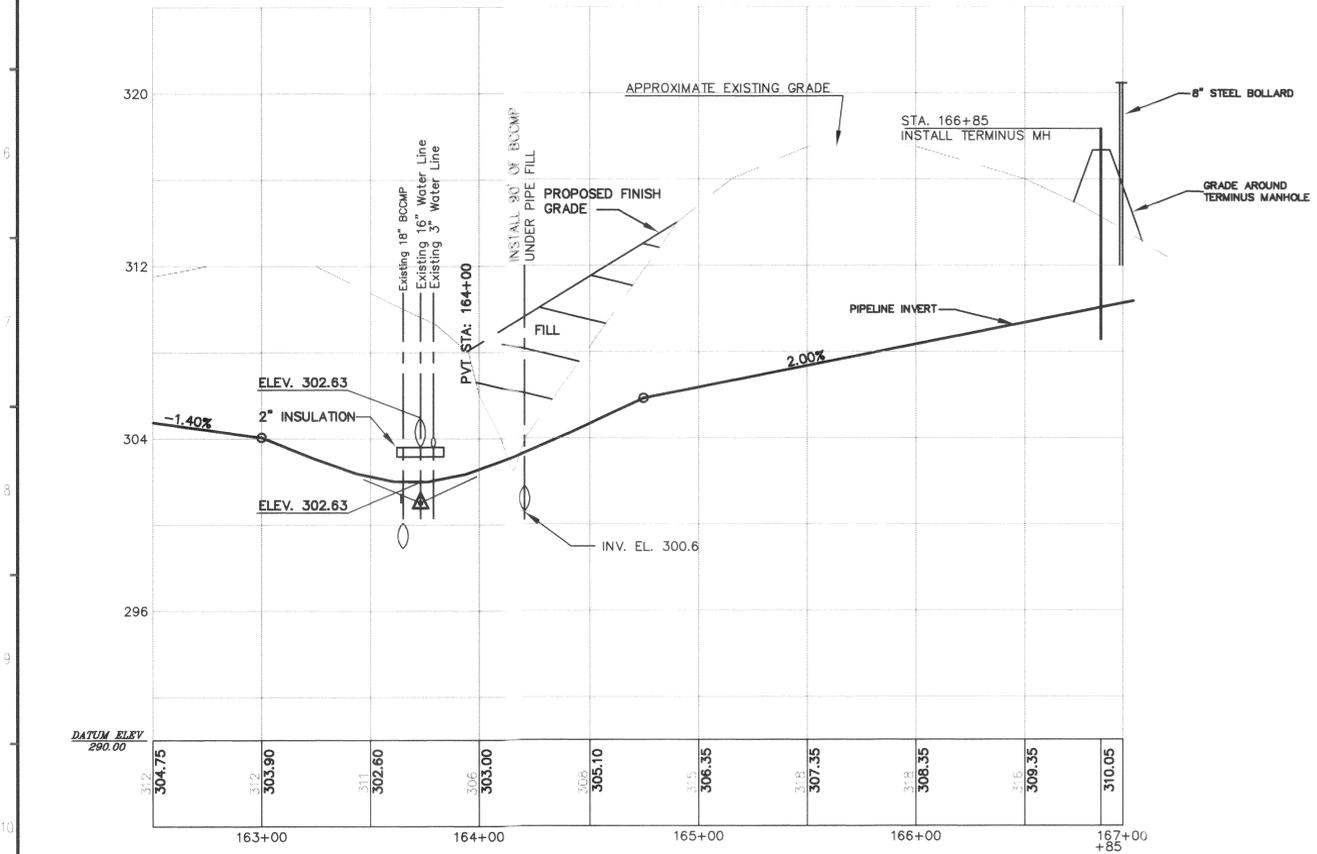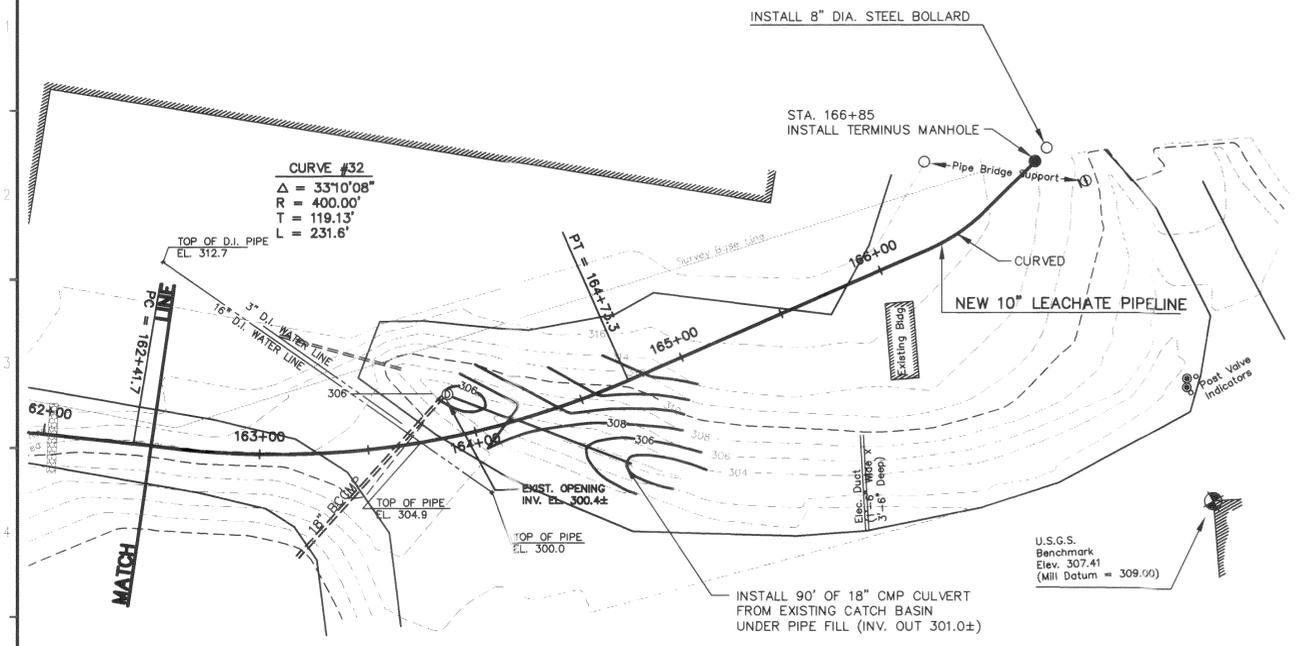

DRAWING NO.	REFERENCE DRAWING TITLE	CODE	NO.	DATE	REVISION	BY	CHKD	APPVD	JOB NO.
YB-20978	RECYCLE FIBER PLANT AND UNDERGROUND UTILITIES, SHTS. 1-6	P	3	3/96	RECORD DRAWING	MSB	PBT		
		C	6	6/95	ISSUED FOR CONSTRUCTION	BAK	PBT		
		B	4	4/95	ISSUED FOR BIDS	RMC	PBT		
		P	4	4/95	PRELIMINARY CONSTRUCTION ISSUE	RMC	PBT		
		P			SUBMITTED W/ PERMIT APPLICATION	JRK	PBT		

**SQUAW BAY CORP**  
CONSULTING ENGINEERS



P.O. BOX 86A CUMBERLAND CENTER, MAINE 04021

DRN	JRK	9/94
CHK	PBT	10/94
CHK		
CORR		
APPVD		
ISSUE CODE		
P - Prelim	B - Bids	
M - Mt. T.O.	C - Const.	
SCALE 1"=40'H; 1"=4'V		

**EAST OPERATION**  
LEACHATE PIPELINE PROJECT  
DOLBY LANDFILL TO THE EAST OPERATION  
STA. 162+50 TO STA. 167+00  
10" GRAVITY SECTION  
PLAN & PROFILE

JOB NO. 22846  
ENG. REQ. NO.  
FILE NO. 2-092-4783

**YB-22974**  
SHEET 1 OF 1

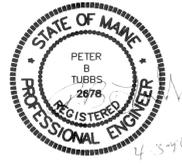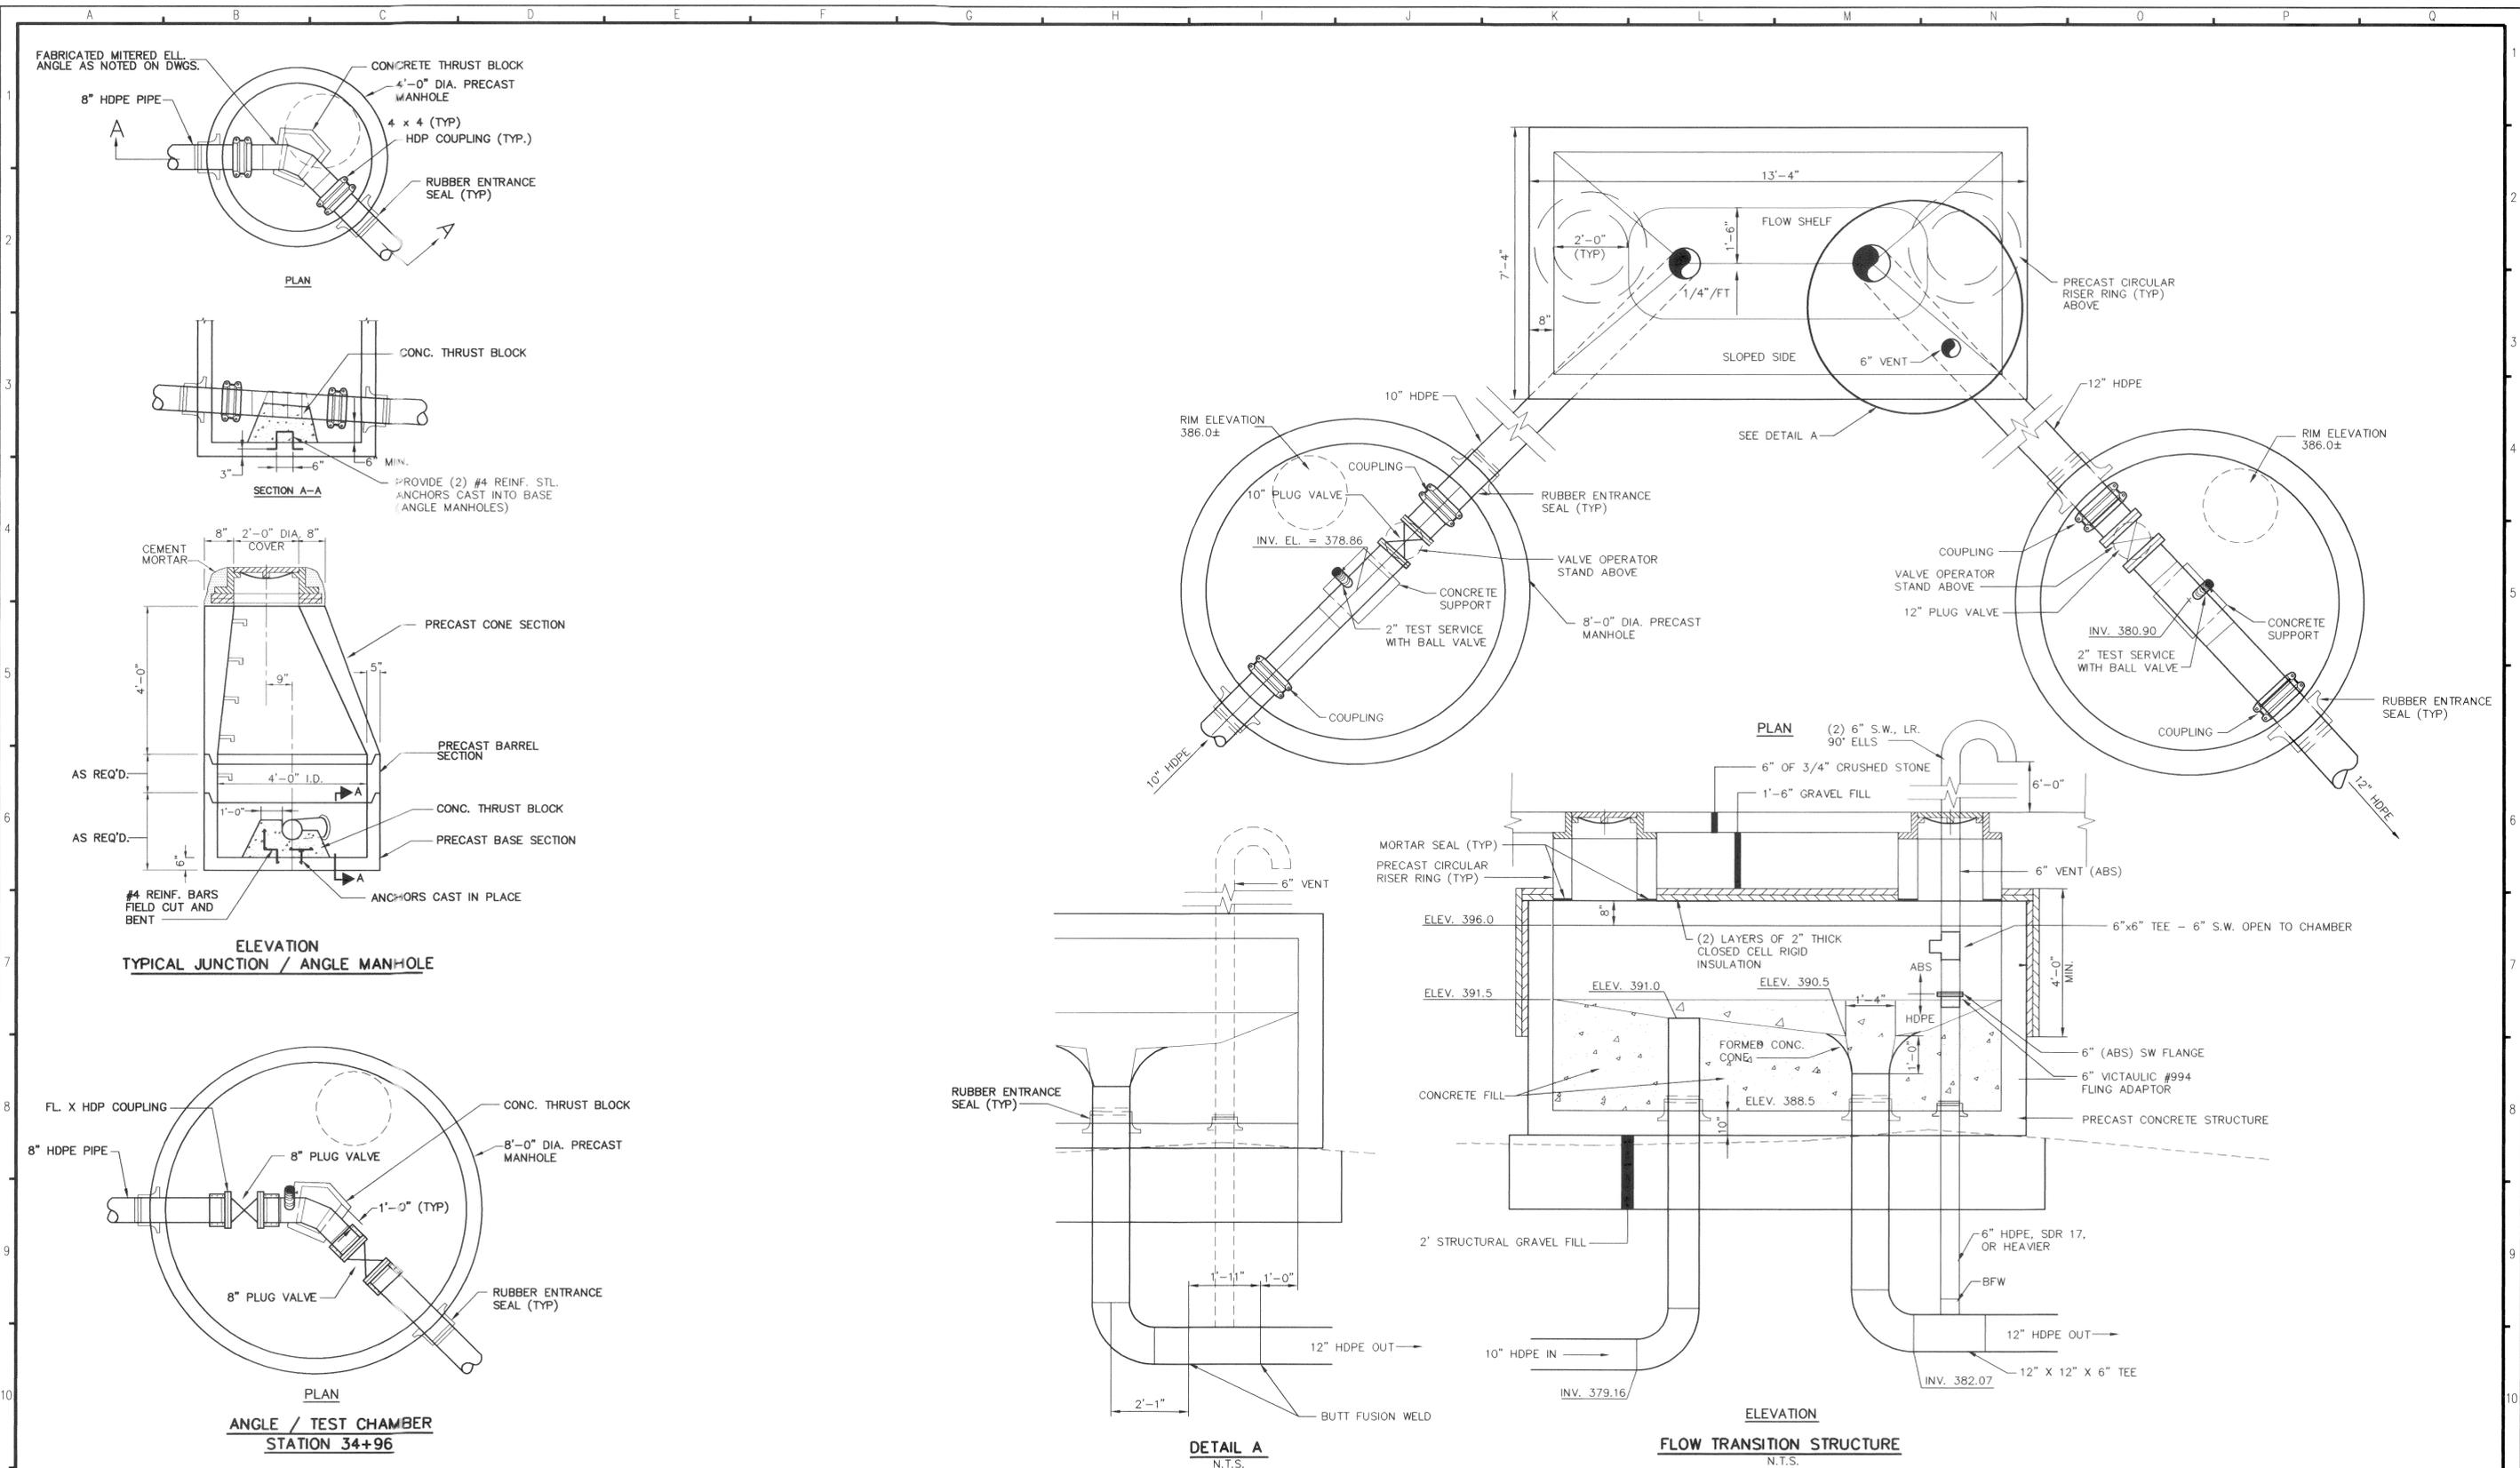

DRAWING NO.	REFERENCE DRAWING TITLE	CODE	NO.	DATE	REVISION	BY	CHK	APPVD	JOB NO.
		C	3/96		RECORD DRAWING	MSB	PBT		
		C	6/95		ISSUED FOR CONSTRUCTION	BAK	PBT		
		B	4/95		ISSUED FOR BIDS	MSB	PBT		
		P	4/95		PRELIMINARY CONSTRUCTION ISSUE	MSB	PBT		

**SQUAW BAY CORP**  
CONSULTING ENGINEERS

P.O. BOX 86A CUMBERLAND CENTER, MAINE 04021

DRN	MSB	4/95
CHK	PBT	4/95
CHK		
CORR		
APPVD		
ISSUE CODE		
P - Prelim	B - Bids	
M - Mtl T.O.	C - Const.	
SCALE AS NOTED		




**EAST OPERATION**  
LEACHATE PIPELINE PROJECT  
DOLBY LANDFILL TO THE EAST OPERATION  
MANHOLES AND STRUCTURES  
MISCELLANEOUS DETAILS





JOB NO. 22846  
ENG. REQ. NO. \_\_\_\_\_  
FILE NO. 2-092-4783

**YB-22975**  
SHEET 1 OF 2



D:\94-227\ACAD\UE\TITLE-2 Thu Mar 26 07:33:46 1996

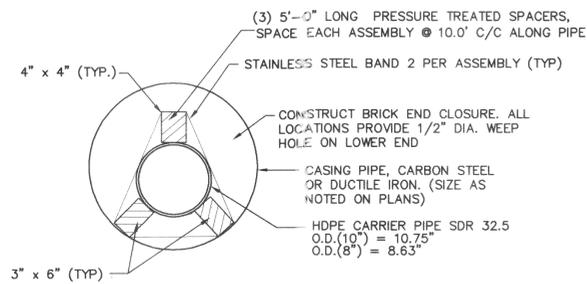

**RAILROAD AND ROUTE 157 CROSSINGS  
PIPE ENCASEMENT**  
N.T.S.

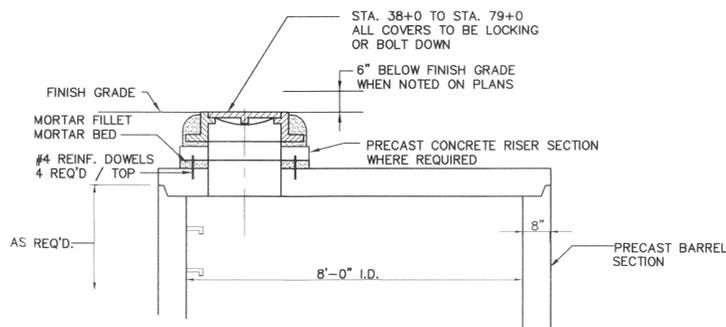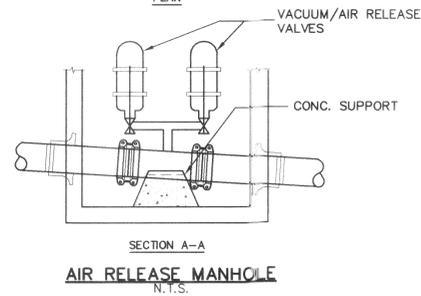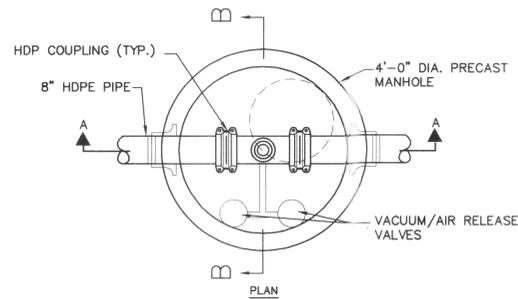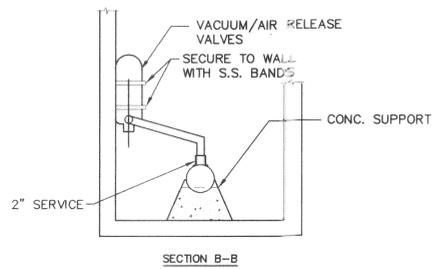

**TYPICAL TOP INSTALLATION  
FLAT TOP MANHOLES AND STRUCTURES**  
N.T.S.

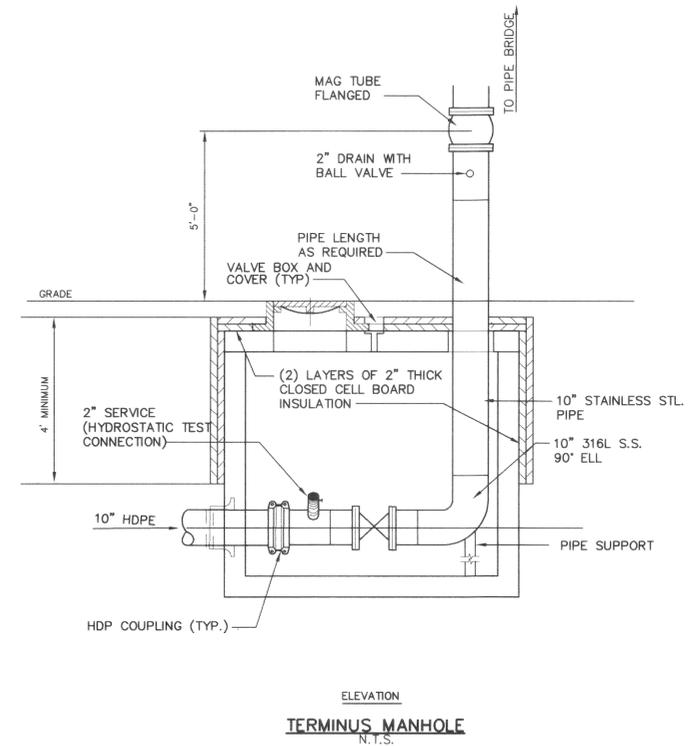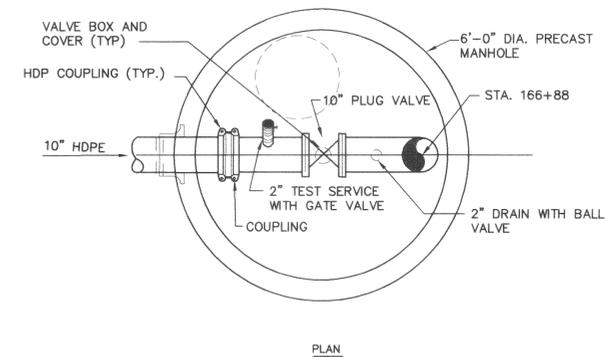

DRAWING NO.	REFERENCE DRAWING TITLE	CODE	NO.	DATE	REVISION	BY	CHKD	APPVD	JOB NO.
		C	3/96		RECORD DRAWING	MSB	PBT		
		C	6/95		ISSUED FOR CONSTRUCTION	BAK	PBT		
		B	4/95		ISSUED FOR BIDS	MSB	PBT		

**SQUAW BAY CORP  
CONSULTING ENGINEERS**



P.O. BOX 86A CUMBERLAND CENTER, MAINE 04021


DRN	MSB	4/95
CHK	PBT	4/95
CHK		
CORR		
APPVD		
ISSUE CODE		
P - Prelim	B - Bids	
M - Mtl T.O.	C - Const.	
SCALE AS NOTED		

**BOWATER**  
Great Northern Paper

**EAST OPERATION  
LEACHATE PIPELINE PROJECT  
DOLBY LANDFILL TO THE EAST OPERATION  
MANHOLES AND STRUCTURES  
MISCELLANEOUS DETAILS**

JOB NO. 22846  
ENG. REQ. NO.  
FILE NO. 2-092-4783

YB-22975  
SHEET 2 OF 2

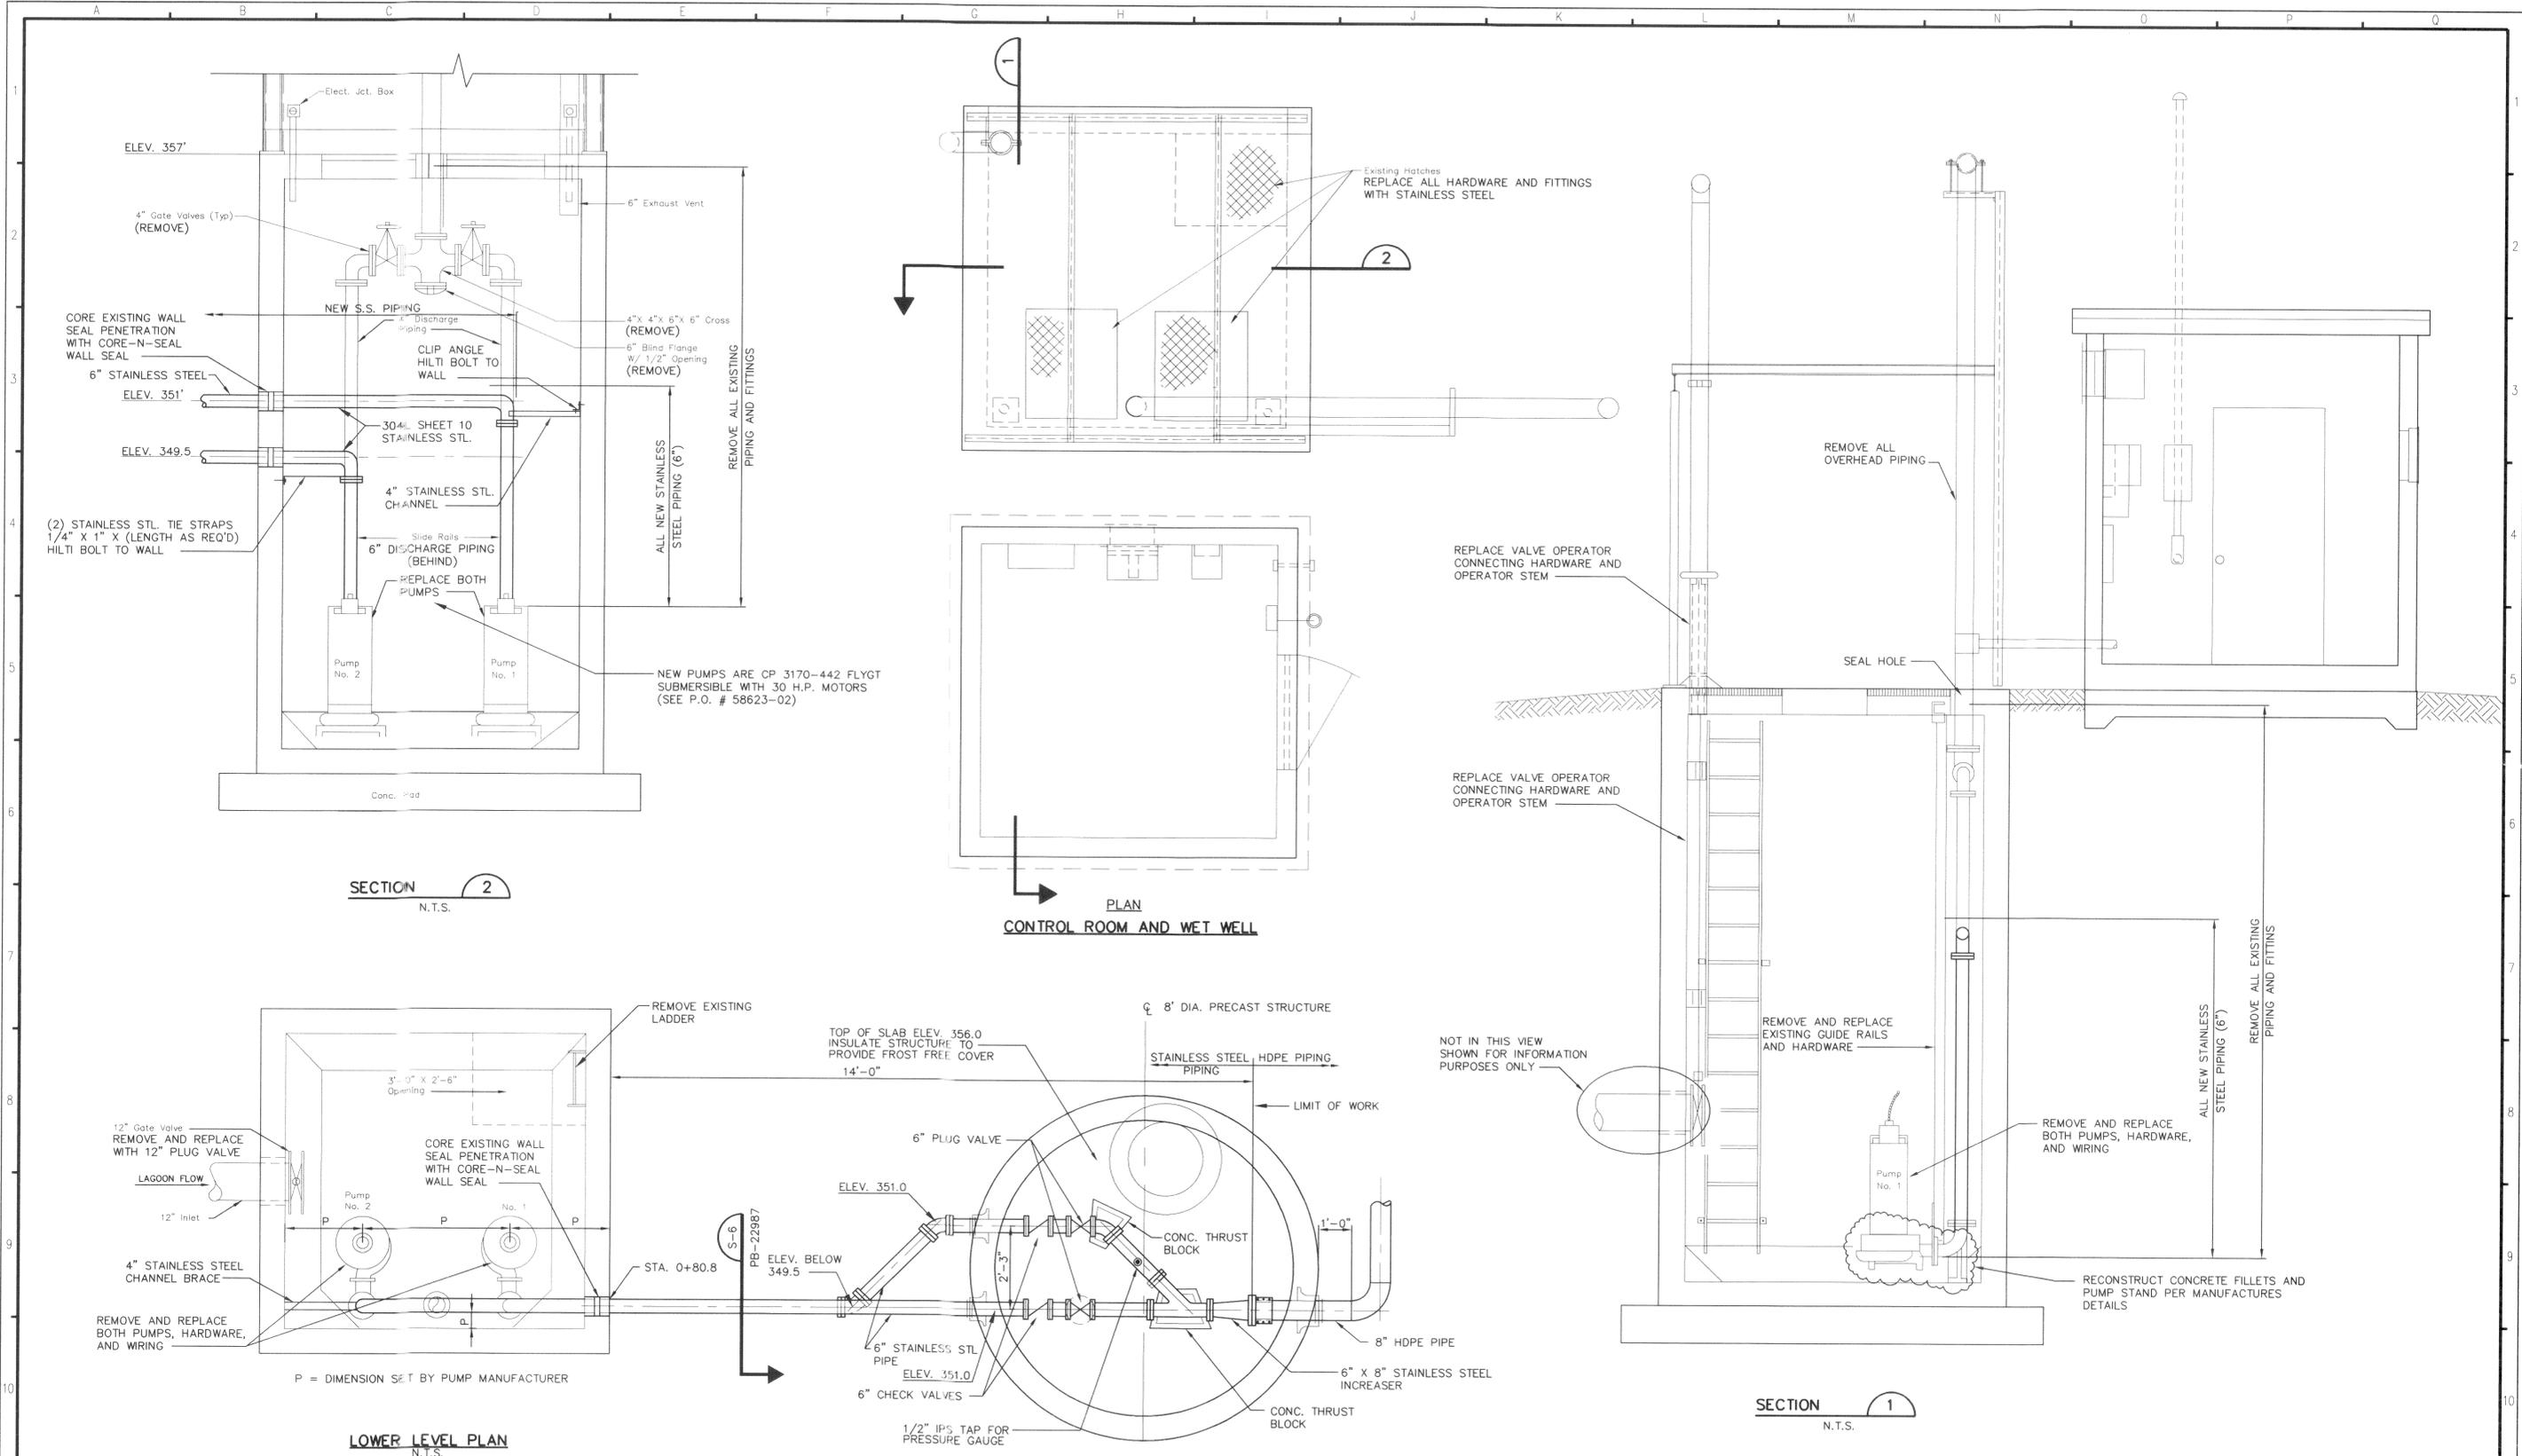

U:\94-227\ACAD\DE\ALL-1.dwg Apr 4 09:16:56 1996



DRAWING NO.	REFERENCE DRAWING TITLE	CODE	NO.	DATE	REVISION	BY	CHK	APPVD	JOB NO.
SB - 14888	BOYDCO - LEACHATE PUMP STATION PLANS AND SECTIONS								
		C	3/96		RECORD DRAWING		MSB	PBT	
		C	6/95		ISSUED FOR CONSTRUCTION		BAK	PBT	
		B	6/95		ISSUED FOR BIDS		MSB	PBT	
		P	4/95		PRELIMINARY CONSTRUCTION ISSUE		MSB	PBT	

**SQUAW BAY CORP**  
CONSULTING ENGINEERS



P.O. BOX 86A CUMBERLAND CENTER, MAINE 04021

DRN	MSB	4/95
CHK	PBT	4/95
CHK		
CORR		
APPVD		
ISSUE CODE		
P - Prelim	B - Bids	
M - Mt. T.O.	C - Const.	
SCALE AS NOTED		


**BOWATER**  
Great Northern Paper

**EAST OPERATION**  
**LEACHATE PIPELINE PROJECT**  
DOLBY LANDFILL TO THE EAST OPERATION  
EXISTING PUMP STATION MODIFICATIONS  
PLANS AND SECTIONS

JOB NO. 22846  
ENG. REQ. NO. YB-22976  
FILE NO. 2-092-4783

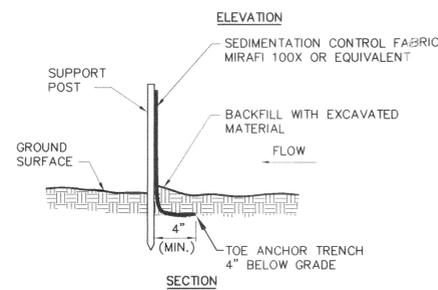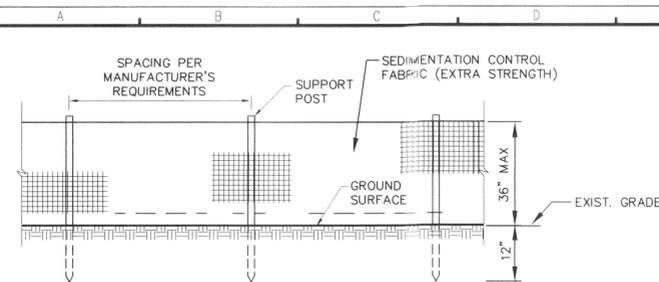




**SILTATION FENCE (KEYED IN)**  
N.T.S.

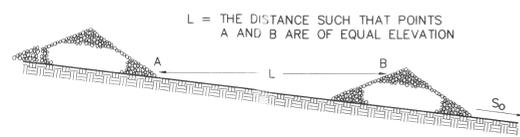


SPACING BETWEEN CHECK DAMS

S <sub>0</sub> (FT./FT.)	L (FT.)
0.020	75
0.030	50
0.040	40
0.050	30
0.080	20
0.100	10


**STONE CHECK DAMS**  
N.T.S.

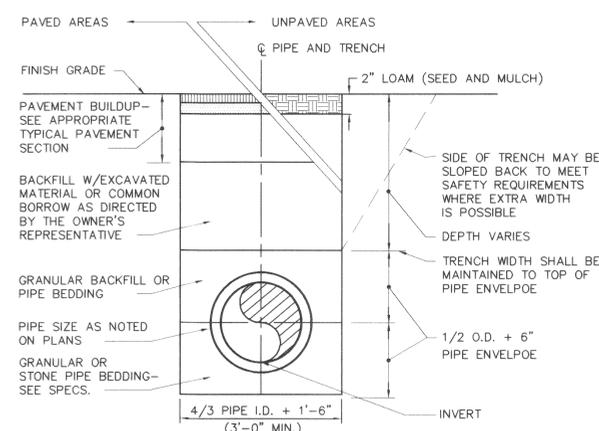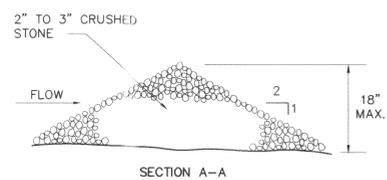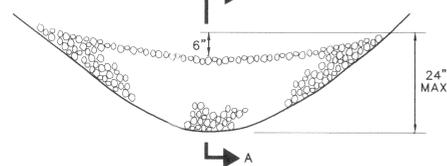


**TYPICAL TRENCH DETAIL**  
N.T.S.

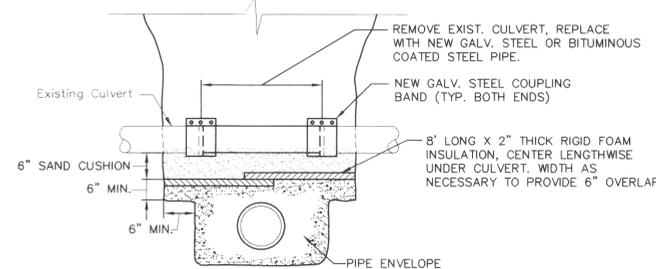

**CULVERT RESTORATION**  
N.T.S.

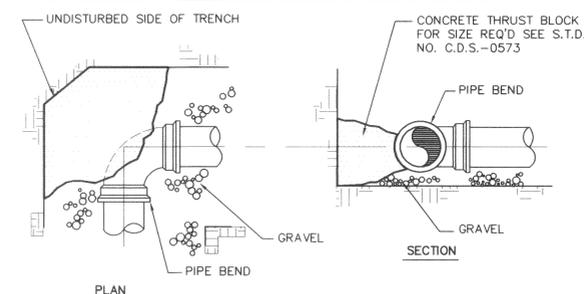


**TYPICAL THRUST BLOCK PLACEMENT ON BENDS**  
N.T.S.

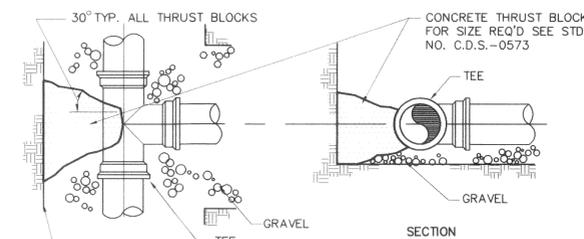

**TYPICAL THRUST BLOCK PLACEMENT ON TEES**  
N.T.S.

		BEARING ON UNDISTURBED SOIL (SQUARE FT.)				
		90° BENDS	45° BENDS	TEES & PLUGS	HYDRANTS	
PIPE SIZE	FITTINGS	4"	2.0	1.0	1.0	N/A
	6"	3.0	2.0	2.0	6.0	
	8"	5.0	3.0	4.0	N/A	
	10"	7.0	4.0	5.0	N/A	
	12"	10.0	6.0	7.0	N/A	
	14"	13.0	7.0	10.0	N/A	
16"	17.0	9.0	12.0	N/A		

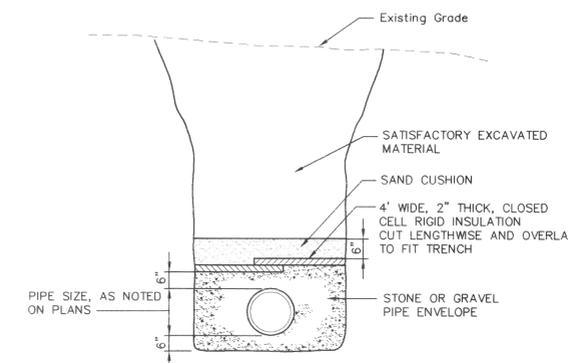

**TYPICAL SECTION TRENCH INSULATION**  
N.T.S.

**TEMPORARY AND PERMANENT EROSION AND SEDIMENTATION CONTROL**

**A. GENERAL**

- All soil erosion and sediment control will be done in accordance with the Maine Erosion and Sediment Control Handbook for Construction: Best Management Practices, Cumberland County Soil and Water Conservation District, Department of Environmental Protection, March 1991, and as currently revised.
- Drainage or pumping will not be discharged into any stream, brook or drainage course or any wetland. Discharge points shall be established and protected to collect sediments before discharge onto upland areas.
- Disturbed areas will be permanently stabilized within 15 days of final grading. Disturbed areas not to be worked upon within 14 days of disturbance, shall be temporarily stabilized within 7 days of the disturbance.
- Removal of trees, bushes and other vegetation as well as disturbance of topsoil will be kept to a minimum in all areas while allowing proper site operations.
- Stockpiles shall be located in a manner such that natural drainage is not obstructed and no off-site sedimentation will result. Silt fence will be installed around the perimeter of all stockpiles. Topsoil stockpiles surrounded with siltation fencing or temporarily mulched.

**B. TEMPORARY MEASURES**

- Silt Fence
  - Silt fence will be installed prior to and down-gradient of all construction activity where soil disturbance may result in erosion.
  - Silt fences will be removed when they have served their useful purpose, but not before the upgradient areas have been permanently stabilized.
  - Silt fences will be inspected immediately after each rainfall and at least daily during prolonged rainfall. Repairs will be made as necessary. Any required repairs will be made immediately.
  - Sediment deposits shall be removed after each storm event if significant buildup has occurred.
- Stone Check Dams
  - Stone check dams should be constructed of 2 to 3 inch stone. The stone should be placed according to the configuration shown to ensure that the center of the dam is lower than the edges.
  - Sediments will be removed from behind the check dams when it has accumulated to one half of the original height of the dam.

**C. INSPECTIONS**

Inspections will be undertaken by qualified personnel to ensure that temporary and permanent erosion and sedimentation controls are properly installed and correctly functioning, and that additional erosion control measures are installed as needed. Such inspections will occur bi-weekly and after each significant rainfall event (1 inch or more within a 24 hour period) during construction until permanent erosion control measures have been installed and the site is stabilized.



DRAWING NO.	REFERENCE DRAWING TITLE	CODE	NO.	DATE	REVISION	BY	CHK	APPVD	JOB NO.
		C	3/96		RECORD DRAWING		MSB	PBT	
		C	6/95		ISSUED FOR CONSTRUCTION		BAK	PBT	
		B	4/95		ISSUED FOR BIDS		MSB	PBT	
		P	4/25		PRELIMINARY CONSTRUCTION ISSUE		MSB	PBT	





**SQUAW BAY CORP**  
CONSULTING ENGINEERS

P.O. BOX 86A CUMBERLAND CENTER, MAINE 04021

DRN	MSB	4/95
CHK	PBT	4/95
CHK		
CORR		
APPVD		
ISSUE CODE		
P - Prelim	B - Bids	
M - Mt. T.O.	C - Const.	
SCALE AS NOTED		

**EAST OPERATION**  
**LEACHATE PIPELINE PROJECT**  
DOLBY LANDFILL TO THE EAST OPERATION  
EROSION CONTROL AND MISCELLANEOUS DETAILS

JOB NO. 22846  
ENG. REQ. NO. YB-22977  
FILE NO. 2-092-4783  
SHEET 1 OF 1

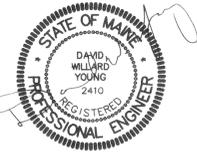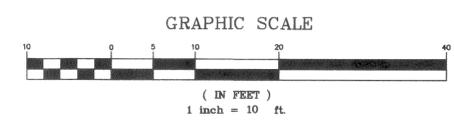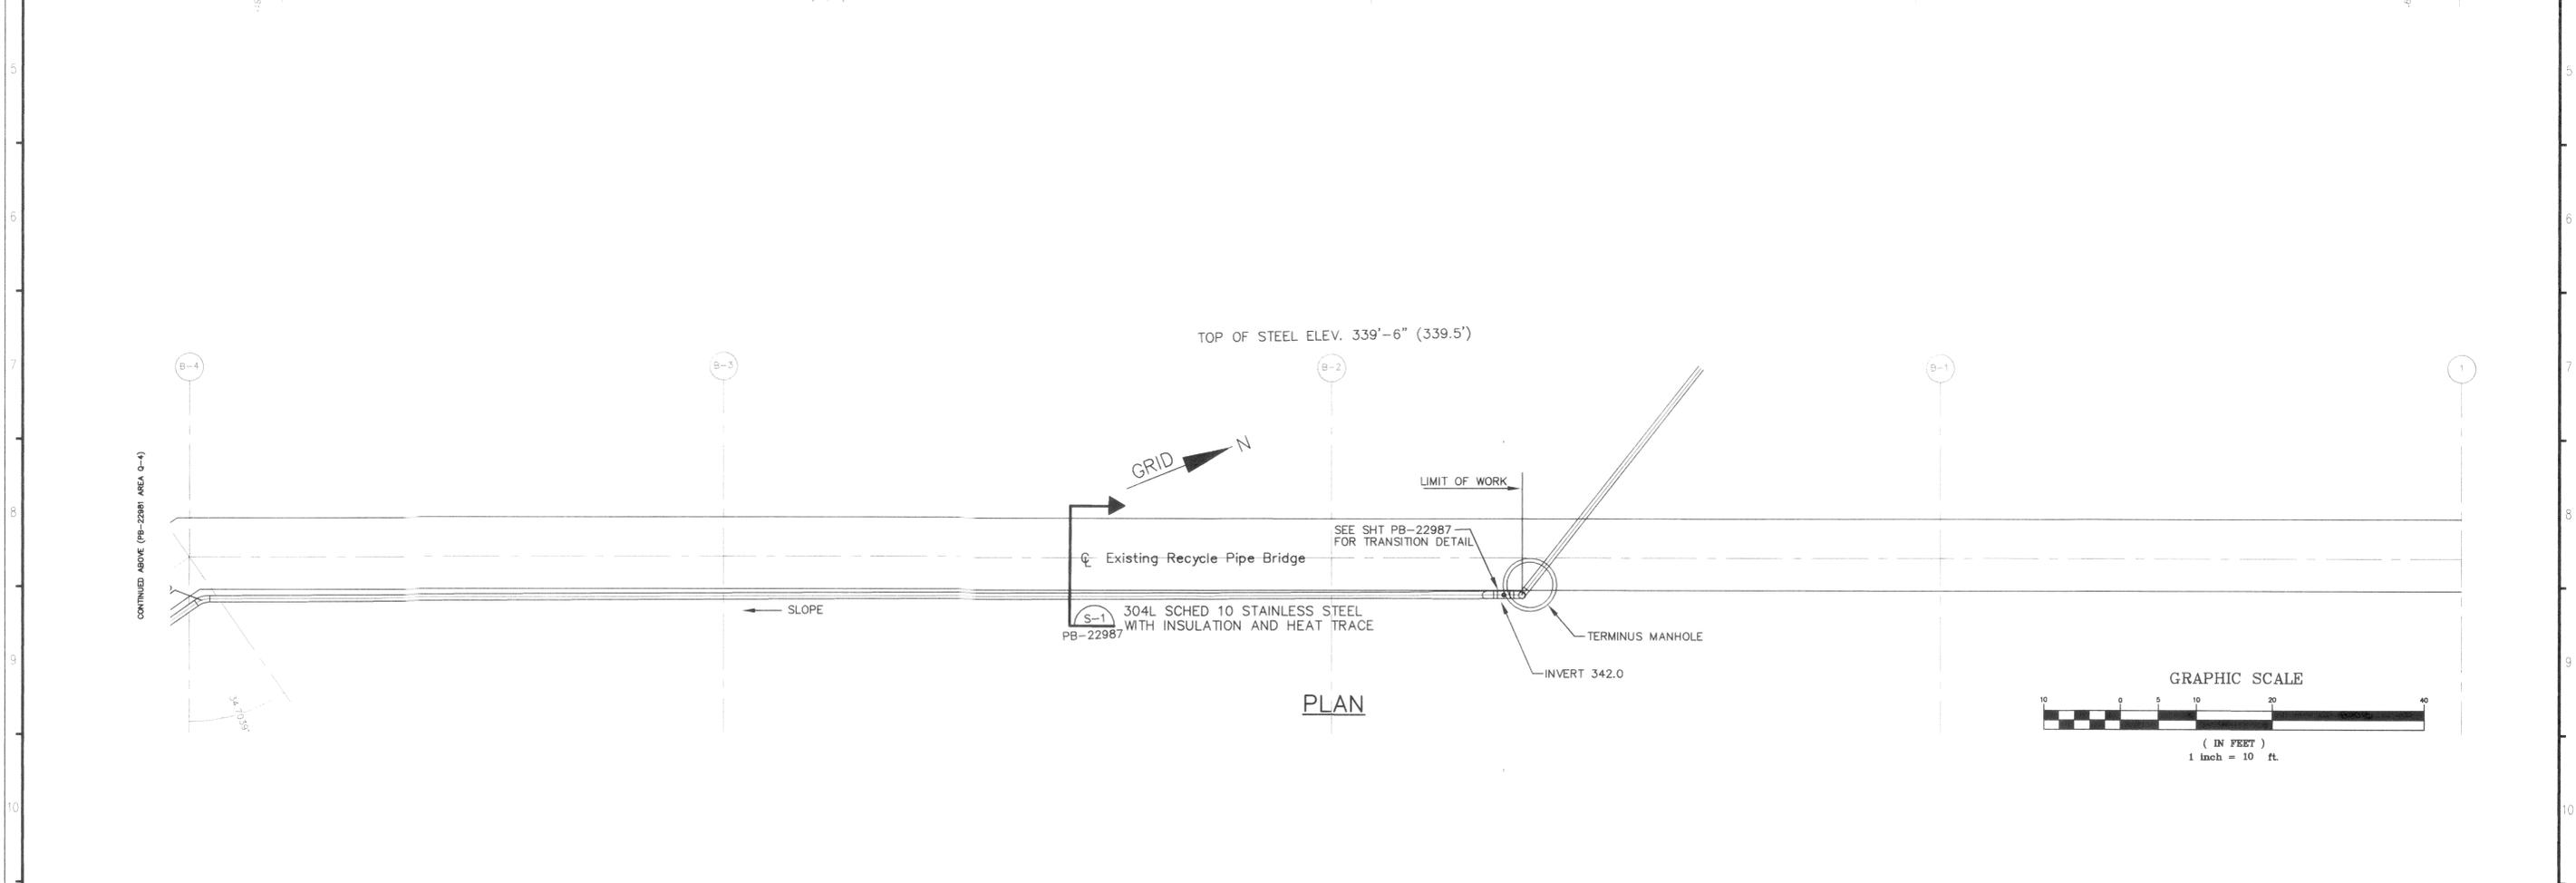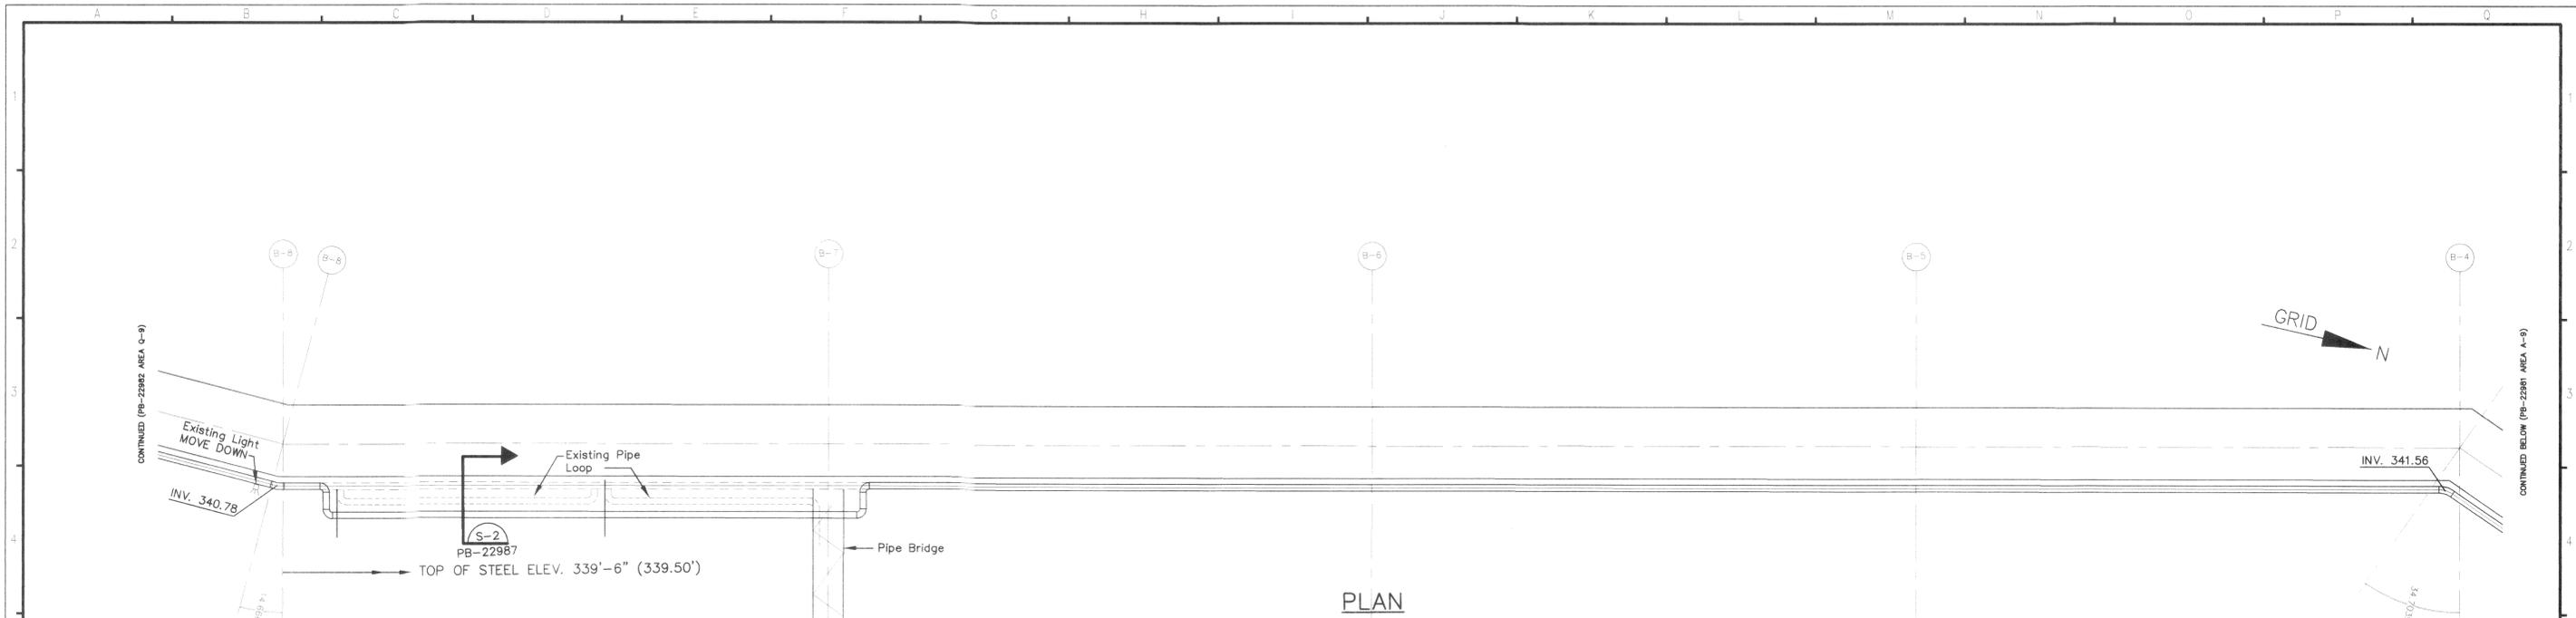

DRAWING NO.	REFERENCE DRAWING TITLE	CODE	NO.	DATE	REVISION	BY	CHKD	APPVD	JOB NO.
PF-01632-C	SIMONS ENGINEERING/RECYCLE FIBER PLANT	C		8/17/95	ISSUED FOR CONSTRUCTION	BOB	DWY		
PF-01631-D	SIMONS ENGINEERING/RECYCLE FIBER PLANT	P		8/8/95	FOR CLIENT REVIEW	BOB	DWY		
		P		5/28/95	FOR CLIENT REVIEW	MSB	DWY		

**SQUAW BAY CORP**  
CONSULTING ENGINEERS

P.O. BOX 86A CUMBERLAND CENTER, MAINE 04021

DRN	DWY	5/95
CHK		
CHK		
CORR		
APPVD		
ISSUE CODE		
P - Prelim	B - Bids	
M - Mtl T.O.	C - Const.	
SCALE 1" = 10'		




**BOWATER**  
Great Northern Paper

EAST OPERATION  
LEACHATE PIPELINE PROJECT  
DOLBY LANDFILL TO THE EAST OPERATION  
PIPE BRIDGE  
10" GRAVITY SEWER

JOB NO. 22846  
ENG. REQ. NO. \_\_\_\_\_  
FILE NO. 2-092-4783

PB-22981  
SHEET 1 OF 8

L: 94-22-02 ACAD 22/02 Thu Aug 17 11:46:16 1995

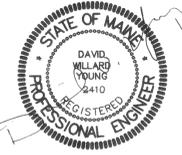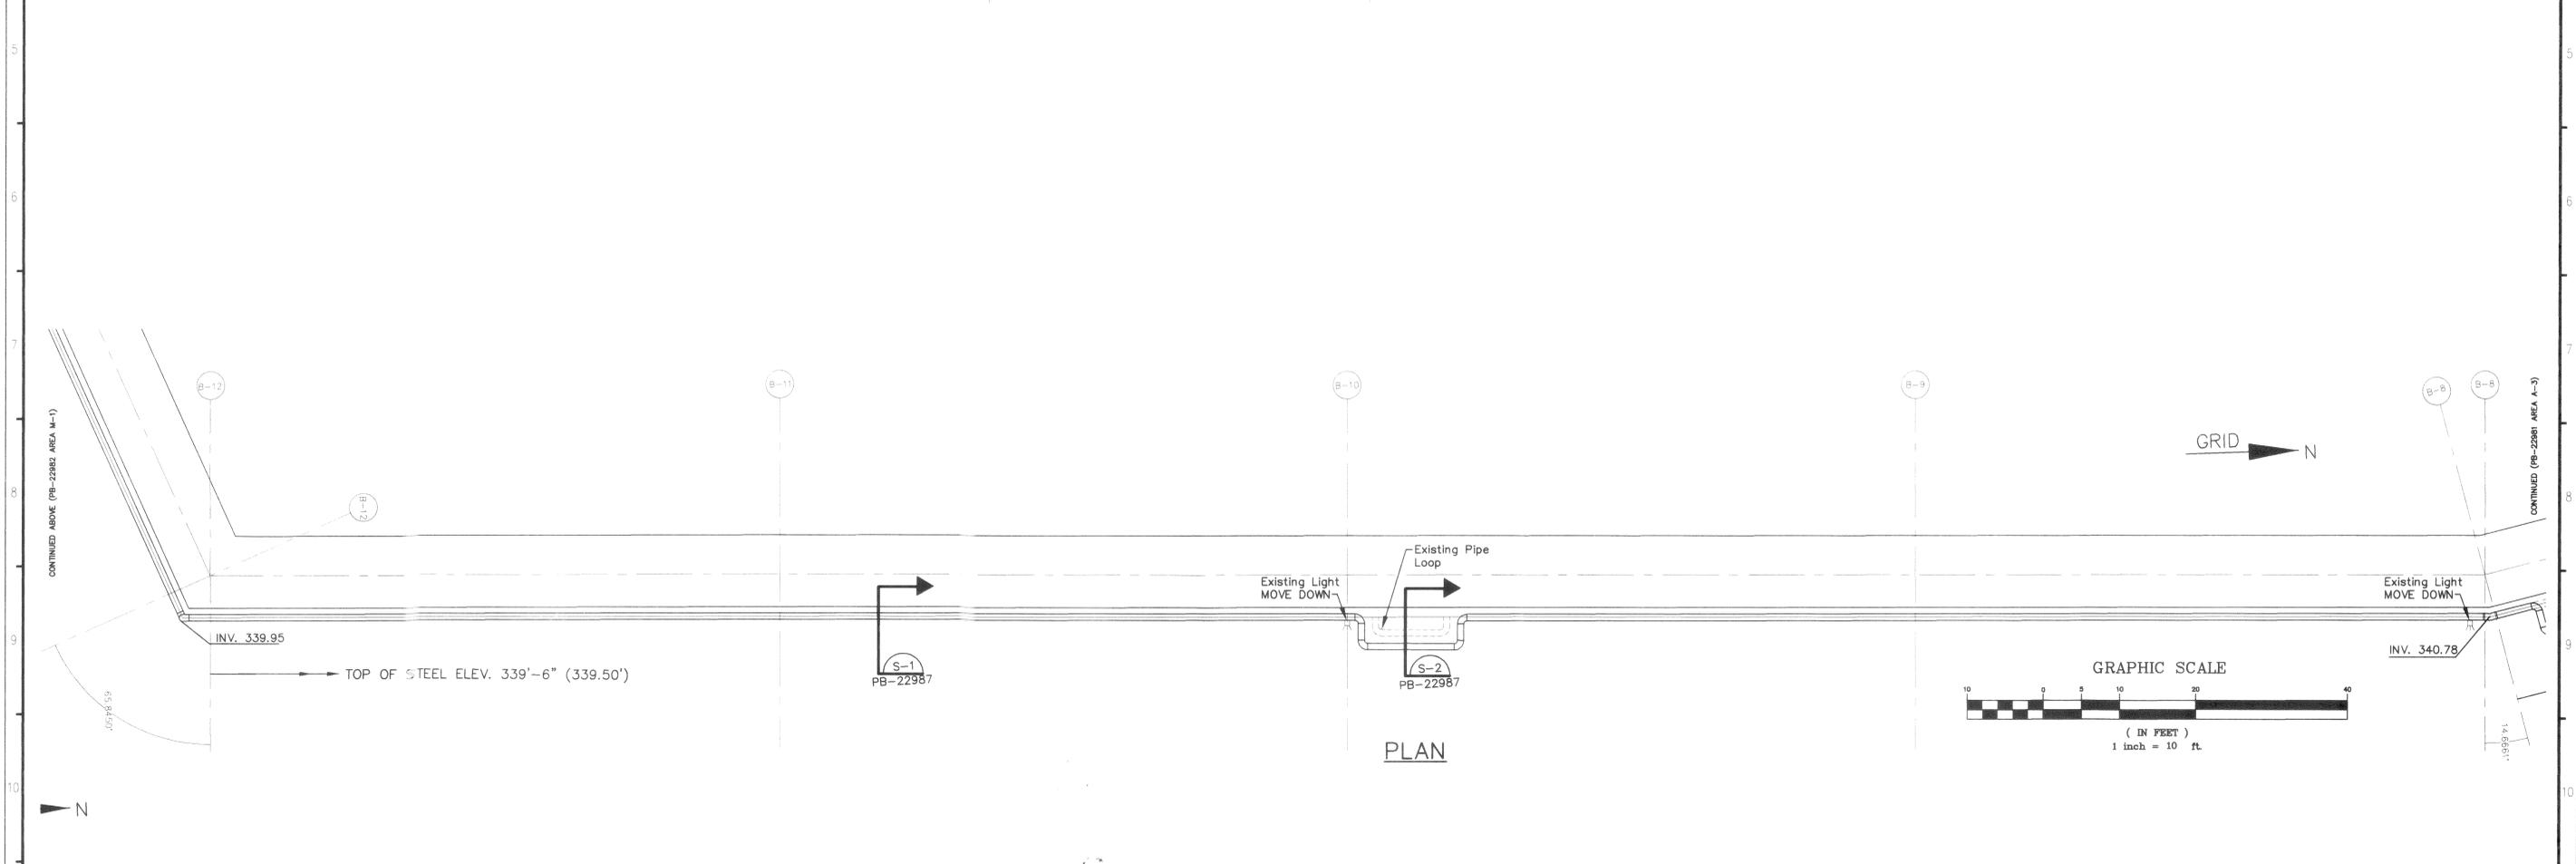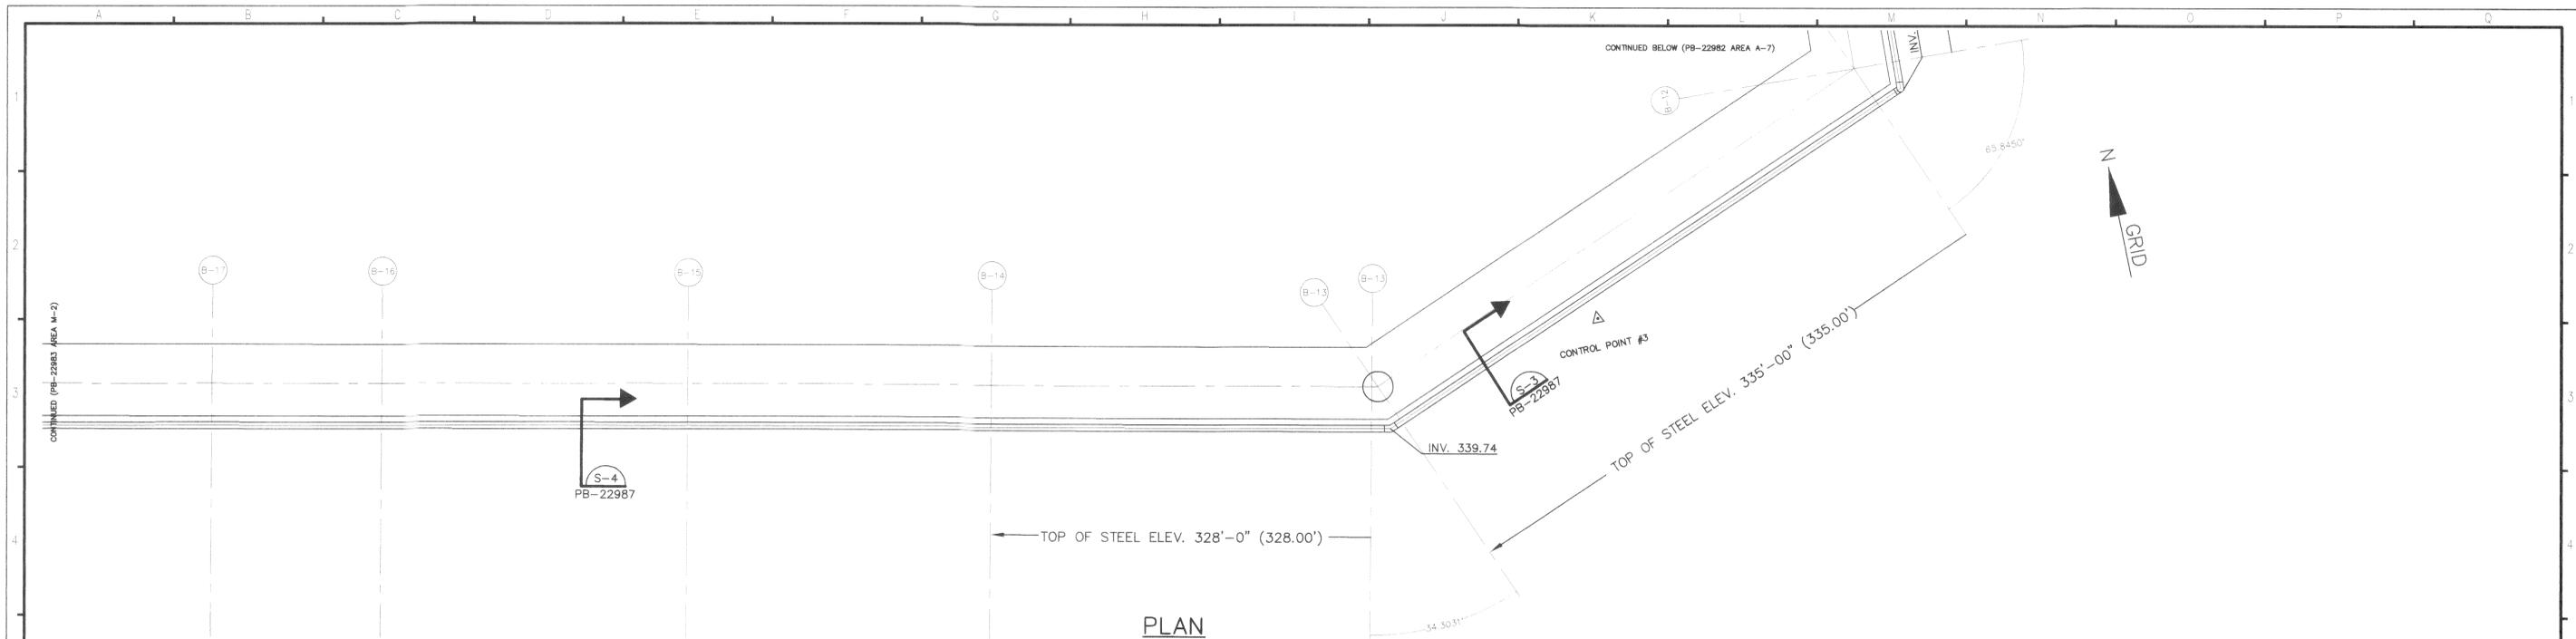

DRAWING NO.	REFERENCE DRAWING TITLE	CODE	NO.	DATE	REVISION	BY	CHKD	APPVD	JOB No.
PF-01633-C	SIMONS ENGINEERING/RECYCLE FIBER PLANT	C		8/17/95	ISSUED FOR CONSTRUCTION	BOB	DWY		
PF-01634-B	SIMONS ENGINEERING/RECYCLE FIBER PLANT	P		8/8/95	FOR CLIENT REVIEW	MSB	DWY		
		P		5/26/95	FOR CLIENT REVIEW	MSB	DWY		

**SQUAW BAY CORP**  
CONSULTING ENGINEERS

P.O. BOX 86A CUMBERLAND CENTER, MAINE 04021

DRN	DWY	5/95
CHK		
CHK		
CORR		
APPVD		
ISSUE CODE		
P - Prelim	B - Bids	
M - Mtl. T.O.	C - Const.	
SCALE 1" = 10'		


**BOWATER**  
Great Northern Paper

EAST OPERATION  
LEACHATE PIPELINE PROJECT  
DOLBY LANDFILL TO THE EAST OPERATION  
PIPE BRIDGE  
10" GRAVITY SEWER


JOB NO. 22846  
ENG. REQ. NO. \_\_\_\_\_  
FILE NO. 2-092-4783

PB-22982  
SHEET 2 OF 8

L: 94-22/02 ACAD 22-02 Thu Aug 17 11:51:48 1995

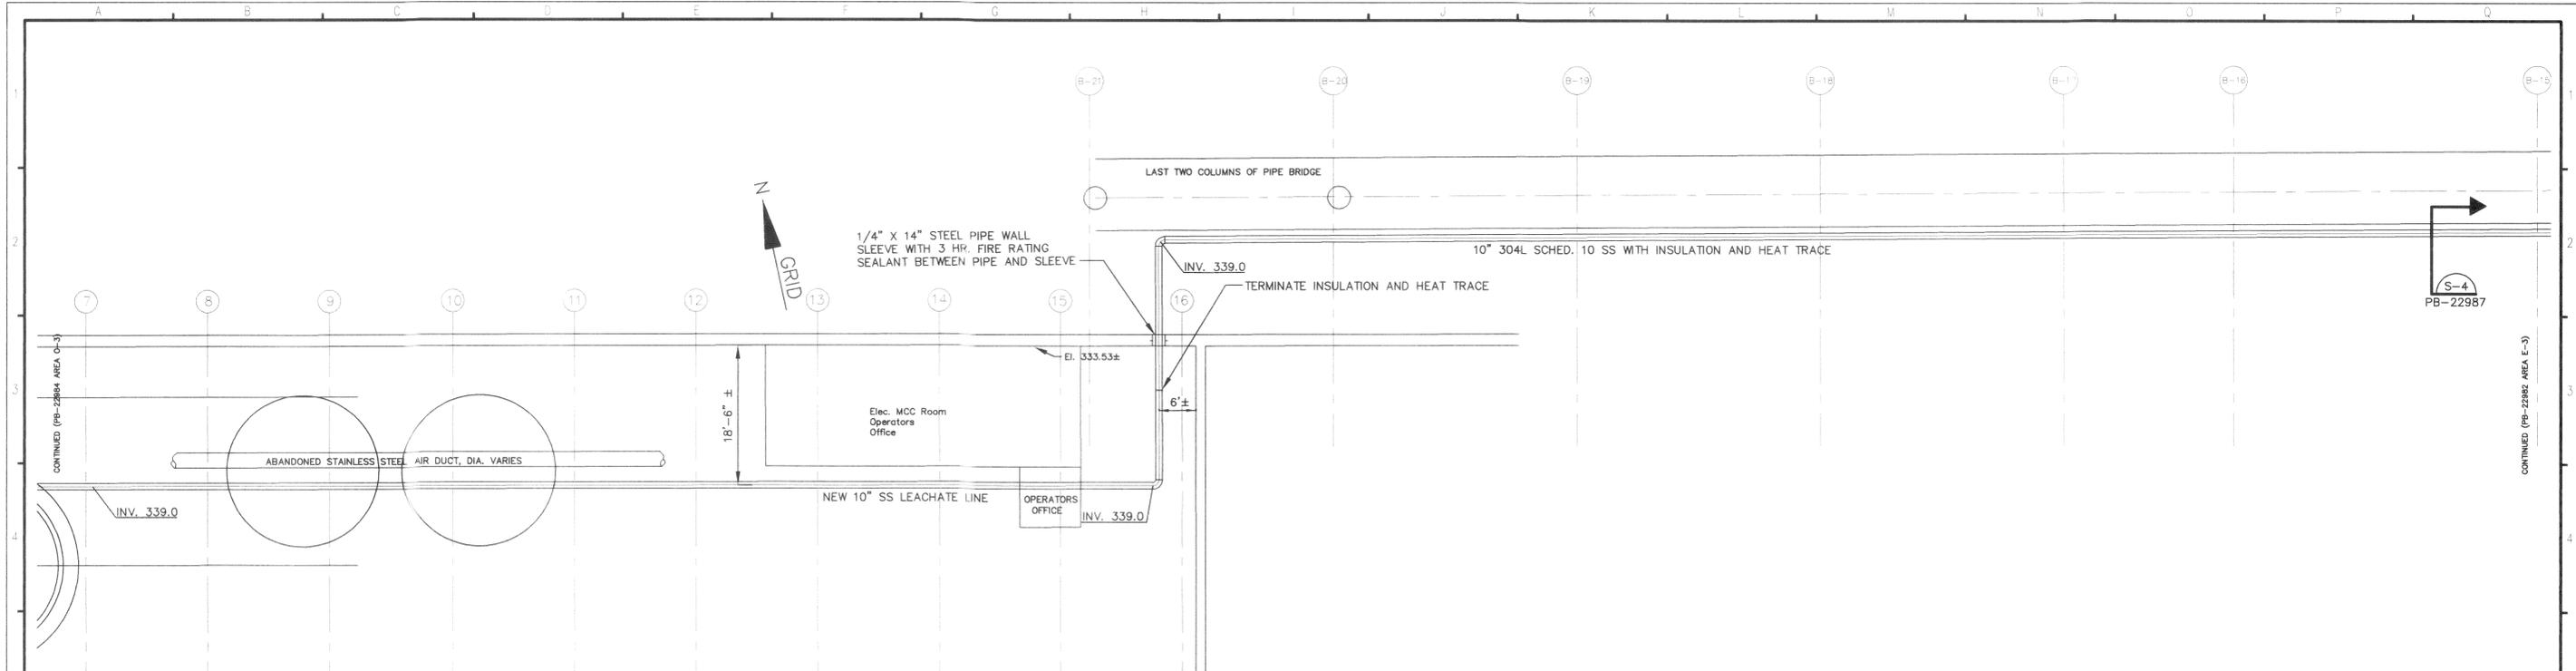


PLAN

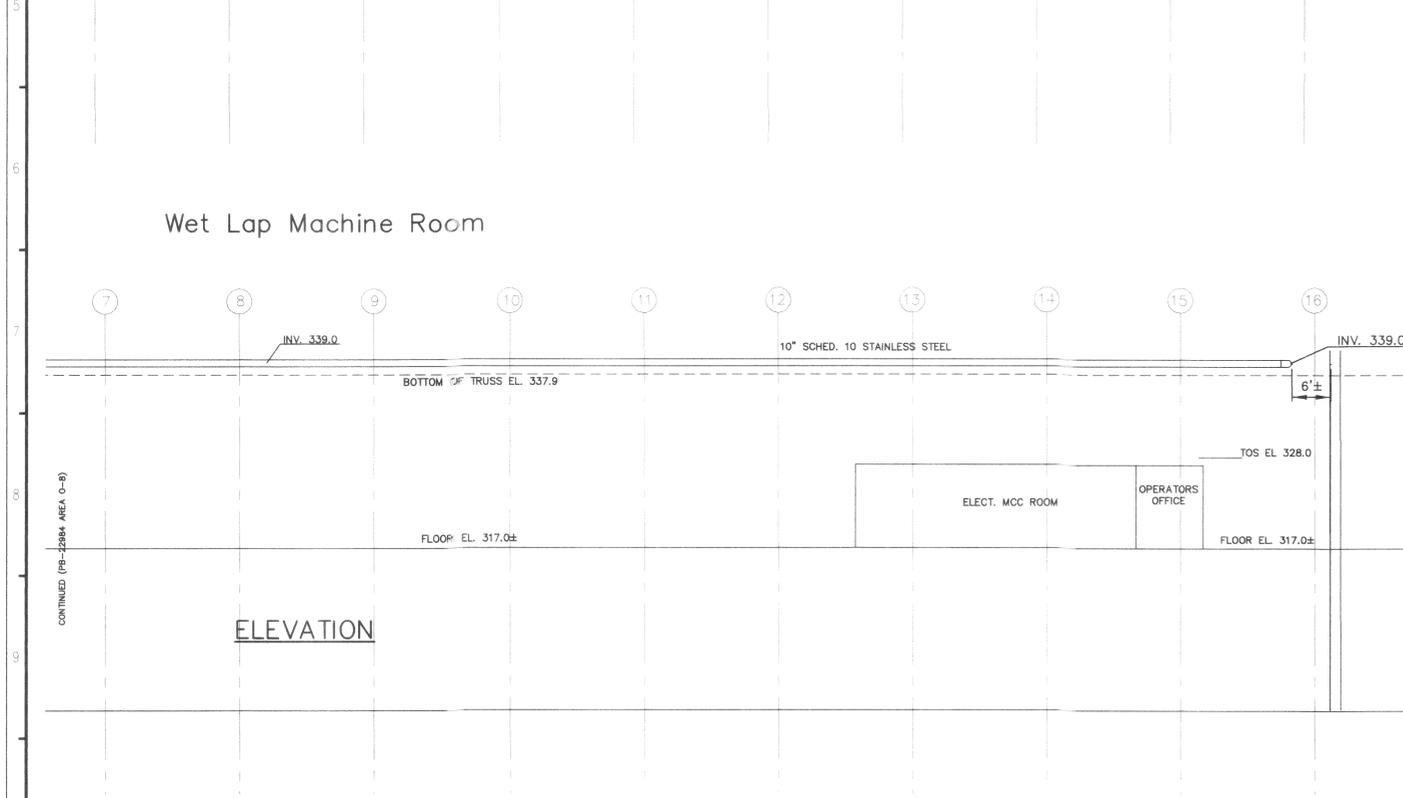

ELEVATION

Wet Lap Machine Room

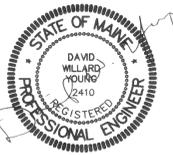

DRAWING NO.	REFERENCE DRAWING TITLE	CODE	NO.	DATE	REVISION	BY	CHKD	APPVD	JOB NO.
PF-01634-B	SIMONS ENGINEERING/RECYCLE FIBER PLANT			8/17/95	ISSUED FOR CONSTRUCTION	BOB	DWY		
				8/8/95	ISSUED FOR CLIENT REVIEW				
				5/26/95	ISSUED FOR CLIENT REVIEW	MSB	DWY		

SQUAW BAY CORP  
CONSULTING ENGINEERS



P.O. BOX 86A CUMBERLAND CENTER, MAINE 04021


DRN	DWY	5/95
CHK		
CHK		
CORR		
APPVD		
ISSUED FOR CONSTRUCTION		
P - Prelim	B - Bids	
M - Mt. T.O.	C - Const.	
SCALE	1" = 10'	



EAST OPERATION  
LEACHATE PIPELINE PROJECT  
DOLBY LANDFILL TO THE EAST OPERATION  
PIPE BRIDGE AND WET LAP ROOM  
10" GRAVITY SEWER


JOB NO. 22846  
ENG. REQ. NO. \_\_\_\_\_  
FILE NO. 2-092-4783

PB-22983  
SHEET 3 OF 8

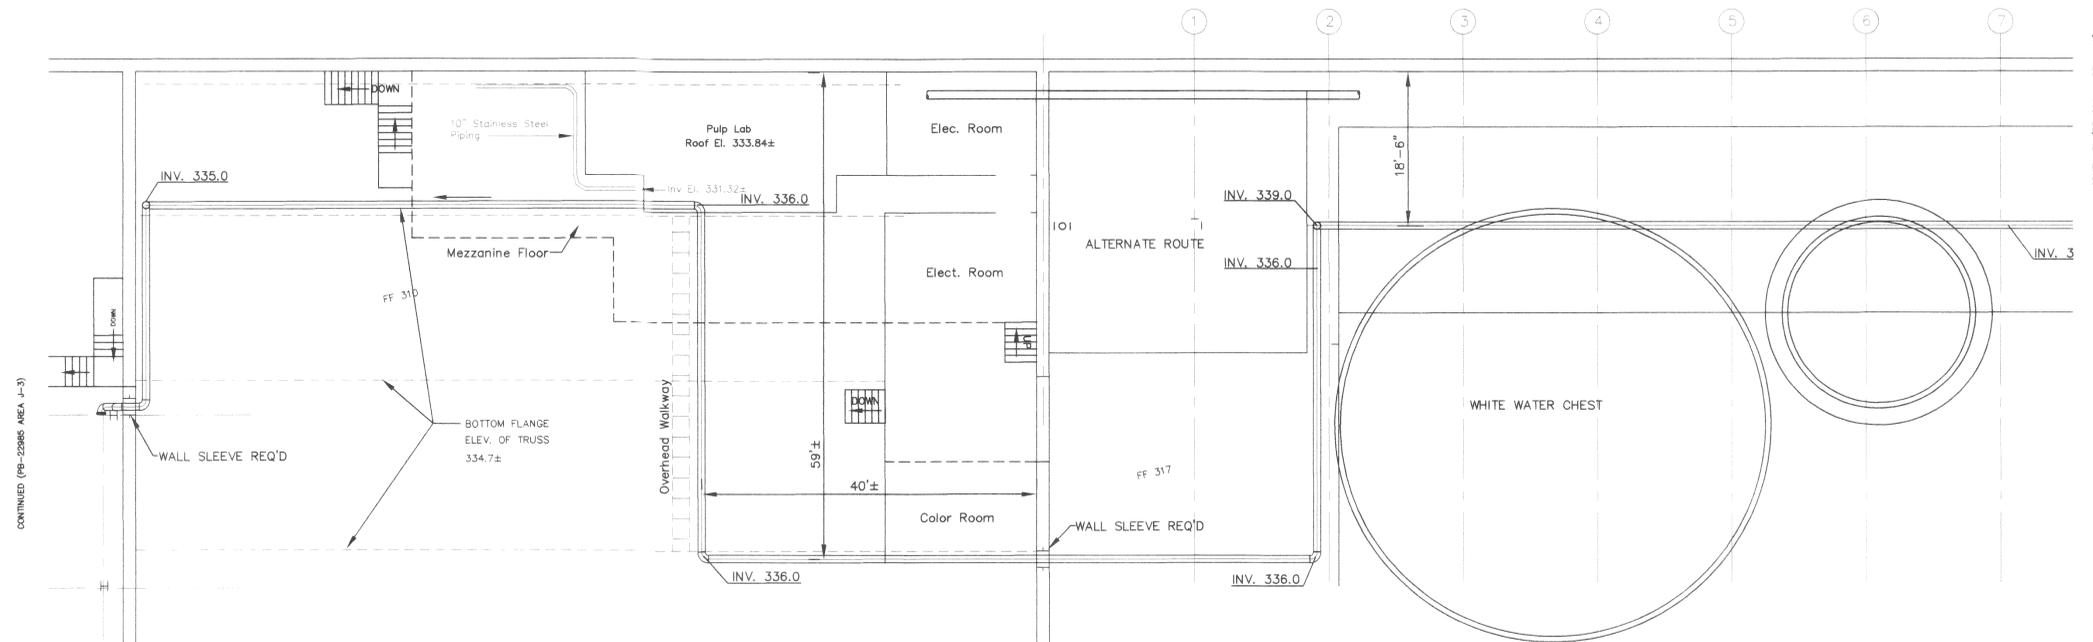

PLAN

← DISC FILTER AREA      Screen Room      → Wet Lap Machine Room

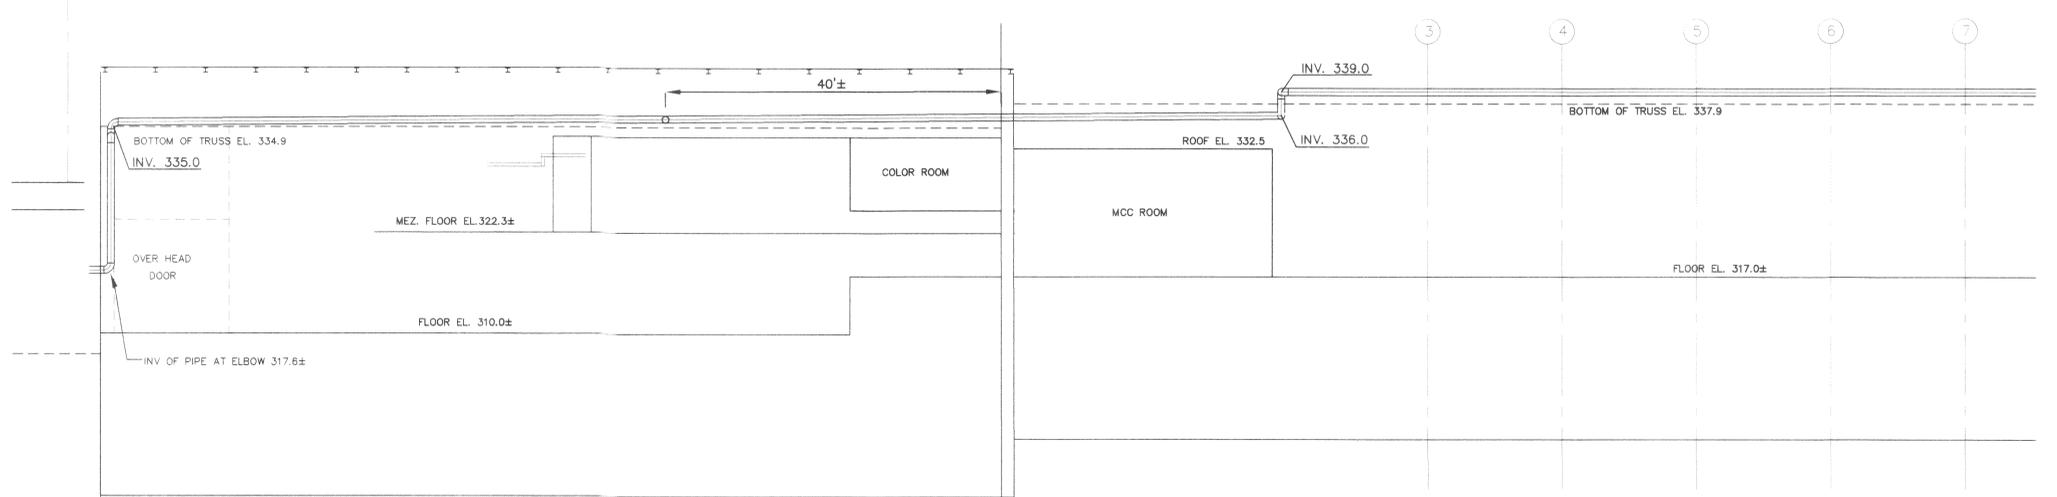

ELEVATION



DRAWING NO.	REFERENCE DRAWING TITLE	CODE	IND.	DATE	REVISION	BY	CHKD	APPVD	JOB NO.
		C		8/17/95	ISSUED FOR CONSTRUCTION	BDG	DWY		
				8/8/95	ISSUED FOR CLIENT REVIEW	MSB	DWY		
				8/26/95	ISSUED FOR CLIENT REVIEW	MSB	DWY		

**SQUAW BAY CORP**  
CONSULTING ENGINEERS

P.O. BOX 86A CUMBERLAND CENTER, MAINE 04021

DRN	DWY	5/95
CHK		
CHK		
CORR		
APPVD		
ISSUE CODE		
P - Prelim	B - Bids	
M - Mt. T.O.	C - Conet.	
SCALE 1" = 10'		




EAST OPERATION  
LEACHATE PIPELINE PROJECT  
DOLBY LANDFILL TO THE EAST OPERATION  
WET LAP AND SCREEN ROOM AREA  
10" GRAVITY SEWER

JOB NO. 22846  
ENG. REQ. NO. \_\_\_\_\_  
FILE NO. 2-092-4783


**PB-22984**  
SHEET 4 OF 8

L: 94-22/02-ACAD/22/02 Mod Aug 21 15:48:23 1995

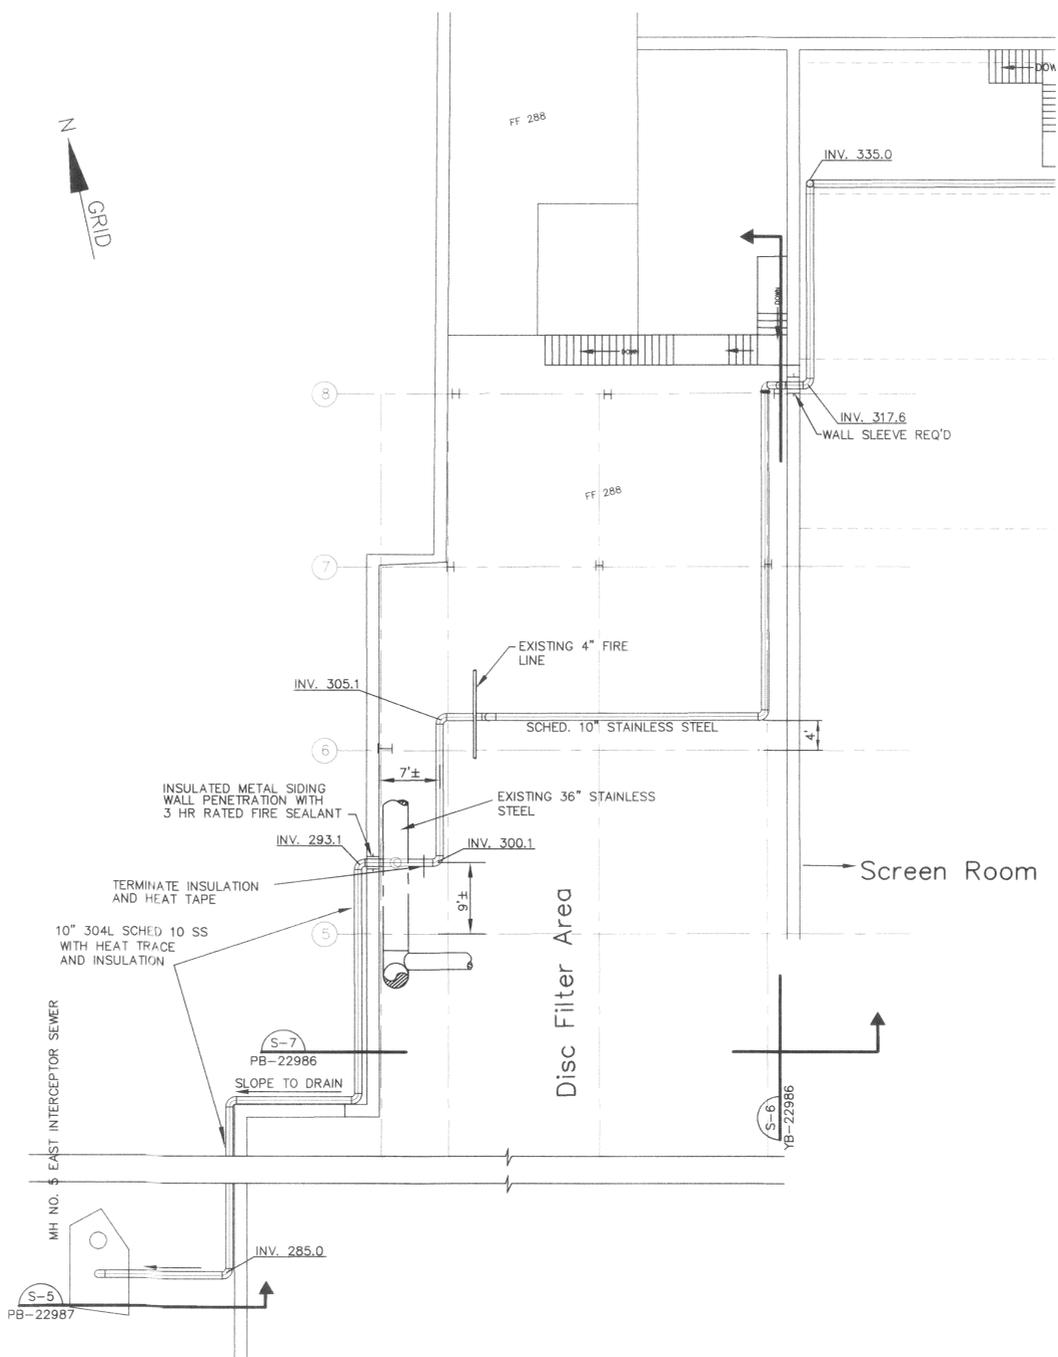

CONTINUED (PB-22984 AREA E-3)

PLAN

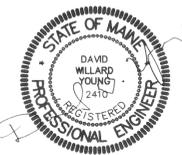

DRAWING NO.	REFERENCE DRAWING TITLE	CODE	NO.	DATE	REVISION	BY	CHKD	APPVD	JOB NO.
AF-375-E	SIMONS ENGINEERING/DISC FILTER BLDG.								
YF-719-F	SIMONS ENGINEERING/GROUND WOOD IMPROVEMENTS STEEL @ EL 310	C		8/17/95	ISSUED FOR CONSTRUCTION	BDG	DWY		
YF-725-B	SIMONS ENGINEERING/EAST INTERCEPTOR SEWER	P		8/8/95	ISSUED FOR CLIENT REVIEW	MSB	DWY		
YF-696-B	SIMONS ENGINEERING/EAST INTERCEPTOR SEWER	P		5/26/95	ISSUED FOR CLIENT REVIEW	MSB	DWY		

**SQUAW BAY CORP**  
CONSULTING ENGINEERS



P.O. BOX 86A CUMBERLAND CENTER, MAINE 04021

DRN	DWY	5/95
CHK		
CHK		
CORR		
APPVD		
ISSUE CODE		
P - Prelim	B - Bids	
M - Mtl T.O.	C - Const.	
SCALE 1" = 10'		





EAST OPERATION  
LEACHATE PIPELINE PROJECT  
DOLBY LANDFILL TO THE EAST OPERATION  
DISC FILTER AREA  
10" GRAVITY SEWER

JOB NO. 22846  
ENG. REQ. NO.  
FILE NO. 2-992-4783

**PB-22985**  
SHEET 5 OF 8

L: 54-22702 ACAD 1-300 Thu Aug 17 13:38:38 1995

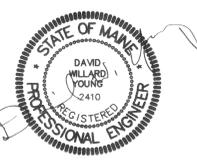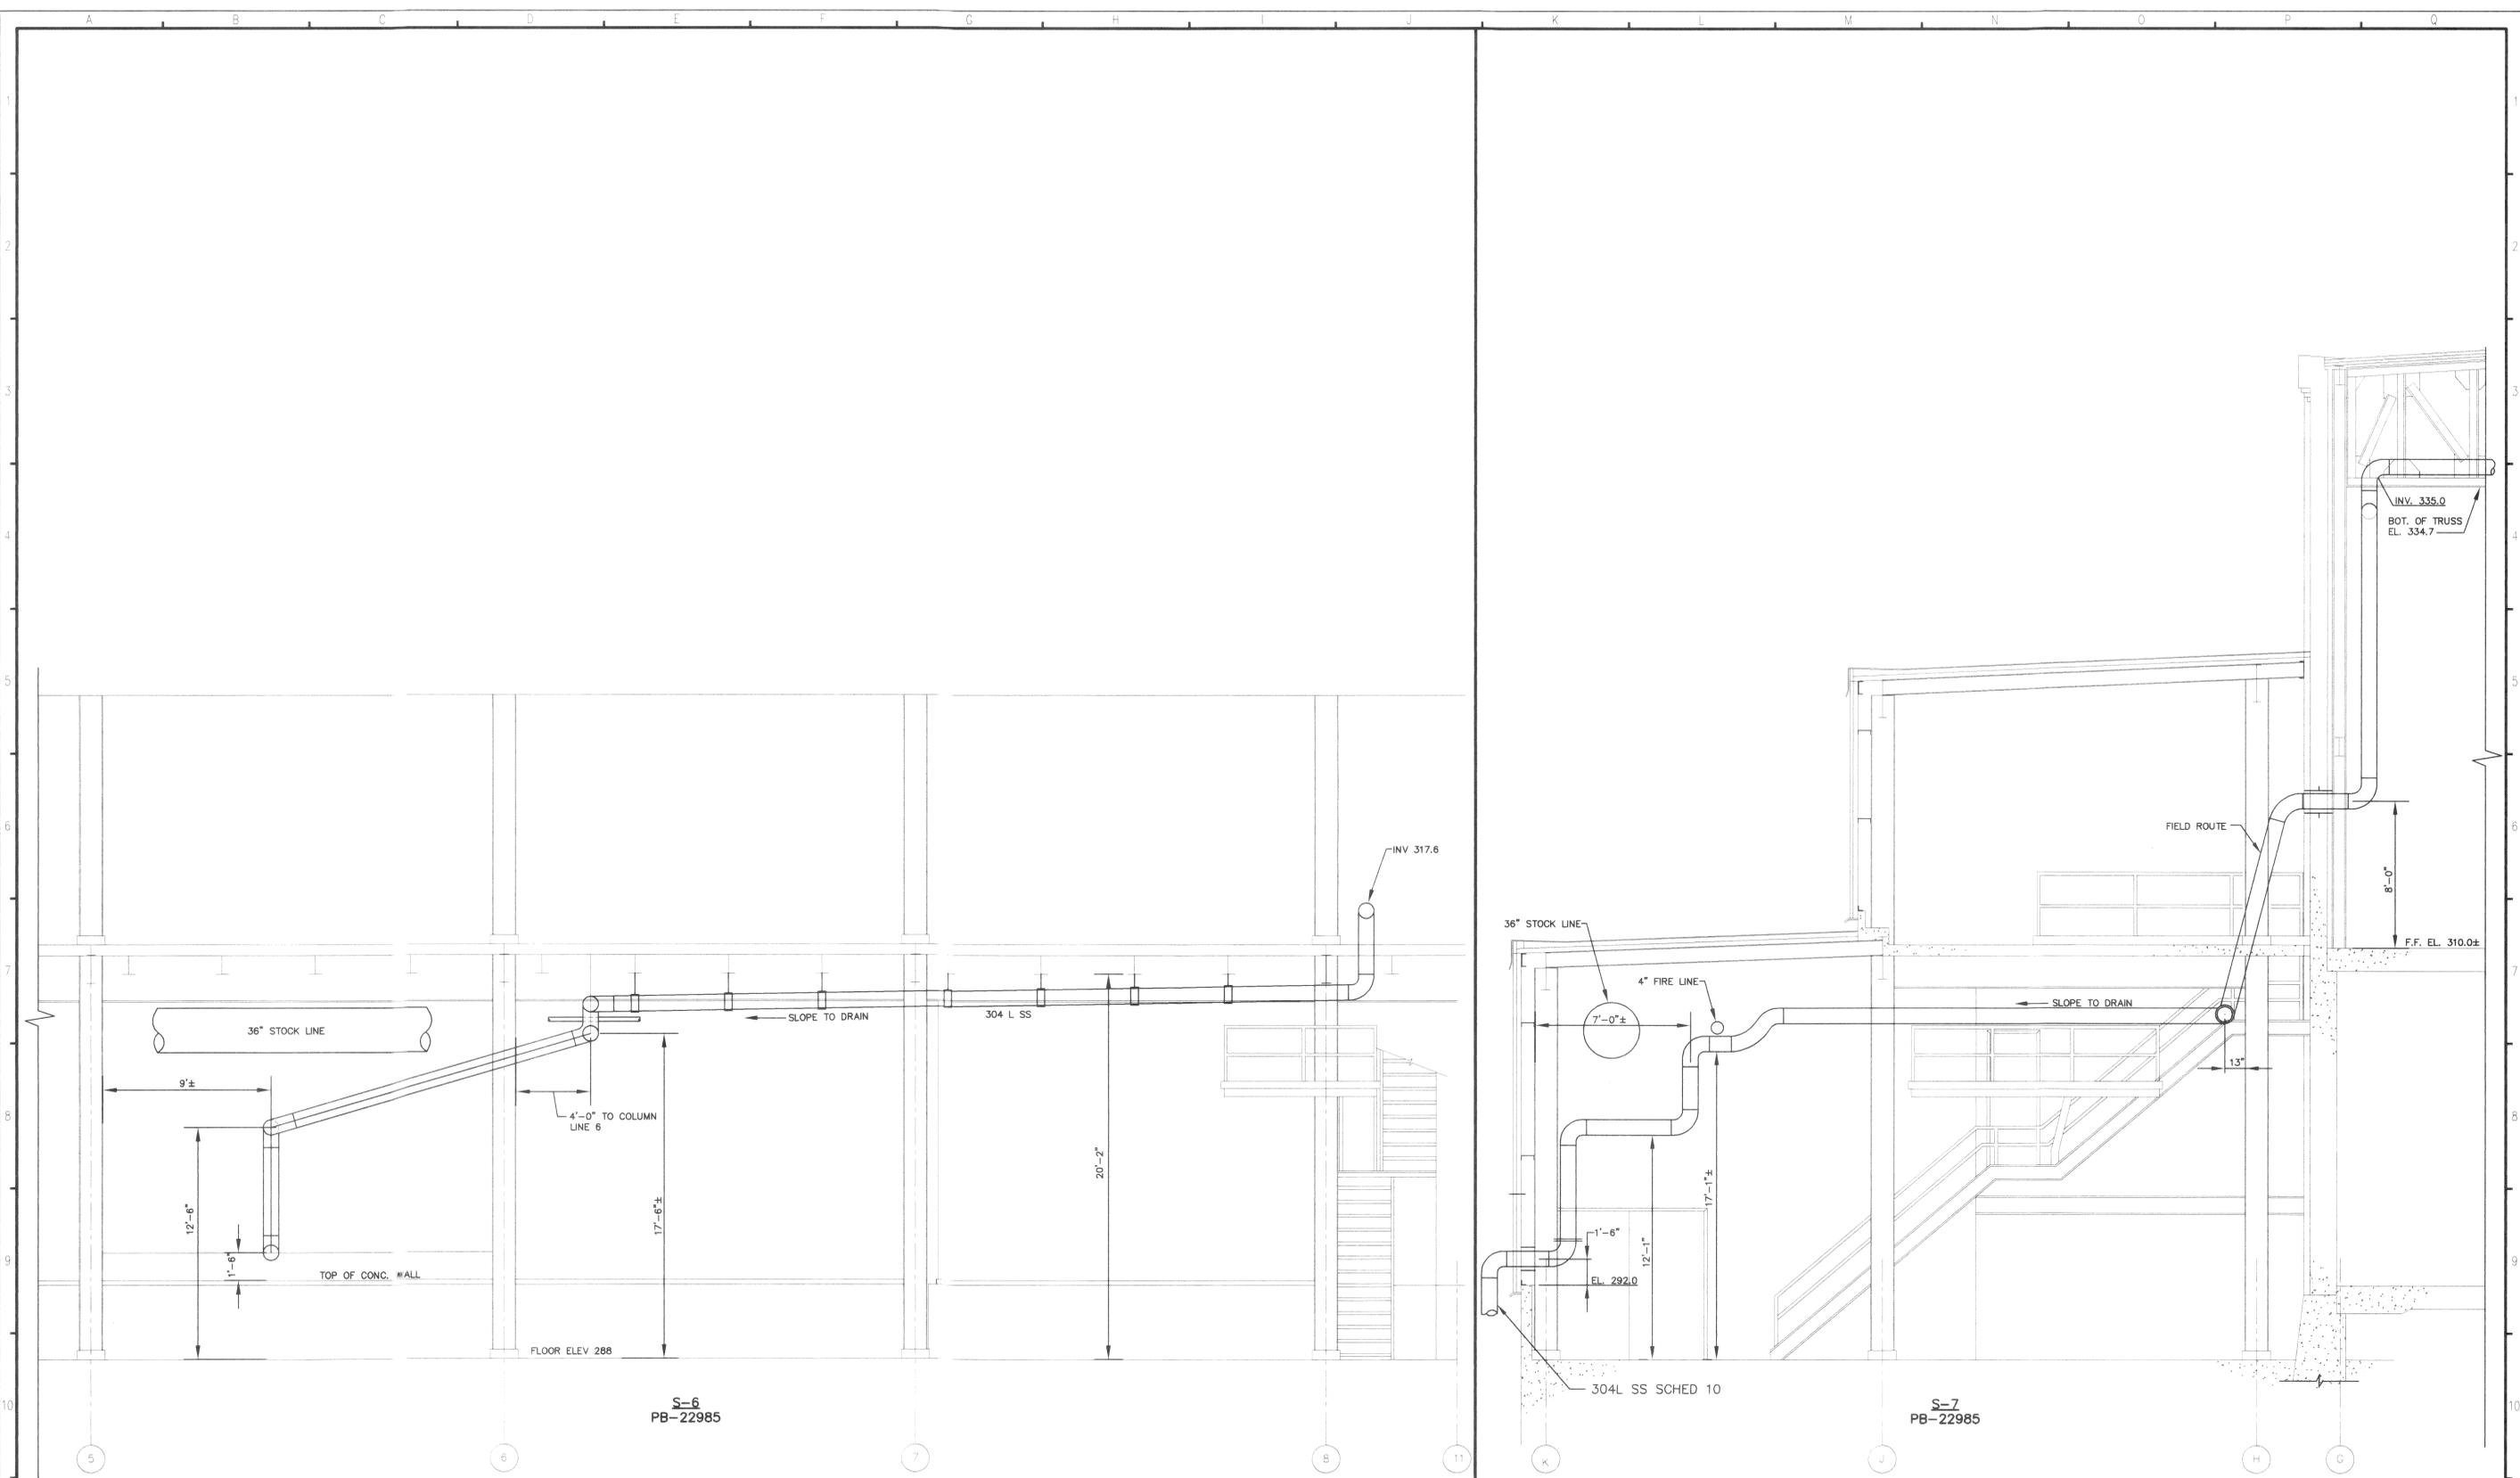

DRAWING NO.	REFERENCE DRAWING TITLE	CODE	NO.	DATE	REVISION	BY	CHKD	APPVD	JOB No.
SF-719-F	SIMONS ENGINEERING GROUND WOOD IMPROVEMENTS --STEEL @ EL. 310	C		8/17/95	ISSUED FOR CONSTRUCTION	BOB	DWY		
AF-737-B	SIMONS ENGINEERING GROUND WOOD IMPROVEMENTS -- DISC FILTER BLDG.	P		8/8/95	FOR CLIENT REVIEW	MSB	DWY		
		P		5/26/95	FOR CLIENT REVIEW	MSB	DWY		

**SQUAW BAY CORP**  
CONSULTING ENGINEERS



P.O. BOX 86A CUMBERLAND CENTER, MAINE 04021


DRN	
CHK	
CHK	
CORR	
APPVD	
ISSUE CODE	
P - Prelim.	B - Bids
M - Mt. T.O.	C - Const.
SCALE 1/4"=1'-0"	



EAST OPERATION  
LEACHATE PIPELINE PROJECT  
DISC FILTER AREA


JOB NO. 22846  
ENG. REQ. NO. \_\_\_\_\_  
FILE NO. 2-092-4783

**PB-22986**  
SHEET 6 OF 8

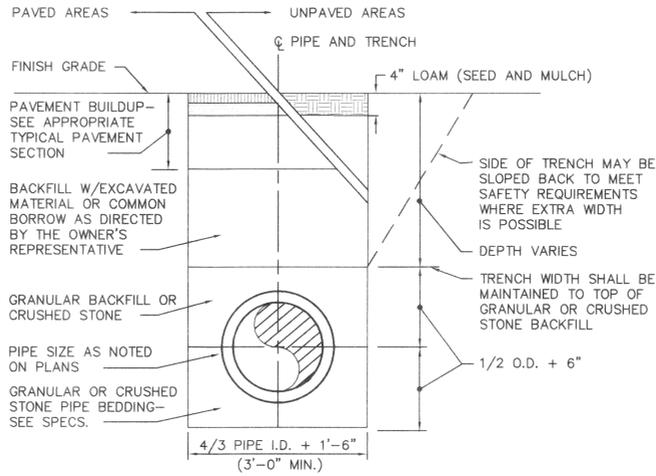


TYPICAL TRENCH DETAIL


N.T.S.  
S-6

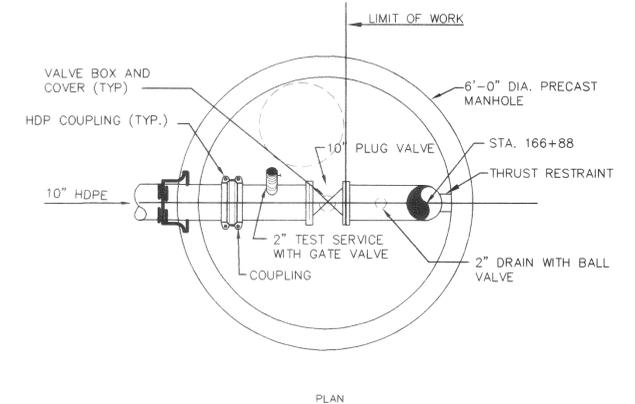


PLAN

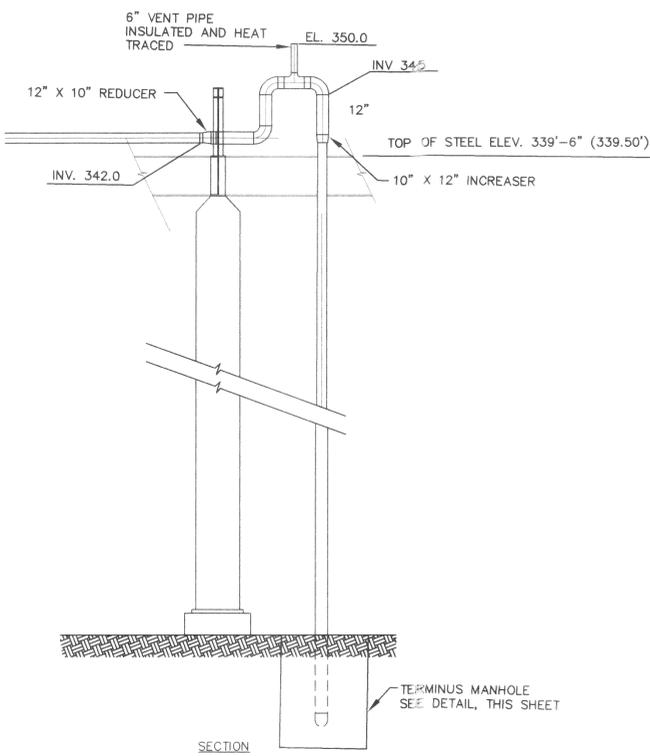


TRANSITION DETAIL  
N.T.S.

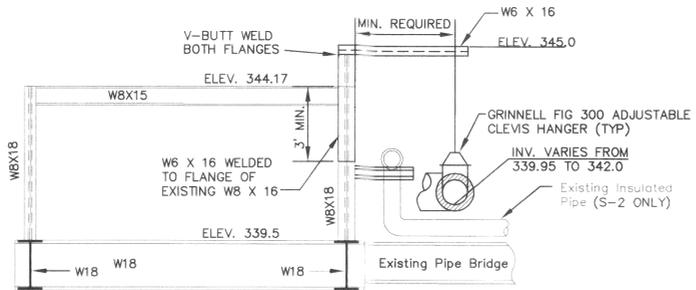


S-1 AND S-2

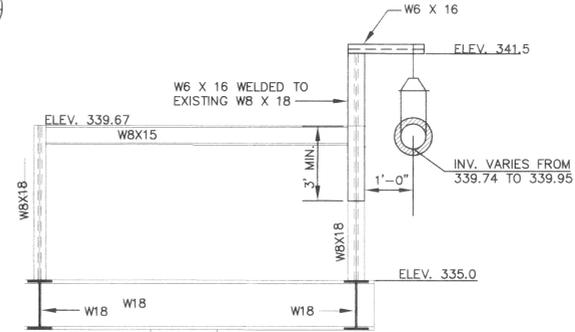


S-3

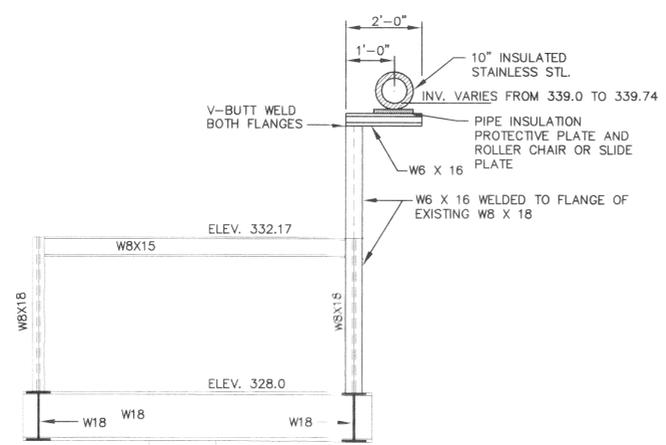

S-4

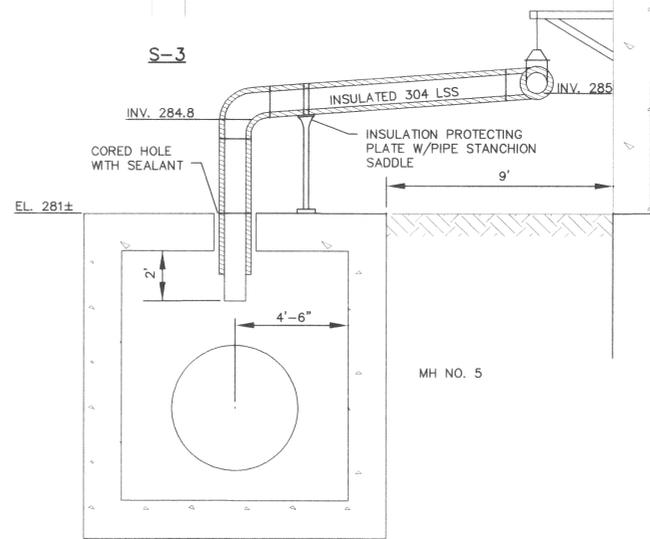

S-5

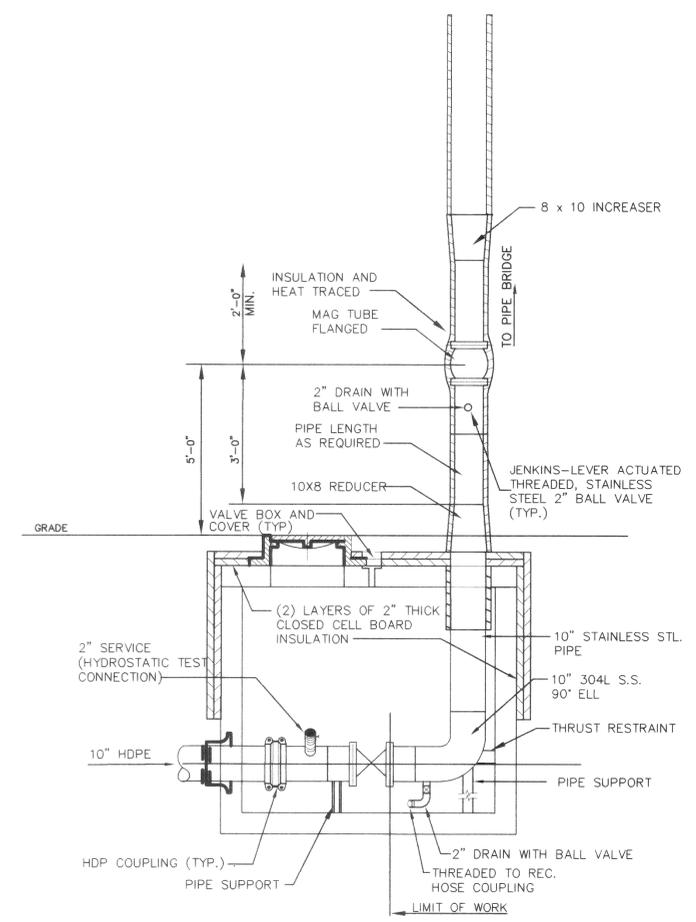

TERMINUS MANHOLE  
N.T.S.



DRAWING NO.	REFERENCE DRAWING TITLE	CODE	NO.	DATE	REVISION	BY	CHK	APPVD	JOB NO.
		C		8/17/95	ISSUED FOR CONSTRUCTION	BOB	DWY		
		P		8/8/95	FOR CLIENT REVIEW	MSB	DWY		
		P		5/28/95	FOR CLIENT REVIEW	MSB	DWY		

**SQUAW BAY CORP**  
CONSULTING ENGINEERS

P.O. BOX 86A CUMBERLAND CENTER, MAINE 04021

DRN	DWY	5/95
CHK		
CHK		
CORR		
APPVD		
ISSUE CODE		
P - Prelim	B - Bids	
M - Mt T.O.	C - Const.	
SCALE N.T.S.		

Great Northern Paper

EAST OPERATION  
LEACHATE PIPELINE PROJECT  
DOLBY LANDFILL TO THE EAST OPERATION  
SECTIONS AND DETAILS  
10" GRAVITY SEWER

JOB NO. 22846  
ENG. REQ. NO.  
FILE NO. 2-092-4783


PB-22987  
SHEET 7 OF 8

U:\94-22\102-ACAD\22702.dwg, Aug 21 14:47:56, 1995.

# MAINE DEPARTMENT OF ECONOMIC AND COMMUNITY DEVELOPMENT LEACHATE PIPELINE RELOCATION GNP MILL FACILITY EAST MILLINOCKET, MAINE

TITLE	DWG NO
COVER SHEET	
SYMBOLS & ABBREVIATIONS	C-100
SITE OVERVIEW PLAN	C-101
LEACHATE PIPELINE PLAN AND PROFILE	C-200
LEACHATE PIPELINE PLAN AND PROFILE	C-201
LEACHATE PIPELINE PLAN AND PROFILE	C-202
SECTIONS AND DETAILS	C-300
SECTIONS AND DETAILS	C-301
SECTIONS AND DETAILS	C-302
SECTIONS AND DETAILS	C-303
SECTIONS AND DETAILS	C-304
SECTIONS AND DETAILS	C-305
FLOW METER BUILDING ELECTRICAL PLAN	6312-14001-E03


LOCATION MAP

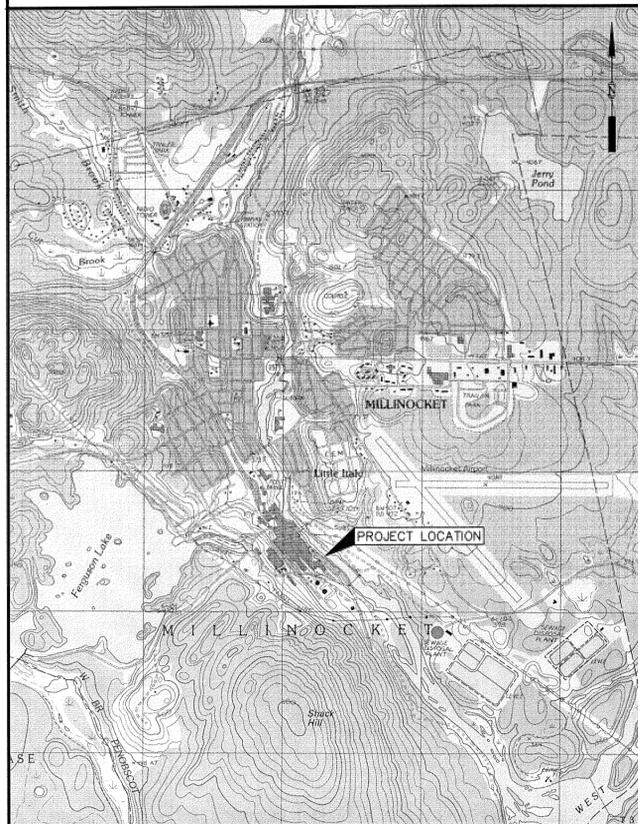

**SME**  
Sevee & Maher Engineers, Inc.

ENVIRONMENTAL • CIVIL • GEOTECHNICAL • WATER • COMPLIANCE


4 Blanchard Road, PO Box 85A, Cumberland Center, Maine 04021  
Phone 207.829.5016 • Fax 207.829.5692 • www.smemaine.com

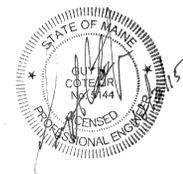

**RECORD DRAWINGS**






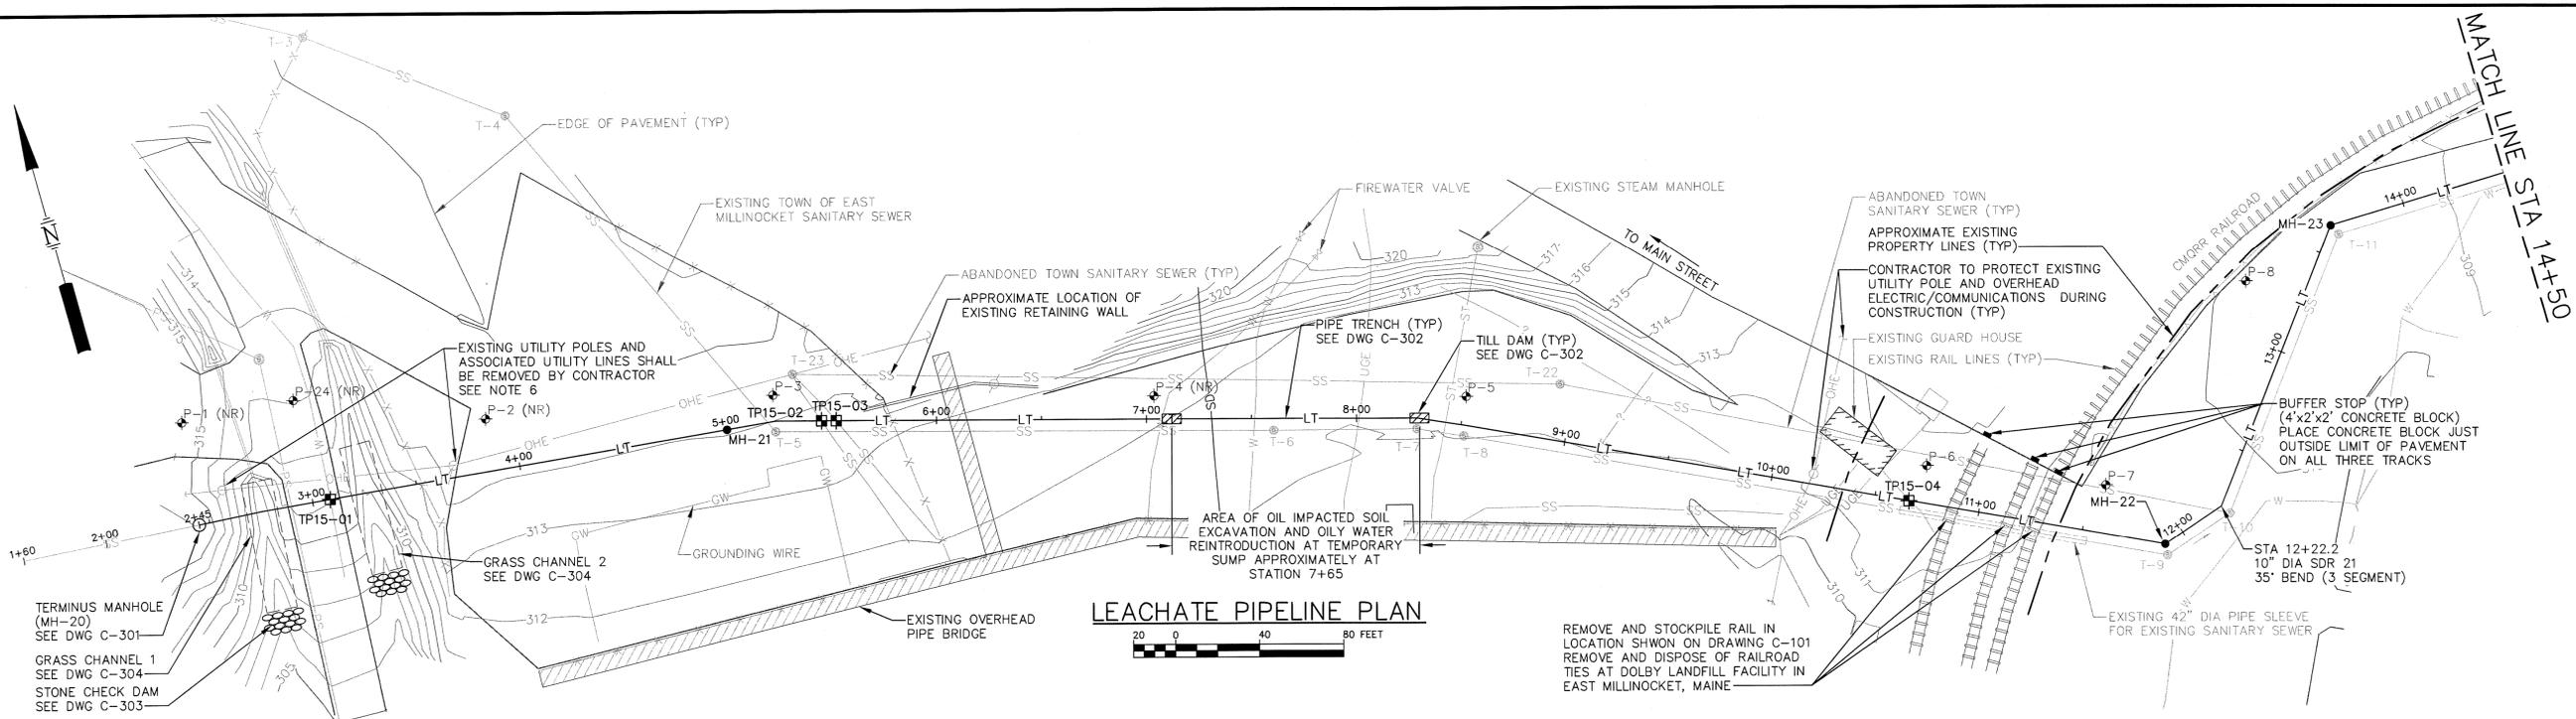


**LEACHATE PIPELINE PLAN**




REMOVE AND STOCKPILE RAIL IN LOCATION SHOWN ON DRAWING C-101 REMOVE AND DISPOSE OF RAILROAD TIES AT DOLBY LANDFILL FACILITY IN EAST MILLINOCKET, MAINE

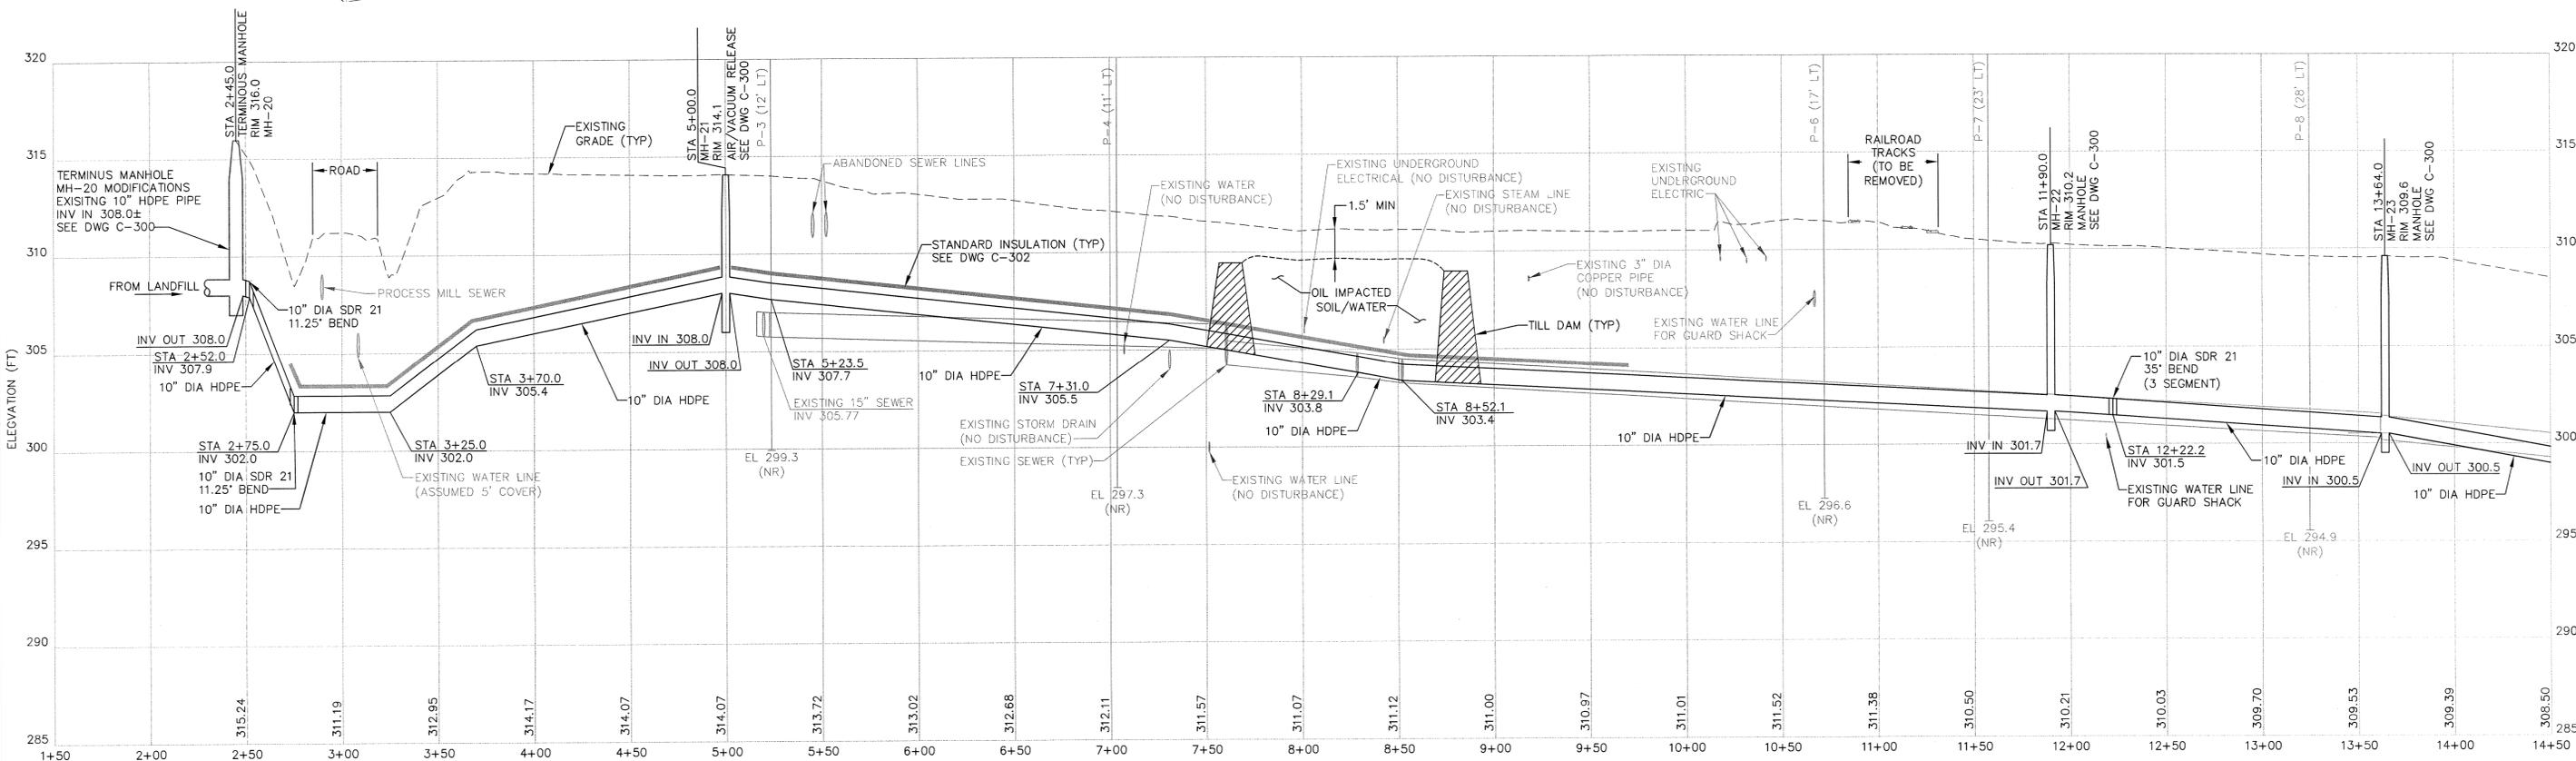

**LEACHATE PIPELINE PROFILE**

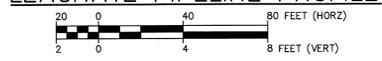

- NOTES**
1. BASE MAP PREPARED BY SEVEE & MAHER ENGINEERS, INC, CUMBERLAND, MAINE. HORIZONTAL DATUM MAINE STATE COORDINATE SYSTEM EAST ZONE, SPC 1801. VERTICAL DATUM IS NAVD 88, GEOID 12.
  2. BORING LOCATIONS AND TOWN OF EAST MILLINOCKET SANITARY SEWER PIPE INVERTS FIELD SURVEYED BY SEVEE & MAHER ENGINEERS, INC. OF CUMBERLAND MAINE. BORING DESIGNATION NR=NO REFUSAL. LOCATIONS OF ALL OTHERS IS APPROXIMATE AND ARE BASED ON HISTORICAL PLANS AND ON UTILITY SURVEY BY DIGSMART.
  3. ALL SITE AND CONSTRUCTION ACTIVITIES SHALL BE IN COMPLIANCE WITH MEDEP BEST MANAGEMENT PRACTICES AND EXISTING FEDERAL, STATE, AND LOCAL PERMITS AND PERMITTING REQUIREMENTS FOR THE SITE.
  4. CONTRACTOR SHALL TEST PIT TO A DEPTH OF 15- FEET BELOW GROUND SURFACE OR TO UNKNOWN UTILITY AT ALL TEST PIT LOCATIONS SHOWN.
  5. UTILITIES AND STRUCTURES DAMAGED DURING CONSTRUCTION SHALL BE REPAIRED BY THE CONTRACTOR TO THE SATISFACTION OF THE UTILITY OWNER AT NO ADDITIONAL COST TO THE OWNER.
  6. THE PROPERTY OWNER HAS EXPRESSED NO OBJECTION TO REMOVAL OF POWER LINES AND POLES. CONTRACTOR SHALL CONFIRM ALL LINES TO BE REMOVED ARE DEENERGIZED PRIOR TO REMOVAL.

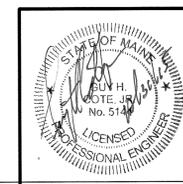

MAINE DEPARTMENT OF ECONOMIC AND COMMUNITY DEVELOPMENT  
**LEACHATE PIPELINE RELOCATION**  
 GNP MILL FACILITY  
 EAST MILLINOCKET, MAINE

**LEACHATE PIPELINE PLAN AND PROFILE**

**SME**  
 Sevee & Maher Engineers, Inc.  
 ENVIRONMENTAL • CIVIL • GEOTECHNICAL • WATER • COMPLIANCE  
 4 Blanchard Road, PO Box 85A, Cumberland Center, Maine 04021  
 Phone 207.829.5016 • Fax 207.829.5692 • www.smemaine.com

DESIGN BY: BDP  
 DRAWN BY: SJM  
 DATE: 5/2015  
 CHECKED BY: BDP  
 LMN: LT-PLAN-PROF  
 CTB: SME-STD

JOB NO. 14134.09 DWG FILE BASE  
**C-200**

REV.	BY	DATE	STATUS
	BDP	12/15	RECORD DRAWING
	BDP	8/15	REVISED PER CHANGE ORDER 1
	BDP	7/15	ISSUED FOR CONSTRUCTION
	BDP	7/15	REVISED PER ADDENDUM 1
	BDP	6/15	ISSUED FOR BID



















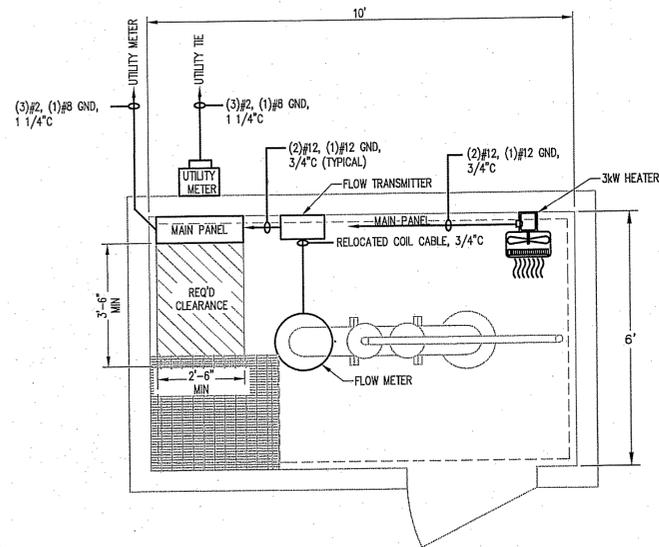


**POWER PLAN - UPPER**  
**FLOW METER BUILDING (MH27)**  
 SCALE: NTS

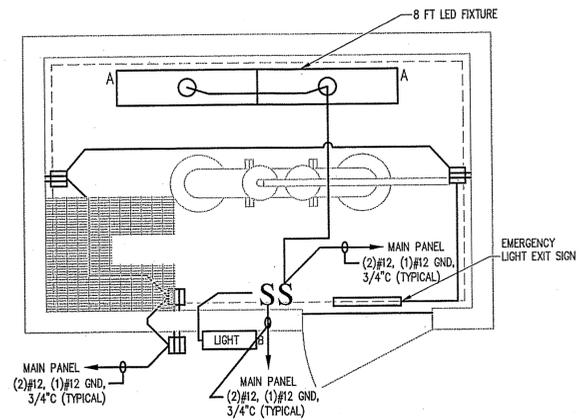


**LIGHTING PLAN**  
**FLOW METER BUILDING (MH27)**  
 SCALE: NTS

CIRCUIT DIRECTORY			
1	LEFT OF PANEL - RECEPTILES TOWNSIDE	2	INSIDE & OUTSIDE LIGHTS
3		4	RIGHT OF PANEL RECEPTILES
5		6	EXIT-EMERGENCY LIGHT
7		8	ELECTRIC SPACE HEATER
9		10	ELECTRIC SPACE HEATER
11		12	FLOW METER
13		14	


**PANEL SCHEDULE**  
 MAIN PANEL

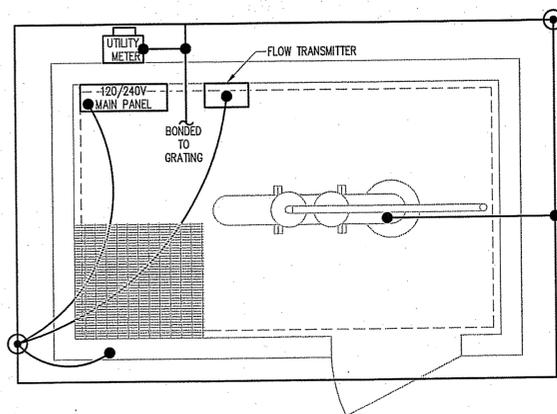

**GROUNDING PLAN**  
**FLOW METER BUILDING (MH27)**  
 SCALE: NTS

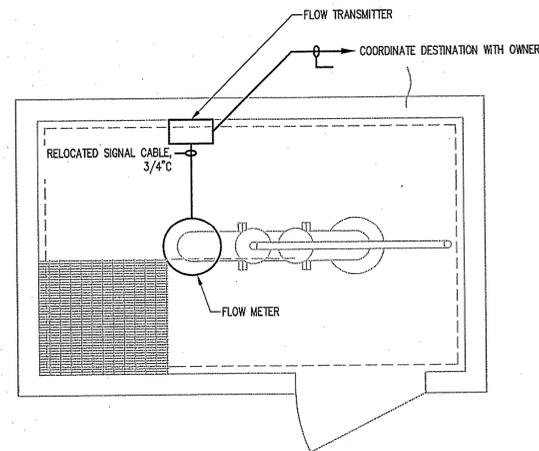

**I&C PLAN**  
**FLOW METER BUILDING (MH27)**  
 SCALE: NTS

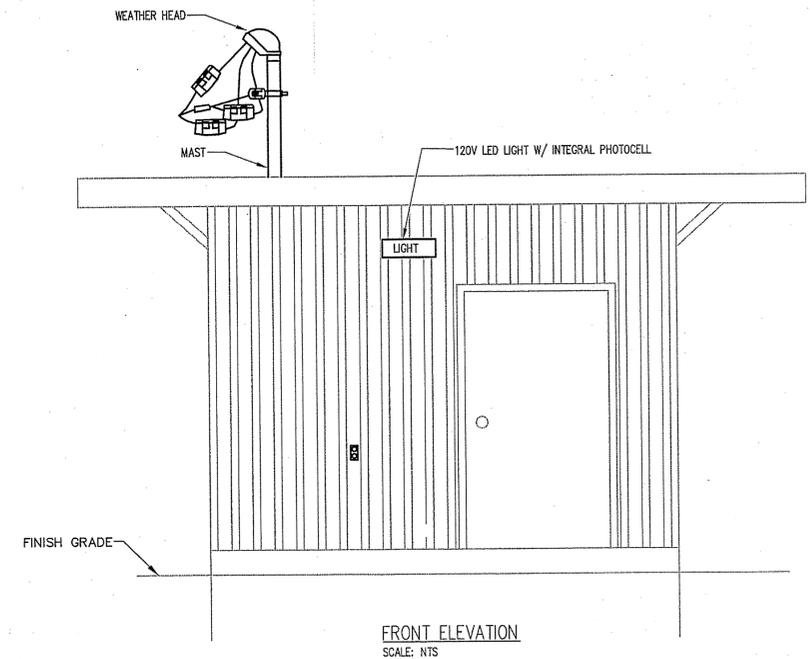

**FRONT ELEVATION**  
 SCALE: NTS

**NOTES:**

- TYPE "A" FIXTURES SHOWN SHALL BE MODEL NUMBER LUN4-24818HO-EJ-PEBA AS MANUFACTURED BY COLUMBIA LIGHTING, OR APPROVED EQUAL. PROVIDE BACKUP BATTERY PACK FOR EGRESS LIGHTING REQUIREMENTS.
- TYPE "B" FIXTURE SHOWN SHALL BE MODEL NUMBER LMC-18LI-SK-E-2-PQ(1) WITH PHOTOCELL AND POLYCARBONATE SHIELD AS MANUFACTURED BY HUBBELL OUTDOOR LIGHTING, OR APPROVED EQUAL.
- PROVIDE ELECTRICAL SERVICE AND UTILITY METER PER ALL ELECTRICAL UTILITY (EMERA) REQUIREMENTS. COORDINATE WITH EMERA FOR ALL ELECTRICAL SERVICE WORK.
- MAINTAIN MINIMUM REQUIRED CLEARANCE IN FRONT OF MAIN PANEL AS INDICATED.
- GFCE RECEPTILES SHOWN SHALL BE PROVIDED WITH WEATHERPROOF IN-USE RATED COVERS.
- ELECTRICAL EQUIPMENT SHALL BE SURFACE MOUNTED.
- MAIN PANEL SHALL HAVE 100A RATED MAIN CIRCUIT BREAKER AND 100A RATED BUSES. IT SHALL HAVE 16 CIRCUITS MINIMUM AND BE RATED NEMA 12.
- BOND BUILDING REBAR, UTILITY METER, TRANSMITTER, PIPE AND PANEL TO SINGLE GROUND ROD ADJACENT TO BUILDING.
- RELOCATE EXISTING FLOW TRANSMITTER FROM PRESENT LOCATION. LOCATE TRANSMITTER ADJACENT TO FLOW METER SUCH THAT EXISTING CABLE CAN BE RE-POSD. COORDINATE FLOW TRANSMITTER OUTPUT SIGNAL REQUIREMENTS WITH OWNER.

**DISCLAIMER:**

EXISTING BUILDING INFORMATION REPRODUCED FROM ORIGINAL PRINT.  
 MID-SOUTH ENGINEERING HAS NOT VERIFIED THE ACCURACY OF THE INFORMATION SUPPLIED FROM THIS DRAWING.

**RECORD DRAWING**

THIS DRAWING DEPICTS INFORMATION BASED ON OWNER'S RECORD COPY OF DRAWINGS, SPECIFICATIONS, CHANGE ORDERS, WORK CHANGE DIRECTIVES, FIELD ORDERS, AND OTHER WRITTEN INTERPRETATIONS AND CLARIFICATIONS, AS DELIVERED TO MID-SOUTH ENGINEERING AND ANNOTATED BY OWNER TO SHOW CHANGES MADE DURING CONSTRUCTION. THESE CHANGES MADE DURING CONSTRUCTION HAVE NOT BEEN VERIFIED BY MID-SOUTH ENGINEERING. THEREFORE MID-SOUTH ENGINEERING CANNOT SEAL THIS DRAWING. USE OF THIS INFORMATION SHALL BE AT THE USER'S RISK.

NO.	DATE	BY	DESCRIPTION
1	12/23/15	CJB	ISSUED RECORD DRAWING
0	6/23/15	GAG	ISSUED FOR CONSTRUCTION

REVISIONS	
1658 Malvern Ave. Hot Springs, Arkansas 71901	
200 Mackean Drive Carv, North Caroling 27511	
70 Spring Street, Suite 3 Millinocket, Maine 04462	
WWW.MSECO.COM	

<b>MID-SOUTH ENGINEERING</b>			
LEACHATE PIPELINE RELOCATION GNP MILL FACILITY ELECTRICAL PLAN			
SEVEE & MAHER ENGINEERS, INC. EAST MILLINOCKET, MAINE			
SCALE NTS	DRN. GAG	6/17/15	DRAWING NO. 6312-14001-E03
	APP. DEM	6/19/15	

**APPENDIX C**  
**INSPECTION LOGS**

First Inspection

**DOLBY LANDFILL  
LANDFILL INSPECTION CHECKLIST**

Date: \_\_\_\_\_

Time: \_\_\_\_\_

Weather: \_\_\_\_\_

Inspected By: \_\_\_\_\_

ITEM	CONDITION	
	Ok	Not Ok
<b>DOLBY I LANDFILL</b>		
<b>COVER SYSTEM</b>		
Erosion, Channeling, Eruptions		
Poor Drainage, Ponding		
Excessive Set ling, Crack Development		
Grass Die-off-Failure to Thrive		
Mowing Required		
Germination of Trees, Deep Root Vegetation		
Animal Burrowing		
<b>COLLECTION PONDS</b>		
West End Pond Level (low, medium, or high)		
East End Pond Level (low, medium, or high)		
Vegetative Build-up in Ponds (Cat Tails and Trees)		
<b>ACCESS GATES</b>		
Gates Secured and Working Properly (Facility Main Gates)		
Road Accessible by Vehicle		
<b>DOLBY II LANDFILL</b>		
<b>COVER SYSTEM</b>		
Erosion, Channeling, Eruptions		
Poor Drainage, Ponding		
Excessive Set ling, Crack Development		
Grass Die-off, Failure to Thrive		
Mowing Required (Mowing Should Occur Next Year due to Woody Vegetation)		
Germination of Trees, Deep Root Vegetation		
Animal Burrowing		
<b>PERIMETER DRAIN CATCH BASINS</b>		
Build-up Sediment in Catch Basins		
Flow Conditions (low, medium, or high)		
Catch Basins Intact and Serviceable		
<b>LEACHATE HOLDING POND</b>		
Iron Staining (wooded area east of pond)		
Holding Pond Level		
<b>DOLBY III LANDFILL</b>		
<b>COVER SYSTEM</b>		
Erosion, Channeling, Eruptions		
Excessive Set ling, Crack Development		
Grass Die-off-Failure to Thrive		
Mowing Required		
Germination of Trees, Deep Root Vegetation		
Poor Drainage, Ponding		

First Inspection

ITEM	CONDITION	
	Ok	Not Ok
<b>DOLBY III LANDFILL (Cont'd)</b>		
Animal Burrowing		
Access Road Condition		
Gas Vent Pipes		
Active Area Berm		
<b>PERIMETER DRAIN AND CATCH BASINS</b>		
Build-up of Sediment in Catch Basins		
Valves Functioning Properly (free turning)		
<b>LEACHATE COLLECTION POND</b>	<b>Ok</b>	<b>Not OK</b>
<b>LINER</b>		
Condition of Liner (rips, holes, torn seams)		
<b>LEACHATE PUMP STATION</b>		
Build-up Sediment in Wetwells or Leachate Pond		
Pumps Functioning Properly (amps, noises)		
Valves Functioning Properly (free turning)		
Flow Conditions (low, medium, or high)		
Properly Vented		
Electrical Panel Inspection (corrosion, etc.)		
Flow Meter Inspection		
Transducer		
<b>LEAK DETECTION SYSTEM</b>		
Pump functioning properly (amps, noises)		
Flow Conditions (low, medium, high)		
Flow Meter Inspection		
Control Panel Inspection		
<b>UNDERDRAIN PUMPING SYSTEM</b>		
Pump functioning properly		
Flow Conditions		
<b>SITE SEDIMENTATION STRUCTURES</b>		
<b>NORTHWEST SEDIMENT POND (SEDIMENT POND 3)</b>		
Check Outlet Structure for Condition		
Water Level (low, medium, or high)		
<b>WEST SEDIMENT POND (SEDIMENT POND 2)</b>		
Check Outlet Structure for Condition		
Water Level (low, medium, or high)		
<b>SOUTHWEST SEDIMENT POND (SEDIMENT POND 1)</b>		
Check Outlet Structure for Condition		
Water Level (low, medium, or high)		
<b>SITE ROADWAYS AND DRAINAGE</b>		
Check Catch Basins for Build-up of Sediment		
Check Culverts for Blocked Drainage and/or damage		
Check Monitoring Wells for Visual Damage		
General condition of Perimeter Roadways		
<b>LEACHATE PIPELINE</b>		
Check Manhole Exterior Condition		
Check Transition Station Exterior Condition		
Check Aboveground Utility Line to the Transition Station		
General condition of Leachate Pipeline Access Road		

First Inspection

**COMMENTS:**

1.

**RECOMMENDED ACTIONS:**

1.

**Manhole Inspection**  
**Dolby Landfill, East Millinocket, Maine**  
**Month Day, Year**

**DOLBY LANDFILL**  
**CONCRETE MANHOLE INSPECTION FORM**

**Manhole / Catch Basin No:** \_\_\_\_\_ **CB #** \_\_\_\_\_

Landfill Location: \_\_\_\_\_

Date: \_\_\_\_\_ Time: \_\_\_\_\_

Weather: \_\_\_\_\_ Inspected by: \_\_\_\_\_

Date of last inspection: \_\_\_\_\_

Exterior Condition (Comments): \_\_\_\_\_

Cracks: \_\_\_\_\_

Holes: \_\_\_\_\_

Flaking: \_\_\_\_\_

Seeps: \_\_\_\_\_

Other: \_\_\_\_\_

Interior Condition (Comments): \_\_\_\_\_

Cracks: \_\_\_\_\_

Holes: \_\_\_\_\_

Flaking: \_\_\_\_\_

Seeps: \_\_\_\_\_

Other: \_\_\_\_\_

Corrective Action required (Y/N): \_\_\_\_\_

Date and Details of Corrective Actions (if needed): \_\_\_\_\_

\_\_\_\_\_

Attachments: Photos

**Manhole Inspection**  
**Dolby Landfill, East Millinocket, Maine**  
**Month Day, Year**

CB-# Exterior

CB-# Interior

**APPENDIX D**

**ACTION LEAKAGE RATE/RESPONSE ACTION PLAN  
FOR LEACHATE POND LINER**

## **ACTION LEAKAGE RATE/RESPONSE ACTION PLAN FOR LEACHATE POND LINER**

Note to Reader: This plan is an update of the Action Leakage Rate/Response Action Plan prepared for the Dolby leachate pond in 2006. The update did not change the calculations used for determining the action leakage rate. At the time of this plan, in 2006, the existing leachate pond had not been constructed. The narrative for this plan recognizes that the leachate pond was subsequently constructed in 2007.

A leak detection system was included in the leachate pond construction to monitor the performance of the primary liner. The leak detection system consists of a drainage geocomposite layer below the primary 60-mil HDPE geomembrane. Beneath the leak detection system is a secondary 60-mil HDPE geomembrane overlying a geosynthetic clay liner (GCL), followed by a 12-inch-thick compacted clay layer. At the south end of the leak detection system is a 6-inch diameter SDR-17 HDPE perforated pipe buried in a 12-inch-thick layer of 3/4-inch drainage stone (i.e., a sump). Sample tubing is provided in the leak detection piping system so that the landfill operator can sample the contents of the sump. All water collected in the leak detection system drains to the leak detection sump. The leak detection sump is equipped with a 1/2-HP submersible pump, which is activated by a transducer system. The discharge line from the pump contains a flow meter for recording discharge from the leak detection layer. The pump discharges to the leachate pump station sump where it is pumped off-site. The engineering drawings for the leachate pond are appended to the Post-Closure Monitoring and Maintenance Plan for Dolby Landfill.

Estimated Liner Leakage Rates. The amount of leakage through the primary liner depends on several factors, including the following:

- The number and size of holes or imperfections in the geomembrane liner;
- The head above the primary liner;
- The uniformity of contact between the geomembrane liner and underlying geocomposite; and
- The hydraulic conductivity of the material in contact with the primary liner.

Typically, two-hole or imperfections sizes are used in defining leakage rates through a geomembrane liner system. Small holes (i.e.,  $3 \times 10^{-6} \text{ m}^2$ ) roughly equal to the thickness of the geomembrane should be considered representative of actual field conditions and more typical of operating conditions. A larger hole (i.e.,  $1 \times 10^{-4} \text{ m}^2$ ) should be used to size the hydraulic capacity of the leak detection layer (ref. Cell and Liner System Detailed Design (Design Examples), J.P. Giroud/Geosyntec Consultants, 1992).

For the leachate pond, Sevee & Maher Engineers, Inc. (SME) calculated leakage rates through the primary liner using the larger hole size. The frequency of imperfections in a geomembrane is associated with the degree of QA/QC associated with the manufacture and installation of the membrane. Because a detailed geomembrane QA/QC program was developed for the project (ref. "Contract Documents and Construction Specifications for Leachate Pond Redevelopment, Dolby III Landfill", SME, Revised May

2006), a minimal number of defects are anticipated. Giroud et al. suggests that for liner installation with good QA/QC, between one and three manufacture holes per acre and one installation defect per acre can be expected. SME calculated total leakage rates through the primary liner for one hole per acre (with a size of  $1 \times 10^{-4} \text{ m}^2$ ) to predict the hydraulic capacity of the leak detection system.

The second variable affecting flow through the primary geomembrane liner is hydraulic head on the liner. SME used a hydraulic head for a pond level at a normal operating depth of two feet to determine the leak detection time.

The last two variables that affect leakage rate through the primary liner are the hydraulic conductivity of the materials in contact with the liner and the contact conditions. Calculated flow estimates were based on the proposed liner design. For primary liner, which will be underlain by a drainage geocomposite and secondary liner, flow rates were estimated based on analytical models developed by Giroud and Bonaparte (1989b) for flow through composite liners. Giroud and Bonaparte defined two conditions corresponding to the contact made between the geomembrane and underlying material that affect the flow through the geomembrane liner. A good contact is defined by Bonaparte et al. as a membrane installed with few wrinkles on top of a low hydraulic conductivity soil layer. Poor contact is defined as a geomembrane installed with a certain number of wrinkles and/or placed on a low-hydraulic conductivity soil layer that has not been well compacted and does not appear smooth. SME developed estimates of leakage through the primary geomembrane liner system for a single geomembrane underlain by a high permeability material (drainage geocomposite). Based on these variables, leakage rates through the primary geomembrane liner systems were calculated for the worst case. SME also evaluated hydraulic capacities of the leak detection system to handle the calculated flows and the time of travel for these flows in the leak detection systems. For the conditions described above, the calculations demonstrate that the leak detection system has the capacity to both handle worst case design flows and detect leaks in an approximate 20-hour period. This exceeds the regulatory requirement of detecting leaks from a leachate pond liner system within 24-hours.

An action leakage rate (ALR) of 20 gallons per acre per day (gpad) was established for the leachate pond. This is the standard action leakage rate value used by the U.S.EPA and the MEDEP. The ALR represents the minimum rate of leakage that will trigger interaction between the landfill owner and the MEDEP to determine the appropriate response action for the leakage.

### Monitoring Frequency

The total flows will be obtained daily from a flow meter installed on the discharge lines for the leak detection system. Leak detection water quality samples will be collected during the regular water quality sampling rounds three times per year. The water quality samples of the leak detection sump will be collected using a peristaltic pump. The data will be incorporated into the submittals to the MEDEP.

### Reporting Procedures

The landfill operator will submit a yearly report presenting all of the data collected during the preceding year and any recommended changes to the monitoring program, such as adjustments of the UAL values.

### Response Actions

The landfill operator will record daily flow measurements from the leak detection discharge pipe and notify the MEDEP within 5 working days of obtaining four consecutive readings suggesting primary liner seepage is in exceedance of ALR. As weather conditions allow, the landfill operator will drain the leachate pond and visually inspect the liner and repair damaged areas within 15 days and no more than 30 days after notifying the MEDEP. If the visual inspection and subsequent repairs fail to reduce the seepage rate below the ALR, the landfill operator will consult with the MEDEP regarding other remedial measures.

The landfill operator will prepare a report summarizing the results of the inspection and repairs and submit it to the MEDEP for its review. The report will contain recommendations for continuation of the sampling program.<sup>1</sup>

---

<sup>1</sup> The leak detection calculations were transmitted in a letter to MEDEP (Lou Pizzuti) dated May 17, 2006.

**APPENDIX E**

**POST-CLOSURE COST ESTIMATE**



4 Blanchard Road, P.O. Box 85A  
Cumberland, ME 04021  
Tel: 207.829.5016

Project Name: *Dolby Landfill Post Closure Cost Estimate*  
Project Location: *East Millinocket, Maine*  
Project No.: *240002.05*

By: *TJM*  
Date: *12/23/2024*  
Checked By: *NMT*  
Date: *4/2/2025*

**OPINION OF POST CLOSURE COST**

**OPINION OF POST-CLOSURE COST**

ITEM	DESCRIPTION	YEARS	COST/YEAR	ESTIMATED TOTAL COST
<b>1. LANDFILL MAINTENANCE COSTS</b>				
a.	<b>General Site Repairs and Maintenance</b>			
	<i>Required repairs will include erosion repairs of the cover system, siltation removal from the stormwater conveyance system, surface repairs to the roads, and culvert maintenance every year.</i>	1-15	\$ 2,200.00	\$ 11,000.00
		15-30	\$ 2,200.00	\$ 44,000.00
b.	<b>Mowing</b>			
	<i>Approximately 133 acres of the landfill facility will require mowing. Mowing will occur once every other year. Trimming trees along leachate transport pipeline every 5 years.</i>	1-30	\$ 22,600.00	\$ 339,000.00
c.	<b>Snow Removal</b>			
	<i>Road maintenance during the winter months will include plowing, sanding, and shoveling</i>	1-30	\$ 6,200.00	\$ 186,000.00
d.	<b>Gas Control System</b>			
	<i>This item provides for the replacement of one gas vent riser every 2 years. The cost will include repairs to the geomembrane and documentation of the repairs.</i>	1-30	\$ 1,500.00	\$ 22,500.00
e.	<b>Groundwater Monitoring System</b>			
	<i>This item provides the cost to replace two monitoring wells over the 30-year post-closure period. The cost includes drilling, installation, development, and documentation.</i>	1-30	\$ 17,700.00	\$ 17,700.00
		<b>SUBTOTAL LANDFILL MAINTENANCE = \$</b>		<b>620,200.00</b>
<b>2. LANDFILL INSPECTIONS</b>				
a.	<b>Independent Engineering Firm</b>			
	<i>Cost associated with this item assumes "local" inspections performed once per week during 30-year post-closure period. Includes three annual site visits by an independent engineering firm.</i>	1-15	\$ 34,000.00	\$ 782,000.00
		15-30	\$ 34,000.00	\$ 782,000.00
b.	<b>Geotechnical Inspections</b>			
	<i>Includes aerial survey every fifth year for 30-year post-closure to evaluate landfill settlement.</i>	1-15	\$ 2,200.00	\$ 6,600.00
		15-30	\$ 2,200.00	\$ 6,600.00
		<b>SUBTOTAL INSPECTION COST = \$</b>		<b>1,577,200.00</b>
<b>3. LEACHATE MANAGEMENT</b>				
a.	<b>General Cost</b>			
	<i>General cost associated with general repairs and maintenance to the pump station structure, pumps, fittings, valves, meters, and lighting.</i>	1-30	\$ 1,600.00	\$ 48,000.00
b.	<b>Leachate Pipe Flushing and Leachate Pond Maintenance</b>			
	<i>This item includes cost to perform inspection and repair/maintenance of air release valves, pipeline cleaning, pond cleaning, and pump rebuilding/maintenance every third year during post closure period. This annual cost is expected to become lower as leachate flows from landfill diminishes and the need for pipeline and pump capacity are reduced.</i>	1-15	\$ 166,000.00	\$ 830,000.00
		15-30	\$ 166,000.00	\$ 830,000.00
		<b>SUBTOTAL LEACHATE MANAGEMENT = \$</b>		<b>1,708,000.00</b>
<b>4. ENGINEERING DESIGN SUPPORT</b>				
	<i>Cost associated with engineering design support includes oversight of subcontractors, interaction with owner and regulatory agencies, quality control, project management, and administration.</i>	1-15	\$ 13,000.00	\$ 195,000.00
		15-30	\$ 13,000.00	\$ 195,000.00
		<b>SUBTOTAL ENGINEERING DESIGN SUPPORT = \$</b>		<b>390,000.00</b>
<b>4. Gas Monitoring &amp; Water Quality Monitoring, Testing, and Reporting</b>				
	<i>Costs associated with water quality monitoring, testing, and reporting include field sampling, laboratory analysis, reporting, equipment cost, mileage, hotel, and meal cost and miscellaneous materials cost. This item also includes gas monitoring that will coincide with the water quality sampling. The water sampling will be at a rate of two times a year for the first five years and once per year for a reduced number of wells and parameters for the next twenty five years.</i>	1-5	\$ 60,000.00	\$ 300,000.00
		6-30	\$ 30,000.00	\$ 750,000.00
		<b>SUBTOTAL GAS AND WATER QUALITY MONITORING = \$</b>		<b>300,000.00</b>
		<b>TOTAL POST CLOSURE MONITORING AND MAINTENANCE COST - 30 YEARS = \$</b>		<b>4,595,400.00</b>

Notes:

- All values are in 2024 dollars. Does not include electrical costs for the leachate transport pipeline and the leachate treatment at municipally owned wastewater treatment plant in East Millinocket. All costs are estimated average annual costs.
- New leachate pumps average cost \$40,000. Pumps typically last 20 years. Replacement cost for pumps are considered unforeseen.
- Actual costs may vary.
- Assumes no additional cover upgrade projects to occur in 30-year post-closure period. If Dolby II receives an upgrade to the existing cover, monitoring and maintenance costs may increase for the duration of the cover upgrade project.