

F.H.W.A. DIST. NO.	STATE	PROJECT NUMBER	SHEET NO.	TOTAL SHEETS
1	MAINE	12-295-3(94)50	1	130
		12-295-3(106)50		

STATE OF MAINE
DEPARTMENT OF TRANSPORTATION



PORTLAND
CUMBERLAND COUNTY
MAINE FEDERAL AID INTERSTATE
PROJECT NO. IR - 295 - 3(94)50
LIGHTING
AND
WIDENING OF TUKEY'S BRIDGE
PROJECT LENGTH 0.096 MILES

AND

PROJECT NO. IR-295-3(106)50
A GRADING, DRAINAGE, BASE, AND PAVEMENT PROJECT
PROJECT LENGTH = 0.0 MILES

CONVENTIONAL SIGNS

COUNTY LINES	TRAVELLED WAY - PROPOSED
TOWN LINES	UNDERGROUND UTILITIES - EXISTING
PROPERTY LINES	UNDERGROUND UTILITIES - PROPOSED
R/W LINES - EXISTING	RAILROAD - SINGLE TRACK
R/W LINES - NEW - ACCESS CONTROL	RAILROAD - DOUBLE TRACK
R/W LINES - NEW - NO ACCESS CONTROL	UTILITY POLE - EXISTING
CULVERT - EXISTING	UTILITY POLE - JOINT OCCUPANCY
CULVERT - PROPOSED	PROPOSED UTILITY POLE - TEMPORARY
CURBING - EXISTING	PROPOSED UTILITY POLE - PERMANENT
CURBING - PROPOSED	TREES
TRAVELLED WAY - EXISTING	WOODS

SPECIFICATIONS

DESIGN: Load Factor Design per AASHTO Standard Specifications for Highway Bridges 1983.
CONTRACT: State of Maine, Department of Transportation, Standard Specifications, Highways and Bridges, Revision of January 1984.

DESIGN LOADING

LIVE LOAD: HS 25
STRESS CYCLES: 500,000 (lane), 2,000,000 (truck)

MATERIALS

CONCRETE:
Seals: Class S
All Others: Class A
REINFORCING STEEL: ASTM A615, Grade 60
STRUCTURAL STEEL: All Materials: ASTM A36
High Strength Bolts: ASTM A325, Type I

BASIC DESIGN STRESSES

CONCRETE: $f'_c = 3,000$ psi.
REINFORCING STEEL: $f_y = 60,000$ psi.
STRUCTURAL STEEL: ASTM A36: $F_y = 36,000$ psi.
ASTM A325: $F_y = 25,000$ psi.

Plans of the existing bridge are available for the Contractor's reference at the Bridge Design Office in Augusta. The plans are reproductions of original drawings as prepared for the construction of the bridge and it is very unlikely that the plans will show any construction field changes or any alterations which may have been made to the bridge during its life span.


COAST GUARD PERMIT NO. TO BE SUPPLIED LATER

TRAFFIC DATA

A.D.T. 1985 54,280
A.D.T. 2005 67,480
D.H.V. 7,423
T(%) 8(%)
D(%) 60(%)
V 50 MPH
18 KIPS 1,277

NOTE

All work contemplated under this contract to be governed by and in conformity with the STANDARD SPECIFICATIONS (revision of January 1984) and supplements thereto, except as modified on the plans and in the special provisions.

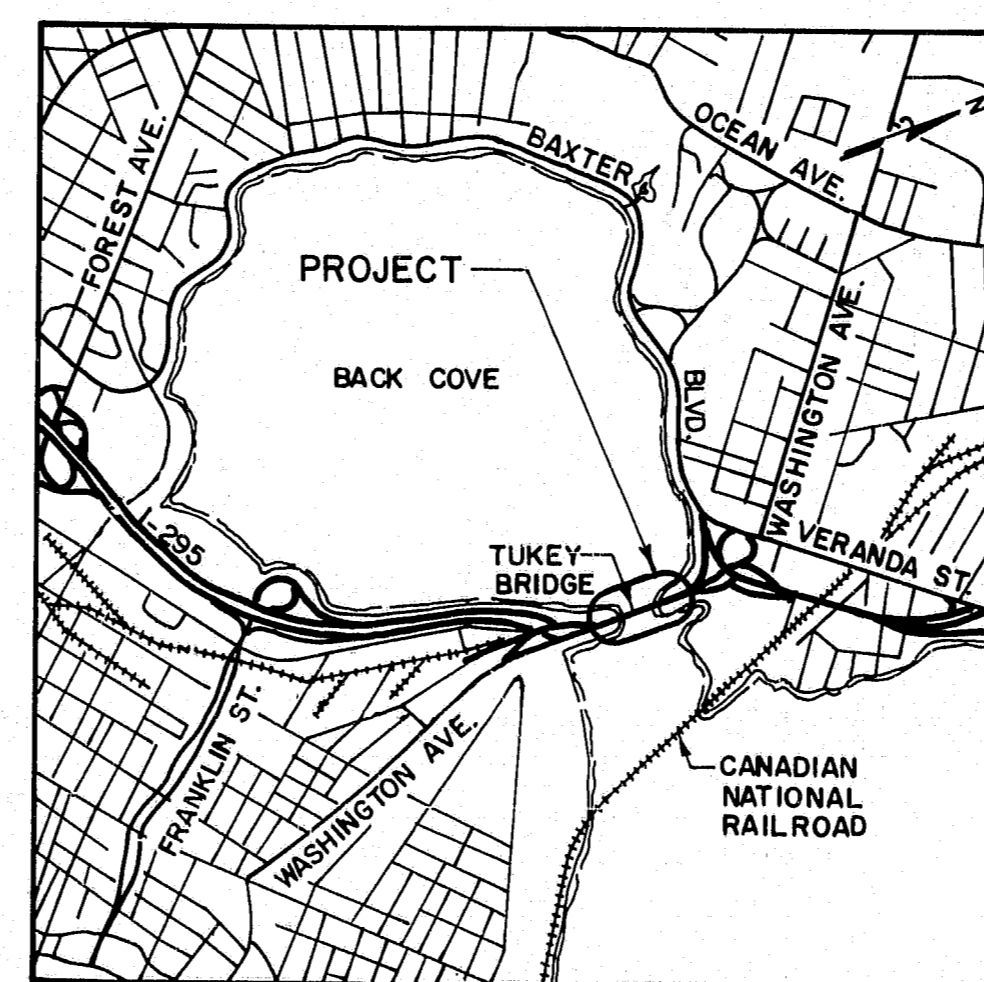

LOCATION MAP

INDEX OF SHEETS

SHEET NO.	DESCRIPTION
1	TITLE
2	ESTIMATED QUANTITIES
3-5	R.O.W. PLANS
	IR-295-3(94)50 (TUKEY'S BRIDGE)
6	PLAN & ELEVATION
7	TYPICAL SECTION & NOTES
8-11	SUBSURFACE SOILS DATA
12	SUBSTRUCTURE LAYOUT & SLAB ELEVATION
13	ABUTMENT 1 - PLAN, ELEVATION & WINGWALLS
14	ABUTMENT 2 - PLAN, ELEVATION & WINGWALLS
15	ABUTMENT DETAILS & PIPE LAYOUT
16	PIERS - NORTHBOUND
17	PIERS - SOUTHBOUND
18	STRUCTURAL STEEL - FRAMING PLAN, SPLICES, STIFF, CONN.
19	STRUCTURAL STEEL - GIRDER ELEVATIONS & CAMBER
20	STRUCTURAL STEEL - UTILITY HANGERS
21	SUPERSTRUCTURE - SLAB PLAN
22	SUPERSTRUCTURE - TRANSV. SECTION DETAILS
23	NAVIGATION LIGHTING
24	APPROACH SLAB & BIKEWAY AT ABUTMENTS
25	SEQUENCE OF CONSTRUCTION
26-29	REINFORCING STEEL SCHEDULES
30-39	BRIDGE STANDARD DETAILS
40-43	LIGHTING PLANS
44-47	LIGHTING STANDARD DETAILS
	IR-295-3(106)50 (GRAD., DRAIN., BASE, & PAVT)
48	KEY PLAN, LEGEND & GENERAL NOTES
49-50	TYPICAL SECTIONS
51	DRAINAGE SUMMARY
52-51	STANDARD DETAILS
62, 63	CONSTRUCTION PHASING PLANS
64	ADVISORY SIGNING PLAN
65-68	INITIAL TRAFFIC PLANS
69, 70, 71	INTERMEDIATE TRAFFIC PLANS
71, 72	FINAL TRAFFIC PLANS
73	ADVISORY SIGN SUMMARY
74, 75	SIGN SUMMARY
76	SIGN ASSEMBLY & DETAILS
77	SIGN TRUSS ERECTION DETAILS
78	FOUNDATION DETAILS FOR HIGH MAST LIGHTING
79	BRIDGE DEMOLITION PLAN
80, 81	CONSTRUCTION BASELINE GEOMETRY PLANS
82-91	GENERAL CONSTRUCTION PLANS
92	B & M ACCESS ROAD
93-97	GRADING AND DRAINAGE PLANS
98-99	PROFILES
100-130	CROSS SECTIONS

REVISD AS BUILT 1986 (HIGHWAY)
John R. Mangel 3-30-91
NOTE: THE MAJORITY OF THIS PROJECT (HIGHWAY) WAS REBUILT UNDER CONTRACTS I-295-3(95) & I-295-3(100)
J. Mangel

103-265

APPROVED: STATE OF MAINE
DEPARTMENT OF TRANSPORTATION
COMMISSIONER
6-5-85
CHIEF ENGINEER
6-5-85

WRIGHT-PIERCE
IN ASSOCIATION WITH
WILBUR SMITH & ASSOCIATES INC.
AMES ASSOCIATES
HALEY & ALDRICH INC.

UNITED STATES
DEPARTMENT OF TRANSPORTATION
FEDERAL HIGHWAY ADMINISTRATION
REGION 1
APPROVED: DIVISION ADMINISTRATOR DATE

REVISIONS 44 132 82355

ESTIMATED QUANTITIES					
ITEM NO.	DESCRIPTION	PROJECT NO. IR-295-3(04)50 QUANTITY	PROJECT NO. IR-295-3(06)50 QUANTITY	TOTAL QUANTITY	UNIT
201.23	REMOVING SINGLE TREES TOP ONLY	-	30	30	EACH
201.24	REMOVING STUMP	-	30	30	EACH
202.09	REMOVE EXISTING SIGN TRUSS	-	1	1	L.S.
202.127	REMOVE EXISTING BITUMINOUS PAVEMENT	-	1	1	L.S.
202.128	REMOVE CONCRETE CURBS AND SIDEWALKS	-	1	1	L.S.
202.191	REMOVE EXISTING BRIDGE - BAXTER BLVD.	-	1	1	L.S.
202.192	REMOVE EXISTING BRIDGE - PEDESTRIAN	-	1	1	L.S.
202.20	COMMON EXCAVATION	1525	8950	9875	C.Y.
202.24	COMMON BORROW	210	11940	12150	C.Y.
202.25	GRAVULAR BORROW	1450	2200	3650	C.Y.
202.26	GRAVEL BORROW	150	-	150	C.Y.
202.29	SELECTED GRAVULAR MATERIAL	-	750	750	C.Y.
206.061	STRUCTURAL EARTH EXCAV. DRAINAGE & MINOR STRUC. BELOW GRADE	310	30	340	C.Y.
206.081	STRUCTURAL EARTH EXCAVATION - ABUTMENTS	160	-	160	C.Y.
206.10	STRUCTURAL EARTH EXCAVATION - PIERS	815	-	815	C.Y.
206.161	TRENCH EXCAVATION & BACKFILL - STA. 191+00, 1-295	-	1	1	L.S.
206.162	TRENCH EXCAVATION & BACKFILL - STA. 161+00, 1-295	-	1	1	L.S.
206.17	PLANT MIX BIT. BASE COURSE - GRADILING B	-	1100	1100	TON
204.09	AGGREGATE BASE COURSE - CRUSHED TYPE A	-	210	210	C.Y.
204.101	AGGREGATE SUBBASE COURSE - GRAVEL	15	5300	5315	C.Y.
403.07	HOT BITUMINOUS PAVEMENT - GRADILING B	-	1030	1030	TON
403.08	HOT BITUMINOUS PAVEMENT - GRADILING C	1005	745	1750	TON
403.10	HOT BITUMINOUS PAVEMENT - GRADILING D	5	-	5	TON
403.11	HOT BITUMINOUS PAVEMENT - GRADILING E	-	50	50	TON
410.19	EMULSIFIED ASPHALT, APPLIED	-	500	500	GALLON
501.216	STEEL H-BEAM PILES, 73 LBS./FT.	5989	-	5989	L.F.
502.21	STRUCTURAL CONCRETE ABUTMENTS & RETAINING WALLS	225	-	225	C.Y.
502.23	STRUCTURAL CONCRETE PIERS	704	-	704	C.Y.
502.24	STRUCTURAL CONCRETE PIERS UNDERWATER	760	-	760	C.Y.
502.26	STRUCTURAL CONC. RDWAY & SIDEWALK SLAB ON STEEL BRIDGES	1	-	1	L.S.
502.31	STRUCTURAL CONCRETE APPROACH SLABS	1	-	1	L.S.
503.12	REINFORCING STEEL, FABRICATED & DELIVERED	300200	-	300200	LB.
503.13	REINFORCING STEEL, PLACING	300200	-	300200	LB.
504.10	STRUCTURAL STEEL FABRICATED & DELIVERED	1	-	1	L.S.
504.11	STRUCTURAL STEEL ERECTION	1	-	1	L.S.
505.08	SHEAR CONNECTORS	1	-	1	L.S.
506.141	FIELD PAINTING NEW STRUCTURAL STEEL	1	-	1	L.S.
506.142	FIELD PAINTING EXISTING STRUCTURAL STEEL	1	-	1	L.S.
506.16	SURFACE PREPARATION OF EXISTING STRUCTURAL STEEL	7900	-	7900	M.H.
507.092	ALUMINUM BRIDGE RAILING, 2-BAR	532	-	532	L.F.
507.096	ALUMINUM BRIDGE RAILING, PEDESTRIAN, W/PALES	539	-	539	L.F.
508.13	MEMBRANE WATERPROOFING	1	-	1	L.S.
511.0701	COFFERDAM PIER 1 NORTHBOUND	1	-	1	L.S.
511.0702	COFFERDAM PIER 2 NORTHBOUND	1	-	1	L.S.
511.0703	COFFERDAM PIER 3 NORTHBOUND	1	-	1	L.S.
511.0704	COFFERDAM PIER 1 SOUTHBOUND	1	-	1	L.S.
511.0705	COFFERDAM PIER 2 SOUTHBOUND	1	-	1	L.S.
511.0706	COFFERDAM PIER 3 SOUTHBOUND	1	-	1	L.S.
514.06	CURING BOX FOR CONCRETE CYLINDERS	1	-	1	EACH
515.21	PROTECTIVE COATINGS FOR CONCRETE SURFACES	1	-	1	L.S.
520.24	BRIDGE JOINT MODIFICATIONS	4	-	4	EACH
525.90	GRANITE MASONRY	2928	-	2928	S.F.
525.91	EXISTING GRANITE WALL REPAIR	1	-	1	L.S.
526.90	TEMPORARY CONCRETE BARRIER - TYPE 1	1070	4010	5080	L.F.
526.92	PERMEALANT CONCRETE BARRIER - TYPE 3	543	-	543	L.F.
526.93	RESET TEMPORARY CONCRETE BARRIER - TYPE 1	2040	3190	5230	L.F.
527.91	ENERGY ABSORBING SYSTEM, TEMPORARY	1	-	1	EACH
527.92	PORTABLE CRASH BARREL	50	-	50	BACH
528.155	12" RCP CLASS III	100	-	100	L.F.
528.156	15" RCP CLASS III	24	-	24	L.F.
528.157	18" RCP CLASS III	34	-	34	L.F.
528.158	21" RCP CLASS III	145	-	145	L.F.
528.159	24" RCP CLASS III	185	-	185	L.F.
528.160	CATCH BASIN TYPE B1	1	-	1	EACH
528.161	ALTERING CATCH BASIN	1	-	1	EACH
528.162	CATCH BASIN TYPE PG-C	1	-	1	EACH
528.163	CATCH BASIN TYPE AG-F	1	-	1	EACH

ESTIMATED QUANTITIES					
ITEM NO.	DESCRIPTION	PROJECT NO. IR-295-3(04)50 QUANTITY	PROJECT NO. IR-295-3(06)50 QUANTITY	TOTAL QUANTITY	UNIT
600.17	GUARD RAIL TYPE 3B - SINGLE RAIL	-	262.5	262.5	L.F.
600.39	GUARD RAIL DELINEATOR POST	-	4	4	EACH
600.96	GUARD RAIL REMOVED AND RESET	-	2883	2883	L.F.
600.96A	GUARD RAIL REMOVED AND STACKED	-	1172	1172	L.F.
601.23	CHAIN LINK FENCE GATE	-	1	1	EACH
601.24	REMOVE AND RESET FENCE	-	260	260	L.F.
601.243	REMOVE AND STACK FENCE	-	634	634	L.F.
601.36	BRACING ASSEMBLY TYPE I - CHAIN LINK FENCE - G.P.T.	-	4	4	EACH
601.37	BRACING ASSEMBLY TYPE II - CHAIN LINK FENCE - G.P.T.	-	9	9	EACH
601.38	VERTICAL BRIDGE CURB TYPE 1B	543	-	543	L.F.
601.39	VERTICAL BRIDGE CURB - SPECIAL	543	-	543	L.F.
601.31	CURB TYPE 3	-	450	450	L.F.
601.38	RESET CURB TYPE 1	-	320	320	L.F.
601.441	CURBING, REMOVED AND STACKED	-	3255	3255	L.F.
610.08	PLAIN RIPRAP	-	650	650	C.Y.
610.20	MORTARED SLOPE PAVING	-	75	75	S.Y.
610.15	RIPRAP - REMOVE AND RESET	-	415	415	C.Y.
610.16	HEAVY RIPRAP	2942	1000	3942	C.Y.
615.07	LOAM	110	850	960	C.Y.
616.08	SODDING	91	650	741	S.Y.
618.14	SEEDING METHOD NO. 2	20	132	152	UNIT
618.15	TEMPORARY SEEDING	15	103	118	LB.
619.12	MULCH	245	174	419	UNIT
620.50	FILTER FABRIC - WOVEN	16000	8050	24050	S.F.
620.111	PRECAST CONCRETE - JUNCTION BOX	2	-	2	EACH
620.112	PRECAST CONCRETE - JUNCTION BOX	1	-	1	EACH
620.71	METALLIC CONDUIT	235	-	235	L.F.
620.72	NON-METALLIC CONDUIT	111	-	111	L.F.
620.73	PREWIRED CONDUIT SECONDARY WIRING	2490	-	2490	L.F.
620.393	CONTROLLER CABINET FOUNDATION	2	-	2	EACH
620.361	REMOVE OR MODIFY CONCRETE FOUNDATION	59	-	59	EACH
620.362	MODIFY CONCRETE FOUNDATION	3	-	3	EACH
620.371	SPECIAL FOUNDATION - TOWER NO. 19	1	-	1	EACH
620.374	SPECIAL FOUNDATION - TOWER NO. 21	1	-	1	EACH
620.375	SPECIAL FOUNDATION - TOWER NO. 22	1	-	1	EACH
620.376	SPECIAL FOUNDATION - TOWER NO. 23	1	-	1	EACH
620.376	SPECIAL FOUNDATION - TOWER NO. 24	1	-	1	EACH
620.377	SPECIAL FOUNDATION - TOWER NO. 25	1	-	1	EACH
620.378	SPECIAL FOUNDATION - TOWER NO. 26	1	-	1	EACH
620.379	SPECIAL FOUNDATION - TOWER NO. 27	1	-	1	EACH
621.69	WHITE OR YELLOW PAVEMENT & CURB MARKING	-	115	115	S.F.
621.67	REMOVING PAVEMENT MARKINGS	724	2220	2944	S.F.
621.681	TEMP. & PAINTED PAVEMENT MARKING WHITE OR YELLOW	8850	25500	34350	L.F.
621.682	HIGHWAY LIGHTING SYSTEM	1	-	1	L.S.
624.164	LUMINAIRES FOR HIGH MAST LIGHTING	28	-	28	EACH
624.207	HIGH MAST LIGHT STANDARD	8	-	8	EACH
625.15	RETAINING WALL	1	-	1	L.S.
627.07	SPRINKLING	-	250	250	M.G.
628.02	CALCIUM CHLORIDE	-	25	25	TON
628.02	NAVIGATIONAL LIGHTS	1	-	1	L.S.
628.021	TEMPORARY NAVIGATIONAL LIGHTS	1	-	1	L.S.
629.18	FIELD OFFICE, TYPE A	1/2	1/2	1	EACH
629.21	TESTING FACILITIES, SOILS	1	-	1	L.S.
629.22	TESTING FACILITIES, BITUMINOUS MIXES	1	-	1	L.S.
643.71	TRAFFIC SIGNAL MODIFICATION	-	1	1	L.S.
643.103	DEMOLISH GUIDE SIGN	-	5	5	EACH
643.106	DEMOLISH REG. WARN., COURSE, & RTE. MARKER ASS. SIGN	-	52	52	EACH
643.113	REINSTALL GUIDE SIGN	-	4	4	EACH
643.116	REINSTALL REG. WARN., COURSE, & RTE. MARKER ASS. SIGN	-	6	6	EACH
643.121	OVERHEAD SIGN TRUSS	-	1	1	L.S.
643.201	DEMOLITABLE REFLECTORIZED DELINEATOR, SINGLE	-	38	38	EACH
652.90	FLASHING ARROW BOARD	-	2	2	EACH
652.91	TYPE 3 BARRICADE	-	71	71	EACH
652.92	DRUM	-	30	30	EACH
652.93	CONSTRUCTION SIGNS	-	4104	4104	S.F.
652.96	MAINTENANCE OF TRAFFIC CONTROL DEVICES	-	450	450	CAL. DAY
652.98	FLAGGERS	-	3600	3600	M.H.
656.03	TEMPORARY SILT FENCES	-	2200	2200	L.F.
657.14	SEEDING PITS	-	1.6	1.6	UNIT
659.10	MOBILIZATION	-	0.5	0.5	L.S.
660.21	OUT-THE-JOB TRAILING (BID)	1000	1000	4000	M.H.

SUMMARY OF EXCAVATION & BORROW					
COMMON EXCAVATION FOR ESTIMATE	BRIDGE CONTRACT	1975 CY			
CROSS SECTIONS		7891 CY			
BAXTER BLVD / BATES ST. INTERSECTION		150 CY			
WASHINGTON AVE. U.B. (WA-3) STRIATED STRIP		891 CY			
WASHINGTON AVE. S.B. (WA-2) MEDIAN		78 CY			
GRUBBLING		127 CY			
TOTAL COMMON EXCAVATION		9860 CY			
FILL FOR COMMON BORROW CALCULATIONS					
CROSS SECTIONS		20155 CY			
BAXTER BLVD / BATES ST. INTERSECTION		128 CY			
GRUBBLING		127 CY			
LIGHT FOUNDATIONS		465 CY			
TOTAL FILL		20875 CY			
AVAILABLE COMMON EXCAVATION FOR BORROW EXCAVATION					
(1) TOTAL COMMON EXCAVATION DEDUCTIONS:		127 CY			
GRUBBLING		127 CY			
(2) TOTAL DEDUCTIONS		127 CY			
TOTAL AVAILABLE COMMON EXCAV. (1) MINUS (2)		9733 CY			
TOTAL AVAILABLE STRUCTURAL EXCAVATION		307 CY			
TOTAL AVAILABLE NON-ROCK EXCAVATION		10040 CY			
COMPUTATION OF COMMON BORROW FOR ESTIMATE					
TOTAL FILL		20875 CY			
TOTAL AVAILABLE NON-ROCK EXCAV. 10040 * 0.85 =		8534 CY			
TOTAL FILL MINUS TOTAL AVAILABLE EXCAV.		12341 CY			
GRAV. BORROW IN LOW WET AREAS (SEWER AC. RD.)		1887 CY			
TOTAL FILL MINUS REG. GRAV. BOR. W/IN FILL		10454 CY			
COMMON BORROW = 10454 * 1.15 =		12022 CY			
COMPUTATION OF GRAVULAR BORROW FOR ESTIMATE					
GRAVULAR BORROW IN LOW WET AREAS (SEW. AC. RD.)		1887 CY			
GRAVULAR BORROW (BRIDGE)		461 CY			
GRAVULAR BORROW (LIGHT STANDARDS)		800 CY			
GRAVULAR BORROW = 3148 * 1.15 =		3621 CY			
COMPUTATION OF GRAVEL BORROW FOR ESTIMATE					
GRAVEL BORROW (BRIDGE CONTRACT) * 1.28 * 1.15 =		148 CY			
ESTIMATE OF LUMP SUM ITEMS					
502.26	STR. CONC., RDWAY & BIKEWAY SLABS	994 CY			
502.31	STR. CONC., APPROACH SLABS	39 CY			
504.10	STR. STEEL, FAB. & DELIVERY	1039 200 LB.			
504.11	STR. STEEL, STRUCTURE	5 016 LB.			
505.08	SHEAR COLLECTORS	3 016 LB.			
506.141	FIELD PAINTING NEW STR. STEEL	1039 200 LB.			
506.142	FIELD PAINTING EXIST. STR. STEEL	2000 000 LB.			
508.13	MEMBRANE WATERPROOFING	6 851 S.Y.			

REV.	DESCRIPTION	BY	DATE
ADD	ITEM 527.32	BWA	6-0-85
REVISE	QUANTITIES	BWA	6-0-85

STATE OF MAINE
DEPARTMENT OF TRANSPORTATION
1-295 PORTLAND


ESTIMATED QUANTITIES

SHEET 2 OF AUGUSTA, MAINE



103-266

DRAWING 44-132-457-10-1

F.W.A. REG. NO.	STATE	PROJECT NUMBER	SHEET NO.	TOTAL SHEETS
1	MAINE	103-267-3(95)	2	35

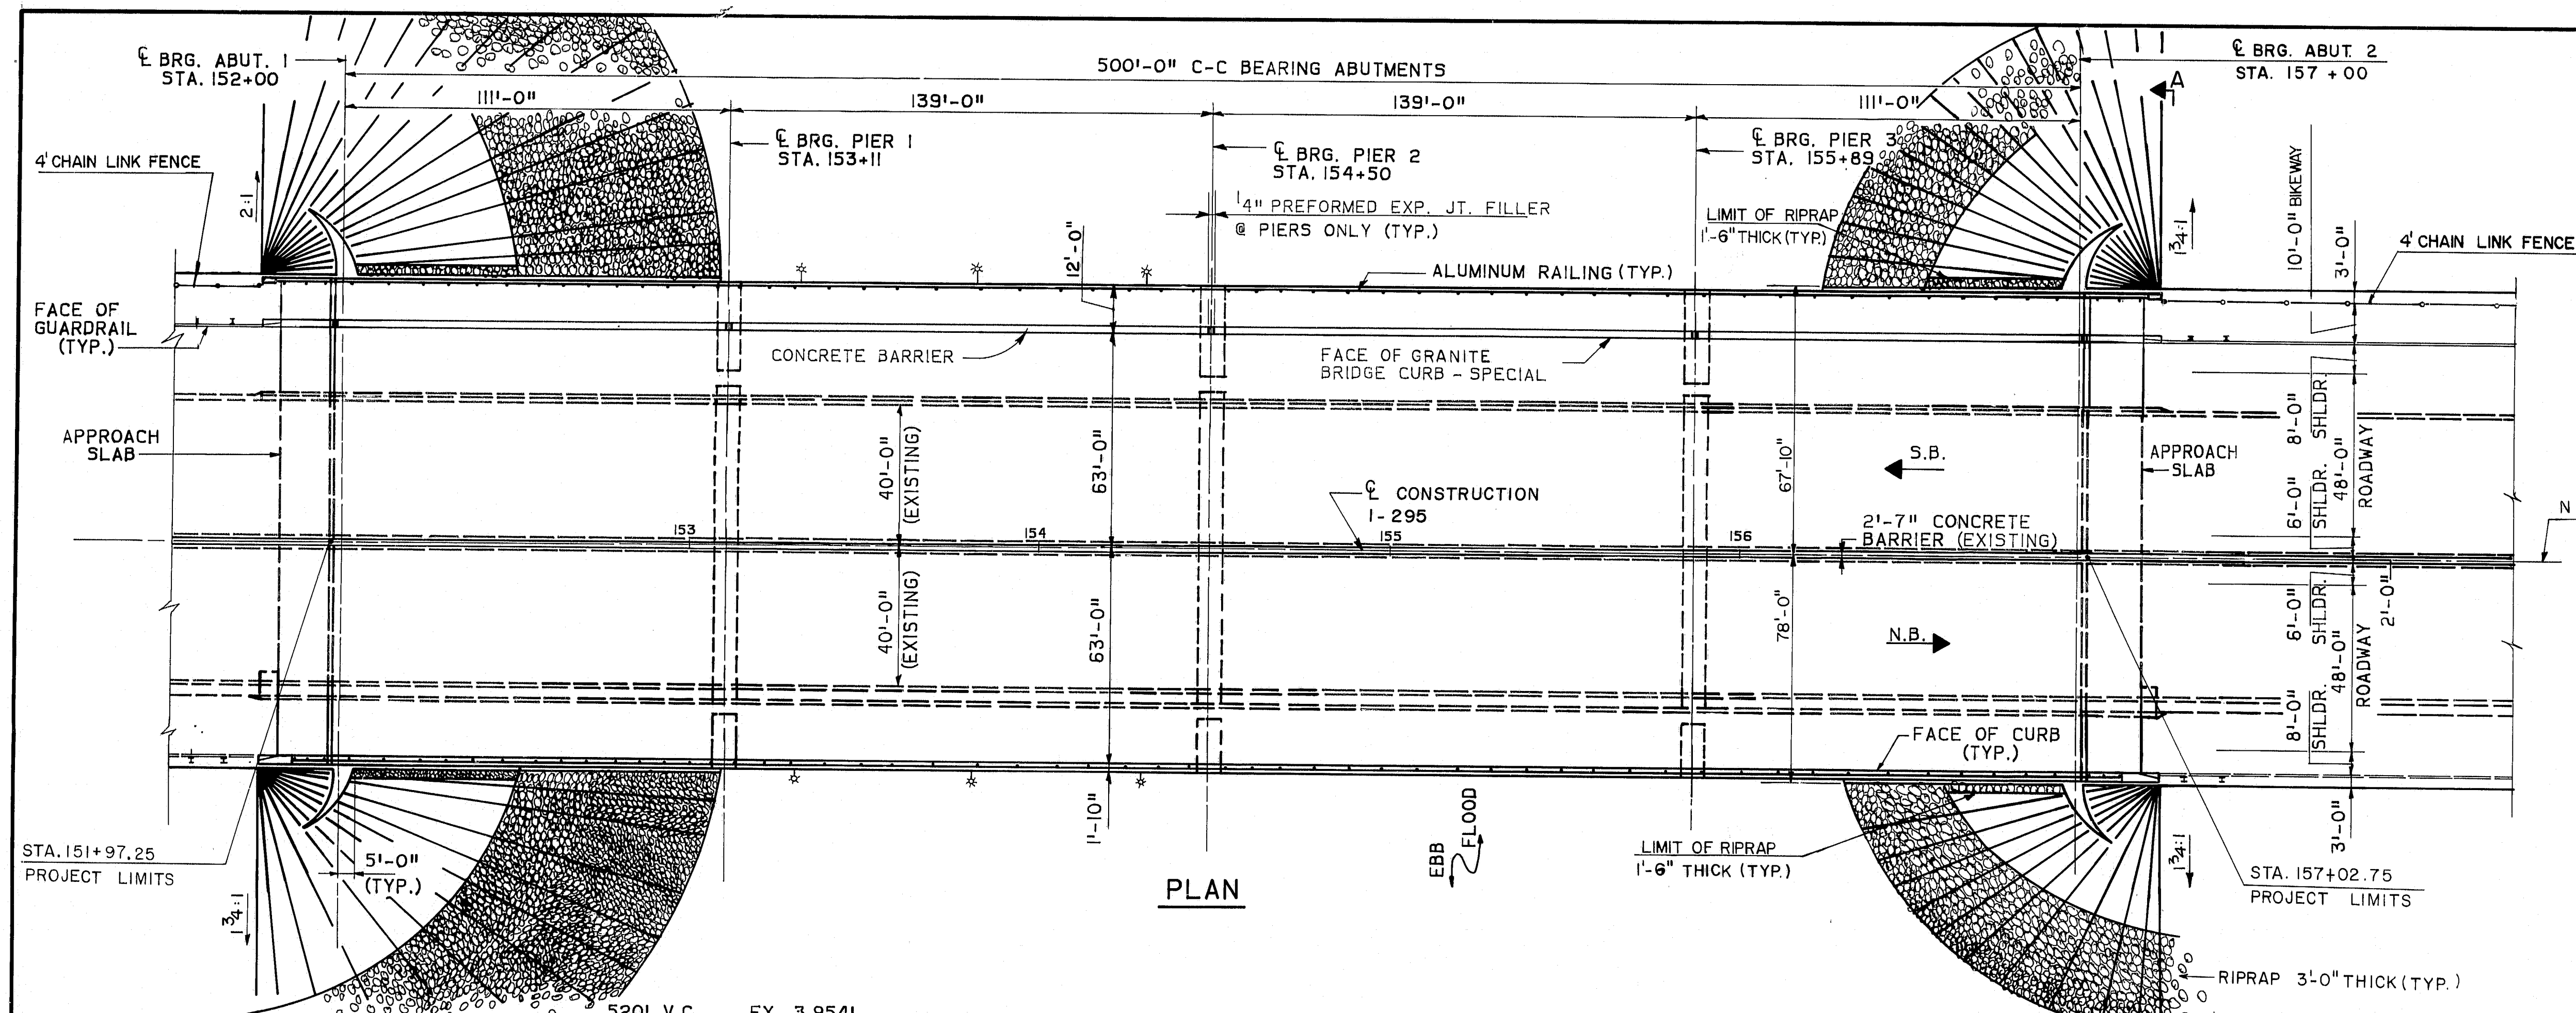

NOTE: FOR TRANSITION CURBS SEE HIGHWAY DRAWINGS.

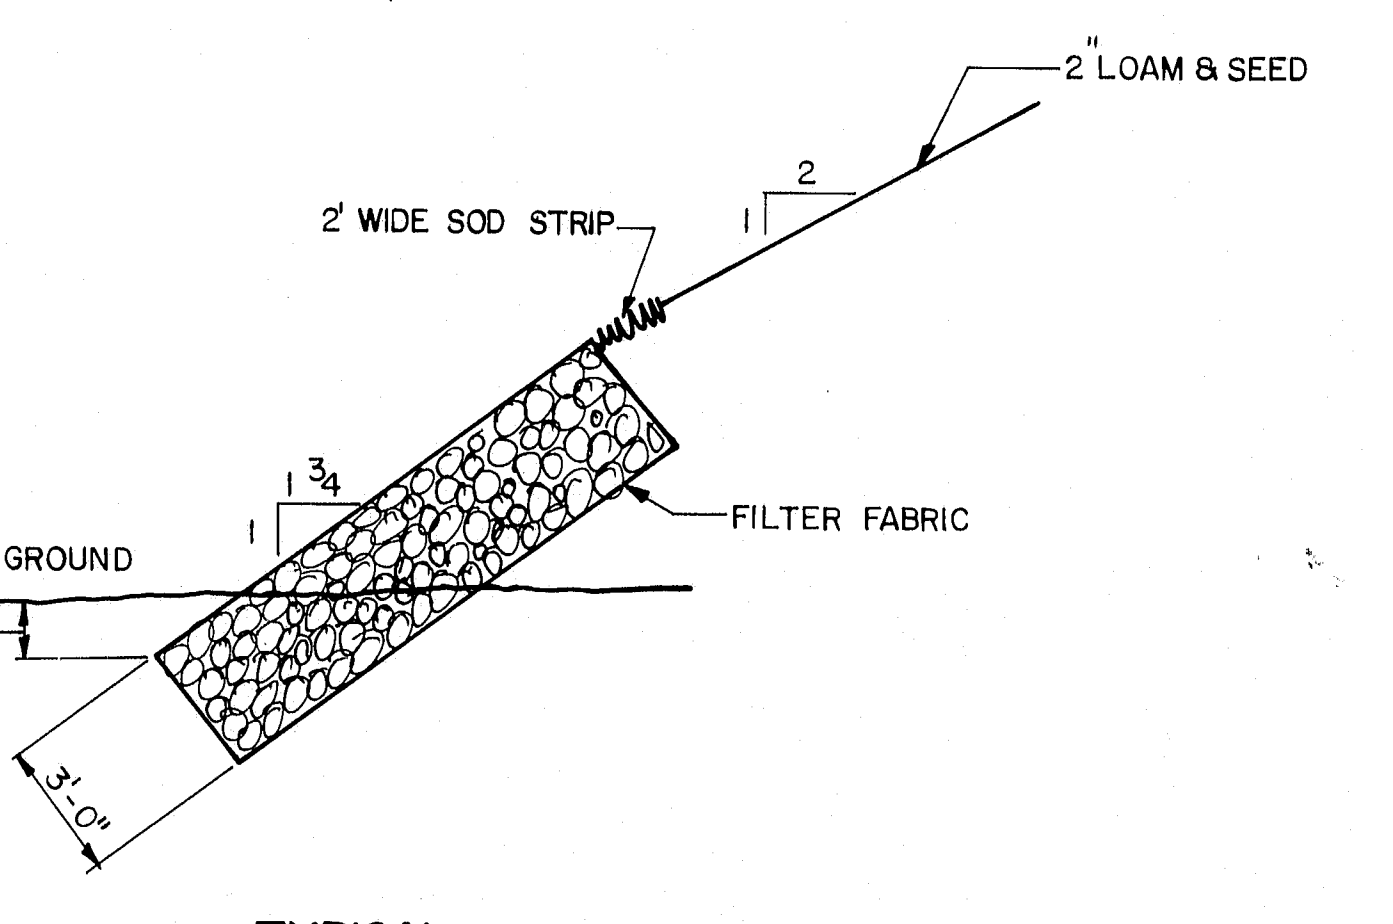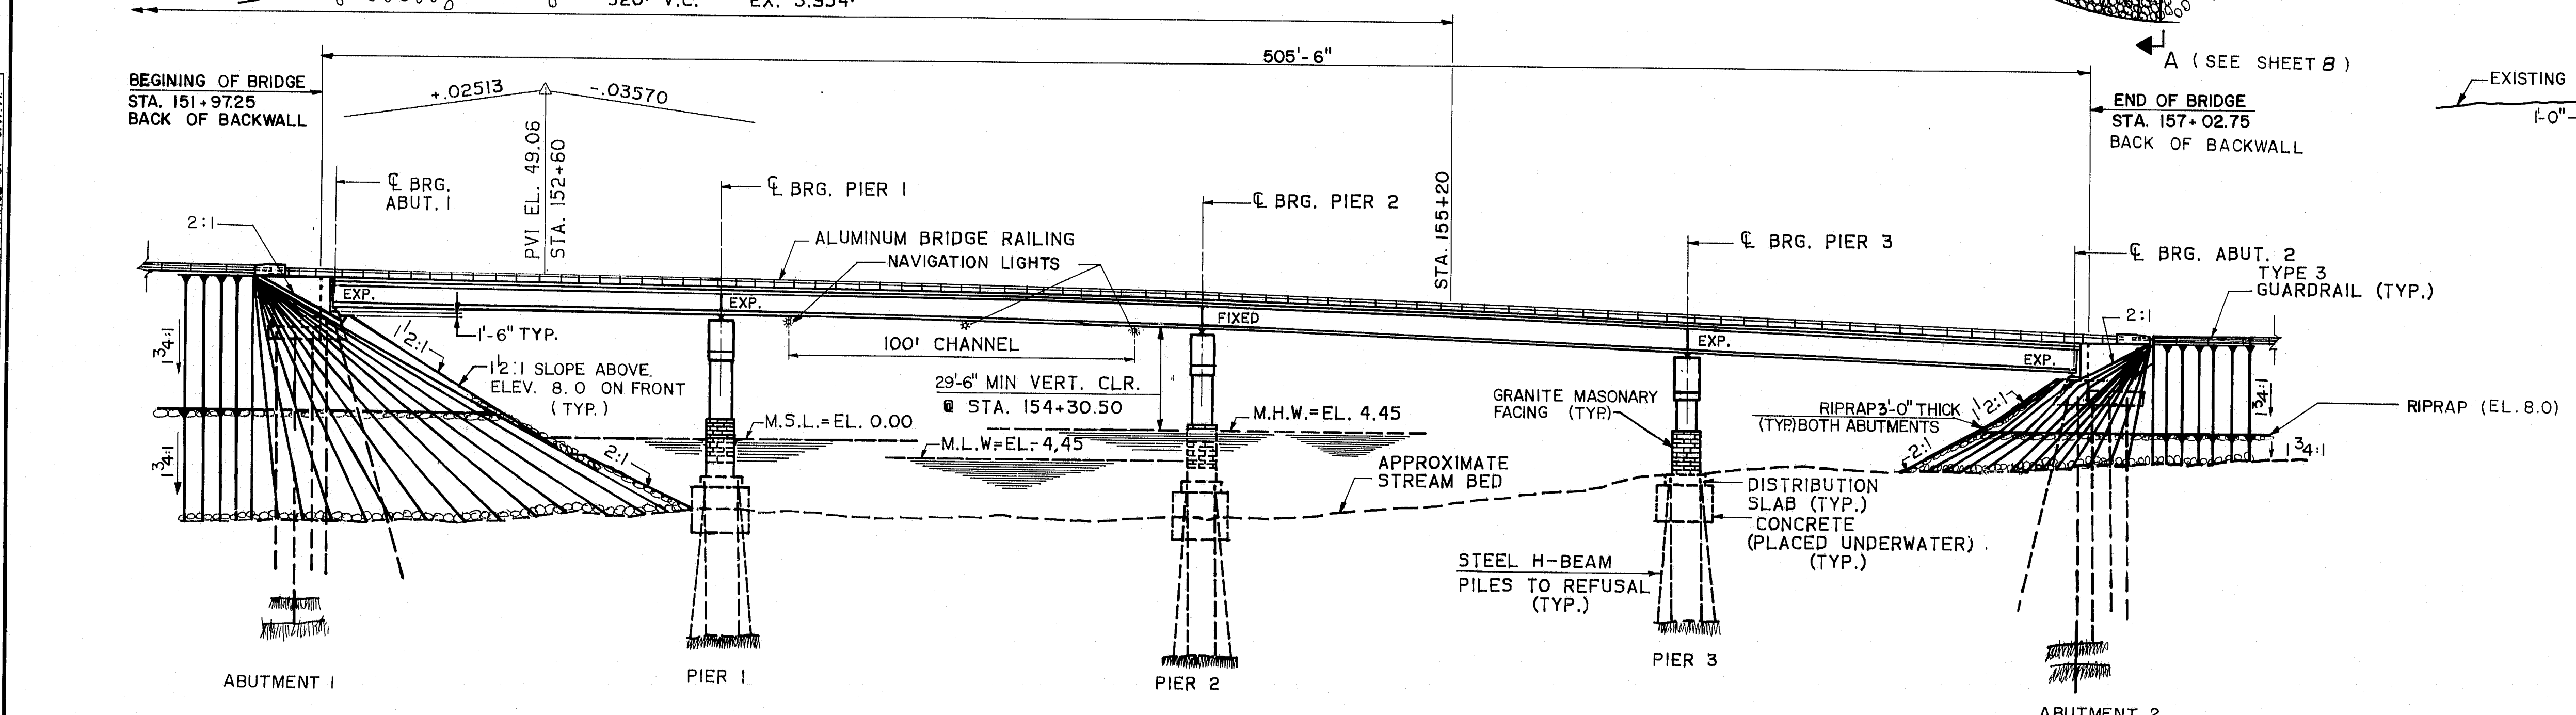

NOTE: TOP OF RIP-RAP EXTENDED TO ELEV. AT ABUT #1 & #2 EASTSIDE. THIS WORK DONE UNDER CONTRACT I-295-3(95)

103-267

PROJECT DESIGN	ENGINEER	DATE
DESIGN-DETAILED	A.F.	12/24/91
CHECKED	J.D.D.	2-85
REVISIONS		
FIELD CHANGES		


NOTE: RIPRAP BELOW EL. 8.0 SHALL TAPER FROM 2:1 AT THE FASCIA LINE TO 1:1 AT NORMAL TO CENTERLINE CONSTRUCTION.
RIPRAP BELOW EL. 8.0 IS HEAVY RIPRAP.
RIPRAP ABOVE EL. 8.0 IS PLAIN RIPRAP.

ELEVATION

COAST GUARD PERMIT NO.

STATE OF MAINE
DEPARTMENT OF TRANSPORTATION
1-295 INTERCHANGE COMPLEX
TUKEYS BRIDGE
OVER
BACK COVE
IN THE TOWN OF
PORTLAND
CUMBERLAND COUNTY
PLAN & ELEVATION
SHEET 2 OF 35 AUGUSTA, MAINE

F.W.A. DIST. NO.	STATE	PROJECT NUMBER	SHEET NO.	TOTAL SHEETS
	MAINE	IR-295-3004	7	130

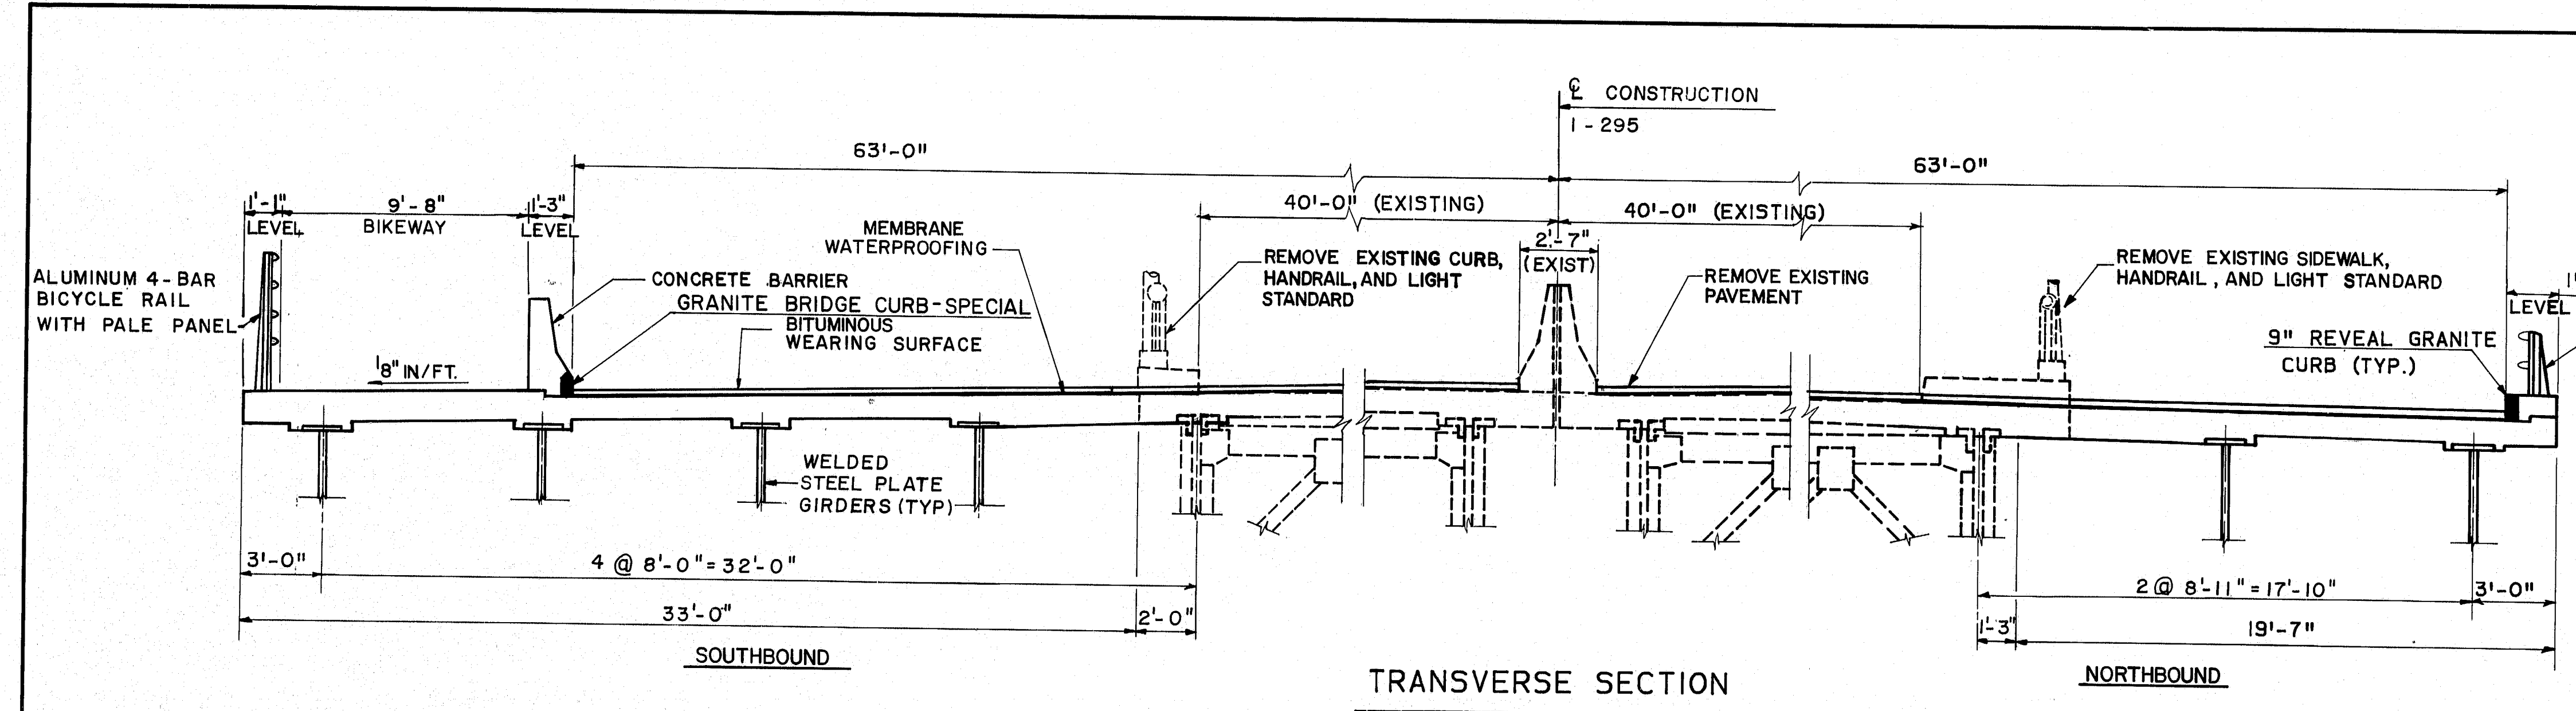

TRANSVERSE SECTION

SPECIFICATIONS

DESIGN: LOAD FACTOR DESIGN PER AASHTO STANDARD SPECIFICATIONS FOR HIGHWAY BRIDGES 1983.
 CONTRACT: STATE OF MAINE, DEPARTMENT OF TRANSPORTATION, STANDARD SPECIFICATIONS, HIGHWAYS AND BRIDGES, REVISION OF JAN. 1984.

DESIGN LOADING

LIVE LOAD: HS 25
 STRESS CYCLES: 500,000 (LANE), 2,000,000 (TRUCK)

MATERIALS


CONCRETE: SEALS CLASS S
 ALL OTHERS CLASS A
 REINFORCING STEEL: ASTM A615 GRADE 60.
 STRUCTURAL STEEL: ALL MATERIAL ASTM A36
 HIGH STRENGTH BOLTS ASTM A325, TYPE 1.

BASIC DESIGN STRESSES


CONCRETE: $f'_c = 3,000$ PSI.
 REINFORCING STEEL: $f_y = 60,000$ PSI.
 STRUCTURAL STEEL: ASTM A36 $F_y = 36,000$ PSI.
 ASTM A325 $F_v = 25,000$ PSI.

TRAFFIC DATA


AADT 1985 = 54,280
 AADT 2005 = 67,480
 DHV = 7,423
 T (%) = 8%
 D (%) = 60%
 V = 50 MPH
 18 KIPS = 1,277

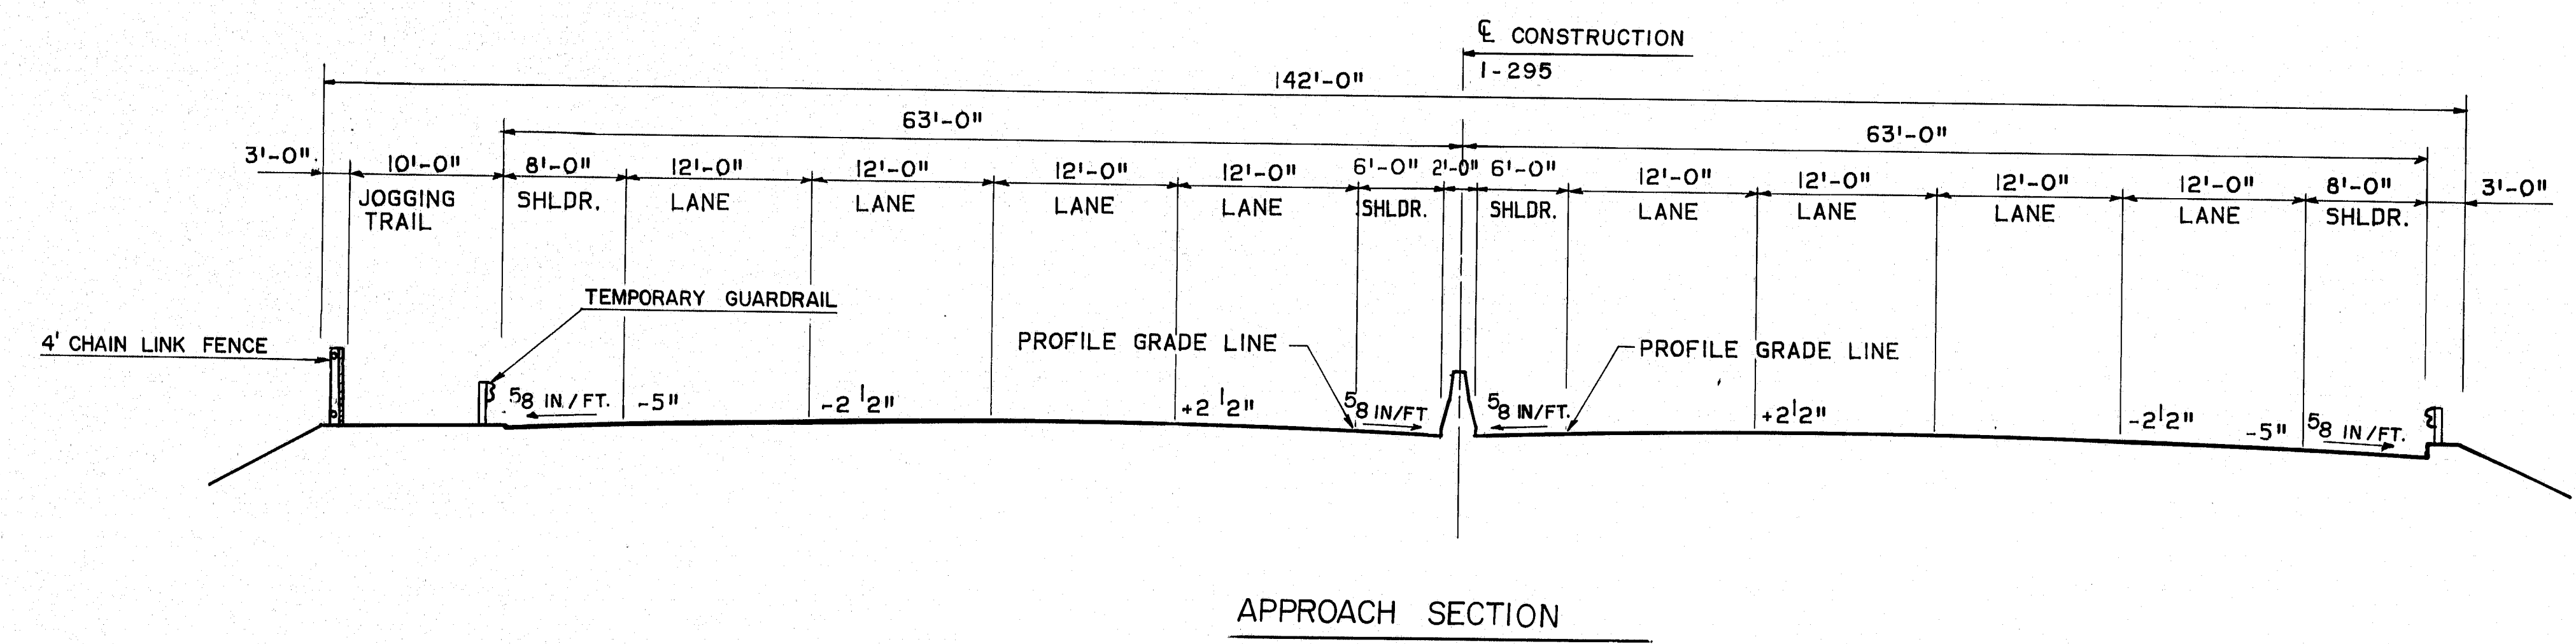

APPROACH SECTION

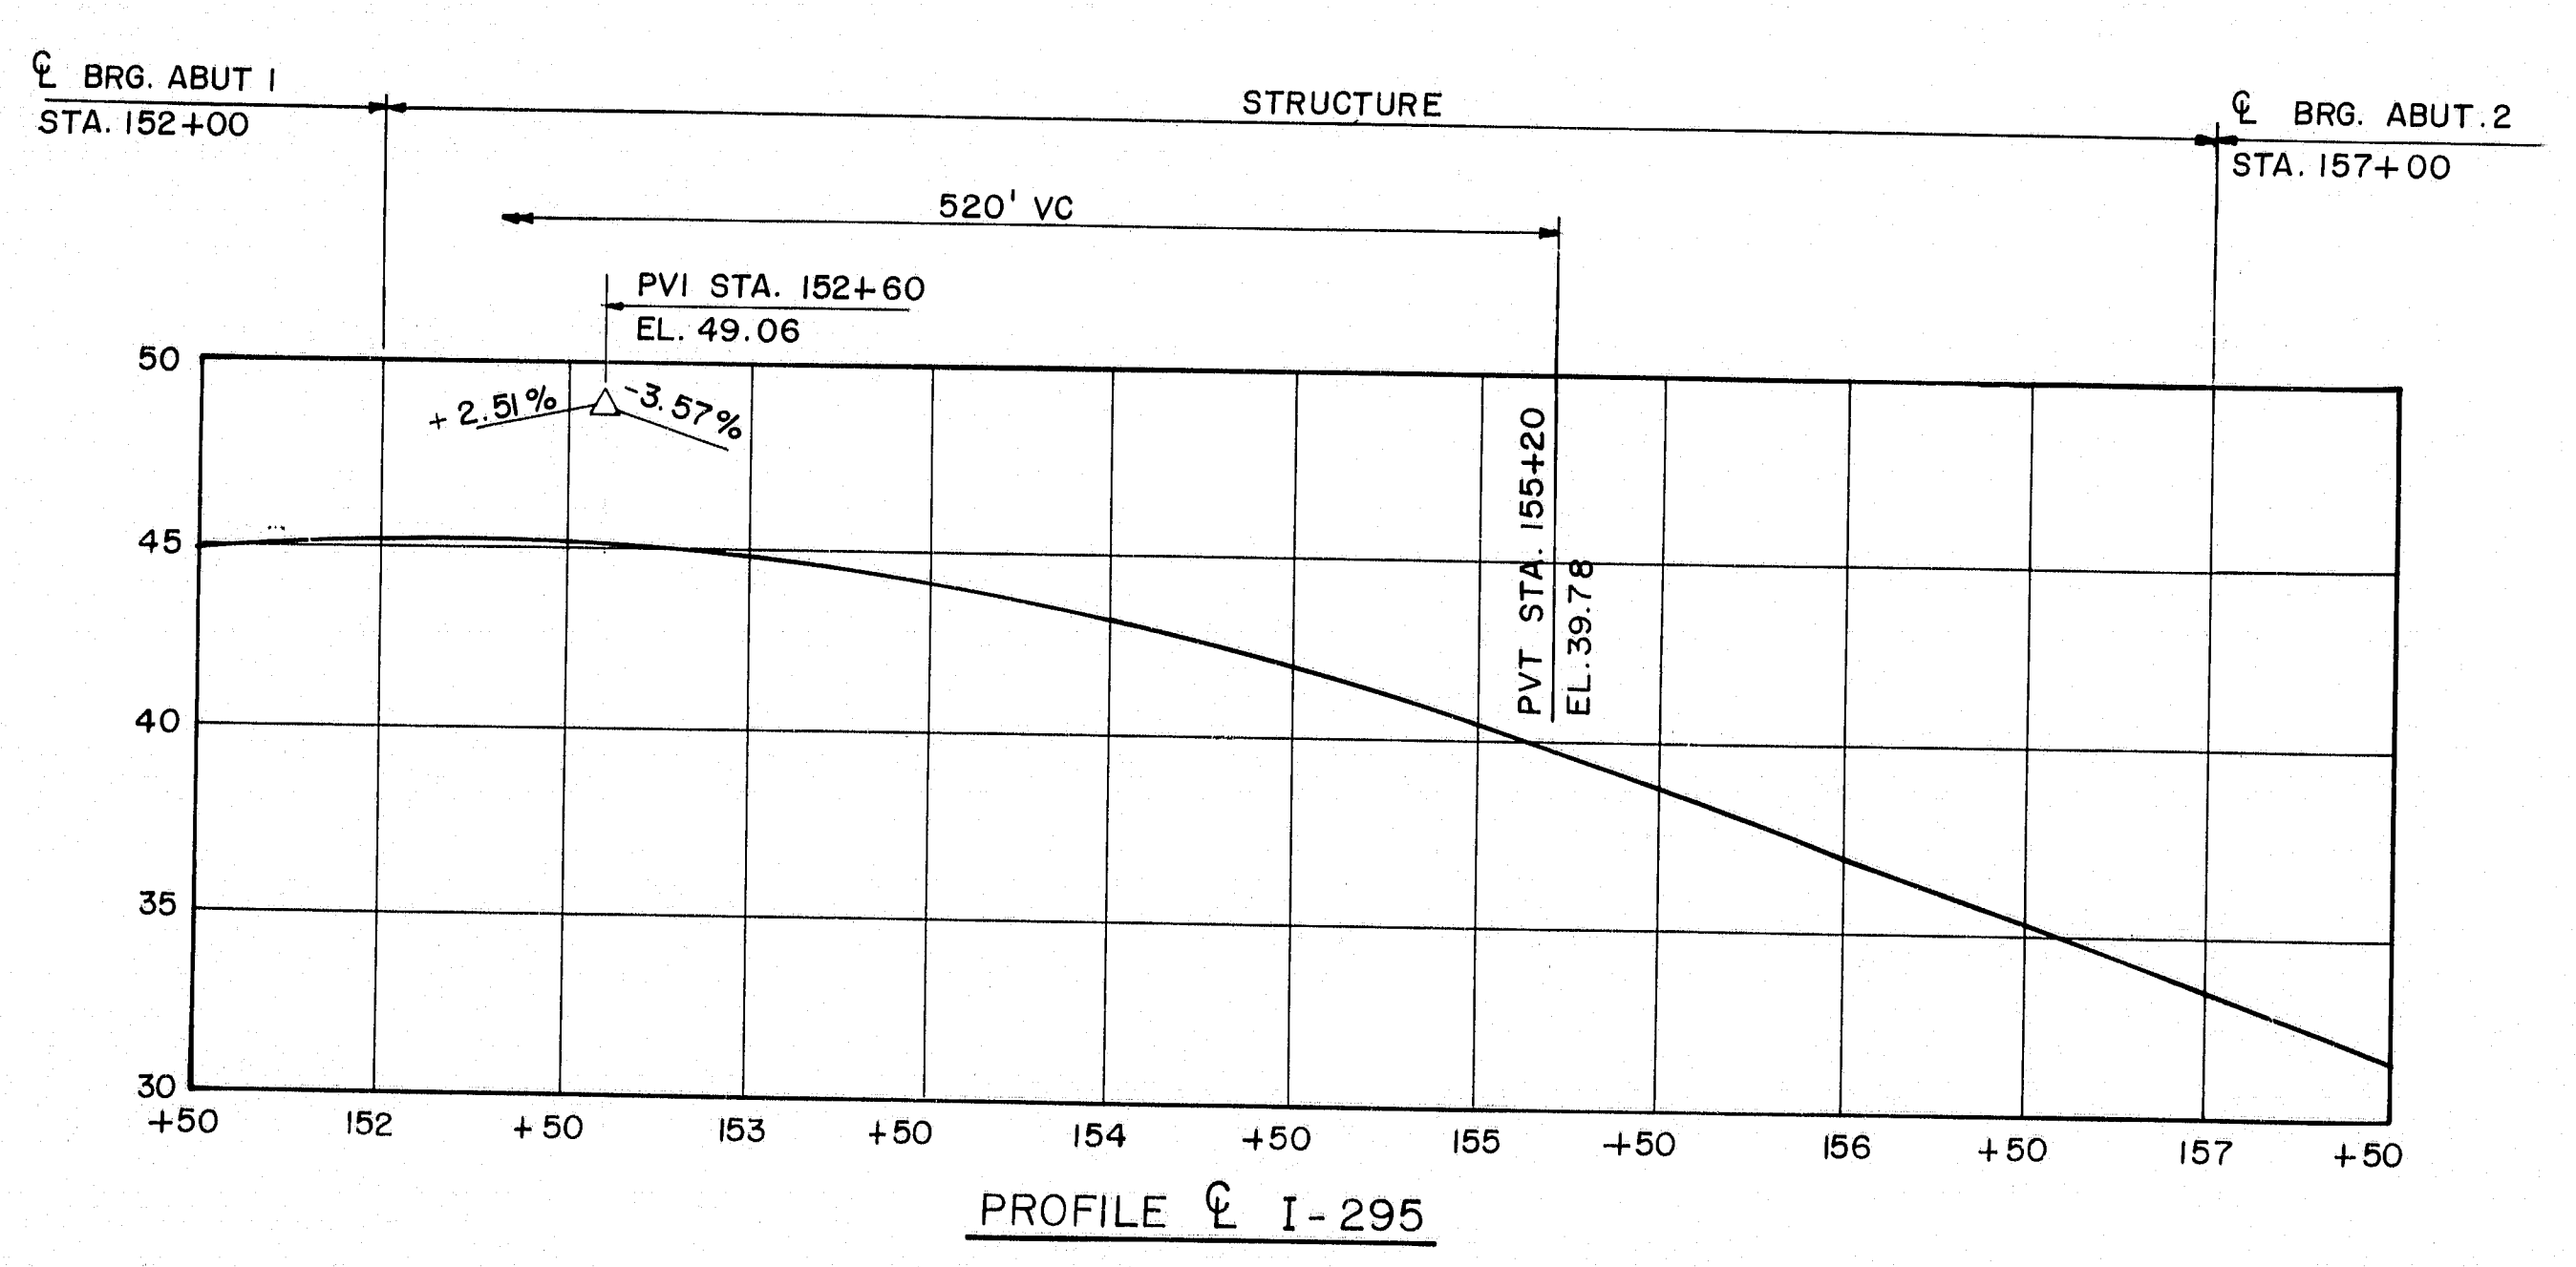

PROFILE I-295

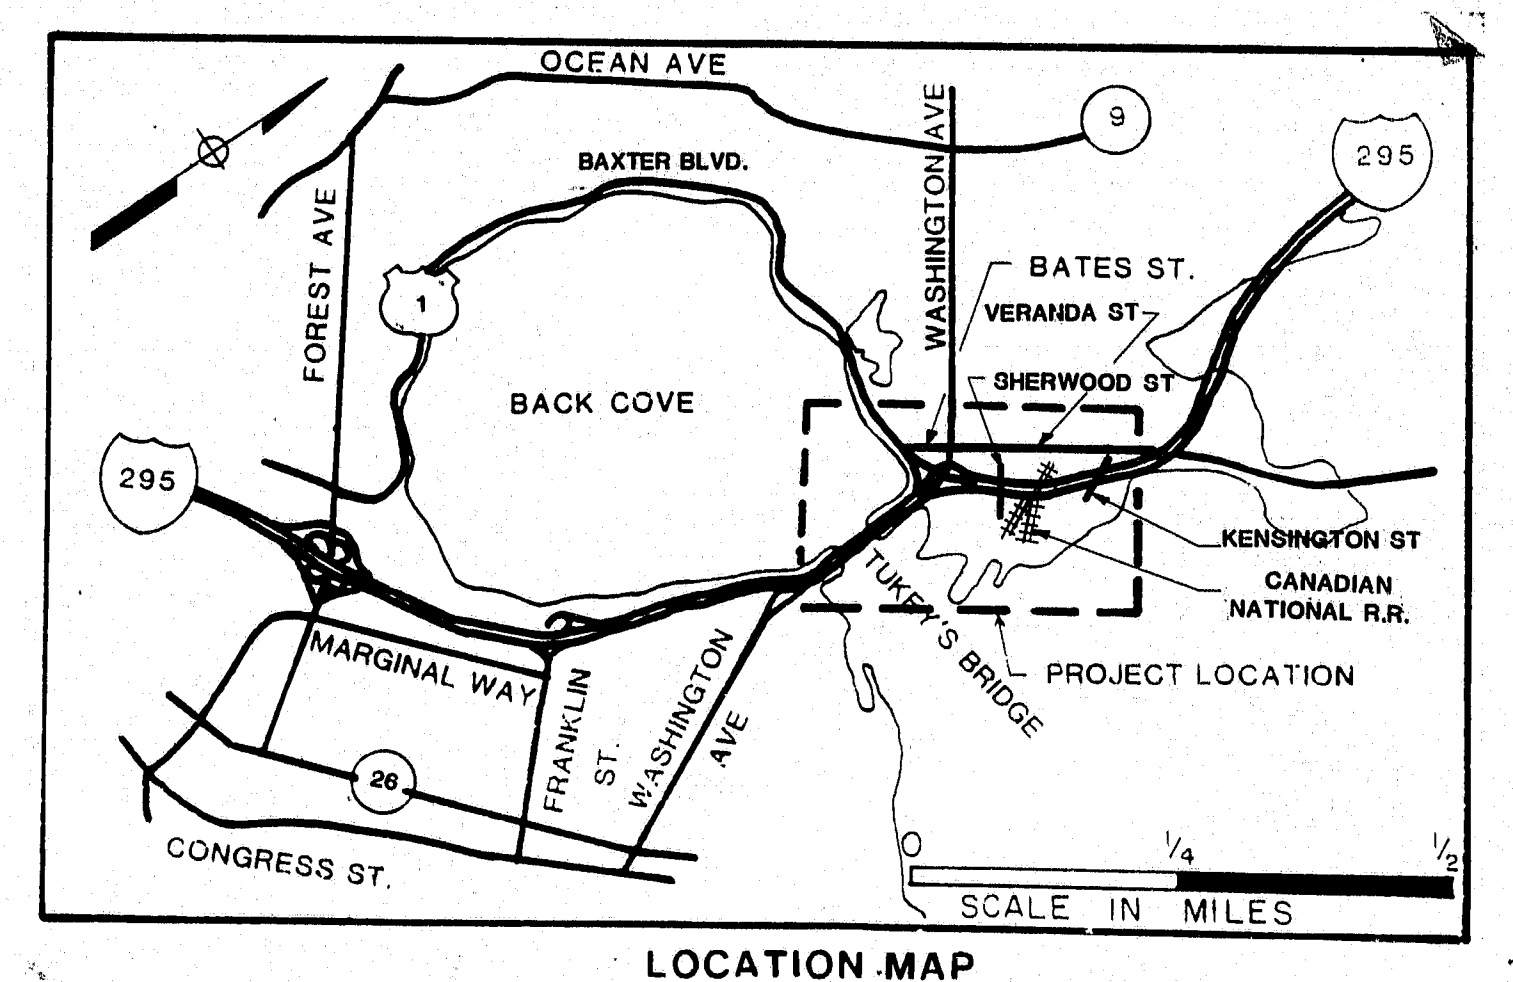

LOCATION MAP




103-268

STATE OF MAINE
 DEPARTMENT OF TRANSPORTATION
 I-295 INTERCHANGE COMPLEX
 TUKEYS BRIDGE
 OVER
 BACK COVE
 IN THE TOWN OF
 PORTLAND
 CUMBERLAND COUNTY
 TYPICAL SECTION
 SHEET 3 OF 35 AUGUSTA, MAINE

PROJECT DESIGN ENGINEER	AF	DATE	2/785
DESIGN - DETAILED	AF		
CHECKED	AH		
REVISIONS			
FIELD CHANGES			

IN CHARGE OF J.W.H.

F.W. R.A. REG. NO.	STATE	PROJECT NUMBER	SHEET NO.	TOTAL SHEETS
1	MAINE	IR-295-3(94)50	B	170

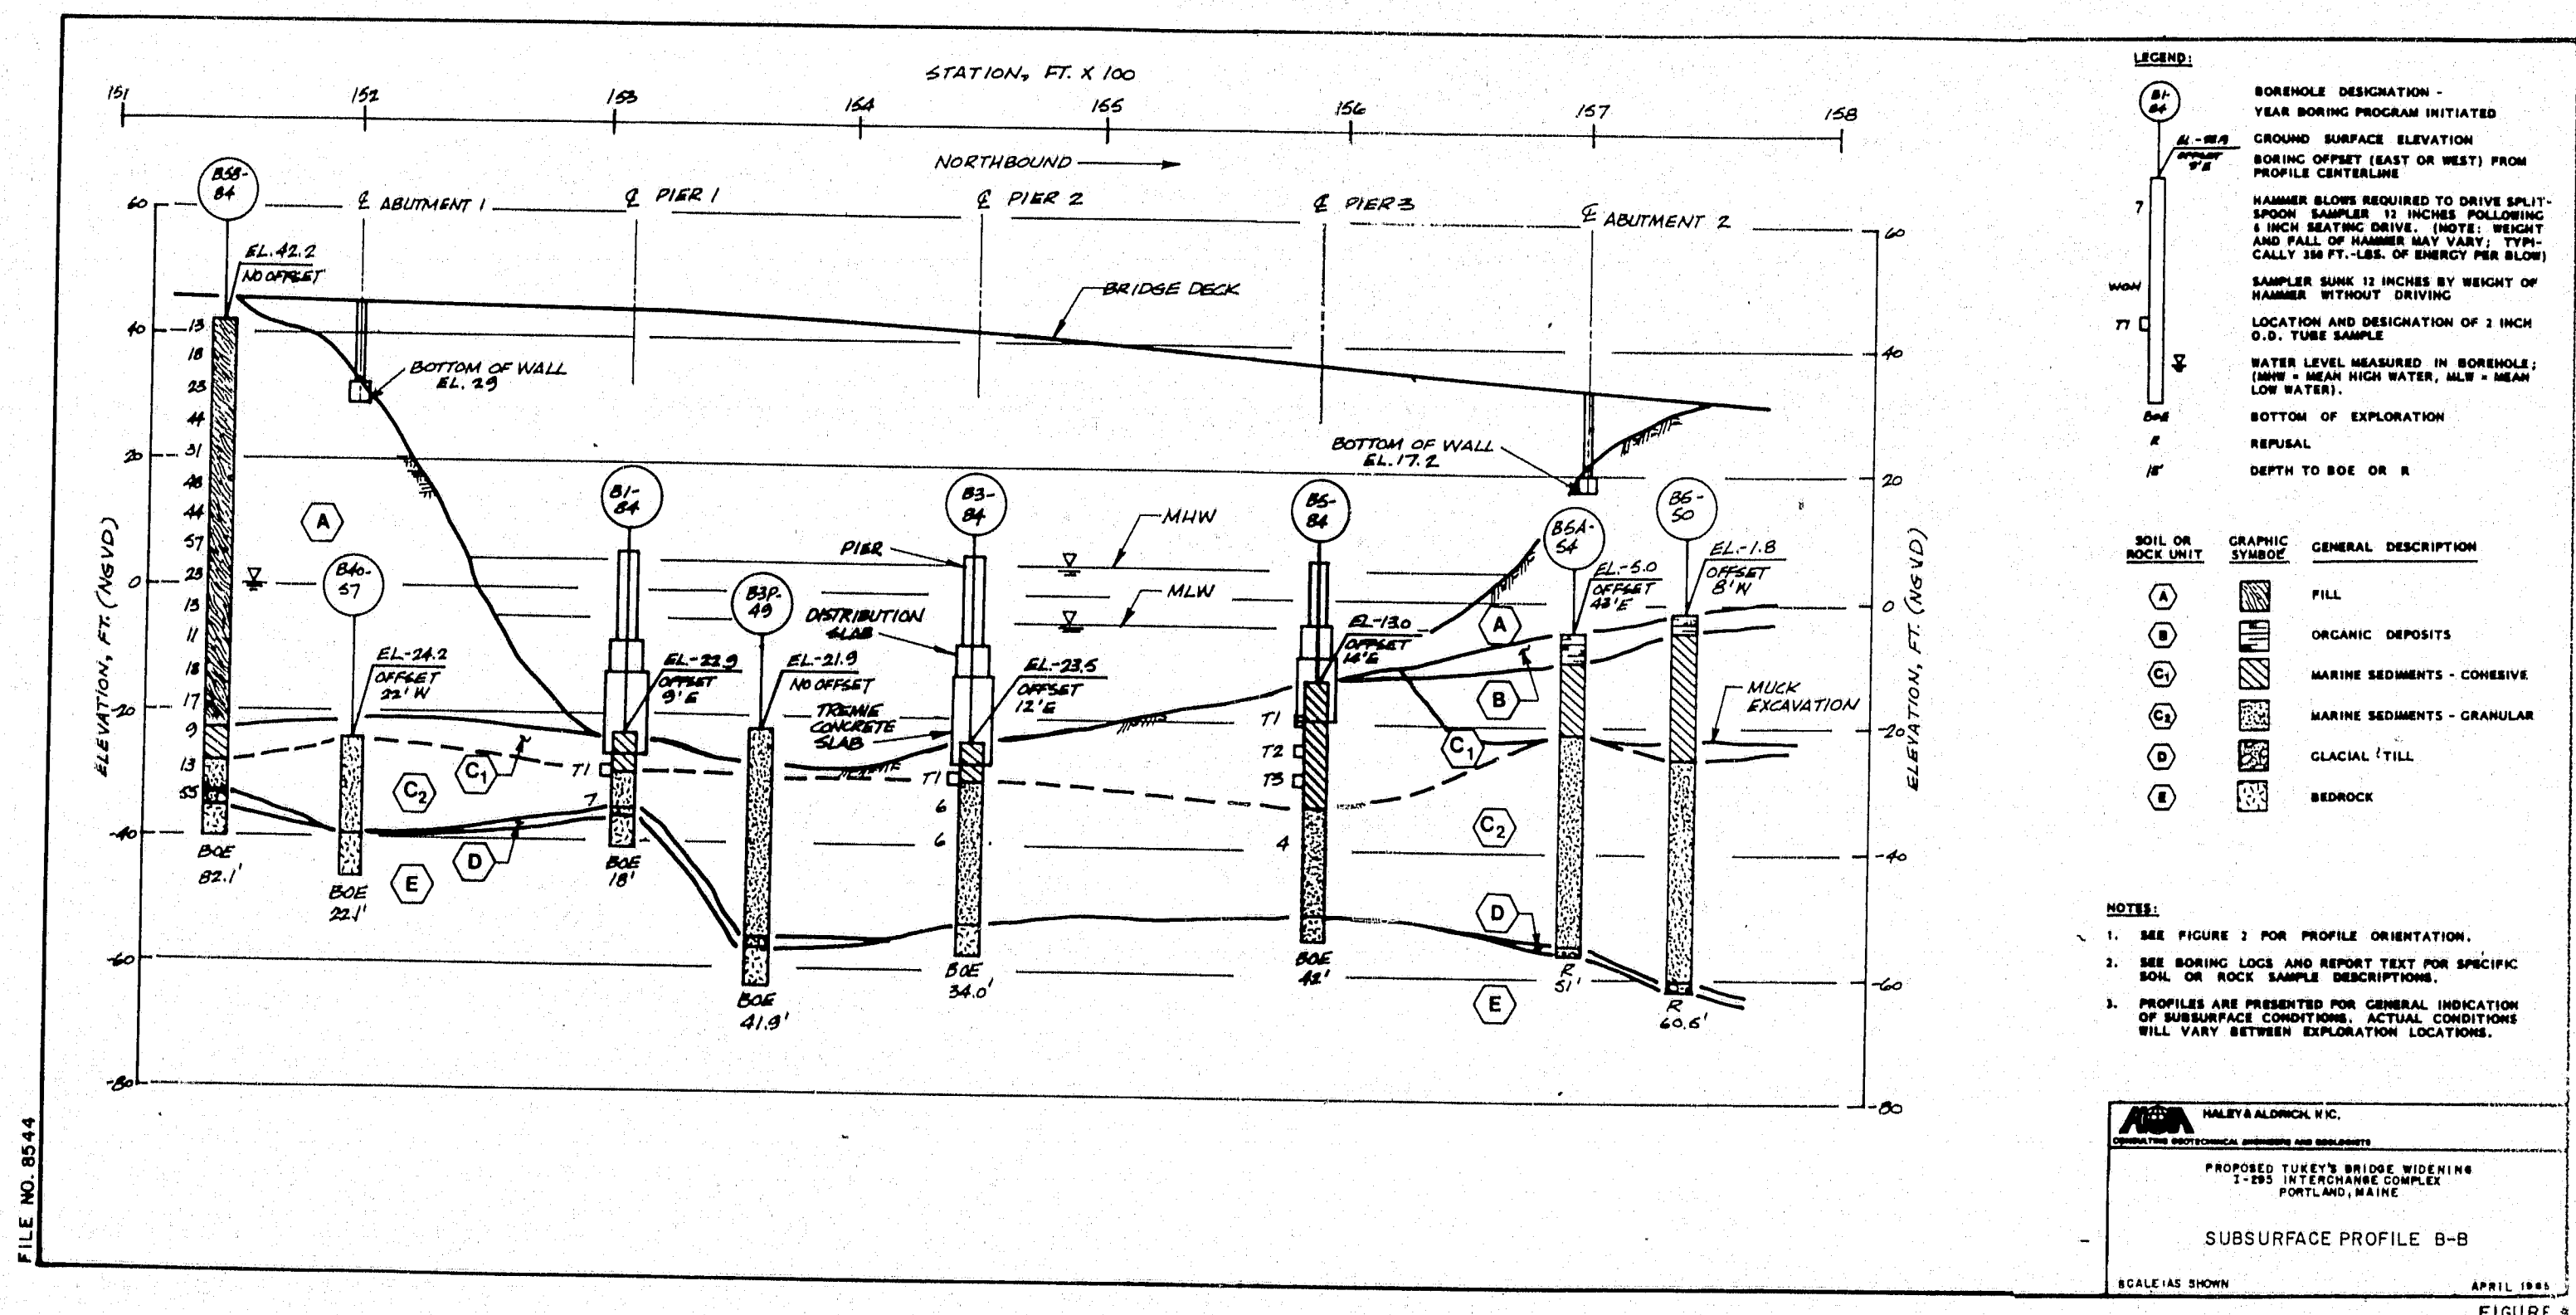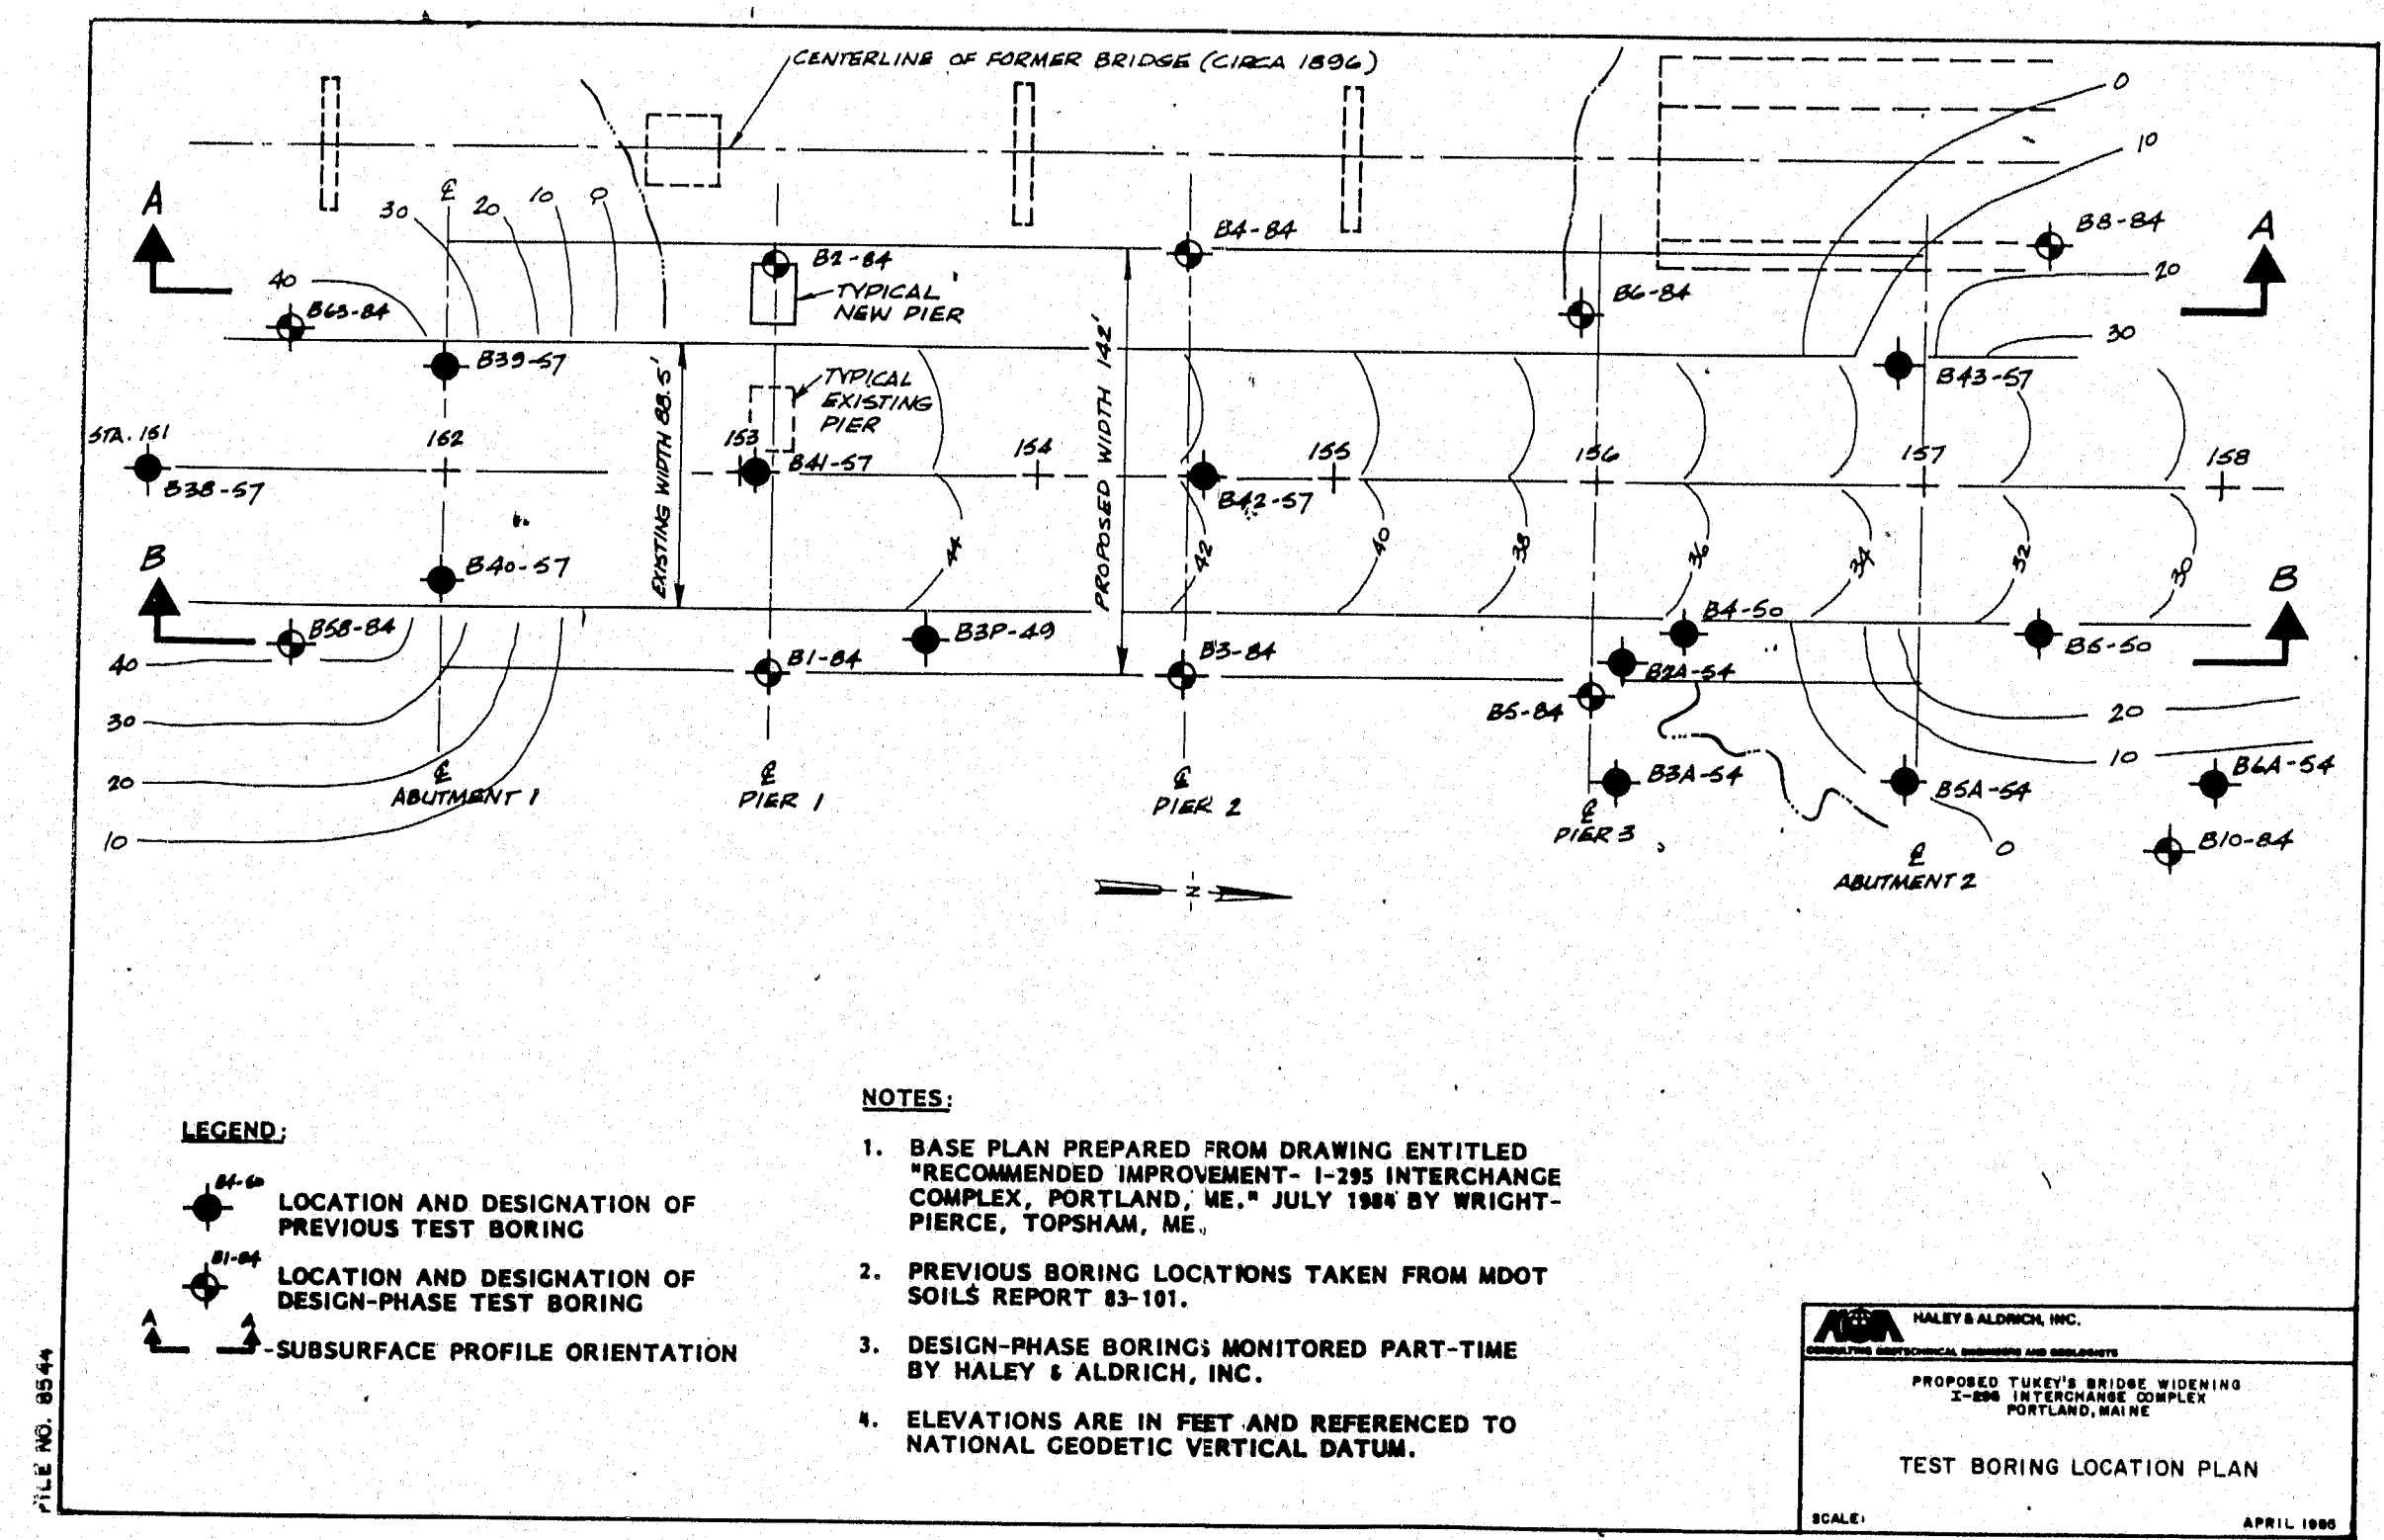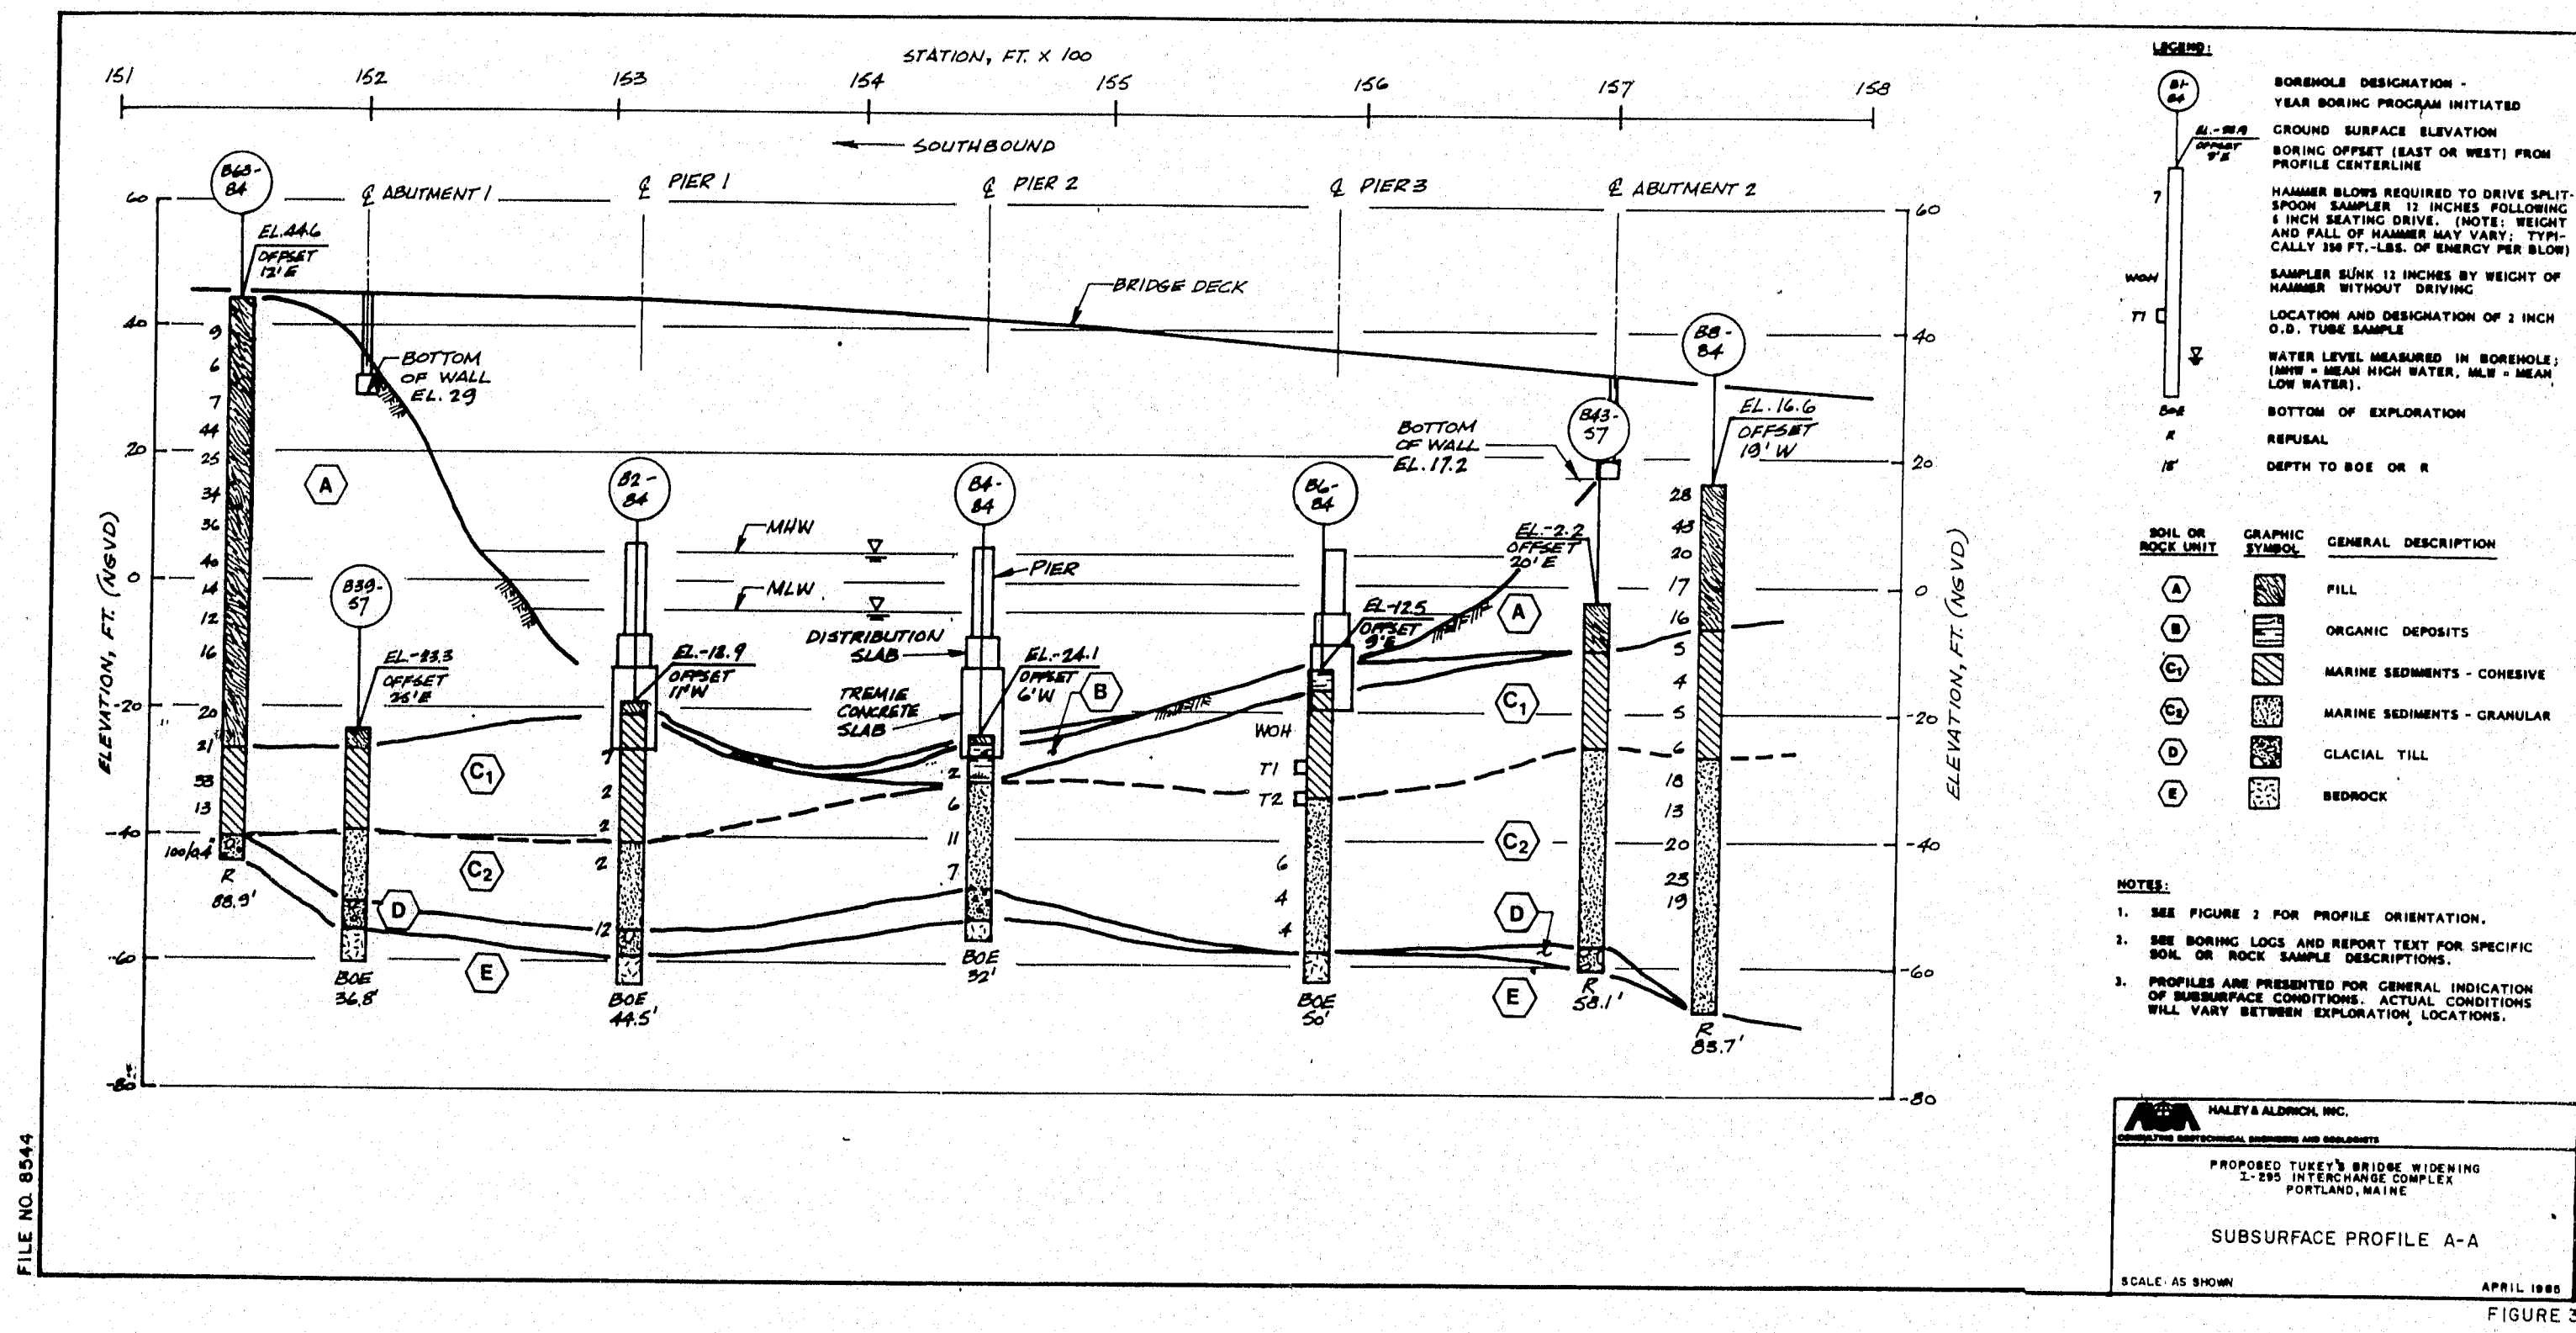

NOTES

- Boring Location Plan and soil-profiles were taken from "Report on Subsurface Investigation and Foundation Recommendations, Proposed Tukey's Bridge Widening, I-295 Interchange Complex, Portland, Maine" prepared by Haley & Aldrich, Inc. and dated 2 April 1985.
- Refer to the above referenced geotechnical report for discussion of subsurface conditions and foundation construction considerations.

PROJECT DESIGN ENGINEER	DATE
DESIGN - DETAILED	
CHECKED	
REVISIONS	
FIELD CHANGES	









STATE OF MAINE
 DEPARTMENT OF TRANSPORTATION
 I-295 INTERCHANGE COMPLEX
 TUKEYS BRIDGE
 OVER
 BACK COVE
 IN THE TOWN OF
 PORTLAND
 CUMBERLAND COUNTY
 SUBSURFACE SOILS DATA
 SHEET 4 OF 35 AUGUSTA, MAINE

103-269

F.R.W. NO.	STATE	PROJECT NUMBER	SHEET NO.	TOTAL SHEETS
1	MAINE	IR-295-3(94)50	9	120

BORING NOTES

- All samples and vane tests are made ahead of casing
 - Water elevation
 - Number of blows required to drive extra heavy casing one foot with 400 ft. lbs. of energy per blow
 - Location of sample or sample attempt
 - Number and type of dry sample
 - ID 5 H Sampler #1290's
 - IC 2" O.D. 16 ga. seamless tubing
 - IU 3 1/2" O.D. 16 ga. seamless tubing
 - IW Wash sample and number
 - MD Unsuccessful sample attempt and type of sampler
 - Number of blows required to drive spoon or tubing one foot with 350 ft. lbs. of energy per blow
 - H Sampling spoon or seamless tubing driven by static weight of drill rods and hammer
 - P Piston sampler
 - Field vane test
 - Bottom of boring (may not be bottom of soil strata)
 - Refusal of drill rods or casing (may not be ledge)
 - Locations cored by diamond bit and per cent recovery of rock
- SHEAR NOTES**
- Field vane shear strengths
 - Laboratory vane shear strengths
 - Shear strengths in excess of capacity of equipment
 - One half unconfined compressive strengths
- WATER CONTENT NOTES**
- Natural water contents, given as per cent of dry weight
 - Plastic and liquid limits
 - Ignition losses are given as per cent of dry weight

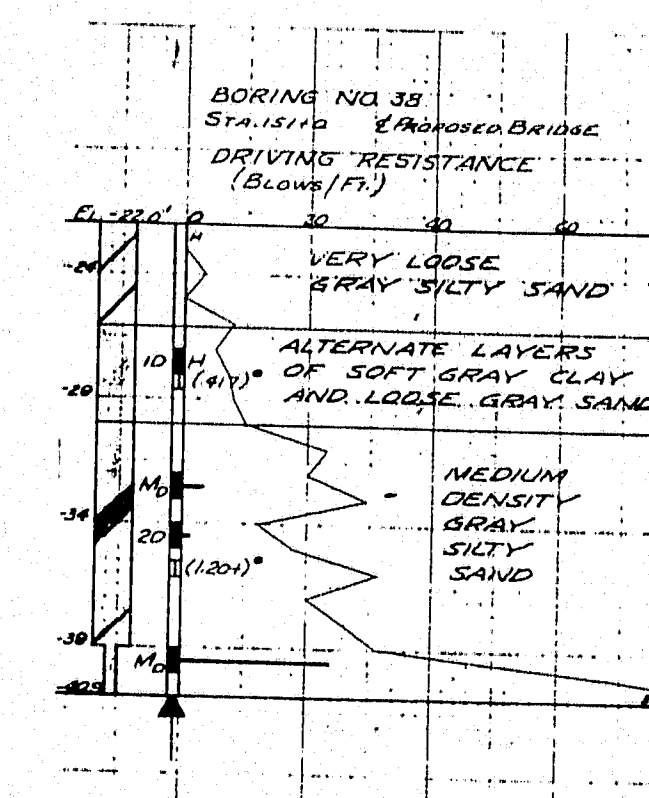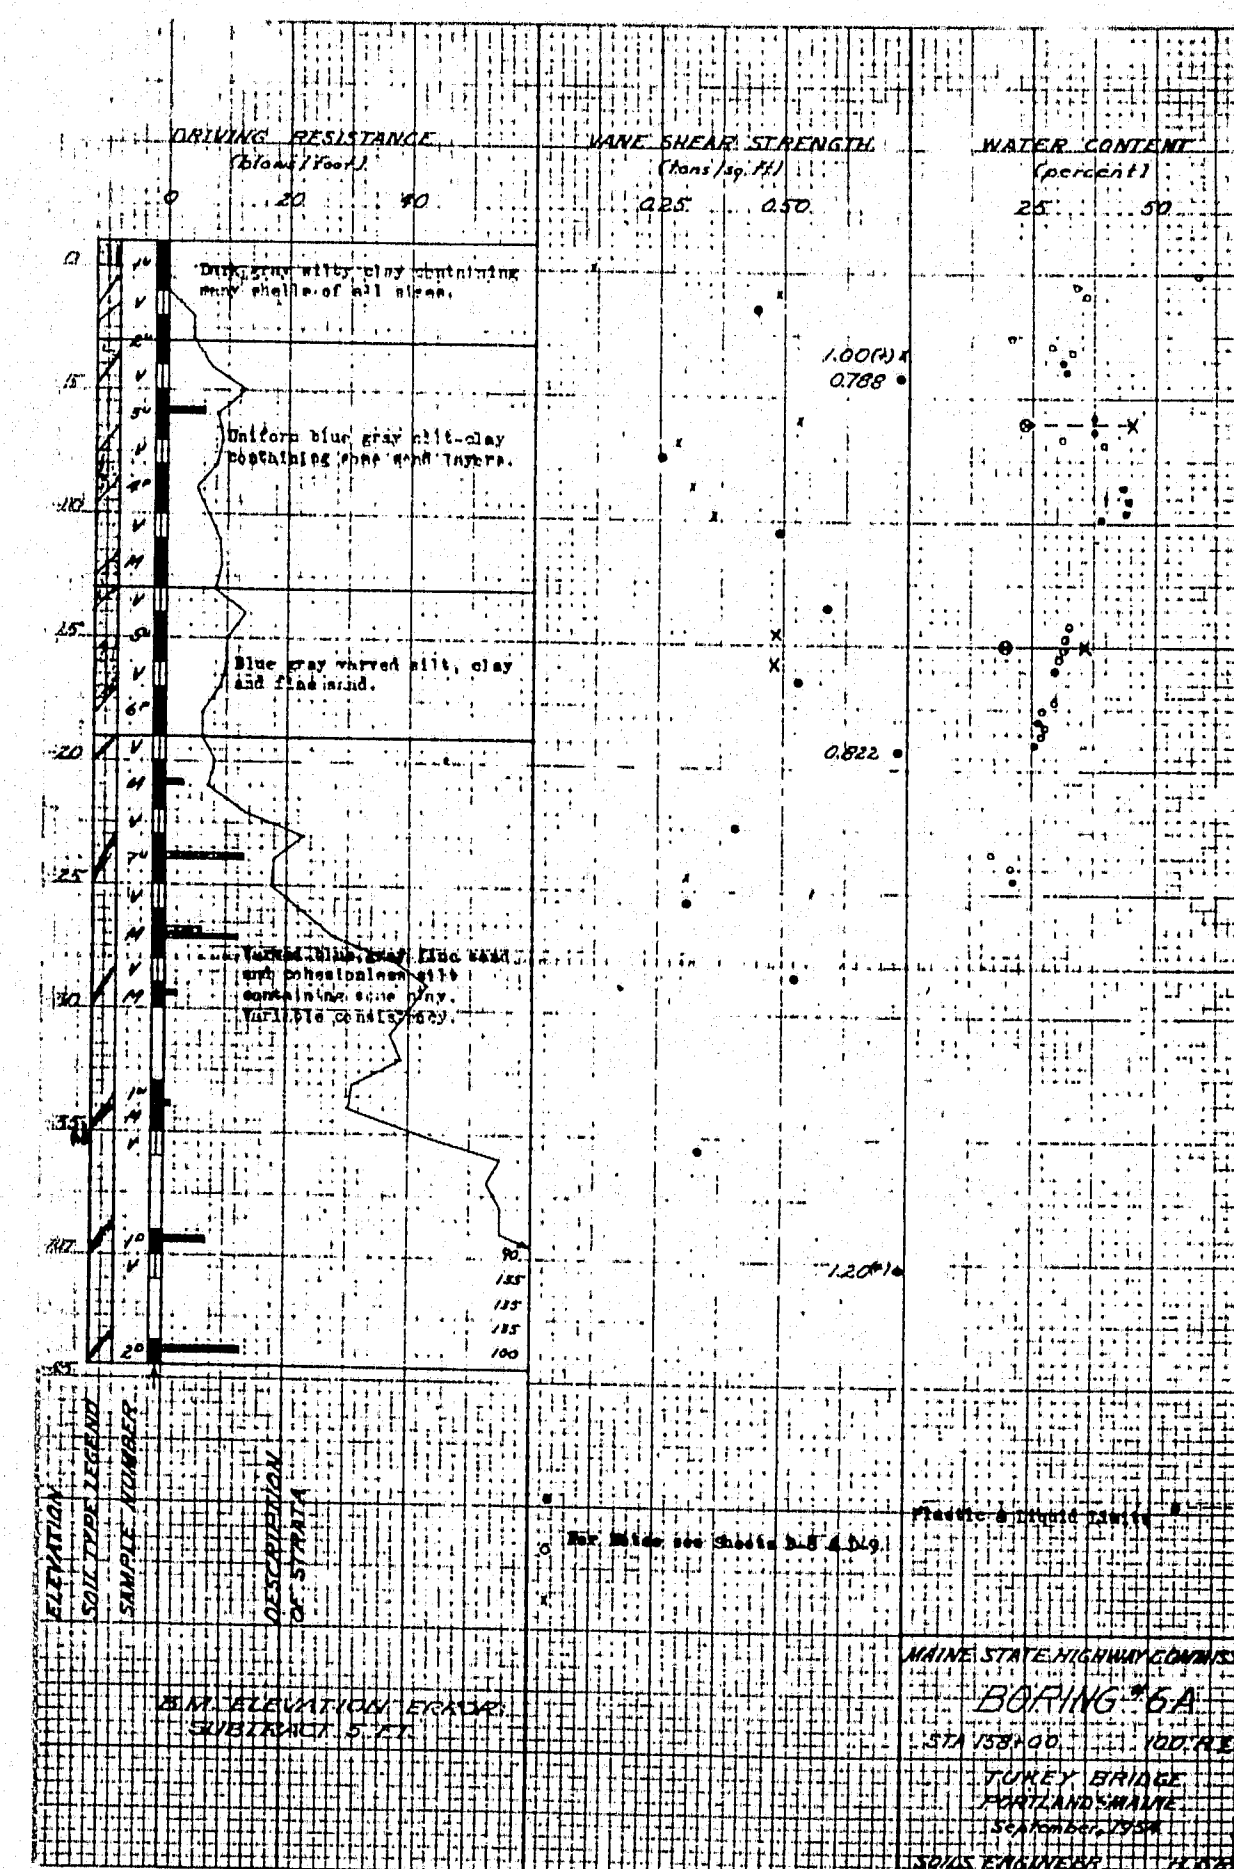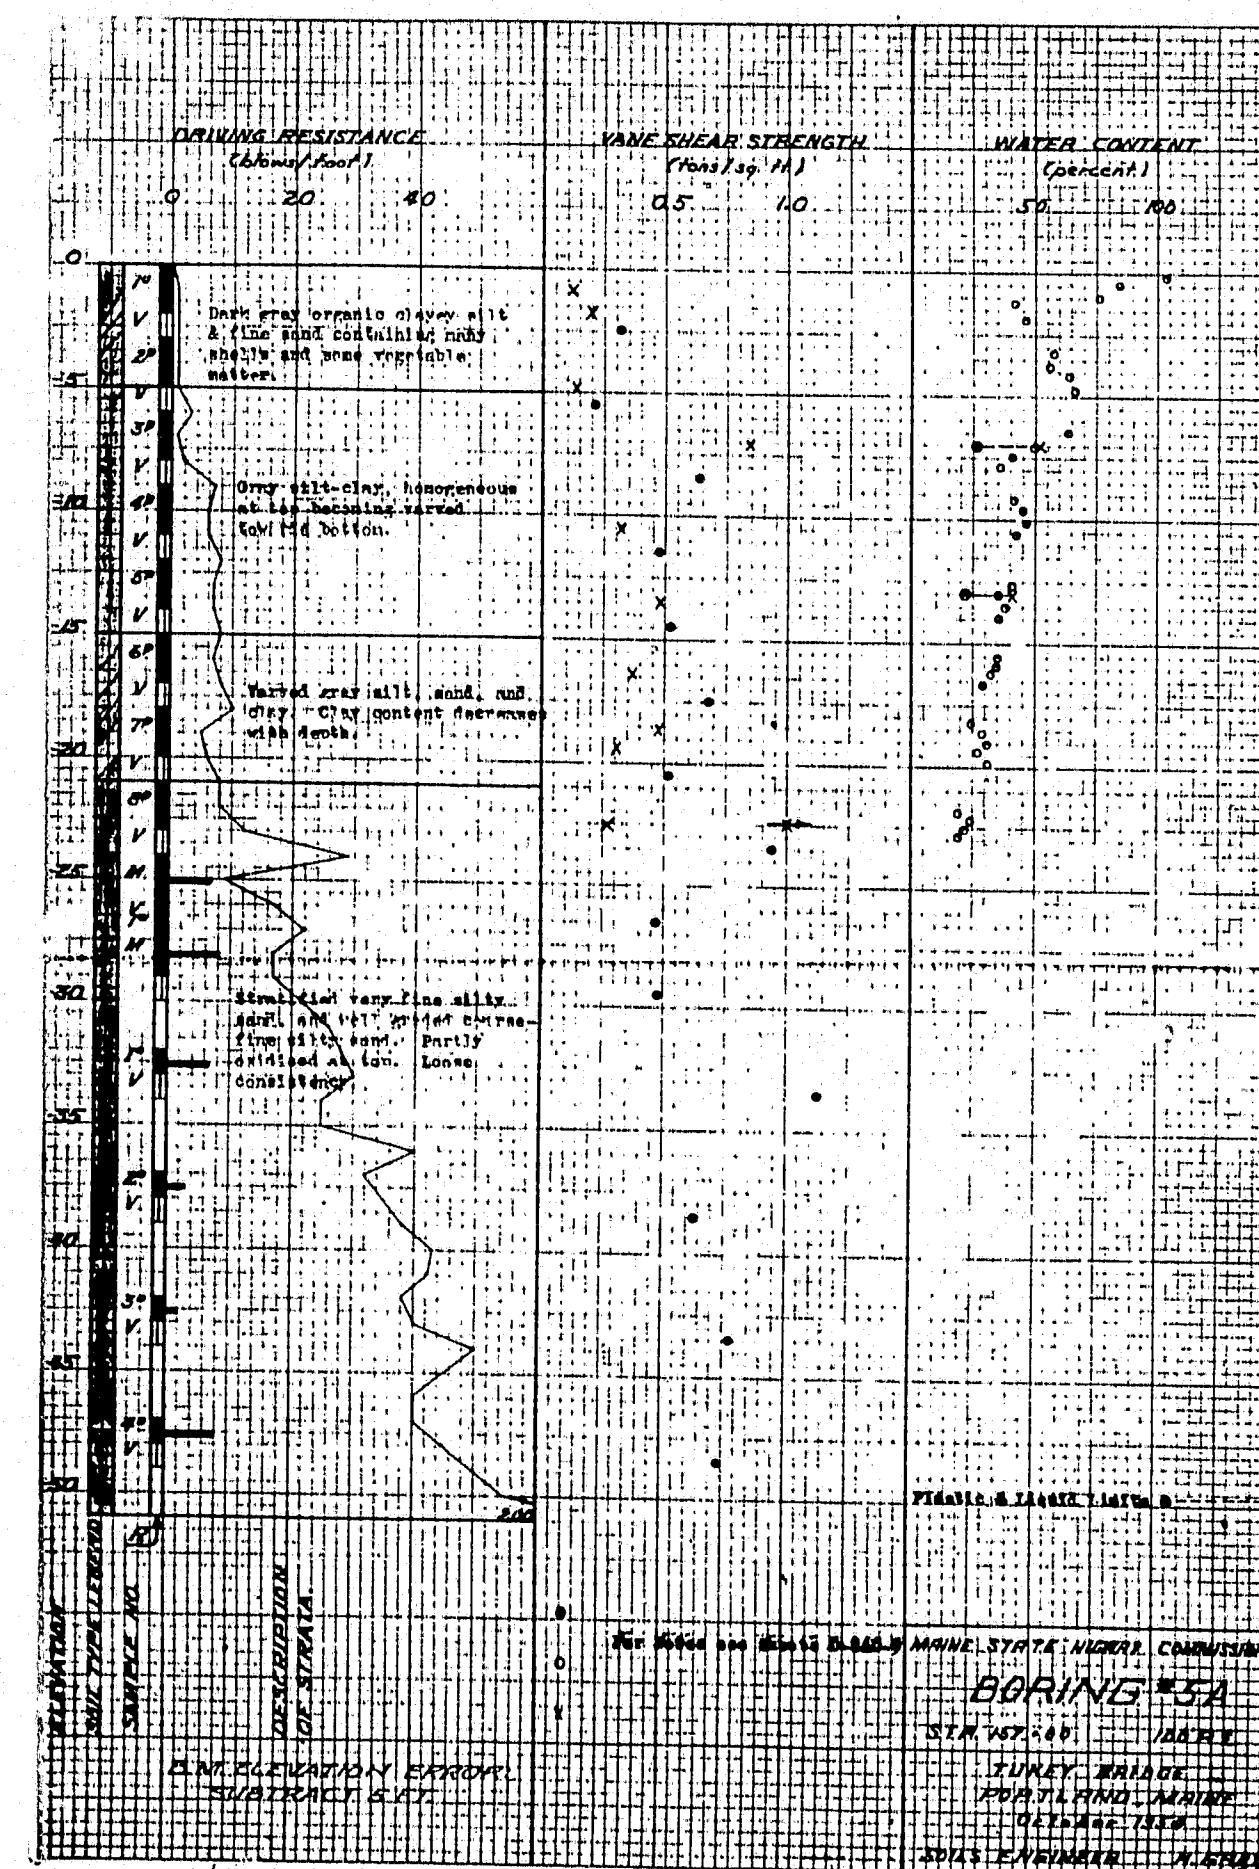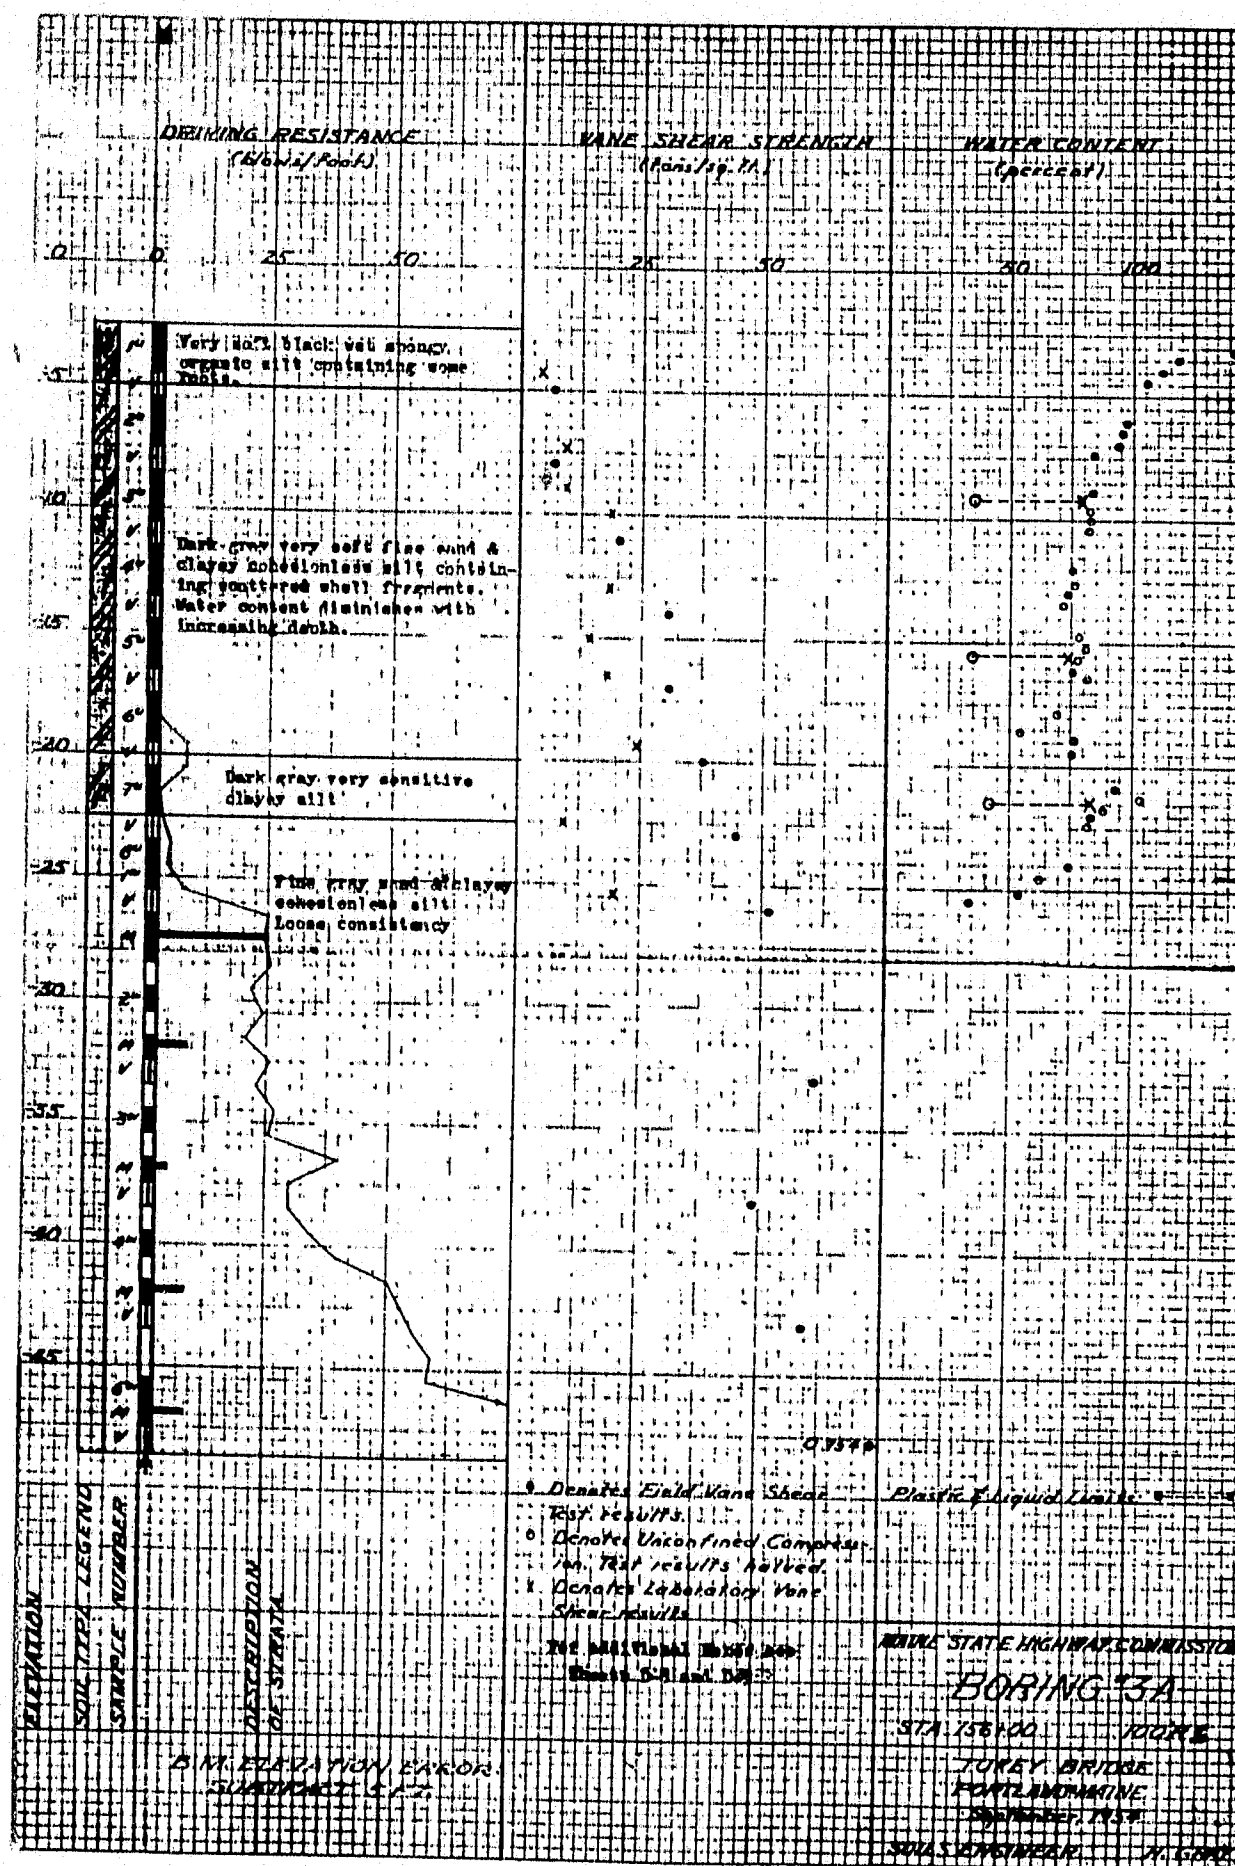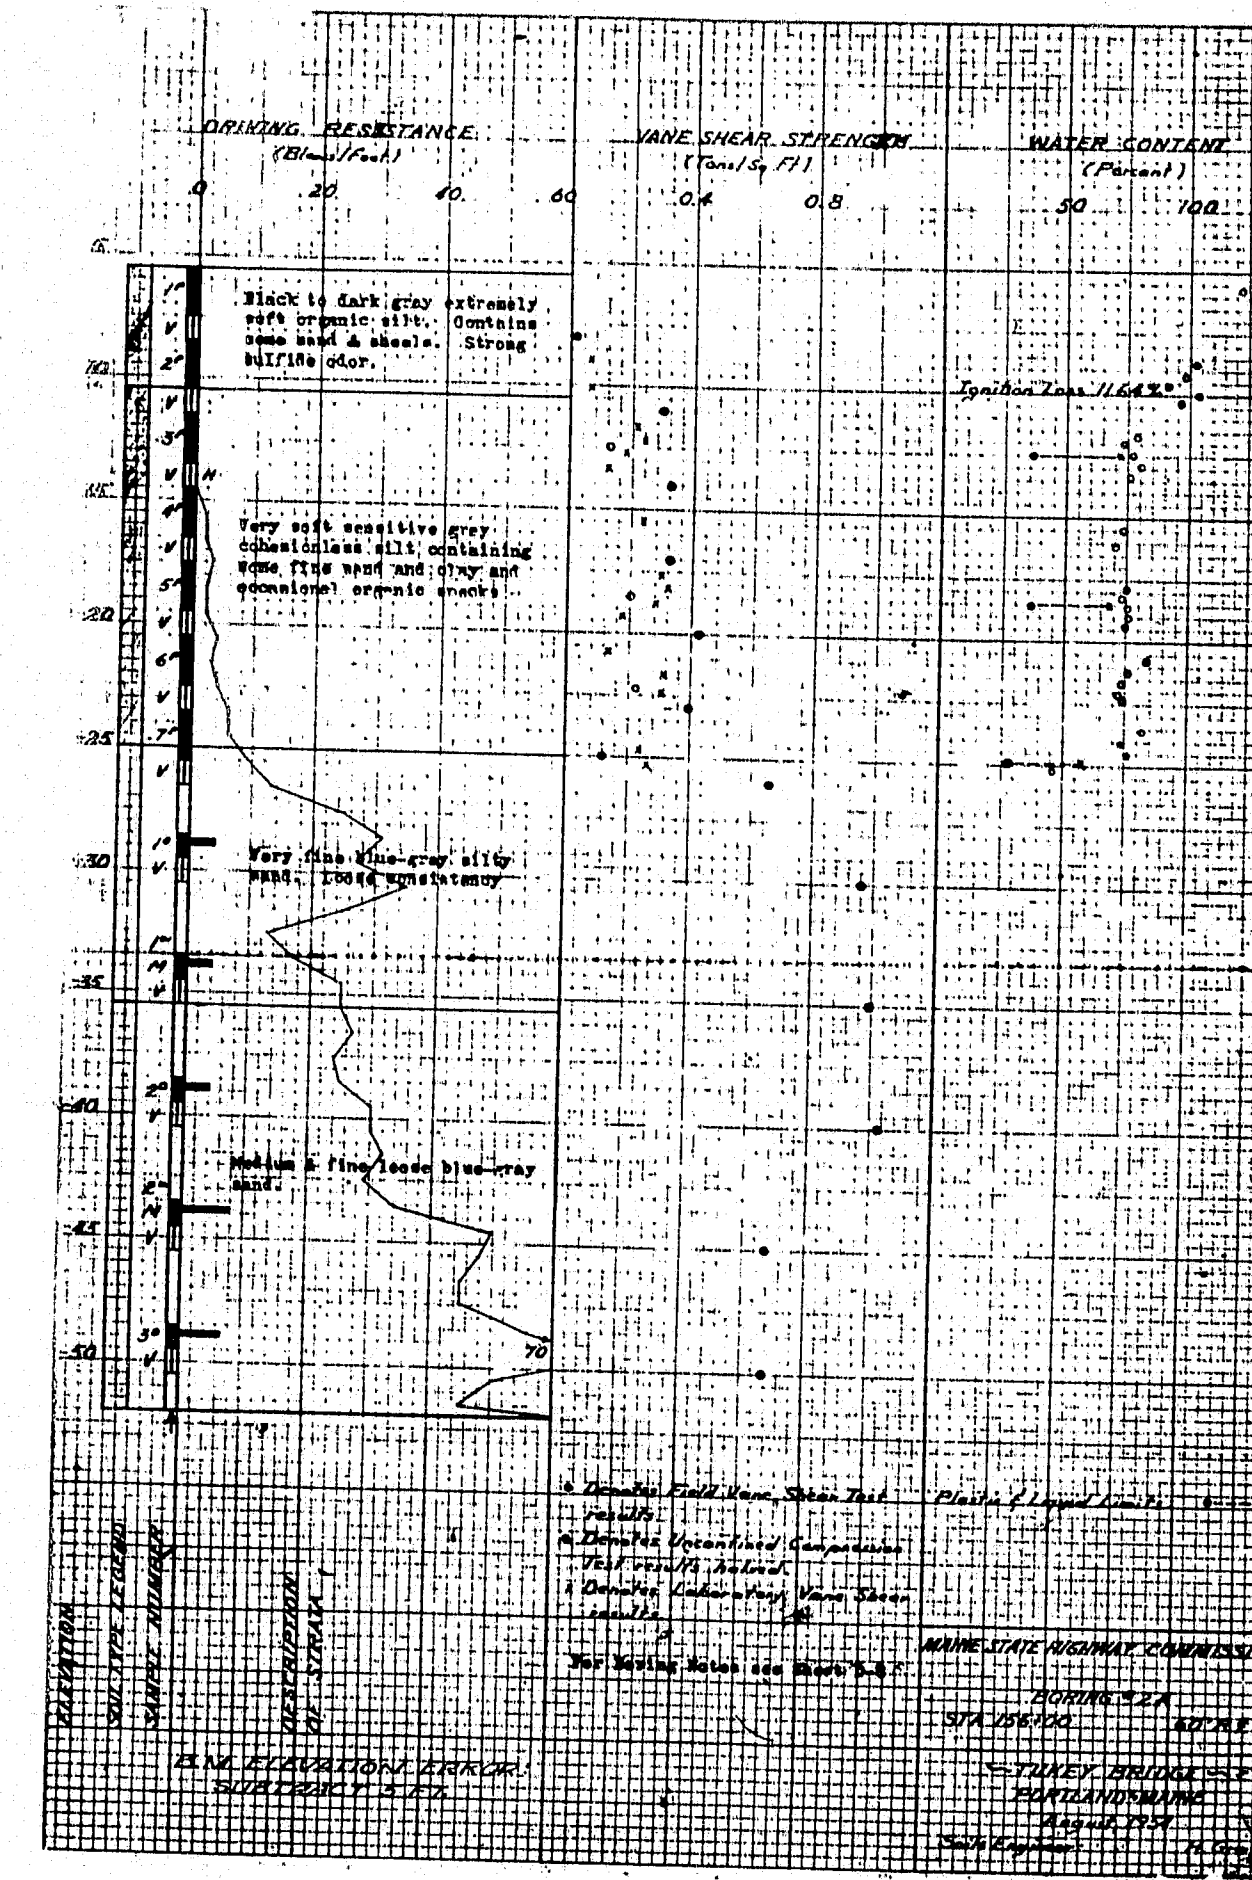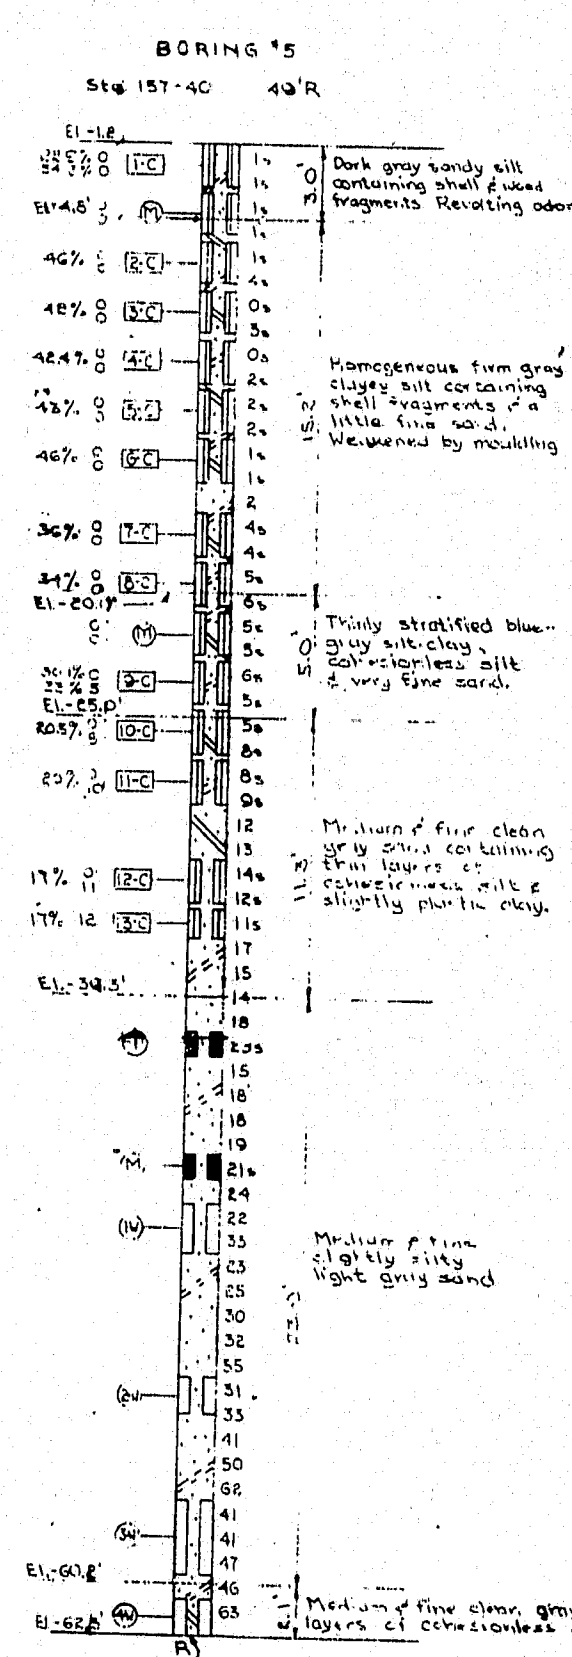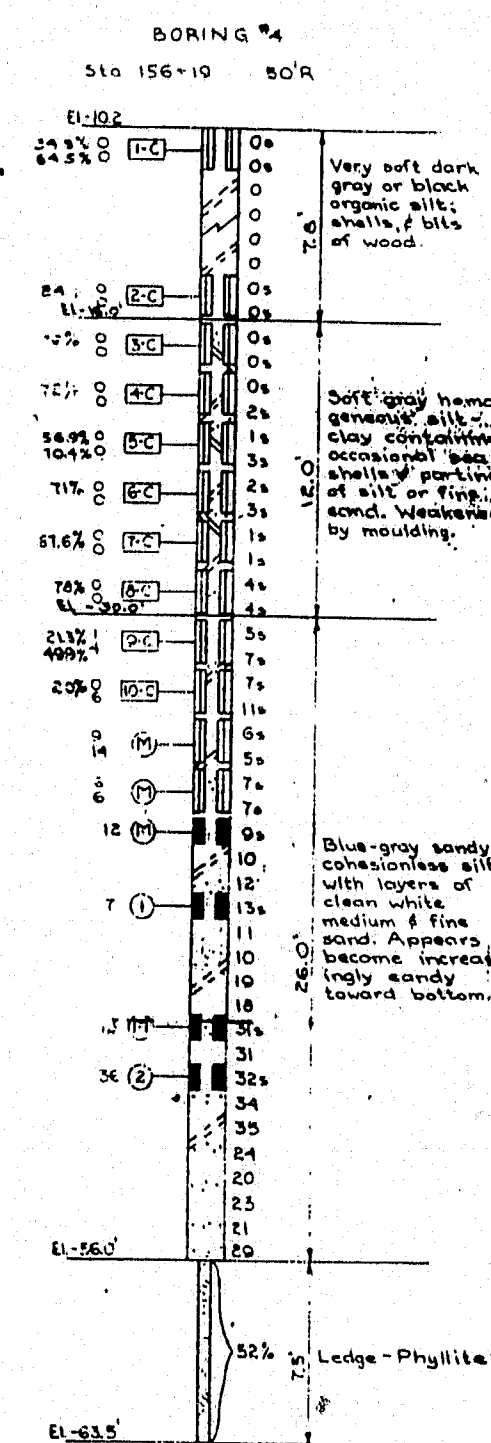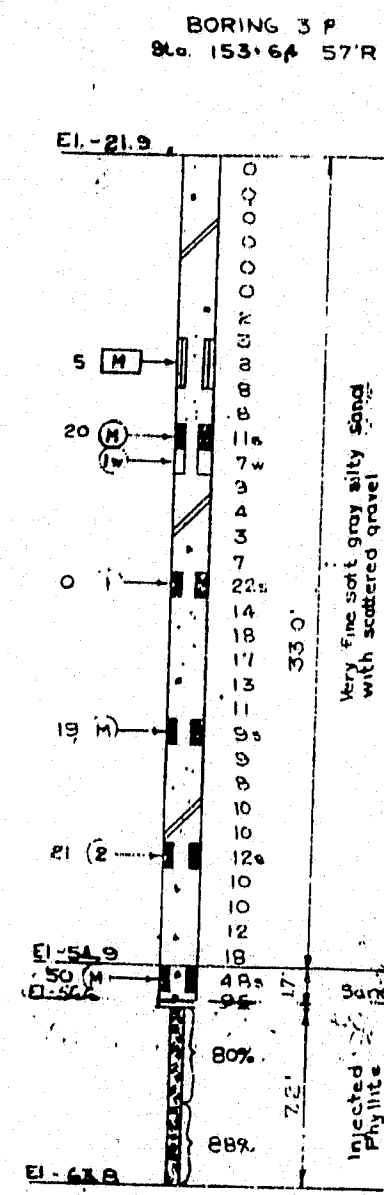

NOTES:

1. See Sheet No. 4 for exploration locations and generalized soil profiles.
2. Test boring logs prepared by Material & Research Division, Maine Department of Transportation.
3. Borings drilled prior to 1984 represent ground surface elevations and subsurface stratifications which existed at the time of drilling. Subsequent construction activities resulted in dredging of organic and clay deposits in the vicinity of Borings B43-57, B54-54, B5-30 and B54-54. Embankments were then constructed in the dredged area and in the vicinity of Borings B38-57, B39-55 and B40-57.
4. Refer to geotechnical report for discussion of subsurface conditions and foundation considerations.

103-270



STATE OF MAINE
DEPARTMENT OF TRANSPORTATION

**I-295 INTERCHANGE COMPLEX
TUKEYS BRIDGE
OVER
BACK COVE
IN THE TOWN OF
PORTLAND
CUMBERLAND COUNTY
SUBSURFACE SOILS DATA**

SHEET 5 OF 35 AUGUSTA, MAINE


PROJECT DESIGN ENGINEER	BY	DATE
DESIGN - DETAILED		
CHECKED		
FIELD CHANGES		

BORINGS 44132-4710-1

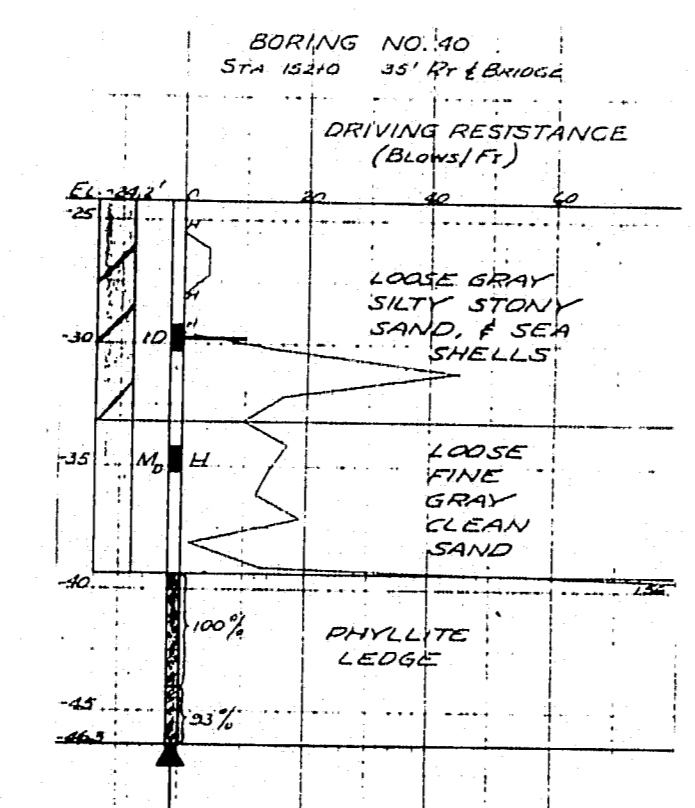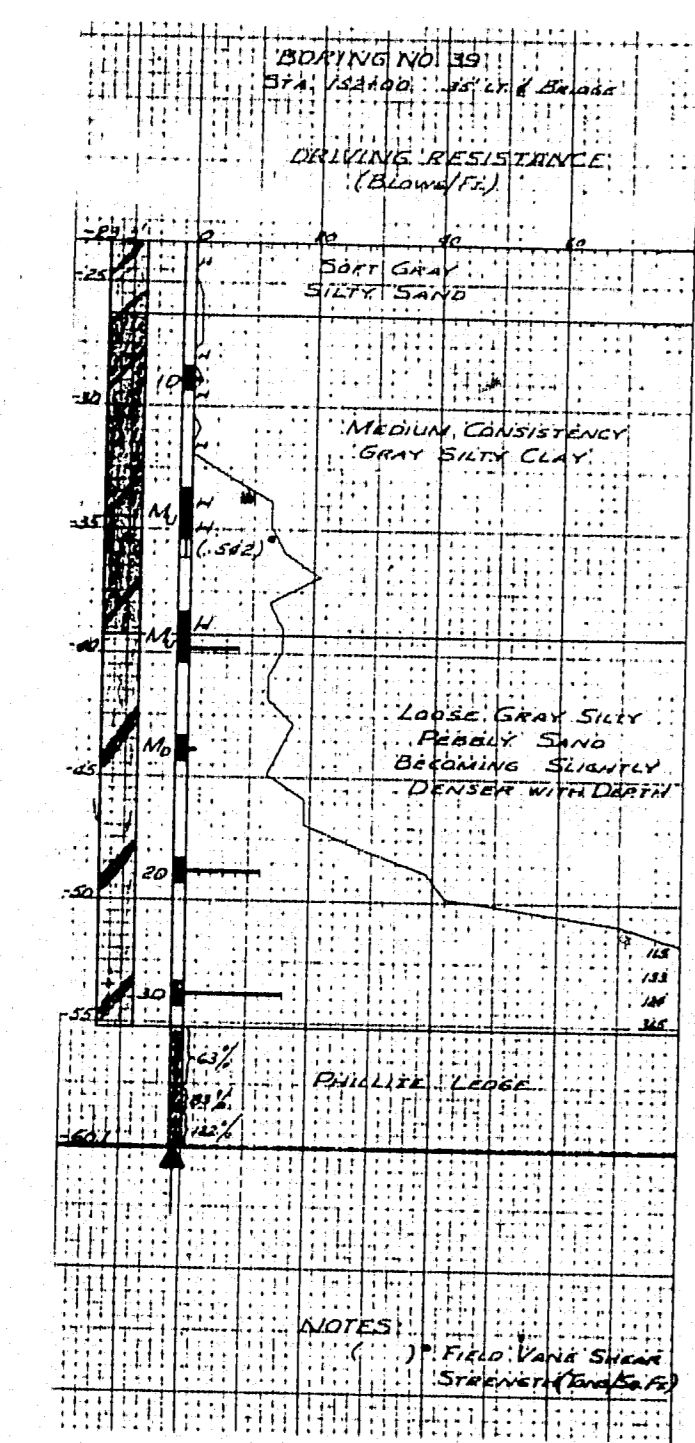


MAINE STATE HIGHWAY COMMISSION
 BORING NO. 80
 STATION 153+00.66' R
 TURKEY BRIDGE - PORTLAND
 SCALE: 1" = 10' (VERTICAL)
 DATE: NOVEMBER 1984
 SOIL ENGINEERING LAB. U.S.A.


MAINE STATE HIGHWAY COMMISSION
 BORING NO. 80
 STATION 153+00.66' R
 TURKEY BRIDGE - PORTLAND
 SCALE: 1" = 10' (VERTICAL)
 DATE: NOVEMBER 1984
 SOIL ENGINEERING LAB. U.S.A.

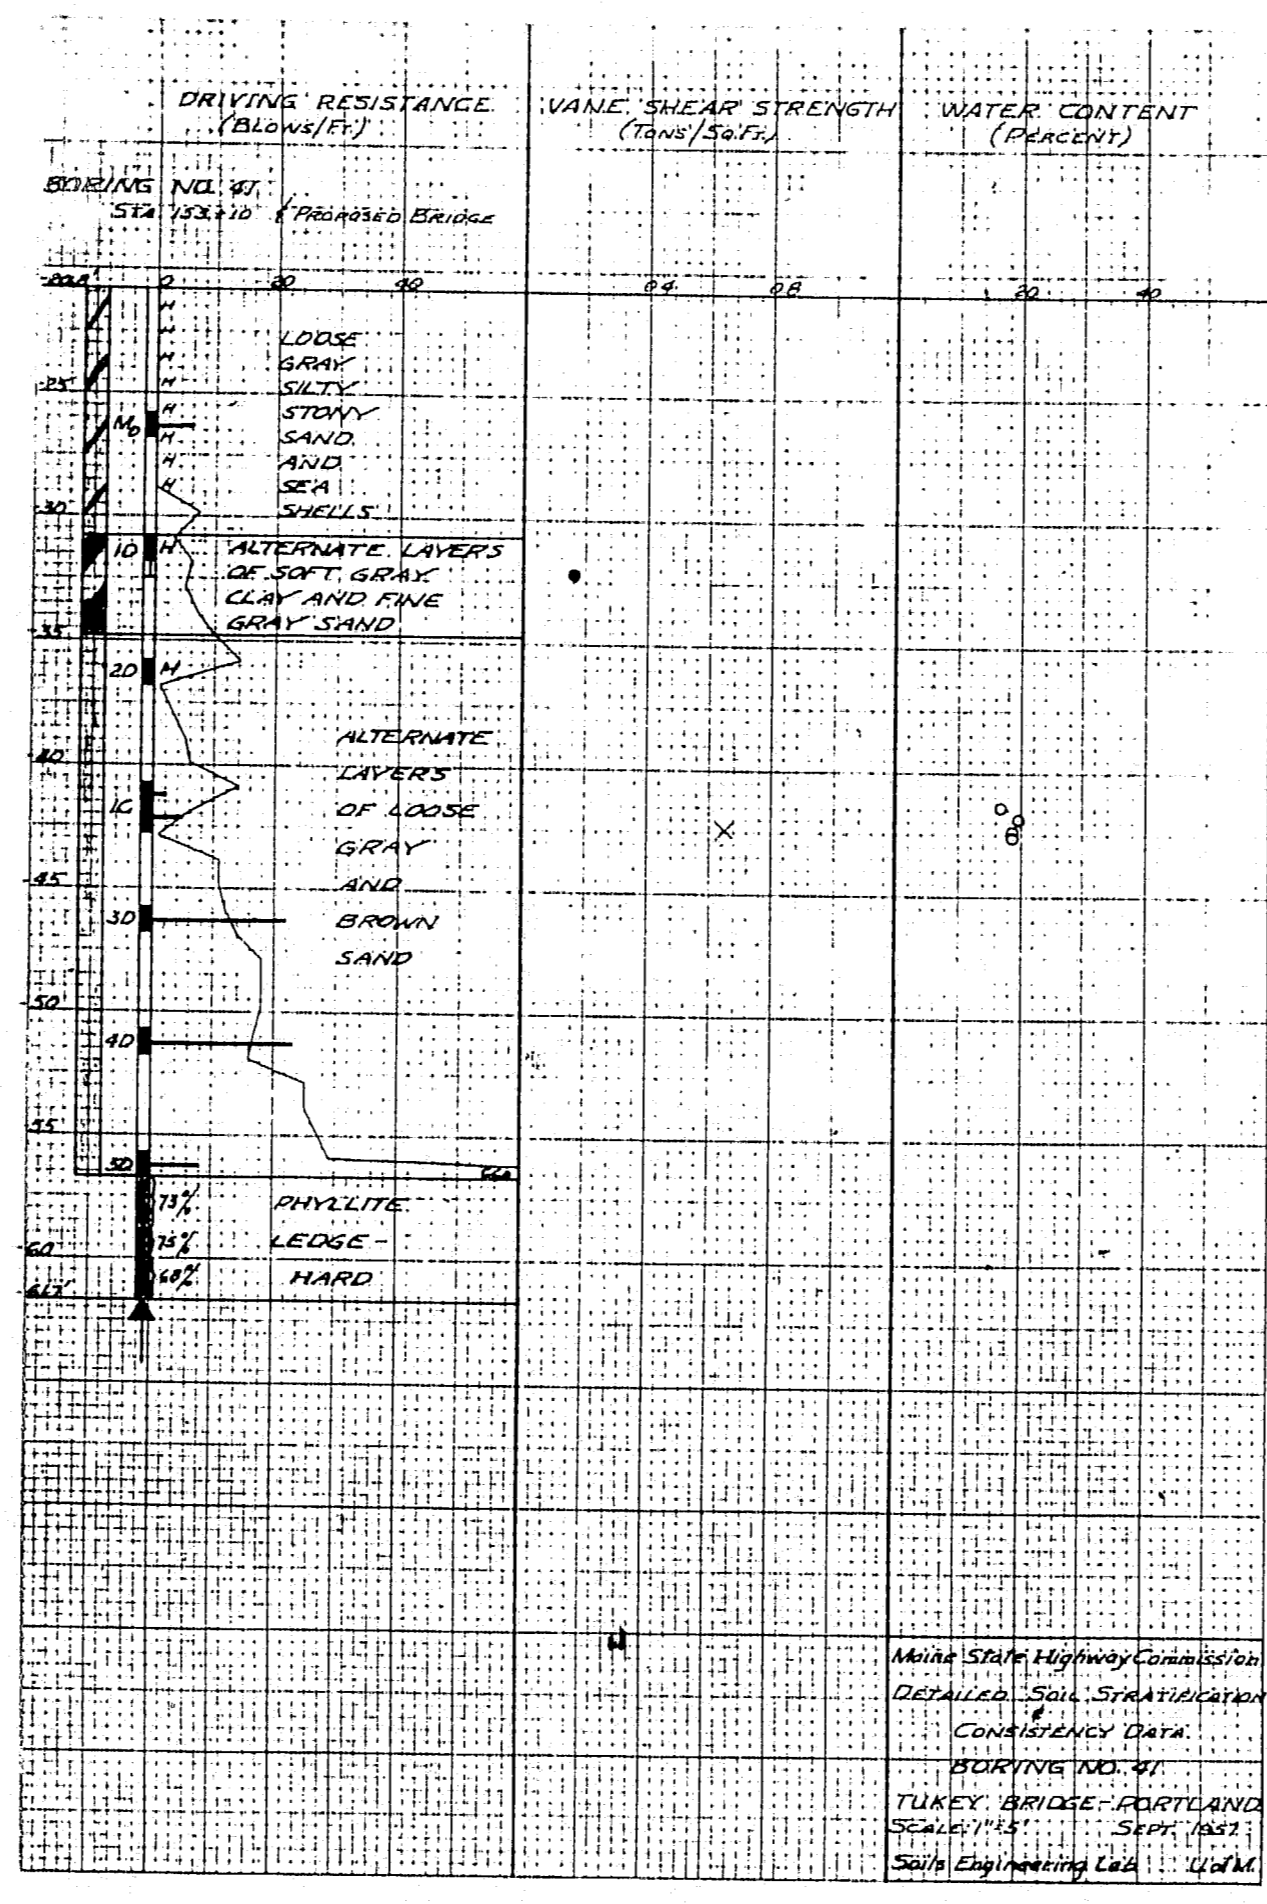

MAINE STATE HIGHWAY COMMISSION
 BORING NO. 81
 STATION 153+00.71' L
 TURKEY BRIDGE - PORTLAND
 SCALE: 1" = 10' (VERTICAL)
 DATE: NOVEMBER 1984
 SOIL ENGINEERING LAB. U.S.A.




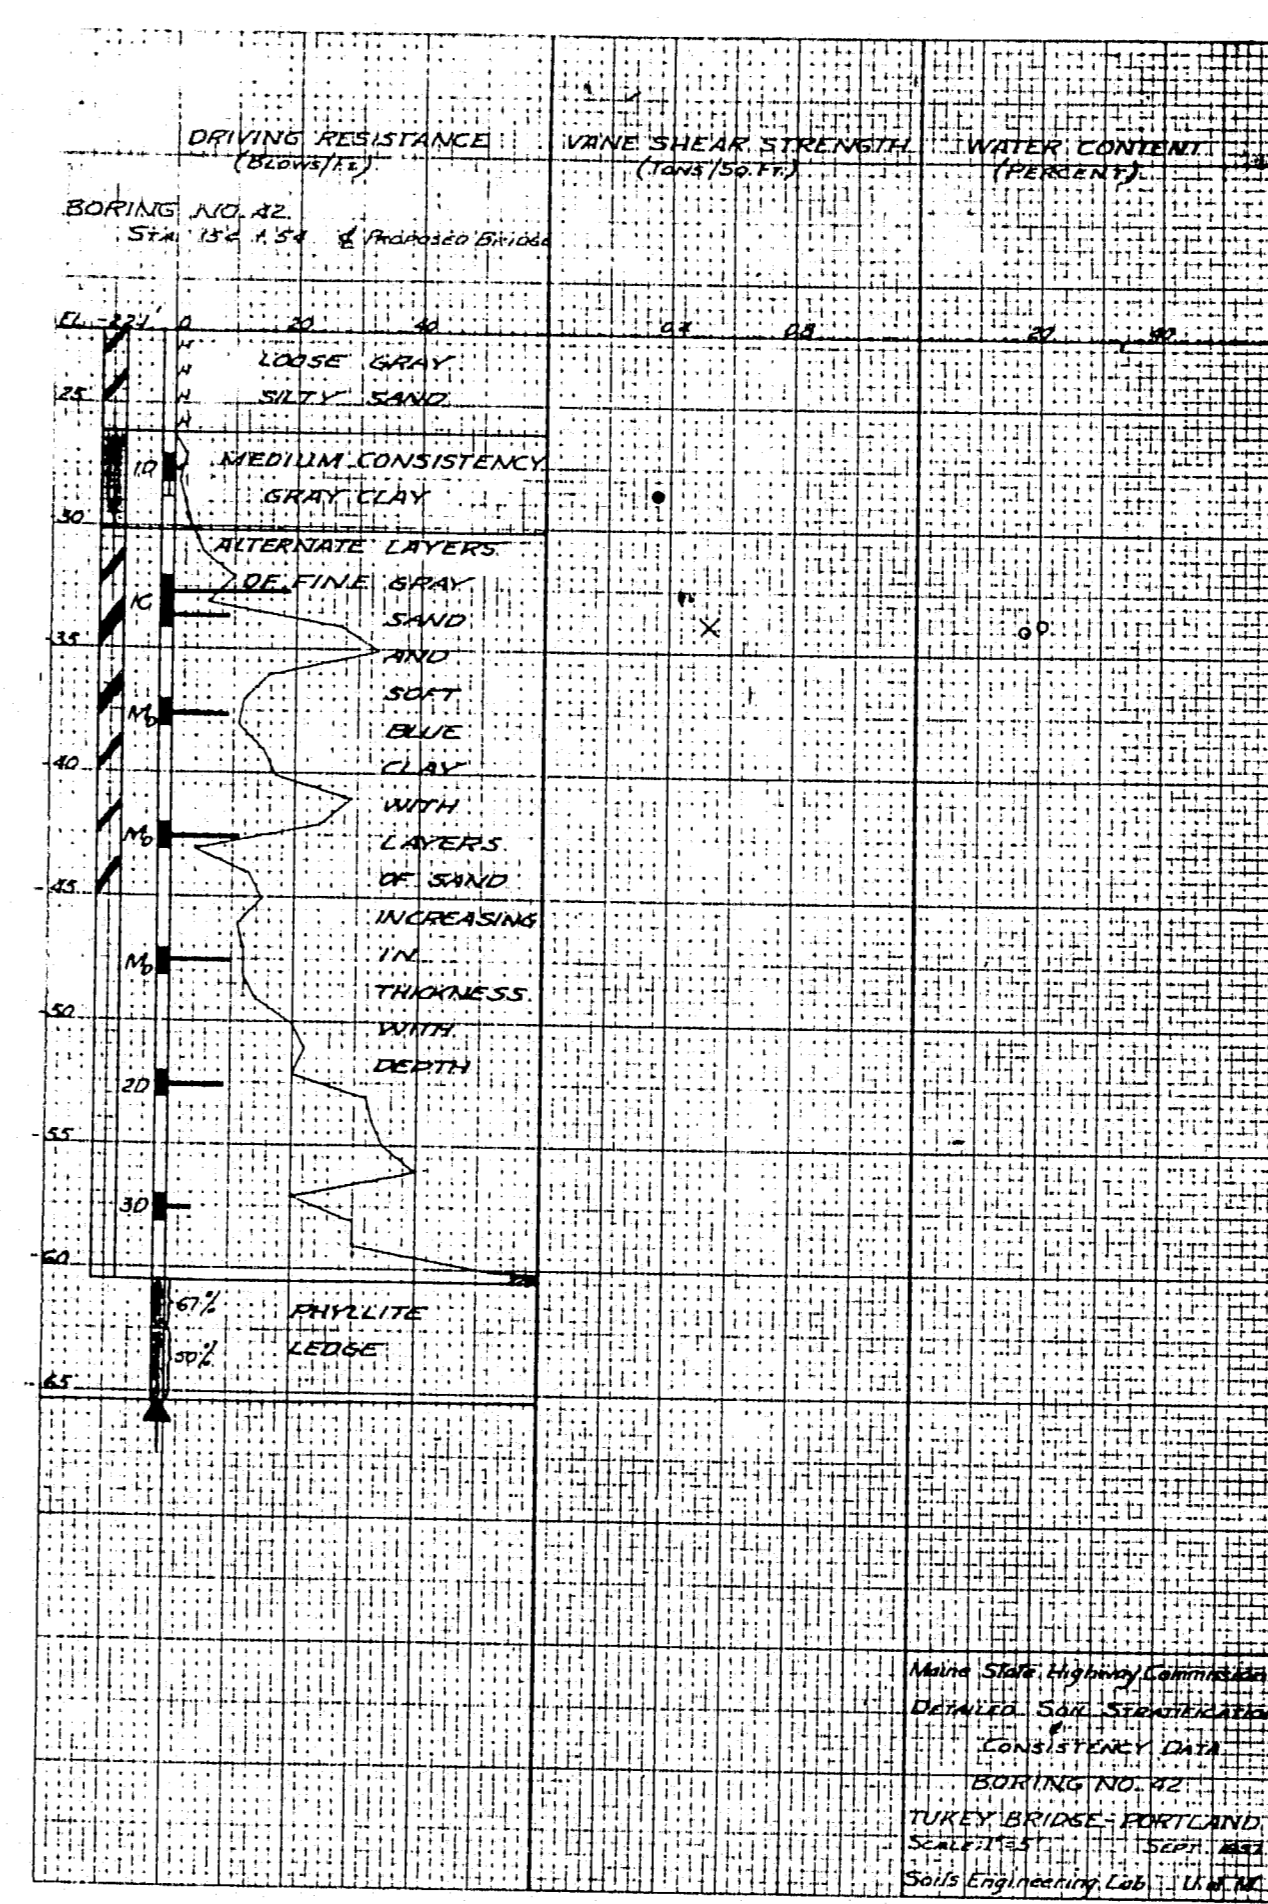


MAINE STATE HIGHWAY COMMISSION
 BORING NO. 82
 STATION 154+50.69' R
 TURKEY BRIDGE - PORTLAND
 SCALE: 1" = 10' (VERTICAL)
 DATE: NOVEMBER 1984
 SOIL ENGINEERING LAB. U.S.A.

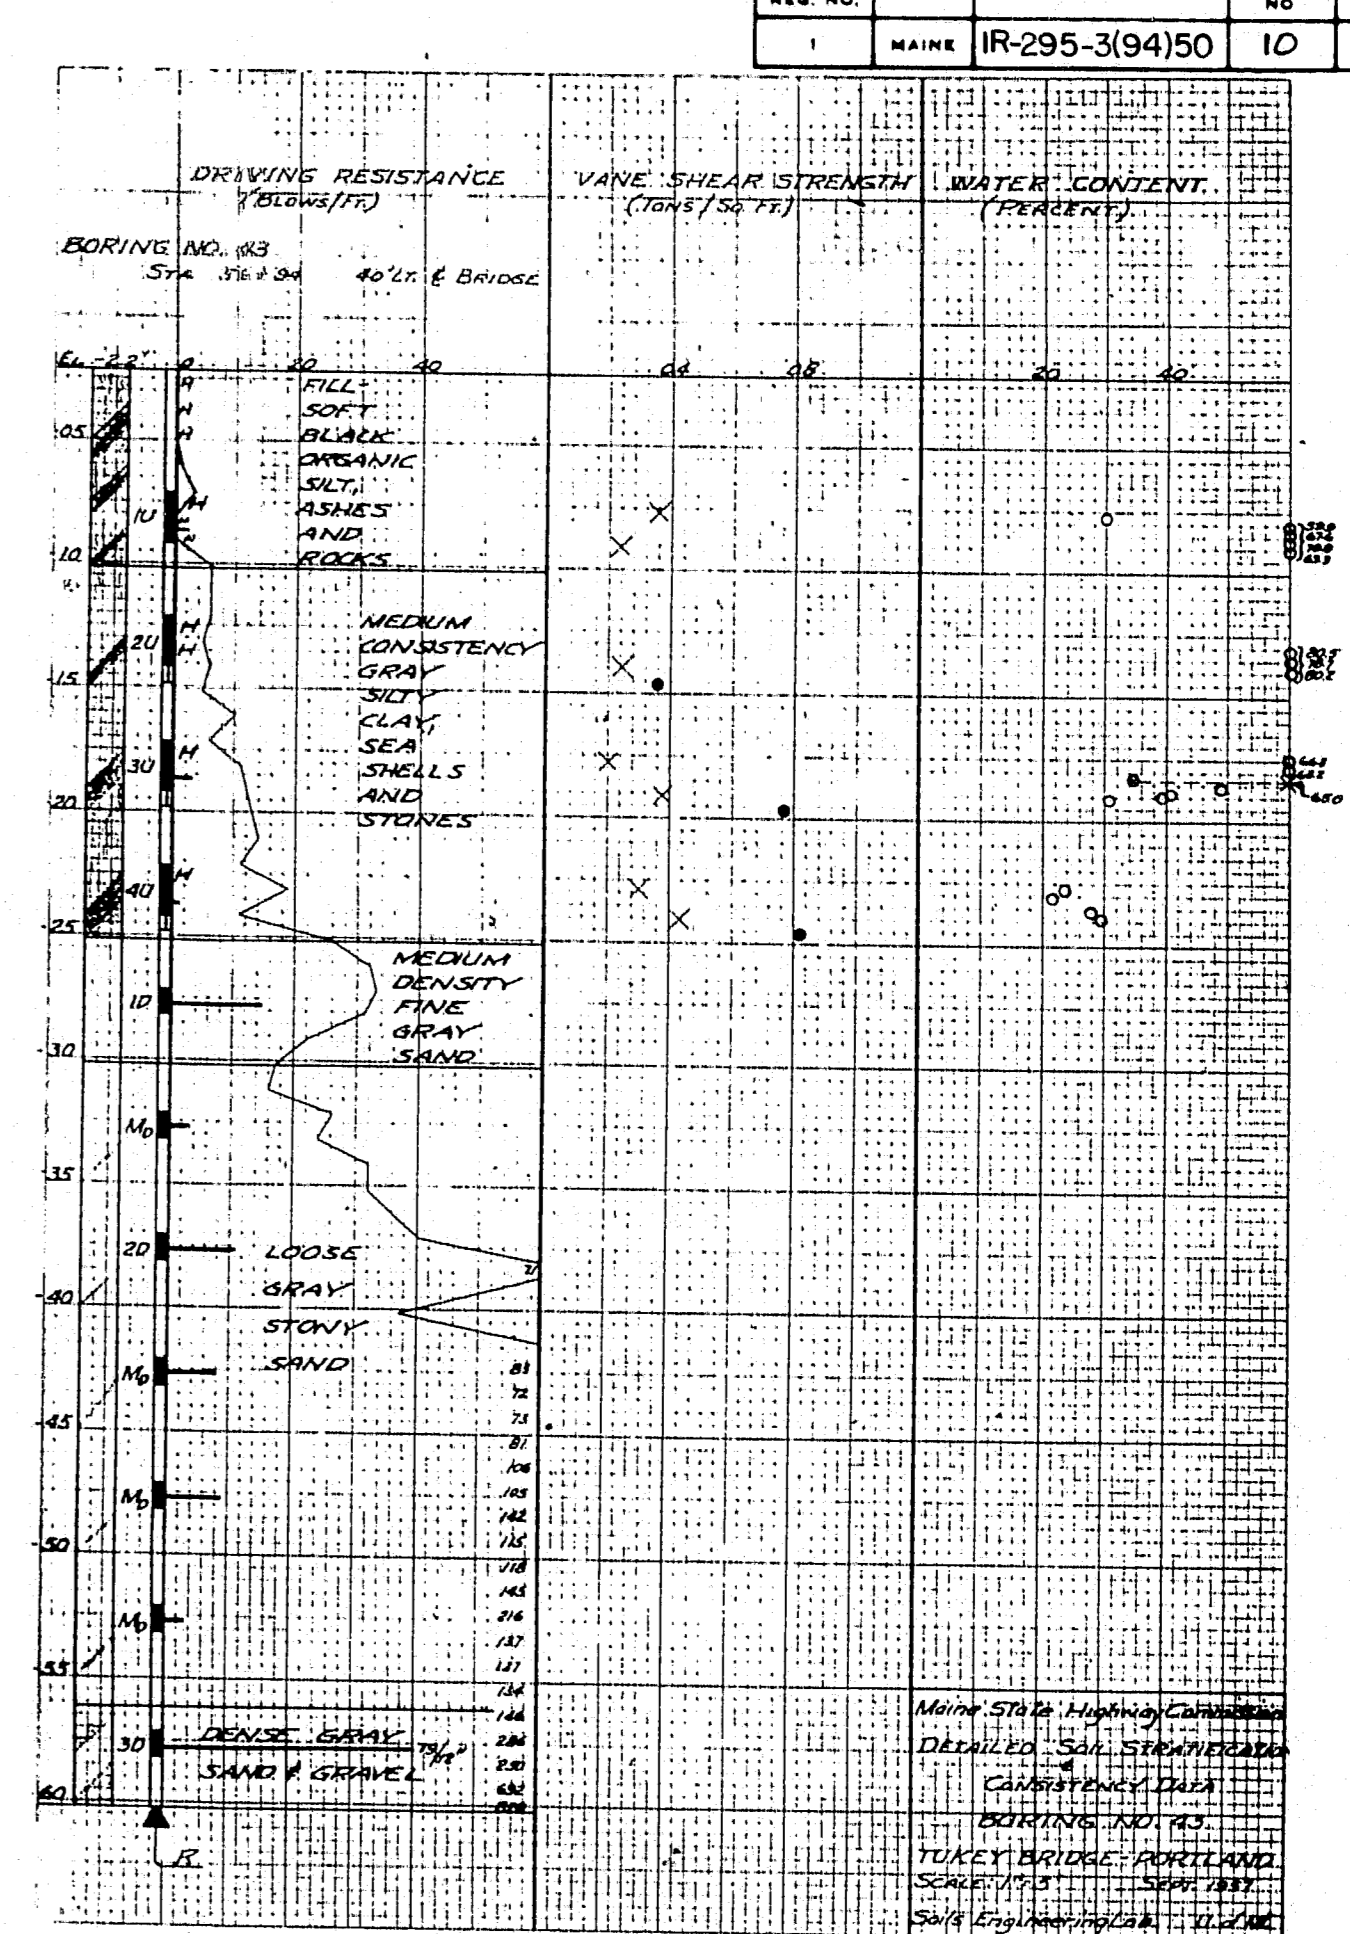

MAINE STATE HIGHWAY COMMISSION
 BORING NO. 83
 STATION 154+50.66' L
 TURKEY BRIDGE - PORTLAND
 SCALE: 1" = 10' (VERTICAL)
 DATE: NOVEMBER 1984
 SOIL ENGINEERING LAB. U.S.A.

PROJECT DESIGN ENGINEER	BY	DATE
DESIGN - DETAILED		
CHECKED		
REVISIONS		
FIELD CHANGES		



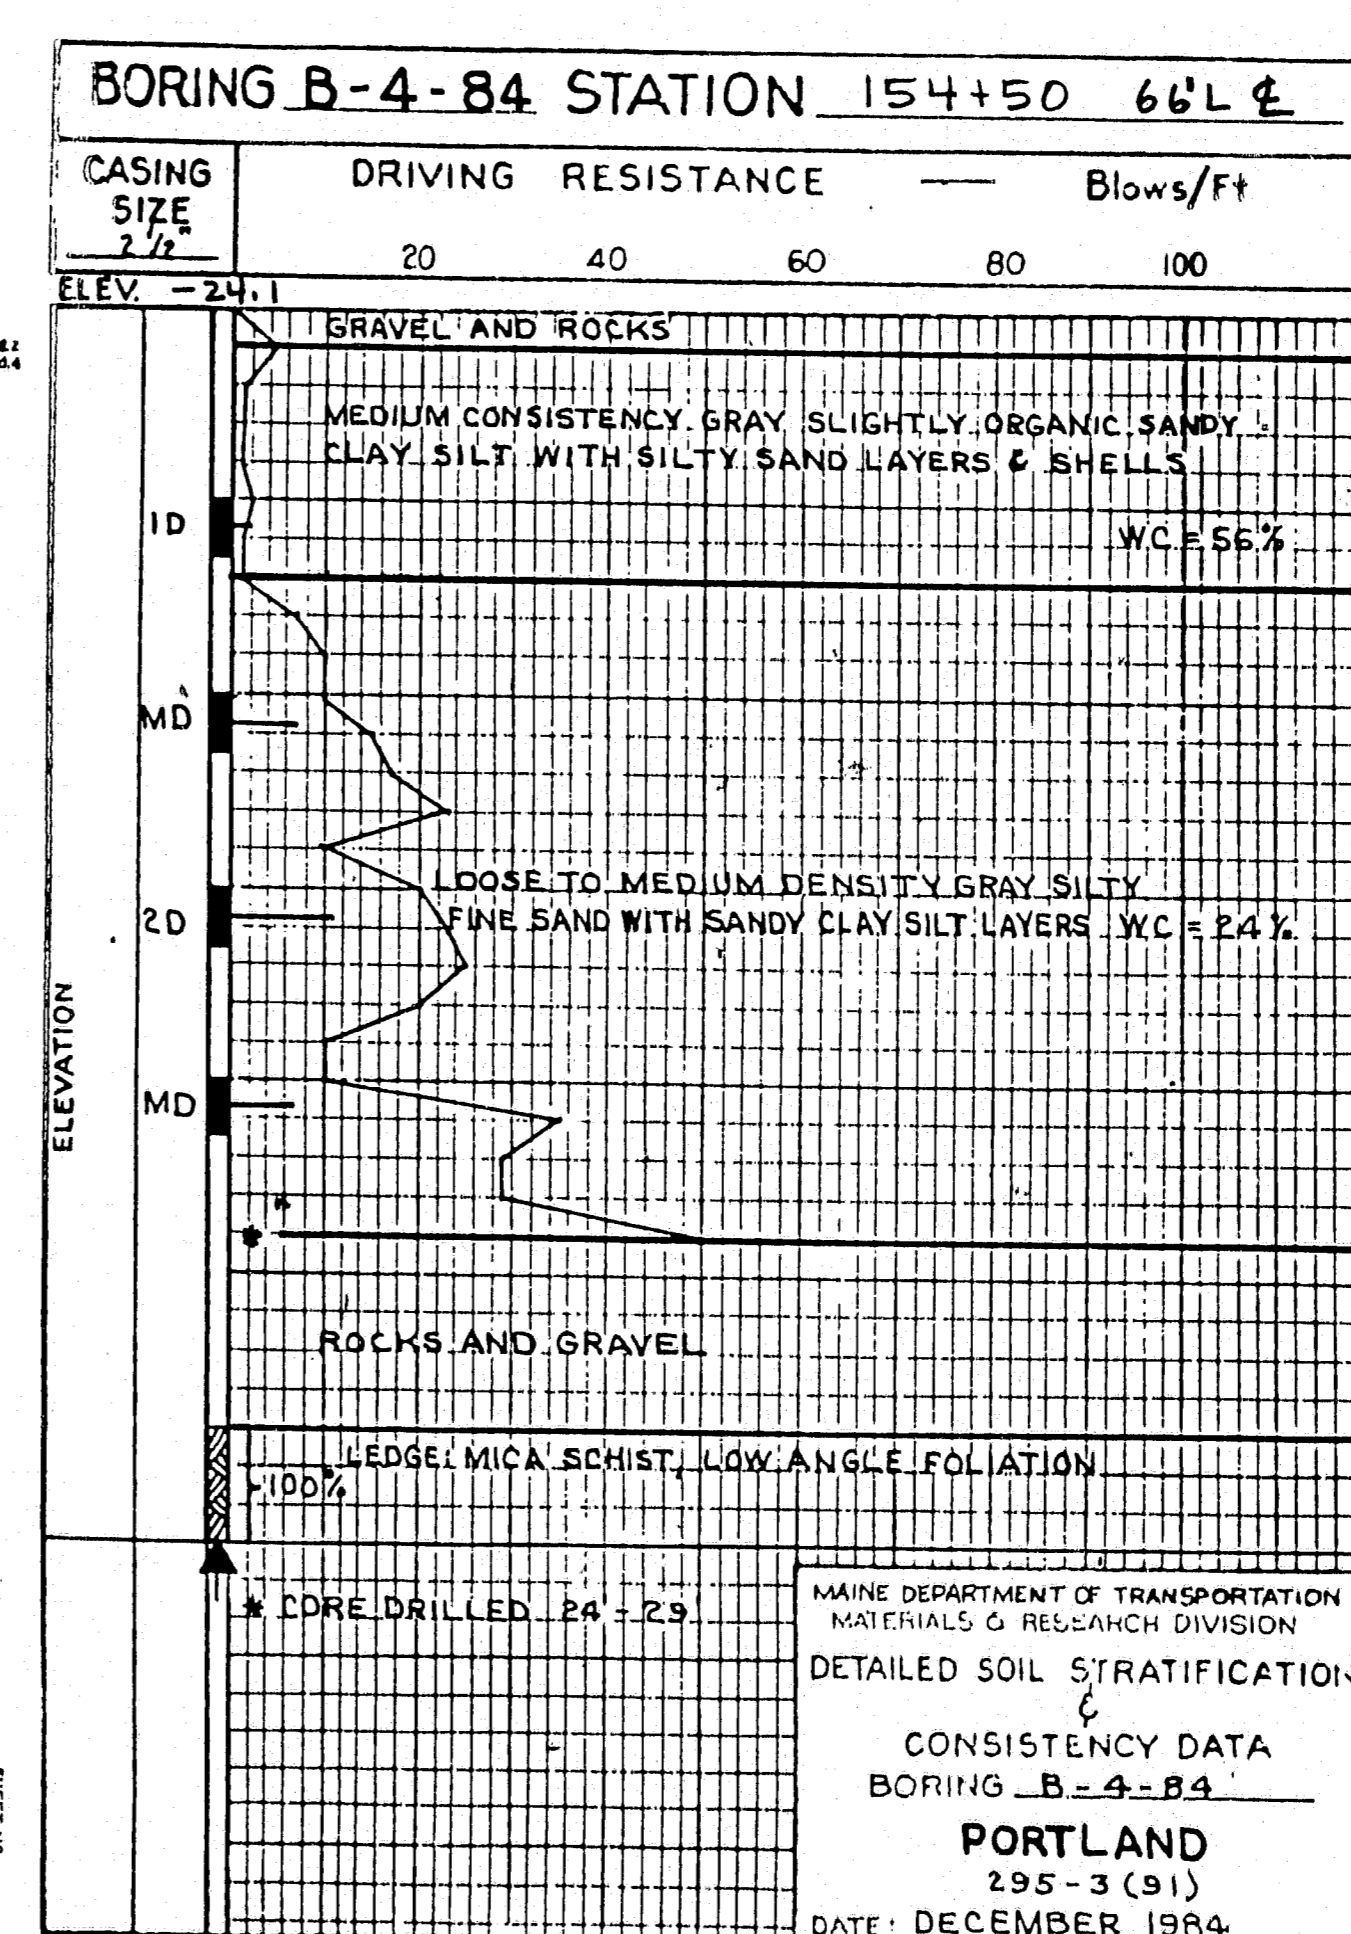
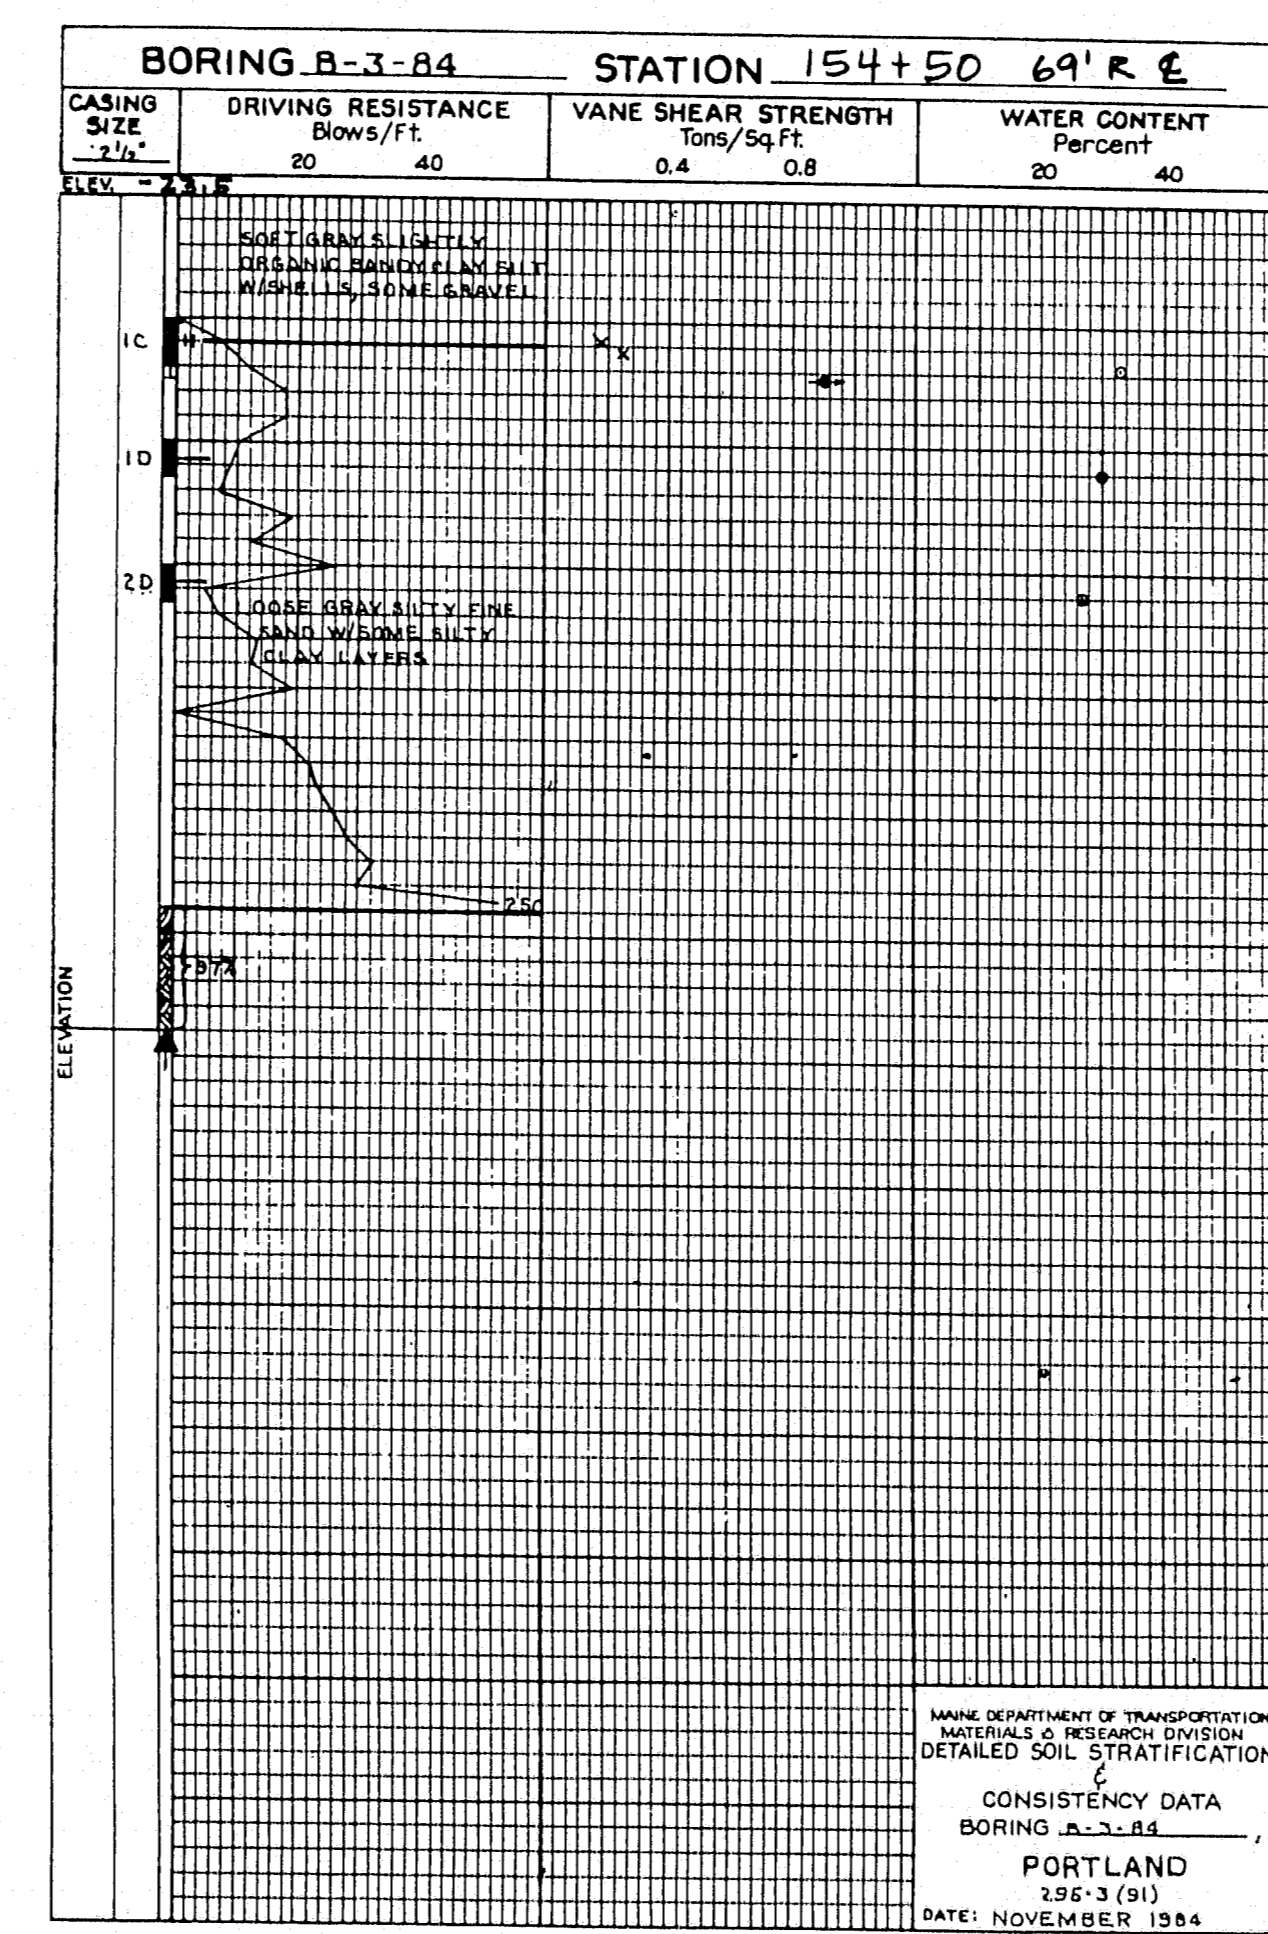
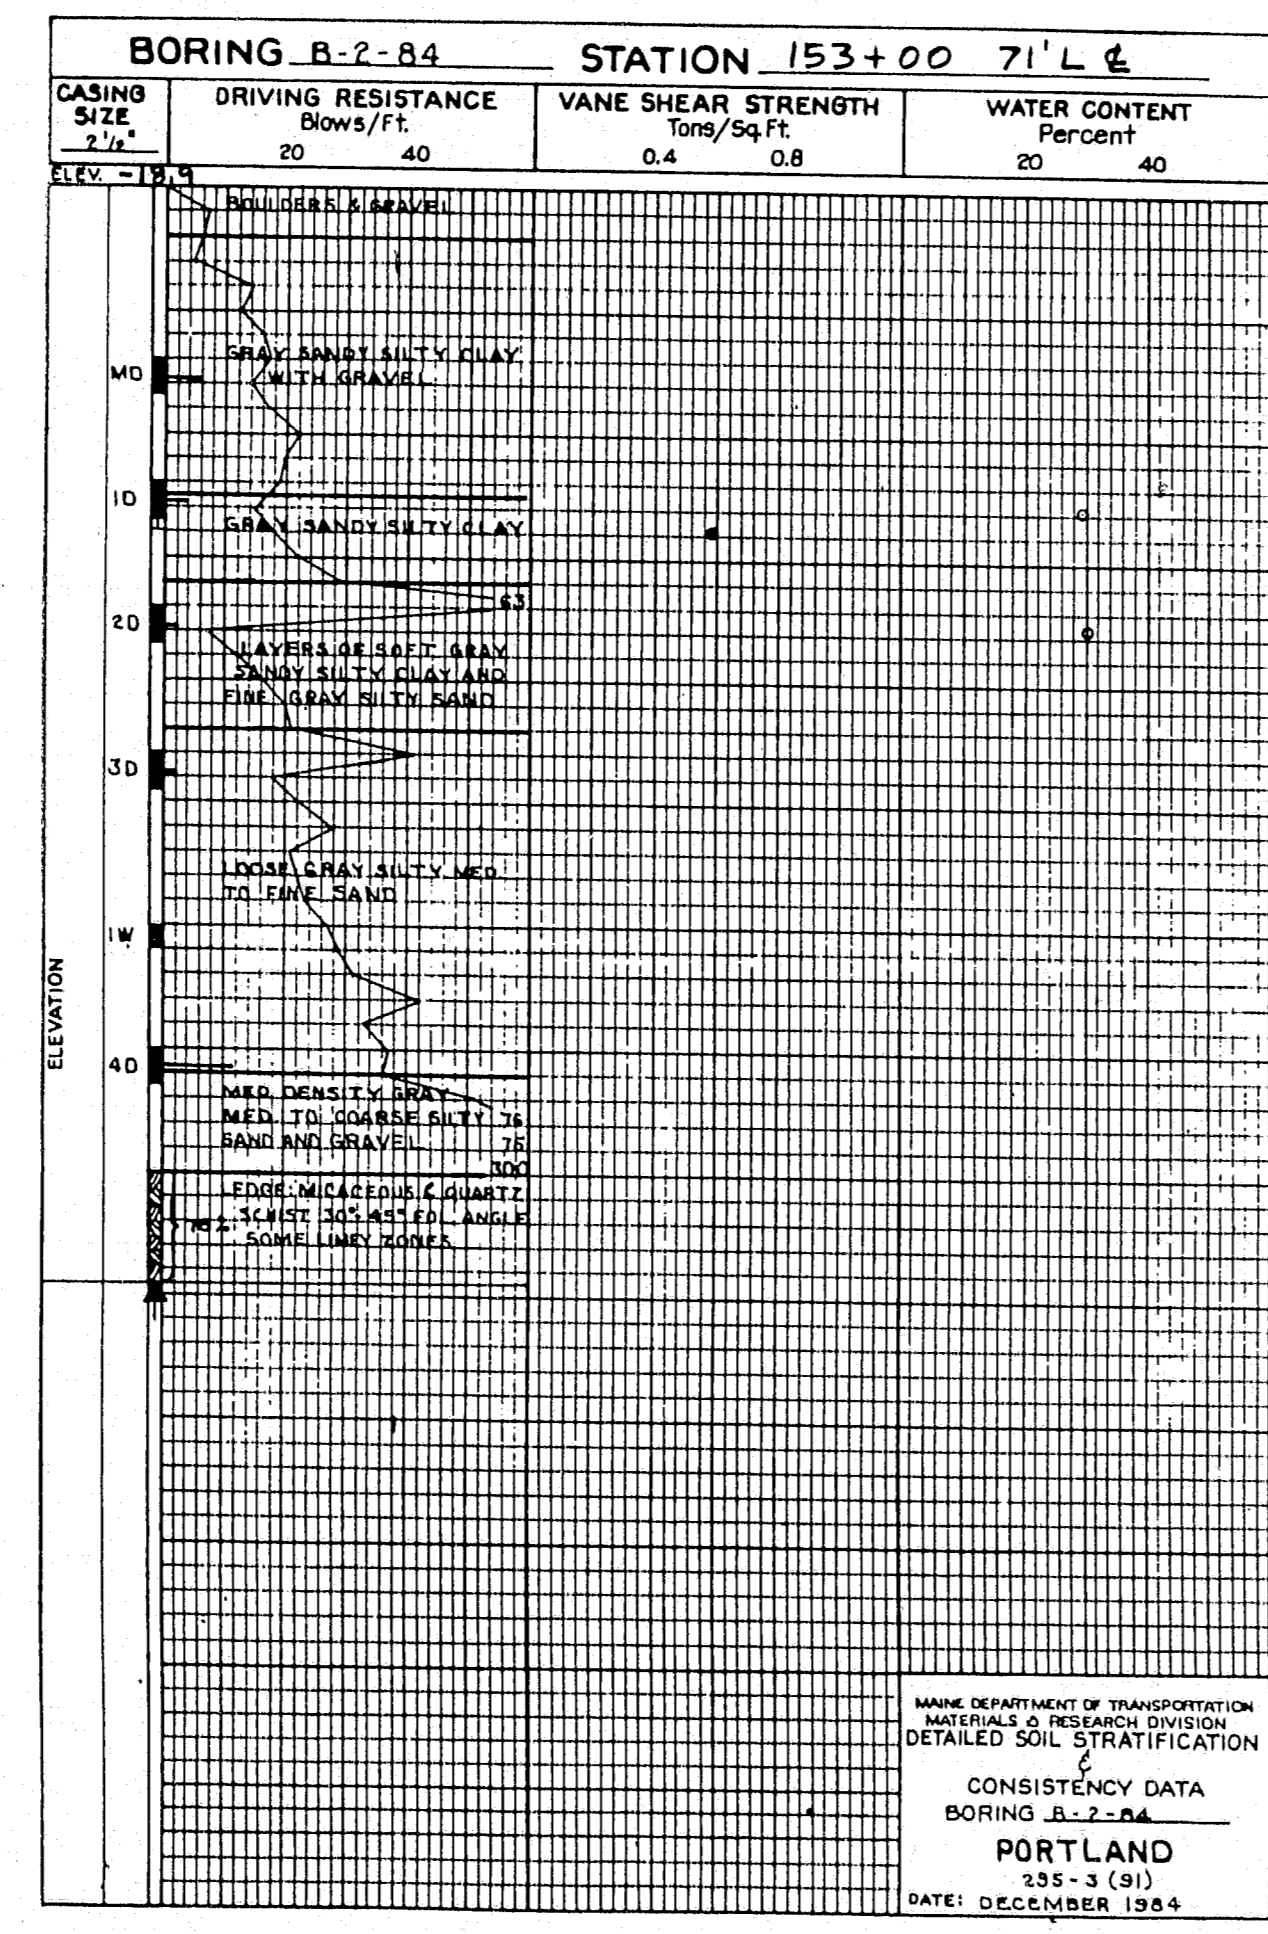
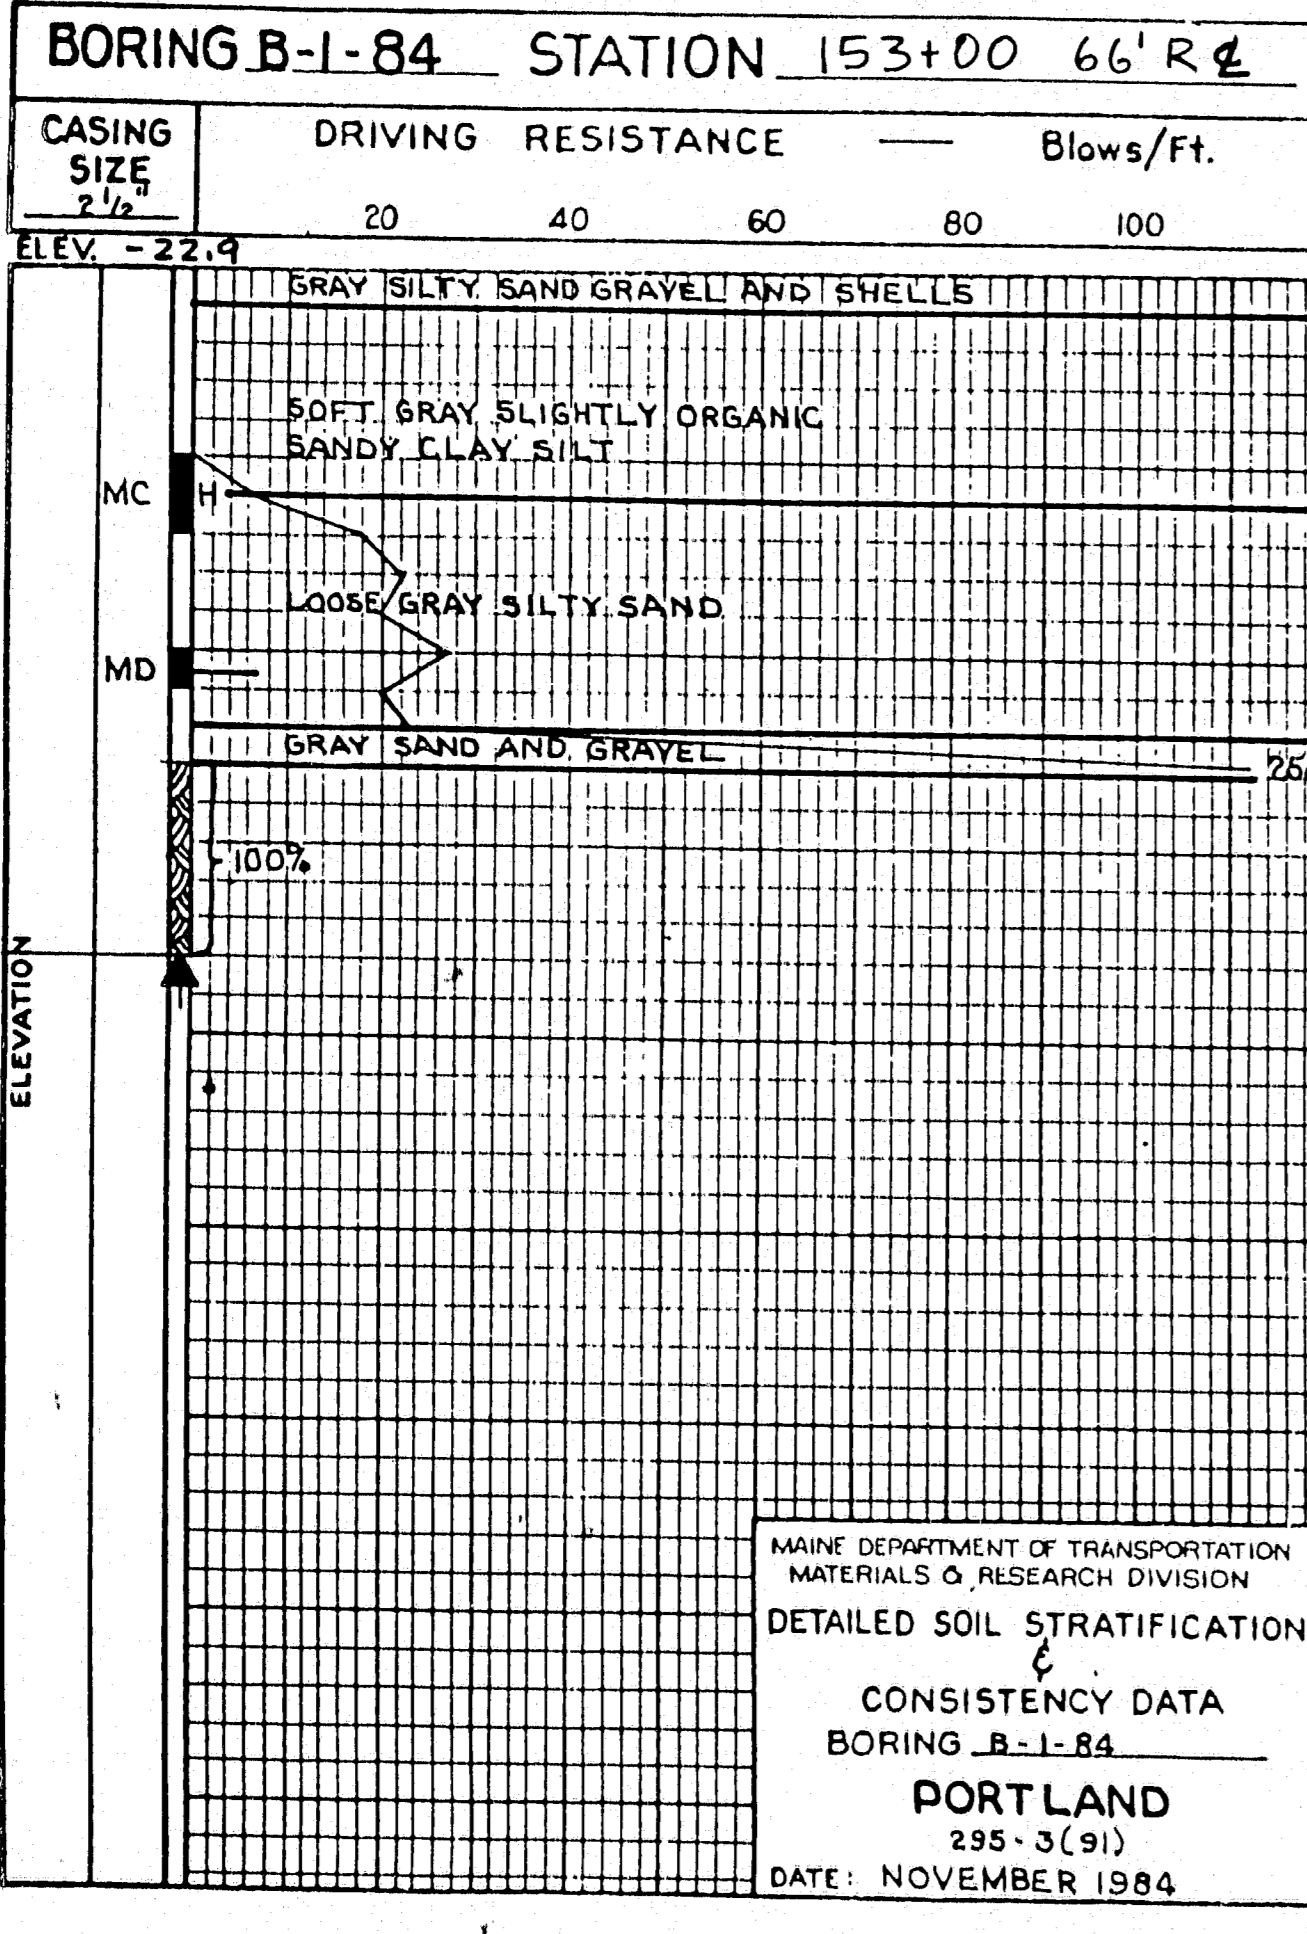


NOTE:
 REFER TO NOTES 1 TO 4, SHEET 10.5

103-271

STATE OF MAINE
 DEPARTMENT OF TRANSPORTATION
 I-295 INTERCHANGE COMPLEX
 TUKEYS BRIDGE
 OVER
 BACK COVE
 IN THE TOWN OF
 PORTLAND
 CUMBERLAND COUNTY
 SUBSURFACE SOILS DATA
 SHEET 6 OF 35 AUGUSTA, MAINE



F.R.W. NO.	STATE	PROJECT NUMBER	SHEET NO.	TOTAL SHEETS
1	MAINE	R-295-3(94)50	11	120

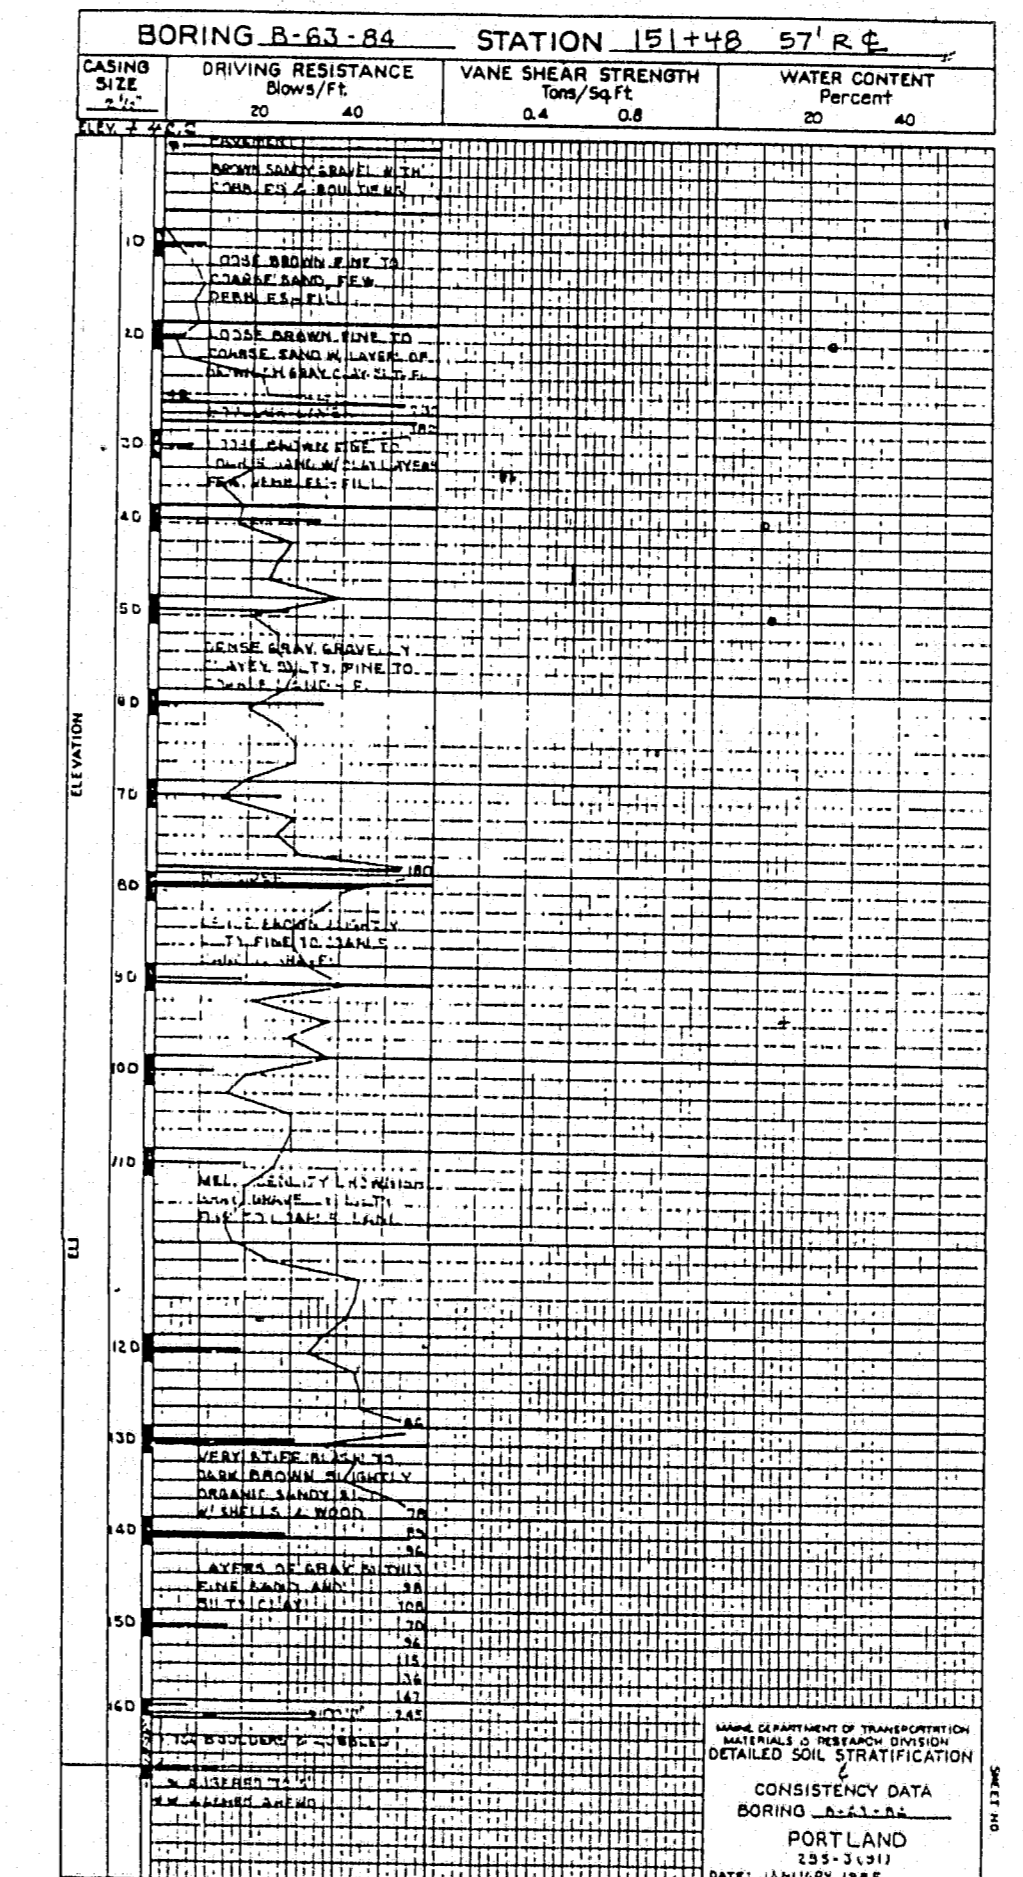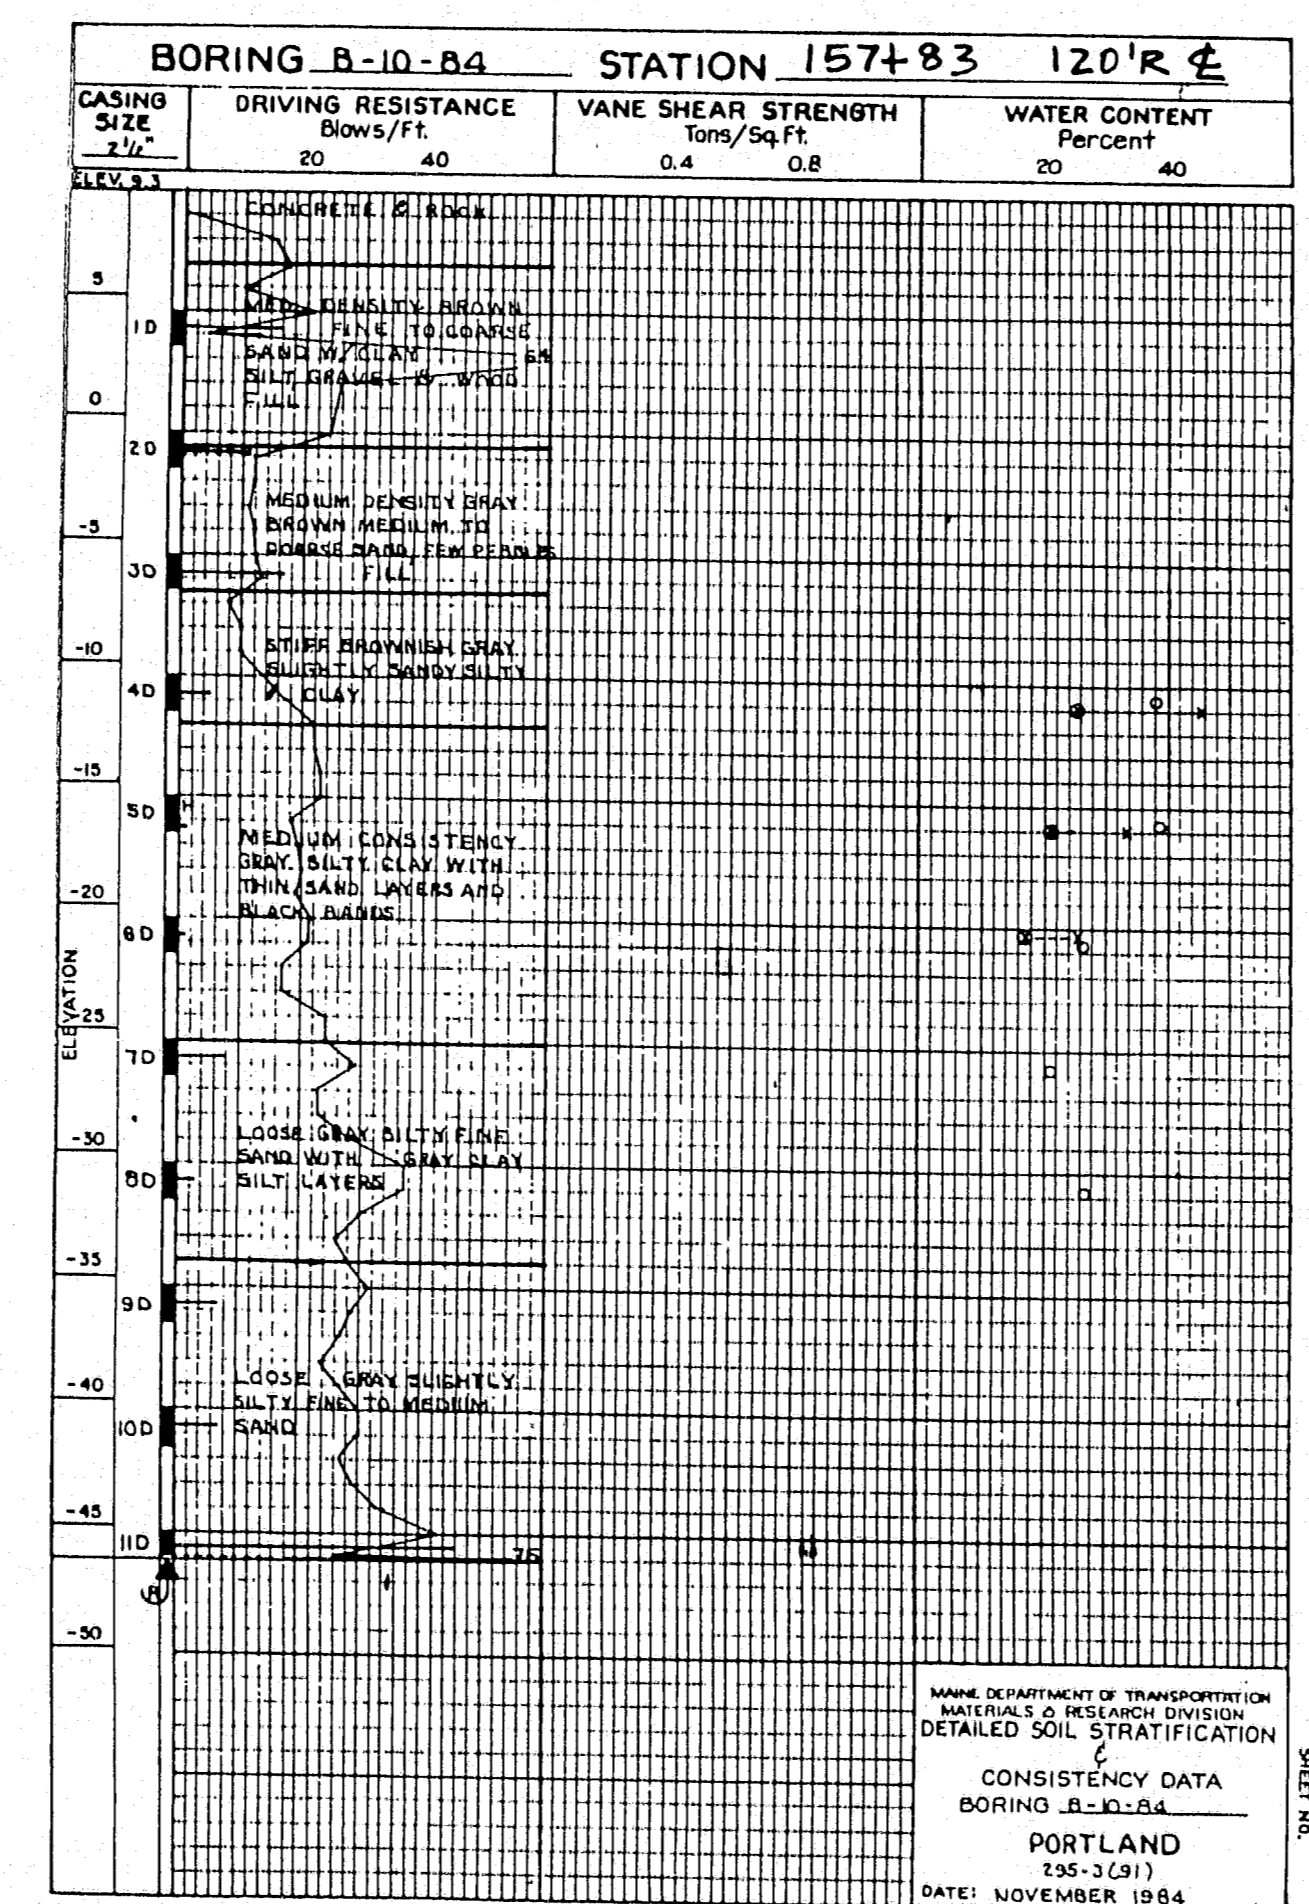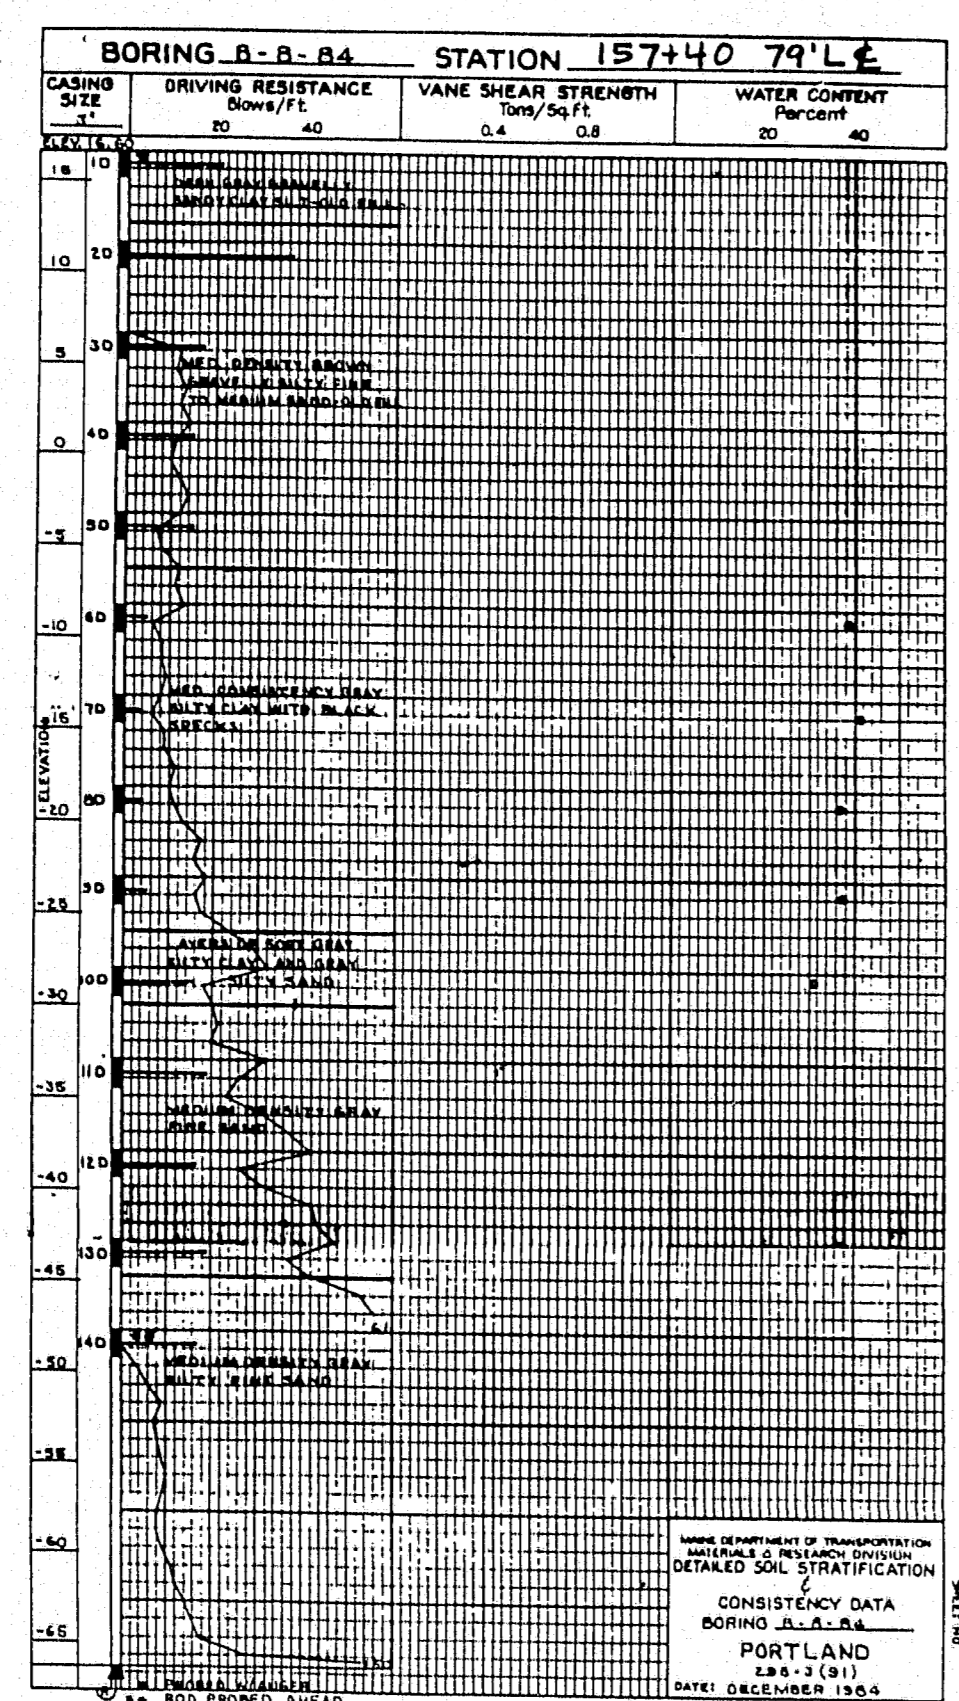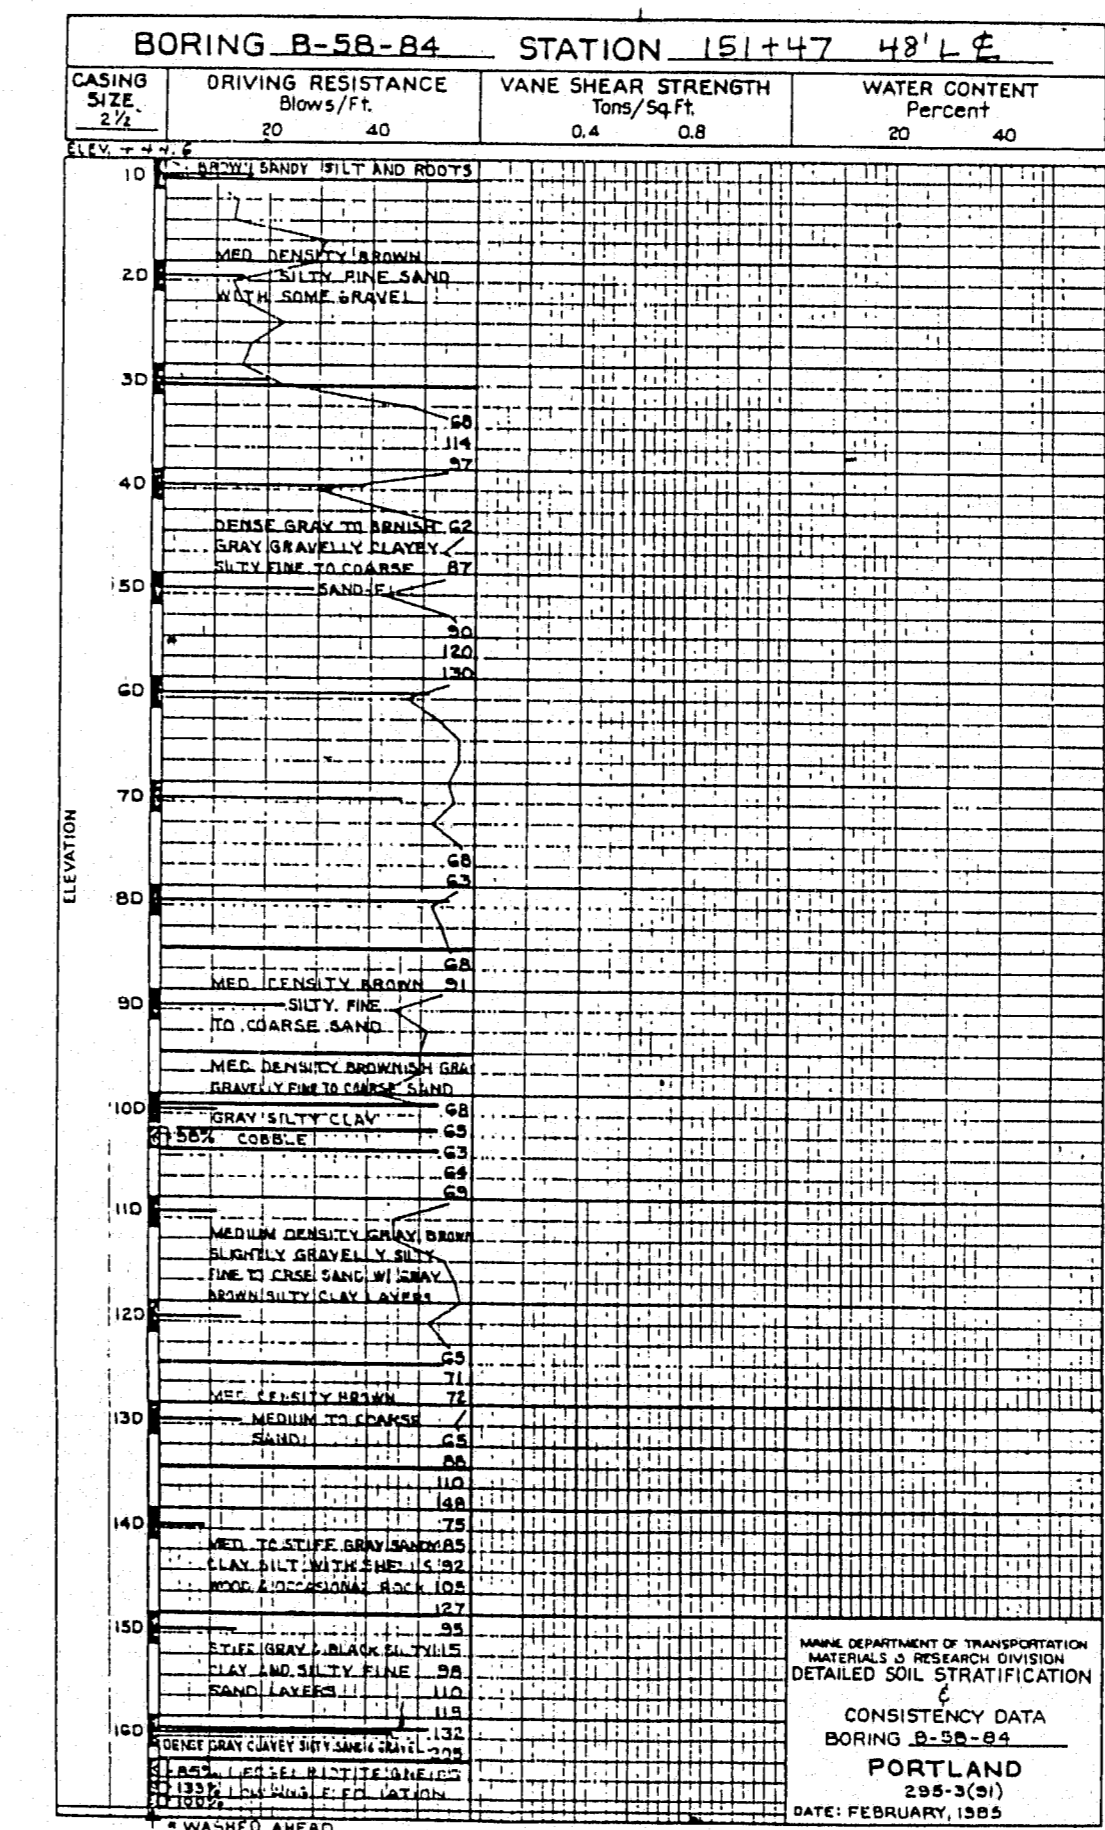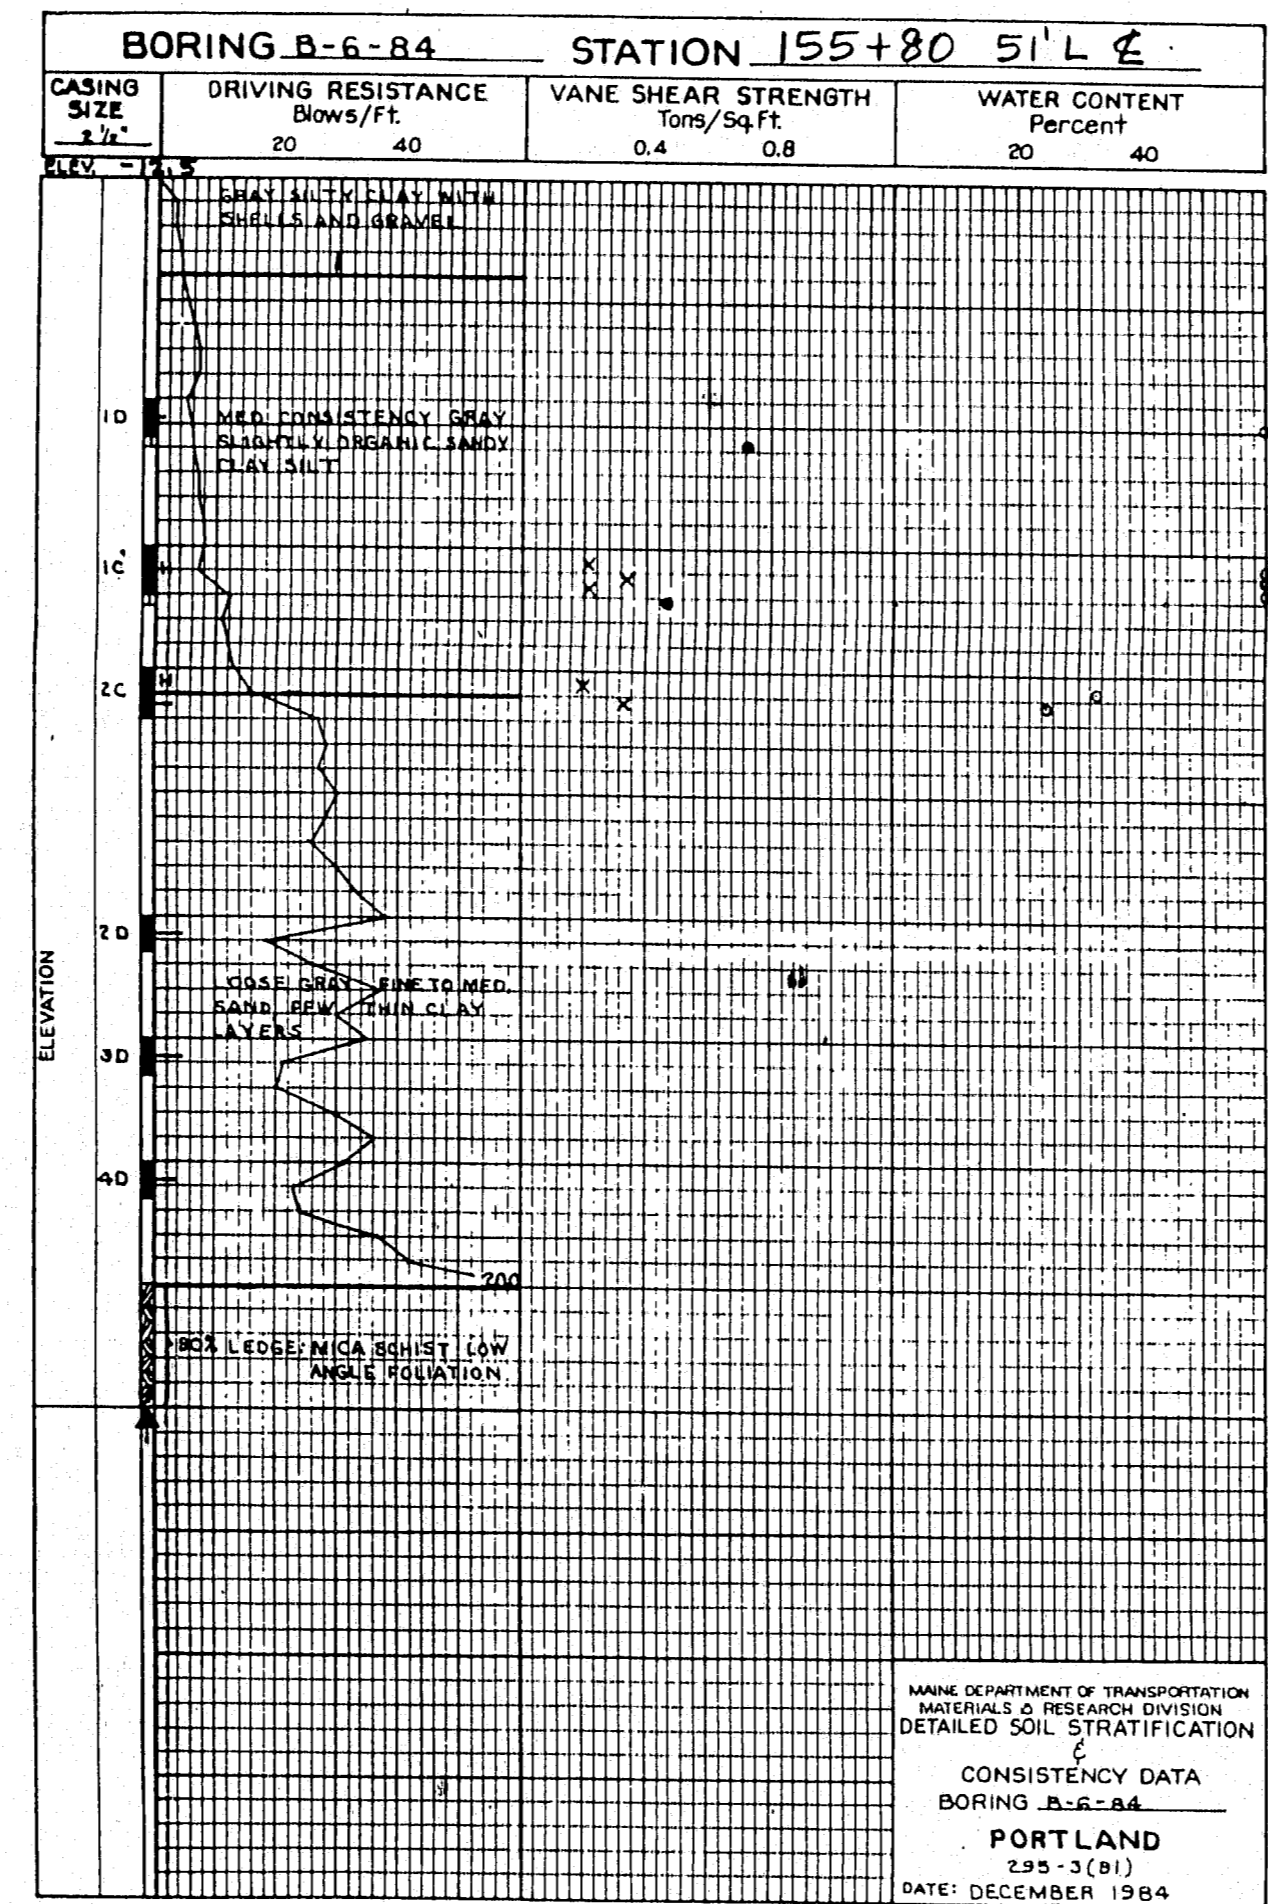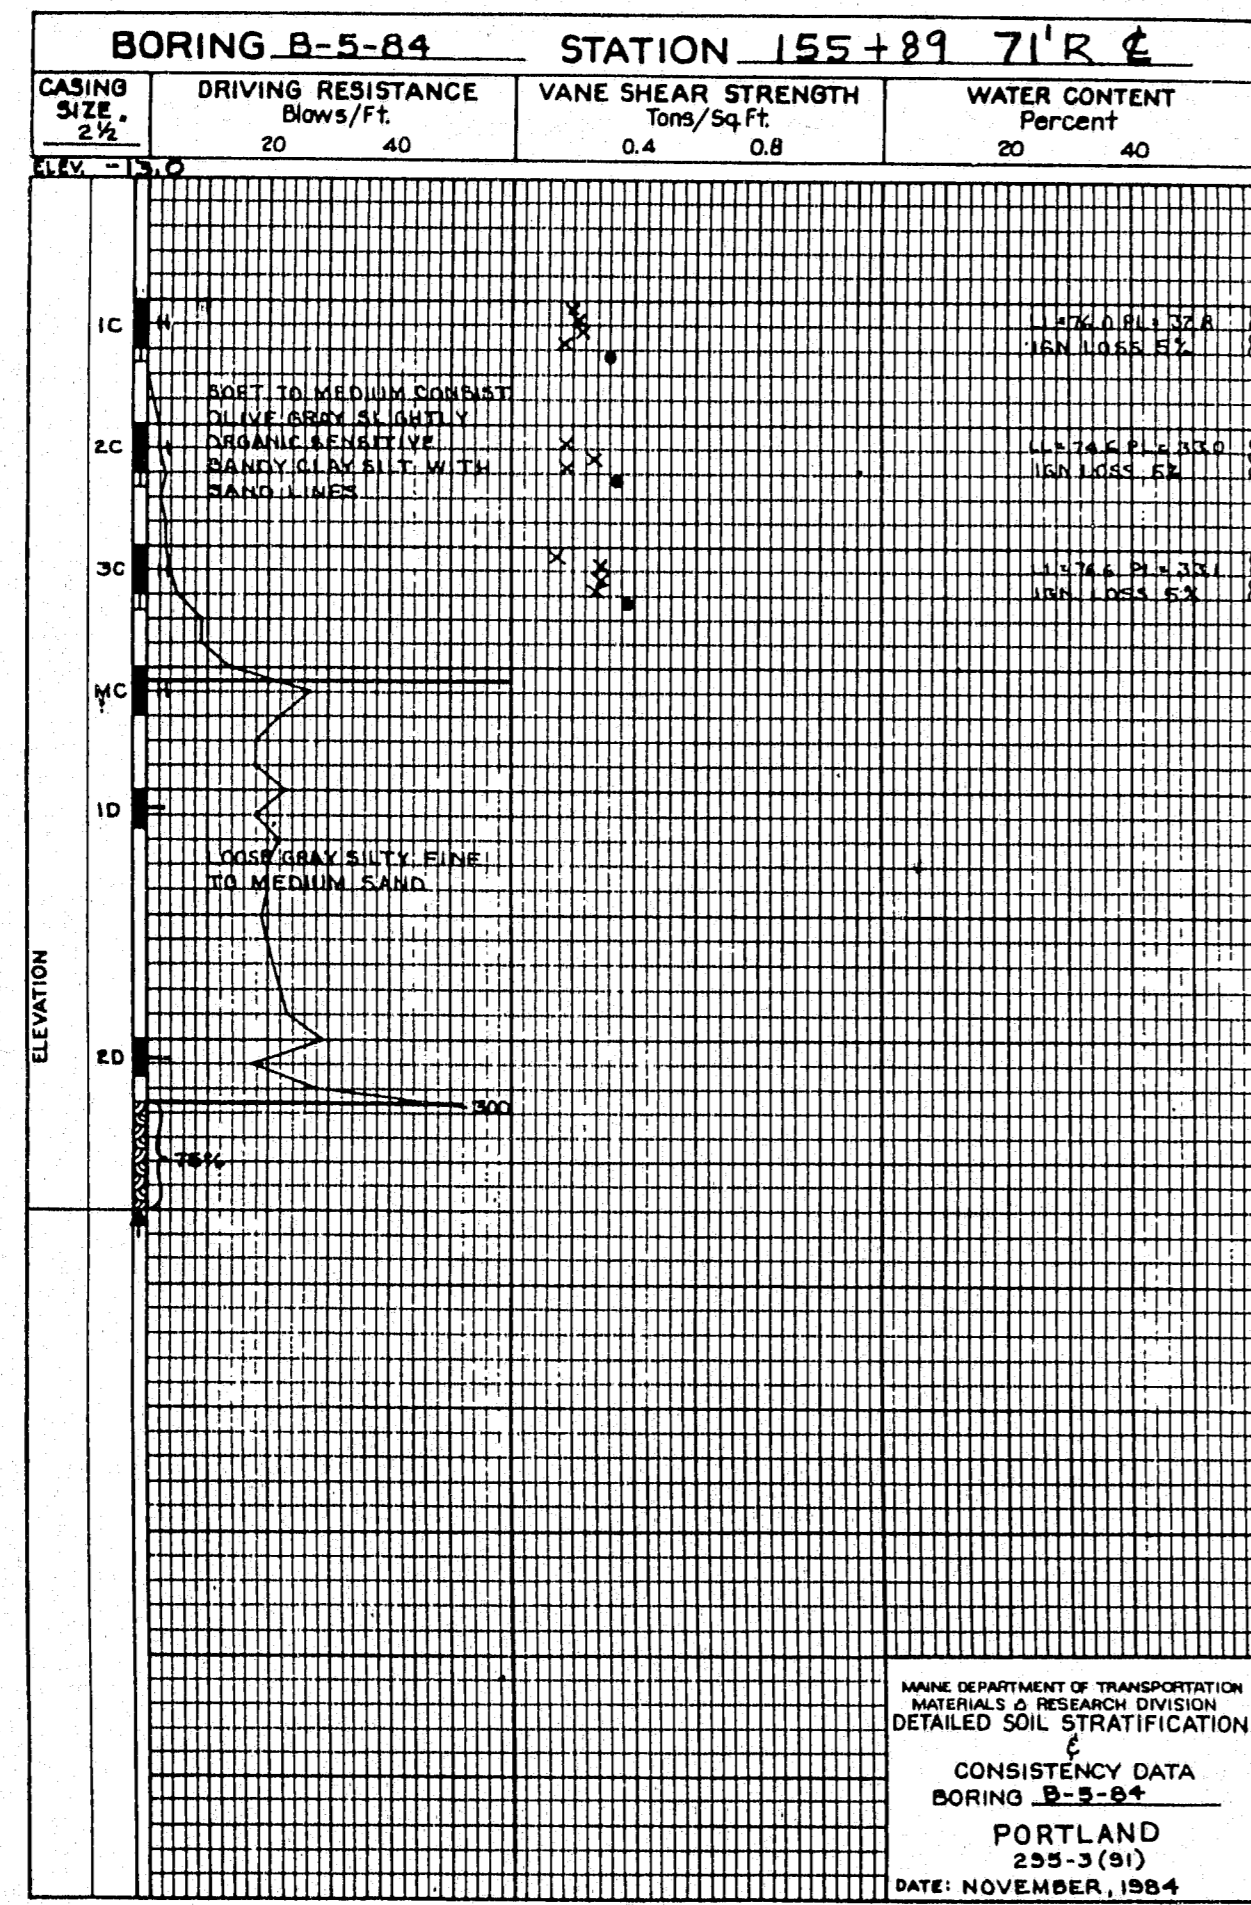

PROJECT DESIGN ENGINEER	BY	DATE
DESIGN - INSTALLED		
CHECKED		
REVISIONS		
FIELD CHANGES		

NOTE: 103-272
REFER TO NOTES 1 TO 4, SHEET NO. 9


STATE OF MAINE
DEPARTMENT OF TRANSPORTATION
I-295 INTERCHANGE COMPLEX
TUKEYS BRIDGE
OVER
BACK COVE
IN THE TOWN OF
PORTLAND
CUMBERLAND COUNTY
SUBSURFACE SOILS DATA
SHEET 7 OF 35 AUGUSTA, MAINE

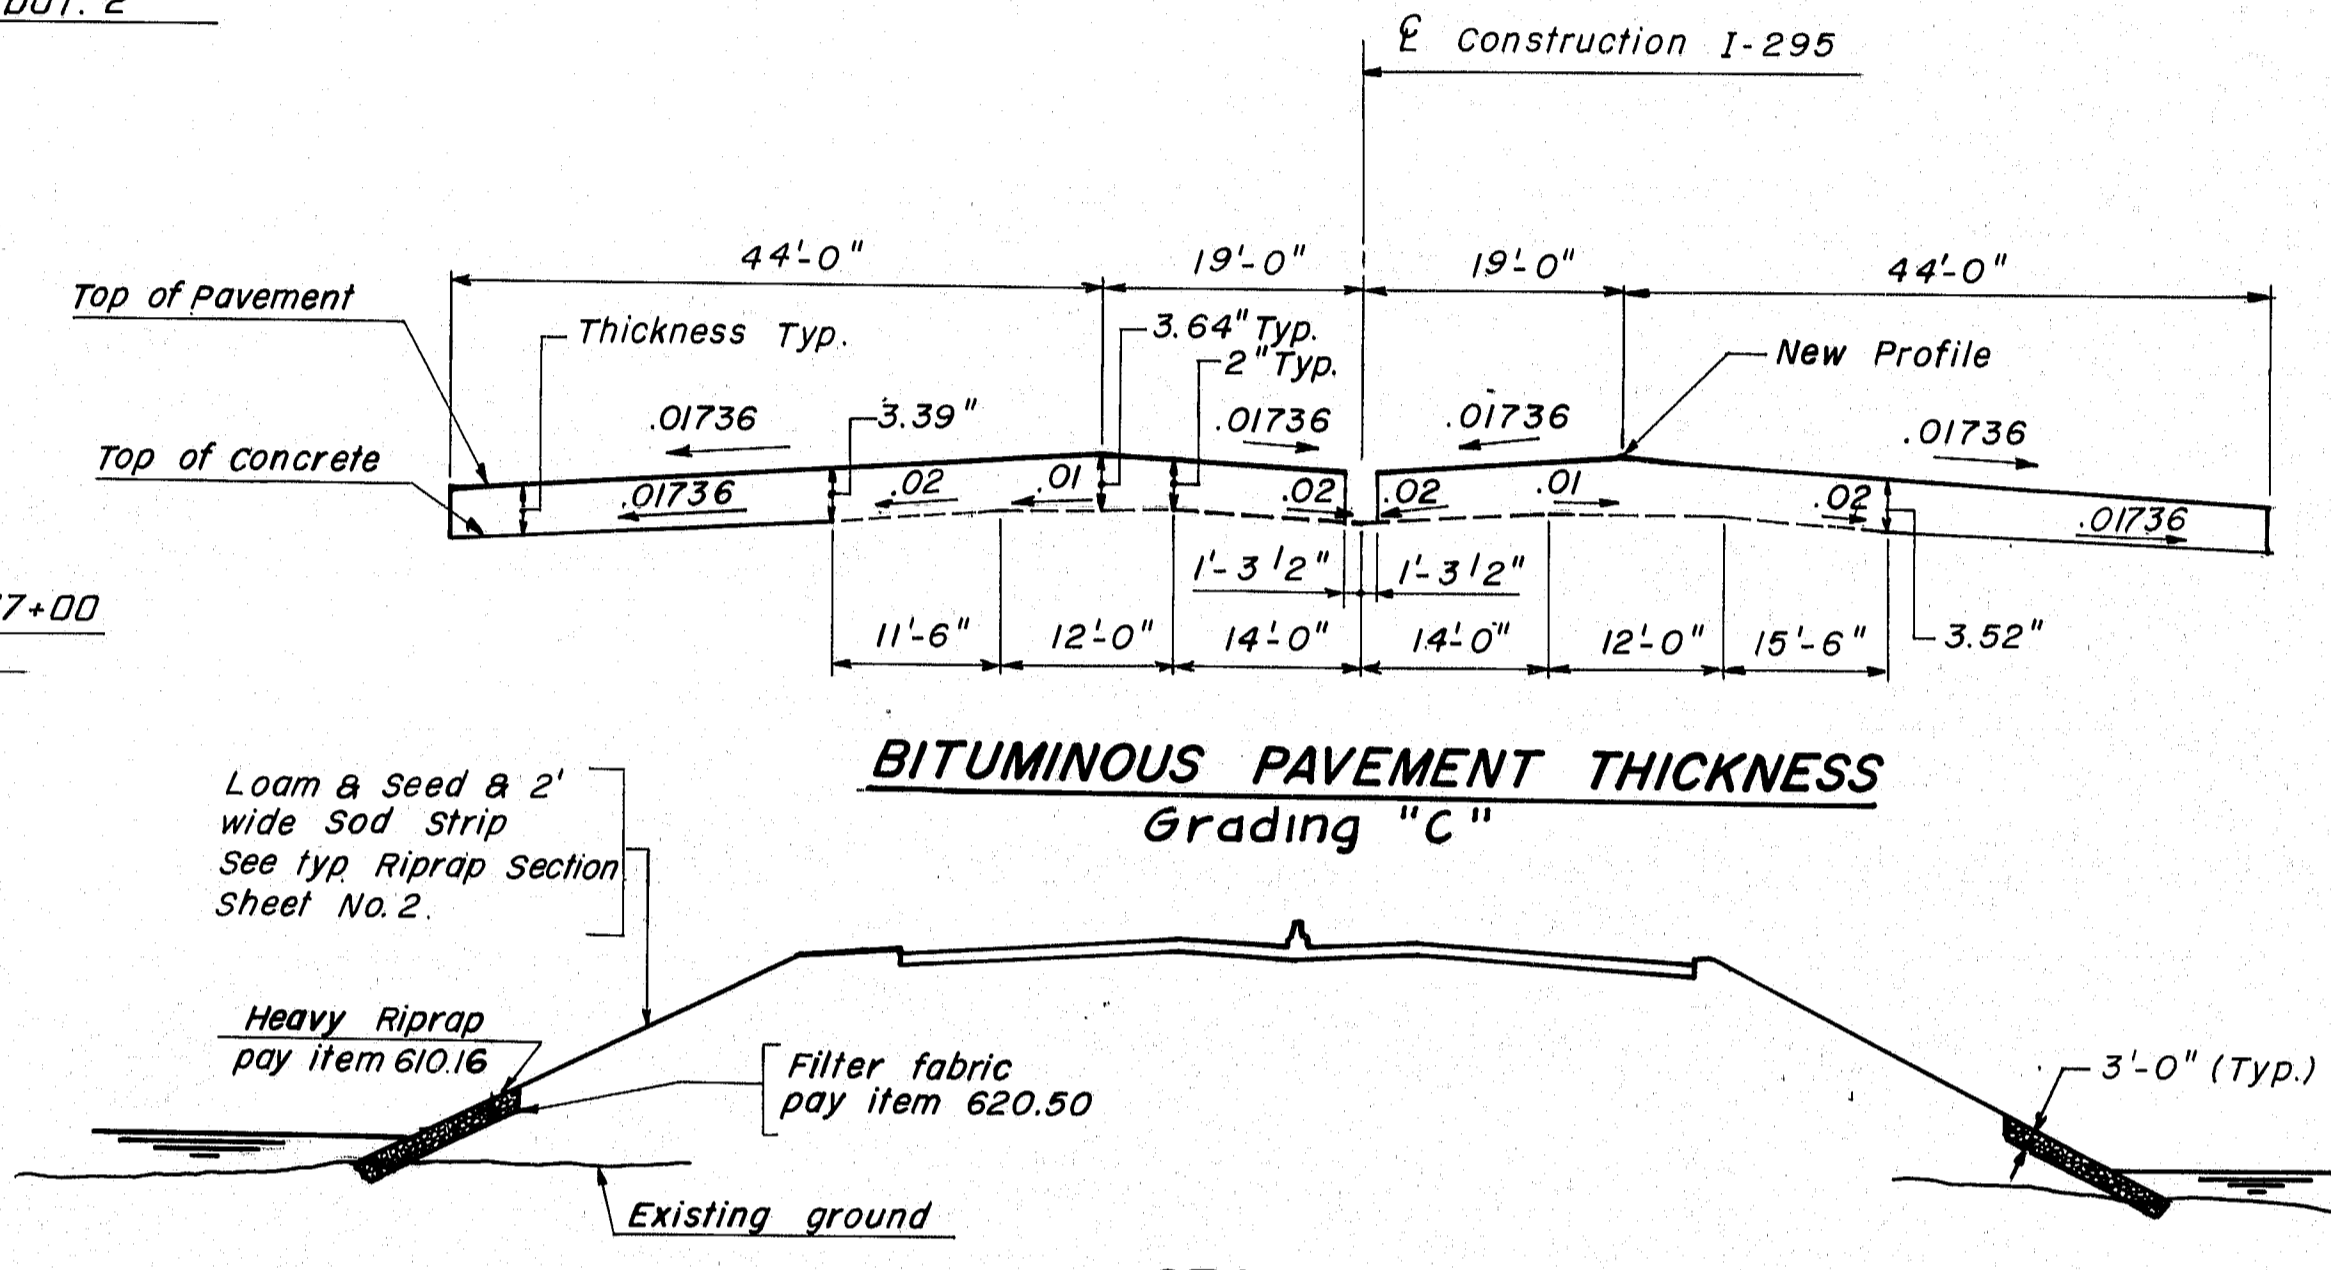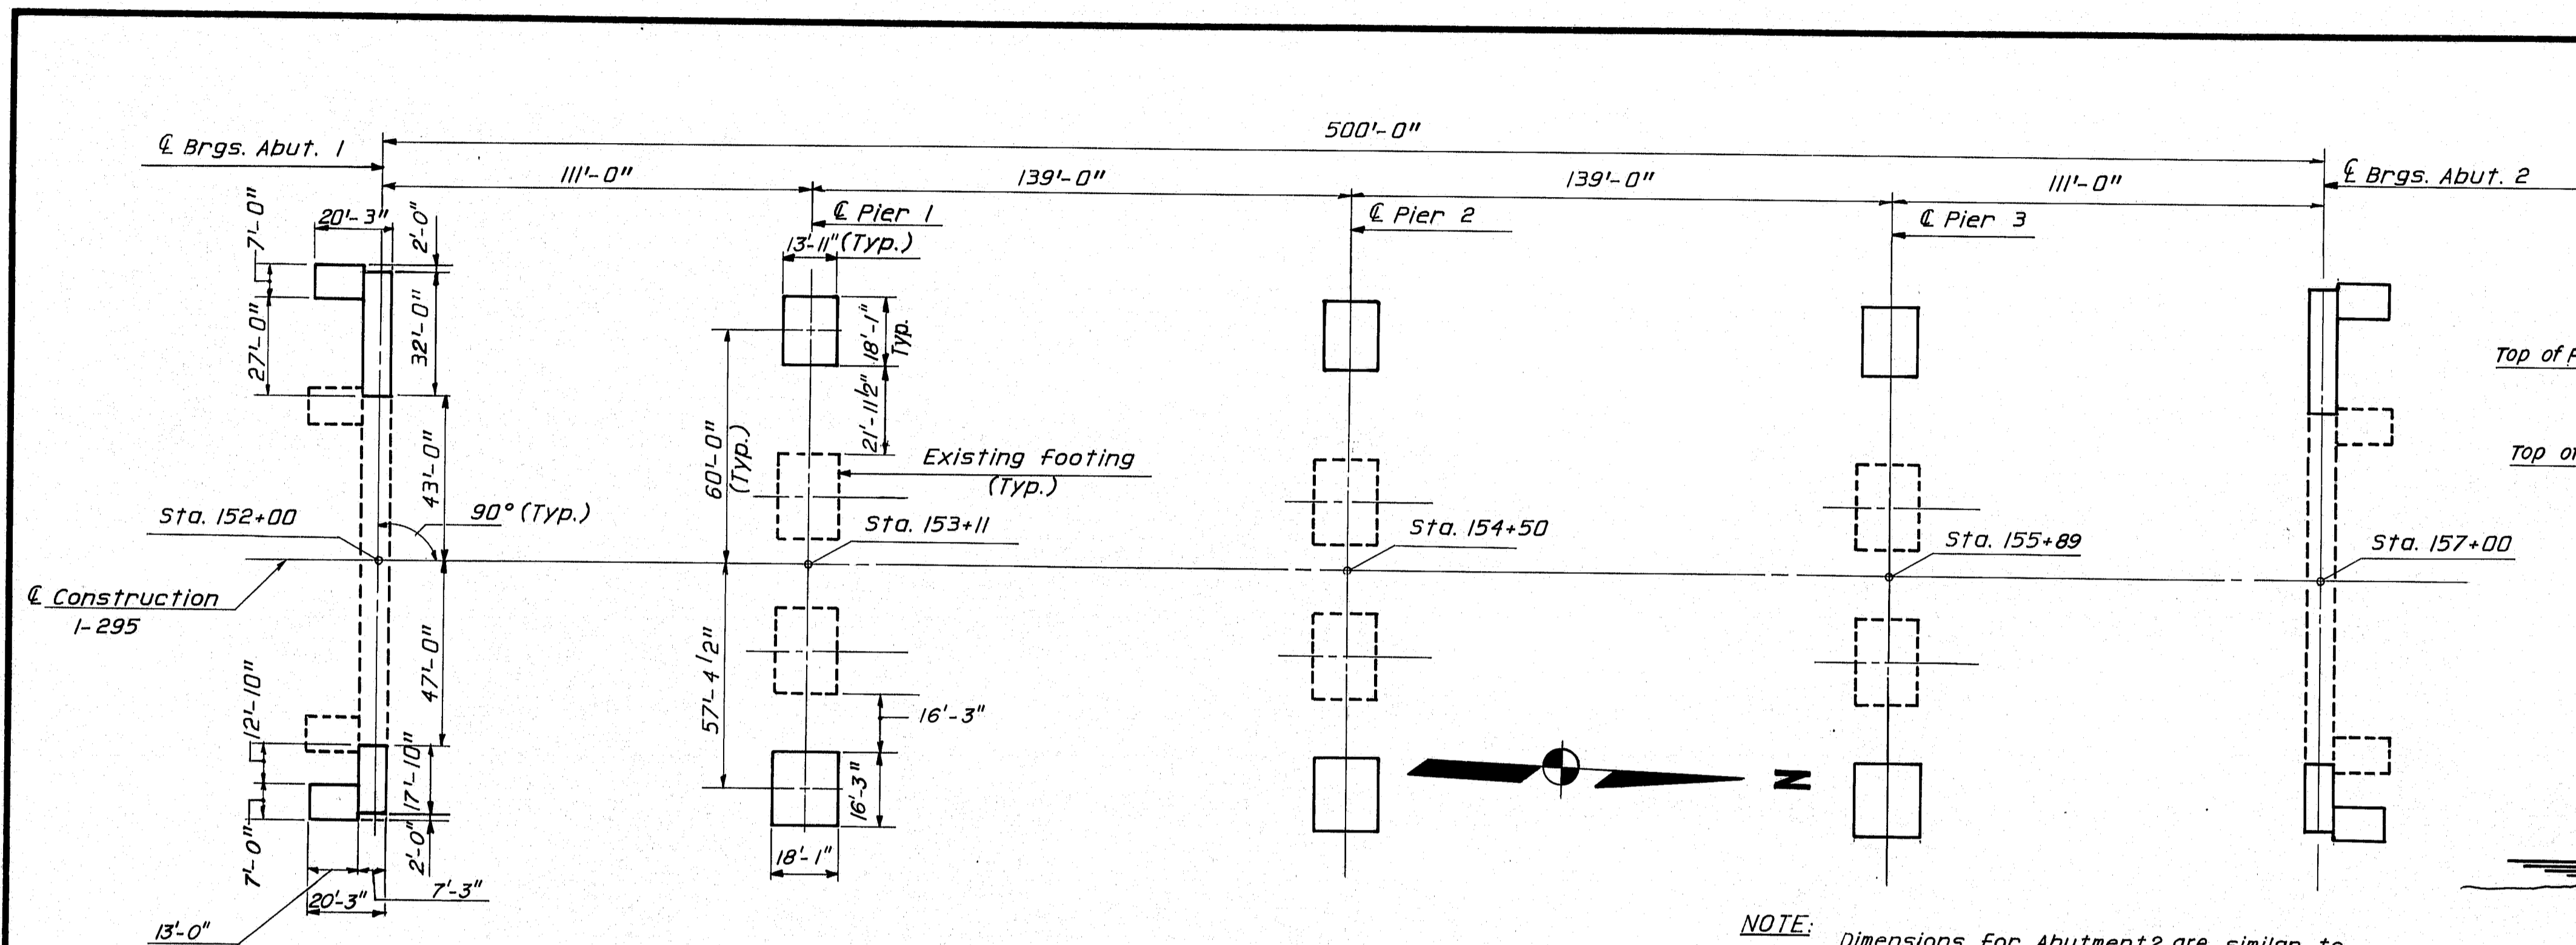

SUBSTRUCTURE LAYOUT

SECTION A-A
See Sheet 2 for Location

		BOTTOM OF SLAB ELEVATIONS																											
STATION		152+00 & E. Brg. Abut. 1	152+10	152+20	152+30	152+40	152+50	152+60	152+70	152+80	152+90	153+00	153+10	153+20	153+30	153+40	153+50	153+60	153+70	153+80	153+90	154+00	154+10	154+20	154+30	154+40	154+50 & E. Brg. Abut. 2		
G1	Elevation	43.460	43.503	43.532	43.542	43.530	43.499	43.443	43.370	43.271	43.196	43.075	42.959	42.954	42.842	42.721	42.593	42.455	42.305	42.138	41.953	41.748	41.523	41.285	41.033	40.771	40.502	40.238	
	Conc. DL + Superimposed DL Deflection (Ft.)	0	.028	.053	.071	.079	.079	.070	.055	.036	.018	.005	0	0	.005	.018	.036	.055	.072	.083	.088	.084	.073	.056	.036	.018	.005	0	
G2	Elevation	43.599	43.643	43.672	43.682	43.671	43.640	43.583	43.510	43.420	43.320	43.214	43.098	43.093	42.981	42.860	42.732	42.595	42.446	42.273	42.093	41.888	41.663	41.437	41.173	40.910	40.641	40.377	
	Conc. DL + Superimposed DL Deflection (Ft.)	0	.029	.054	.072	.081	.081	.071	.056	.036	.018	.005	0	0	.005	.018	.036	.056	.073	.085	.089	.085	.074	.057	.037	.018	.005	0	
G3	Elevation	43.738	43.781	43.799	43.821	43.810	43.779	43.722	43.649	43.559	43.459	43.353	43.237	43.205	43.120	42.999	42.871	42.734	42.585	42.418	42.232	42.027	41.802	41.565	41.312	41.064	40.780	40.515	
	Conc. DL + Superimposed DL Deflection (Ft.)	0	.029	.054	.072	.081	.081	.071	.056	.036	.018	.005	0	0	.005	.018	.036	.056	.073	.085	.089	.085	.074	.057	.037	.018	.005	0	
G4	Elevation	43.878	43.922	43.951	43.961	43.951	43.919	43.863	43.789	43.700	43.599	43.493	43.337	43.371	43.260	43.139	43.047	42.875	42.726	42.561	42.383	42.168	41.943	41.705	41.452	41.189	40.920	40.654	
	Conc. DL + Superimposed DL Deflection (Ft.)	0	.029	.054	.072	.082	.081	.072	.056	.037	.018	.005	0	0	.005	.018	.037	.057	.074	.086	.090	.086	.075	.057	.037	.018	.005	0	
G15	Elevation	43.728	43.764	43.783	43.786	43.756	43.726	43.679	43.598	43.513	43.416	43.314	43.190	43.184	43.061	42.935	42.800	42.657	42.525	42.376	42.207	42.017	41.779	41.565	41.306	41.038	40.764	40.495	
	Conc. DL + Superimposed DL Deflection (Ft.)	0	.033	.062	.083	.093	.092	.082	.063	.042	.021	.006	0	0	.005	.018	.037	.059	.078	.091	.096	.092	.080	.061	.039	.019	.005	0	
G16	Elevation	43.573	43.605	43.622	43.620	43.597	43.553	43.503	43.435	43.358	43.258	43.158	43.035	43.029	42.908	42.778	42.641	42.495	42.341	42.210	42.041	41.851	41.649	41.403	41.146	40.881	40.609	40.340	
	Conc. DL + Superimposed DL Deflection (Ft.)	0	.029	.054	.072	.081	.080	.071	.055	.036	.018	.005	0	0	.004	.016	.033	.052	.069	.080	.085	.081	.070	.054	.034	.017	.004	0	

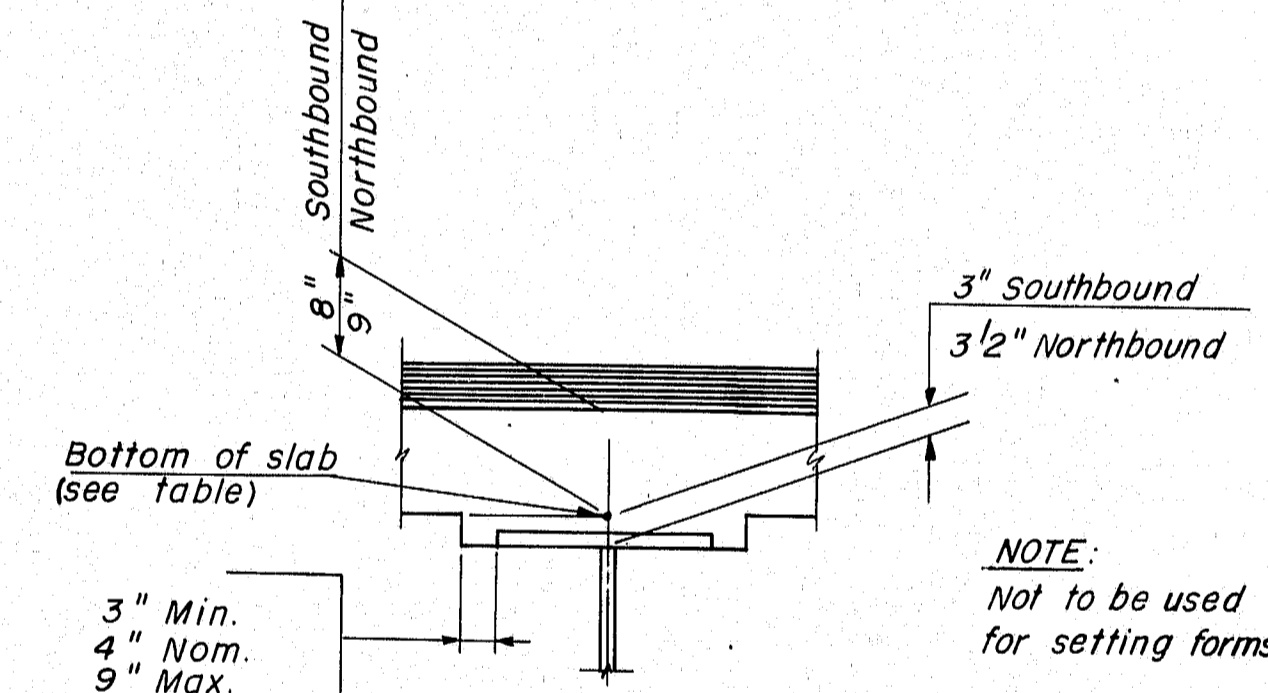

BLOCKING DETAIL

NOTE:
1. Elevations are based on Field Book No. 295/1304
2. Bottom of slab elevations are adjusted to compensate for Concrete Dead Load & Superimposed Dead Load deflections.

		BOTTOM OF SLAB ELEVATIONS																											
STATION		154+50 & E. Brg. Abut. 2	154+60	154+70	154+80	154+90	155+00	155+10	155+20	155+30	155+40	155+50	155+60	155+70	155+80	155+90	156+00	156+10	156+20	156+30	156+40	156+50	156+60	156+70	156+80	156+90	157+00 & E. Brg. Abut. 2		
G1	Elevation	40.238	39.954	39.675	39.389	39.093	38.783	38.457	38.112	37.755	37.387	37.015	36.626	36.238	35.855	35.524	35.180	34.815	34.478	34.163	33.844	33.519	33.155	32.783	32.401	32.012	31.620		
	Conc. DL + Superimposed DL Deflection (Ft.)	0	.005	.018	.036	.056	.073	.084	.088	.083	.072	.055	.036	.018	.005	0	0	.005	.018	.036	.055	.070	.079	.079	.071	.053	.028	0	
G2	Elevation	40.377	40.093	39.831	39.523	39.233	38.923	38.597	38.252	37.893	37.527	37.155	36.765	36.377	35.994	35.663	35.319	34.933	34.617	34.303	33.984	33.610	33.296	32.923	32.534	32.152	31.759		
	Conc. DL + Superimposed DL Deflection (Ft.)	0	.005	.018	.037	.057	.074	.085	.089	.085	.073	.056	.036	.018	.005	0	0	.005	.018	.036	.056	.071	.081	.072	.054	.029	0		
G3	Elevation	40.515	40.232	39.954	39.668	39.322	39.026	38.731	38.391	38.035	37.666	37.294	36.904	36.516	36.113	35.802	35.478	35.139	34.756	34.442	34.133	33.799	33.435	33.062	32.680	32.291	31.898		
	Conc. DL + Superimposed DL Deflection (Ft.)	0	.005	.018	.037	.057	.074	.085	.089	.085	.073	.056	.036	.018	.005	0	0	.005	.018	.036	.056	.071	.081	.072	.054	.029	0		
G4	Elevation	40.654	40.372	40.093	39.808	39.512	39.203	38.877	38.538	38.176	37.794	37.435	37.045	36.656	36.273	35.941	35.598	35.254	34.933	34.617	34.303	33.984	33.610	33.296	32.923	32.534	32.152	31.759	
	Conc. DL + Superimposed DL Deflection (Ft.)	0	.005	.018	.037	.057	.075	.086	.090	.086	.074	.057	.037	.018	.005	0	0	.005	.018	.037	.056	.072	.081	.082	.072	.054	.029	0	
G15	Elevation	40.495	40.206	39.926	39.638	39.340	39.028	38.703	38.358	38.001	37.642	37.257	36.879	36.504	36.135	35.816	35.474	35.124	34.805	34.522	34.256	34.004	33.740	33.385	33.019	32.642	32.257	31.868	
	Conc. DL + Superimposed DL Deflection (Ft.)	0	.005	.019	.039	.061	.080	.092	.096	.091	.078	.059	.037	.018	.005	0	0	.006	.021	.042	.063	.082	.092	.093	.083	.062	.033	0	
G16	Elevation	40.340	40.050	39.769	39.478	39.178	38.862	38.537	38.186	37.835	37.469	37.095	36.720	36.347	35.979	35.661	35.319	34.927	34.591	34.256	33.918	33.573	33.218	32.853	32.485	32.128	31.773		
	Conc. DL + Superimposed DL Deflection (Ft.)	0	.004	.017	.034	.054	.070	.081	.085	.080	.069	.052	.033	.016	.004	0	0	.005	.018	.036	.055	.071	.080	.081	.072	.054	.029	0	











103-273

STATE OF MAINE
DEPARTMENT OF TRANSPORTATION
I-295 INTERCHANGE COMPLEX
TUKEYS BRIDGE
OVER
BACK COVE
IN THE TOWN OF
PORTLAND
CUMBERLAND COUNTY
SUBSTRUCTURE LAYOUT & SLAB ELEVATION
SHEET 8 OF 35 AUGUSTA, MAINE

PROJECT DESIGN ENGINEER: A.F.
DESIGN-DETAILED: J.D.
CHECKED: J.D.
REVISIONS: J.D.
FIELD CHANGES: J.D.
DATE: 2/7/85

BRUNNIG 44-132-457(1)

F.W.A. DIST. NO.	STATE	PROJECT NUMBER	SHEET NO.	TOTAL SHEETS
1	MAINE	R-295-3(94)50	16	190

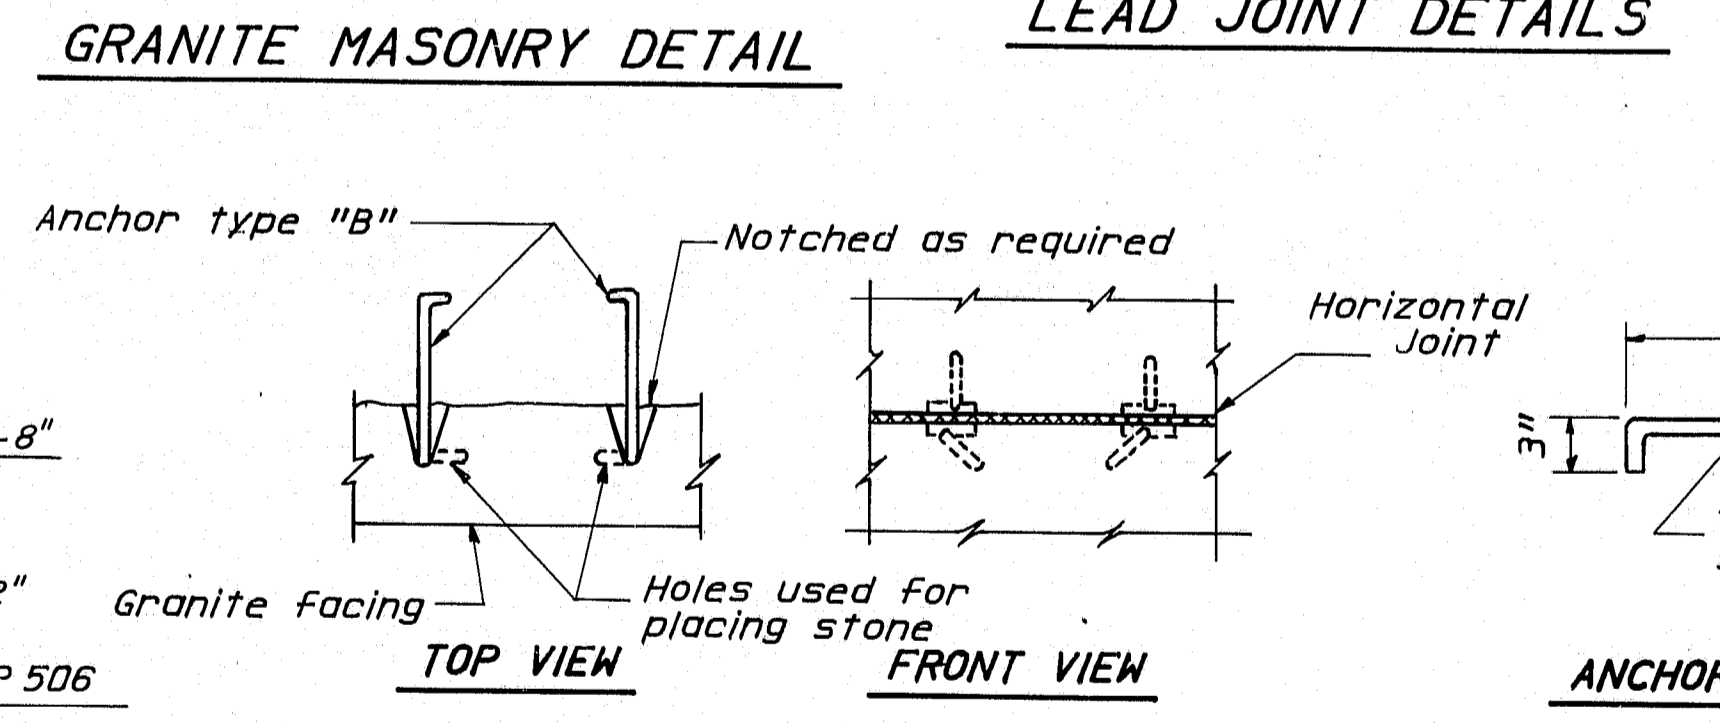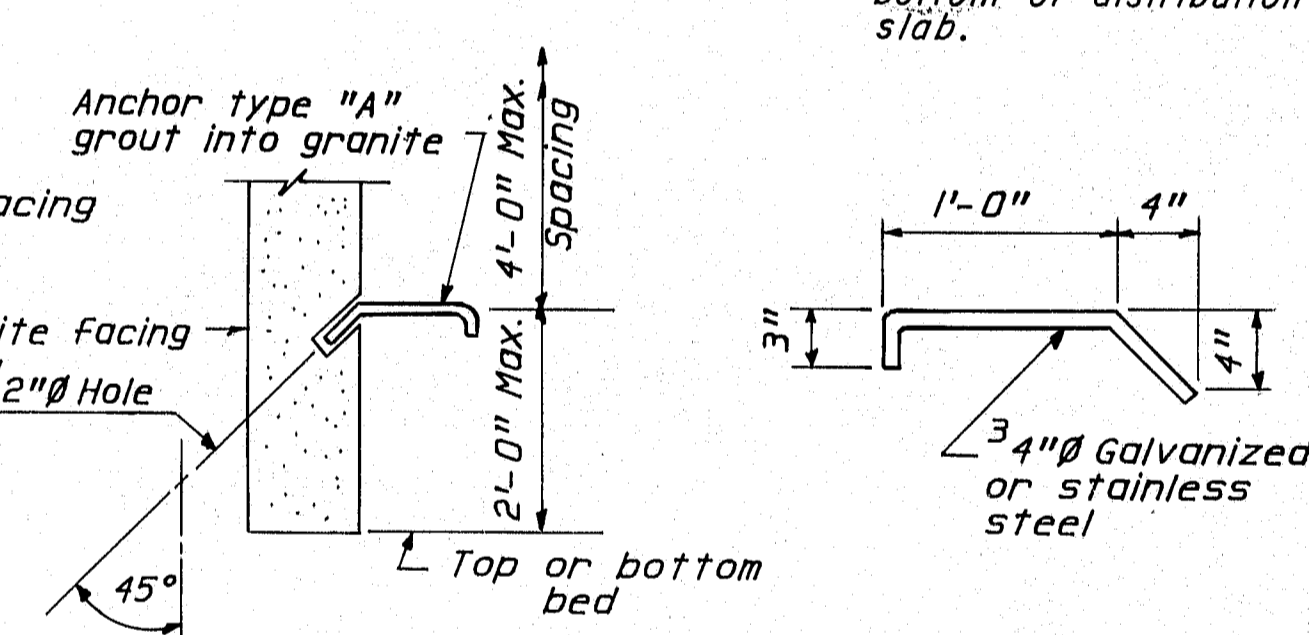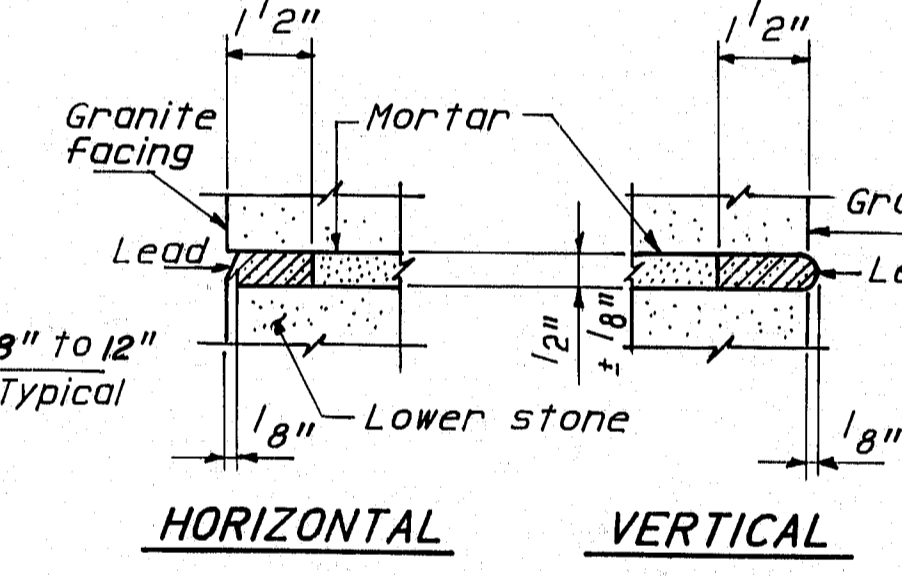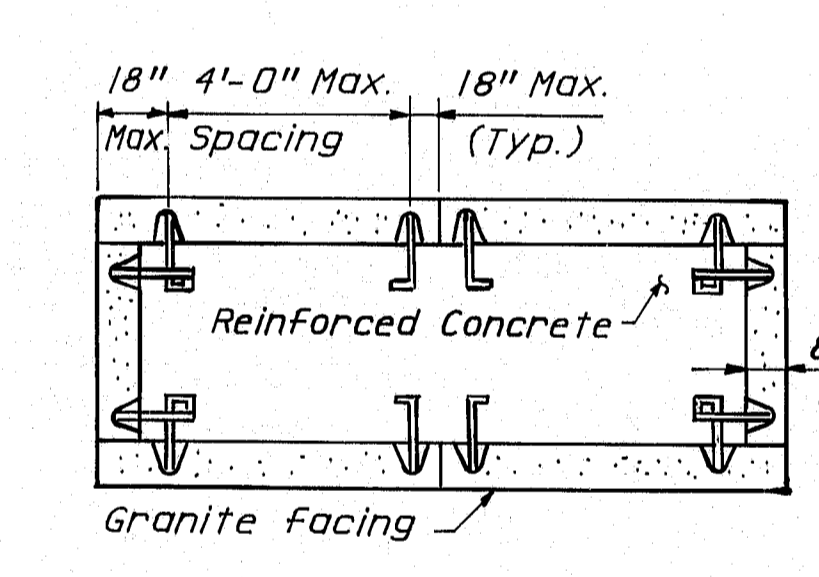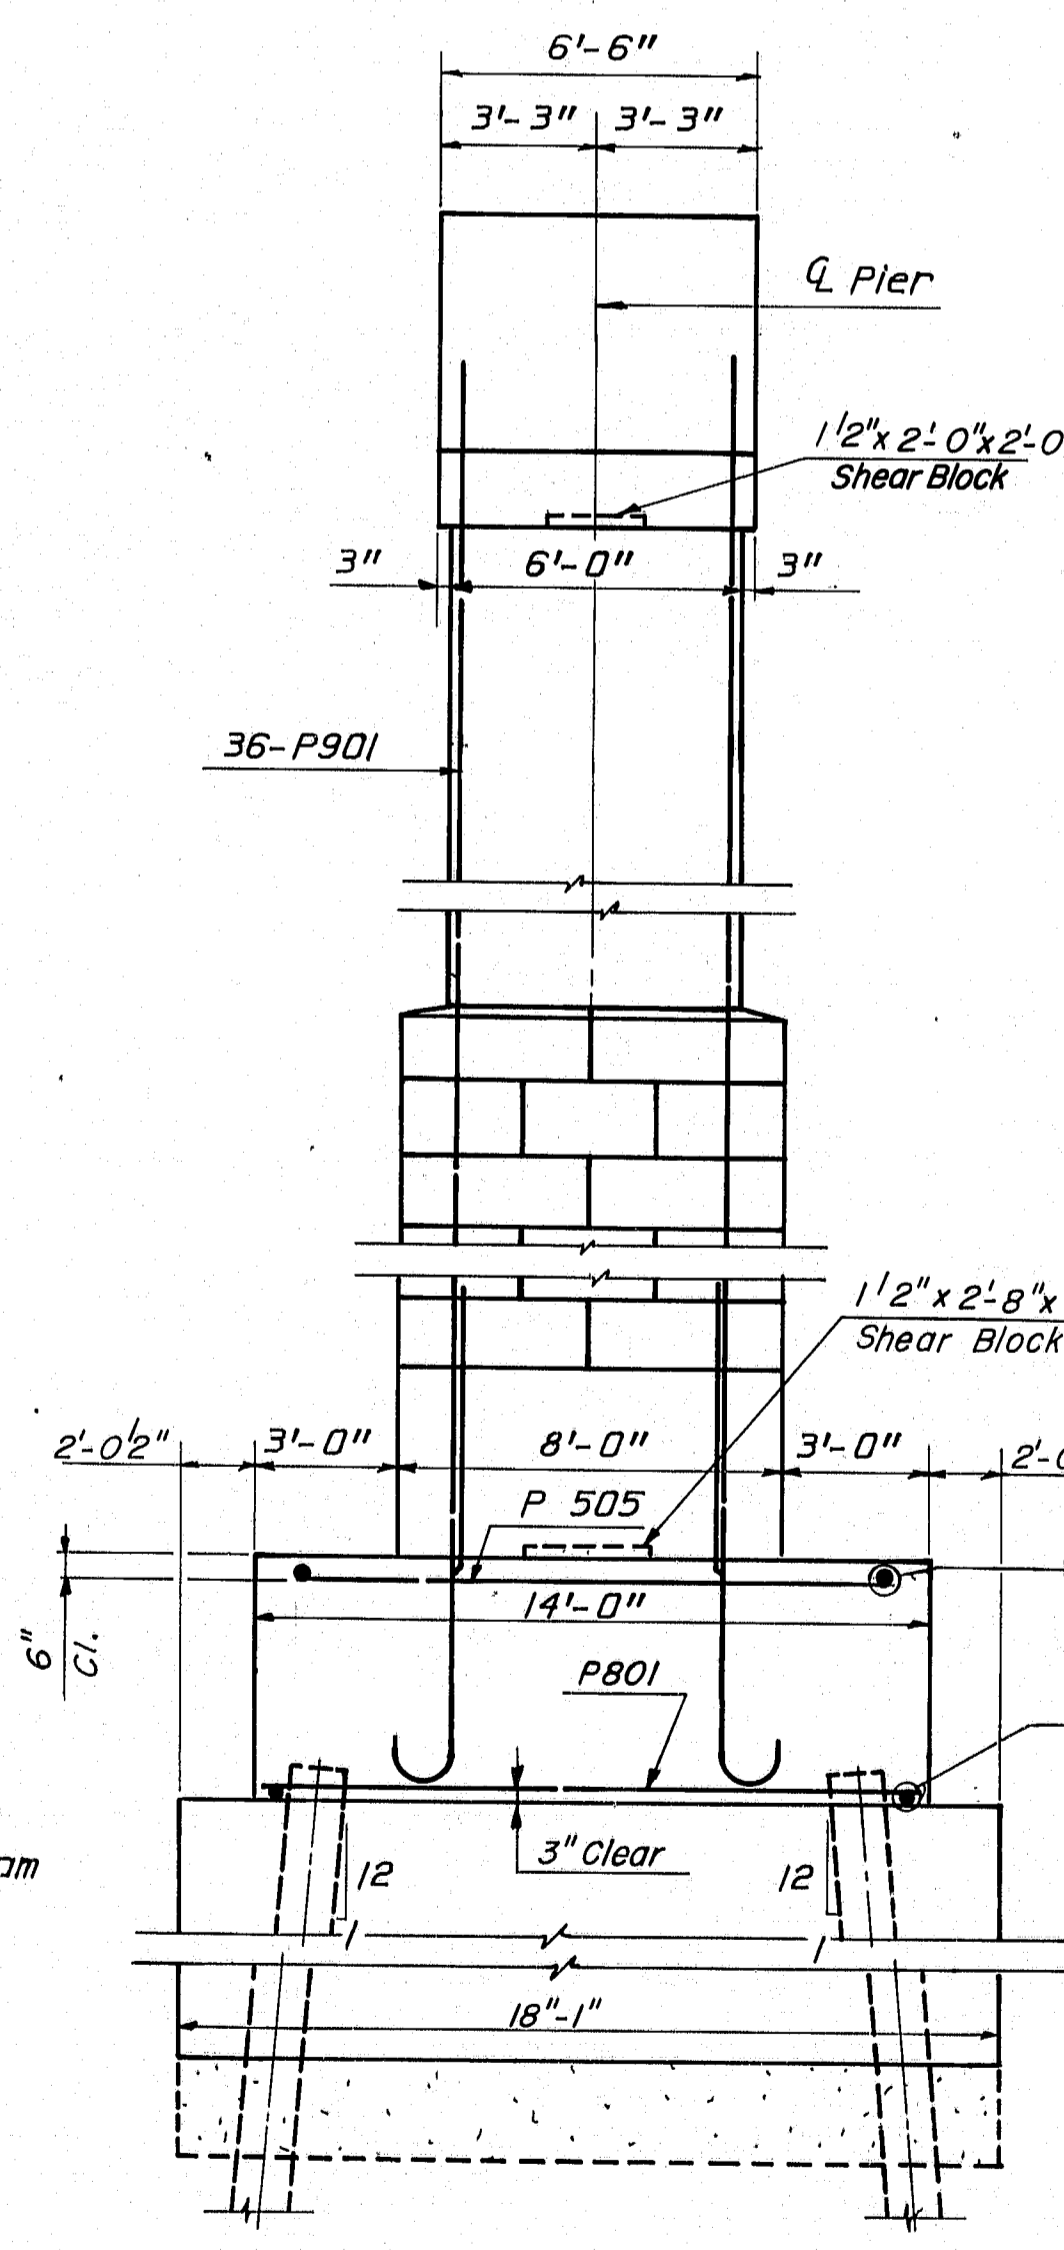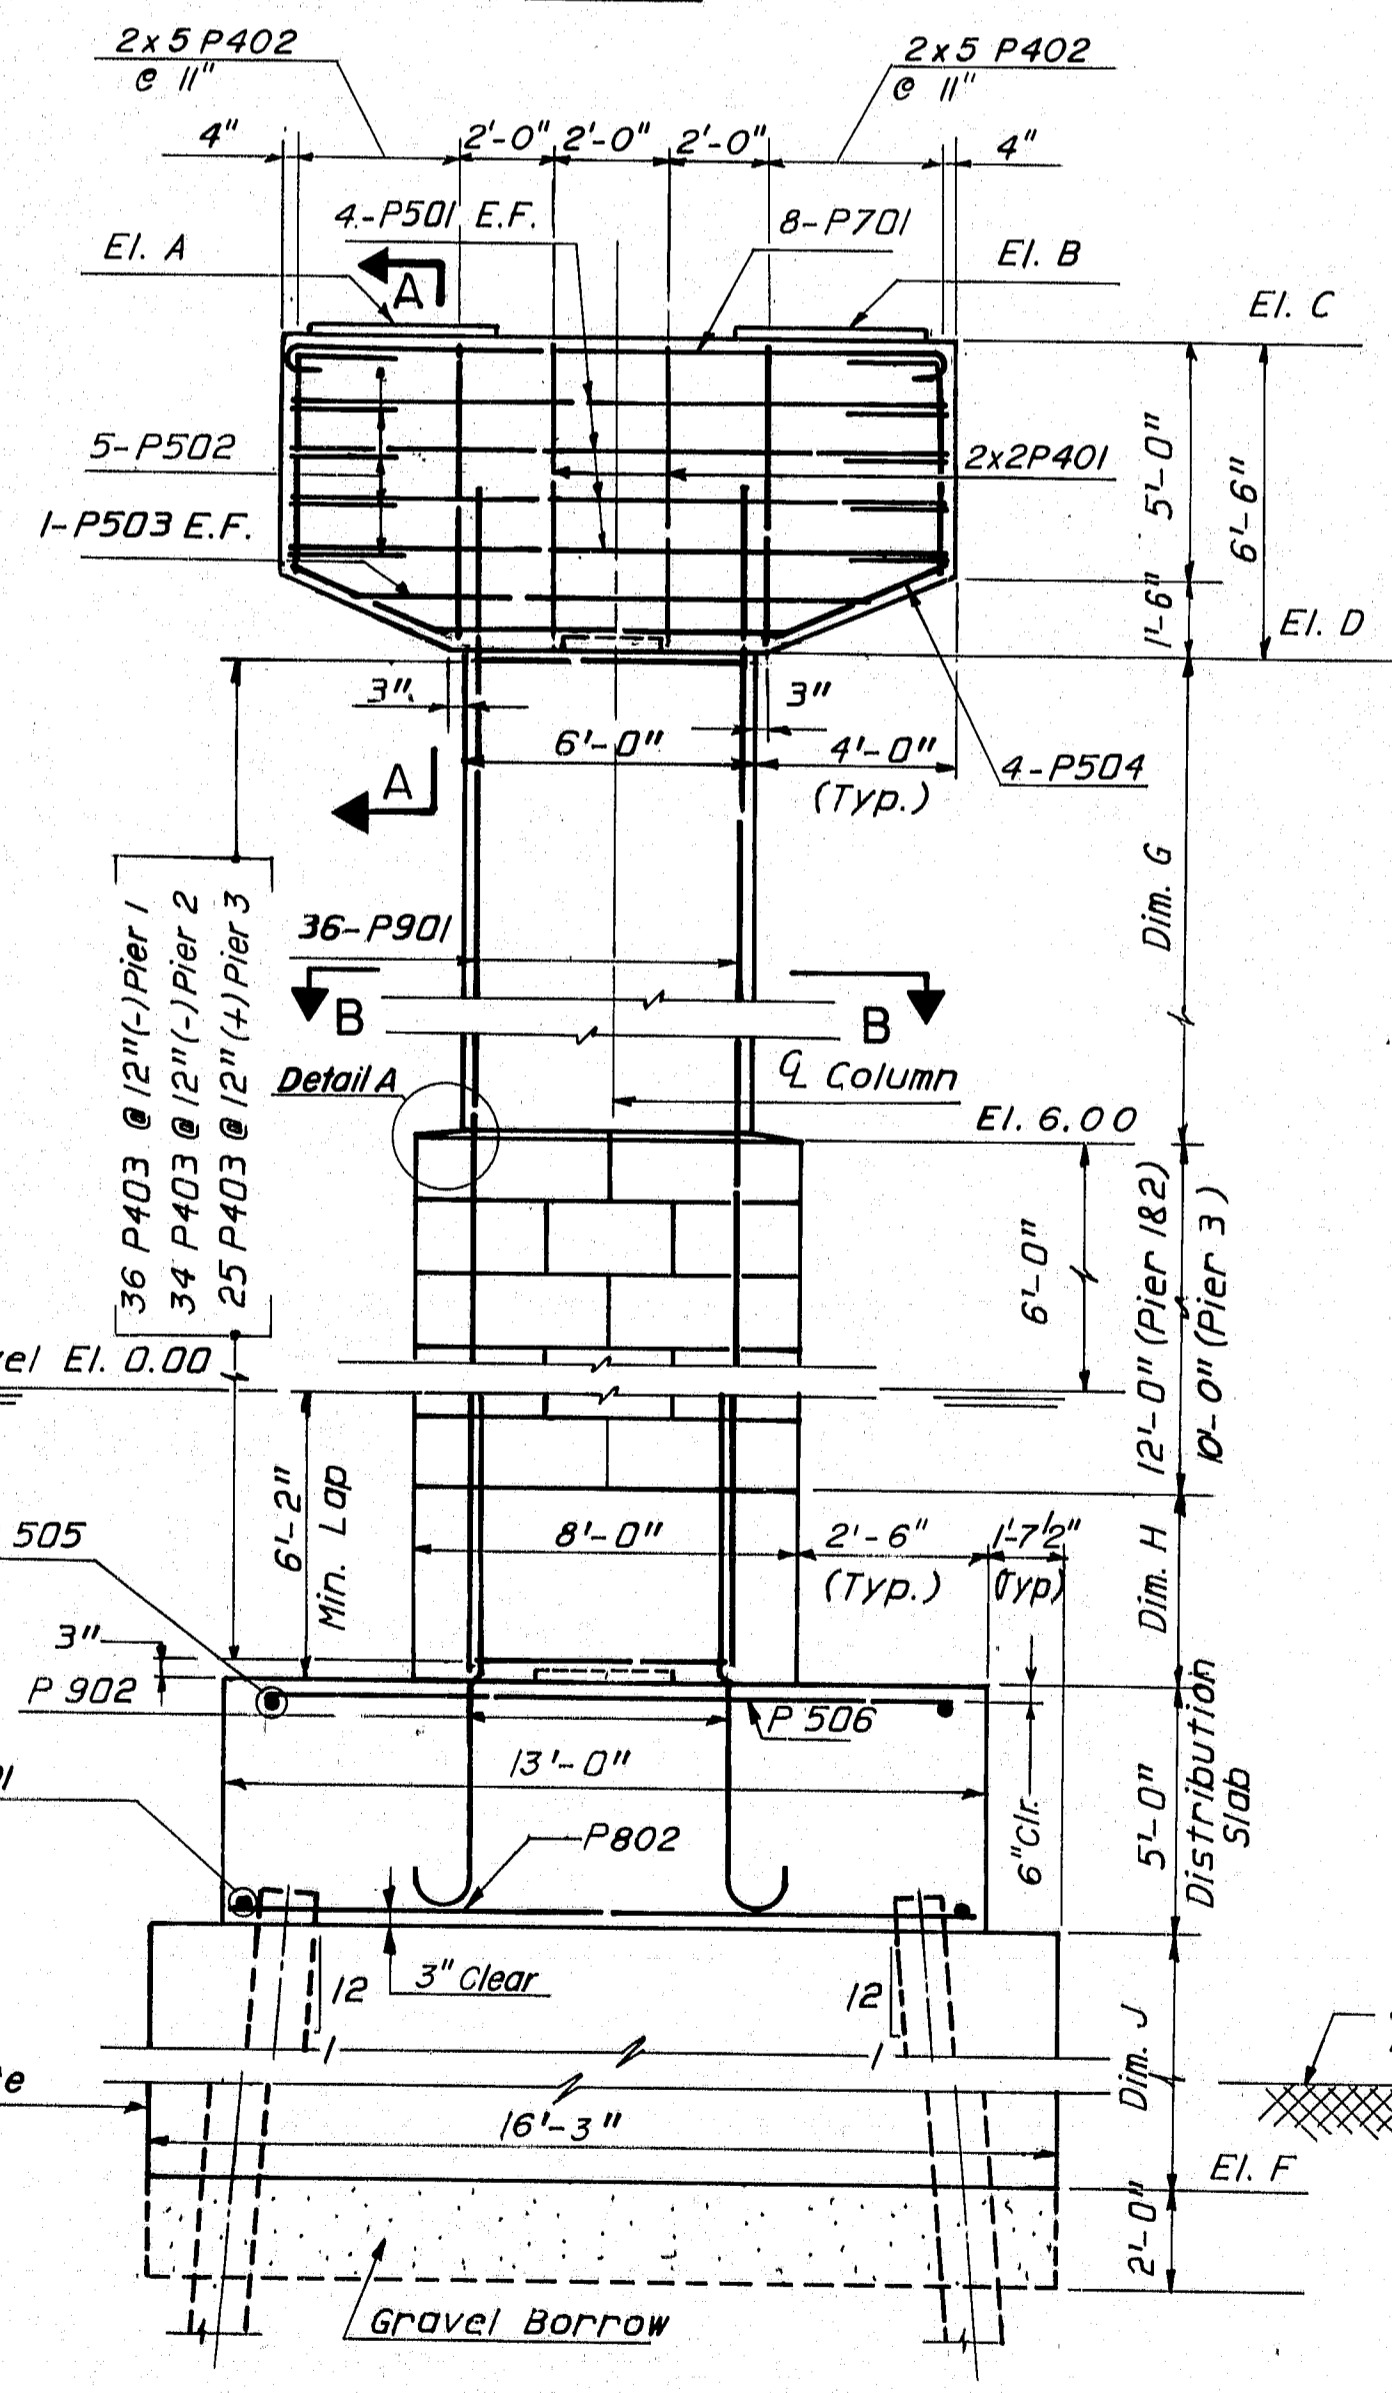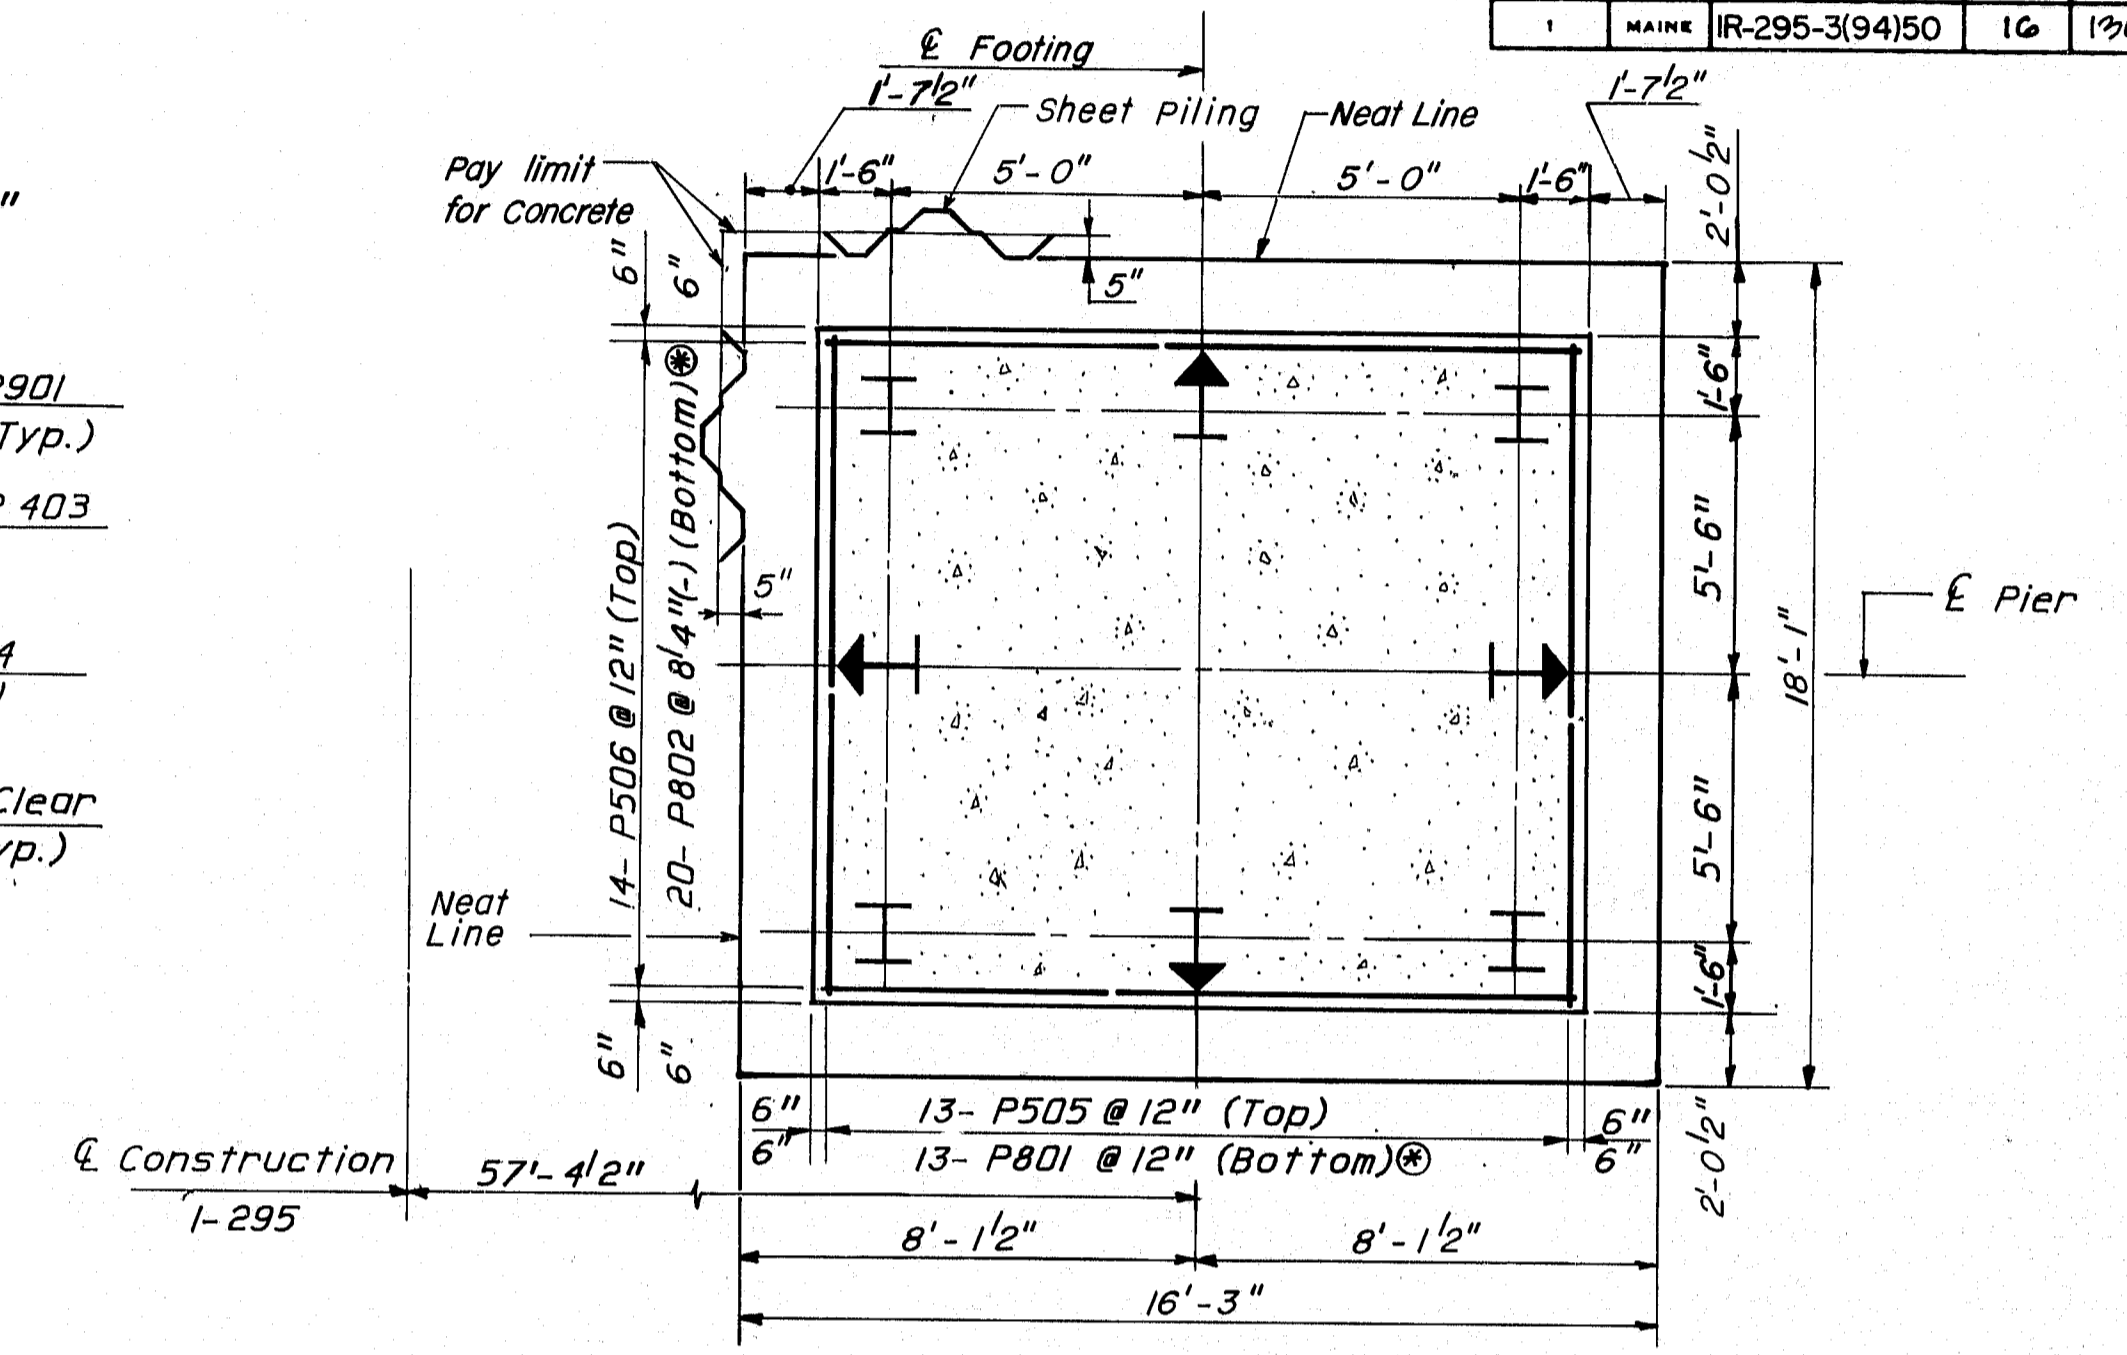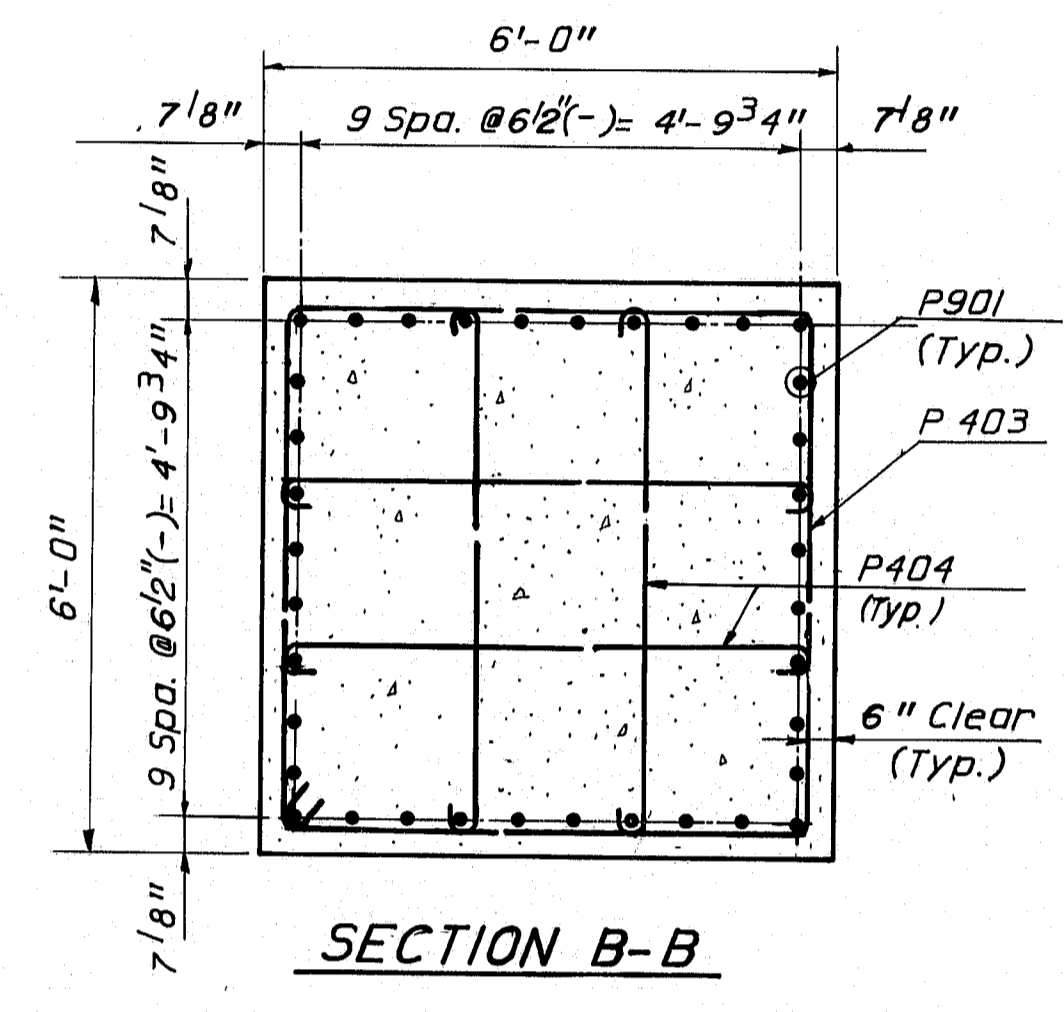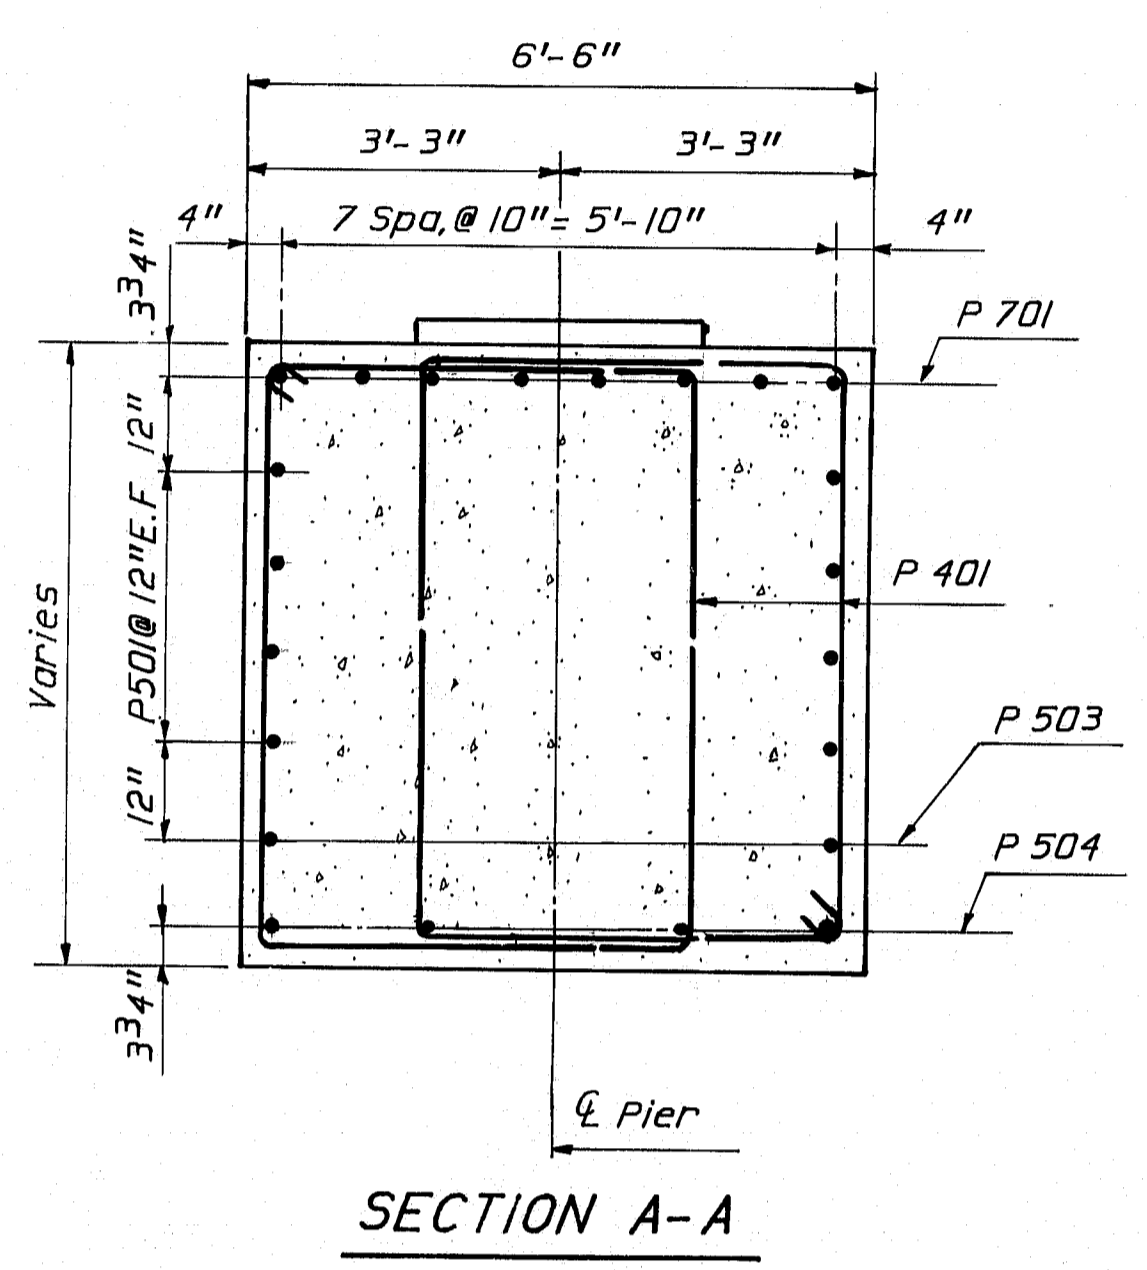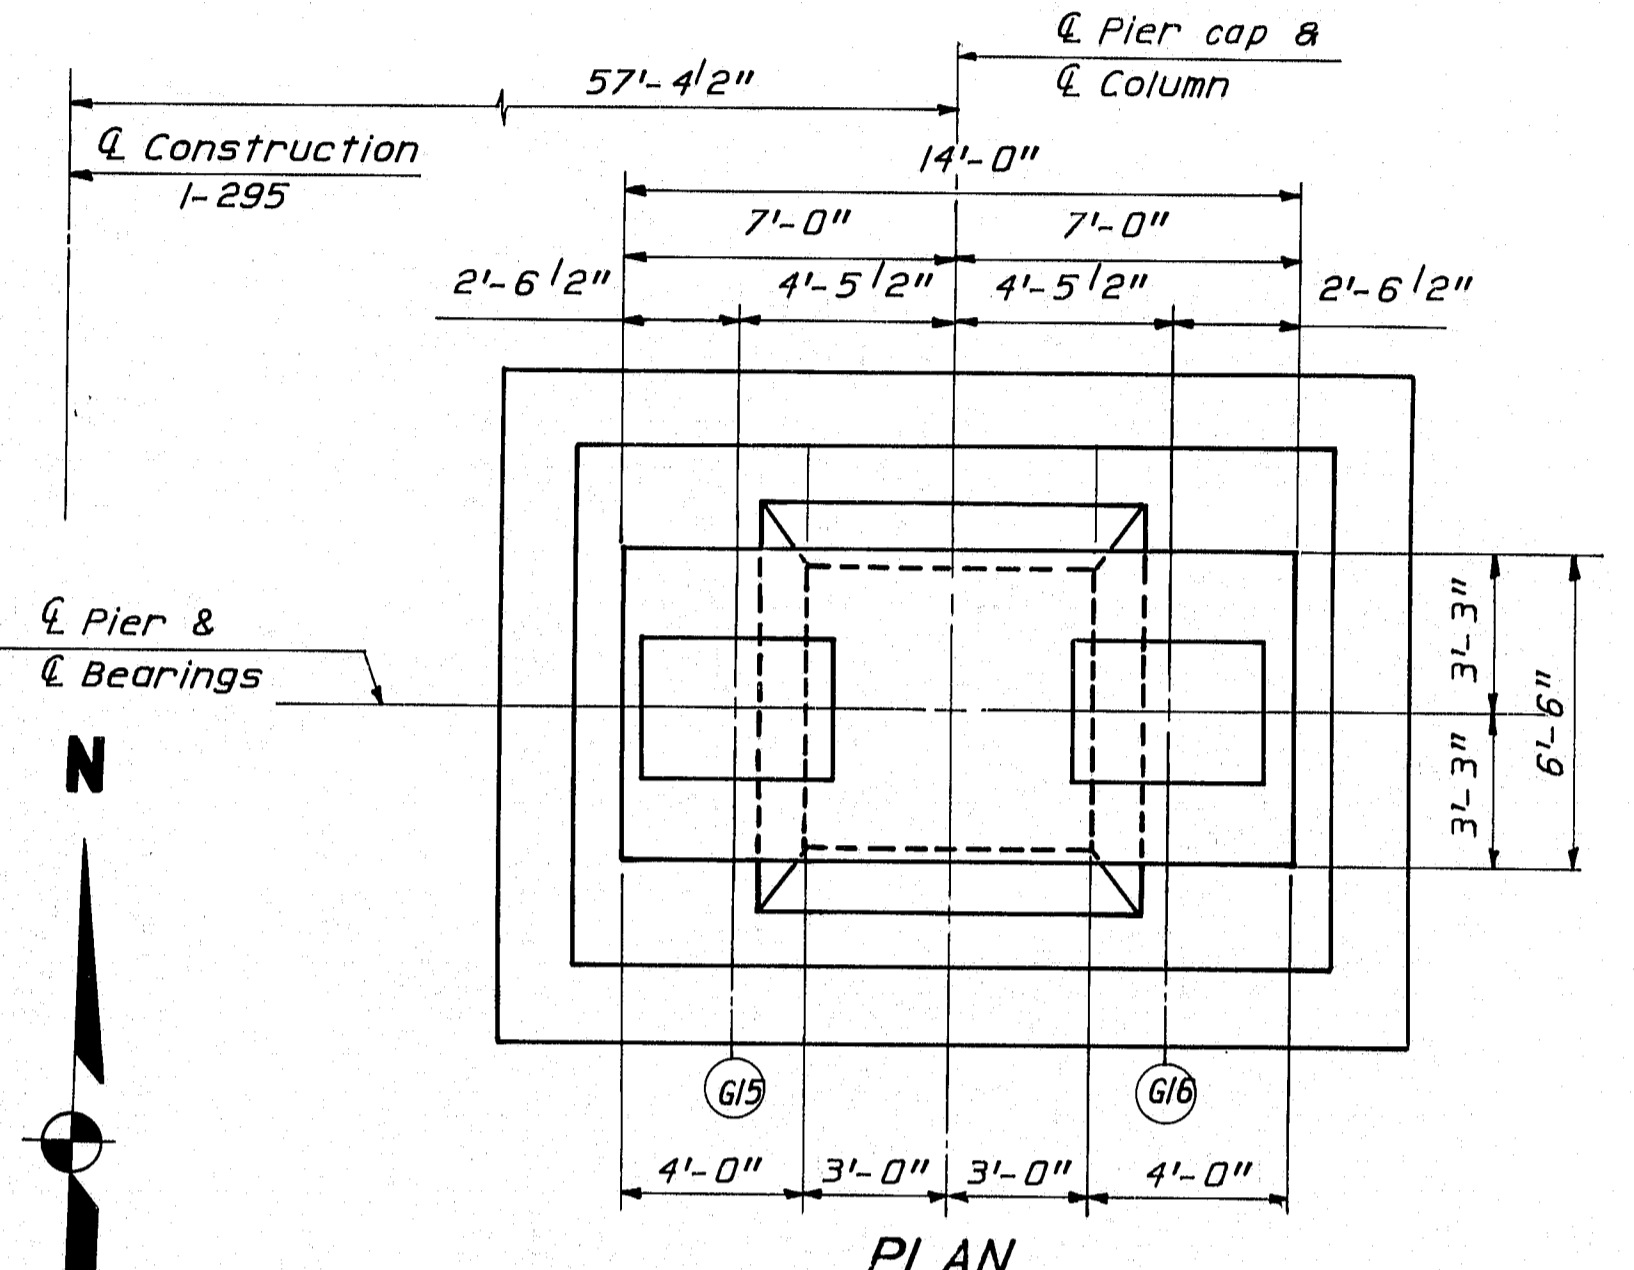

ANCHORS - BACK FACE
(For Stones > 4'-0" High)

- DESIGN CRITERIA**
1. Critical AASHTO Loading - Group 1 for Pier Cap.
 2. Buoyancy - Water level assumed at Elevation 6.00.
 3. Stream flow - velocity of 10 feet per second skewed at perpendicular to longitudinal centerline of pier.
 4. Wind - 100 mph. or 50 psf.
 5. Ice - Thickness 18 inches, pressure 100 psi at Elevation 6.00, 30 percent of nose force applied transverse to pier.

- REFERENCE:**
1. For Pedestal details, see Sheet No. 13
 2. For Reinforcing schedule, see Sheet No. 23
 3. For pile notes see sheet No. 13
 4. For Pier Notes, see sheet No. 13

	STATION	EL. A	EL. B	EL. C	EL. D	EL. E	EL. F	DIM. G	DIM. H	DIM. J
Pier 1	153+11	34.12	33.97	33.64	27.14	-21.80	-26.50	21'-1 5/8"	2'-0"	13'-6"
Pier 2	154+50	32.33	32.17	31.84	25.34	-22.30	-27.00	19'-4 1/8"	2'-0"	14'-0"
Pier 3	155+89	26.75	26.60	26.27	19.77	-7.30	-19.50	13'-9 1/4"	0'-0"	10'-6"





103-277

STATE OF MAINE
DEPARTMENT OF TRANSPORTATION
I-295 INTERCHANGE COMPLEX
TUKEYS BRIDGE
OVER
BACK COVE
IN THE TOWN OF
PORTLAND
CUMBERLAND COUNTY
PIERS 1, 2, & 3, NORTHBOUND
SHEET 12 OF 35 AUGUSTA, MAINE





PROJECT DESIGN ENGINEER	A.F.	DATE	2/85
DESIGN - DETAIL	C.H.		
CHECKED	A.F.		
REVISIONS			
FIELD CHANGES			

BRUNNEN 44-132-6570-1

F.R.W.A. REG. NO.	STATE	PROJECT NUMBER	SHEET NO.	TOTAL SHEETS
1	MAINE	IR-295-3(94)50	17	130

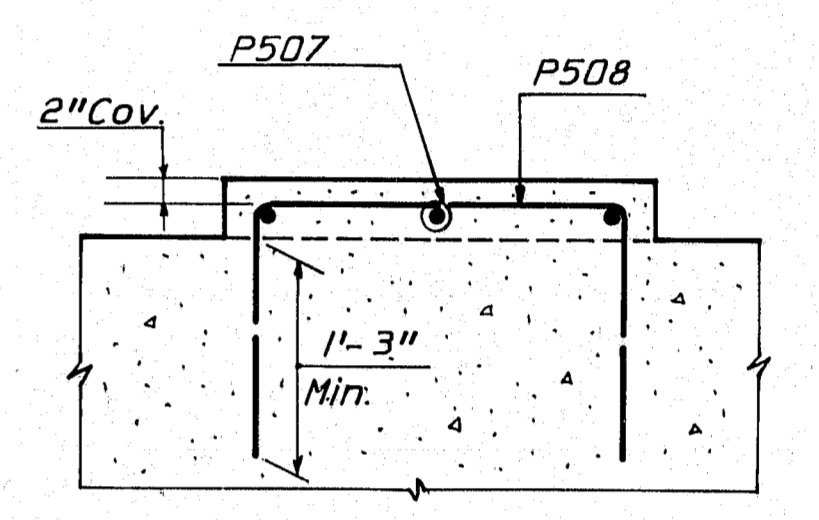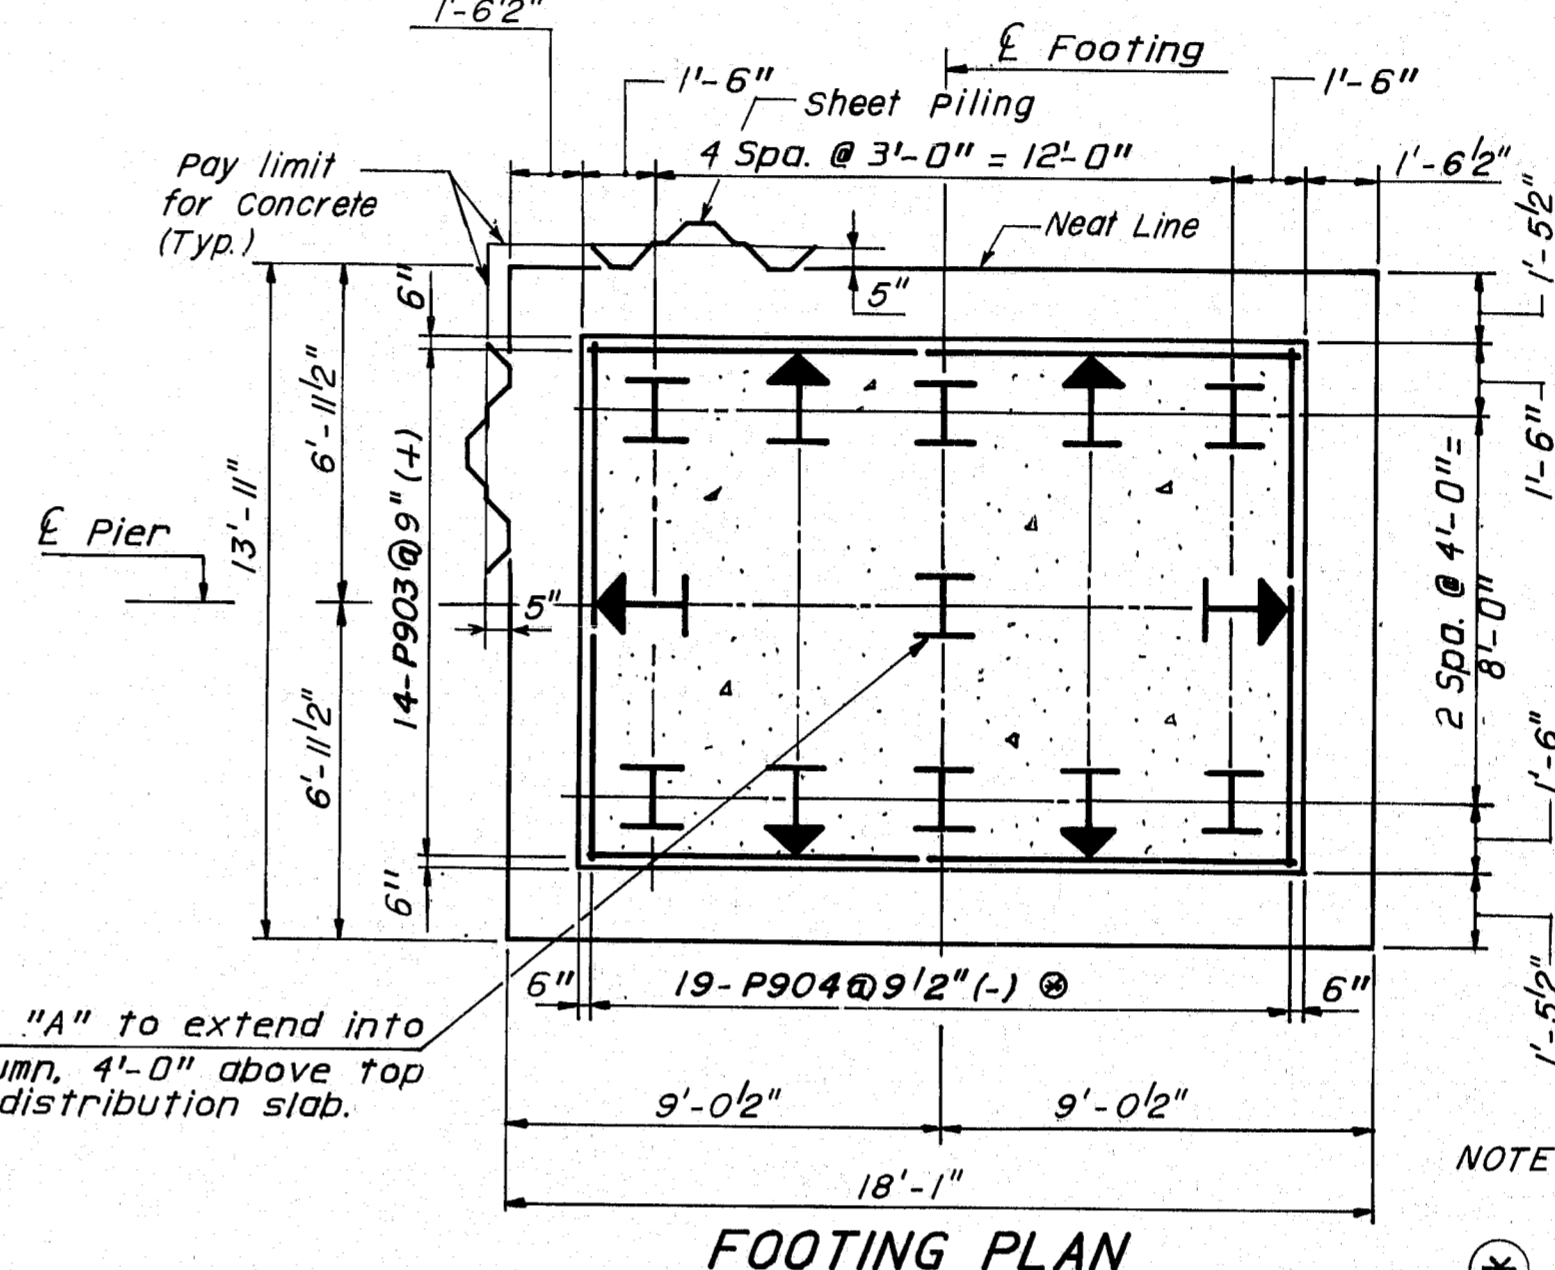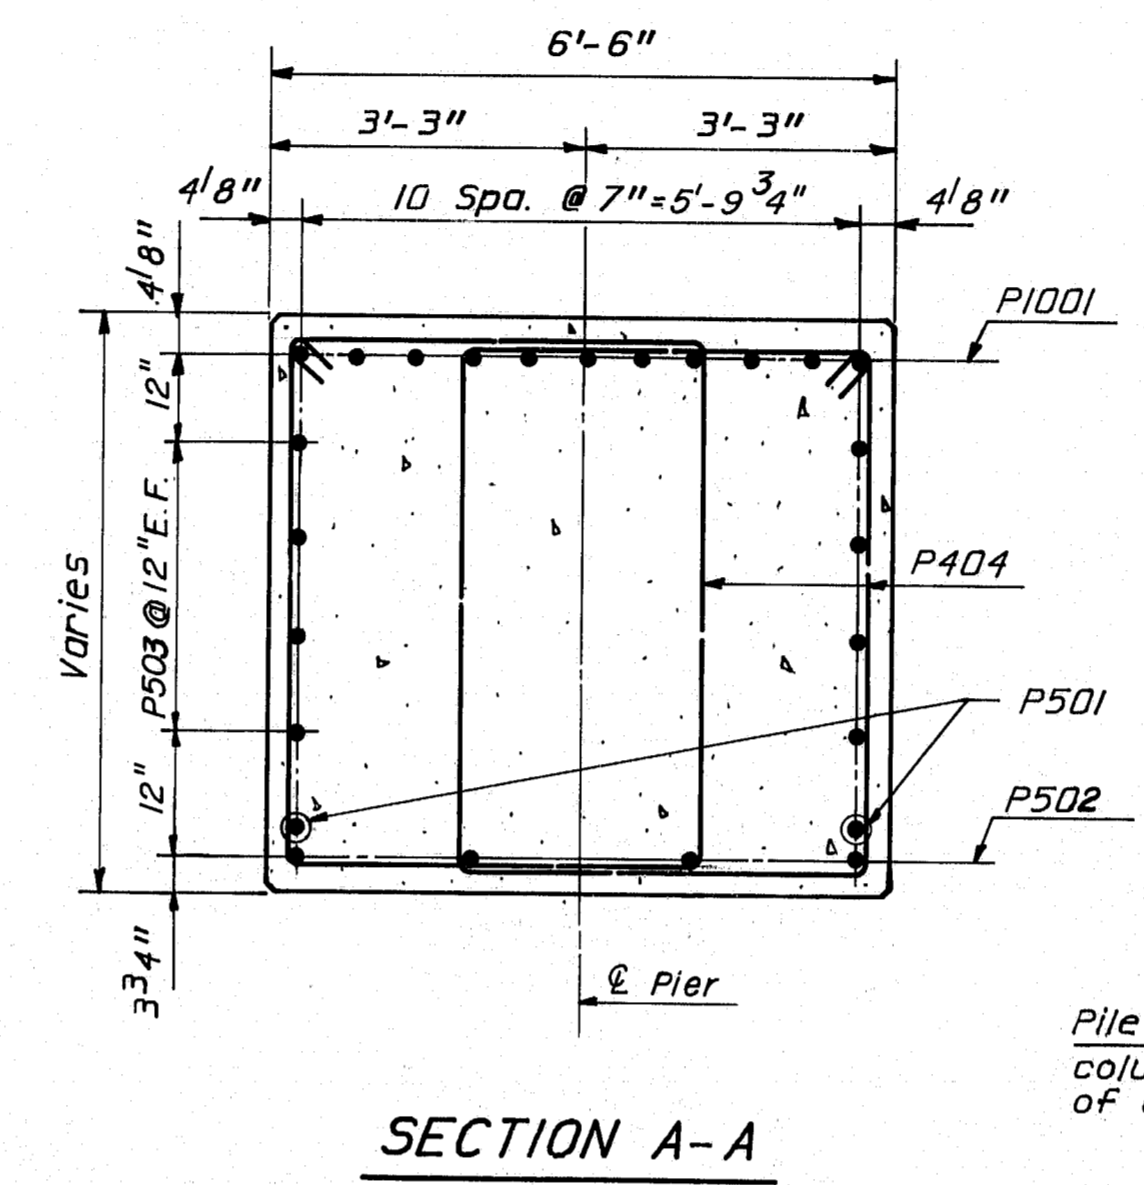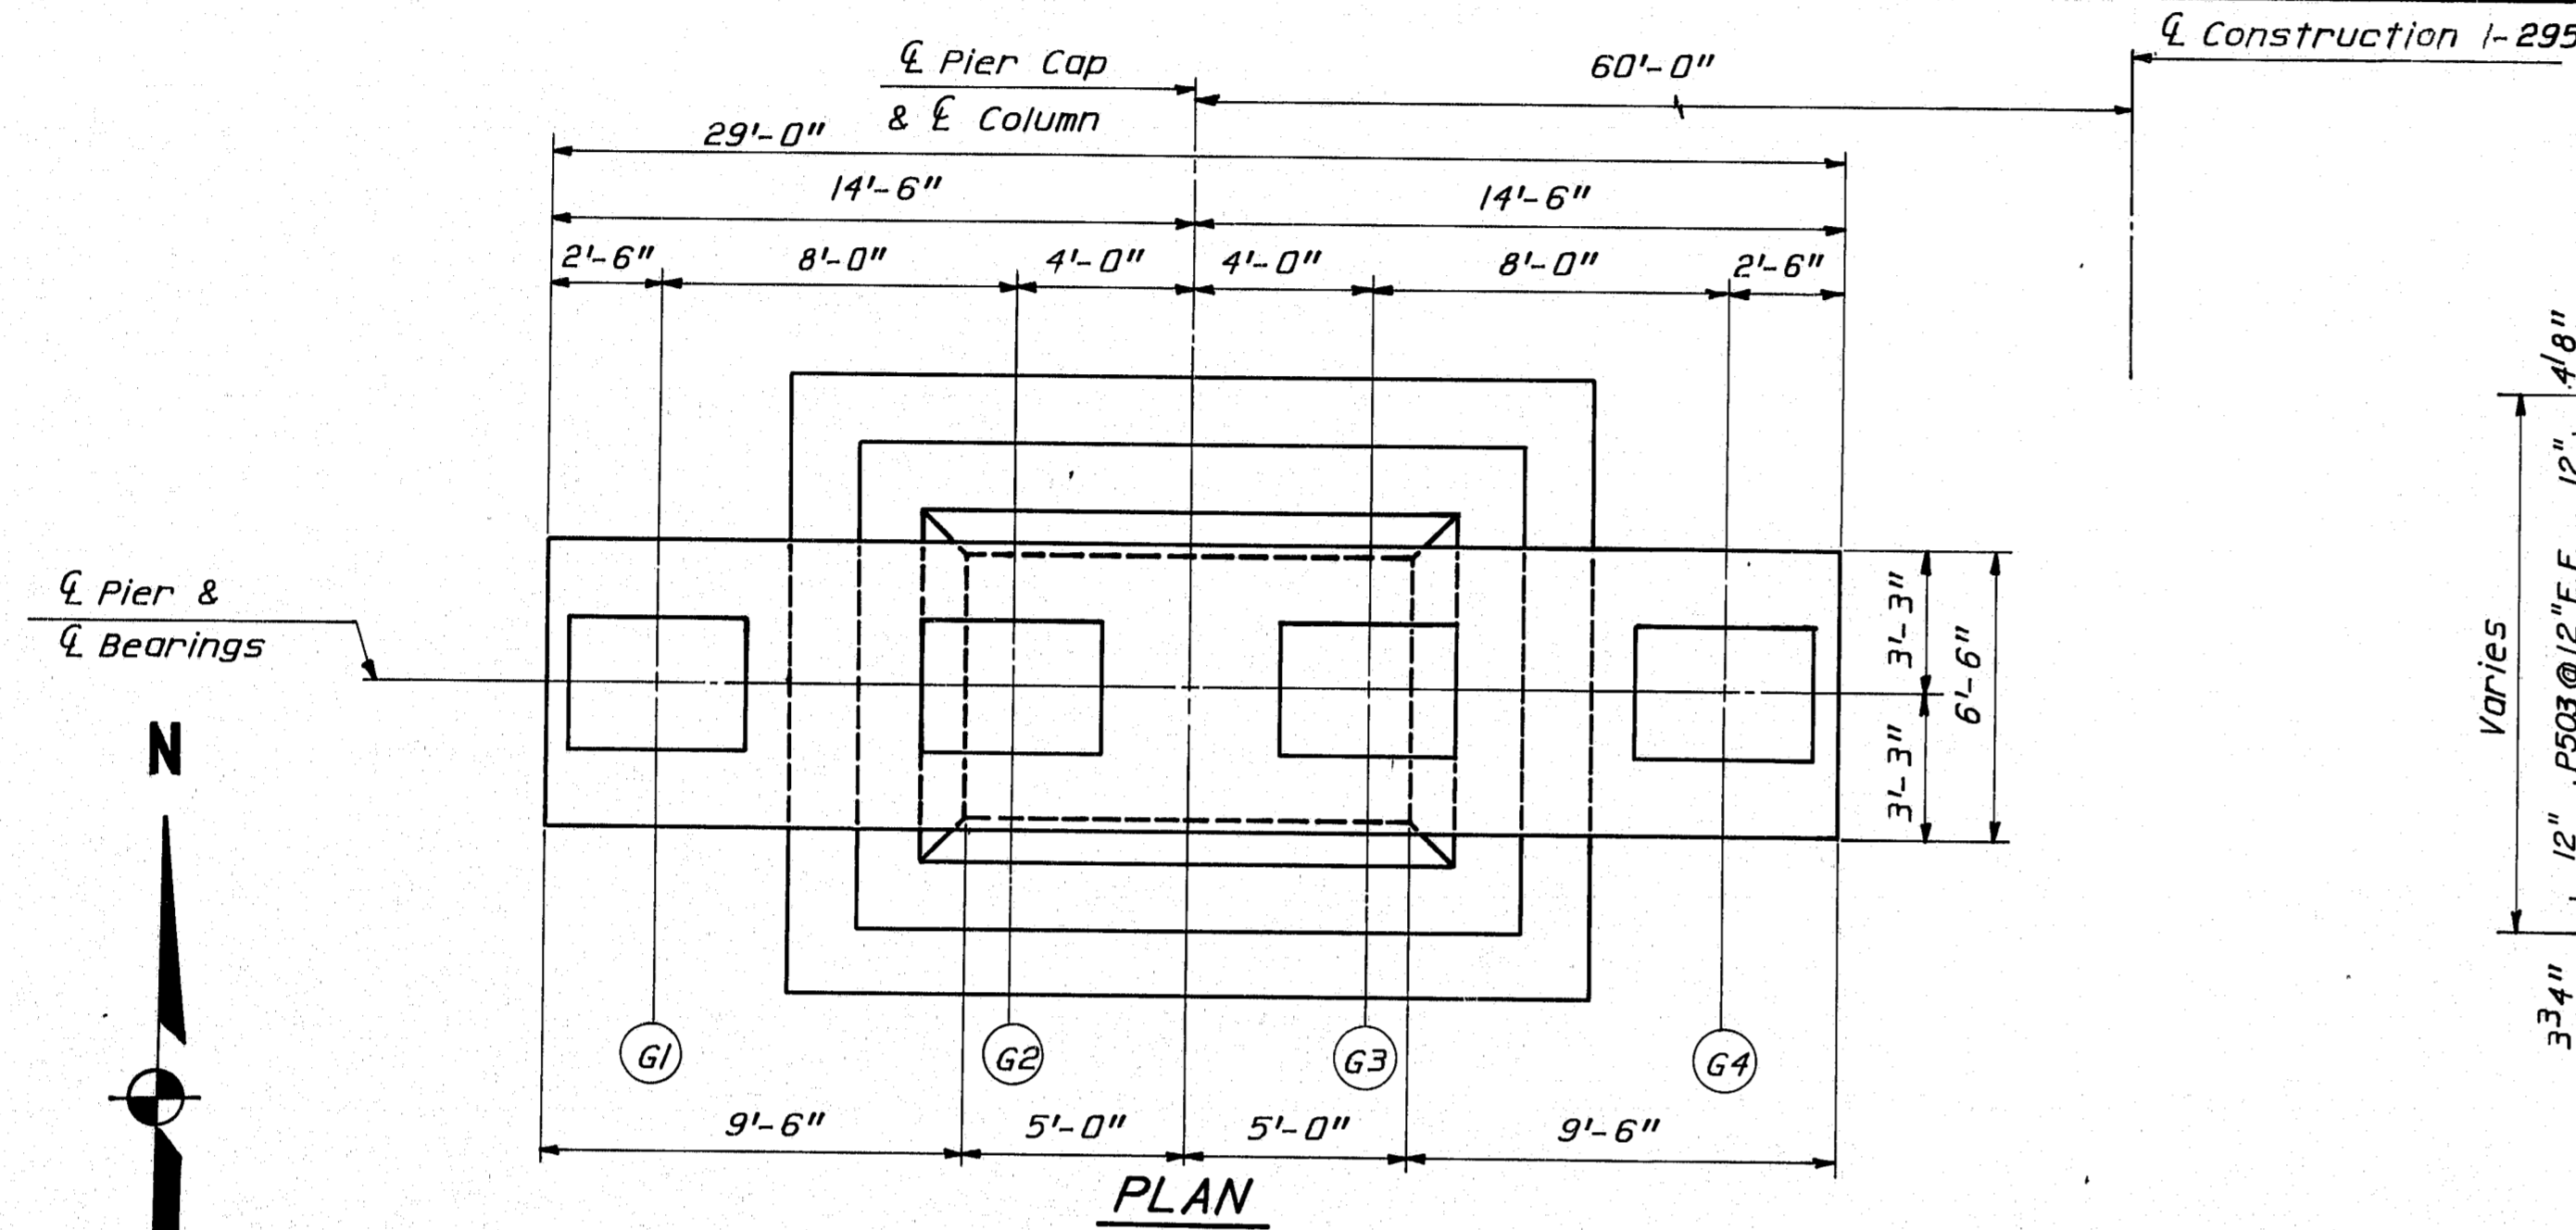

NOTE: Pile dimensioning is measured along bottom of distribution slab.
 (*) Place bars to clear Pile "A"

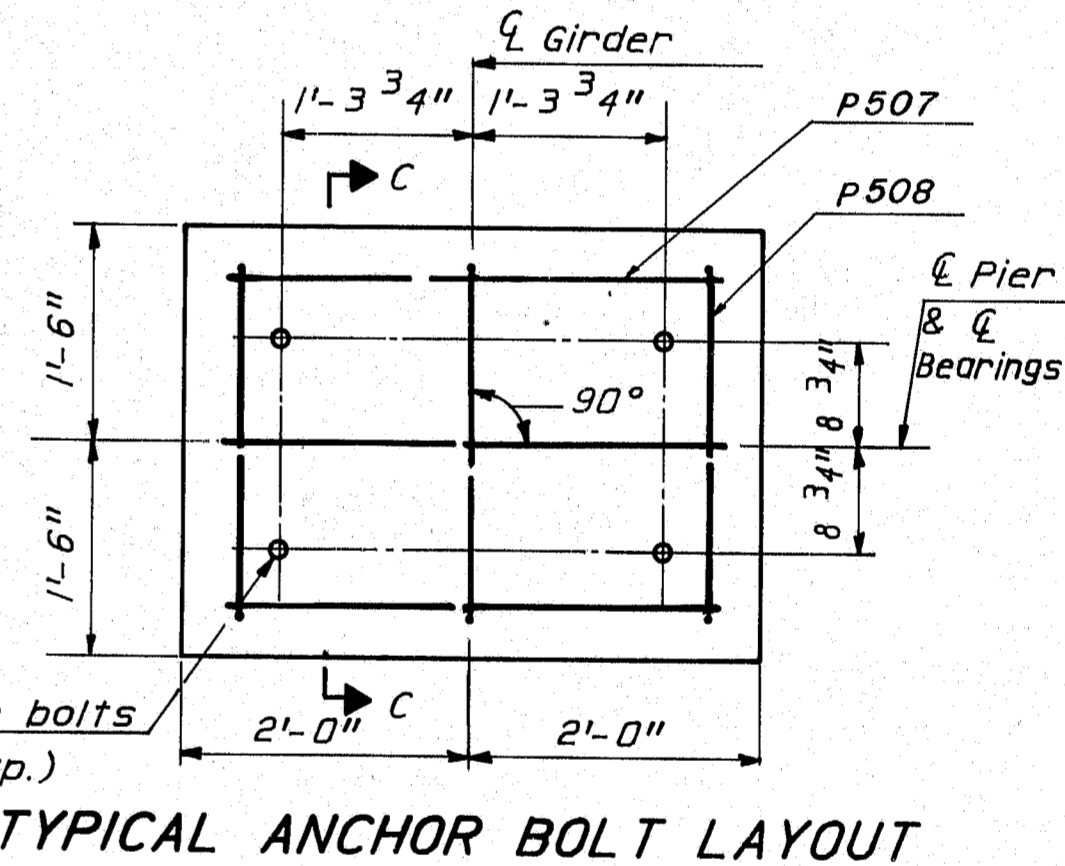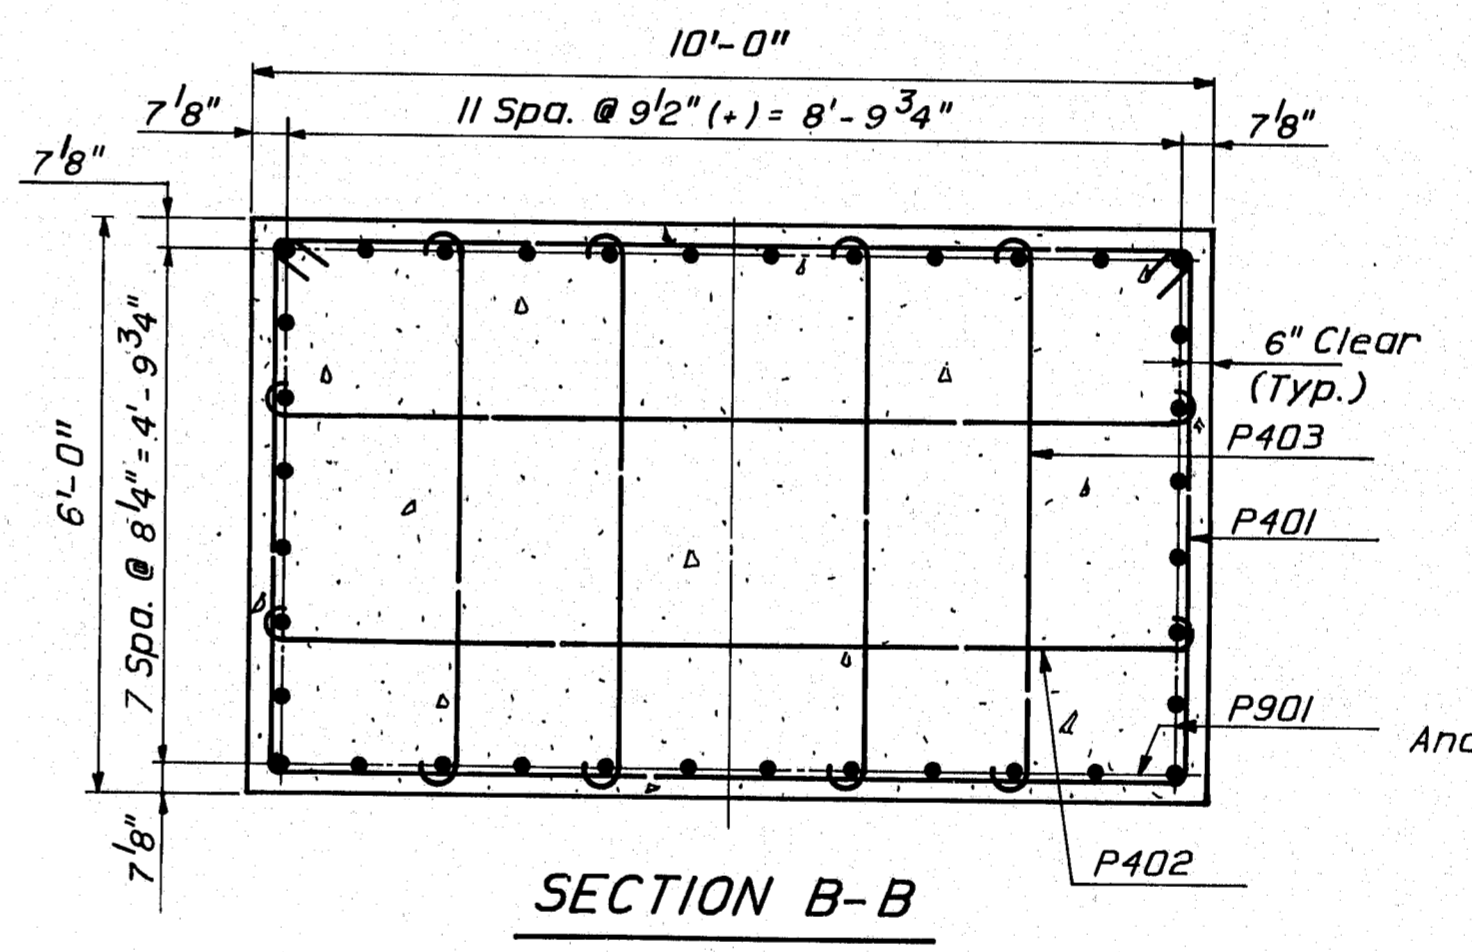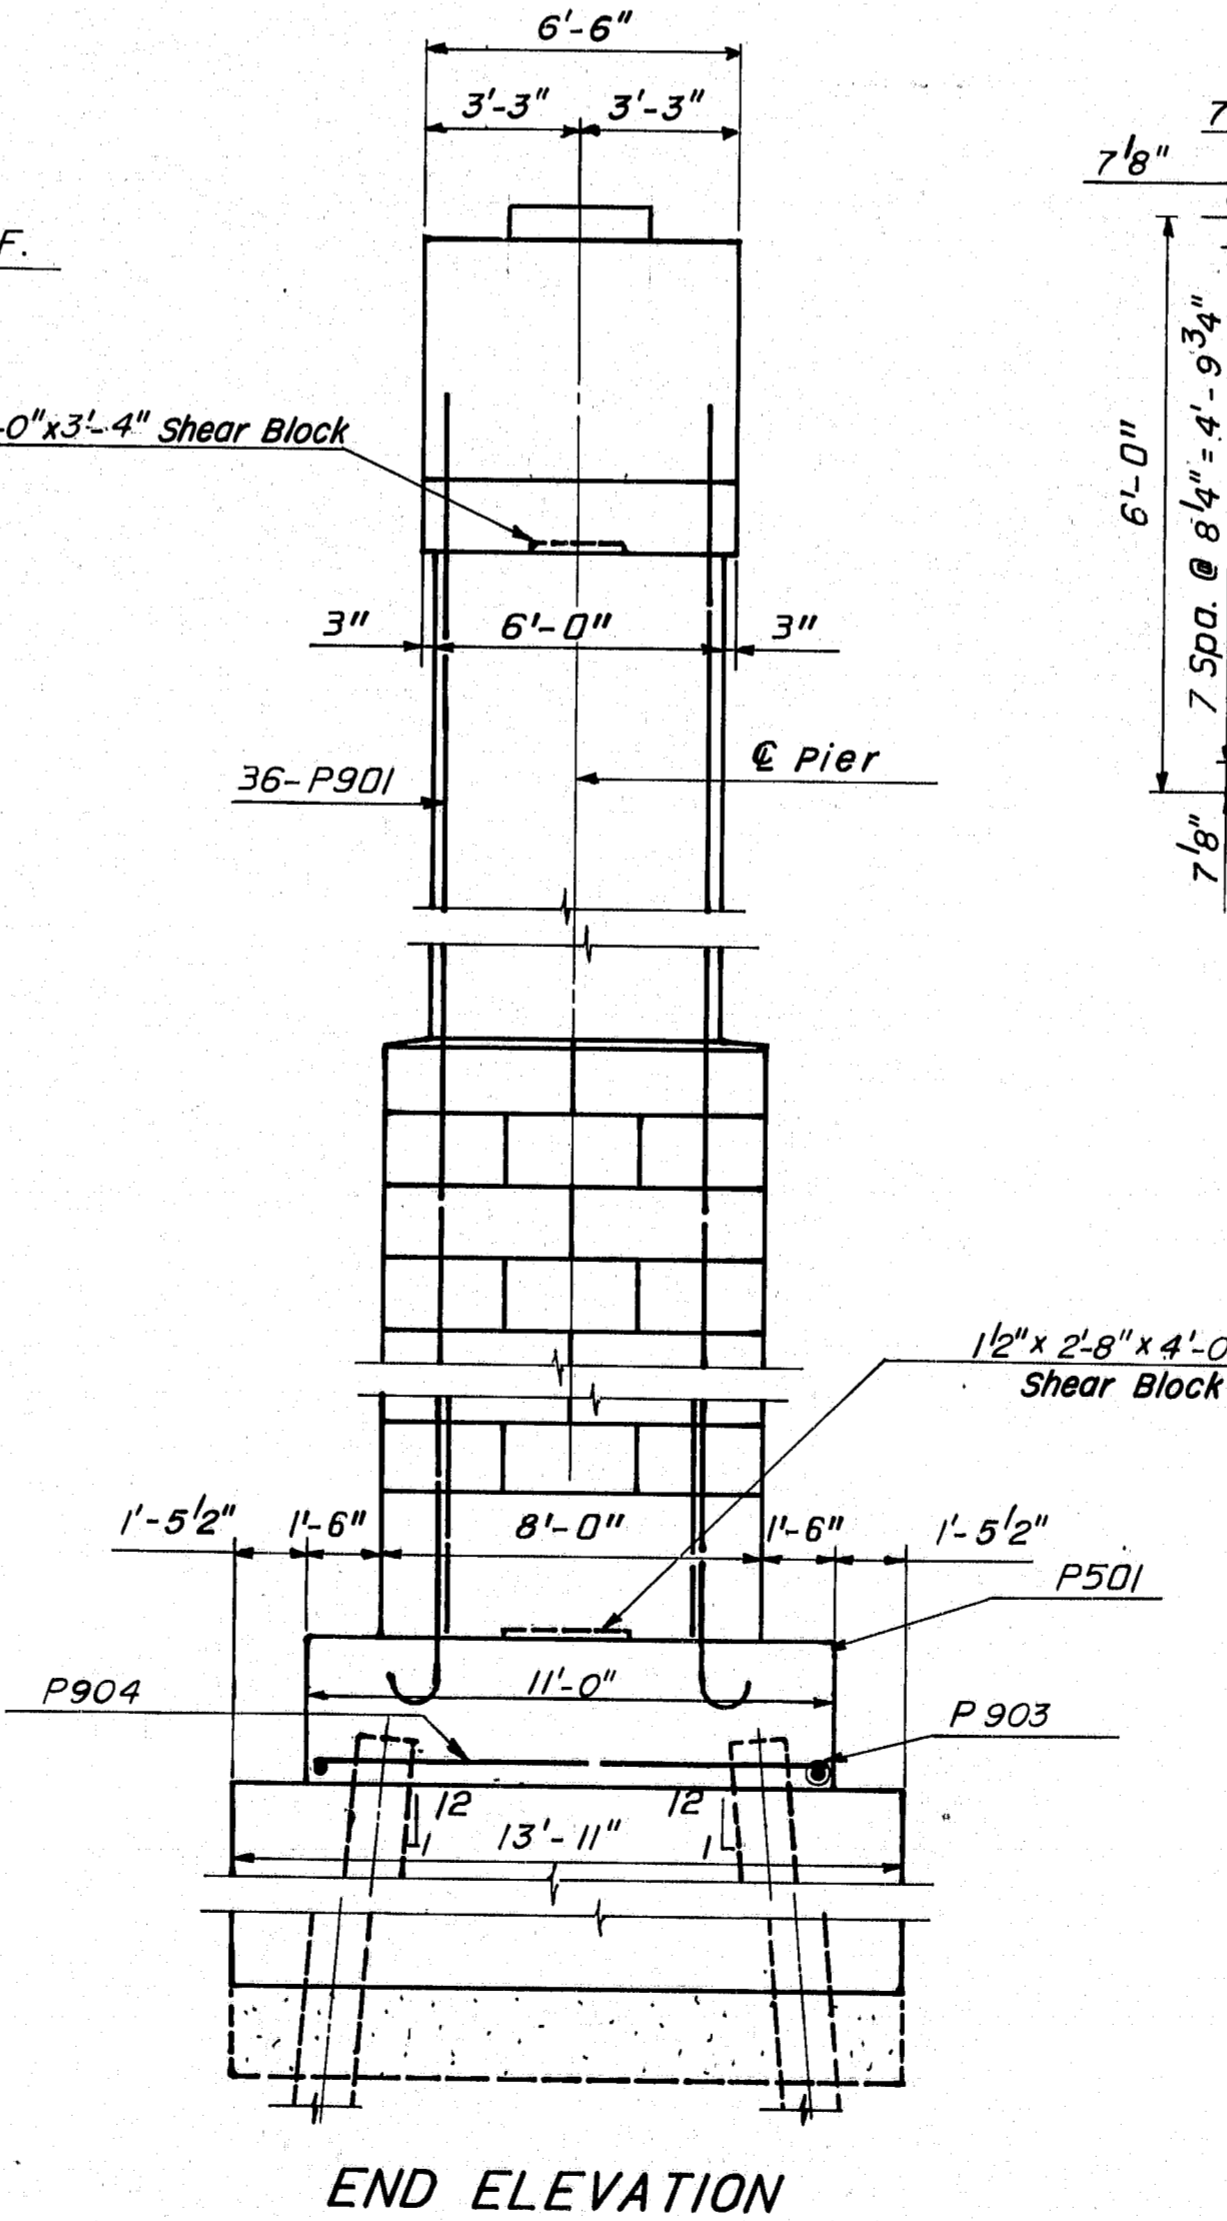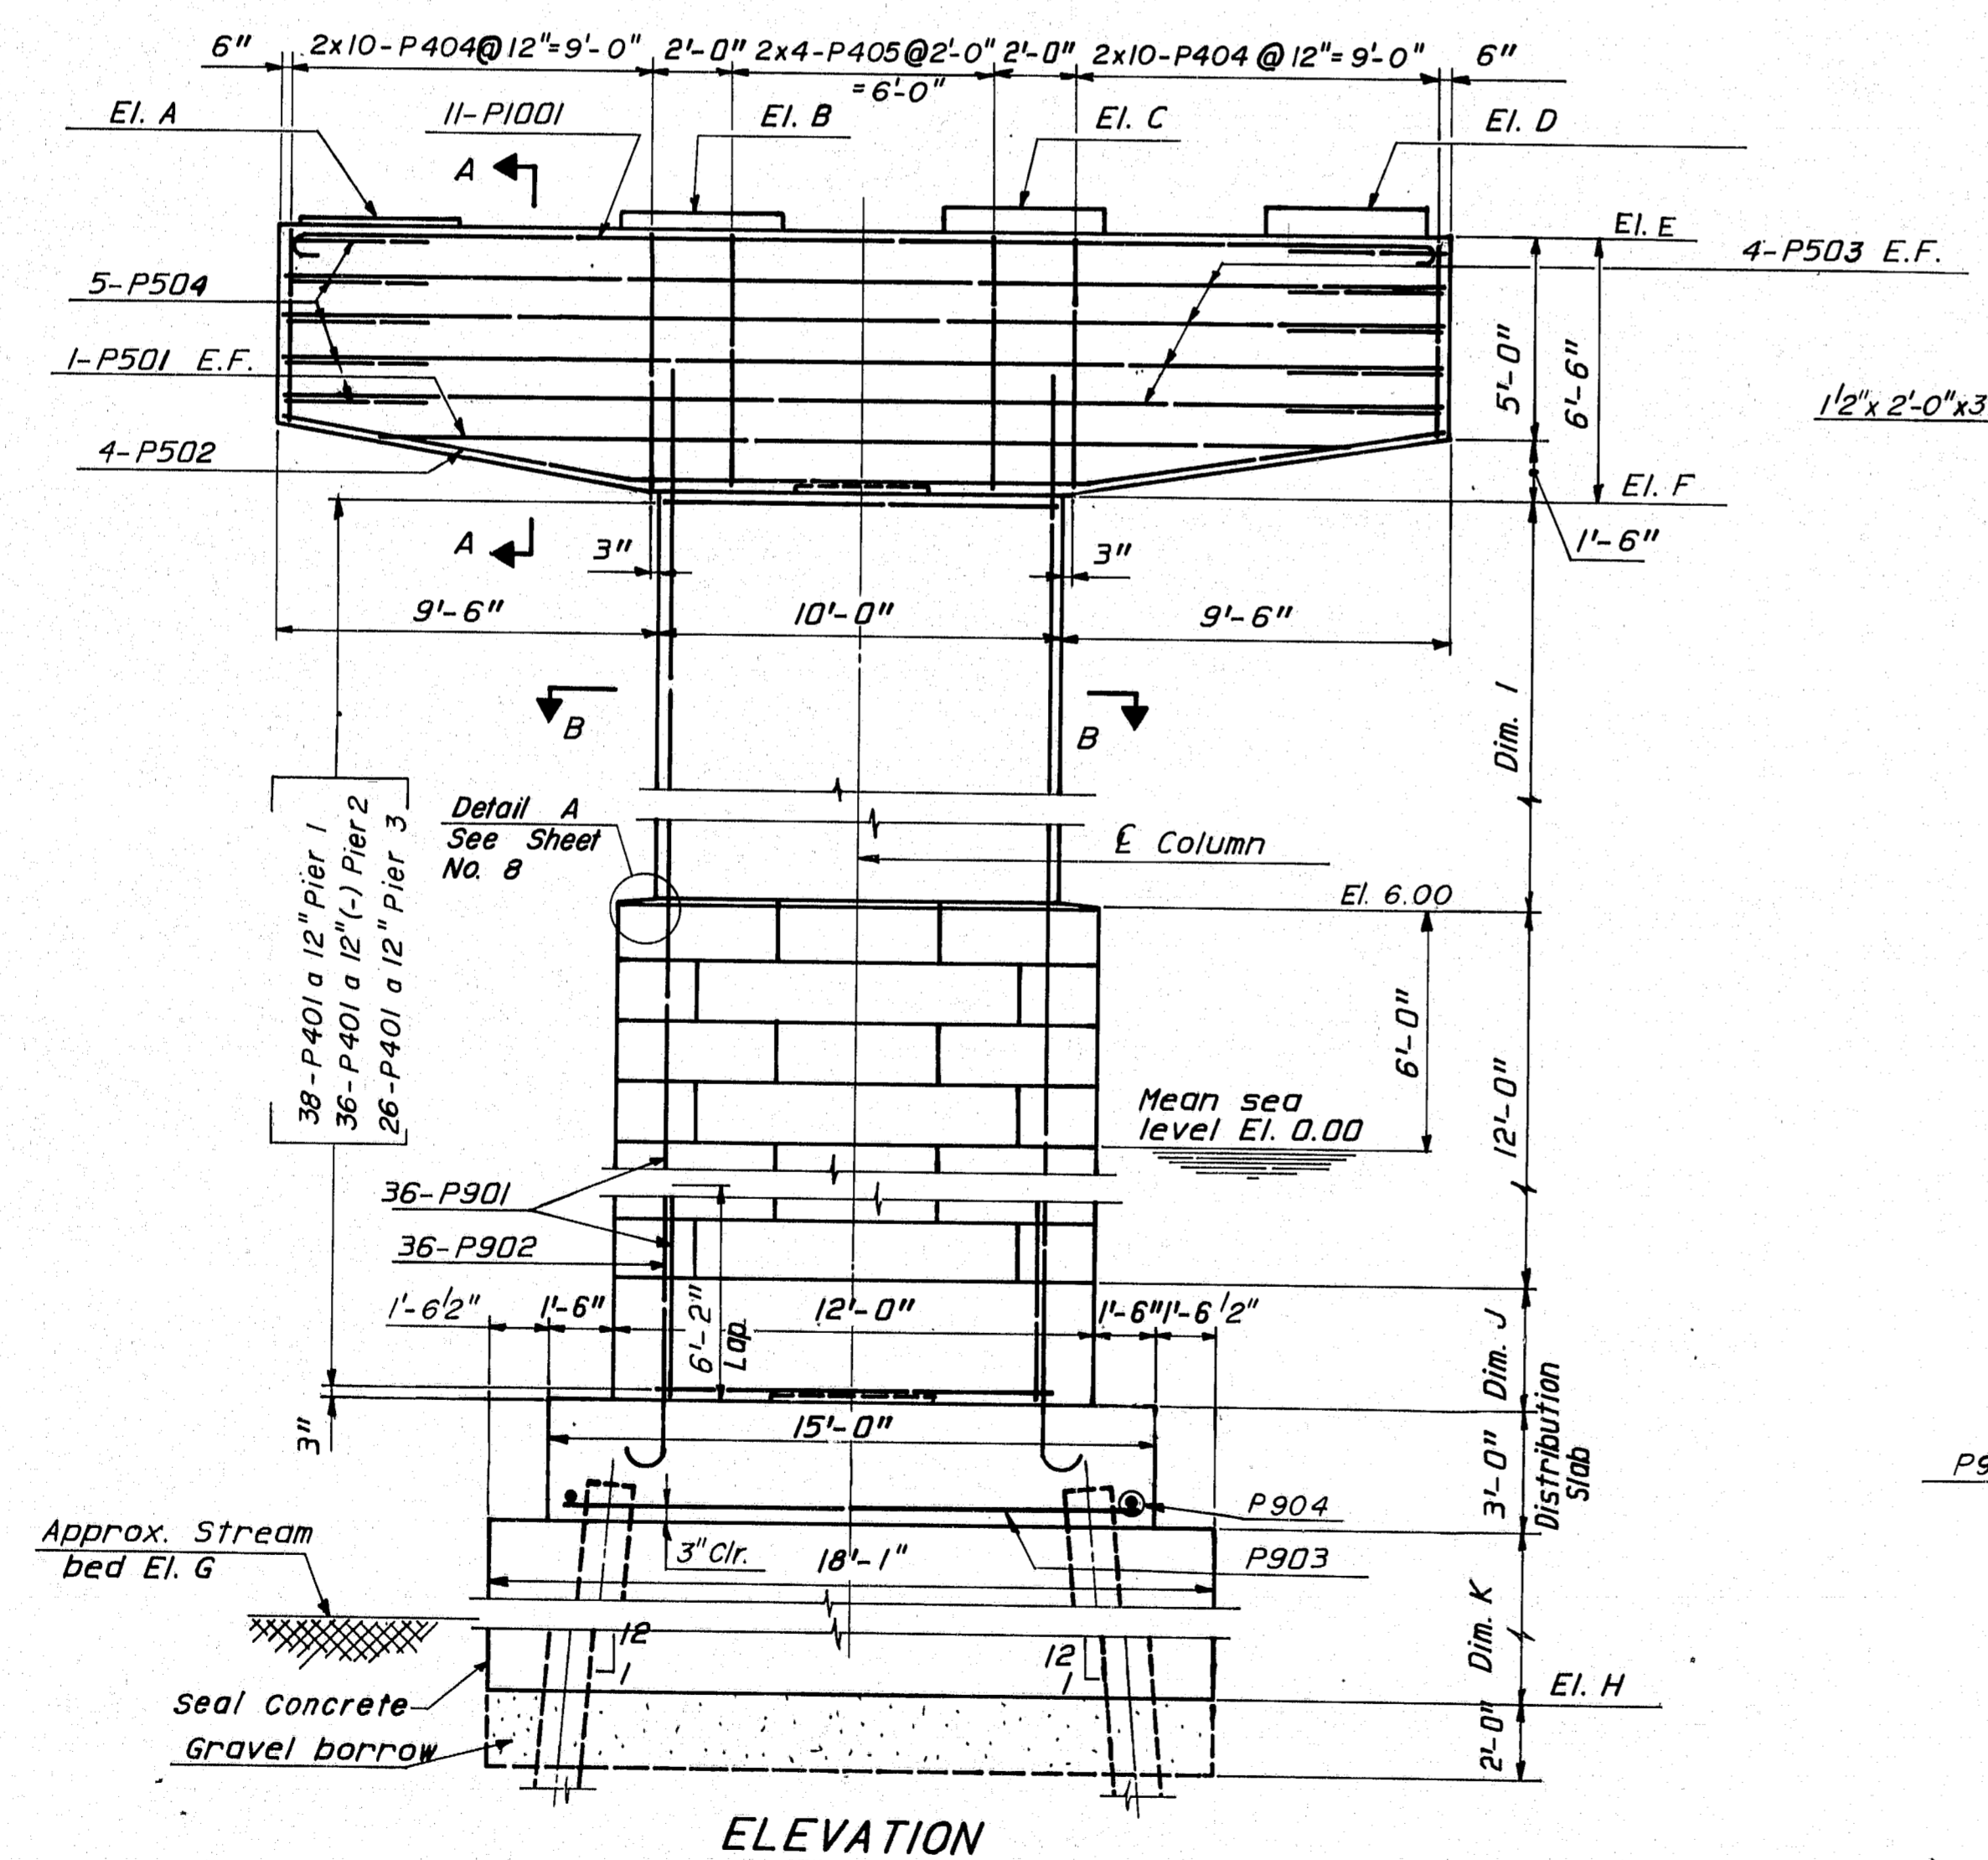

PILE NOTES:

1. Piles marked thus \rightarrow shall be battered 1" per foot in the direction of the arrow.
2. All piles are HP 14x73. Maximum calculated pile loads 97 tons for southbound piers and 104 tons for northbound piers.
3. Embedment of piles in distribution slab may vary between 1'-0" and 2'-0". The actual embedment length up to a maximum of 1'-6" will be included in the measurement for payment.

NOTES:

1. Reinforcing steel shall have 3" minimum cover unless otherwise indicated.
2. The depth of the seal is set for a water elevation of 6.00. If the water elevation at the time of construction is higher, the depth of seal shall be adjusted.
3. Seal concrete dimensions are predicated on the use of standard sheet pile section PDA27 or equivalent steel sheet piling, using appropriate standard rolled corners. Pay dimensions for seal concrete shall be to the neat lines shown plus 5" all around.

REFERENCE:

1. For Design Criteria, see sheet No. 12
2. For Granite Masonry Details, see Sheet No. 12
3. For Reinforcing Steel Schedule, see Sheet No. 24

LOCATION	NO.	LENGTH	PILE "A"	
			NO.	LENGTH
SOUTHBOUND	Abut. 1	11	95'	
	Abut. 2	11	83'	
	Pier 1	12	47'	1 53'
NORTHBOUND	Pier 2	12	42'	1 48'
	Pier 3	12	51'	1 57'
	Abut. 1	9	65'	
	Abut. 2	9	80'	
	Pier 1	8	25'	
	Pier 2	8	42'	
	Pier 3	8	44'	


PIER ELEVATIONS & DIMENSIONS												
Location	STATION	EL. A	EL. B	EL. C	EL. D	EL. E	EL. F	EL. G	EL. H	DIM. I	DIM. J	DIM. K
Pier 1	153+11	33.94	34.08	34.22	34.36	33.61	27.11	-21.8	-26.5	21'-1 3/8"	4'-0"	13'-6"
Pier 2	154+50	32.12	32.26	32.40	32.54	31.79	25.29	-22.3	-27.0	19'-3 1/2"	4'-0"	14'-0"
Pier 3	155+89	26.51	26.65	26.79	26.93	26.18	19.68	-7.3	-19.5	13'-8 1/8"	0'-0"	10'-6"

PROJECT DESIGN ENGINEER	AF	DATE	2/85
DESIGN - DETAILED	AH	BY	AW
CHECKED	AT	DATE	2/85
FIELD CHANGES			


103-278

STATE OF MAINE
 DEPARTMENT OF TRANSPORTATION
 1-295 INTERCHANGE COMPLEX
 TUKEYS BRIDGE
 OVER
 BACK COVE
 IN THE TOWN OF
 PORTLAND
 CUMBERLAND COUNTY
 PIERS 1, 2 & 3, SOUTHBOUND
 SHEET 13 OF 35 AUGUSTA, MAINE

F.R.W.A. REG. NO.	STATE	PROJECT NUMBER	SHEET NO.	TOTAL SHEETS
1	MAINE	IR-295-3(94)50	10	120

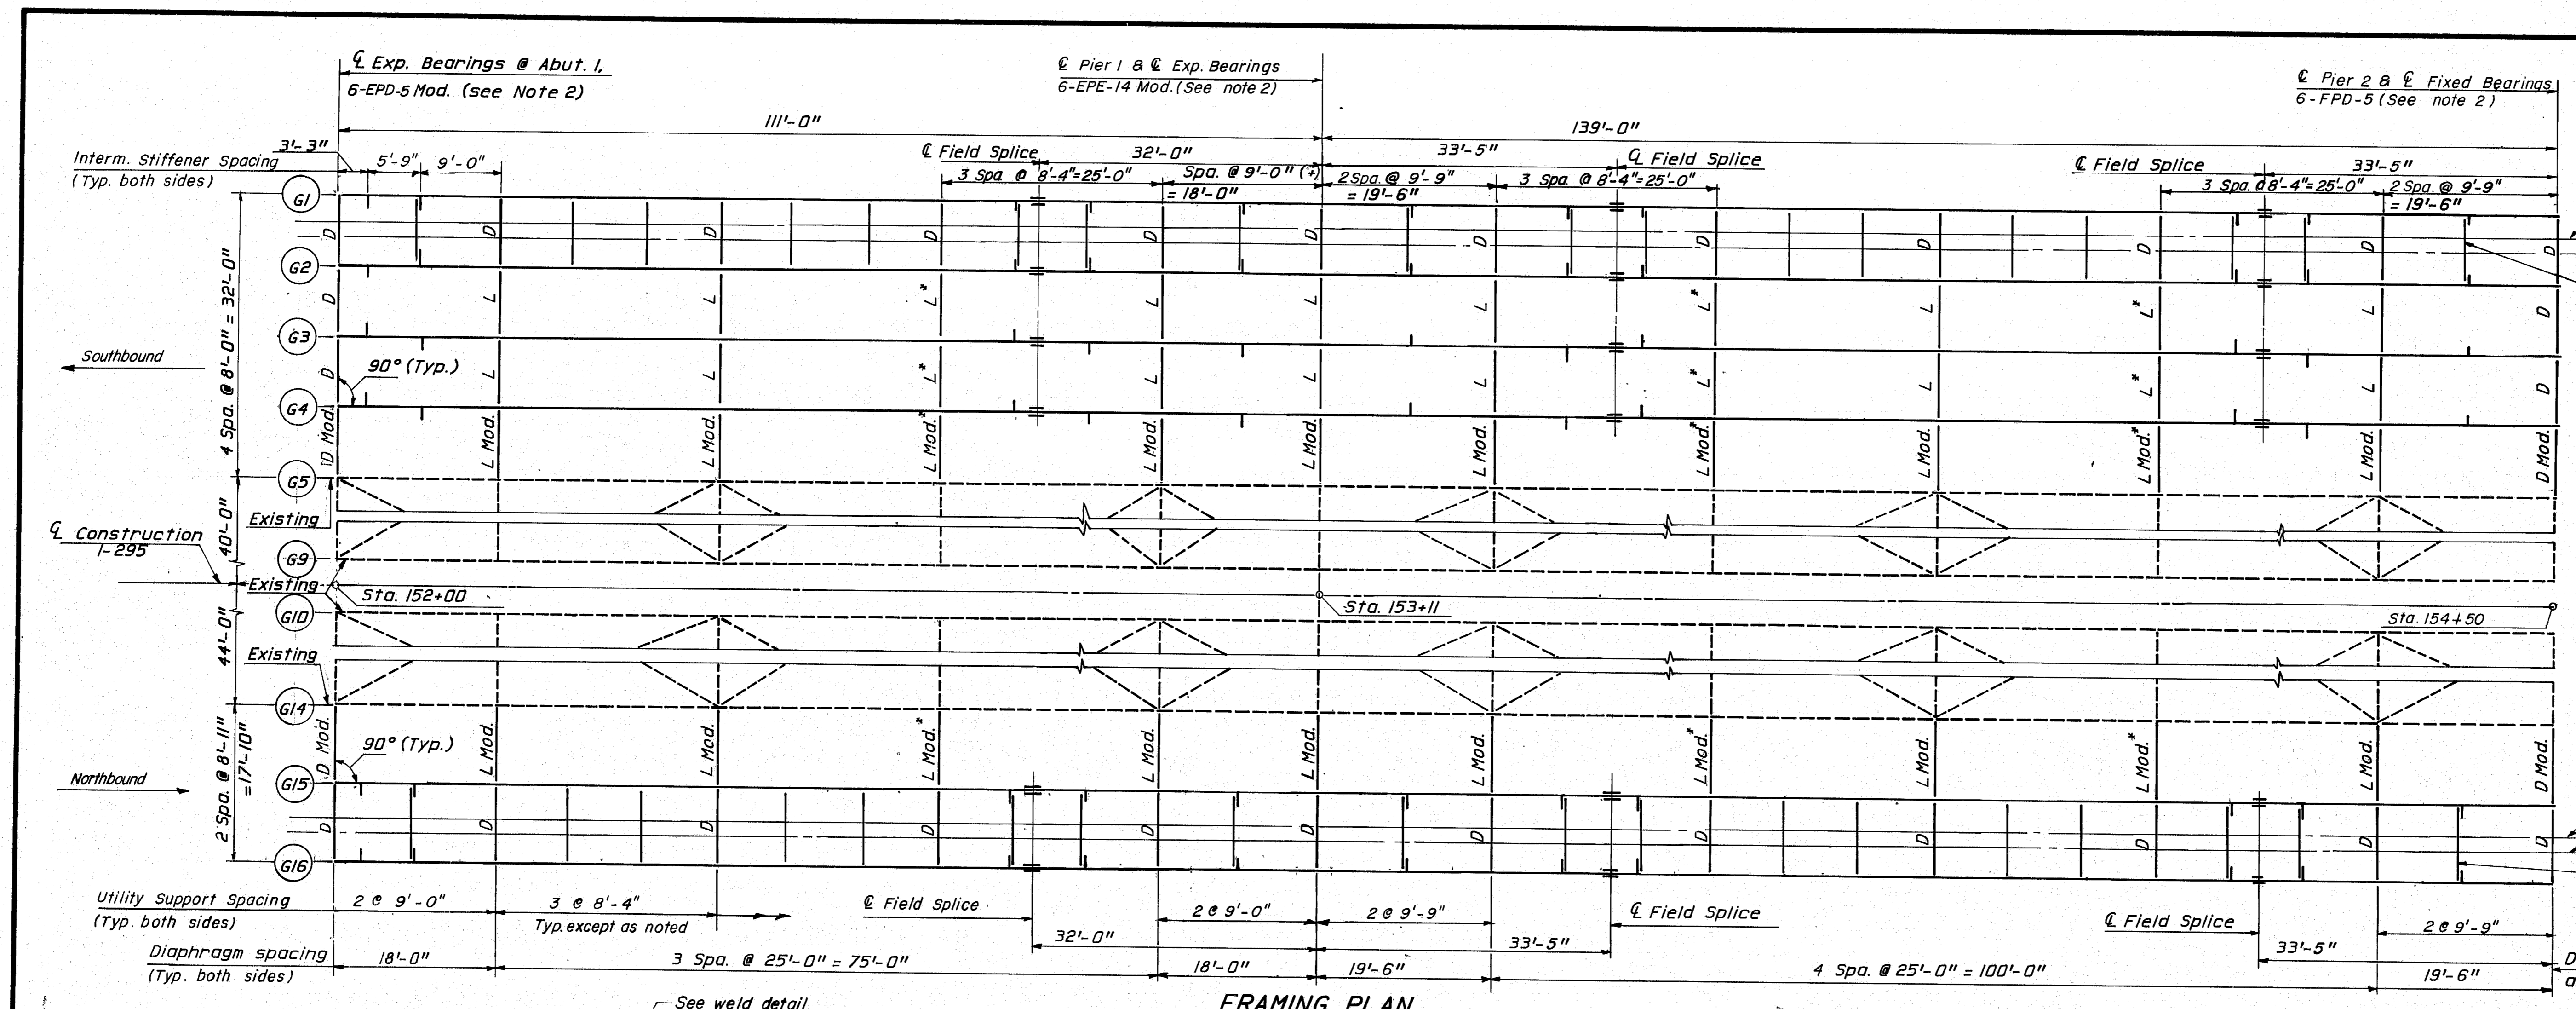

6" ϕ Gas Pipe
 9-4" ϕ Telephone ducts
 Utility support D1 (Typ.)

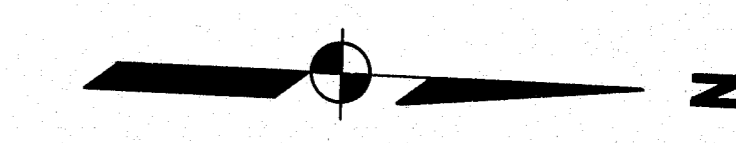

8" ϕ oil filled conduit
 9-4" ϕ Elec. ducts
 Utility support D2 (Typ.)

FRAMING PLAN

STRUCTURAL STEEL NOTES:

- NOTE:**
 At the locations marked with an asterisk (*) the Type L or Type L Modified diaphragm shall be changed to a Type D or Type D Modified diaphragm respectively at the locations where the contractor elects to terminate the slab placement. No extra compensation will be allowed for any diaphragms so substituted, and any additional costs will be considered incidental to the contract items.
- Diaphragms D Mod. & L Mod. shall be erected after dead load deflection has occurred.
 - The 18" dimensions shown in Detail "A" of the Standard Details (BD 100-81) shall be altered to be 5/16" to accommodate transverse expansion and contraction.
 - The sole plates of EPE-14 and FPD-5 will project outside of the girder flange. Therefore, the girder to sole plate 1/2" fillet weld shall be made on top of and across the sole plate along the edges of the girder flanges. The weld shall be returned 3/4" transversely onto the girder flange to the weld termini. Set sole plates centered transversely on pins at 45°.
 - Cross Frame or diaphragm connection plates may be either plumb or normal to the top flange.
 - The Bearing Setting Chart indicates the required final position of the bearings. It is anticipated that the bearings at Abutments will move 1/16" away from the fixed bearings due to placement of the superstructure concrete. No separate payment will be made for resetting bearings to the final position if an adjustment is required.
 - See Notes on Sheet No. 15.


REFERENCES

- Bearing Pedestals BD 100-81 & Notes above
 Expansion Device BD 125-82
 Shear Connectors BD 126-81 & Sheet No. 15
 Drains (Item 502.26) BD 126-81
 Diaphragms BD 113-81 & Sheet No. 18


NOTE:

For Utility Support Details, see Sheet No. 16


103-249

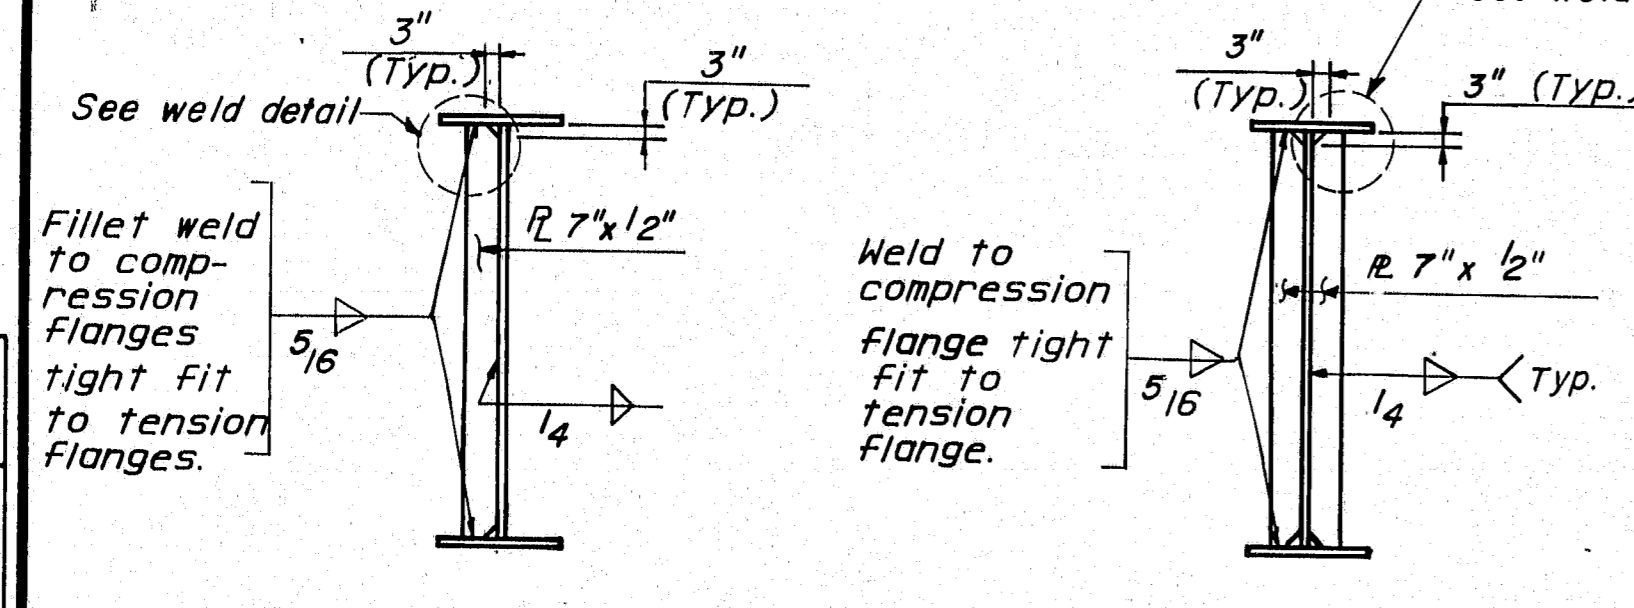


INTERMEDIATE WEB STIFFENER CONNECTION PLATES

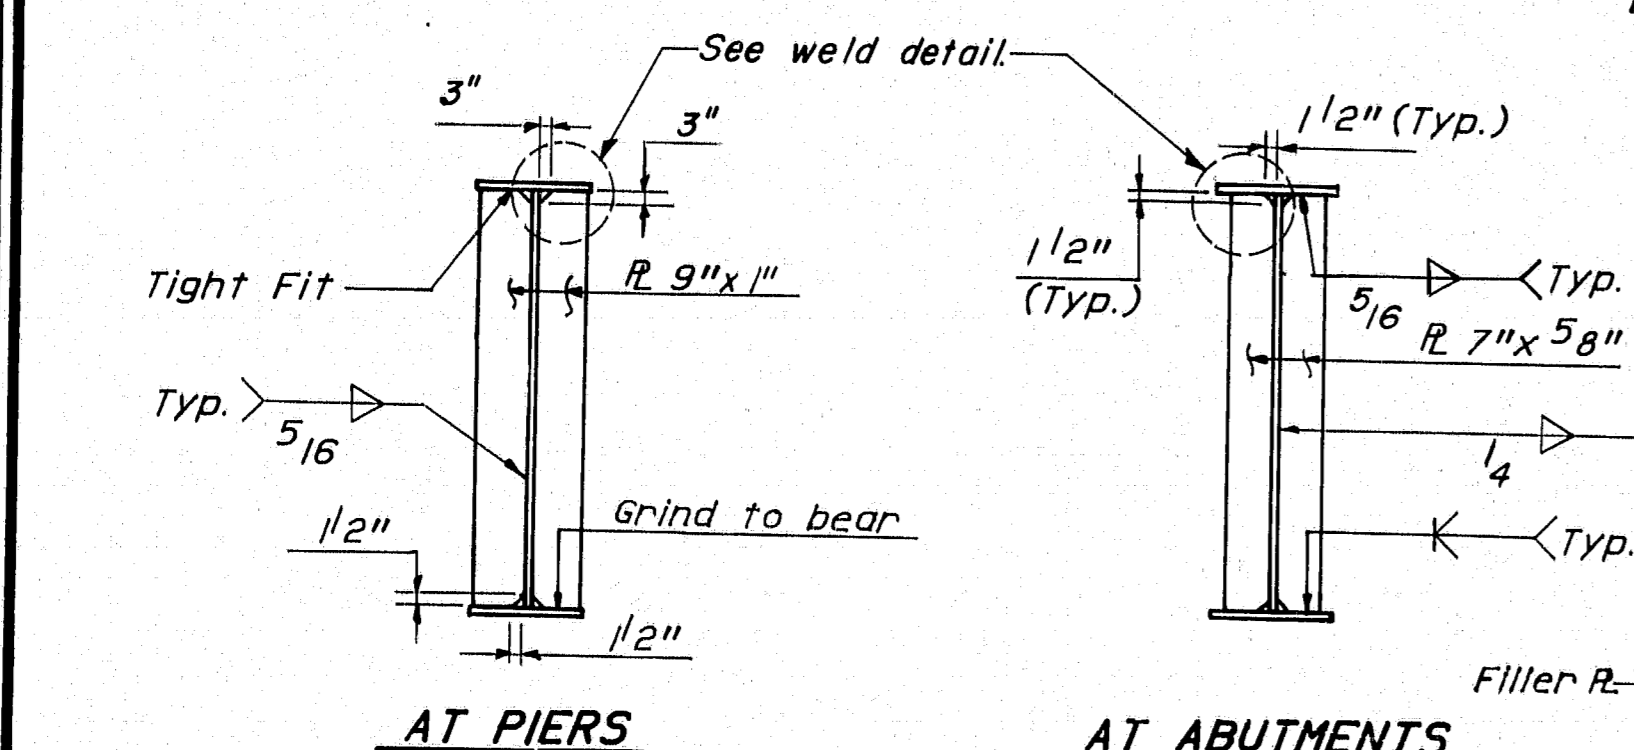


BEARING STIFFENER

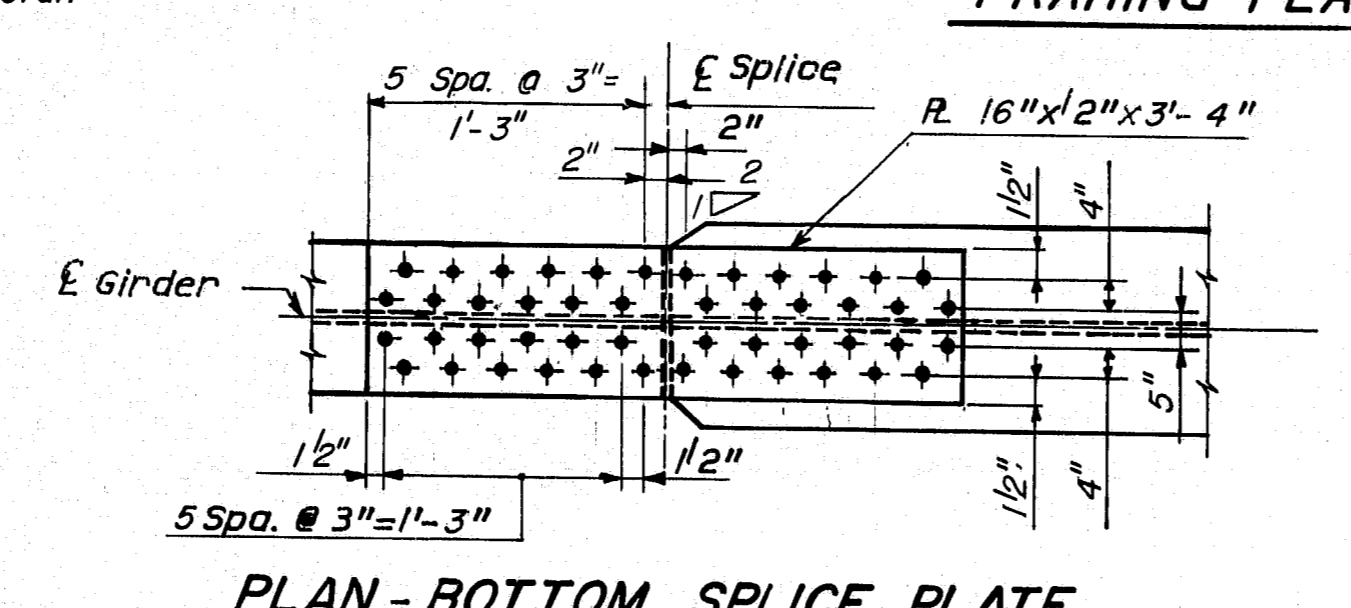

PLAN-BOTTOM SPLICE PLATE

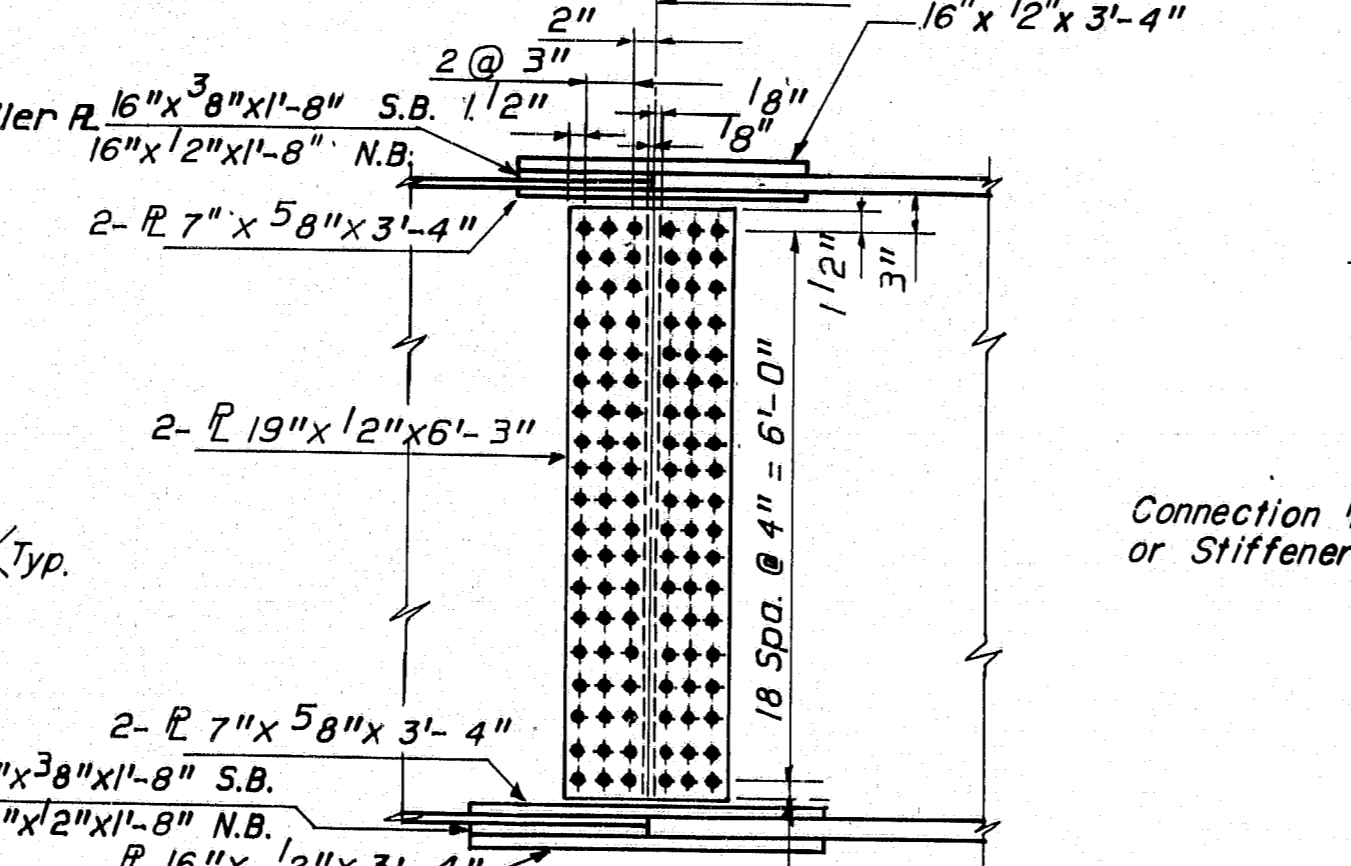

ELEVATION SPLICE DETAIL

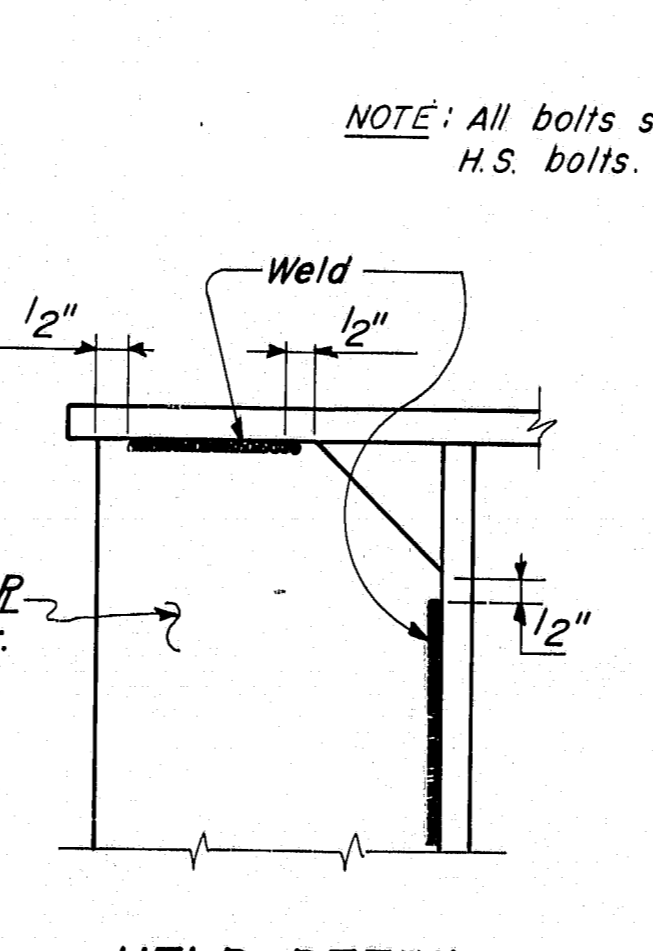

WELD DETAIL


NOTE:
 All plates welded to the girders (connection R's, stiffeners, etc.) shall have their welds terminated 1/2" from the ends of the plates. See Weld Detail above.

PROJECT ENGINEER	DATE
DESIGN - DETAILED	2/7/85
CHECKED	JDD/ZAH
REVISIONS	
FIELD CHANGES	

BRUNING 44-132-02710-1


STATE OF MAINE
 DEPARTMENT OF TRANSPORTATION
 I-295 INTERCHANGE COMPLEX
 TUKEYS BRIDGE
 OVER
 BACK COVE
 IN THE TOWN OF
 PORTLAND
 CUMBERLAND COUNTY
 FRAMING PLAN
 SHEET 14 OF 35 AUGUSTA, MAINE

F.R.W.A. REG. NO.	STATE	PROJECT NUMBER	SHEET NO.	TOTAL SHEETS
1	MAINE	R-295-3(94)50	17	190

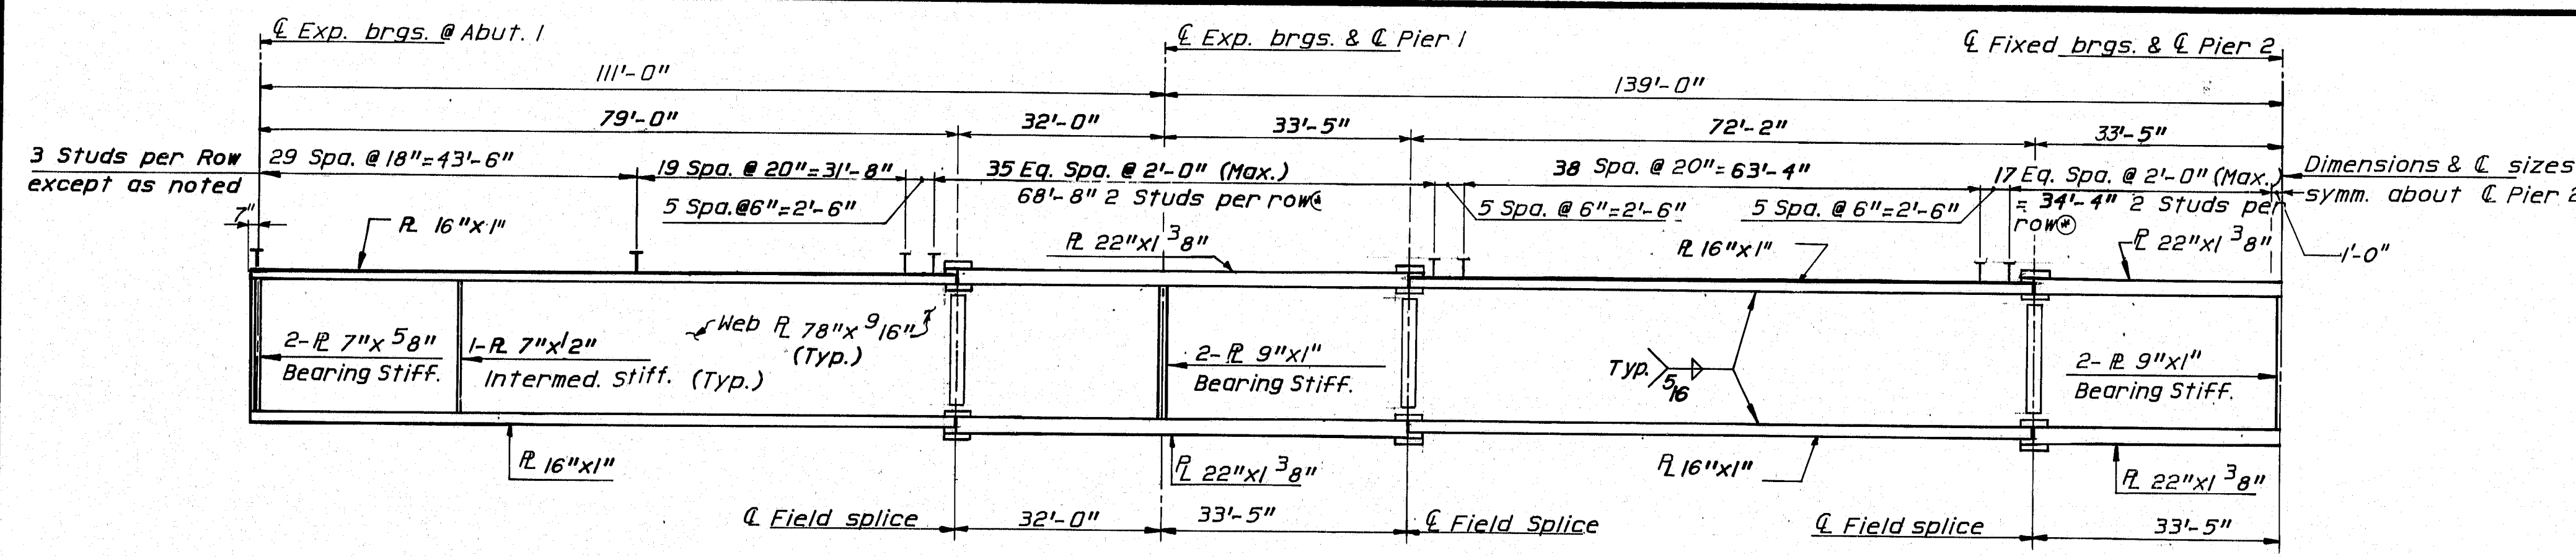

GIRDER ELEVATION - SOUTHBOUND

No. of Studs per Girder = 816

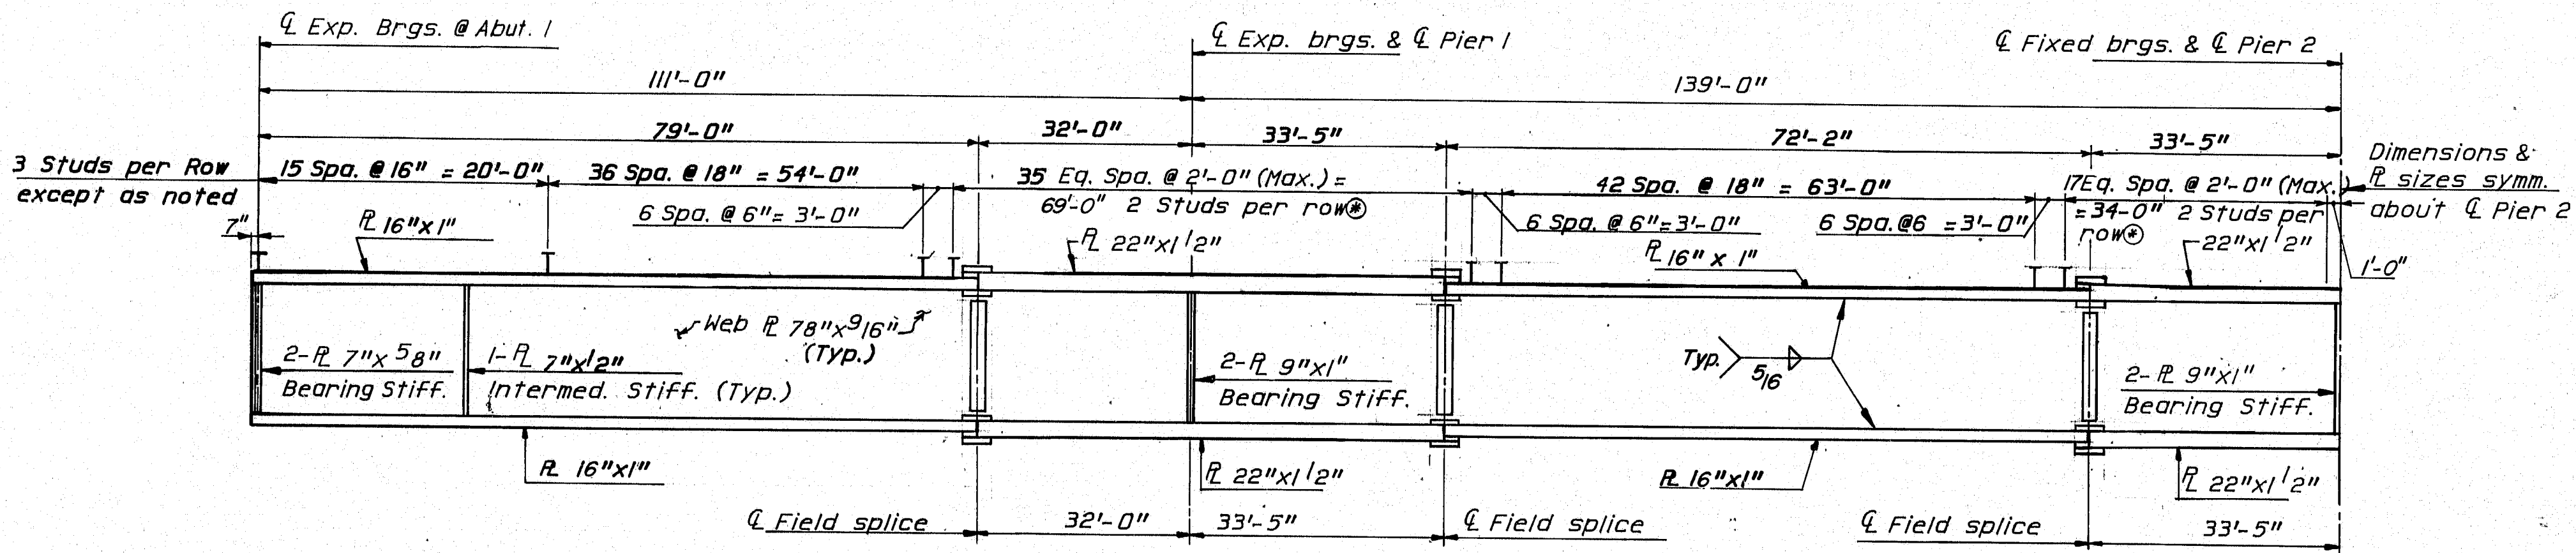


GIRDER ELEVATION - NORTHBOUND

No. of Studs per Girder = 876
Total No. Studs this project = 5016

Place single studs per row over splice.

* Camber ordinates are adjusted for Dead Load Deflection.

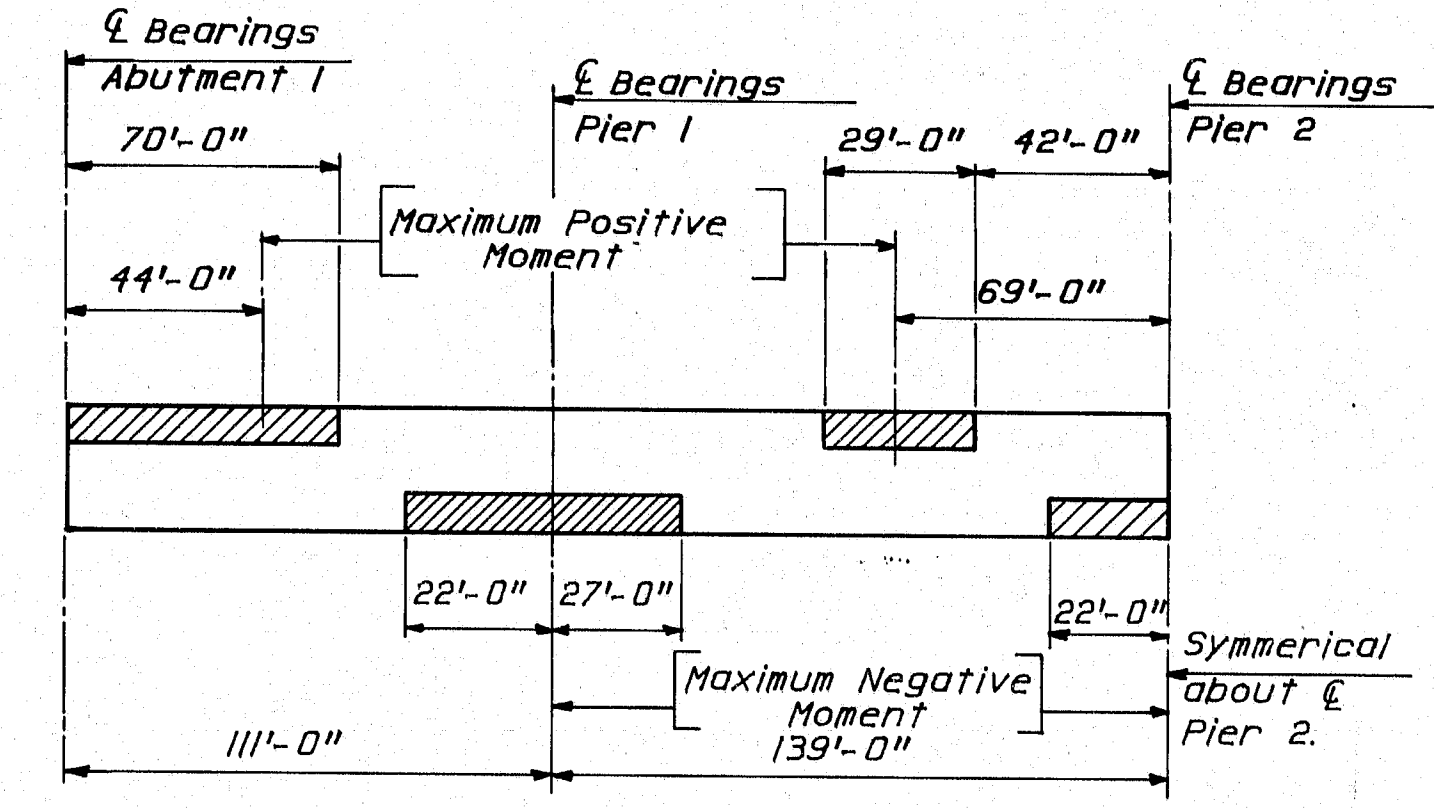


GIRDER STRESS DIAGRAM

NOTE: Cross hatched areas are always in compression. Others are in tension or have stress reversal.


NOTES:

- Camber ordinates, as shown are computed to compensate for all dead load deflections and for the curvature of the finished grade profile.
- Butt weld splices in flanges shall be not less than 3 feet in the web plates in the web plates.
- The Bearing Setting Chart indicates the required final position of the bearings. It is anticipated that the bearings at Abutment 1 and at Abutment 2 will move 1/8 inch away from the fixed bearings due to the placement of the superstructure concrete. No separate payment will be made for resetting bearings to the final position if an adjustment is required.
- No transverse butt weld splices will be allowed in the flange plates or web plates within 10' from points of maximum negative moment or maximum positive moment.
- Sections of flange plates or web plates between transverse shop splice and a field splice shall be not less than 30 feet in length unless otherwise shown on the Plans.
- Bearing stiffeners shall be plumb after erection and dead loading of the structure. Intermediate web stiffeners may be either plumb or normal to the top flange.

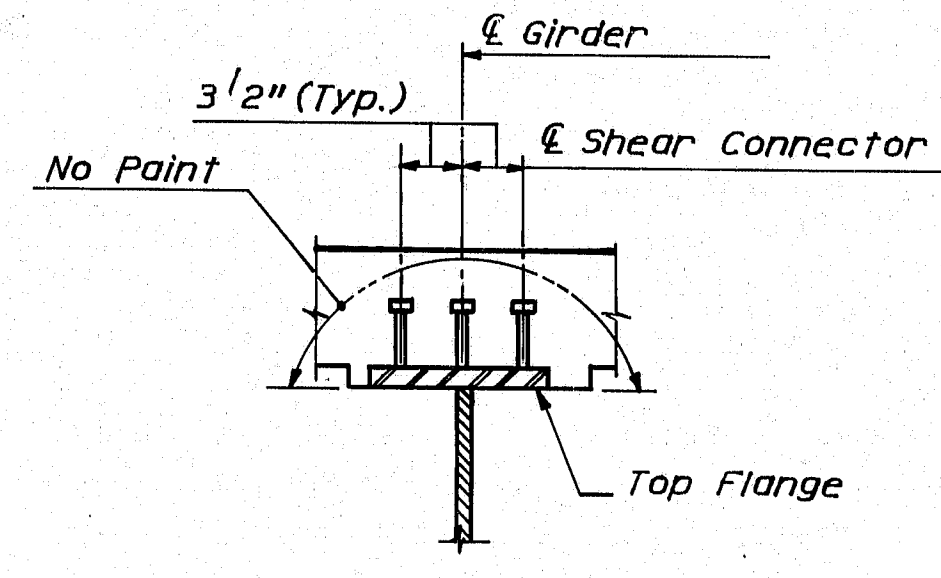


TYPICAL GIRDER SECTION


		CAMBER TABLE (Ft.) *																																							
POINT		10	11	12	13	14	15	16	17	18	19	20	21	22	23	24	25	26	27	28	29	30	31	32	33	34	35	36	37	38	A	B	C	D	E	F	G	H	I	J	
CAMBER ORDINATE	SOUTH-BOUND	.61	0	.109	.149	.110	0	.016	.020	.019	0	.088	.121	.088	0	.018	.020	.018	0	.070	.083	.051	0	-.028	-.042	-.030	0	.042	.057	.041	0	11.860	11.671	11.332	10.937	9.540	8.638	7.696	5.208	3.963	2.859
	NORTH-BOUND	.63	0	.111	.151	.111	0	.016	.019	.018	0	.089	.121	.089	0	.017	.019	.018	0	.071	.084	.052	0	-.029	-.043	-.030	0	.044	.059	.042	0	11.860	11.672	11.332	10.939	9.541	8.638	7.697	5.209	3.963	2.859
	64	0	.107	.152	.113	0	.015	.018	.018	0	.089	.122	.089	0	.017	.018	.017	0	.071	.084	.052	0	-.030	-.044	-.031	0	.043	.060	.043	0	11.860	11.672	11.332	10.939	9.541	8.638	7.698	5.209	3.963	2.860	
	65	0	.116	.158	.116	0	.013	.016	.015	0	.092	.126	.092	0	.016	.016	.015	0	.073	.088	.055	0	-.031	-.048	-.033	0	.047	.067	.047	0	11.860	11.676	11.332	10.941	9.543	8.638	7.700	5.211	3.963	2.864	
	616	0	.111	.150	.111	0	.017	.021	.020	0	.088	.120	.089	0	.019	.021	.019	0	.069	.083	.051	0	-.028	-.043	-.030	0	.042	.059	.042	0	11.860	11.671	11.332	10.935	9.538	8.638	7.695	5.206	3.963	2.859	

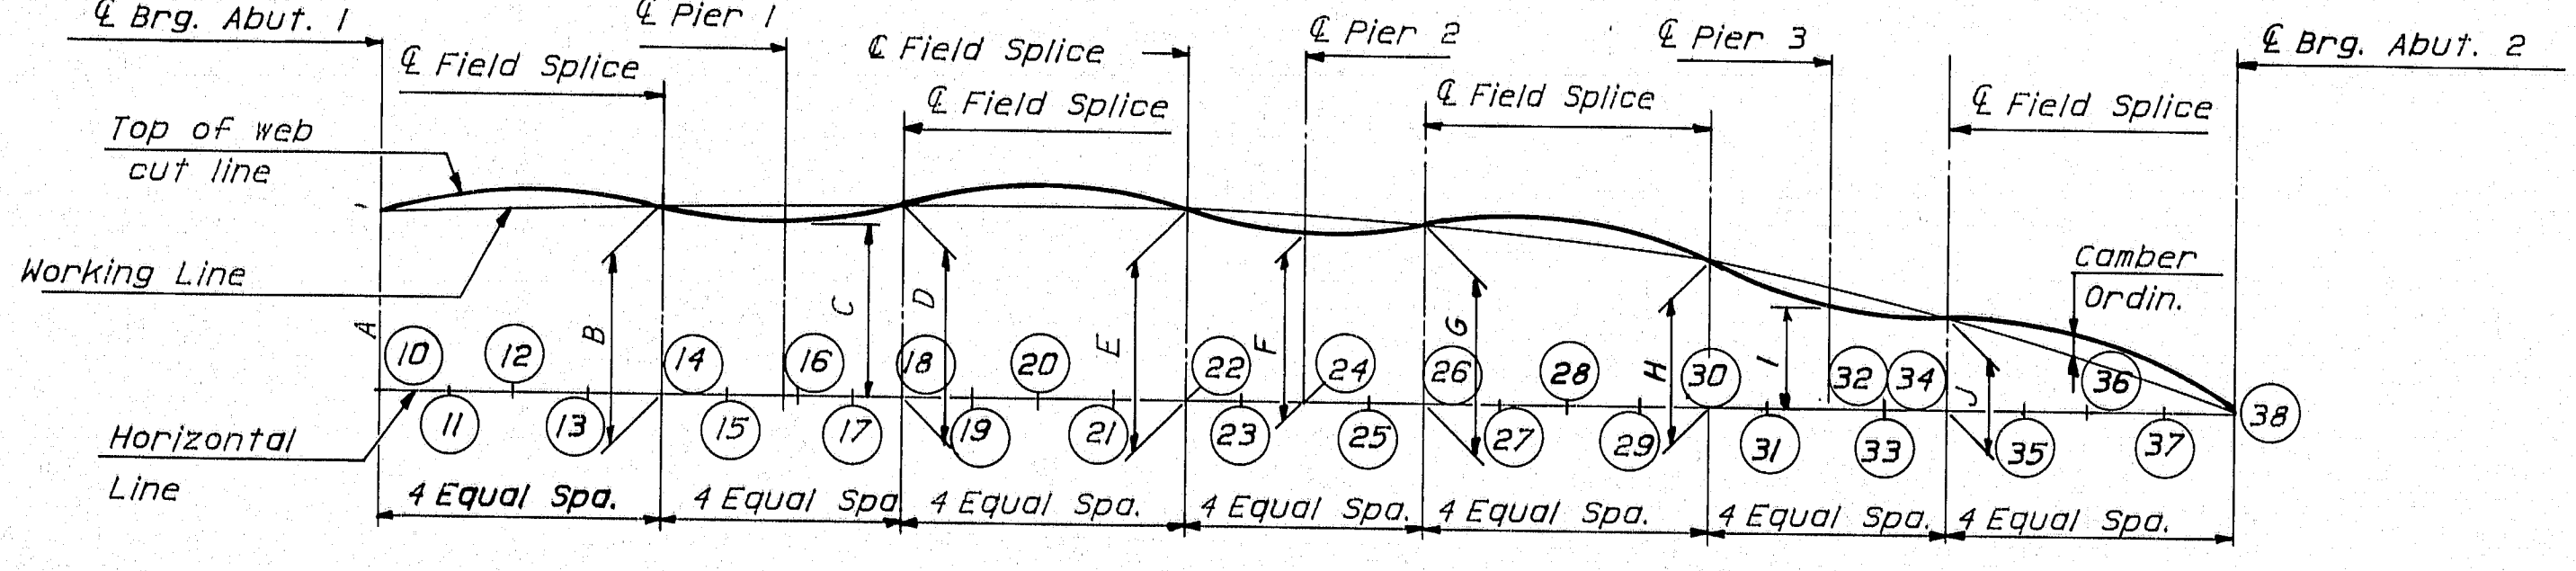

CAMBER DIAGRAM

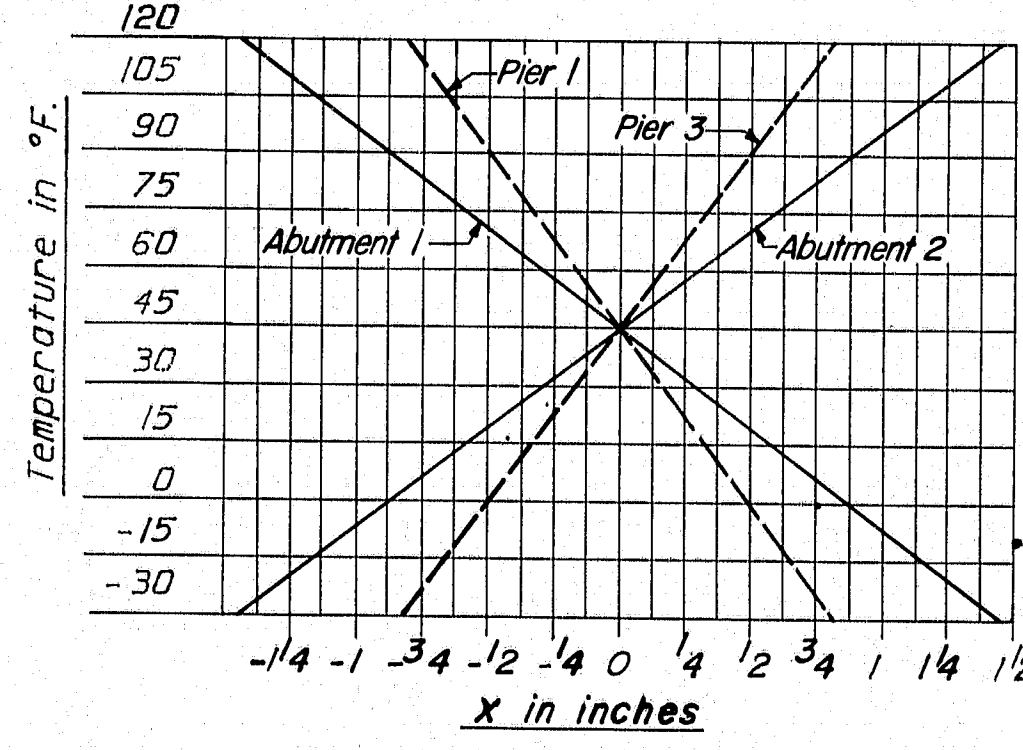

BEARING SETTING CHART

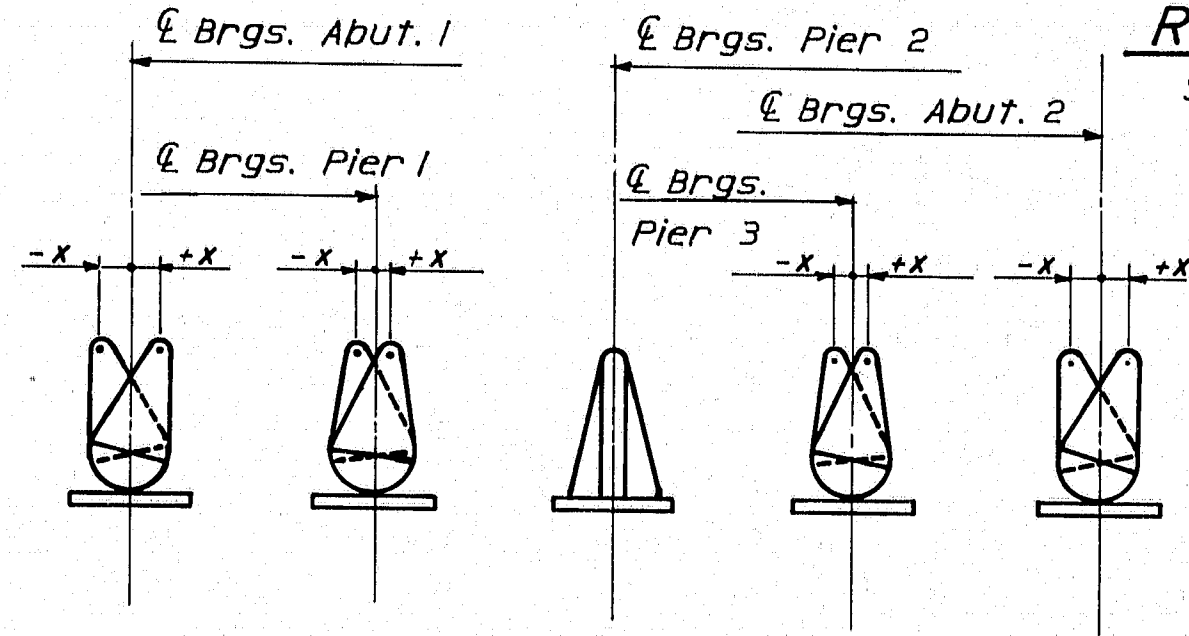

BEARING SETTING DETAIL

REFERENCE

Shear connector detail BD 126-81

STATE OF MAINE
DEPARTMENT OF TRANSPORTATION

1-295 INTERCHANGE COMPLEX
TUKEYS BRIDGE
OVER
BACK COVE
IN THE TOWN OF
PORTLAND
CUMBERLAND COUNTY
GIRDER ELEVATION & CAMBER TABLE


SHEET 15 OF 35 AUGUSTA, MAINE

103-280


PROJECT DESIGN ENGINEER	A.F.	DATE	2/85
DESIGN - DETAILED	A.F.	A.S.	
CHECKED	A.F./J.D.D.		
REVISIONS			
FIELD CHANGES			

REVISED 44-122-057101


F.R.W.A. REG. NO.	STATE	PROJECT NUMBER	SHEET NO.	TOTAL SHEETS
1	MAINE	IR-295-319450	20	120

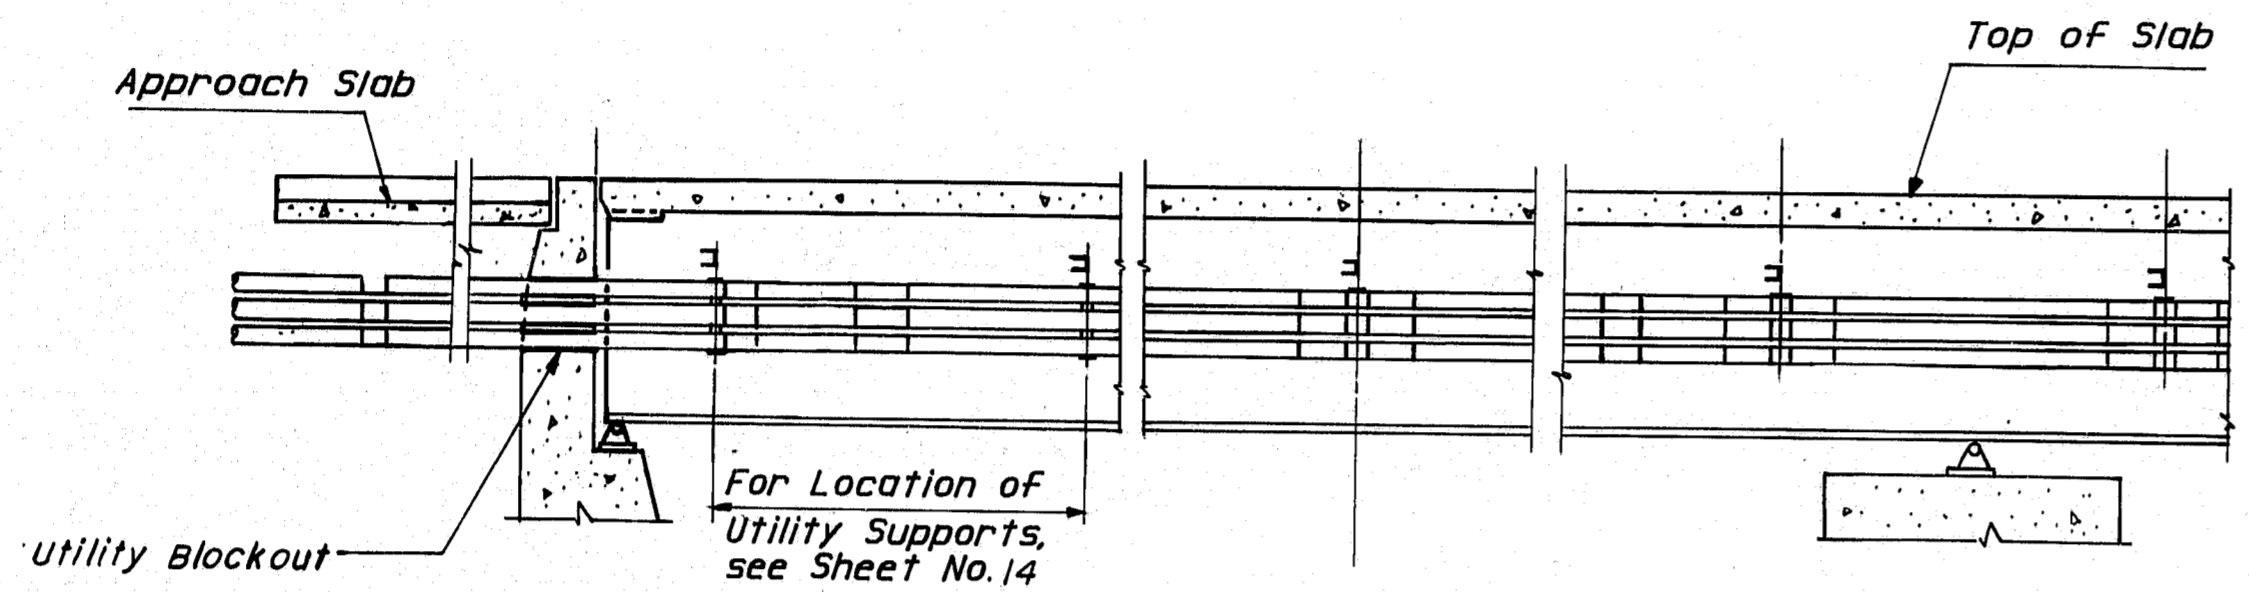


ABUTMENT PIER
ELEVATION - 9-4" TELEPHONE & ELECTRICITY DUCTS

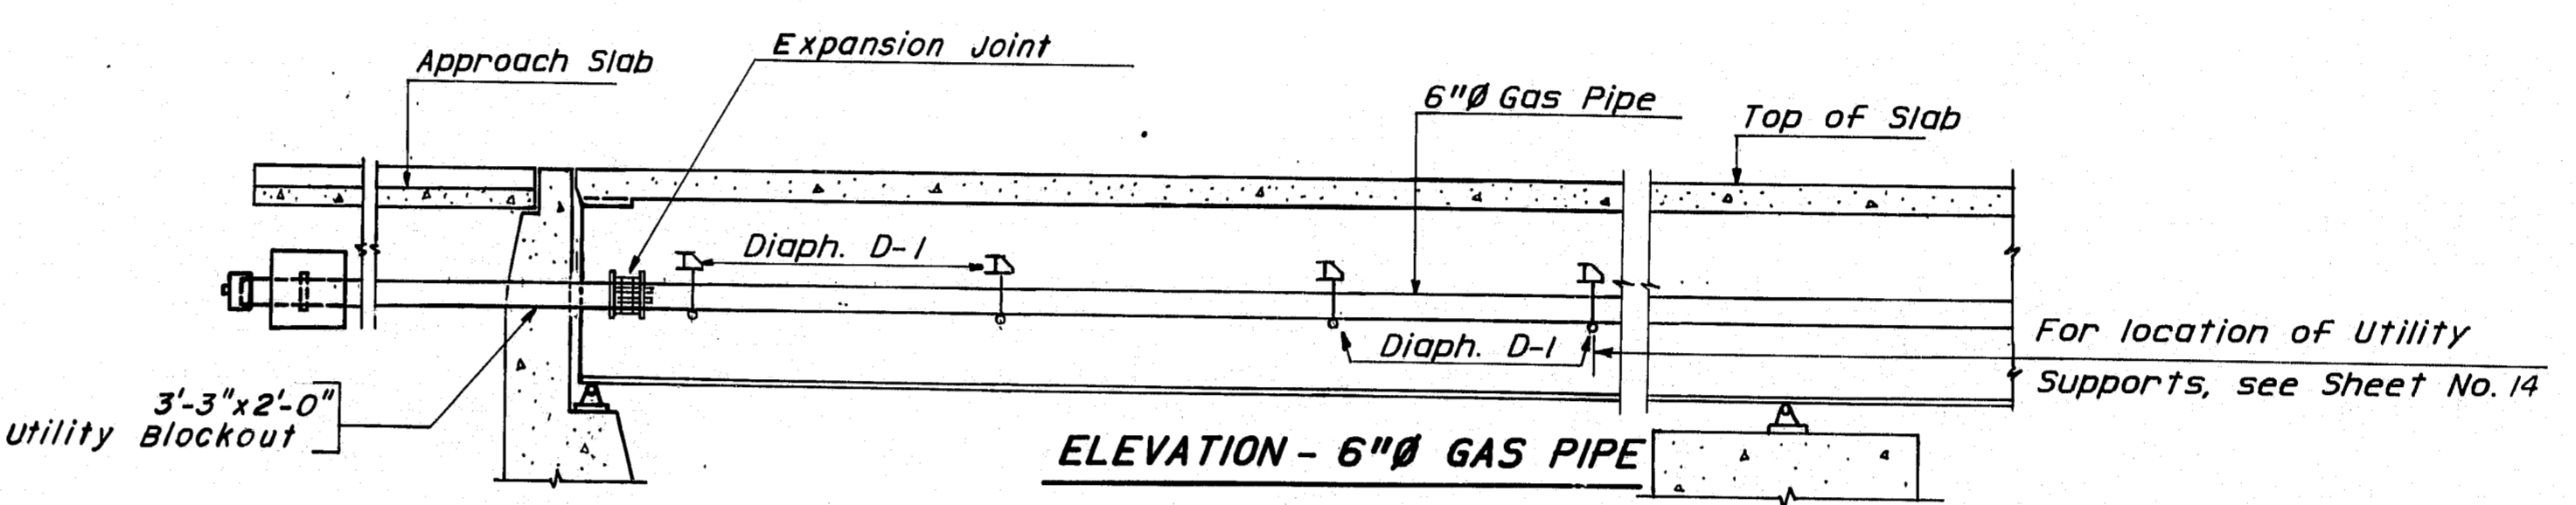


ELEVATION - 6" GAS PIPE

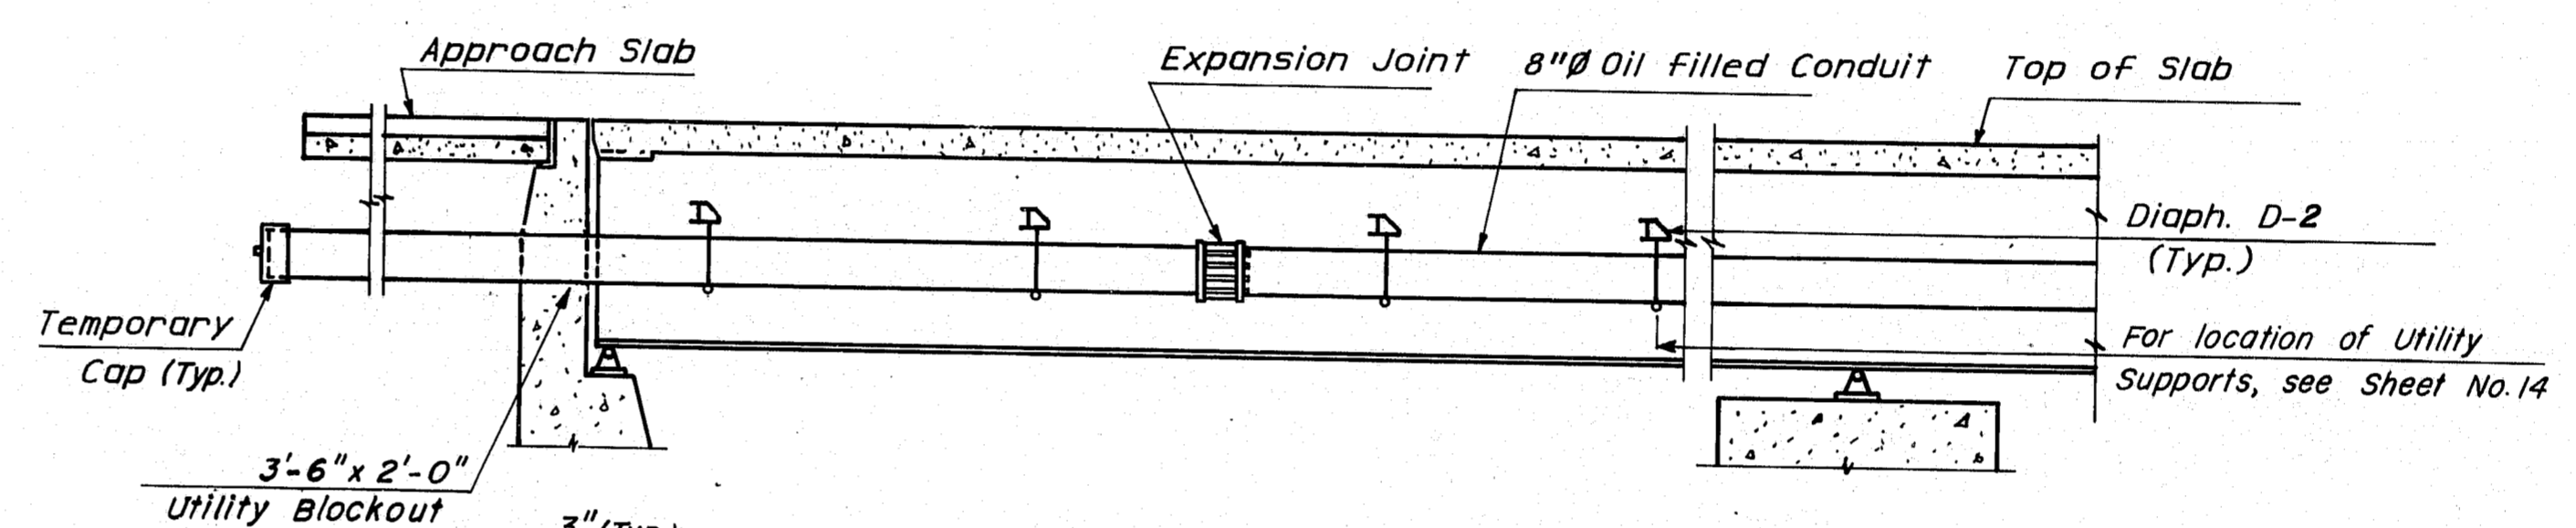


ELEVATION - 8" OIL FILLED CONDUIT

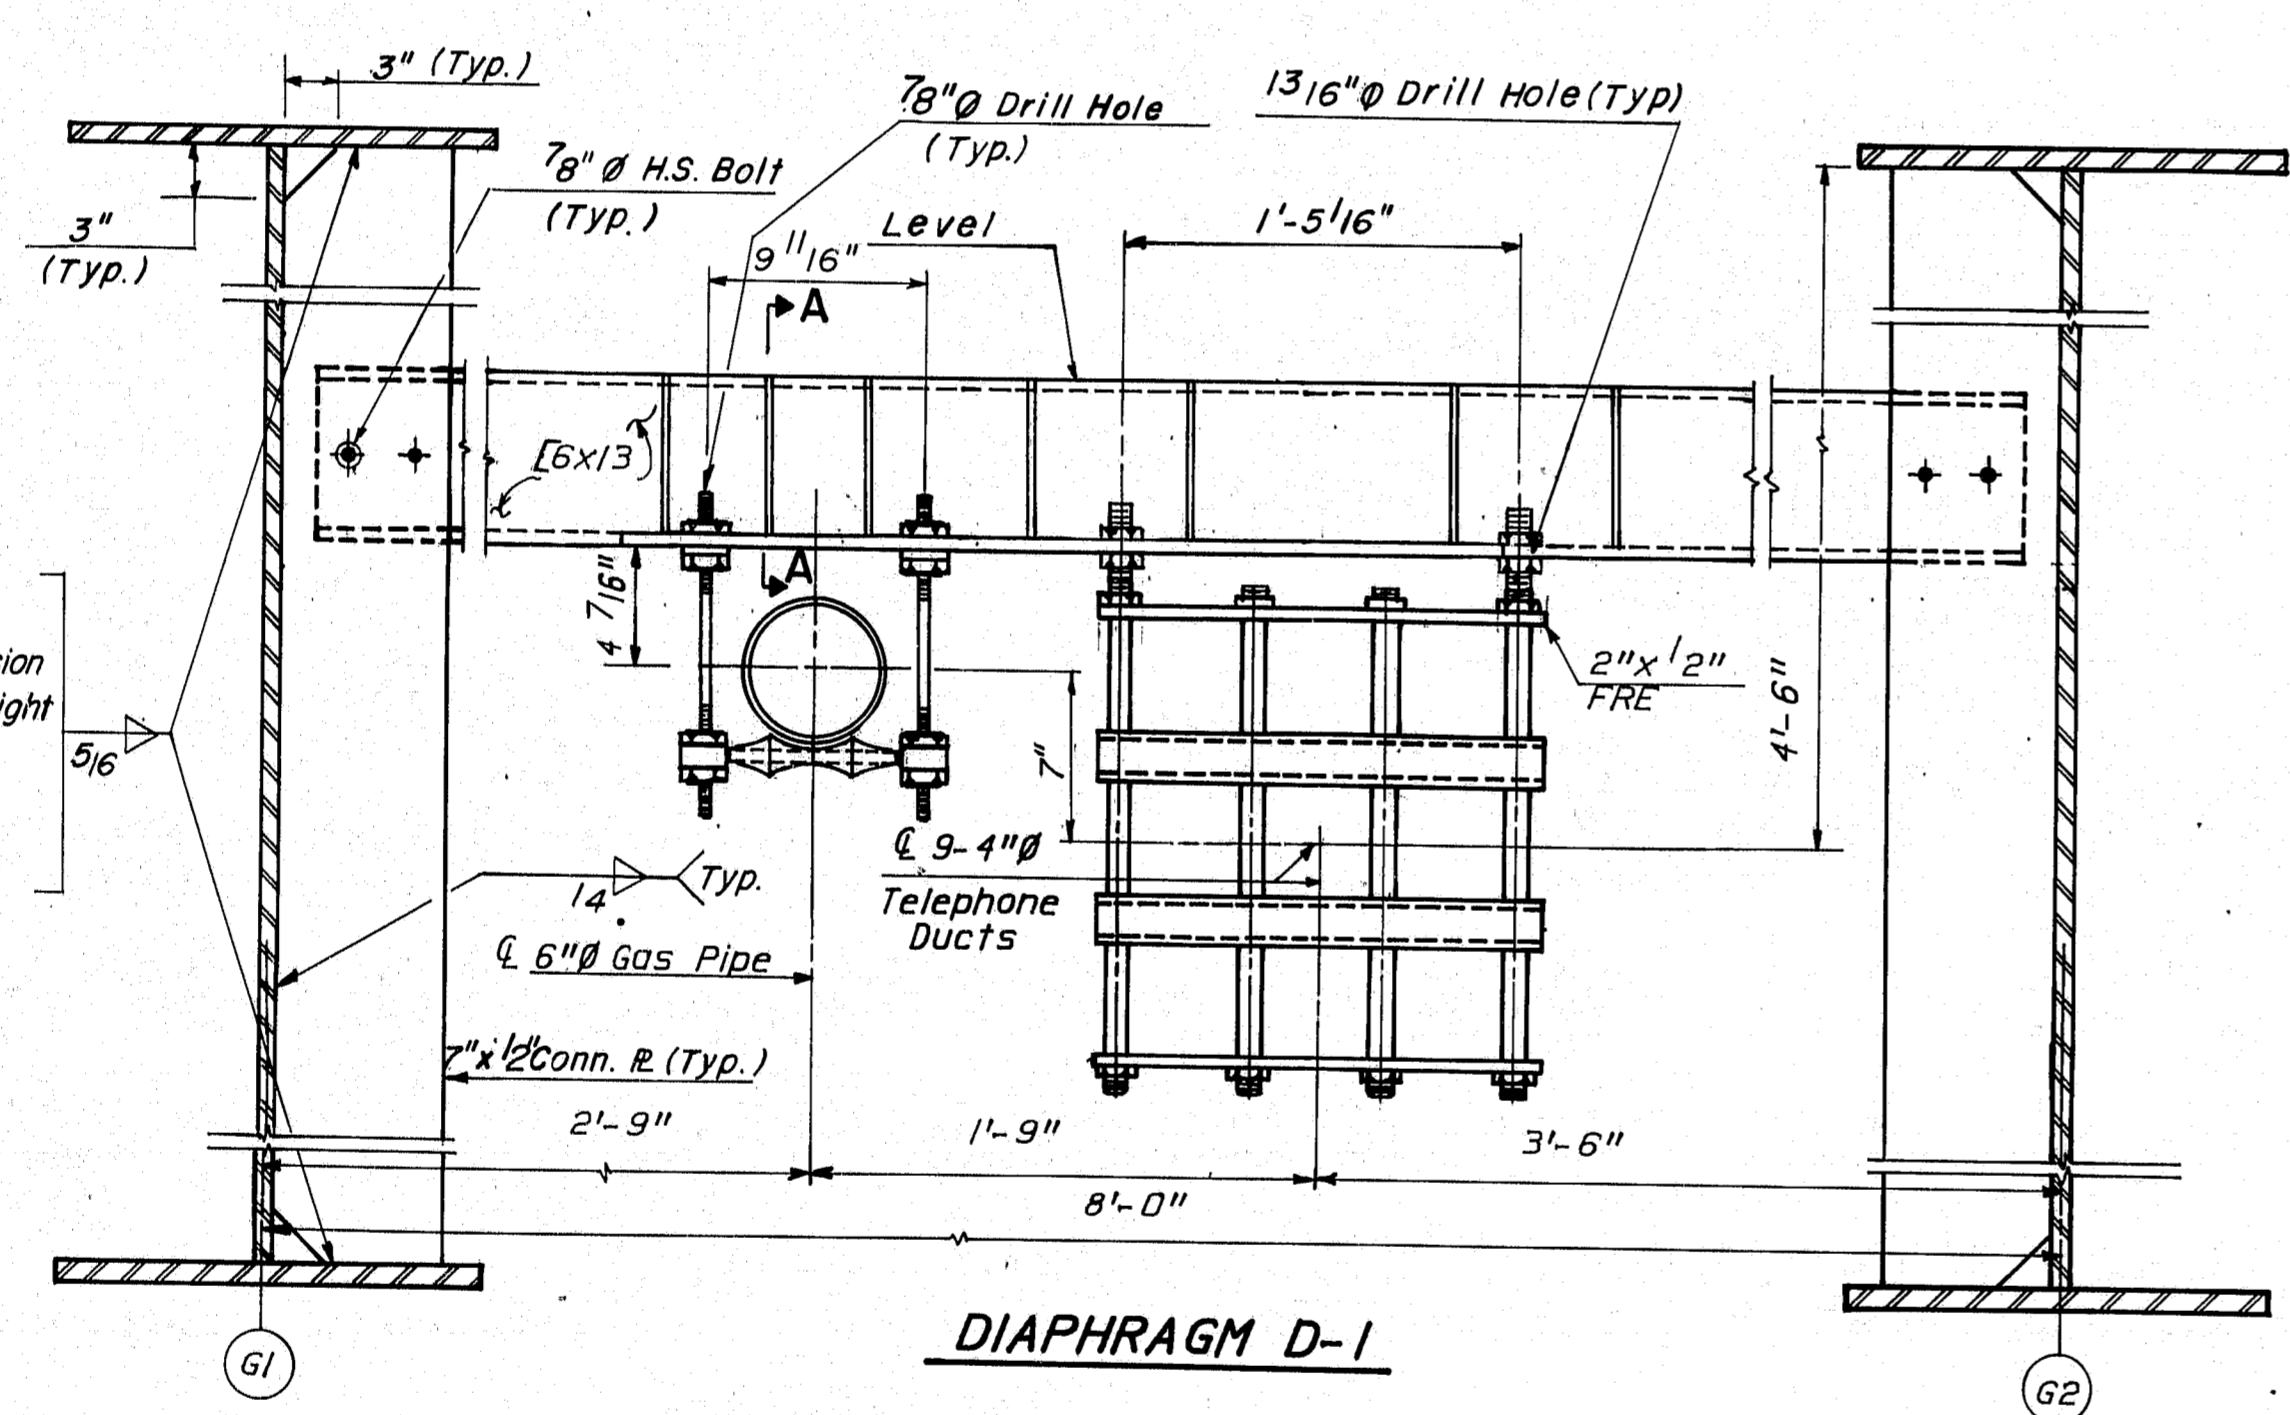

DIAPHRAGM D-1

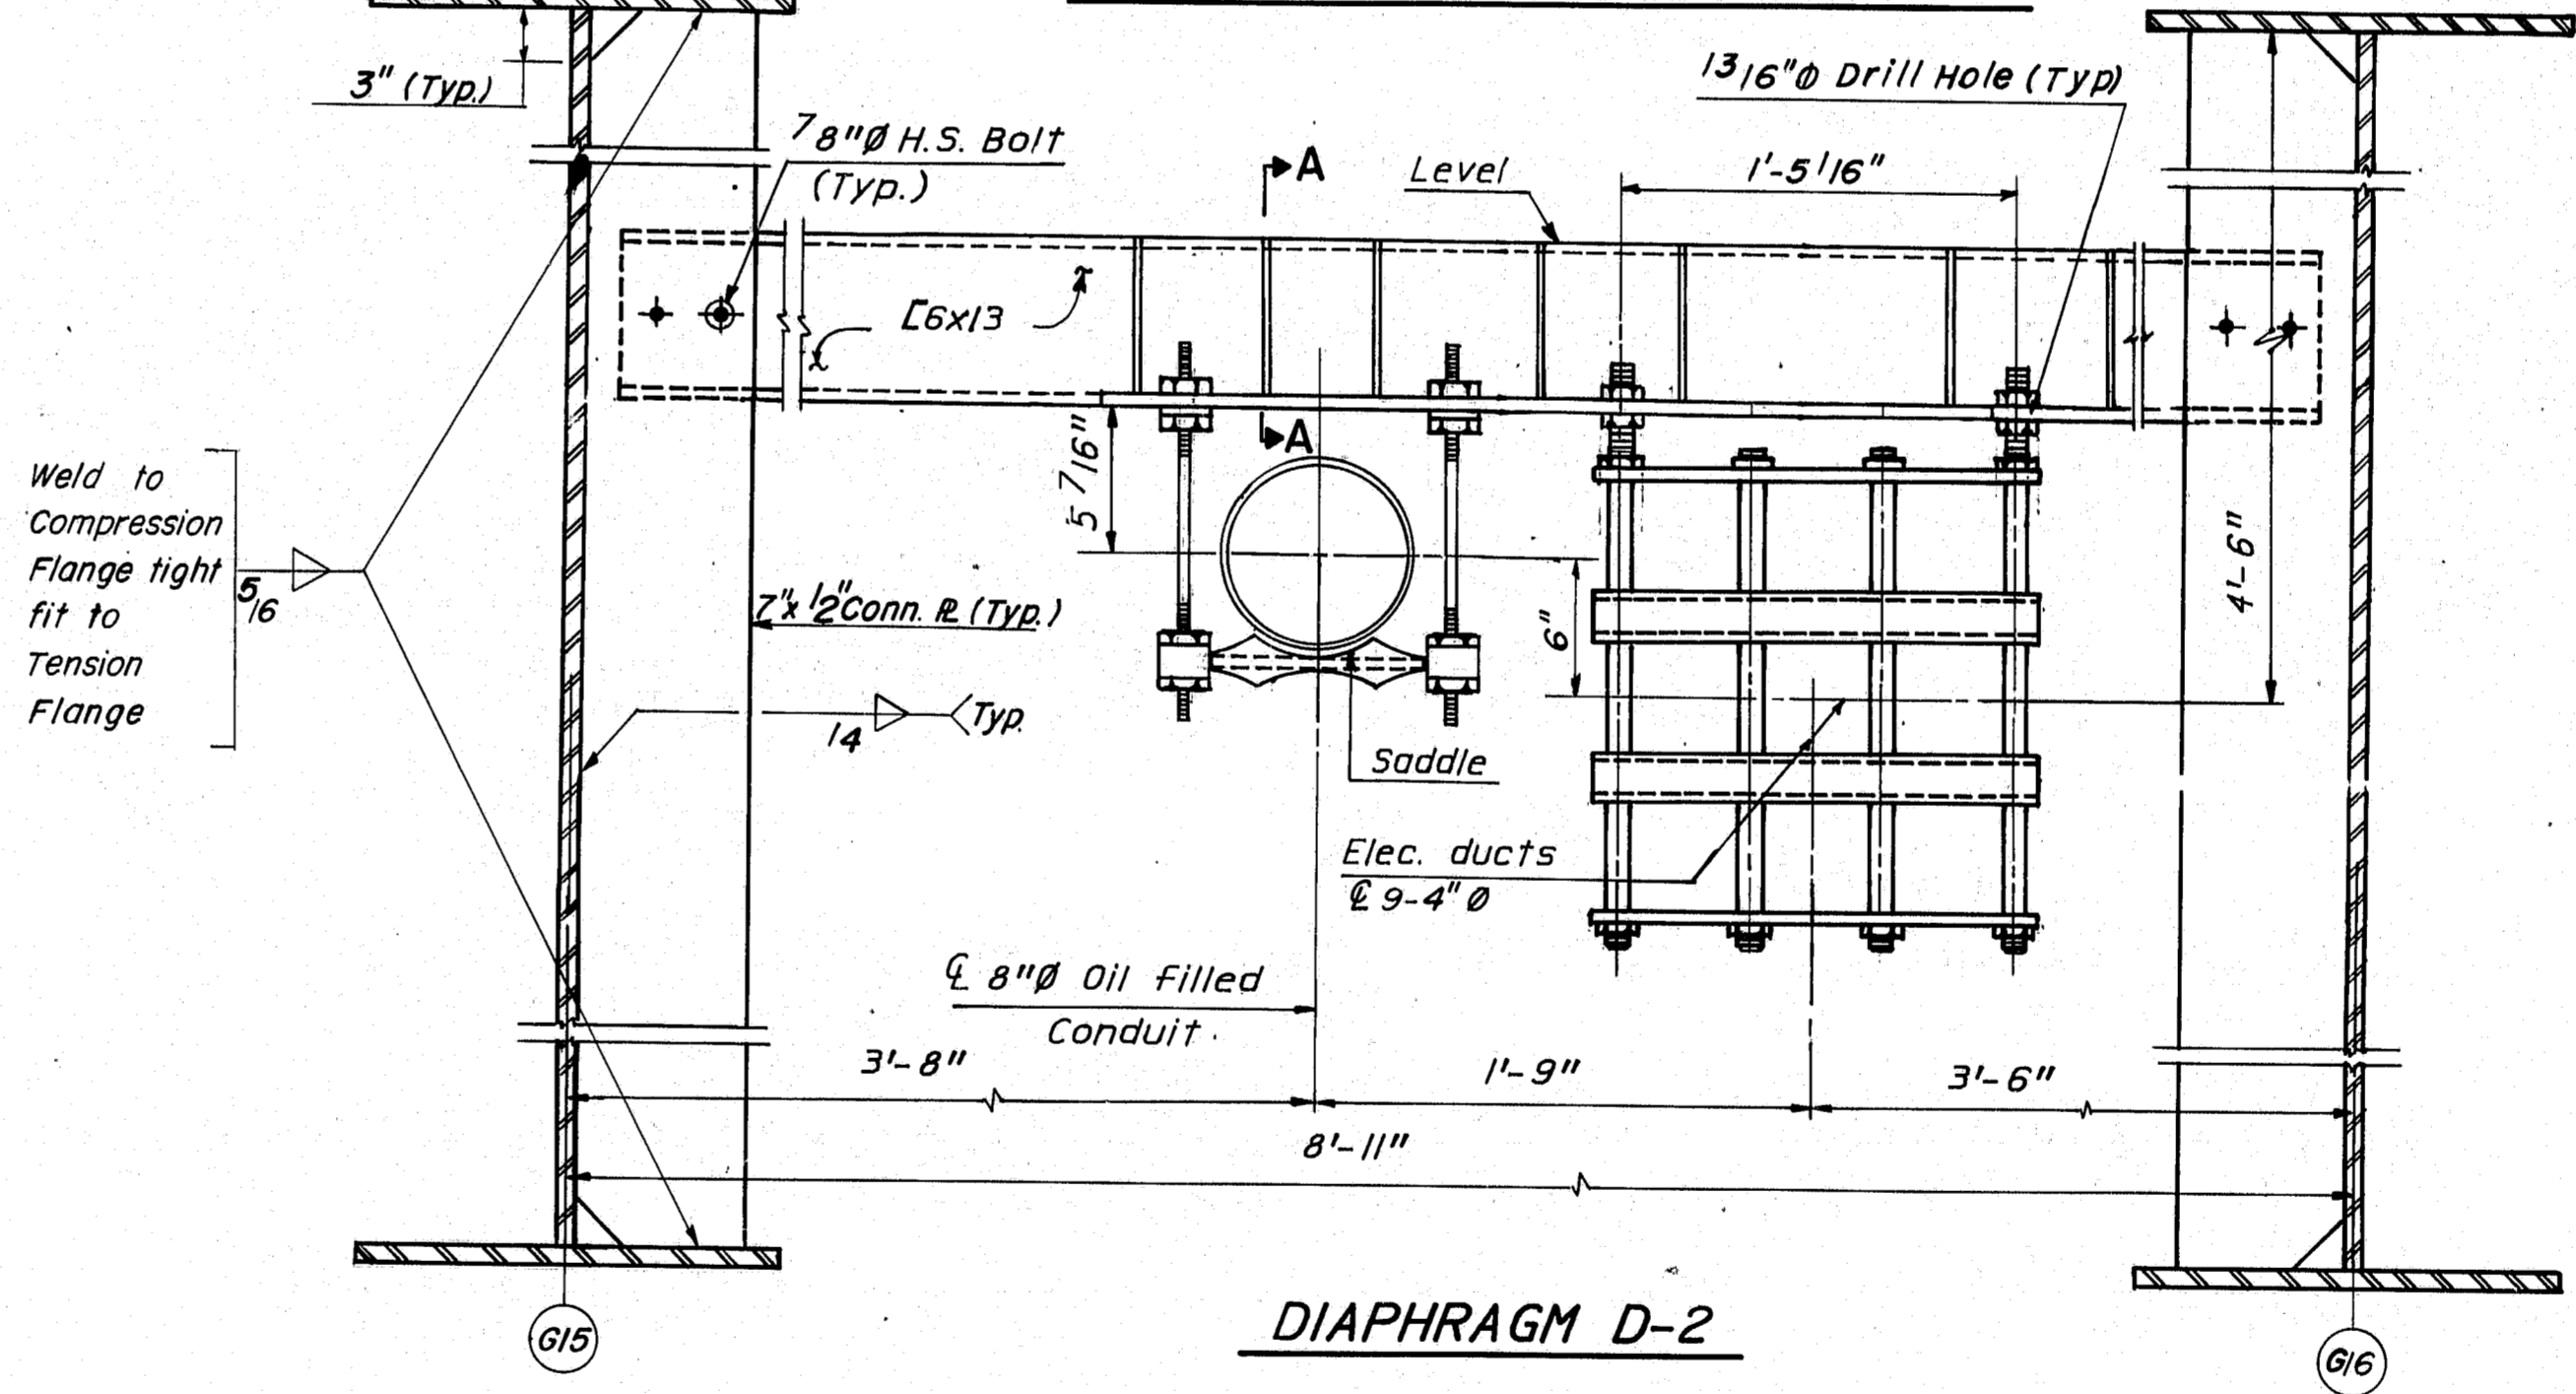

DIAPHRAGM D-2

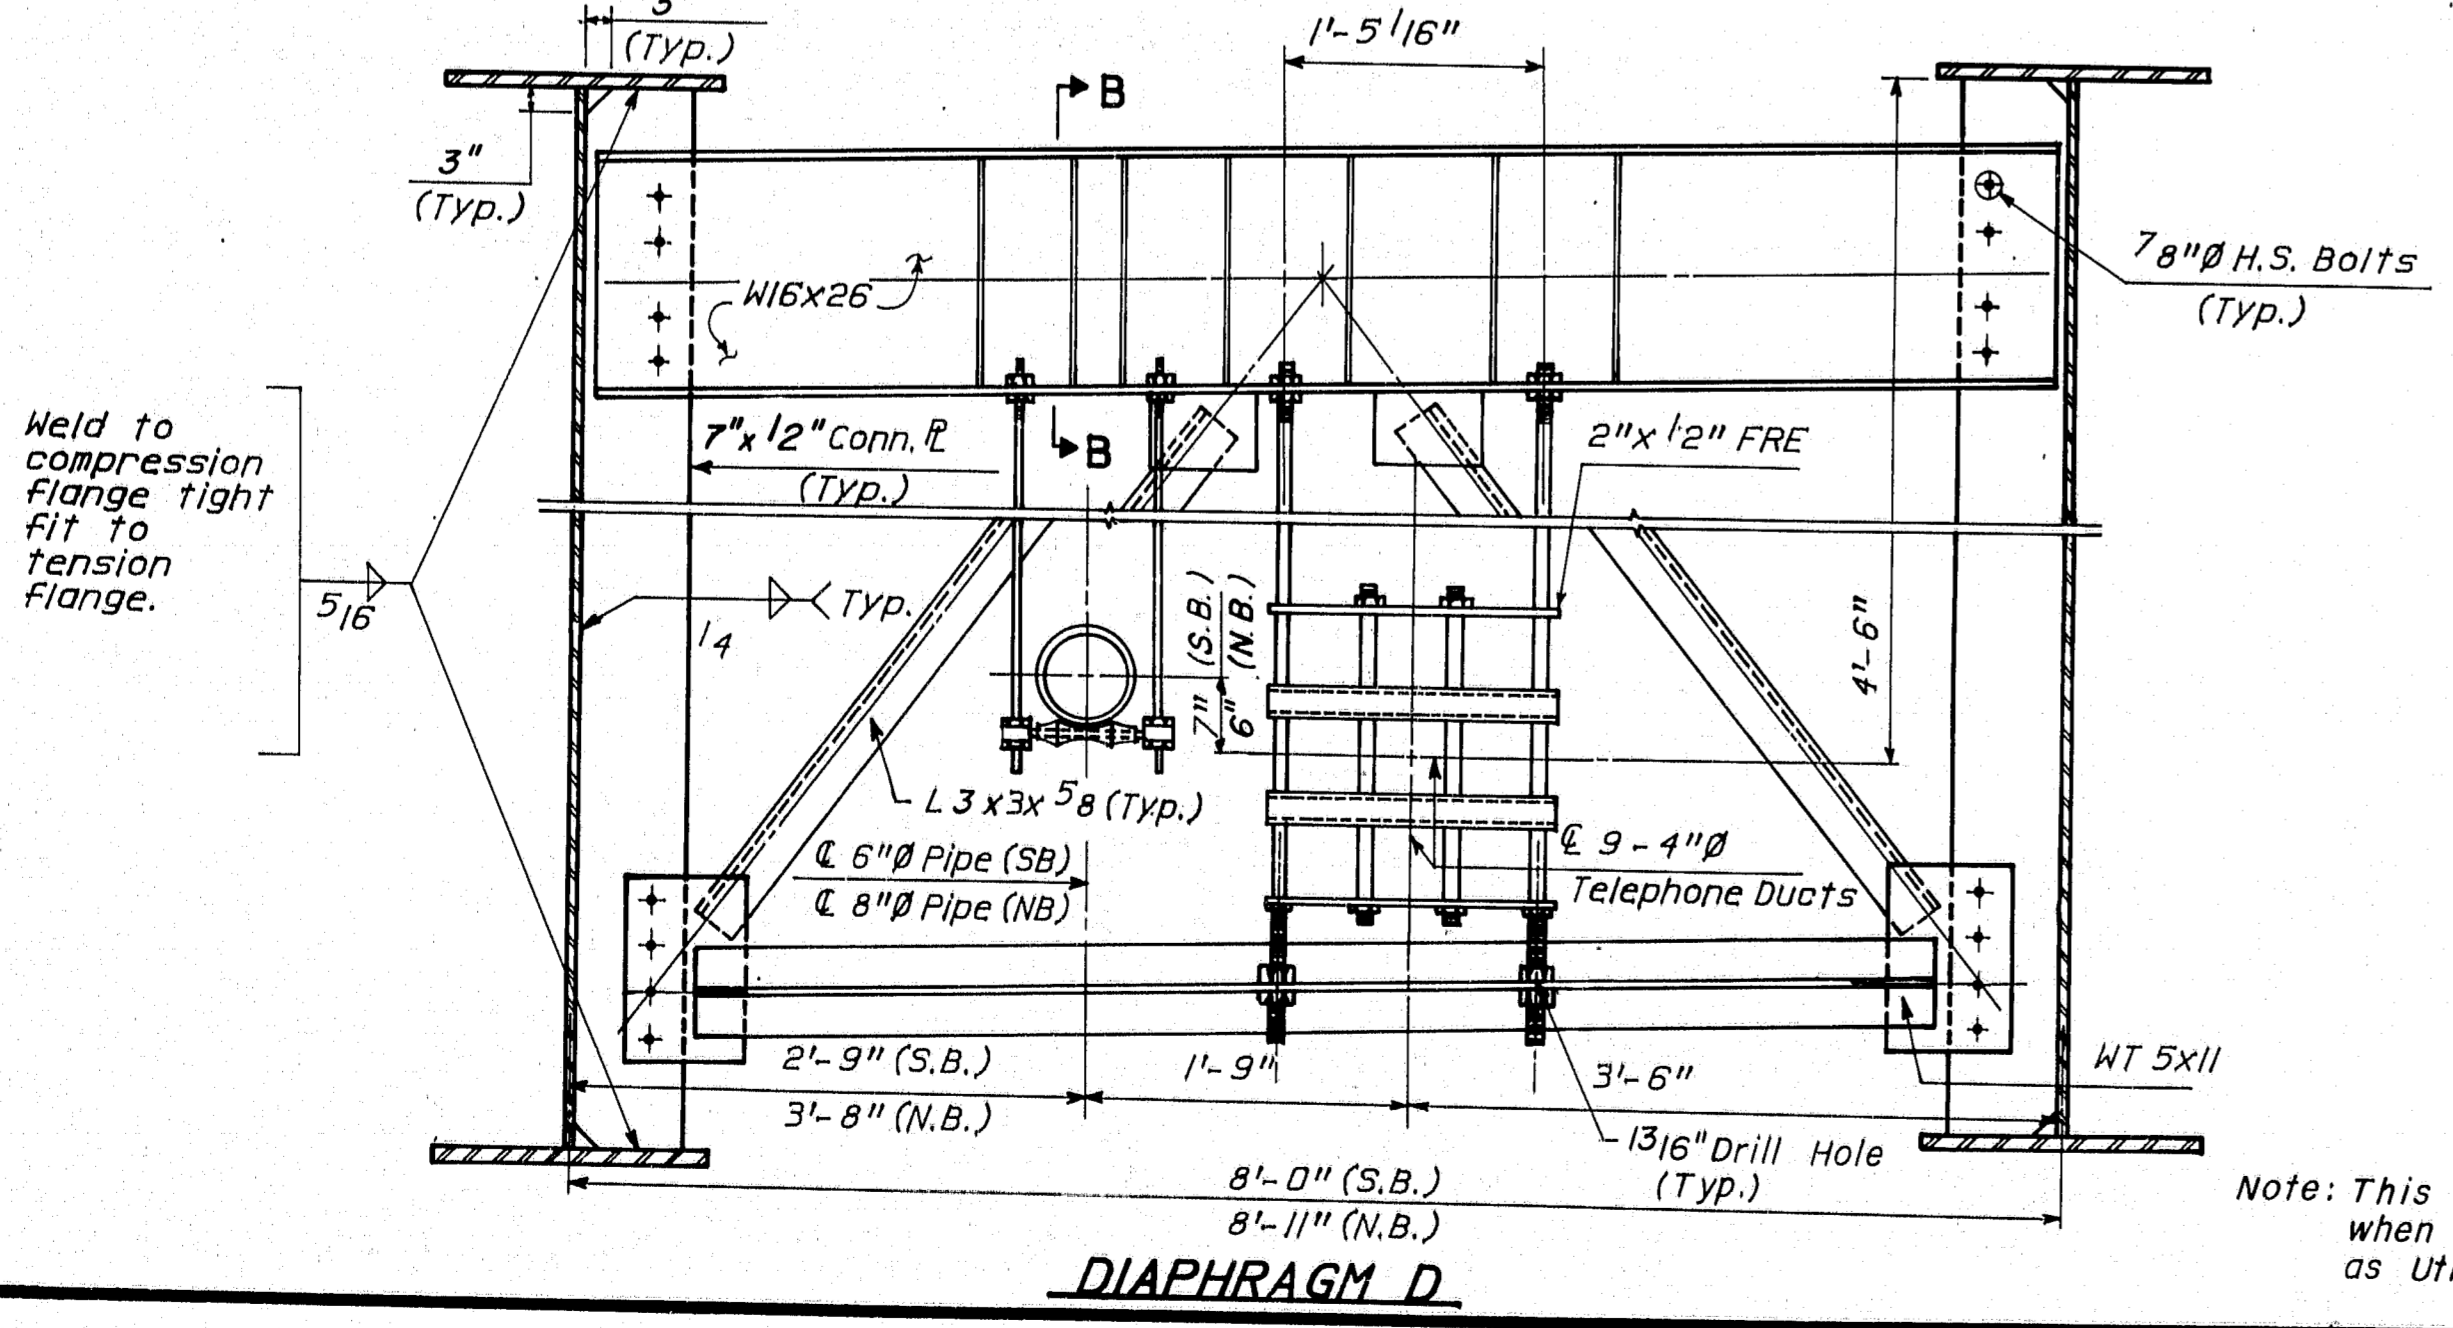

DIAPHRAGM D


Note: This Detail applies only when diaphragm D is used as utility hanger.

NOTES

- All conduits, pipe, expansion joints, adapters, sleeves, shall be furnished & installed by respective utility companies.
- Hanger details shown are designed for the following Dead Loads:
 8" Oil filled conduit = 70 lb./ft.
 9-4" Elec. ducts = 55 lb./ft.
 9-4" Tel. ducts = 150 lb./ft.
 6" Gas pipe = 25 lb./ft.

REFERENCE

For location of Utility supports, see Sheet No. 14

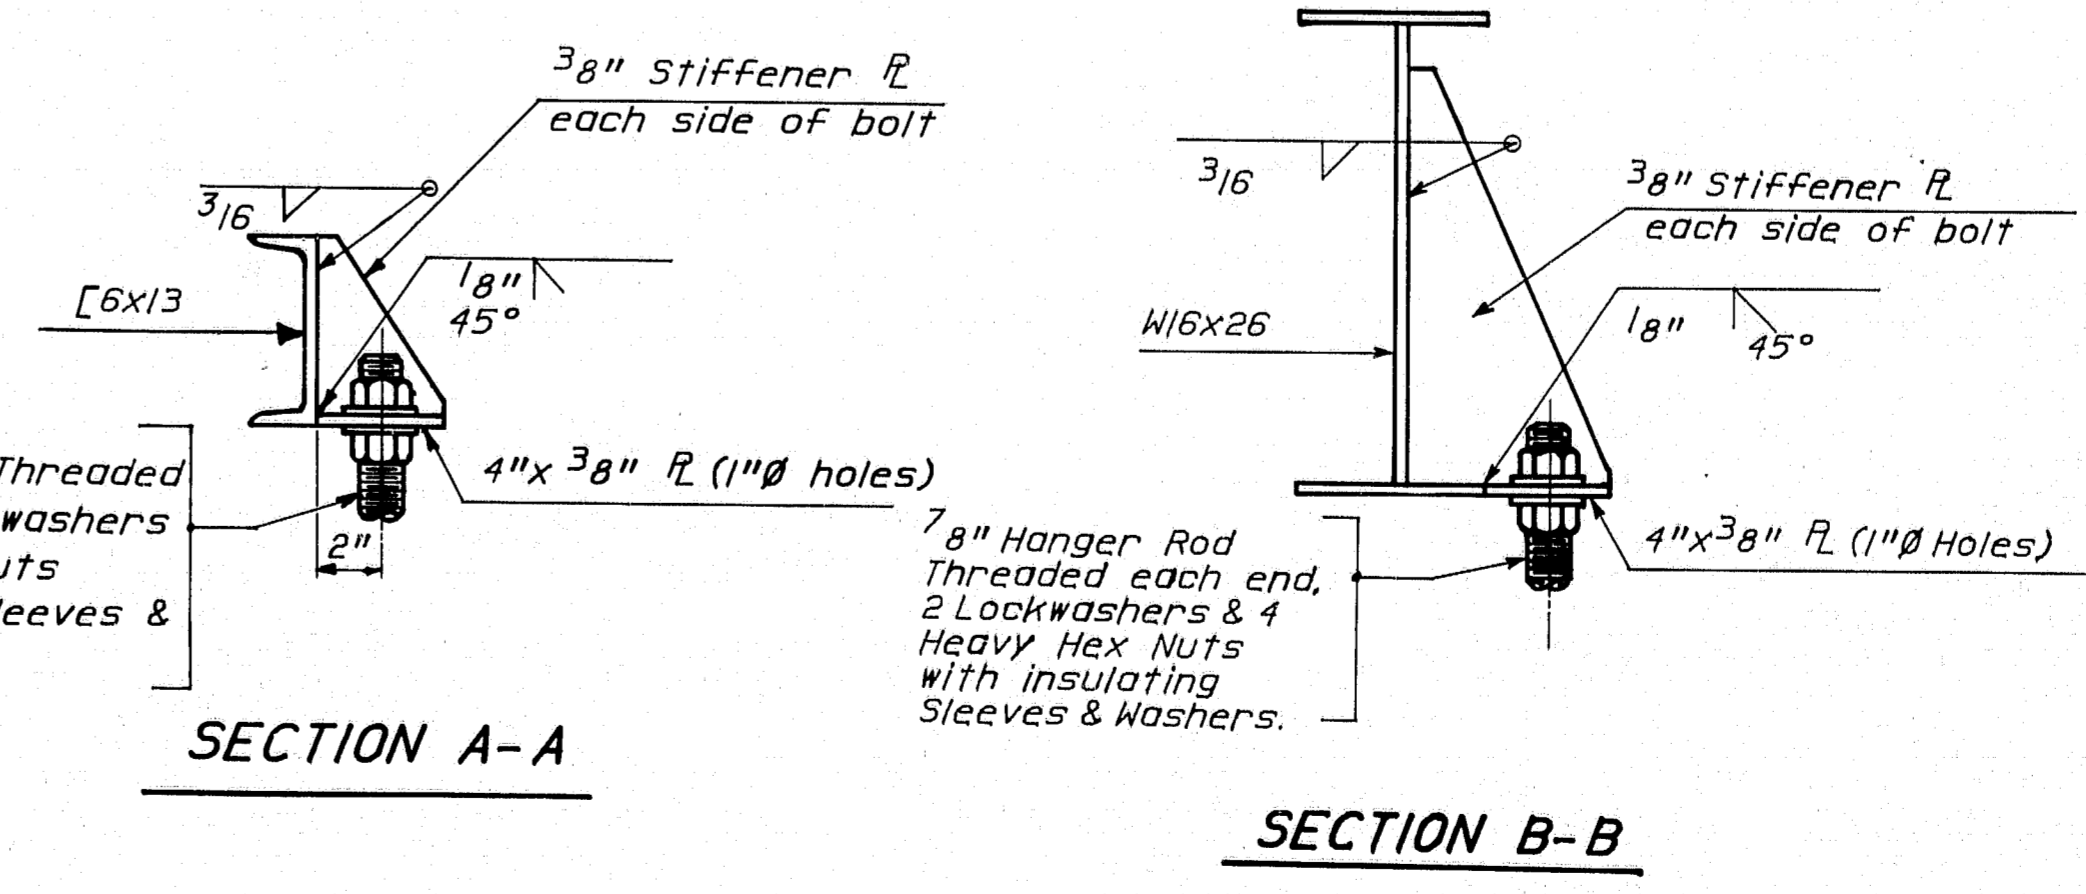

SECTION A-A

SECTION B-B

PROJECT ENGINEER	DATE
DESIGN - DETAILED	2/85
CHECKED	
REVISIONS	
FIELD CHANGES	


103-281

STATE OF MAINE
DEPARTMENT OF TRANSPORTATION


1-295 INTERCHANGE COMPLEX
TUKEYS BRIDGE
OVER
BACK COVE
IN THE TOWN OF
PORTLAND
CUMBERLAND COUNTY
UTILITY SUPPORT DETAILS

SHEET 16 OF 35 AUGUSTA, MAINE

F.W.A. REG. NO.	STATE	PROJECT NUMBER	SHEET NO.	TOTAL SHEETS
1	MAINE	R-295-3(94)50	21	120


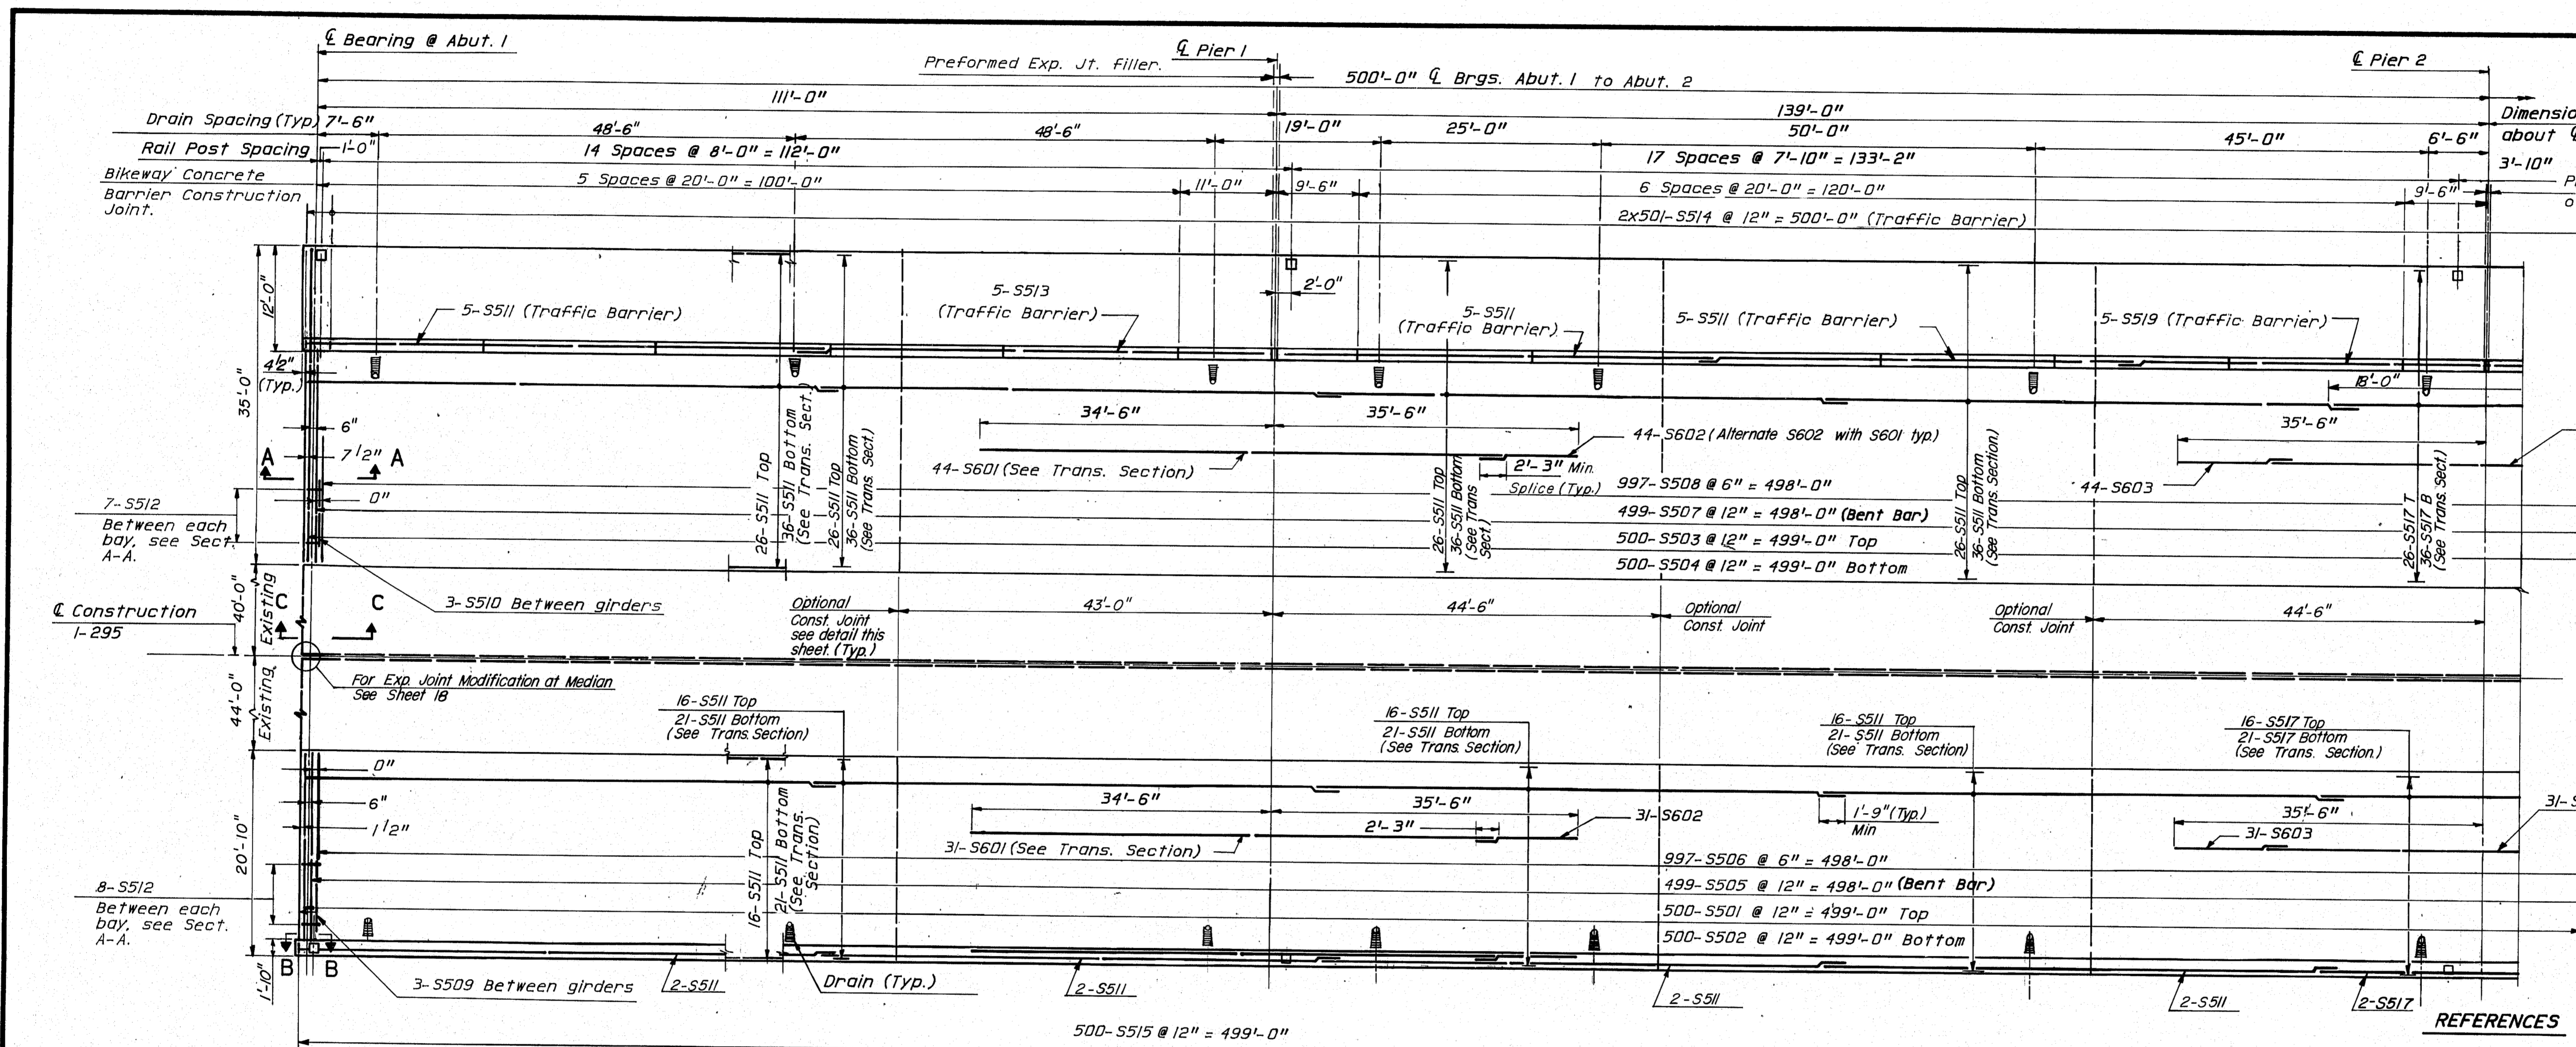


NOTE: The armored joints for the expansion devices may have a butt joint per unit as determined by the contractor to facilitate placement. The gland seal shall be one continuous piece per unit installed after the complete installation of the joint armor.

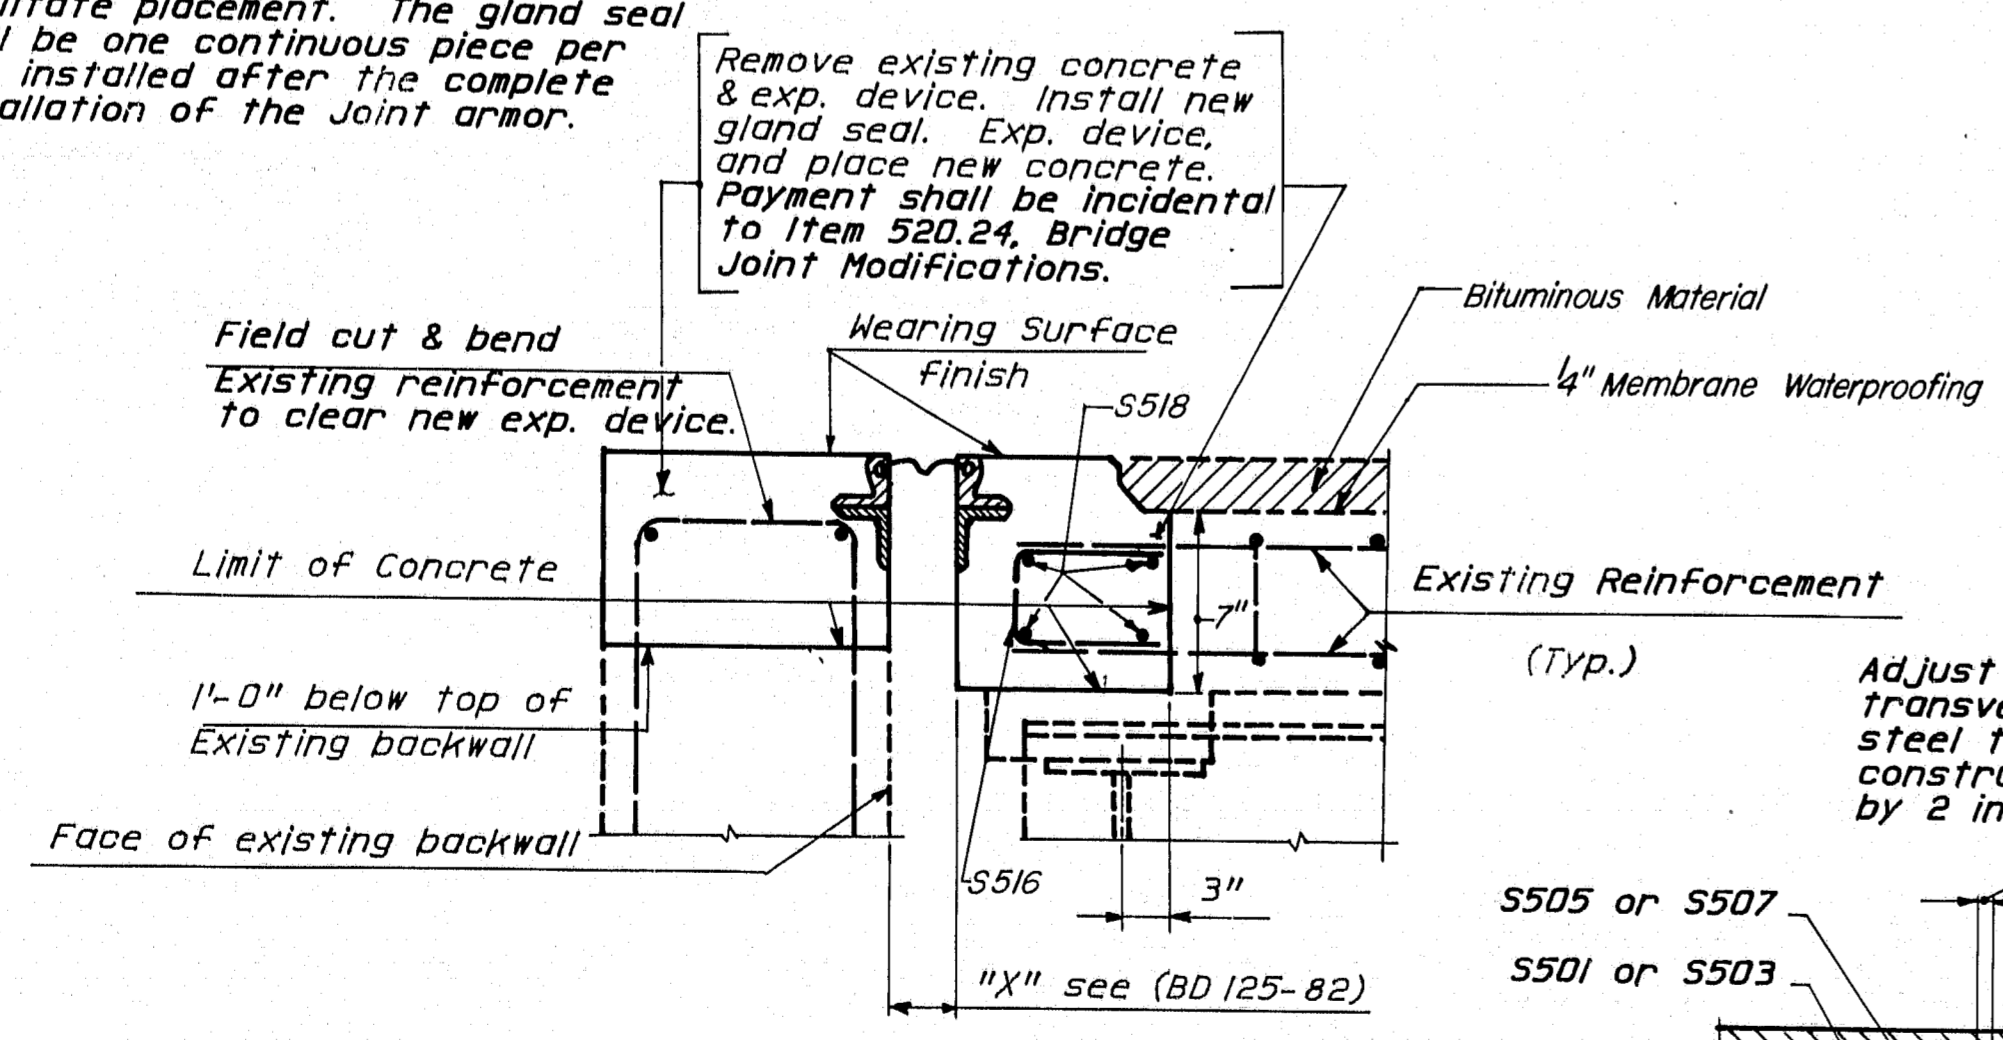

NOTE: For Exp. Device Detail, see (BD 125-82).

SLAB PLAN

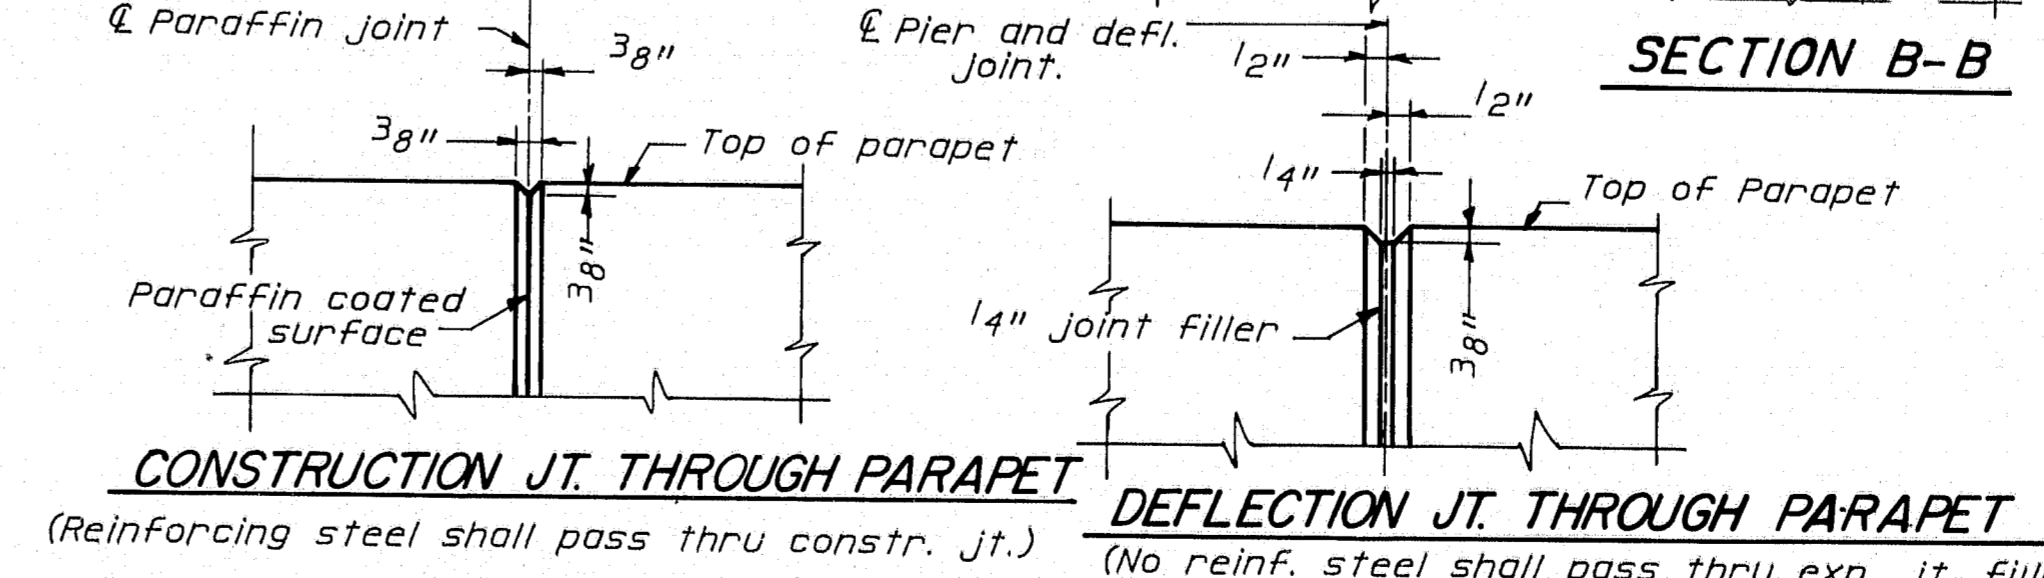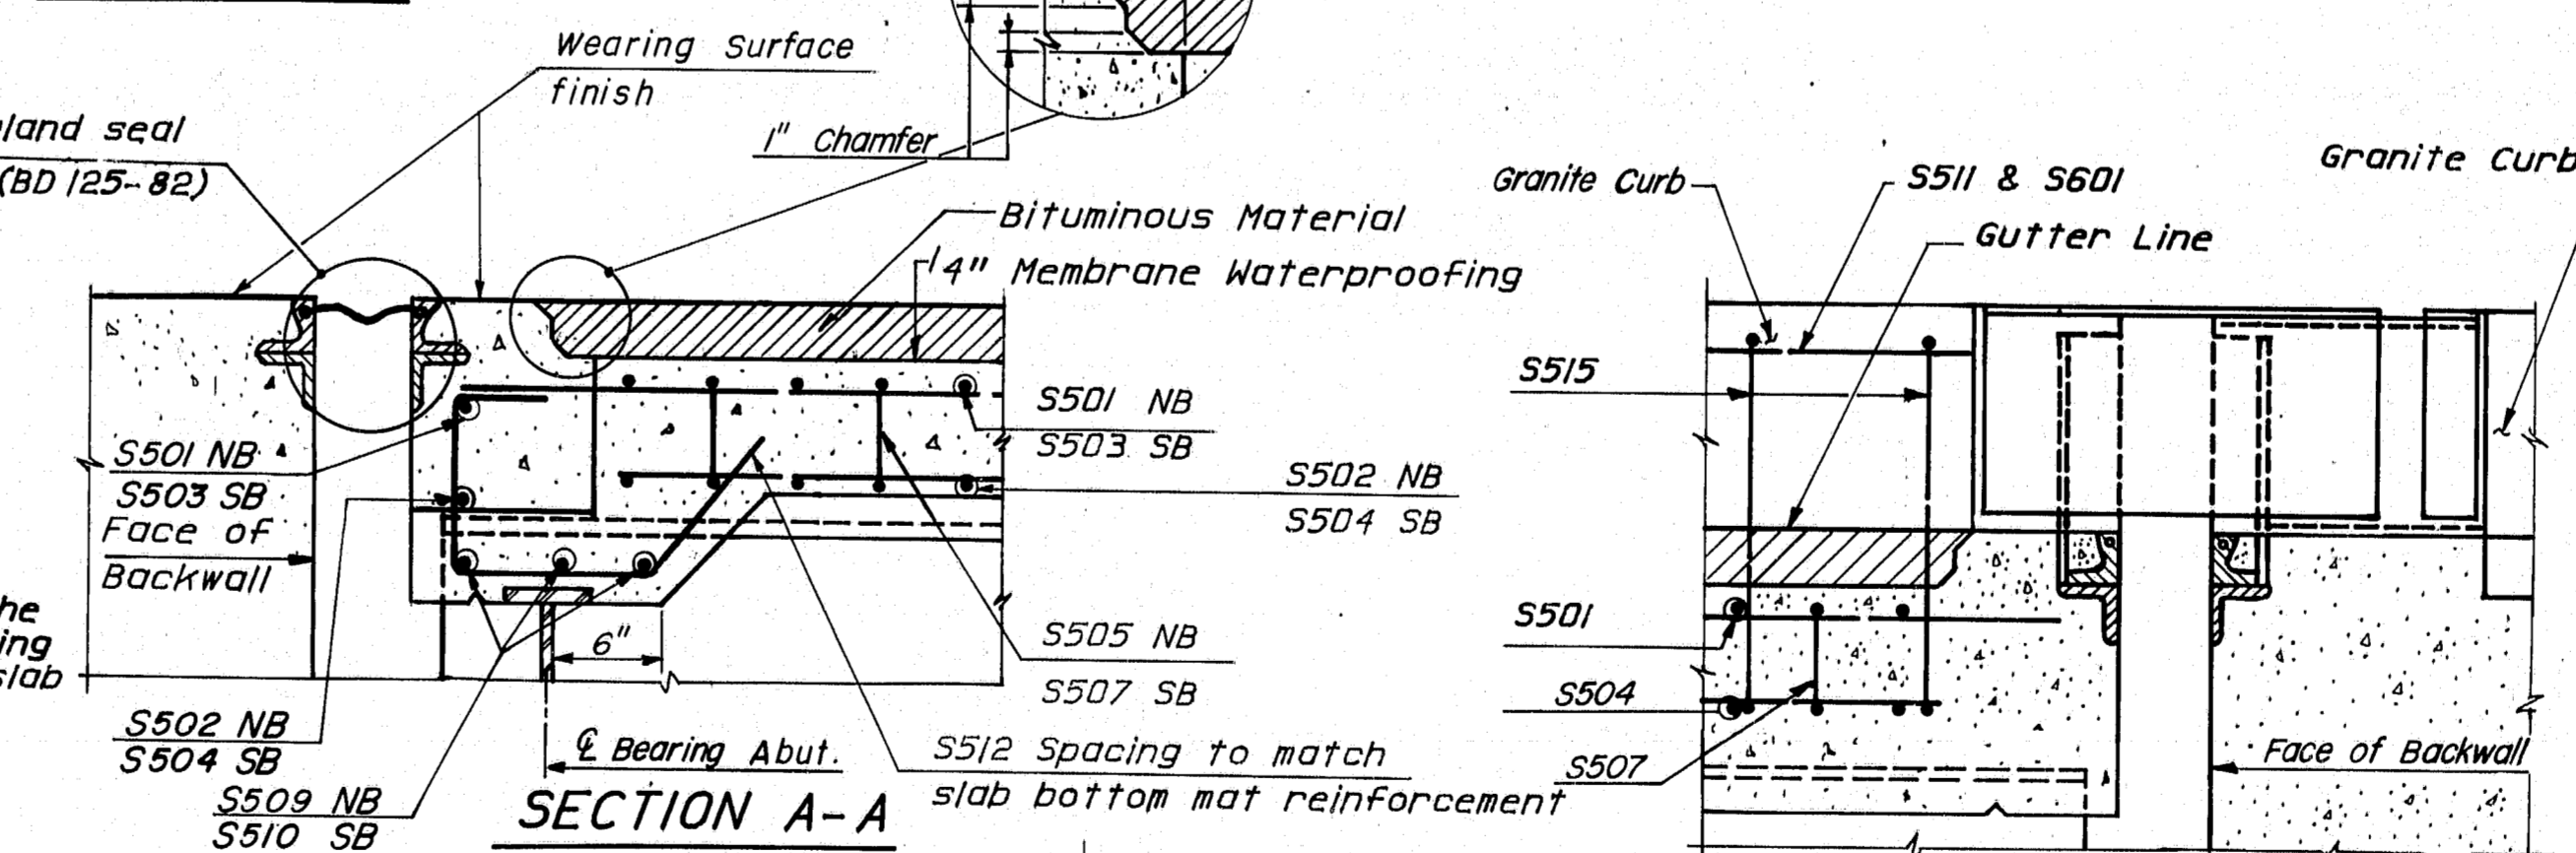

NOTE: Parapet shall be poured in alternate sections and shall have a curing period of 14 days between pours.

NOTE: Unless the superstructure slab concrete is placed in one continuous operation, the initial placement shall start at a simply supported end of the deck slab and shall terminate at the completion of a positive moment section. Successive placements shall proceed from the end of the previous placement, terminate at the completion of a positive moment section, and include two or more spans. The placement sequence of the superstructure slab concrete shall be approved by the Engineer. Concrete in a placement shall be kept plastic one complete span behind the span being placed. A minimum of five days shall elapse between successive partial placements.

103-282

STATE OF MAINE
DEPARTMENT OF TRANSPORTATION


1-295 INTERCHANGE COMPLEX
TUKEYS BRIDGE
OVER
BACK COVE
IN THE TOWN OF
PORTLAND
CUMBERLAND COUNTY

SLAB PLAN
SHEET 17 OF 35 AUGUSTA, MAINE

PROJECT ENGINEER	DATE
DESIGN DETAIL	4/1/85
CHECKED	4/1/85
REVISIONS	2-85
FIELD CHANGES	


BRUNING 44-132 6/7/81

F.W. No.	STATE	PROJECT NUMBER	SHEET NO.	TOTAL SHEETS
1	MAINE	103-284	22A	130

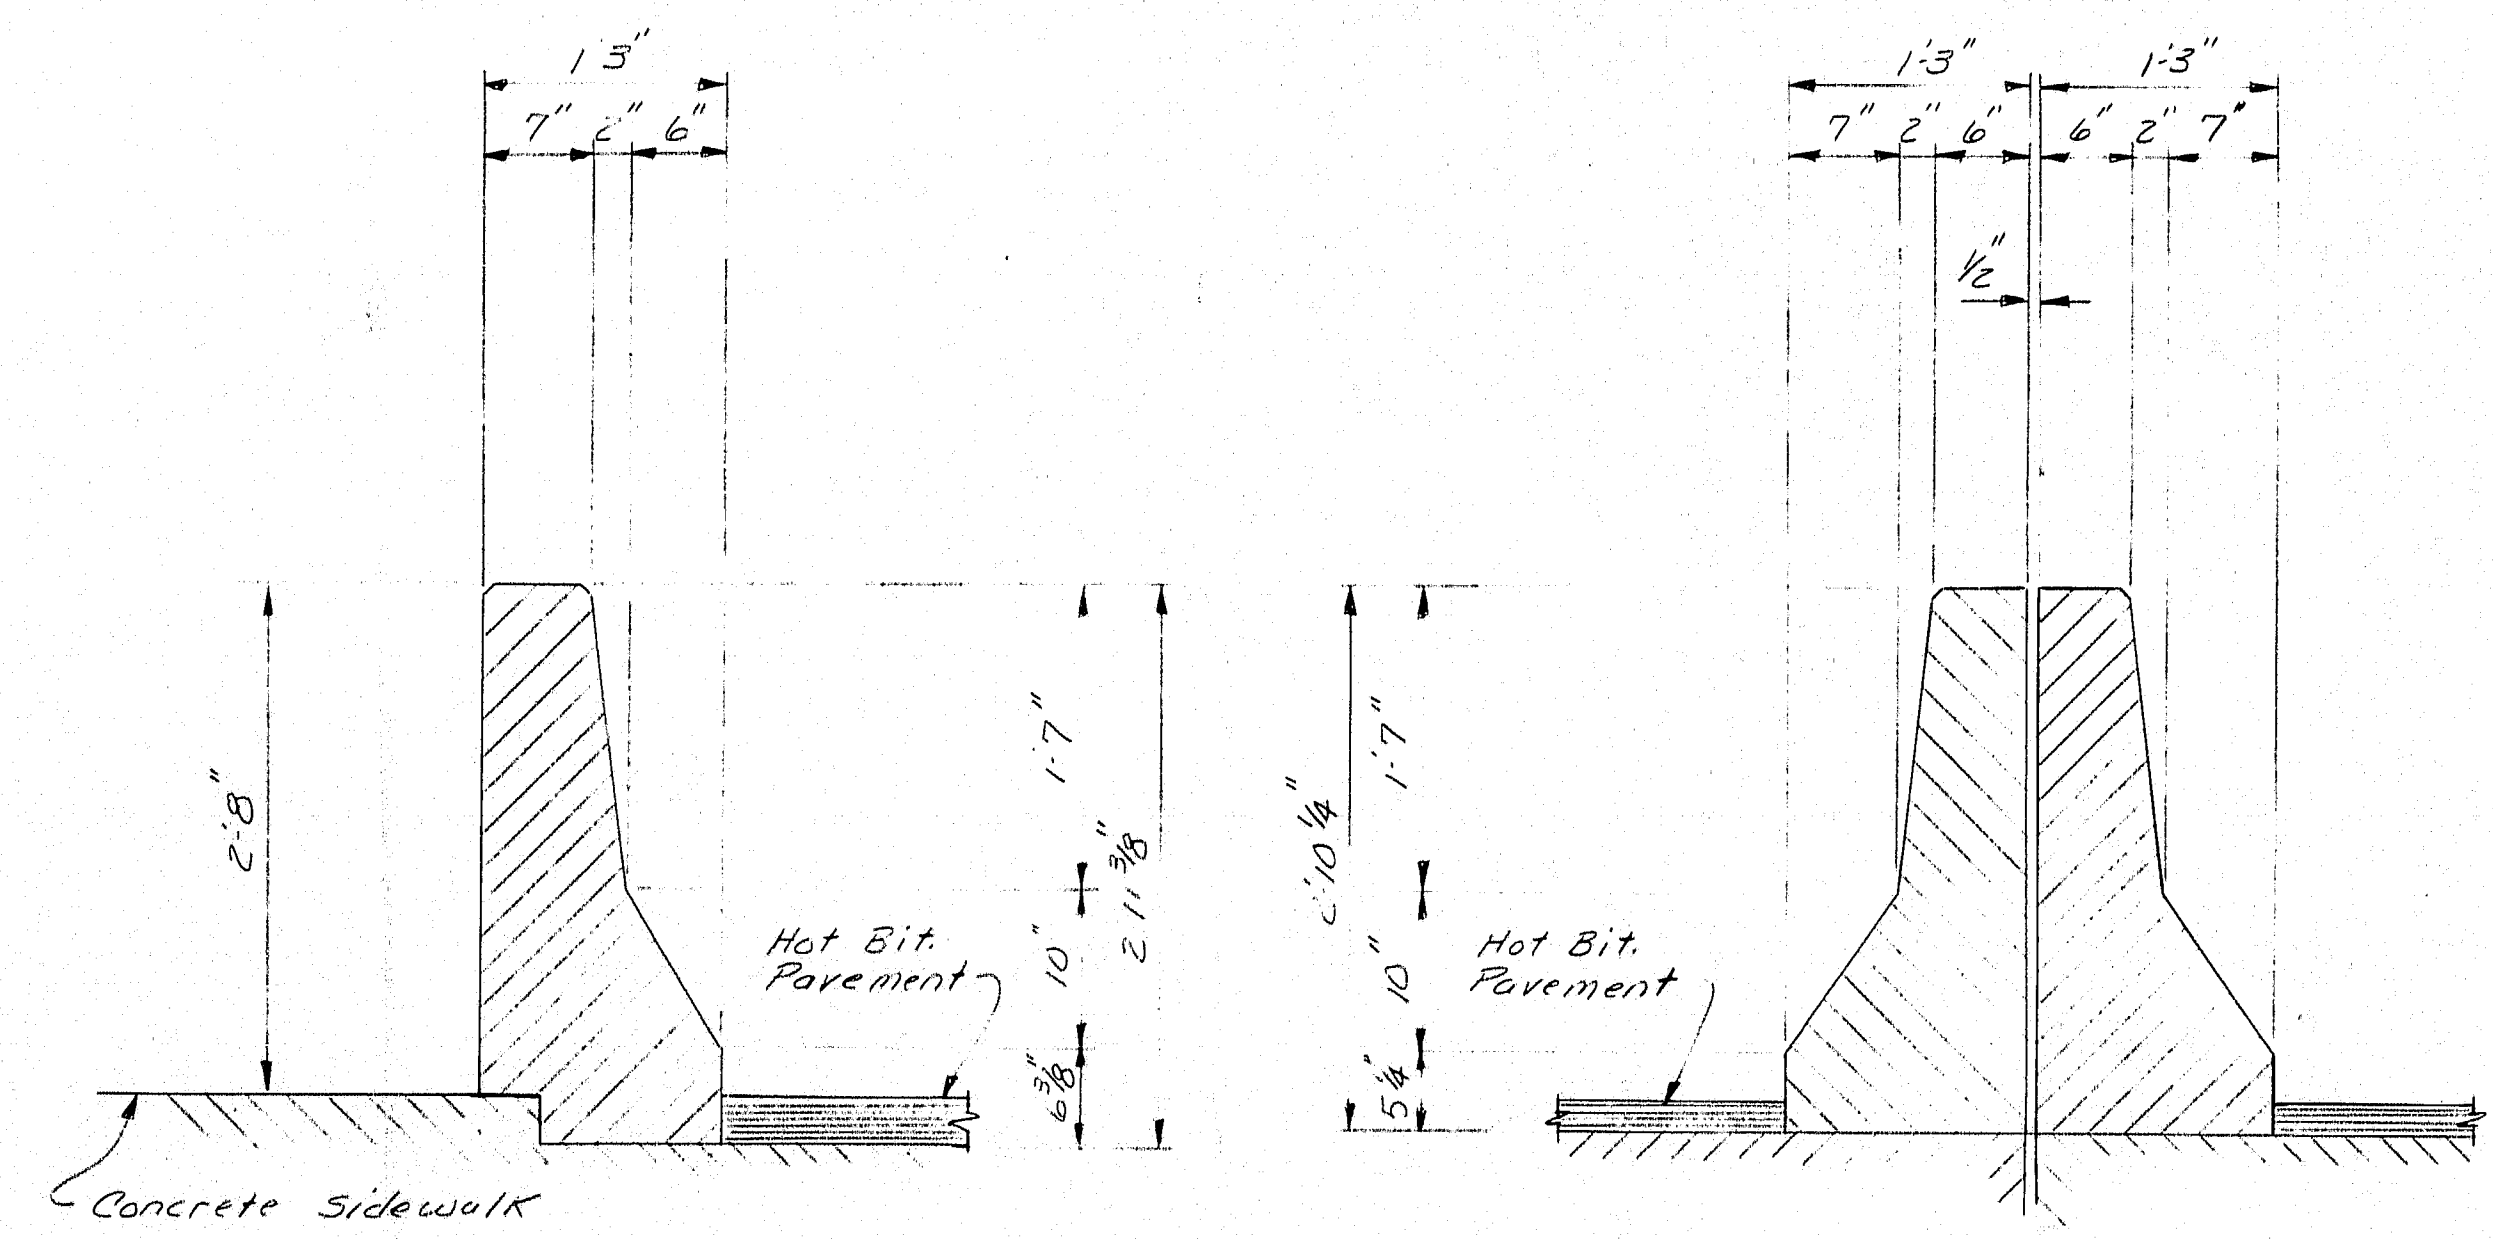


PEDESTRIAN BARRIER
(Concrete dimensions)


EXISTING MEDIAN BARRIER
(Concrete dimensions)

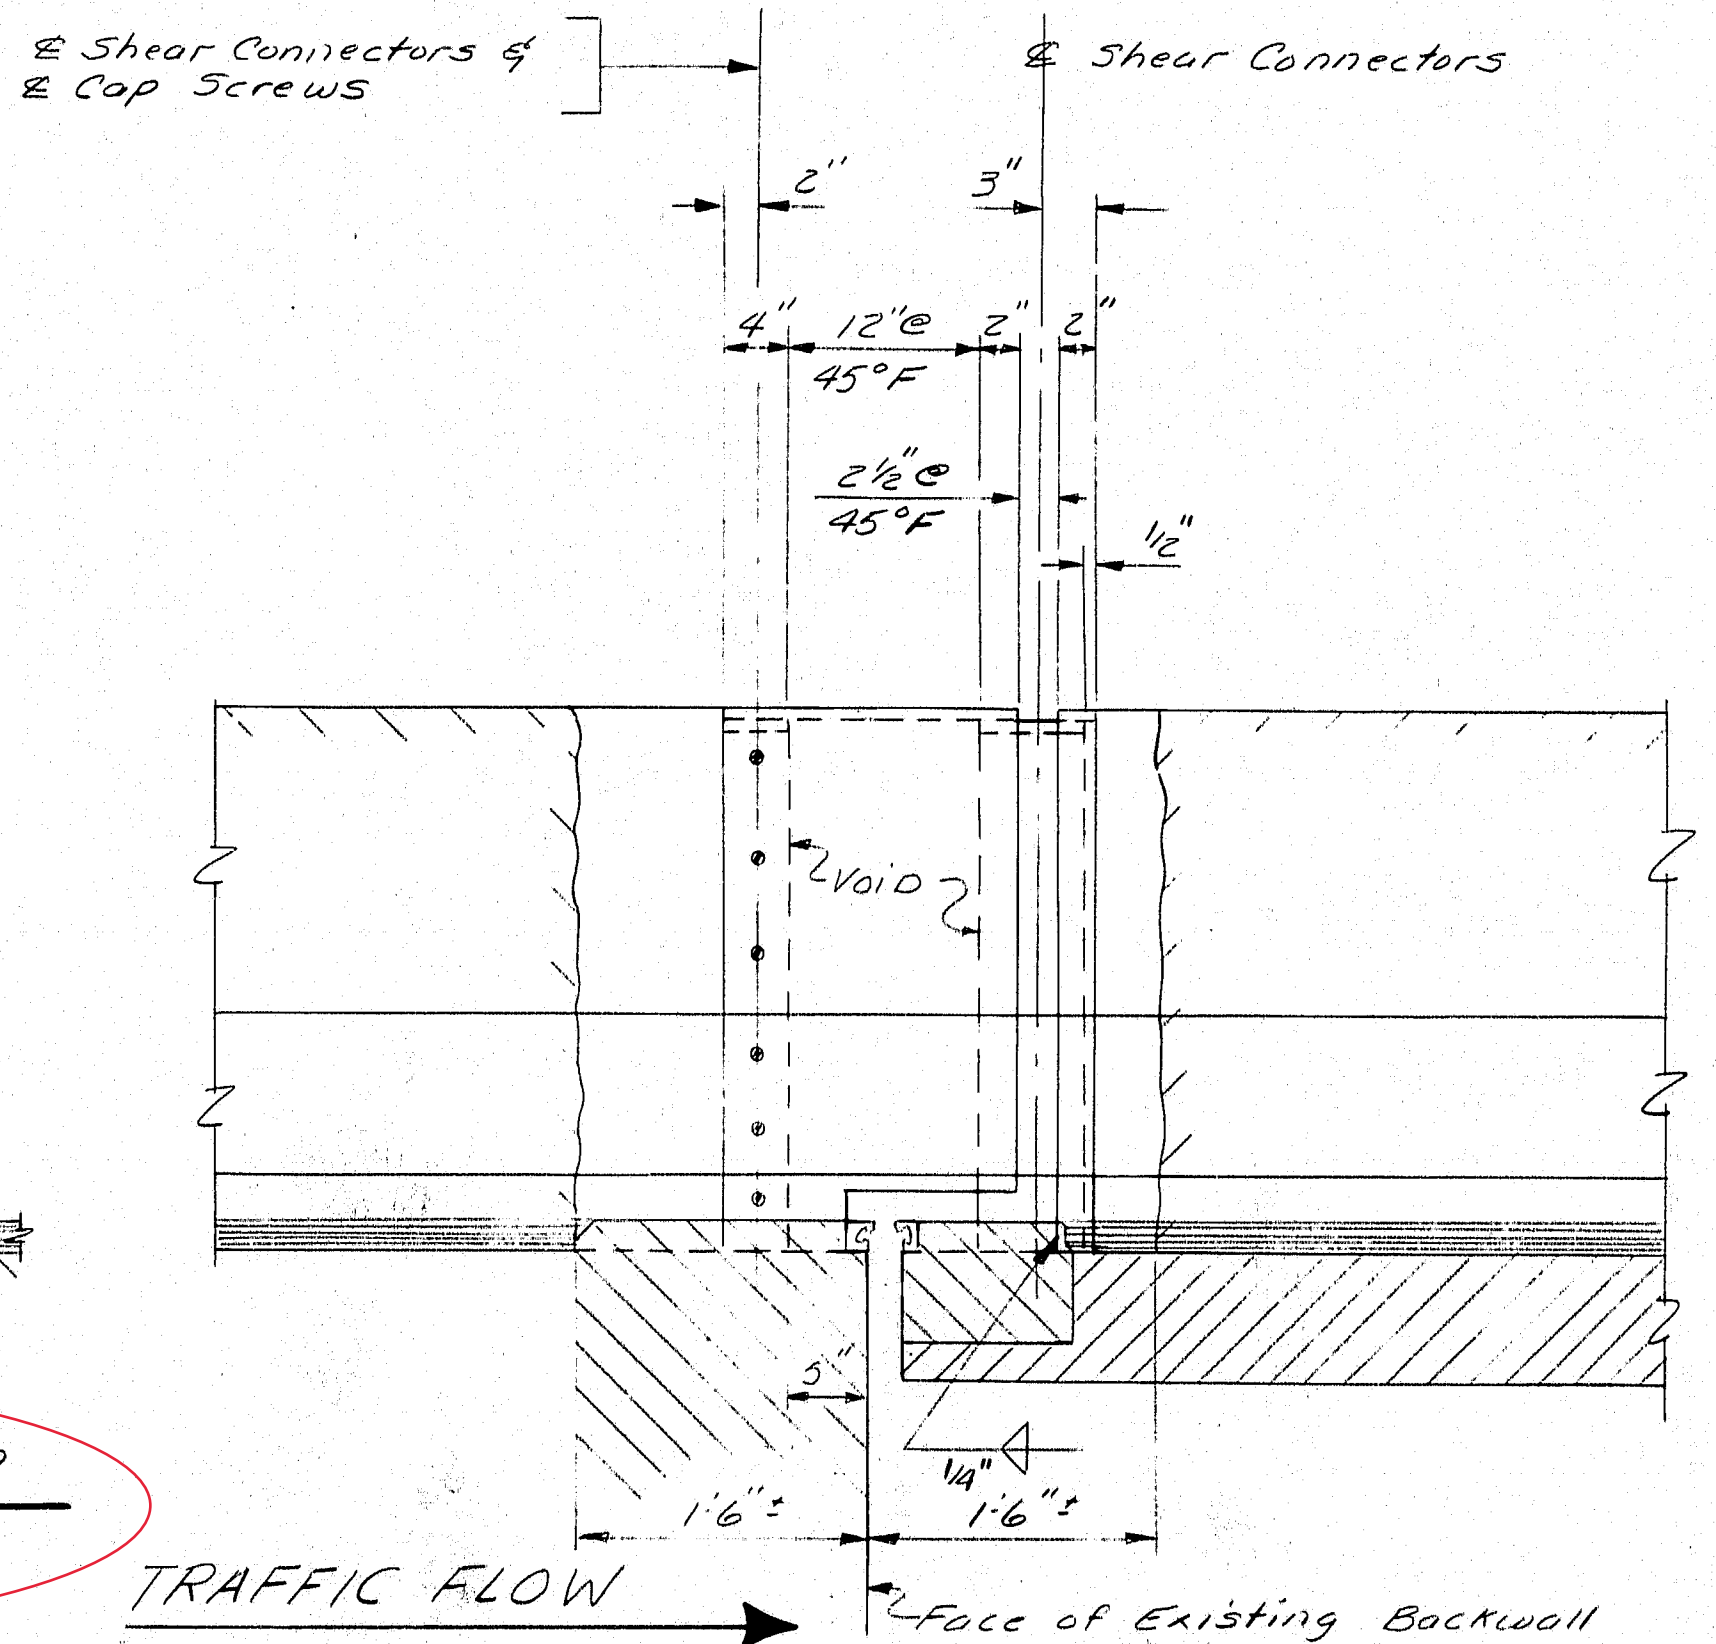

VIEW A-A
Median Barrier shown, rotate 180° for Pedestrian Barrier

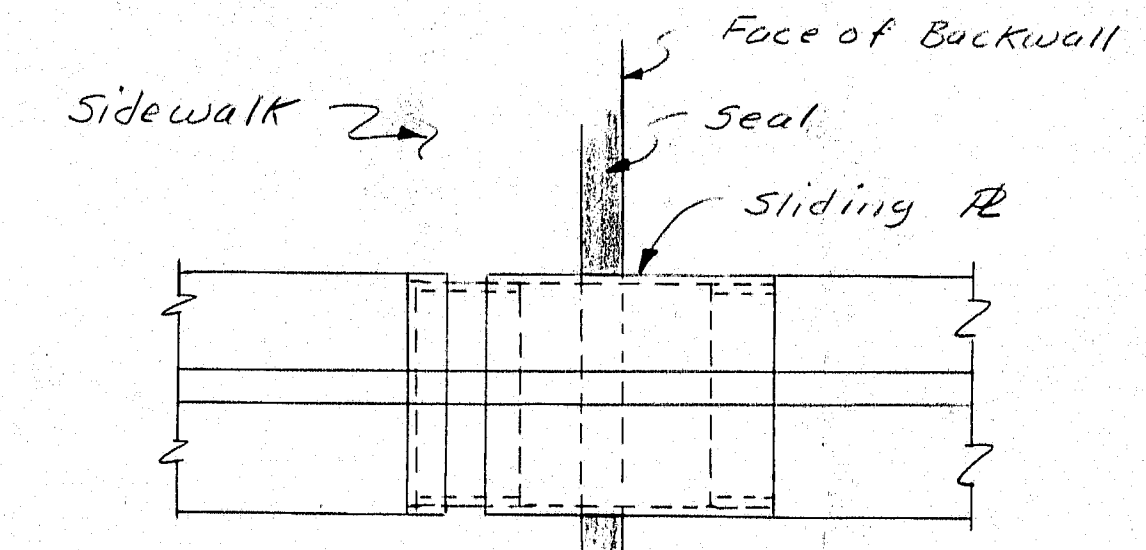


PLAN PEDESTRIAN BARRIER

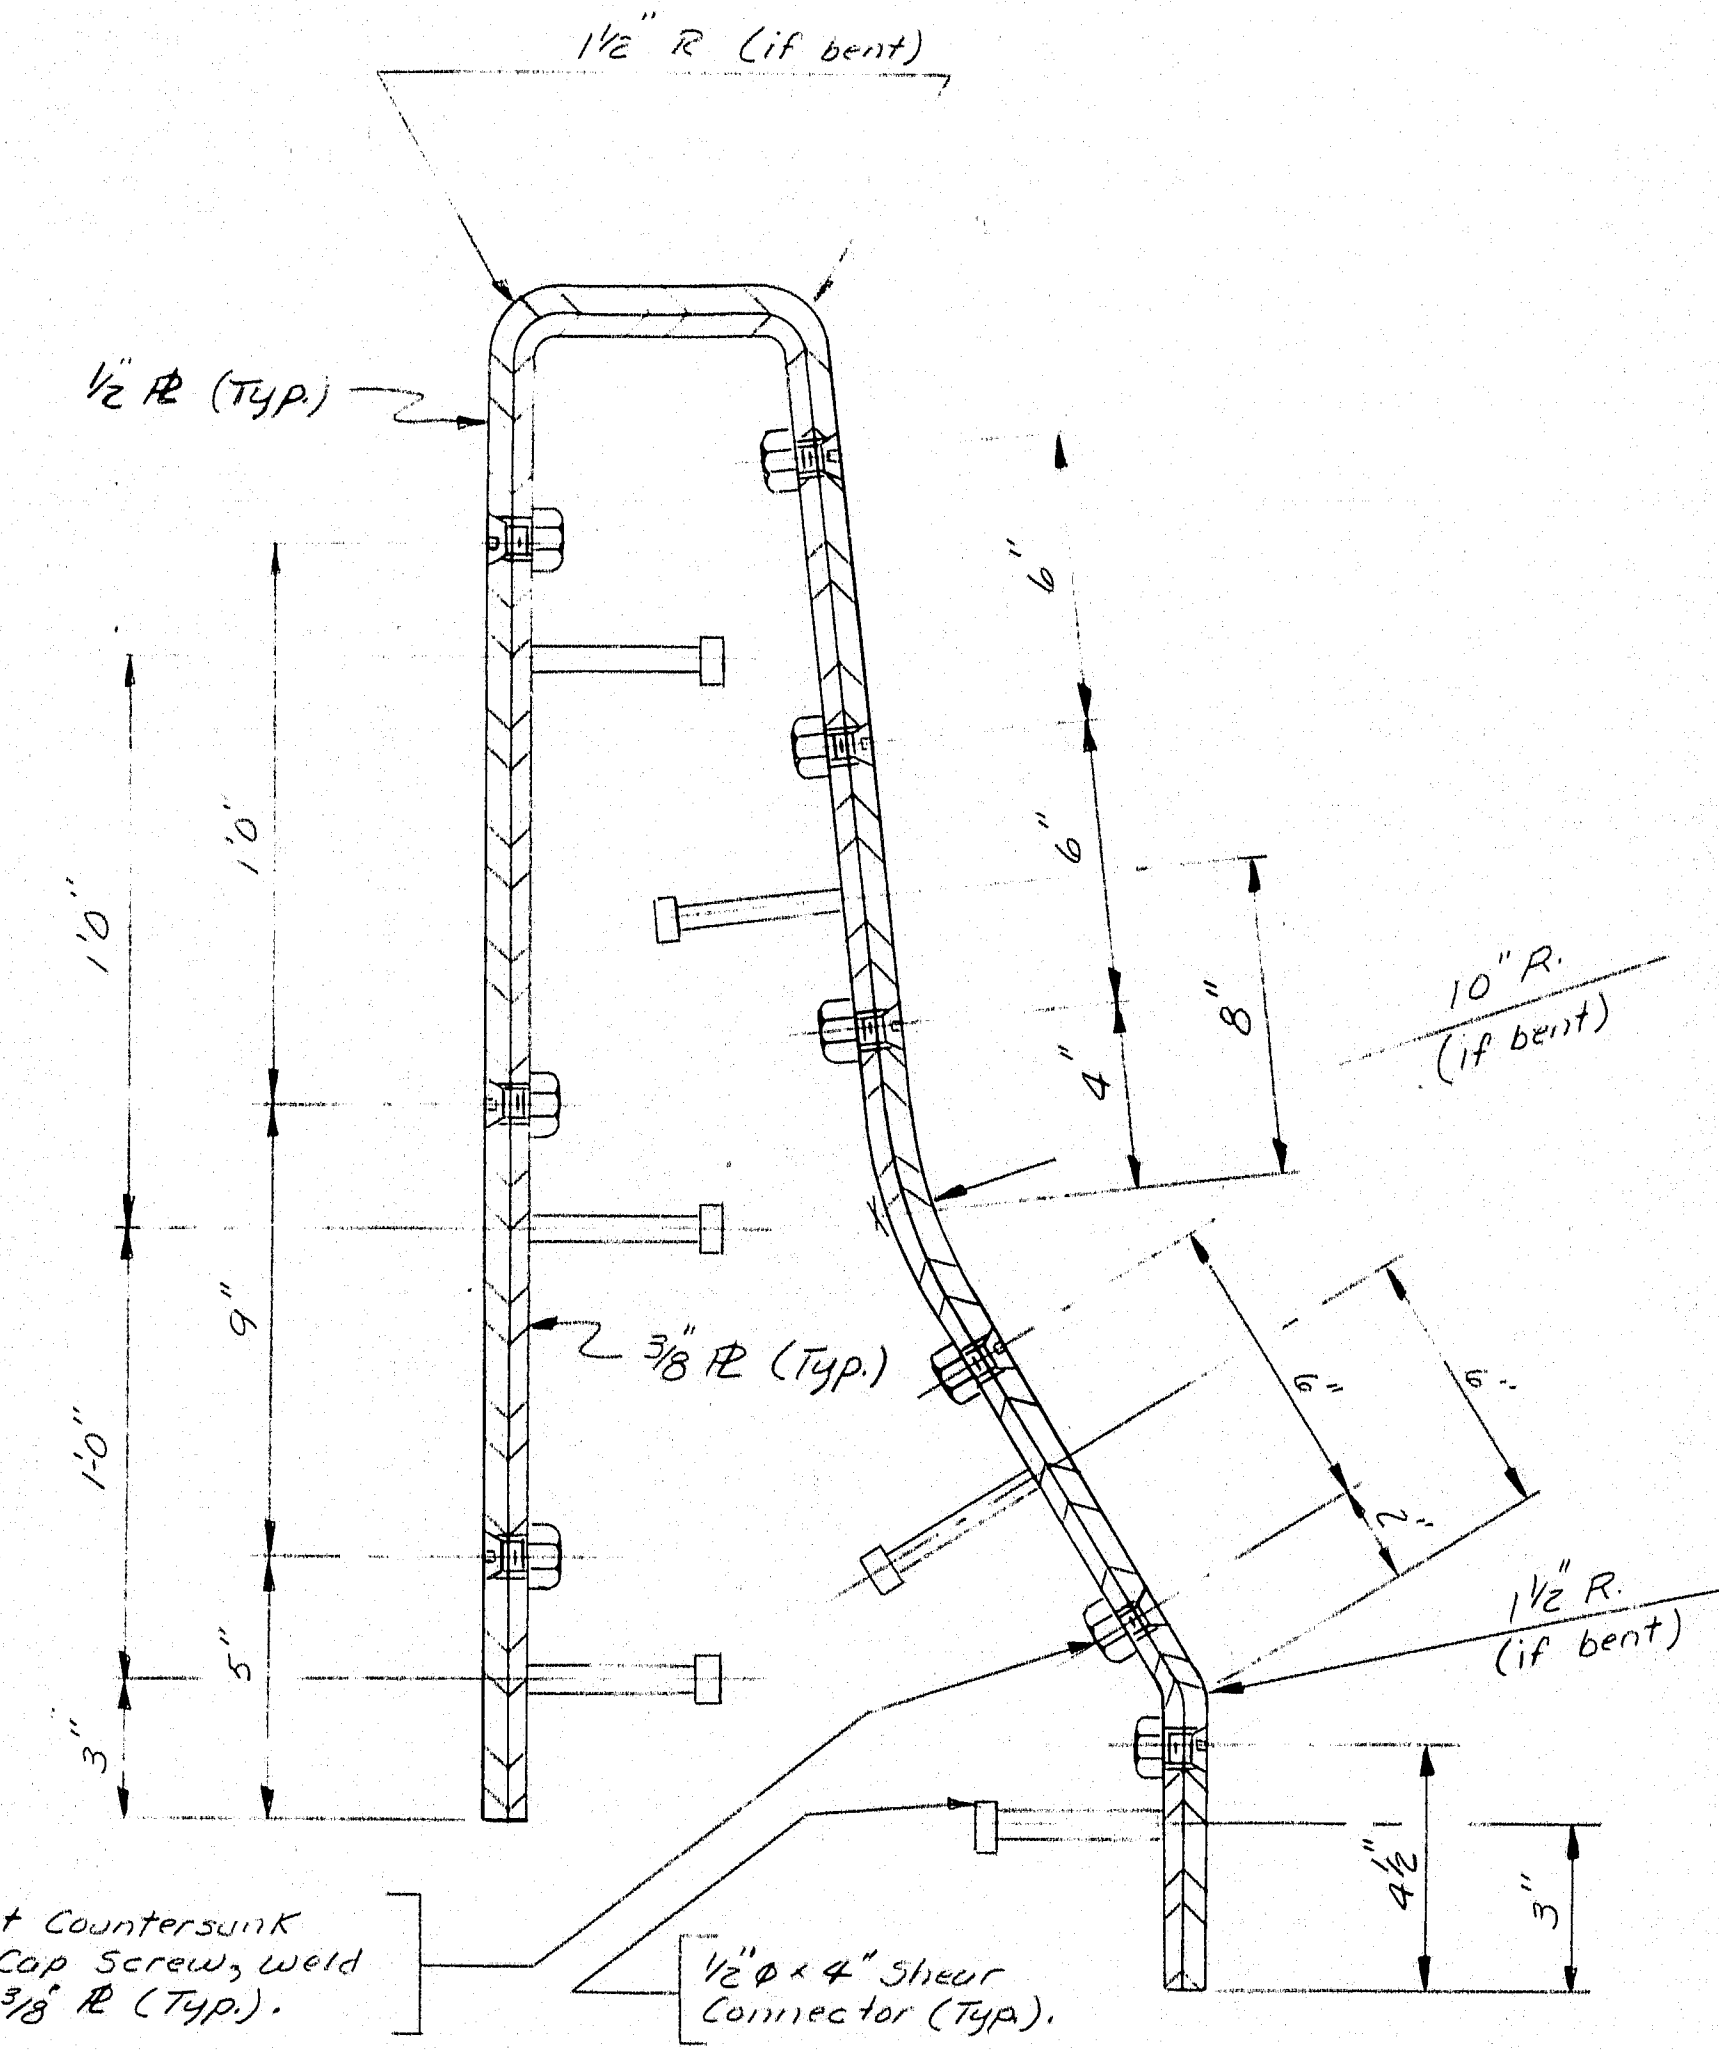

PEDESTRIAN BARRIER BENT R OPTION


NOTE:
Except as shown, outside dimensions shall conform to permanent concrete barrier shown above. Plates may be bent, welded or both. ASTM A36 Steel.

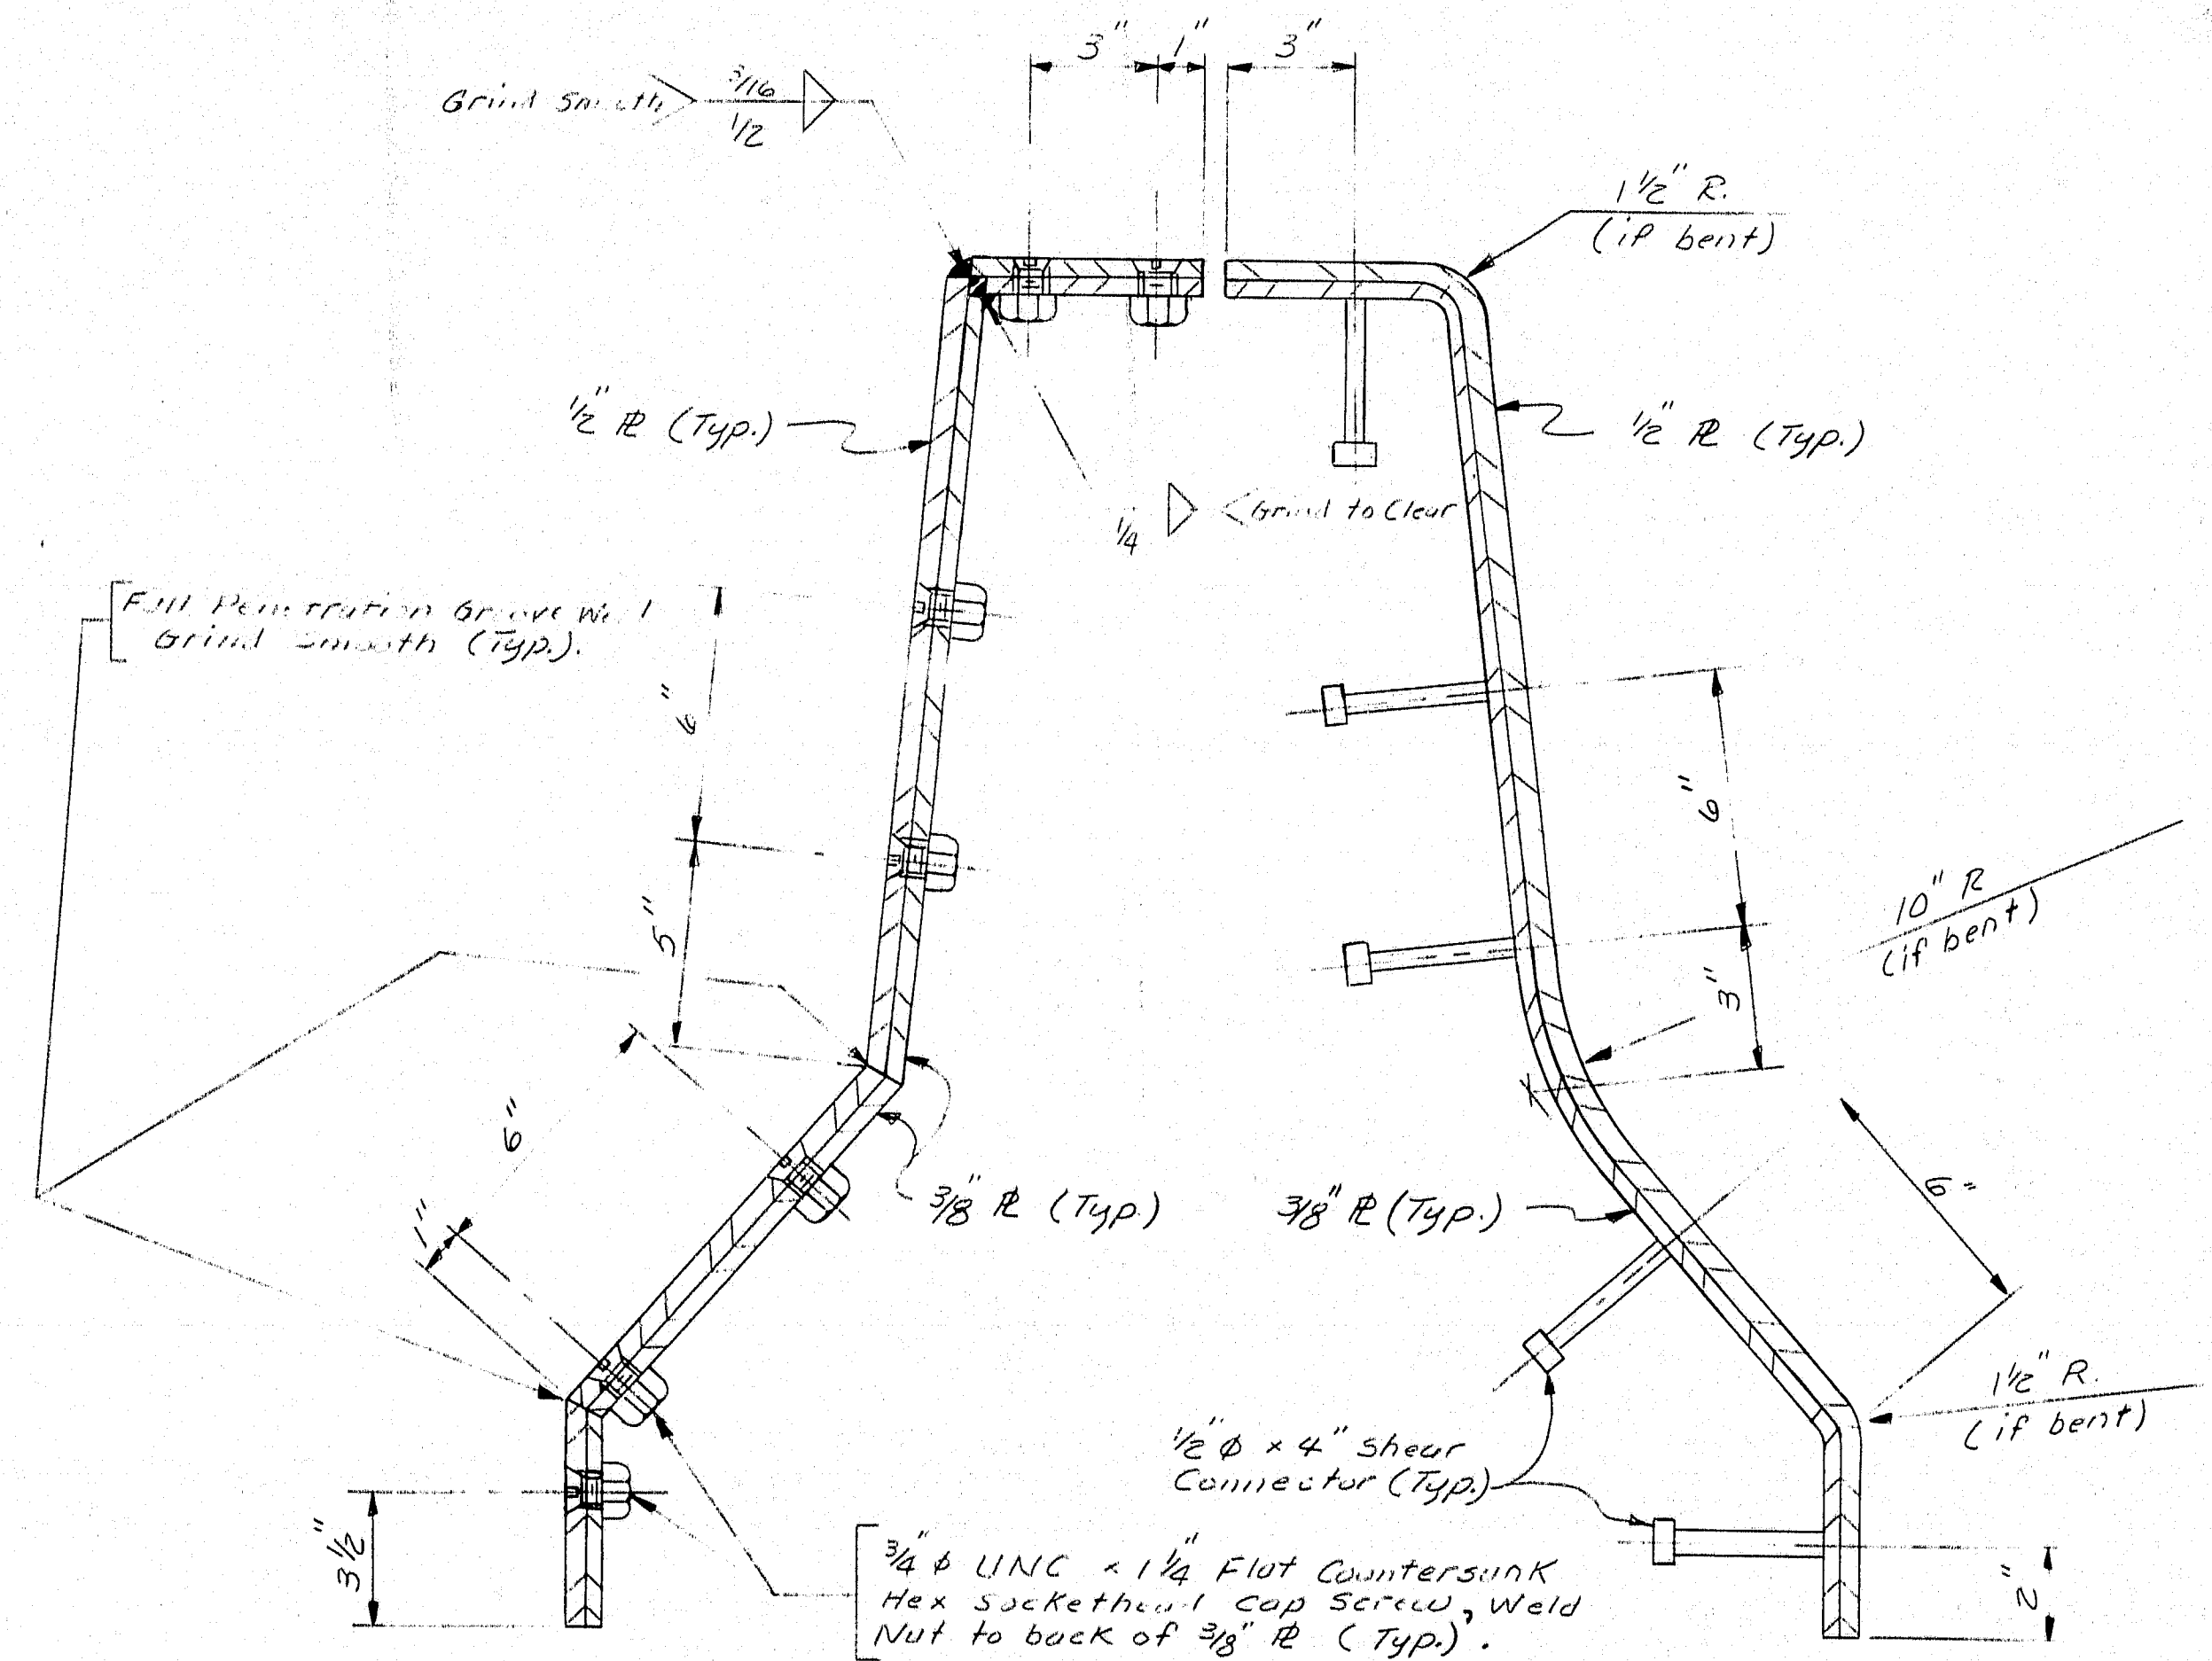

WELDED OPTION
Showing cap screws location

BENT R OPTION
Showing Shear connector locations

MEDIAN BARRIER

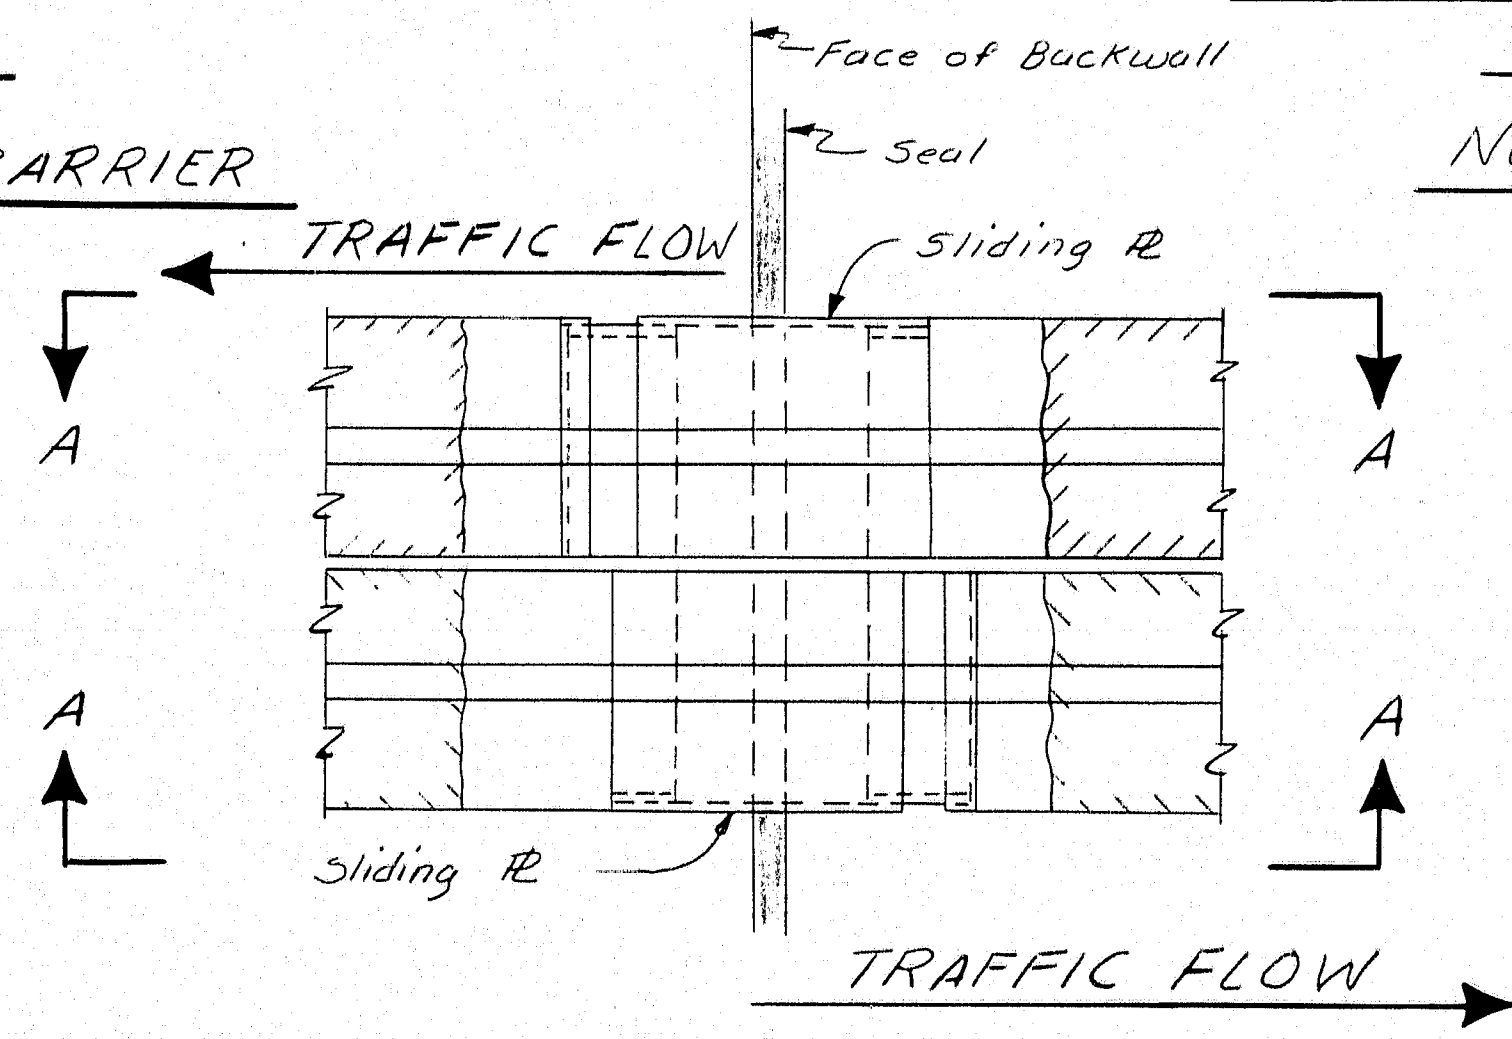


PLAN MEDIAN BARRIER

PROJECT DESIGN ENGINEER	DATE
BY VLS	3-86
DESIGN - DETAILED	
CHECKED	
REVISIONS	
FIELD CHANGES	



103-284

STATE OF MAINE
DEPARTMENT OF TRANSPORTATION
I-295 INTERCHANGE COMPLEX
TUKEYS BRIDGE
OVER
BACK COVE
IN THE TOWN OF
PORTLAND
CUMBERLAND COUNTY
BARRIER EXPANSION DAM
SHEET 18A OF 35 AUGUSTA, MAINE

F.R.N.A. NO.	STATE	PROJECT NUMBER	SHEET NO.	TOTAL SHEETS
1	MAINE	IR-295-3(94)50	23	120

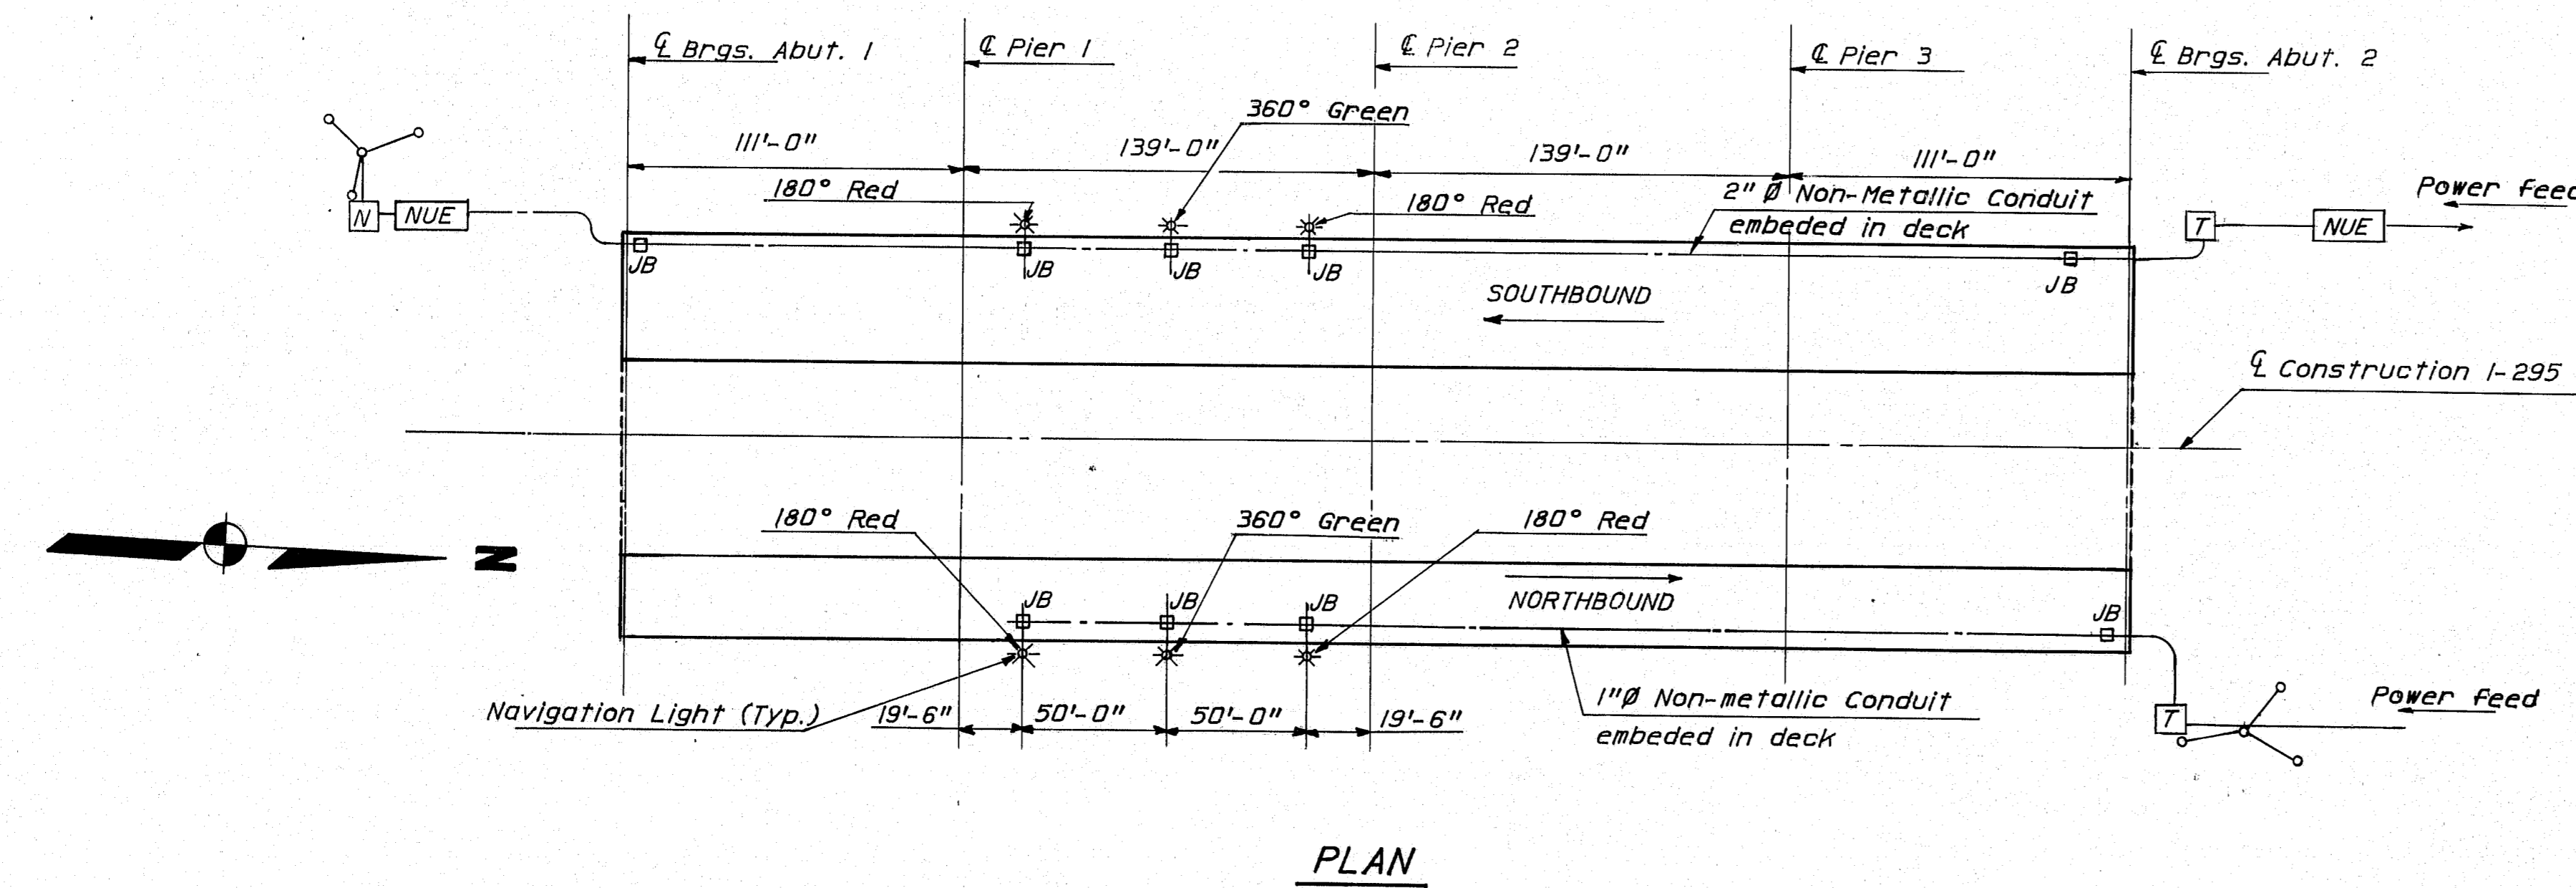


PLAN

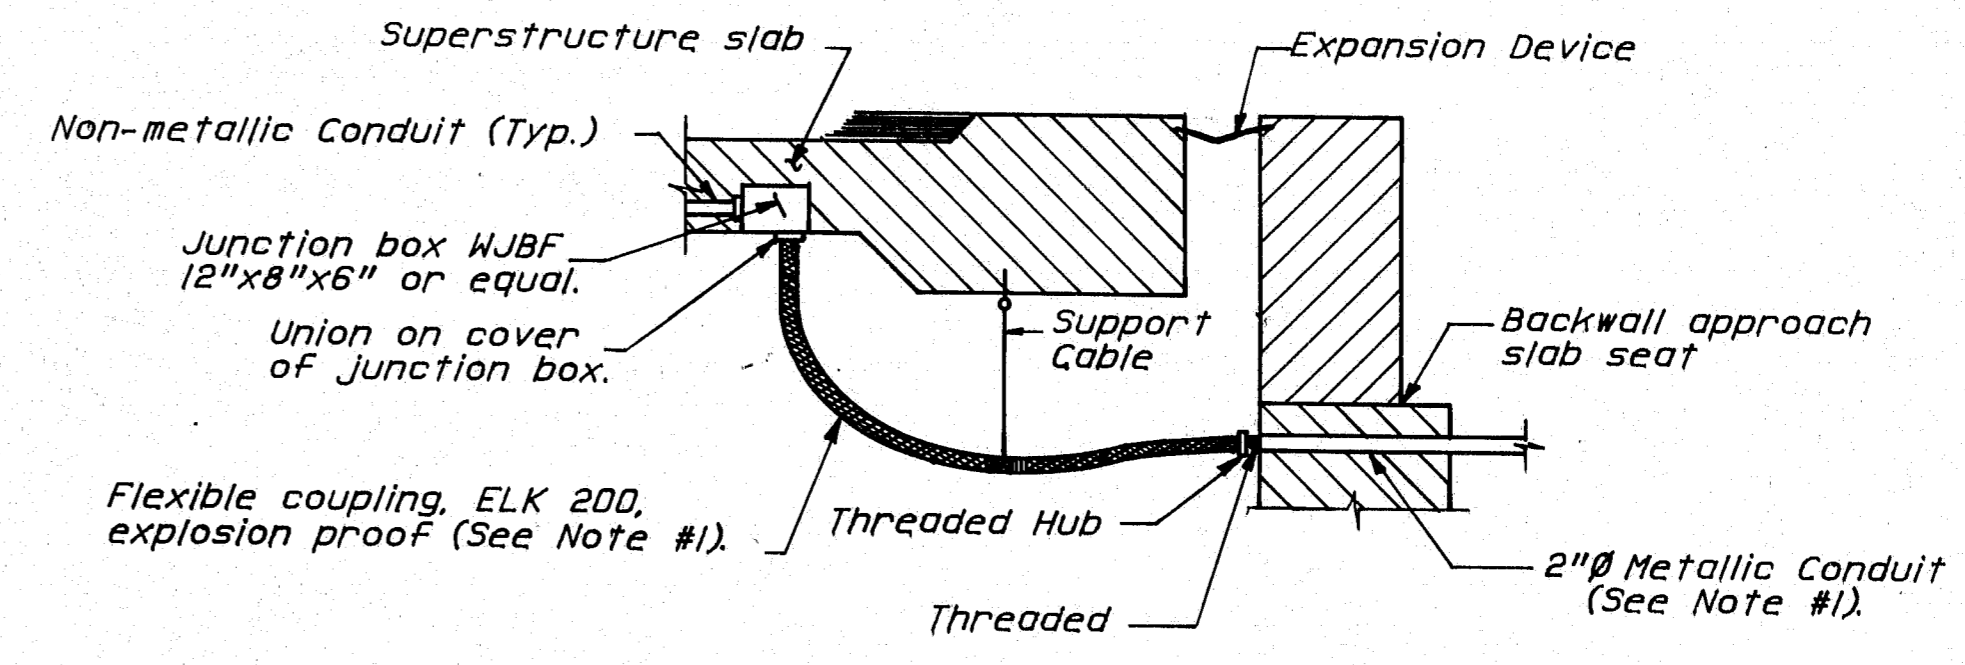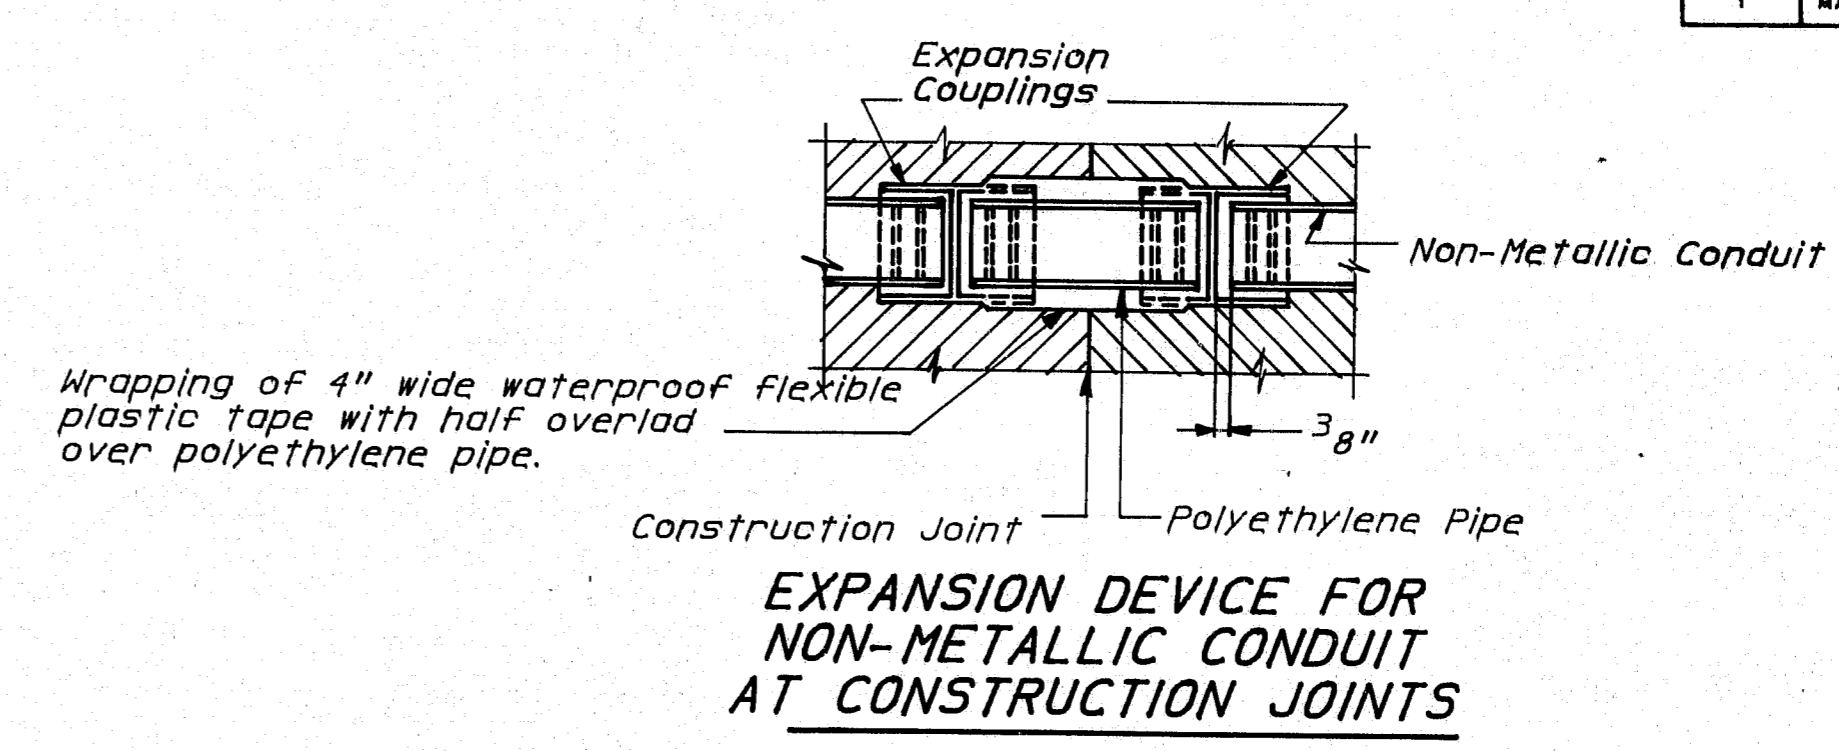

TYPICAL CONDUIT SYSTEM AT ABUTMENTS

ELECTRICAL SYMBOLS LEGEND


- New Lighting Tower & Luminaires
- New Underground Electrical wiring
- Junction Box
- Transformer / Control Cabinet (See Elec. Dwg.)

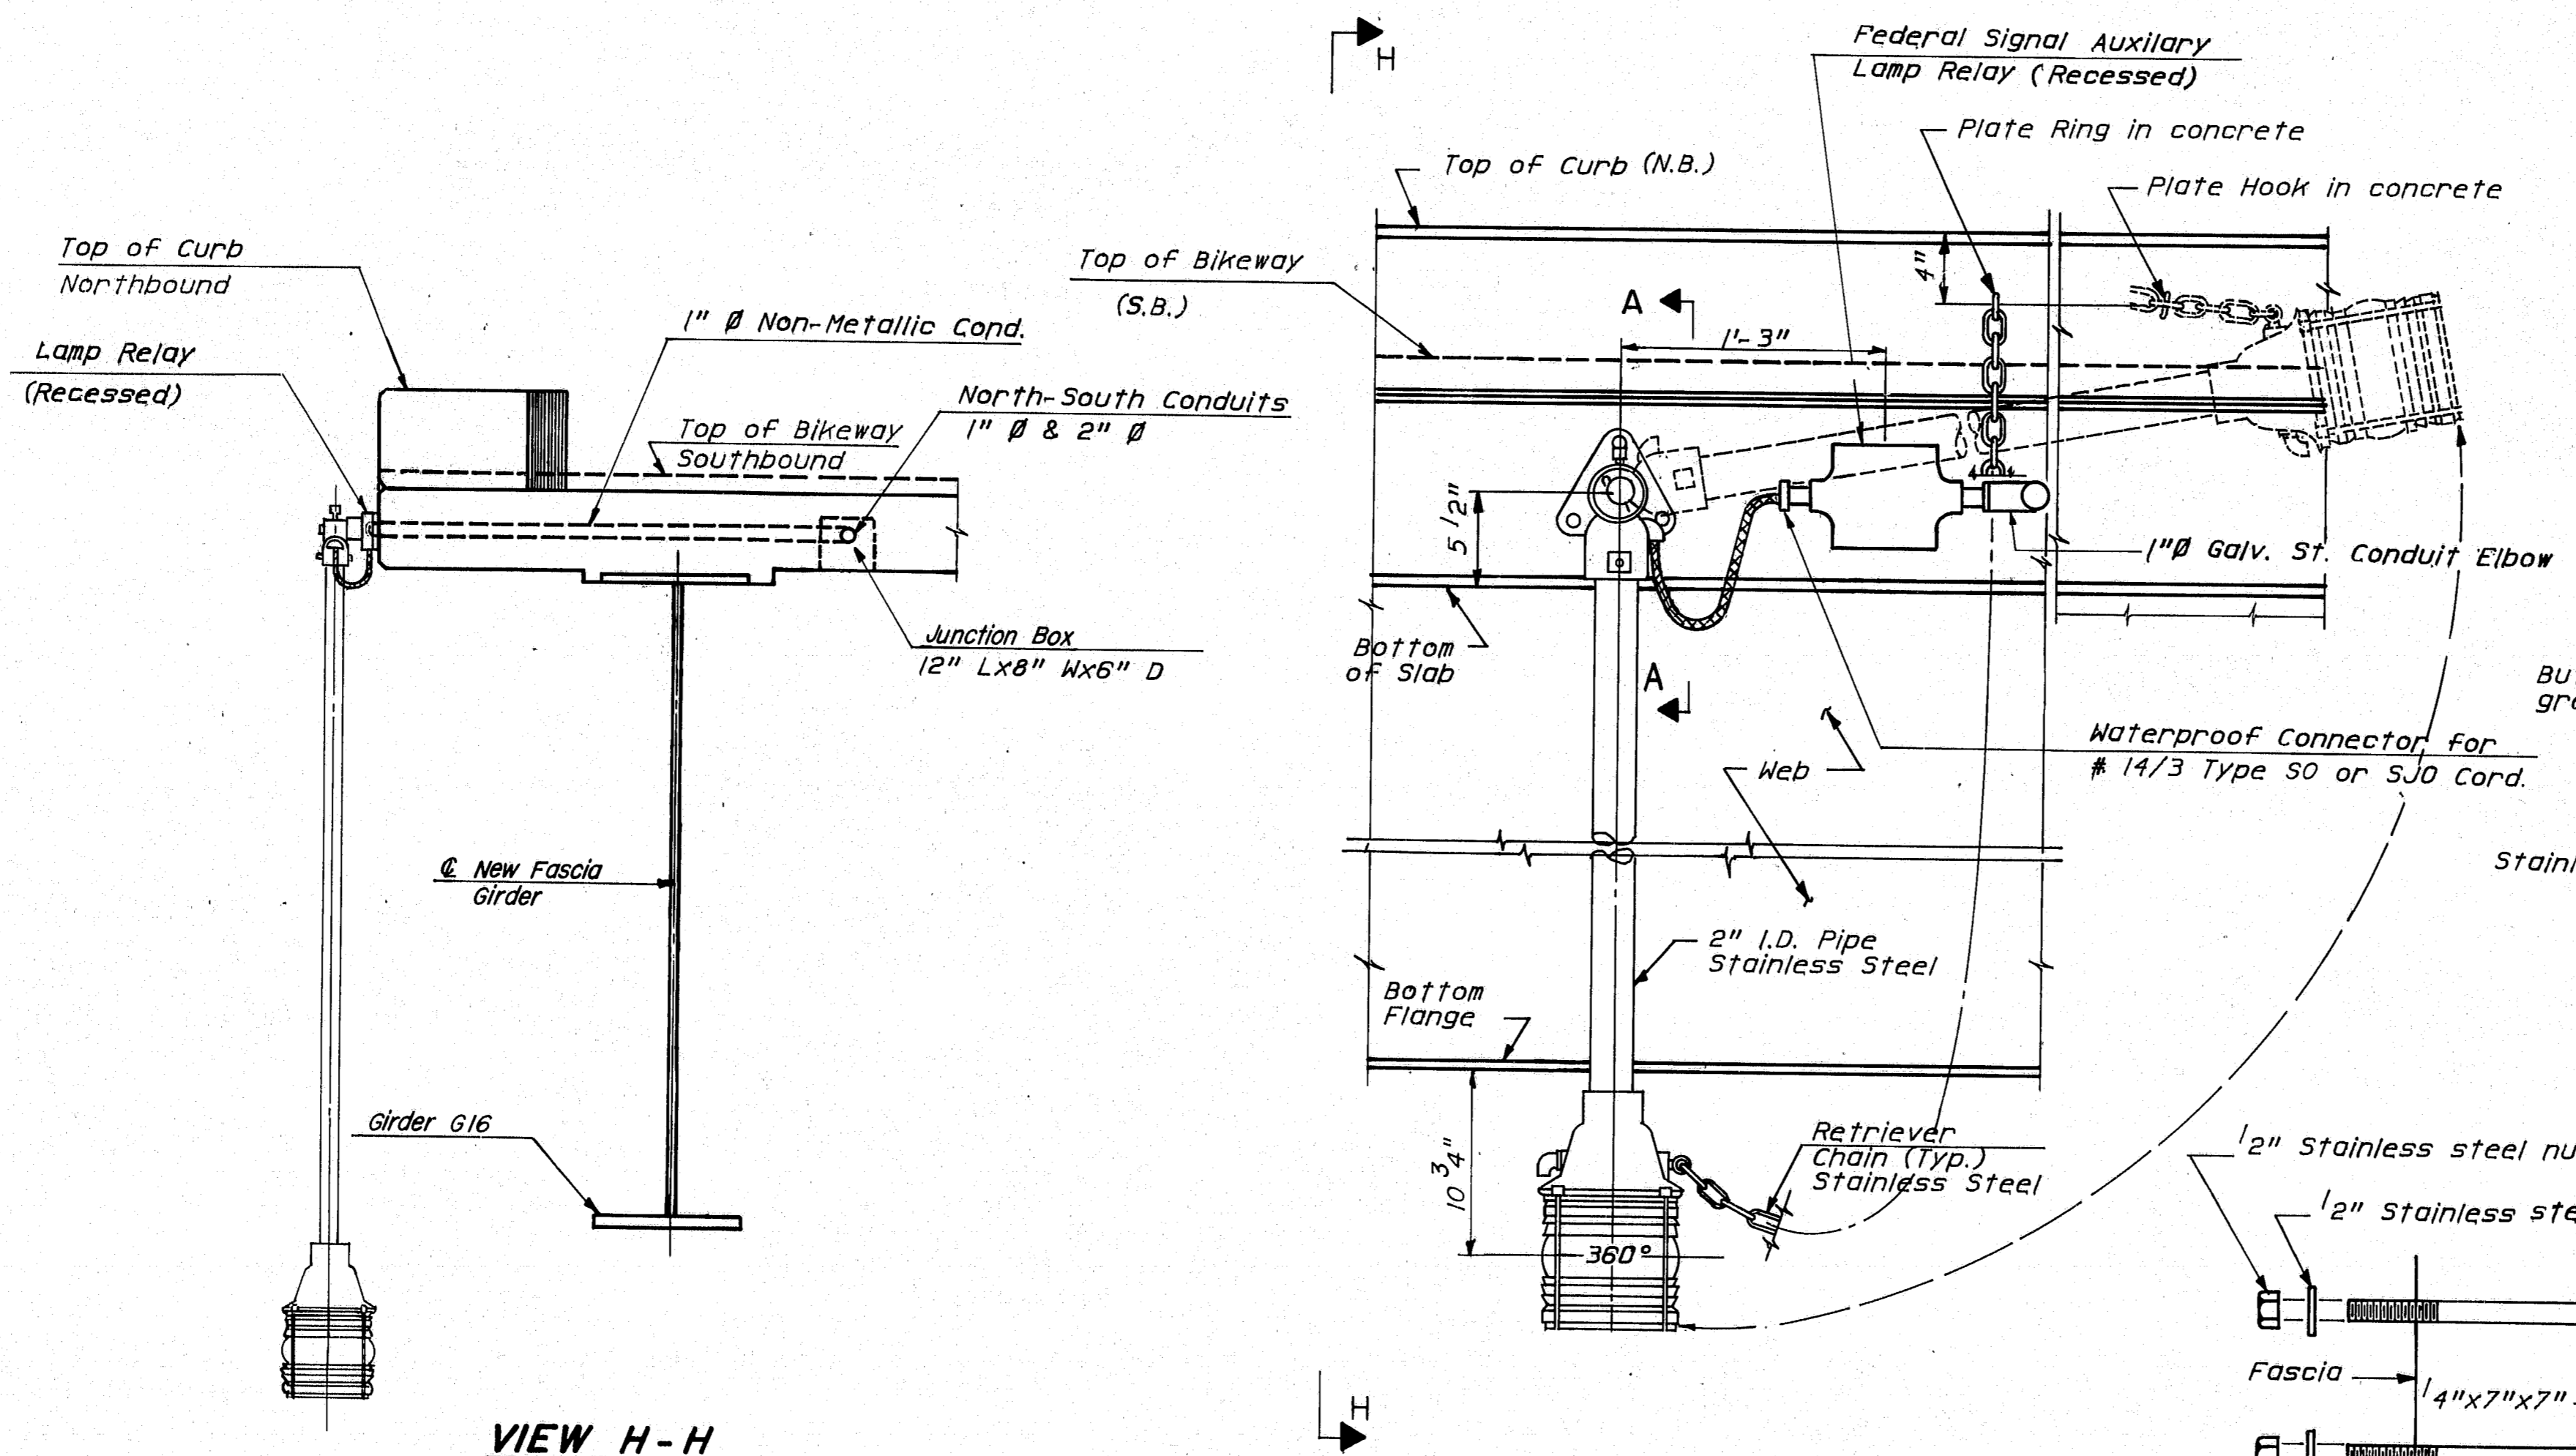

VIEW H-H

NAVIGATION LIGHT ANCHORAGE

(6 Required 4 Red @ 180° & 2 Green @ 360°)

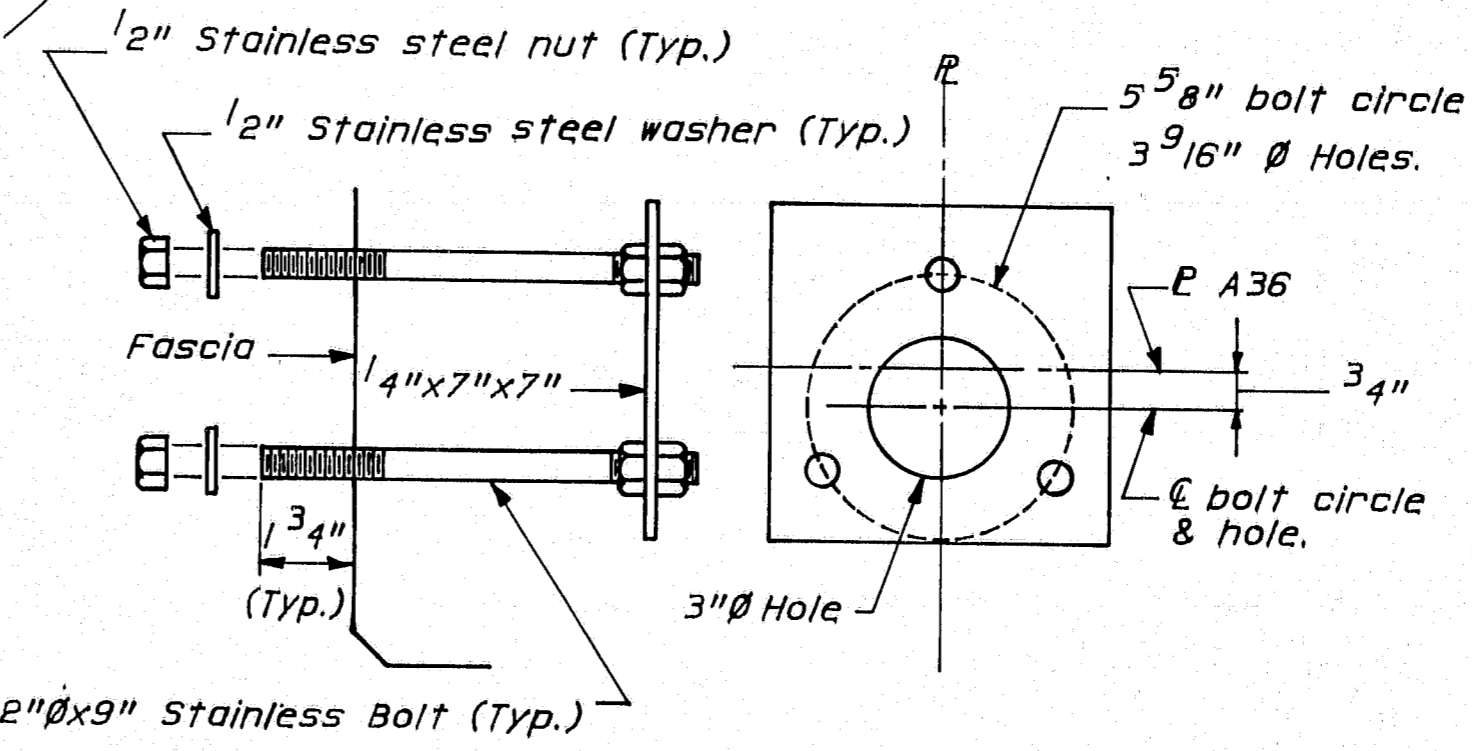

NAVIGATION LIGHT ANCHORAGE

(6 Required)

NOTES:

1. No separate payment will be made for ECK 200 Flexible coupling, support cable, 2" metallic conduit and related hardware. The cost will be considered incidental to Item 638.01. Embedded work in structures.
2. Work this sheet with Lighting Plan - Tukey's Bridge Area.
3. Conduits embedded in the concrete superstructure shall have drain TEE's at low points.

103-285

STATE OF MAINE
DEPARTMENT OF TRANSPORTATION

1-295 INTERCHANGE COMPLEX
TUKEYS BRIDGE
OVER
BACK COVE
IN THE TOWN OF
PORTLAND
CUMBERLAND COUNTY







NAVIGATION LIGHTING

SHEET 19 OF 35 AUGUSTA, MAINE

PROJECT DESIGN ENGINEER	DATE
AF	2-85
DESIGN - DETAILED	
CHECKED	
FIELD CHANGES	

BRUNING 44-132-45710-1

F.R.N.A. NO.	STATE	PROJECT NUMBER	SHEET NO.	TOTAL SHEETS
1	MAINE	IR-295-3(94)50	24	130

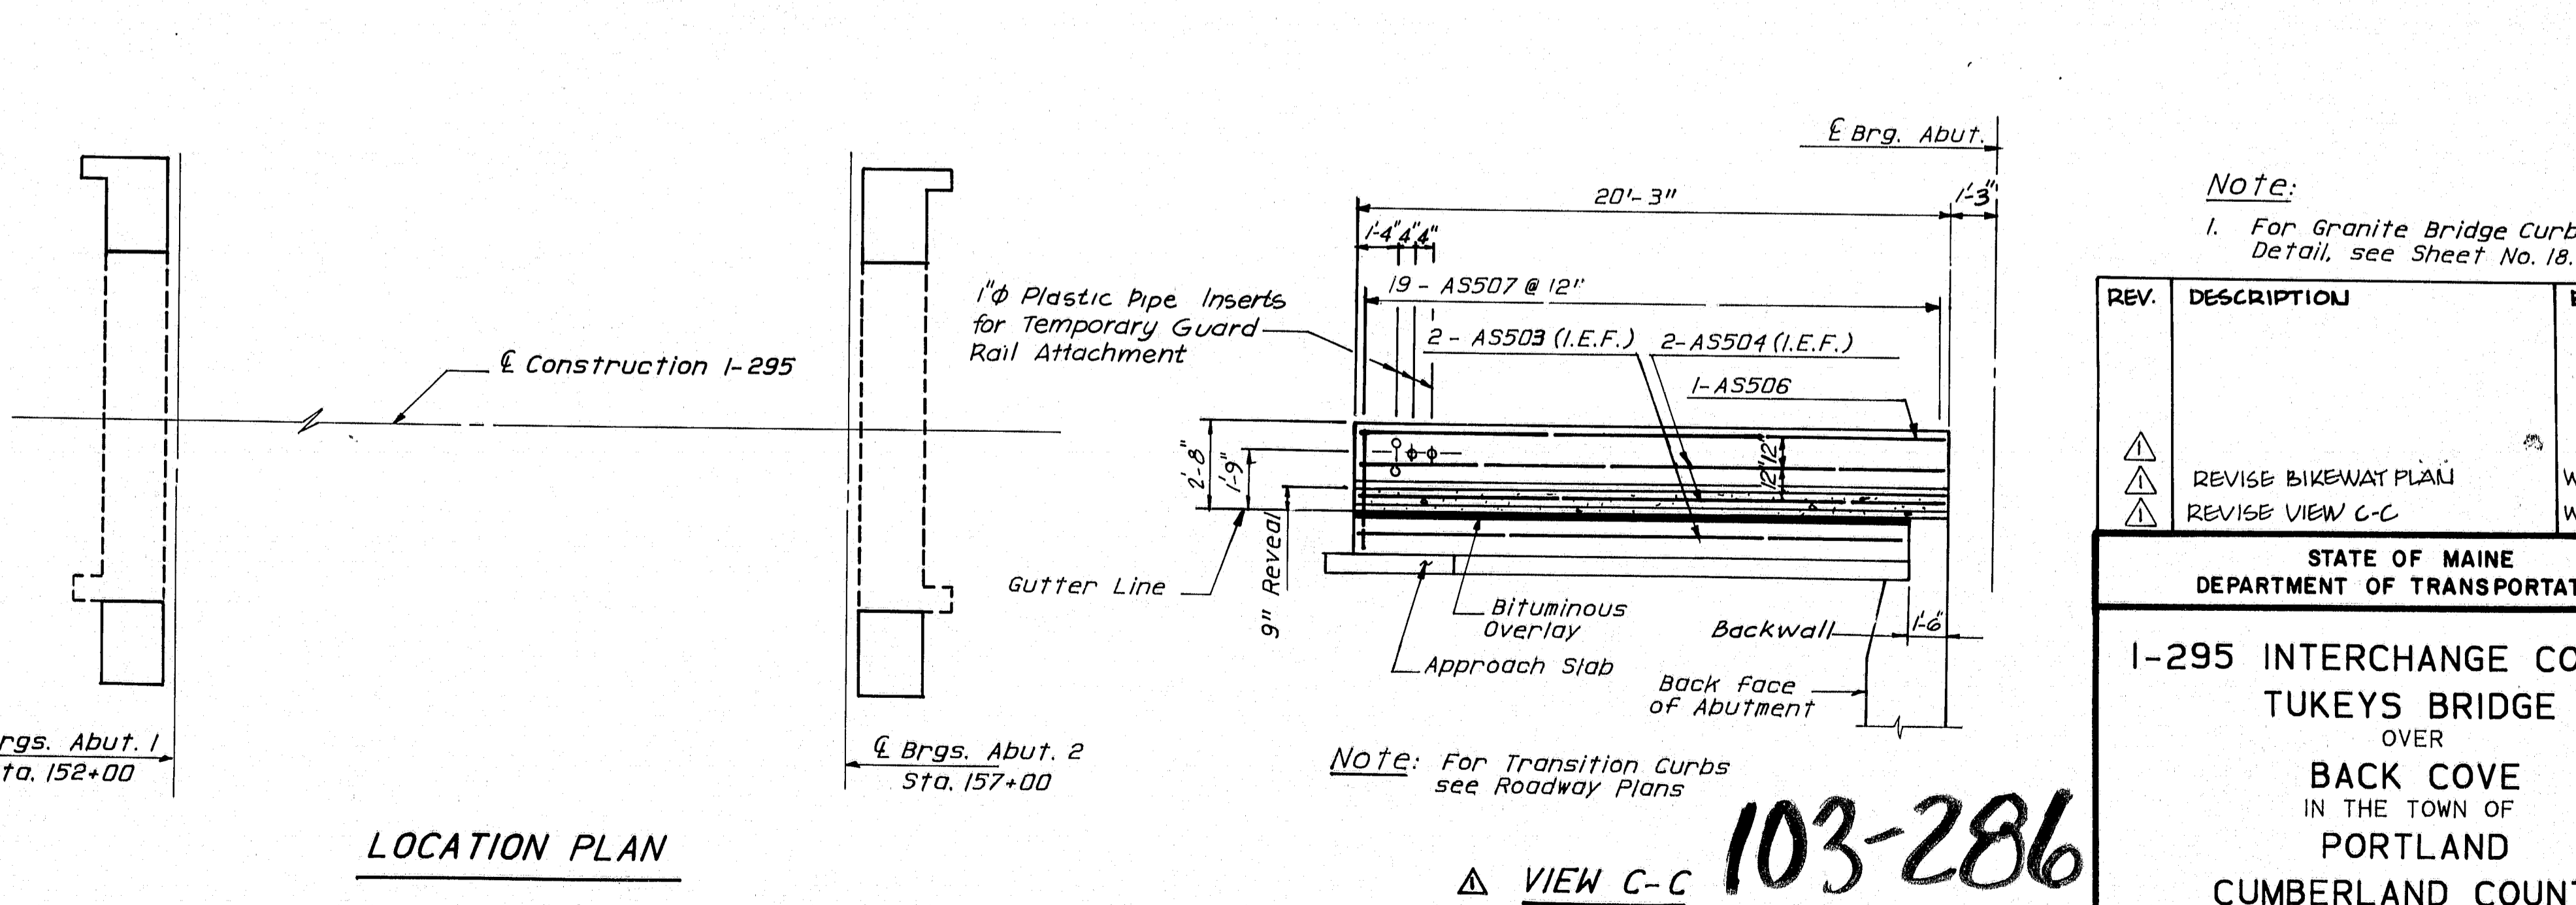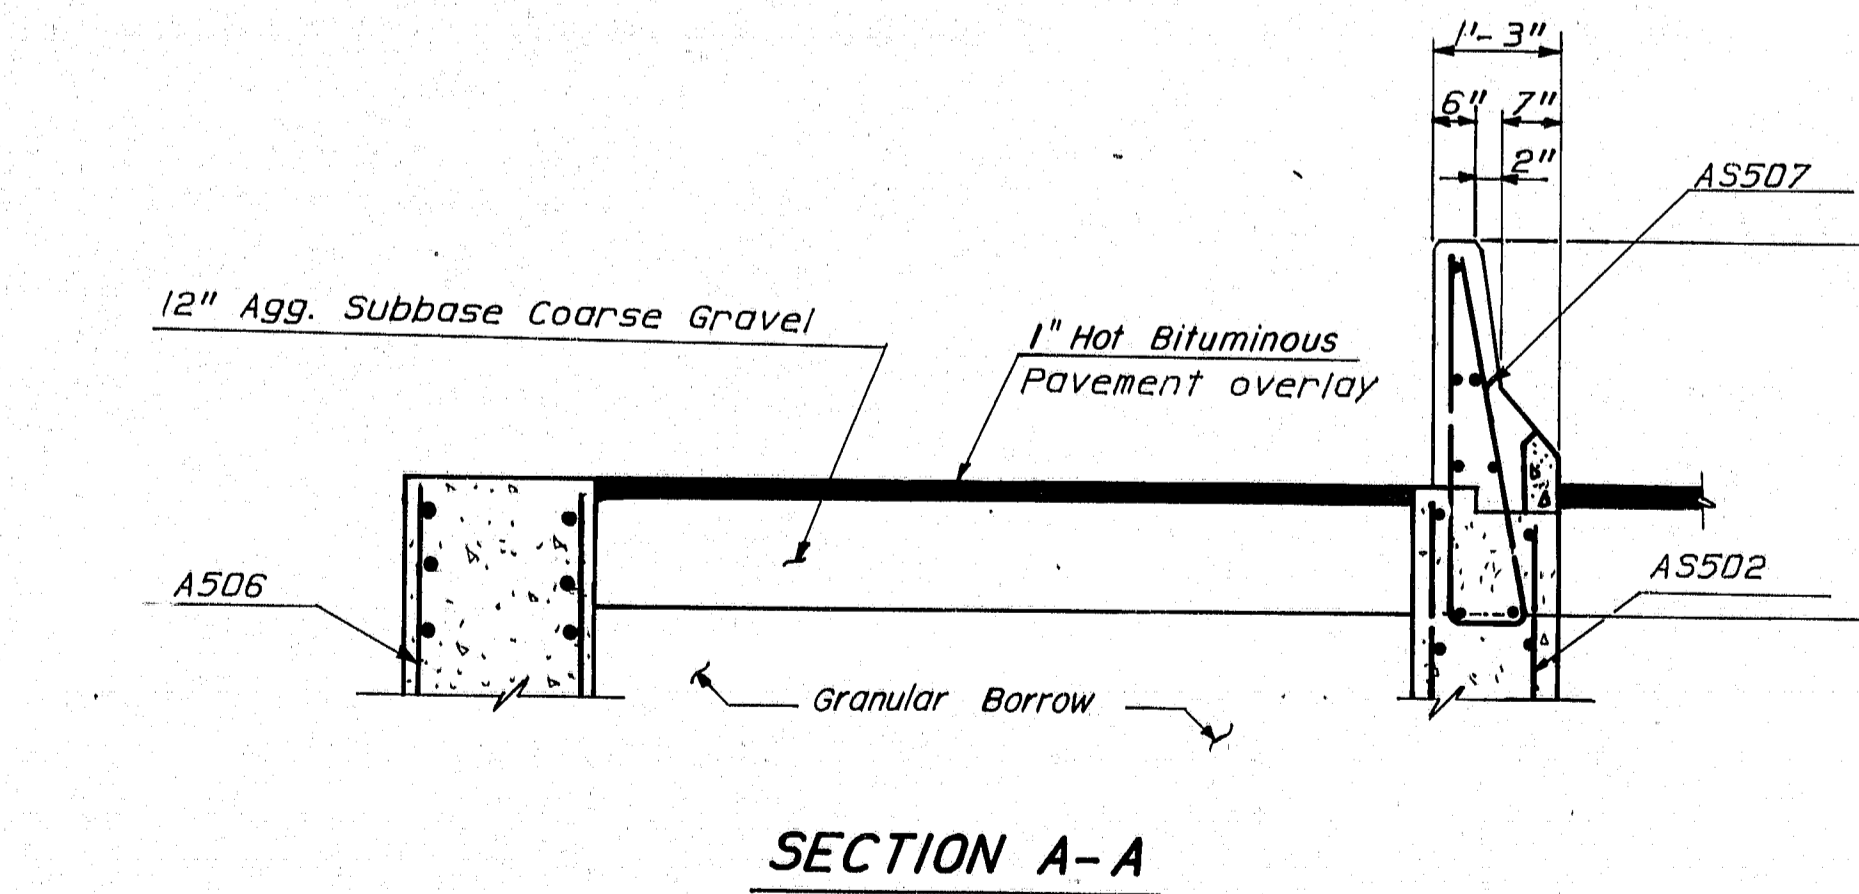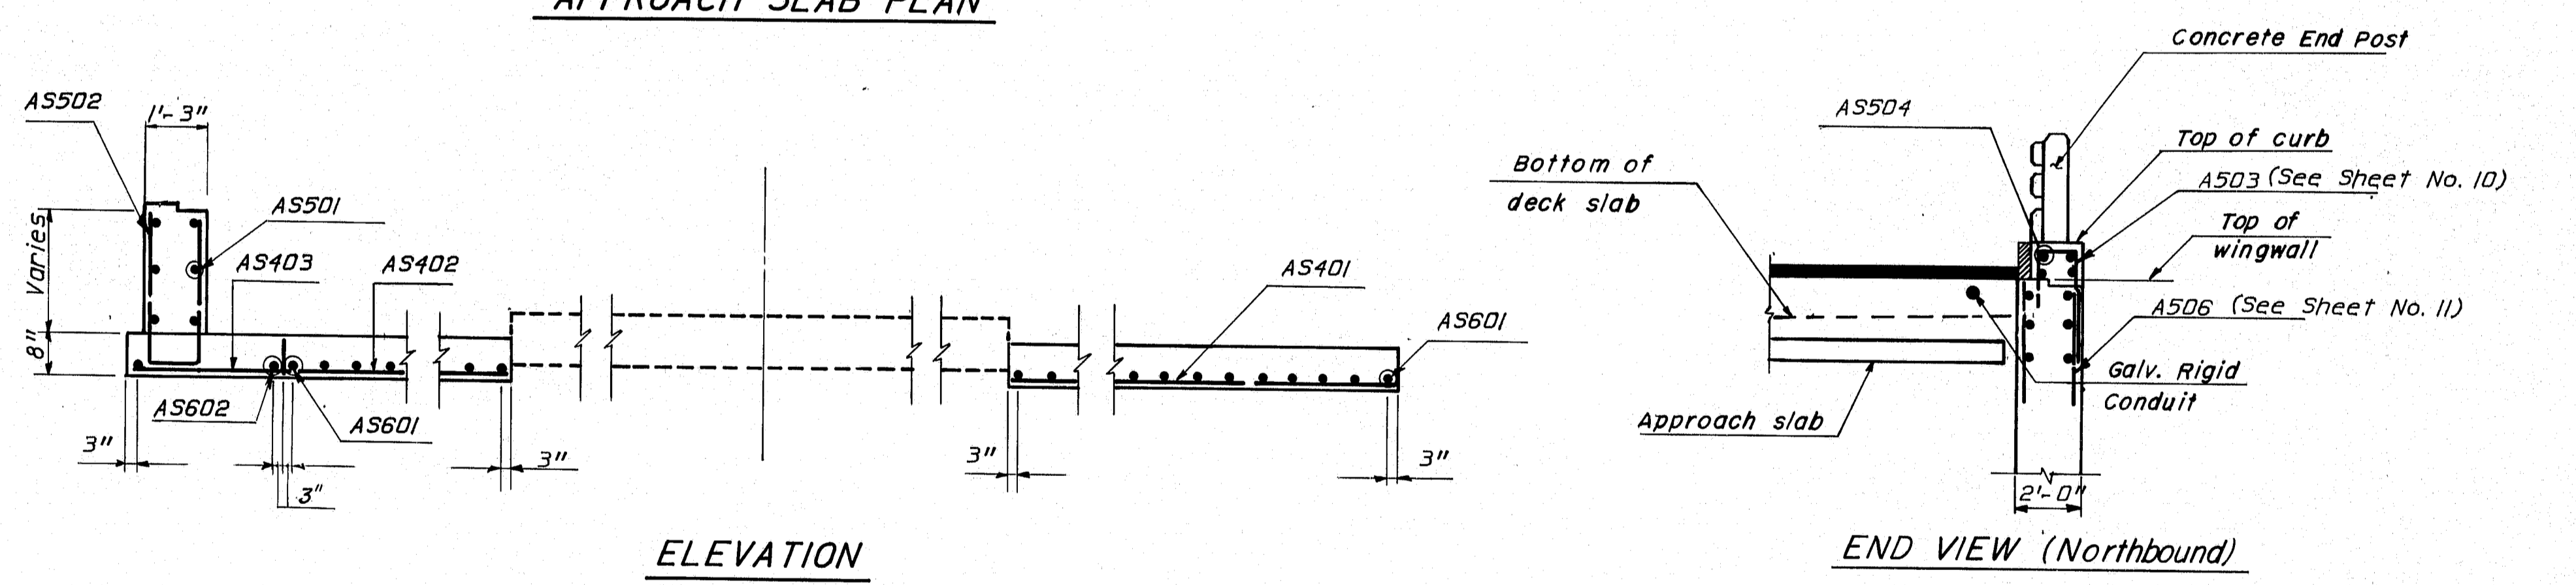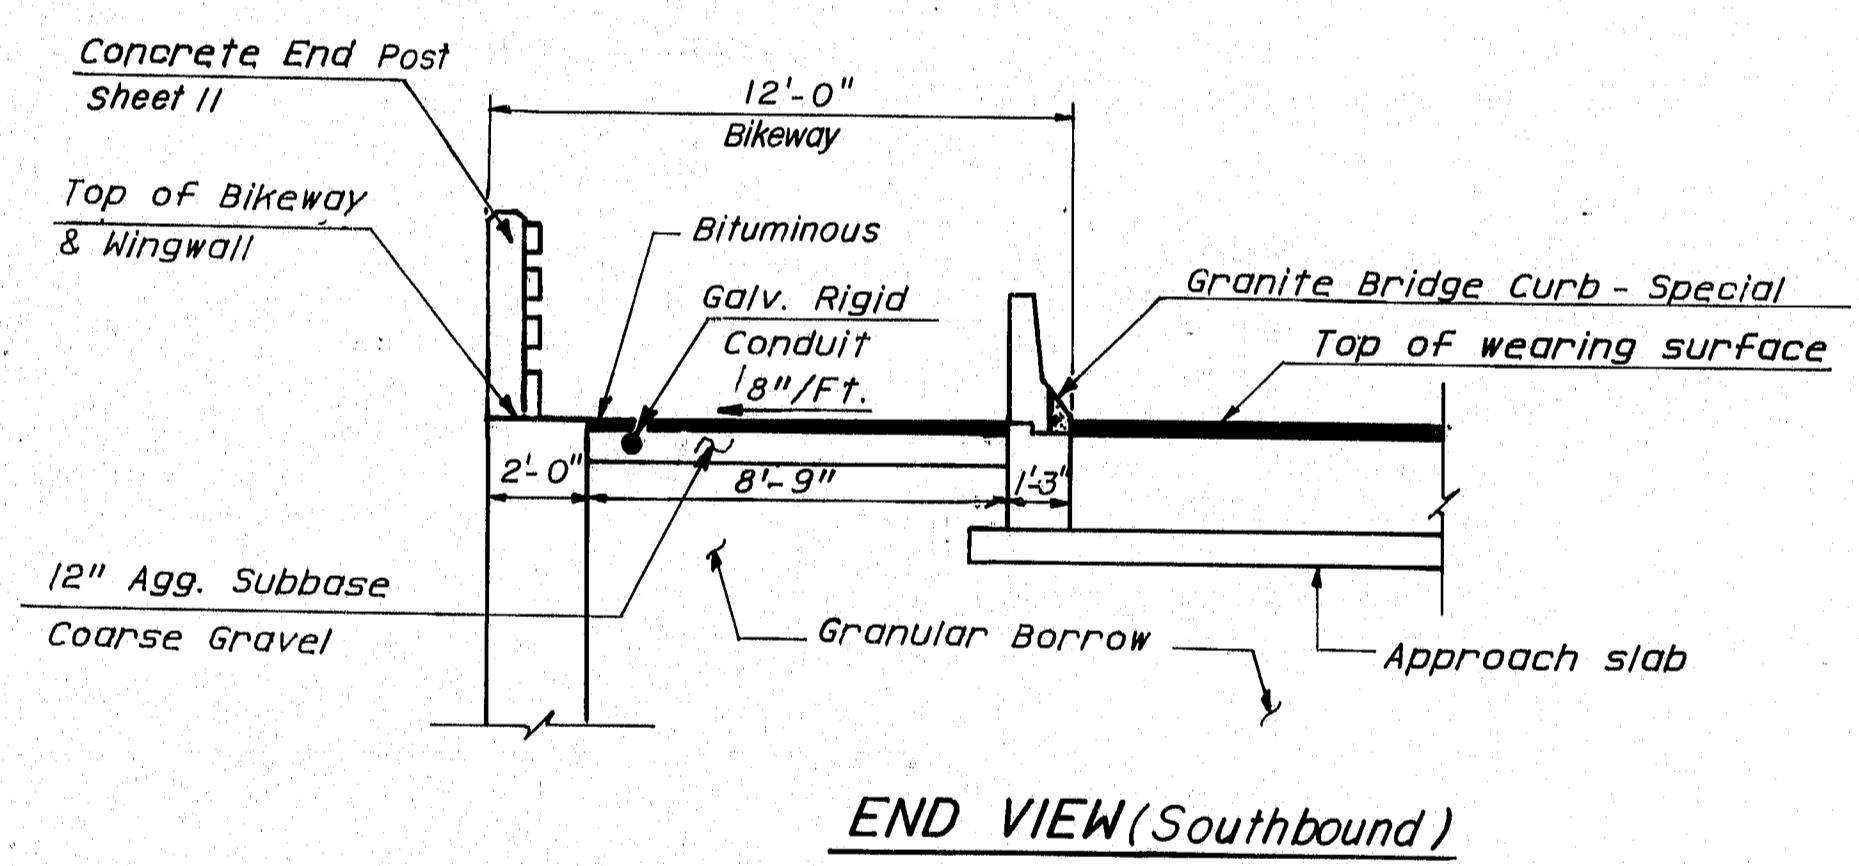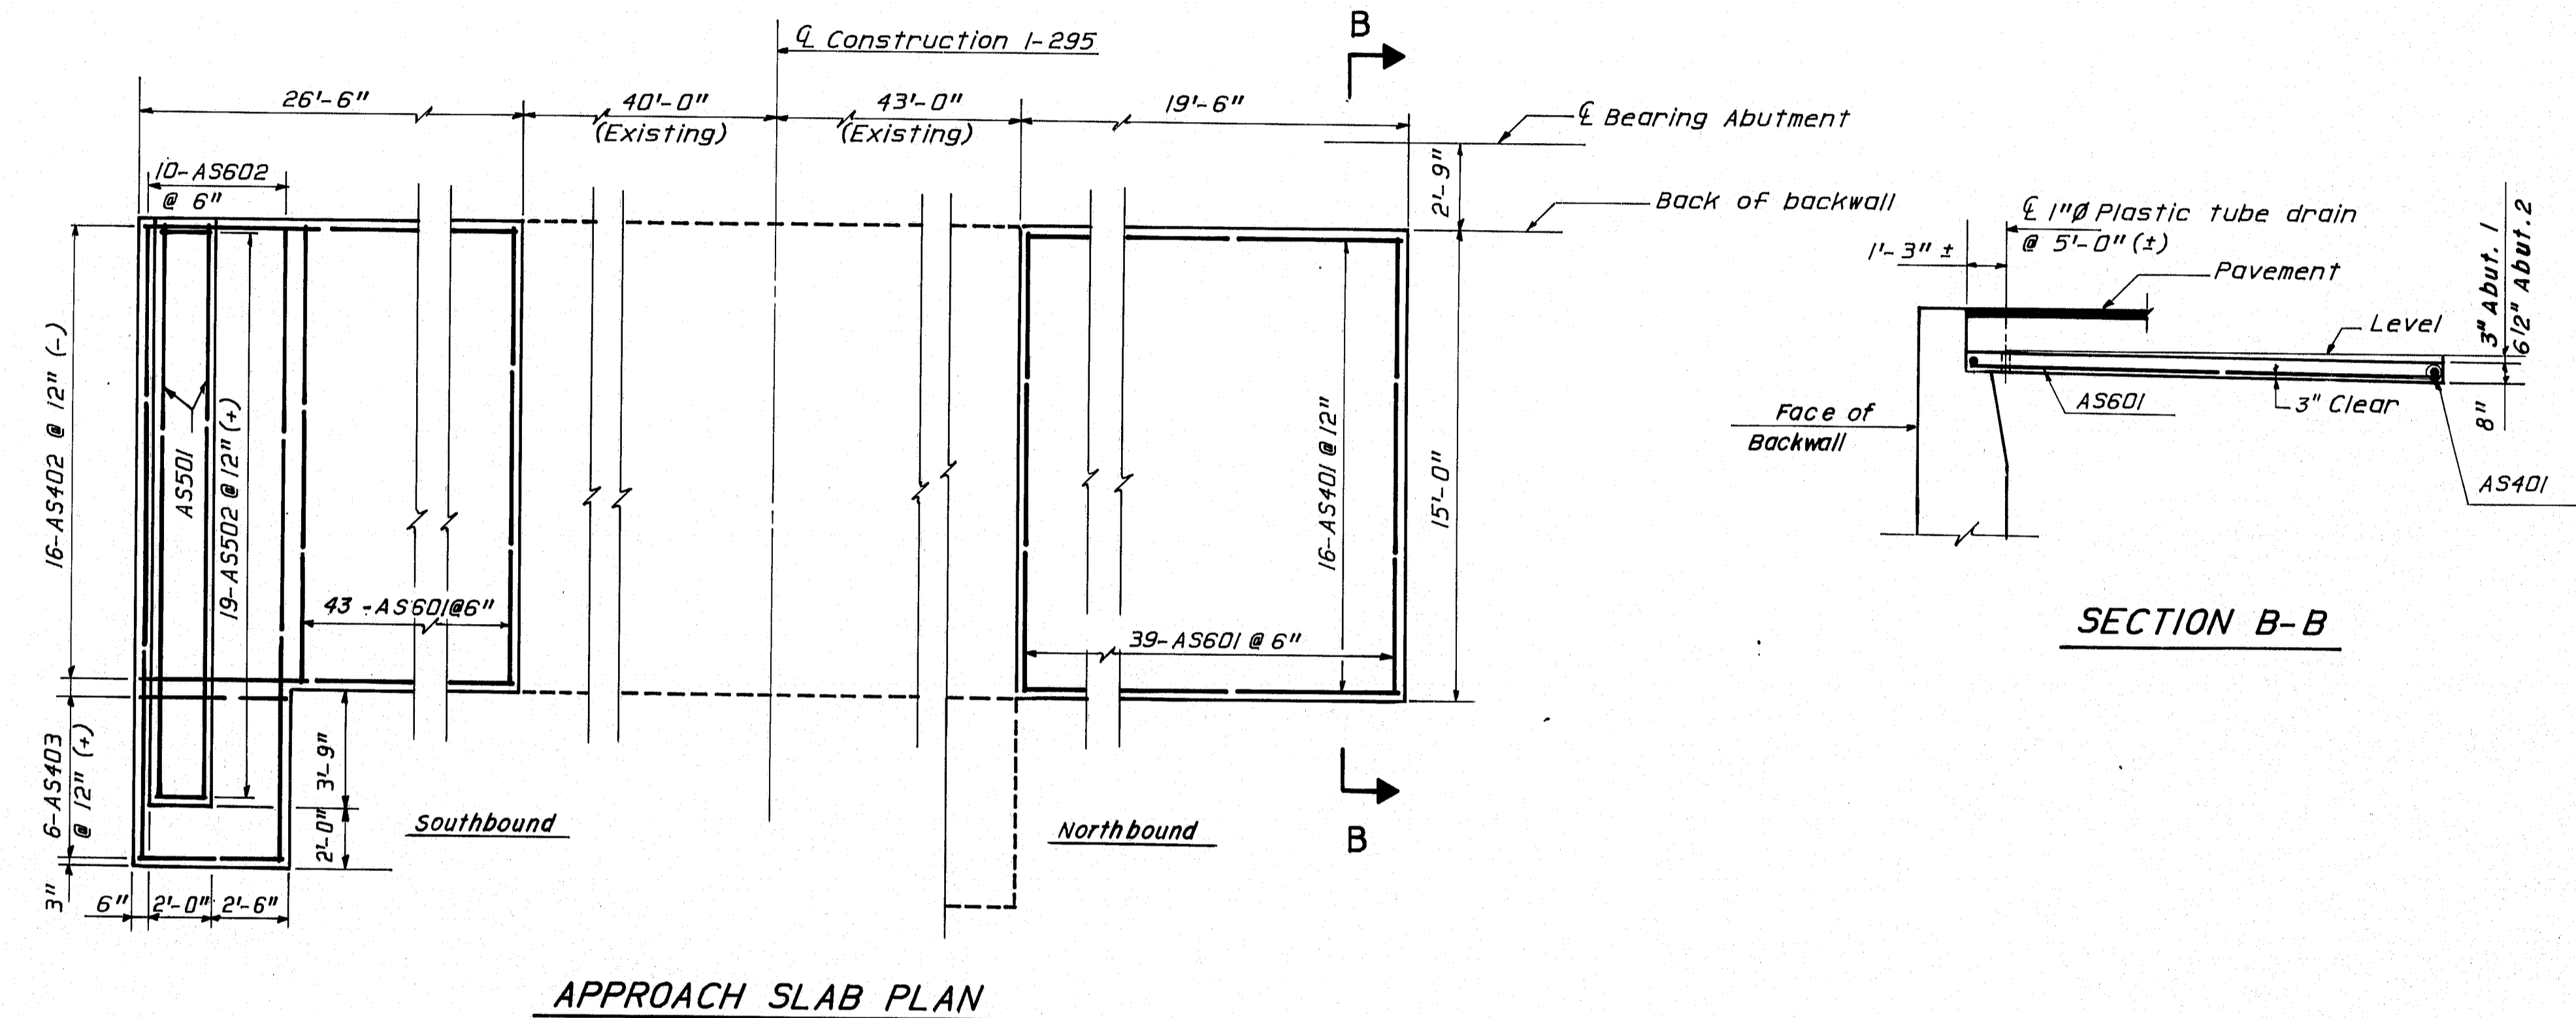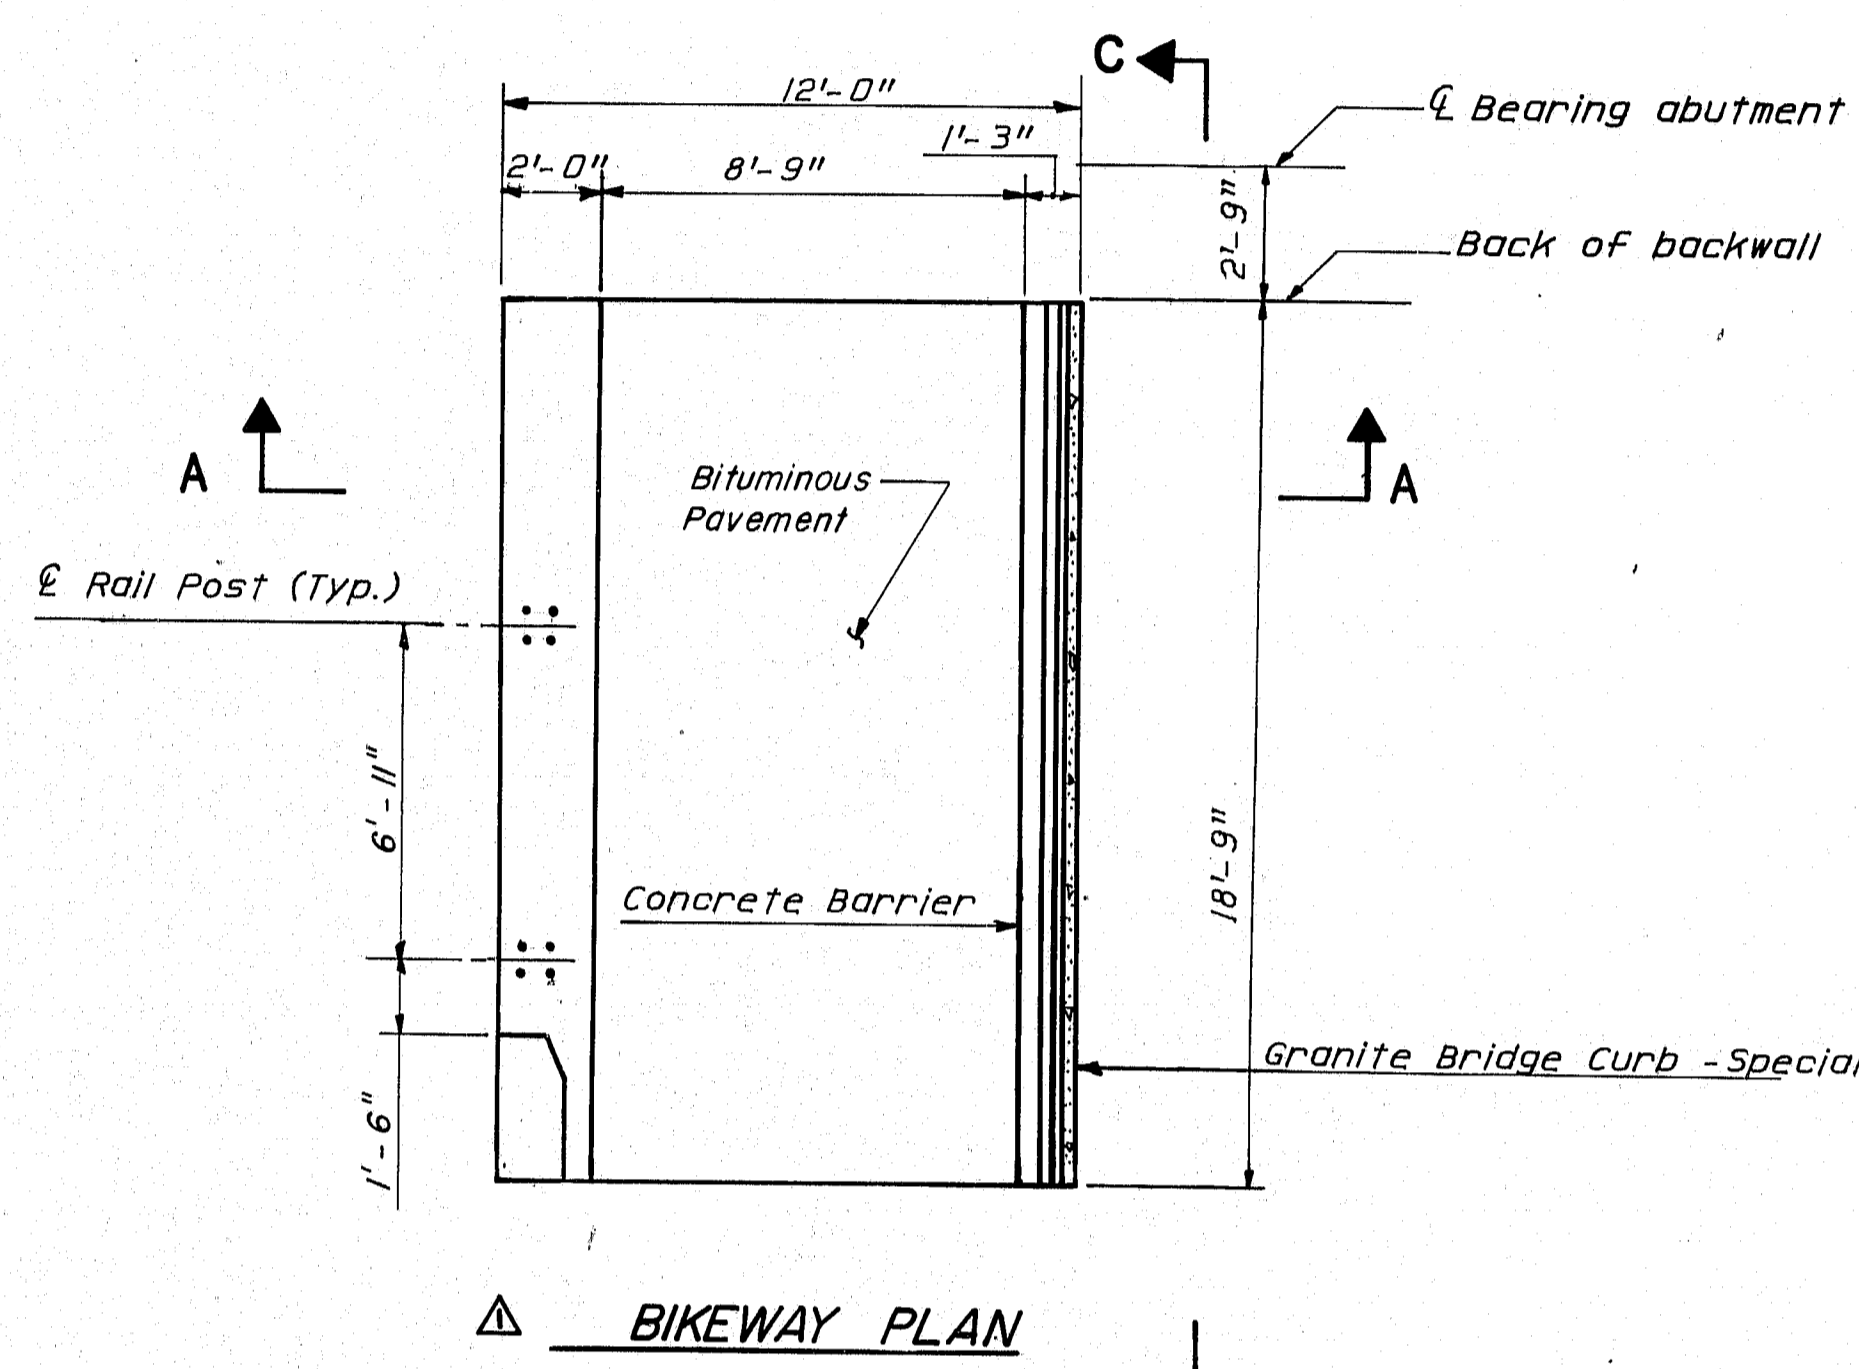

SECTION B-B

VIEW C-C

103-286

PROJECT DESIGN ENGINEER	A.F.	DATE	2/85
DESIGN - DETAILED	J.D.D.	C.H.	
CHECKED	A.F.		
REVISIONS			
FIELD CHANGES			

Note:
1. For Granite Bridge Curb-Special Detail, see Sheet No. 18.


REV.	DESCRIPTION	BY	DATE
△	REVISE BIKEWAY PLAN	W-P	6-6-85
△	REVISE VIEW C-C	W-P	6-6-85

STATE OF MAINE
DEPARTMENT OF TRANSPORTATION

**I-295 INTERCHANGE COMPLEX
TUKEYS BRIDGE
OVER
BACK COVE
IN THE TOWN OF
PORTLAND
CUMBERLAND COUNTY
APPROACH SLAB DETAILS**

SHEET 20 OF 35 AUGUSTA, MAINE

F.W.A. REG. NO.	STATE	PROJECT NUMBER	SHEET NO.	TOTAL SHEETS
1	MAINE	IR-295-384150	29	120

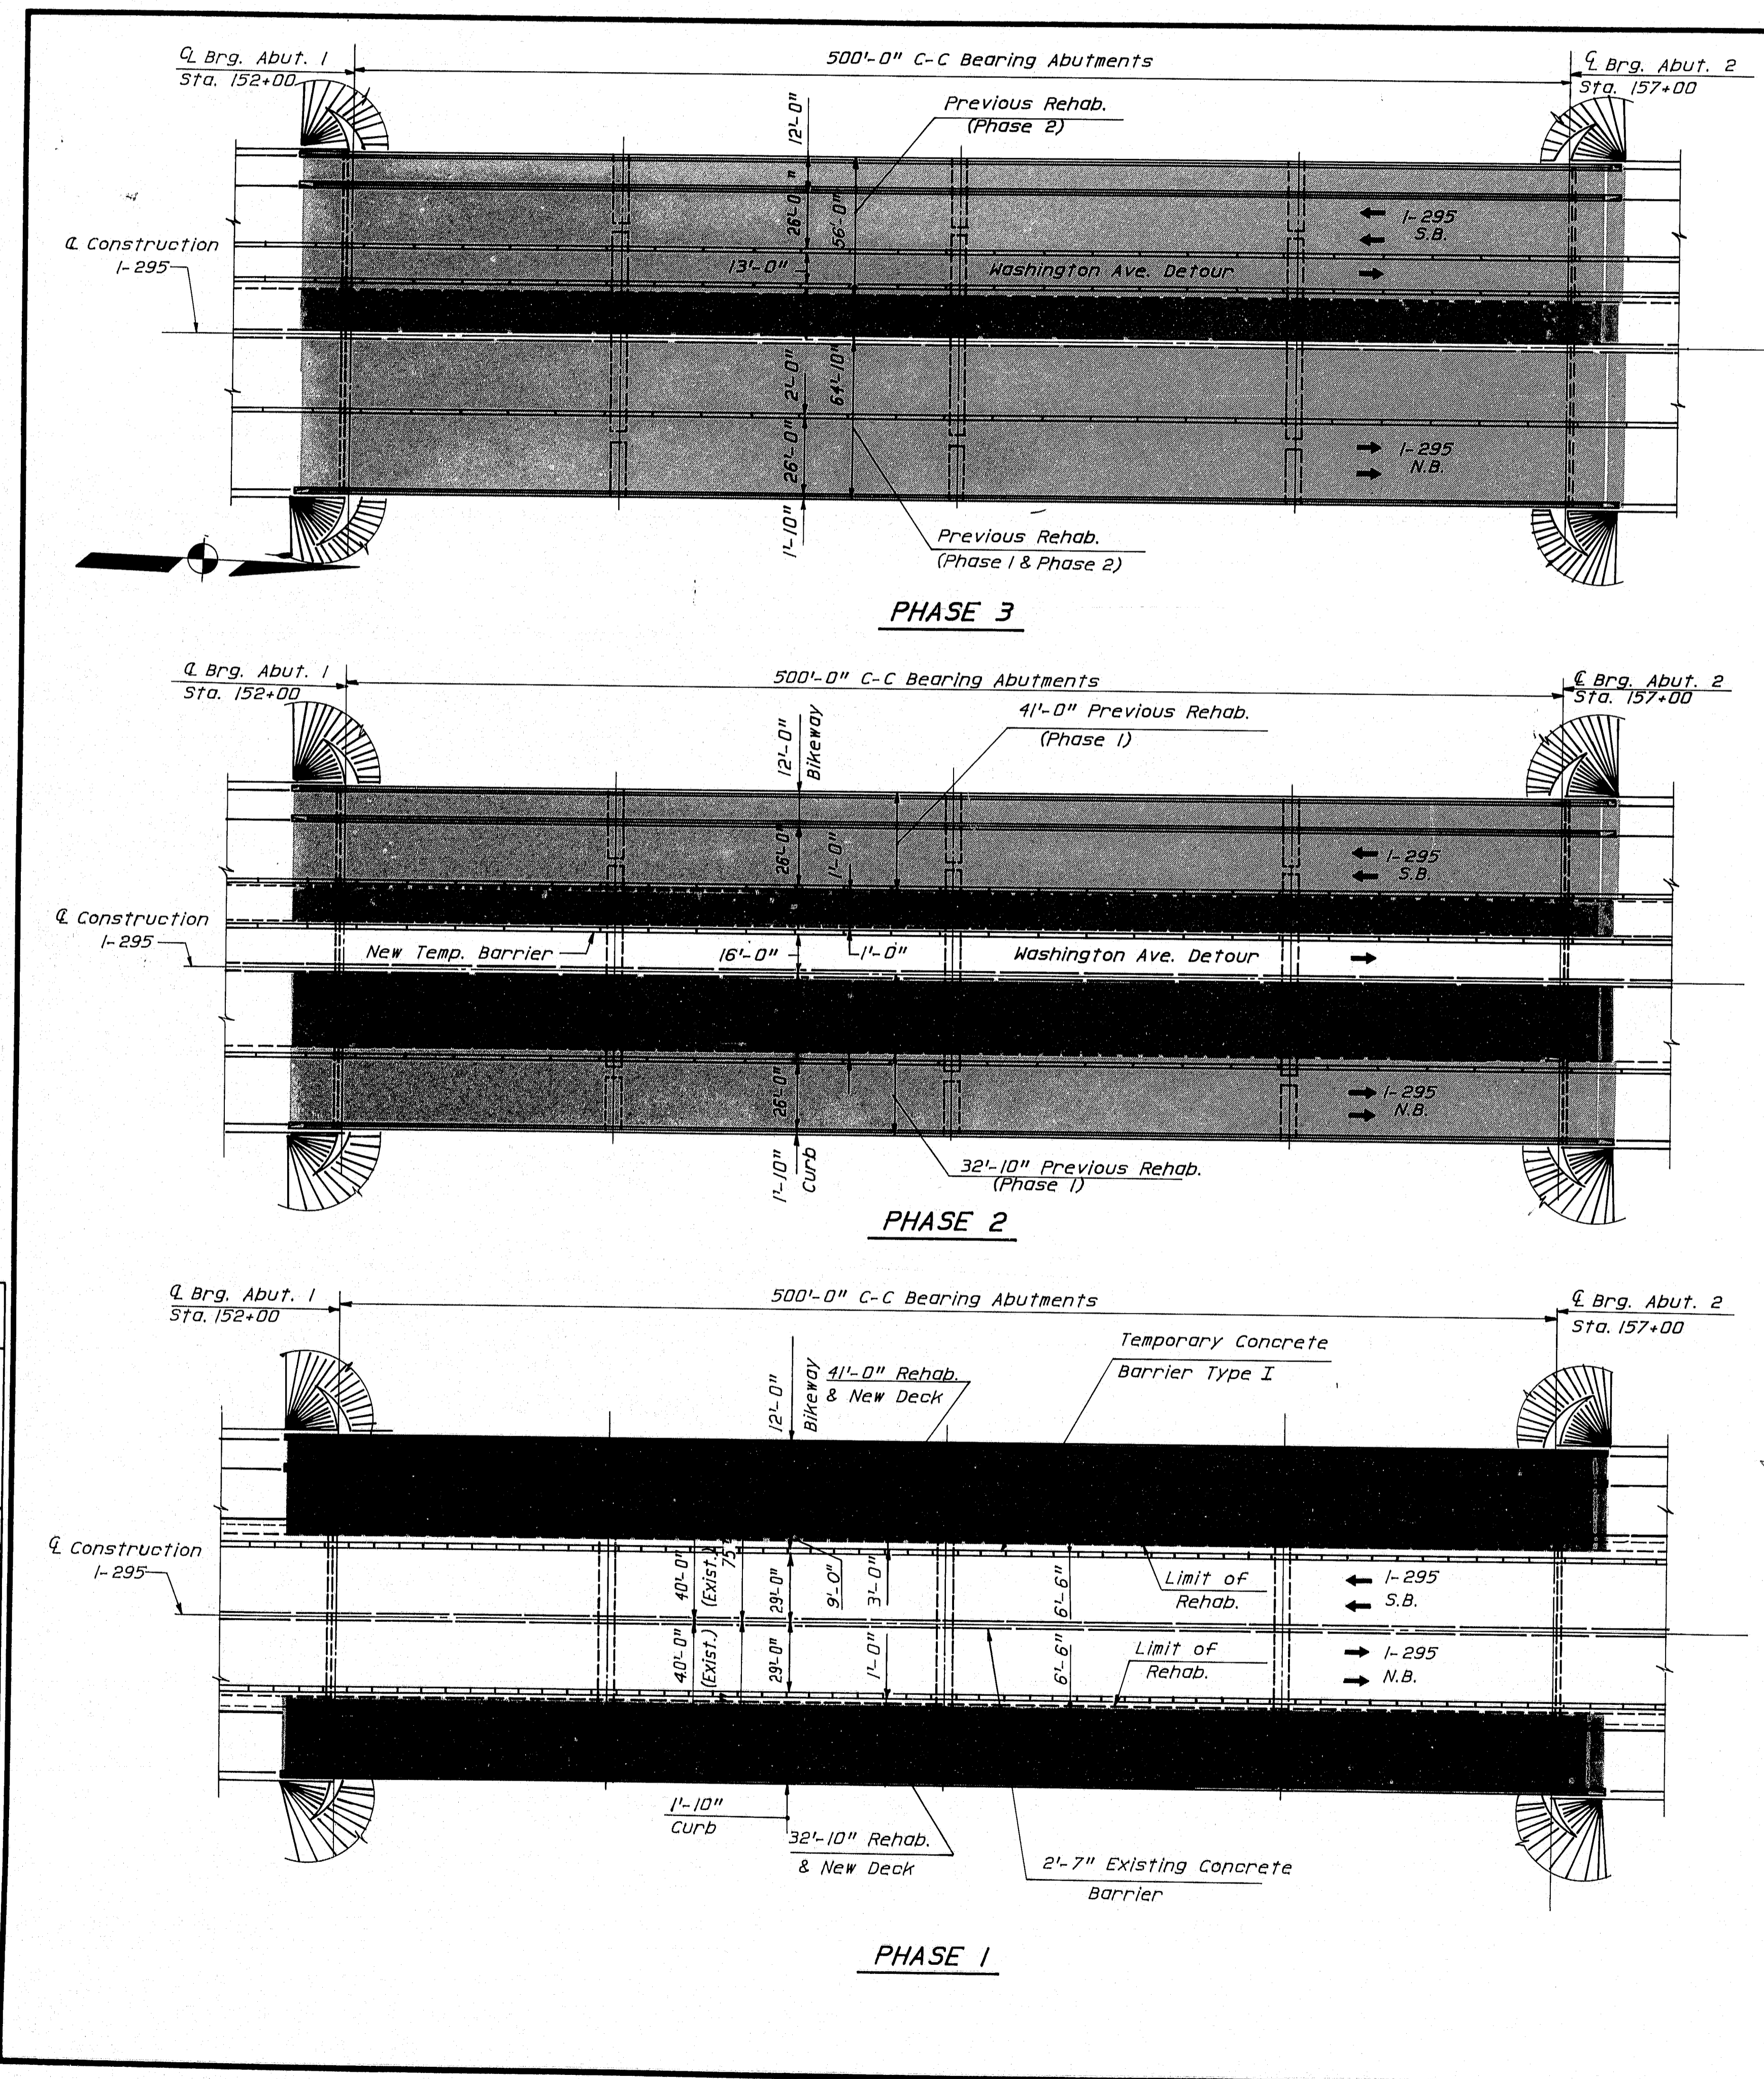

SCHEDULE OF OPERATIONS

- All adjustments in operations must be coordinated with the interchange contractor.
- Construction warning signs are to be corrected to reflect changes in the traffic operation.
- Reposition phase 2 new temporary concrete barrier type I.
- Remove existing bituminous wearing surface and rehab as shown on plan.


NOTE: The existing bituminous pavement has an epoxy penetrating sealer. It is not necessary to remove this sealer.

SCHEDULE OF OPERATIONS

- All adjustments in operations must be coordinated with the interchange contractor.
- Construction warning signs are to be corrected to reflect changes in the traffic operation.
- Remove and place temporary lane markings as determined by the changes in traffic lanes.
- Remove and reposition temporary concrete barrier type I.
- Place new temporary concrete barrier for Washington Avenue detour traffic.
- Remove existing bituminous wearing surface and rehab as shown on plan.

SCHEDULE OF OPERATIONS

- Construction warning signs are to be located and erected as the first order of work. See initial traffic plans.
- Place temporary lane markings as required to direct traffic around the construction area.
- Place temporary precast concrete barrier type I on existing bridge and approaches.
- Remove existing bridge railing, existing light standard, existing sidewalk concrete and slab concrete.
- Construct new deck & Rehab. existing bridge as shown on plan.

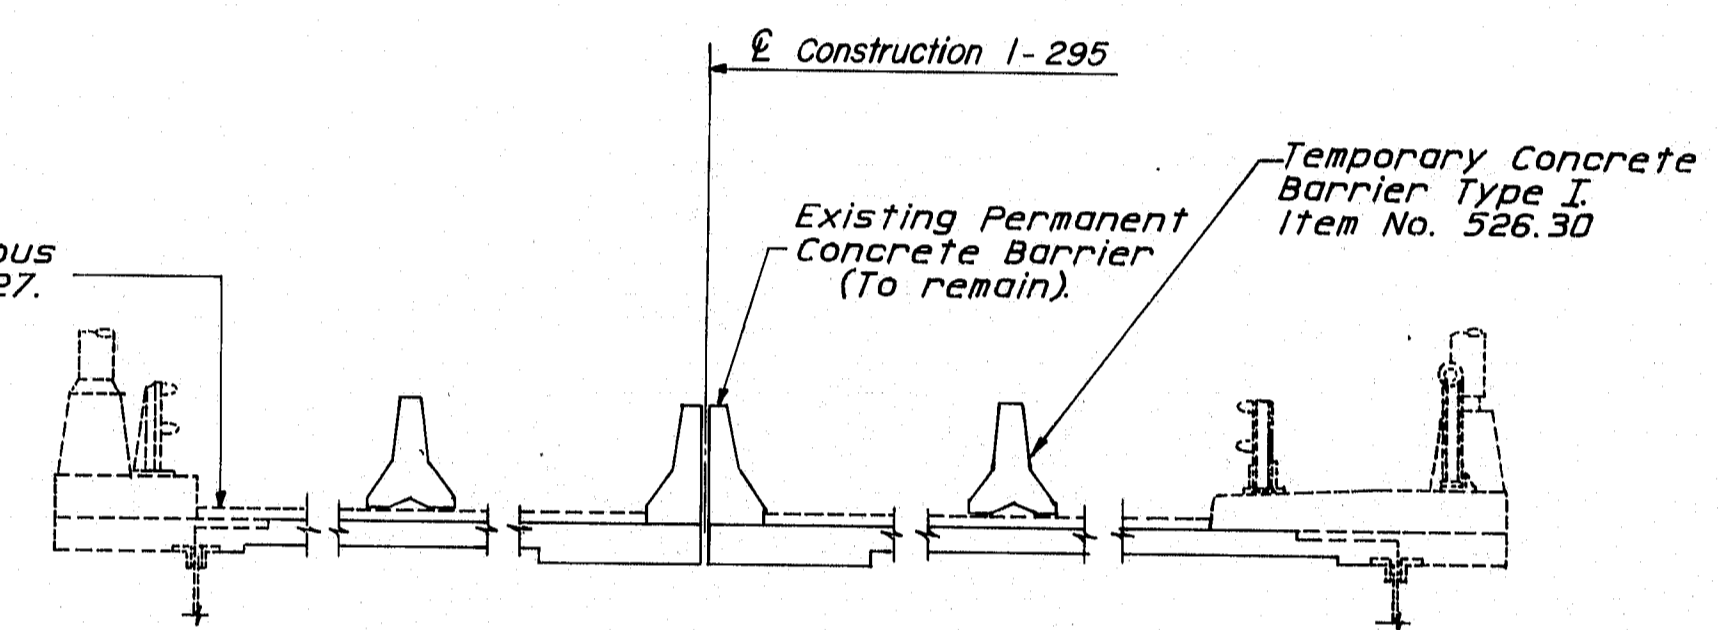

EXISTING BRIDGE SECTION

Girders not shown for clarity.

Payment for the removal of existing bridge railing, existing Light Standard, existing sidewalk concrete and slab concrete shall be considered incidental to Item 202.128. Removal of existing concrete curbs and sidewalks, (Typ.) Bridge rail and light standards shall be salvaged and stacked, property of MDOT.

LEGEND

- Denotes Direction of Traffic
- - - Denotes Limit of Rehab.
- - - Denotes Concrete Chop out
- ▬ Denotes Temporary Concrete Barrier
- Denotes Rehab. or New Deck.
- ▨ Denotes previous Rehab.

PROJECT DESIGN ENGINEER	DATE
J.F.	4/7/85
DESIGN - DETAILED	
CHECKED	
REVISIONS	
FIELD CHANGES	


103-287

STATE OF MAINE
DEPARTMENT OF TRANSPORTATION
I-295 INTERCHANGE COMPLEX
TUKEYS BRIDGE
OVER
BACK COVE
IN THE TOWN OF
PORTLAND
CUMBERLAND COUNTY
SEQUENCE OF CONSTRUCTION

REINFORCING STEEL SCHEDULE

STRAIGHT BARS										BENT BARS													
MARK	NO.	LENGTH	LOCATION	MARK	NO.	LENGTH	LOCATION	MARK	NO.	LENGTH	TYPE	A	B	C	D	E	F	G	H	O	R	LOCATION	
ABUTMENT 1				ABUTMENT 2				ABUTMENT 1															
A401	26	6'-6"	Wingwall Footing	A401	26	6'-6"	Wingwall Footing	A416	2	12'-6"	L	1'-0"	11'-6"										Backwall
A402			Cancelled	A402			Cancelled																
A403	32	12'-9"	Wingwall Footing	A403	32	12'-9"	Wingwall Footing																
A404	24	4'-8"	Abutment Footing	A404	24	4'-8"	Abutment Footing	A503	21	9'-11"	S	0"	4'-0"	1'-11"	4'-0"								Wingwall Stem
A405	12	9'-3"	Abutment Footing	A405	12	9'-3"	Abutment Footing	A504															Cancelled
A406	37	17'-4"	Abutment Footing	A406	37	17'-4"	Abutment Footing	A505	10	7'-8" to 11'-8"	SL	0"	3'-11" to 5'-11"	1'-6"	3'-11" to 5'-11"								Wingwall Stem Incr. 2 ea. by 6"
A407	37	31'-6"	Abutment Footing	A407	37	31'-6"	Abutment Footing	A511	50	15'-2"	A	4'-4"	6'-8"	4'-2"	1'-0"	0"	0"	0"					Abutment Footing
A408	16	19'-9"	Wingwall Stem	A408	16	19'-9"	Wingwall Stem	A512	50	13'-9"	A	0"	4'-2"	5'-3"	0"	4'-4"	1'-0"	0"					Abutment Footing
A409	12	15'-0" to 19'-0" Incr. 4 ea. by 2'-0"	Wingwall Stem	A409	12	15'-4" to 19'-4" Incr. 4 ea. by 2'-0"	Wingwall Stem	A513	47	13'-2"	S	0"	9'-3"	1'-0"	2'-11"								Backwall
A410	12	14'-9"	Wingwall Stem	A410	12	14'-9"	Wingwall Stem	A514	47	7'-10"	A	0"	0"	9"	0"	2'-9"	6"	4'-4"					Backwall
A411	12	12'-3"	Wingwall Stem	A411	12	12'-3"	Wingwall Stem																
A412	4	5'-9"	Wingwall Stem	A412	4	5'-9"	Wingwall Stem																
A413	17	5'-4"	Abutment Footing	A413	17	5'-4"	Abutment Footing																
A414	8	4'-0"	Backwall	A414	8	4'-0"	Backwall																
A415	8	2'-6"	Backwall	A415	8	2'-6"	Backwall	A416	2	12'-6"	L	1'-0"	11'-6"										Backwall
A416	86	3'-0"	Abutment Dowel	A516	86	3'-0"	Abutment Dowel																
A501	26	6'-6"	Wingwall Footing	A501	26	6'-6"	Wingwall Footing	A503	21	9'-11"	S	0"	4'-0"	1'-11"	4'-0"								Wingwall Stem
A502	158	5'-0"	Footings - Dowels	A502	158	5'-0"	Footings - Dowels	A504															Cancelled
A506	52	11'-11"	Wingwall Stem	A506	52	11'-11"	Wingwall Stem	A505	10	9'-6" to 13'-6"	SL	0"	4'-0" to 6'-0"	1'-6"	4'-0" to 6'-0"								Wingwall Stem Incr. 2 ea. by 6"
A507	12	9'-2"	Wingwall Stem	A507	12	9'-2"	Wingwall Stem	A511	50	15'-2"	A	4'-4"	6'-8"	4'-2"	1'-0"	0"	0"	0"					Abutment Footing
A508	4	17'-4"	Abutment Footing	A508	4	17'-4"	Abutment Footing	A512	50	13'-9"	A	0"	4'-2"	5'-3"	0"	4'-4"	1'-0"	0"					Abutment Footing
A509	4	31'-6"	Abutment Footing	A509	4	31'-6"	Abutment Footing	A513	47	12'-11"	S	0"	9'-0"	1'-0"	2'-11"								Backwall
A510	4	16'-3"	Abutment Footing	A510	4	16'-3"	Abutment Footing	A514	47	7'-10"	A	0"	0"	9"	0"	2'-9"	6"	4'-4"					Backwall

PRWA	STATE	PROJECT NUMBER	SHEET NO.	TOTAL SHEETS
1	MAINE	IR-295-3(94)50	26	120

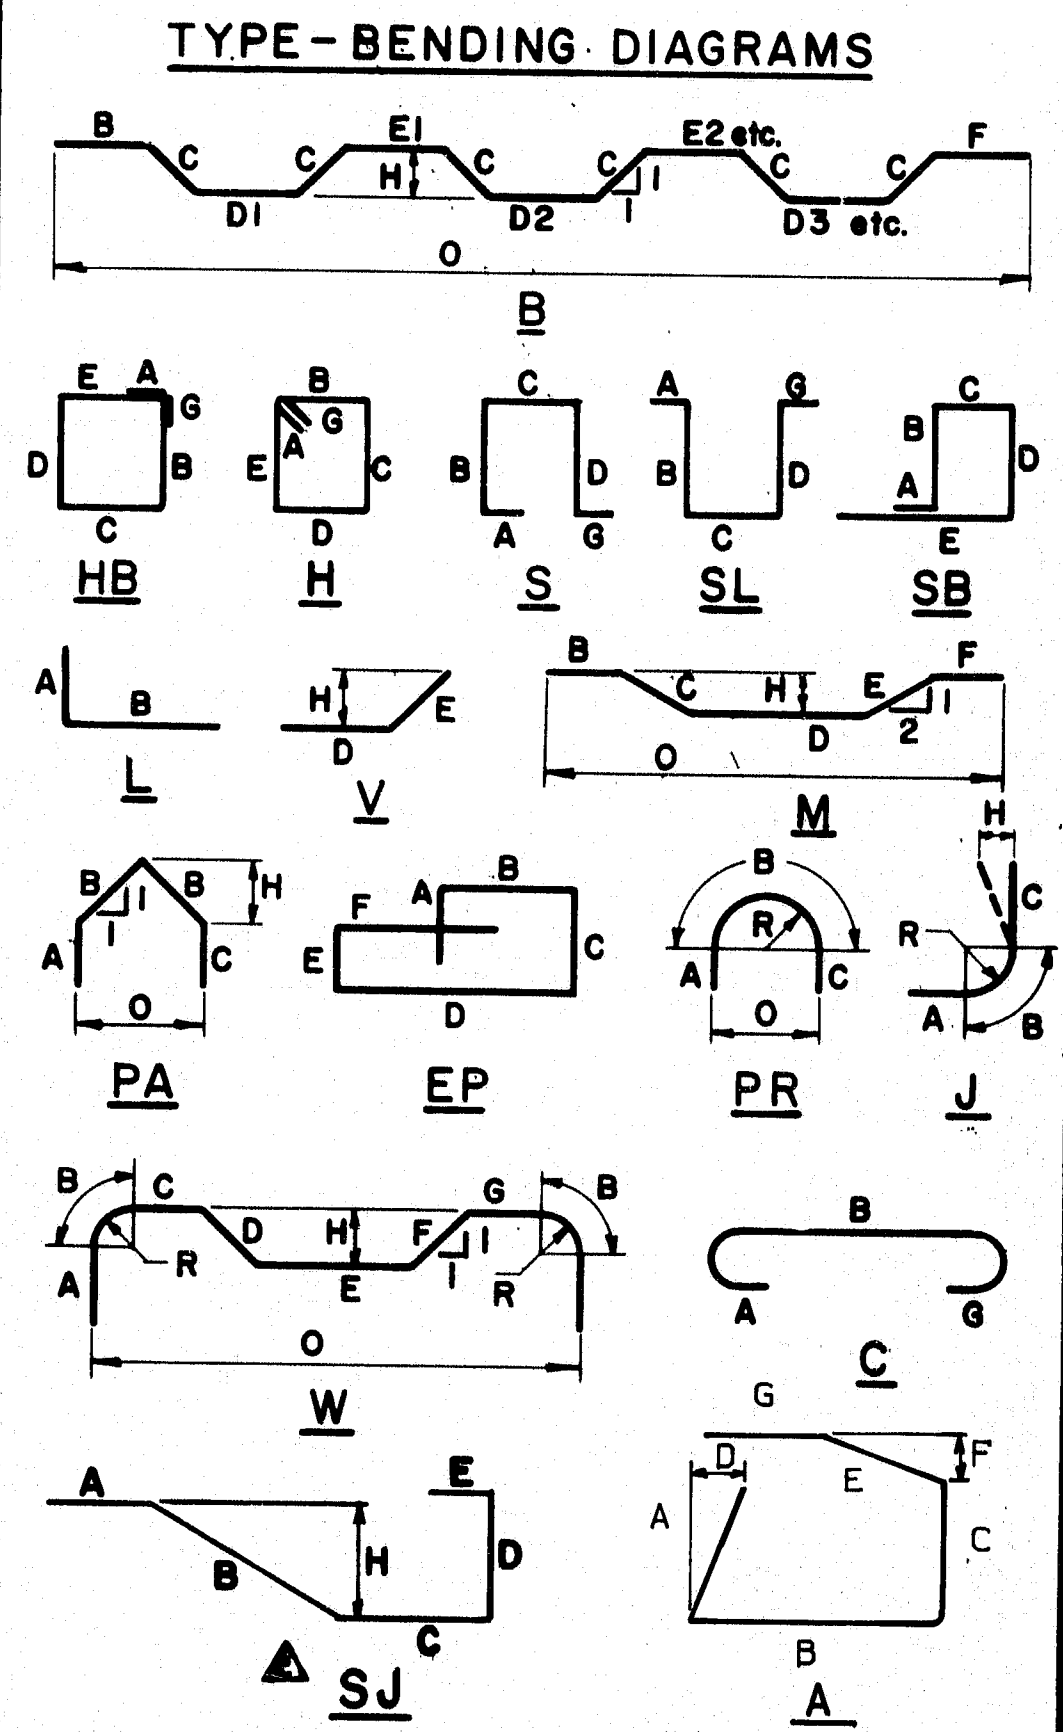

All dimensions are out to out of reinf. bar
 Bending details and hooks shall conform to the recommendations of the current revision of ACI Standard 318. Δ
 Reinforcing Bar: ASTM A615 Grade 60

- GENERAL NOTES**
- First digit(s) following the letter of the Mark indicates size of reinf. bar.
 Mark (A 502) bar size - #5
 Mark (P 100) bar size - #10
 Mark (S 603) bar size - #6
 - Each truss bar, Type B, may be replaced by two (2) straight bars (one top & one bottom) of the same bar size as the truss bar. Payment in either case shall be based on truss bars as scheduled on plans.

103-288
 New Bent Bar Type S3 9-26-83
 Revised ACI Standard 5-12-83

REVISIONS	DATE
STATE OF MAINE DEPARTMENT OF TRANSPORTATION	
1-295 INTERCHANGE COMPLEX TUKEYS BRIDGE OVER BACK COVE IN THE TOWN OF PORTLAND CUMBERLAND COUNTY REINFORCING SCHEDULE - 1	
SHEET 22 OF 35 AUGUSTA, MAINE	

DESIGN - DETAIL	DATE
CHECKED	BY
REVISIONS	CFK
FIELD CHANGES	JDD
	2-85
PLANS	


REINFORCING STEEL SCHEDULE

STRAIGHT BARS												BENT BARS														
MARK	NO.	LENGTH	LOCATION	MARK	NO.	LENGTH	LOCATION	MARK	NO.	LENGTH	LOCATION	MARK	NO.	LENGTH	TYPE	A	B	C	D	E	F	G	H	O	R	LOCATION
PIER 1 NORTHBOUND												PIER 1 NORTHBOUND														
	P501	8	13'-6"	Pier Cap		P701	8	15'-2"	C	10"	13'-6"														Pier Cap	
	P503	2	11'-0"	Pier Cap		P502	10	10'-6"	S	0"	2'-3"	6'-0"	2'-3"													Pier Cap
	P505	13	13'-0"	Distribution Slab		P504	4	14'-0"	D	3'-9"	6'-6"	3'-9"	1'-6"	1'-6"												Pier Cap
	P506	14	12'-0"	Distribution Slab		P508	6	7'-4"	S	0"	1'-10"	3'-8"	1'-10"													Pier pad
	P507	6	2'-6"	Pier Pad																						
	P901	36	39'-0"	Column																						
	P801	13	13'-0"	Distribution Slab		P902	36	11'-3"	C	1'-3"	10'-0"															Distribution Slab
	P802	20	12'-0"	Distribution Slab		P401	4	21'-6"	H	6"	4'-3"	6'-0"	4'-3"	6'-0"												Pier Cap
						P402	20	18'-6"	H	6"	4'-3"	4'-6"	4'-3"	4'-6"												Pier Cap
																										Incr. Ea. @ 4 1/2"
						P403	36	21'-0"	H	6"	5'-0"	5'-0"	5'-0"	5'-0"												Column
						P404	144	6'-6"	C	6"	5'-6"															Column

REINFORCING STEEL SCHEDULE

STRAIGHT BARS												BENT BARS															
MARK	NO.	LENGTH	LOCATION	MARK	NO.	LENGTH	LOCATION	MARK	NO.	LENGTH	LOCATION	MARK	NO.	LENGTH	TYPE	A	B	C	D	E	F	G	H	O	R	LOCATION	
<i>SUPERSTRUCTURE</i>												<i>APPROACH SLAB</i>															
S501	502	23'-0"	Transverse - Slab (N.B.)	AS401	32	19'-0"	Transverse - N.B.	EP401	16	1'-10"	End Post Dowels	S505	499	23'-10"	B		4'-5"	8'-2"	3'-11"	4'-0"	4'-9"			6"	23'-0"	Transverse - Slab (N.B.)	
S502	502	20'-7"	Transverse - Slab (N.B.)	AS402	32	26'-0"	Transverse - S.B.	EP405	8	1'-5"	End Post (2 bar)	S506	997	13'-11 1/2"	M		4'-5"	1'-0 3/4"	3'-5"	1'-0 3/4"	4'-0"			9"	13'-4"	Transverse - Slab (N.B.)	
S503	502	37'-2"	Transverse - Slab (S.B.)	AS403	12	4'-6"	Transverse - S.B.	EP407			Canceled	S507	499	38'-7 1/8"	B		4'-7"	7'-8"	3'-6"	3'-8"	4'-3"			5"	37'-2"	Transverse - Slab (S.B.)	
S504	502	34'-9"	Transverse - Slab (S.B.)									S508	997	12'-10 3/4"	M		3'-8"	11'-3 8"	3'-6"	11'-3 8"	4'-3"			8"		Transverse - Slab (S.B.)	
S509	12	8'-9"	Transverse - Slab (N.B.)									SS12	88	3'-6"	SJ	0"	1'-2"	11"	10"	7"				10"		End of Slab	
S510	24	7'-10"	Transverse - Slab (S.B.)	AS501	12	18'-3"	Bikeway					SS14	1002	4'-1"	L	10"	3'-3"										Traffic Barrier
S513	10	52'-9"	Traffic Barrier	AS503	4	18'-3"	Approach Barrier	EP508	8	4'-0"	End Post (2,3 & 4 bar)	SS15	500	5'-8"	S	10"	1'-6"	1'-0"	1'-6"					10"			Curb
S517	111	36'-0"	Longitudinal - Slab	AS504	10	19'-9"	Approach Barrier					SS16	168	2'-3"	S	0"	1'-0"	3"	1'-0"								End of Slab (SB&NB)
S519	16	45'-0"	End of Slab (SB&NB)	AS505			Canceled																				
S601	231	60'-0"	Over Piers	AS601	164	14'-6"	Longitudinal																				
S602	154	12'-3"	Over Piers	AS602	20	20'-3"	Longitudinal - S.B.																				
S603	77	13'-3"	Over Piers									AS502	38	5'-1"	SB	0"	2'-2"	9"	2'-2"								Bikeway
S519	10	22'-6"	Traffic Barrier									AS506															Canceled
												AS507	38	7'-6"	S		3'-6"	6"	3'-6"								Approach Barrier

F.R.S.A. REG. NO.	STATE	PROJECT NUMBER	SHEET NO.	TOTAL SHEETS
1	MAINE	12-292-3(94)50	40	130

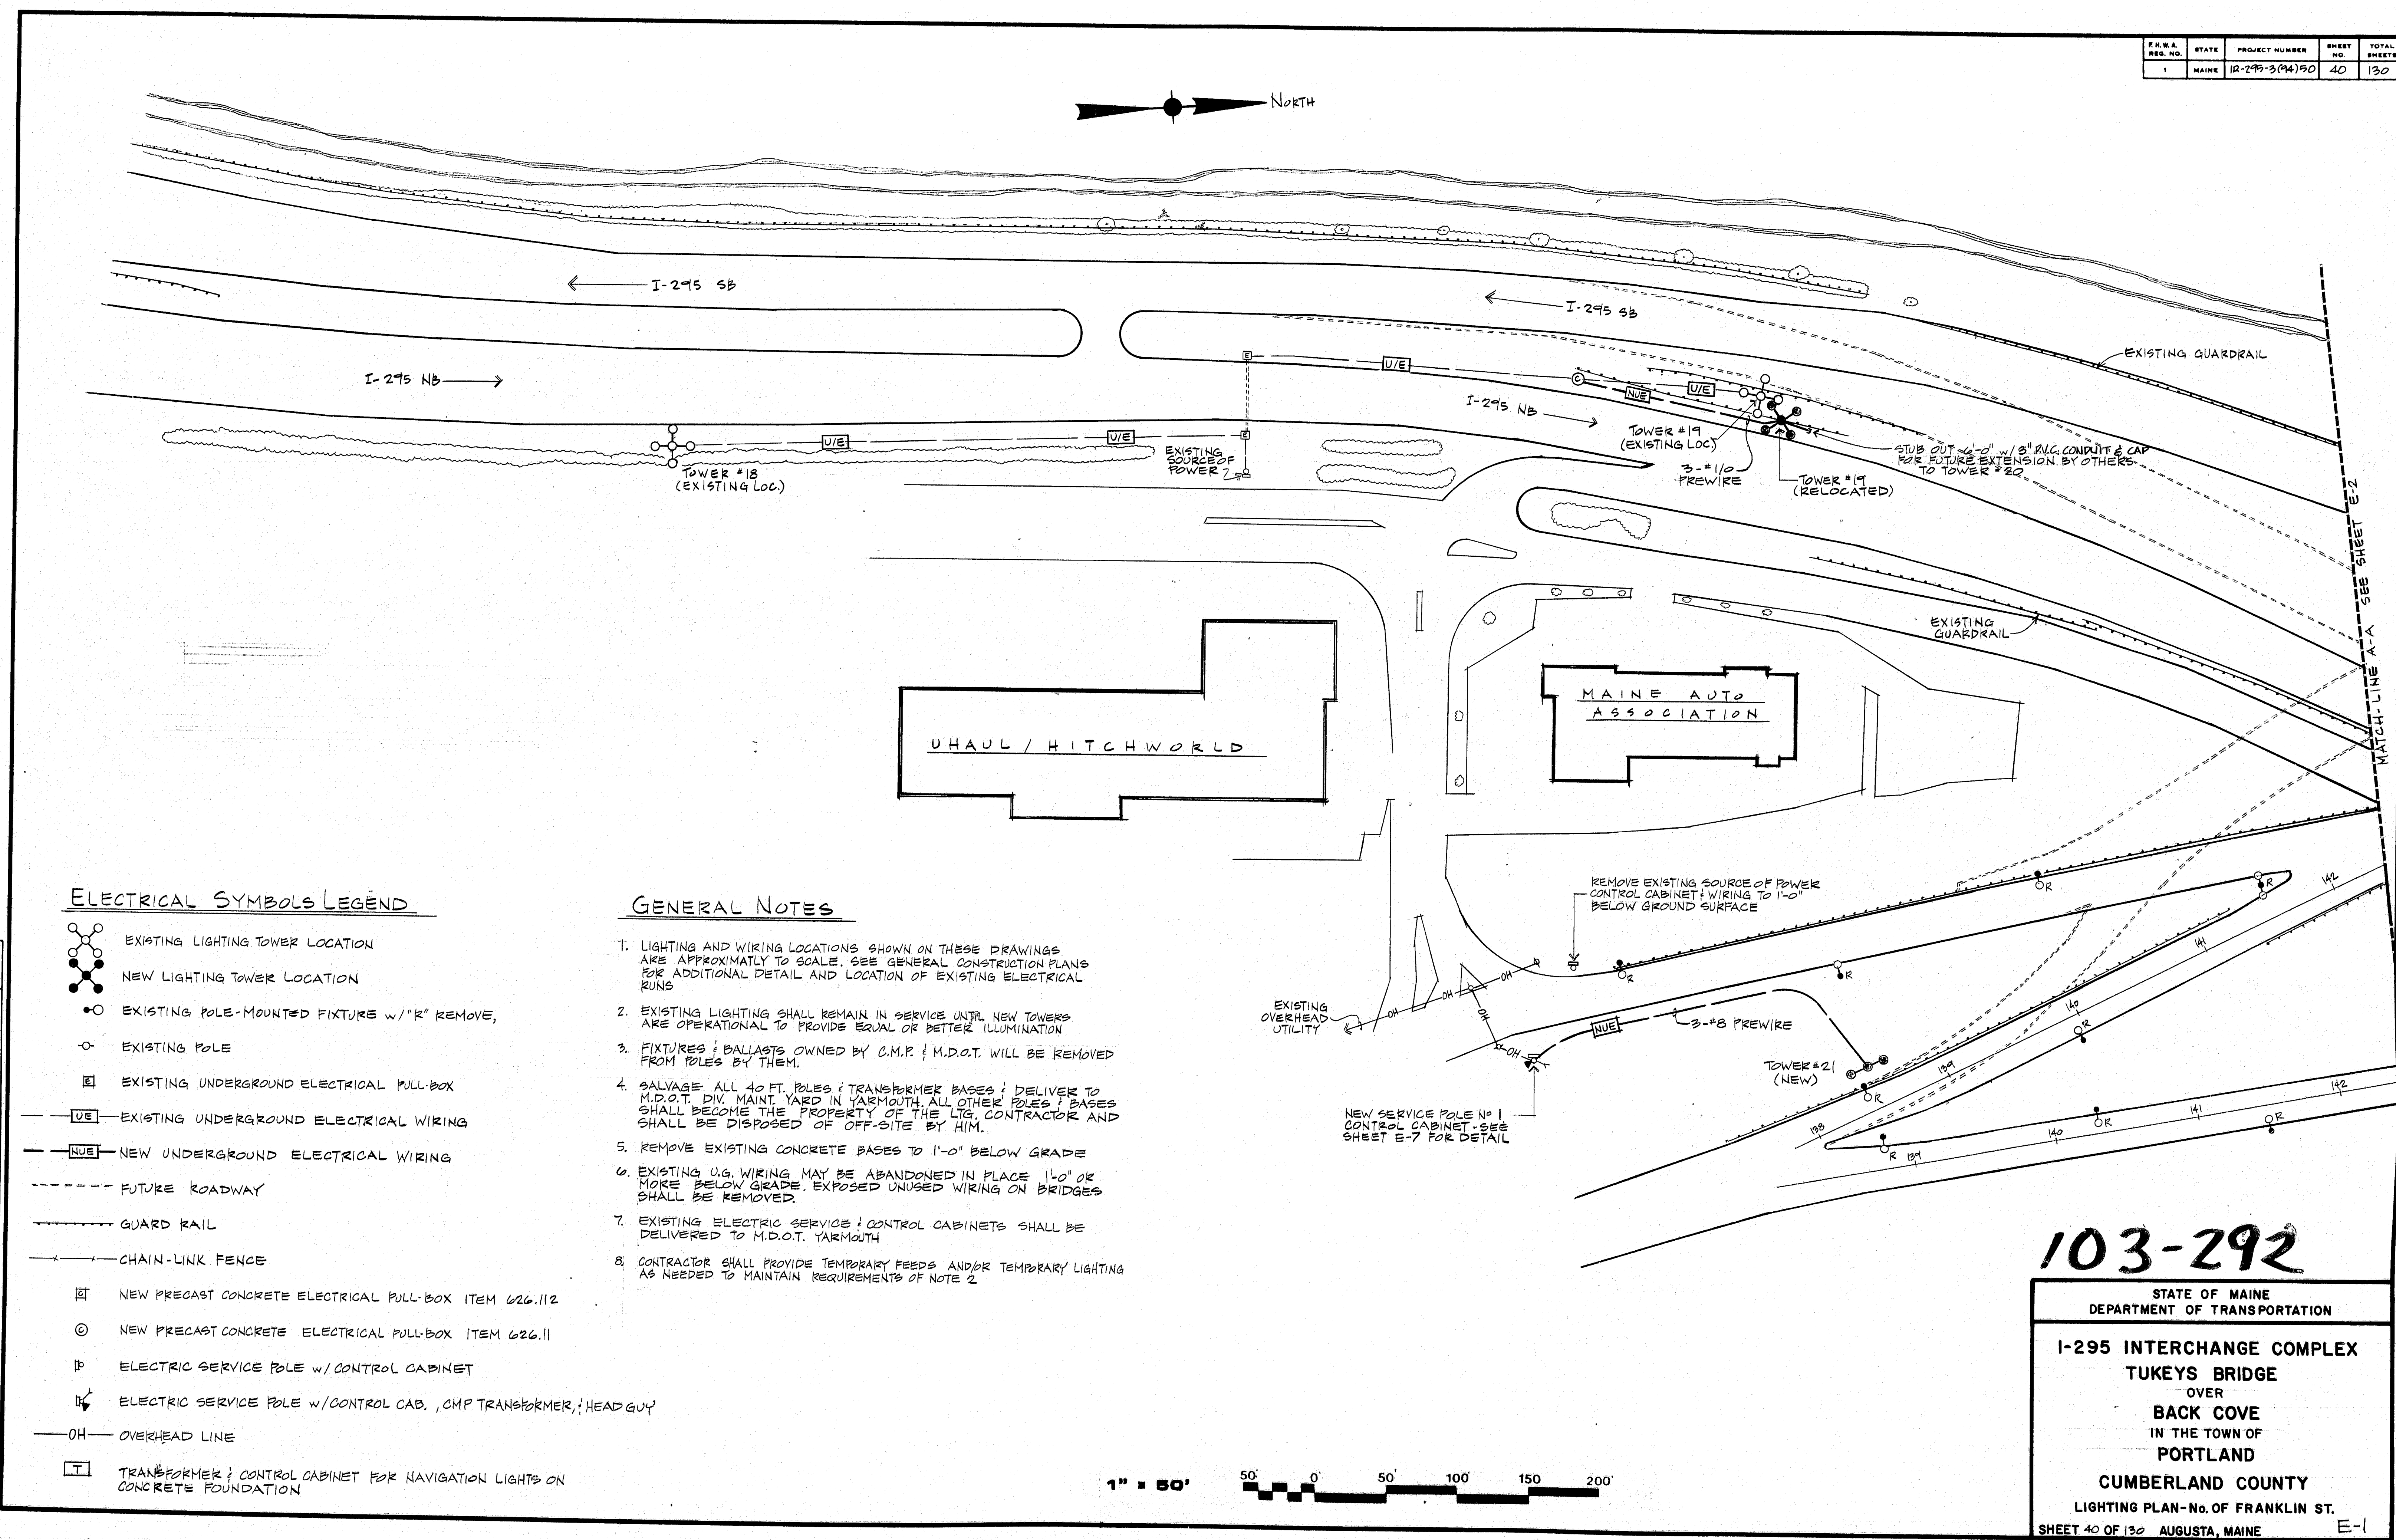

ELECTRICAL SYMBOLS LEGEND

- EXISTING LIGHTING TOWER LOCATION
- NEW LIGHTING TOWER LOCATION
- EXISTING POLE-MOUNTED FIXTURE W/ "R" REMOVE
- EXISTING POLE
- EXISTING UNDERGROUND ELECTRICAL PULL-BOX
- EXISTING UNDERGROUND ELECTRICAL WIRING
- NEW UNDERGROUND ELECTRICAL WIRING
- FUTURE ROADWAY
- GUARD RAIL
- CHAIN-LINK FENCE
- NEW PRECAST CONCRETE ELECTRICAL PULL-BOX ITEM 626.112
- NEW PRECAST CONCRETE ELECTRICAL PULL-BOX ITEM 626.11
- ELECTRIC SERVICE POLE W/ CONTROL CABINET
- ELECTRIC SERVICE POLE W/ CONTROL CAB., CMP TRANSFORMER, HEAD GUY
- OVERHEAD LINE
- TRANSFORMER & CONTROL CABINET FOR NAVIGATION LIGHTS ON CONCRETE FOUNDATION


GENERAL NOTES

1. LIGHTING AND WIRING LOCATIONS SHOWN ON THESE DRAWINGS ARE APPROXIMATELY TO SCALE. SEE GENERAL CONSTRUCTION PLANS FOR ADDITIONAL DETAIL AND LOCATION OF EXISTING ELECTRICAL RUNS
2. EXISTING LIGHTING SHALL REMAIN IN SERVICE UNTIL NEW TOWERS ARE OPERATIONAL TO PROVIDE EQUAL OR BETTER ILLUMINATION
3. FIXTURES & BALLASTS OWNED BY C.M.P. / M.D.O.T. WILL BE REMOVED FROM POLES BY THEM.
4. SALVAGE ALL 40 FT. POLES & TRANSFORMER BASES & DELIVER TO M.D.O.T. DIV. MAINT. YARD IN YARMOUTH. ALL OTHER POLES & BASES SHALL BECOME THE PROPERTY OF THE LIG. CONTRACTOR AND SHALL BE DISPOSED OF OFF-SITE BY HIM.
5. REMOVE EXISTING CONCRETE BASES TO 1'-0" BELOW GRADE
6. EXISTING U.G. WIRING MAY BE ABANDONED IN PLACE 1'-0" OR MORE BELOW GRADE. EXPOSED UNUSED WIRING ON BRIDGES SHALL BE REMOVED.
7. EXISTING ELECTRIC SERVICE & CONTROL CABINETS SHALL BE DELIVERED TO M.D.O.T. YARMOUTH
8. CONTRACTOR SHALL PROVIDE TEMPORARY FEEDS AND/OR TEMPORARY LIGHTING AS NEEDED TO MAINTAIN REQUIREMENTS OF NOTE 2

DATE	BY	PROJECT DESIGN ENGINEER	DESIGN - DETAILED	CHECKED	REVISIONS	FIELD CHANGES

PLANS

BRUNING 44132 (2/7/91)

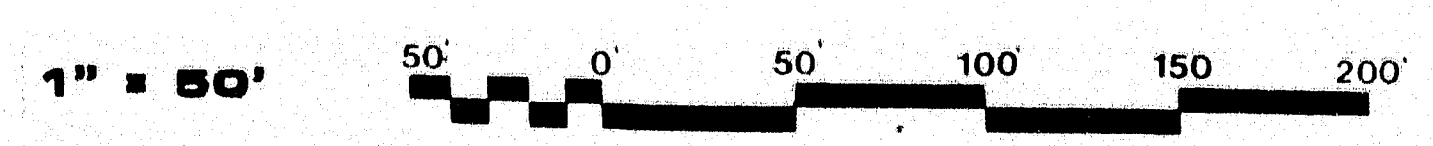


103-292

STATE OF MAINE
DEPARTMENT OF TRANSPORTATION

**I-295 INTERCHANGE COMPLEX
TUKEYS BRIDGE
OVER
BACK COVE
IN THE TOWN OF
PORTLAND
CUMBERLAND COUNTY**

LIGHTING PLAN - No. OF FRANKLIN ST.
SHEET 40 OF 130 AUGUSTA, MAINE E-1


F.R.A. NO.	STATE	PROJECT NUMBER	SHEET NO.	TOTAL SHEETS
1	MAINE	R-293-3(94)50	41	130

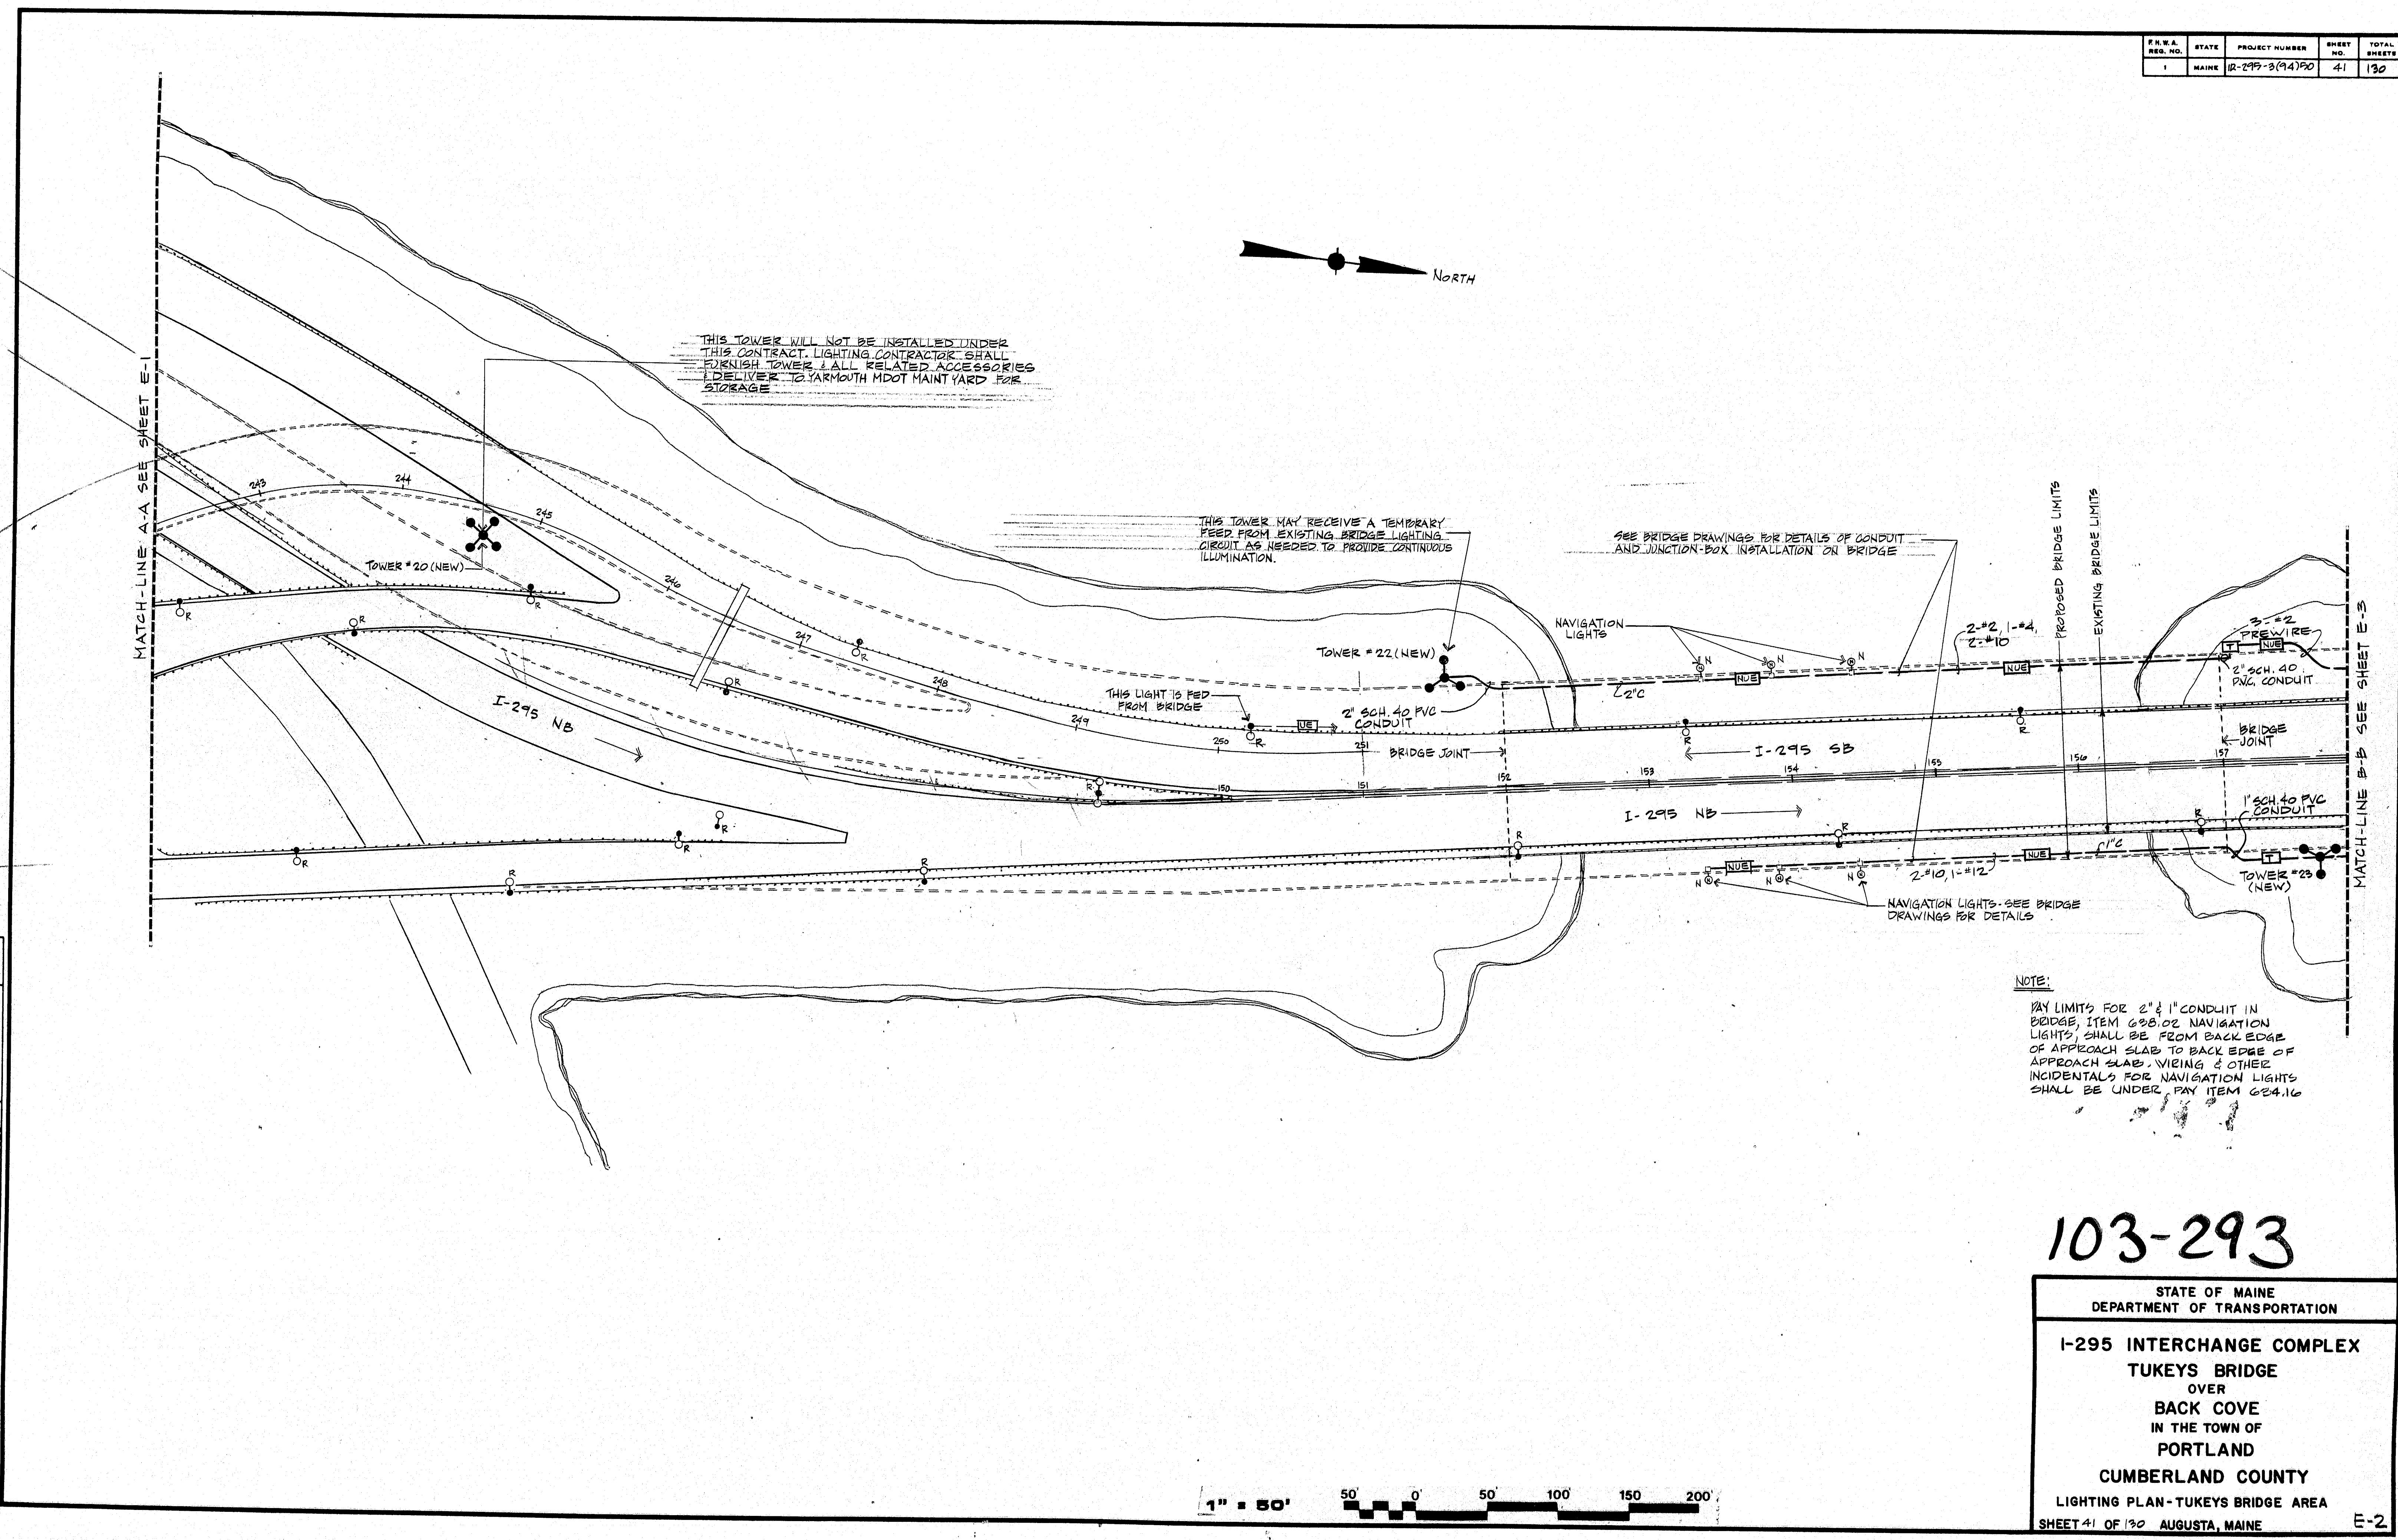

PROJECT DESIGN ENGINEER	BY	DATE
DESIGN - DETAILED		
CHECKED		
REVISIONS		
FIELD CHANGES		

PLANS

REVISION 44.13.02.01

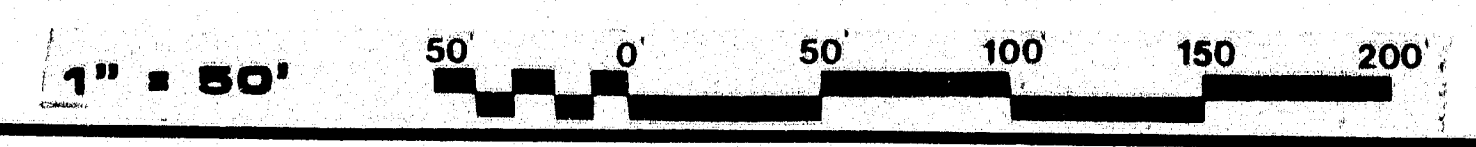



103-293

STATE OF MAINE
DEPARTMENT OF TRANSPORTATION

**I-295 INTERCHANGE COMPLEX
TUKEYS BRIDGE
OVER
BACK COVE
IN THE TOWN OF
PORTLAND
CUMBERLAND COUNTY**

LIGHTING PLAN - TUKEYS BRIDGE AREA
SHEET 41 OF 130 AUGUSTA, MAINE E-2

F.R.W.A. PER. NO.	STATE	PROJECT NUMBER	SHEET NO.	TOTAL SHEETS
1	MAINE	103-294-2(94)100	42	130

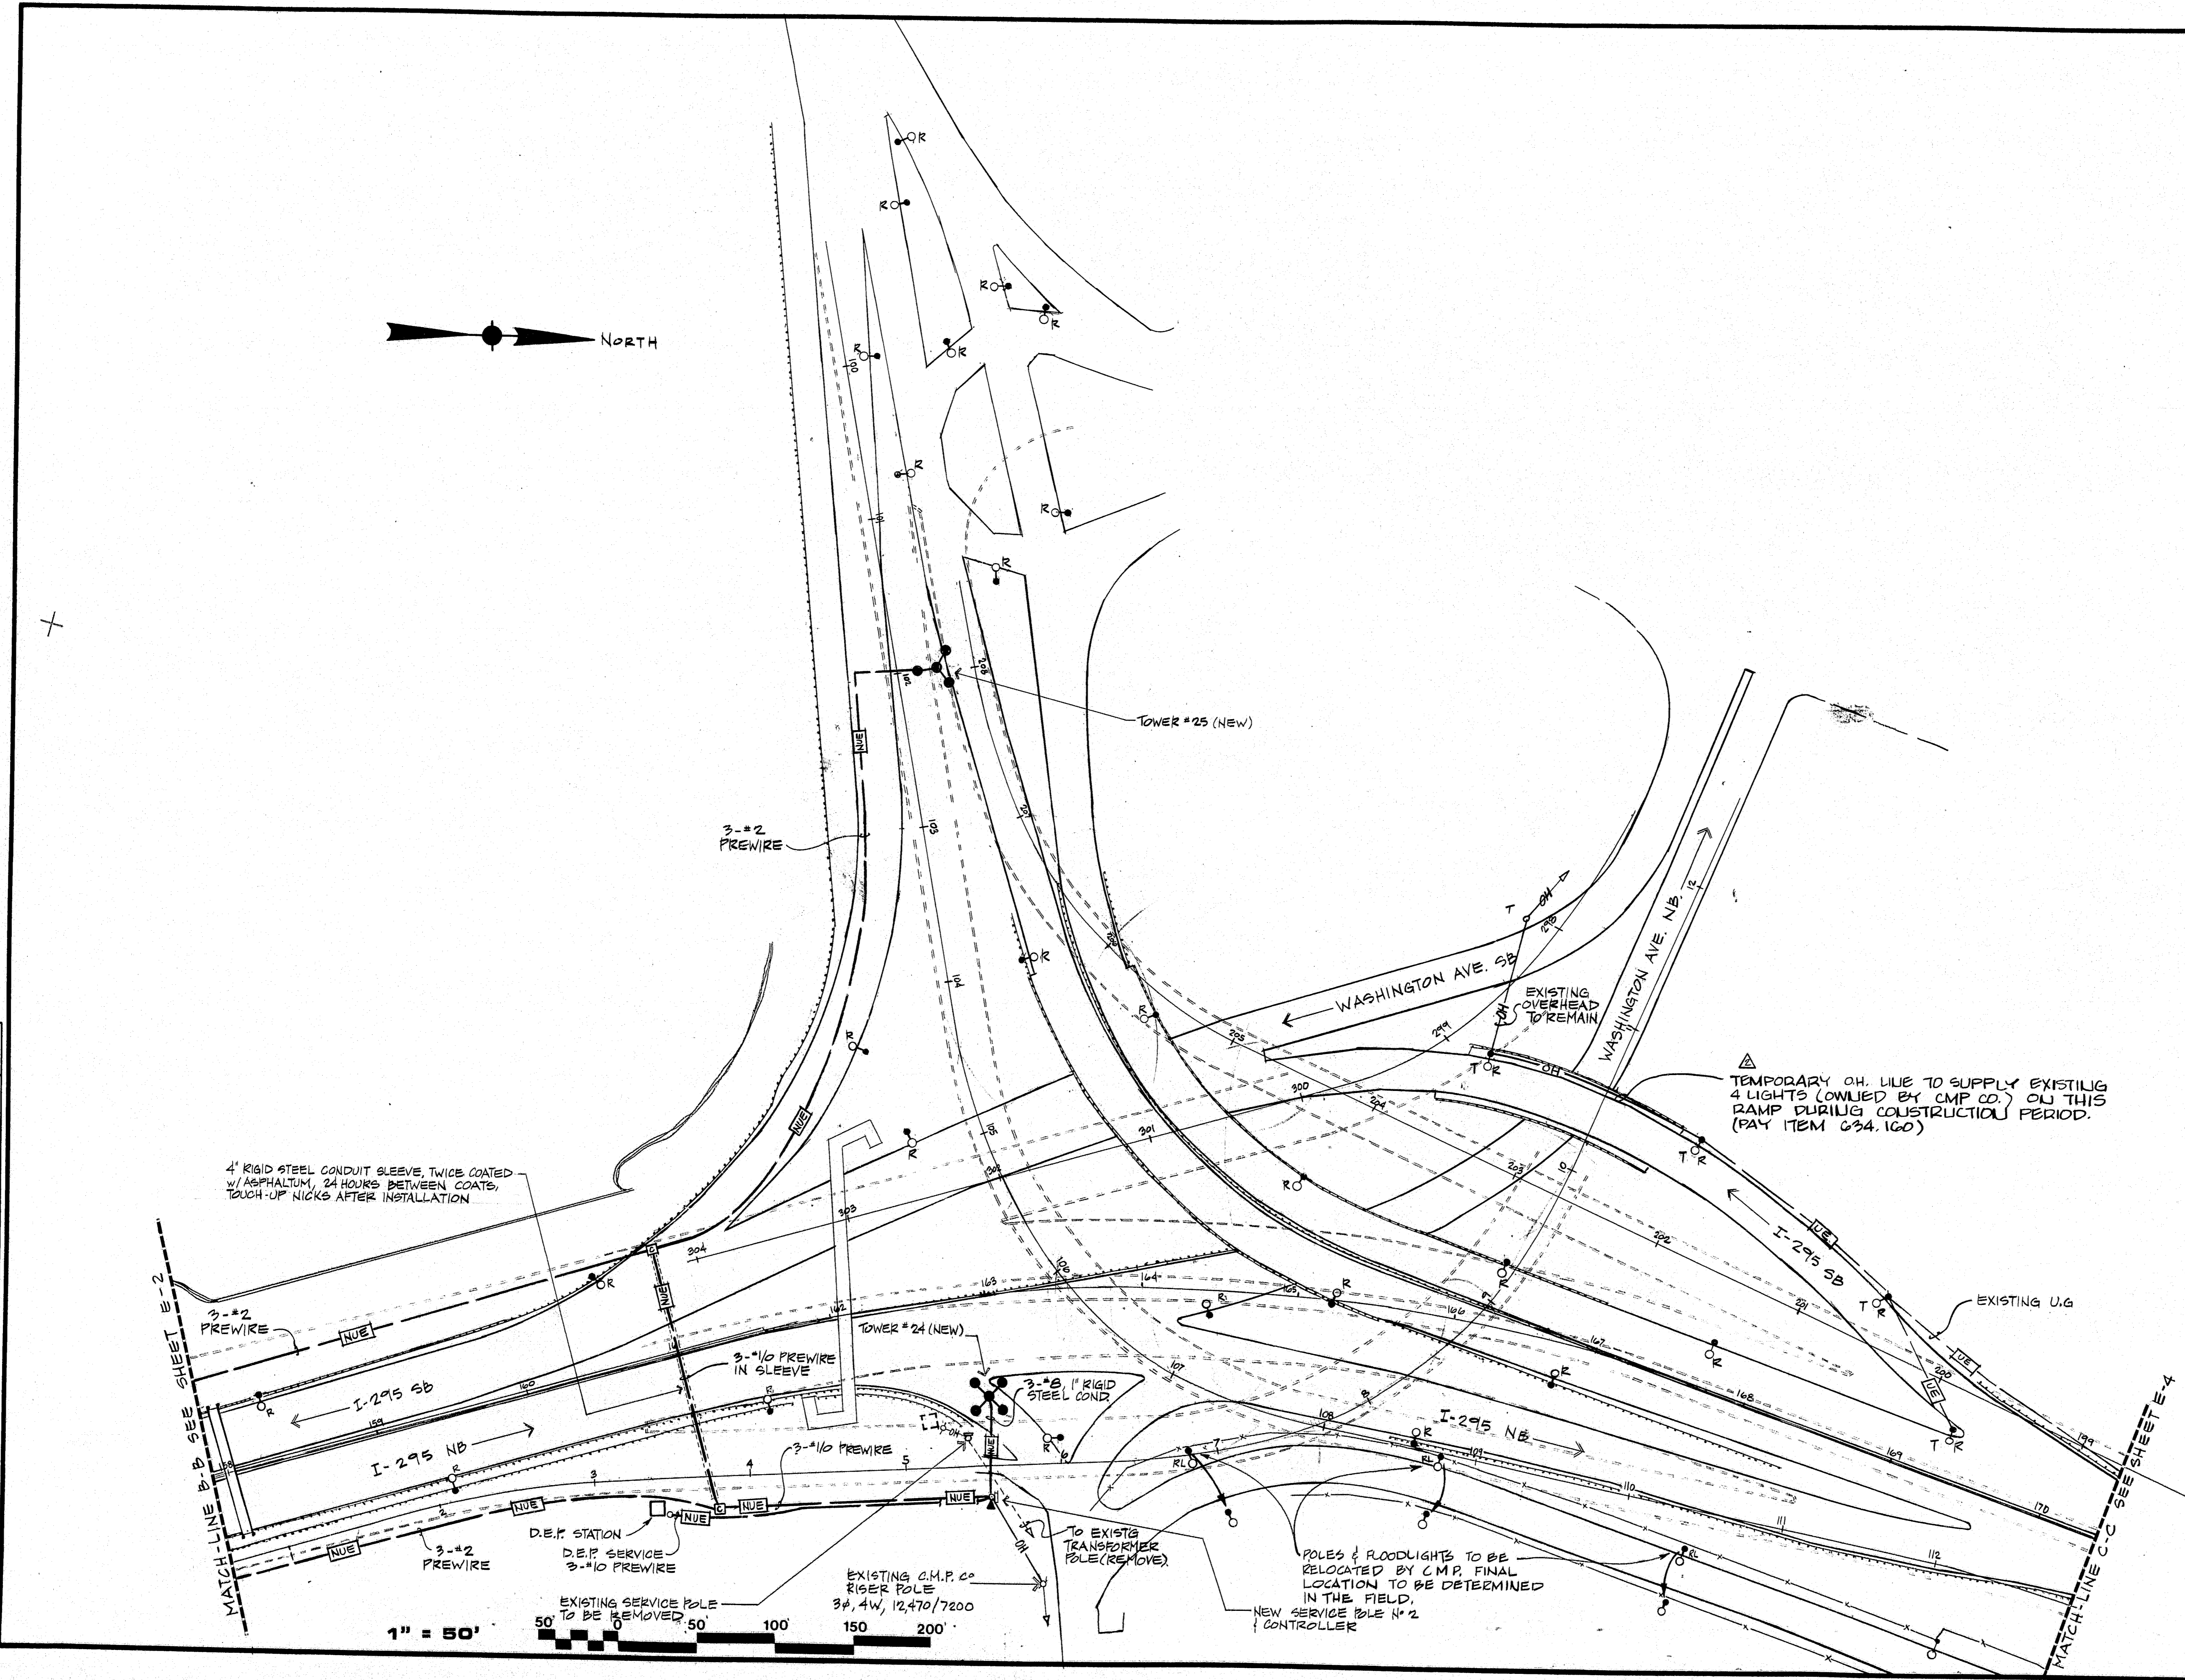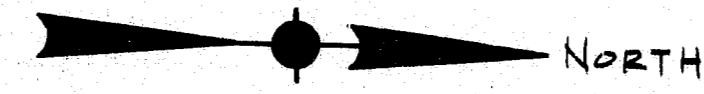

PROJECT DESIGN ENGINEER	BY	DATE
DESIGNED		
DRAWN		
CHECKED		
REVISIONS		
FIELD CHANGES		

PLANS

BRUNING 44132 07/01

103-294



REV.	DESCRIPTION	BY	DATE
1	ADDENDUM 1	S.S.A.	6-12-85
2	WILLOW CONDUIT LOCATION REV.	S.S.S.	6-12-85

STATE OF MAINE
DEPARTMENT OF TRANSPORTATION

**1-295 INTERCHANGE COMPLEX
TUKEYS BRIDGE
OVER
BACK COVE
IN THE TOWN OF
PORTLAND
CUMBERLAND COUNTY**

LIGHTING PLAN-INTERCHANGE AREA
SHEET 42 OF 130 AUGUSTA, MAINE E-3

F.R.A. REG. NO.	STATE	PROJECT NUMBER	SHEET NO.	TOTAL SHEETS
1	MAINE	IR-295-3(04)50	43	130

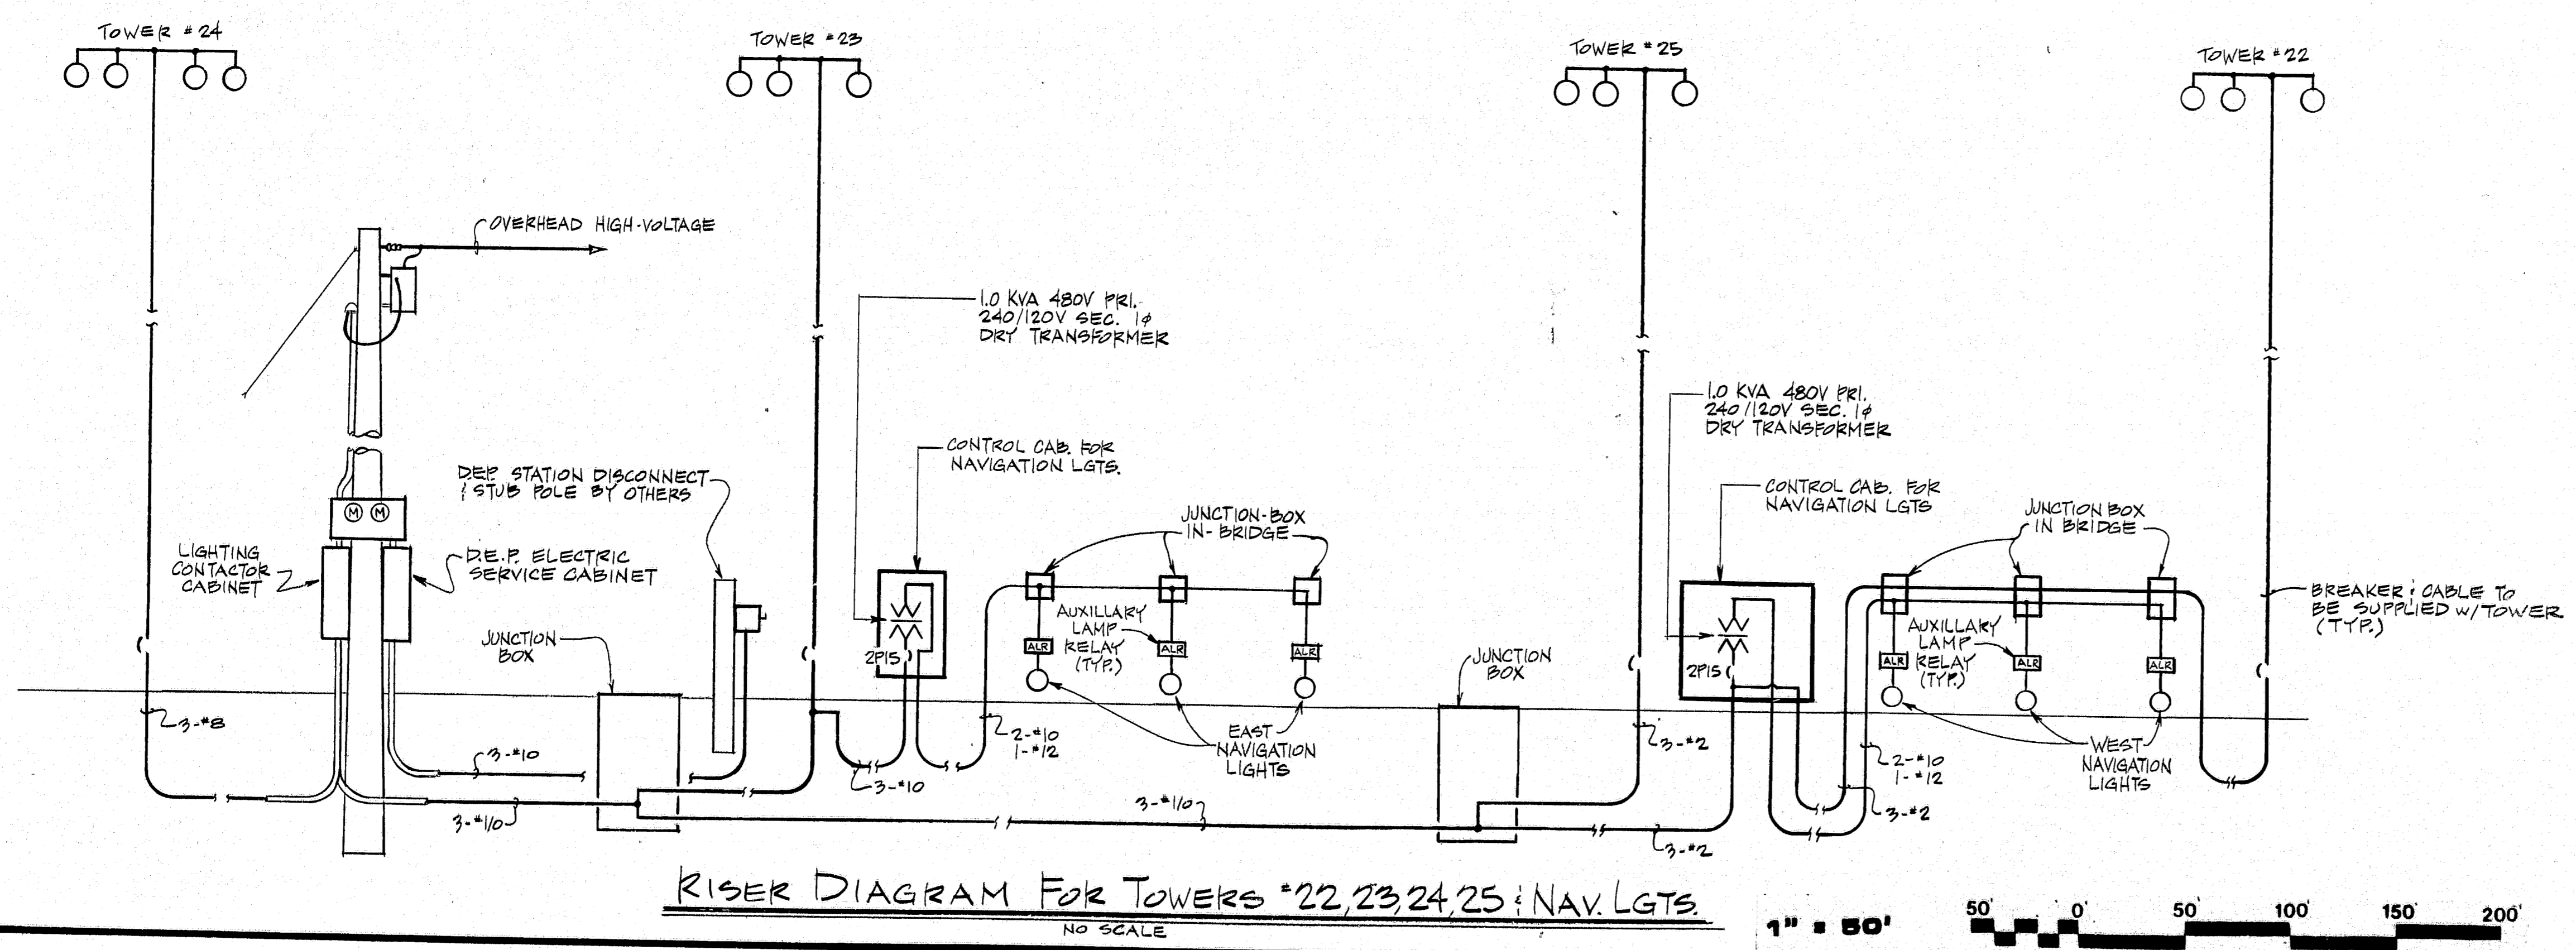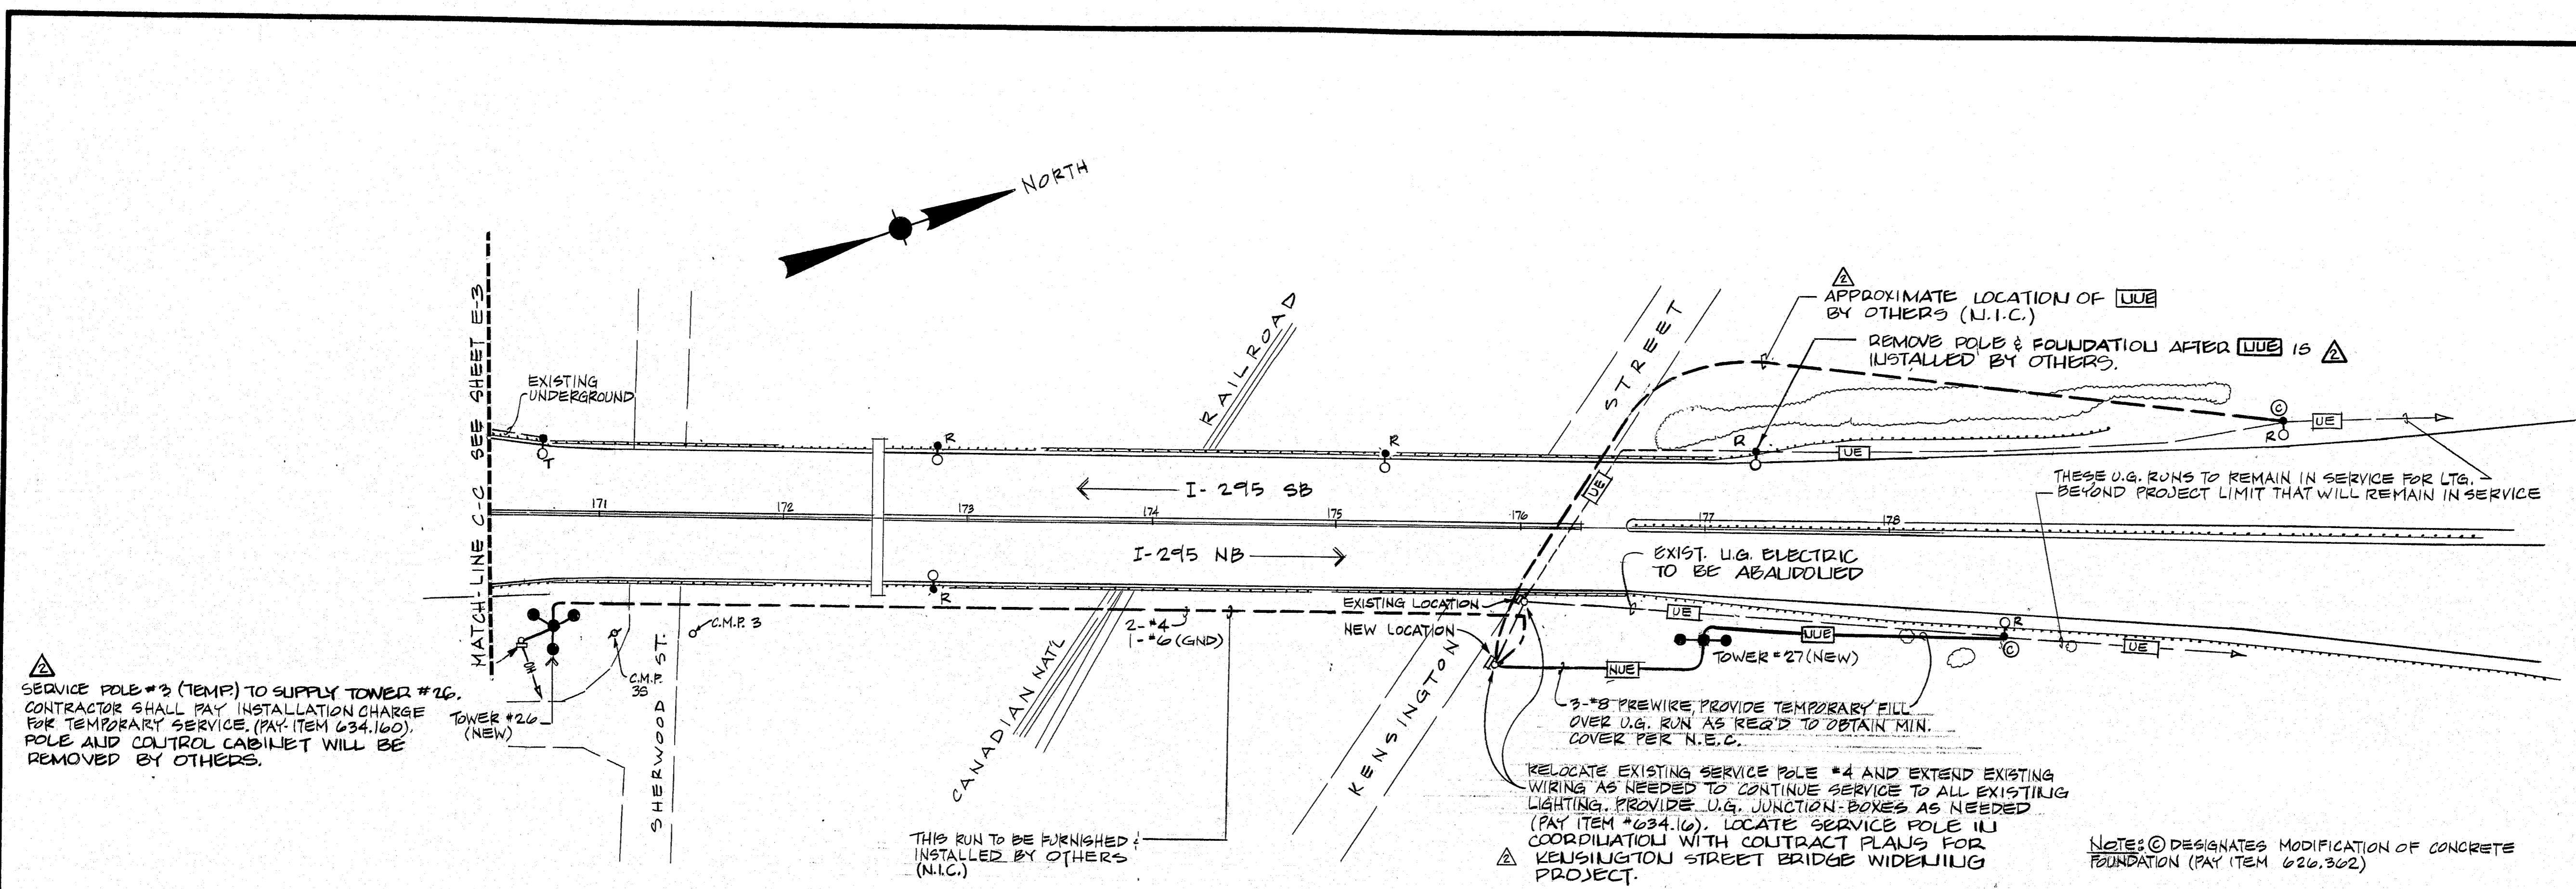

RISER DIAGRAM FOR TOWERS #22, 23, 24, 25 & NAV. LGTS.
NO SCALE




PROJECT DESIGN ENGINEER	DATE
BY	
DESIGN - DETAILED	
CHECKED	
REVISIONS	
FIELD CHANGE	

103-295

REV.	DESCRIPTION	BY	DATE
△	ADDENDUM 1	SSS	6-12-85
△	MAJOR CONDUIT LOCATION REV.	SSS	6-12-85


STATE OF MAINE
DEPARTMENT OF TRANSPORTATION
I-295 INTERCHANGE COMPLEX
TUKEYS BRIDGE
OVER
BACK COVE
IN THE TOWN OF
PORTLAND
CUMBERLAND COUNTY
LIGHTING PLAN - SHERWOOD ST./KENSINGTON ST.
SHEET 43 OF 130 AUGUSTA, MAINE E-4

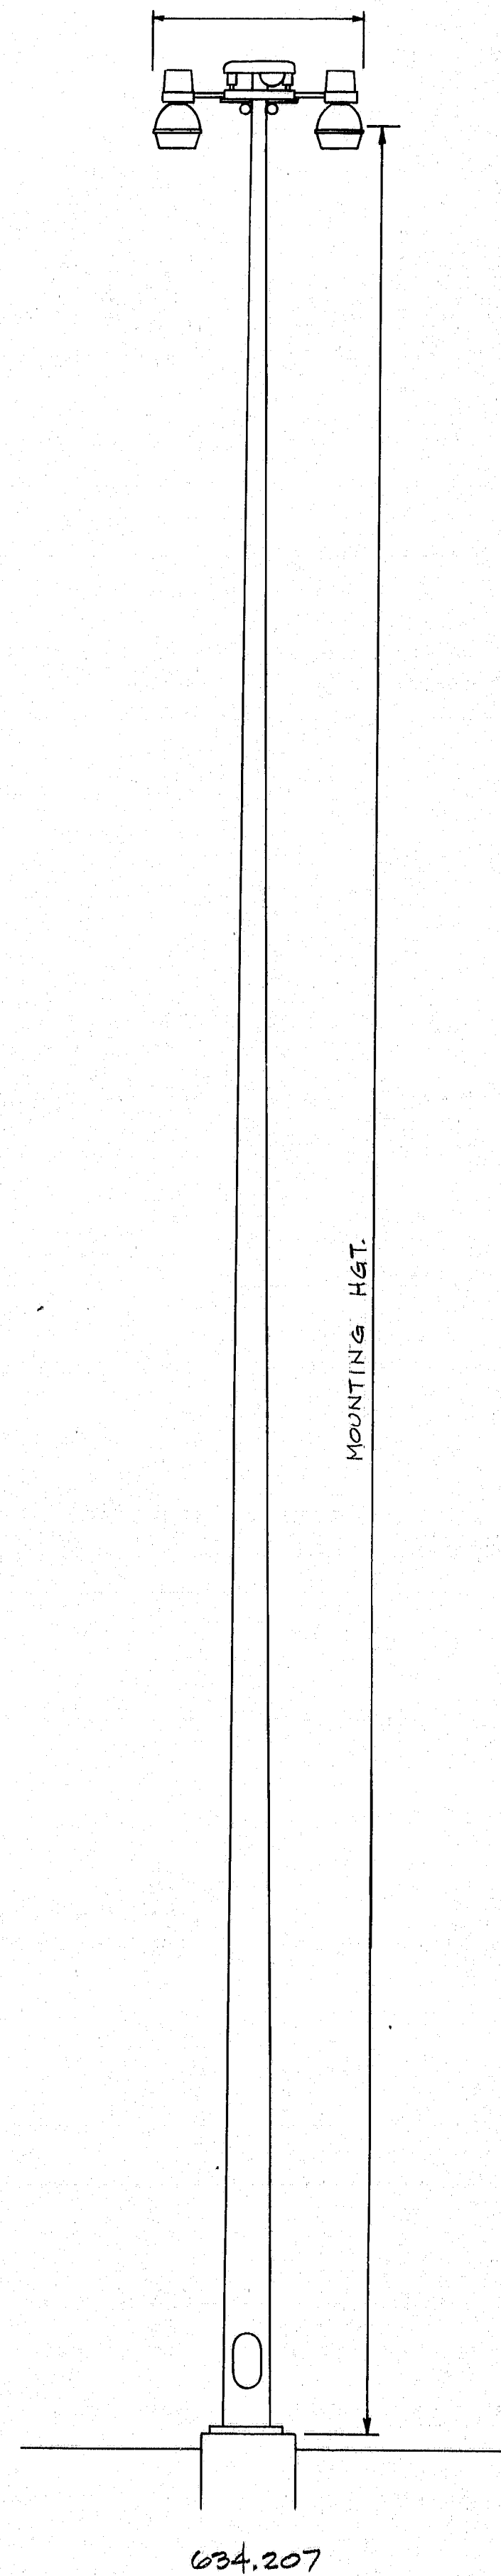


LIGHTING TOWER SCHEDULE

TOWER NO.	HGT (FT)	LOCATION STATION	OFFSET	LUMINAIRE QTY.	WATTS	DISTRIB.	REMARKS
19	100'	437+50	10' LT	4	1000	LAN	EXISTING TOWER, RELOCATE; REPLACE LUMINAIRE
20	100'	444+30	75' LT	4			NEW TOWER - INSTALLED IN FUTURE BY OTHERS
21	60'	237+90	50' LT	2			NEW TOWER
22	60'	151+60	80' LT	3			
23	60'	157+65	60' LT	3			
24	80'	5+55	45' LT	4			
25	60'	102+00	24' LT	3			
26	60'	170+75	60' RT	3			
27	60'	177+00	60' RT	2			


NOTE: BALLASTS SHALL BE 480V

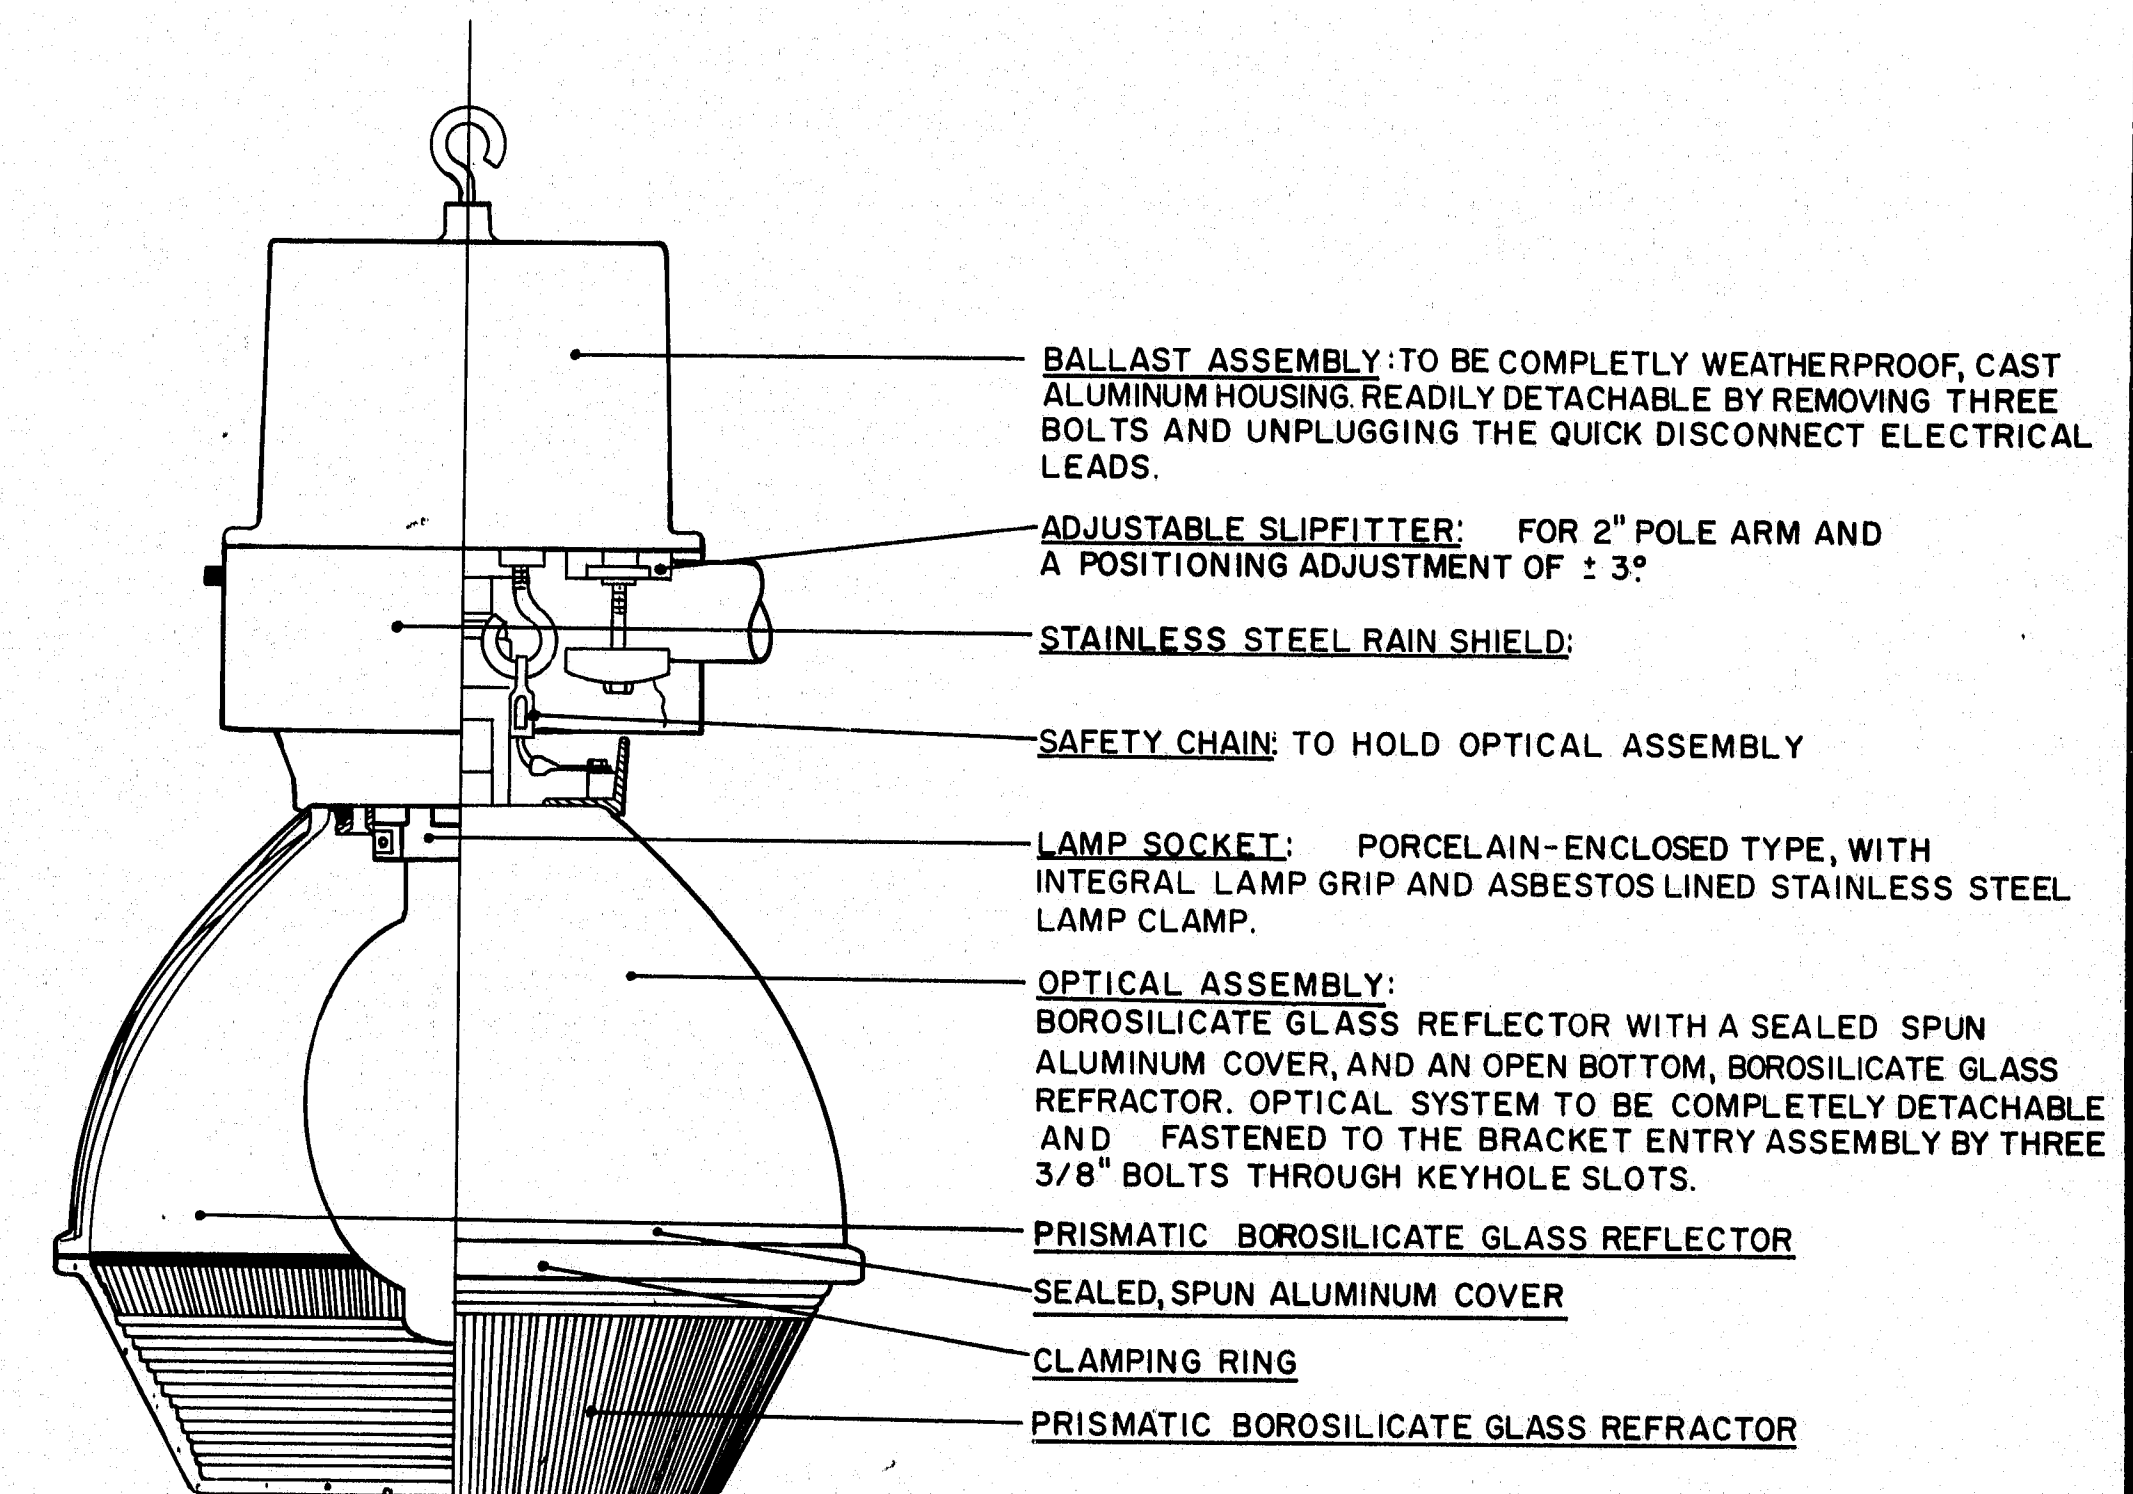


1000 WATT LUMINAIRE

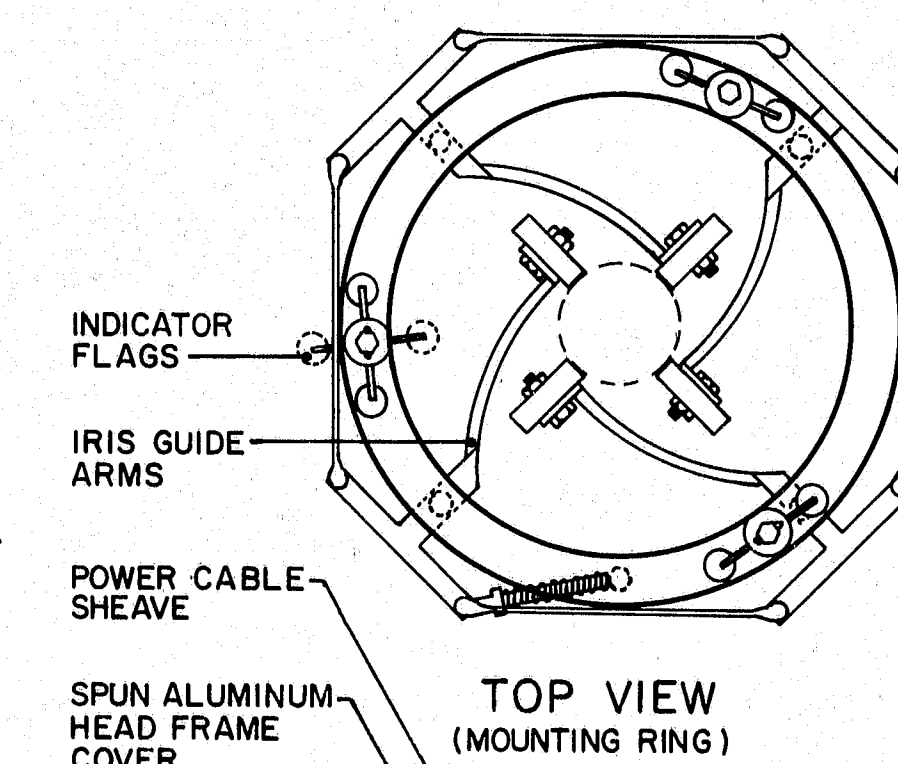

TOP VIEW (MOUNTING RING)

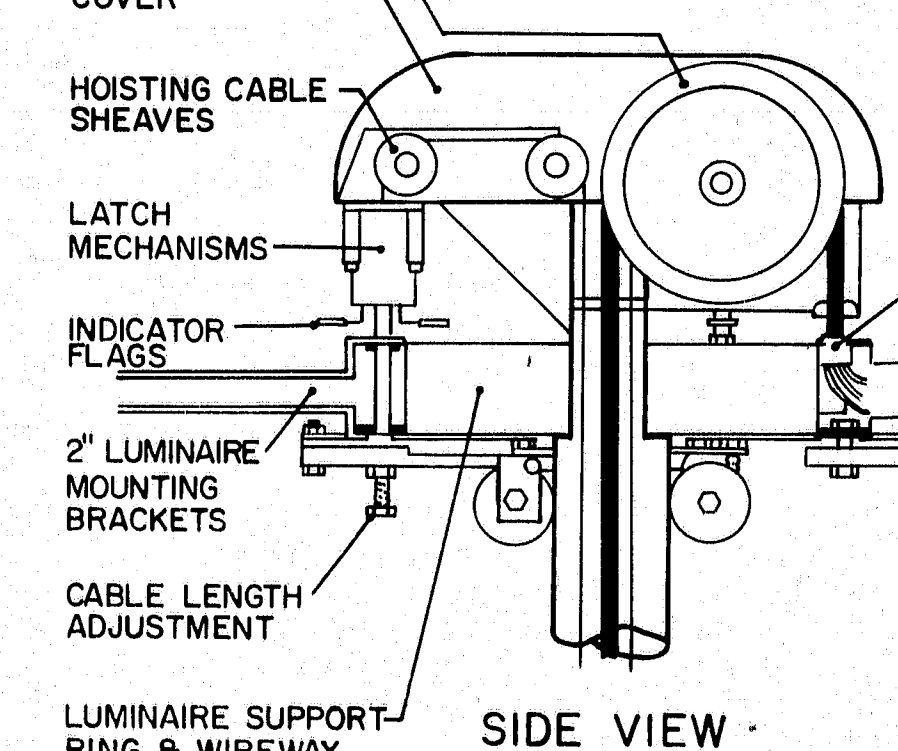

SIDE VIEW

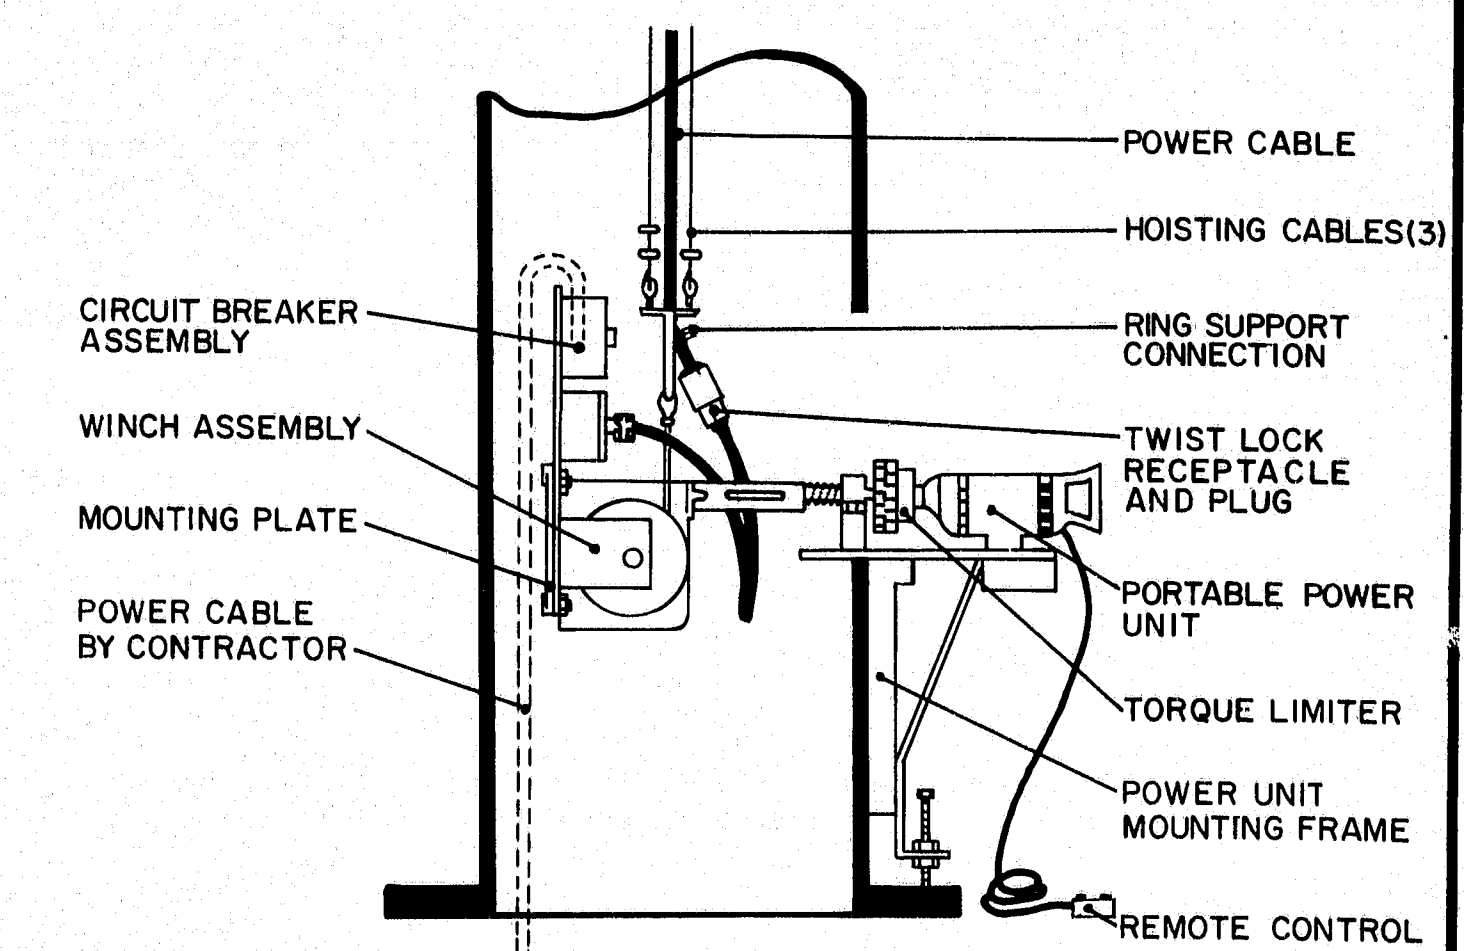


POLE BASE DETAIL WITH PORTABLE LOWERING DEVICE

103-296


STATE OF MAINE
DEPARTMENT OF TRANSPORTATION
STANDARD DETAILS
HIGH-MAST LIGHTING

DESIGN - DETAILED	DATE
REVISIONS	
FIELD CHANGES	
PLANS	

F.R.W. NO.	STATE	PROJECT NUMBER	SHEET NO.	TOTAL SHEETS
1	MAINE	IR-295-3(106)50	48	170

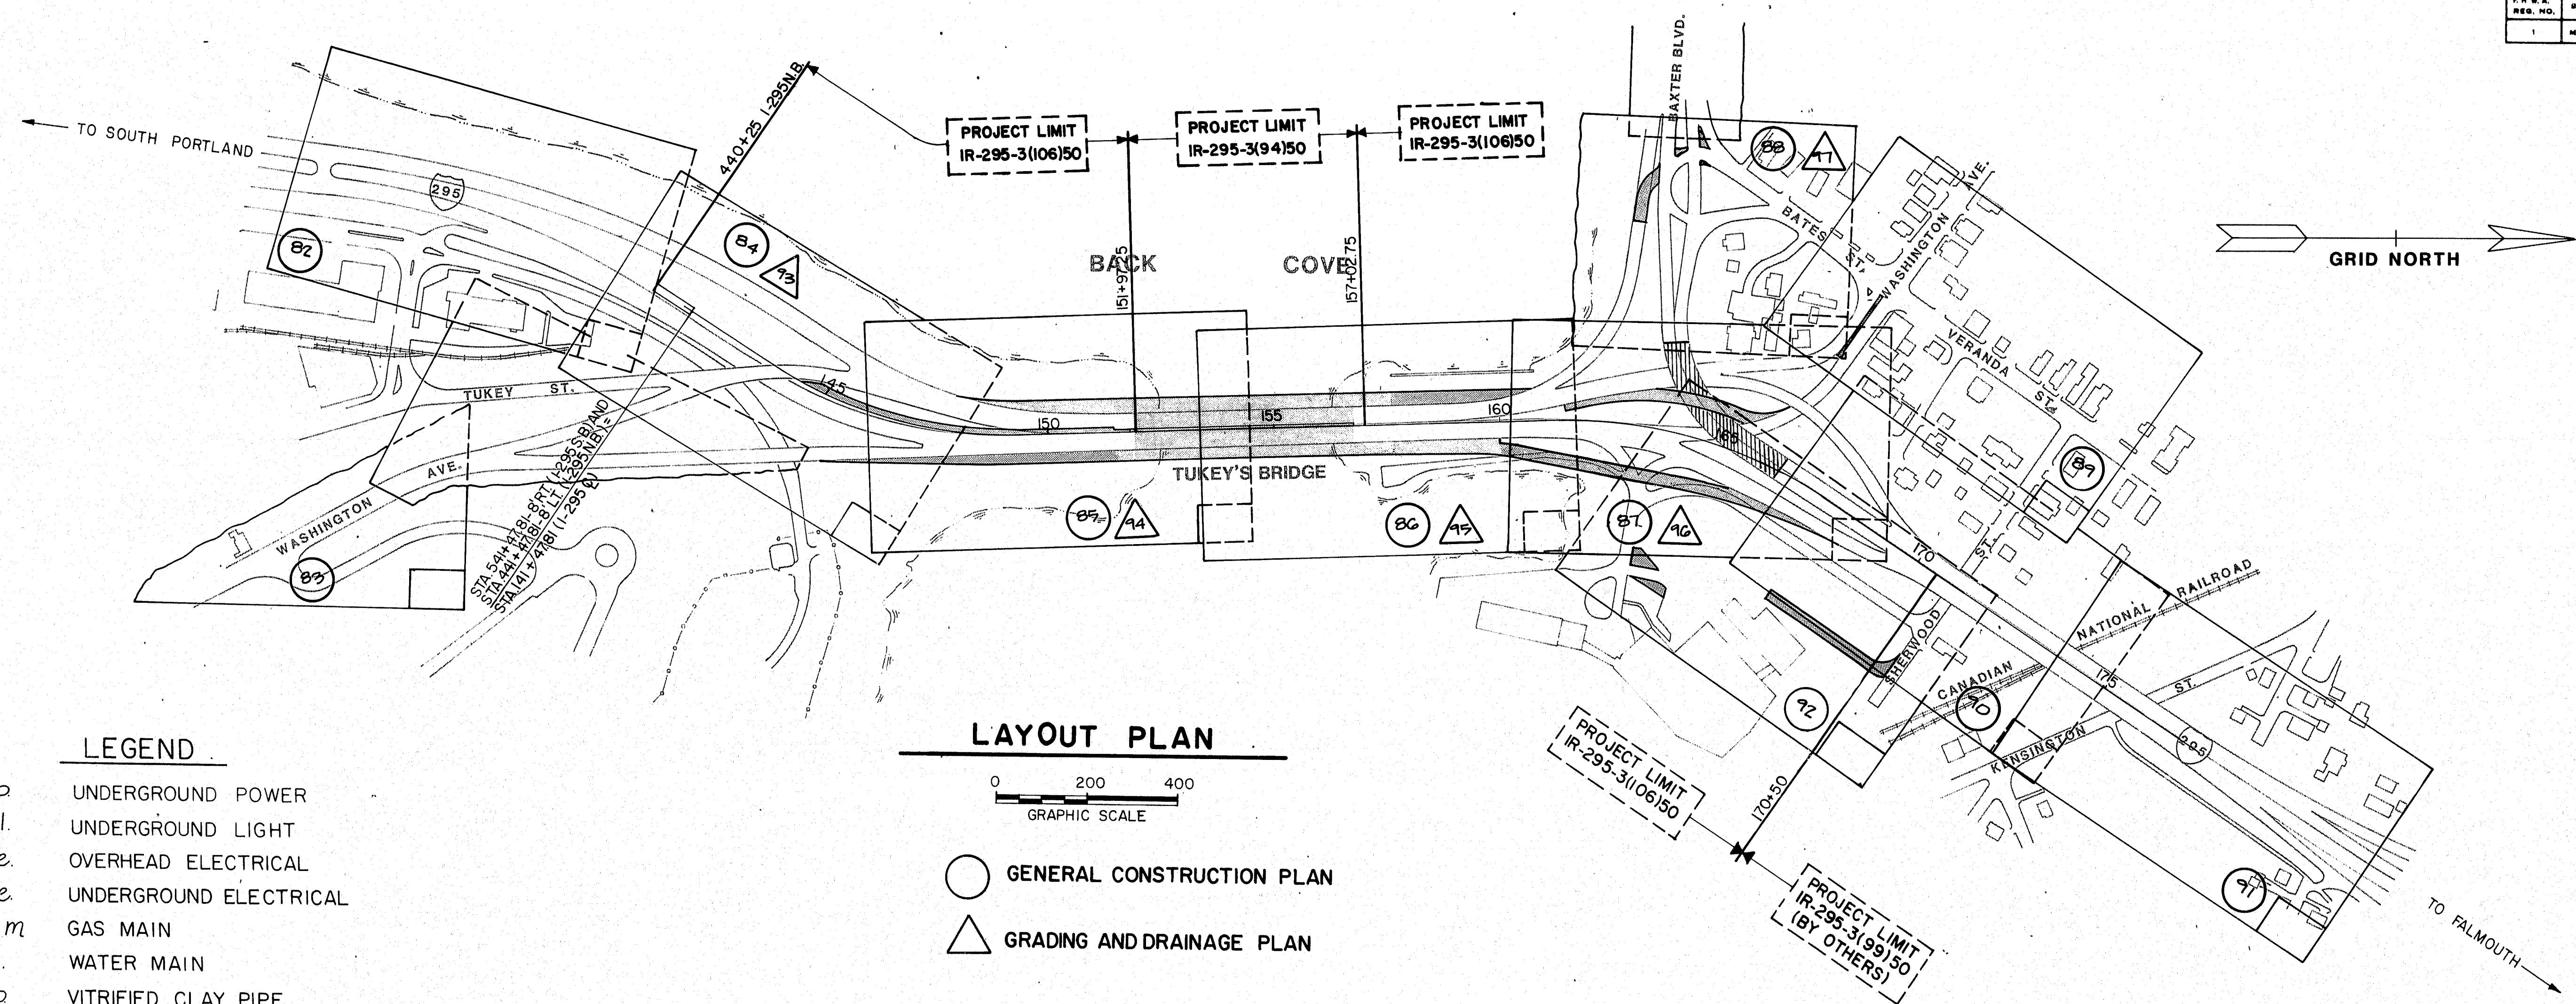

LAYOUT PLAN

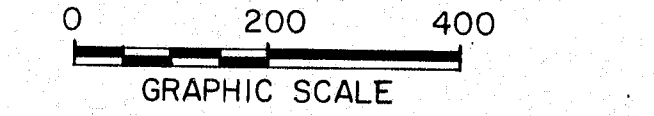


- GENERAL CONSTRUCTION PLAN
- △ GRADING AND DRAINAGE PLAN

GENERAL NOTES

- LEGEND**
- ugp UNDERGROUND POWER
 - ugl UNDERGROUND LIGHT
 - ohc OVERHEAD ELECTRICAL
 - uge UNDERGROUND ELECTRICAL
 - gas m GAS MAIN
 - w m WATER MAIN
 - vcp VITRIFIED CLAY PIPE
 - acp ASBESTOS CEMENT PIPE
 - rcp REINFORCED CONCRETE PIPE
 - cip CAST IRON PIPE
 - br BRICK SEWER OR STORM DRAIN LINE
 - cb CATCH BASIN
 - dmh DRAINAGE MANHOLE
 - tmh TELEPHONE MANHOLE
 - emh ELECTRICAL MANHOLE
 - smh SEWER MANHOLE
 - net NEW ENGLAND TELEPHONE
 - cmp CENTRAL MAINE POWER
 - sd STORM DRAIN-TYPE OF PIPE UNKNOWN
 - s SEWER-TYPE OF PIPE UNKNOWN
 - wso WATER SHUT OFF
 - b.o BLOW OFF
 - jb JUNCTION BOX

1. UTILITIES INVOLVED IN THIS CONTRACT ARE:
 - CITY OF PORTLAND (FIRE ALARM)
 - CITY OF PORTLAND (SEWER & DRAINS)
 - CENTRAL MAINE POWER COMPANY
 - PORTLAND WATER DISTRICT
 - NORTHERN UTILITIES, INC., (GAS)
 - NEW ENGLAND TELEPHONE CO.
 - MAINE DEPARTMENT OF ENVIRONMENTAL PROTECTION
2. CLEARING IS SHOWN ON THE PLANS. BRUSH AND TREES LESS THAN 12" SHALL BE REMOVED WITHIN THE CONSTRUCTION LIMITS, INCIDENTAL TO ITEM 203.20 COMMON EXCAVATION.
3. GRANULAR BORROW USED TO BACKFILL MUCK EXCAVATION OR IN LOW WET AREAS TO 1" ABOVE WATER LEVEL OR OLD GROUND SHALL MEET REQUIREMENTS FOR GRANULAR BORROW-UNDERWATER BACKFILL.
4. ALL DITCH ELEVATIONS SHOWN ON THE CROSS SECTIONS ARE FOR THE FINISH DITCH FLOW LINE.
5. EXISTING TOPOGRAPHIC PLANS AND CROSS SECTIONS WERE COMPUTER GENERATED BY AERIAL PHOTOGRAMMETRY. SOME DISCREPANCIES BETWEEN EXISTING ELEVATIONS SHOWN ON CONTOUR PLANS AND ON CROSS SECTIONS HAVE BEEN NOTICED. EXISTING DETAIL AND DIMENSIONS ALSO DIFFER BETWEEN THE TOPOGRAPHIC PLANS AND THE CROSS SECTIONS IN SOME LOCATIONS. THE CROSS SECTIONS WERE GENERATED POINT BY POINT, AND ARE THEREFORE A MORE ACCURATE REPRESENTATION OF EXISTING CONDITIONS.
6. ONE GUARDRAIL DELINEATOR POST SHALL BE INSTALLED AT EACH GUARD RAIL END BOTH FOR TEMPORARY CONSTRUCTION AND FOR PERMANENT CONSTRUCTION. RESET EXISTING DELINEATOR POSTS FOR TEMPORARY CONSTRUCTION.
7. UTILITY LOCATIONS AND RELOCATIONS (BY OTHERS) ARE SHOWN ON THE GRADING AND DRAINAGE PLANS. THE LOCATION, SIZE, AND DEPTH OF EXISTING SUBSURFACE UTILITIES SHOWN ON THE PLANS WERE COMPILED FROM AVAILABLE RECORD DRAWINGS AND A LIMITED NUMBER OF TEST PITS AND ARE NOT WARRANTED TO BE CORRECT. THE LOCATIONS ARE APPROXIMATE ONLY AND IN SOME CASES MAY BE INCOMPLETE. THE CONTRACTOR SHALL NOTIFY ALL UTILITIES REQUIRED AND VERIFY THE LOCATIONS OF ALL EXISTING SUBSURFACE UTILITIES PRIOR TO PERFORMING ANY WORK.
8. LOAM SHALL BE PLACED 2" DEEP AS SHOWN ON THE PLANS OR AS DESIGNATED BY THE ENGINEER.
9. EXISTING MONUMENT CONTROL WITHIN THE PROJECT LIMITS WILL NOT BE REESTABLISHED.
10. PLACE 2" WIDE ROD STRIP AT THE FOLLOWING LOCATIONS:
 - BEHIND CURBS
 - ABOVE RIPRAP
 - ADJACENT TO TEMPORARY PAVEMENT IN SPECIFIED LOCATIONS
11. ALL SLOPES SHALL BE SEEDED WITH SEEDING, METHOD NO. 2 UNLESS OTHERWISE NOTED.
12. MULCH SHALL BE APPLIED IN AREAS SEEDED BY SEEDING METHOD NO. 2 AND THOSE AREAS TO BE TEMPORARY SEEDED.
13. ALL EXCAVATION BELOW SUBGRADE FOR CATCH BASINS NOTED "REMOVE AND FILL" SHALL BE PAID FOR UNDER ITEM 203.20. ALL PLUGS SHALL BE CONSTRUCTED OF MORTAR AS DIRECTED BY THE ENGINEER, PAYMENT TO BE INCIDENTAL TO ITEM 203.20.
14. WHERE NEW ROADWAY PAVEMENT ADJACENT TO EXISTING ROADWAY PAVEMENT RESULTS IN A VERTICAL DIFFERENCE IN GRADE, HOT BITUMINOUS PAVEMENT, GRADING C, SHALL BE PLACED A MINIMUM DISTANCE OF 25 FEET BACK ON THE SIDE OF THE VERTICAL DROP SO AS TO RESULT IN A SMOOTH RAMPED TRANSITION BETWEEN ELEVATIONS.
15. TEMPORARY PAVEMENT IS TYPICALLY 4" HOT BITUMINOUS PAVEMENT OVER 18" AGGREGATE SUBBASE - GRAVEL MATERIAL.
16. ALL PAVEMENTS SHALL BE SWEEP CLEAN OF ALL LOOSE MATERIAL BEFORE TRAFFIC IS PERMITTED ON THEM.
17. IF FOUNDATION MATERIAL IS REQUIRED UNDER CULVERTS, IT SHALL MEET THE REQUIREMENTS FOR GRANULAR BORROW - UNDERWATER BACKFILL AND WILL BE PAID FOR UNDER ITEM 203.25.
18. DRAIN STRUCTURE OFFSET LOCATIONS FROM BASELINES ARE MEASURED TO THE FAR EDGE OF FRAMES.
19. CABLE GUARDRAIL SHALL BE REMOVED FROM CONSTRUCTION AREAS. POSTS AND HARDWARE SHALL BE DELIVERED AND STACKED ON WOODEN PLANKS AT MDOT MAINTENANCE LOT, PLEASANT HILL ROAD, SCARBOROUGH AND CABLE SHALL BE DISPOSED BY THE CONTRACTOR OFF THE SITE, AT NO ADDITIONAL COMPENSATION.
20. VERTICAL DATUM USED IS MEAN SEA LEVEL (N.G.V.D.).
21. NO LOAM SALVAGE IS ANTICIPATED.
22. BENCHING OF EXISTING FILL SLOPES SHALL BE REQUIRED FOR SOME EMBANKMENT CONSTRUCTION WHERE SHOWN ON THE SECTIONS.

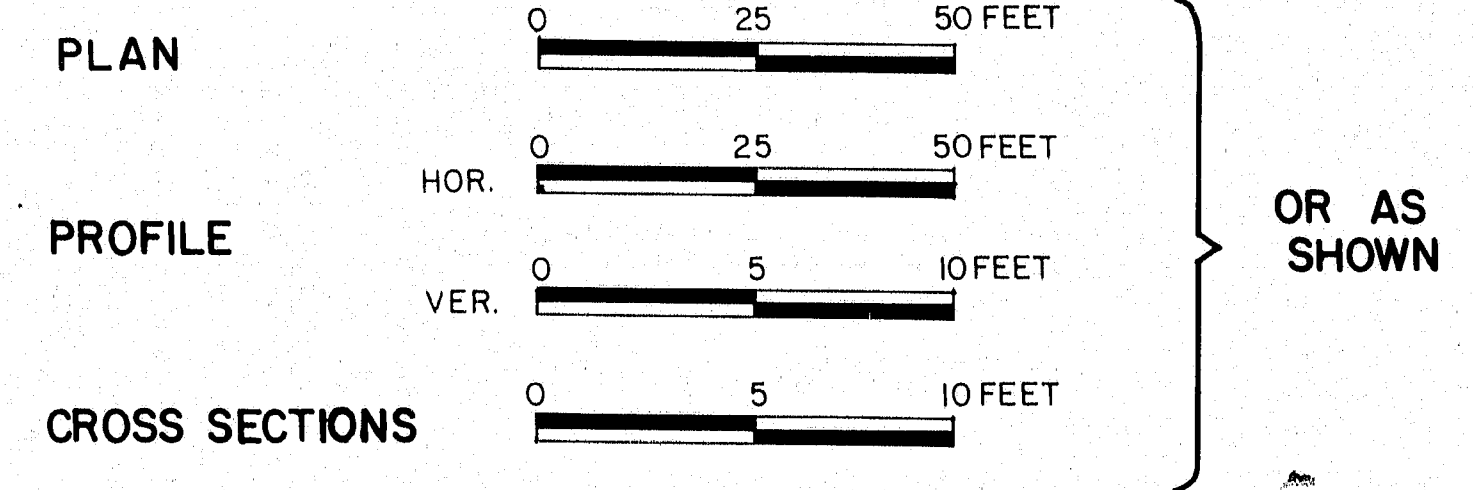

PLAN SCALES

PROJECT DESIGN ENGINEER	DATE
BY	
DESIGN - DETAILED	
CHECKED	
REVISIONS	
FIELD CHANGES	


103-297

STATE OF MAINE
DEPARTMENT OF TRANSPORTATION
I-295 PORTLAND

KEY PLAN, LEGEND & GENERAL NOTES


SHEET 48 OF 170 AUGUSTA, MAINE

F.R.N.A. REG. NO.	STATE	PROJECT NUMBER	SHEET NO.	TOTAL SHEETS
1	MAINE	IR-295(106)50	49	130

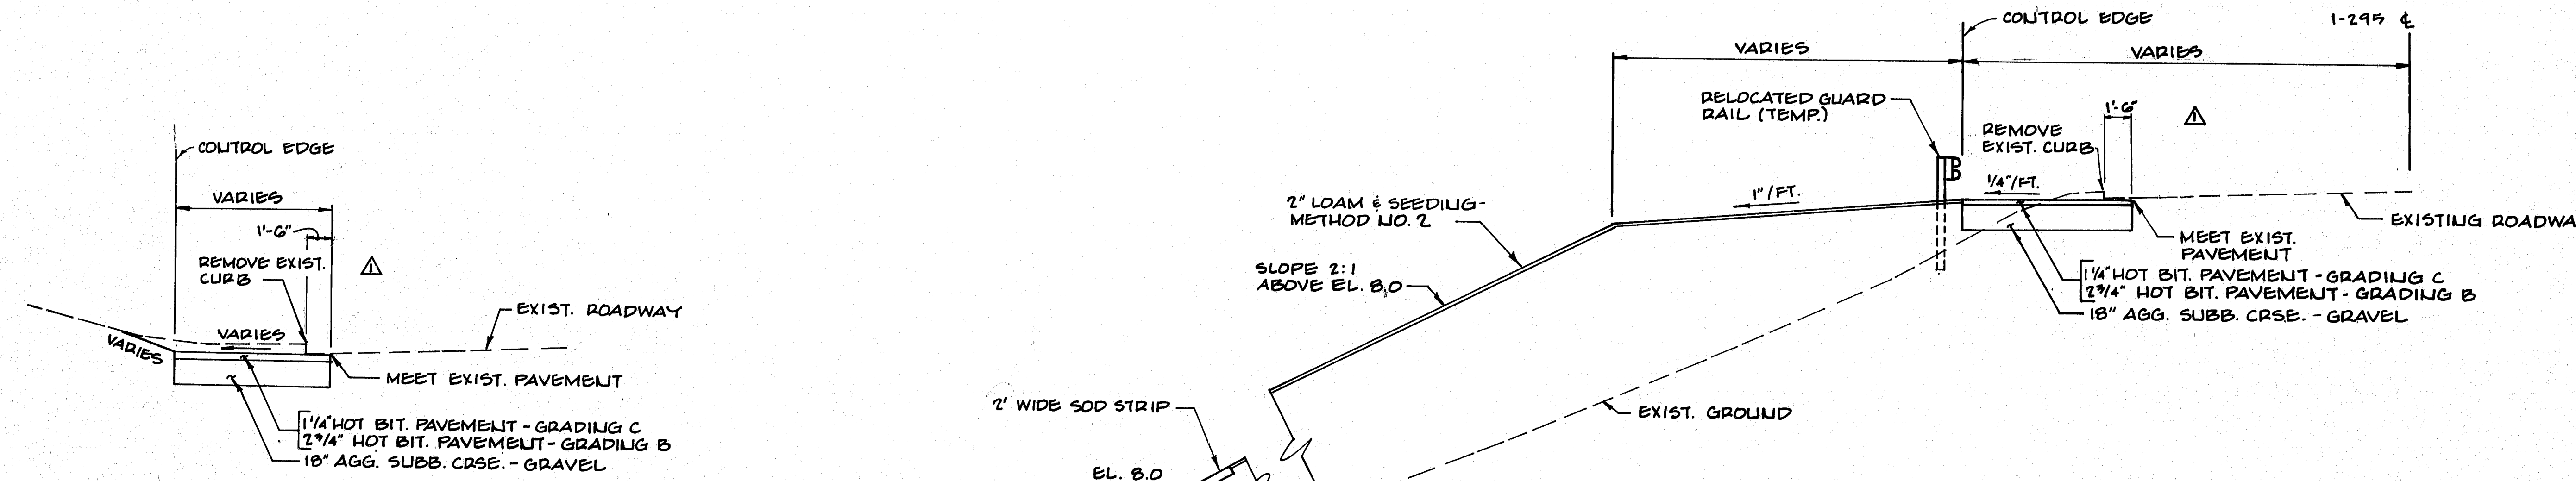


I-295 MEDIAN
STA. 144+25 ± TO STA. 151+75


I-295 S.B. / RAMP WA-4
STA. 247+51.24, WA-4 LT. TO STA. 151+75, I-295 LT.

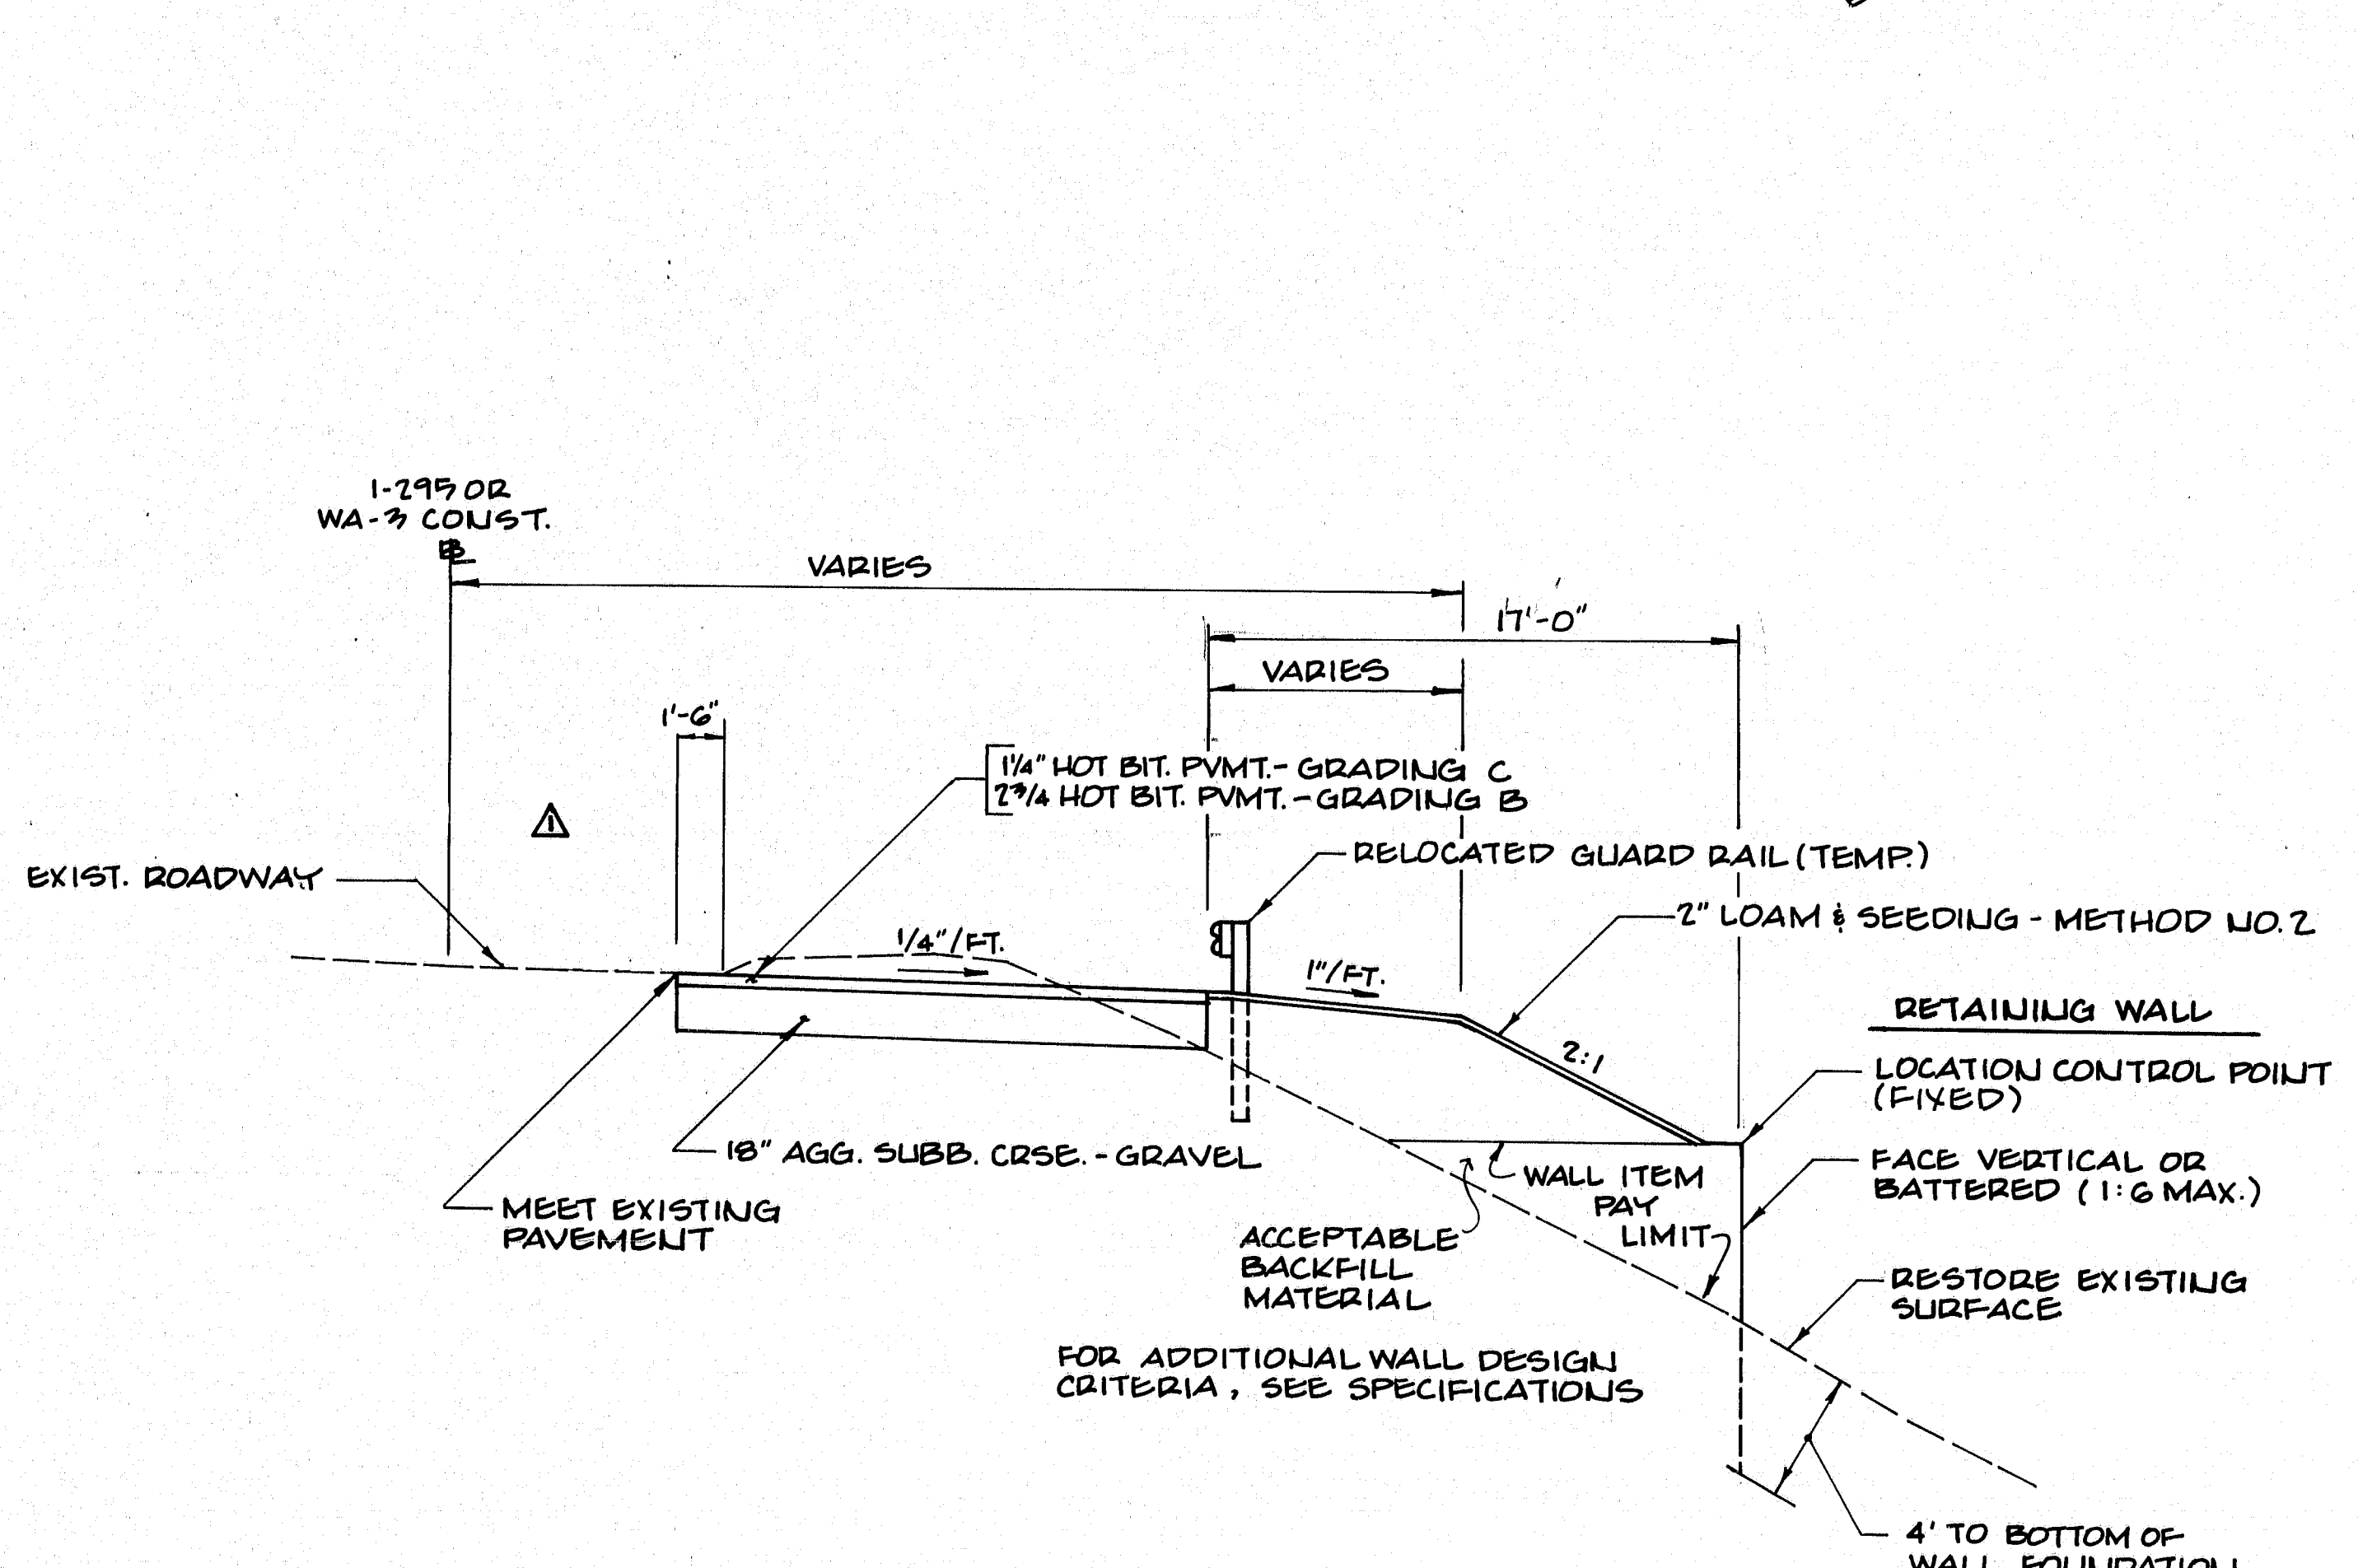

I-295 N.B. / RAMP WA-3
STA. 647+00, WA-3 RT. TO STA. 151+75, I-295 RT.

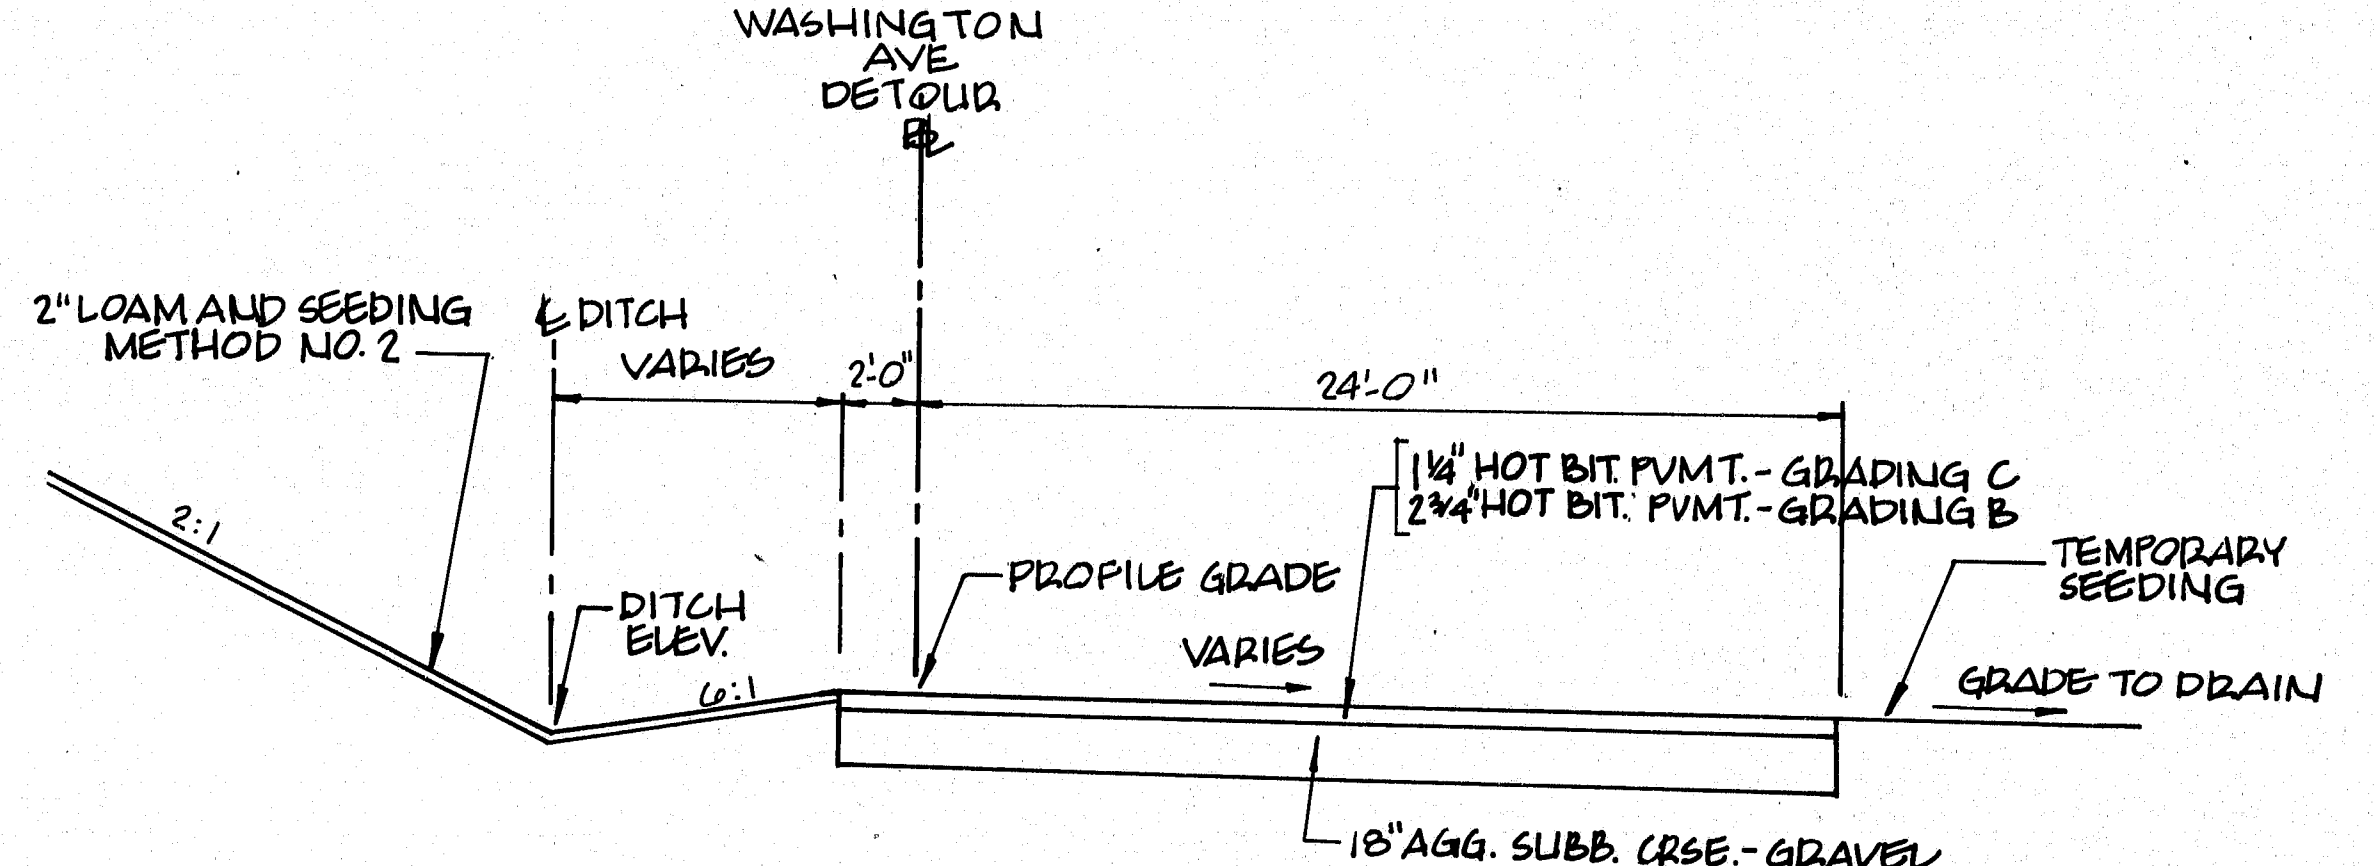

WASHINGTON AVE. DETOUR
STA. 9+00 ± TO STA. 14+27 ±

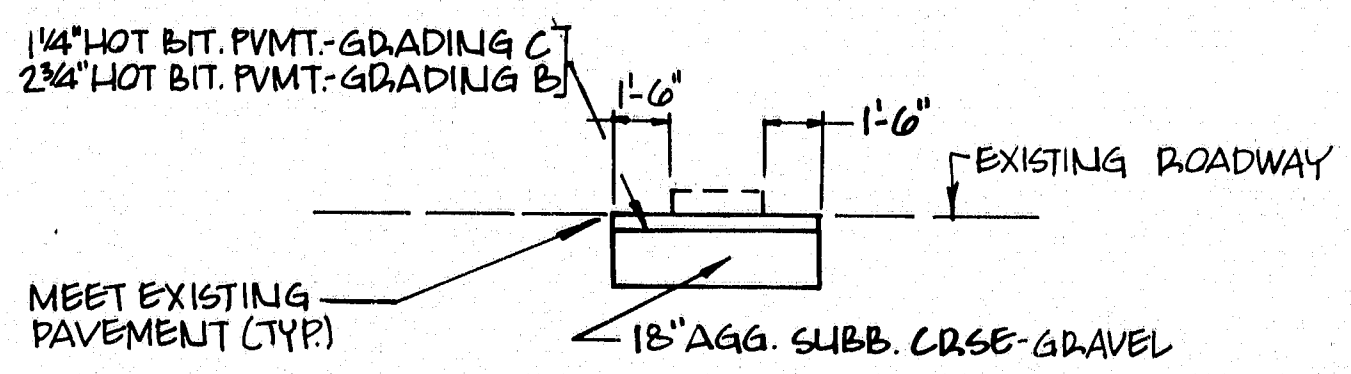

WASHINGTON AVE. MEDIAN REMOVAL
STA. 296+17 (WA-2EXT) TO STA. 297+30 (WA-2)


103-298

NOTES:
1. THE PAVEMENT AND BASE DEPTHS AS SHOWN ON THE PLANS ARE INTENDED TO BE NOMINAL.
2. WHEN SUPERELEVATION EXCEEDS 3/8" PER FOOT, LOW SIDE SHOULDER SHALL HAVE THE SAME SLOPE AS PAVEMENT.
3. N.I.C. MEANS NOT IN THIS CONTRACT.


STATE OF MAINE DEPARTMENT OF TRANSPORTATION	
I-295 PORTLAND	
TYPICAL SECTIONS	
REV	DESCRIPTION
BY	DATE

PROJECT DESIGN ENGINEER	DATE
DESIGN - DETAILED	
CHECKED	
FIELD CHANGES	
PLANS	


BRUNING 44-132-45710-1

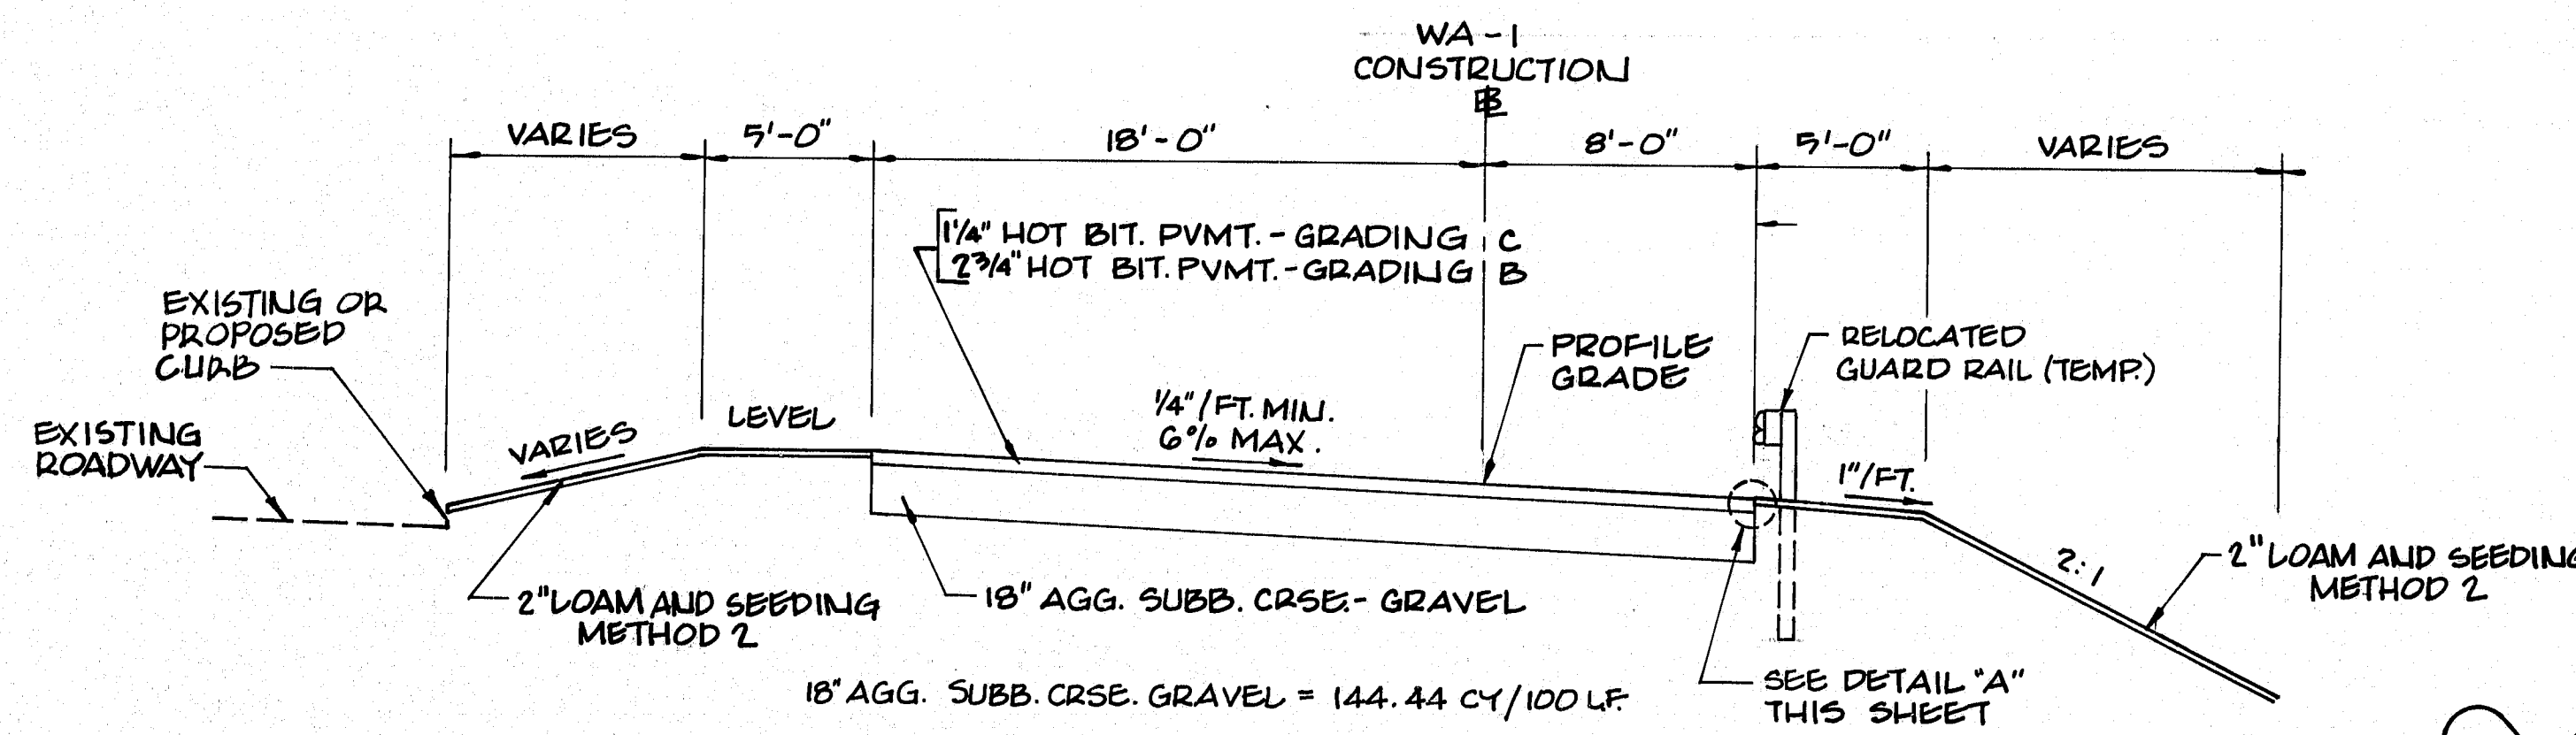


I-295 N.B. DETOUR
 STA. 2+50 WA-1 TO
 STA. 210+00 I-295 N.B. DETOUR

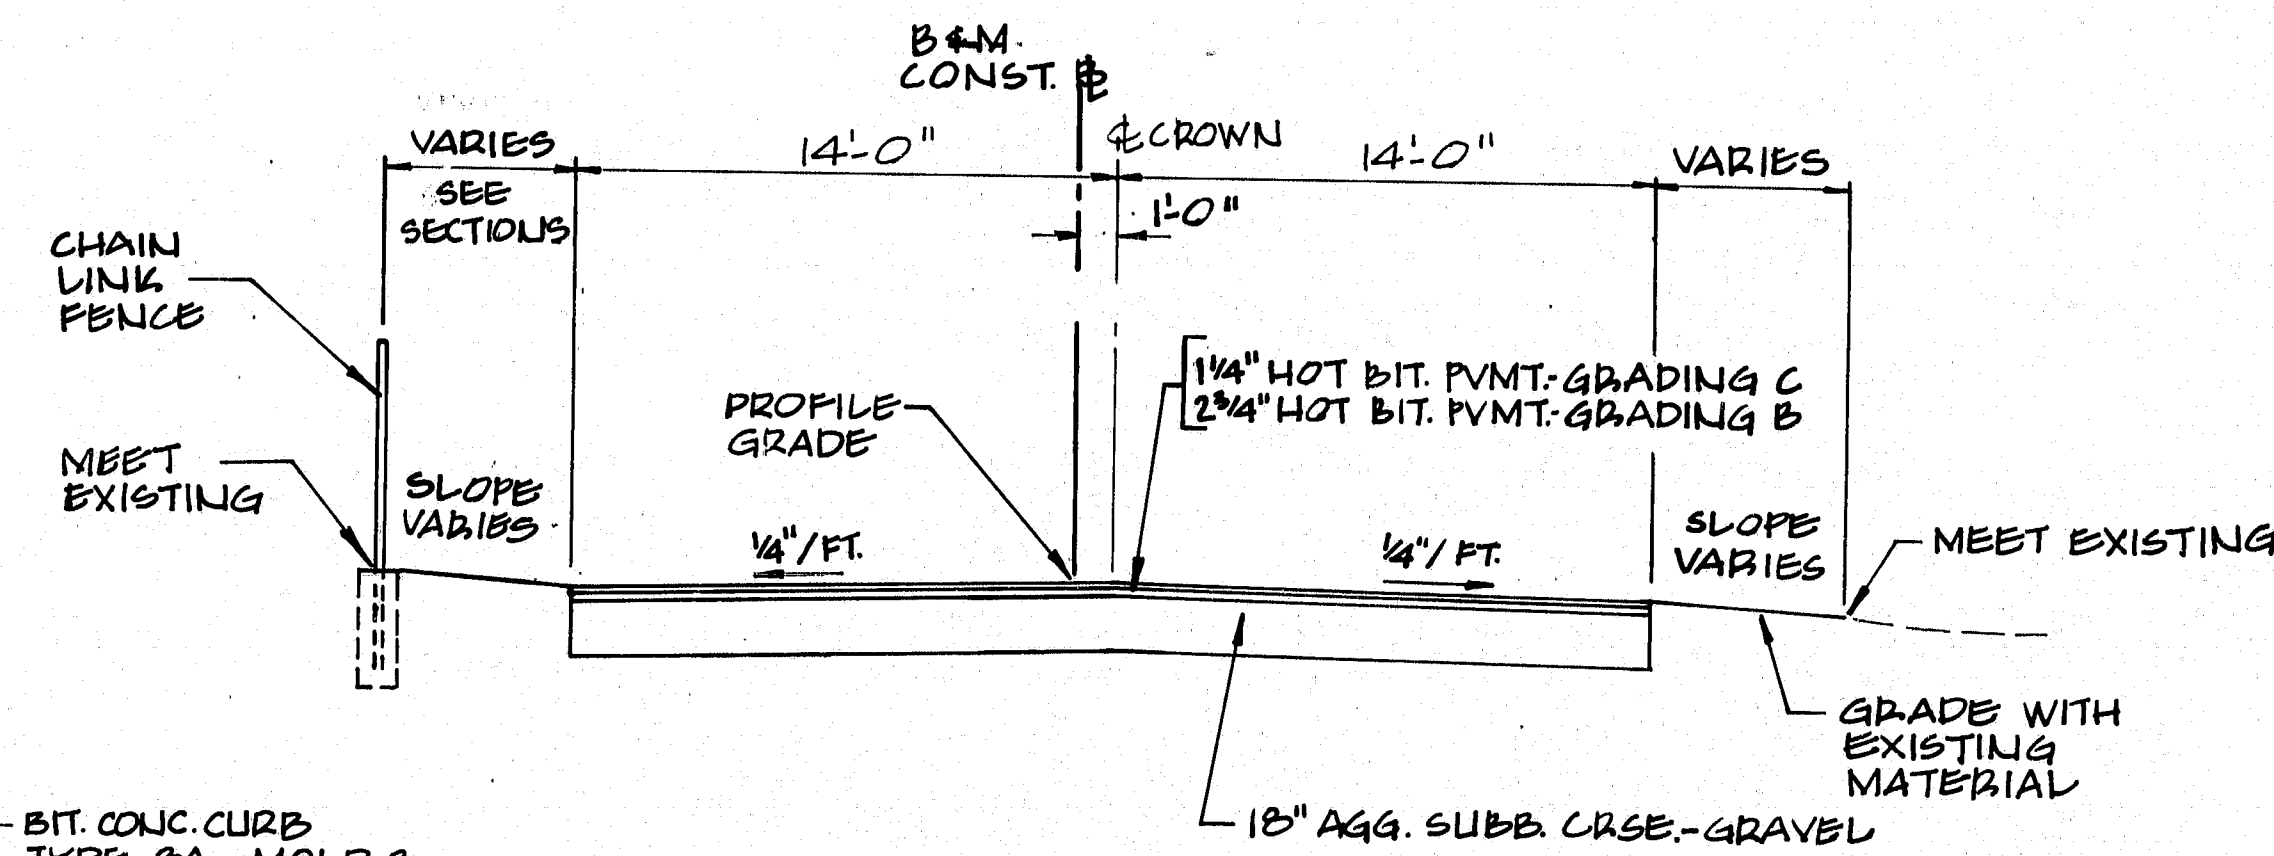


B & M DRIVEWAY

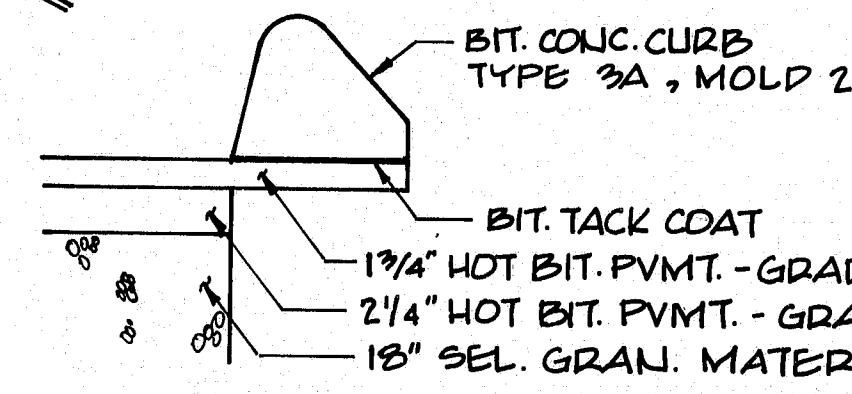


DETAIL "A"
 STA. 2+50 WA-1
 TO STA. 3+50 WA-1

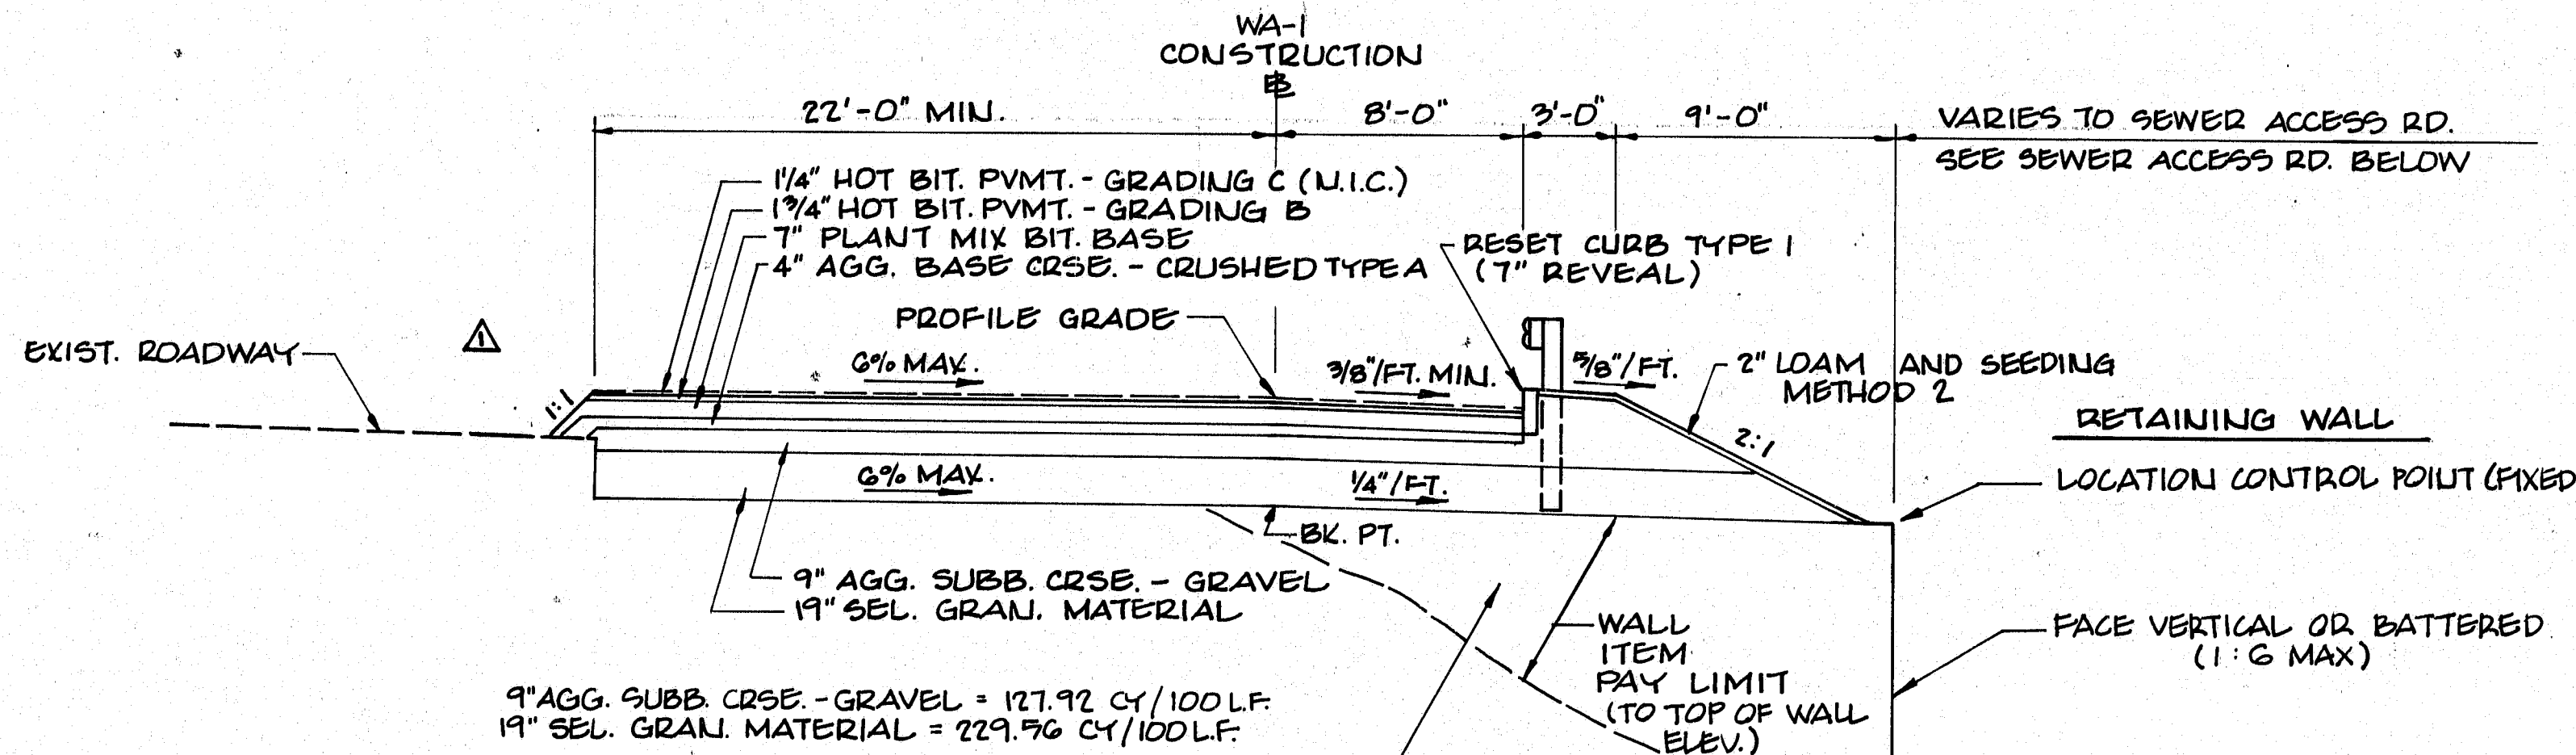

I-295 N.B. DETOUR
 STA. 157+02.75, I-295 RT. TO
 STA. 2+50, WA-1 RT.

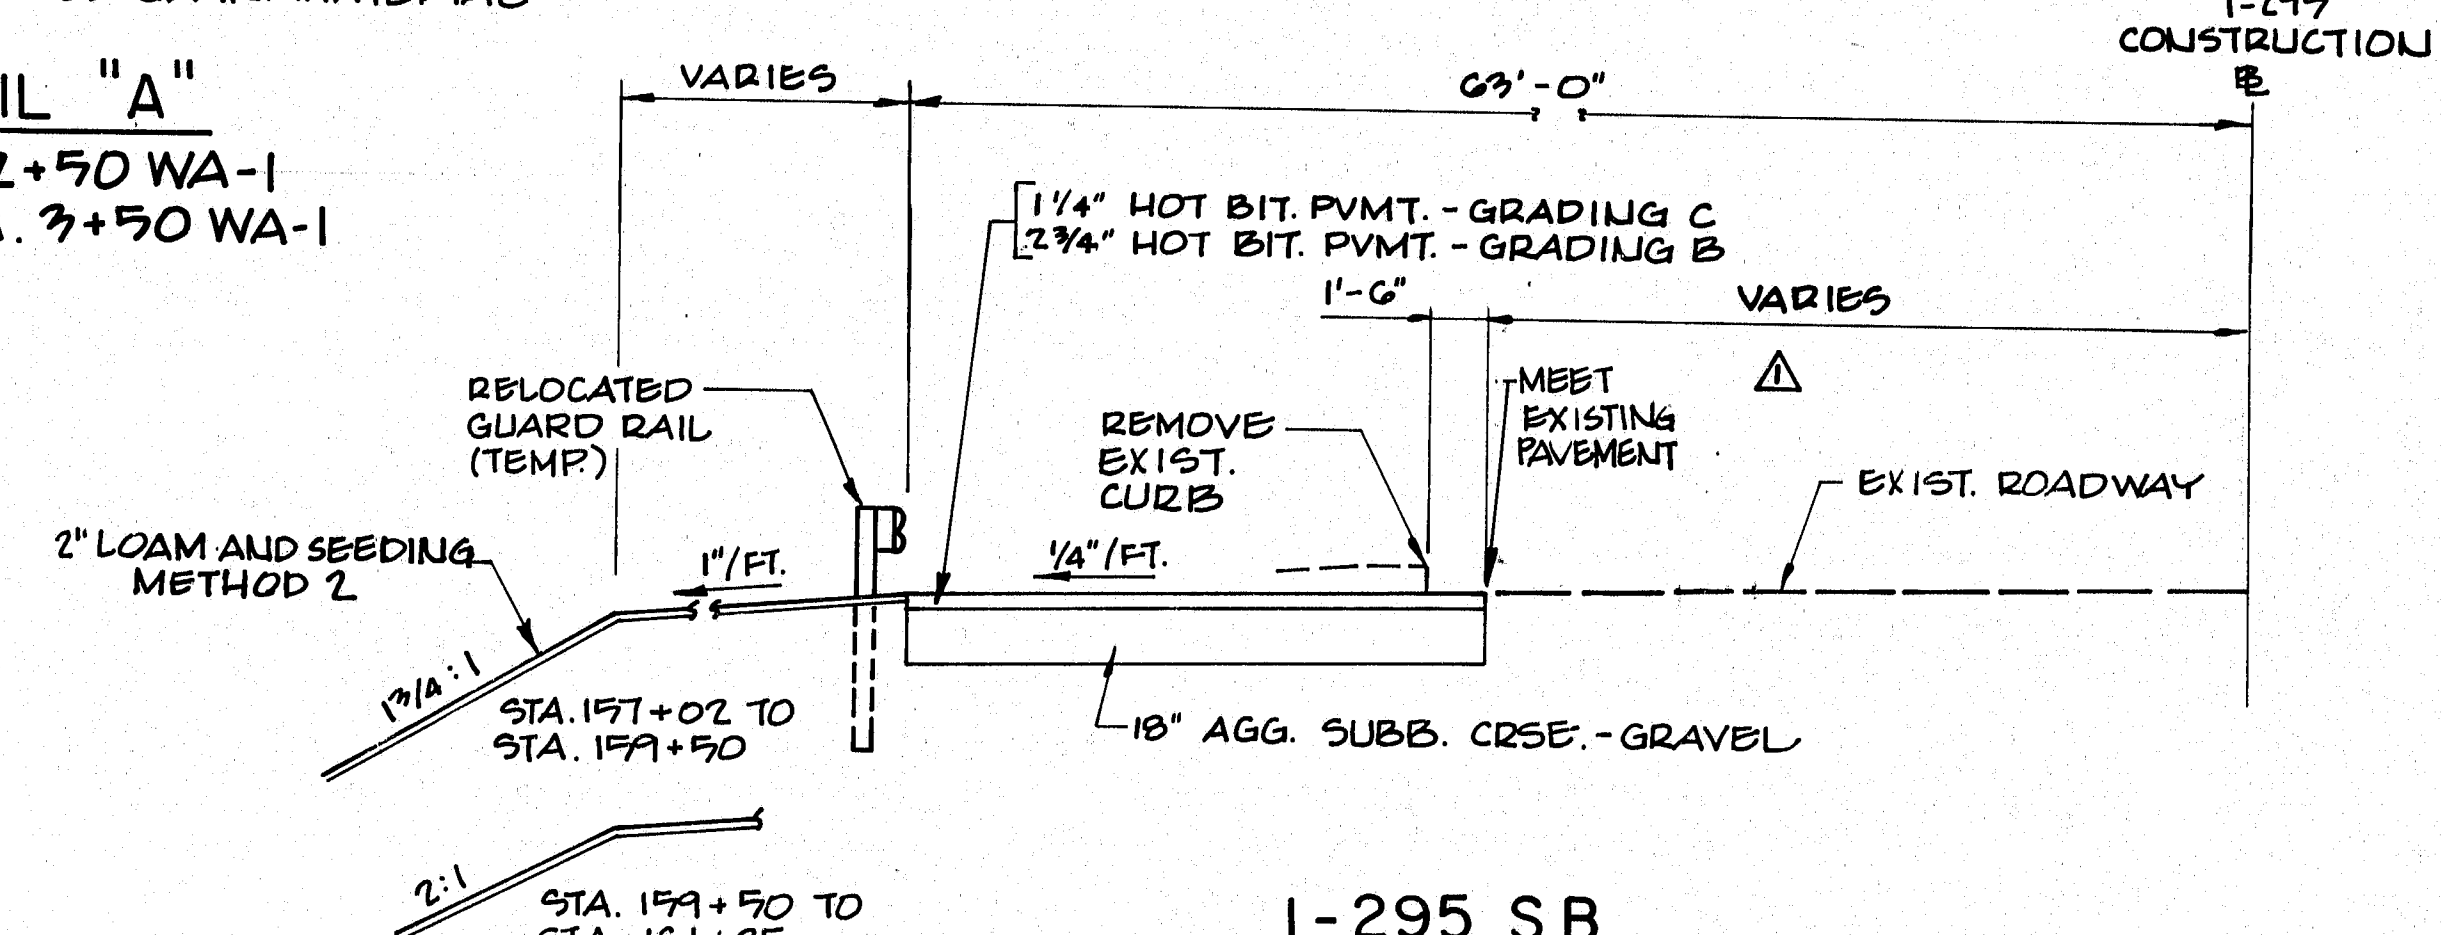

I-295 S.B.
 STA. 157+02.75, I-295 LT. TO
 STA. 160+80, I-295 LT.

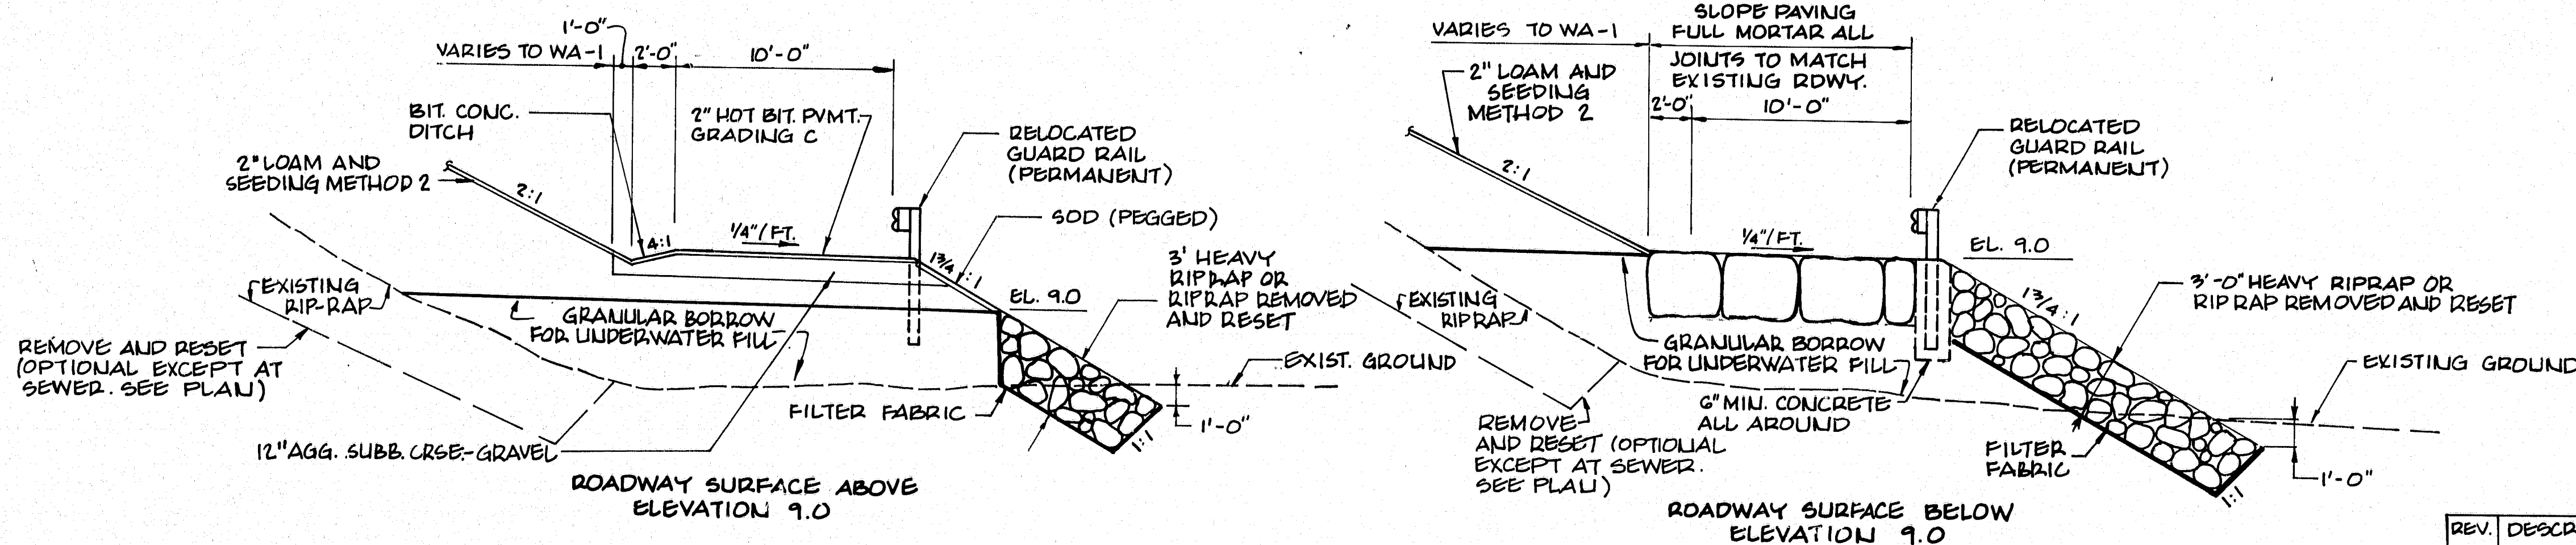

SEWER ACCESS ROAD

THE SEWER ACCESS ROAD SHALL BE CONSTRUCTED TO ELEV. 7.0. THE PROPOSED 48\"/>

103-299

NOTES:
 1. THE PAVEMENT AND BASE DEPTHS AS SHOWN ON THE PLANS ARE INTENDED TO BE NOMINAL.
 2. WHEN SUPERELEVATION EXCEEDS 1/8\"/>

STATE OF MAINE
 DEPARTMENT OF TRANSPORTATION
 I-295 PORTLAND
TYPICAL SECTIONS AND DETAILS

REV.	DESCRIPTION	BY	DATE

PROJECT DESIGN ENGINEER	DATE
DESIGN DETAILER	
CHECKED	
REVISIONS	
FIELD CHANGES	

BRUNING 44 132 42710

DRAINAGE

STATION	RCP			CAP		CMP		CULVERT PIPE		CATCH BASINS						MAN HOLES	UNDERDRAINS				REMARKS	
	SIZE	LENGTH	CLASS	SIZE	LENGTH	SIZE	LENGTH	SIZE	LENGTH	A1-C	A1-P	B1	B1-C	C1	E		F	B	C	D		E
NORTH OF TUKEY'S BRIDGE																						
RAMP WA-1																						
1+03, 8' RT.																						
1+03, 8' RT. TO 40' RT.																						
2+05, 26' LT. TO 3+43 8' RT.																						
3+43, 8' RT.																						
3+43, 9' RT. TO 37' RT.																						
3+43, 8' RT.																						
3+43, 41' RT.																						
3+43, 41' RT. TO 63' RT.																						
4+49, 60' RT. TO 4+71 3/4' LT.																						
4+66, 66' RT. TO 6+41, 8' RT.																						
4+66, 64' RT. TO 5+40, 41' RT.																						
WASHINGTON AVE. DETOUR																						
14+10, 9' RT.																						
NORTH OF TUKEY'S BRIDGE																						
I-295																						
157+75 1/2' LT. TO 157+60 3/4' LT.																						
157+77 1/2' LT. TO 158+77 1/2' LT.																						
157+75 1/2' LT.																						
WA-2																						
302+84 1/2' RT. TO 303+31 1/2' RT.																						
302+62 1/2' RT. TO 302+84 1/2' RT.																						
302+84 65' RT.																						
SOUTH OF TUKEY'S BRIDGE																						
I-295																						
144+91, 3' LT.																						
146+91, 8'																						
147+61, 8'																						
148+88, 8'																						
149+91, 1' LT.																						
149+90, 39' RT.																						
RAMP WA-3																						
645+50, 20' RT.																						
647+50, 8' RT.																						

DRAINAGE CONT'D.

STATION	RCP			BCCMP		CMP		CULVERT PIPE		CATCH BASINS						MAN HOLES	UNDERDRAINS				REMARKS	
	SIZE	LENGTH	CLASS	SIZE	LENGTH	SIZE	LENGTH	SIZE	LENGTH	A1-C	A1-P	B1	B1-C	C1	E		F	B	C	D		E

103-300

REVISED AS BUILT 1986
John L. Mayhew

STATE OF MAINE DEPARTMENT OF TRANSPORTATION
1-295 PORTLAND
DRAINAGE SUMMARY
SHEET 51 OF 130 AUGUSTA, MAINE


DRAWING 44-132-30026

REEL

103

5/ 301 thru 400

F.R.A. REG. NO.	STATE	PROJECT NUMBER	SHEET NO.	TOTAL SHEETS
1	MAINE	IR-295-3(10650)	62	120

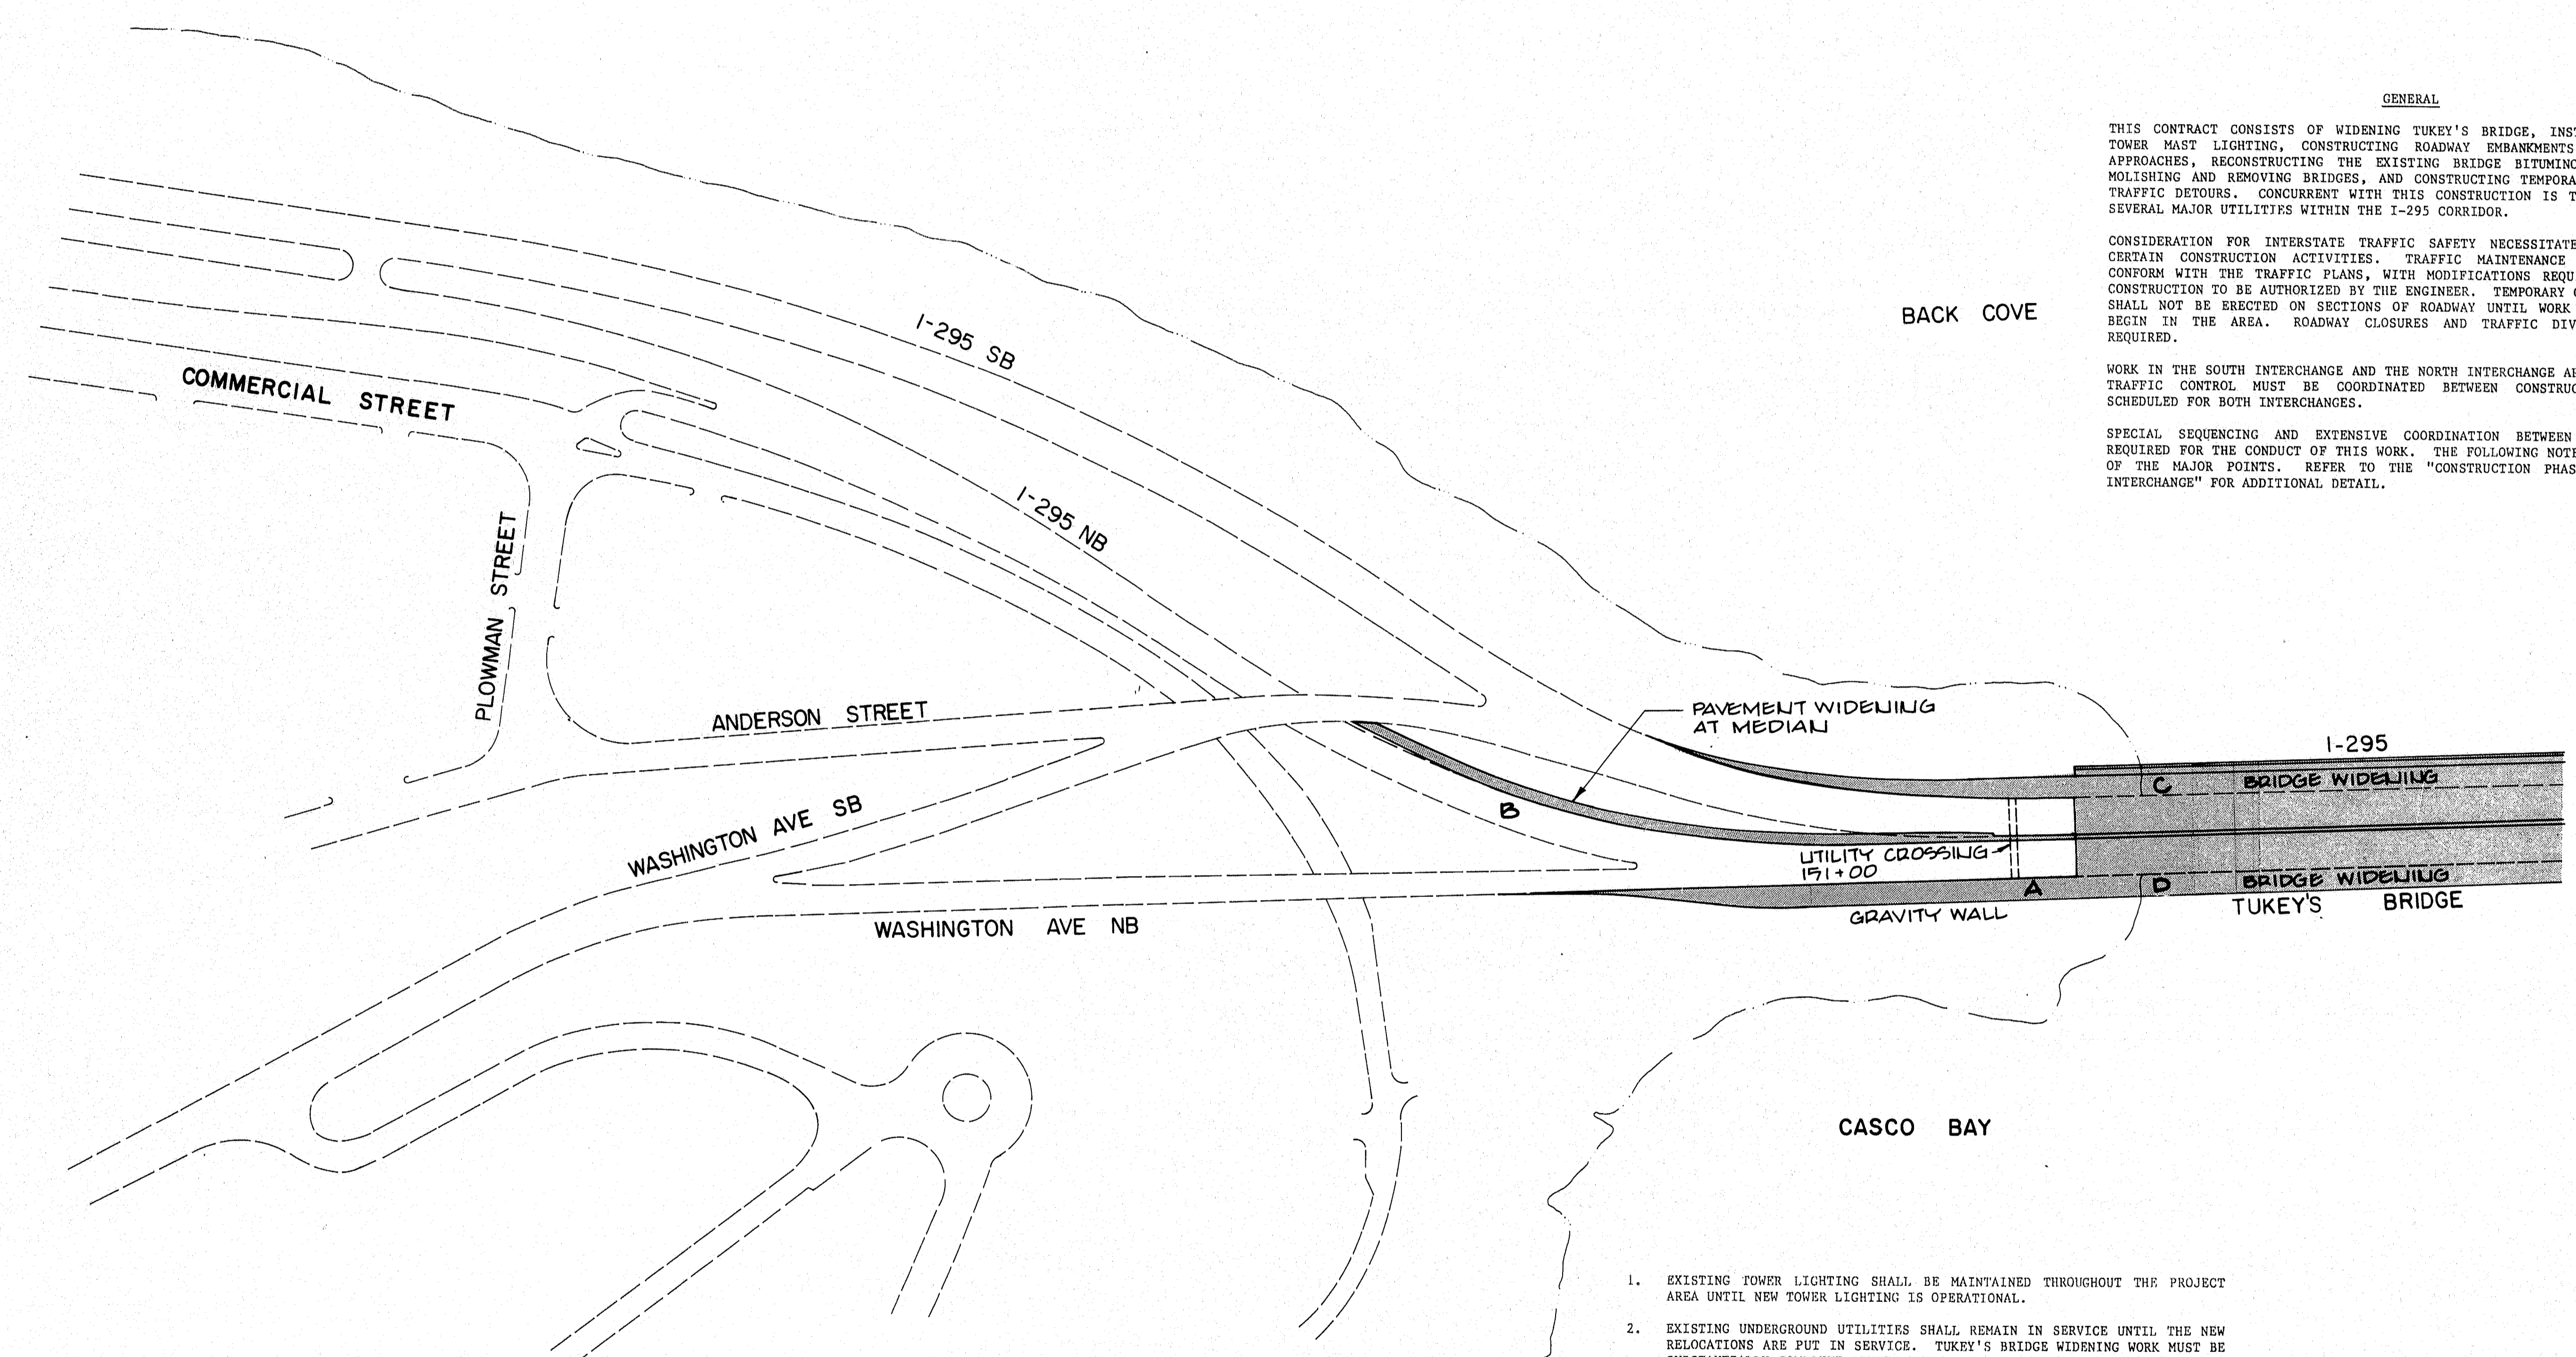

GENERAL

THIS CONTRACT CONSISTS OF WIDENING TUKEY'S BRIDGE, INSTALLING NEW HIGH TOWER MAST LIGHTING, CONSTRUCTING ROADWAY EMBANKMENTS ON THE BRIDGE APPROACHES, RECONSTRUCTING THE EXISTING BRIDGE BITUMINOUS SURFACE, DEMOLISHING AND REMOVING BRIDGES, AND CONSTRUCTING TEMPORARY PAVEMENTS FOR TRAFFIC DETOURS. CONCURRENT WITH THIS CONSTRUCTION IS THE RELOCATION OF SEVERAL MAJOR UTILITIES WITHIN THE I-295 CORRIDOR.

CONSIDERATION FOR INTERSTATE TRAFFIC SAFETY NECESSITATES SEQUENCING OF CERTAIN CONSTRUCTION ACTIVITIES. TRAFFIC MAINTENANCE SHALL GENERALLY CONFORM WITH THE TRAFFIC PLANS, WITH MODIFICATIONS REQUIRED BY SPECIFIC CONSTRUCTION TO BE AUTHORIZED BY THE ENGINEER. TEMPORARY CONCRETE BARRIERS SHALL NOT BE ERECTED ON SECTIONS OF ROADWAY UNTIL WORK IS SCHEDULED TO BEGIN IN THE AREA. ROADWAY CLOSURES AND TRAFFIC DIVERSIONS WILL BE REQUIRED.

WORK IN THE SOUTH INTERCHANGE AND THE NORTH INTERCHANGE ARE INTER-RELATED. TRAFFIC CONTROL MUST BE COORDINATED BETWEEN CONSTRUCTION OPERATIONS SCHEDULED FOR BOTH INTERCHANGES.

SPECIAL SEQUENCING AND EXTENSIVE COORDINATION BETWEEN ACTIVITIES ARE REQUIRED FOR THE CONDUCT OF THIS WORK. THE FOLLOWING NOTES HIGHLIGHT SOME OF THE MAJOR POINTS. REFER TO THE "CONSTRUCTION PHASING PLAN, NORTH INTERCHANGE" FOR ADDITIONAL DETAIL.

- EXISTING TOWER LIGHTING SHALL BE MAINTAINED THROUGHOUT THE PROJECT AREA UNTIL NEW TOWER LIGHTING IS OPERATIONAL.
- EXISTING UNDERGROUND UTILITIES SHALL REMAIN IN SERVICE UNTIL THE NEW RELOCATIONS ARE PUT IN SERVICE. TUKEY'S BRIDGE WIDENING WORK MUST BE SUBSTANTIALLY COMPLETE BEFORE THE RELOCATION WORK CAN COMMENCE ON THE BRIDGE.
- PEDESTRIAN TRAFFIC THROUGH THE PROJECT AREA SHALL BE PROHIBITED.
- THE TWO UTILITY CROSSINGS OF I-295 AT STATIONS 151+00 AND 161+00 SHALL BE THE RESPONSIBILITY OF THE MDT CONTRACTOR. THESE CROSSINGS SHALL BE MADE BY OPEN CUTTING AT PERIODS OF LOW TRAFFIC VOLUMES, EITHER AT NIGHT OR ON A SUNDAY.
- CONSTRUCTION SEQUENCING NECESSARY FOR SPECIFIED TRAFFIC CONTROL SHALL BE AS FOLLOWS:
 - CONSTRUCT GRAVITY WALL, EMBANKMENT, TUKEY'S BRIDGE ABUTMENT EXTENSION. TRAFFIC CONTROL SHALL CONFORM TO THE INITIAL TRAFFIC PLAN.
 - CONSTRUCT WIDENING OF I-295 PAVEMENT AT THE MEDIAN. TRAFFIC CONTROL SHALL CONFORM TO THE INTERMEDIATE TRAFFIC PLAN, STEP 1.
 - COMPLETE WIDENING OF SOUTH BOUND LANES ON TUKEY'S BRIDGE. TRAFFIC CONTROL SHALL CONFORM TO THE INTERMEDIATE TRAFFIC PLAN, STEP 2.
 - COMPLETE WIDENING OF NORTH BOUND LANES ON TUKEY'S BRIDGE. TRAFFIC CONTROL SHALL CONFORM TO THE FINAL TRAFFIC CONTROL PLAN.


103-301

STATE OF MAINE DEPARTMENT OF TRANSPORTATION I-295 PORTLAND CONSTRUCTION PHASING PLAN SOUTH INTERCHANGE SHEET 62 OF 120 AUGUSTA, MAINE

PROJECT DESIGN ENGINEER	BY	DATE
PLANS		
DESIGN - DETAILED		
CHECKED		
REVISIONS		
FIELD CHANGES		

BRUNING 44 132 6710 1

F.R. & S.D. NO.	STATE	PROJECT NUMBER	SHEET NO.	TOTAL SHEETS
1	MAINE	R-295-3(06)50	63	130

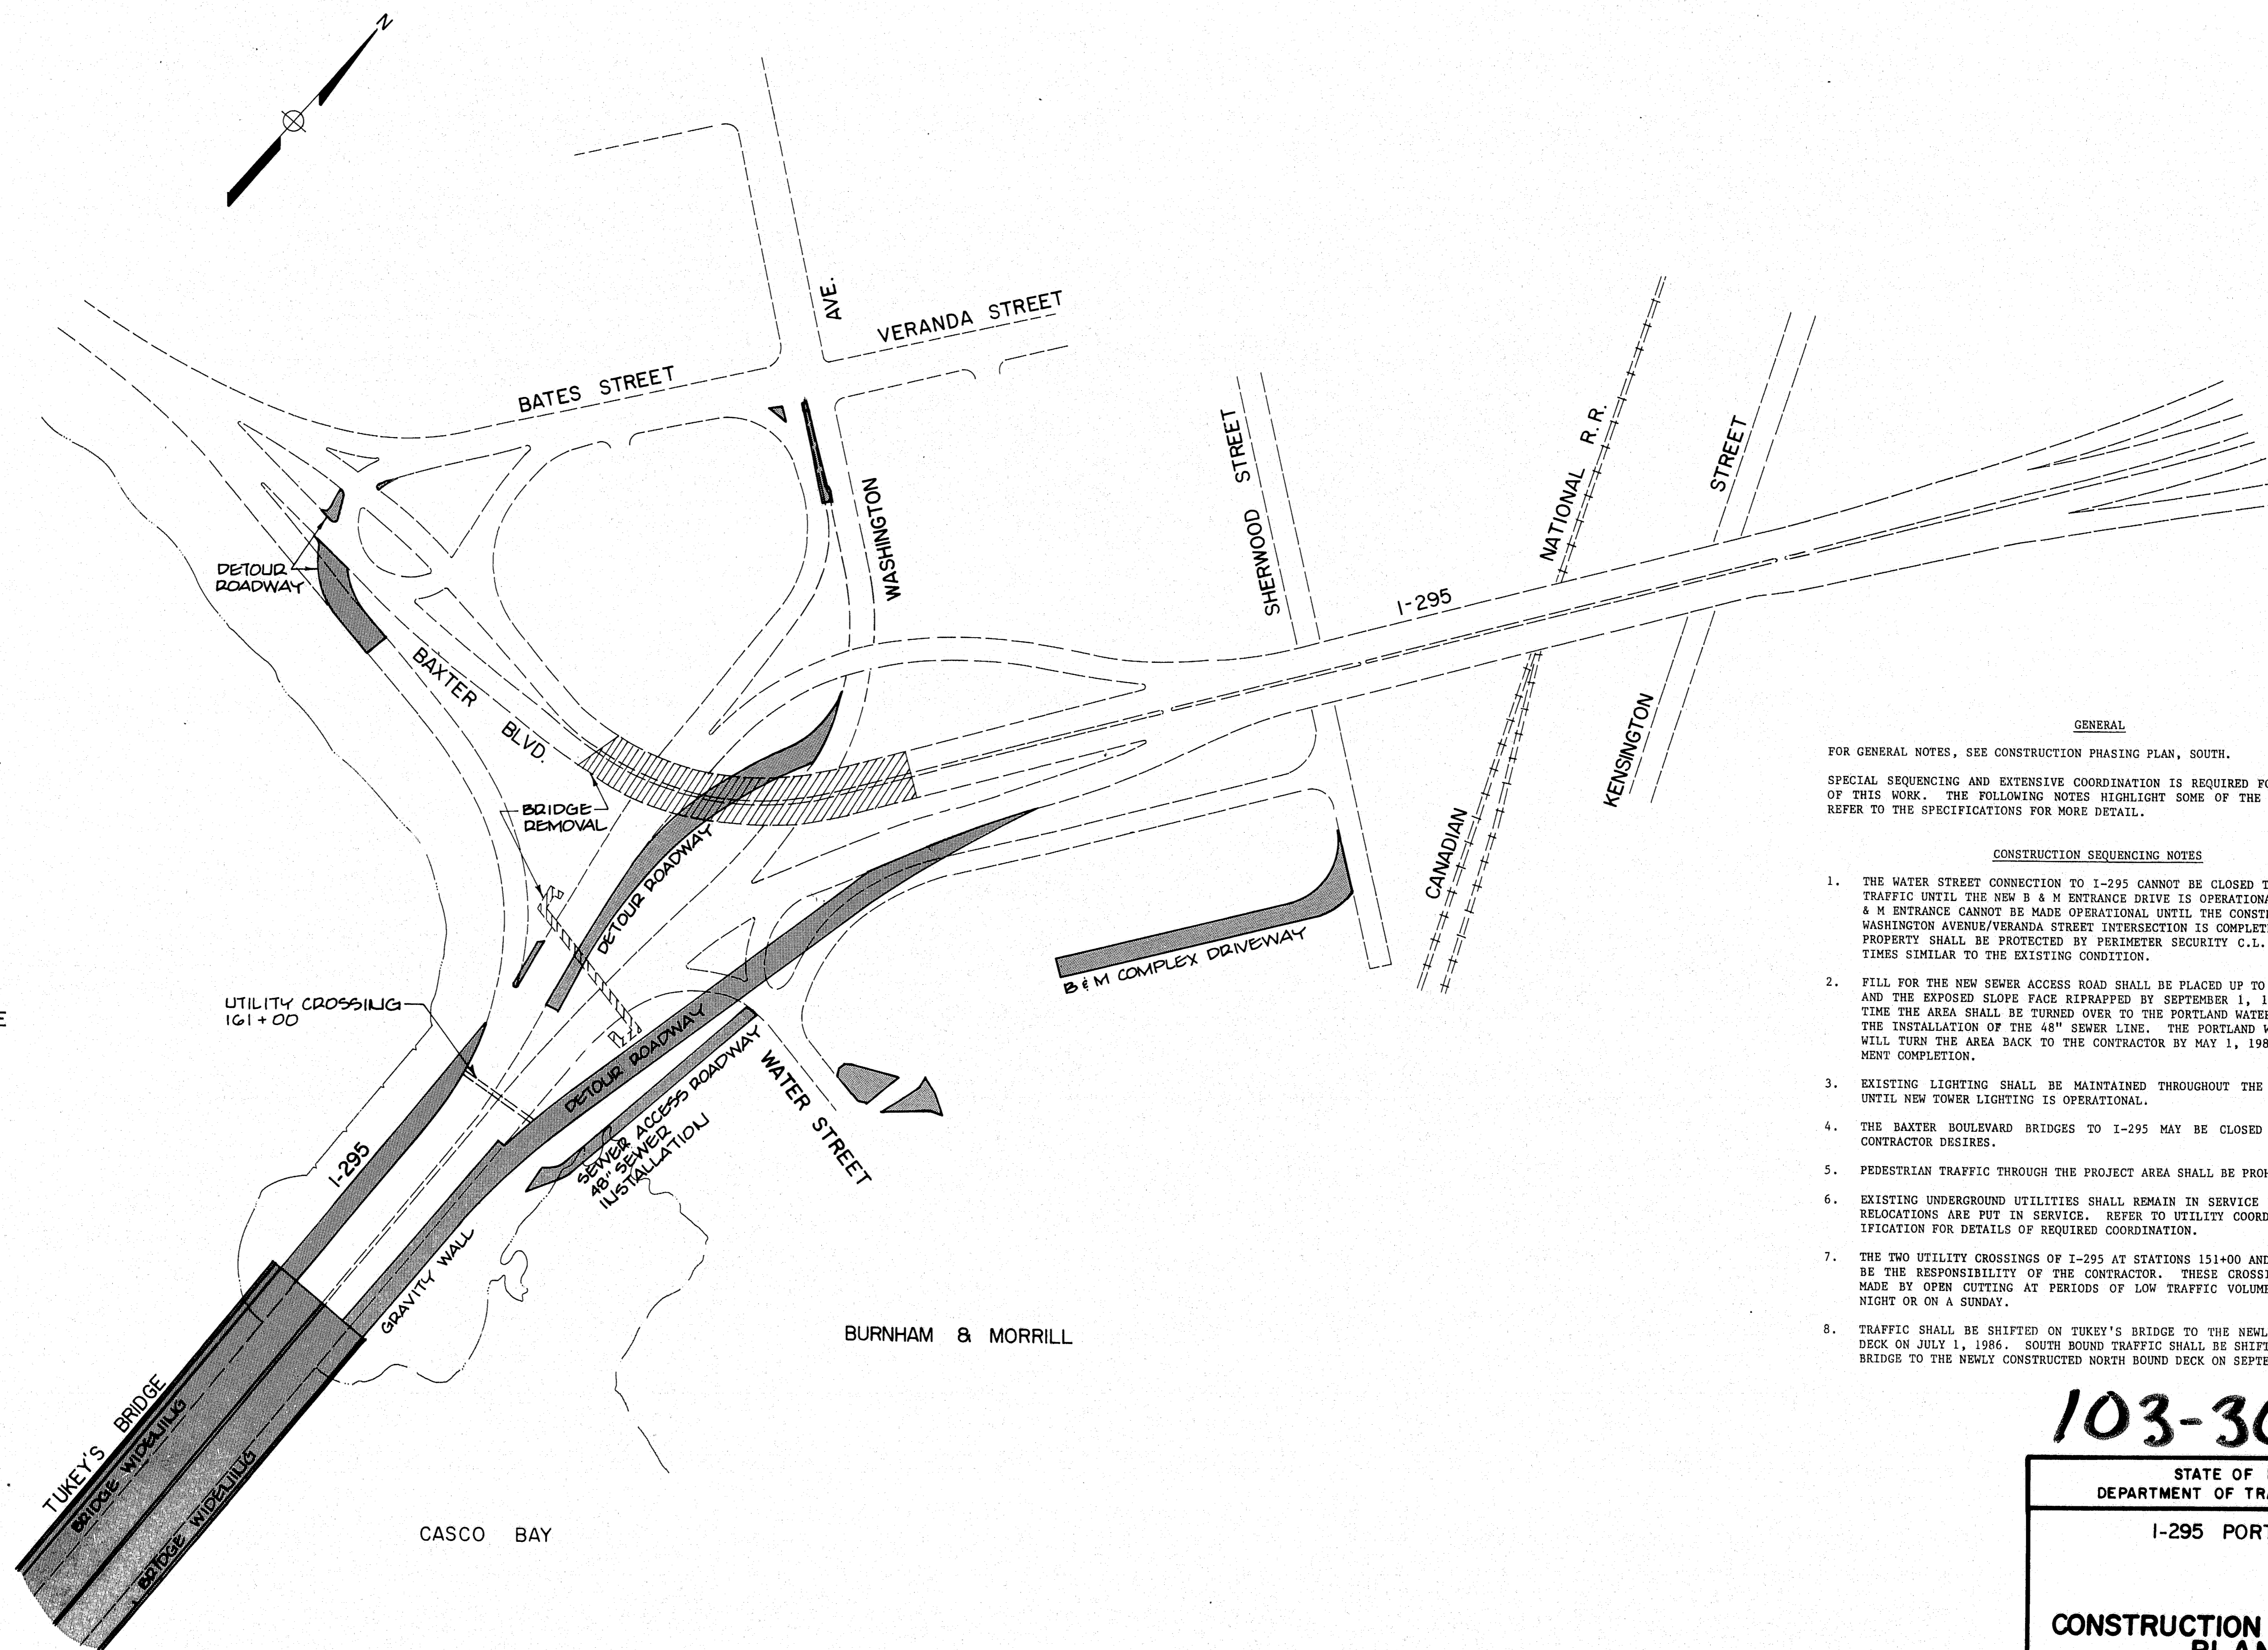

GENERAL
 FOR GENERAL NOTES, SEE CONSTRUCTION PHASING PLAN, SOUTH.
 SPECIAL SEQUENCING AND EXTENSIVE COORDINATION IS REQUIRED FOR THE CONDUCT OF THIS WORK. THE FOLLOWING NOTES HIGHLIGHT SOME OF THE MAJOR POINTS. REFER TO THE SPECIFICATIONS FOR MORE DETAIL.

CONSTRUCTION SEQUENCING NOTES

1. THE WATER STREET CONNECTION TO I-295 CANNOT BE CLOSED TO B & M TRUCK TRAFFIC UNTIL THE NEW B & M ENTRANCE DRIVE IS OPERATIONAL. THE NEW B & M ENTRANCE CANNOT BE MADE OPERATIONAL UNTIL THE CONSTRUCTION AT THE WASHINGTON AVENUE/VERANDA STREET INTERSECTION IS COMPLETED. THE B & M PROPERTY SHALL BE PROTECTED BY PERIMETER SECURITY C.L. FENCE AT ALL TIMES SIMILAR TO THE EXISTING CONDITION.
2. FILL FOR THE NEW SEWER ACCESS ROAD SHALL BE PLACED UP TO ELEVATION 4.0 AND THE EXPOSED SLOPE FACE RIPRAPPED BY SEPTEMBER 1, 1985. AT WHICH TIME THE AREA SHALL BE TURNED OVER TO THE PORTLAND WATER DISTRICT FOR THE INSTALLATION OF THE 48" SEWER LINE. THE PORTLAND WATER DISTRICT WILL TURN THE AREA BACK TO THE CONTRACTOR BY MAY 1, 1986 FOR EMBANKMENT COMPLETION.
3. EXISTING LIGHTING SHALL BE MAINTAINED THROUGHOUT THE PROJECT AREA UNTIL NEW TOWER LIGHTING IS OPERATIONAL.
4. THE BAXTER BOULEVARD BRIDGES TO I-295 MAY BE CLOSED WHENEVER THE CONTRACTOR DESIRES.
5. PEDESTRIAN TRAFFIC THROUGH THE PROJECT AREA SHALL BE PROHIBITED.
6. EXISTING UNDERGROUND UTILITIES SHALL REMAIN IN SERVICE UNTIL THE NEW RELOCATIONS ARE PUT IN SERVICE. REFER TO UTILITY COORDINATION SPECIFICATION FOR DETAILS OF REQUIRED COORDINATION.
7. THE TWO UTILITY CROSSINGS OF I-295 AT STATIONS 151+00 AND 161+00 SHALL BE THE RESPONSIBILITY OF THE CONTRACTOR. THESE CROSSINGS SHALL BE MADE BY OPEN CUTTING AT PERIODS OF LOW TRAFFIC VOLUMES, EITHER AT NIGHT OR ON A SUNDAY.
8. TRAFFIC SHALL BE SHIFTED ON TUKEY'S BRIDGE TO THE NEWLY CONSTRUCTED DECK ON JULY 1, 1986. SOUTH BOUND TRAFFIC SHALL BE SHIFTED ON TUKEY'S BRIDGE TO THE NEWLY CONSTRUCTED NORTH BOUND DECK ON SEPTEMBER 1, 1986.



PROJECT DESIGN ENGINEER	BY	DATE
DESIGN - DETAILED		
REVISION		
FIELD CHANGES		

BRUNING 44132 45710-1

103-302

STATE OF MAINE
 DEPARTMENT OF TRANSPORTATION
 I-295 PORTLAND
CONSTRUCTION PHASING PLAN
 NORTH INTERCHANGE
 SHEET 63 OF 130 AUGUSTA, MAINE

F.R.D. NO.	STATE	PROJECT NUMBER	SHEET NO.	TOTAL SHEETS
1	MAINE	R-295-3106/50	64	130

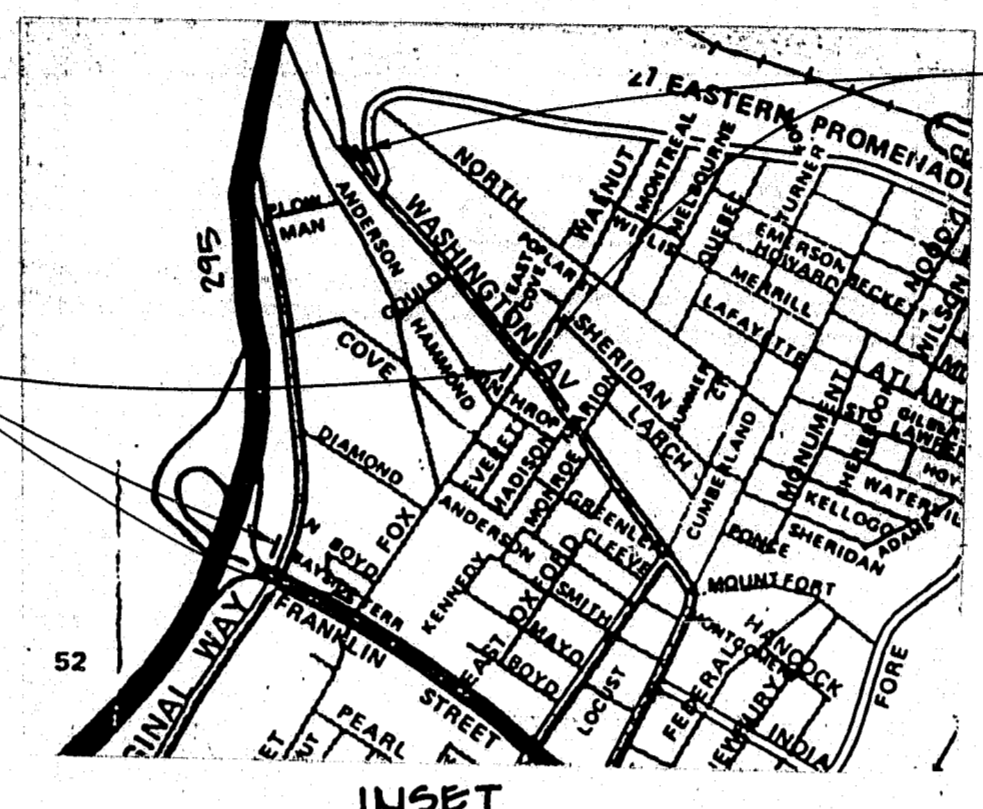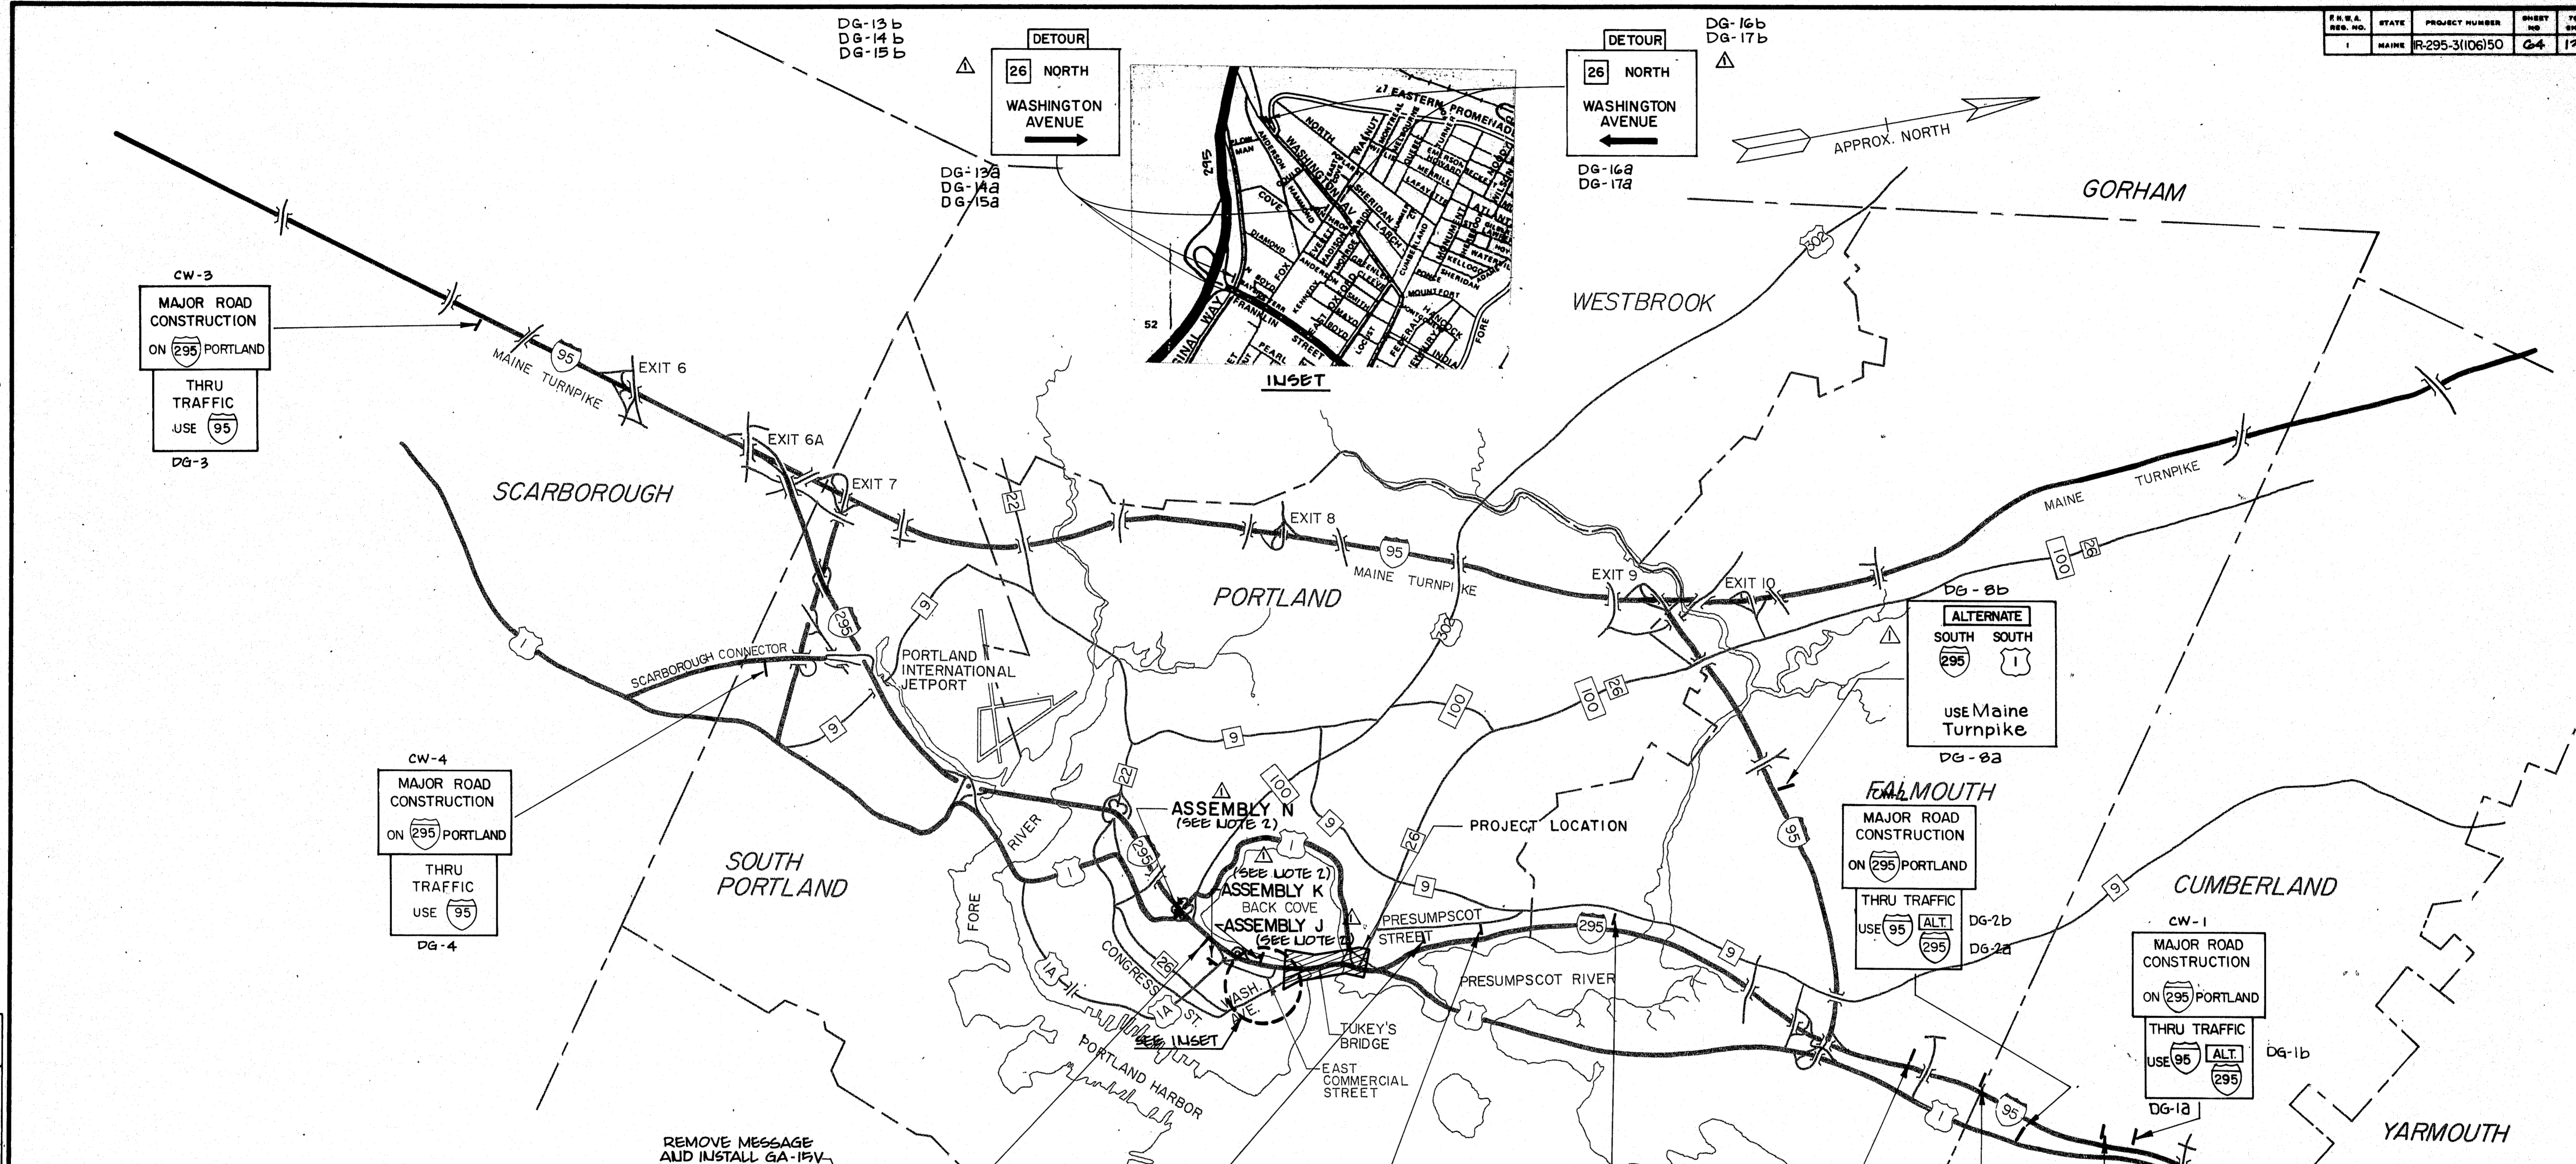

CW-3
MAJOR ROAD CONSTRUCTION
ON 295 PORTLAND
THRU TRAFFIC USE 95
DG-3

CW-4
MAJOR ROAD CONSTRUCTION
ON 295 PORTLAND
THRU TRAFFIC USE 95
DG-4


REMOVE MESSAGE AND INSTALL GA-15V
CAPE ELIZABETH
GA-15V
DETOUR
GA-15b
EXISTING SIGN
Washington Ave.
EXIT LEFT 1 MILE
GA-15a
LEFT LANE
GA-15W
(SEE NOTE 2)

1 SOUTH BAXTER BLVD. BRIDGE CLOSED 1/2 MILE CW-7
1 SOUTH BAXTER BLVD. BRIDGE CLOSED 1 MILE CW-6
1 SOUTH BAXTER BLVD. BRIDGE CLOSED 2 MILES CW-5

DG-7C EXIT 15 ALTERNATE SOUTH SOUTH 295 SOUTH Saco Kittery 1/2 MILE DG-7A
DG-6C EXIT 15 ALTERNATE SOUTH SOUTH 295 SOUTH Saco Kittery 1 MILE DG-6A
DG-5C EXIT 15 ALTERNATE SOUTH SOUTH 295 SOUTH Saco Kittery 2 MILES DG-5A

DG-8b ALTERNATE SOUTH SOUTH 295 SOUTH use Maine Turnpike DG-8a

CW-1 MAJOR ROAD CONSTRUCTION ON 295 PORTLAND THRU TRAFFIC USE 95 ALT 295 DG-1b
DG-1a

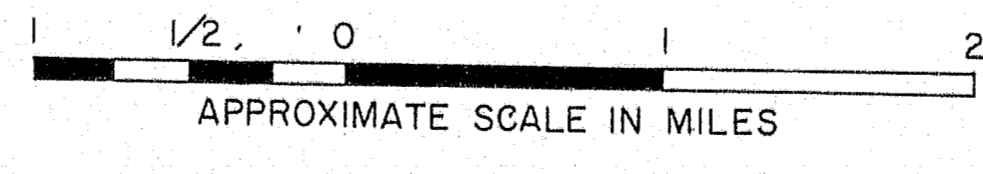

- NOTES:
- ADVISORY SIGNING AND SUPPORTS SHALL BE PAID FOR UNDER ITEM NO. 092.99, CONSTRUCTION SIGNING.
 - THE FOLLOWING CHANGES SHALL BE MADE WHEN TRAFFIC IS DIRECTED AS SHOWN ON THE INTERMEDIATE TRAFFIC PLAN, STEP 2:
 - ALTER ASSEMBLY K TO CONFORM WITH ASSEMBLY L AND RESET AT THE EXIT RAMP, SHOWN AS #
 - ALTER ASSEMBLY J TO CONFORM WITH ASSEMBLY C
 - ERECT ASSEMBLY L AT THE NORTHBOUND ENTRANCE RAMP
 - ALTER EXISTING SIGN GA-15a
 - SET UP DETOUR SHOWN IN INSET

PROJECT ENGINEER	DATE
DESIGN - DETAILED	
CHECKED	
REVISIONS	
FIELD CHANGES	

PLANS


REV.	DESCRIPTION	BY	DATE
1	INSET	BNA	6-6-85
2	ADDITIONAL SIGNS	BNA	6-6-85
3	NOTE 2, ASSEMBLY L	BNA	6-6-85

STATE OF MAINE
DEPARTMENT OF TRANSPORTATION
I-295 PORTLAND

ADVISORY SIGNING PLAN

103-303

F.S.M.A. REG. NO.	STATE	PROJECT NUMBER	SHEET NO.	TOTAL SHEETS
1	MAINE	R-295-3(108)50	07	120

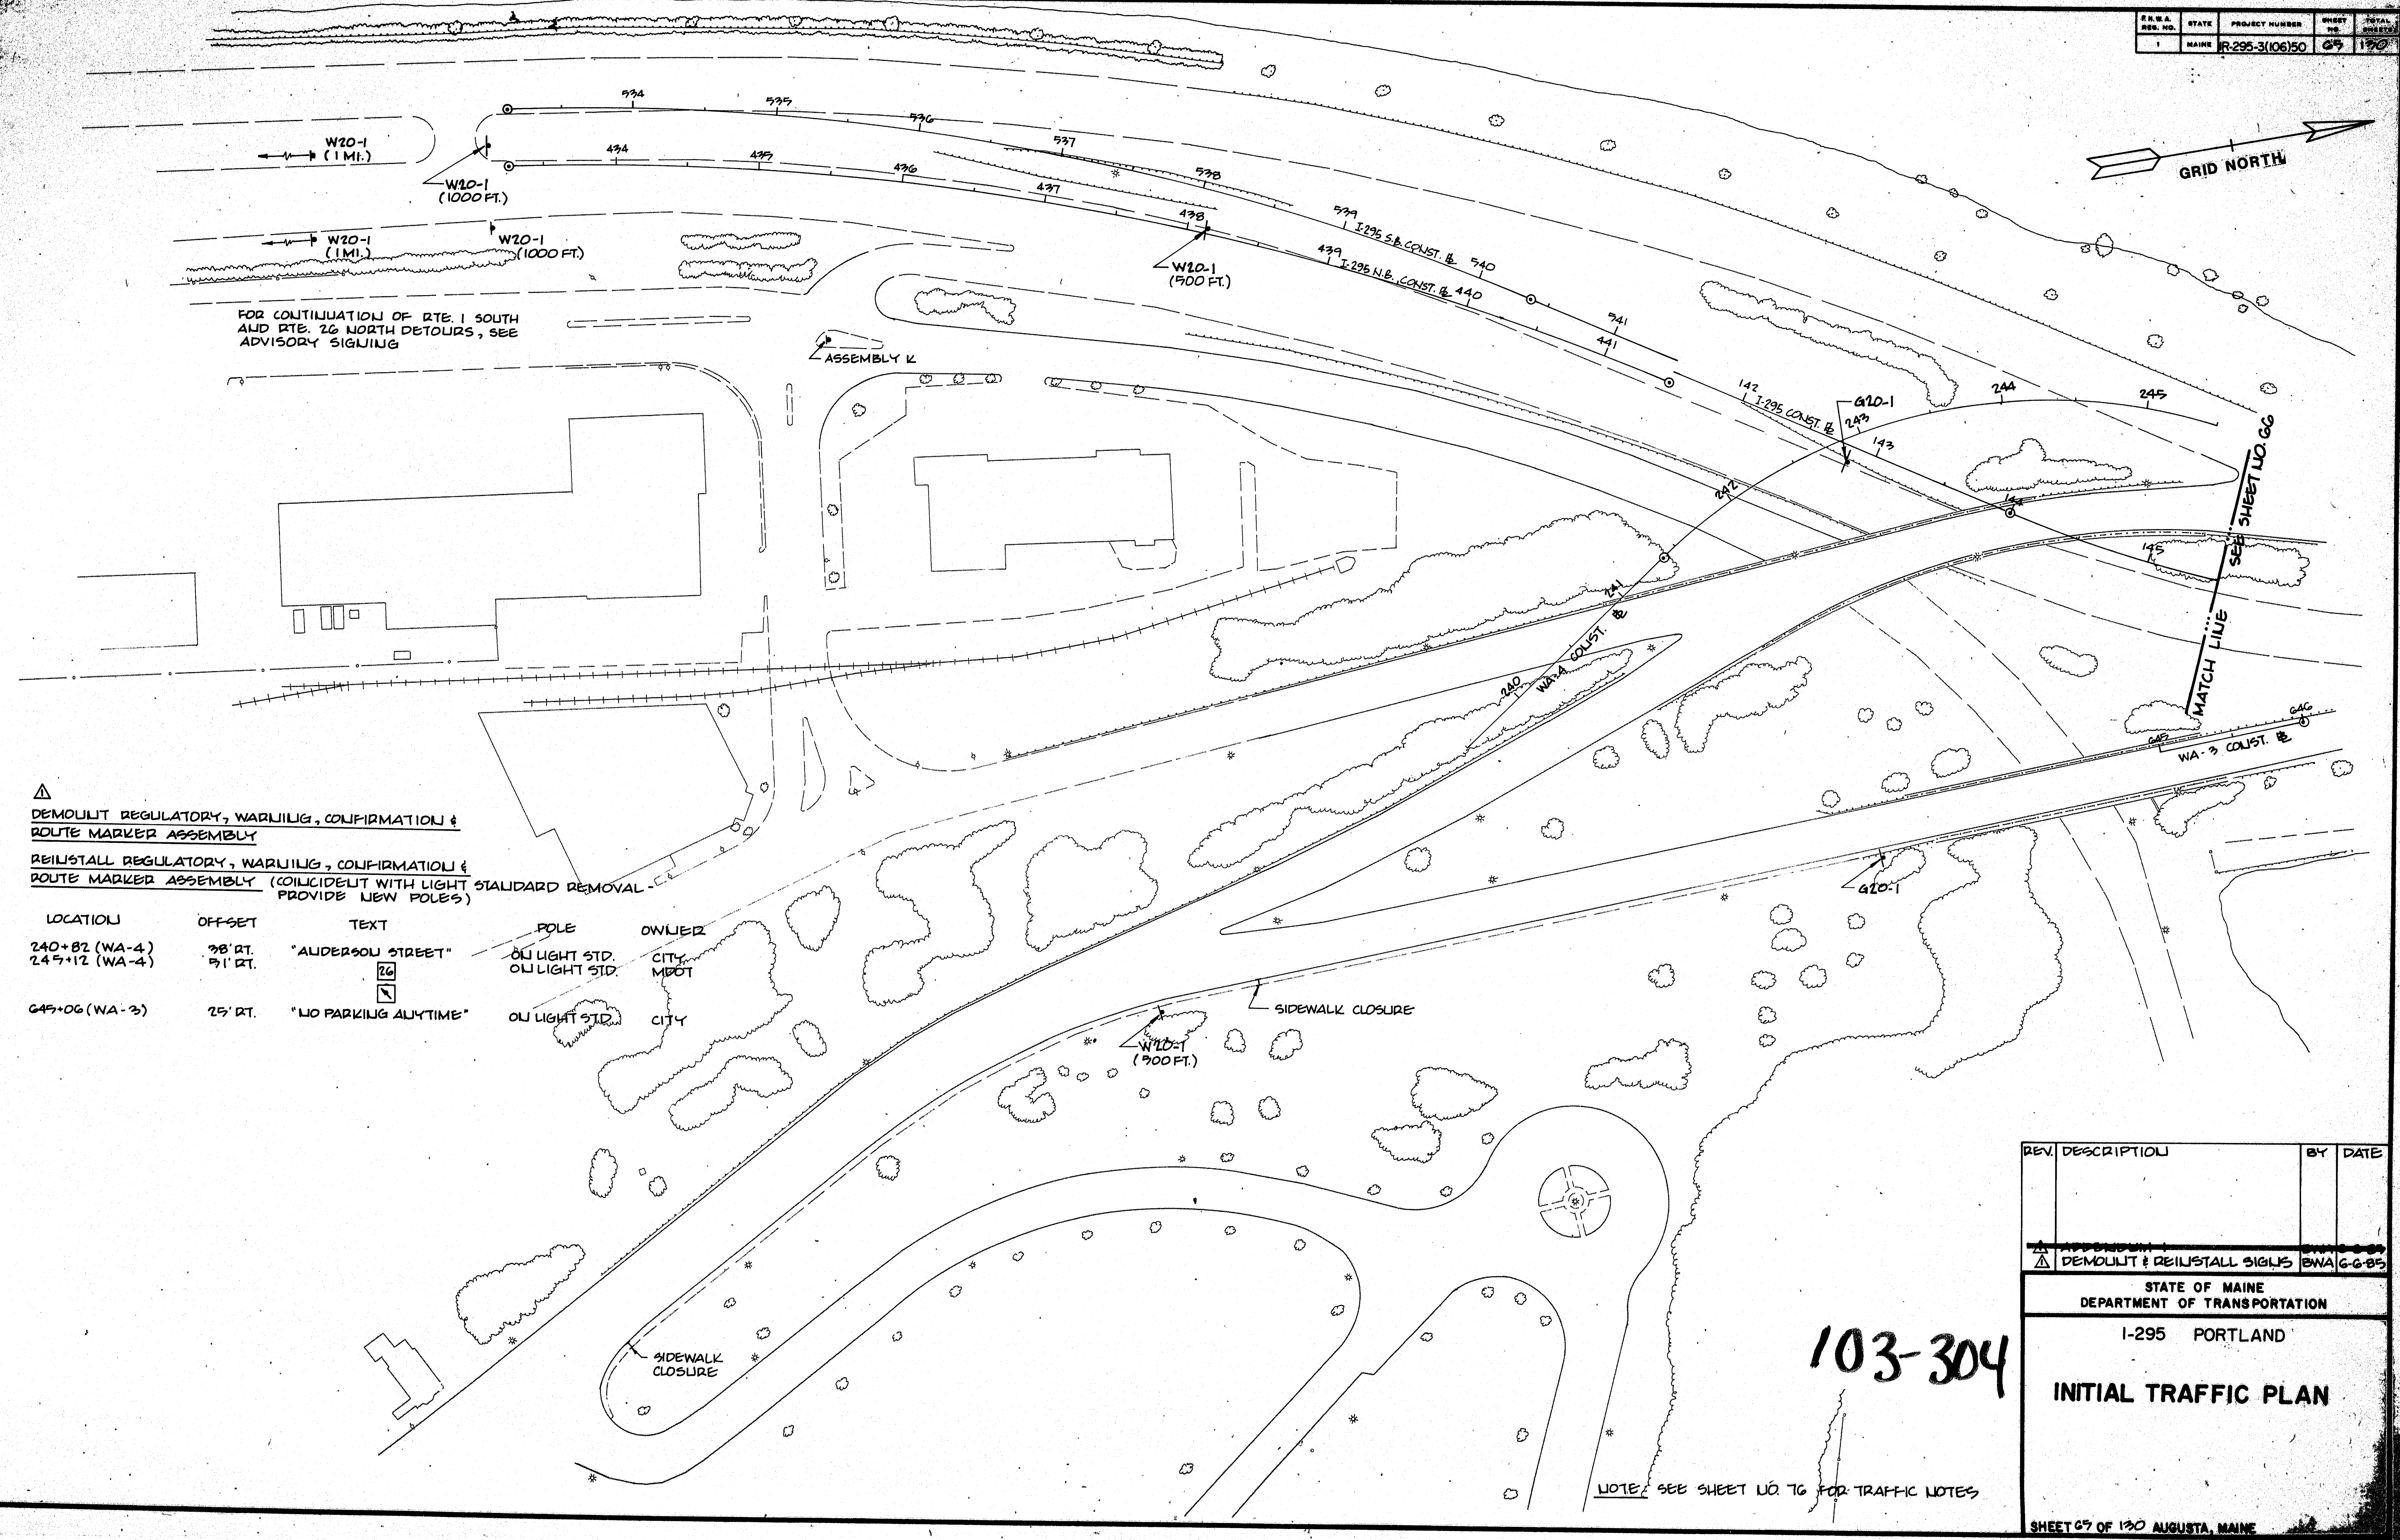

FOR CONTINUATION OF RTE. 1 SOUTH AND RTE. 26 NORTH DETOURS, SEE ADVISORY SIGNING

▲ DEMOLIT REGULATORY, WARNING, CONFIRMATION & ROUTE MARKER ASSEMBLY
 REINSTALL REGULATORY, WARNING, CONFIRMATION & ROUTE MARKER ASSEMBLY (COINCIDENT WITH LIGHT STANDARD REMOVAL PROVIDE NEW POLES)

LOCATION	OFF-SET	TEXT	POLE	OWNER
240+82 (WA-4)	38' RT.	"ANDERSON STREET"	OL LIGHT STD.	CITY
245+12 (WA-4)	31' RT.	26	OL LIGHT STD.	MBOT
645+06 (WA-3)	75' RT.	"NO PARKING ANYTIME"	OL LIGHT STD.	CITY

PROJECT DESIGN ENGINEER	BY	DATE
DESIGN - DETAILED		
CHECKED		
REVISIONS		
FIELD CHANGES		

PLANS

REV.	DESCRIPTION	BY	DATE
1	APPENDIX 1 DEMOLIT & REINSTALL SIGNS	BWA	6-6-82

STATE OF MAINE
 DEPARTMENT OF TRANSPORTATION
 I-295 PORTLAND

103-304

INITIAL TRAFFIC PLAN


NOTE: SEE SHEET NO. 76 FOR TRAFFIC NOTES

SHEET 07 OF 120 AUGUSTA, MAINE

F.R.A. NO.	STATE	PROJECT NUMBER	SHEET NO.	TOTAL SHEETS
1	MAINE	IR-295-3(106)50	66	120

DEMOUNT GUIDE SIGN
REINSTALL GUIDE SIGN (REINSTALL SIGNS ON NEW SIGN TRUSS)

LOCATION: 158+00 (I-295)
 OFFSET: OVERHEAD


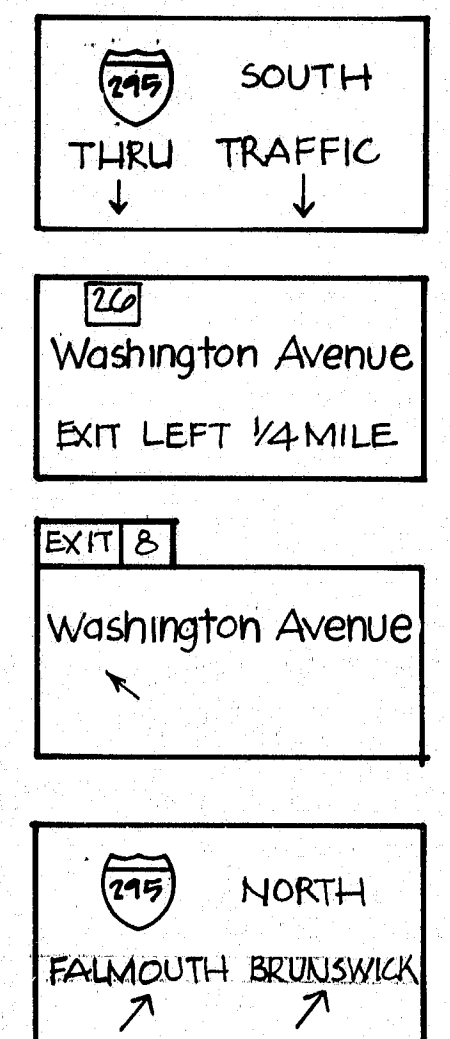


DEMOUNT REGULATORY WARNING CONFIRMATION AND ROUTE MARKER ASSEMBLY

LOCATION	OFFSET	TEXT	POLE	OWNER
158+30 (I-295)	41' LT.	(IA)	ON LIGHT STANDARD	MDOT
250+28 (WA-4)	15' LT.	(IA) TRUCK ROUTE	ON LIGHT STANDARD	MDOT

REINSTALL REGULATORY WARNING CONFIRMATION AND ROUTE MARKER ASSEMBLY

LOCATION	OFFSET	TEXT
158+30 (I-295)	43' LT.	(IA)
250+28 (WA-4)	17' LT.	(IA) TRUCK ROUTE

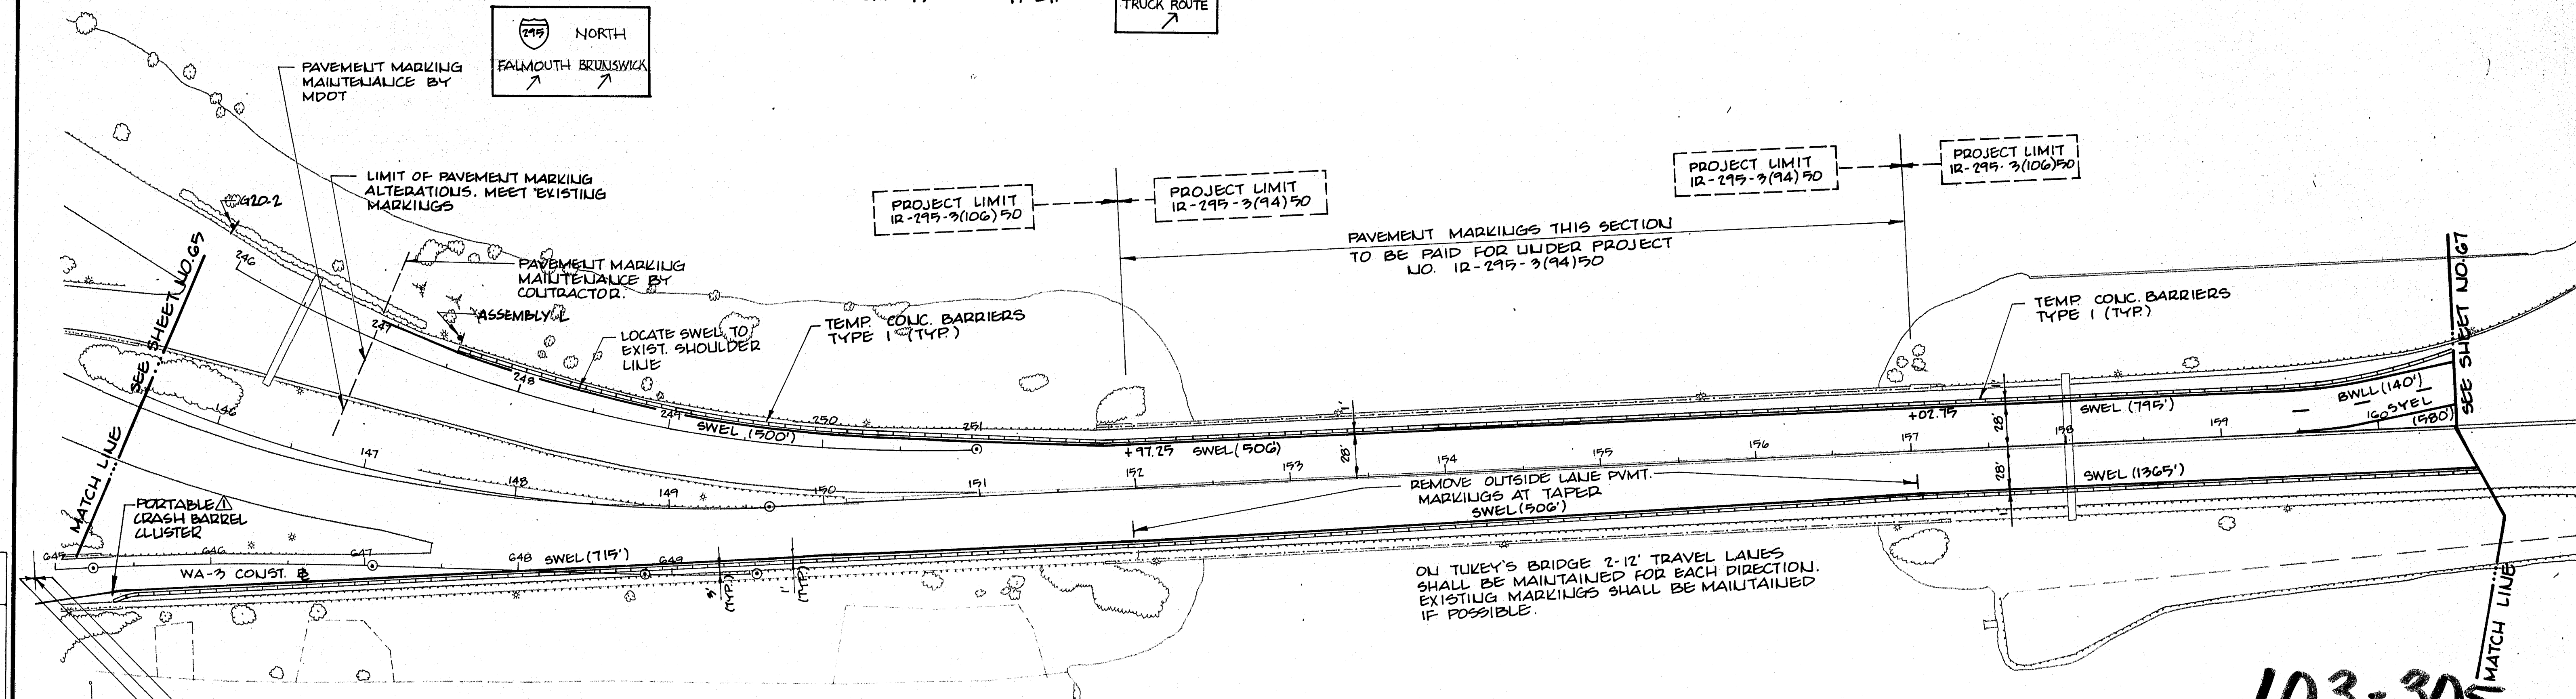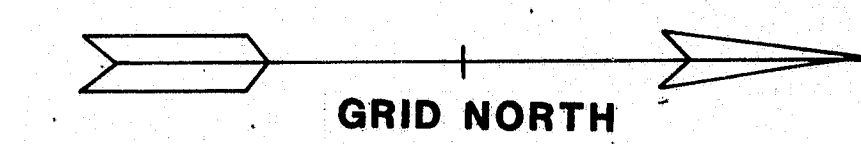

PROJECT DESIGN ENGINEER	DATE
DESIGN - DETAILED	
CHECKED	
REVISIONS	
FIELD CHANGES	

PLANS

DRAWING 44132 07/10/1

103-305

REV	DESCRIPTION	BY	DATE
1	CRASH BARRELS	BWA	0.0.05


STATE OF MAINE
 DEPARTMENT OF TRANSPORTATION
 I-295 PORTLAND
INITIAL TRAFFIC PLAN
 SHEET 66 OF 130 AUGUSTA, MAINE

NOTE: SEE SHEET NO. 76 FOR TRAFFIC NOTES.

DEMOLITION REGULATORY, WARNING, CONFIRMATION, &
ROUTE MARKER ASSEMBLY

F.W.A. REG. NO.	STATE	PROJECT NUMBER	SHEET NO.	TOTAL SHEETS
1	MAINE	R-295-3(106)50	67	130

LOCATION	RT.	TEXT	POLE	OWNER
BAXTER BLVD N.B.	RT.	WASHINGTON AVE. SOUTH BOUND	WOOD	MDOT
97+79 (BB-1)	23' RT.	"SPEED LIMIT 40"	WOOD	MDOT
97+16 (BB-1)	15' RT.	"EMERGENCY SLOW ROUTE" "TOW AWAY ZONE"	CHANNEL	CITY OF PORTLAND
99+46 (BB-1)	16' LT.	BRUNSWICK GRAY	WOOD	MDOT
97+72 (BB-1)	129' LT.	"YIELD"	—	CITY OF PORTLAND
10+98 (BATES)	59' LT.	BRUNSWICK BAXTER BLVD.	(ON LIGHT STD.)	MDOT
100+06 (BB-1)	59' LT.	"STOP", "ONE WAY"	CHANNEL	CITY OF PORTLAND
10+27 (BATES)	57' LT.	"STOP"	CHANNEL	CITY OF PORTLAND
10+97 (BB-1)	88' LT.	"STOP"	CHANNEL	CITY OF PORTLAND
10+43 (BATES)	89' RT.	LEWISTON GRAY ALL TRUCKS	WOOD	MDOT
196+48 (WA-2)	OVER-HEAD	ONLY	OLU MAST ARM	MDOT
101+92 (BB-1)	25' LT.	NORTH	WOOD	MDOT
103+43 (BB-1)	42' LT.	"DO NOT ENTER"	WOOD	MDOT
107+55 (BB-2)	70' RT.	"STOP AHEAD"	WOOD	MDOT
102+94 (BB-1)	8' RT.	"STOP AHEAD"	WOOD	MDOT
102+78 (BB-1)	44' RT.	"STOP AHEAD"	WOOD	MDOT
BAXTER BLVD BRDG.	(10)		CHANNEL	MDOT
BAXTER BLVD BRDG.		"YIELD AHEAD"	WOOD	MDOT
107+80 (1-295)	32' RT.	"YIELD"	WOOD	MDOT
107+00 (1-295)	32' LT.	"30 MPH"	WOOD	MDOT
302+83 (WA-2)	39' RT.	"MERGE"	WOOD	MDOT
303+26 (WA-2)	40' RT.	"STOP"	ALUM.	MDOT
303+87 (WA-2)	40' RT.	"STOP"	WOOD	MDOT
(1-295)		"40 MPH"	(ON LIGHT STD.)	MDOT
10+16 (WATER ST.)	24' RT.	"DO NOT ENTER", "WIDENING WAY"	WOOD	CITY OF PORTLAND
10+16 (WATER ST.)	18' LT.	"RIGHT TURN ONLY"	CHANNEL	CITY OF PORTLAND
10+19 (WATER ST.)	90' LT.	"STOP"	CHANNEL	CITY OF PORTLAND
109+97 (BB-1)	2' LT.	"MERGE"	WOOD	MDOT

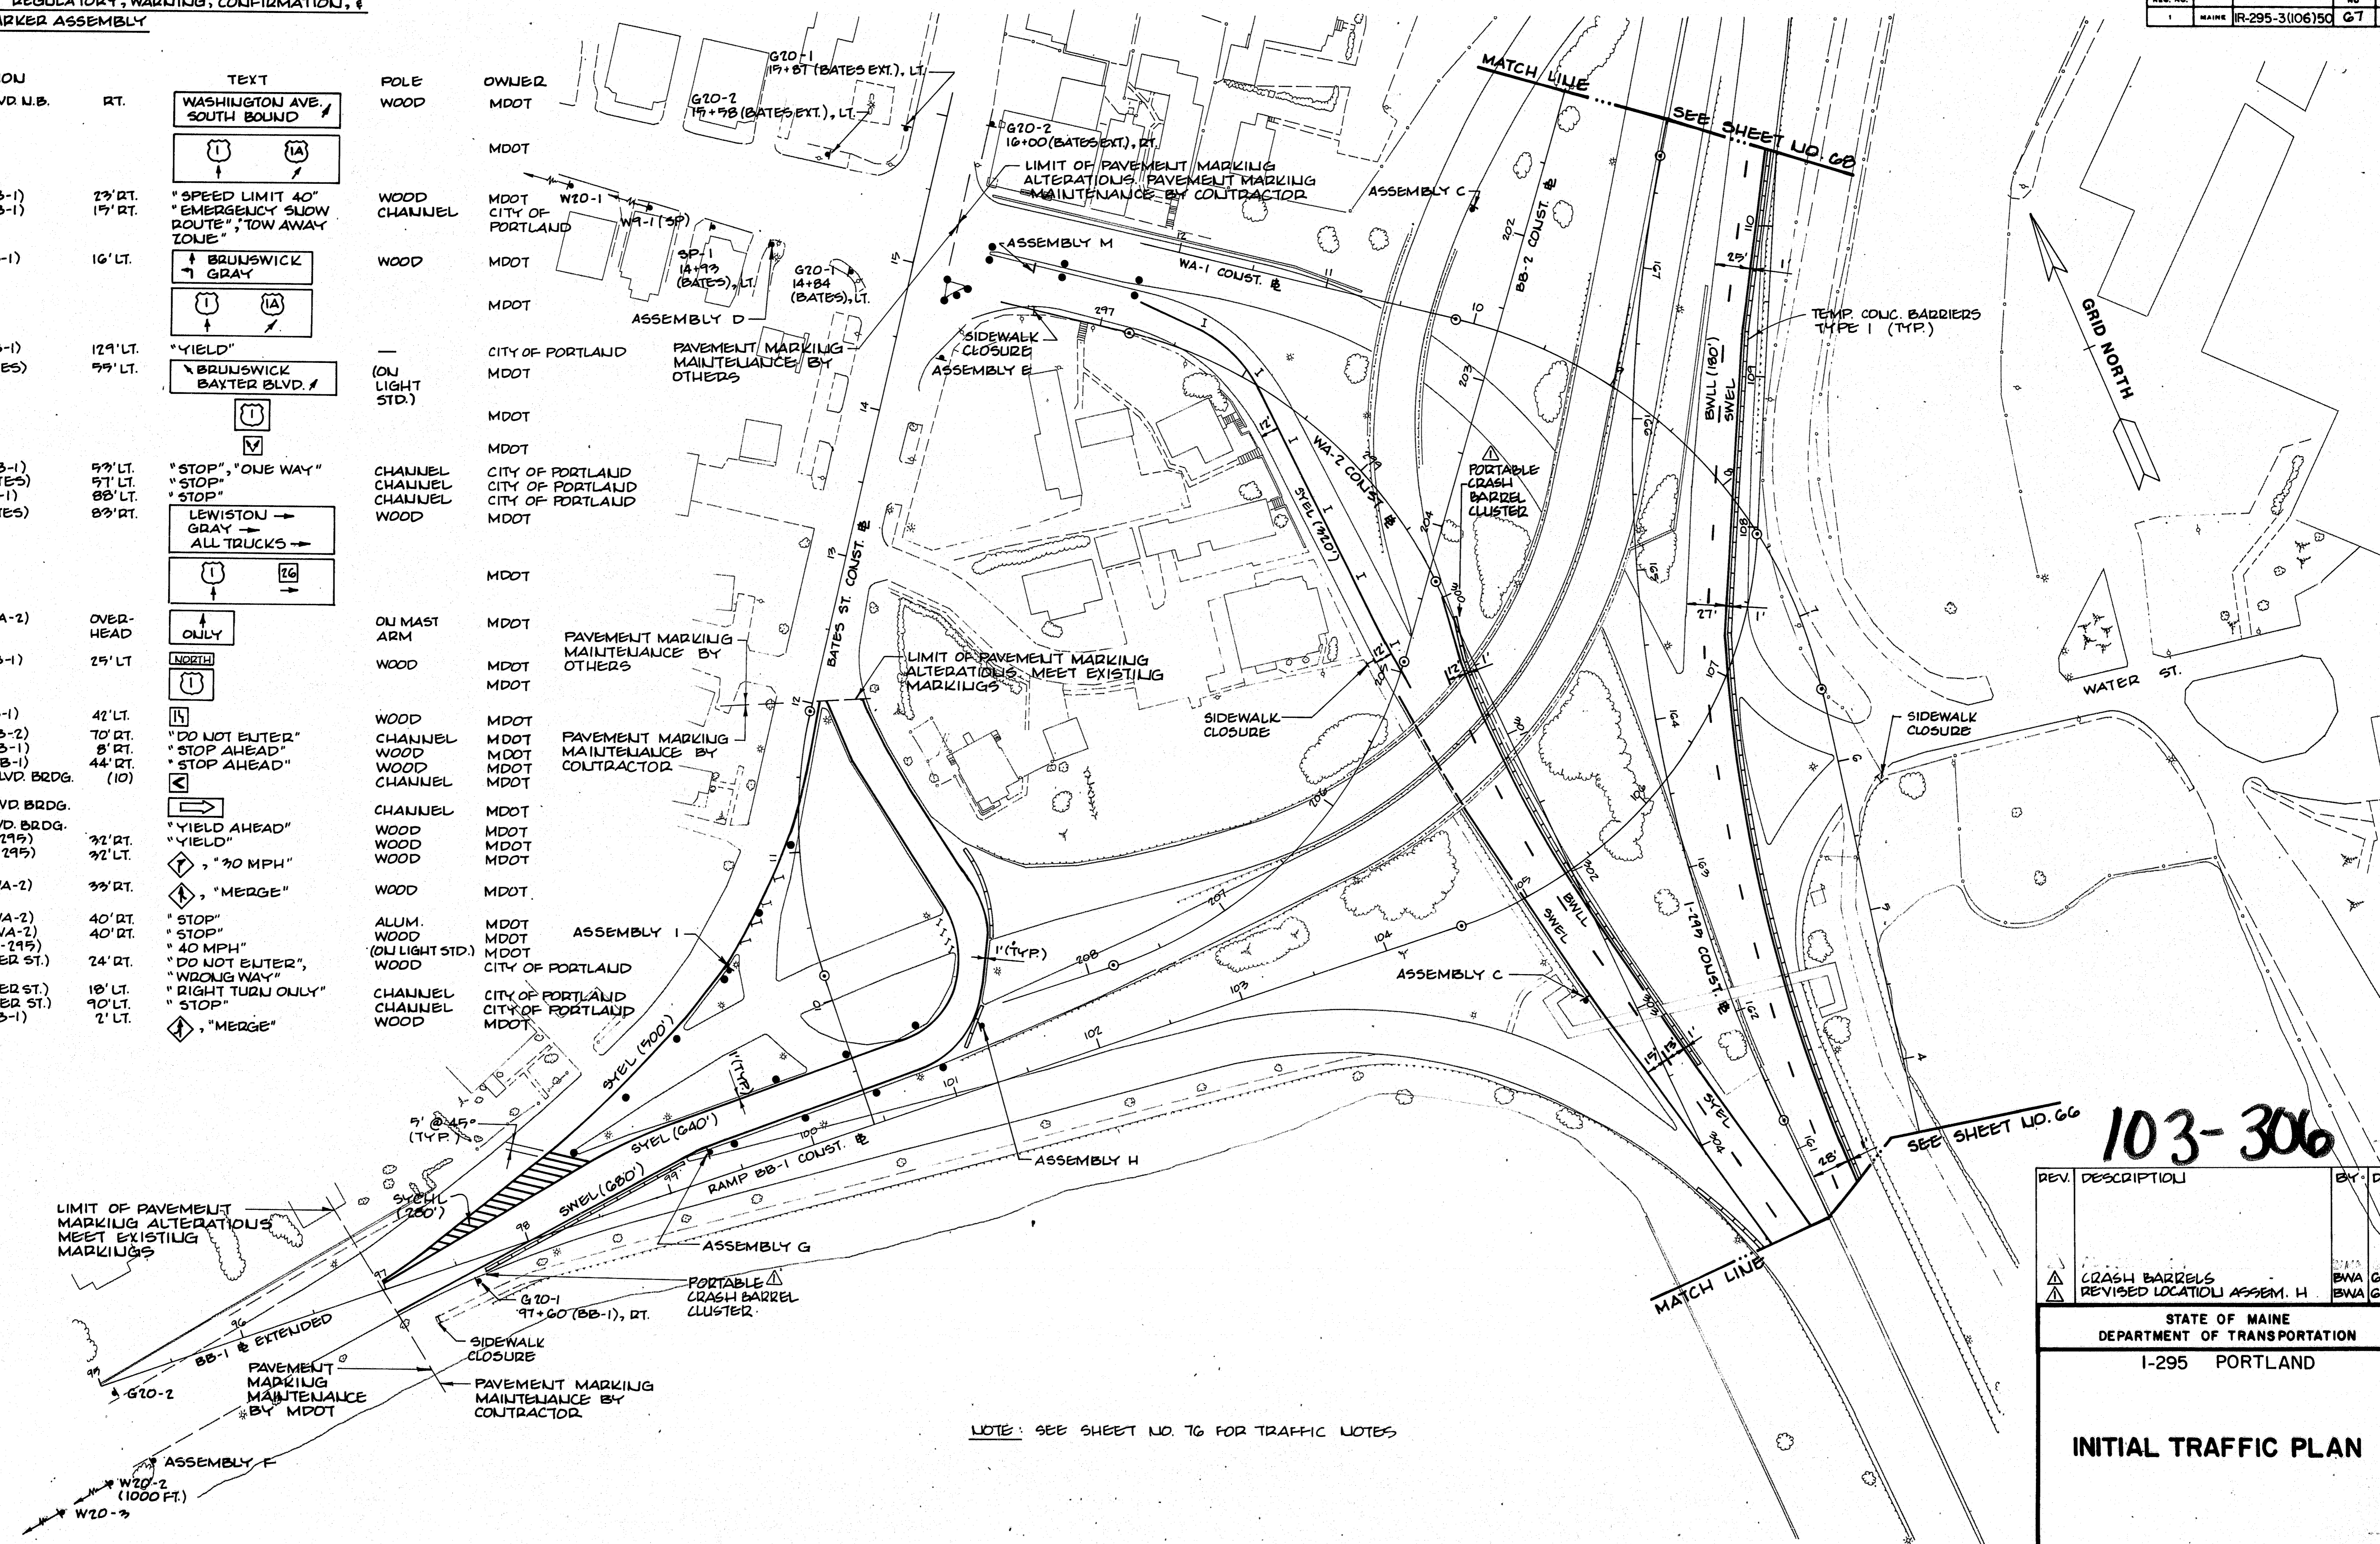

NOTE: SEE SHEET NO. 76 FOR TRAFFIC NOTES

103-306

PROJECT DESIGN ENGINEER	BY	DATE
DESIGN - DETAILED		
CHECKED		
REVISIONS		
FIELD CORRECTIONS		
PLANS		

REV.	DESCRIPTION	BY	DATE
1	CRASH BARRELS REVISED LOCATION ASSEM. H	BWA	G.G. 8/95
2		BWA	G.G. 8/95


STATE OF MAINE
DEPARTMENT OF TRANSPORTATION
1-295 PORTLAND

INITIAL TRAFFIC PLAN

F.R.E.A. REG. NO.	STATE	PROJECT NUMBER	SHEET NO.	TOTAL SHEETS
1	MAINE	IR-295-3(106)50	68	130




DEMOUNT REGULATORY, WARLING, CONFIRMATION & ROUTE MARKER ASSEMBLY

LOCATION 169+09 (1-295) OFFSET 97' LT. TEXT SOUTH SOUTH POLE 2-WOOD OWNER MDOT

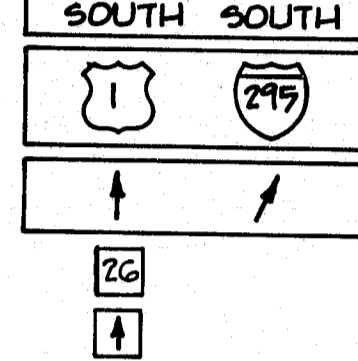

DEMOUNT GUIDE SIGN

LOCATION 172+45 (1-295) OVER-HEAD TRUSS TEXT 26 TO 26 BAXTER BLVD. NO TRUCKS POLE OLI TRUSS OWNER MDOT

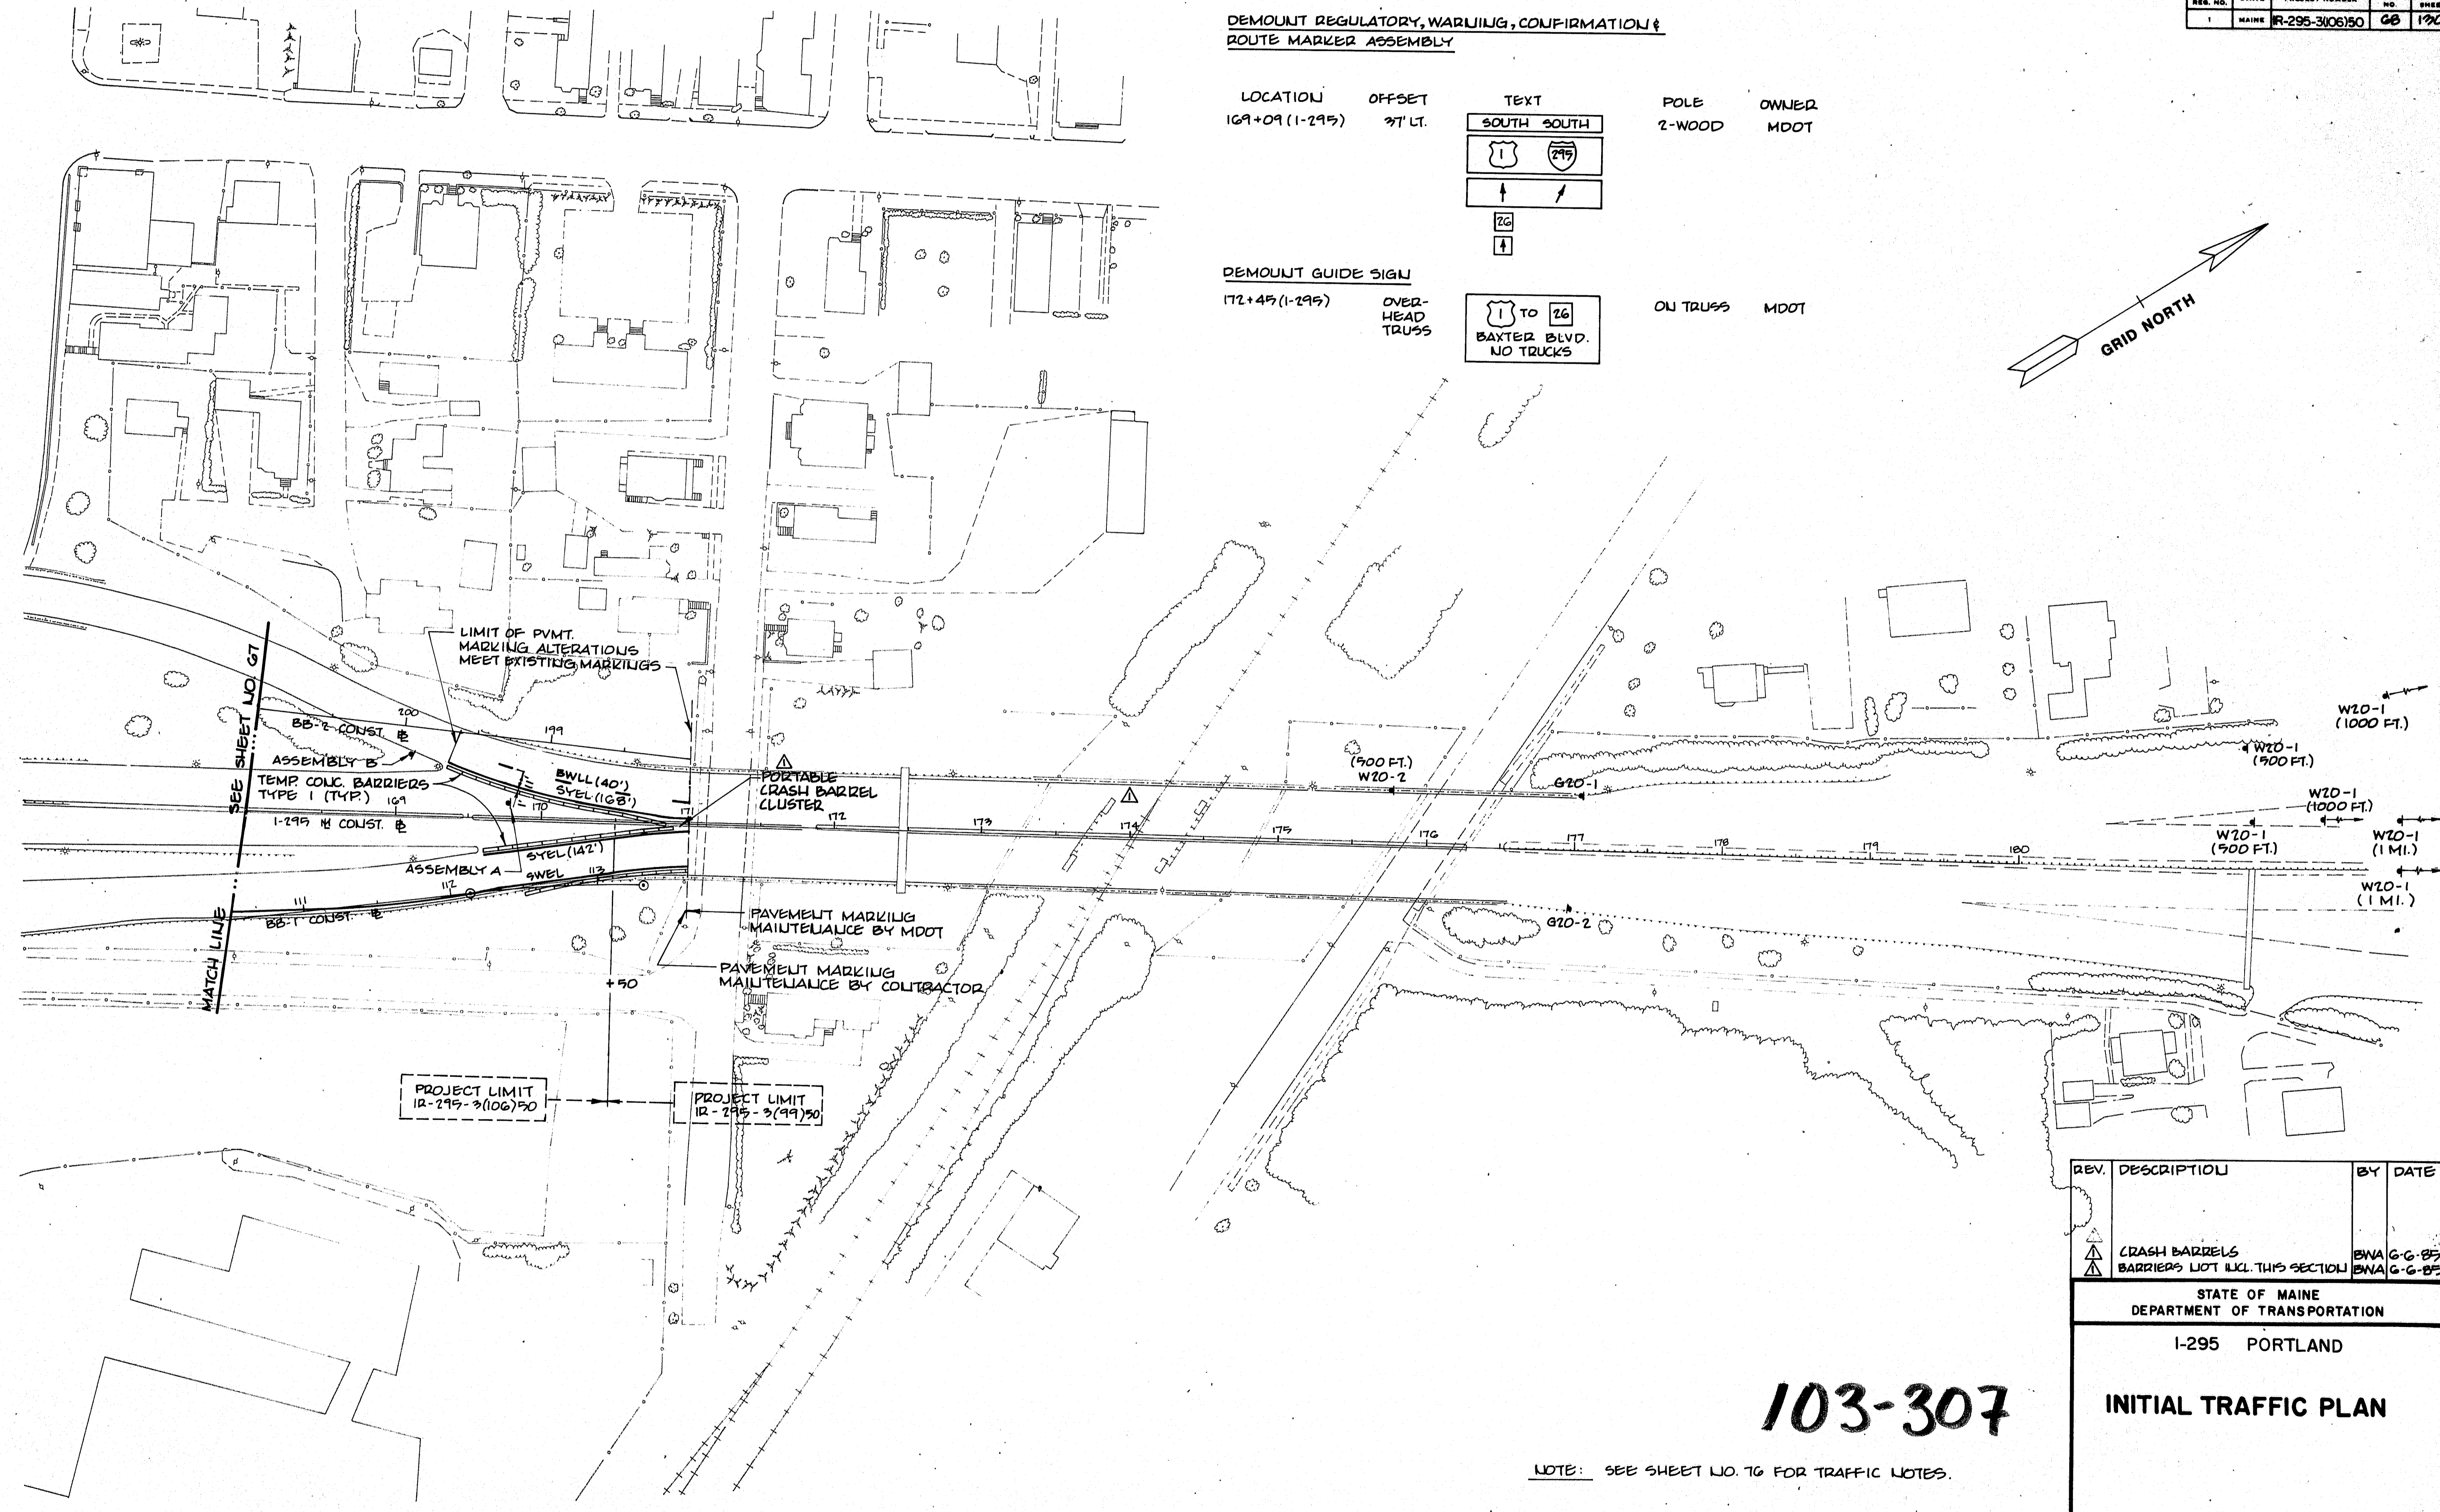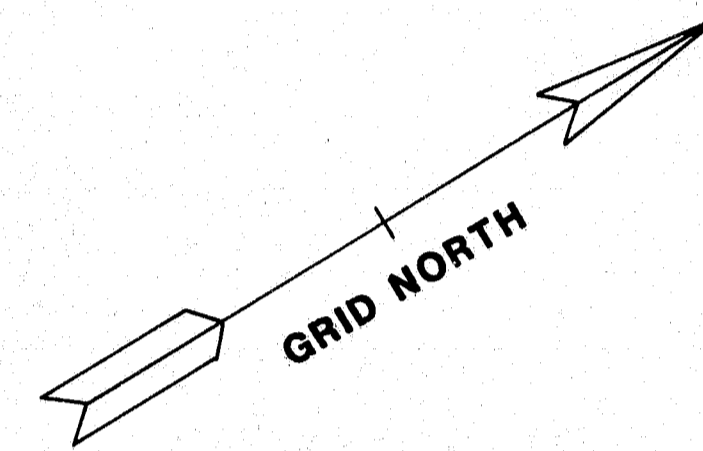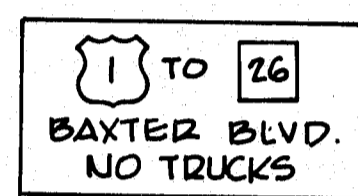

PROJECT DESIGN ENGINEER	BY	DATE
DESIGN - DETAILED		
CHECKED		
REVISIONS		
FIELD CHANGES		
PLANS		

BRUNING 44-132-457101

103-307

NOTE: SEE SHEET NO. 76 FOR TRAFFIC NOTES.

REV.	DESCRIPTION	BY	DATE
1	CRASH BARRELS BARRIERS LOT EXCL THIS SECTION	BWA	G-G-85
2		BWA	G-G-85


STATE OF MAINE
DEPARTMENT OF TRANSPORTATION

I-295 PORTLAND

INITIAL TRAFFIC PLAN

SHEET 68 OF 130 AUGUSTA, MAINE

F.R.A. NO.	STATE	PROJECT NUMBER	SHEET NO.	TOTAL SHEETS
1	MAINE	12-295-3(106)70	69	130

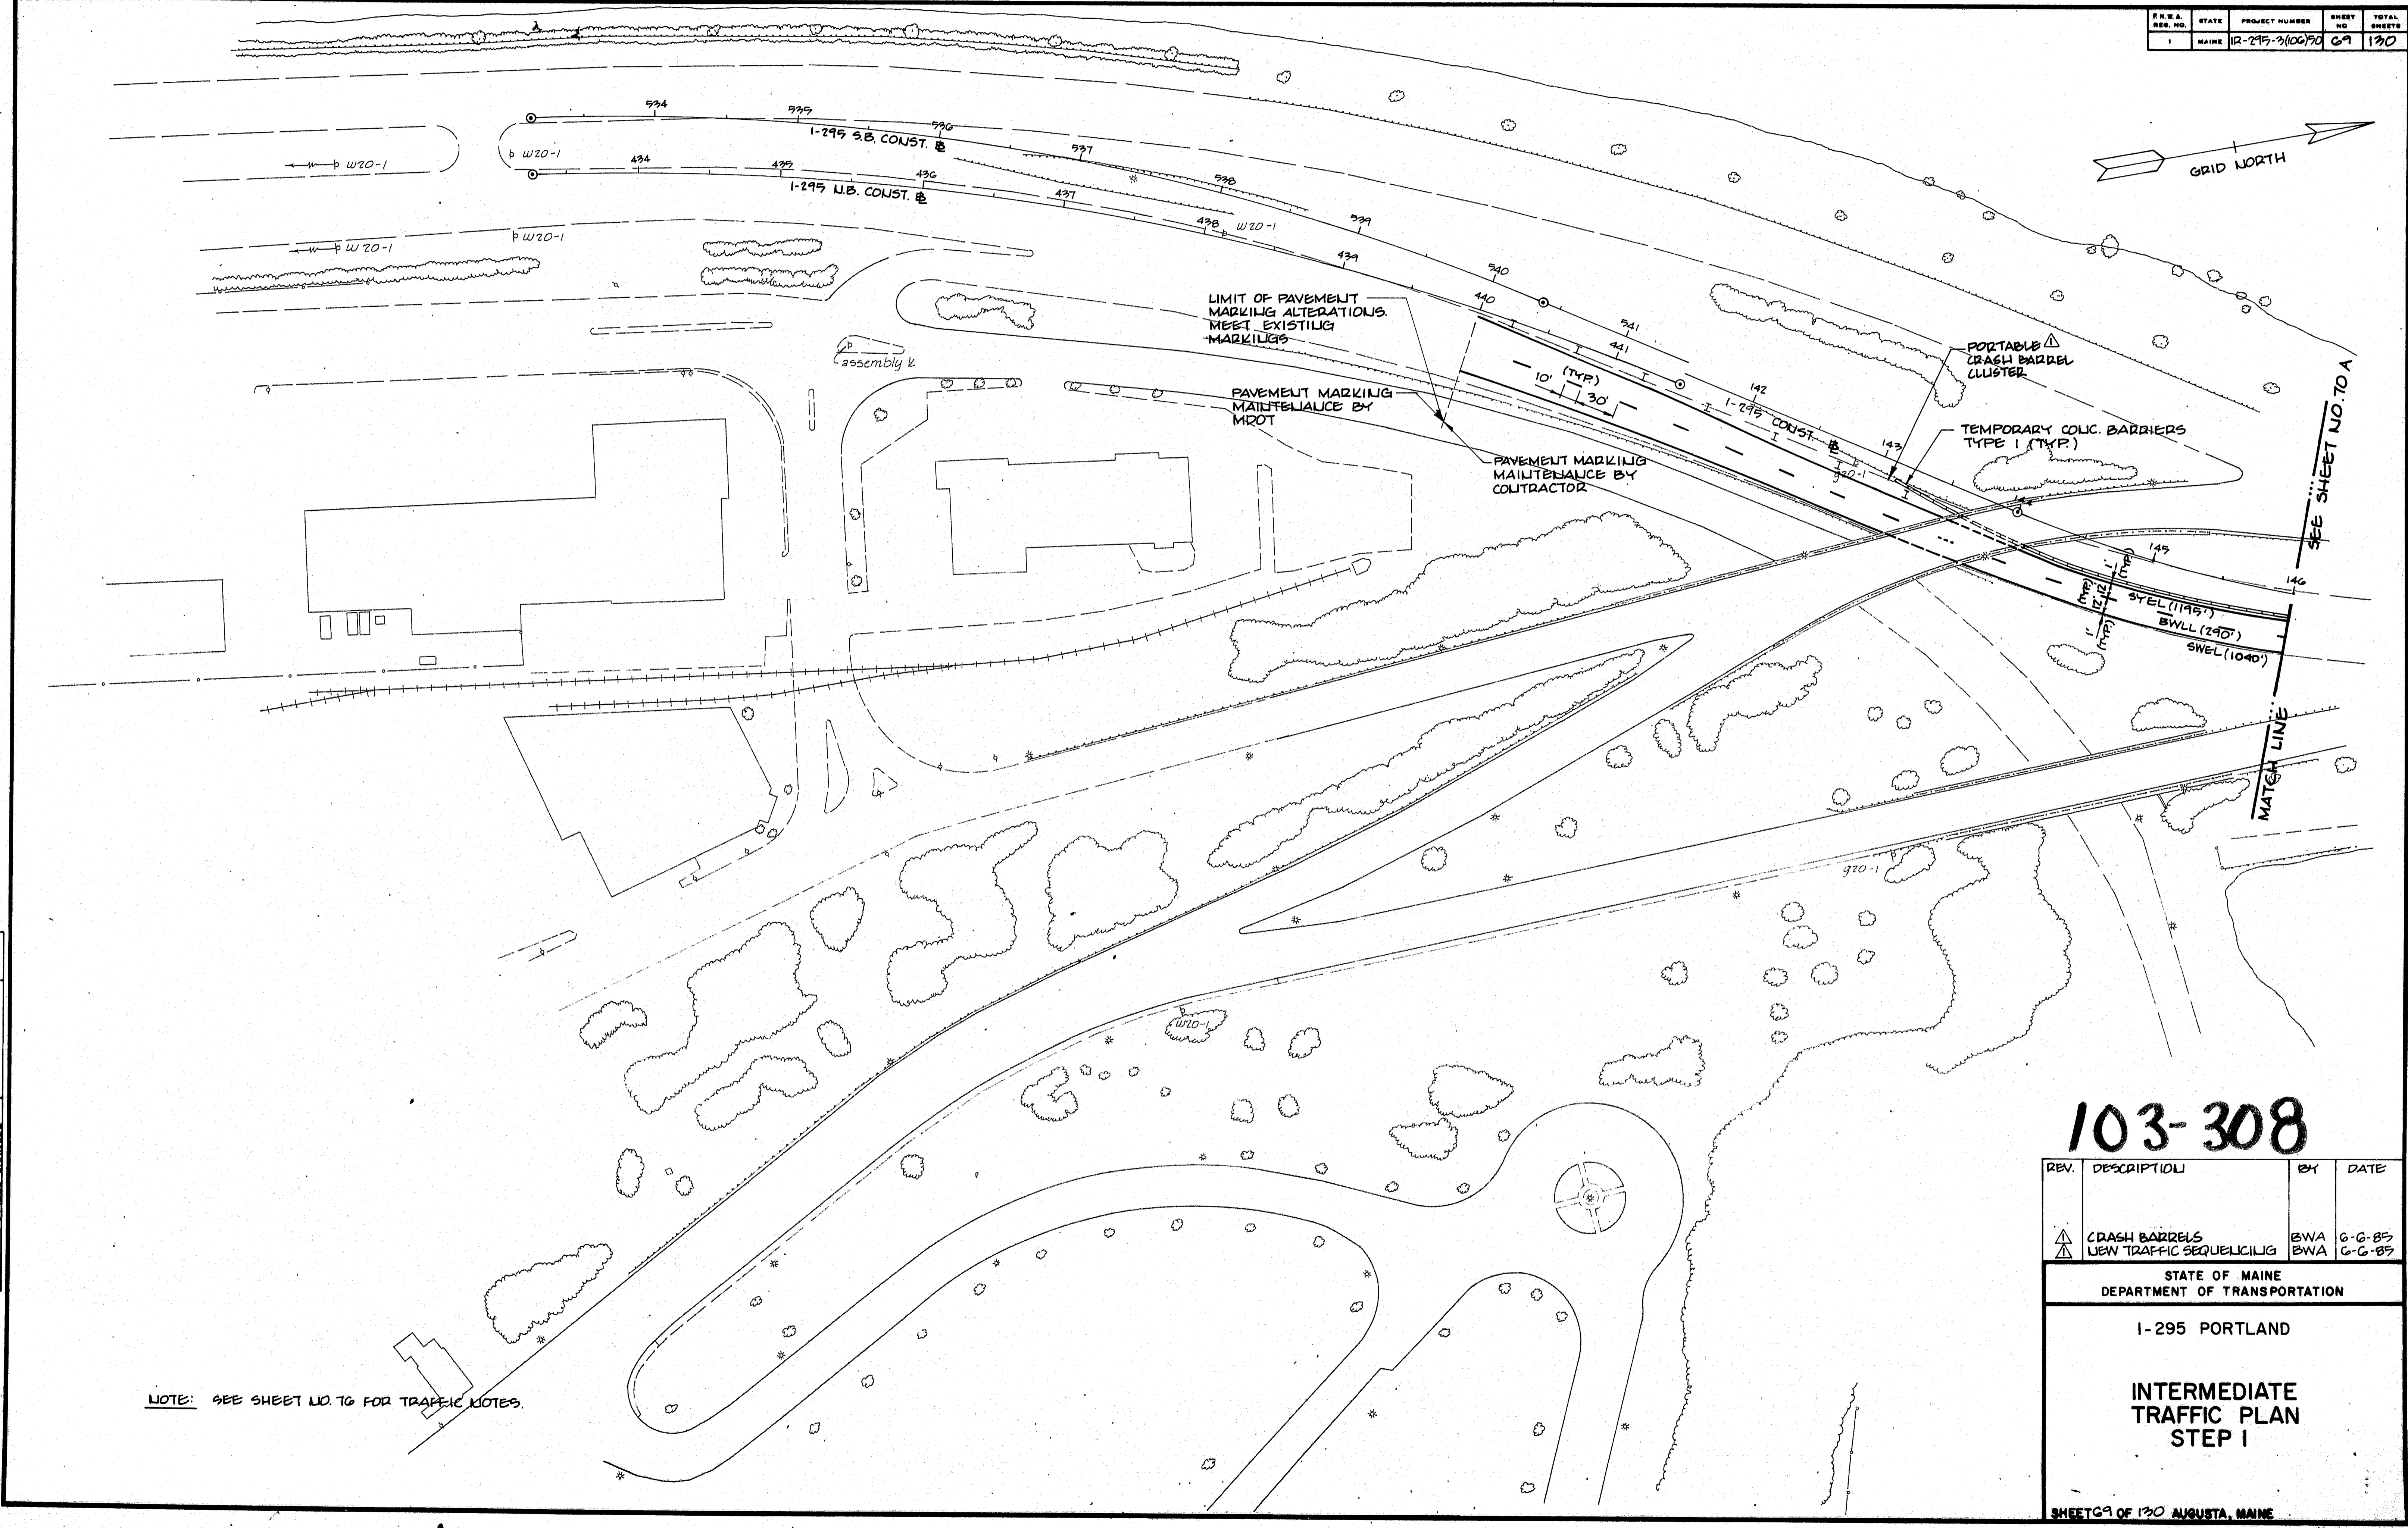

NOTE: SEE SHEET NO. 76 FOR TRAFFIC NOTES.

PROJECT DESIGN ENGINEER	BY	DATE
DESIGN - DETAILED		
CHECKED		
REVISIONS		
FIELD CHANGES		
PLANS		

103-308

REV.	DESCRIPTION	BY	DATE
1	CRASH BARRELS NEW TRAFFIC SEQUENCING	BWA BWA	6-6-85 6-6-85



STATE OF MAINE
DEPARTMENT OF TRANSPORTATION

I-295 PORTLAND

**INTERMEDIATE
TRAFFIC PLAN
STEP I**

SHEET 69 OF 130 AUGUSTA, MAINE

F.R.E.A. DES. NO.	STATE	PROJECT NUMBER	SHEET NO.	TOTAL SHEETS
1	MAINE	12-295-3(106)90	70 A	130

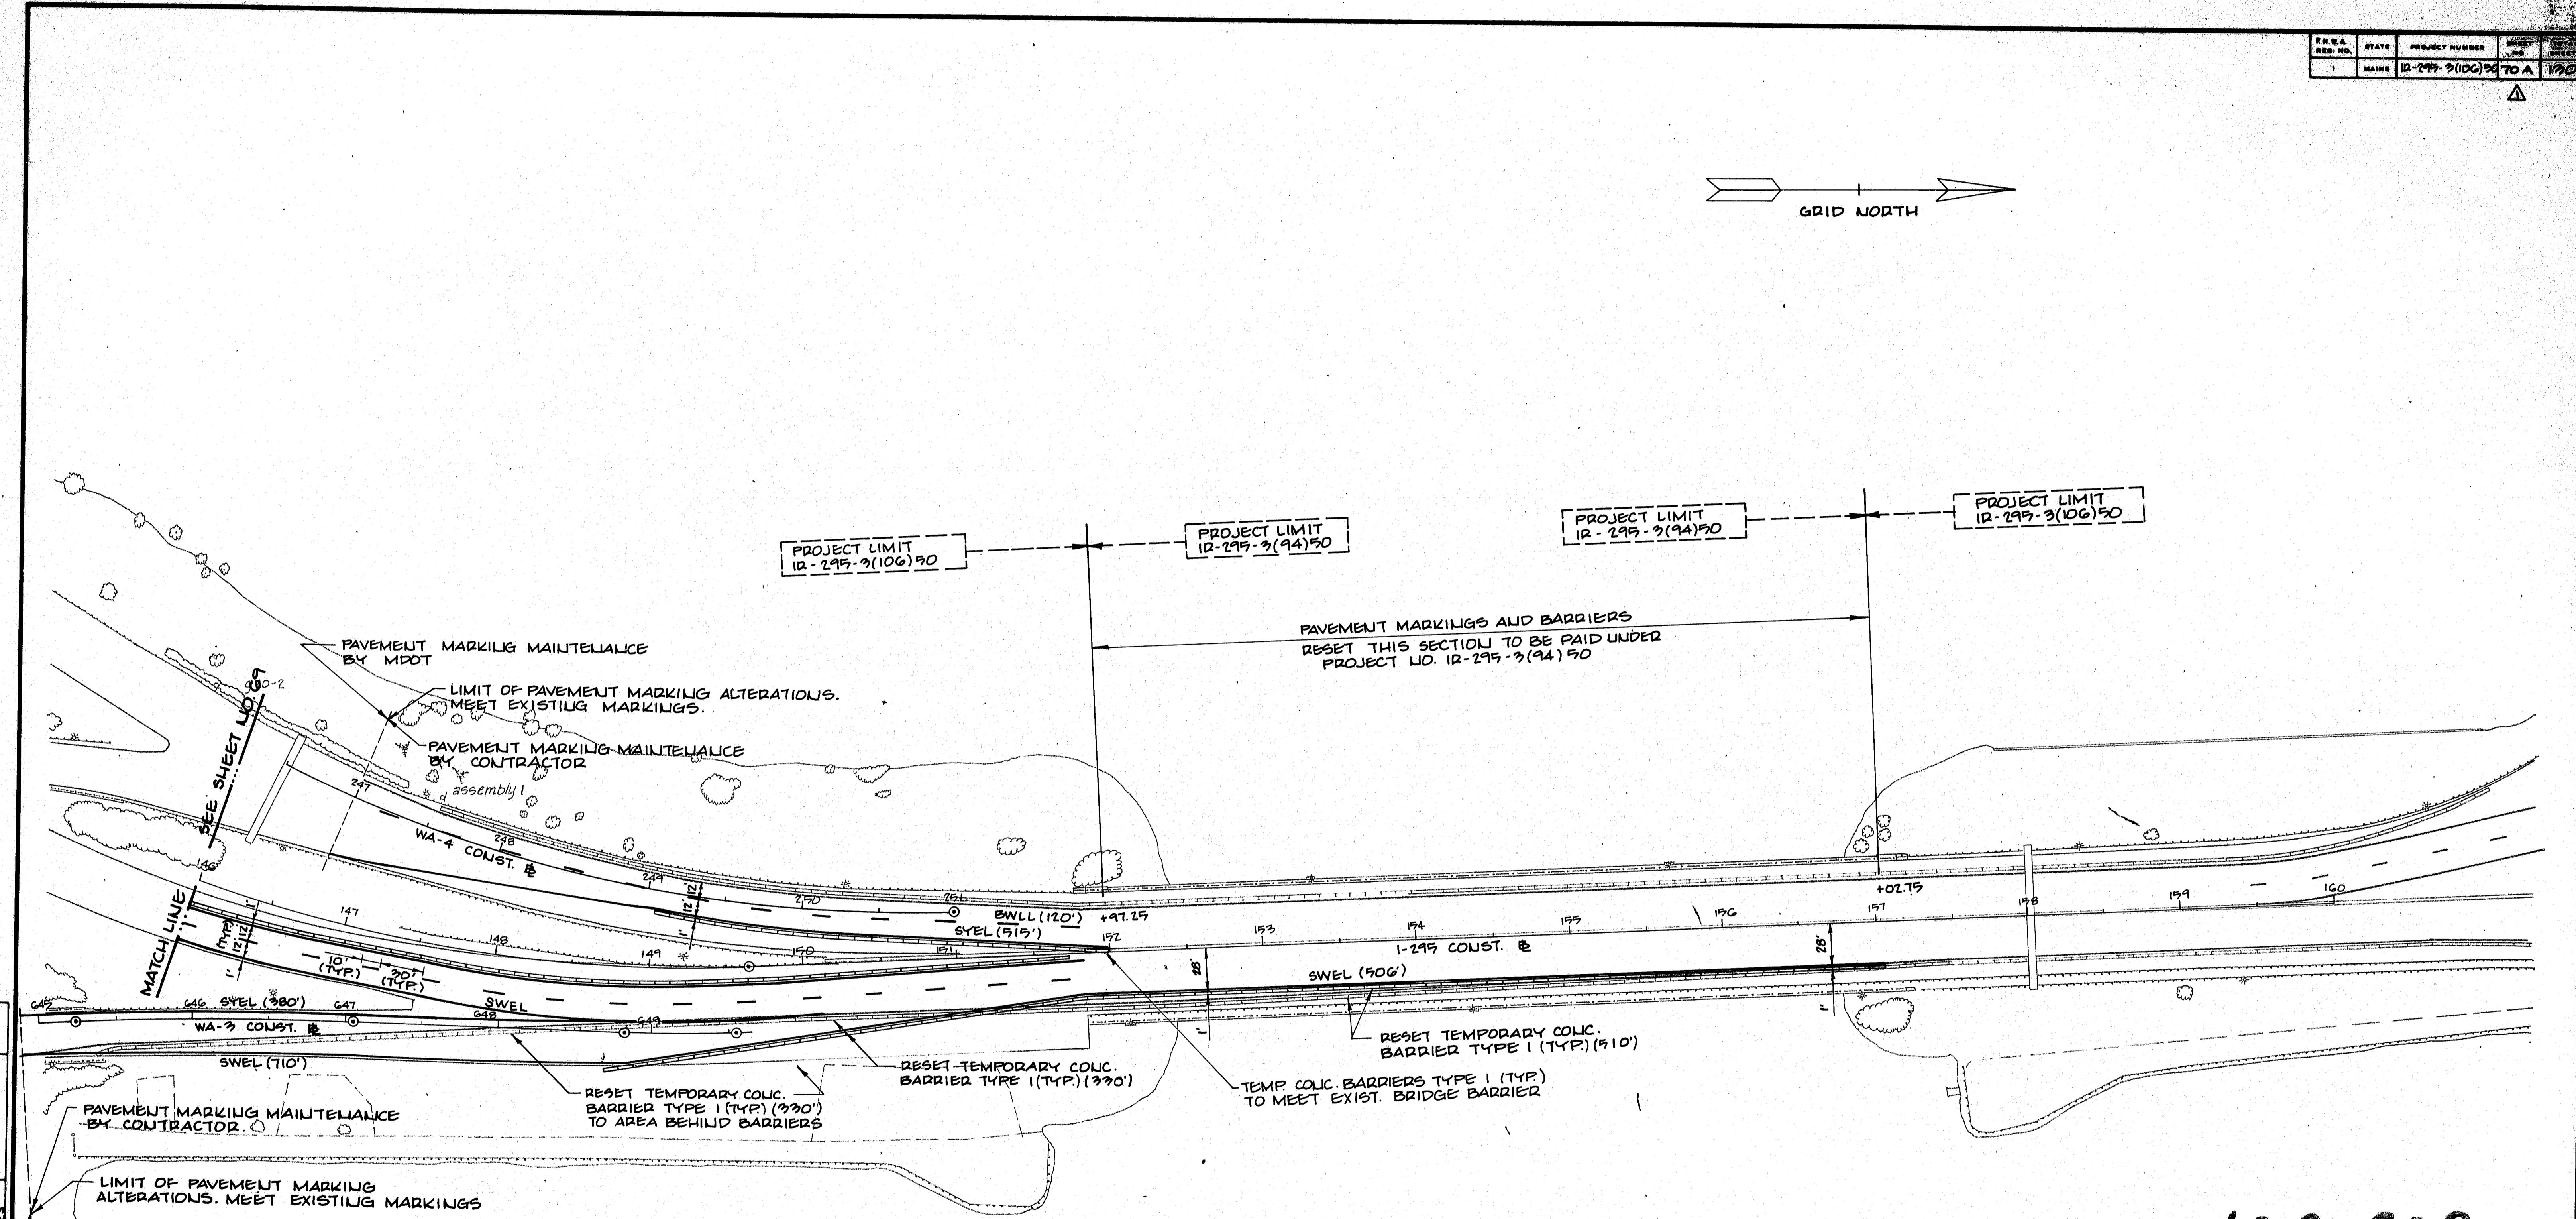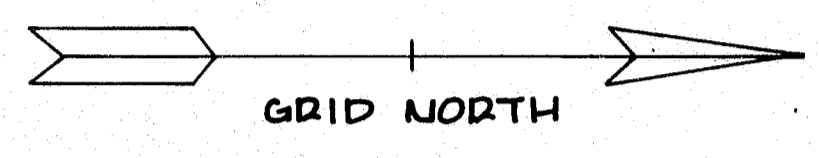

PROJECT DESIGN ENGINEER	DATE
DESIGN - DETAILED	
CHECKED	
REVISIONS	
FIELD CHANGES	
PLANS	

PAVEMENT MARKING MAINTENANCE BY CONTRACTOR

LIMIT OF PAVEMENT MARKING ALTERATIONS. MEET EXISTING MARKINGS

PAVEMENT MARKING MAINTENANCE BY MDPOT

RESET TEMPORARY CONC. BARRIER TYPE 1 (TYP) (330')

RESET TEMPORARY CONC. BARRIER TYPE 1 (TYP) (330')

RESET TEMPORARY CONC. BARRIER TYPE 1 (TYP) (310')

TEMP CONC. BARRIERS TYPE 1 (TYP) TO MEET EXIST. BRIDGE BARRIER


PAVEMENT MARKINGS AND BARRIERS
RESET THIS SECTION TO BE PAID UNDER
PROJECT NO. 12-295-3(94)90

NOTE: SEE SHEET NO. 76 FOR TRAFFIC LOTES.

103-309

REV.	DESCRIPTION	BY	DATE
1	NEW TRAFFIC SEQUENCING (BNA) G-G-89		
STATE OF MAINE DEPARTMENT OF TRANSPORTATION			
1-295. PORTLAND			
INTERMEDIATE TRAFFIC PLAN STEP 1			
SHEET 70 OF 130 AUGUSTA, MAINE			

F.R.A. NO.	STATE	PROJECT NUMBER	SHEET NO.	TOTAL SHEETS
1	MAINE	12-295-3(106)70	70 B	130

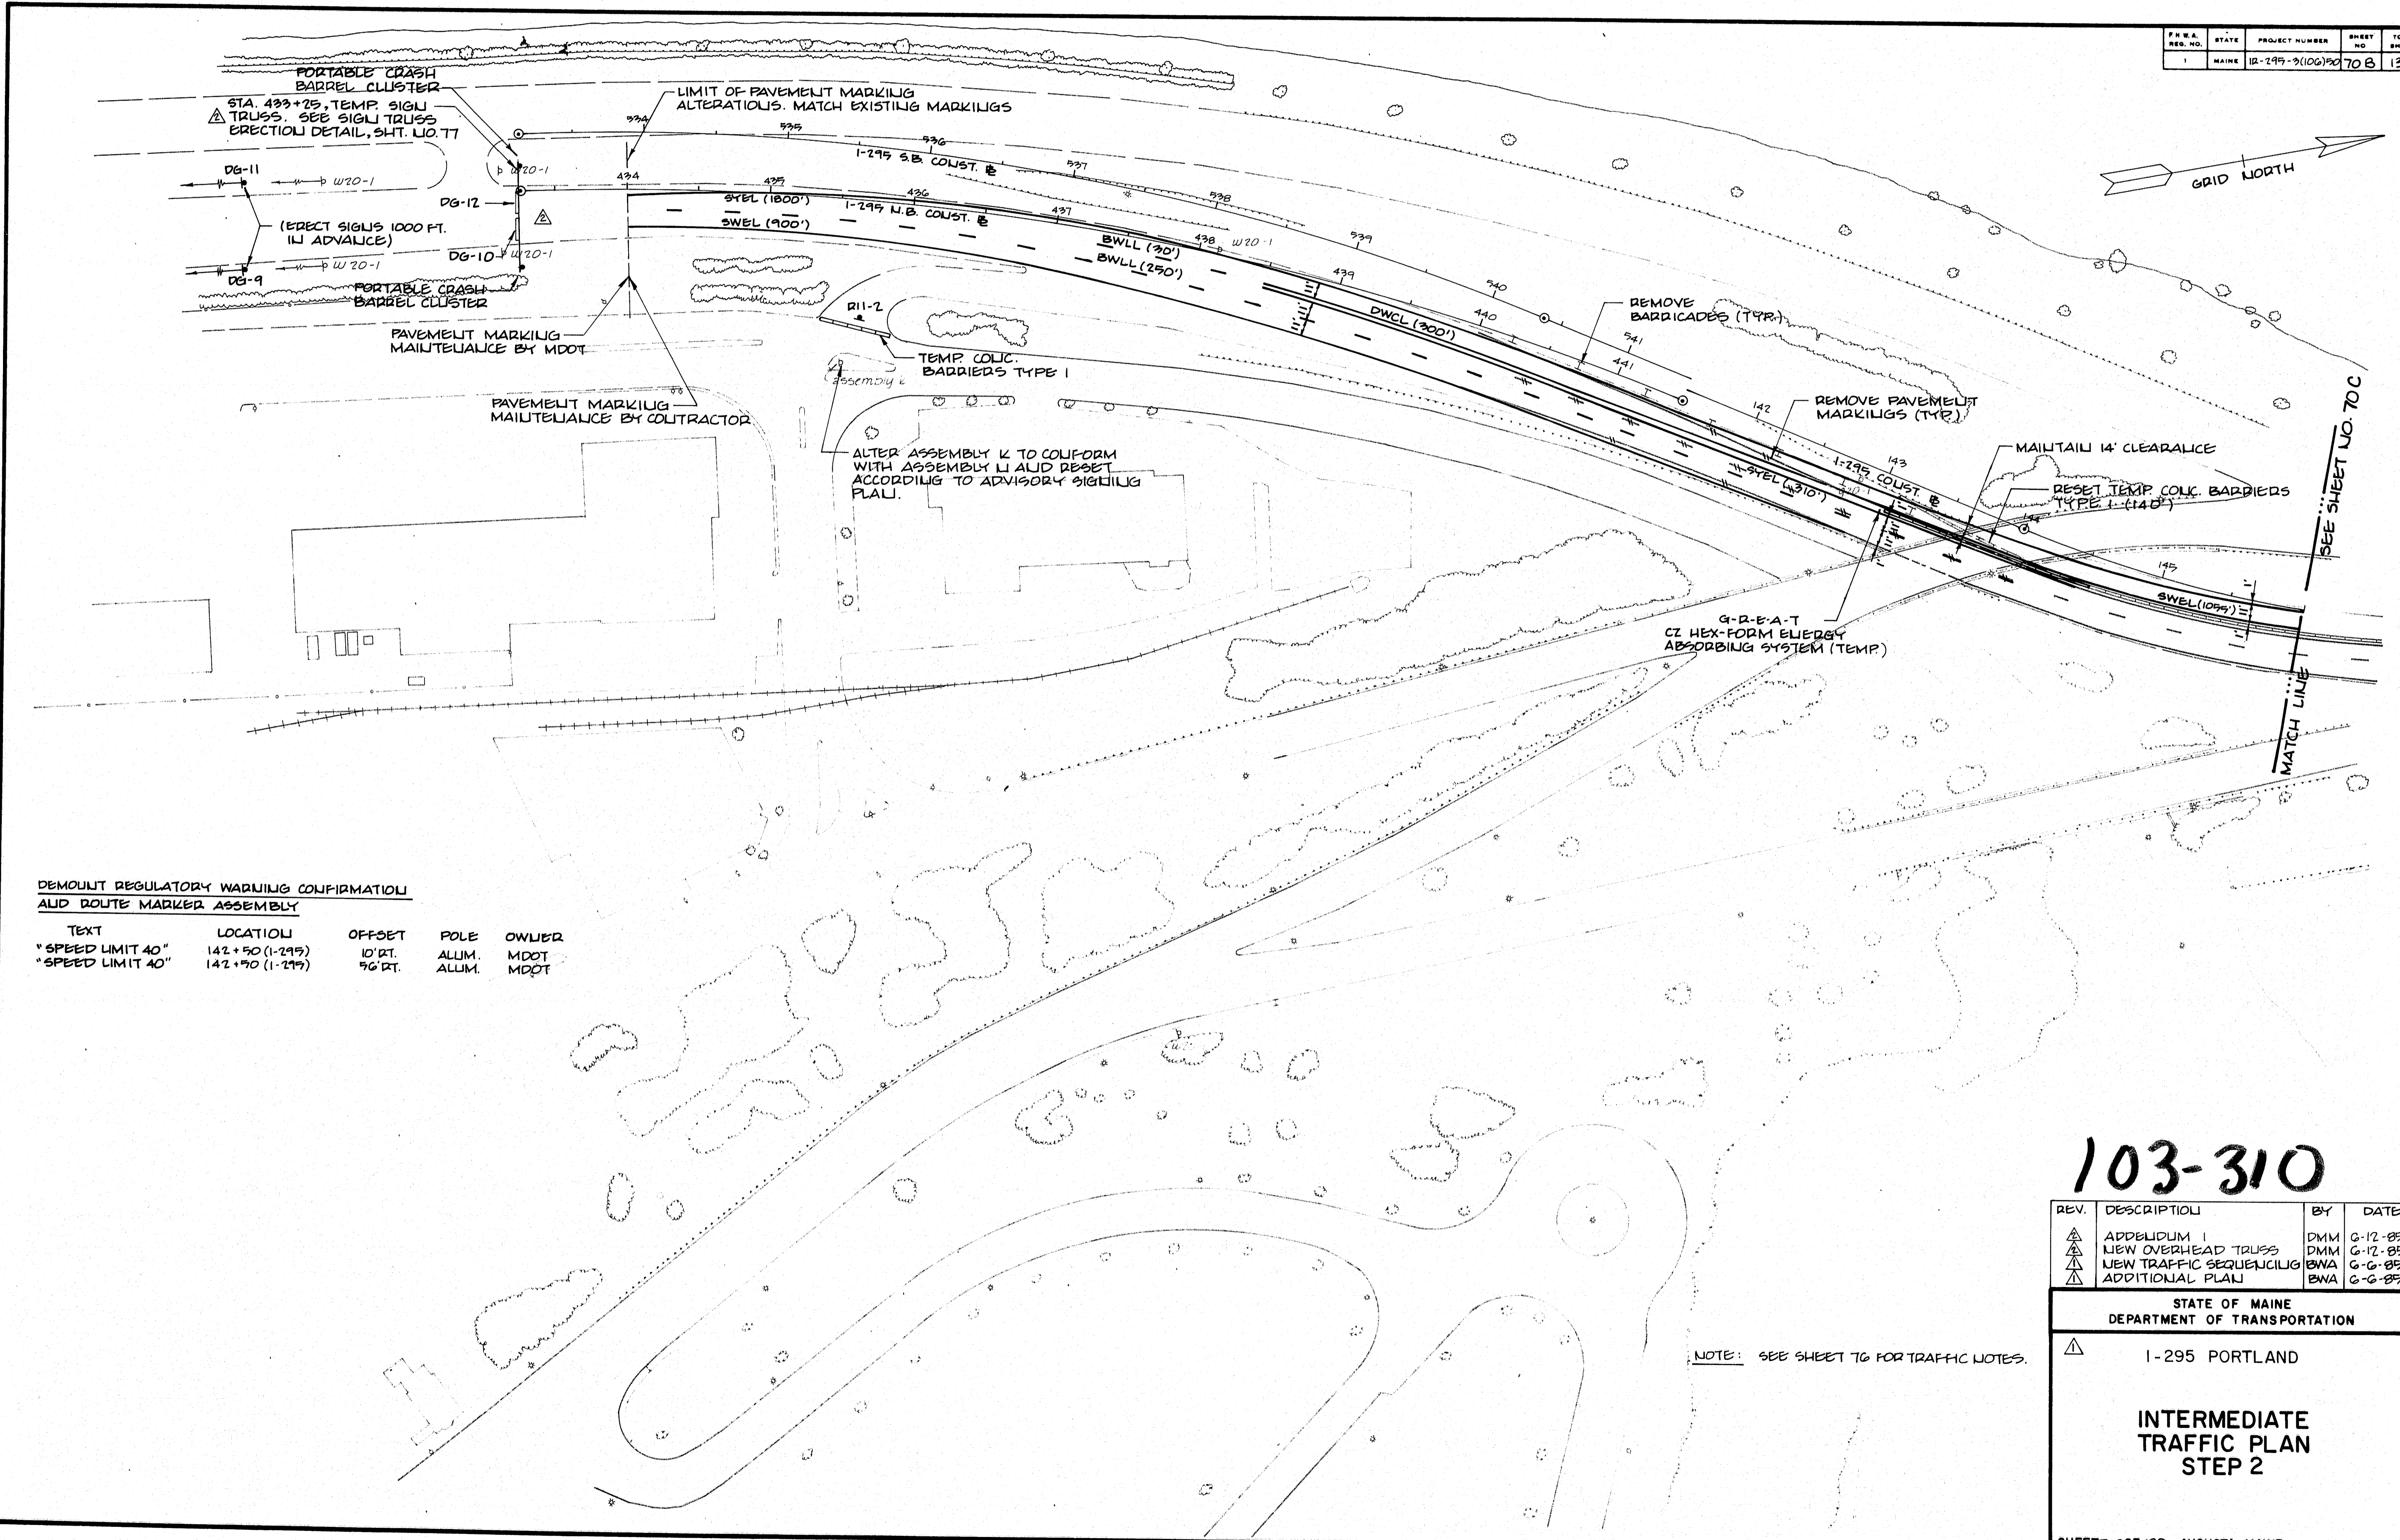

DEMOLISH REGULATORY WARNING CONFIRMATION AND ROUTE MARKER ASSEMBLY

TEXT	LOCATION	OFFSET	POLE	OWNER
"SPEED LIMIT 40"	142+50 (1-295)	10' RT.	ALLUM.	MDOT
"SPEED LIMIT 40"	142+70 (1-295)	96' RT.	ALLUM.	MDOT

PROJECT DESIGN ENGINEER	BY	DATE
DESIGN - DETAILED		
CHECKED		
REVISIONS		
FIELD CHANGES		
PLANS		

103-310

REV.	DESCRIPTION	BY	DATE
1	ADDED ITEM 1	DMM	6-12-85
2	NEW OVERHEAD TRUSS	DMM	6-12-85
3	NEW TRAFFIC SEQUENCING	BWA	6-6-85
4	ADDITIONAL PLAN	BWA	6-6-85

STATE OF MAINE
DEPARTMENT OF TRANSPORTATION



▲ 1-295 PORTLAND

INTERMEDIATE TRAFFIC PLAN STEP 2

SHEET 70 OF 130 AUGUSTA, MAINE

NOTE: SEE SHEET 76 FOR TRAFFIC NOTES.

F.R.S.A. REG. NO.	STATE	PROJECT NUMBER	SHEET NO.	TOTAL SHEETS
1	MAINE	R-295-3(10650)	71	130

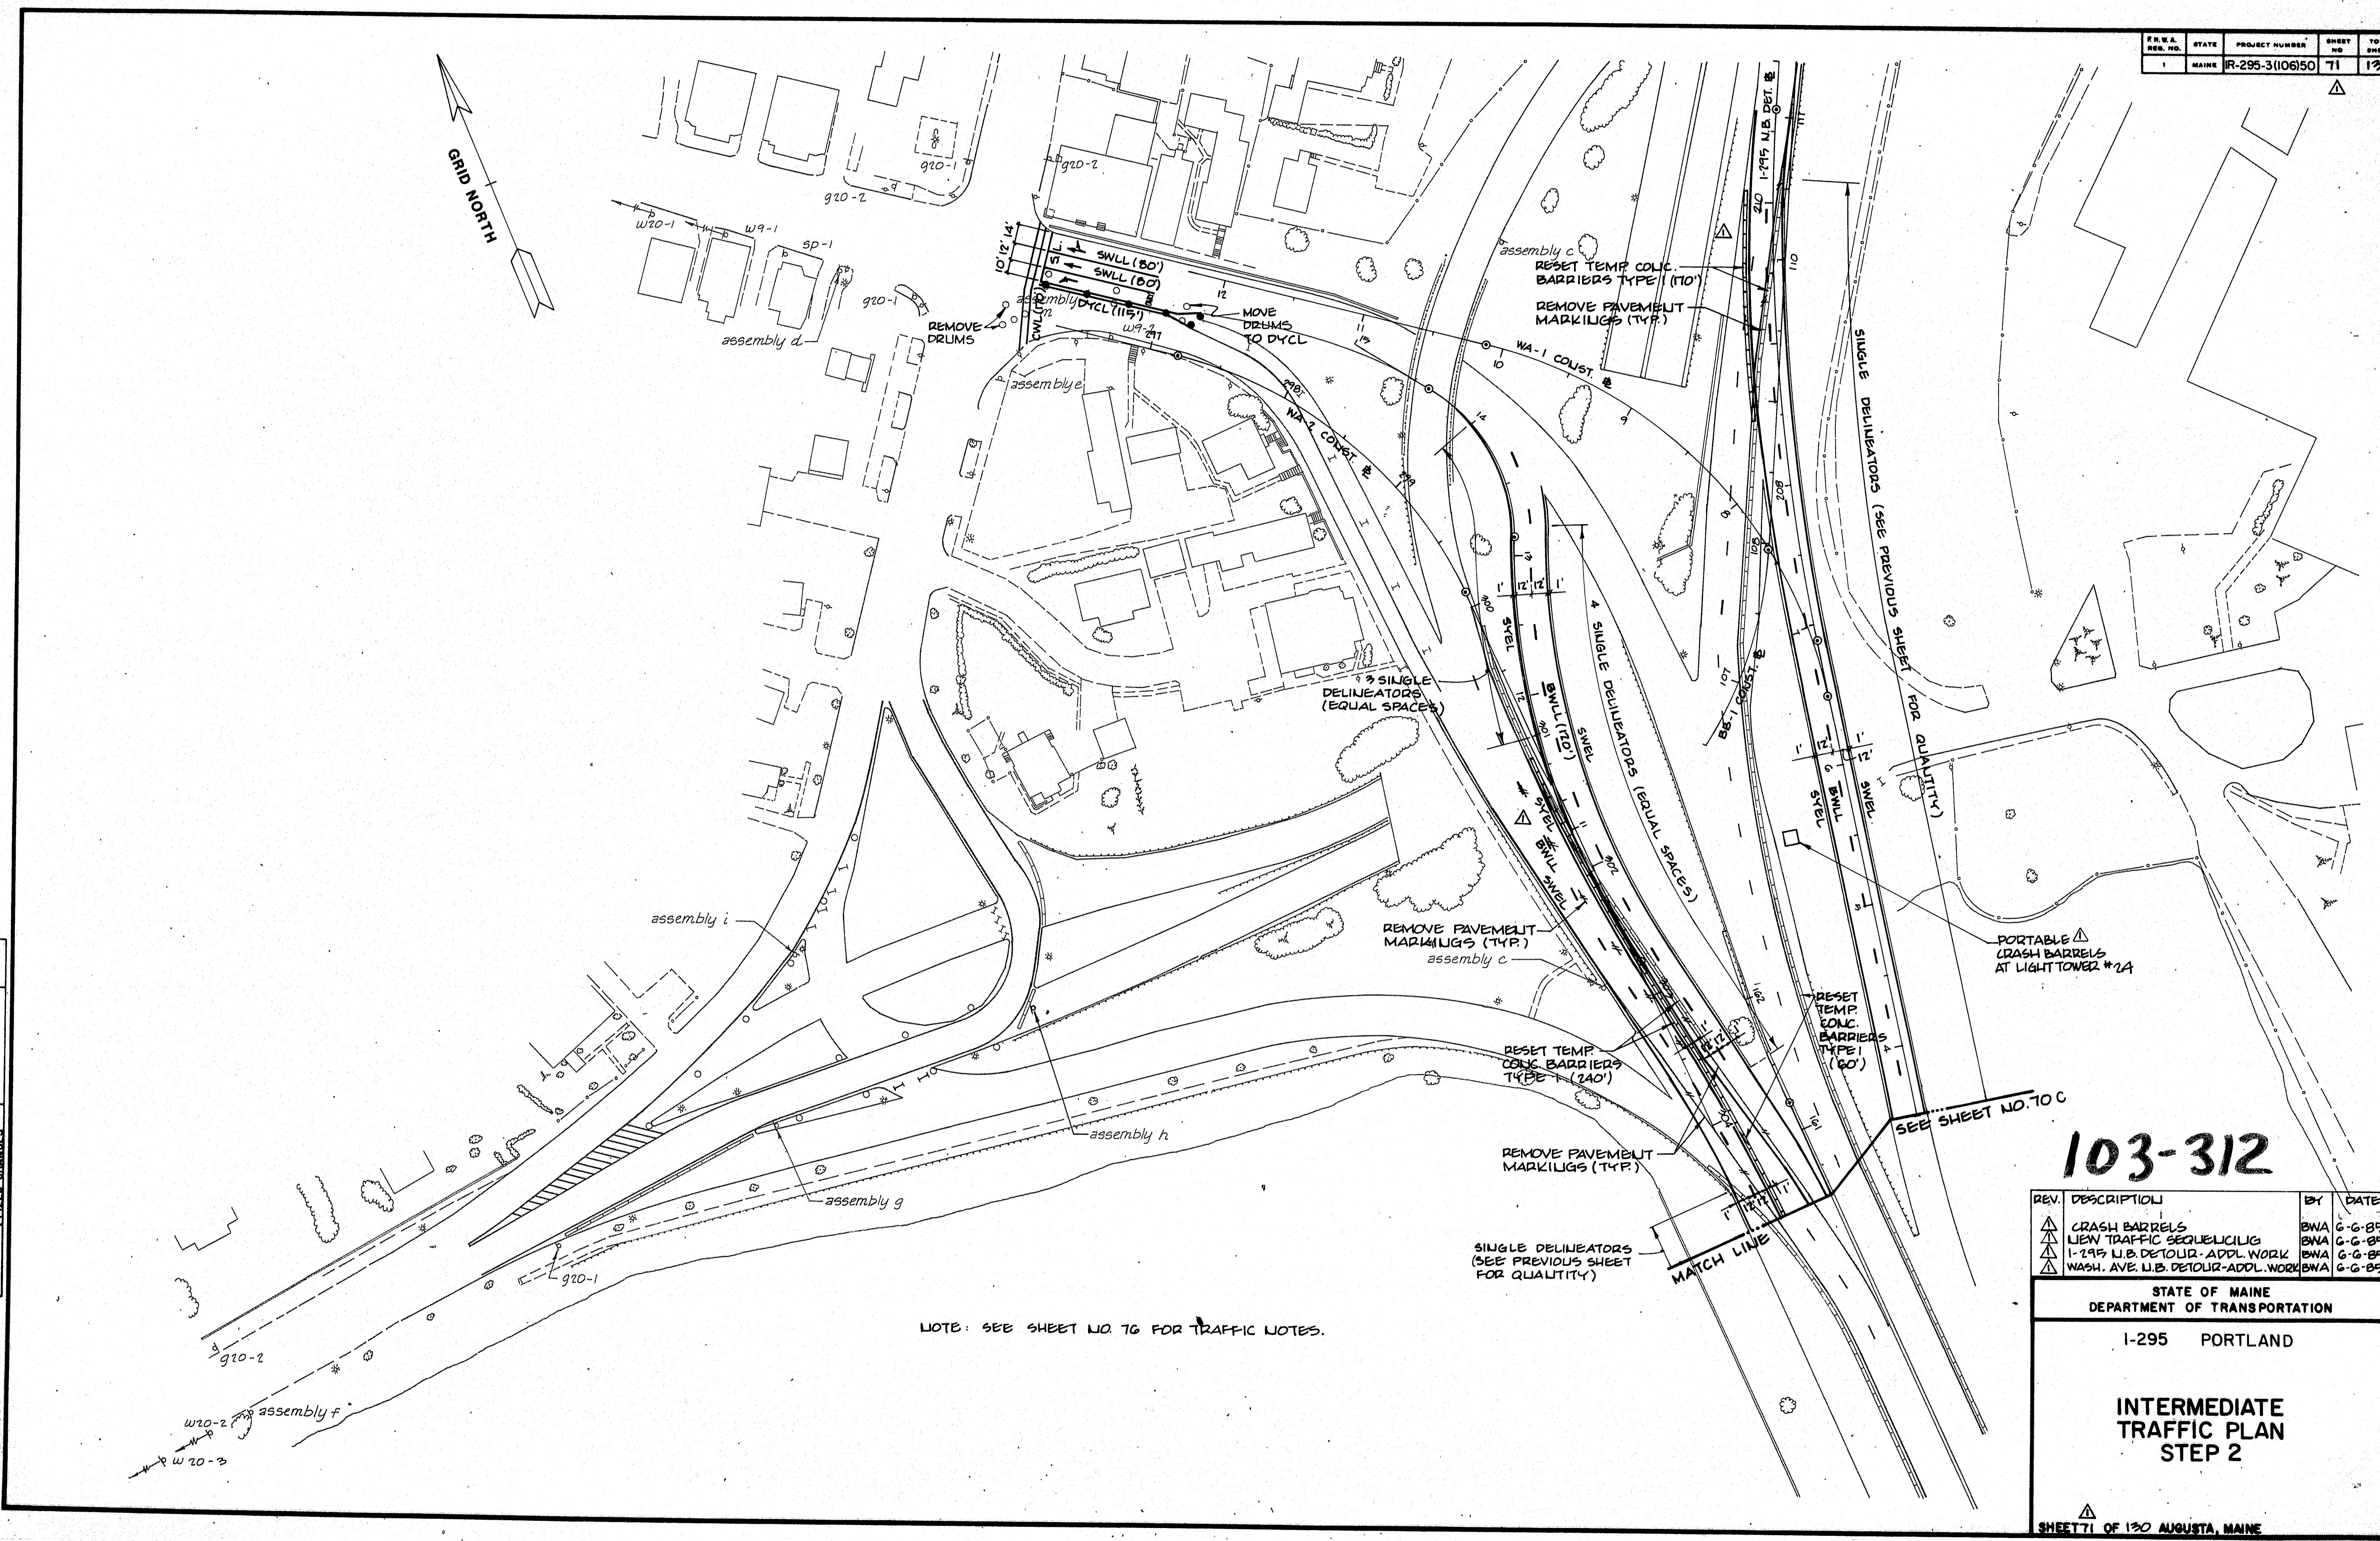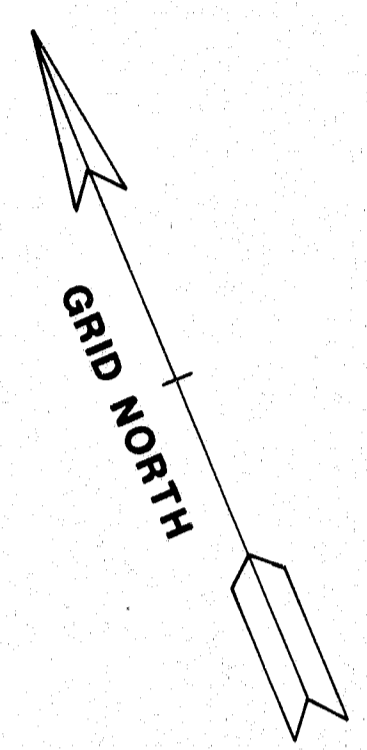

NOTE: SEE SHEET NO. 70 FOR TRAFFIC NOTES.

PROJECT DESIGN ENGINEER	BY	DATE
DESIGN - DETAILED		
CHECKED		
REVISIONS		
FIELD CHANGES		
PLANS		

103-312

REV.	DESCRIPTION	BY	DATE
△	CRASH BARRELS	BWA	6-6-85
△	LEWIS TRAFFIC SEQUENCING	BWA	6-6-85
△	1-295 U.B. DETOUR-ADPL. WORK	BWA	6-6-85
△	WASH. AVE. U.B. DETOUR-ADPL. WORK	BWA	6-6-85



STATE OF MAINE
DEPARTMENT OF TRANSPORTATION

1-295 PORTLAND

**INTERMEDIATE
TRAFFIC PLAN
STEP 2**

SHEET 71 OF 130 AUGUSTA, MAINE

F.R.E.A. DIST. NO.	STATE	PROJECT NUMBER	SHEET NO.	TOTAL SHEETS
1	MAINE	12-215-3(100)90	12	130

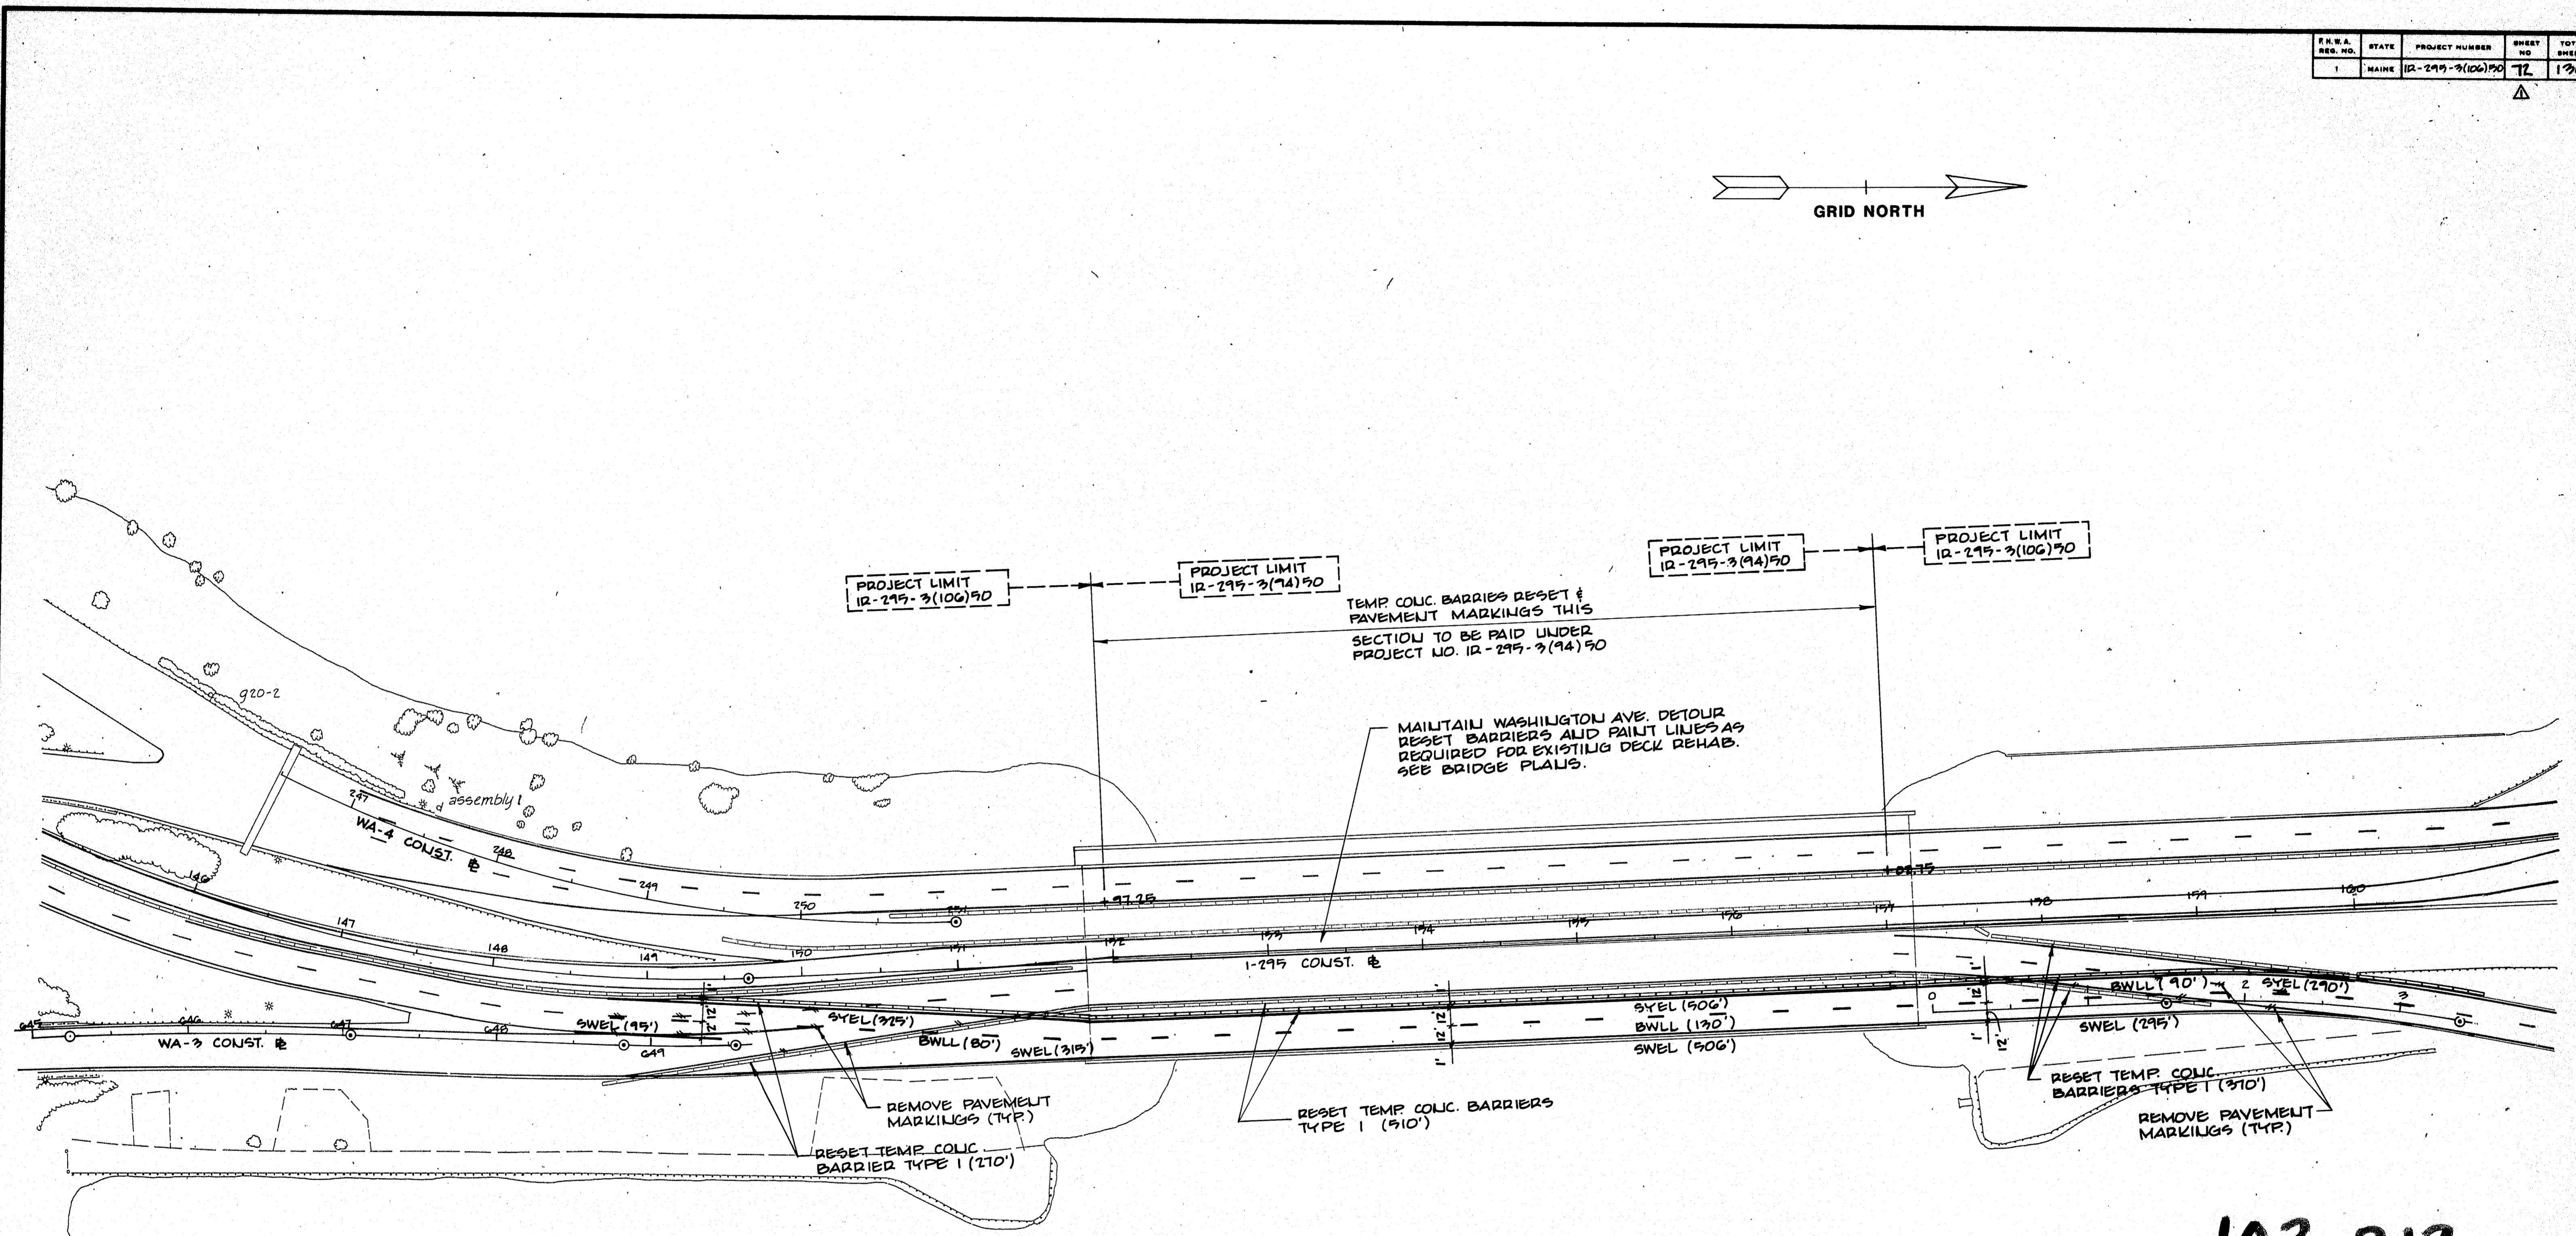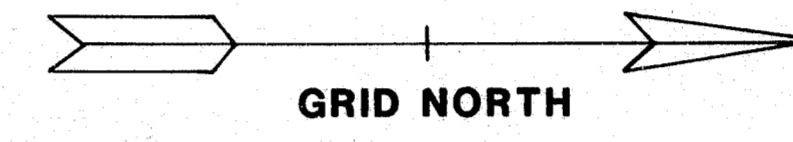

PROJECT DESIGN ENGINEER	BY	DATE
DESIGN - DETAILED		
CHECKED		
REVISIONS		
FIELD CORRECTIONS		

PLANS

NOTE: SEE SHEET NO. 10 FOR TRAFFIC NOTES.

103-313

REV.	DESCRIPTION	BY	DATE
1	NEW TRAFFIC SEQUENCING	BWA	6-6-89

STATE OF MAINE
DEPARTMENT OF TRANSPORTATION
1-295 PORTLAND

FINAL TRAFFIC PLAN

SHEET 12 OF 130 AUGUSTA, MAINE

BRUNING 44-132-47101

TRAFFIC

SIGN

SUMMARY

ITEM NO.	I. D. NO.	SIGN SIZE		TEXT	TEXT DIMENSIONS					SIGN AREA IN SQ. FT.	NO. OF SIGNS REQD.	POST	COLOR	
		HEIGHT	WIDTH		LETTER U.C.	HEIGHT L.C.	C.L. N.	ROUTE MARKER OR SHIELD	ARROW				BACK-GROUND	LEGEND # BORDER
652.35	CW-1 CW-2 CW-3 CW-4	10'-0"	17'-6"	MAJOR ROAD CONSTRUCTION ON PORTLAND		15 15				700.00	4	↑	ORANGE	BLACK
	DG-1a DG-2a	9'-6"	14'-0"	THRU TRAFFIC USE		15 12				266.00	2		↑	↑
	DG-5a	15'-6"	13'-0"	SOUTH SOUTH Saco Kittery 2 MILES	16	12				201.50	1		↑	↑
	DG-6a	15'-6"	13'-0"	SOUTH SOUTH Saco Kittery 1 MILE	16	12				201.50	1		↑	↑
	DG-7a	15'-6"	13'-0"	SOUTH SOUTH Saco Kittery 1/2 MILE	16	12				201.50	1	*	↑	↑
	CW-5	11'-6"	18'-0"	SOUTH BAXTER BLVD. BRIDGE CLOSED 2 MILES		12 15 10				207.00	1		↑	↑
	CW-6	11'-6"	18'-0"	SOUTH BAXTER BLVD. BRIDGE CLOSED 1 MILE		12 15 10				207.00	1		↑	↑
	CW-7	11'-6"	18'-0"	SOUTH BAXTER BLVD. BRIDGE CLOSED 1/2 MILE		12 15 10				207.00	1		↑	↑
	DG-3 DG-4	10'-0"	9'-0"	THRU TRAFFIC USE		15 15 12				180.00	2		↑	↑
	DG-8a	11'-6"	10'-6"	SOUTH SOUTH USE Maine Turnpike	13.3	10				120.75	1	↓	↑	↑
652.35	DG-5b DG-6b DG-7b	2'-6"	7'-0"	EXIT 15		10 15				52.50	3	↓	GREEN	WHITE

ITEM NO.	I. D. NO.	SIGN SIZE		TEXT	TEXT DIMENSIONS					SIGN AREA IN SQ. FT.	NO. OF SIGNS REQD.	POST	COLOR	
		HEIGHT	WIDTH		LETTER U.C.	HEIGHT L.C.	C.L. N.	ROUTE MARKER OR SHIELD	ARROW				BACK-GROUND	LEGEND # BORDER
652.35	DG-1b DG-2b	2'-6"	4'-6"	ALT						22.50	2	↑	ORANGE	BLACK
652.35	DG-5c DG-6c DG-7c DG-8b	2'-6"	9'-0"	ALTERNATE						90.00	4	↑	ORANGE	BLACK

- "STANDARDS" REFER TO MANUAL ON UNIFORM TRAFFIC CONTROL DEVICES (1978).
 - SIGN AREAS ARE COMPUTED TO THE NEAREST ONE HUNDRETH.
 - REFLECTIVE SHEETING SHALL BE ENGINEERING GRADE AND LETTERS SHALL BE RETRO-REFLECTIVE SHEETING.
- * THE CONTRACTOR SHALL PROVIDE SIGN SUPPORTS AND MAINTENANCE OF SIGNS FOR THE DURATION OF THE PROJECT. THE METHOD OF SUPPORT SHALL CONFORM TO THE AASHTO, "STANDARD SPECIFICATIONS FOR STRUCTURAL SUPPORTS FOR HIGHWAY SIGNS, LUMINAIRES, AND TRAFFIC SIGNALS", 1975, AND "GUIDE FOR SELECTING, LOCATING, AND DESIGNING TRAFFIC BARRIERS", 1977.

LEGEND
 U.C. = UPPER CASE LETTERS
 L.C. = LOWER CASE LETTERS
 C.L. = CAPITAL LETTERS
 N. = NUMERALS

103-314

REV.	DESCRIPTION	BY	DATE
1	ADDED LUMIN I LETTER SIZE INCREASED	BNA	6-12-85
2	ADDITIONAL REFERENCE	BNA	6-12-85
3	ADDITIONAL NOTE	DMM	6-12-85
4	ADDITIONAL SIGN	DMM	6-12-85
5	ADDITIONAL SIGN	DMM	6-12-85

MAINE STATE HIGHWAY COMMISSION
 AUGUSTA, MAINE

1-295 PORTLAND

ADVISORY SIGN SUMMARY

TRAFFIC

SIGN

SUMMARY

ITEM NO.	I. D. NO.	SIGN SIZE		TEXT	TEXT DIMENSIONS					SIGN AREA IN SQ. FT.	NO. OF SIGNS REQD.	POST	COLOR	
		HEIGHT	WIDTH		LETTER		HEIGHT	ROUTE MARKER OR SHIELD	ARROW				BACK-GROUND	LEGEND BORDER
					U.C.	L.C.								
652.35	MI-1	24"	30"							5.00	1		RED BLUE	WHITE
	MI-4	24"	24"							32.00	8		WHITE BLACK	BLACK
	MI-4	24"	24"							8.00	2		WHITE BLACK	
	MI-6	24"	24"	26						24.00	6		WHITE BLACK	
	M3-1	12"	24"	NORTH						18.00	9		WHITE BLACK	
	M3-3	12"	24"	SOUTH						16.00	8		WHITE BLACK	
	M4-8	12"	24"	DETOUR						18.00	9		ORANGE BLACK	
	M4-10L	18"	48"							6.00	1		ORANGE BLACK	BLACK
	M4-10R	18"	48"							6.00	1		ORANGE BLACK	BLACK
	M5-1	15"	21"							4.37	2		WHITE BLACK	
	M6-1L	15"	21"							6.57	3		WHITE BLACK	
	M6-1R	15"	21"							2.19	1		WHITE BLACK	
	M6-2	15"	21"							10.94	5		WHITE BLACK	
	M6-3	15"	21"							15.31	7		WHITE BLACK	
	R11-2	30"	48"	ROAD CLOSED						30.00	3		WHITE BLACK	

ITEM NO.	I. D. NO.	SIGN SIZE		TEXT	TEXT DIMENSIONS					SIGN AREA IN SQ. FT.	NO. OF SIGNS REQD.	POST	COLOR	
		HEIGHT	WIDTH		LETTER		HEIGHT	ROUTE MARKER OR SHIELD	ARROW				BACK-GROUND	LEGEND BORDER
					U.C.	L.C.								
652.35	WI-1L	30"	30"							6.25	1		ORANGE BLACK	
	W9-1 (SP)	36"	36"							9.00	1		ORANGE BLACK	
	W13-1	18"	18"	15 MPH						2.25	1		ORANGE BLACK	
	W20-1	36"	36"							9.00	1		ORANGE BLACK	
	W20-1	36"	36"							36.00	4		ORANGE BLACK	
	W20-1	36"	36"							36.00	4		ORANGE BLACK	
	W20-1	36"	36"							36.00	4		ORANGE BLACK	
	W20-2	36"	36"							9.00	1		ORANGE BLACK	
	W20-2	36"	36"							9.00	1		ORANGE BLACK	
	W20-3	48"	48"							16.00	1		ORANGE BLACK	
	W20-7A	36"	36"							36.00	4		ORANGE BLACK	
	W20-7A	24"	24"							16.00	4		ORANGE BLACK	

- "STANDARDS" REFER TO MANUAL ON UNIFORM TRAFFIC CONTROL DEVICES (1978).
- SIGN AREAS ARE COMPUTED TO THE NEAREST ONE HUNDREDTH.
- LOCATIONS FOR SIGNS W20-7A ARE LEFT TO THE DISCRETION OF THE ENGINEER.

LEGEND
 U.C. = UPPER CASE LETTERS
 L.C. = LOWER CASE LETTERS
 C.L. = CAPITAL LETTERS
 N. = NUMERALS

103-315

MAINE STATE HIGHWAY COMMISSION
 AUGUSTA, MAINE

I-295 PORTLAND

SIGN SUMMARY








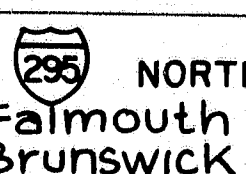
REV.	DESCRIPTION	BY	DATE

△ QUALITY INCREASE BNA 6/20/85



TRAFFIC

SIGN

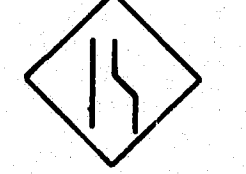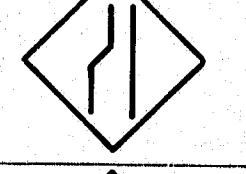SUMMARY

ITEM NO.	I. D. NO.	SIGN SIZE		TEXT	TEXT DIMENSIONS					SIGN AREA IN SQ. FT.	NO. OF SIGNS REQD.	POST	COLOR		
		HEIGHT	WIDTH		LETTER	HEIGHT	ROUTE MARKER OR SHIELD		ARROW				BACK-GROUND	LEGEND	BORDER
							U.C.	L.C.							
652.35	G20-1	36"	60"	ROAD CONSTRUCTION NEXT 1/4 MILE	SEE STANDARDS					90.00	6		ORANGE	BLACK	
	G20-2	24"	60"	END CONSTRUCTION	SEE STANDARDS					50.00	5		ORANGE	BLACK	
		9"	18"	SIDEWALK CLOSED	SEE MDOT STANDARDS					6.75	6		WHITE	BLACK	
	SP-1	48"	48"		SEE DETAIL THIS SHEET					16.00	1		ORANGE	BLACK	
	SP-2	24"	24"		SEE DETAIL THIS SHEET					4.00	1		ORANGE	BLACK	
	DG-13b DG-14b DG-15b DG-16b DG-17b	12"	24"	DETOUR	SEE STANDARDS (M4-8)					10.00	5		ORANGE	BLACK	
	W4-2 (RIGHT)	48"	48"		SEE STANDARDS					16.00	1		ORANGE	BLACK	
	W4-2 (LEFT)	48"	48"		SEE STANDARDS					16.00	1		ORANGE	BLACK	
	W9-1	48"	48"	 "LEFT"						32.00	1 EA. 2		ORANGE	BLACK	
	W9-2	48"	48"	 "RIGHT"						32.00	1 EA. 2		ORANGE	BLACK	
	W13-1	24"	24"	30 M.P.H.						8.00	2		ORANGE	BLACK	
	W20-5	48"	48"	 "LEFT"						32.00	1 EA. 2		ORANGE	BLACK	
	R4-1	30"	24"	DO NOT PASS						10.00	2		WHITE	BLACK	
	DG-9 DG-10	11'-6"	12'-0"		16	12	10	18	36x45	276.00	2		ORANGE	BLACK	

ITEM NO.	I. D. NO.	SIGN SIZE		TEXT	TEXT DIMENSIONS					SIGN AREA IN SQ. FT.	NO. OF SIGNS REQD.	POST	COLOR		
		HEIGHT	WIDTH		LETTER	HEIGHT	ROUTE MARKER OR SHIELD		ARROW				BACK-GROUND	LEGEND	BORDER
							U.C.	L.C.							
652.35	DG-11a DG-12a	13'-6"	14'-6"	26 NORTH Washington Avenue LEFT LANE	16	12	10	18	36x36	391.50	2		ORANGE	BLACK	
	DG-13a DG-14a DG-15a	6'-0"	5'-6"	26 NORTH WASHINGTON AVENUE			6D	12	24x24	99.00	3		ORANGE	BLACK	
	DG-16a DG-17a	6'-0"	5'-6"	26 NORTH WASHINGTON AVENUE			6D	12	24x24	66.00	2		ORANGE	BLACK	
	DG-11b DG-12b GA-15V	15"	30"	DETOUR	SEE STANDARDS (M4-8 SPECIAL)					9.38	3		ORANGE	BLACK	
	GA-15W	2'-6"	9'-0"	LEFT LANE			10			22.50	1		ORANGE	BLACK	

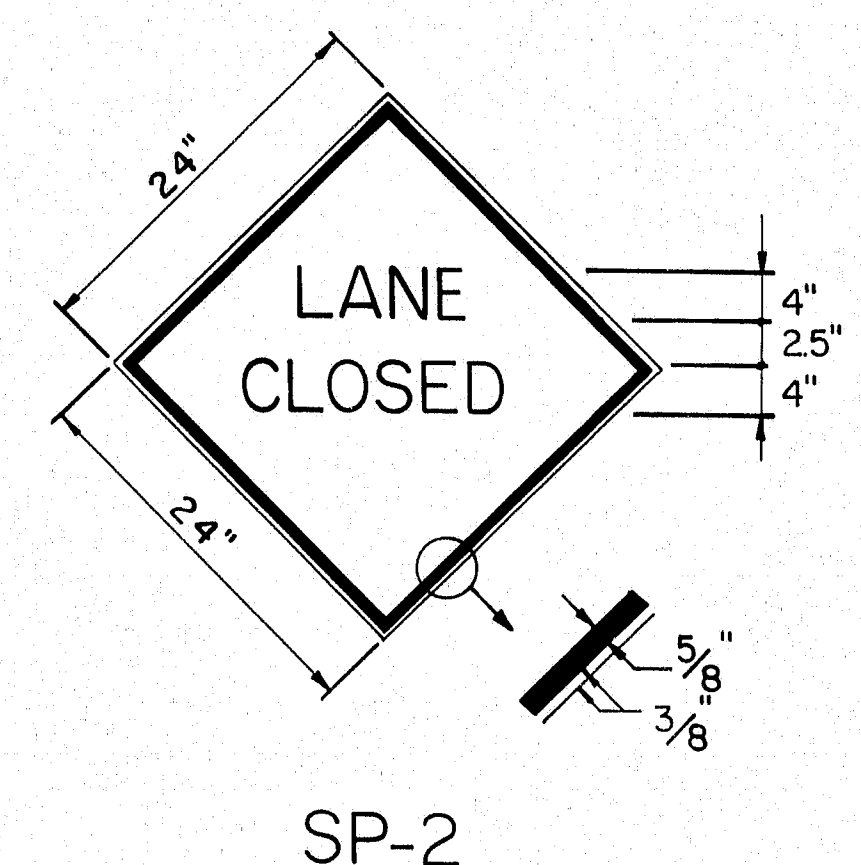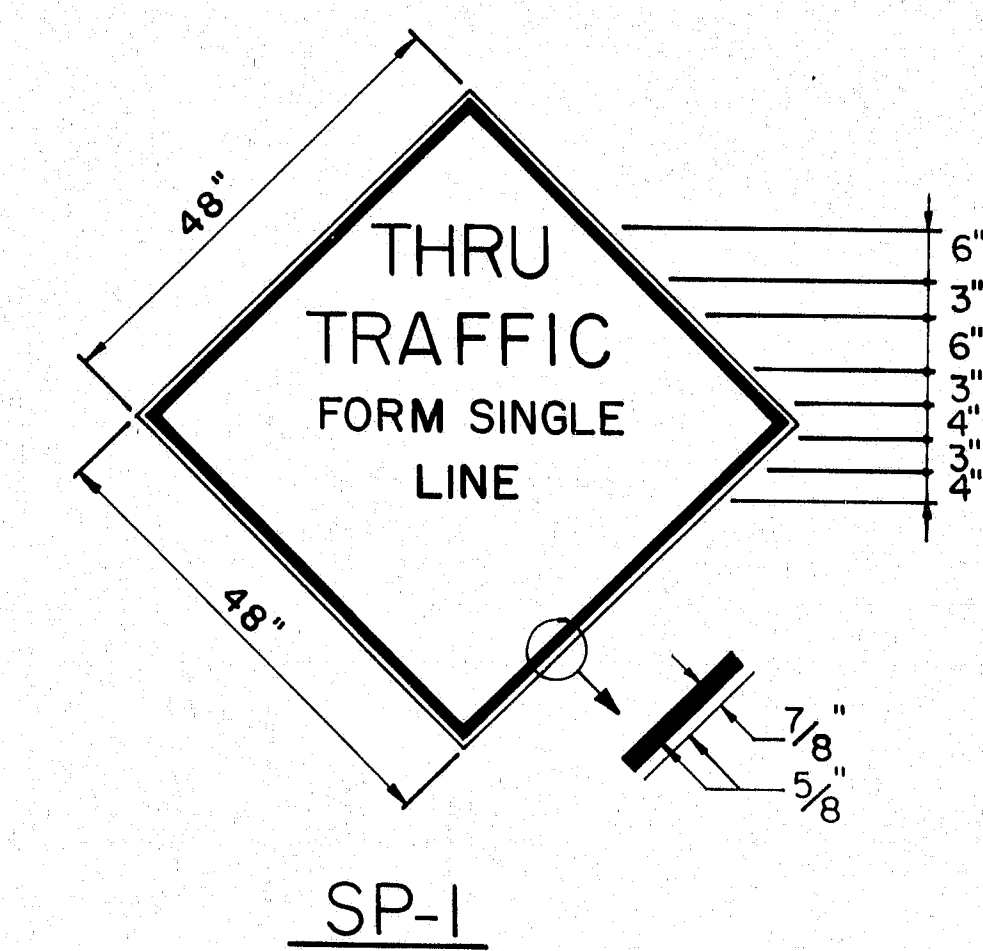

NOTE: SPECIAL SIGNS ABOVE SHALL CONFORM TO THE MANUAL OF UNIFORM TRAFFIC CONTROL DEVICES (1978) IN ADDITION TO THE DETAIL SHOWN.

1. "STANDARDS" REFER TO MANUAL ON UNIFORM TRAFFIC CONTROL DEVICES (1978).
2. SIGN AREAS ARE COMPUTED TO THE NEAREST ONE HUNDREDTH.
3. "LEFT" AND "RIGHT" PLAQUE OVERLAYS SHALL BE PROVIDED FOR CONSTRUCTION SIGNS AS REQUIRED, INCIDENTAL TO ITEM 652.35.


103-316

LEGEND
 U.C. = UPPER CASE LETTERS
 L.C. = LOWER CASE LETTERS
 C.L. = CAPITAL LETTERS
 N. = NUMERALS

REV.	DESCRIPTION	BY	DATE
△	NEW SIGNS	BWA	6-10-85

MAINE STATE HIGHWAY COMMISSION AUGUSTA, MAINE	
I-295 PORTLAND	
SIGN SUMMARY	

F.W.A. REG. NO.	STATE	PROJECT NUMBER	SHEET NO.	TOTAL SHEETS
1	MAINE	IR-295-3106150	76	130

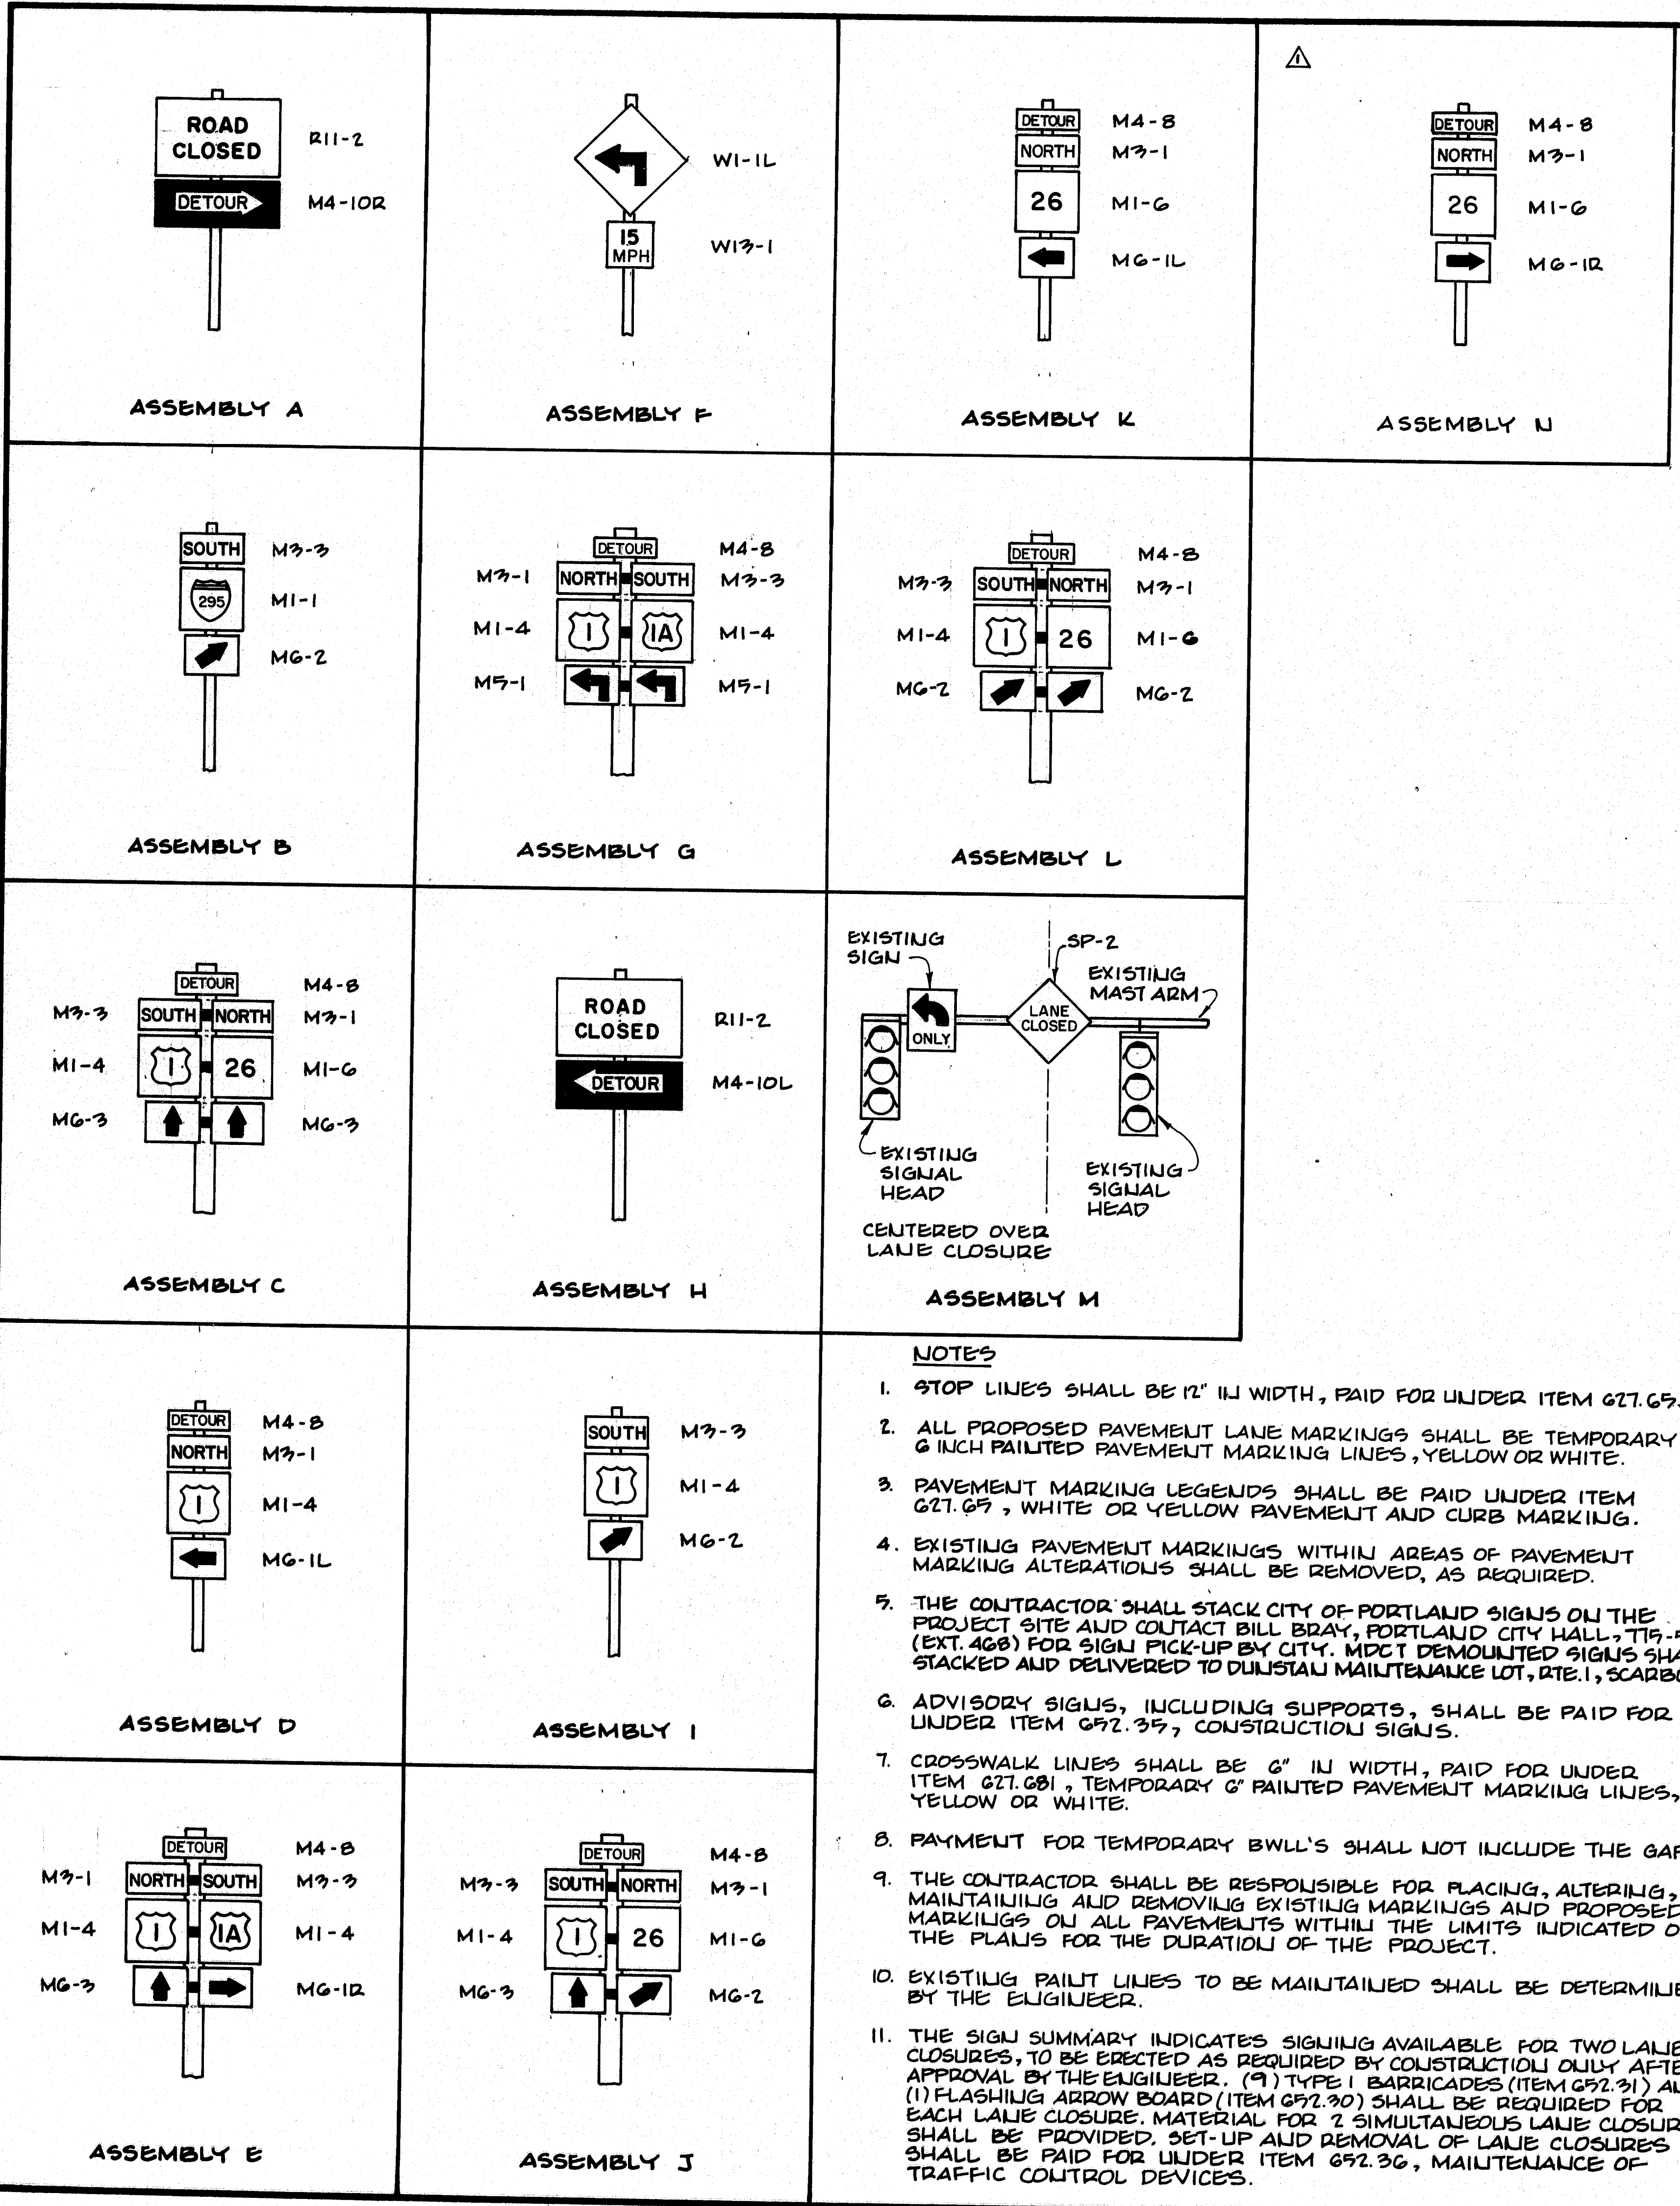

- NOTES**
- STOP LINES SHALL BE 12" IN WIDTH, PAID FOR UNDER ITEM 627.05.
 - ALL PROPOSED PAVEMENT LANE MARKINGS SHALL BE TEMPORARY 6 INCH PAINTED PAVEMENT MARKING LINES, YELLOW OR WHITE.
 - PAVEMENT MARKING LEGENDS SHALL BE PAID UNDER ITEM 627.05, WHITE OR YELLOW PAVEMENT AND CURB MARKING.
 - EXISTING PAVEMENT MARKINGS WITHIN AREAS OF PAVEMENT MARKING ALTERATIONS SHALL BE REMOVED, AS REQUIRED.
 - THE CONTRACTOR SHALL STACK CITY OF PORTLAND SIGNS ON THE PROJECT SITE AND CONTACT BILL BRAY, PORTLAND CITY HALL - 7TH FLOOR (EXT. 408) FOR SIGN PICK-UP BY CITY. MDCT DEMOUNTED SIGNS SHALL BE STACKED AND DELIVERED TO DULISTAU MAINTENANCE LOT, RTE. 1, SCARBOROUGH.
 - ADVISORY SIGNS, INCLUDING SUPPORTS, SHALL BE PAID FOR UNDER ITEM 692.35, CONSTRUCTION SIGNS.
 - CROSSWALK LINES SHALL BE 6" IN WIDTH, PAID FOR UNDER ITEM 627.051, TEMPORARY 6" PAINTED PAVEMENT MARKING LINES, YELLOW OR WHITE.
 - PAYMENT FOR TEMPORARY BWLL'S SHALL NOT INCLUDE THE GAPS.
 - THE CONTRACTOR SHALL BE RESPONSIBLE FOR PLACING, ALTERING, MAINTAINING AND REMOVING EXISTING MARKINGS AND PROPOSED MARKINGS ON ALL PAVEMENTS WITHIN THE LIMITS INDICATED ON THE PLANS FOR THE DURATION OF THE PROJECT.
 - EXISTING PAINT LINES TO BE MAINTAINED SHALL BE DETERMINED BY THE ENGINEER.
 - THE SIGN SUMMARY INDICATES SIGNING AVAILABLE FOR TWO LANE CLOSURES, TO BE ERECTED AS REQUIRED BY CONSTRUCTION ONLY, AFTER APPROVAL BY THE ENGINEER. (9) TYPE 1 BARRICADES (ITEM 692.31) AND (1) FLASHING ARROW BOARD (ITEM 692.90) SHALL BE REQUIRED FOR EACH LANE CLOSURE. MATERIAL FOR 2 SIMULTANEOUS LANE CLOSURES SHALL BE PROVIDED. SET-UP AND REMOVAL OF LANE CLOSURES SHALL BE PAID FOR UNDER ITEM 692.36, MAINTENANCE OF TRAFFIC CONTROL DEVICES.

LEGEND

SYCHL	SOLID YELLOW CHEVRON LINE
CWL	CROSS WALK LINE
SL	STOP LINE
BWLL	BROKEN WHITE LANE LINE
SWLL	SOLID WHITE LANE LINE
SWEL	SOLID WHITE EDGE LINE
SYEL	SOLID YELLOW EDGE LINE
DYCL	DOUBLE YELLOW CENTER LINE
[Symbol]	PROPOSED TEMPORARY CONCRETE BARRIER - TYPE 1 (10 FT. INCREMENTS)
[Symbol]	PROPOSED TYPE 1 BARRICADE
[Symbol]	PROPOSED SIGN
[Symbol]	PROPOSED DRUM
△ DWCL	DOUBLE WHITE CENTER LINE


PROJECT DESIGN ENGINEER	DATE
DESIGN - DETAILED	
CHECKED	
REVISIONS	
FIELD CHANGES	

PLANS


103-317

REV.	DESCRIPTION	BY	DATE
△	ASSEMBLY L ADD DWCL TO LEGEND	BWA BWA	6-6-89 6-6-89
STATE OF MAINE DEPARTMENT OF TRANSPORTATION			
I-295 PORTLAND			
SIGN ASSEMBLY AND DETAILS			
SHEET 76 OF 130 AUGUSTA, MAINE			


F.R.W.A. RES. NO.	STATE	PROJECT NUMBER	SHEET NO.	TOTAL SHEETS
1	MAINE	IR-295-3(106)50	77	130

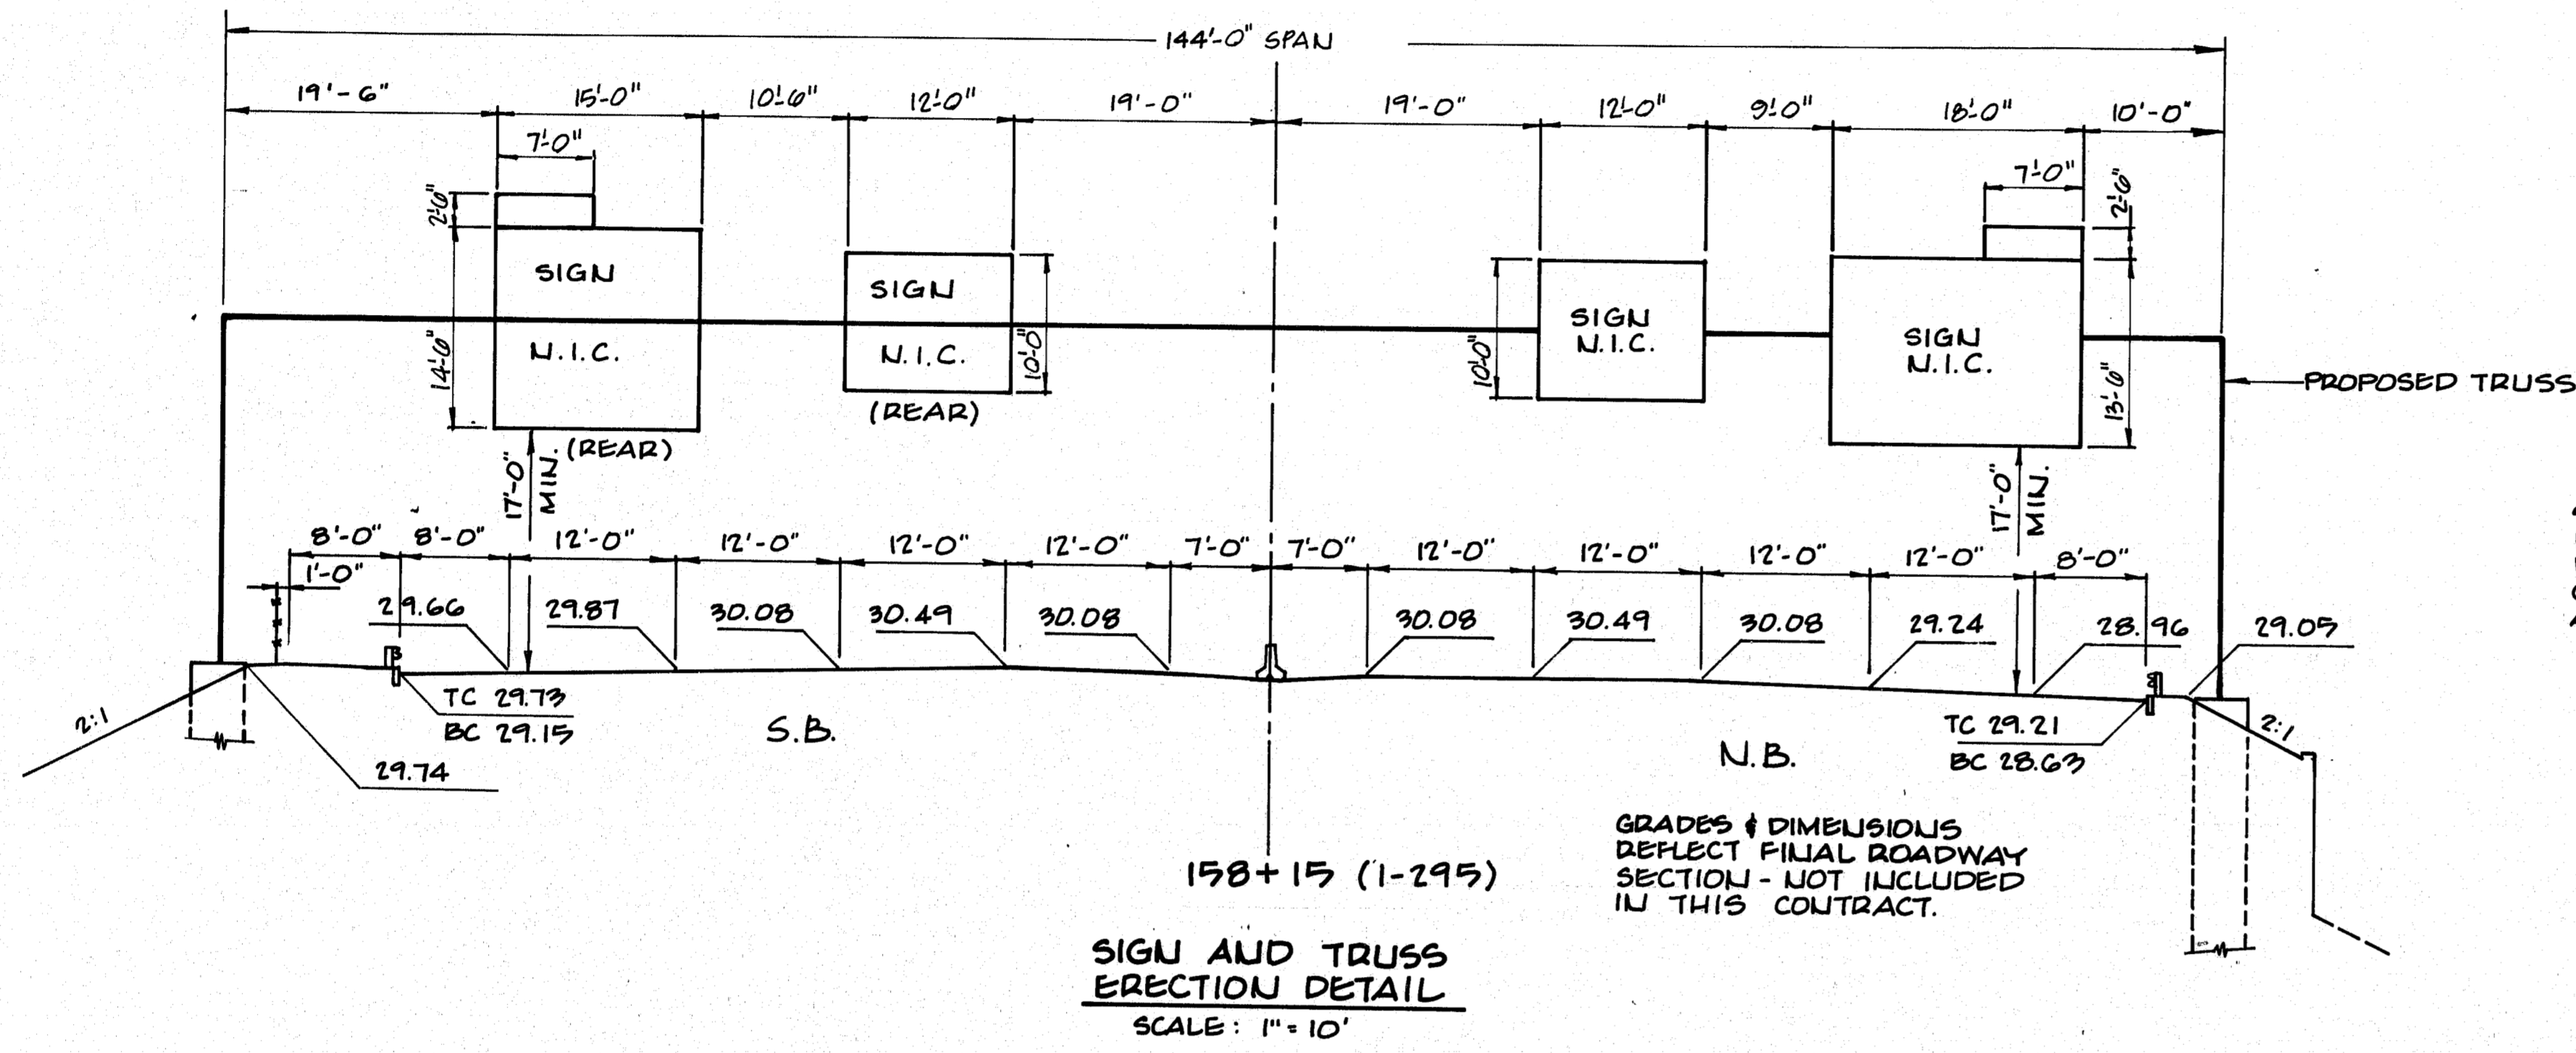

SIGN TRUSS AND FOOTINGS SHALL BE DESIGNED AND CONSTRUCTED TO ACCOMMODATE SIGNS.

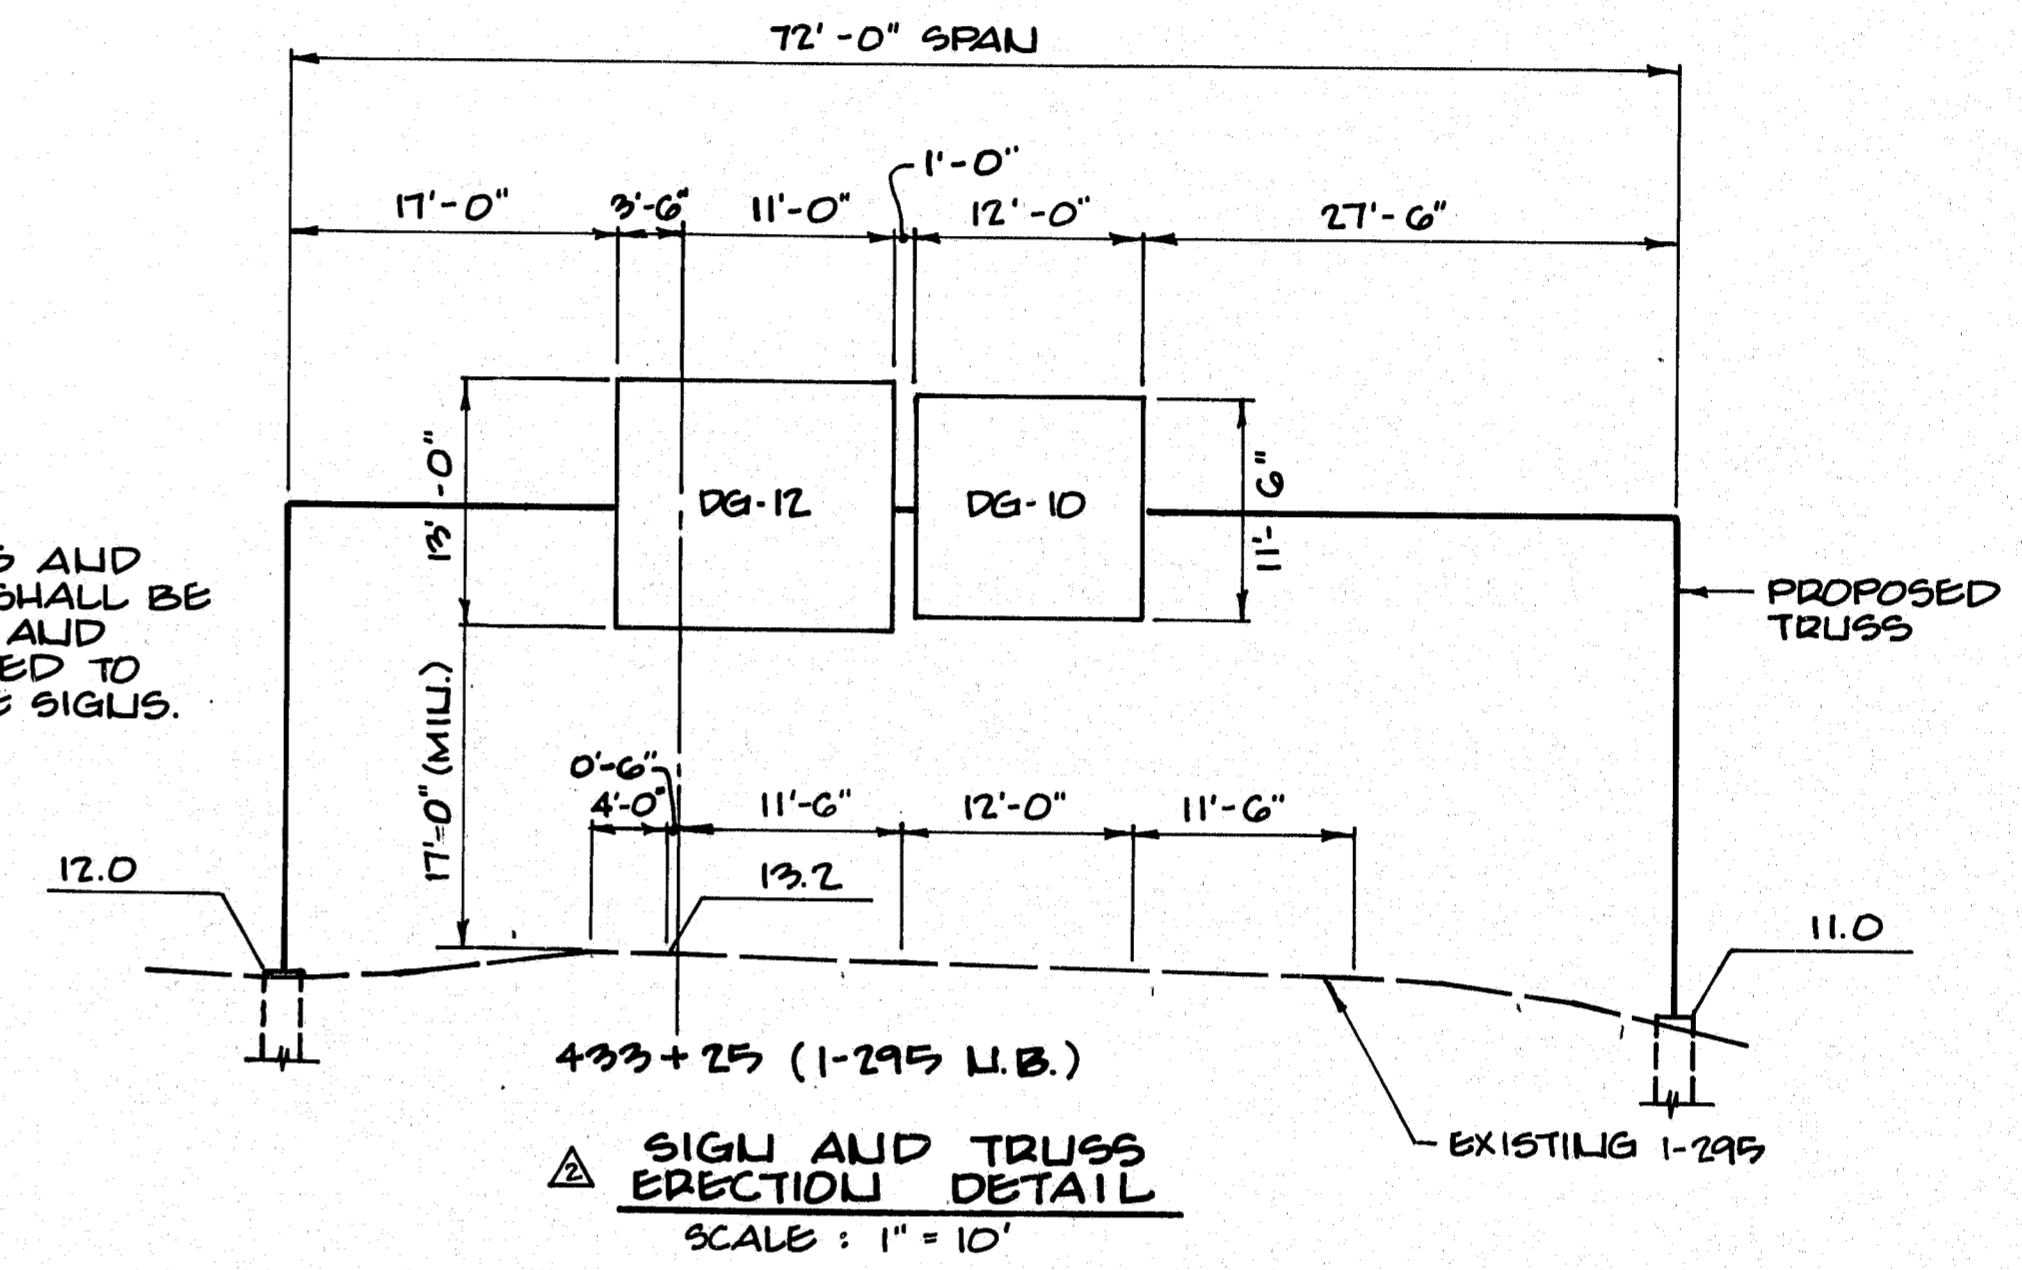

PROJECT DESIGN ENGINEER	DATE
BY	
DESIGN - DETAILED	
CHECKED	
FIELD CHANGES	
PLANS	

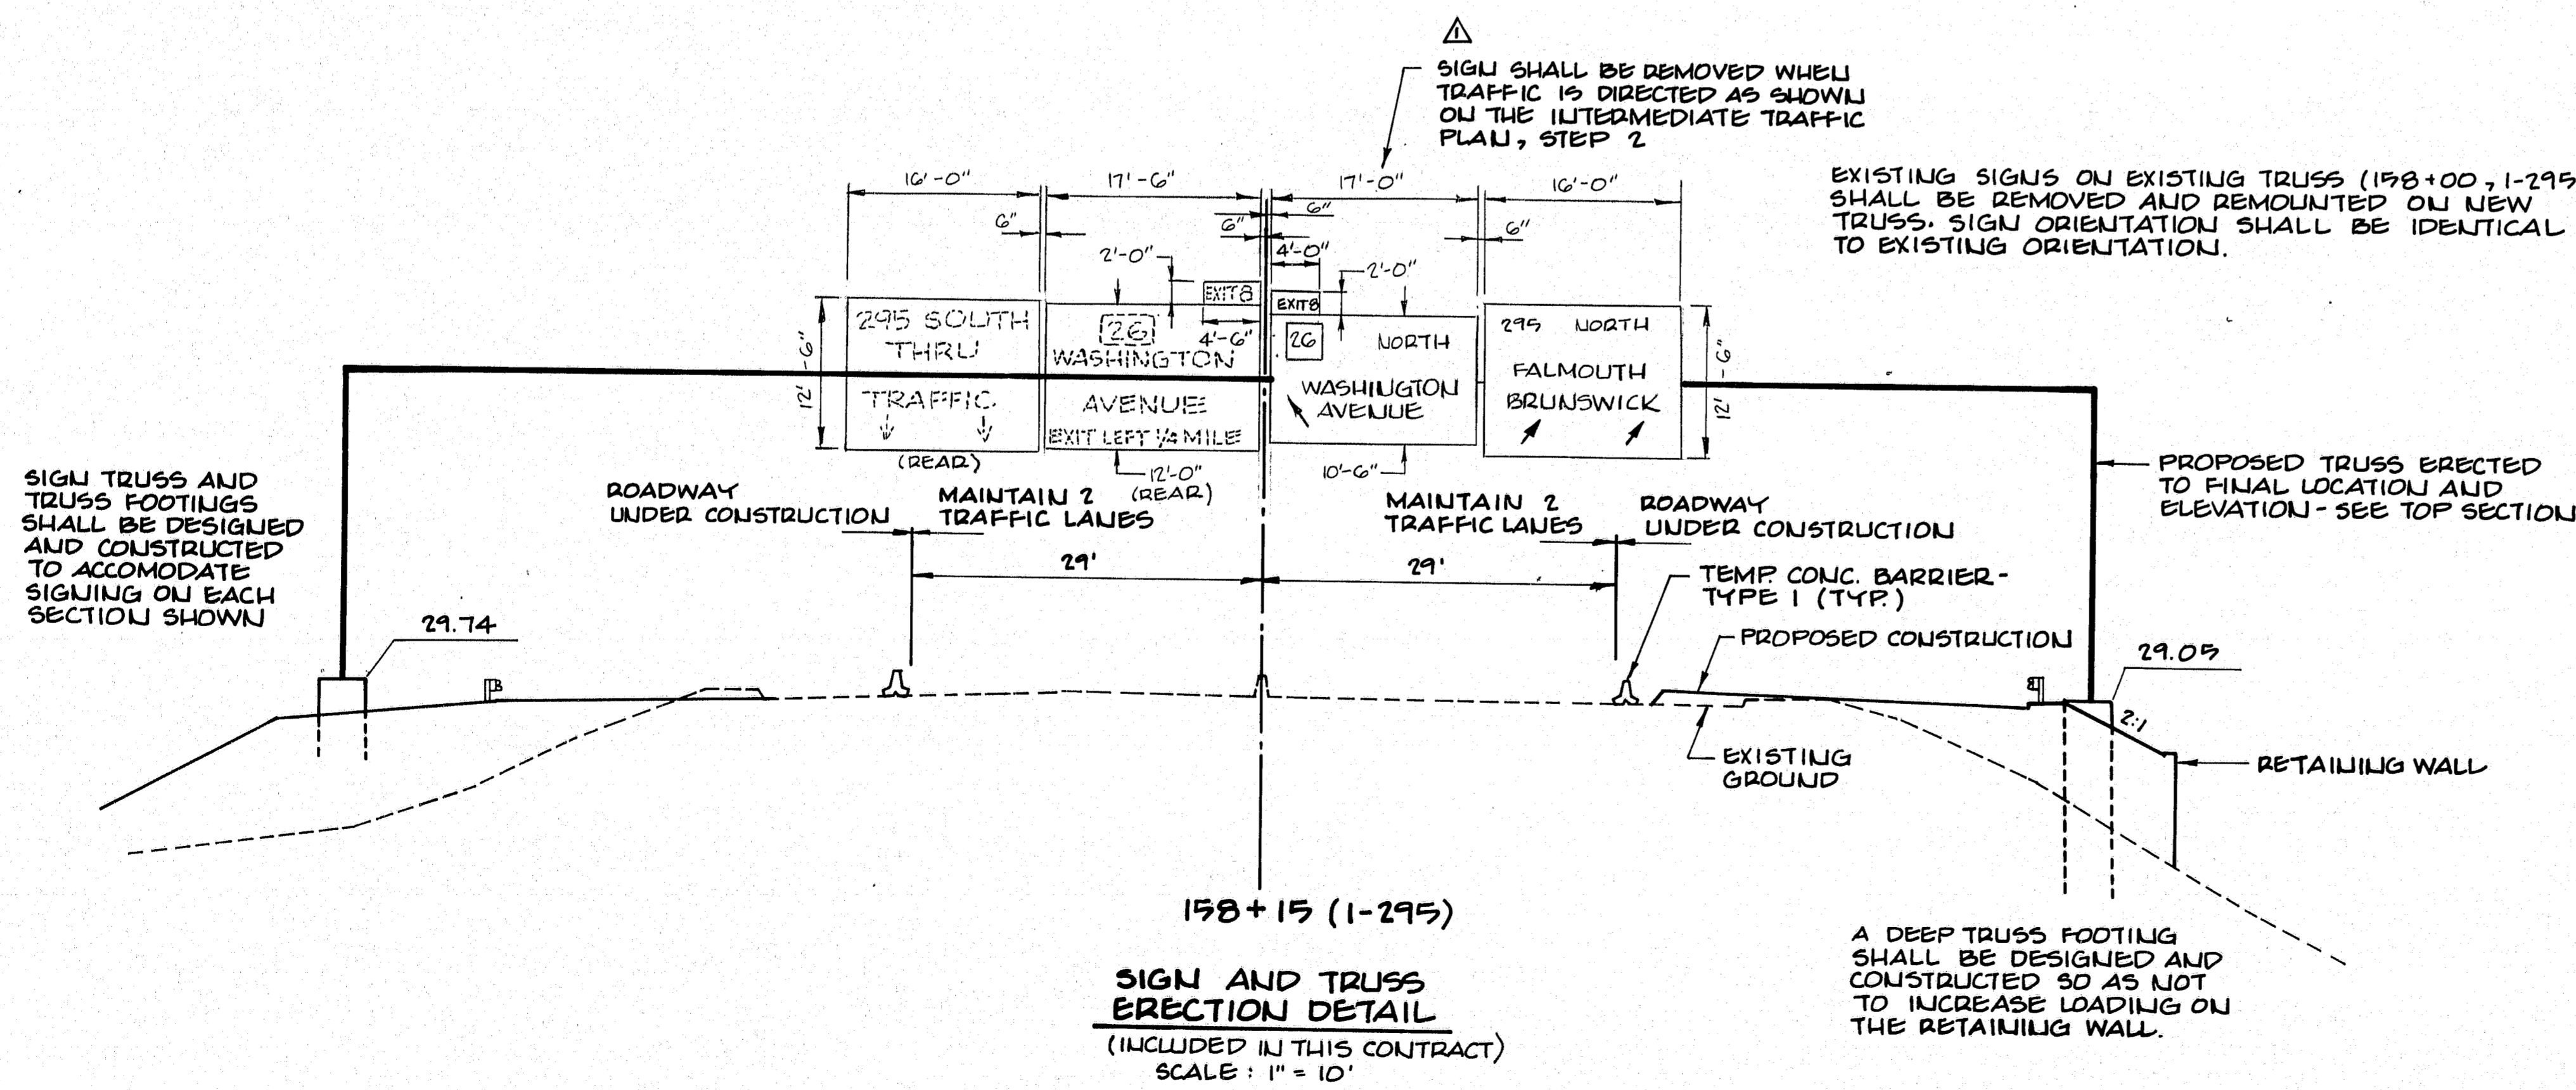

103-318

REV.	DESCRIPTION	BY	DATE
1	ADD LUMEN 1 NEW OVERHEAD SIGN TRUSS REMOVE SIGN	DMM	6-12-85
		DMM	6-12-85
		BWA	6-6-85

STATE OF MAINE
DEPARTMENT OF TRANSPORTATION

I-295 PORTLAND

SIGN TRUSS ERECTION DETAILS

SHEET 77 OF 130 AUGUSTA, MAINE

N.I.C. MEANS NOT IN THIS CONTRACT.

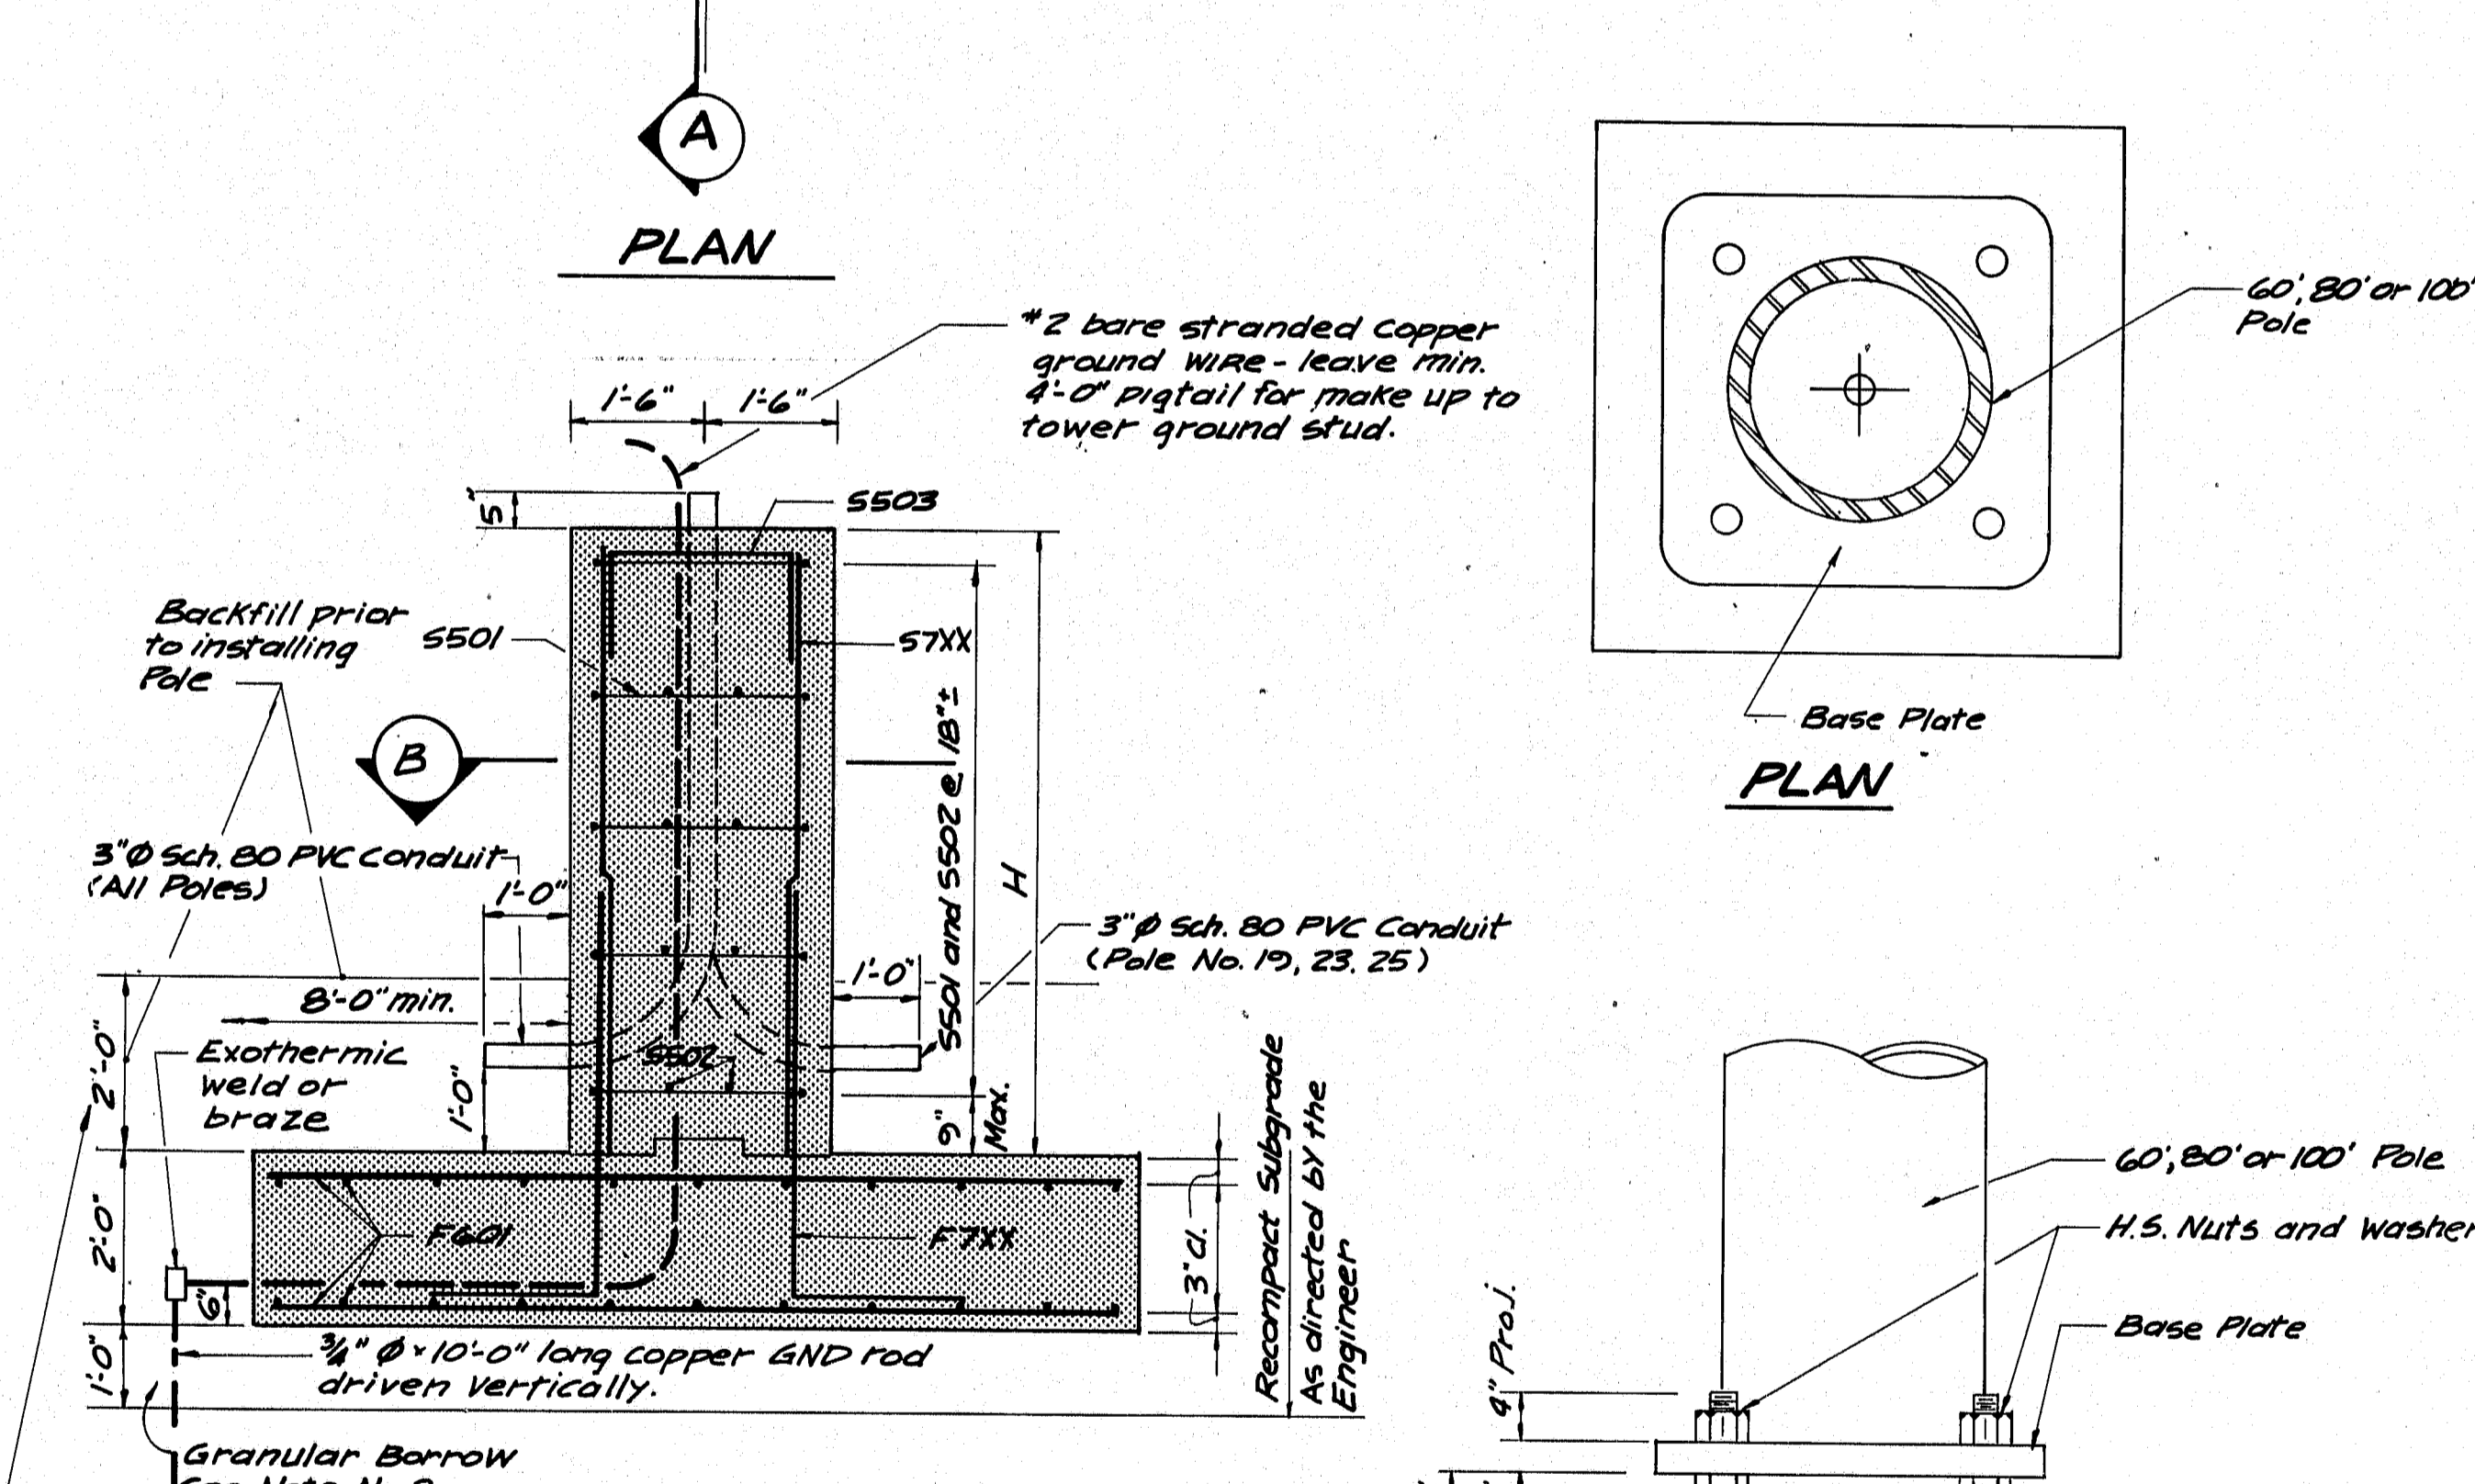
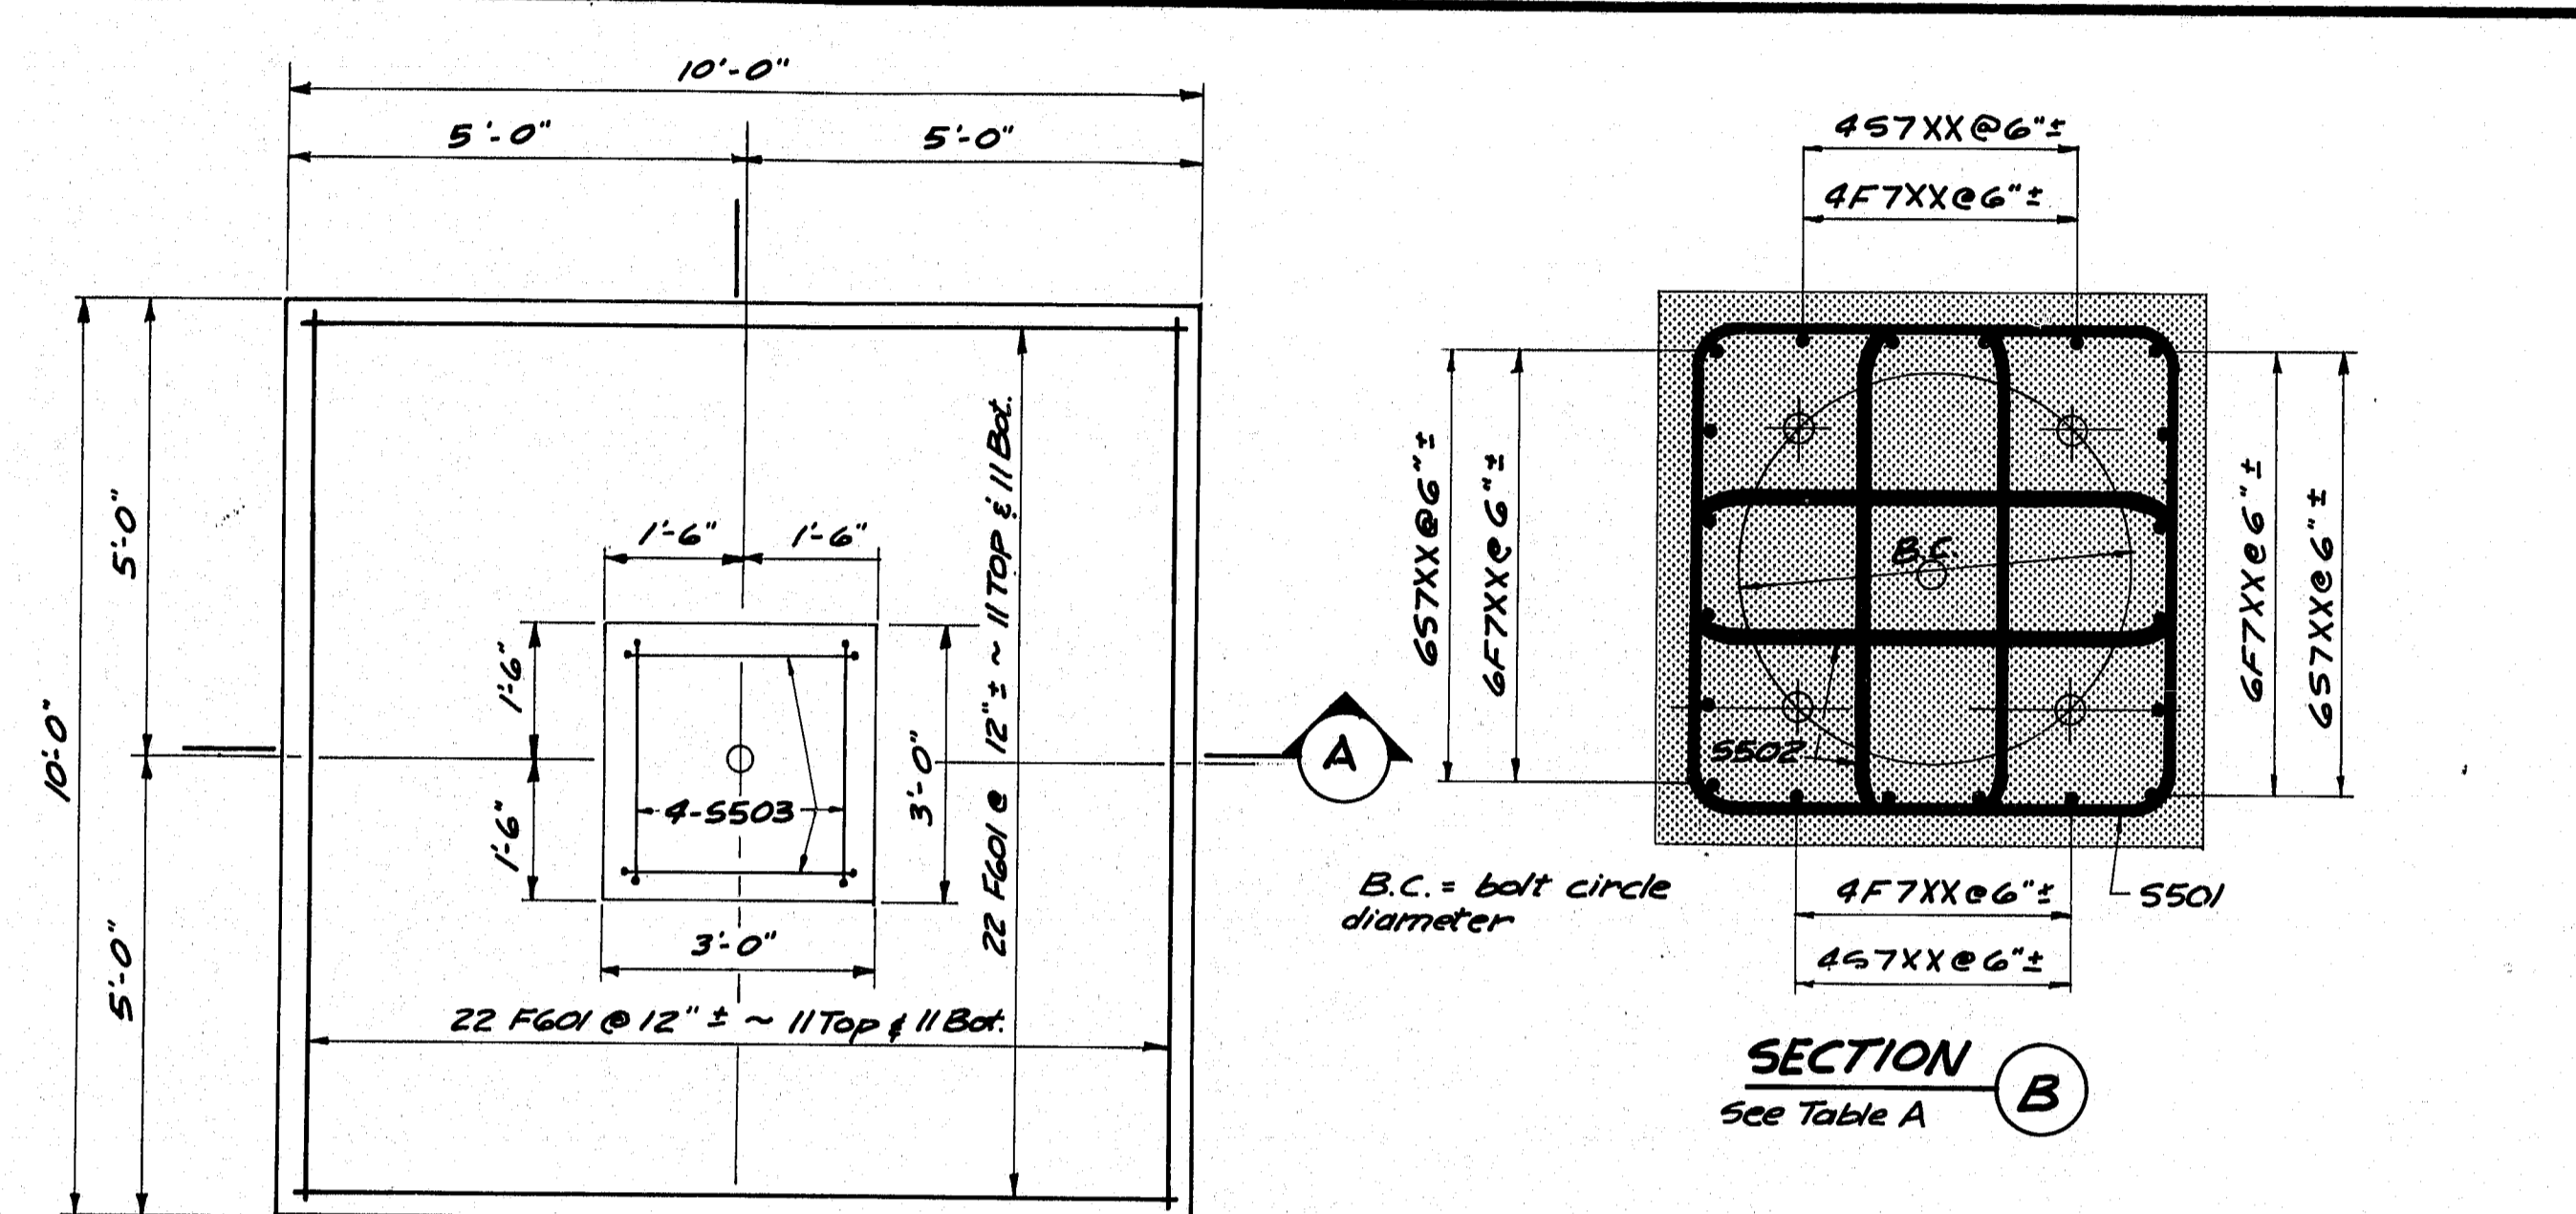


TABLE A

Pole No.	F7X	S7X	S501 OFY	S502 OFY
19 (Reloc)	F701	-	3	6
20 (n.i.c.)	F701	-	3	6
21	F702	S701	6	12
22	F702	S702	10	20
23	F702	S703	12	24
24	F702	S704	4	8
25	F702	S705	5	10
26	F702	S707	8	16
27	F702	S706	6	12

ESTIMATED QUANTITIES















Concrete: 88 Cu. Yd.
Reinforcing Steel: 12,100 Lbs.
(Foundation for Pole No. 20 not included)

MATERIALS

Concrete: Class A
Reinforcing Steel: ASTM A615 Grade 60

BASIC DESIGN STRESSES

Concrete: $f'_c = 3,000$ psi
Reinforcing Steel: $f_y = 60,000$ psi

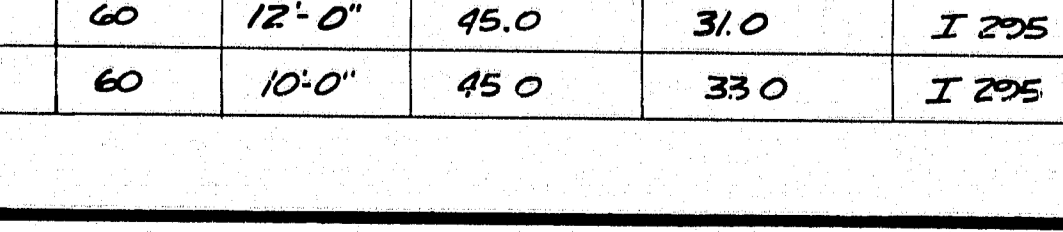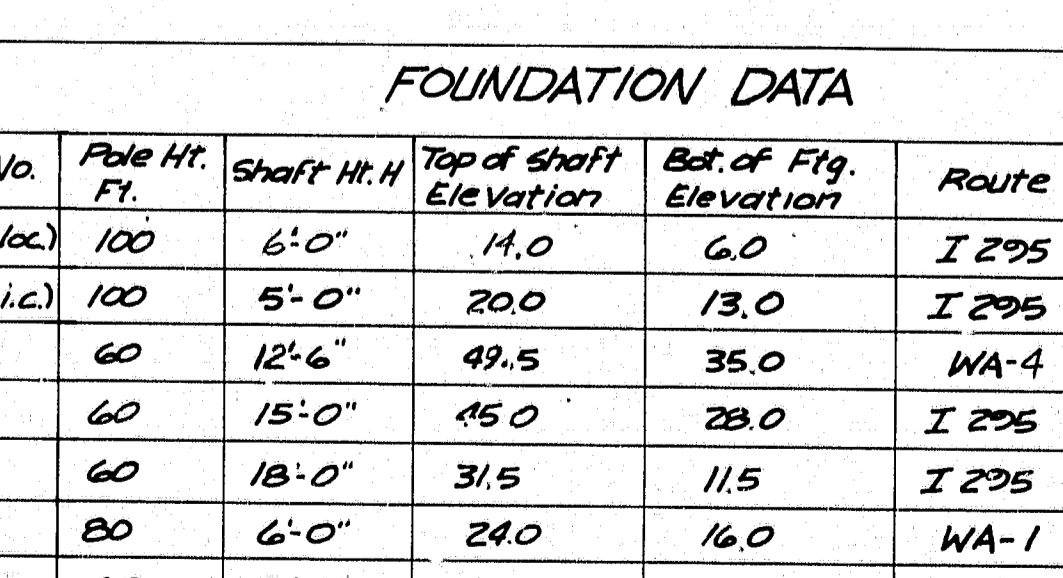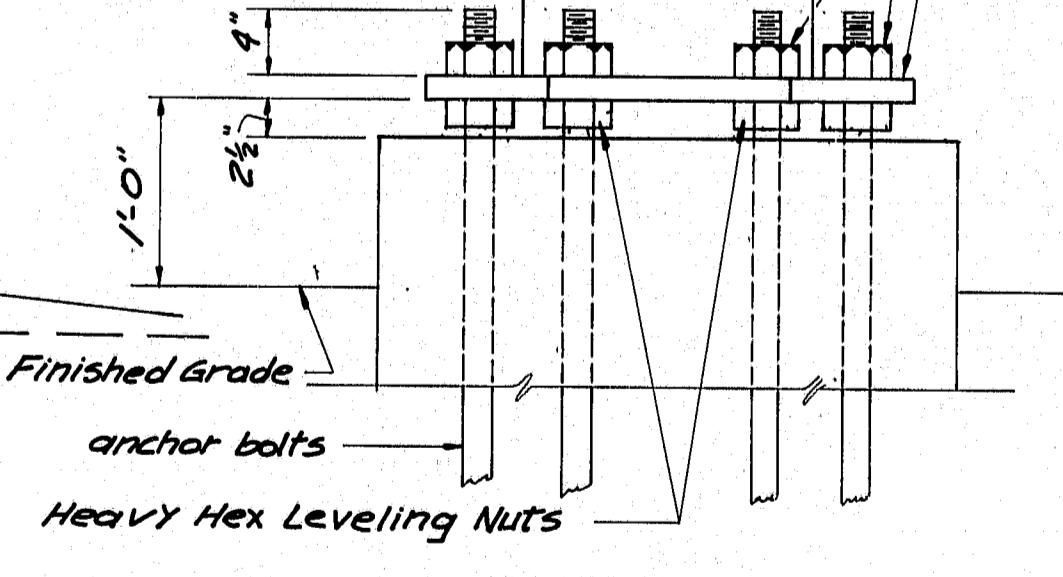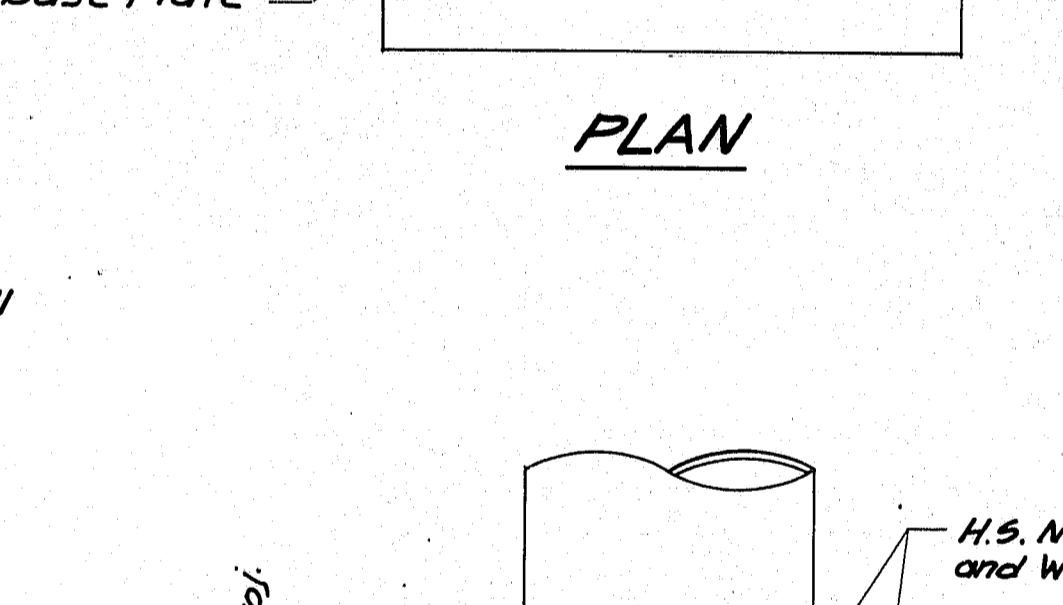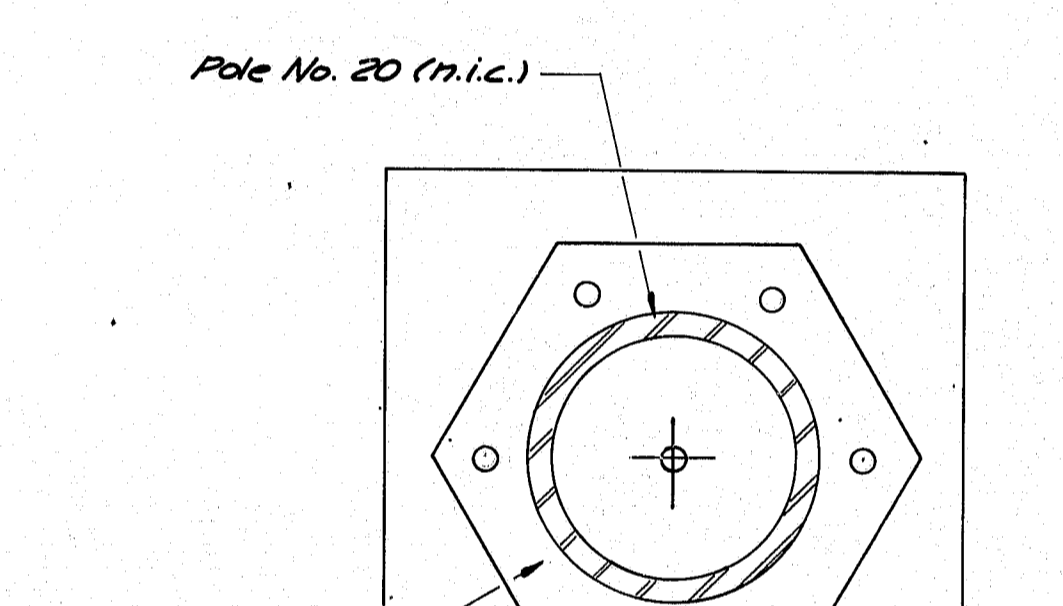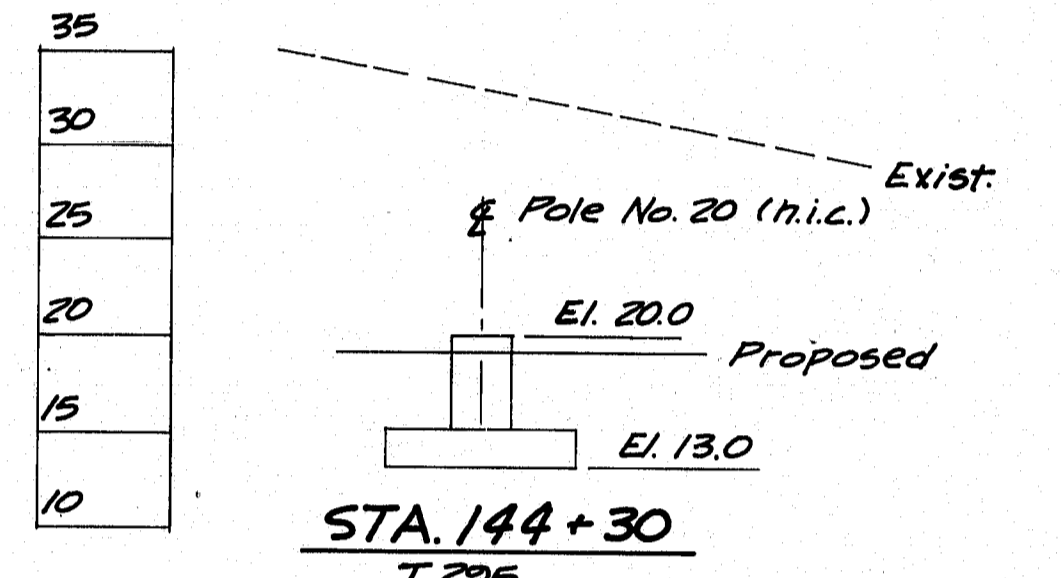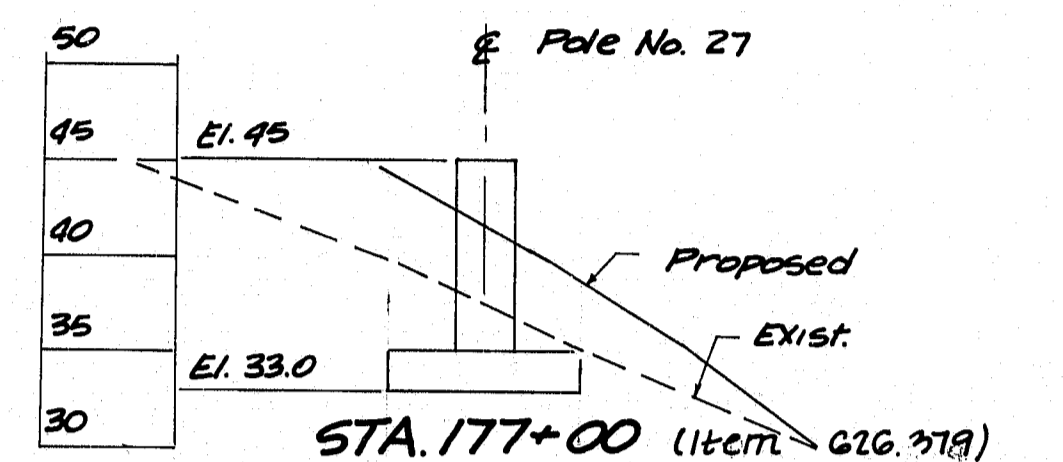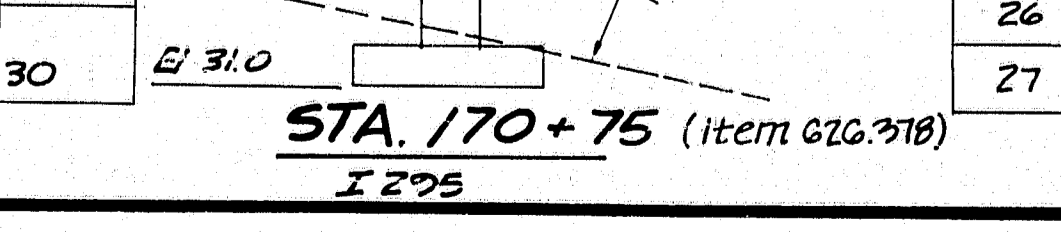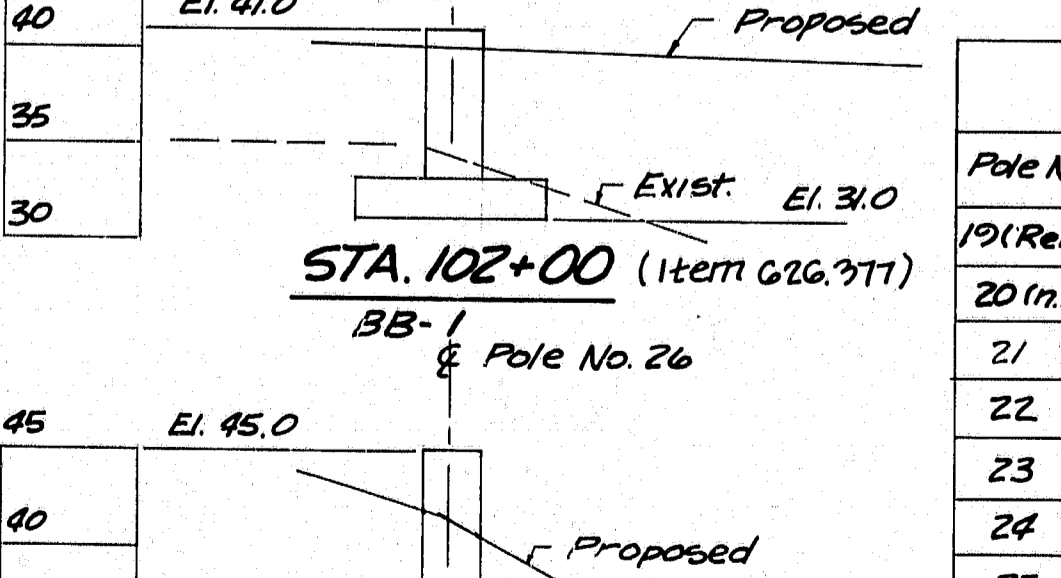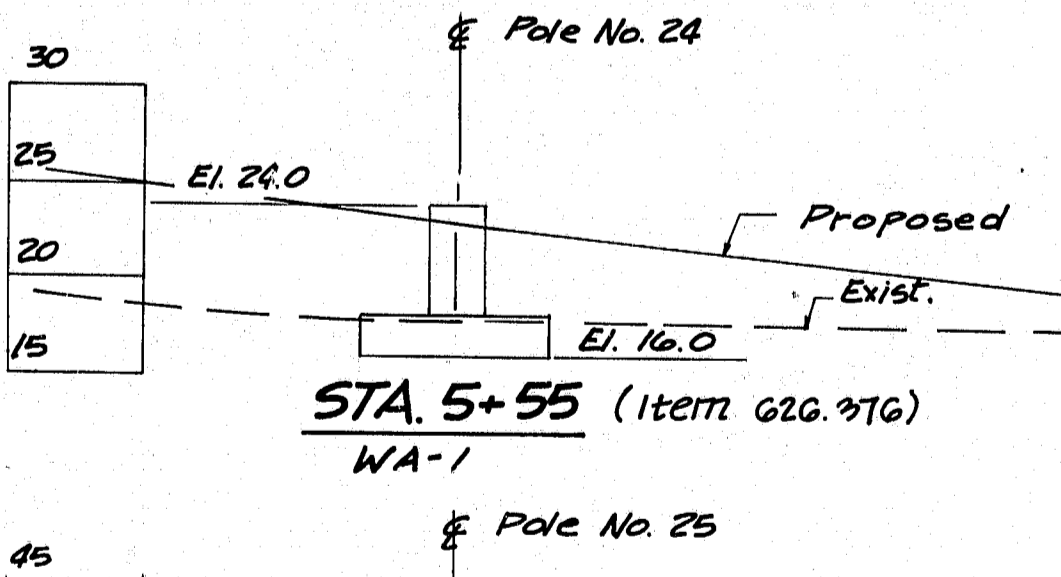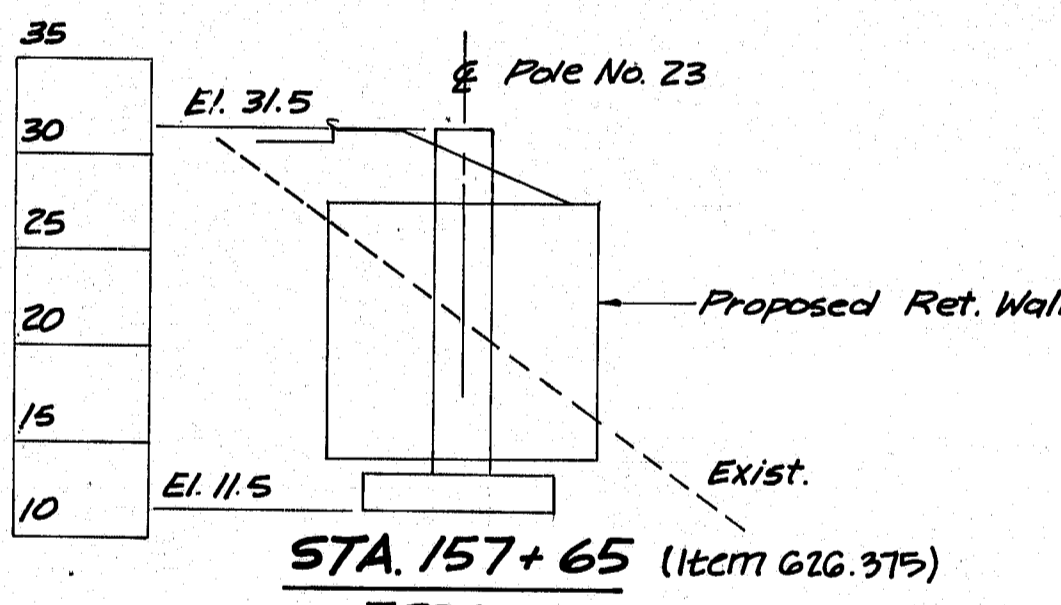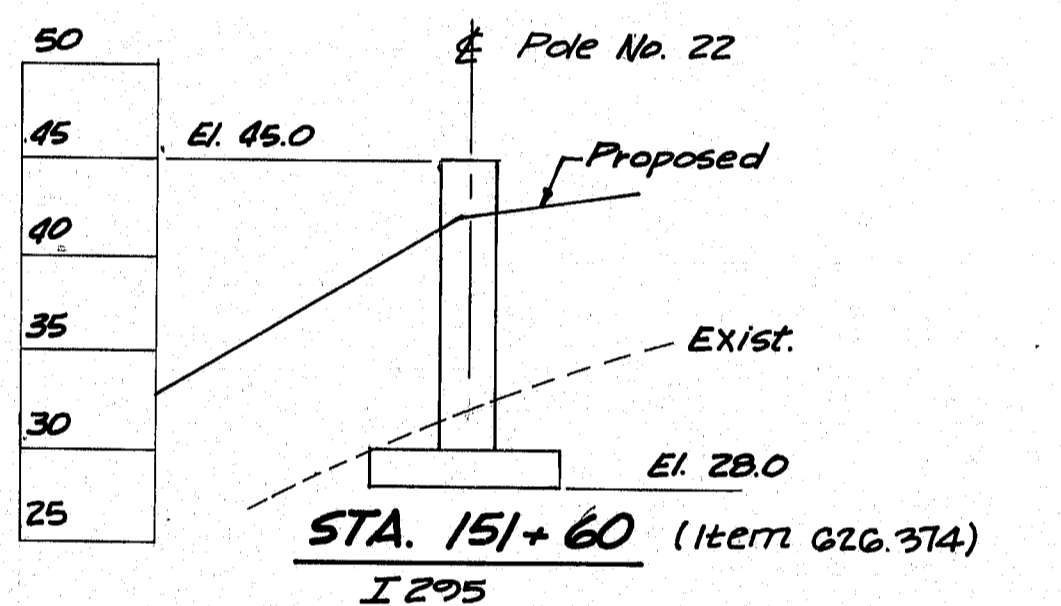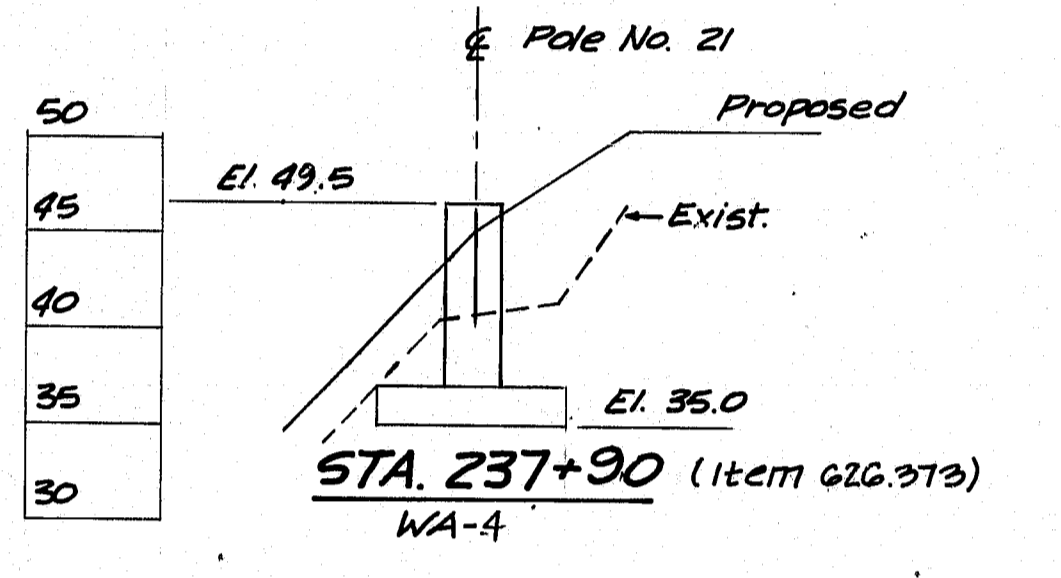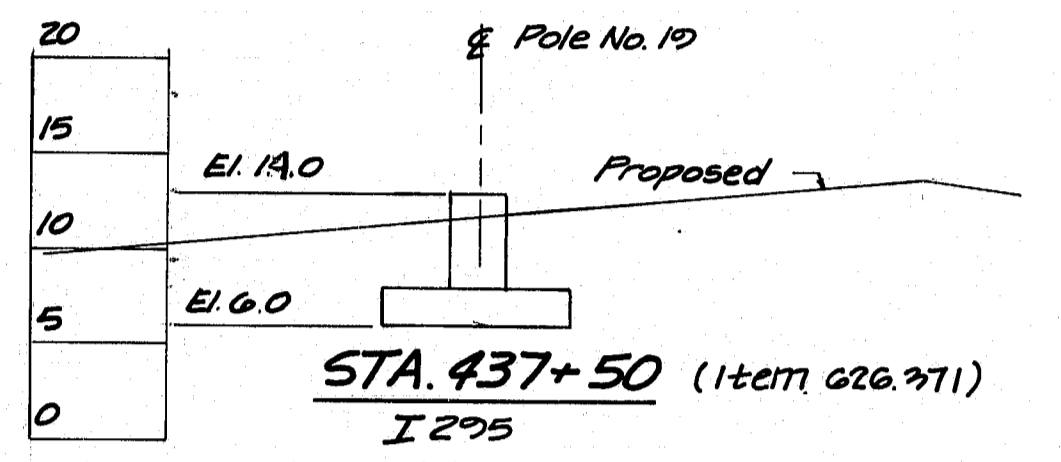

- NOTES:**
- Chamfer all exposed edges of concrete 1/2 inch unless otherwise indicated.
 - All reinforcing steel splices and embedments shall be a minimum of 36 bar diameters unless otherwise indicated.
 - Reinforcing steel shall have 2 inches minimum cover unless otherwise indicated.
 - Place reinforcing steel to clear anchor bolts.
 - Protective Coating for Concrete Surfaces shall be applied to all exposed concrete surfaces to one foot below fin. grade. Payment shall be incidental to special item items. Mortar shall contain an approved non-shrink additive.
 - Dimensions of base plate and bolt circle diameter to be determined by the manufacturer and approved by the Engineer.
 - Bedding and backfill material shall be granular borrow unless existing material is approved by the Engineer.
 - Maximum footing pressure is 10 ton per square foot.
 - All excavation will be paid under Item No. 206.0d.
 - All concrete and reinforcing steel will be paid under Item No. 626.371, 626.373 to 626.379.
 - For location and orientation of foundations see General Construction Plans.
 - Length and size of anchor bolts shall be as supplied by the pole supplier. Number, size and location of anchor bolts for Pole No. 19 shall match the existing.
 - Pole No. 20 is not in this contract (n.i.c.)

REINFORCING STEEL SCHEDULE

Mark No.	Length	Mark No.	Length	Mark No.	Length				
F601	352 9'-6"	S704	20 5'-10"						
S701	20 9'-4"	S705	20 7'-10"						
S702	20 14'-10"	S706	20 9'-10"						
S703	20 17'-10"	S707	20 11'-10"						
Mark No.	Length	Type	A	B	C	D	E	F	R
S501	94 11'-8"	HB	6"	2'-8"	2'-8"	2'-8"	2'-8"	6"	-
S502	108 7'-4"	HB	6"	6"	2'-8"	6"	2'-8"	6"	-
S503	32 5'-1"	S	-	1'-3"	2'-6 3/4"	1'-3"	-	-	-
F701	20 8'-8"	J	1'-7"	9"	6'-4"	-	-	-	6
F702	140 6'-8"	J	1'-7"	9"	4'-4"	-	-	-	6

FOUNDATION DATA

Pole No.	Pole Ht. Ft.	Shaft Ht. H.	Top of Shaft Elevation	Bot. of Fig. Elevation	Route	Station	Offset
19 (Reloc)	100	6'-0"	11.0	6.0	I 295	437+50	16' Lt.
20 (n.i.c.)	100	5'-0"	20.0	13.0	I 295	144+30	75' Lt.
21	60	12'-6"	49.5	35.0	WA-4	237+90	50' Lt.
22	60	15'-0"	45.0	28.0	I 295	151+60	80' Lt.
23	60	18'-0"	31.5	11.5	I 295	157+65	68' Rt.
24	60	6'-0"	24.0	16.0	WA-1	5+55	47' Lt.
25	60	8'-0"	41.0	31.0	BB-1	102+00	24' Lt.
26	60	12'-0"	45.0	31.0	I 295	170+75	60' Rt.
27	60	10'-0"	45.0	33.0	I 295	177+00	60' Rt.

REVISED AS BUILT 1986
John R. Mangel 3-30-91

STATE OF MAINE
DEPARTMENT OF TRANSPORTATION
I-295 PORTLAND

FOUNDATION DETAILS FOR HIGH MAST LIGHTING

103-319

SHEET 78 OF 120 AUGUSTA, MAINE

PROJECT DESIGN ENGINEER: R2E RJB
DATE: [] [] []
DESIGN - DETAILED: R2E RJB
REVISIONS: [] [] []
FIELD CHANGES: [] [] []

BRUNING 44132 45710-1


PEDESTRIAN BRIDGE REMOVAL
ITEM NO. 202.192

- NOTES**
- PLANS OF THE EXISTING BRIDGE MAY BE VIEWED AT THE TRANSPORTATION BUILDING, MDT, AUGUSTA, MAINE.
 - THE BRIDGE FOUNDATIONS SHALL BE REMOVED TO ELEVATION 17.0.
 - BRIDGE REMOVAL SHALL INCLUDE REMOVAL AND DISPOSAL OF STAIRS AND STAIR FOUNDATIONS TO ELEVATION 17.0.
 - ITEM 202.192 SHALL INCLUDE PAYMENT FOR ALL WORK NOTED ON THIS SHEET AND IN THE SPECIFICATIONS UNDER ITEM 202.192.
 - EXCAVATION AND BACKFILL REQUIRED FOR BRIDGE REMOVAL SHALL BE INCLUDED FOR PAYMENT UNDER ITEM 202.192. THE GROUND SURFACE SHALL BE RESTORED TO ITS ORIGINAL GRADE.
 - STRUCTURAL STEEL AND RAILINGS SHALL BE REMOVED AND DELIVERED TO MDT DUNSTAN MAINTENANCE LOT, RTE. 1, SCARBOROUGH.


BAXTER BLVD BRIDGE REMOVAL
ITEM NO. 202.191

- NOTES**
- THE BRIDGE FOUNDATION LOCATIONS, SIZES, ELEVATIONS AND NUMBER OF PILES WERE COMPILED FROM AVAILABLE RECORD DRAWINGS AND ARE NOT WARRANTED TO BE COMPLETE OR CORRECT. THIS INFORMATION IS SHOWN FOR THE CONTRACTOR'S REFERENCE ONLY. PLANS OF THE EXISTING BRIDGES MAY BE VIEWED AT THE TRANSPORTATION BUILDING, MDT, AUGUSTA, MAINE.
 - LIMITS OF BRIDGE SUBSTRUCTURE REMOVAL ARE SHOWN TO REFLECT THE INTENT TO REMOVE ALL FOUNDATIONS AND BRIDGE MATERIALS IN THE VICINITY OF THE EXISTING BRIDGES TO THE EXTENT INDICATED. THE CONTRACTOR IS NOT RELIEVED FROM REMOVING FOUNDATIONS AND BRIDGE MATERIALS NOT SHOWN THAT MAY EXTEND BEYOND THE LIMITS MARKED AND MAY OBSTRUCT PROPOSED CONSTRUCTION, AT NO ADDITIONAL COMPENSATION. SECTIONS OF BRIDGE FOUNDATIONS MAY REMAIN AS NOTED.
 - BRIDGE DRAINAGE CONNECTIONS, ELECTRICAL CONDUIT AND OTHER UNDERGROUND UTILITIES IN THE VICINITY OF BRIDGE REMOVAL SHALL BE PROTECTED FROM DISRUPTION UNTIL AUTHORIZED FOR REMOVAL BY THE ENGINEER. WHEN AUTHORIZED TO COMMENCE BRIDGE REMOVAL THE CONTRACTOR SHALL MAKE WHATEVER REPAIRS ARE NECESSARY TO MAINTAIN SECTIONS OF PIPE AND CONDUIT THAT ARE TO REMAIN, IN SERVICE, AT NO ADDITIONAL COMPENSATION.
 - ALL MATERIAL ABOVE TOP OF FOOTINGS SHALL BE REMOVED EXCEPT AS OTHERWISE NOTED.
 - BRIDGE REMOVAL SHALL ALSO INCLUDE REMOVAL AND DISPOSAL OF APPROACH SLABS, END POSTS, AND MEDIANS TO THE LIMITS OF GRADING SHOWN.
 - ITEM 202.191 SHALL INCLUDE PAYMENT FOR ALL WORK SO NOTED ON THIS SHEET.
 - EXCAVATION, BACKFILL AND GRADING WITHIN THE GRADING LIMITS INDICATED SHALL BE INCLUDED FOR PAYMENT UNDER ITEM 202.191. EXCAVATION, BACKFILL AND GRADING REQUIRED FOR BRIDGE SUBSTRUCTURE REMOVAL FOR ABUTMENT A AND ABUTMENT B SHALL BE PAID UNDER ITEM 202.191. EXCAVATION, BACKFILL AND GRADING OUTSIDE THESE LIMITS SHALL BE PAID UNDER APPLICABLE ITEMS DESCRIBED ELSEWHERE. FINAL GRADING SHALL CONFORM TO THE GRADING PLAN.
 - STRUCTURAL STEEL, BRIDGE RAIL AND BRIDGE MEDIAN RAIL, INCLUDING BRIDGE RAIL ON THE APPROACHES, SHALL BE REMOVED AND DELIVERED TO MDT DUNSTAN MAINTENANCE LOT, RTE 1, SCARBOROUGH.

FOOTING DESIGNATION	DESCRIPTION OF WORK
1,2,3,4,5	REMOVE ALL MATERIAL ABOVE TOP OF FOOTINGS
6,7,8,9,10,15,21	REMOVE ALL MATERIAL ABOVE ELEVATION 18.0
14,22	REMOVE ALL MATERIAL ABOVE ELEVATION 17.0
11,12,13	REMOVE ALL MATERIAL ABOVE ELEVATION 15.5
16,17,18,19,20	REMOVE ALL MATERIAL ABOVE TOP OF FOOTINGS
23,24,25	REMOVE ONLY SECTIONS OF FOOTINGS OUTSIDE THE HORIZONTAL LIMITS OF THE EXISTING ROADWAY. REMOVE ALL MATERIAL ABOVE ELEVATION 18.0 ON THESE SECTIONS.
26	REMOVE ALL MATERIAL ABOVE ELEVATION 36.0

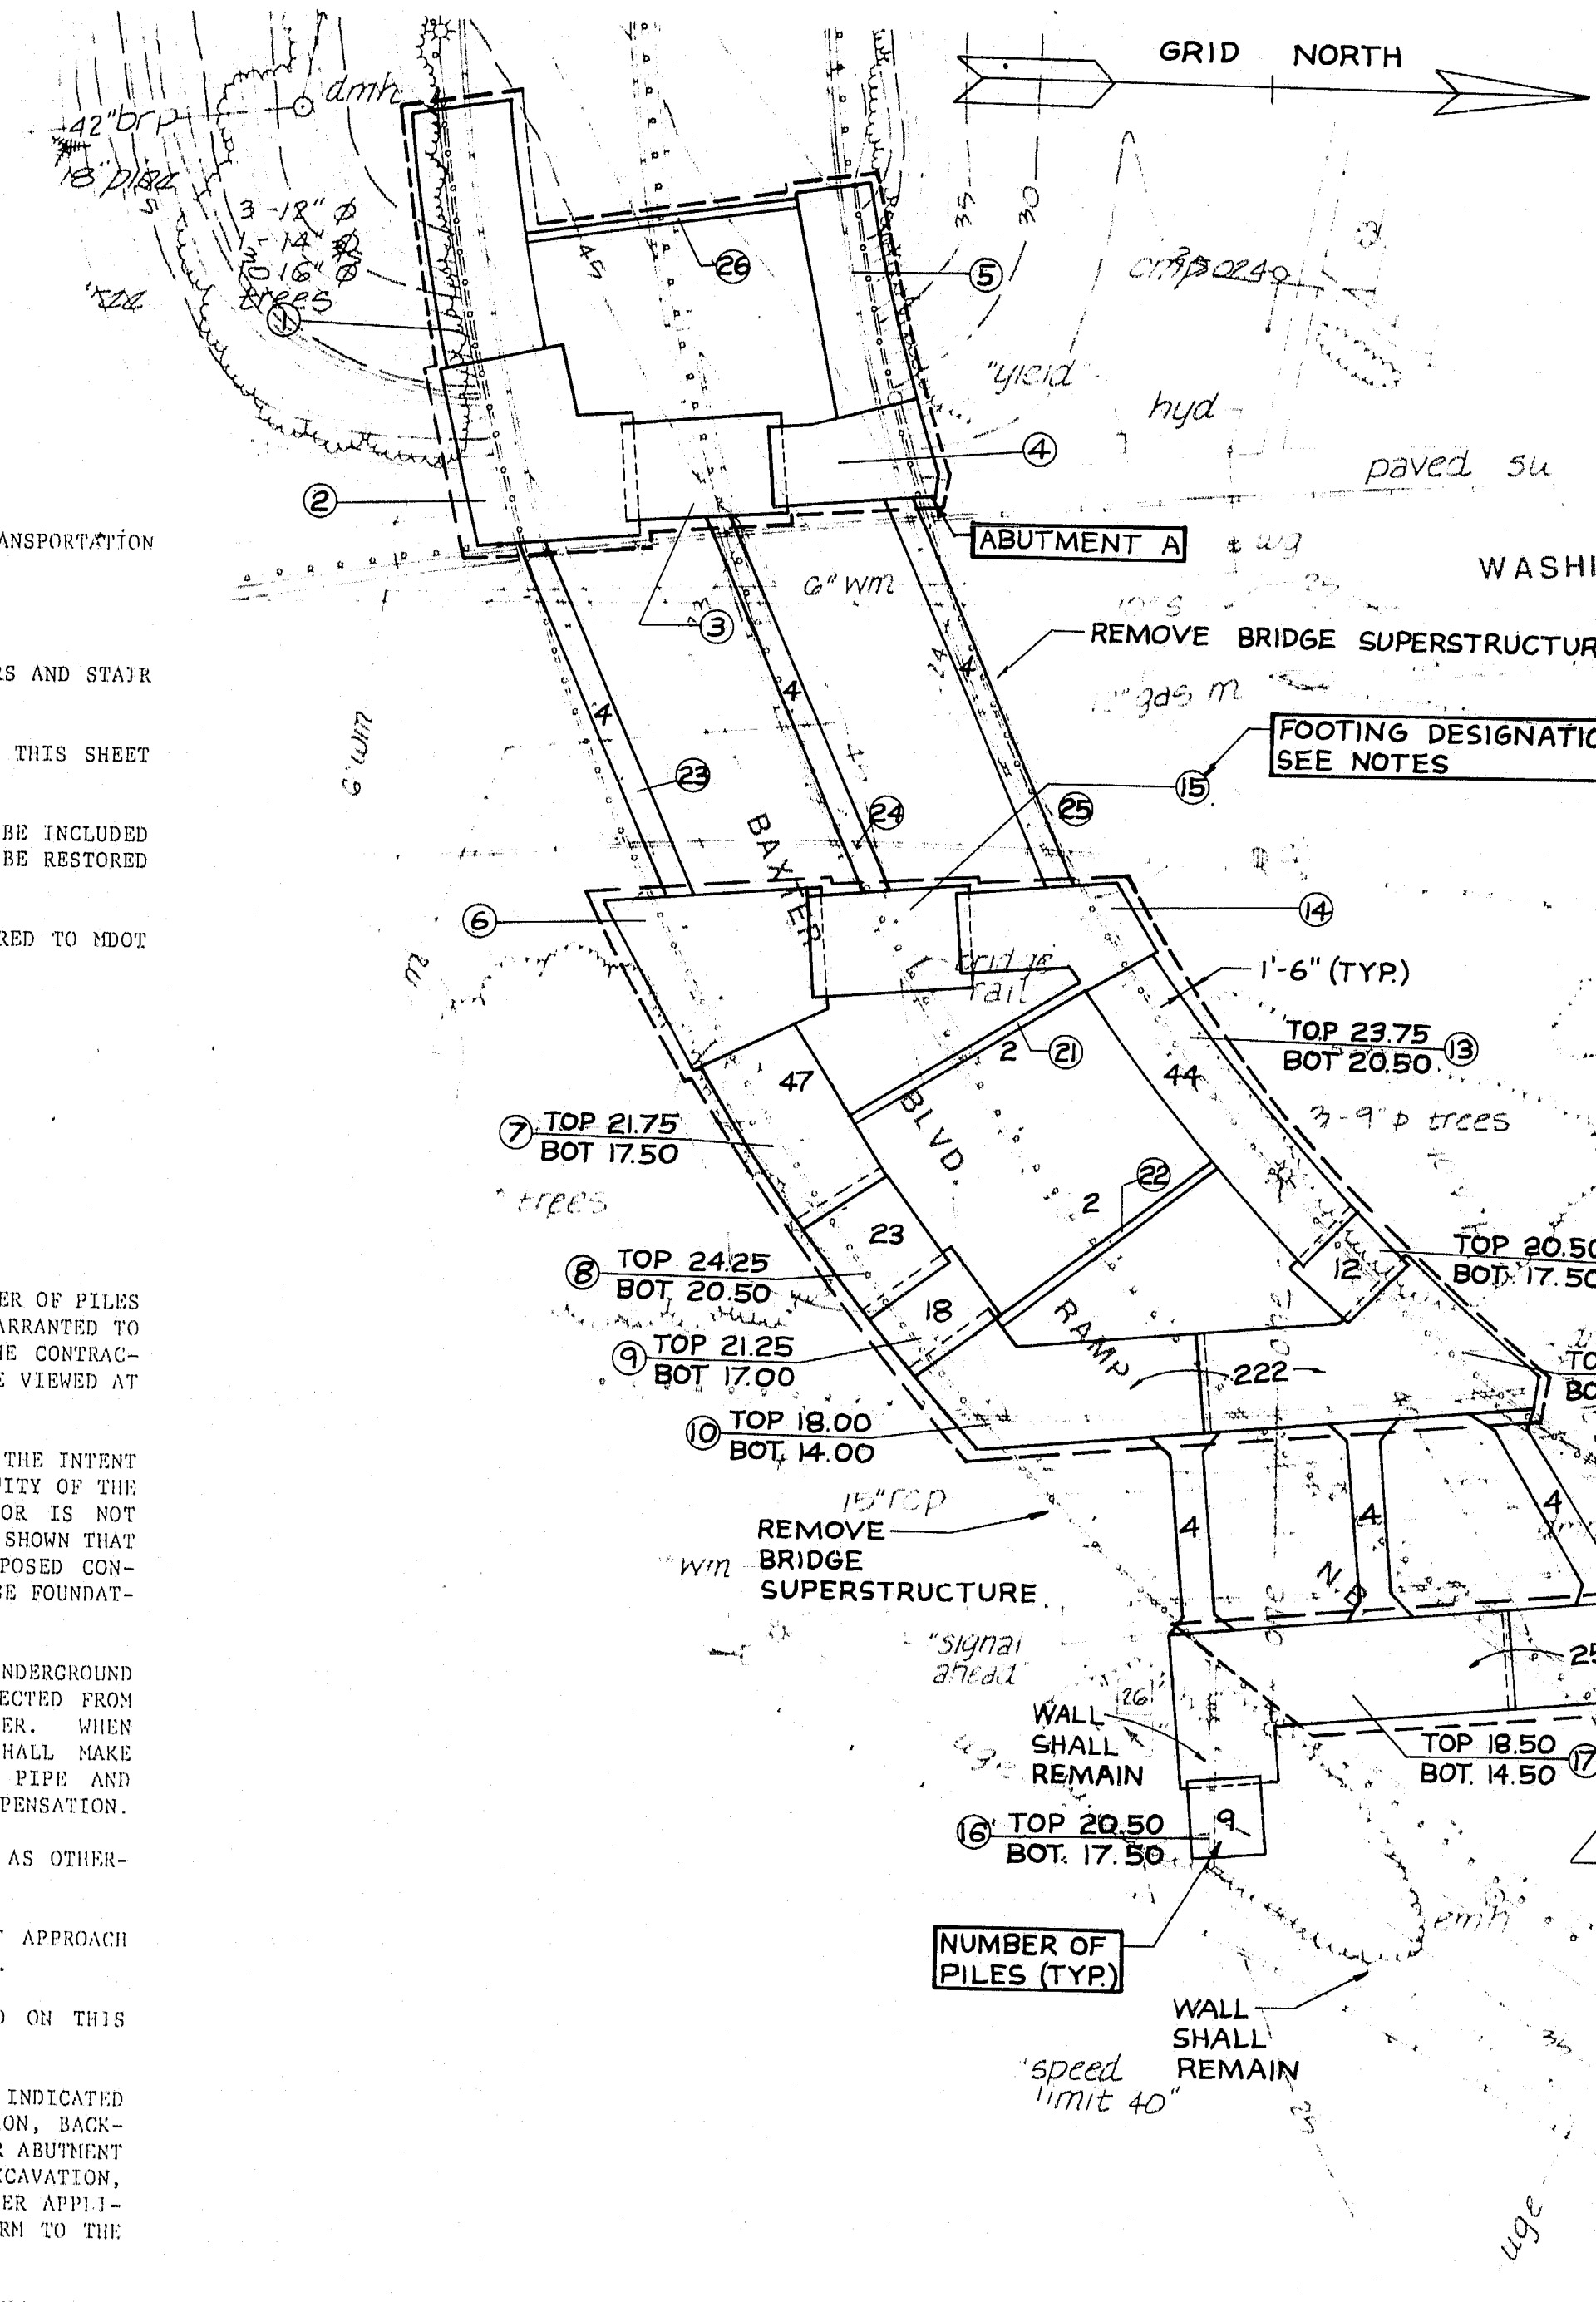

BAXTER BLVD BRIDGE REMOVAL
DEMOLITION PLAN
ITEM 202.191

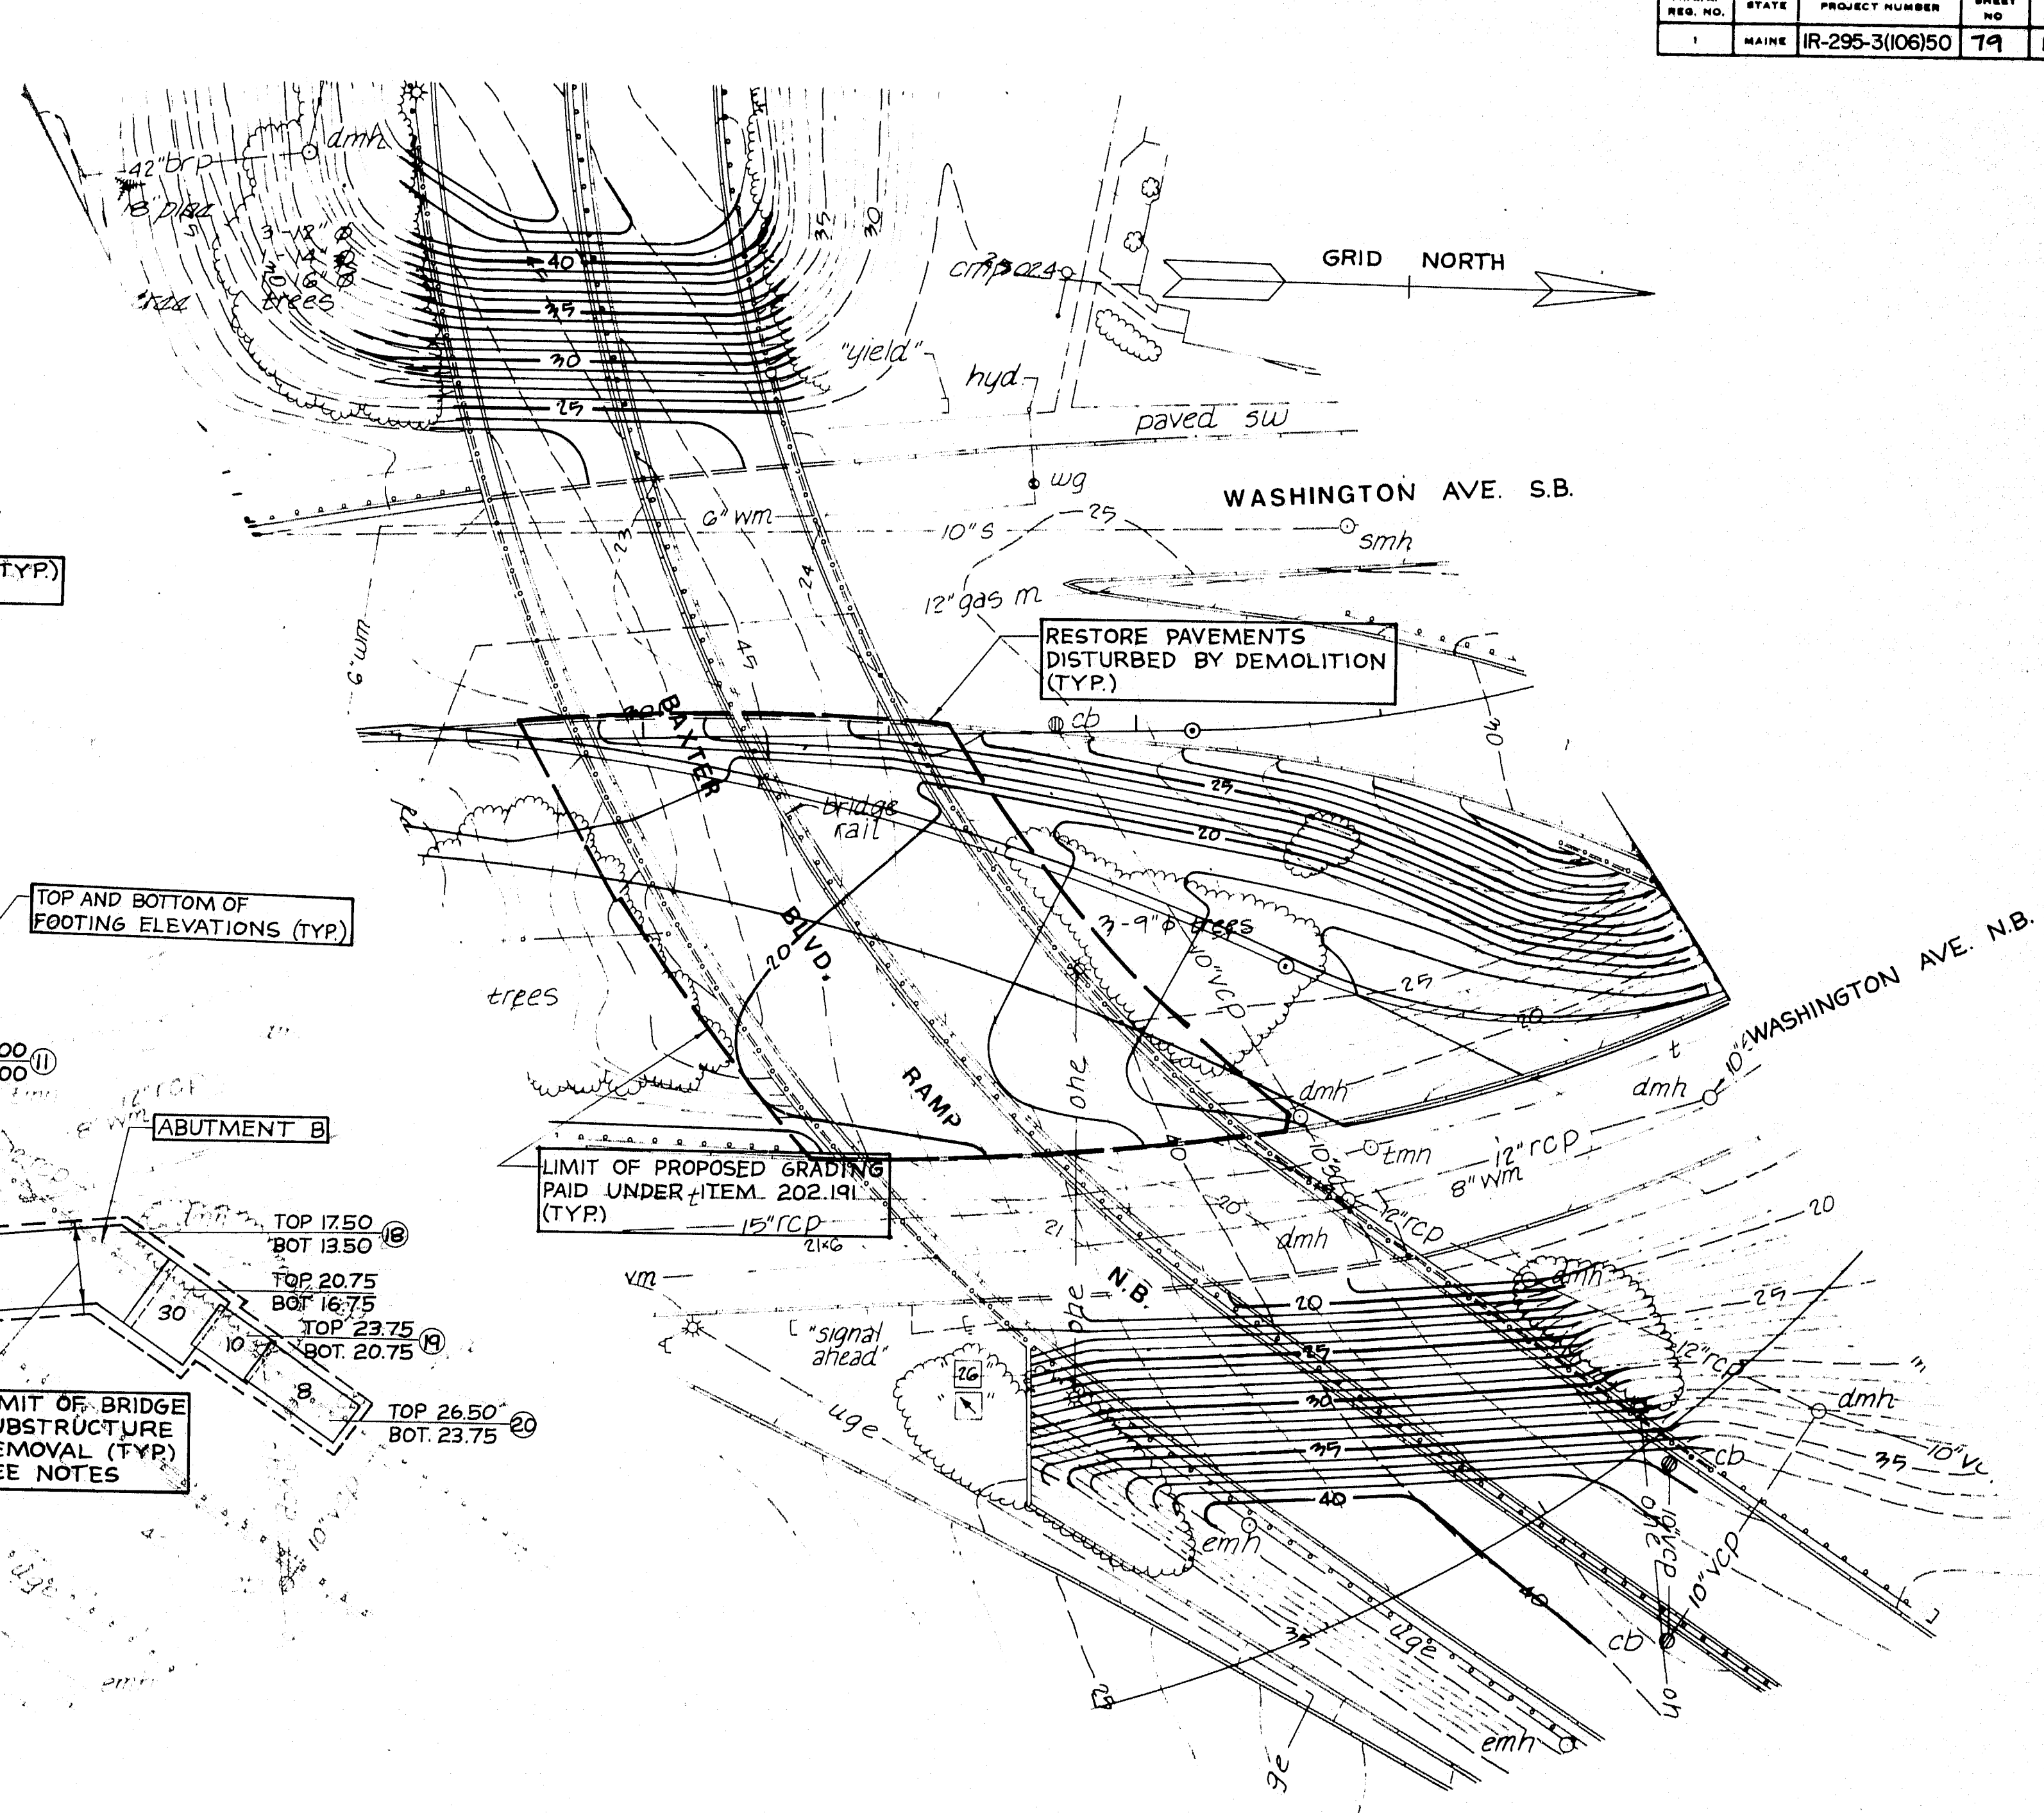

BAXTER BLVD BRIDGE REMOVAL
GRADING PLAN
ITEM 202.191

PROJECT ENGINEER	DATE
DESIGN-DETAILED	
CHECKED	
FIELD CHANGES	
PLANS	

BAXTER BLVD. BRIDGE REMOVAL
PEDESTRIAN BRIDGE REMOVAL
MAINTENANCE OF TRAFFIC NOTES

SCHEDULING FOR BRIDGE SUPERSTRUCTURE REMOVAL SHALL BE AT PERIODS OF LOW TRAFFIC VOLUMES, EITHER AT NIGHT OR ON SUNDAYS. NO WORK WILL BE ALLOWED ON SPECIFIED HOLIDAYS AND HOLIDAY WEEKENDS.

THE CONTRACTOR SHALL BE RESPONSIBLE FOR NOTIFYING ALL CITY AND STATE AGENCIES (POLICE, FIRE, ETC.) OF ANY ANTICIPATED TRAFFIC INTERRUPTIONS DURING BRIDGE REMOVAL. PROVISIONS SHALL BE MADE BY THE CONTRACTOR TO PROTECT TRAFFIC FROM FALLING DEBRIS AND FROM ALL OTHER MATERIALS AND EQUIPMENT THAT ARE IN PROXIMITY TO THE TRAVELLED WAYS. TRAFFIC SHALL BE MAINTAINED AS INDICATED ON THE TRAFFIC PLANS EXCEPT AS SPECIFIED HEREINAFTER. AT LEAST ONE LANE OF INTERSTATE TRAFFIC IN EACH DIRECTION SHALL BE MAINTAINED AT ALL TIMES DURING SUPERSTRUCTURE REMOVAL. ADDITIONAL TRAFFIC BARRIERS AND SIGNS NOT SHOWN ON THE PLANS THAT WILL BE REQUIRED FOR THE CONTRACTOR TO SAFELY COMPLETE BRIDGE REMOVAL WHILE MAINTAINING TRAFFIC SHALL BE ERRECTED, RESET AS REQUIRED, AND REMOVED, WHEN AUTHORIZED BY THE ENGINEER, WITH PAYMENT TO BE INCLUDED UNDER THE APPLICABLE ITEMS.

103-320


STATE OF MAINE
DEPARTMENT OF TRANSPORTATION

1-295 PORTLAND


BRIDGE DEMOLITION PLAN

SHEET 79 OF 130 AUGUSTA, MAINE

F.W.A. REG. NO.	STATE	PROJECT NUMBER	SHEET NO.	TOTAL SHEETS
1	MAINE	R-295-3(106)50	80	120

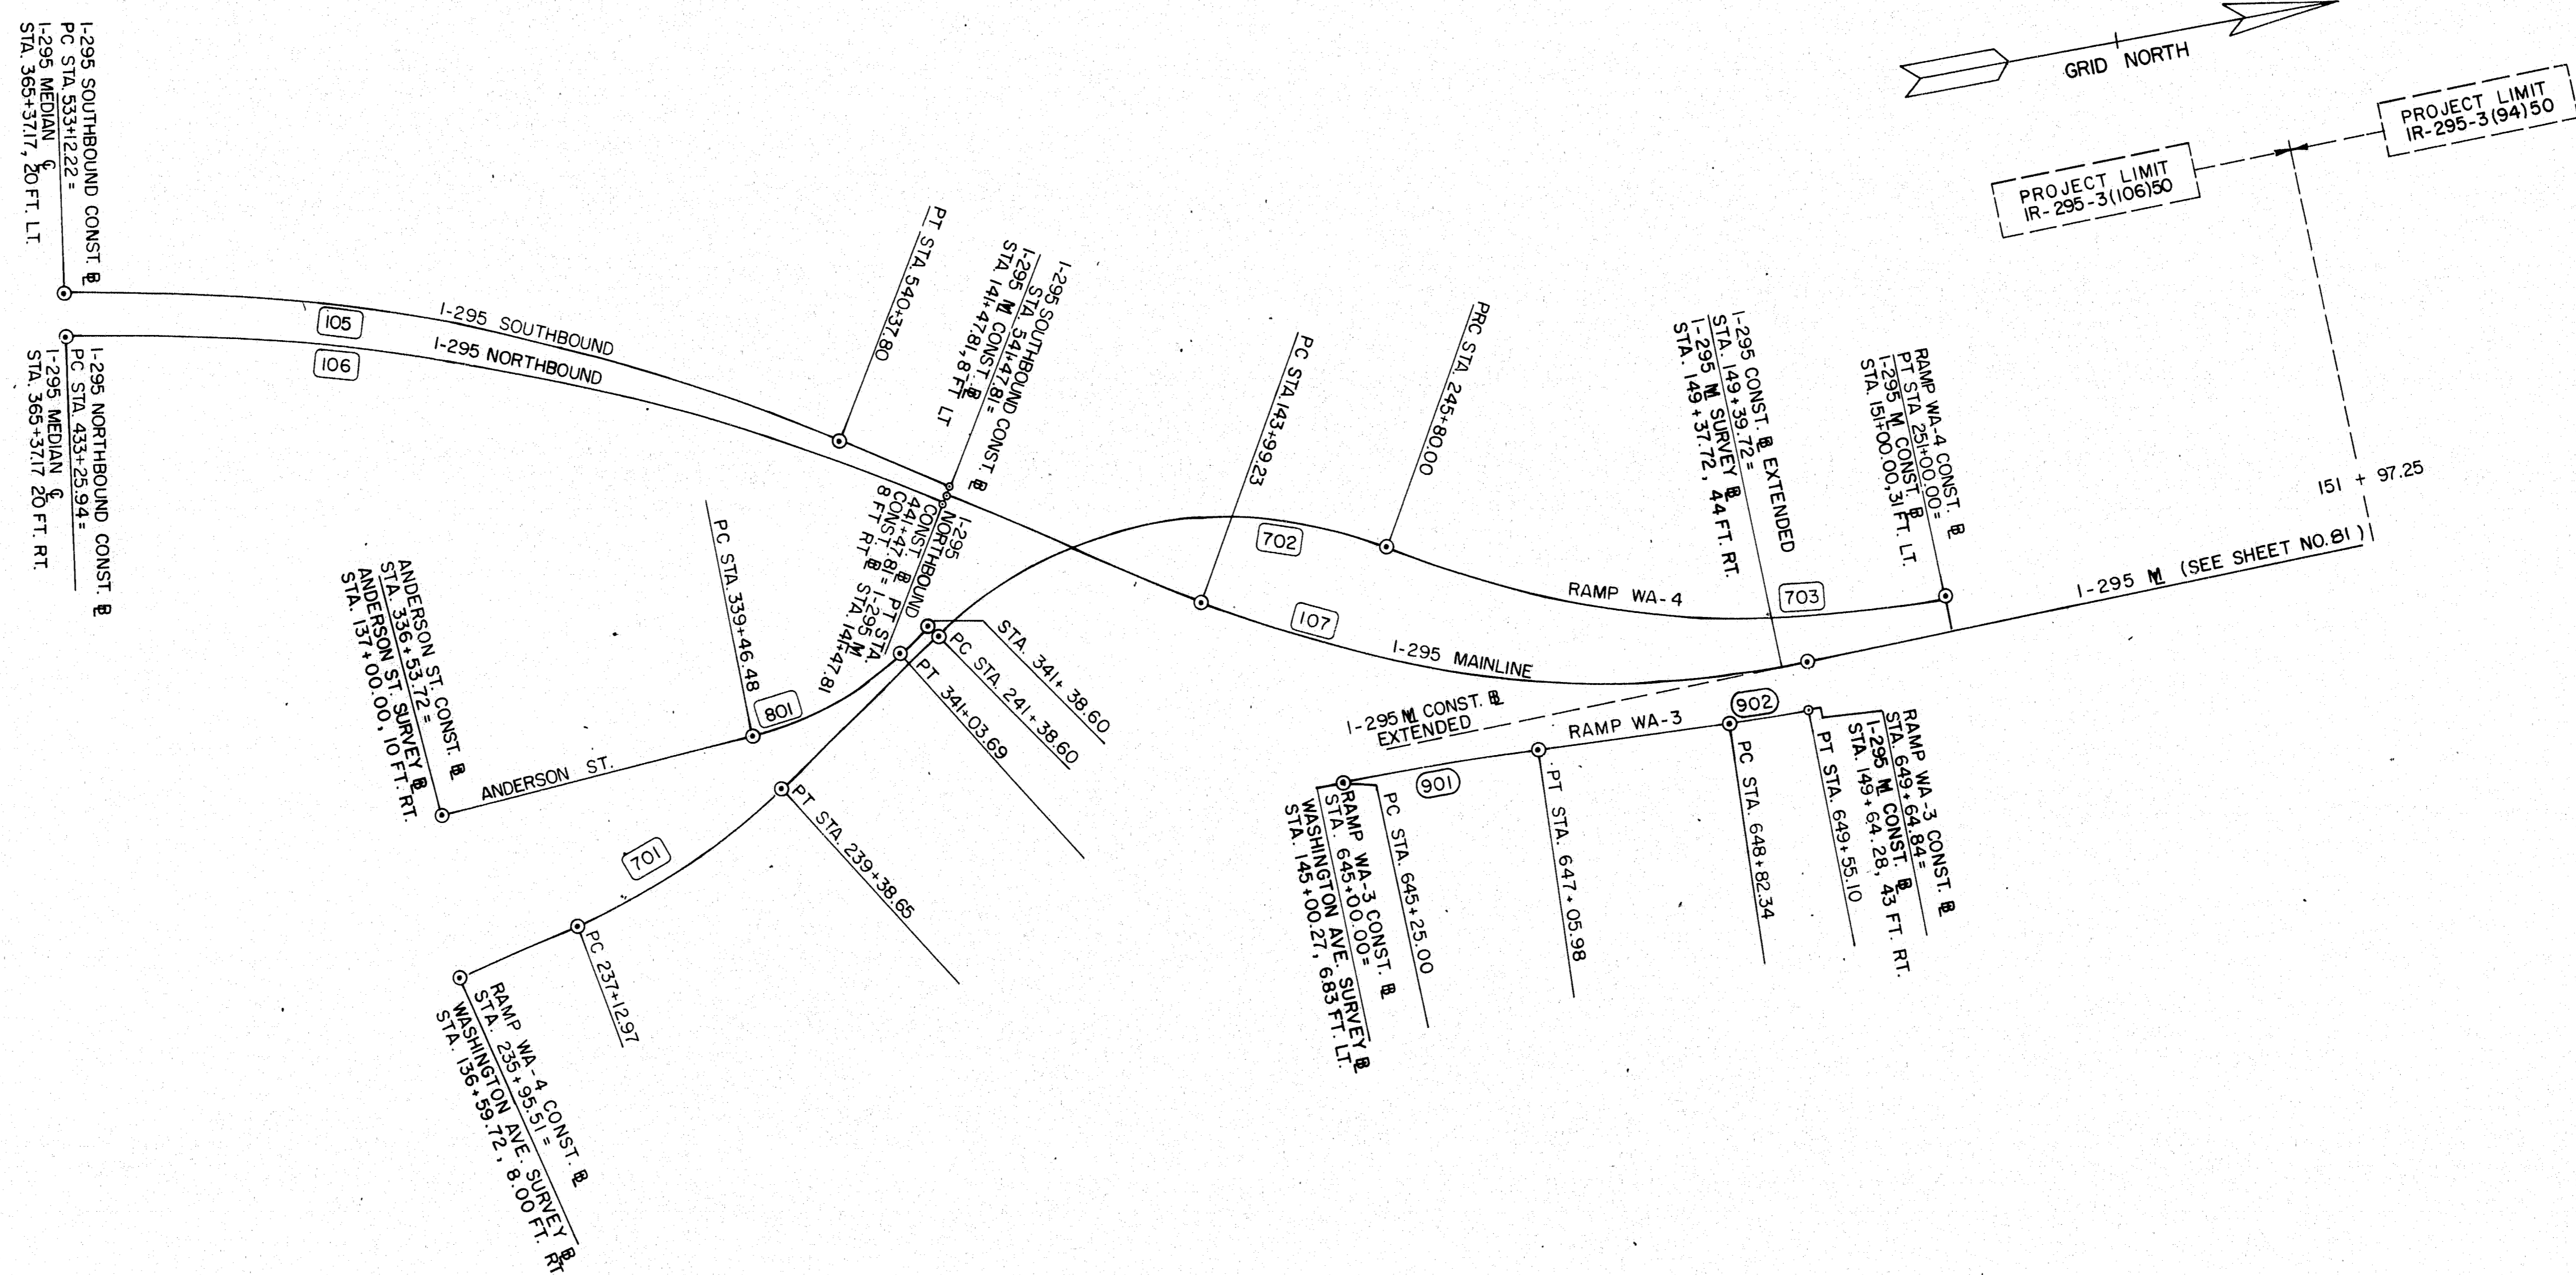

CURVE NO.	Δ	D	T	L	R	E	PC STA.	PI STA.	PT STA.
105	24-36-50	3-23-32	368.48	725.58	1689.00	39.73	533+12.22	536+80.69	540+37.80
106	24-36-50	2-59-42	417.37	821.87	1913.13	44.90	433+25.94	437+43.31	441+47.81
107	35-00-00	6-11-39	291.65	565.05	1925.00	44.89	143+99.23	146+90.88	149+64.28
701	20-41-22	9-10-02	114.08	225.69	625.00	10.33	237+12.97	238+27.05	239+38.65
702	66-33-13	15-04-40	249.39	441.40	380.00	74.53	241+38.60	243+87.99	245+80.00
703	34-05-20	6-33-20	267.95	520.00	874.00	40.15	245+80.00	248+47.95	251+00.00
801	30-01-28	19-05-55	80.45	157.21	300.00	10.60	339+46.48	340+26.93	341+03.69
901	4-30-30	2-29-28	90.54	180.98	2300.00	1.78	645+25.00	646+15.53	647+05.98
902	4-31-36	6-13-14	36.40	72.77	921.07	0.72	648+82.34	649+18.74	649+55.10

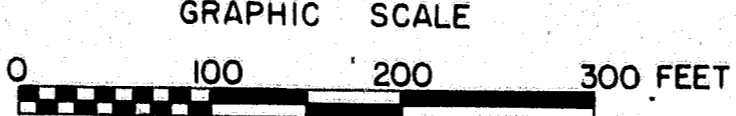

ALL CENTERLINES AS BUILT

J. Mayol
3-20-91


103-321

STATE OF MAINE
DEPARTMENT OF TRANSPORTATION
I-295 PORTLAND
**CONSTRUCTION BASELINE
GEOMETRY**
SOUTH INTERCHANGE
SHEET 80 OF 120 AUGUSTA, MAINE

PROJECT DESIGN ENGINEER	BY	DATE
DESIGN - DETAILED		
CHECKED		
REVISIONS		
FIELD CHANGES		

BRUNING 44 132 4710-1


F.W.A. REG. NO.	STATE	PROJECT NUMBER	SHEET NO.	TOTAL SHEETS
1	MAINE	1-295-3(106)50	81	130

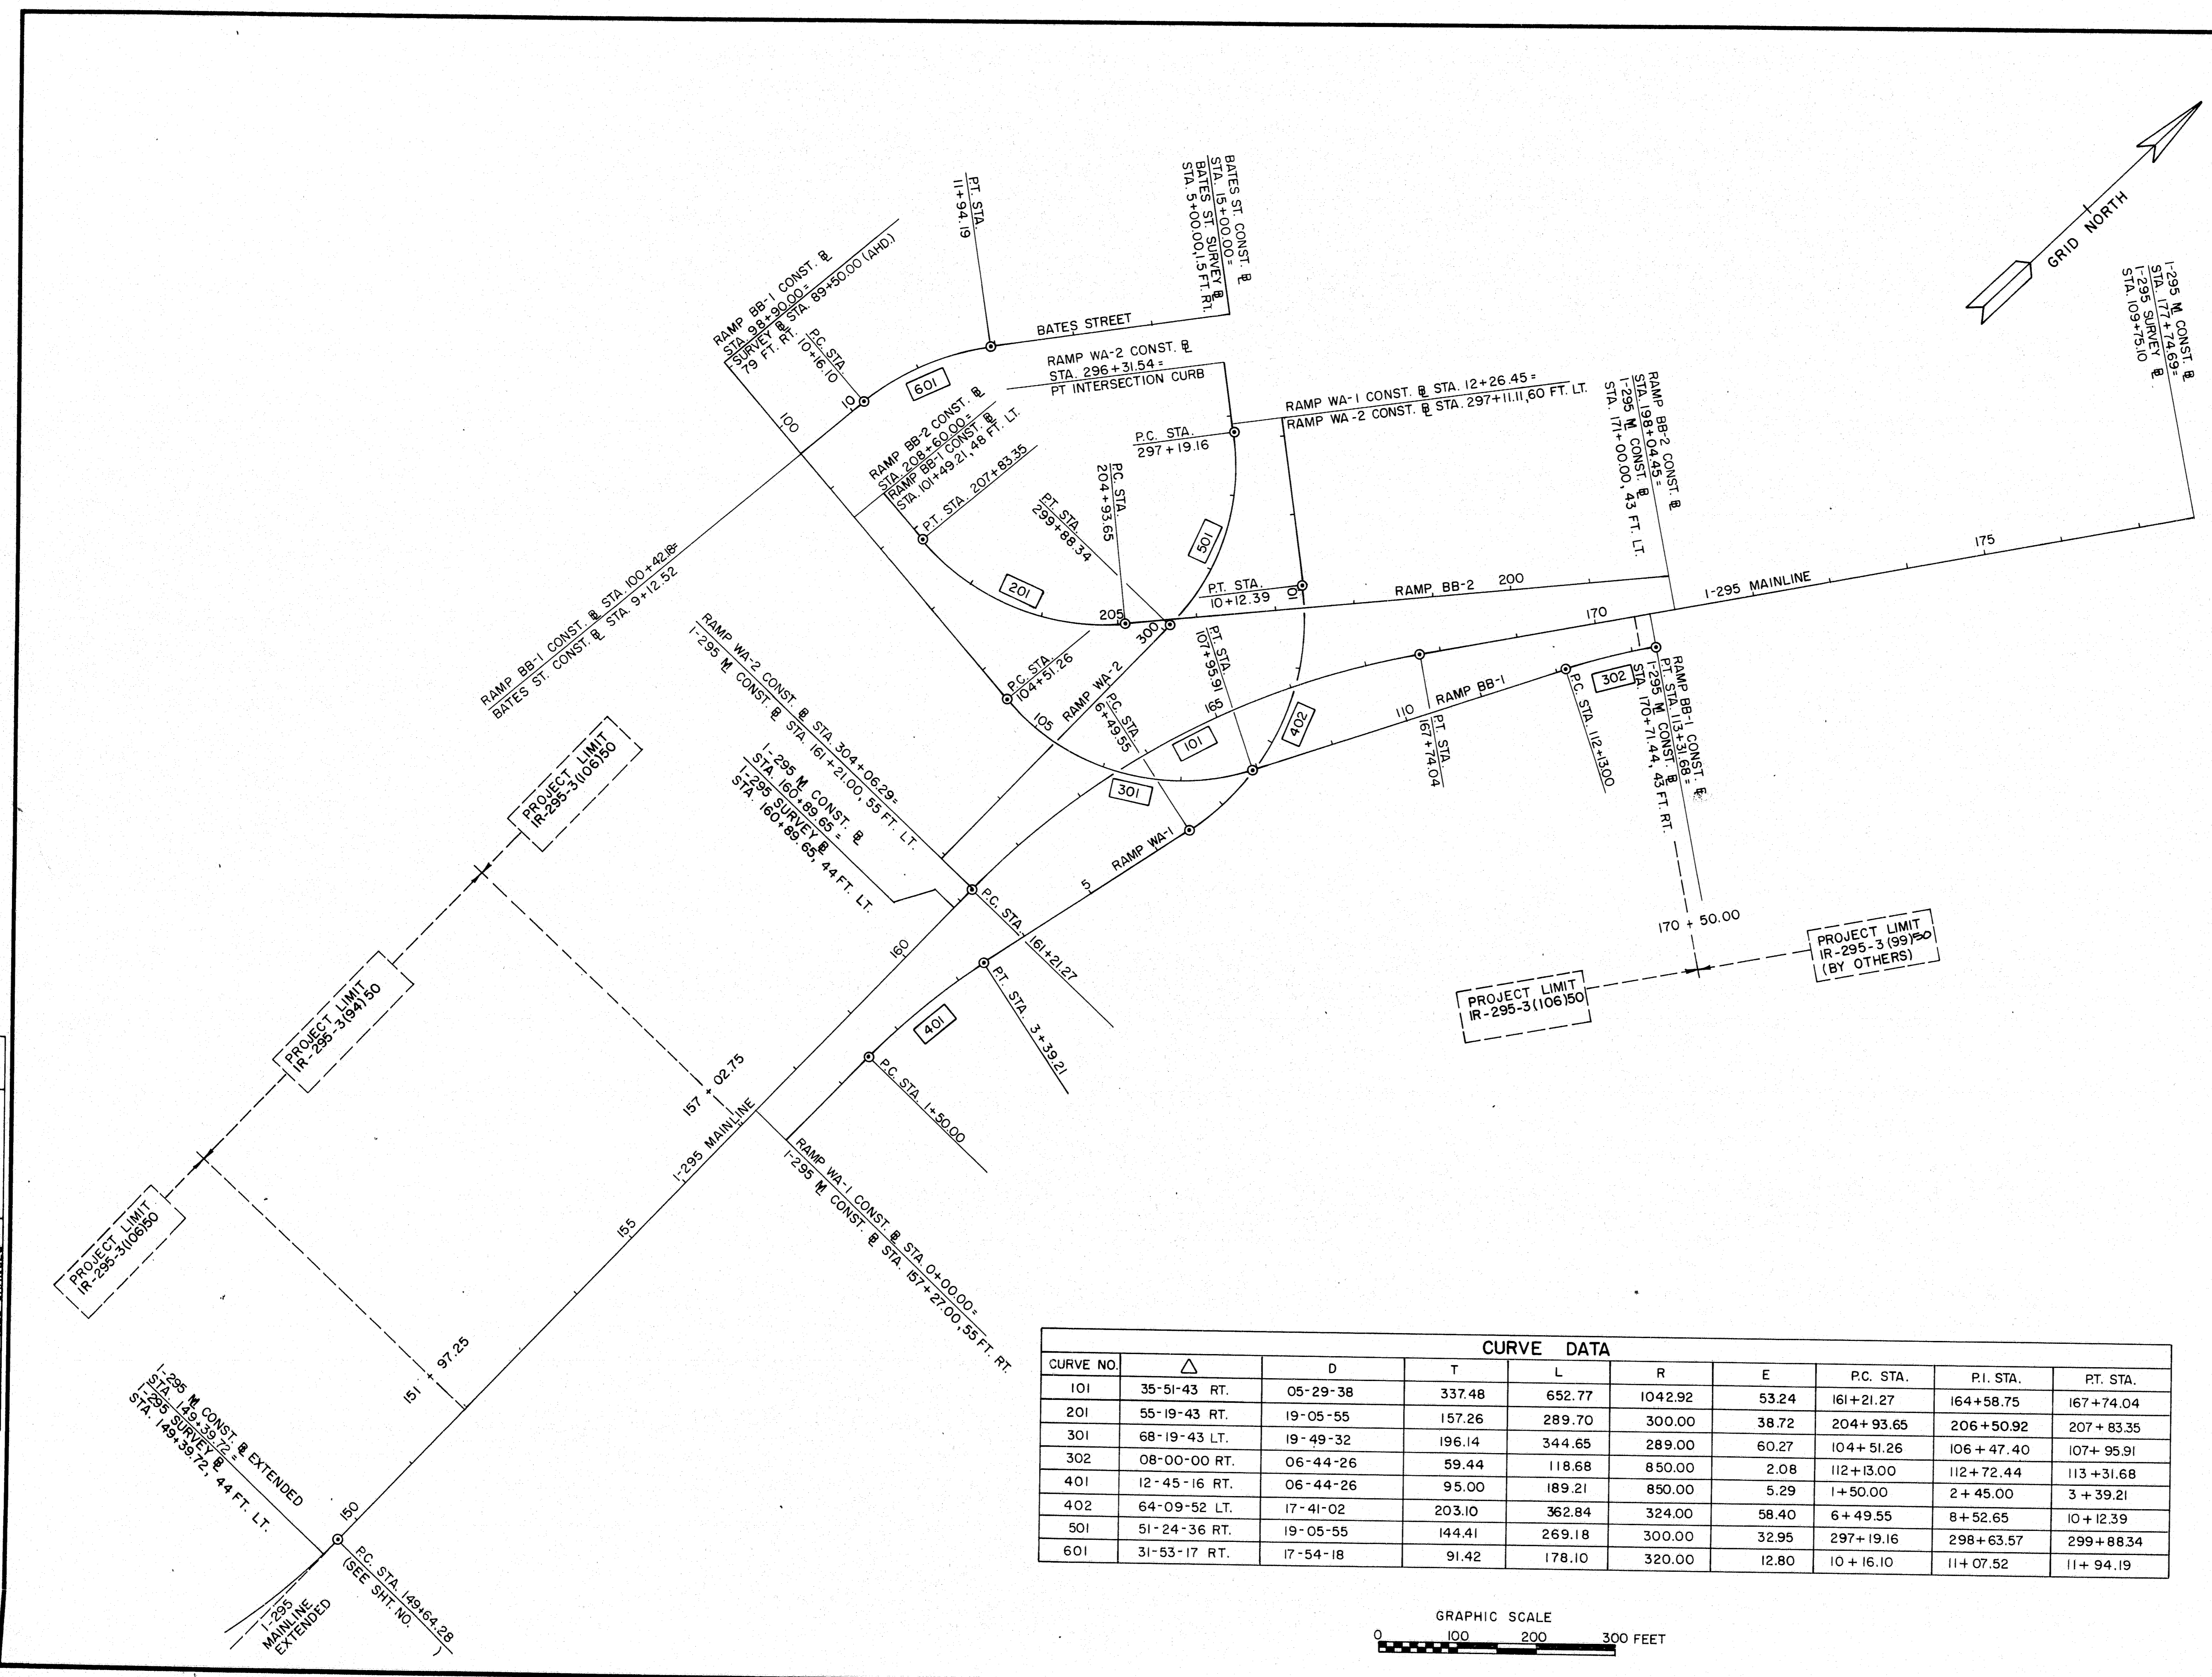

PROJECT DESIGN ENGINEER	DATE
DESIGN - DETAILED	
CHECKED	
REVISIONS	
FIELD CHANGES	

PLANS

CURVE NO.	Δ	CURVE DATA							
		D	T	L	R	E	P.C. STA.	P.I. STA.	P.T. STA.
101	35-51-43 RT.	05-29-38	337.48	652.77	1042.92	53.24	161+21.27	164+58.75	167+74.04
201	55-19-43 RT.	19-05-55	157.26	289.70	300.00	38.72	204+93.65	206+50.92	207+83.35
301	68-19-43 LT.	19-49-32	196.14	344.65	289.00	60.27	104+51.26	106+47.40	107+95.91
302	08-00-00 RT.	06-44-26	59.44	118.68	850.00	2.08	112+13.00	112+72.44	113+31.68
401	12-45-16 RT.	06-44-26	95.00	189.21	850.00	5.29	1+50.00	2+45.00	3+39.21
402	64-09-52 LT.	17-41-02	203.10	362.84	324.00	58.40	6+49.55	8+52.65	10+12.39
501	51-24-36 RT.	19-05-55	144.41	269.18	300.00	32.95	297+19.16	298+63.57	299+88.34
601	31-53-17 RT.	17-54-18	91.42	178.10	320.00	12.80	10+16.10	11+07.52	11+94.19

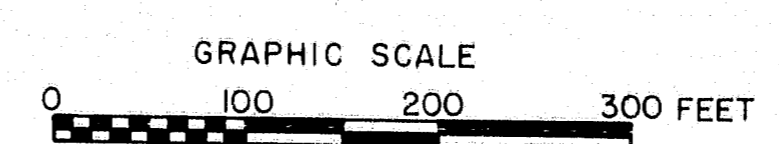

ALL CENTERLINES AS BUILT

John May
3-30-91

103-322

STATE OF MAINE
DEPARTMENT OF TRANSPORTATION

**CONSTRUCTION
BASELINE
GEOMETRY**



SHEET 81 OF 130 AUGUSTA, MAINE

Contract 1 Main 100 State Route

REV. NO.	STATE	PROJECT NUMBER	SHEET NO.	TOTAL SHEETS
1	MAINE	12-295-3(100)90	82	130

GUARD RAIL - REMOVE AND RESET

REMOVE FROM
 STA. 436+43 (I-295 N.B.) 22' LT. TO STA. 438+14 (I-295 N.B.) 18' LT. 175 L.F.
 RESET TO
 STA. 436+39 (I-295 N.B.) 22' LT. TO STA. 438+14 (I-295 N.B.) 14' LT. 175 L.F.

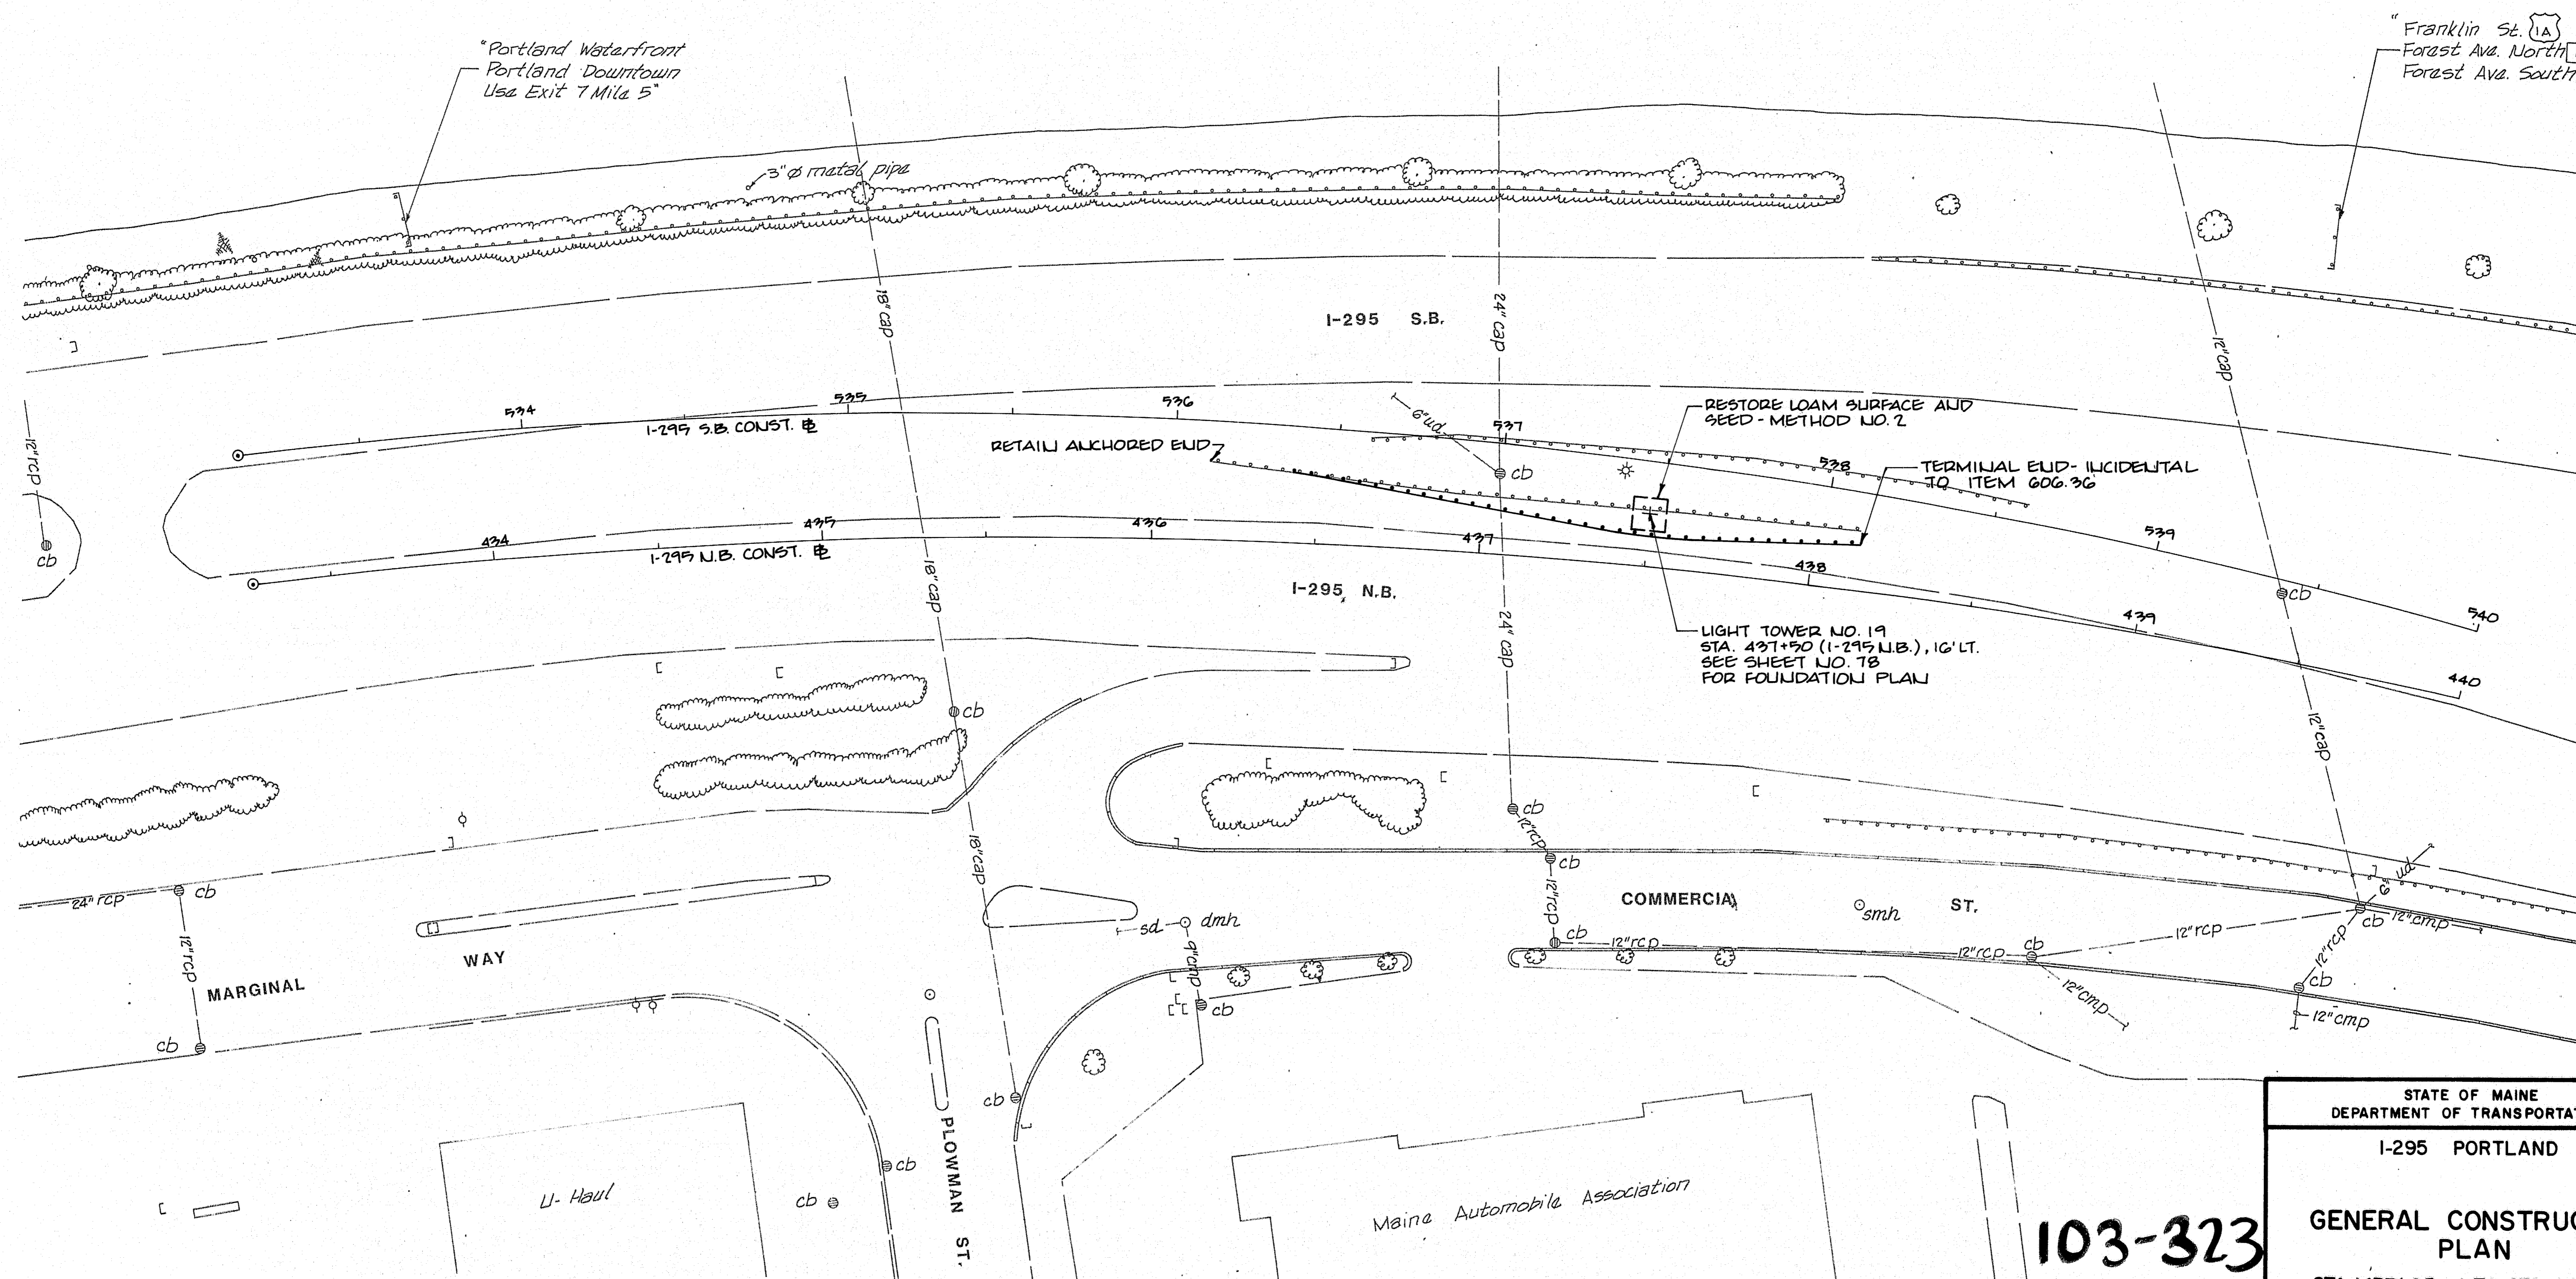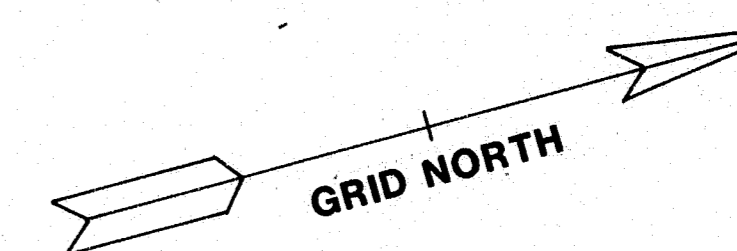

PROJECT DESIGN ENGINEER	BY	DATE
DESIGN - DETAILED		
CHECKED		
REVISIONS		
FIELD CHANGES		

103-323

STATE OF MAINE
 DEPARTMENT OF TRANSPORTATION

I-295 PORTLAND


GENERAL CONSTRUCTION PLAN

STA. 433+25.94 TO STA. 440+00
 (I-295 N.B.)

SHEET 82 OF 130 AUGUSTA, MAINE

BRUNING 44-132-8270-1

F.R.A. DIST. NO.	STATE	PROJECT NUMBER	SHEET NO.	TOTAL SHEETS
1	MAINE	R-295-3(106)150	83	190

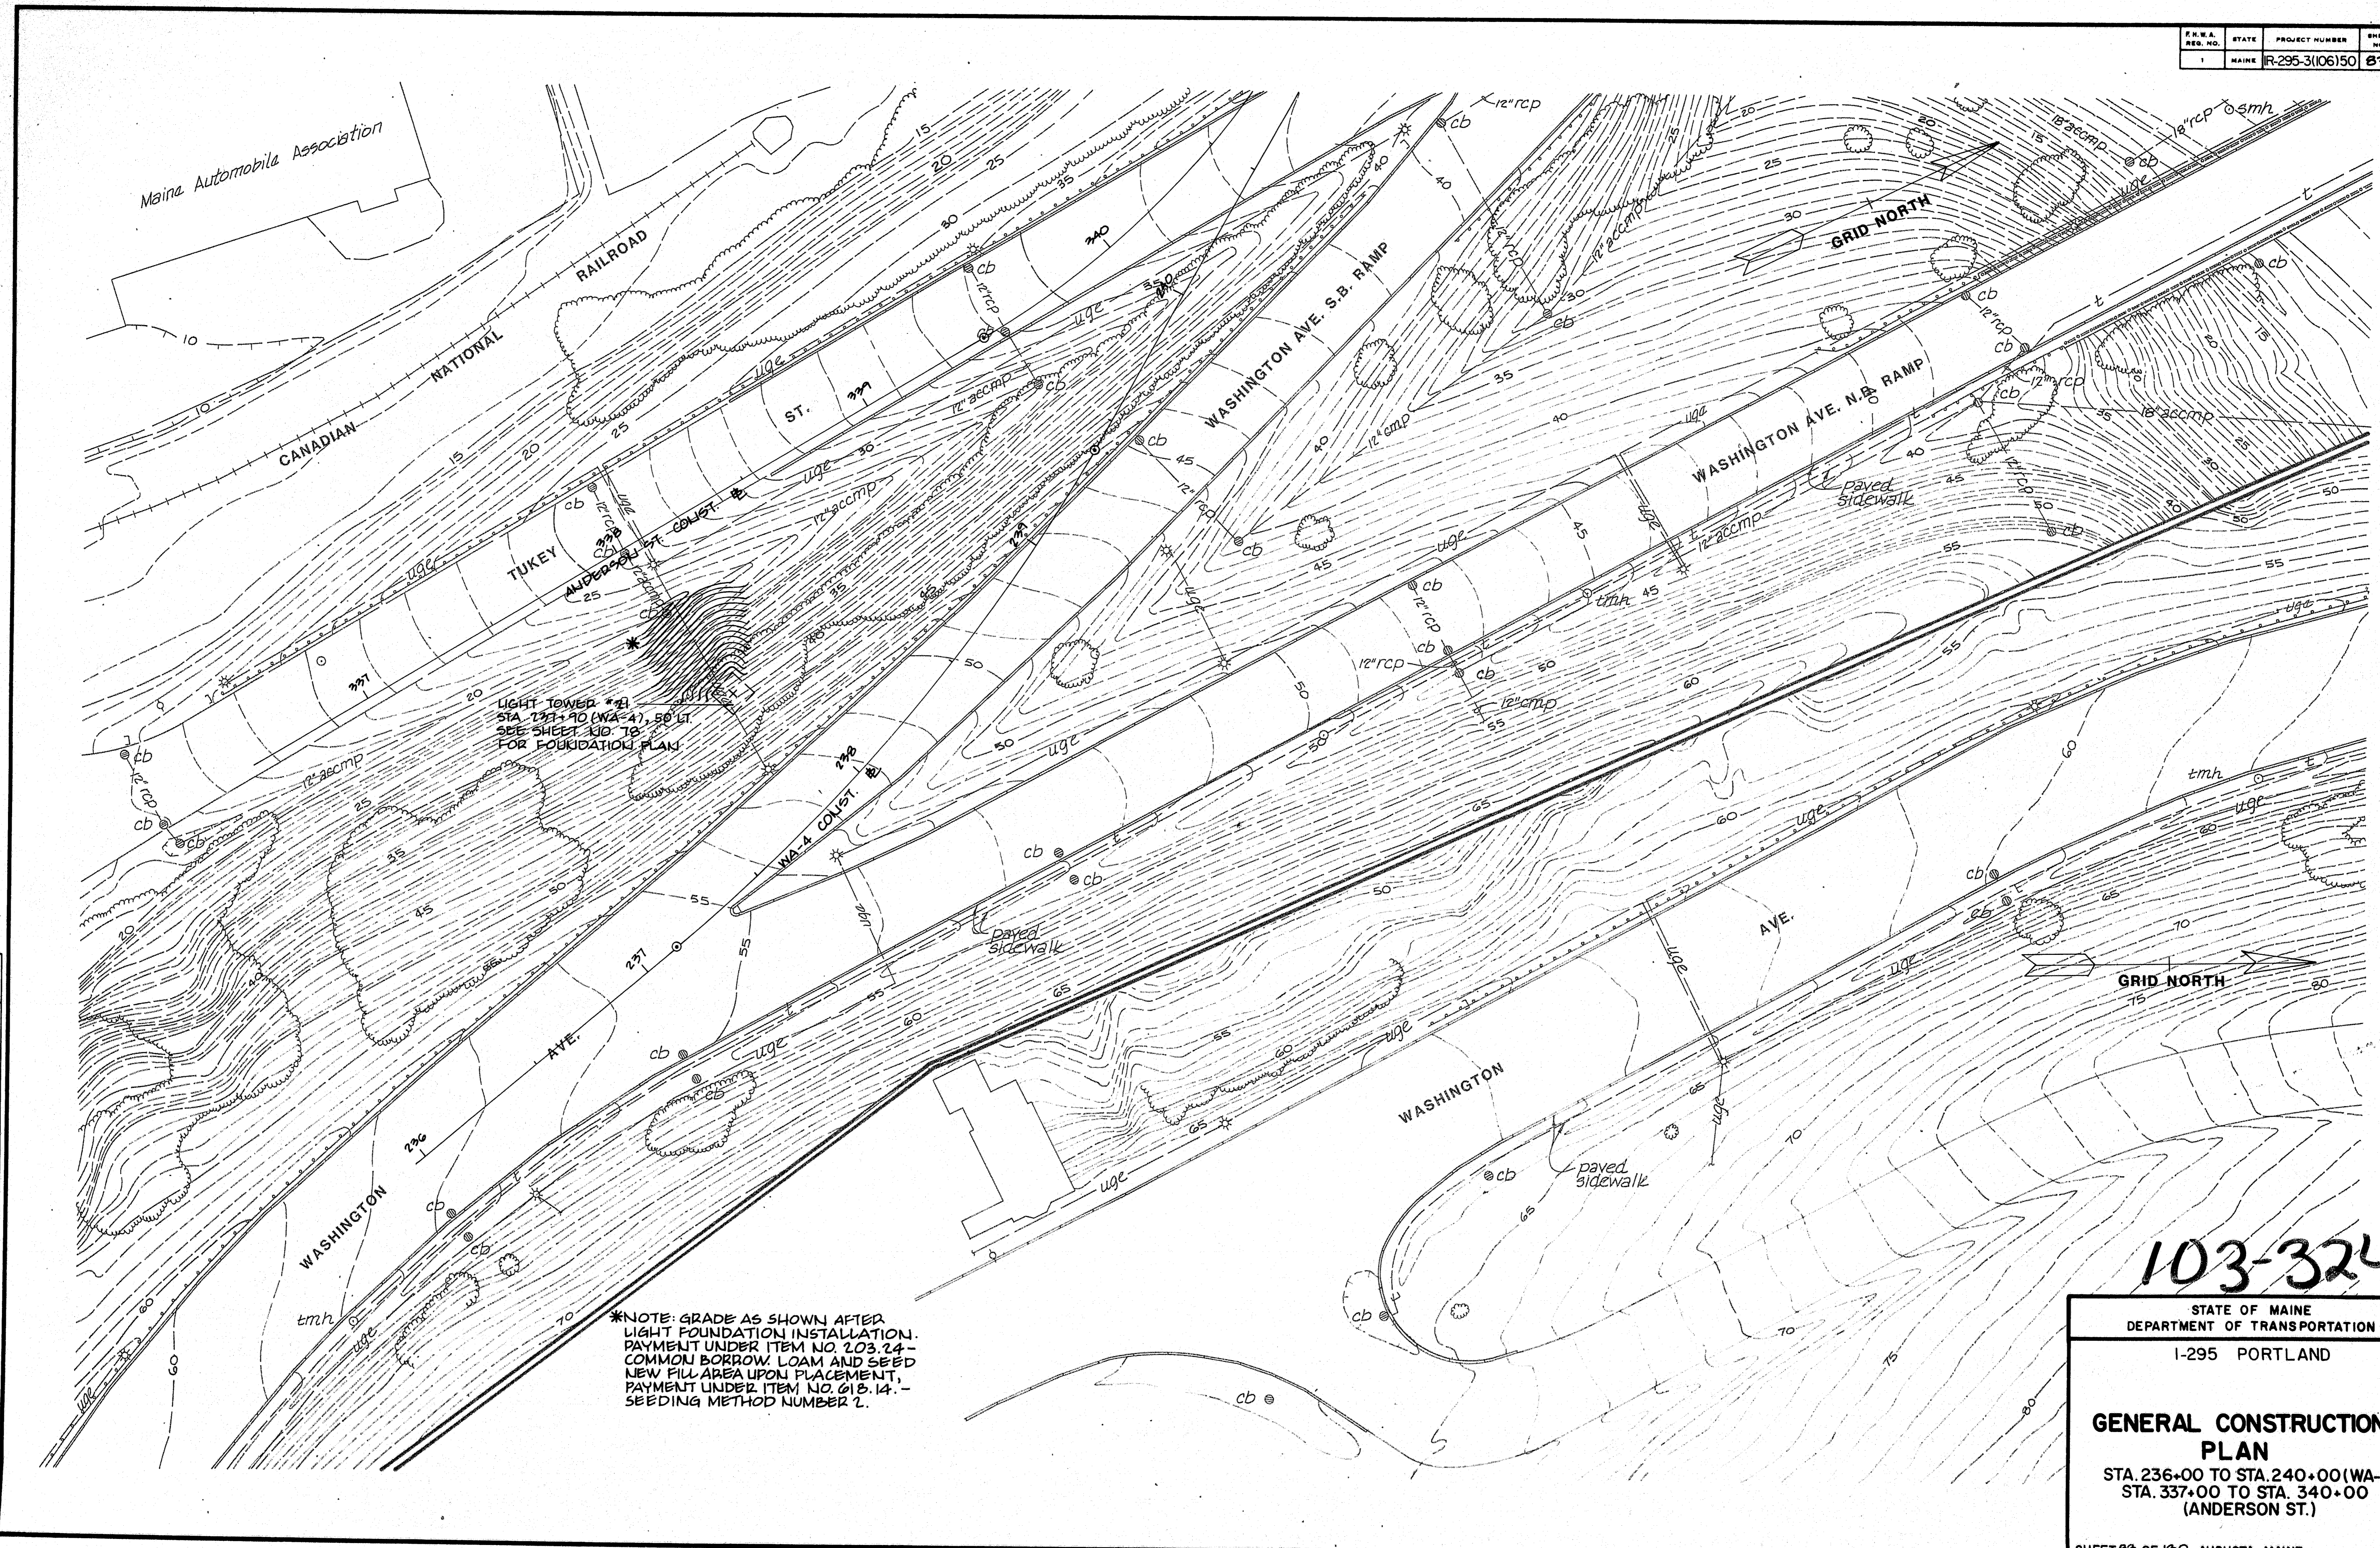

LIGHT TOWER #41
 STA. 237+40 (WA-4), 50 FT.
 SEE SHEET NO. 78
 FOR FOUNDATION PLAN

*NOTE: GRADE AS SHOWN AFTER
 LIGHT FOUNDATION INSTALLATION.
 PAYMENT UNDER ITEM NO. 203.24 -
 COMMON BORROW, LOAM AND SEED
 NEW FILL AREA UPON PLACEMENT,
 PAYMENT UNDER ITEM NO. 615.14 -
 SEEDING METHOD NUMBER 2.

103-324

STATE OF MAINE
 DEPARTMENT OF TRANSPORTATION
 I-295 PORTLAND

GENERAL CONSTRUCTION PLAN
 STA. 236+00 TO STA. 240+00 (WA-4)
 STA. 337+00 TO STA. 340+00
 (ANDERSON ST.)

SHEET 83 OF 190 AUGUSTA, MAINE

PROJECT DESIGN ENGINEER	BY	DATE
DESIGN - DETAILED		
CHECKED		
REVISIONS		
FIELD CHANGES		

PLANS

BRUNING 44-132-45710-1

GUARD RAIL - REMOVED AND RESET
GUARD RAIL - REMOVED AND STACKED

STA.	REMOVE FROM	OFFSET TO	STA.	OFFSET	L.F.
G45+42 (WA-3)	20' RT.	151+82 (1-295)	40' RT.	697'	
G46+20 (WA-3)	20' RT.	151+82 (1-295)	40' RT.	760'	
					1197'
G45+42 (WA-3)	RESET TO	151+82 (1-295)	63' RT.	699' (TEMP.)	


CURB REMOVED AND STACKED.
RESET CURB TYPE 1

STA.	REMOVE FROM	OFFSET TO	STA.	OFFSET	L.F.
G45+42 (WA-3)	21' RT.	151+82 (1-295)	40' RT.	699'	

REMOVING SINGLE TREE TOP ONLY
REMOVING STUMP

STA.	OFFSET	TREE	STUMP
145+83 (1-295)	29' LT.	12"	12"
145+95 (1-295)	19' LT.	12"	12"
G46+70 (WA-3)	30' RT.	12"	12"

F.R.W.A. NO.	STATE	PROJECT NUMBER	SHEET NO.	TOTAL SHEETS
1	MAINE	12-295-3(02)70	84	130

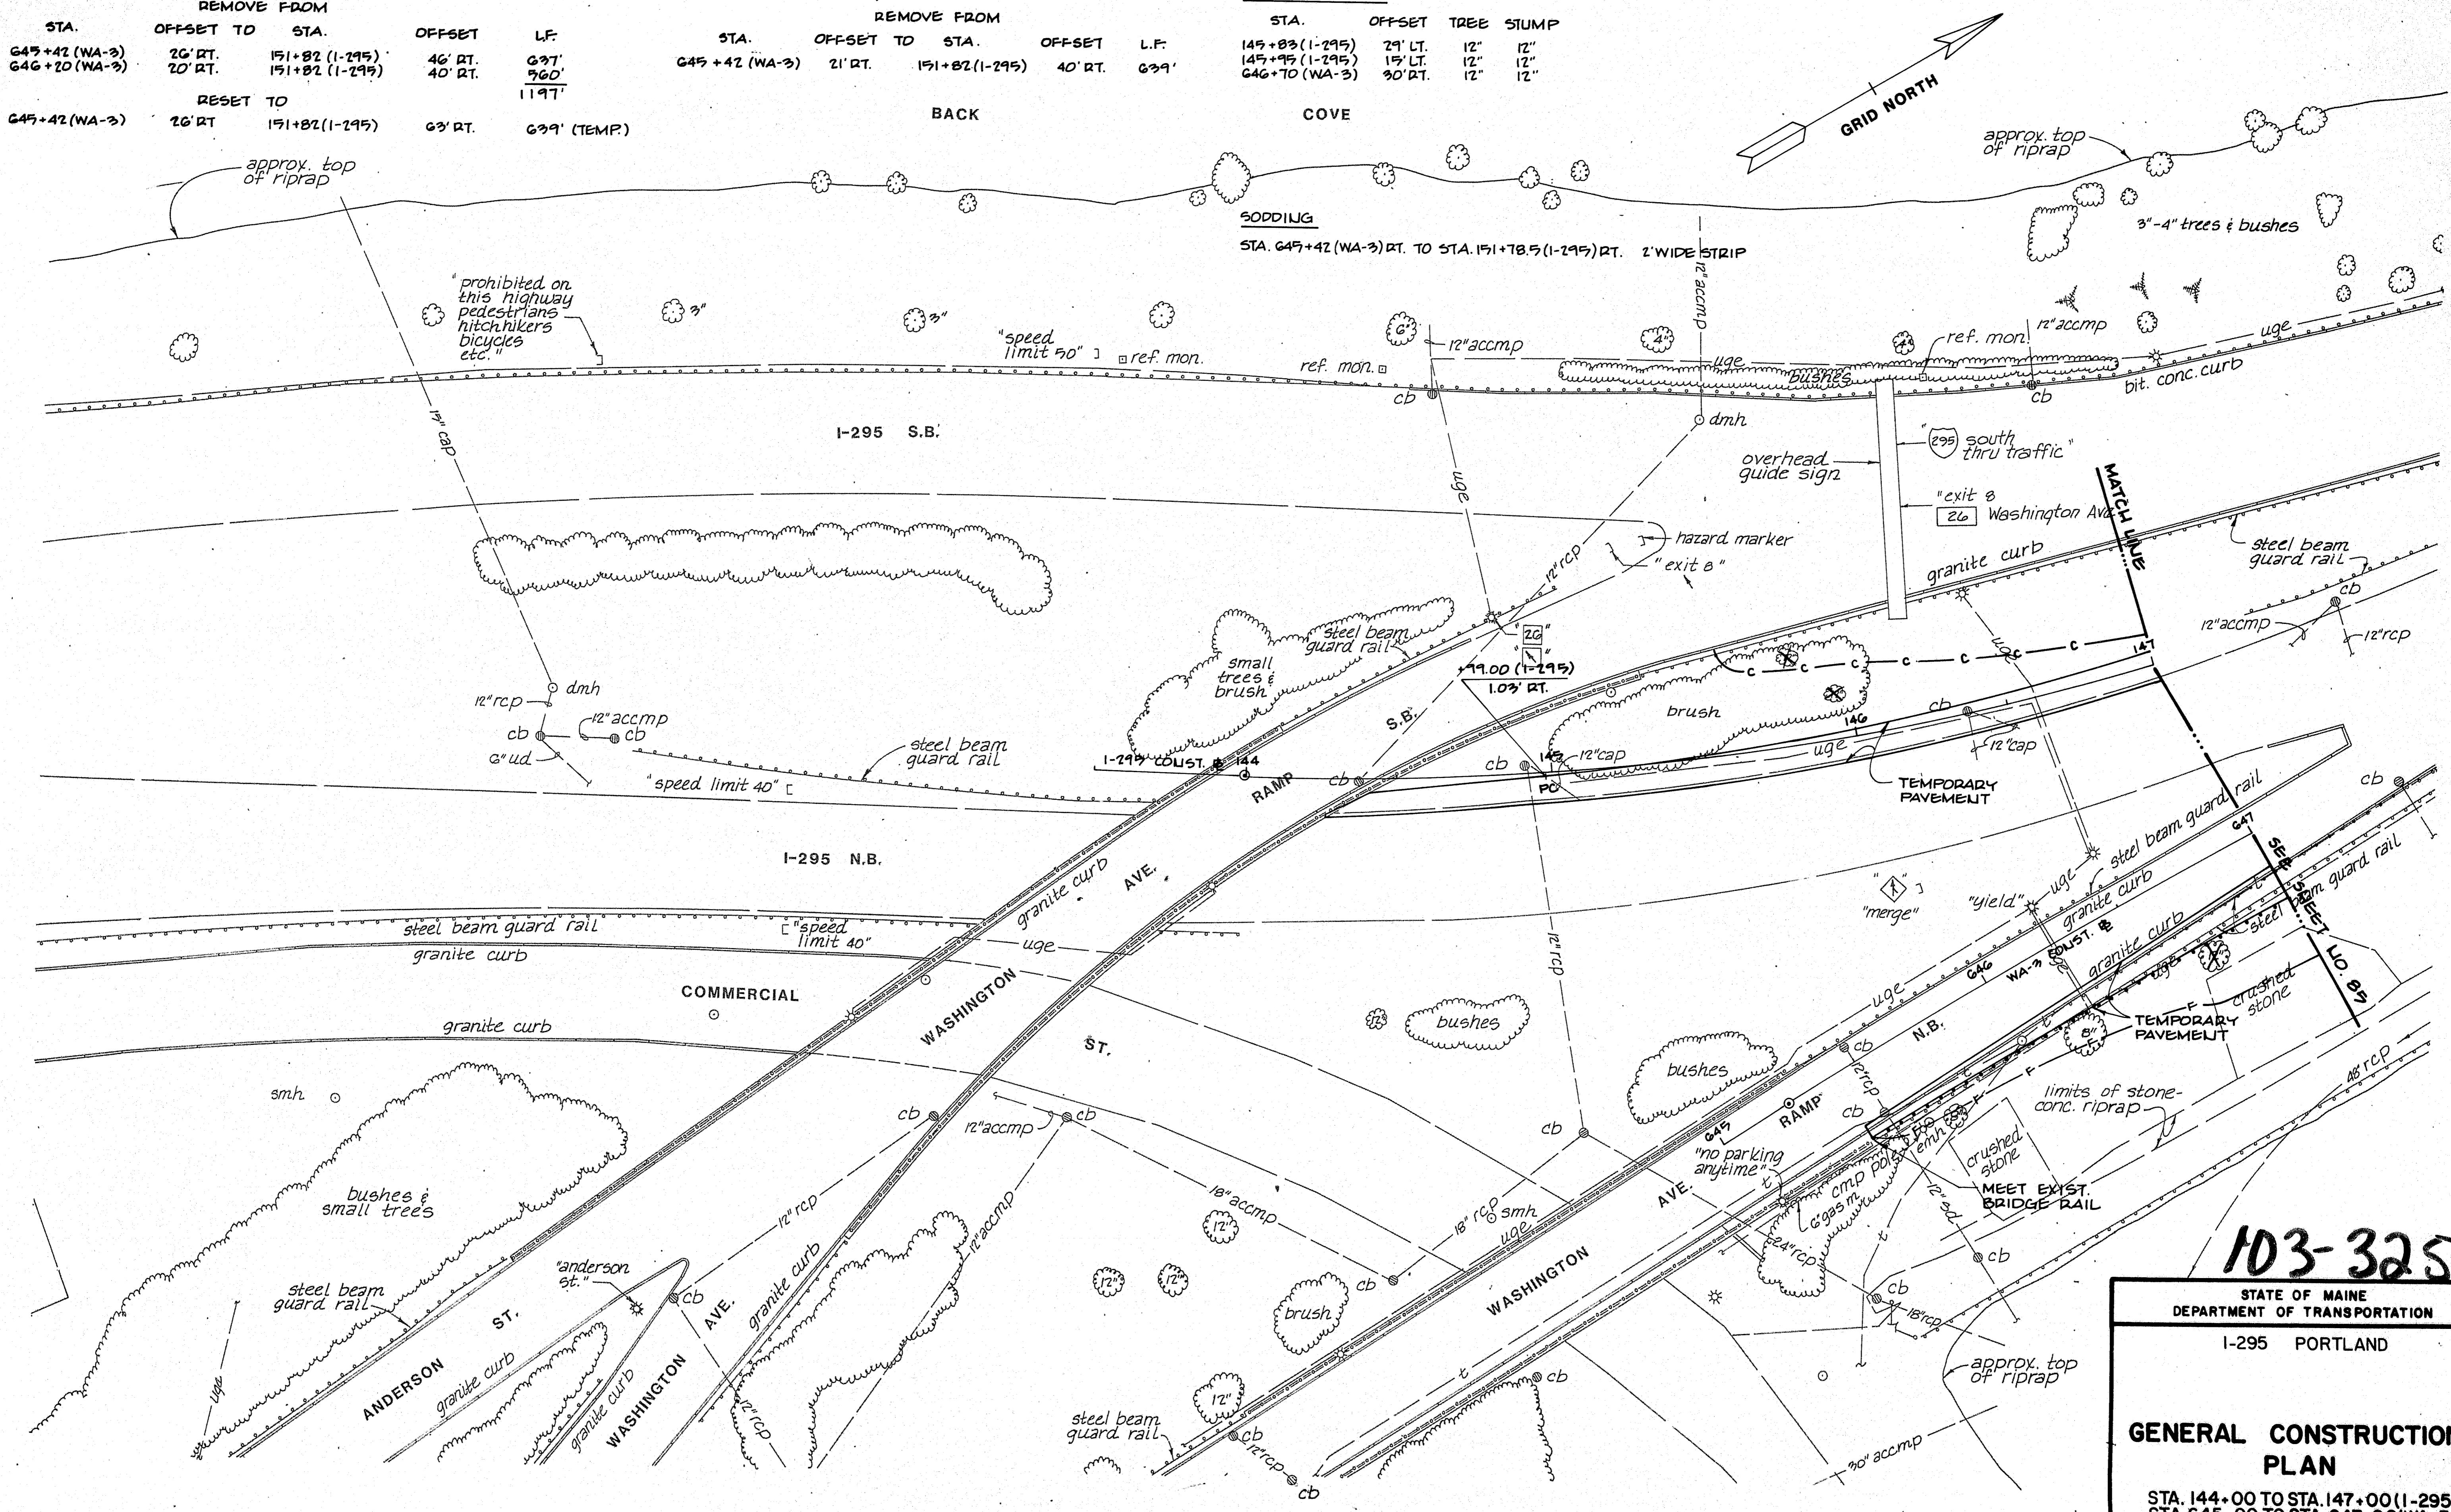

PROJECT DESIGN ENGINEER	DATE
PLANS	
DESIGN - DETAILED	
CHECKED	
REVISIONS	
FIELD CHANGES	

103-325

STATE OF MAINE
 DEPARTMENT OF TRANSPORTATION

I-295 PORTLAND


GENERAL CONSTRUCTION PLAN

STA. 144+00 TO STA. 147+00 (1-295)
 STA. 645+00 TO STA. 647+00 (WA-3)

SHEET 84 OF 130 AUGUSTA, MAINE

F.R.A. NO.	STATE	PROJECT NUMBER	SHEET NO.	TOTAL SHEETS
1	MAINE	12-295-3(106)90	89	130

SODDING
 STA. 247+50 (WA-4) LT. TO STA. 191+78.5 (1-295) LT. 2' WIDE STRIP

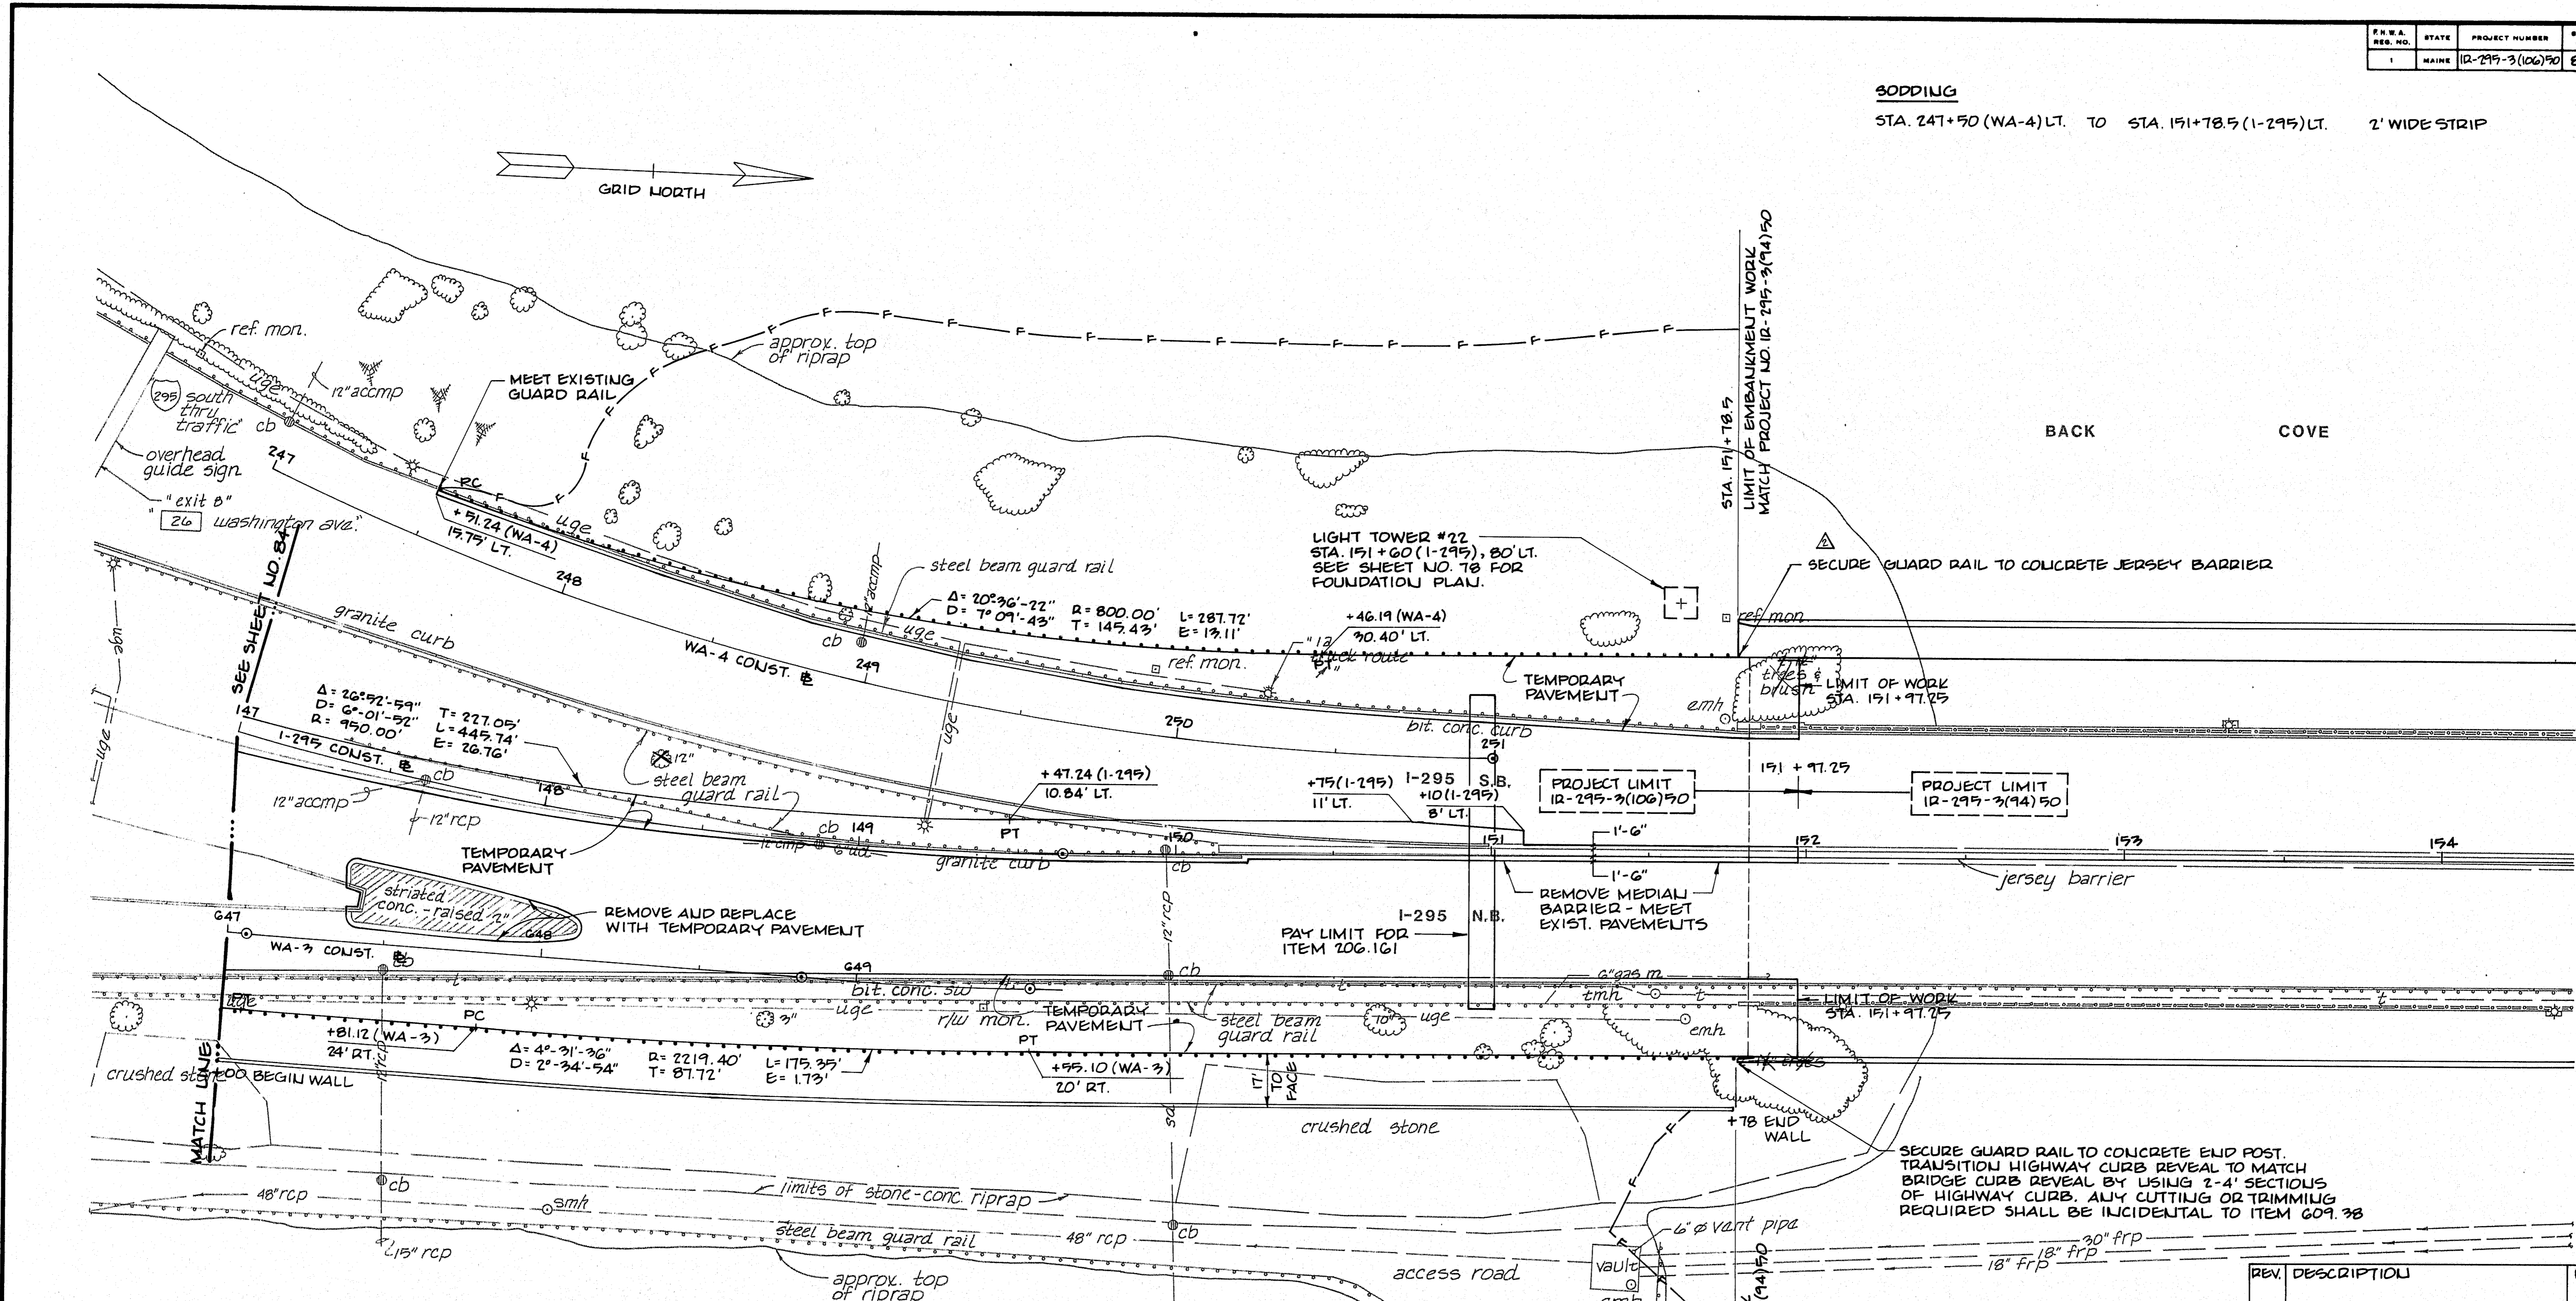

**CURB REMOVED AND STACKED
 RESET CURB TYPE 1**

STA.	REMOVE FROM OFFSET TO	STA.	OFFSET	LF
247+51 (WA-4)	16' LT.	191+82 (1-295)	39' LT.	424'
149+50 (1-295)	16' LT.	151+00 (1-295)	2' LT.	153'
647+36 (WA-3)	18' LT.	647+36 (WA-3)	10' LT.	19'
				596'

**GUARD RAIL - REMOVED AND RESET
 GUARD RAIL - REMOVED AND STACKED**

STA.	REMOVE FROM OFFSET TO	STA.	OFFSET	LF
247+50 (WA-4)	11' LT.	191+82 (1-295)	40' LT.	425'
147+39 (1-295)	7' LT.	190+14 (1-295)	0' LT.	280'
149+50 (1-295)	12' LT.	150+14 (1-295)	4' LT.	95'
				770'

RESET TO

STA.	OFFSET TO	STA.	OFFSET	LF
247+50 (WA-4)	11' LT.	191+82 (1-295)	63' LT.	424' (TEMP)

HEAVY RIPRAP

STA.	TO	STA.
248+25 (WA-4) LT.	191+78.5 (1-295) LT.	(BELOW EL. 8.0)
191+39 (1-295) RT.	191+78.5 (1-295) RT.	(BELOW EL. 8.0)

**REMOVING SINGLE TREE TOP ONLY
 REMOVING STUMP**

STA.	OFFSET	TREE	STUMP
148+34 (1-295)	20' LT.	12"	12"
191+77 (1-295)	60' RT.	2-12"	2-12"
191+73 (1-295)	53' LT.	2-12"	2-12"

PROJECT DESIGN ENGINEER	DATE
DESIGN - DETAILED	
CHECKED	
FIELD CHANGES	
PLANS	

REV.	DESCRIPTION	BY	DATE
ADDENDUM 1			
NOTE			
STATE OF MAINE DEPARTMENT OF TRANSPORTATION			
1-295 PORTLAND			
GENERAL CONSTRUCTION PLAN			
STA. 147+00 TO STA. 151+97.25 (1-295) STA. 647+00 TO STA. 649+64.84 (WA-3)			
SHEET 89 OF 130 AUGUSTA, MAINE			

103-326

BRUNING 44132 45710.1


GUARD RAIL TYPE 3B

STA.	TO STA.	OFFSET	L.F.
157+17 (1-295)	158+77 (1-295)	6 3/4 RT.	162.5'
1+50 (WA-1)	2+50 (WA-1)	8' RT.	100'
			262.5'

CURB TYPE 3

STA.	OFFSET TO STA.	OFFSET	L.F.
2+50 (WA-1)	8' RT.	3+50 (WA-1)	8' RT.
			100' (TEMP.)

FR. NO.	STATE	PROJECT NUMBER	SHEET NO.	TOTAL SHEETS
1	MAINE	R-295-3(106)50	86	130

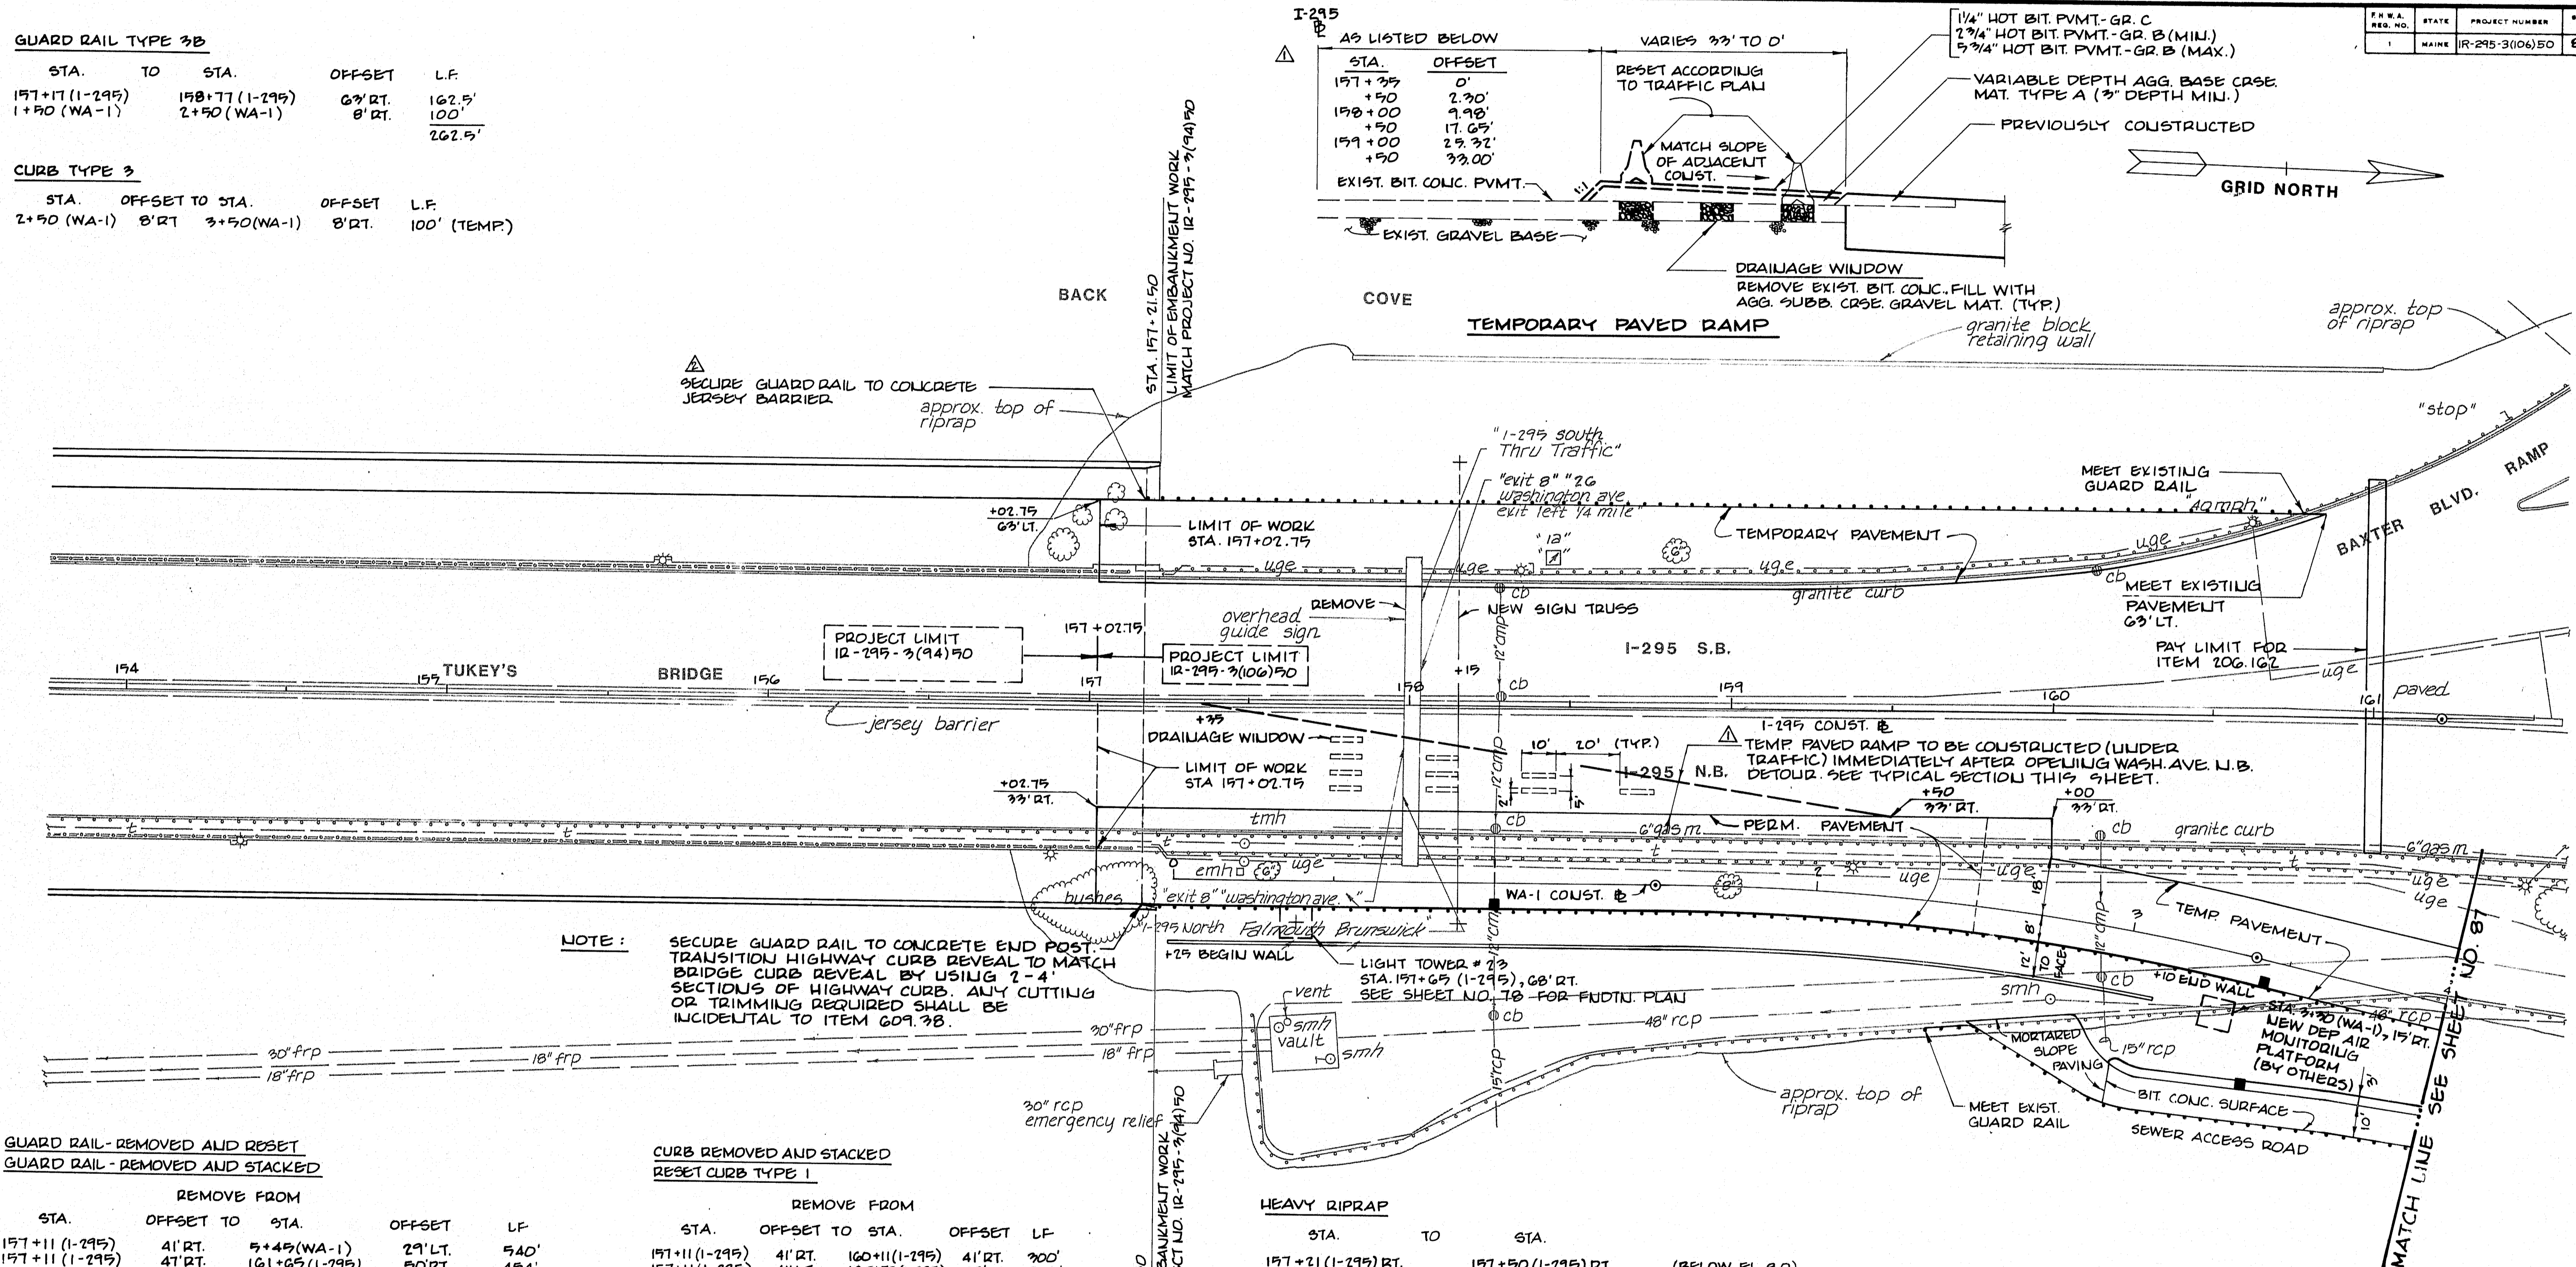

NOTE: SECURE GUARD RAIL TO CONCRETE END POST. TRANSITION HIGHWAY CURBS REVEAL TO MATCH BRIDGE CURBS REVEAL BY USING 1-4 SECTIONS OF HIGHWAY CURB. ANY CUTTING OR TRIMMING REQUIRED SHALL BE INCIDENTAL TO ITEM 609.38.

GUARD RAIL - REMOVED AND RESET

STA.	OFFSET TO STA.	OFFSET	L.F.
157+11 (1-295)	41' RT.	5+45 (WA-1)	29' LT.
157+11 (1-295)	41' RT.	161+65 (1-295)	50' RT.
157+11 (1-295)	41' LT.	160+80 (1-295)	64' LT.
2+40 (WA-1)	40' RT.	4+85 (WA-1)	8' LT.
			242'
			160'

RESET TO

STA.	OFFSET TO STA.	OFFSET	L.F.
2+50 (WA-1)	8' RT.	171+07 (1-295)	68' RT.
157+17 (1-295)	6 3/4 RT.	161+00 (1-295)	6 3/4 RT.
2+40 (WA-1)	40' RT.	5+86 (WA-1)	37' RT.
			341' (PERM.)
			1781'

CURB REMOVED AND STACKED

STA.	OFFSET TO STA.	OFFSET	L.F.
157+11 (1-295)	41' RT.	160+11 (1-295)	41' RT.
157+11 (1-295)	41' LT.	160+79 (1-295)	69' LT.
			372'
			672'

RESET TO

STA.	OFFSET TO STA.	OFFSET	L.F.
157+21 (1-295)	6 3/4 RT.	2+50 (WA-1)	8' RT.
			254.7'
			256'

REVIS.	DESCRIPTION	BY	DATE
1	ADD ENDUM I	BWA	6-12-85
2	NOTE	BWA	6-12-85
3	GUARD RAIL LOCATION	BWA	6-12-85
4	TEMP PAVED RAMP	BWA	6-6-85

STATE OF MAINE
 DEPARTMENT OF TRANSPORTATION

I-295 PORTLAND

GENERAL CONSTRUCTION PLAN

STA. 157+02.75 TO STA. 161+00 (I-295)
 STA. 0+00 TO STA. 4+00 (RAMP WA-1)


SHEET 86 OF 130 AUGUSTA, MAINE

103-327

PROJECT DESIGN ENGINEER	DATE
BY	
DESIGN - DETAILED	
CHECKED	
REVISIONS	
FIELD CHANGES	

BRUNING 44-132-6710-1

F.R.N.A. NO.	STATE	PROJECT NUMBER	SHEET NO.	TOTAL SHEETS
1	MAINE	R-295-3106)50	81	130

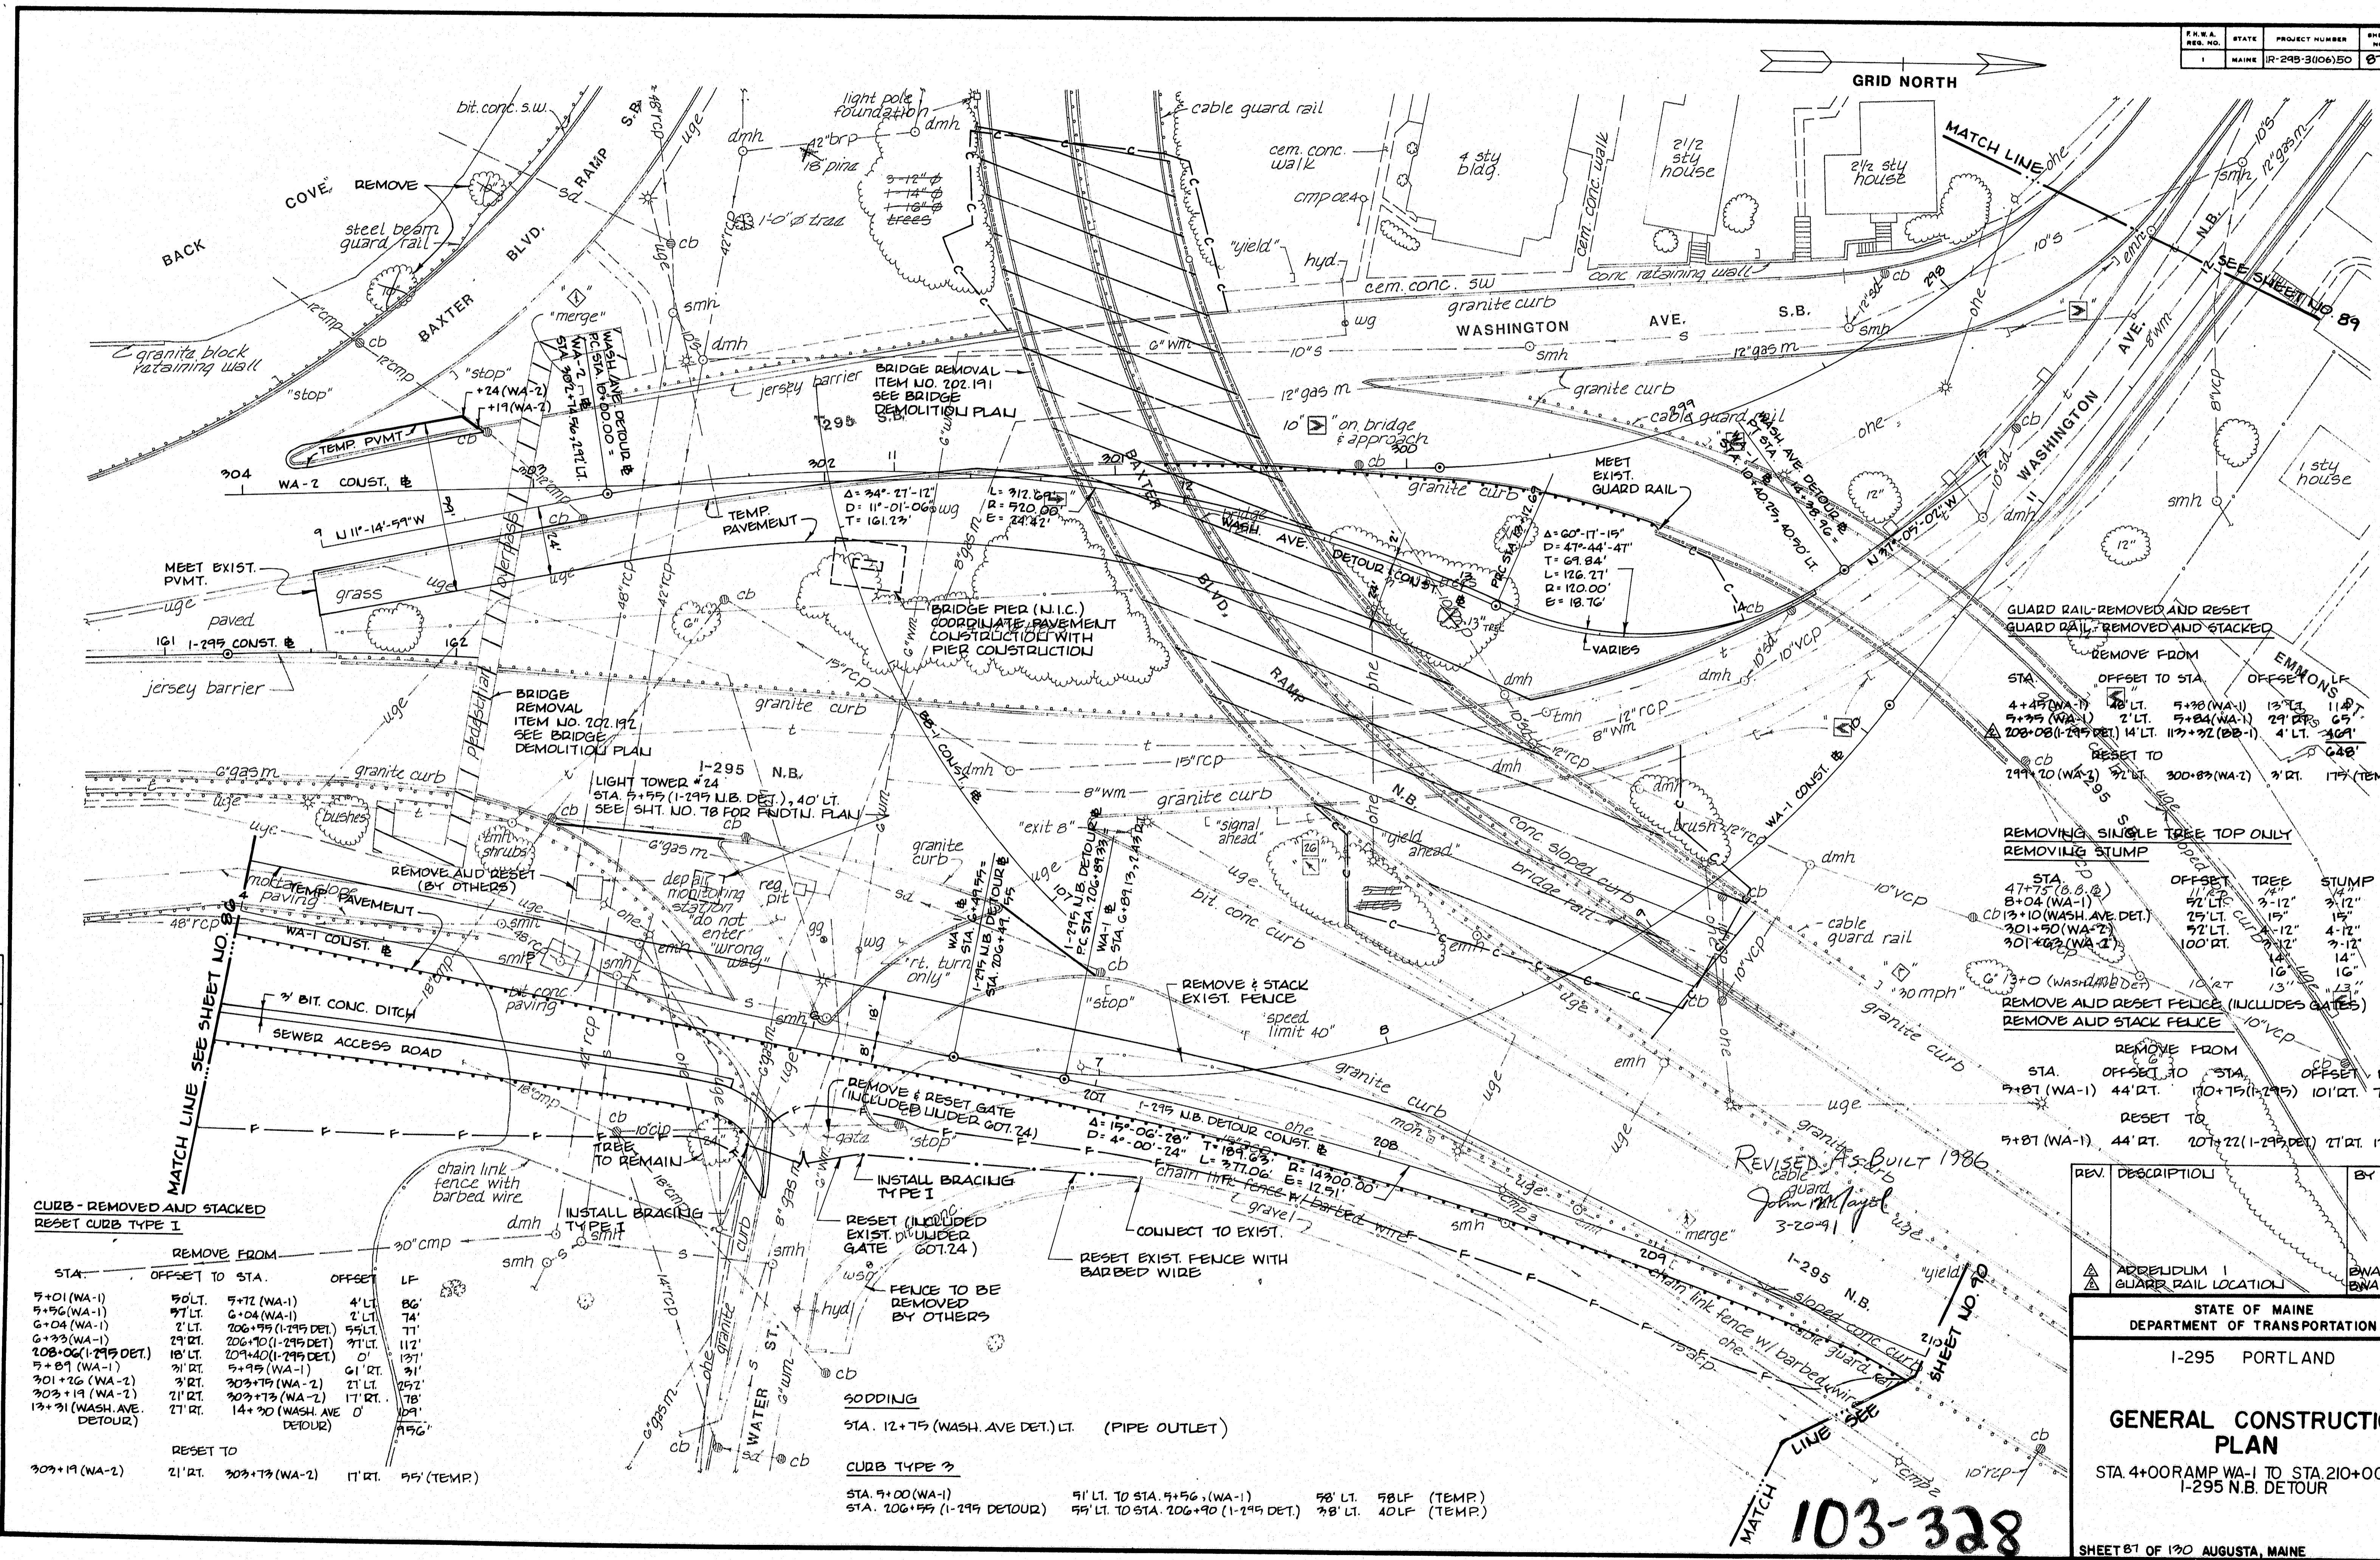

PROJECT ENGINEER	DATE
DESIGN - DETAILED	
CHECKED	
REVISIONS	
FIELD CHANGE	

CURB - REMOVED AND STACKED
RESET CURB TYPE I

STA.	REMOVE FROM	OFFSET TO STA.	OFFSET	LF
5+01 (WA-1)	50' LT.	5+72 (WA-1)	4' LT.	86'
5+56 (WA-1)	5' LT.	6+04 (WA-1)	2' LT.	74'
6+04 (WA-1)	2' LT.	206+99 (I-295 DET.)	55' LT.	71'
6+33 (WA-1)	29' RT.	206+70 (I-295 DET.)	71' LT.	112'
208+06 (I-295 DET.)	18' LT.	209+40 (I-295 DET.)	0'	137'
5+81 (WA-1)	3' RT.	5+95 (WA-1)	0' RT.	31'
5+01+26 (WA-2)	3' RT.	5+95+19 (WA-2)	21' LT.	252'
5+03+19 (WA-2)	21' RT.	5+95+13 (WA-2)	11' RT.	178'
13+31 (WASH. AVE. DETOUR)	27' RT.	14+30 (WASH. AVE. DETOUR)	0'	129'
309+19 (WA-2)	21' RT.	309+73 (WA-2)	11' RT.	55' (TEMP.)

SODDING
STA. 12+75 (WASH. AVE. DET.) LT. (PIPE OUTLET)

CURB TYPE 3
STA. 9+00 (WA-1) 51' LT. TO STA. 5+56 (WA-1) 58' LT. 58LF (TEMP.)
STA. 206+99 (I-295 DETOUR) 55' LT. TO STA. 206+90 (I-295 DET.) 38' LT. 40LF (TEMP.)

EMMOUS LF

STA.	OFFSET TO STA.	OFFSET	LF
4+45 (WA-1)	18' LT.	5+98 (WA-1)	137' LT. 118'
5+95 (WA-1)	2' LT.	5+84 (WA-1)	29' RT. 65'
208+06 (I-295 DET.)	14' LT.	117+32 (DE-1)	4' LT. 46'
244+70 (WA-2)	92' RT.	300+83 (WA-2)	3' RT. 173' (TEMP.)

REMOVING SINGLE TREE TOP ONLY
REMOVING STUMP

STA.	OFFSET	TREE	STUMP
47+75 (R.O.B.)	72' LT.	3-12"	3-12"
5+04 (WA-1)	15' LT.	15"	15"
6+13+10 (WASH. AVE. DET.)	75' LT.	3-12"	4-12"
9+01+50 (WA-2)	92' LT.	3-12"	3-12"
9+01+63 (WA-2)	100' RT.	16"	14"
6+33+0 (WASH. AVE. DET.)	10' AT	13"	13"

REMOVE AND RESET FENCE (INCLUDES GATES)
REMOVE AND STACK FENCE

STA.	OFFSET TO	STA.	OFFSET	LF
5+81 (WA-1)	44' RT.	170+75 (I-295)	101' RT.	745'
5+81 (WA-1)	44' RT.	207+22 (I-295 DET.)	27' RT.	137'

REV. DESCRIPTION BY DATE

STATE OF MAINE
DEPARTMENT OF TRANSPORTATION

I-295 PORTLAND

GENERAL CONSTRUCTION PLAN

STA. 4+00 RAMP WA-1 TO STA. 210+00
I-295 N.B. DETOUR

103-328

SHEET 81 OF 130 AUGUSTA, MAINE

F.R.E.A. NO.	STATE	PROJECT NUMBER	SHEET NO.	TOTAL SHEETS
1	MAINE	IR-295-3(106)90	88	120

CURB REMOVED AND STACKED


STA.	OFFSET	TO	STA.	OFFSET	LF
100+00(BB-1)	18' RT.		101+70(BB-1)	30' RT.	171'
100+00(BB-1)	10' LT.		101+72(BB-1)	3' RT.	173'
100+00(BB-1)	21' LT.		100+93(BB-1)	22' LT.	93'
101+87(BB-1)	30' LT.		102+19(BB-1)	33' LT.	32'
					420'

**REMOVING SINGLE TREE TOP ONLY
REMOVING STUMP**

STA.	OFFSET	TREE	STUMP
101+49(BB-1)	30' RT.	1-12"	1-12"
102+05(BB-1)	40' RT.	1-12"	1-12"
102+54(BB-1)	46' RT.	1-12"	1-12"

CURB TYPE 3

STA.	OFFSET	TO	STA.	OFFSET	LF	REMARKS
100+00(BB-1)	21' LT.		100+00(BB-1)	10' LT.	11'	(TEMP)
1+91(BATES)	47' LT.		9+71(BATES)	57' LT.	36'	(TEMP)
100+93(BB-1)	27' LT.		101+72(BB-1)	3' RT.	126'	(TEMP)
10+73(BATES)	26' LT.		10+71(BATES)	19' LT.	40'	(TEMP)
101+87(BB-1)	30' LT.		102+19(BB-1)	33' LT.	33'	(TEMP)

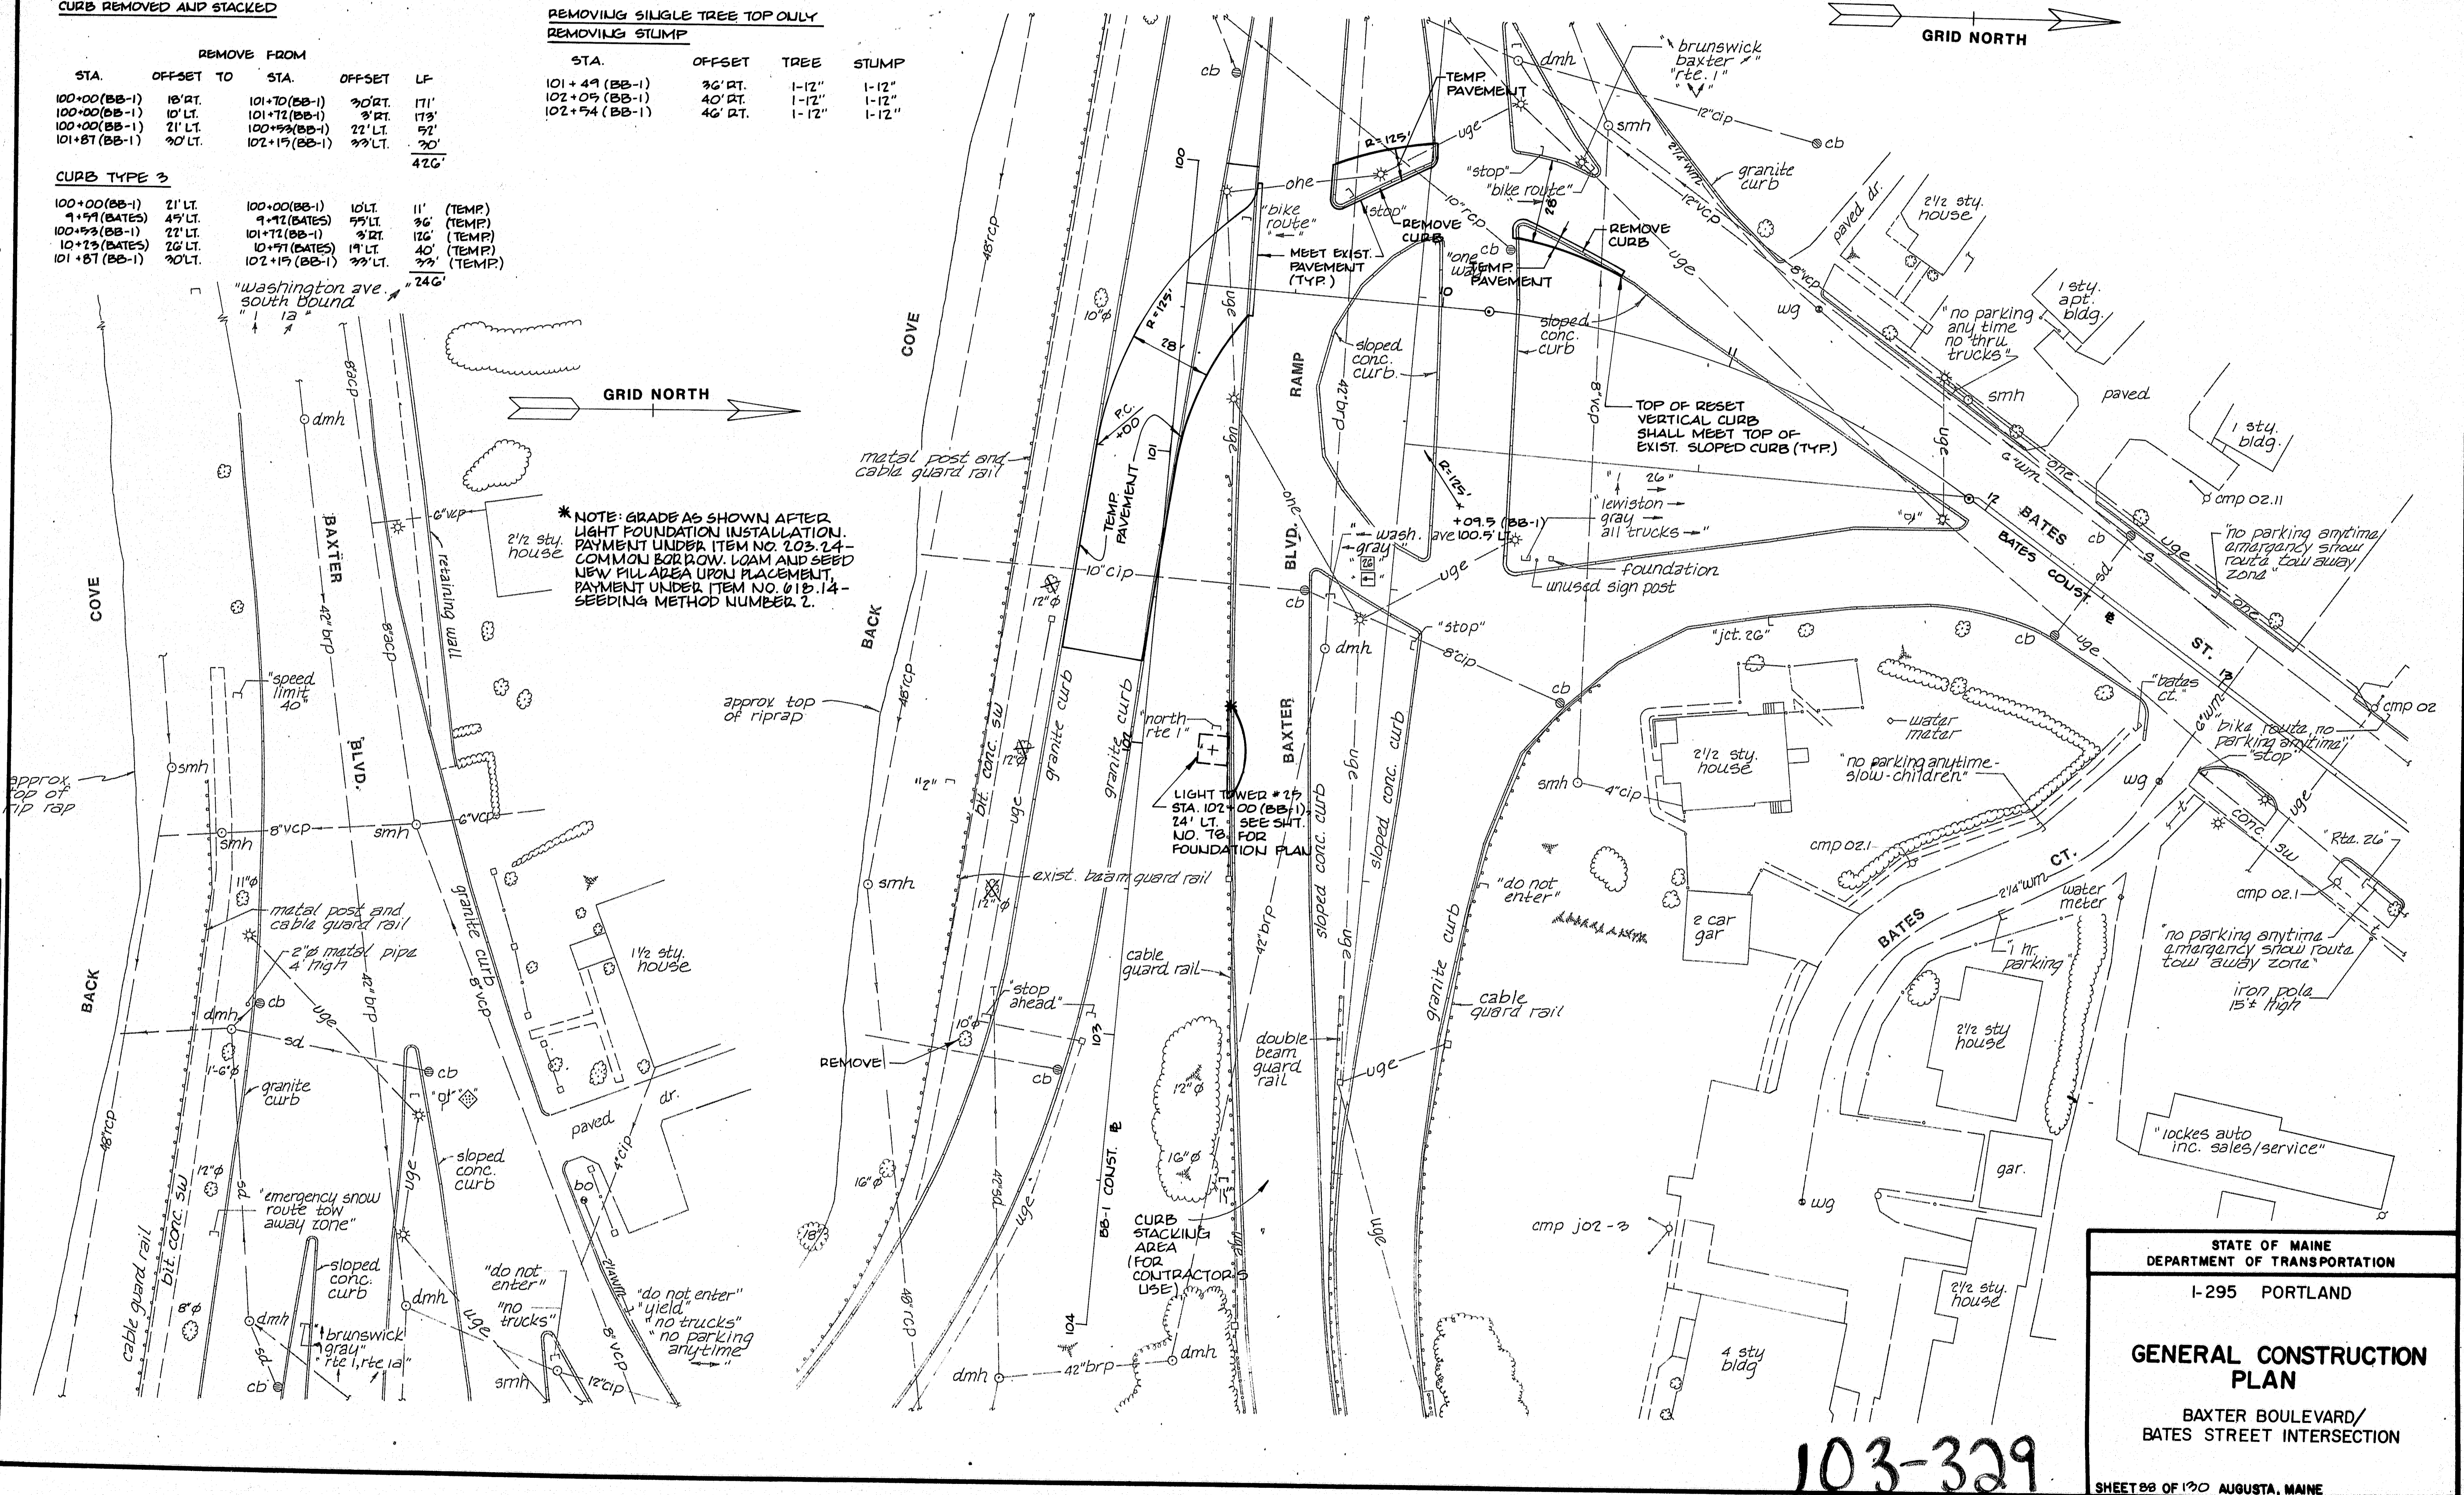

*NOTE: GRADES AS SHOWN AFTER LIGHT FOUNDATION INSTALLATION. PAYMENT UNDER ITEM NO. 2.03.24 - COMMON BORROW, LOAM AND SEED NEW FILL AREA UPON PLACEMENT. PAYMENT UNDER ITEM NO. 015.14 - SEEDING METHOD NUMBER 2.

PROJECT DESIGN ENGINEER	DATE
DESIGN - DETAILED	
CHECKED	
FIELD CHANGES	

STATE OF MAINE
DEPARTMENT OF TRANSPORTATION
1-295 PORTLAND


GENERAL CONSTRUCTION PLAN

BAXTER BOULEVARD/
BATES STREET INTERSECTION

103-329

SHEET 88 OF 120 AUGUSTA, MAINE

F.W.A.	STATE	PROJECT NUMBER	SHEET NO.	TOTAL SHEETS
1	MAINE	R-295-3(06)50	10	130

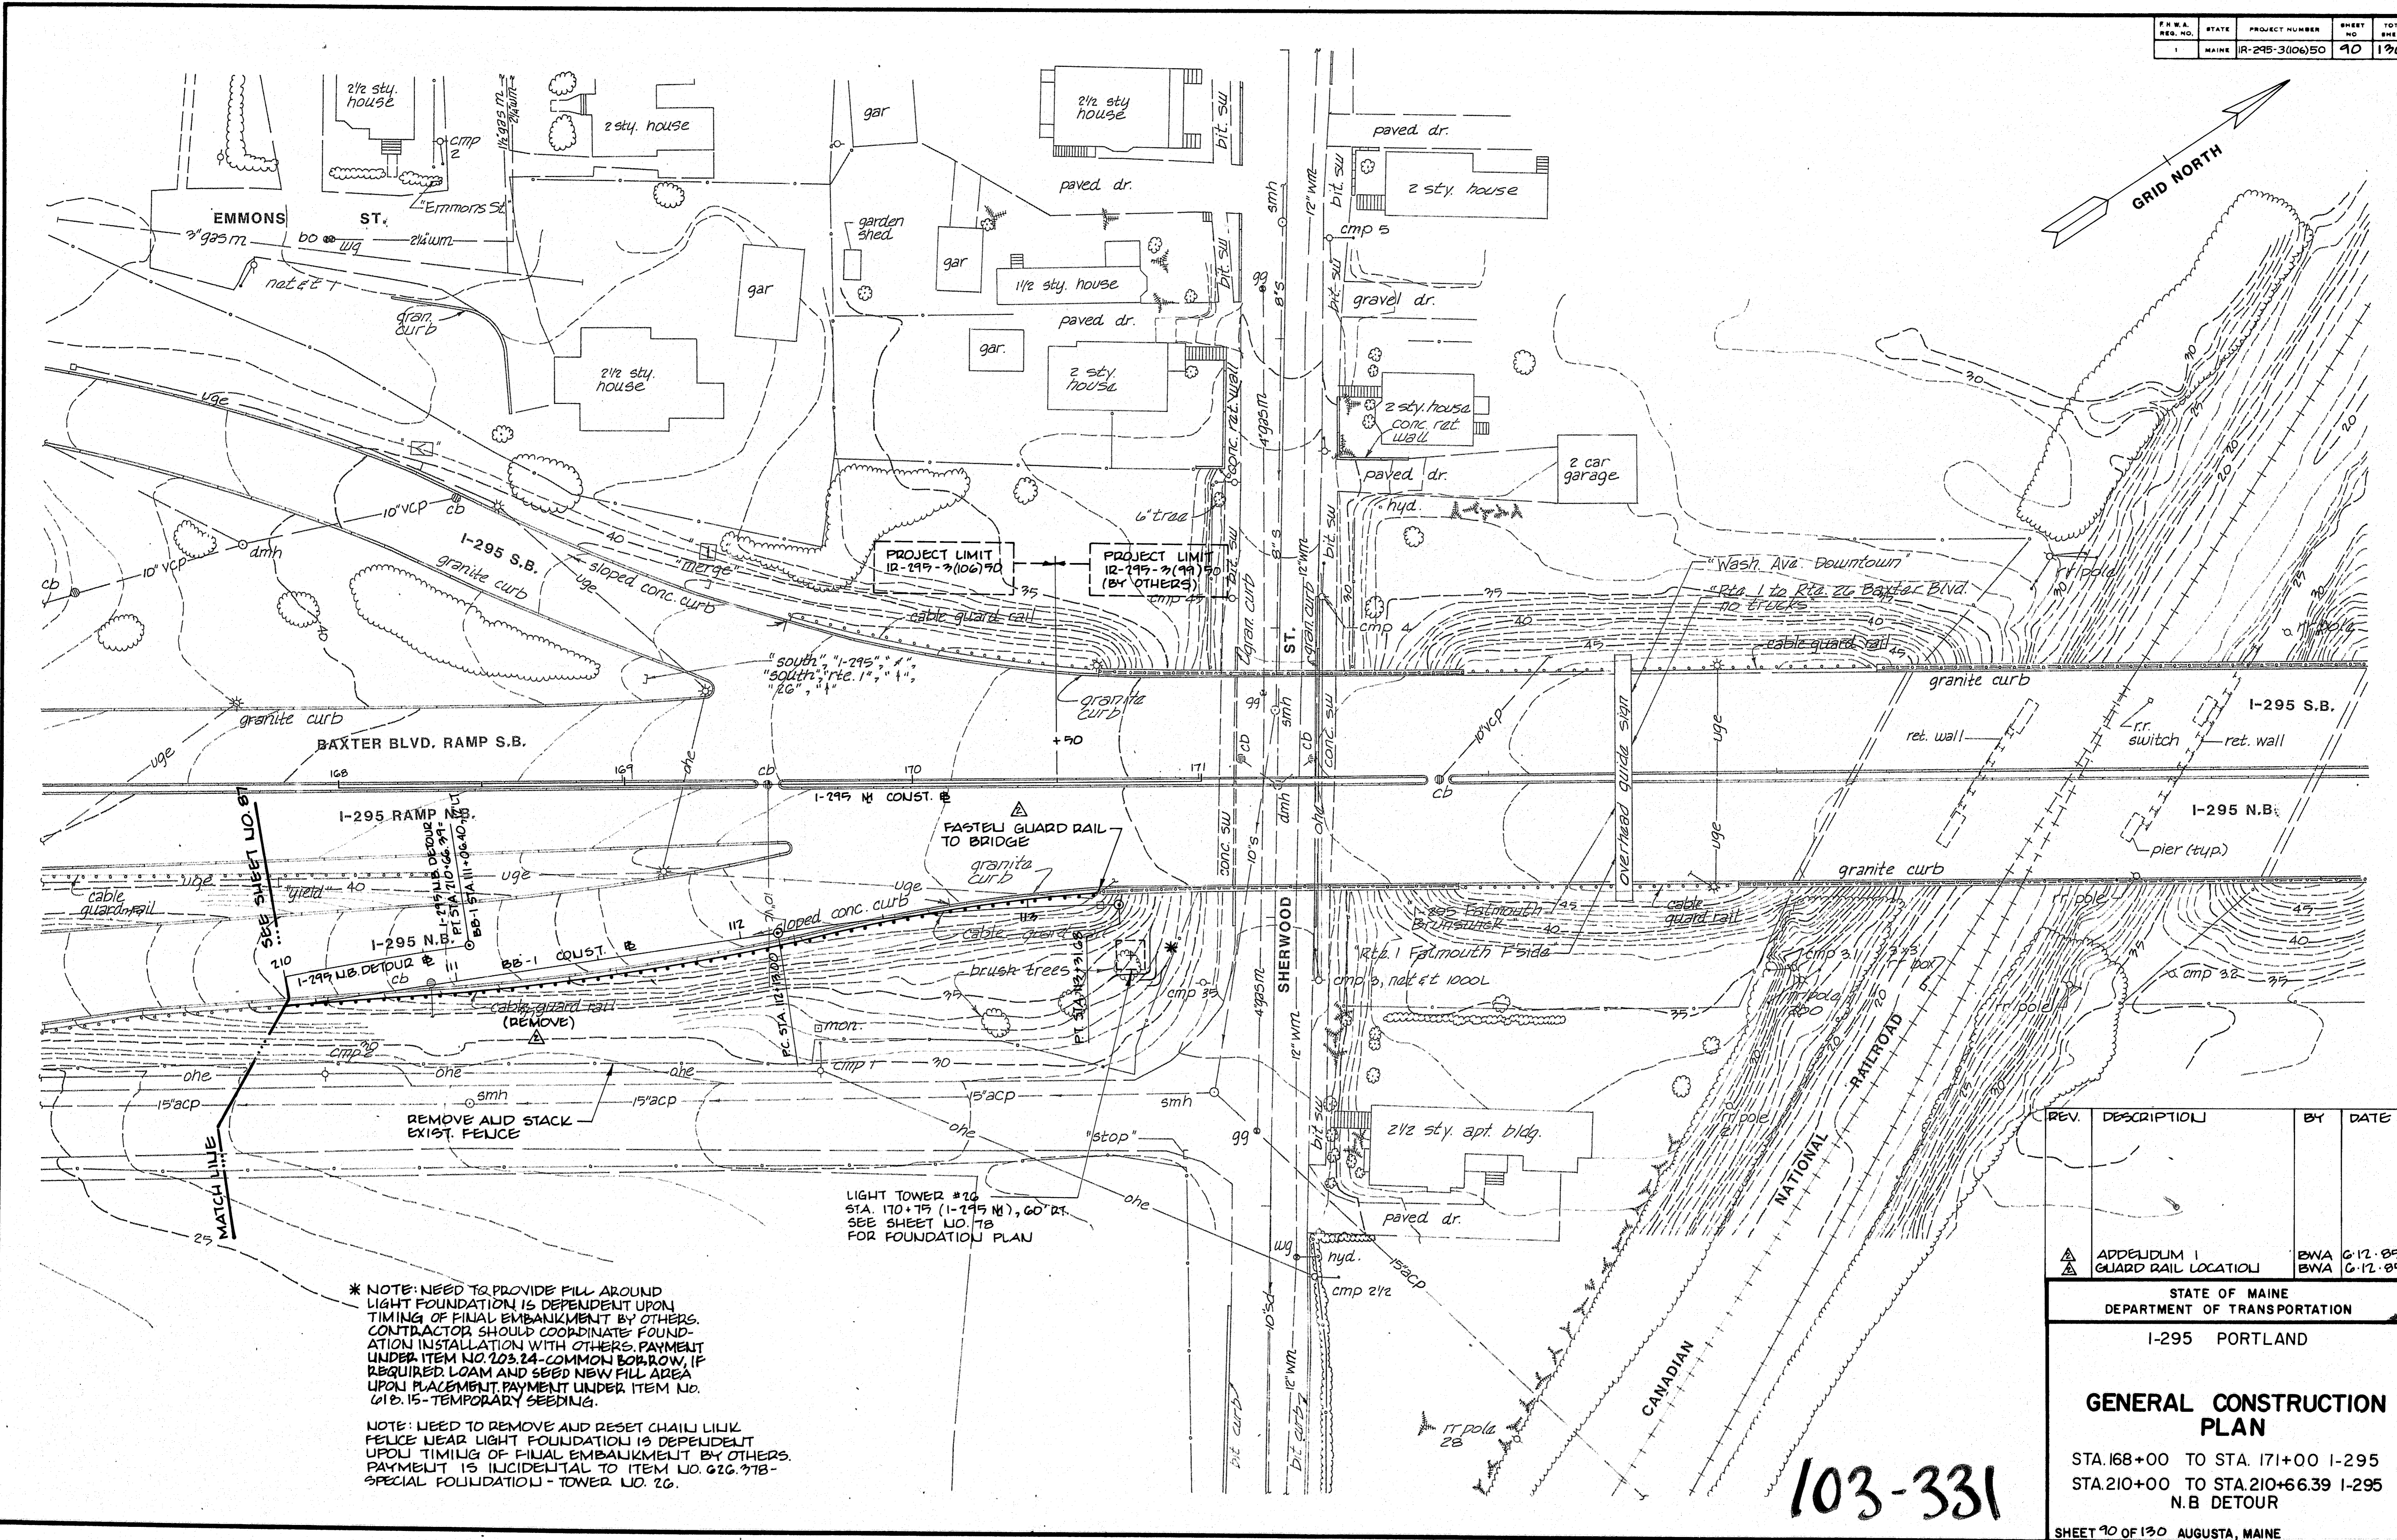

PROJECT DESIGN ENGINEER	DATE
DESIGN DETAILER	
CHECKED	
REVISIONS	
FIELD CHANGES	

* NOTE: NEED TO PROVIDE FILL AROUND LIGHT FOUNDATION IS DEPENDENT UPON TIMING OF FINAL EMBANKMENT BY OTHERS. CONTRACTOR SHOULD COORDINATE FOUNDATION INSTALLATION WITH OTHERS. PAYMENT UNDER ITEM NO. 02.34 - COMMON BORROW, IF REQUIRED LOAM AND SEED NEW FILL AREA UPON PLACEMENT PAYMENT UNDER ITEM NO. 01B.15 - TEMPORARY SEEDING.

NOTE: NEED TO REMOVE AND RESET CHAIN LINK FENCE NEAR LIGHT FOUNDATION IS DEPENDENT UPON TIMING OF FINAL EMBANKMENT BY OTHERS. PAYMENT IS INCIDENTAL TO ITEM NO. 02.34 - SPECIAL FOUNDATION - TOWER NO. 26.

LIGHT TOWER #26
STA. 170+75 (I-295 N.B.), 60' RT.
SEE SHEET NO. 78
FOR FOUNDATION PLAN

REV.	DESCRIPTION	BY	DATE
1	ADDENDUM 1 GUARD RAIL LOCATION	BWA	6.12.05
2		BWA	6.12.05

STATE OF MAINE
DEPARTMENT OF TRANSPORTATION

I-295 PORTLAND


GENERAL CONSTRUCTION PLAN

STA. 168+00 TO STA. 171+00 I-295
STA. 210+00 TO STA. 210+66.39 I-295
N.B. DETOUR

SHEET 10 OF 130 AUGUSTA, MAINE

103-331

F.R.W.A. PROJ. NO.	STATE	PROJECT NUMBER	SHEET NO.	TOTAL SHEETS
1	MAINE	1R-295-300650	91	170

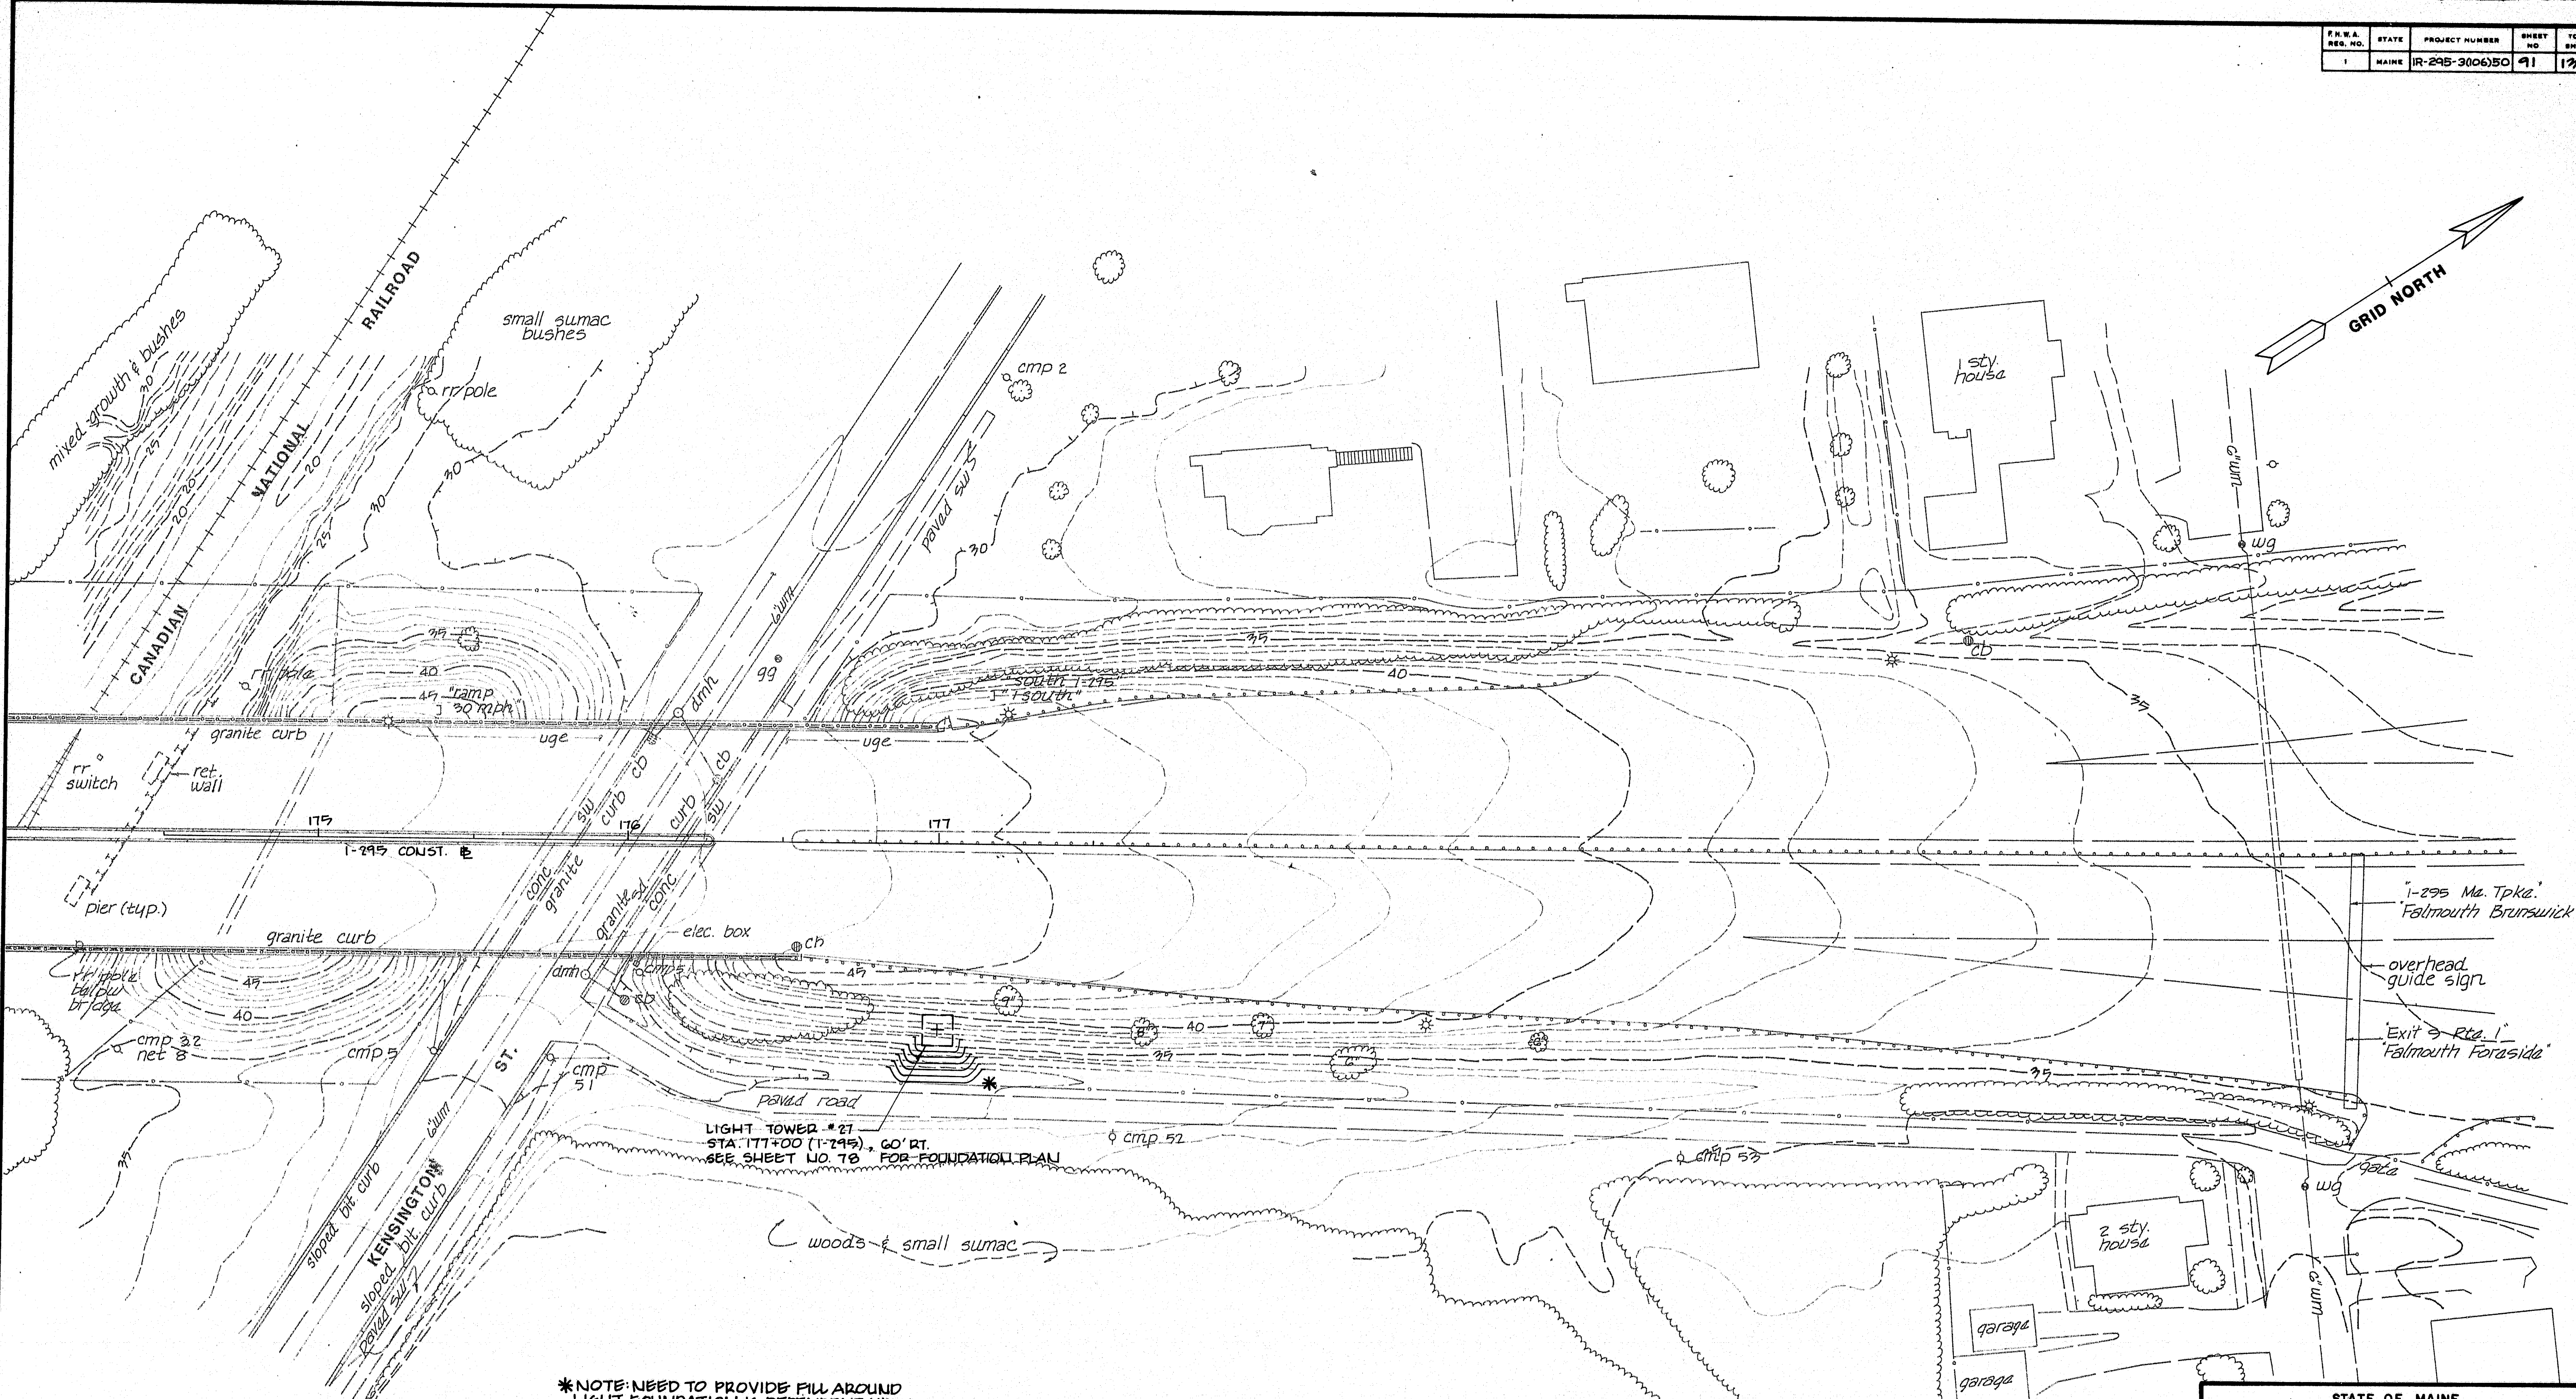

PROJECT ENGINEER	DATE
DESIGNED	
DRAWN	
CHECKED	
REVISIONS	
FIELD CHANGES	

*NOTE: NEED TO PROVIDE FILL AROUND LIGHT FOUNDATION IS DEPENDENT UPON TIMING OF FINAL EMBANKMENT BY OTHERS. CONTRACTOR SHOULD COORDINATE FOUNDATION INSTALLATION WITH OTHERS. PAYMENT UNDER ITEM NO. 203.24 - COMMON BORROW. IF REQUIRED LOAM AND SEED NEW FILL AREA UPON PLACEMENT. PAYMENT UNDER ITEM NO. 616.15 - TEMPORARY SEEDING.

NOTE: USED TO REMOVE AND RESET CHAIN LINK FENCE NEAR LIGHT FOUNDATION IS DEPENDENT UPON TIMING OF FINAL EMBANKMENT BY OTHERS. PAYMENT IS INCIDENTAL TO ITEM NO. 616.319 - SPECIAL FOUNDATION - TOWER NO. 21.

103-332


STATE OF MAINE
DEPARTMENT OF TRANSPORTATION
I-295 PORTLAND

GENERAL CONSTRUCTION PLAN

STA. 175+00 TO STA. 177+00 I-295

SHEET 91 OF 170 AUGUSTA, MAINE

F.R.S. NO.	STATE	PROJECT NUMBER	SHEET NO.	TOTAL SHEETS
1	MAINE	R-295-3106150	72	170

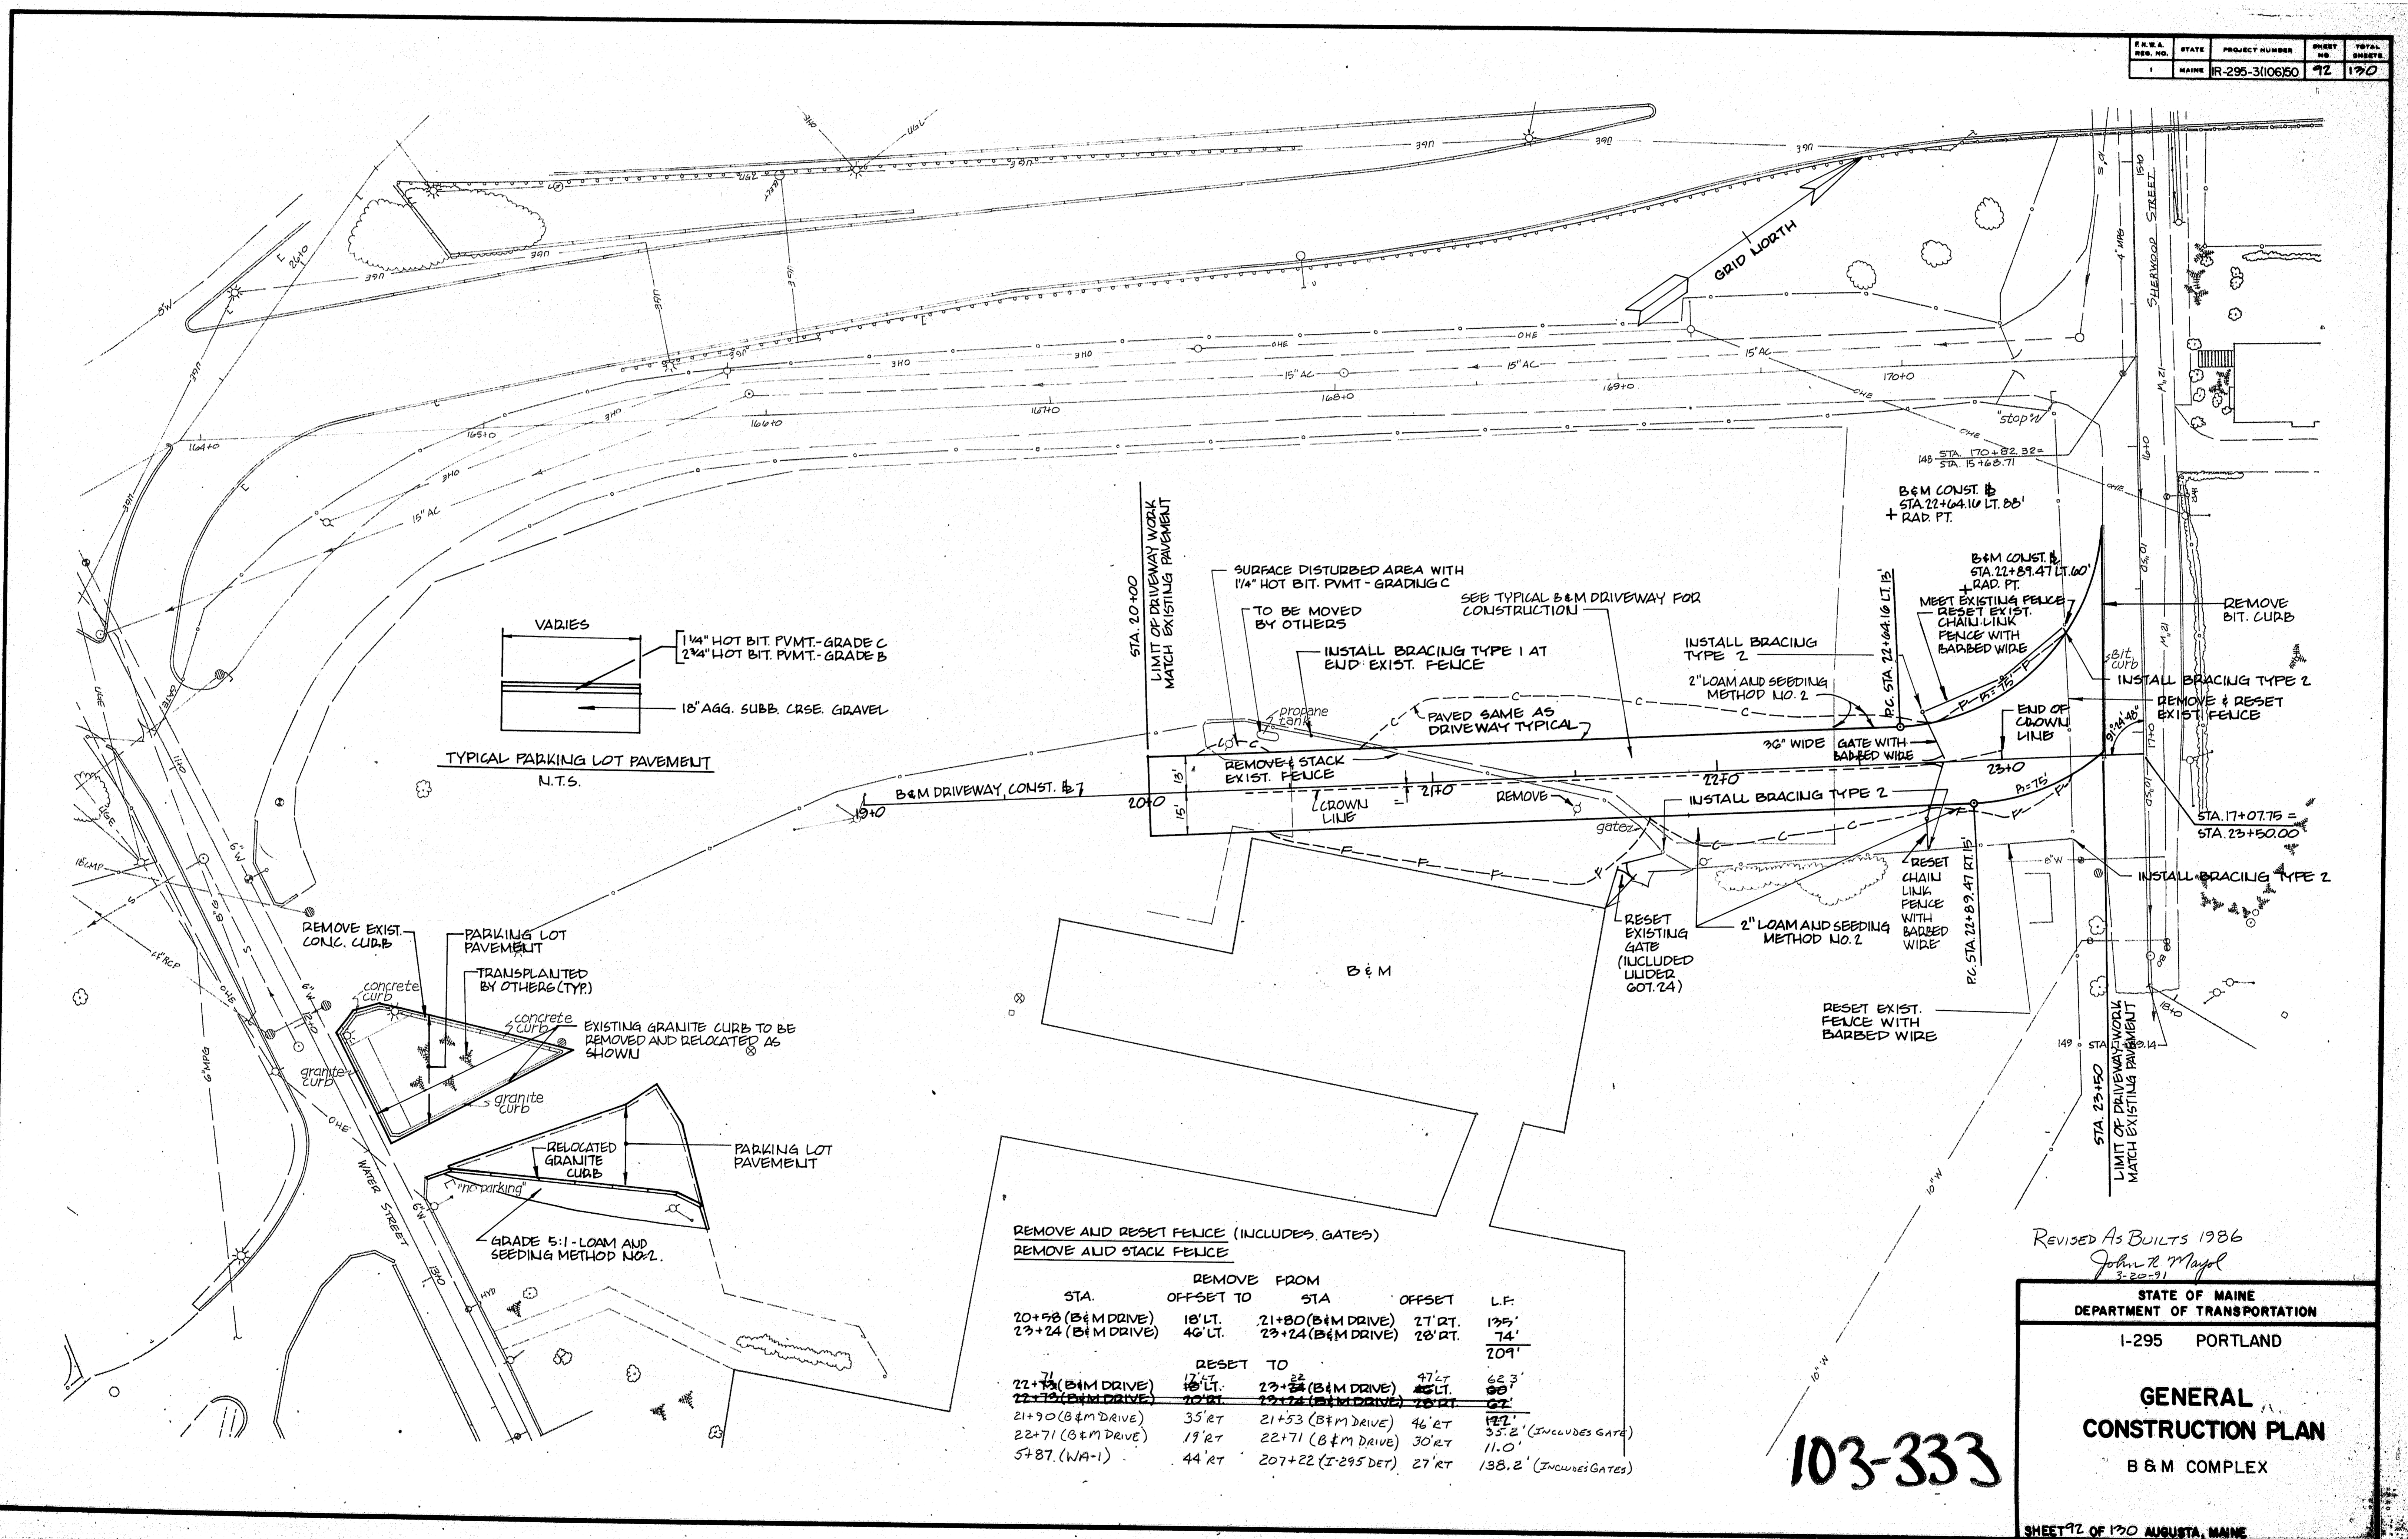

PROJECT DESIGN ENGINEER	DATE
DESIGN - DETAILED	
CHECKED	
REVISIONS	
FIELD CHANGES	
PLANS	

**REMOVE AND RESET FENCE (INCLUDES GATES)
REMOVE AND STACK FENCE**

STA.	REMOVE FROM OFFSET TO	STA.	OFFSET	L.F.
20+98 (B&M DRIVE)	18' LT.	21+80 (B&M DRIVE)	27' RT.	195'
23+24 (B&M DRIVE)	46' LT.	23+24 (B&M DRIVE)	28' RT.	74'
				209'
RESET TO				
22+74 (B&M DRIVE)	12' LT.	23+24 (B&M DRIVE)	47' LT.	62.3'
22+70 (B&M DRIVE)	10' RT.	23+24 (B&M DRIVE)	40' LT.	60'
21+90 (B&M DRIVE)	35' RT.	21+53 (B&M DRIVE)	46' RT.	157'
22+71 (B&M DRIVE)	19' RT.	22+71 (B&M DRIVE)	30' RT.	35.2' (INCLUDES GATE)
5+87 (WA-1)	44' RT.	207+22 (I-295 DET.)	27' RT.	11.0'
				138.2' (INCLUDES GATES)

REVISED AS BUILT 1986
John W. Mayhew
3-20-91

STATE OF MAINE
DEPARTMENT OF TRANSPORTATION
I-295 PORTLAND


**GENERAL
CONSTRUCTION PLAN**
B & M COMPLEX

SHEET 72 OF 170 AUGUSTA, MAINE

103-333

F.R.R. NO.	STATE	PROJECT NUMBER	SHEET NO.	TOTAL SHEETS
1	MAINE	12-277-300024	43	130

NOTE:
THE TELEPHONE, SEWER, GAS, AND UNDERGROUND POWER LINES SHOWN ON THIS SHEET ARE TO BE INSTALLED BY OTHERS, BUT THEIR INSTALLATION CLOSELY COORDINATED WITH THE OTHER ASPECTS OF THE PROPOSED CONSTRUCTION. SEE SPECIAL PROVISIONS.

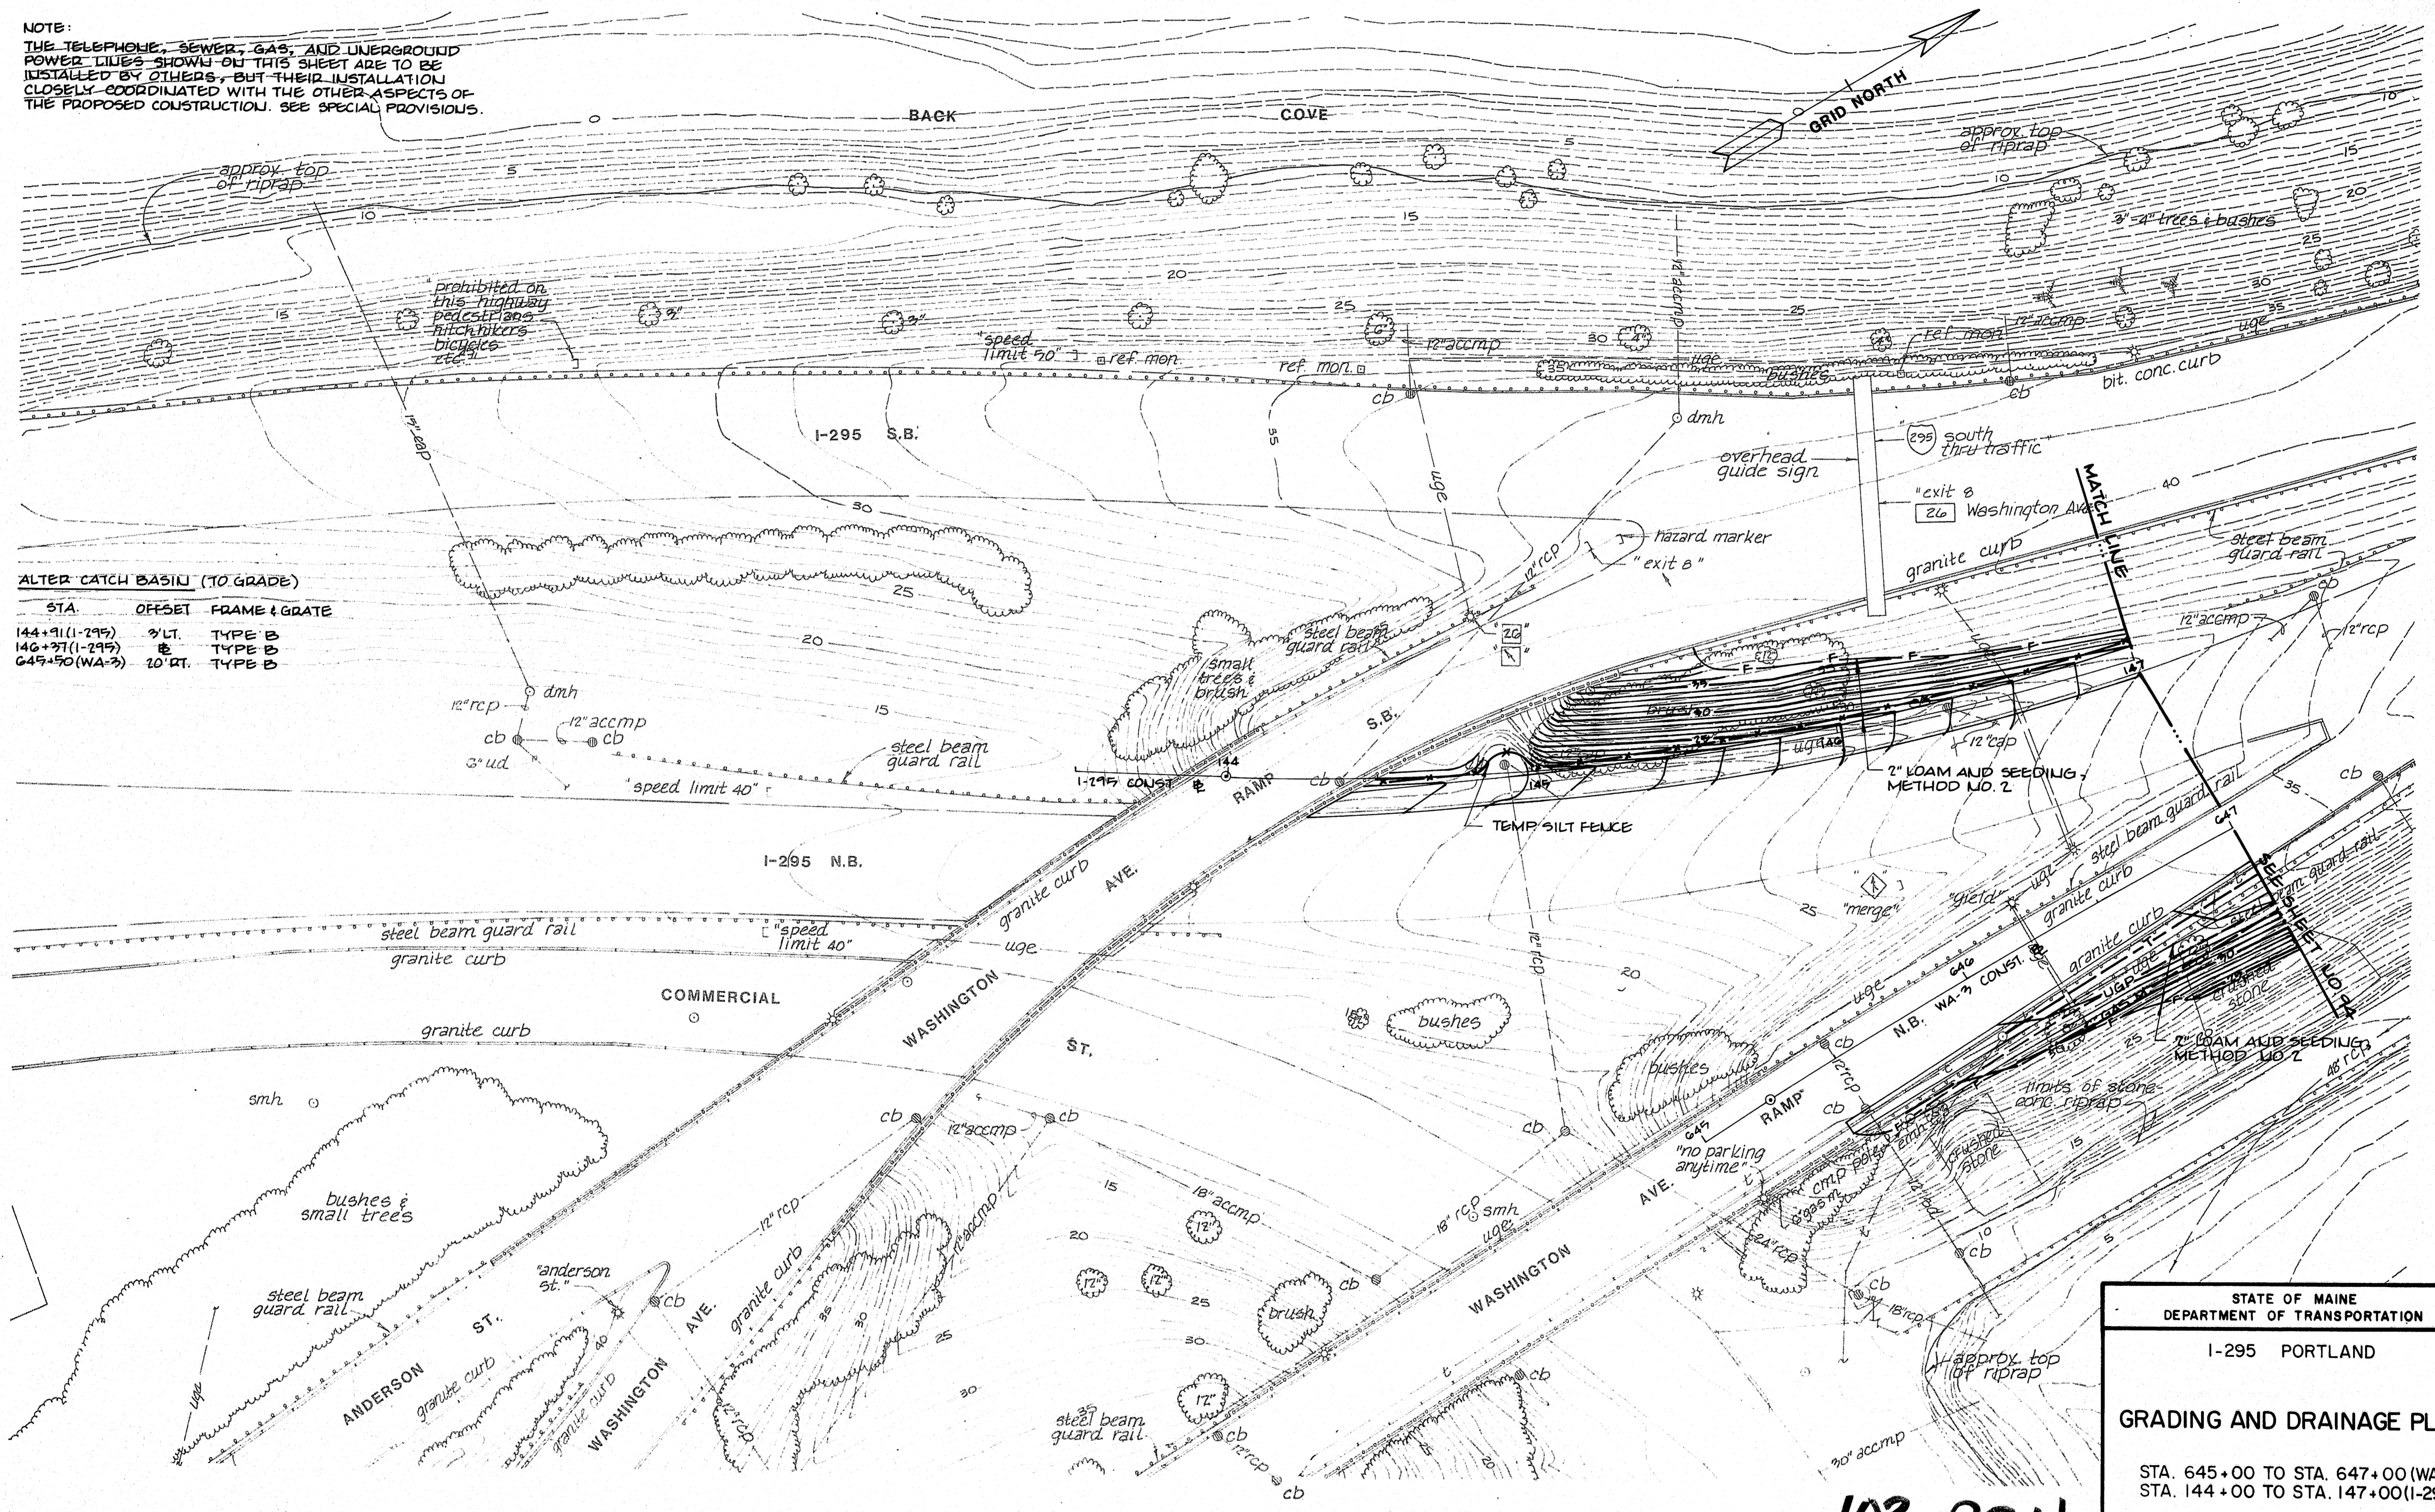

ALTER CATCH BASIN (TO GRADE)

STA.	OFFSET	FRAME & GRATE
144+91 (I-295)	3' LT.	TYPE B
146+97 (I-295)	0'	TYPE B
649+90 (WA-3)	20' RT.	TYPE B

PROJECT ENGINEER	DATE
DESIGN DETAIL	
CHECKED	
REVISIONS	
FIELD CHANGES	

PLANS



STATE OF MAINE
DEPARTMENT OF TRANSPORTATION
I-295 PORTLAND
GRADING AND DRAINAGE PLAN
STA. 645+00 TO STA. 647+00 (WA-3)
STA. 144+00 TO STA. 147+00 (I-295)
SHEET 43 OF 130 AUGUSTA, MAINE

103-334

F.W.A. DIST. NO.	STATE	PROJECT NUMBER	SHEET NO.	TOTAL SHEETS
1	MAINE	10-295-3(100)50	74	120

NOTES

1. SAW CUT EXISTING PAVEMENT
2. APPLY EMULSIFIED ASPHALT TACK COAT TO EDGE OF EXISTING PAVEMENT PRIOR TO PLACING BITUMINOUS TRENCH CAP
3. THE TOP OF THE 4" HOT BIT PAVEMENT LAYER SHALL BE LEFT 1/4" BELOW THE EXISTING PAVEMENT SURFACE AND A SLIM COURSE OF GRADING & PLACED AT THE DIRECTION OF THE ENGINEER AFTER THE TRENCH HAS BEEN SUBJECTED TO TRAFFIC.

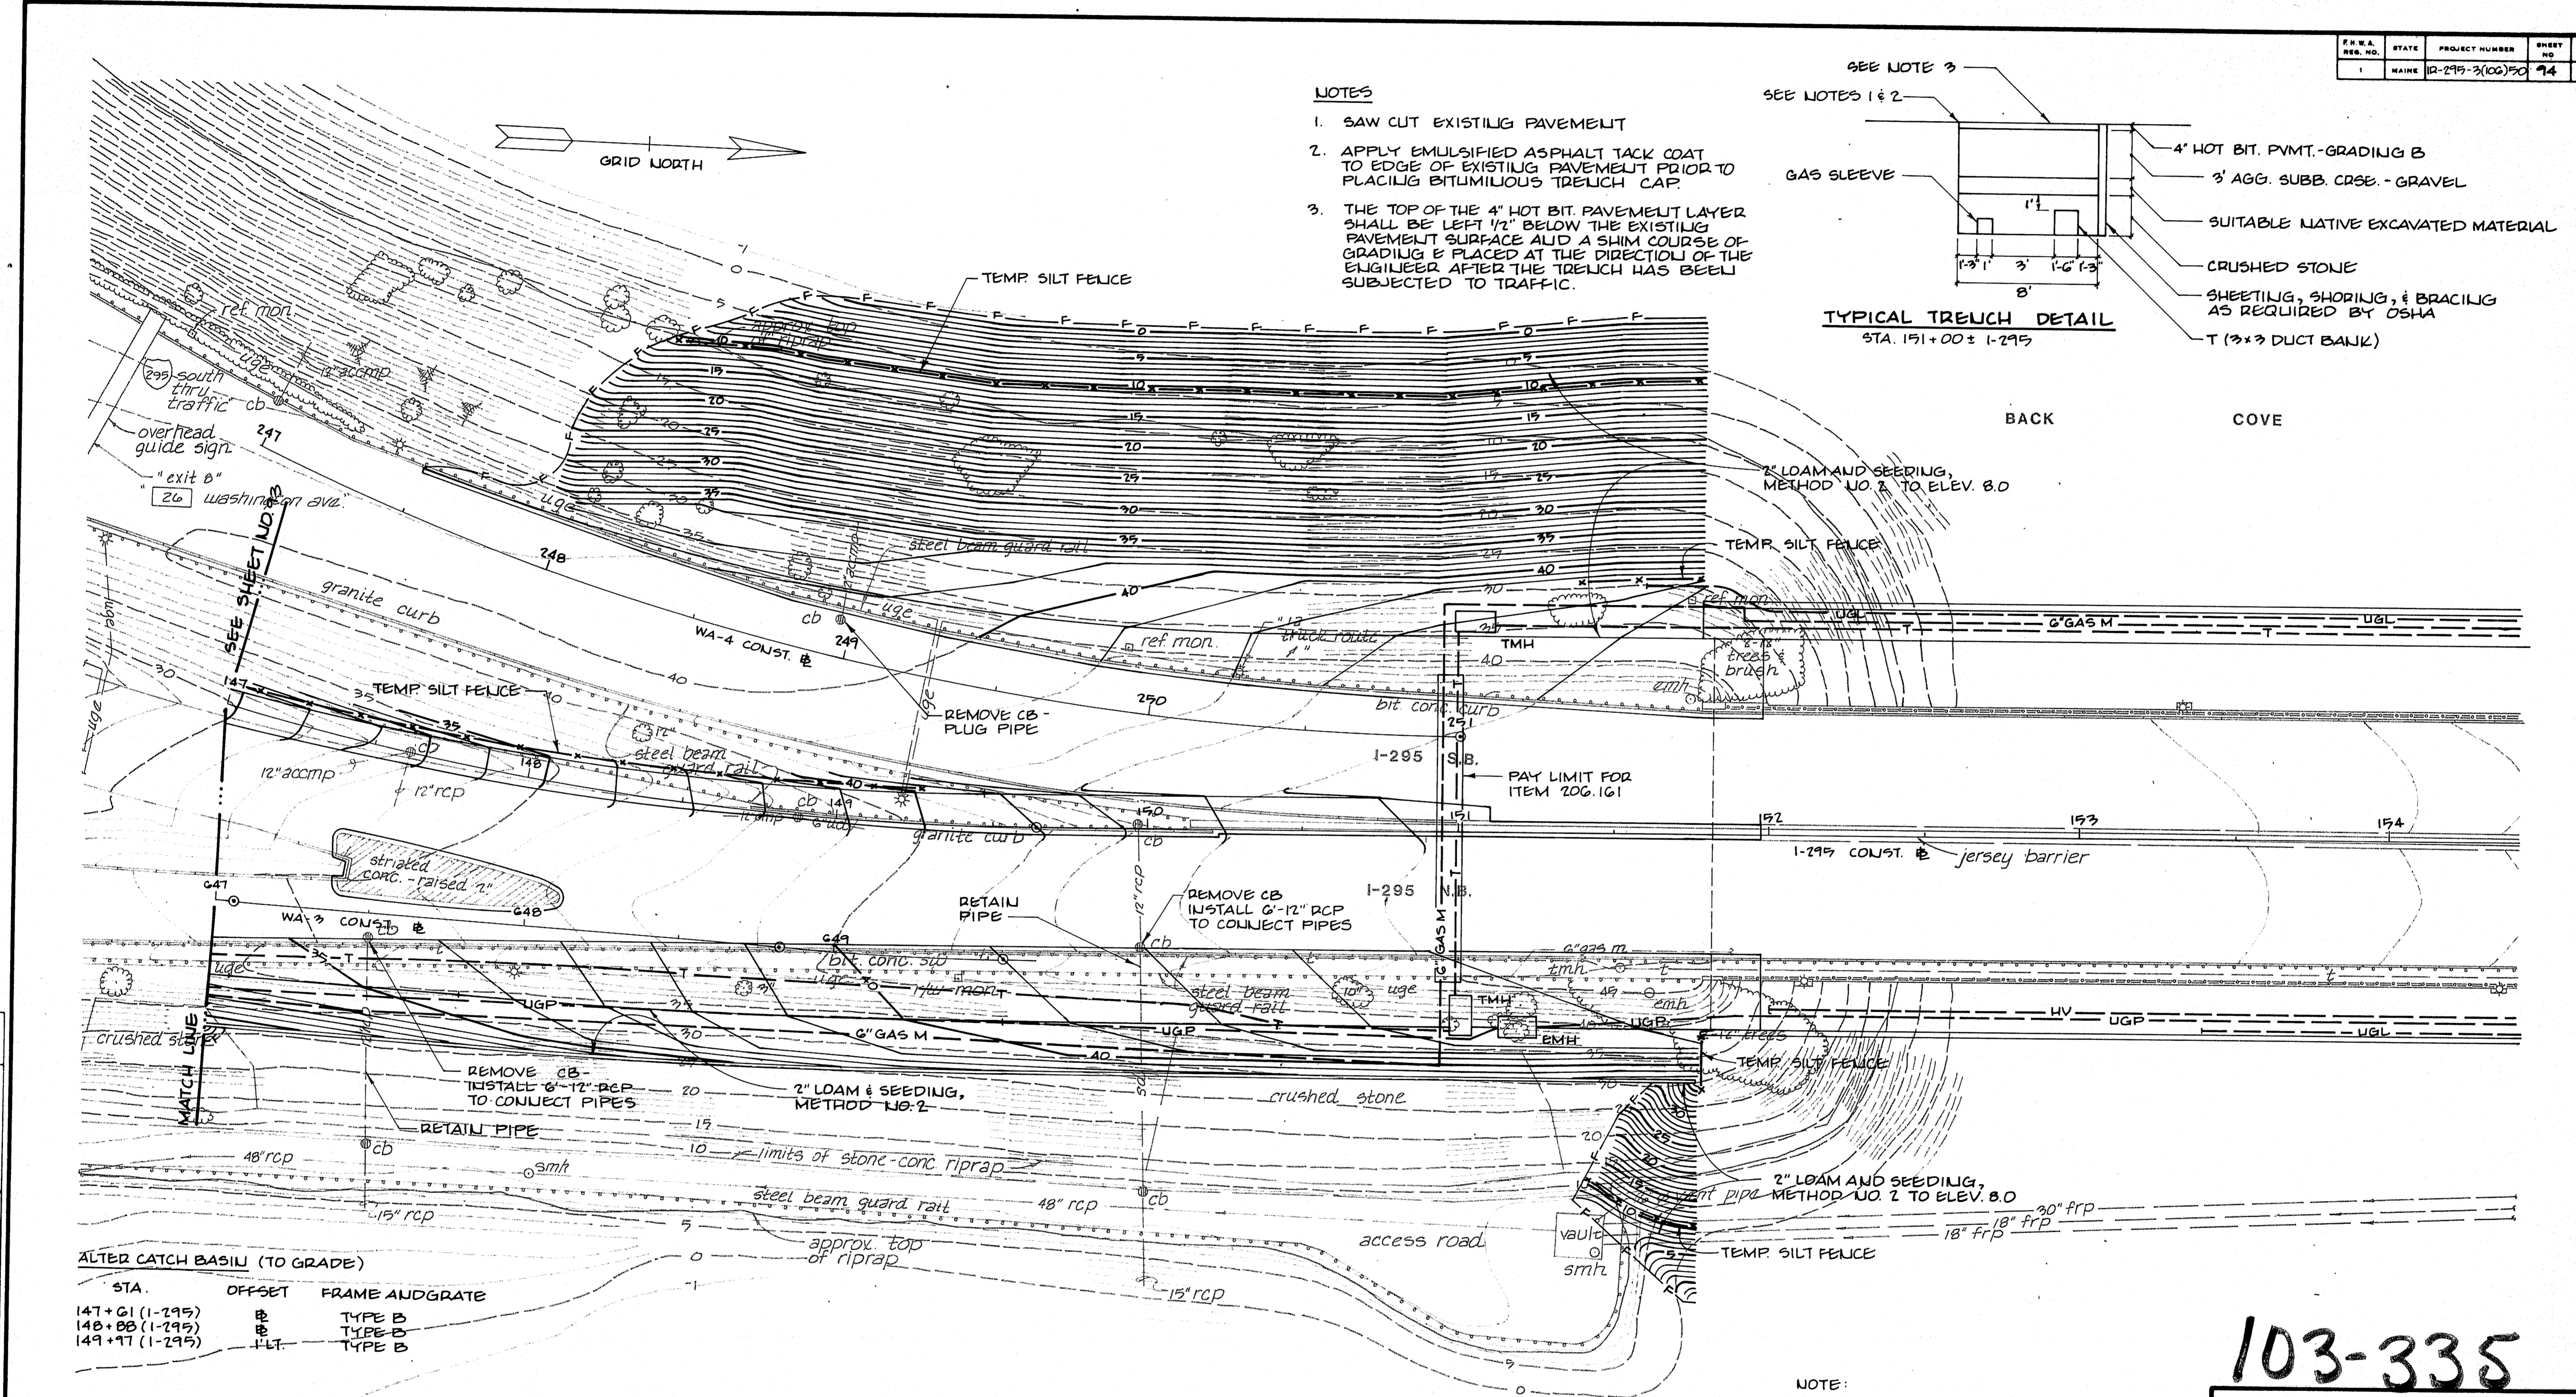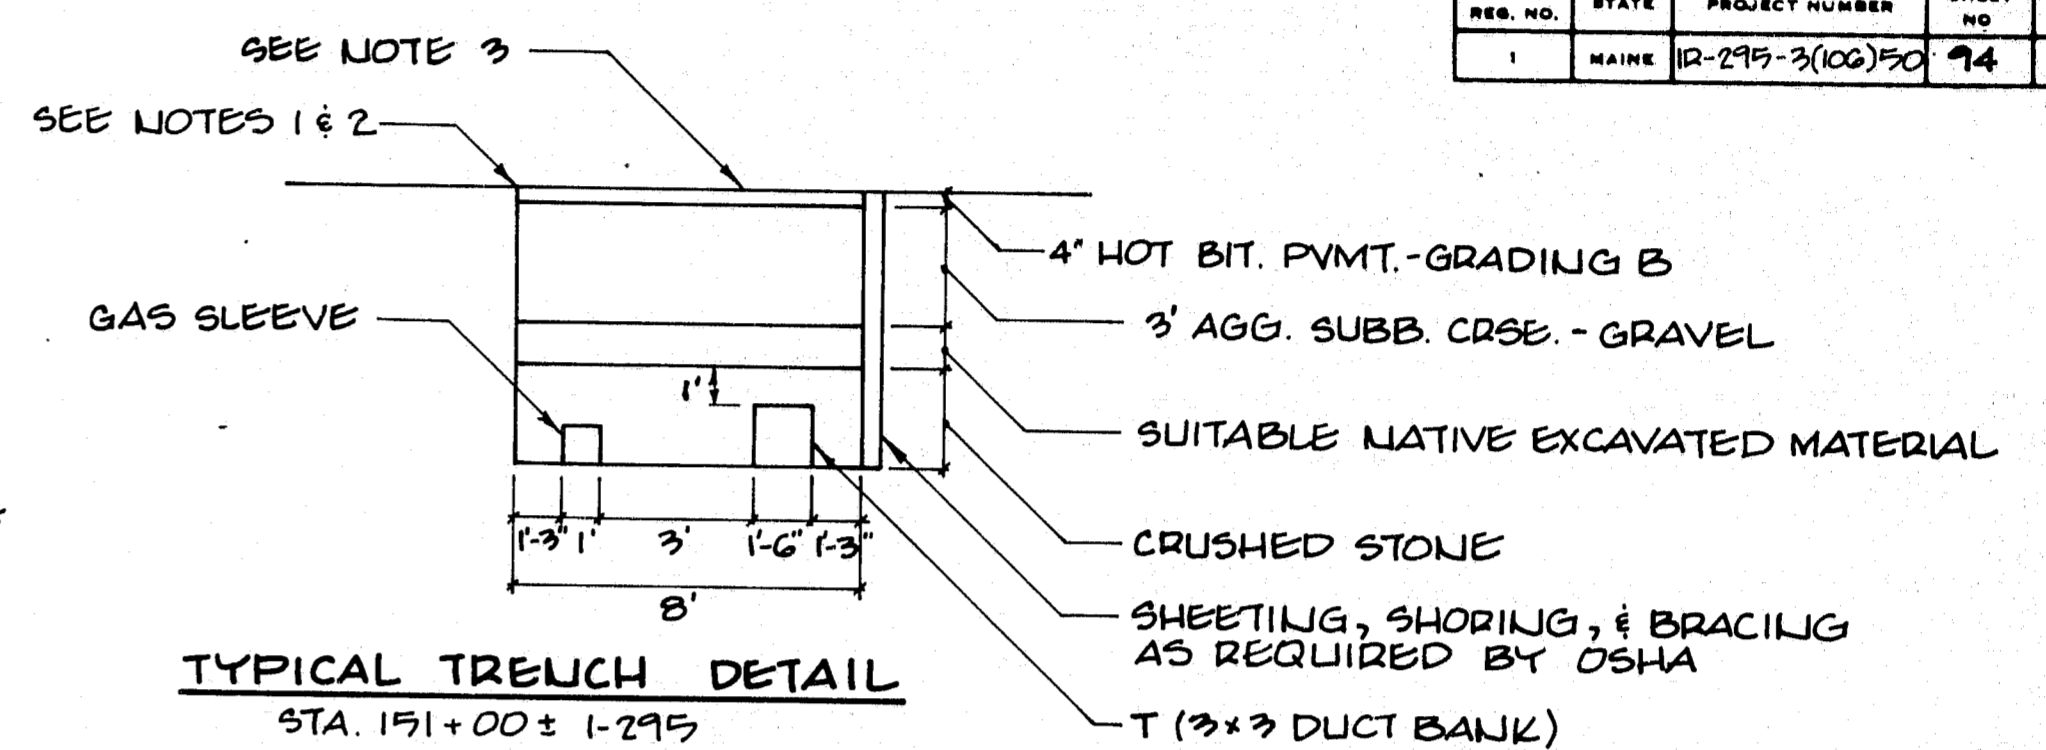

ALTERED CATCH BASIN (TO GRADE)

STA.	OFFSET	FRAME AND GRATE
147+01 (1-295)	BB	TYPE B
148+08 (1-295)	BB	TYPE B
149+17 (1-295)	PLT	TYPE B

NOTE:
THE TELEPHONE, SEWER, GAS, AND UNDERGROUND POWER LINES SHOWN ON THIS SHEET ARE TO BE INSTALLED BY OTHERS, BUT THEIR INSTALLATION CLOSELY COORDINATED WITH THE OTHER ASPECTS OF THE PROPOSED CONSTRUCTION. SEE SPECIAL PROVISIONS.

103-335

STATE OF MAINE
DEPARTMENT OF TRANSPORTATION
I-295 PORTLAND

GRADING AND DRAINAGE PLAN

STA. 147+00 TO STA. 151+97.25 (1-295)
STA. 647+00 TO STA. 649+64.84 (WA-4)


SHEET 74 OF 120 AUGUSTA, MAINE

PROJECT DESIGN ENGINEER	DATE
DESIGN - DETAILED	
CHECKED	
REVISIONS	
FIELD CHANGES	

BRUNING 44-132-45710-1

NOTE:
 THE TELEPHONE, SEWER, GAS, AND UNDERGROUND POWER LINES SHOWN ON THIS SHEET ARE TO BE INSTALLED BY OTHERS, BUT THEIR INSTALLATION CLOSELY COORDINATED WITH THE OTHER ASPECTS OF THE PROPOSED CONSTRUCTION. SEE SPECIAL PROVISIONS.

F.R.A. NO.	STATE	PROJECT NUMBER	SHEET NO.	TOTAL SHEETS
1	MAINE	R-295-300A)B	12	130

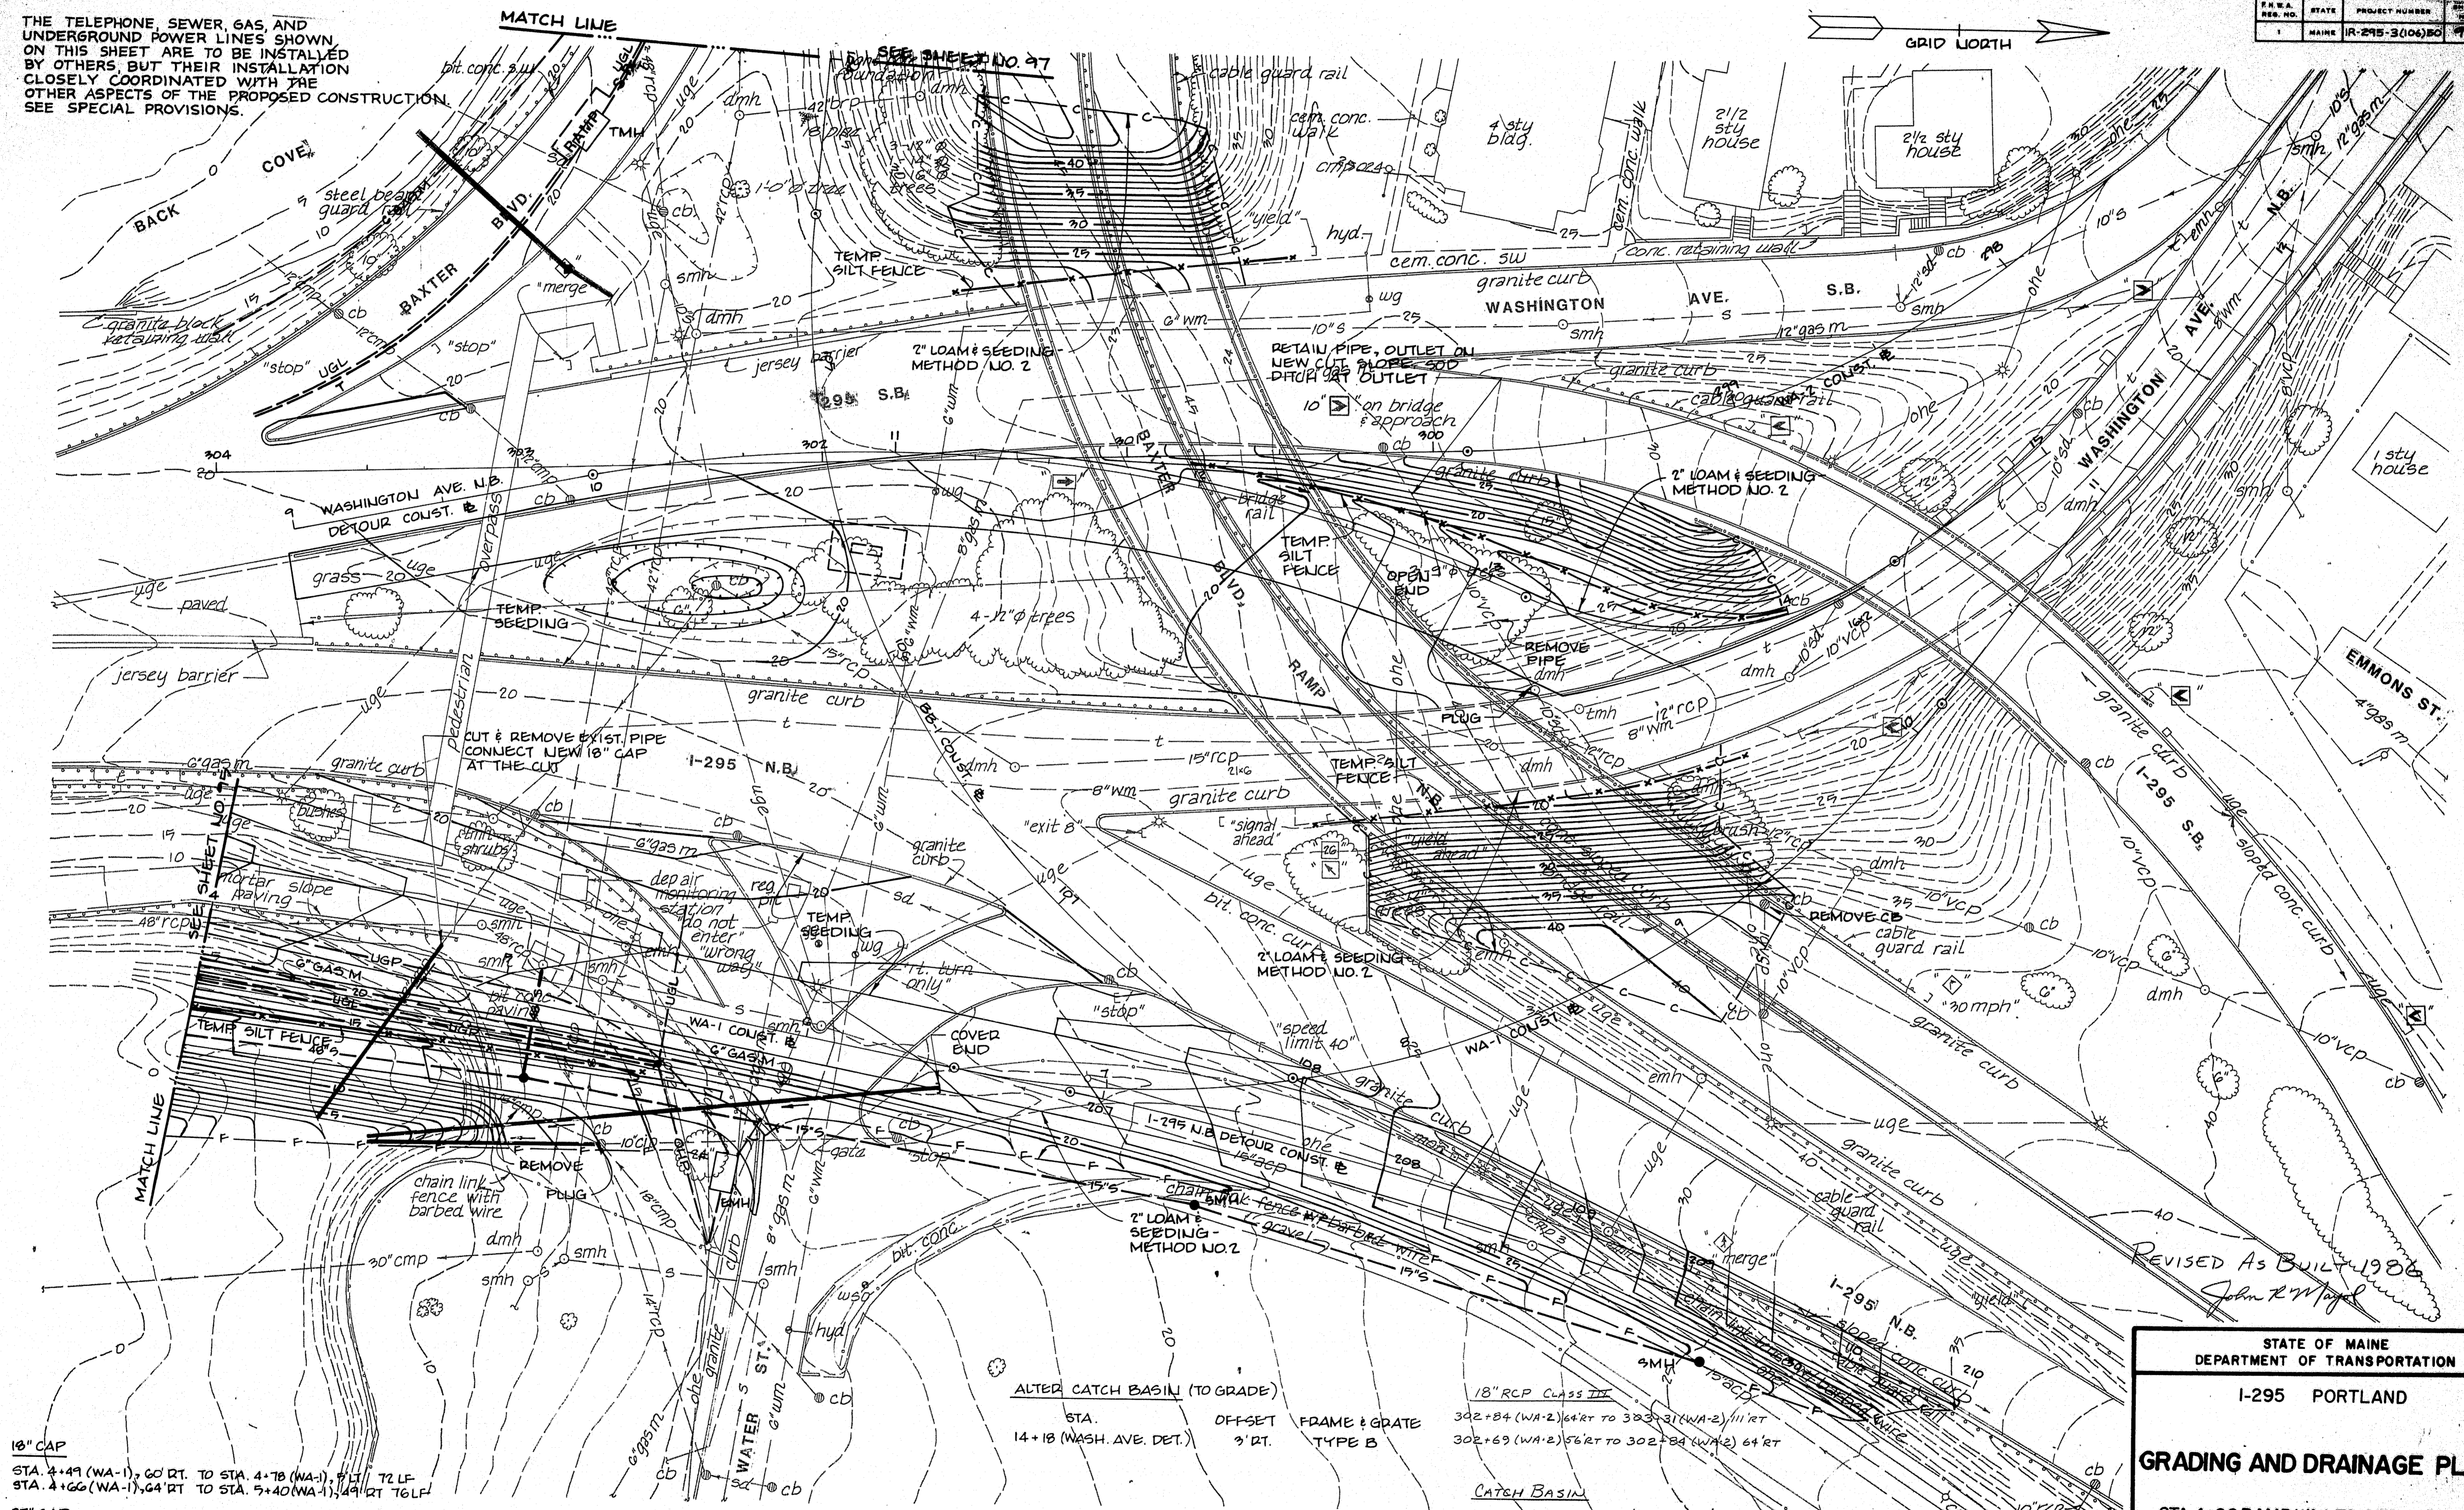

PROJECT DESIGN ENGINEER	DATE
DESIGN - DETAILED	
CHECKED	
FIELD CHANGES	

18" CAP
 STA. 4+49 (WA-1), 60' RT. TO STA. 4+78 (WA-1), 5' LT. 72' LF.
 STA. 4+66 (WA-1), 64' RT. TO STA. 5+40 (WA-1), 49' RT. 76' LF.

21" CAP
 STA. 4+66 (WA-1), 62' RT. TO STA. 6+47 (WA-1), 8' RT. 108' LF.

ALTER CATCH BASIN (TO GRADE)
 STA. 14+18 (WASH. AVE. DET.) OFF-SET 9' RT. FRAME & GRATE TYPE B

18" RCP CLASS III
 302+84 (WA-2) 64' RT. TO 303+31 (WA-2) 111' RT.
 302+69 (WA-2) 56' RT. TO 302+84 (WA-2) 64' RT.

CATCH BASIN
 302+84 (WA-2) 65' RT. A-1

REVISED AS BUILT 1986
 John R. M. [Signature]

STATE OF MAINE
 DEPARTMENT OF TRANSPORTATION

I-295 PORTLAND

GRADING AND DRAINAGE PLAN



STA. 4+00 RAMP WA-1 TO STA. 210+00
 I-295 N. B. DETOUR

SHEET 96 OF 130 AUGUSTA, MAINE

103-337



F.R.A. NO.	STATE	PROJECT NUMBER	SHEET NO.	TOTAL SHEETS
1	MAINE	IR-295-300650	97	120

NOTE:
 THE TELEPHONE, SEWER, GAS, AND UNDERGROUND POWER LINES SHOWN ON THIS SHEET ARE TO BE INSTALLED BY OTHERS, BUT THEIR INSTALLATION MUST BE COORDINATED WITH THE OTHER ASPECTS OF THE PROPOSED CONSTRUCTION. SEE SPECIAL PROVISIONS.

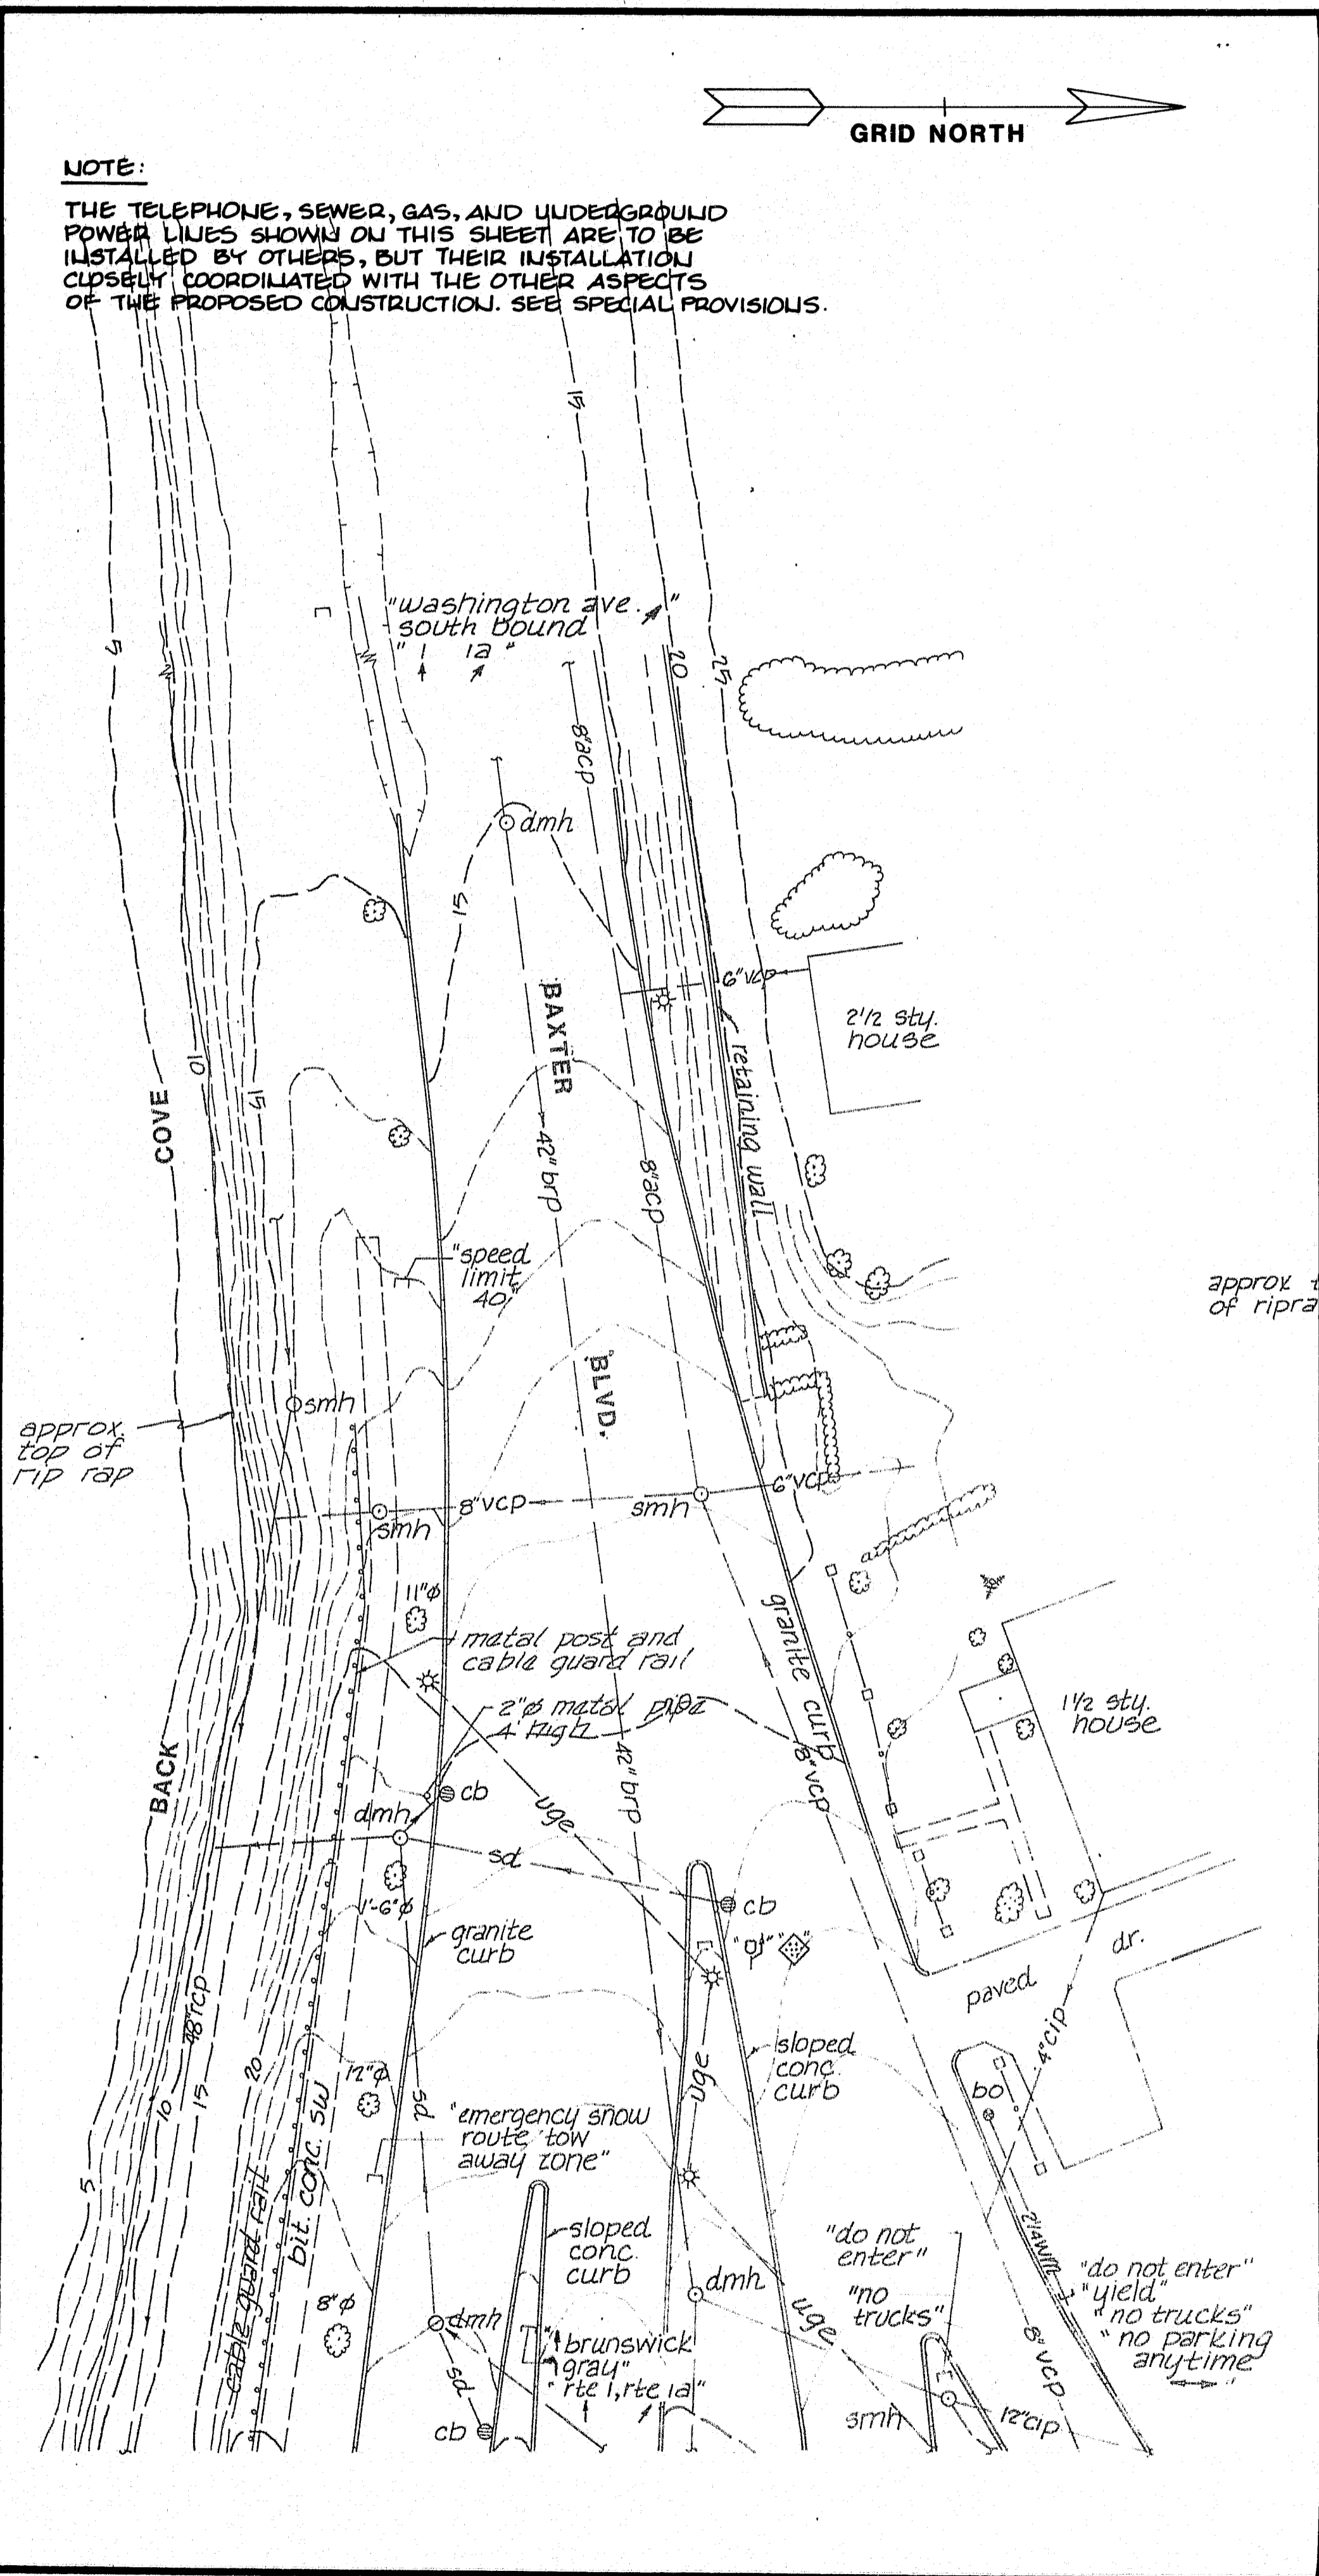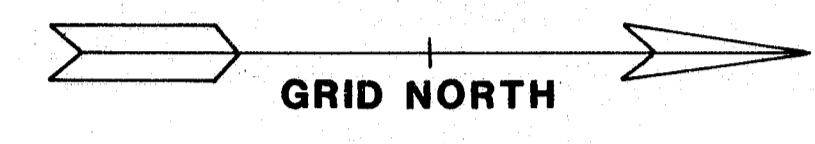

PROJECT DESIGN ENGINEER	DATE
BY	
DESIGN CHECKED	
REVISIONS	
FIELD CHANGES	
PLANS	

BRUNING 44132-4570-1

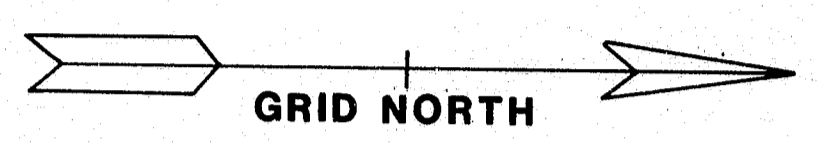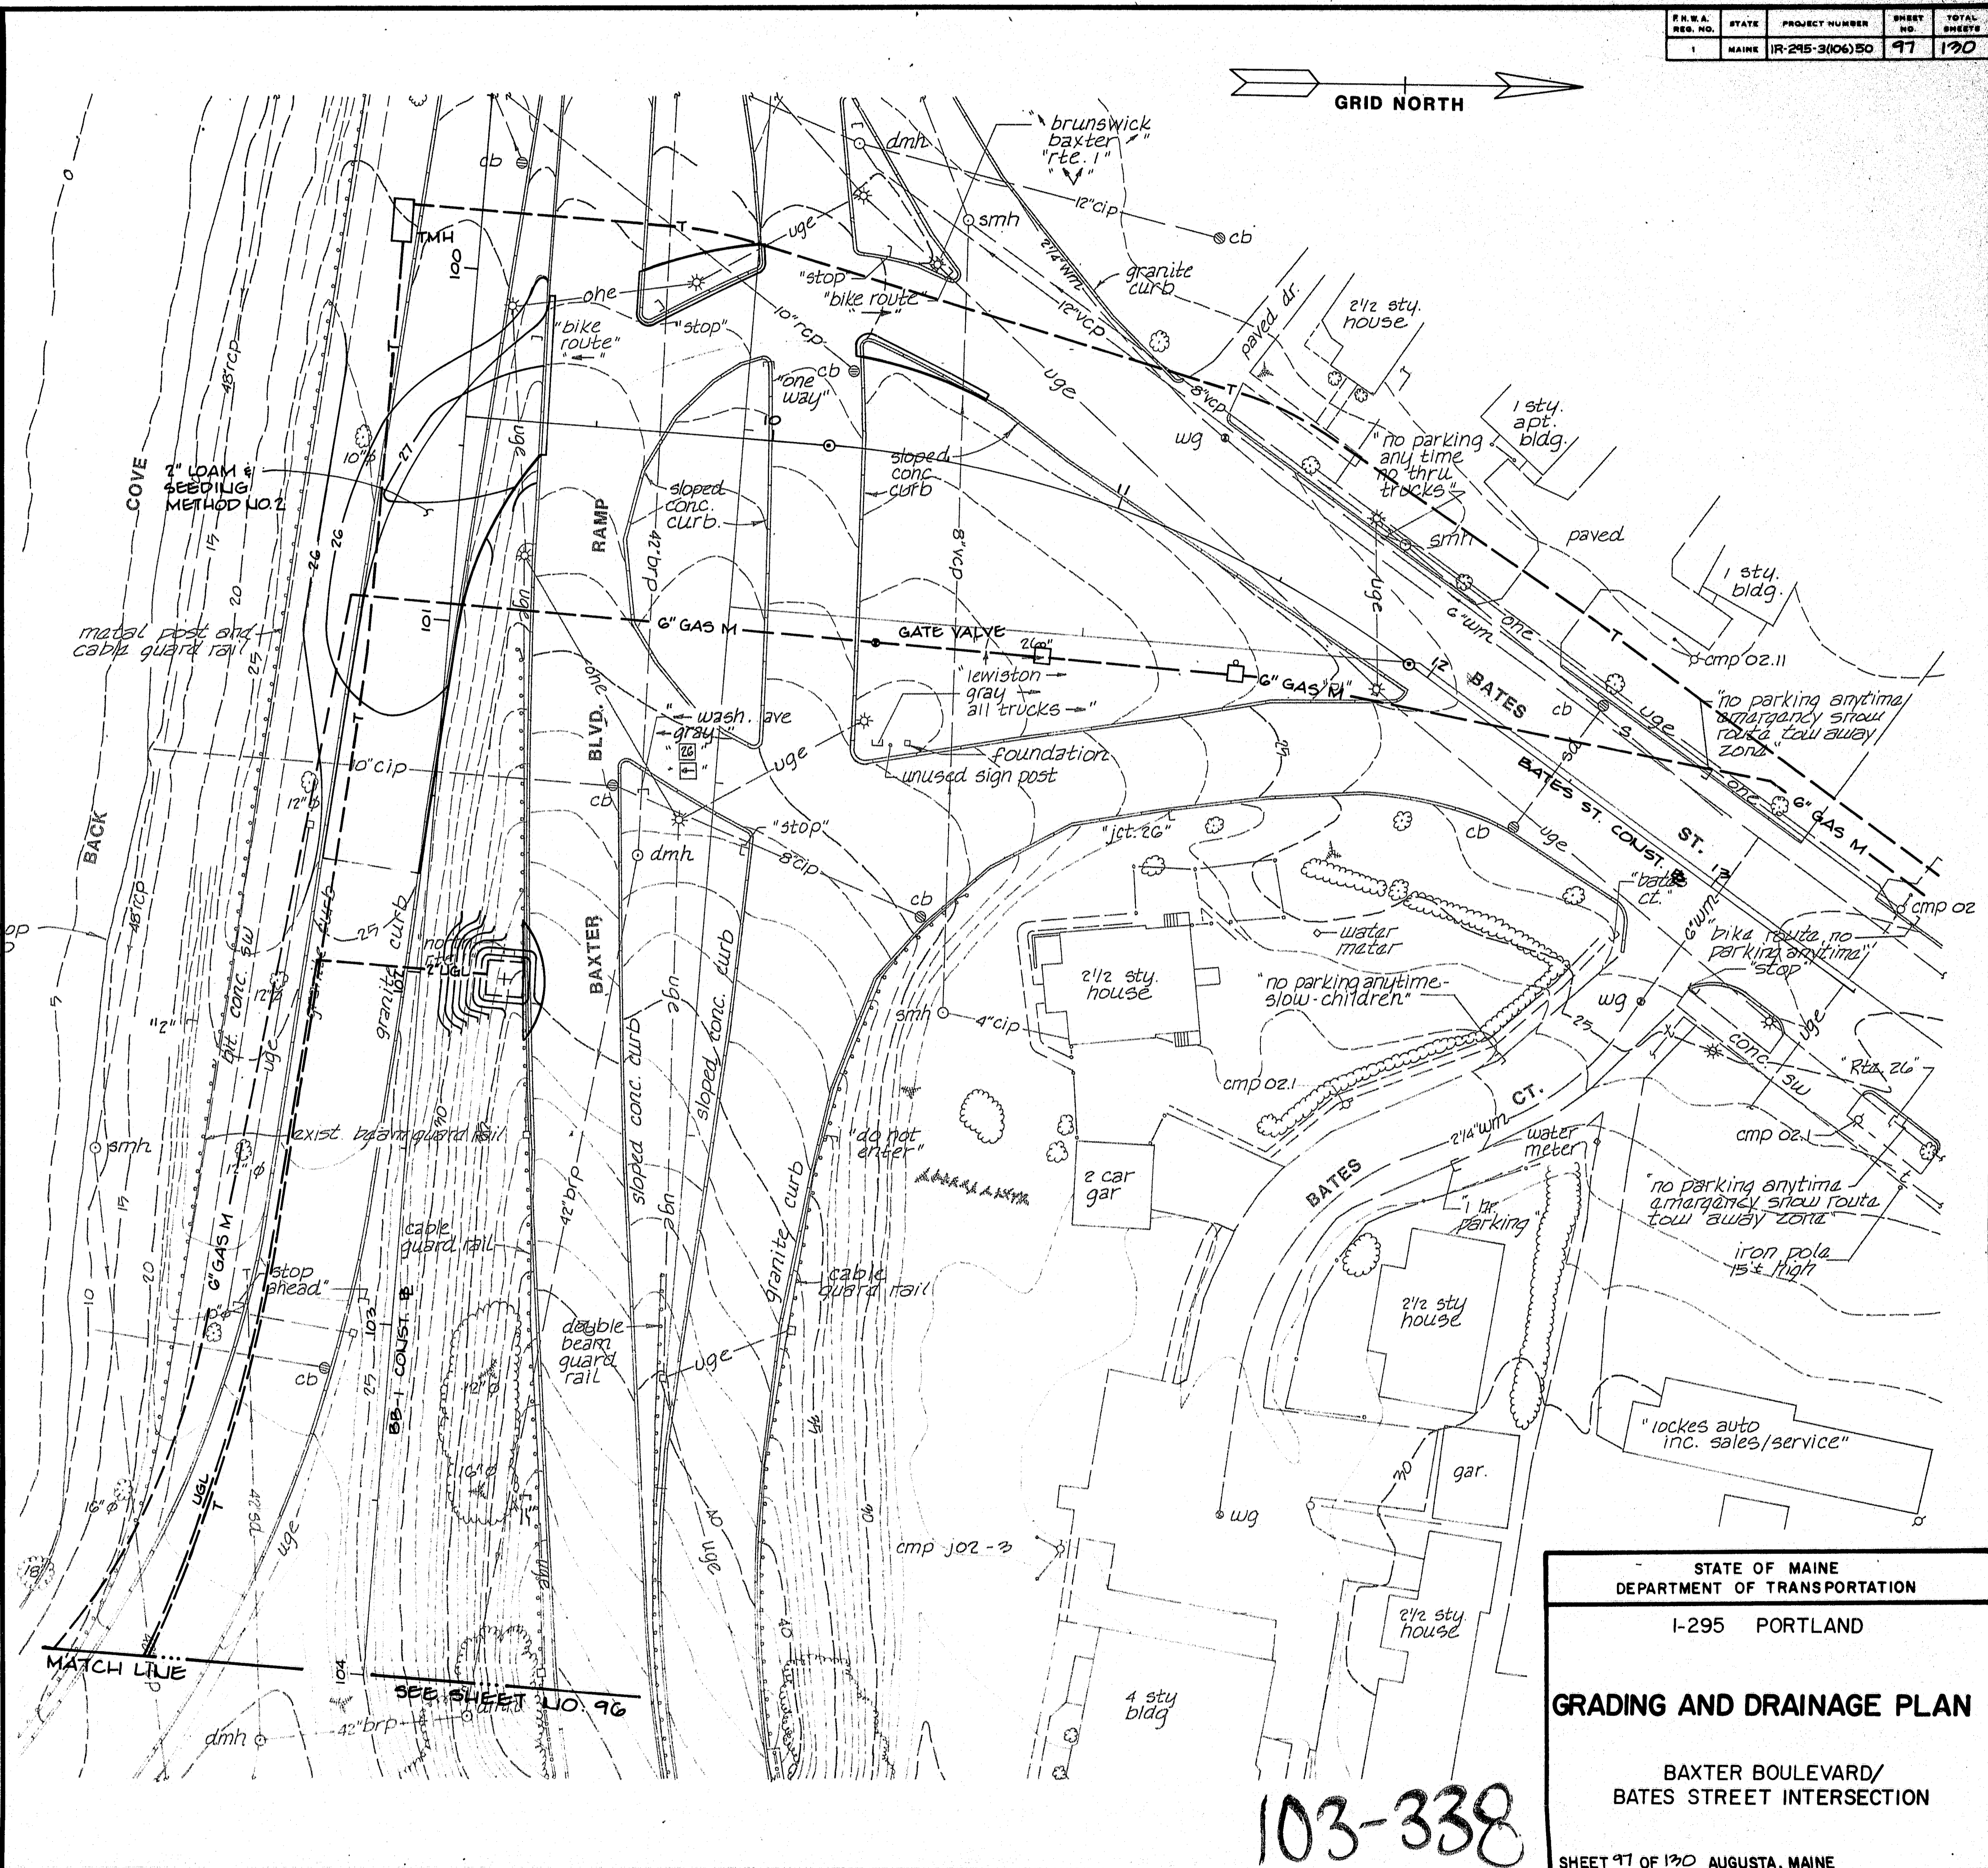

STATE OF MAINE
 DEPARTMENT OF TRANSPORTATION
 I-295 PORTLAND

GRADING AND DRAINAGE PLAN


BAXTER BOULEVARD/
 BATES STREET INTERSECTION

103-338

SHEET 97 OF 120 AUGUSTA, MAINE

DATE	
BY	
REVISIONS	
NO.	DESCRIPTION

DATE	
BY	
REVISIONS	
NO.	DESCRIPTION

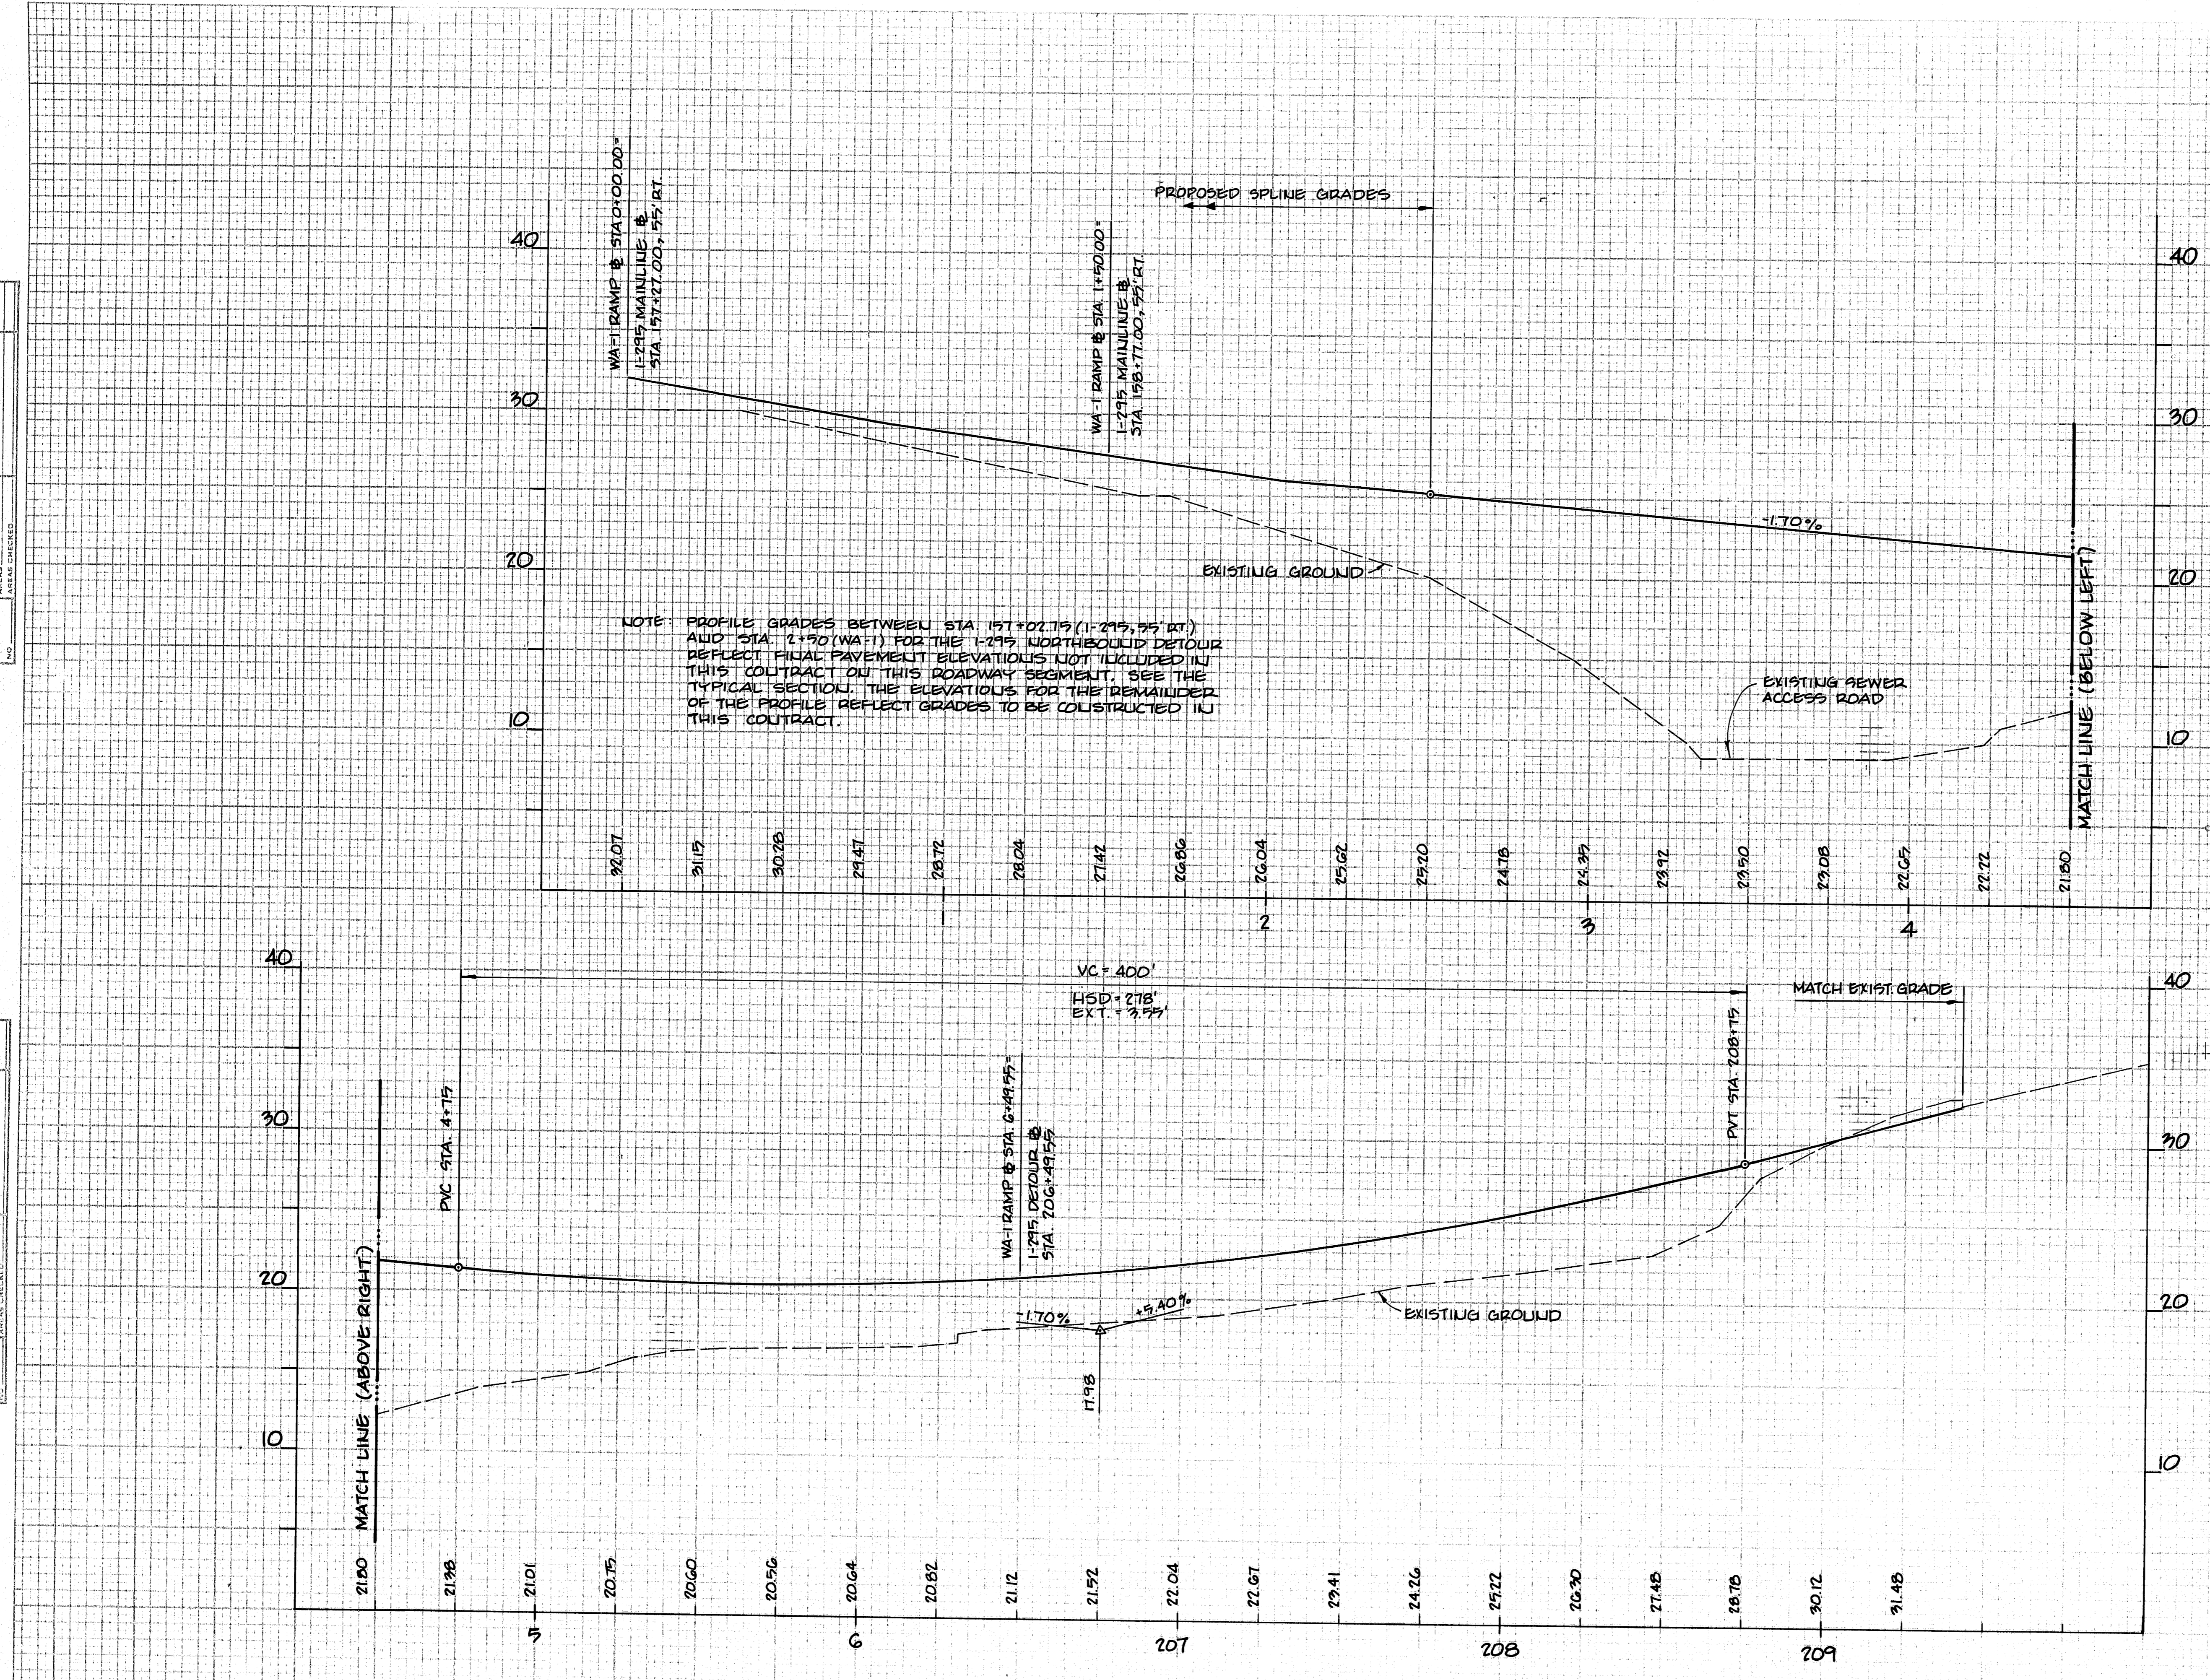

103-339

STATE OF MAINE
DEPARTMENT OF TRANSPORTATION

I-295 PORTLAND

PROFILE

I-295 NORTHBOUND DETOUR


SCALES: HOR. 1" = 25'
VER. 1" = 5'

SHEET 48 OF 130 AUGUSTA, MAINE

F.M.W.A. REG. NO.	STATE	PROJECT NUMBER	SHEET NO.	TOTAL SHEETS
1	MAINE	IR-295-3 (106)50	99	130

DATE	BY

DATE	BY

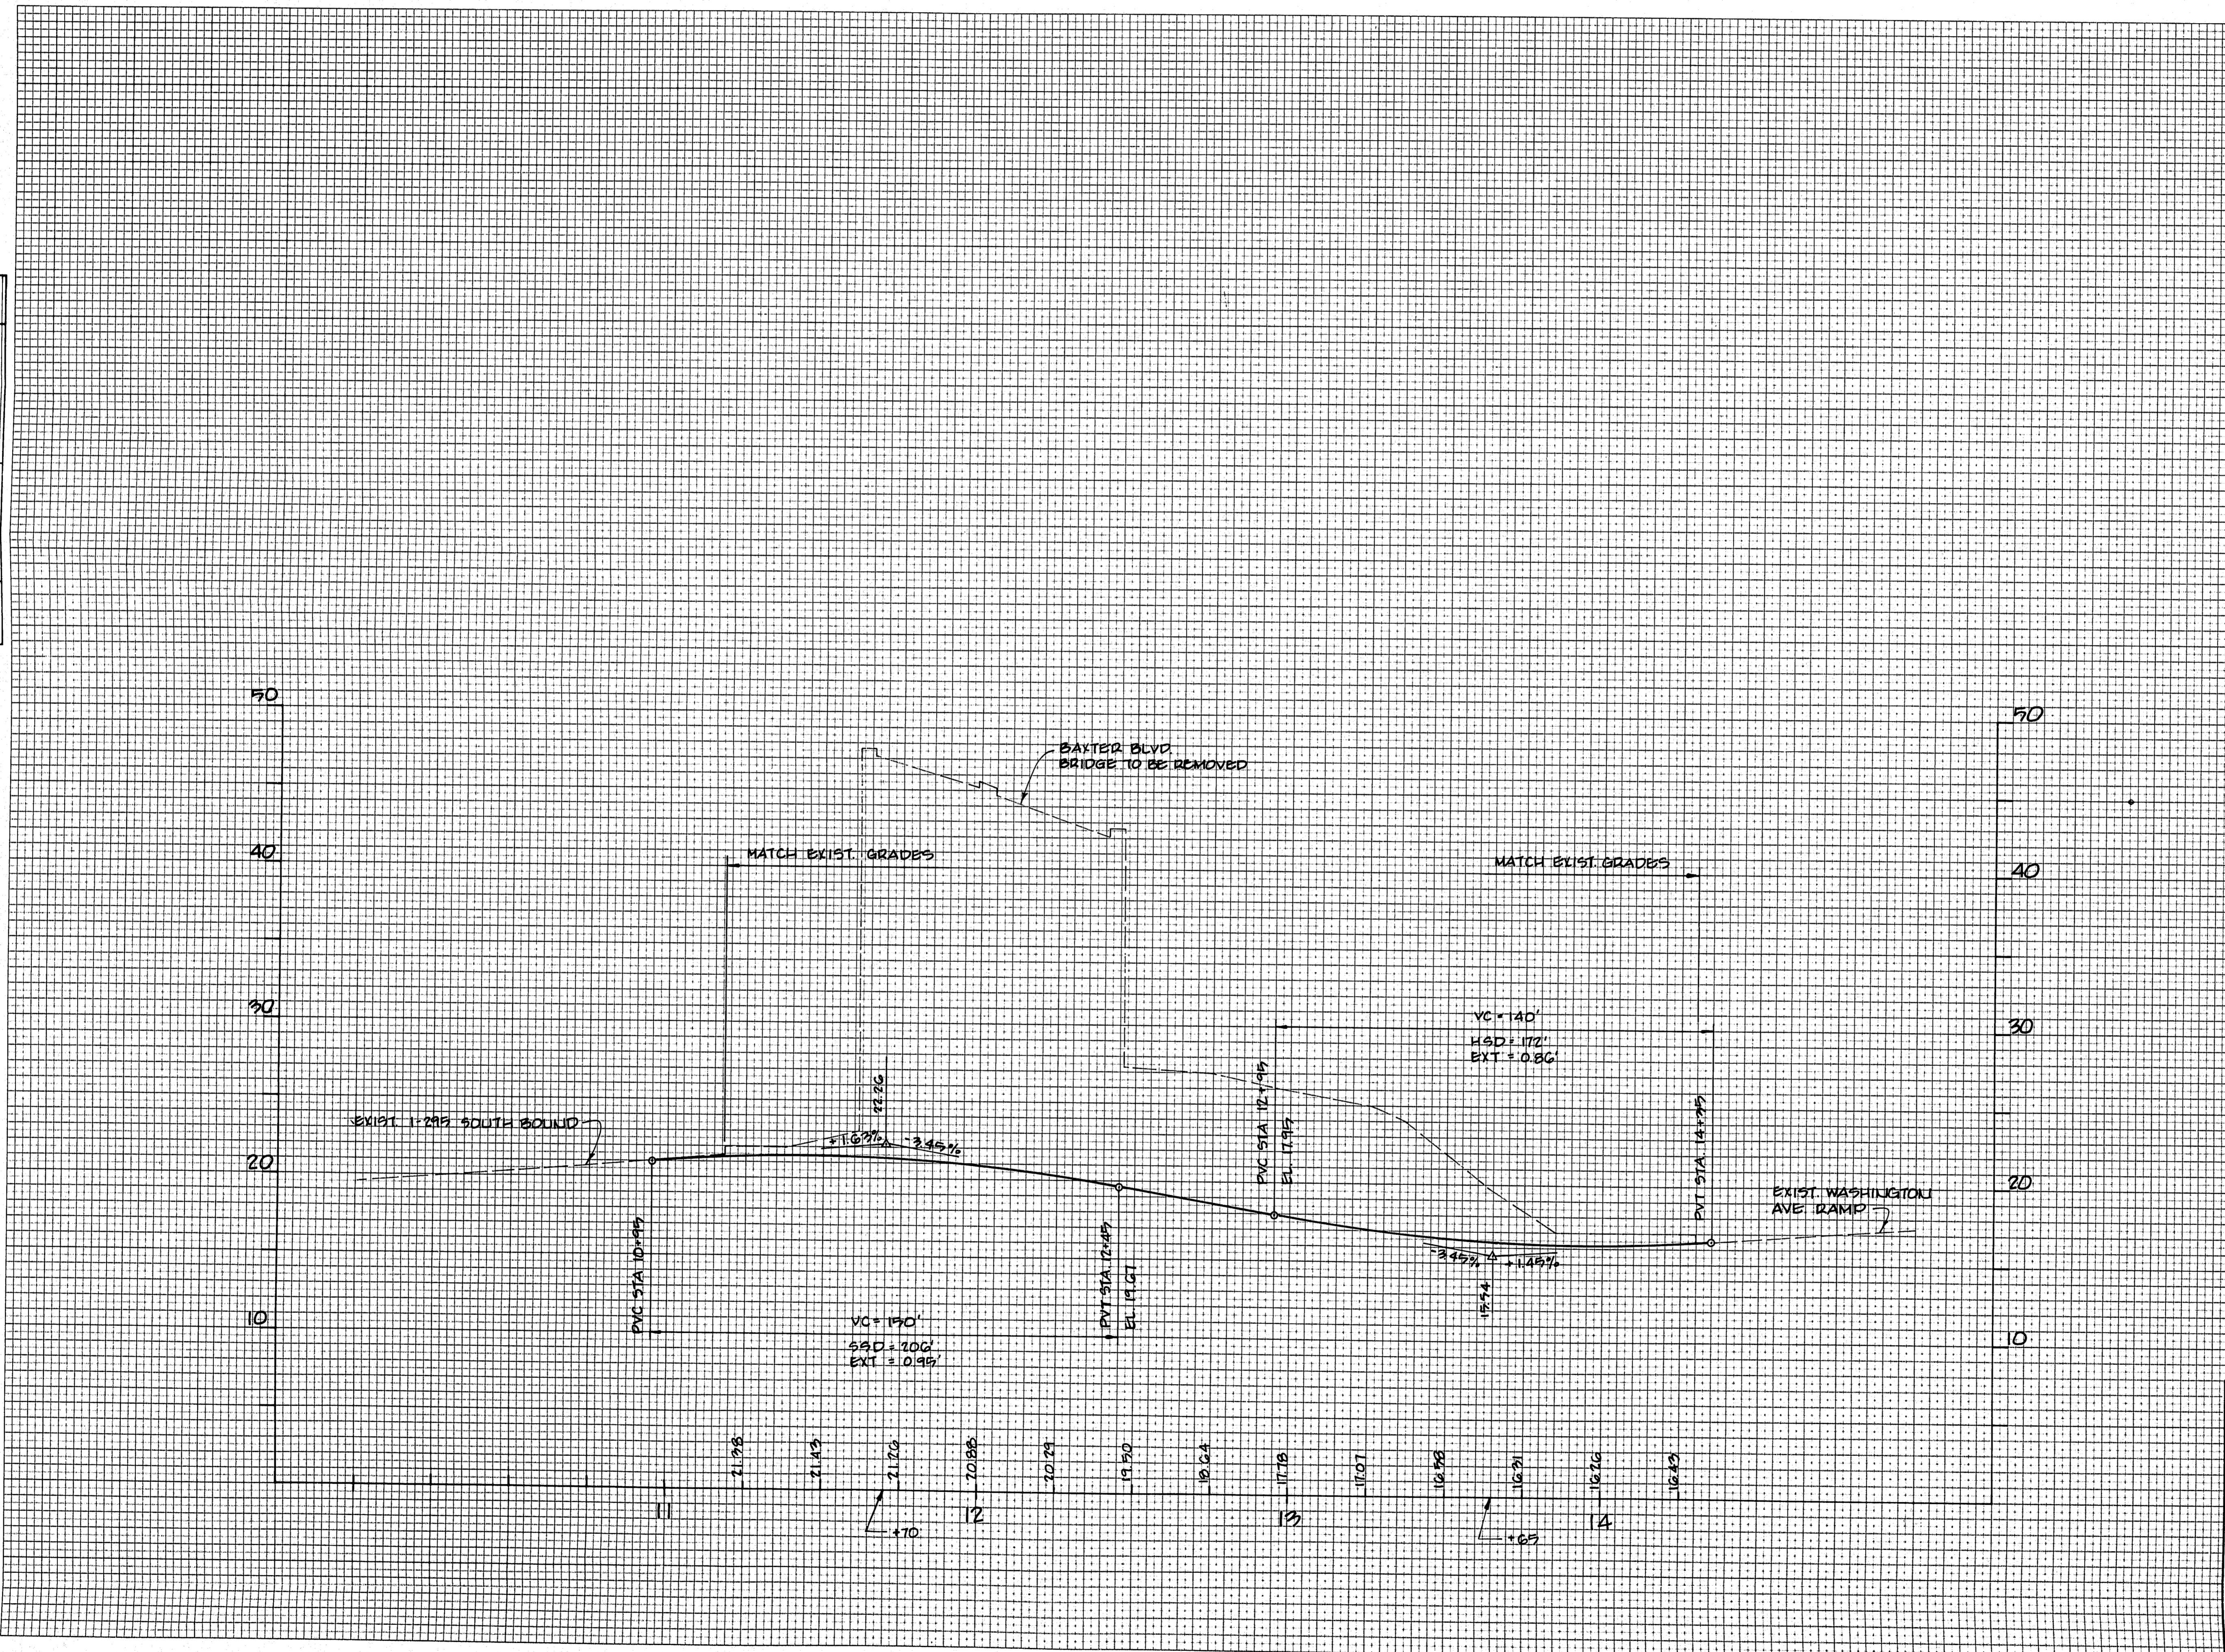

103-340

STATE OF MAINE
DEPARTMENT OF TRANSPORTATION

I-295 PORTLAND

PROFILE

WASHINGTON AVENUE NORTHBOUND DETOUR

SCALES: HOR. 1" = 25'
VER. 1" = 5'

SHEET 99 OF 130 AUGUSTA, MAINE